



NOTE:
1. "WS" DENOTES WATER SERVICE AND THE DIMENSIONS ARE MEASURED FROM EACH LOT CORNER TO ITS CORRESPONDING WATER METER LOCATION.
2. "WV" DENOTES WATER VALVE AND THE DIMENSIONS ARE MEASURED FROM EACH LOT CORNER TO ITS CORRESPONDING LABELED VALVE LOCATION.

WATER AS-BUILT DATA			
ITEM	NORTHING	EASTING	ELEVATION
GATE-VALVES			
A	1065765.20	2344137.76	364.37
B	1065940.30	2344692.79	365.50
C	1065943.62	2344695.65	366.02
D	1066206.46	2344721.44	366.374
E	1066163.49	2344725.54	367.46
F	1066437.44	2344605.76	359.93
G	1066435.42	2344563.60	359.40
H	1066485.38	2344143.11	371.44
45 DEGREE BENDS			
A	1066468.60	2344536.31	NA
STEEL CASING			
A	1066118.46	2344723.00	NA
B	1066156.39	2344725.19	NA
C	1066437.30	2344602.79	NA
D	1066435.50	2344572.69	NA
WATER SERVICES			
LOT 1	1066158.39	2344743.90	368.60
LOT 2	NA	NA	NA
LOT 3	NA	NA	NA
LOT 4	1066488.37	2344506.56	360.39
LOT 5	1066461.03	2344506.64	357.09
LOT 6	1065946.97	2344682.91	365.39
FIRE HYDRANT			
A	1065942.84	2344689.81	366.03
B	1066440.90	2344607.27	360.67
C	1066834.33	2345214.17	371.69

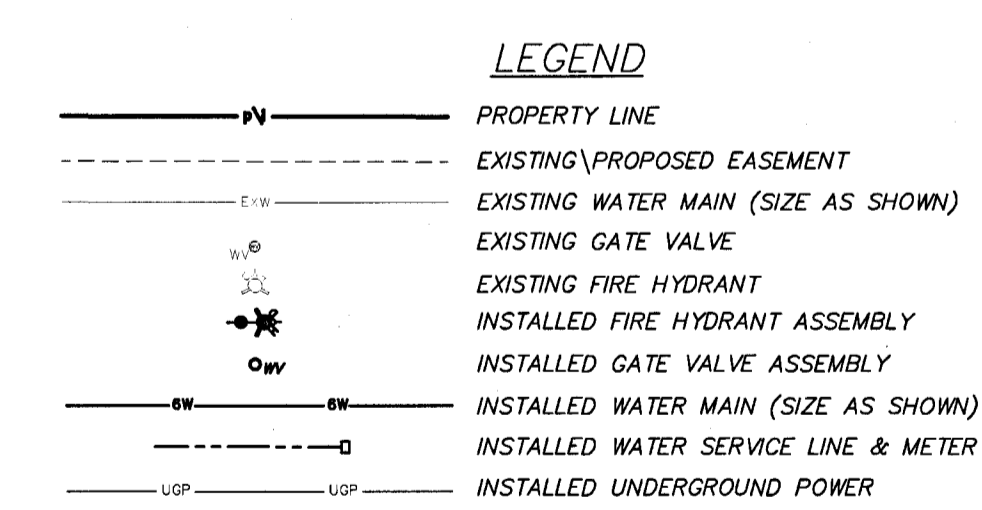

NOTE:
1. THE LOCATION OF THE WATER LINE AS SHOWN IS BASED ON THE FIELD LOCATED VALVES AND HYDRANTS.
2. WATER SERVICES FOR LOT 2 & 3 WILL BE INSTALLED AT A FUTURE DATE, THE LOCATION SHOWN ON THE PLANS ARE THE PROPOSED LOCATIONS.
3. EASEMENTS SHOWN WERE PROVIDED BY OTHERS.
4. DIMENSIONS ON WATER SERVICE LINES ARE FROM EACH LOT CORNER TO WHERE EACH WATER METER WAS INSTALLED WHEN CONSTRUCTION WAS COMPLETE.
5. THE LOCATION OF FUTURE TRANSFORMERS WERE PROVIDED BY OTHERS.

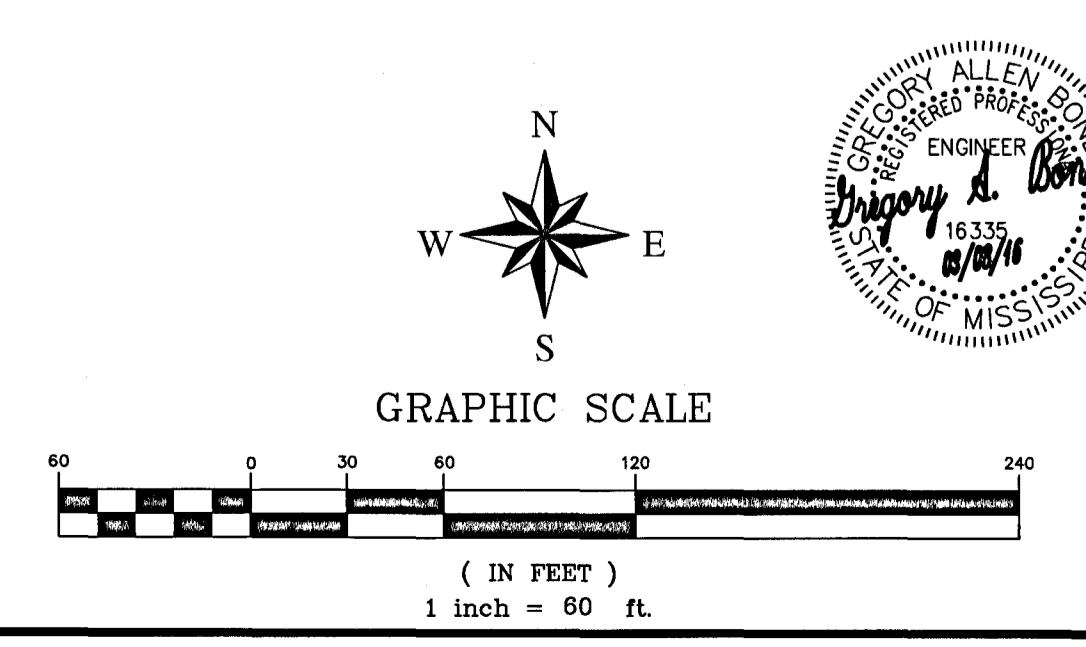

PWP-00238