


WELL NO.	DATE	LOCATION	CAPING SIZE	DEPTH	CAPACITY (GAL)	ELECTRIC MOTOR	AUXILIARY POWER	REMARKS
1	1971	BOGDAN ROAD AT WEST SIDE PLANT	12"x4"	570'	300		DIRECT DRIVE ENGINE	
2	1972	BOGDAN ROAD	12"x5"	584'	300		DIRECT DRIVE ENGINE	REBUILT AND LOWERED 50' IN 1990
3	1975	RICE ROAD	12"x8"	894'	400		DIRECT DRIVE ENGINE	REBUILT AND LOWERED 50' IN 1990
4	1979	ST AUGUSTINE ROAD	12"x8"	524'	400		DIRECT DRIVE ENGINE	
5	1988	CLARKWELL ROAD	12"x8"	1190'	1000		DIRECT DRIVE ENGINE	
6	1990	HWY. 493 SOUTH OF THE CROSS	18"x12"	1202'	1000		DIRECT DRIVE ENGINE	
7	1995	PEARL RIVER CHURCH ROAD	18"x10"		1000		DIRECT DRIVE ENGINE	

TANK NO.	DATE	TYPE	LOCATION	CAPACITY (GALLONS)	HYDRAULIC GRADE LINE	REMARKS
1	1972	80' x 16' STANDPIPE	LAWSON ROAD WEST SIDE SYSTEM	120,000	541'	
2	1979	125' ELEVATED	HOY ROAD EAST SIDE SYSTEM	300,000	490'	
3	1990	135' ELEVATED	HWY 493 WEST SIDE SYSTEM	300,000	541'	
4	1995	135' ELEVATED	PEARL RIVER CHURCH ROAD EAST SIDE SYSTEM	300,000		

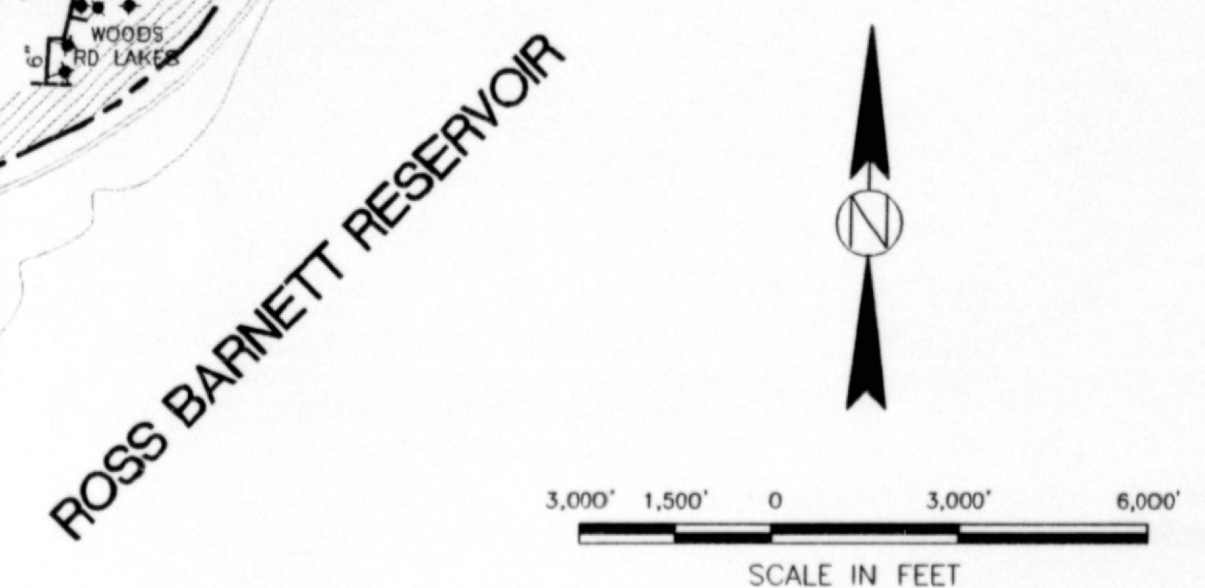

BEAR CREEK WATER ASSOCIATION

DCI DIVERSIFIED CONSULTANTS, INC.
 CONSULTING ENGINEERS ... CITY, COUNTY, AND REGIONAL PLANNERS
 395 EDGEWOOD TERRACE
 JACKSON, MS 39206

046