

TOWNE OF BEAU CHENE

CONSTRUCTION PLANS




VICINITY MAP
SCALE: 1"=2000'

BEAU CHENE INVESTMENTS, LLC
OWNER & DEVELOPER

CONTENTS	
SHEET	DESCRIPTION
1	COVER SHEET
2	LOT LAYOUT & DRAINAGE AND EROSION & SEDIMENT CONTROL PLAN
3	WATER & SEWER LAYOUT
4-5	PLAN & PROFILE SHEETS
6-10	CONSTRUCTION DETAILS

NOTE:
WATER SUPPLY BY CITY OF RIDGELAND.

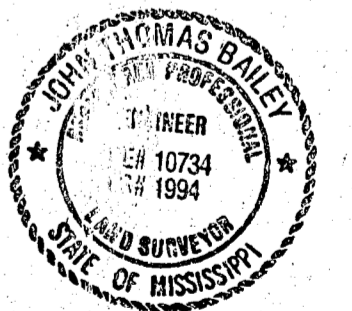

J. Thomas Bailey, P.E.

FINAL PLANS OF
COMPLETED WORK
1-2-07

BAILEY ENGINEERING
Jackson, Mississippi

PWT-02024

GRASSING SCHEDULE

Seed and fertilize all area disturbed within street/road rights-of-way and drainage easements. The following seed mixtures shall be used during the times of year indicated.






March 1 to August 31

Common Bermuda 25 lbs per acre
Bahia 45 lbs per acre

September 1 to February 28

Common Bermuda 15 lbs per acre (use unhulled bermuda)
Bahia 40 lbs per acre
Winter Rye 30 lbs per acre

Before seeding, apply 13-13-13 fertilizer at the rate of 25 lbs per 1000 square feet of seed bed. Sow required seed mixture and rake the seed areas lightly to cover the seeds. Where required, steep slopes and ditch inverts shall be protected with a layer of weed free straw until a growing stand of grass is achieved.

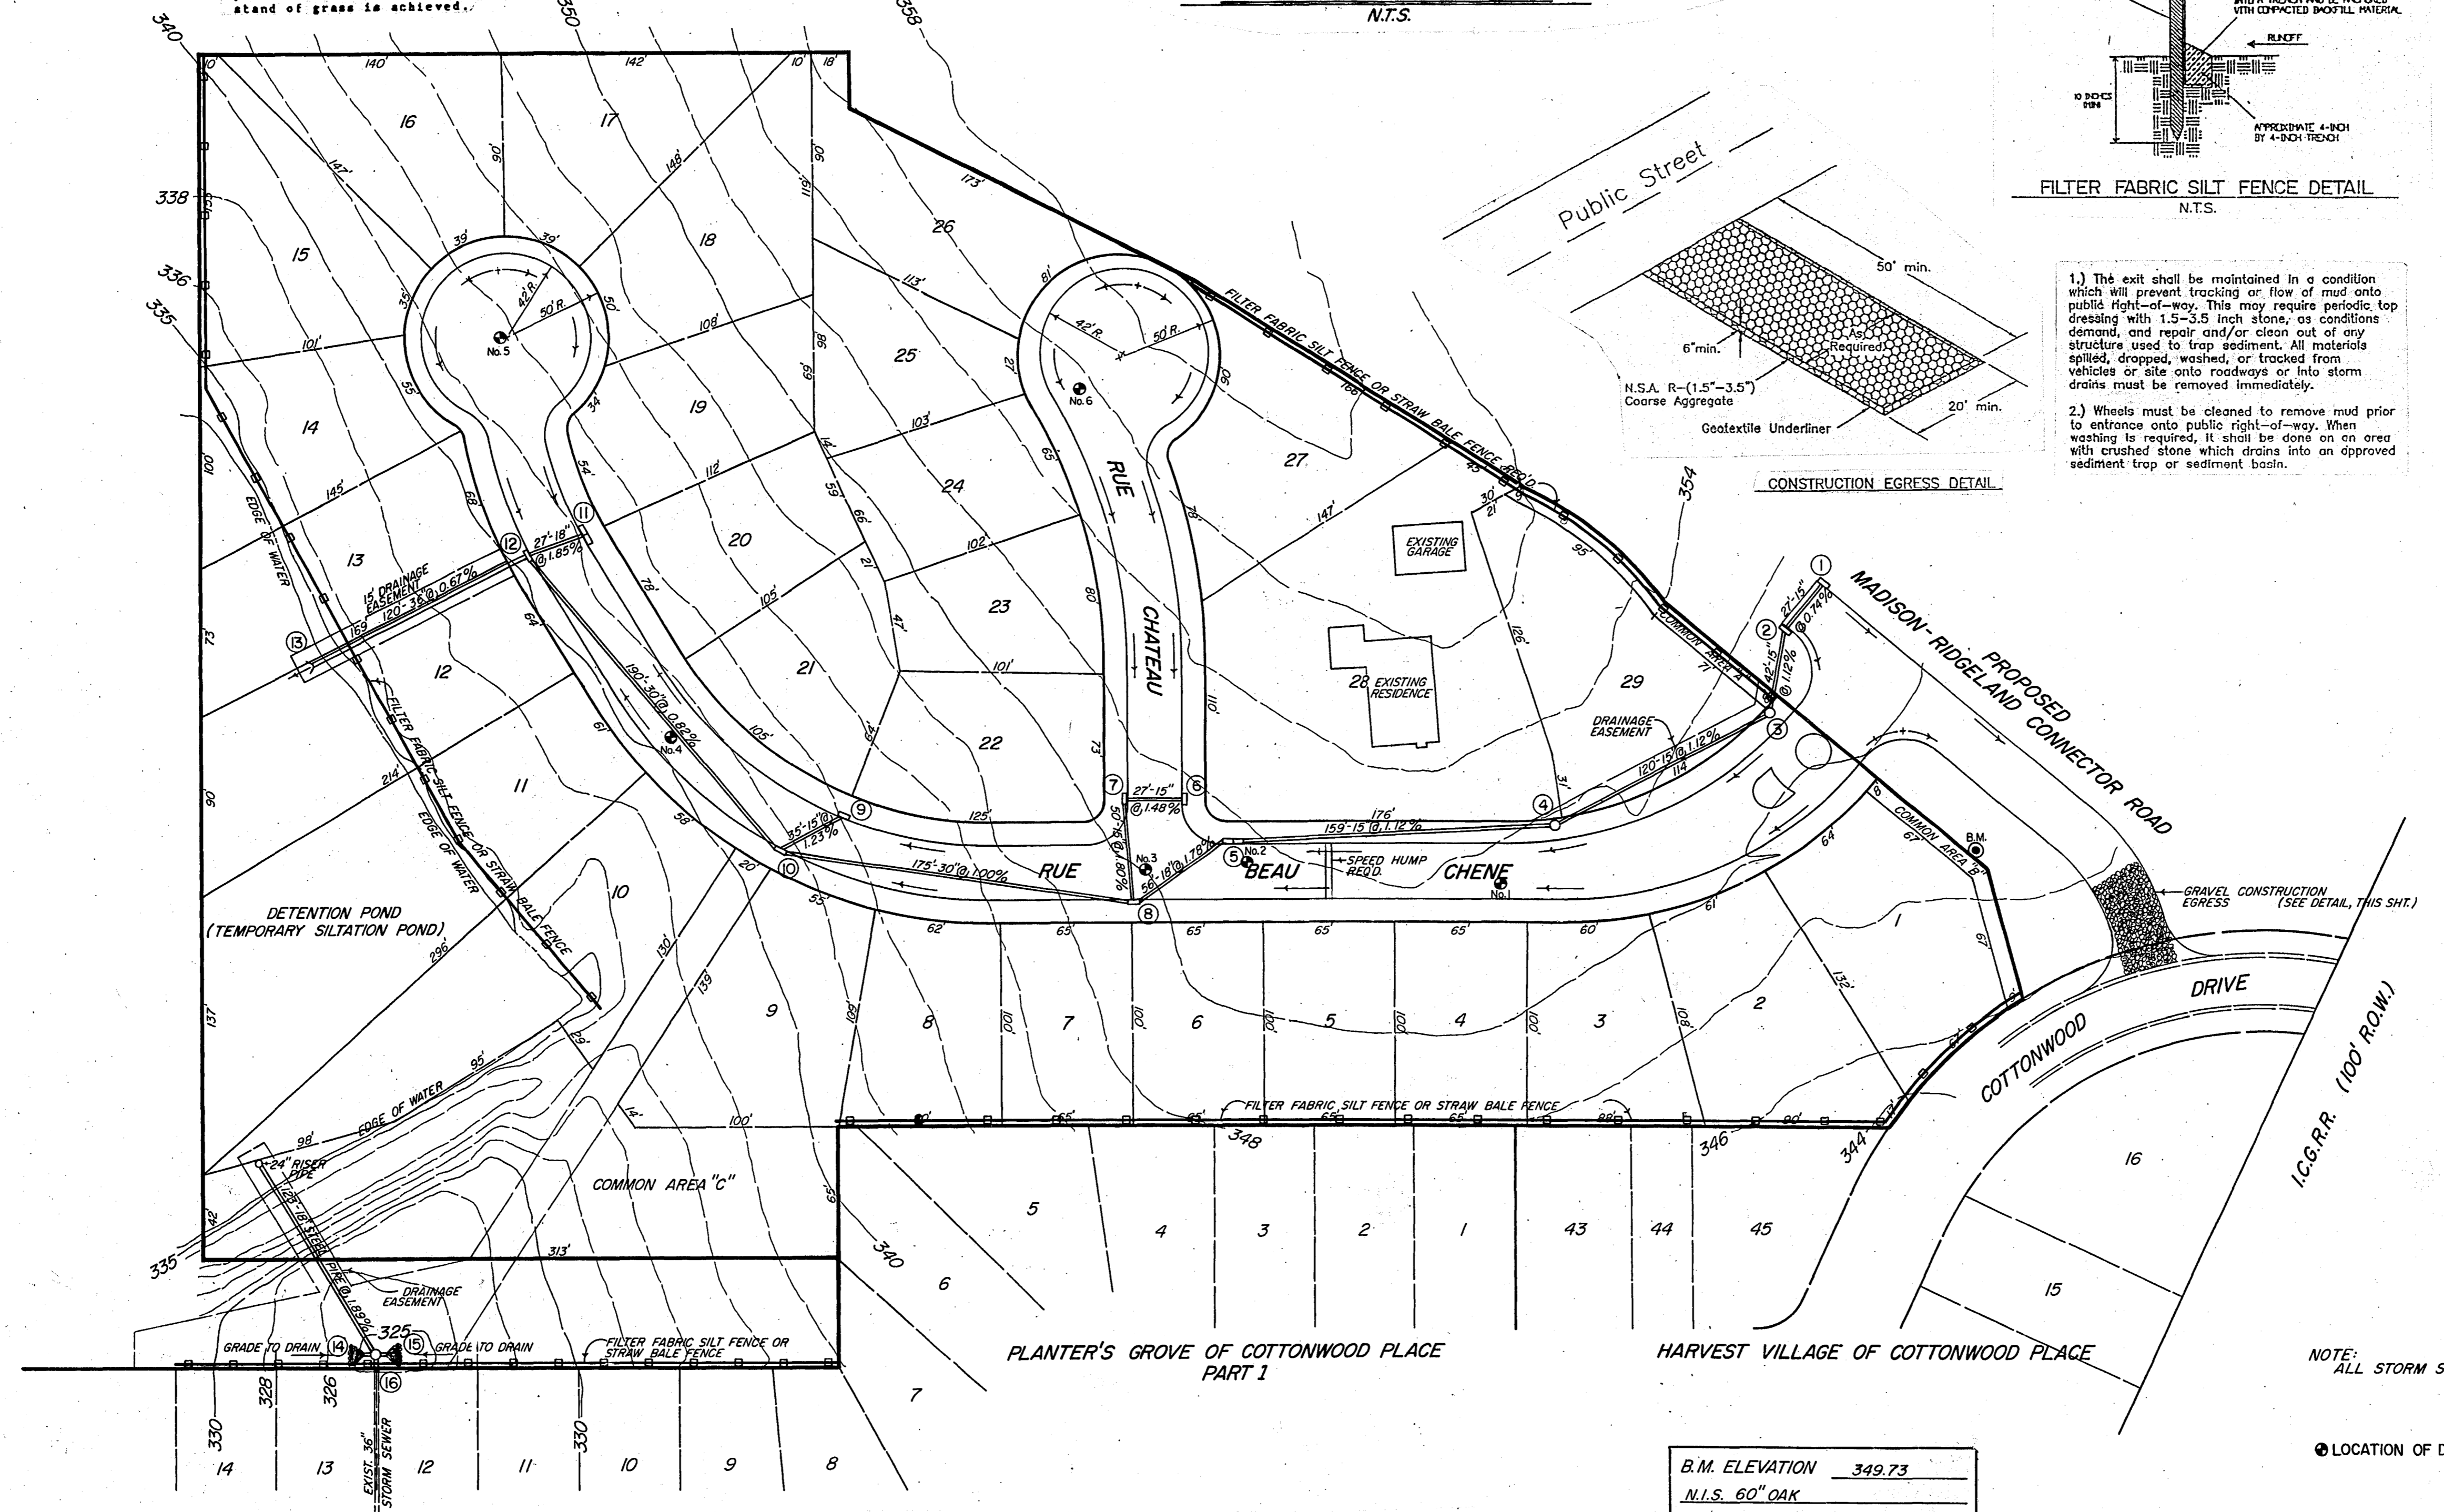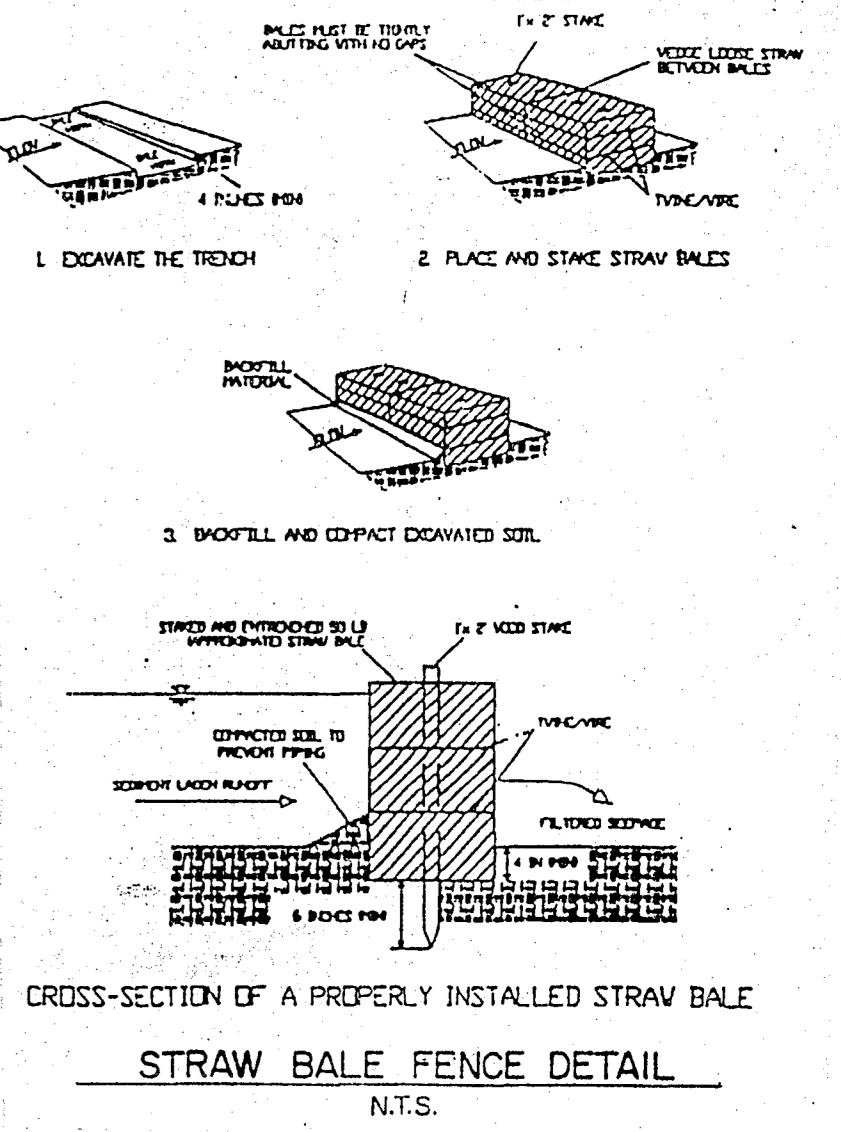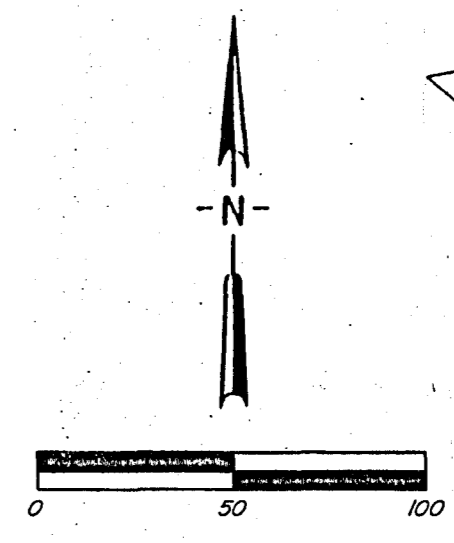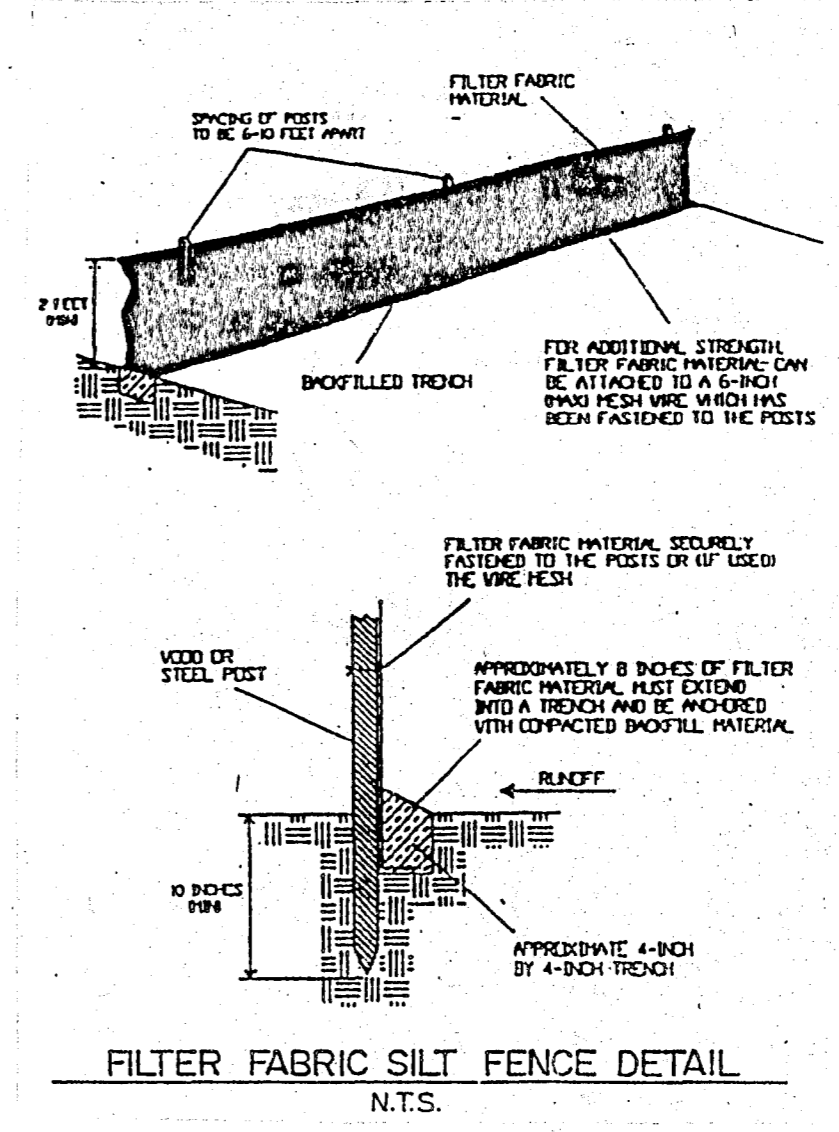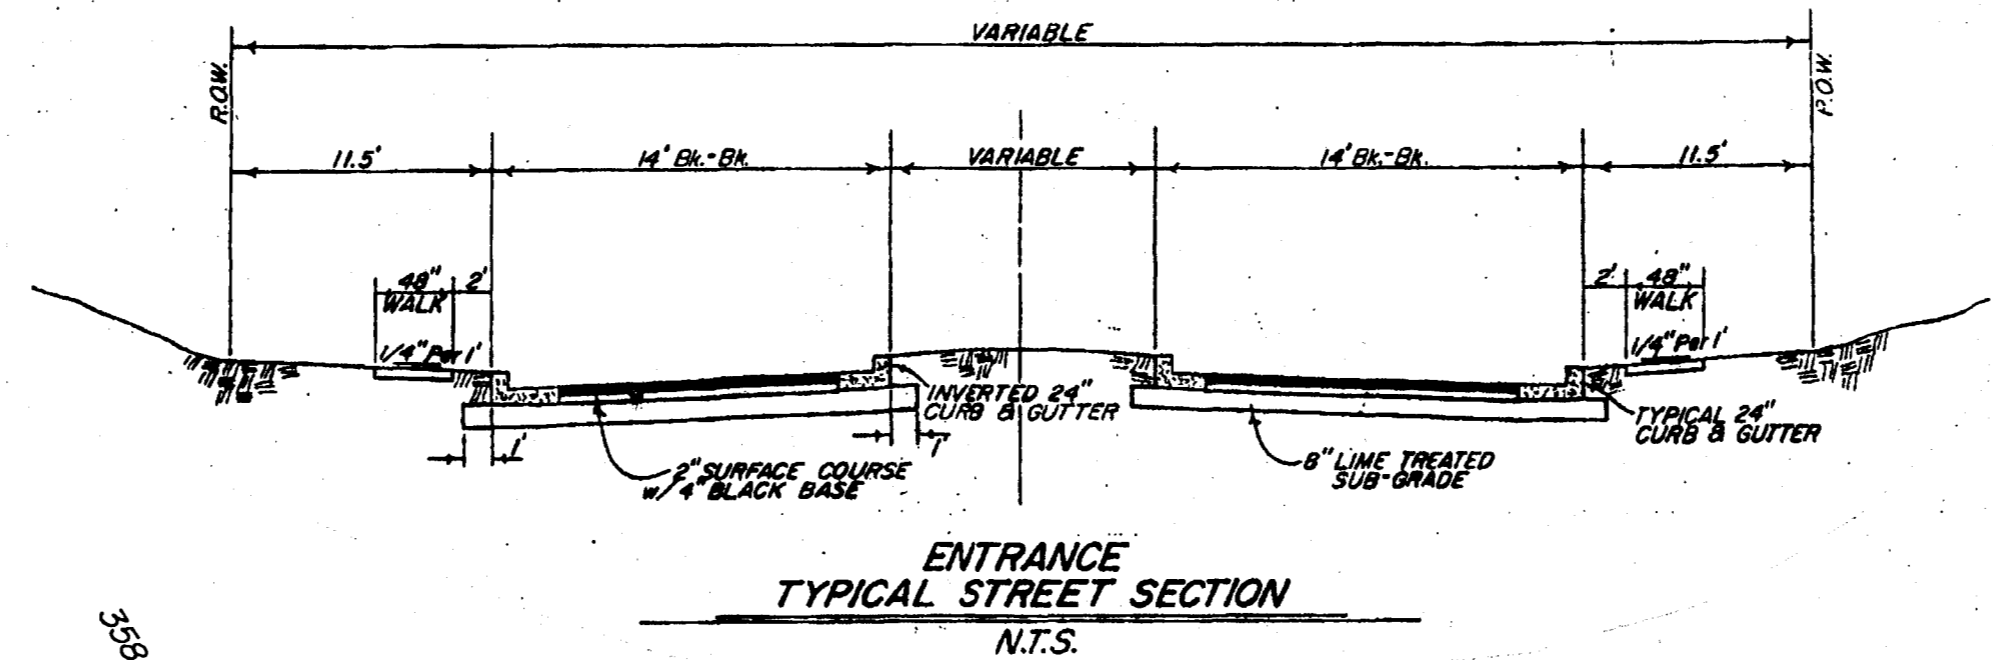


1.) The exit shall be maintained in a condition which will prevent tracking or flow of mud onto public right-of-way. This may require periodic top dressing with 1.5-3.5 inch stone, as conditions demand, and repair and/or clean out of any structure used to trap sediment. All materials spilled, dropped, washed, or tracked from vehicles or site onto roadways or into storm drains must be removed immediately.

2.) Wheels must be cleaned to remove mud prior to entrance onto public right-of-way. When washing is required, it shall be done on an area with crushed stone which drains into an approved sediment trap or sediment basin.

- | | |
|-----------------------------------------------------------------------------------------------------------|-----------------------------------------------------------------------------------------------------------------|
| 1. Curb Inlet
D.A. = 0.3 Ac.
Q = 2.1 cfs
15" Out = 349.00 | 11. Double Curb Inlet
D.A. = 1.3 Ac.
Q = 9.1 cfs
18" Out = 336.50 |
| 2. Curb Inlet
D.A. = 0.8 Ac.
Q = 5.6 cfs
15" In & Out = 348.80 | 12. Curb Inlet
D.A. = 5.4 Ac.
Q = 37.8 cfs
18" In = 336.00
30" In = 335.20
36" Out = 331.80 |
| 3. Storm Sewer Manhole
D.A. = 0.8 Ac.
Q = 5.6 cfs
15" In & Out = 348.33 | 13. 36" Flared End Sect.
36" F.E.S. Out = 331.00 |
| 4. Storm Sewer Manhole
D.A. = 0.8 Ac.
Q = 5.6 cfs
15" In & Out = 346.99 | 14. 15" Flared End Sect.
D.A. = 1.0 Ac
Q = 7.0 cfs
15" F.E.S. In = 325.22 |
| 5. Double Curb Inlet
D.A. = 1.6 Ac.
Q = 11.2 cfs
15" In = 345.20
18" Out = 345.00 | 15. 15" Flared End Sect.
D.A. = 0.2 Ac.
Q = 1.4 cfs
15" F.E.S. In = 325.22 |
| 6. Curb Inlet
D.A. = 0.4 Ac.
Q = 2.8 cfs
15" Out = 346.00 | 16. Tie To Existing 36" w/Storm Sewer Manhole
15" In = 325.14
18" In = 3324.94
Exist. 36" Out = 323.74 |
| 7. Curb Inlet
D.A. = 0.8 Ac.
Q = 5.6 cfs
15" In & Out = 345.60 | |
| 8. Curb Inlet
D.A. = 3.0 Ac.
Q = 21.0 cfs
15" In = 344.70
18" In = 344.00
30" Out = 338.50 | |
| 9. Curb Inlet
D.A. = 0.3 Ac.
Q = 2.1 cfs
15" Out = 338.50 | |
| 10. Curb Inlet
D.A. = 3.6 Ac.
Q = 25.2 cfs
15" In = 338.07
30" In & Out = 336.75 | |

B.M. ELEVATION 349.73
N.I.S. 60" OAK
100 FT. EAST STA. 0+00
ON RUE BEAU CHENE

B.M. ELEVATION 336.06
CHISELED SQUARE ON SE BRIDGE
ABUTMENT - RM 285

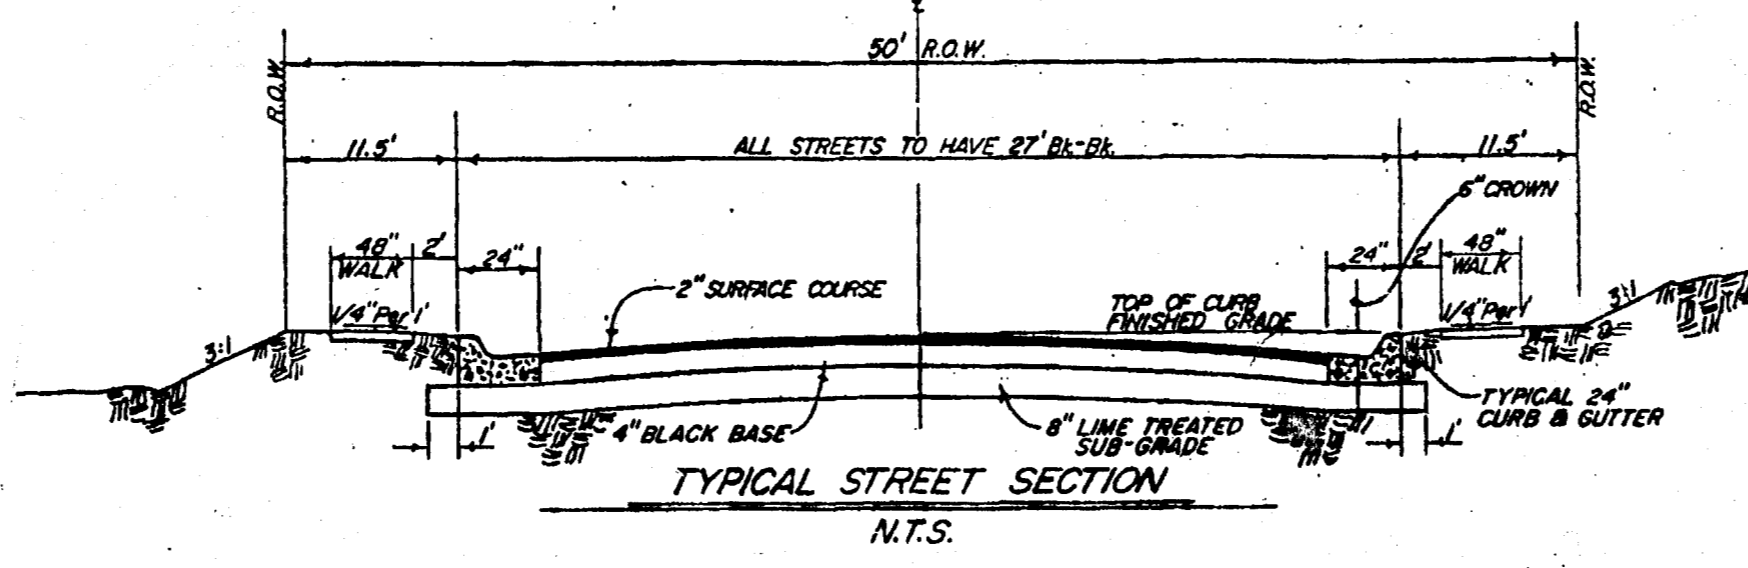

NOTE: CONTOURS ARE 2' INTERVAL.

NOTE: ALL STORM SEWER SHALL BE CONC.

● LOCATION OF DENSITY TEST.



FINAL PLANS OF COMPLETED WORK 1-2-07

DESIGNED: R. DALE	SCALE: 1"=50'				
DRAWN: R. DALE	DWG. NO: 03-301				
APPROVED: T. BAILEY					
DATE: JUNE, 2003					
REV. NO.	DATE	NATURE OF REVISION	BY	CHKD.	APPD.

BAILEY ENGINEERING, INC.
CIVIL ENGINEERING and LAND SURVEYING
JACKSON, MISSISSIPPI

TOWNE OF BEAU CHENE
LOT LAYOUT & DRAINAGE
EROSION & SEDIMENT CONTROL PLAN

SHEET NO. **2**

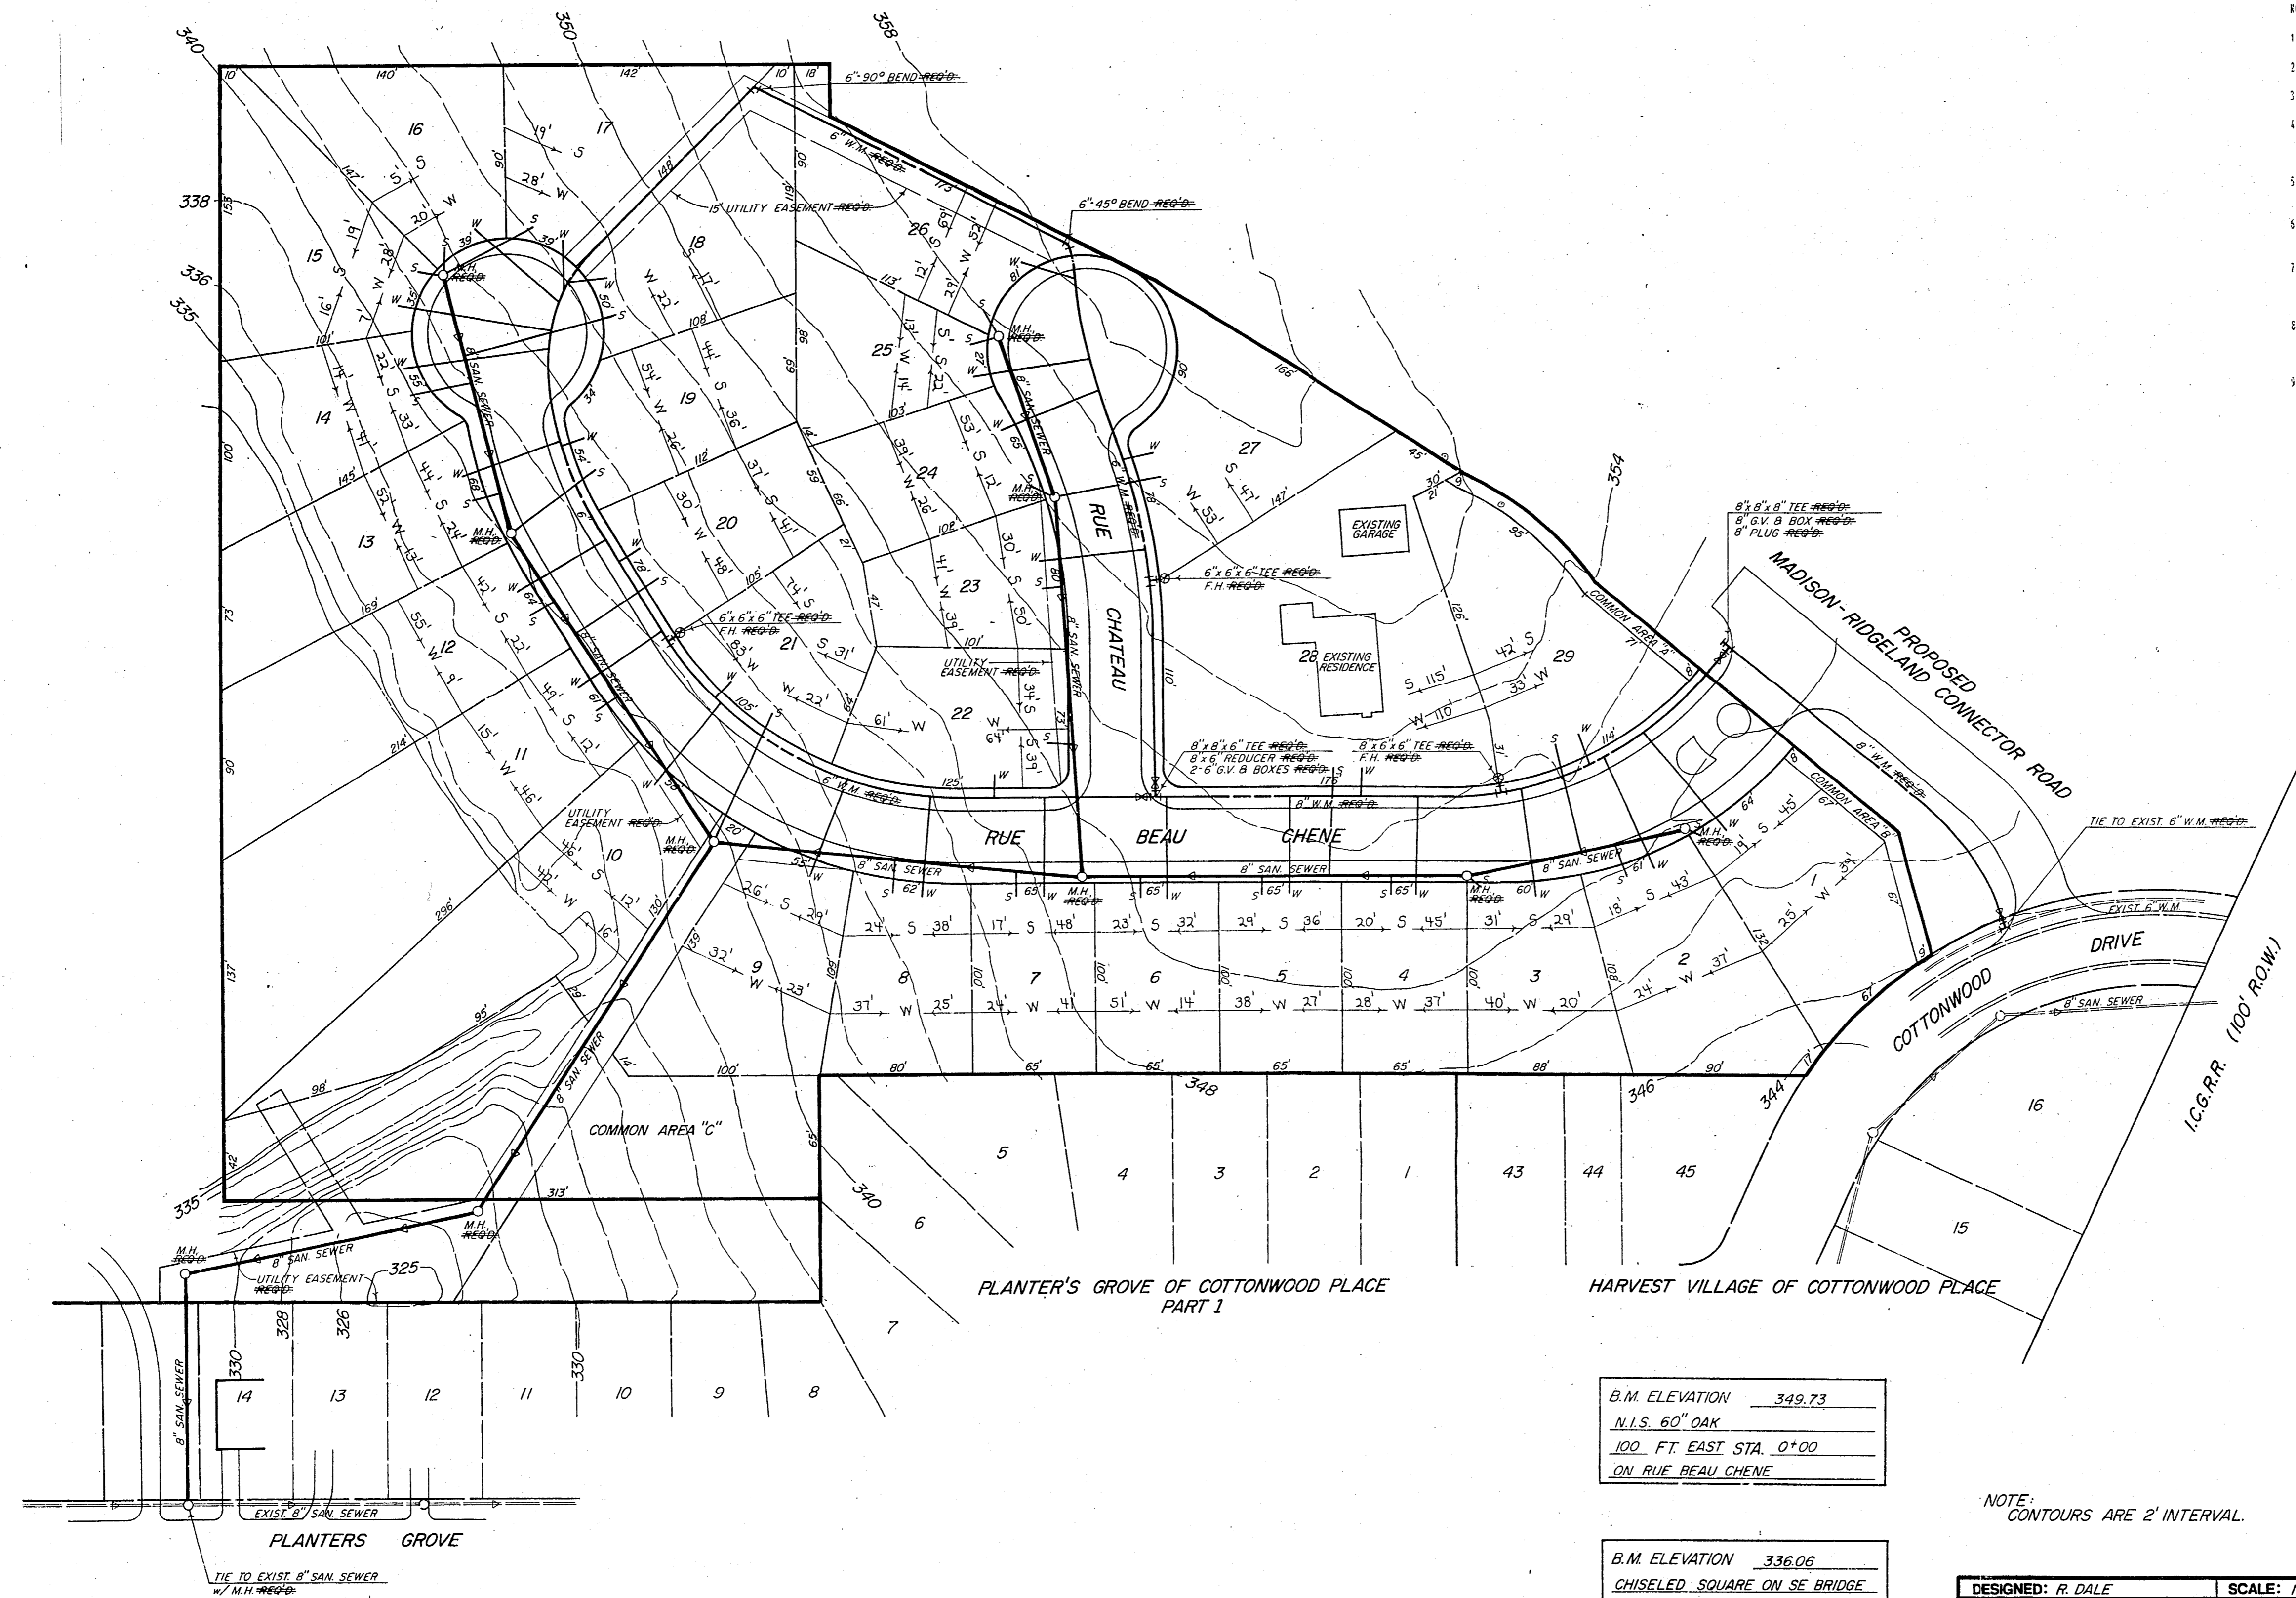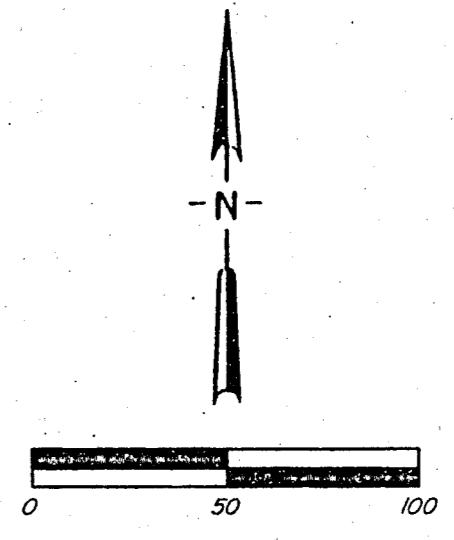

- NOTES:
1. LOT DIMENSIONS ARE SUBJECT TO MINOR CORRECTION.
 2. THE OWNER SHALL FURNISH STREET NAME AND TRAFFIC CONTROL SIGNS AS REQUIRED BY THE CITY OF RIDGELAND.
 3. A 15 FEET WIDR UTILITY EASEMENT IS REQUIRED ON SEWER MAINS OUTSIDE OF THE STREET RIGHTS-OF-WAY.
 4. SPECIFICATIONS FOR ALL ROADWAY AND DRAINAGE MATERIALS SHALL CONFORM TO THE APPLICABLE PROVISIONS OF THE STANDARD SPECIFICATIONS FOR ROAD AND BRIDGE CONSTRUCTION, MISSISSIPPI STATE HIGHWAY DEPARTMENT. CONSTRUCTION OF SUBGRADE, TOPPING, AND BASE COURSE SHALL BE AT LEAST 95% OF MAXIMUM THEORETICAL RESISTANCE.
 5. ALL STREET, SANITARY SEWER AND STORM SEWER CONSTRUCTION TO BE IN ACCORDANCE WITH THE APPROVED PLANS AND SPECIFICATIONS. ALL CONSTRUCTION TO BE SUBJECT TO INSPECTION BY THE CITY OF RIDGELAND.
 6. ALL WATER AND SEWER SERVICES TO BE LOCATED NEAR THE CENTER OF THE LOTS WITH A MINIMUM OF TEN (10) FEET SEPARATION AND SHALL BE STAYED TO THE PROPERTY LINE. ALL SERVICES SHALL BE MAINTAINED ON THE FACE OF THE CURB AS REQUIRED BY THE CITY OF RIDGELAND.
 7. THE CONTRACTOR SHALL LOCATE OR HAVE LOCATED ALL UNDERGROUND UTILITIES, BOTH PUBLIC AND PRIVATE, AND VERIFY THE DEPTH OF EACH BEFORE BEGINNING ANY CONSTRUCTION IN THE AREA OF SUCH UTILITIES. THE CONTRACTOR SHALL BE RESPONSIBLE FOR MAINTAINING SERVICES OF ANY UTILITIES WHICH ARE REQUIRED TO BE RELOCATED UNTIL SUCH ARE PROPERLY RELOCATED.
 8. THE SEWER SYSTEM SHALL BE TESTED IN ACCORDANCE WITH THE APPROVED PLANS AND SPECIFICATIONS AND THE CITY OF RIDGELAND AND SHALL BE THE RESPONSIBILITY OF THE CONTRACTOR. THE CONTRACTOR SHALL GIVE AT LEAST 24 HOURS NOTICE TO THE ENGINEER UNDER THE CITY OF RIDGELAND BEFORE ANY TESTING IS DONE. LOW PRESSURE AIR TEST IN ACCORDANCE WITH ASTM C828-00.
 9. ALL SEWER CONSTRUCTION TO BE IN ACCORDANCE WITH THE APPROVED PLANS AND SPECIFICATIONS AND THE CITY OF RIDGELAND STANDARDS WITH THE FOLLOWING ADDITIONS/EXCEPTIONS.
 - A. BRICK MANHOLES SHALL NOT BE ALLOWED.
 - B. ALL MANHOLES SHALL BE WATERPROOFED USING EPOXY OR BITUMINOUS COATING.
 - C. ALL INLET AND OUTLET PIPES TO MANHOLES SHALL BE JOINED WITH A GASKETED PLUG/TEE WATER-TIGHT CONNECTION THAT ALLOWS DIFFERENTIAL SETTLEMENT TO TAKE PLACE.
 - D. GRAVITY SEWER MAINS AND SERVICES SHALL BE 8" Ø 20 PFC PIPE CONFORMING TO ASTM D3034 AND ASTM D3112 WITH PECTIBLE ELASTOMERIC SEALS CONFORMING TO ASTM F471. ALL SEWER MAINS SHALL BE SIZED AS INDICATED ON THE PLANS. ALL SEWER SERVICE LINES SHALL BE 6" INCH DIAMETER.
 - E. GRAVITY SEWER MAINS AND SERVICES SHALL BE SUBJECT TO A LOW PRESSURE AIR TEST IN ACCORDANCE WITH ASTM C828-00 TO DETECT INFILTRATION/EXFILTRATION. ALL MANHOLE WALLS AND FLOORS SHALL BE VISUALLY INSPECTED FOR INFILTRATION AND PROPERLY SEALED WHEN INFILTRATION IS DETECTED. THE SEWER CONTRACTOR SHALL BE RESPONSIBLE FOR TESTING ALL SANITARY SEWER PIPE AND MANHOLES. ALL TESTS SHALL CONFORM TO THE CITY OF RIDGELAND REQUIREMENTS.
 - F. ALL PRESSURE MAINS SHALL BE CLASS 150 PFC AND MEET THE LATEST REVISIONS OF THE APPLICABLE AWWA STANDARDS. PRESSURE UTILITY TESTS SHALL BE PERFORMED IN ALL PRESSURE MAINS AND SHALL CONFORM TO CURRENT AWWA STANDARD CODE.
 - G. ALL PERMISSIBLE SEWER PIPE SHALL BE SUBJECT TO DEFORMATION TEST BY PULLING A GAGE, MANHOLE, OR OTHER SUITABLE DEVICE WHICH WILL INDICATE DIAMETRICAL DEVIATIONS GREATER THAN 5% OF THE PIPES DIAMETER. ALL PIPE THAT SHOW DEVIATION GREATER THAN 5% OF ITS DIAMETER SHALL BE DISCOVERED, REDDED, REBACKFILLED AND RETESTED UNTIL IT COMPLES. THIS TEST SHALL NOT BE PERFORMED UNTIL THE PIPE HAS BEEN IN PLACE FOR A MINIMUM OF 30 DAYS.
 - H. RECORDS CLASSES A, B, C, OR C, AS DESCRIBED IN ASTM D12-14 (ANSI A108-21) OR WPCP AND NO. 5 FANSE WSP NO. 371 SHALL BE USED FOR ALL RIGID SEWER PIPE AS APPLICABLE FOR THE STRENGTH PIPE USED AND LOADING CONDITIONS ANTICIPATED.
 - I. RECORDS CLASSES 1, 1E, 7A 11E, AS DESCRIBED IN ASTM D1217-14 (ANSI A108-171) SHALL BE USED FOR ALL PERMISSIBLE SEWER PIPE AS APPLICABLE FOR THE STRENGTH PIPE USED AND LOADING CONDITIONS ANTICIPATED.
 - J. BACKFILL AT ALL TRENCHES DURING EXISTING OF PROPOSED PAVEMENT AND CURBS AND GUTTERS ARE TO BE MECHANICALLY COMPACTED IN 6" LAYERED LIFT TO A DENSITY OF 95% (ASTM D1557) OF THE 100% MAXIMUM THEORETICAL DENSITY OF THE NATIVE SOILS CANNOT BE SO COMPACTED, SELECT MATERIALS SHALL BE USED FOR BACKFILL.

- NOTES:
1. Sewer and Water service location measurements are from front lot corners as shown.
 2. Lot dimensions shown are approximate. See recorded plat for true dimensions.
 3. Actual inverts and grades on streets, sanitary sewers and storm sewers may vary slightly from what is shown on the Final Plans of Completed Work.

FINAL PLANS OF COMPLETED WORK
1-2-07

B.M. ELEVATION 349.73
N.I.S. 60" OAK
100. FT. EAST STA. 0+00
ON RUE BEAU CHENE

B.M. ELEVATION 336.06
CHISELED SQUARE ON SE BRIDGE
ABUTMENT - RM 245

NOTE:
CONTOURS ARE 2' INTERVAL.

DESIGNED: R. DALE	SCALE: 1"=50'				
DRAWN: R. DALE	DWG. NO: 03-301				
APPROVED: T. BAILEY					
DATE: JUNE, 2003					
REV. NO.	DATE	NATURE OF REVISION	BY	CHKD.	APPD.


BAILEY ENGINEERING, INC.
CIVIL ENGINEERING and LAND SURVEYING
JACKSON, MISSISSIPPI

TOWNE OF BEAU CHENE
WATER & SEWER LAYOUT

SHEET NO.
3

PLAN
 SHOWN
 NOTED
 NOTE BOOK
 NO. OF WAY CHECKED
 No.

PROFILE
 SHOWN
 NOTED
 NOTE BOOK
 NO. OF GRADE CHECKED
 NO. OF VERTICAL CURVE CHECKED
 No.

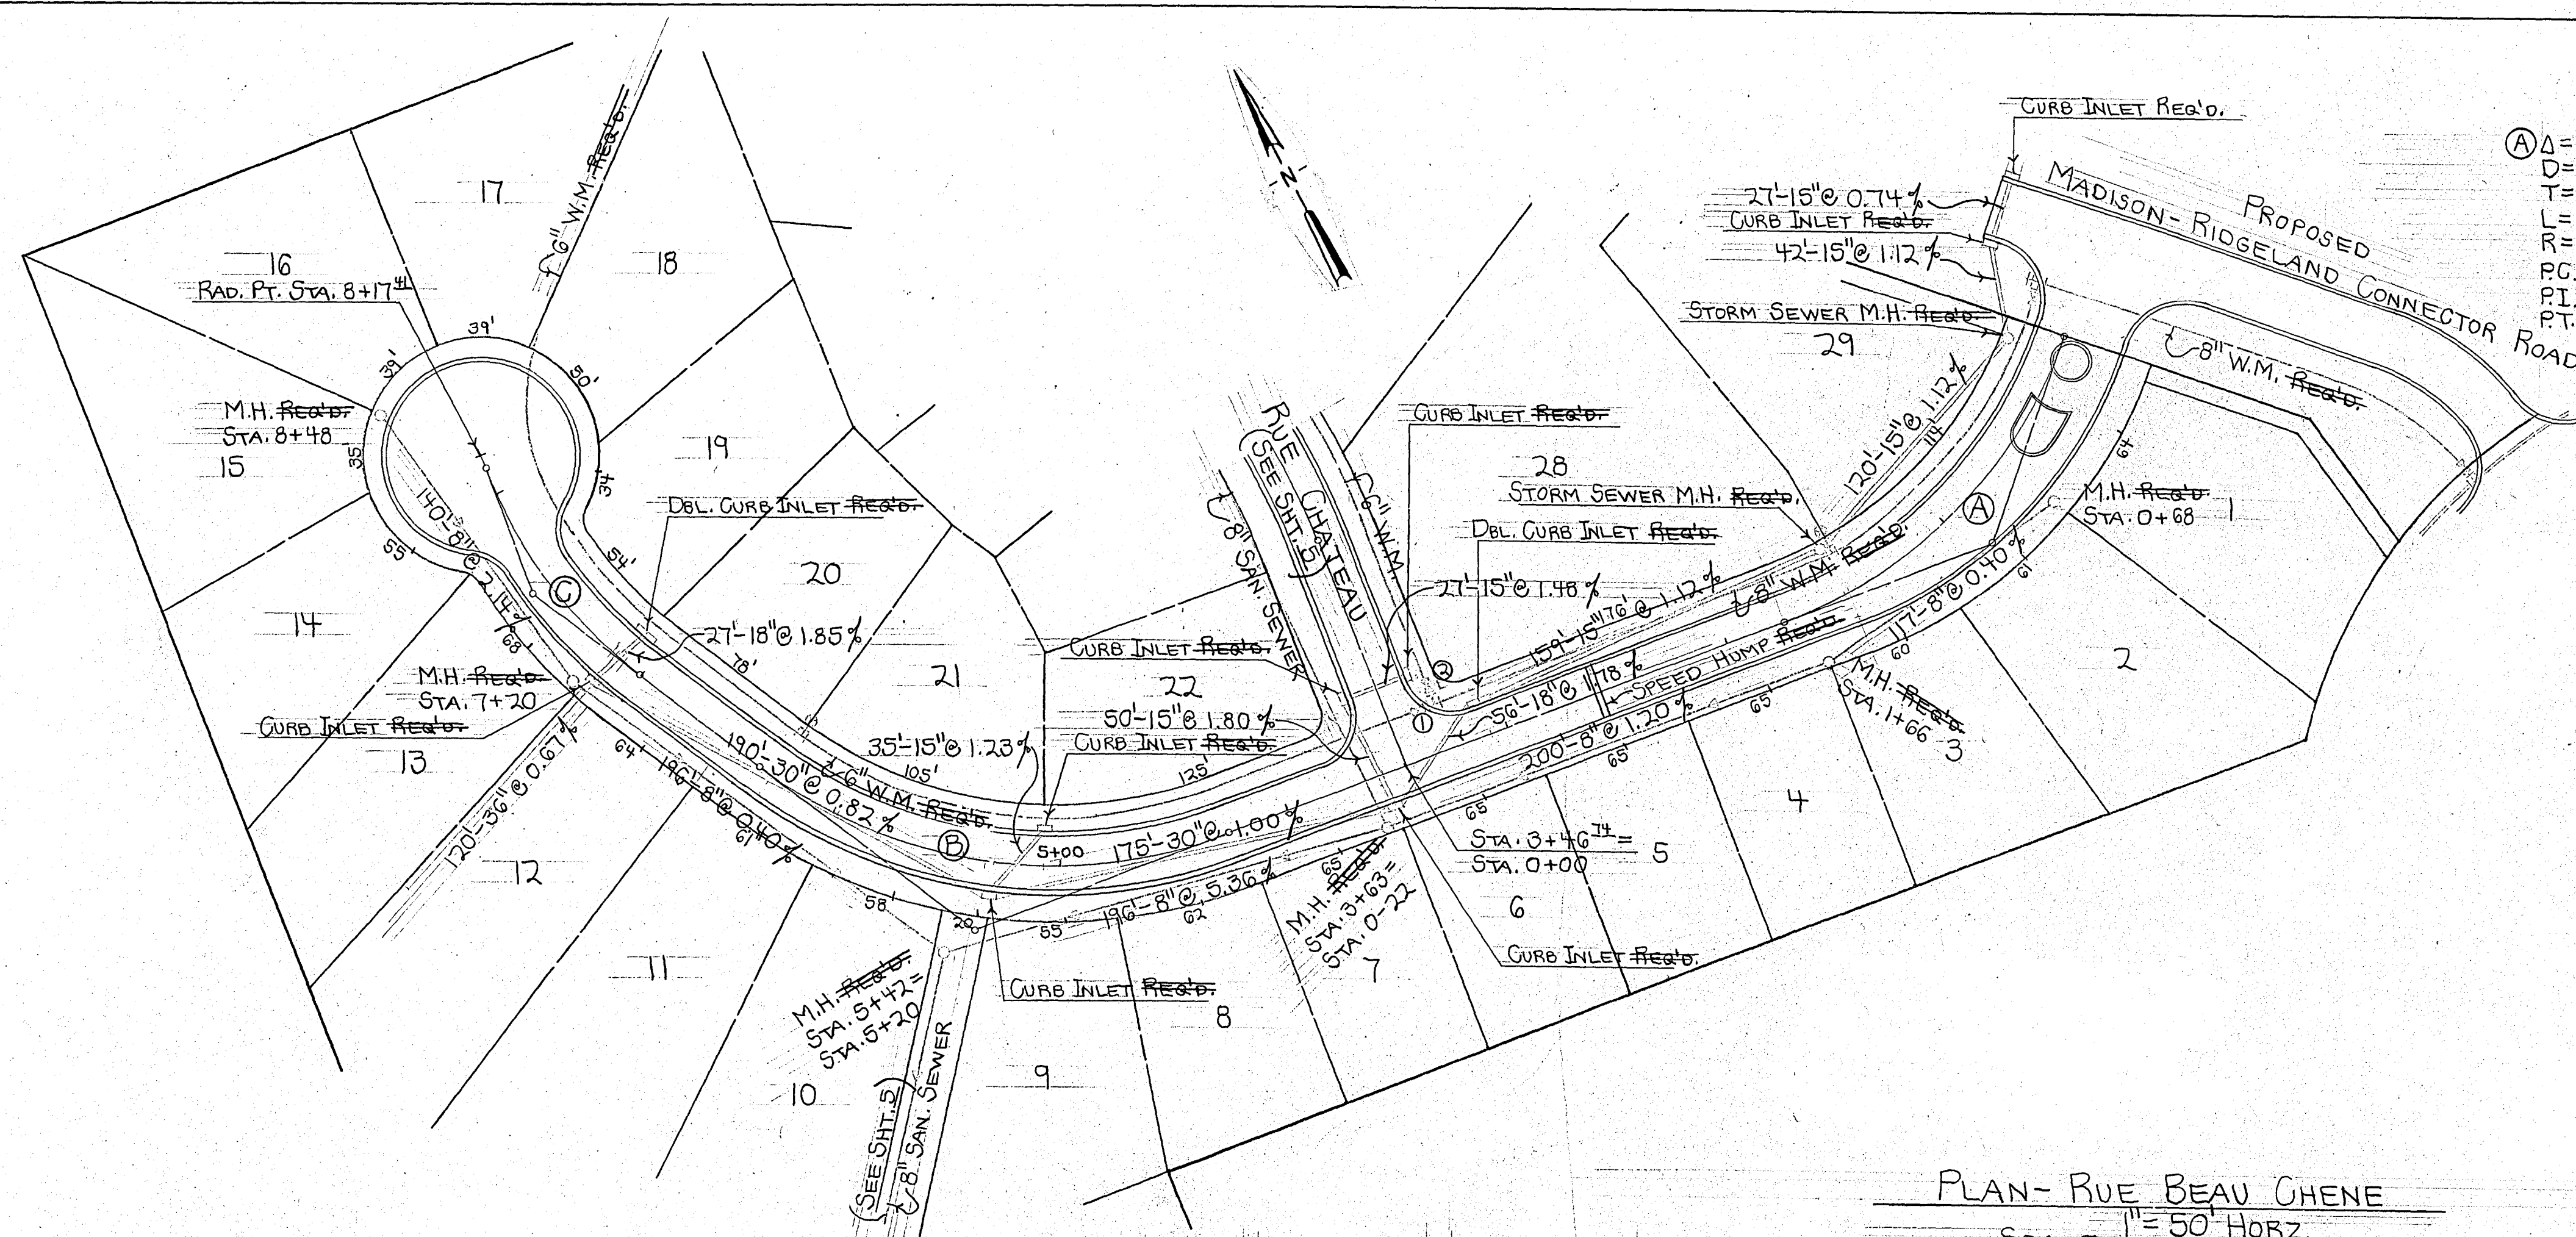


CURVE DATA

Curve	Angle	Radius	Tangent	Length	PC	PT
A	50°19'39" Rt.	28.647890'	43.96'	175.68'	0+00.00	1+15.68
B	58°49'23" Rt.	28.086717'	115.00'	209.43'	4+28.35	5+43.35
C	31°28'15" Rt.	28.321625'	57.00'	111.12'	7+01.98	8+13.10



PLAN - RUE BEAU GHENE
 SCALE: 1" = 50' HORIZ.
 1" = 5' VERT.

FINAL PLANS OF
 COMPLETED WORK
 1-2-07

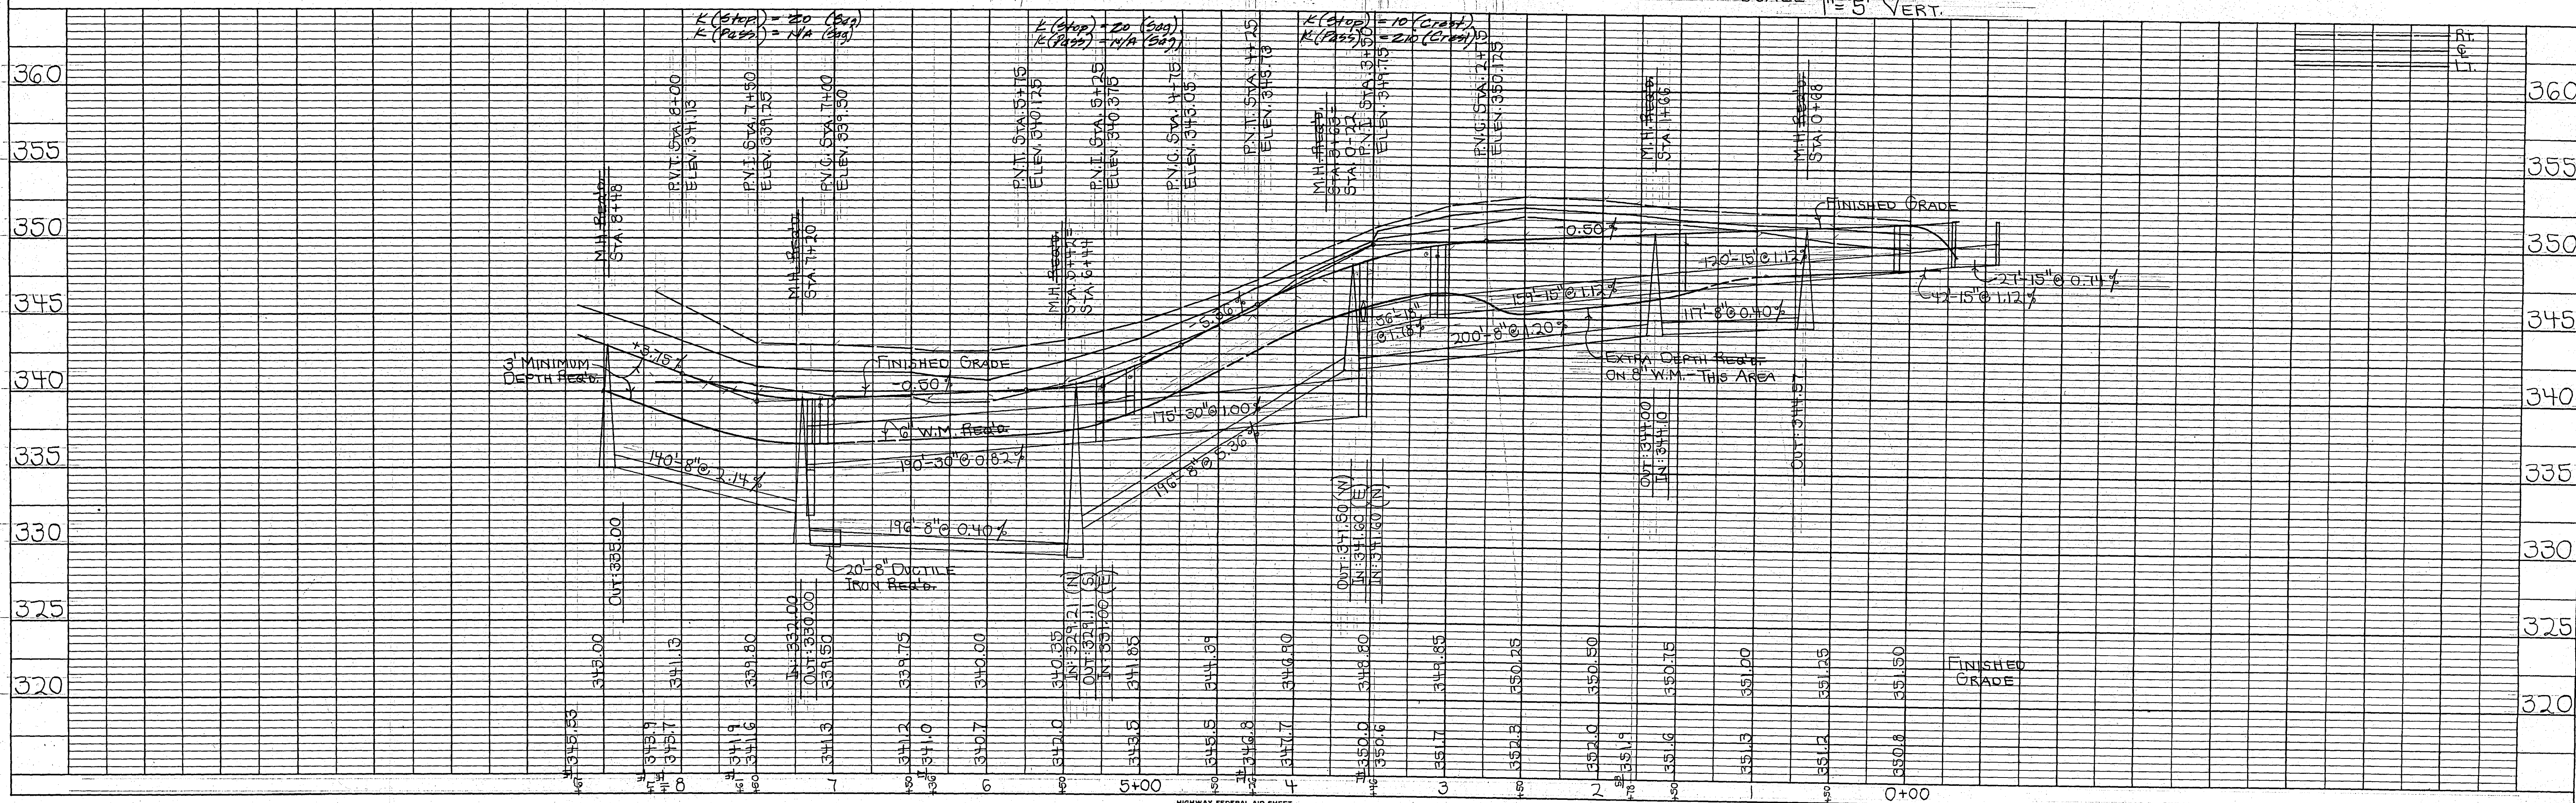

DATE: _____ BY: _____
 SURVEYED: _____
 NOTE BOOK: _____
 ALIGNMENT CHECKED: _____
 NO. OF WAY CHECKED: _____

DATE: _____ BY: _____
 SURVEYED: _____
 NOTE BOOK: _____
 GRADES CHECKED: _____
 E. A. I. NOTED: _____
 STRUCTURE NOTATIONS CHECKED: _____

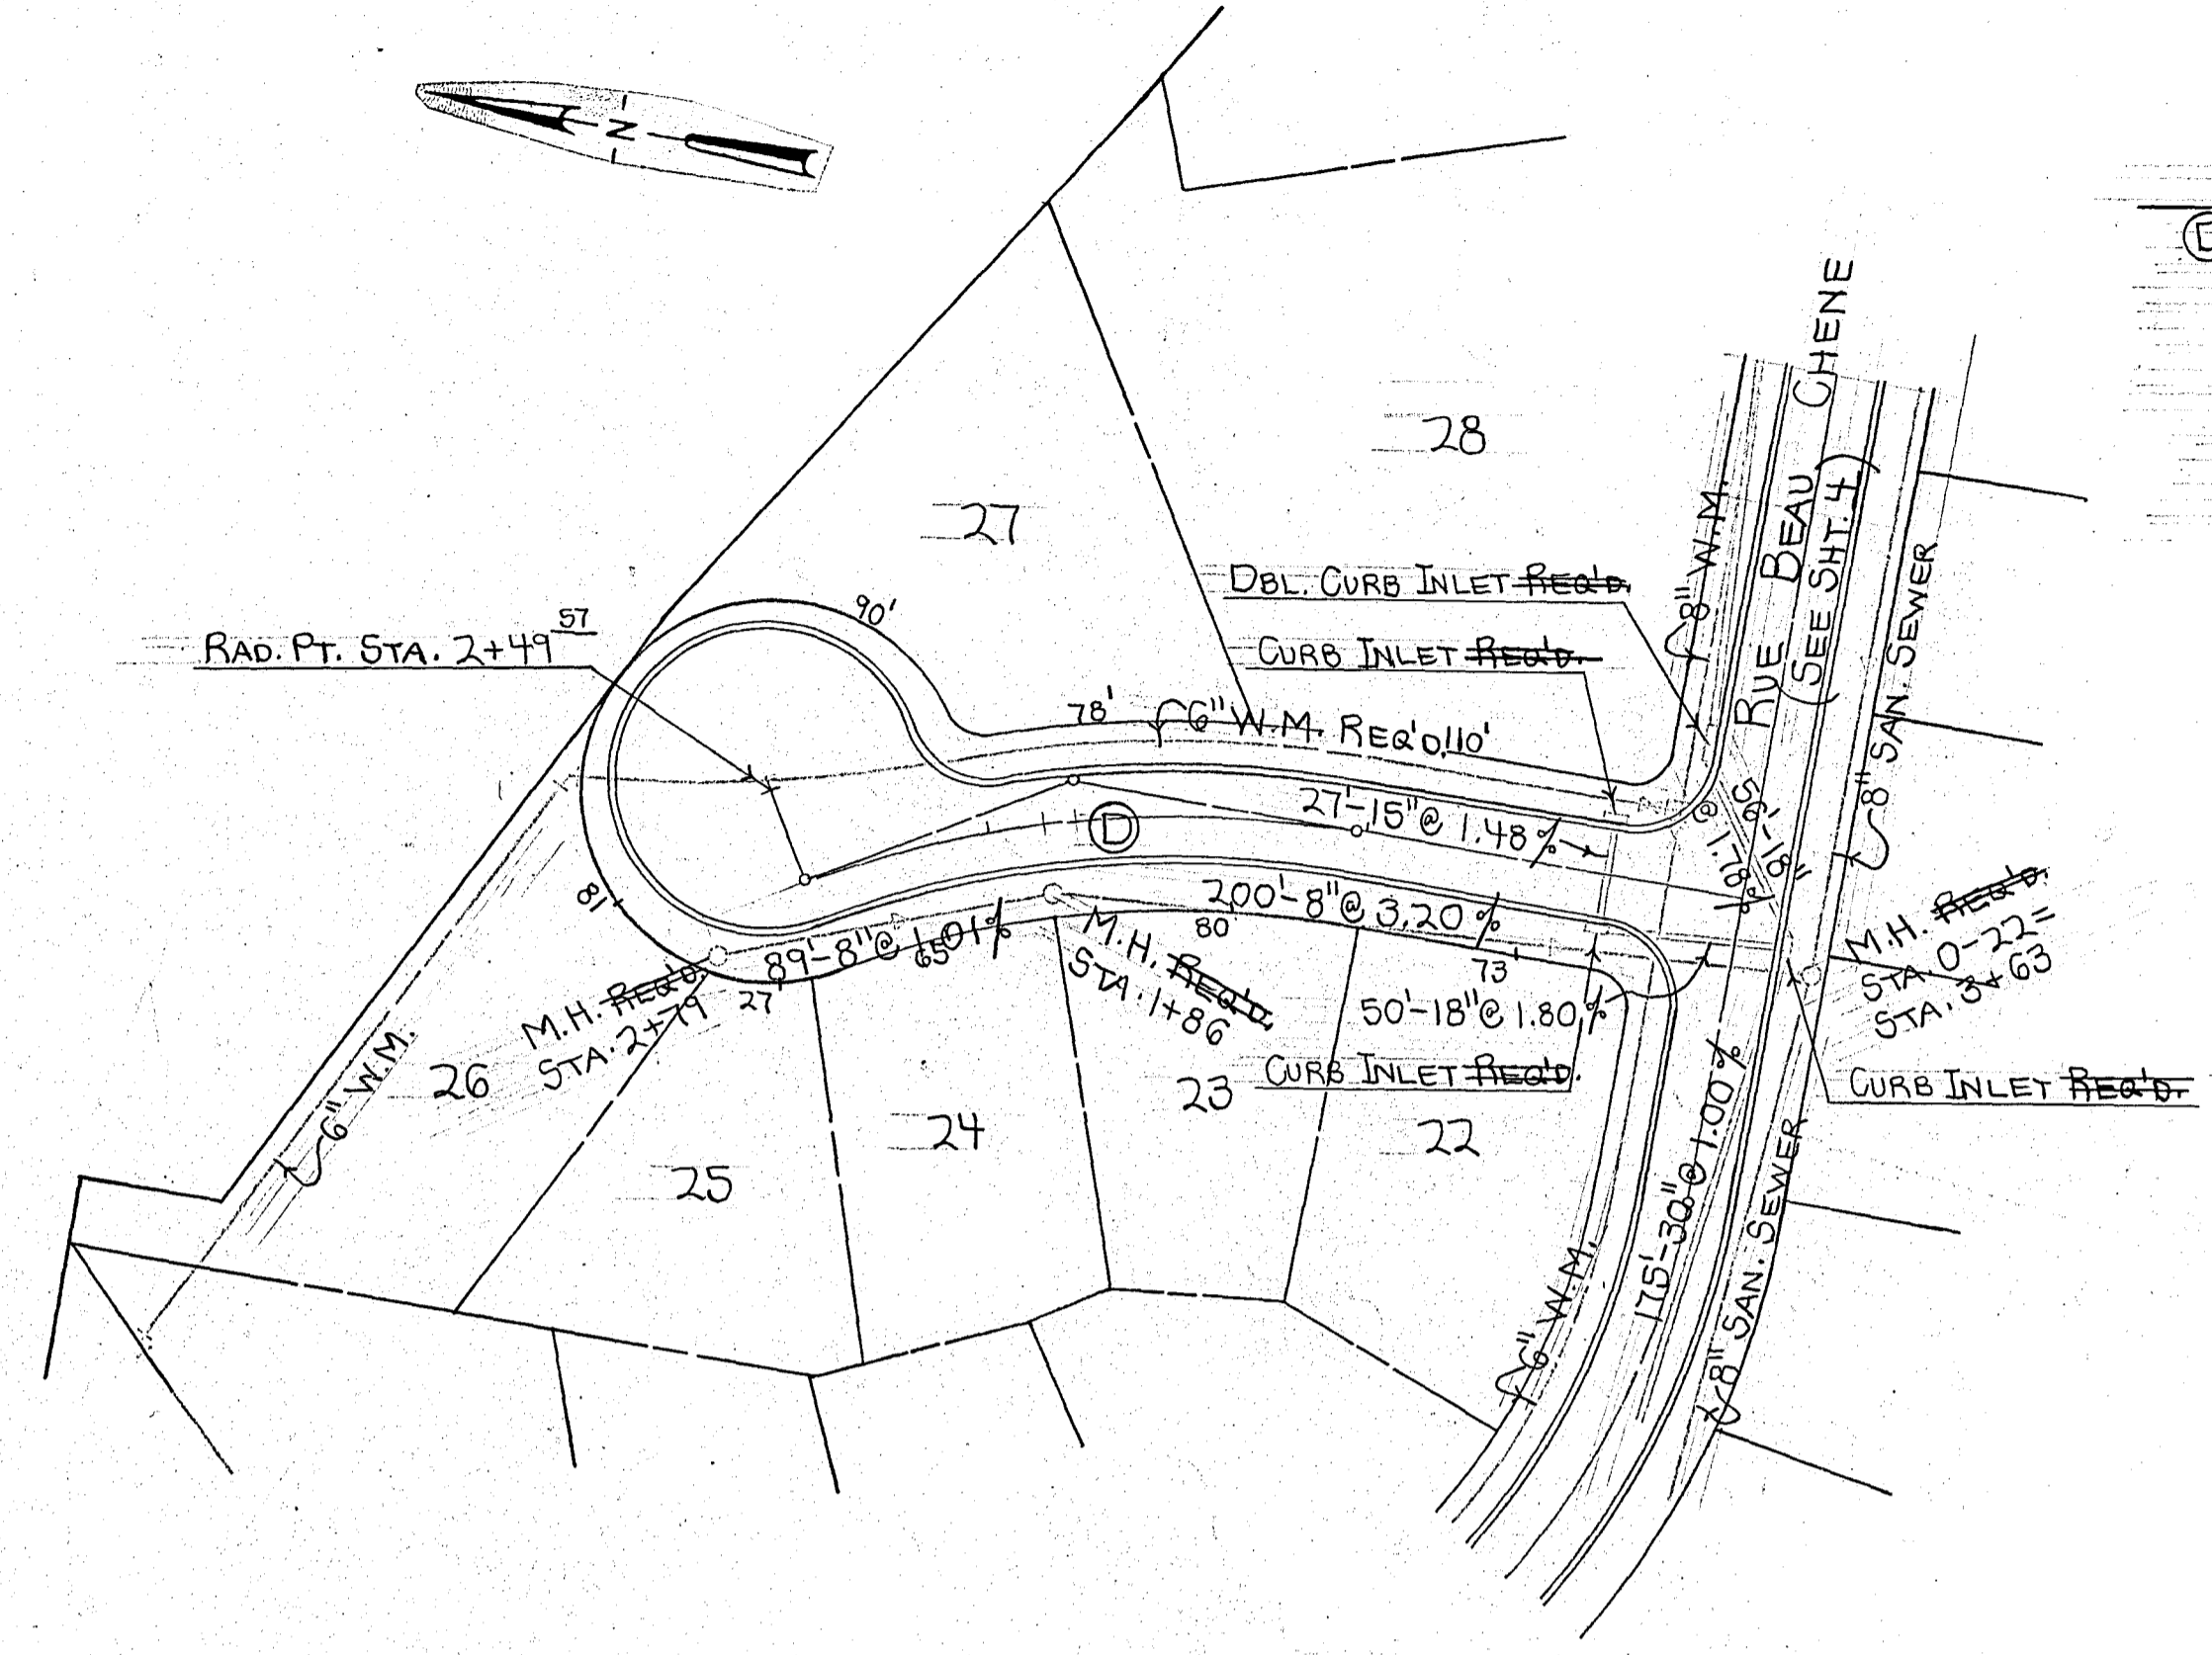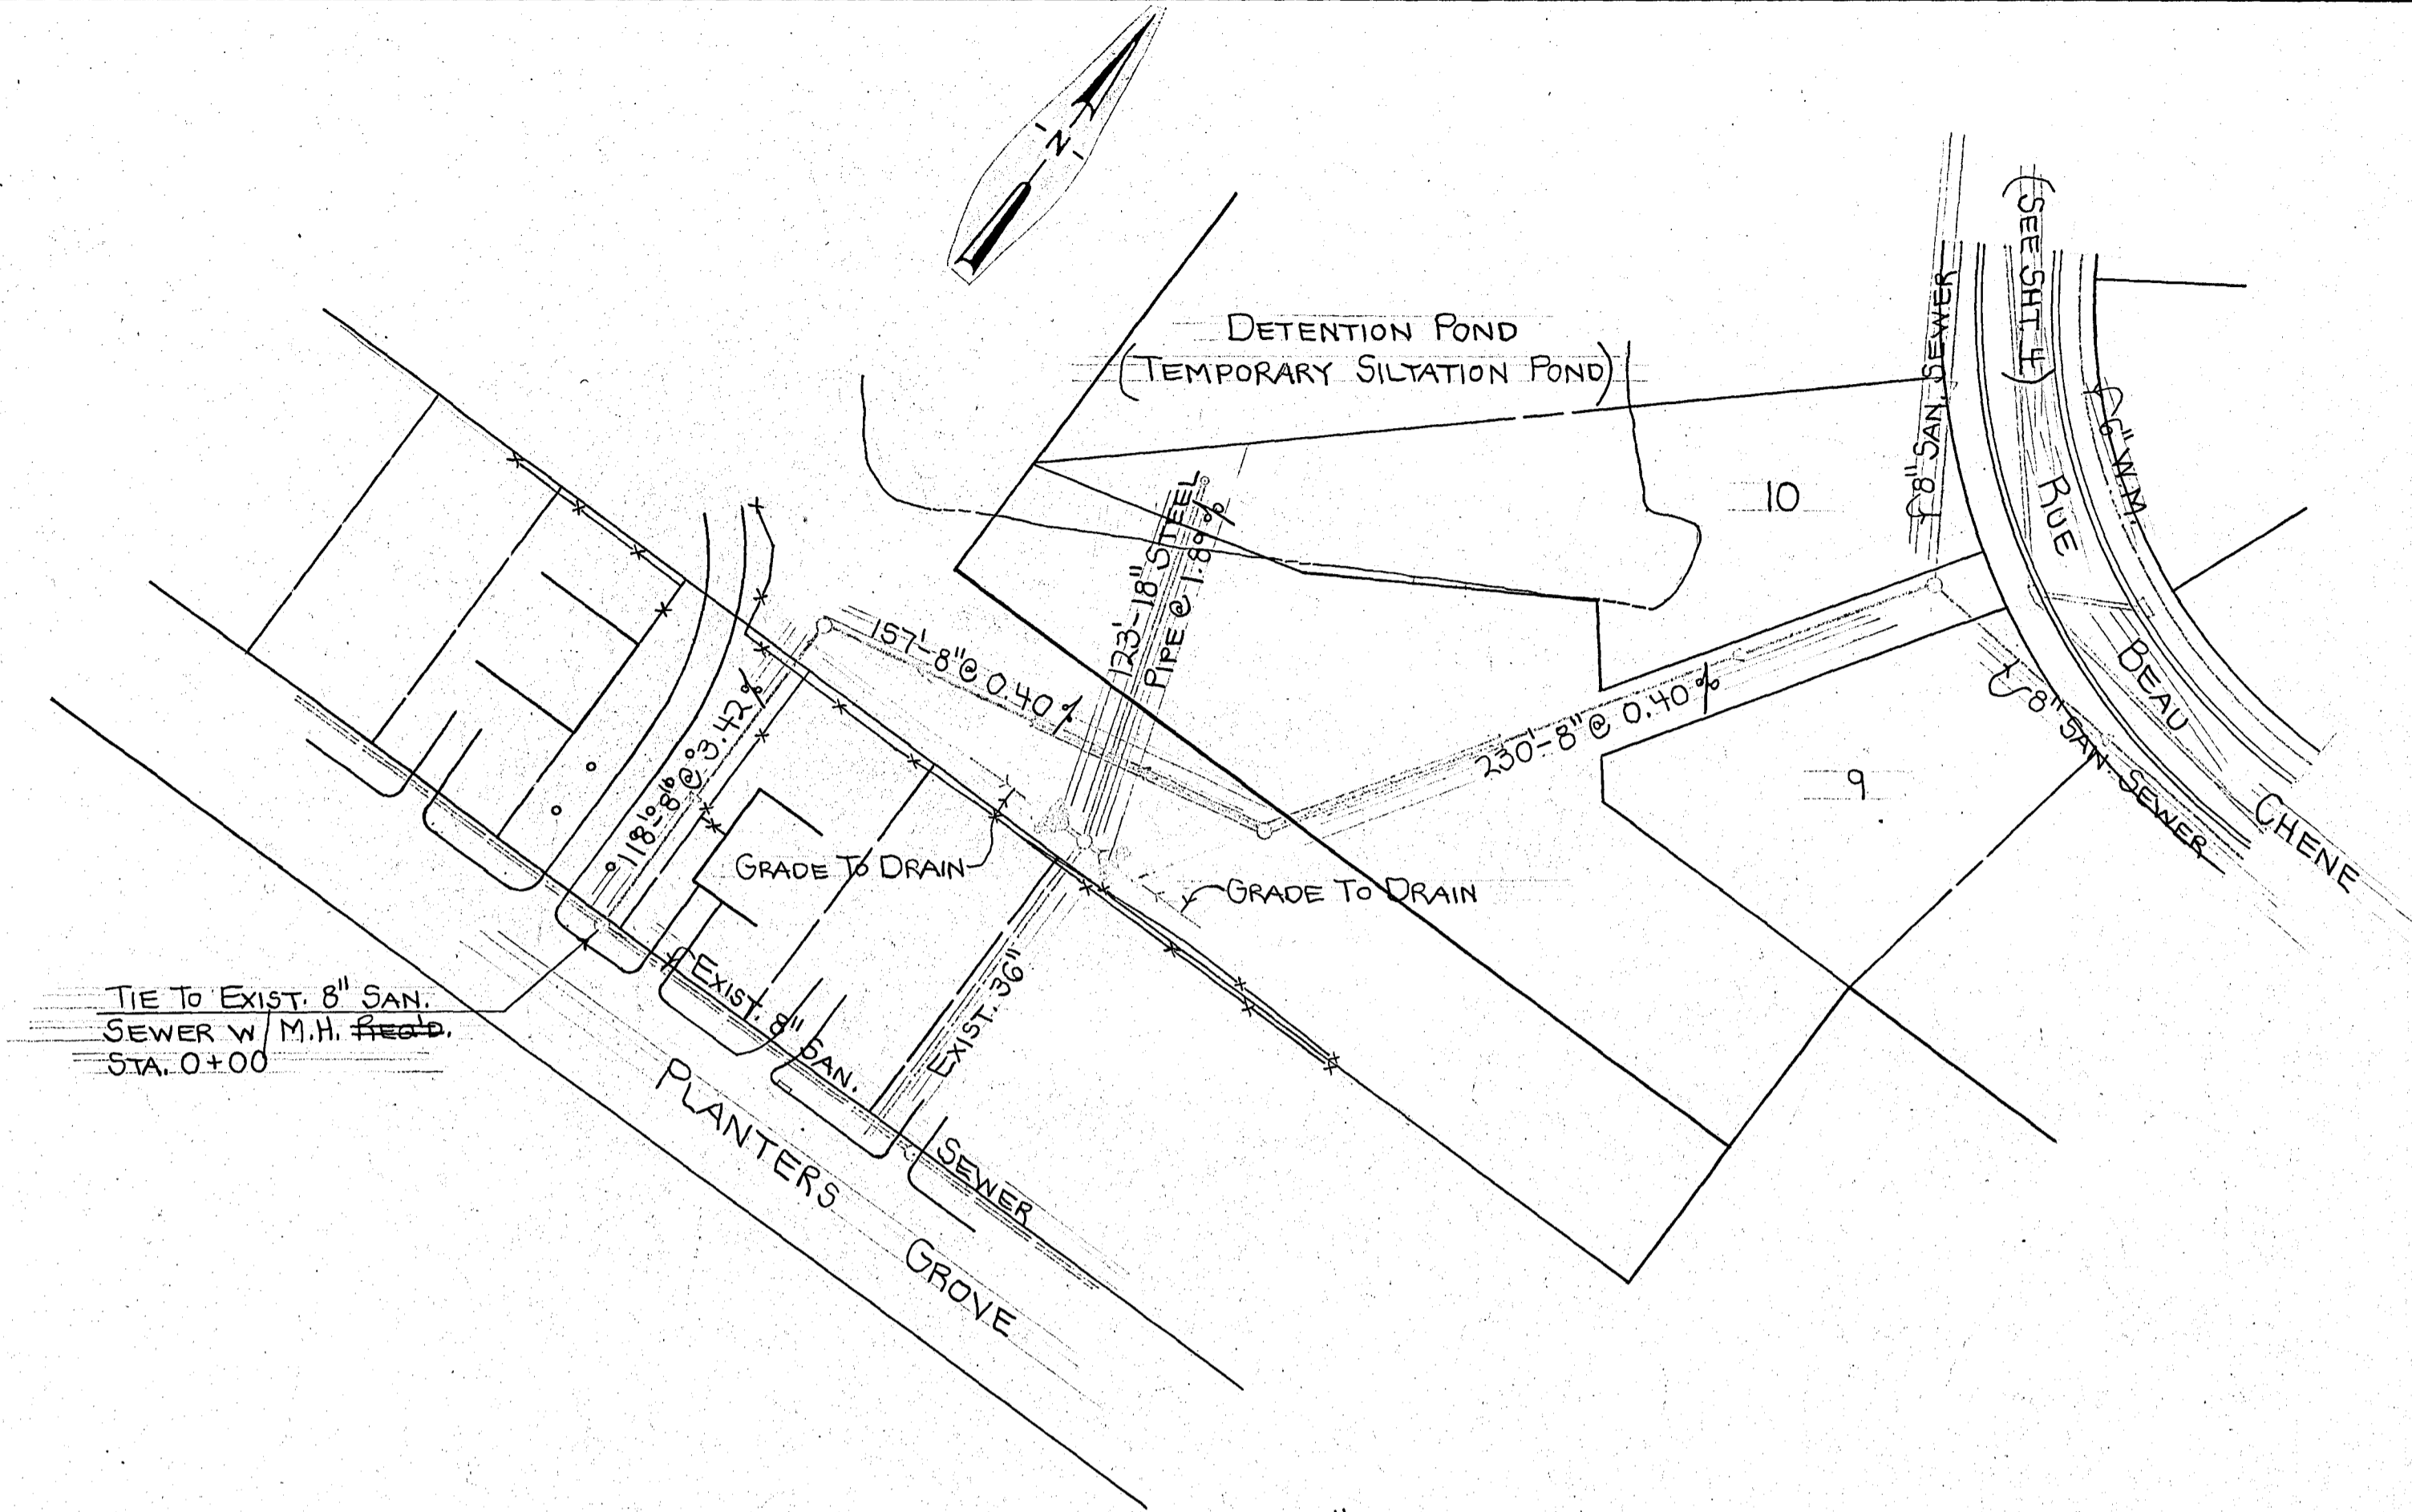


① CURVE DATA
 $\Delta = 30^{\circ}35'14''$
 $D = 20.889978^{\circ}$
 $T = 75.00'$
 $L = 146.42'$
 $R = 274.274'$
 $PG = 1+03.15$
 $PI = 1+78.15$
 $PT = 2+49.57$


PLAN - PROPOSED 8" SANITARY SEWER SERVING TOWNE OF BEAU CHENE
 SCALE: 1" = 50' HORIZ.
 1" = 5' VERT.

PLAN - RUE CHATEAU
 SCALE: 1" = 50' HORIZ.
 1" = 5' VERT.


FINAL PLANS OF COMPLETED WORK
 1-2-07

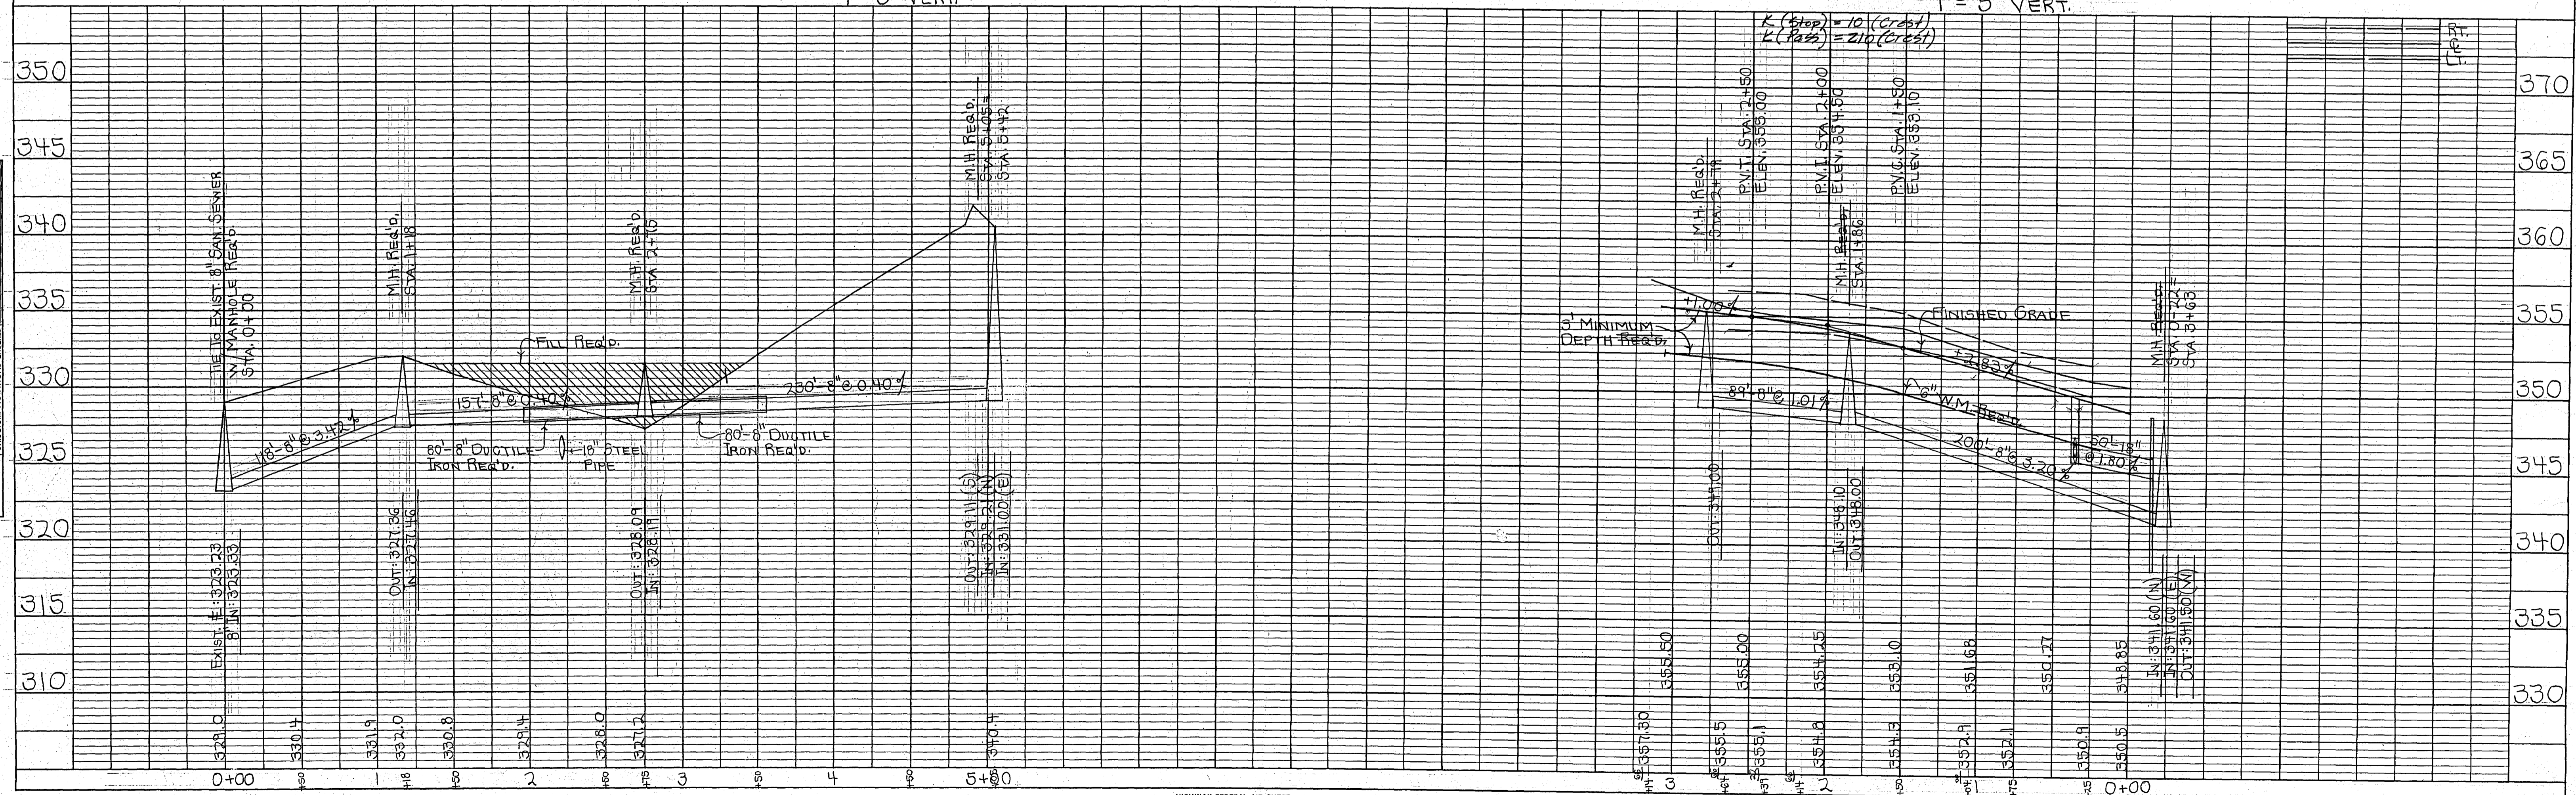

HIGHWAY FEDERAL AID SHEET
 PLATE 1-SINGLE PLAN AND PROFILE-FULL LINE
 NATIONAL PRINTING
 PRINTED IN U.S.A.

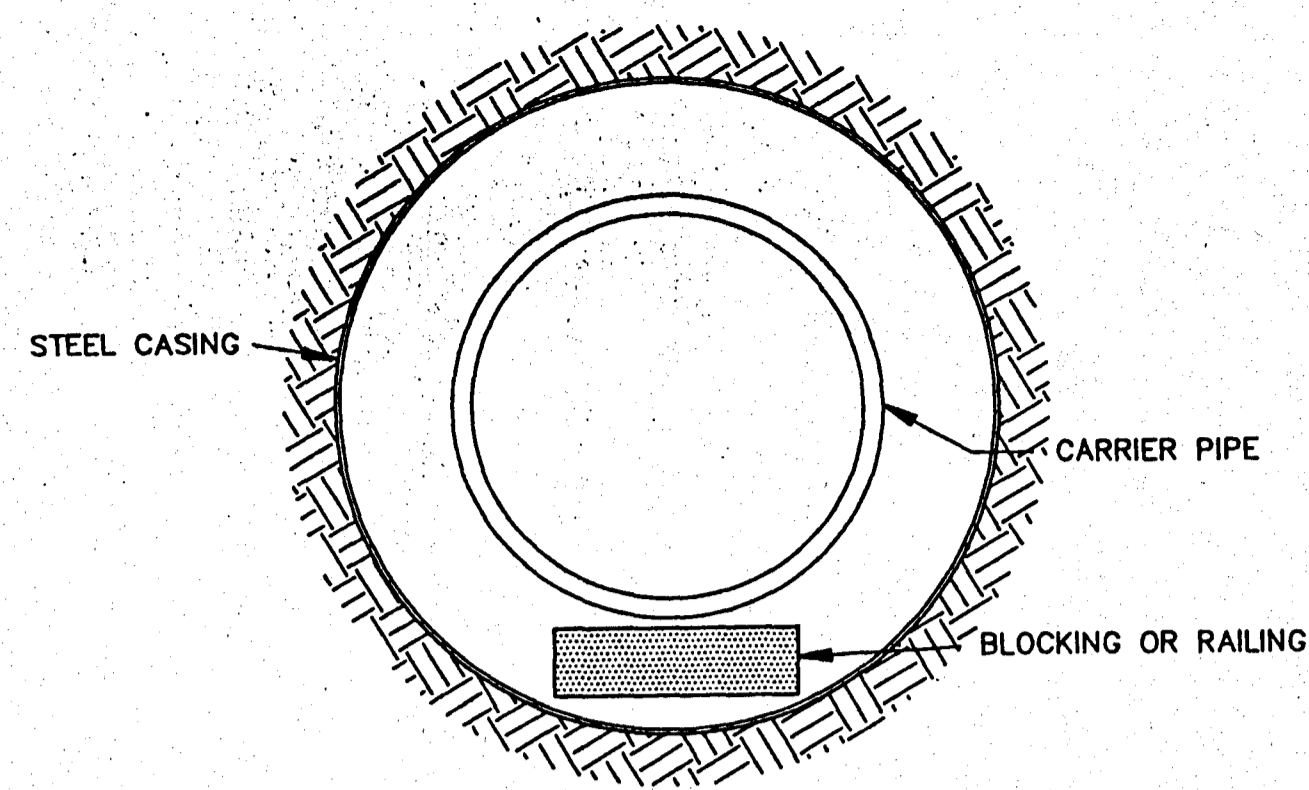

BORE SECTION
N.T.S.

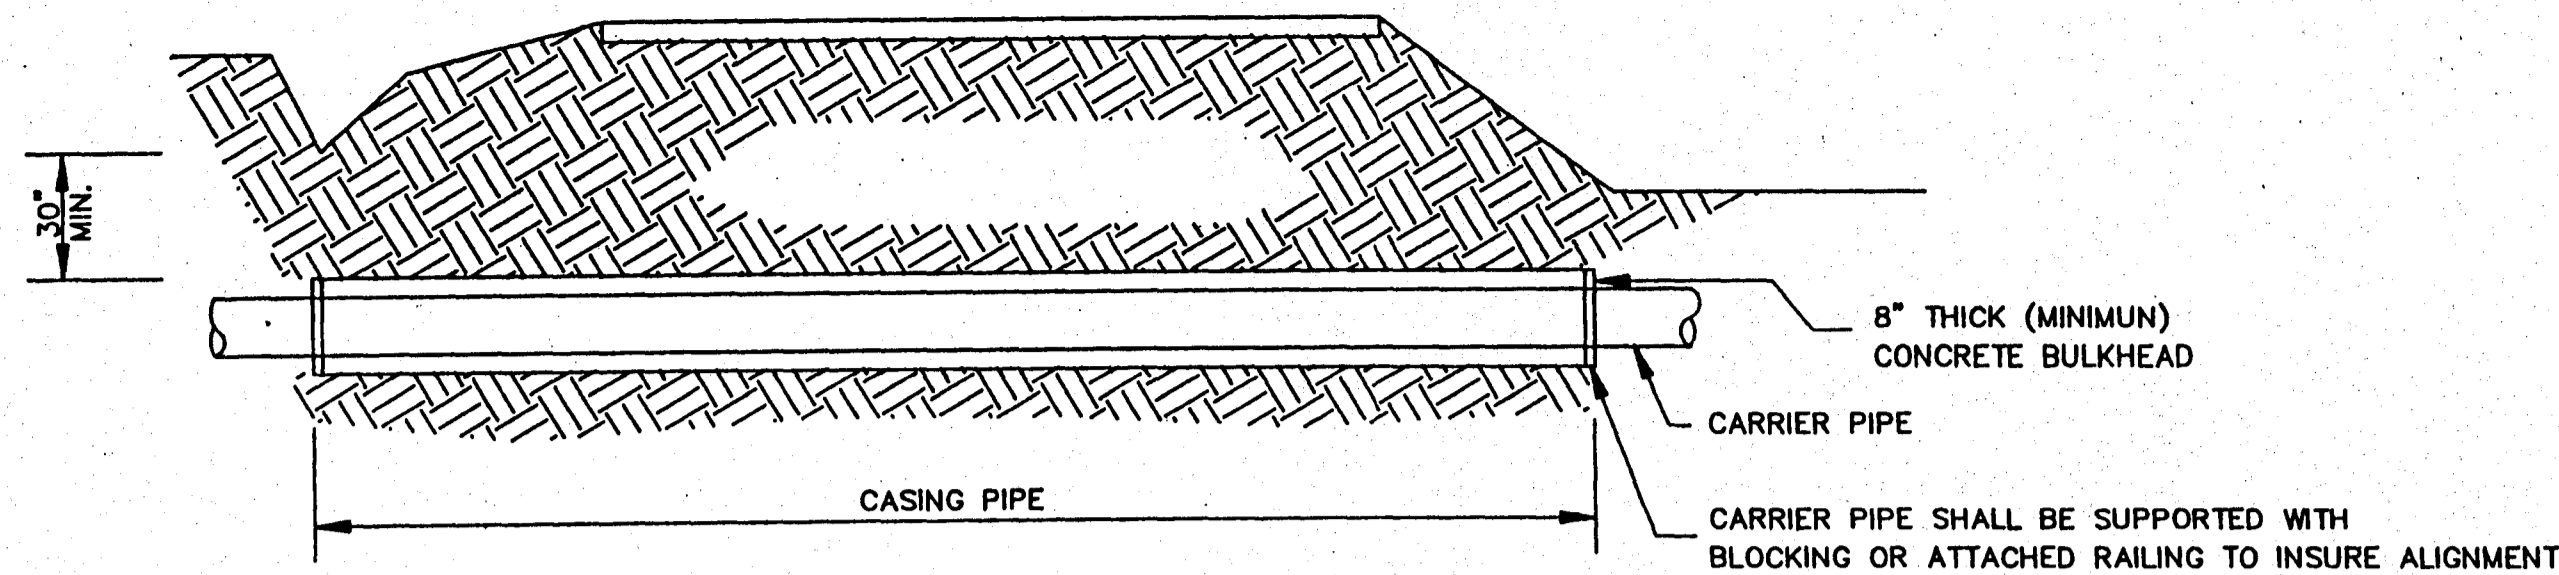


TYPICAL BORE SECTION
N.T.S.

TABLE II
GOVERNING DIMENSIONS FOR MANHOLES


PIPE SIZE	Δ ANGLE	BASE DIAMETER **	"R" *
8" THRU 12"	0° TO 90°	4'	1'- 6"
15"	0° TO 60°	4'	1'- 10"
15"	60° TO 90°	4'	1'- 10"
18"	0° TO 60°	4'	2'- 3"
18"	60° TO 90°	4'	1'- 10"
21"	0° TO 60°	4'	2'- 7"
21"	60° TO 90°	5'	2'- 4"
24"	0° TO 45°	4'	3'- 0"
24"	45° TO 90°	5'	2'- 3"
30"	0° TO 60°	5'	3'- 9"
30"	60° TO 90°	6'	2'- 8"
36"	0° TO 60°	6'	4'- 6"
36"	60° TO 90°	7'	3'- 11"
42"	0° TO 60°	7'	5'- 3"
42"	60° TO 90°	8'	4'- 7"
48"	0° TO 60°	8'	6'- 0"
48"	60° TO 90°	9'	5'- 3"

* SEE SECTIONAL PLAN, STANDARD MANHOLE
** PRECAST MANHOLE

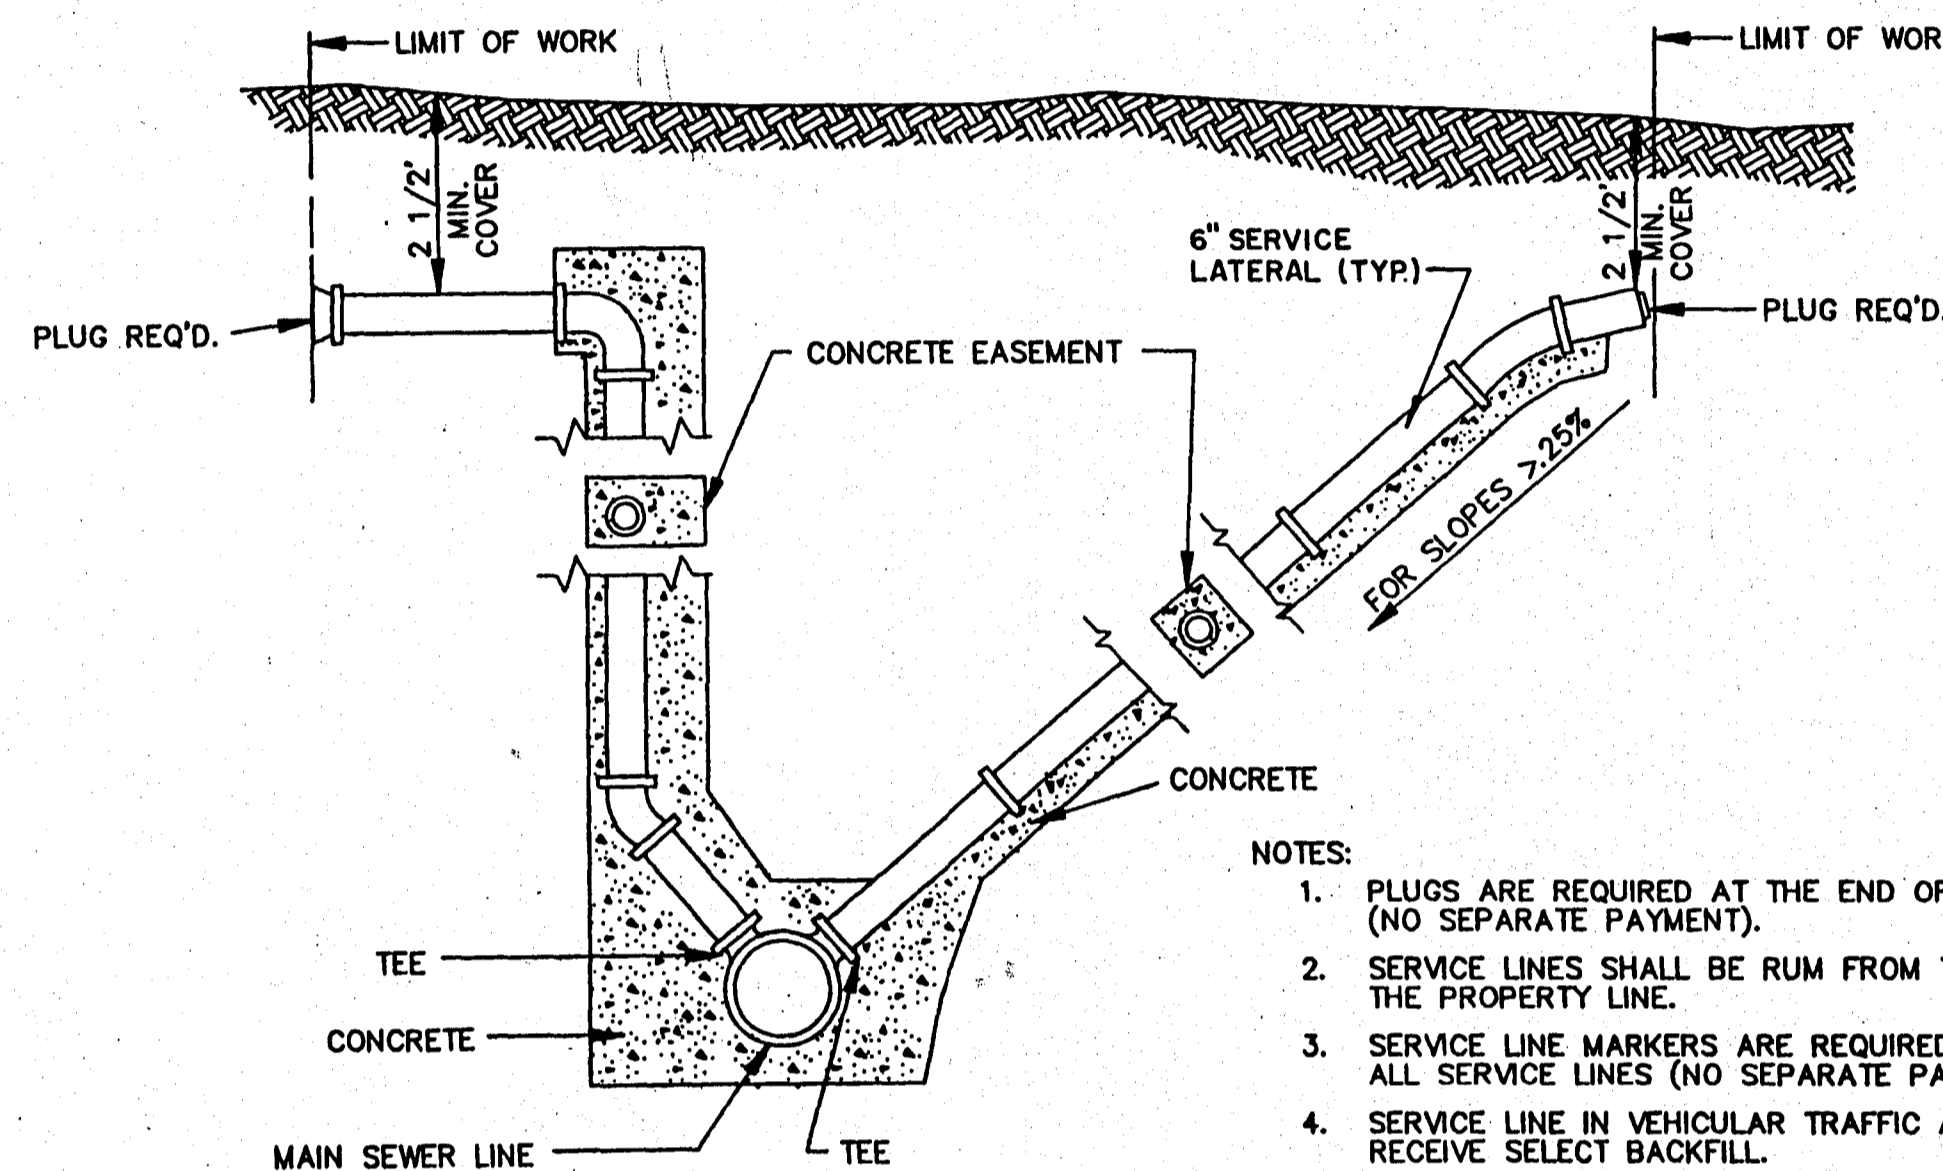


- NOTES:
1. PLUGS ARE REQUIRED AT THE END OF ALL SERVICE LINES (NO SEPARATE PAYMENT).
 2. SERVICE LINES SHALL BE RUN FROM THE SEWER LINES TO THE PROPERTY LINE.
 3. SERVICE LINE MARKERS ARE REQUIRED AT THE END OF ALL SERVICE LINES (NO SEPARATE PAYMENT).
 4. SERVICE LINE IN VEHICULAR TRAFFIC AREA SHALL RECEIVE SELECT BACKFILL.
 5. WHEN MINIMUM COVER CAN NOT BE OBTAINED DUCTILE IRON PIPE SHALL BE USED.

SERVICE CONNECTION FOR DEEP SEWER
N.T.S.

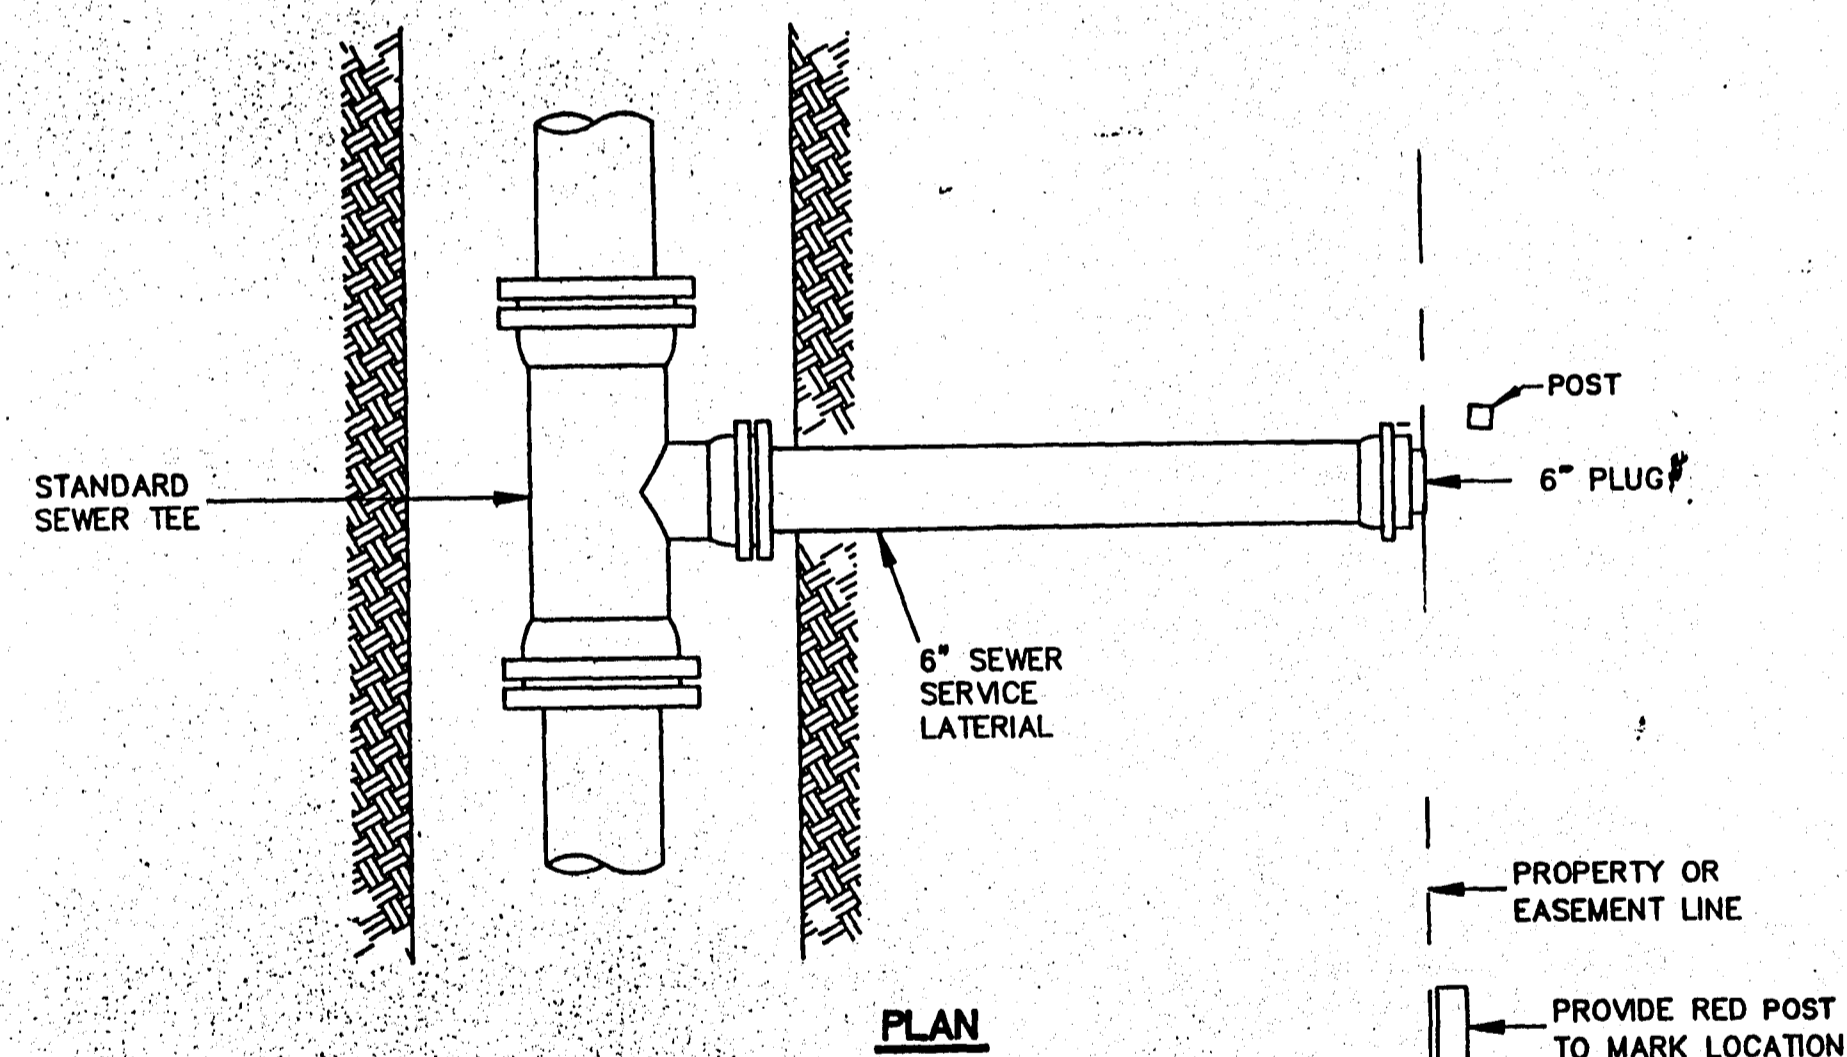


PLAN

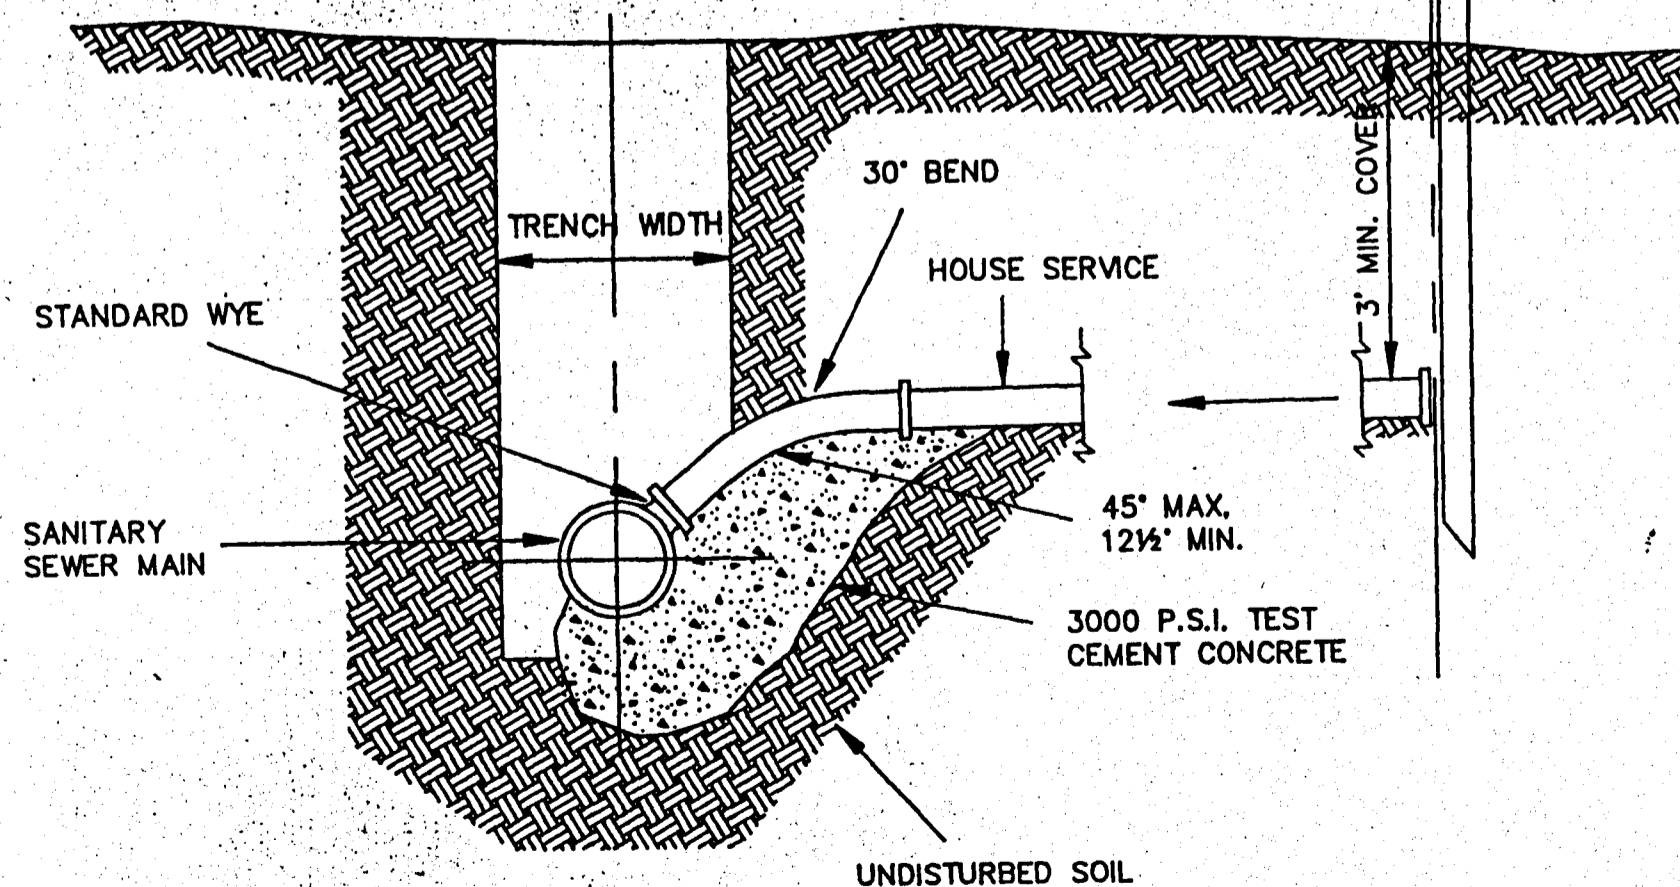


ELEVATION


SEWER SERVICE CONNECTION
N.T.S.

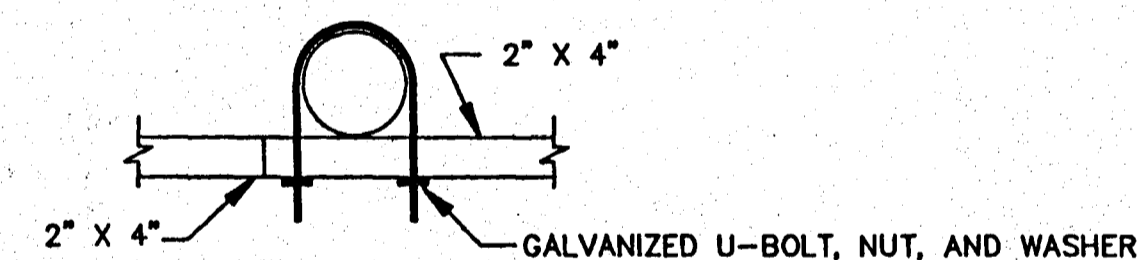

SUPPORT MOUNTING DETAIL
N.T.S.

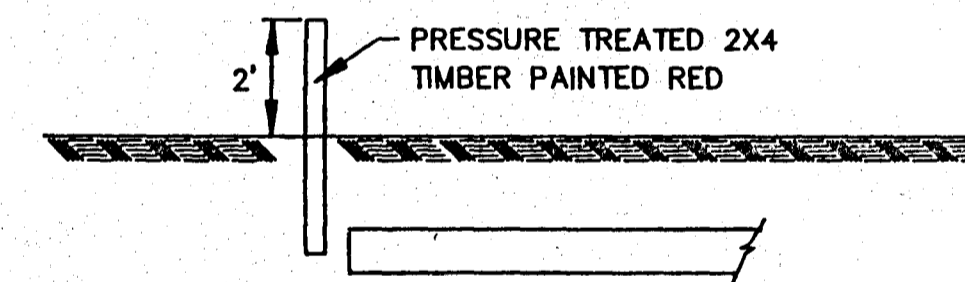

SERVICE LINE MARKER
(NO SEPARATE PAYMENT)
N.T.S.

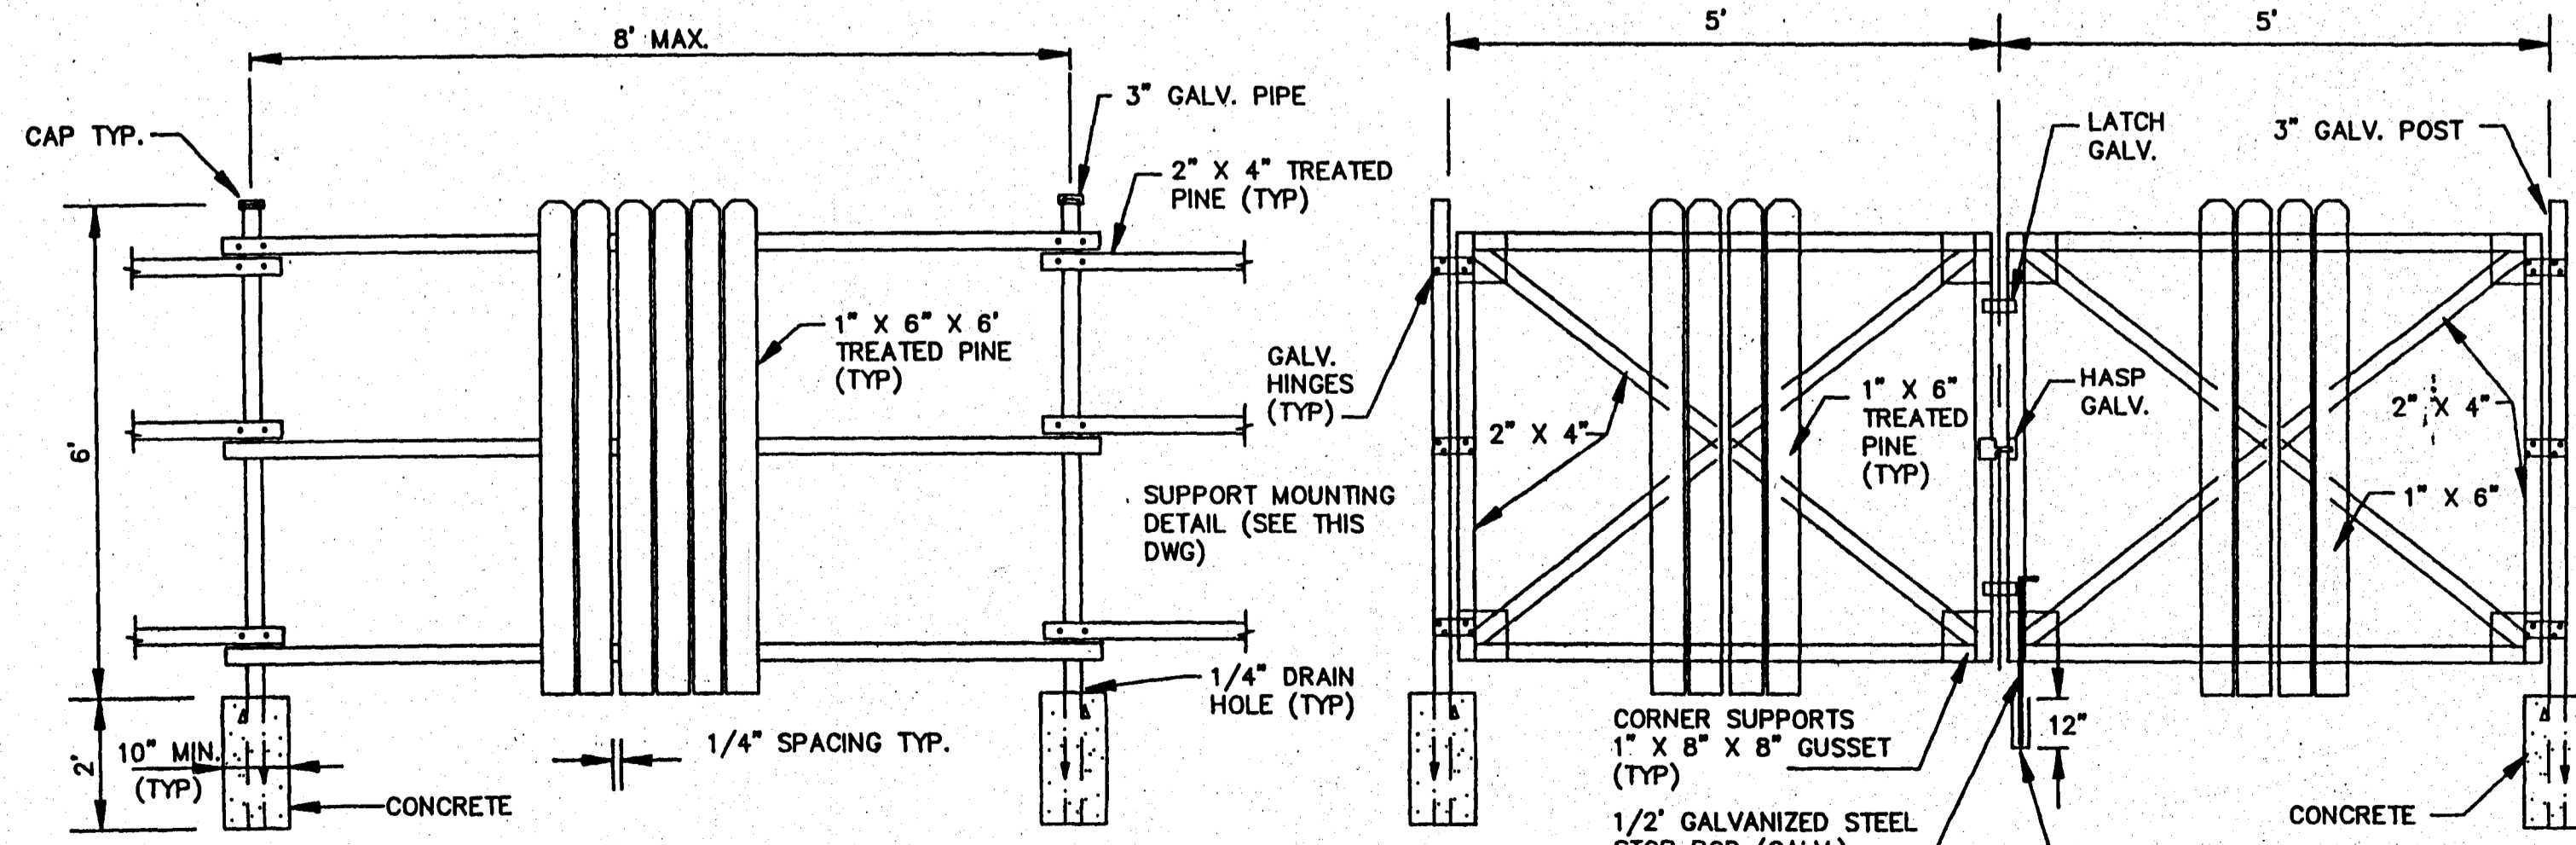

FENCE DETAIL
N.T.S.


GATE DETAIL
N.T.S.

CITY OF RIDGELAND, MS.


STANDARD DETAILS

DSGN:			DRAWING NO.
DRWN:			OF
CHKD:			
SCALE:			


REVISION 7776 FORM 1988

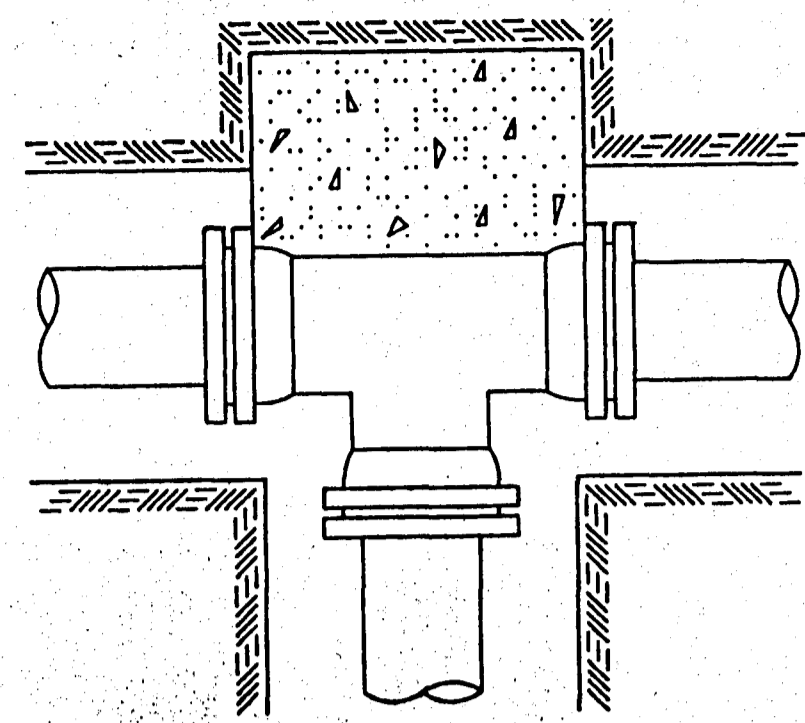


TEE

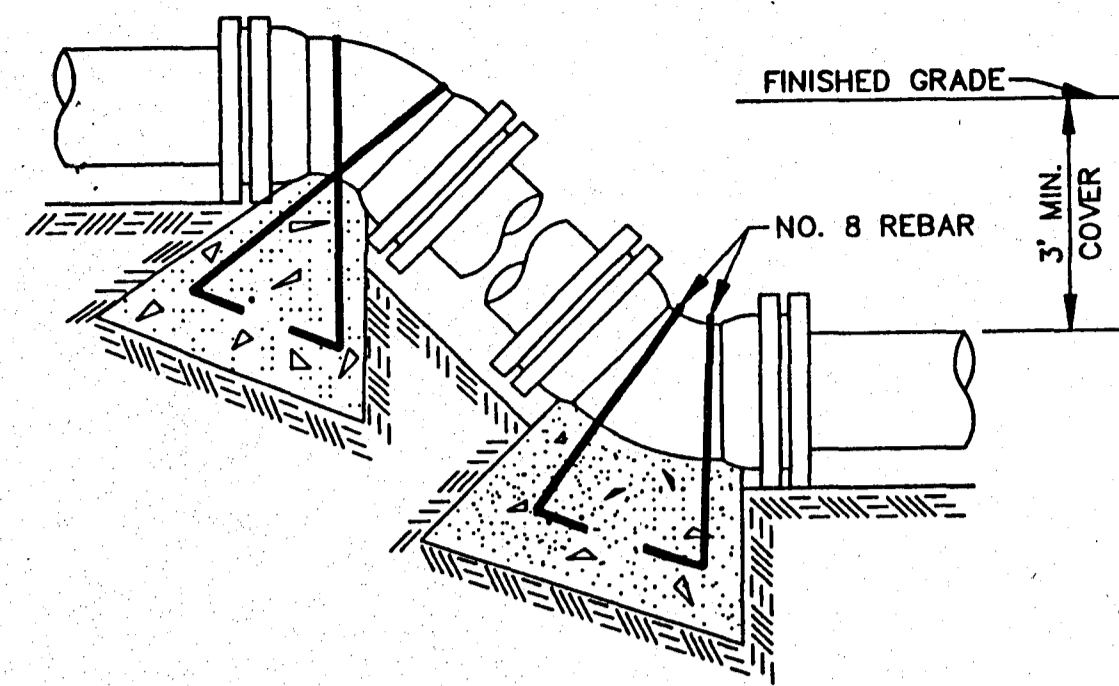


VERTICAL BENDS

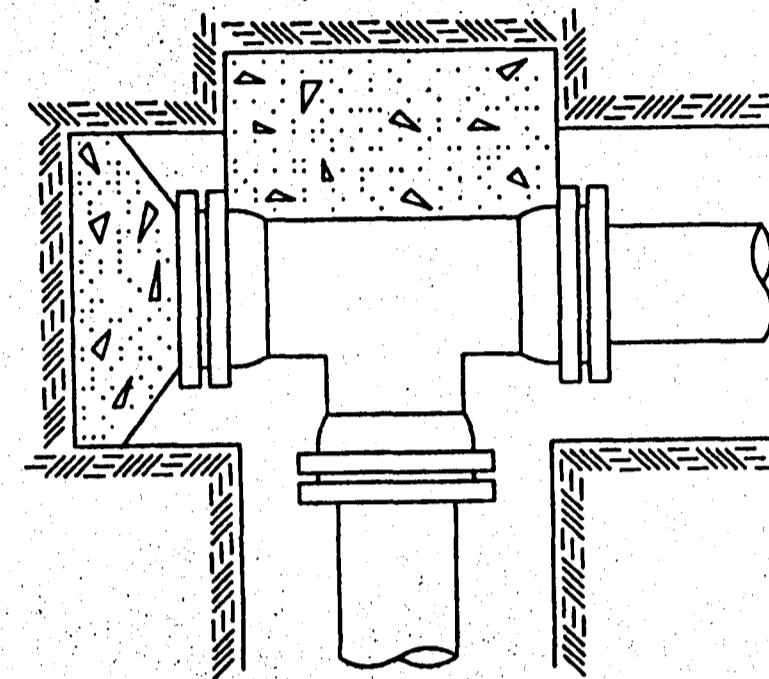

PLUGGED TEE

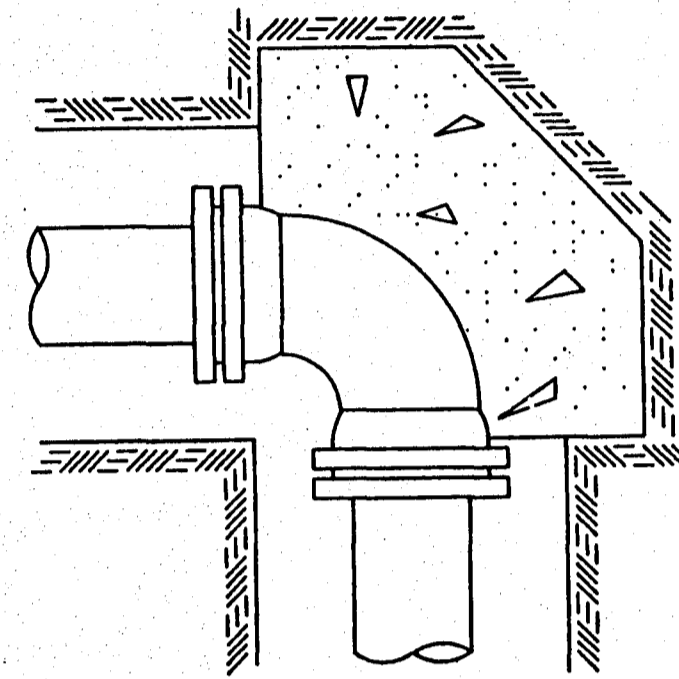

90° BEND

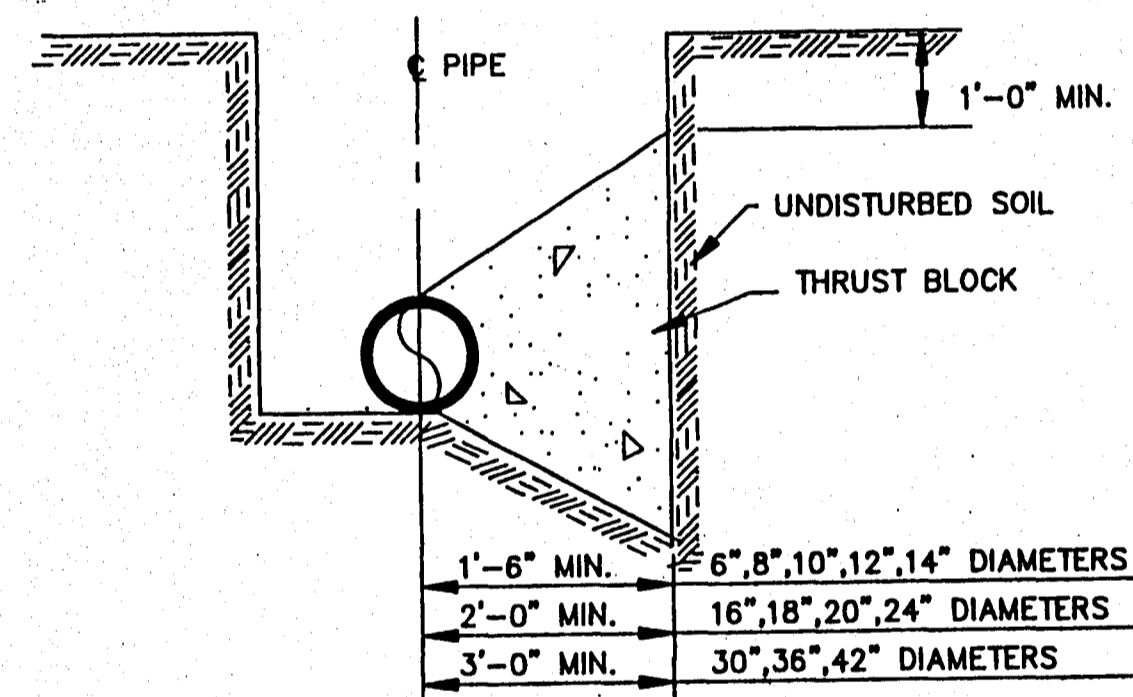

TYPICAL CROSS SECTION

TYPICAL THRUST BLOCKING IN WATER MAINS AND SEWAGE FORCE MAINS

N.T.S.
NOTE: ALL THRUST BLOCKS 2,500 PSI CONCRETE AGAINST UNDISTURBED EARTH


BEARING AREA IN SQ. FT.

NOMINAL PIPE DIAMETER (IN)	VERTICAL BENDS					NOMINAL PIPE DIAMETER (IN)	VERTICAL BENDS				
	DEAD-END OR TEE	90° BEND	45° BEND	22 1/2° BEND	11 1/4° BEND		DEAD-END OR TEE	90° BEND	45° BEND	22 1/2° BEND	11 1/4° BEND
6	2.5	3.0	2.0	2.0	2.0	6	—	—	26.0(1.0)	14.0(5)	7.0(3)
8	4.0	6.0	3.0	2.0	2.0	8	—	—	45.0(1.7)	25.0(9)	13.0(5)
10	6.0	9.0	5.0	2.5	2.0	10	—	—	68.0(2.5)	37.0(1.4)	19.0(7)
12	9.0	11.0	6.0	3.5	2.0	12	—	—	97.0(3.6)	52.0(1.9)	27.0(1.0)
14	12.0	18.0	9.0	5.0	2.5	14	—	—	130(4.8)	70.0(2.8)	36.0(1.3)
16	16.0	22.5	12.0	6.0	3.0	16	—	—	168(6.2)	91.0(3.4)	46.0(1.7)
18	20.0	28.0	15.0	8.0	4.0	18	—	—	211(7.8)	114(4.2)	58.0(2.2)
20	24.5	34.0	19.0	10.0	5.0	20	—	—	259(9.6)	140(5.2)	72.0(2.6)
24	35.0	49.0	27.0	14.0	7.0	24	—	—	370(13.7)	200(7.4)	102(3.8)
30	54.0	76.0	41.0	21.0	10.0	30	—	—	568(21.1)	308(11.4)	156(5.8)
36	77.0	108.0	59.0	30.0	15.0	36	—	—	814(30.1)	440(16.3)	225(8.3)
42	104.0	146.0	79.0	40.0	20.0	42	—	—	1100(40.7)	595(22.0)	303(11.2)


VOLUME OF BLOCKS INCLUDING SOIL LOAD CU. FT. (CU. YDS.)

NOTE: ABOVE VALUES CALCULATED USING P=100 AND ALLOWANCE SOIL BRG. = 1500 PSF. FOR DIFFERENT P, MULTIPLY ABOVE VALUES BY P/100. FOR DIFFERENT SOIL BRG, MULTIPLY ABOVE VALUES BY 1500/S.B.


NOTE: ABOVE VALUES REPRESENT THE VOLUME OF BLOCKS INCLUDING SOIL LOAD IN CU.FT. (CU.YDS.) THE VALUES WERE CALCULATED USING A P=100 PSI AND A S.F.=1.5. FOR DIFFERENT P, MULTIPLY VALUES BY P/100.

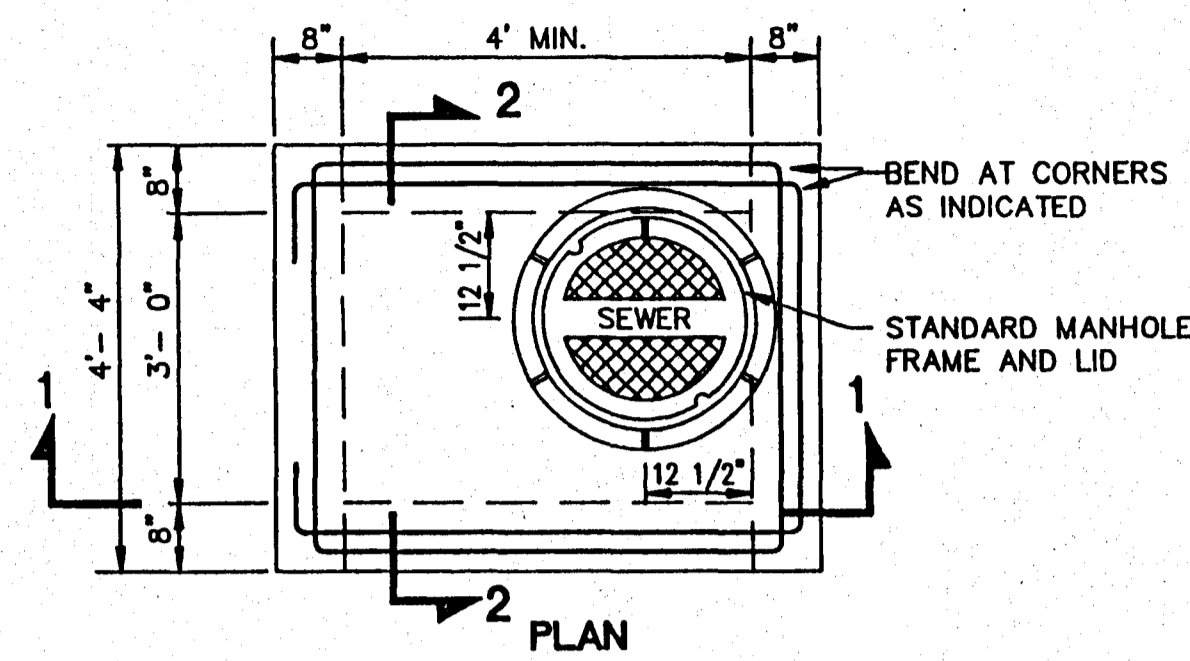

PLAN

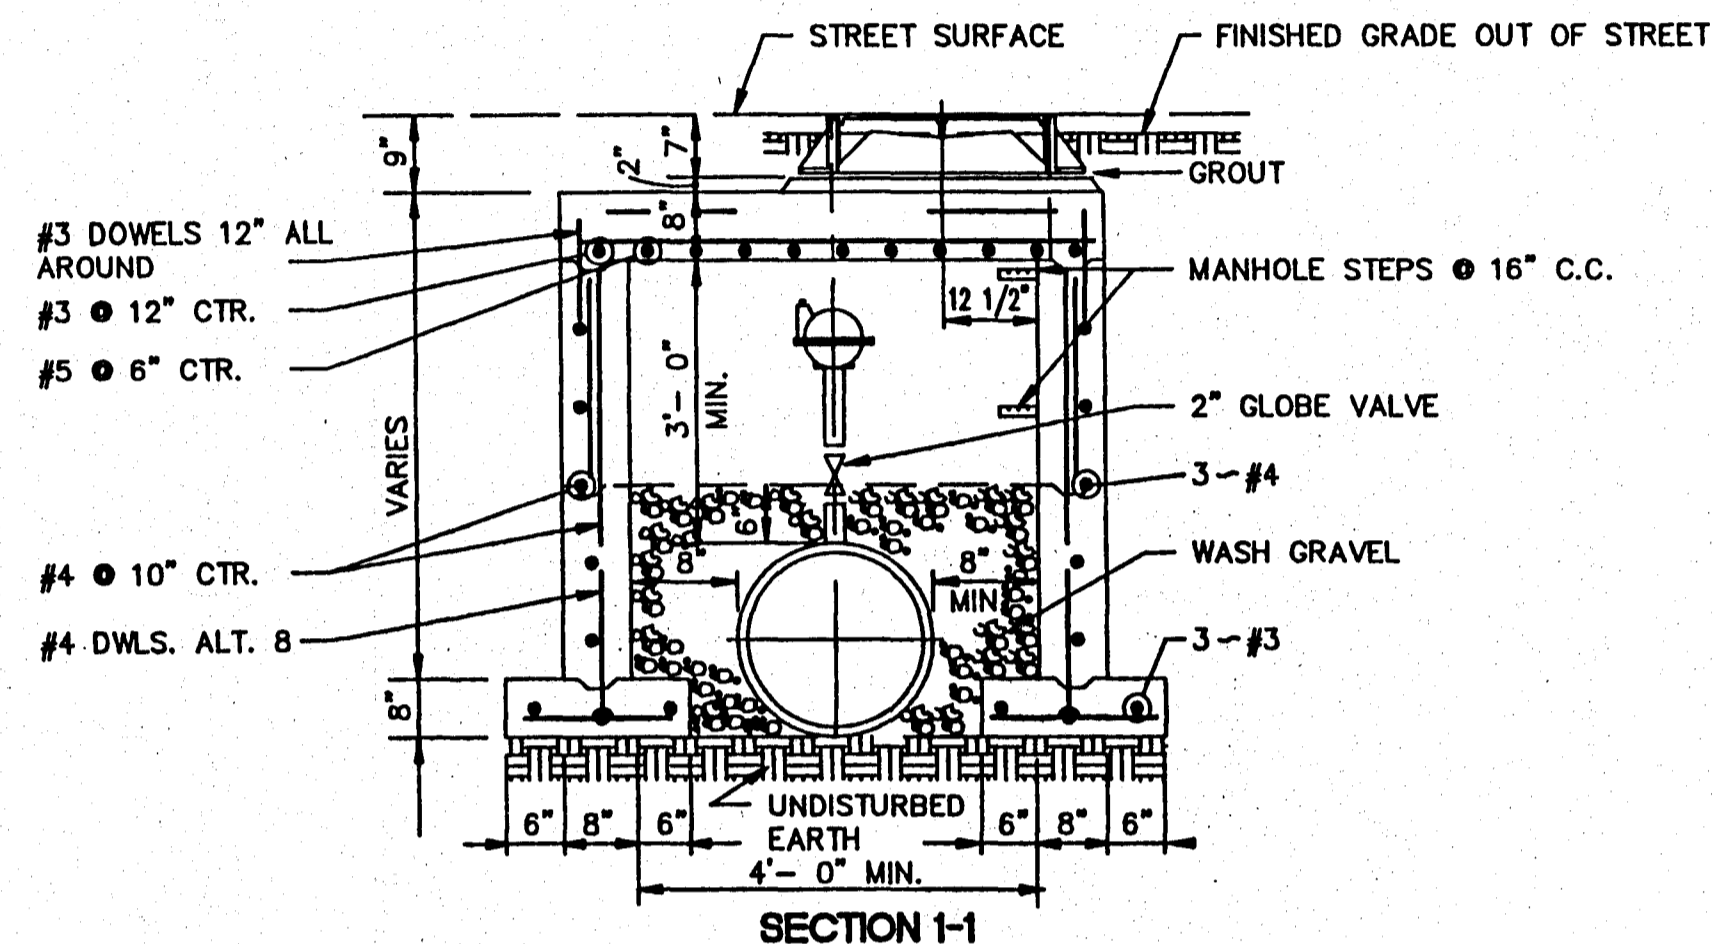


SECTION 1-1

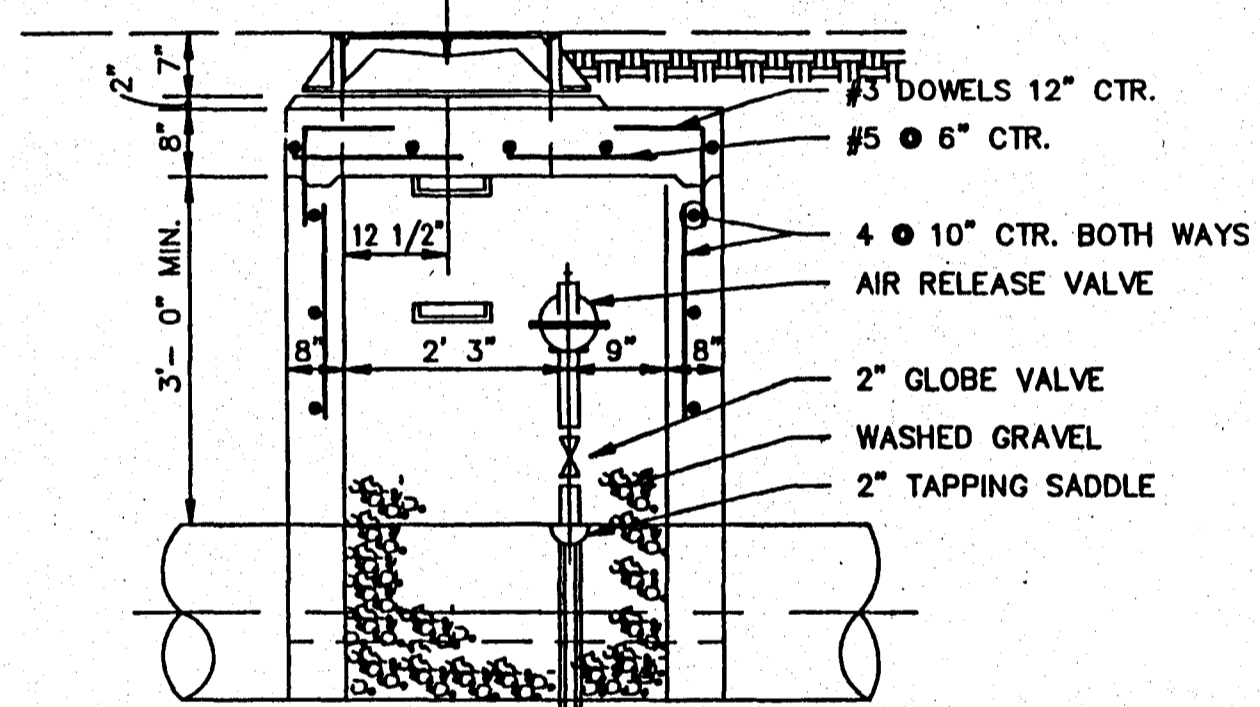


SECTION 2-2

TYPICAL AIR OR AIR VACCUUM RELEASE VALVE INSTALLATION WITH MANHOLE

NOT TO SCALE

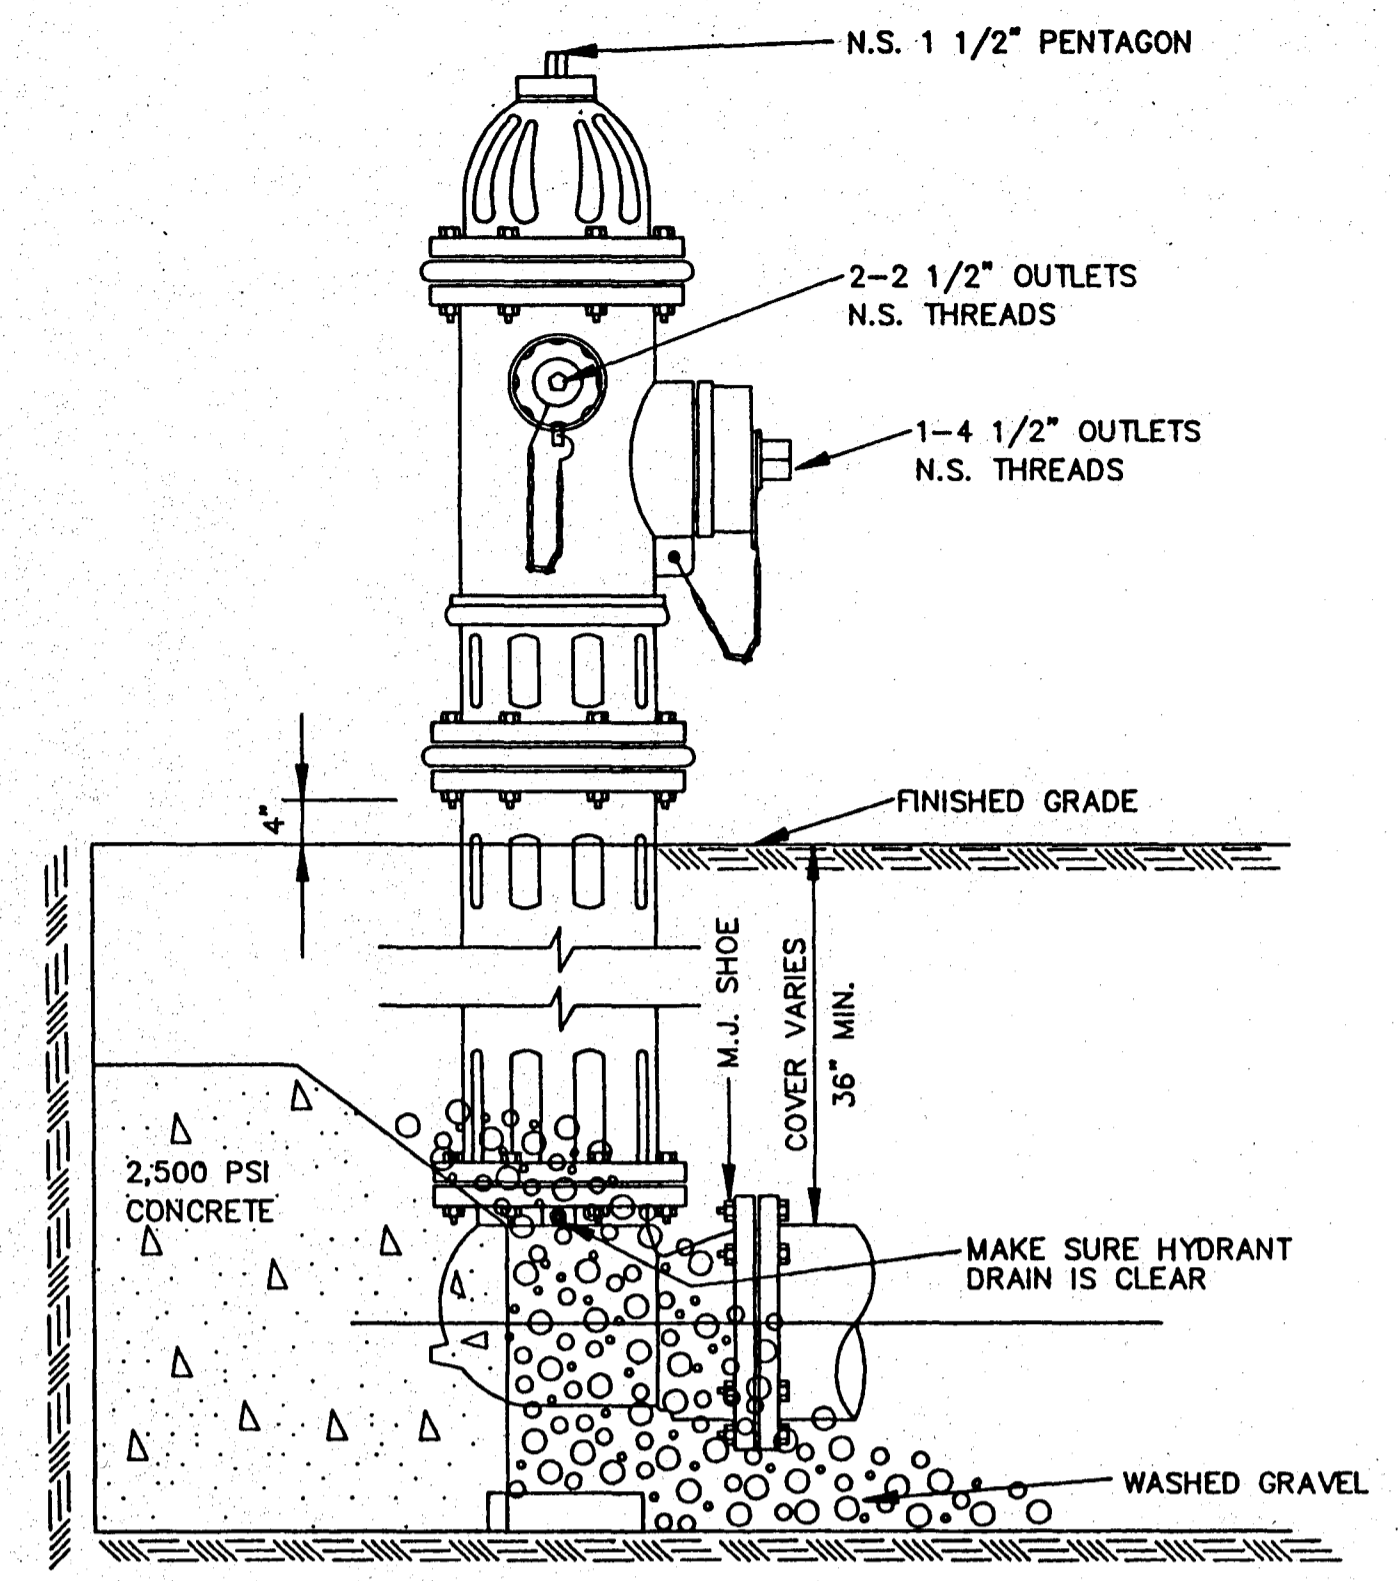


ELEVATION

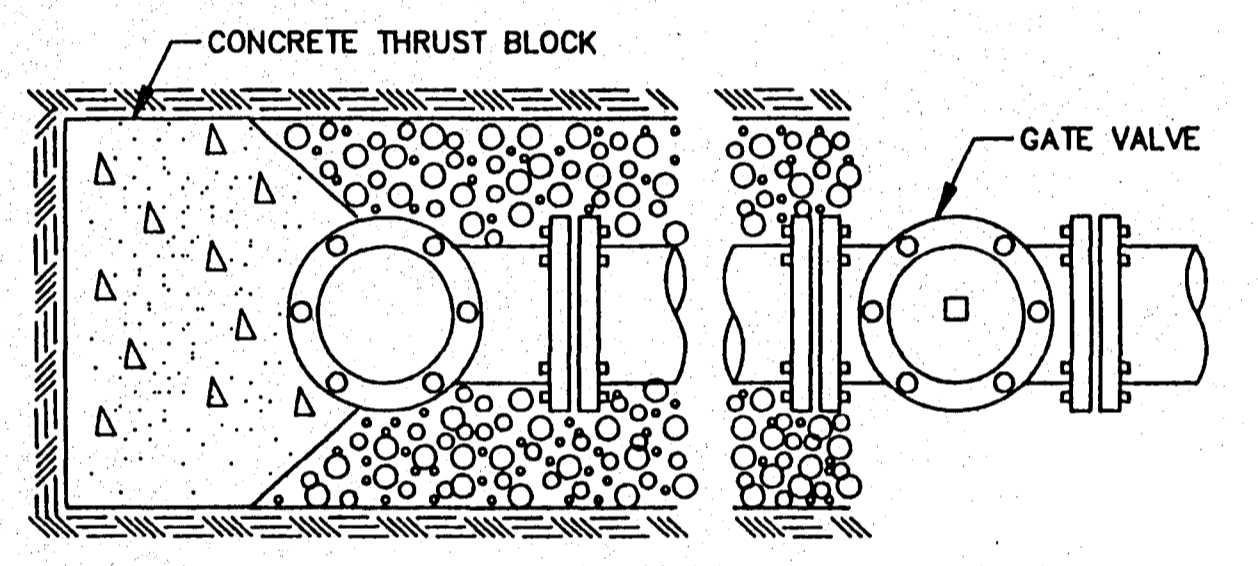

PLAN

TYPICAL FIRE HYDRANT INSTALLATION

NOTE: GATE VALVES W/ ANCHOR COUPLINGS WILL BE REQUIRED ON ALL FIRE HYDRANT LEGS. ANCHOR COUPLING RODS REQ'D.

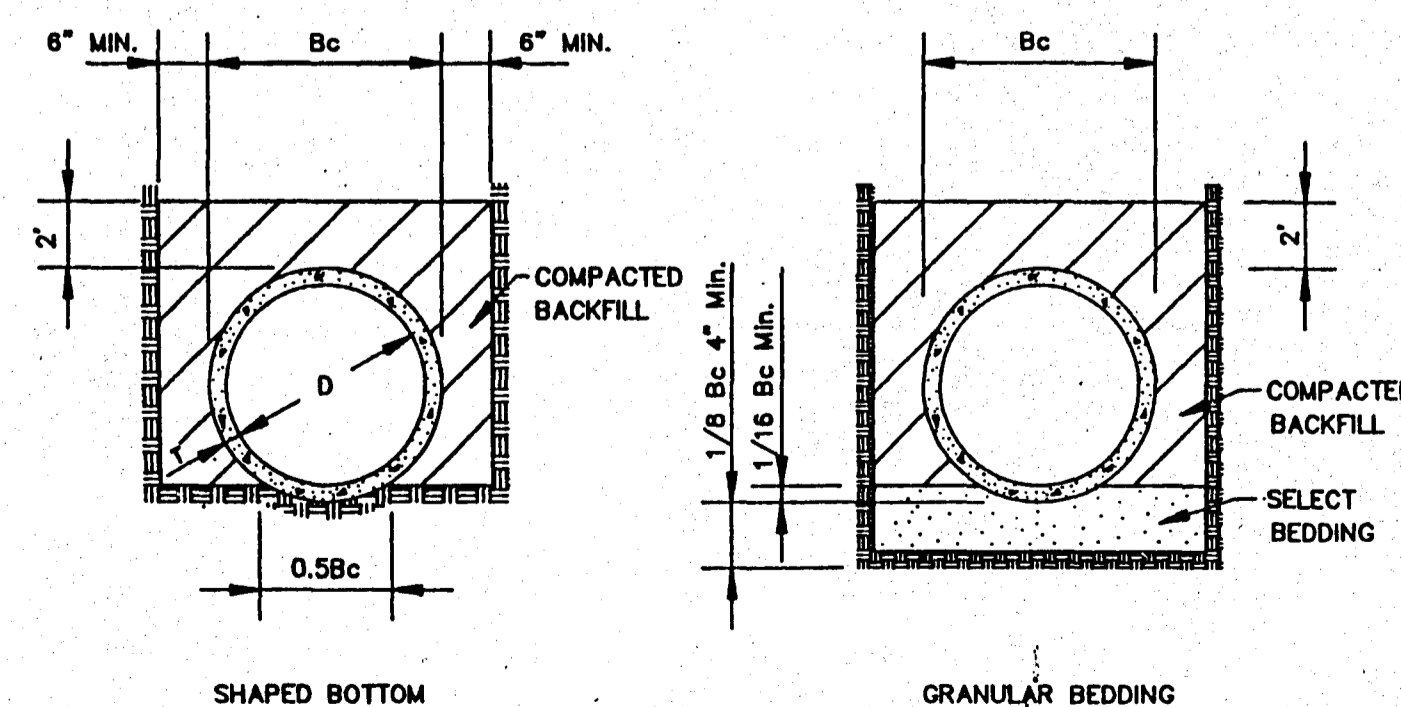


TYPICAL TRENCH DETAILS

N.T.S.


CITY OF RIDGELAND, MS. STANDARD DETAILS

DBGN:	THE CITY OF RIDGELAND	DRAWING NO.
DRWN:		OF
CHKD:		
SCALE:		

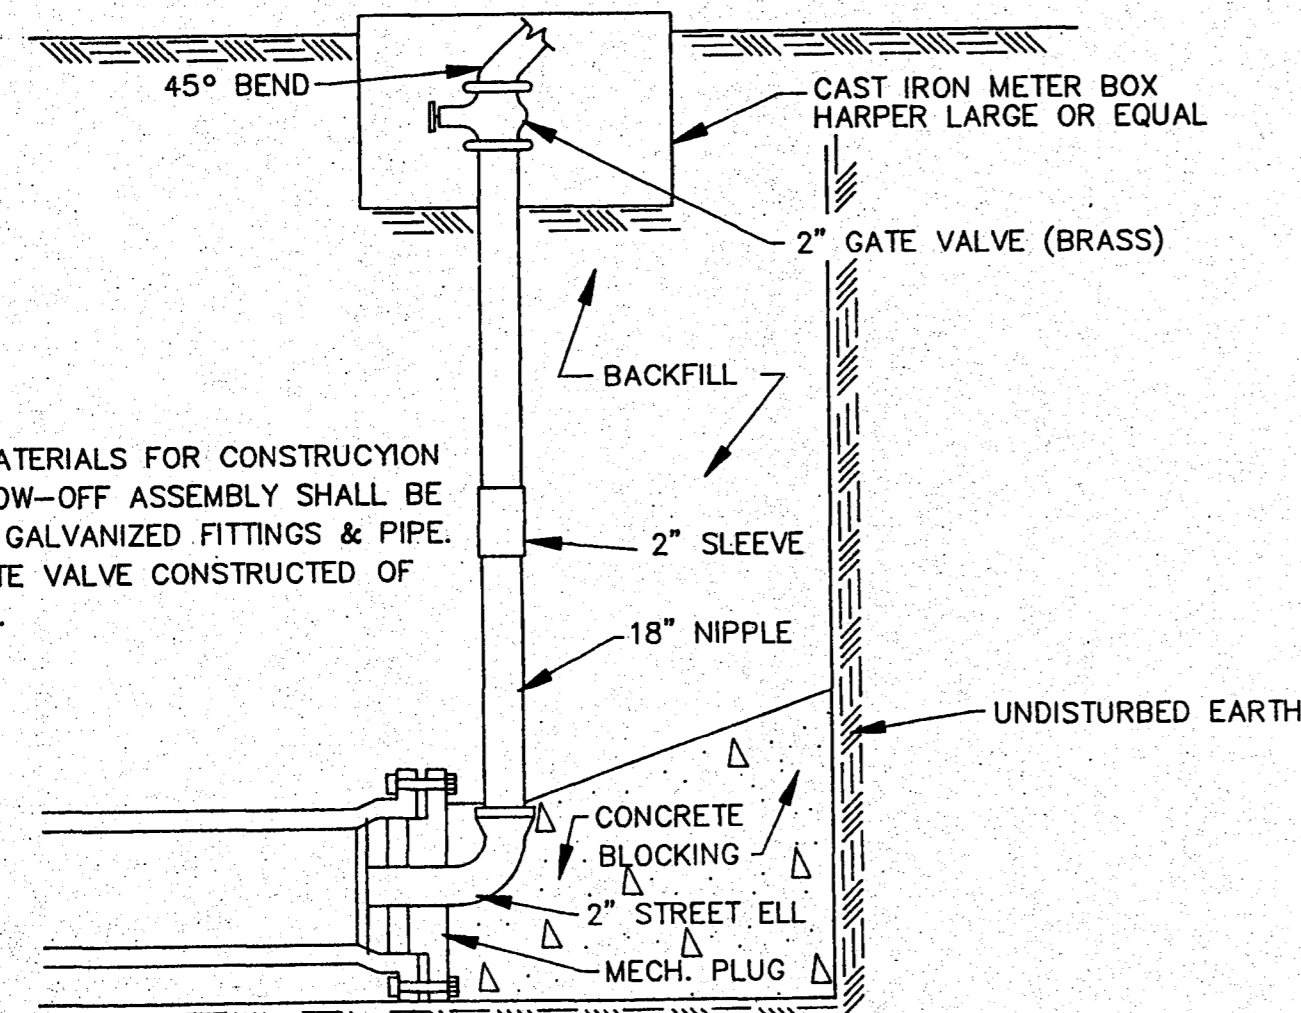


NOTE:
ALL MATERIALS FOR CONSTRUCTION OF BLOW-OFF ASSEMBLY SHALL BE OF 2" GALVANIZED FITTINGS & PIPE. 2" GATE VALVE CONSTRUCTED OF BRASS.


TYPICAL BLOW-OFF ASSEMBLY
N.T.S.

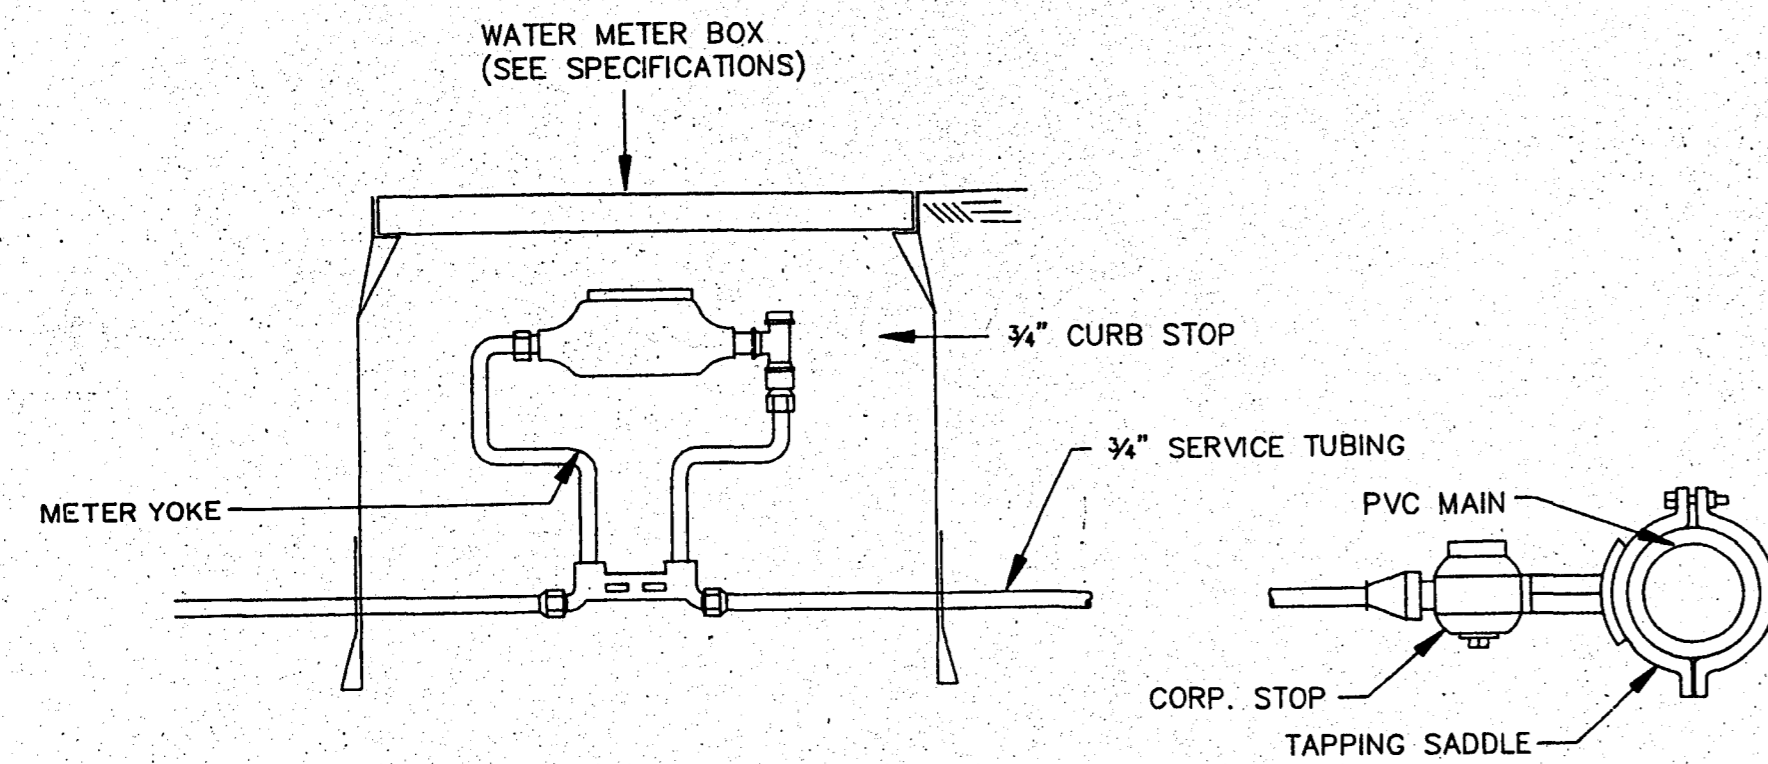


TYPICAL 3/4" WATER SERVICE
N.T.S.

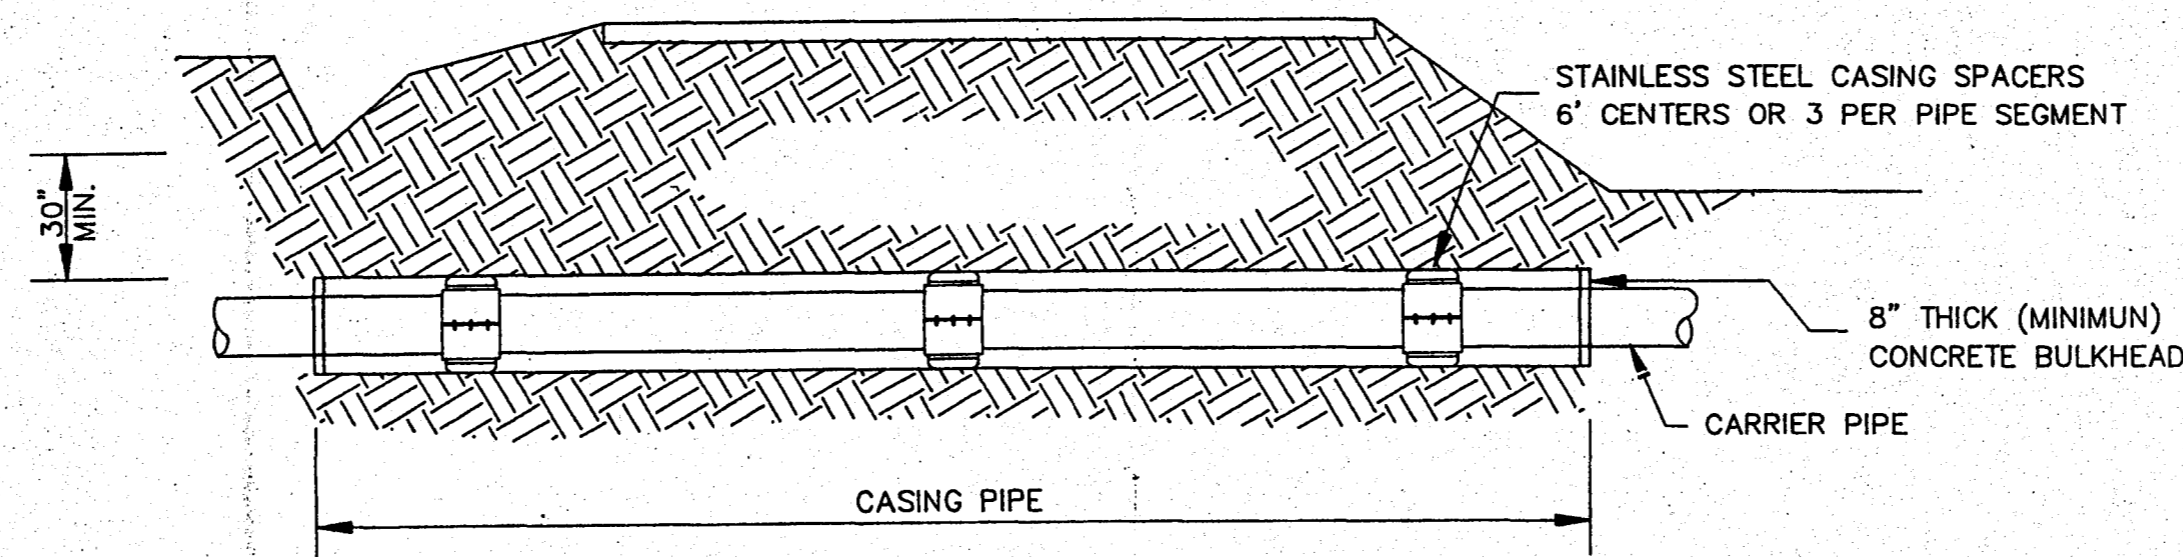


TYPICAL BORE SECTION
N.T.S.

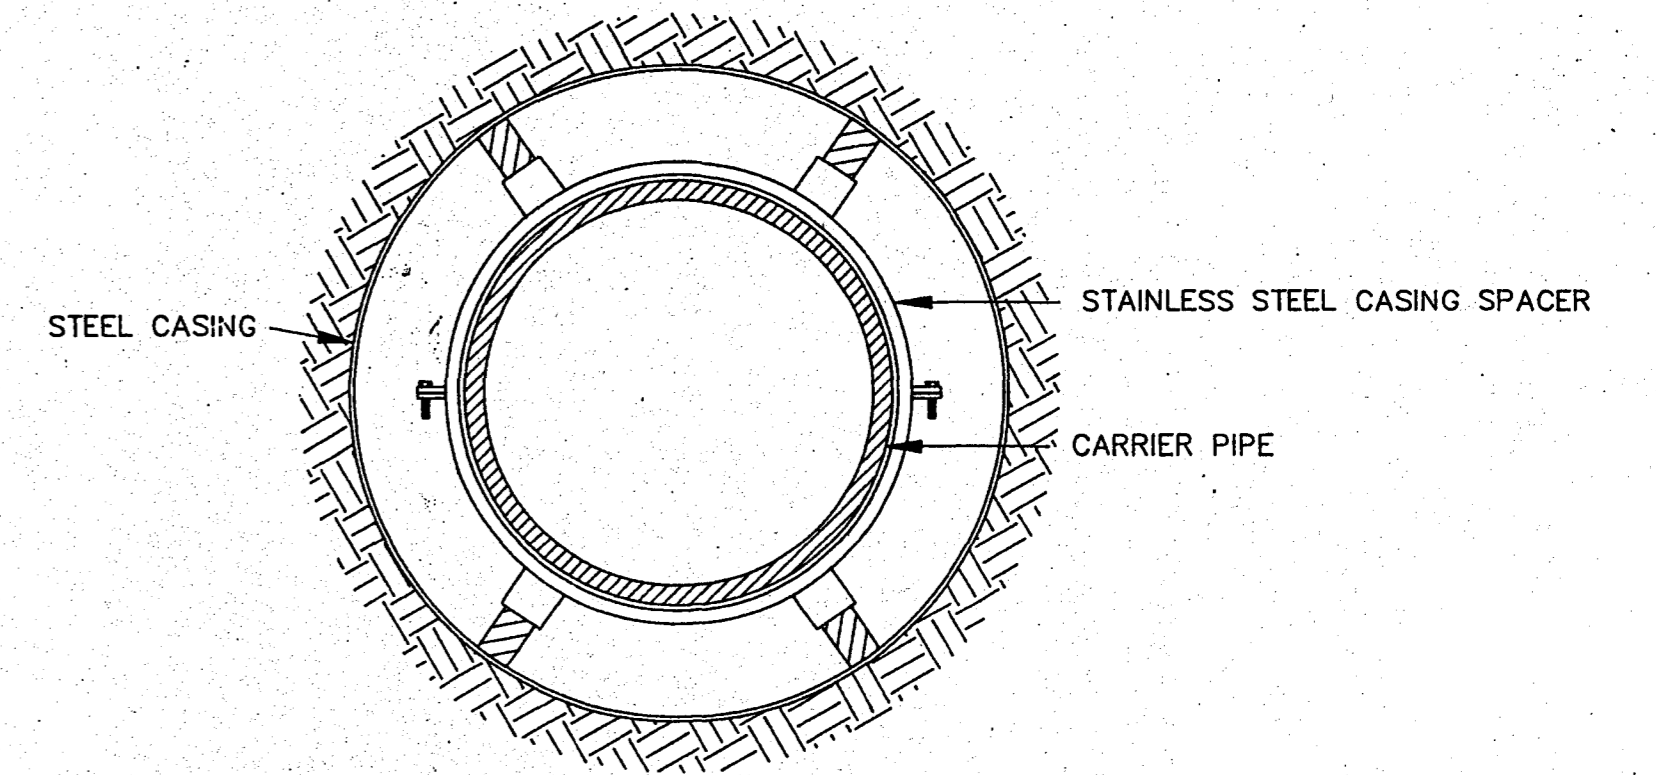


BORE SECTION
N.T.S.

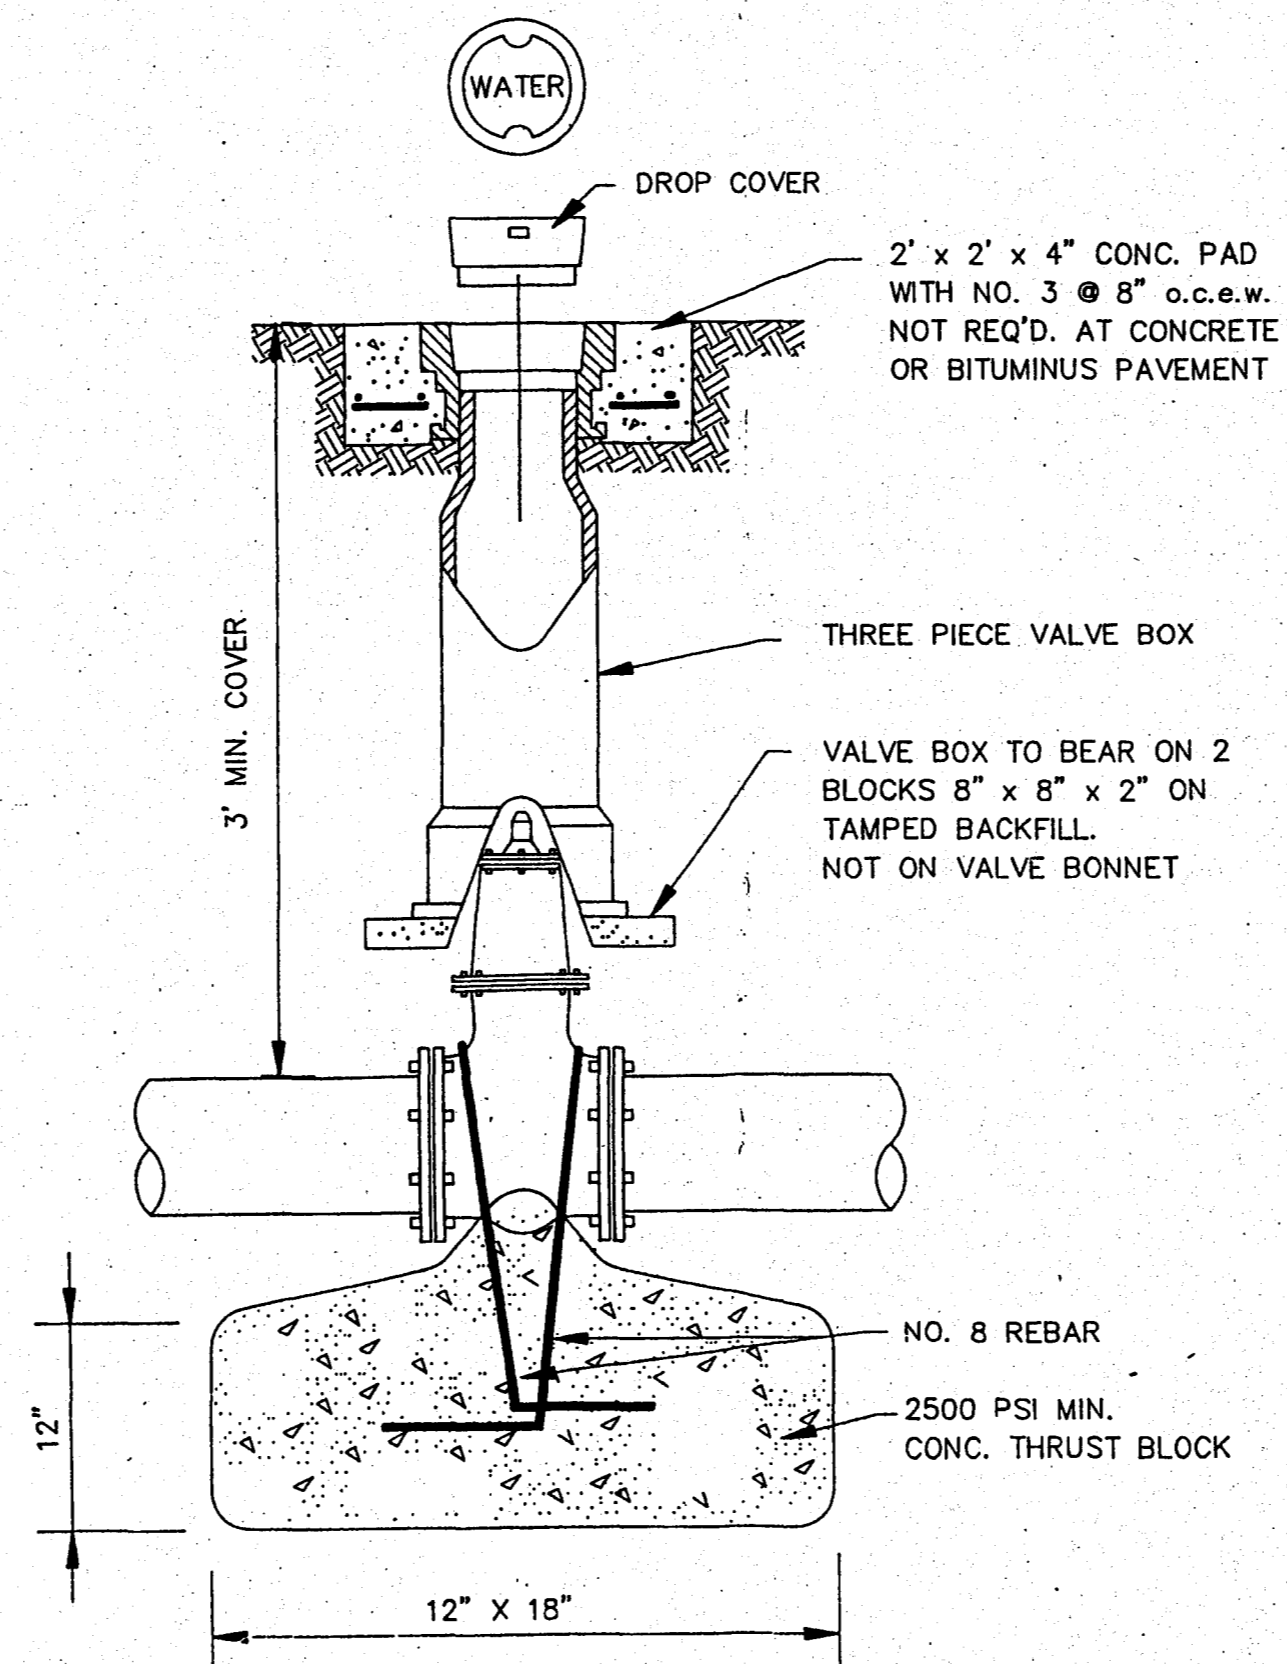


GATE VALVE DETAIL
N.T.S.

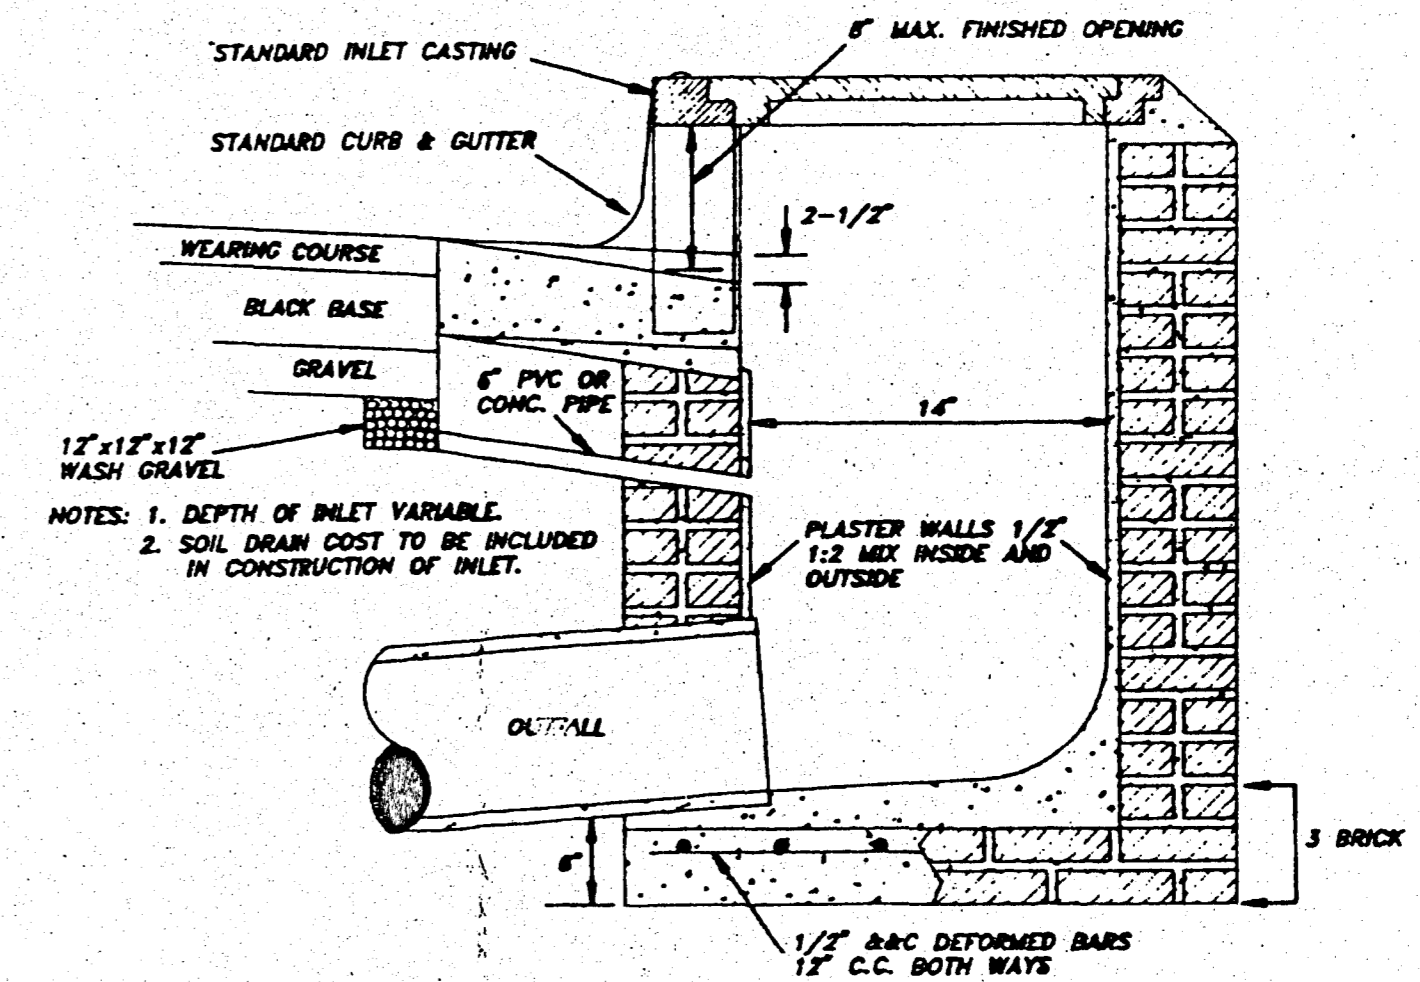

SECTION OF STANDARD CURB INLET

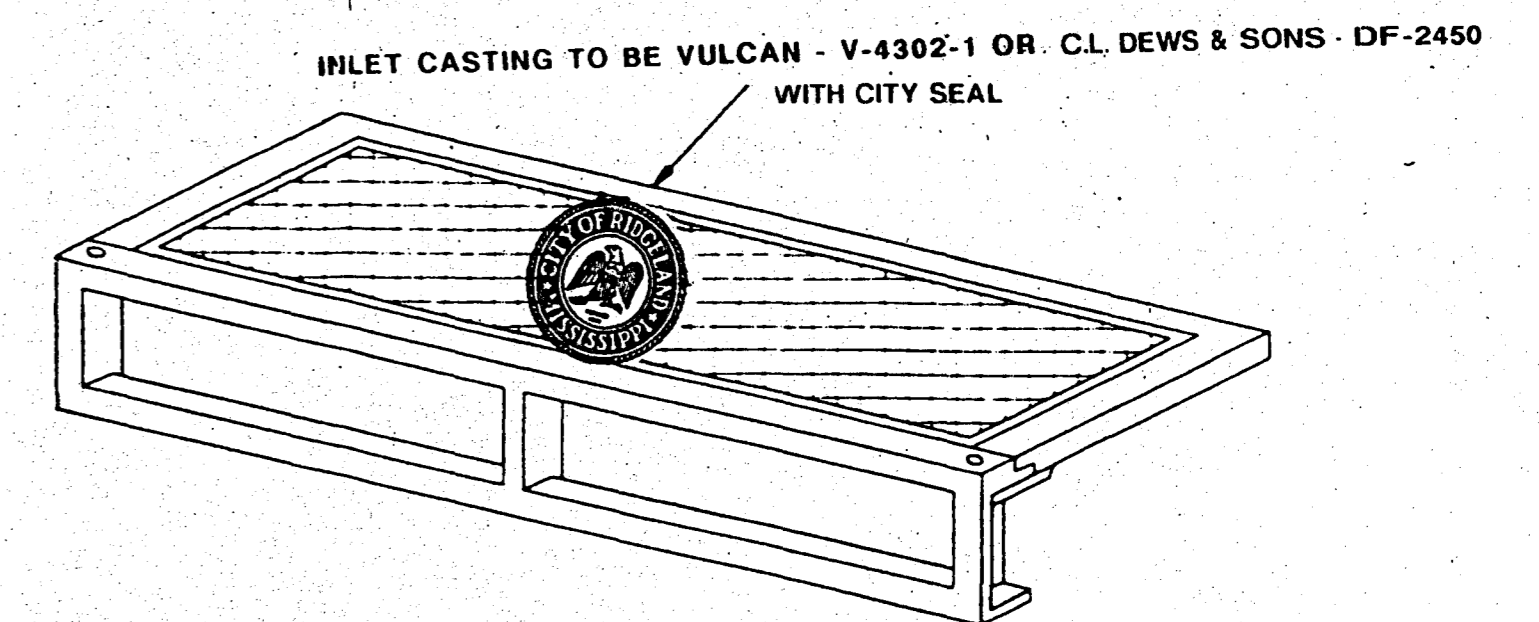

STANDARD CURB INLET CASTING

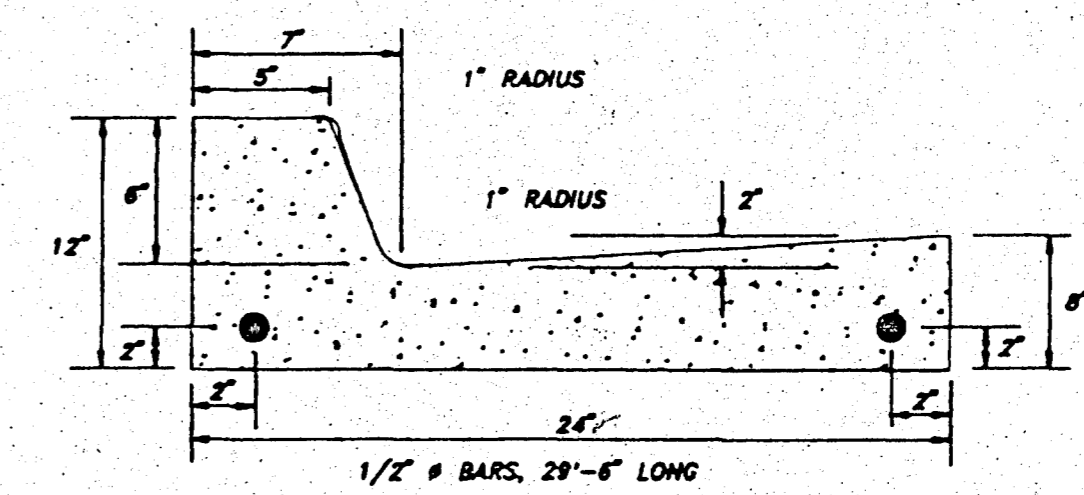

NOTES: 1. ALL CURBS, GUTTERS & DRIVEWAYS TO BE CONSTRUCTED OF 3000 LB. CONCRETE.
2. 2 - 3/4" DOWEL BARS, 15" LONG REQ'D. AT EXPANSION JOINTS. THEY SHALL BE HELD IN PLACE BY APPROVED CHAIRS OR SUPPORTS AND 1/2" EXPANSION MATERIALS.


STANDARD CURB & GUTTER

CITY OF RIDGELAND, MS.

STANDARD DETAILS

DSGN: SV	THE CITY OF RIDGELAND	DRAWING NO.
DRWN: BRM		OF
CHKD: SV		
SCALE: N.T.S.		

DRAWING 77596 FROM 13865

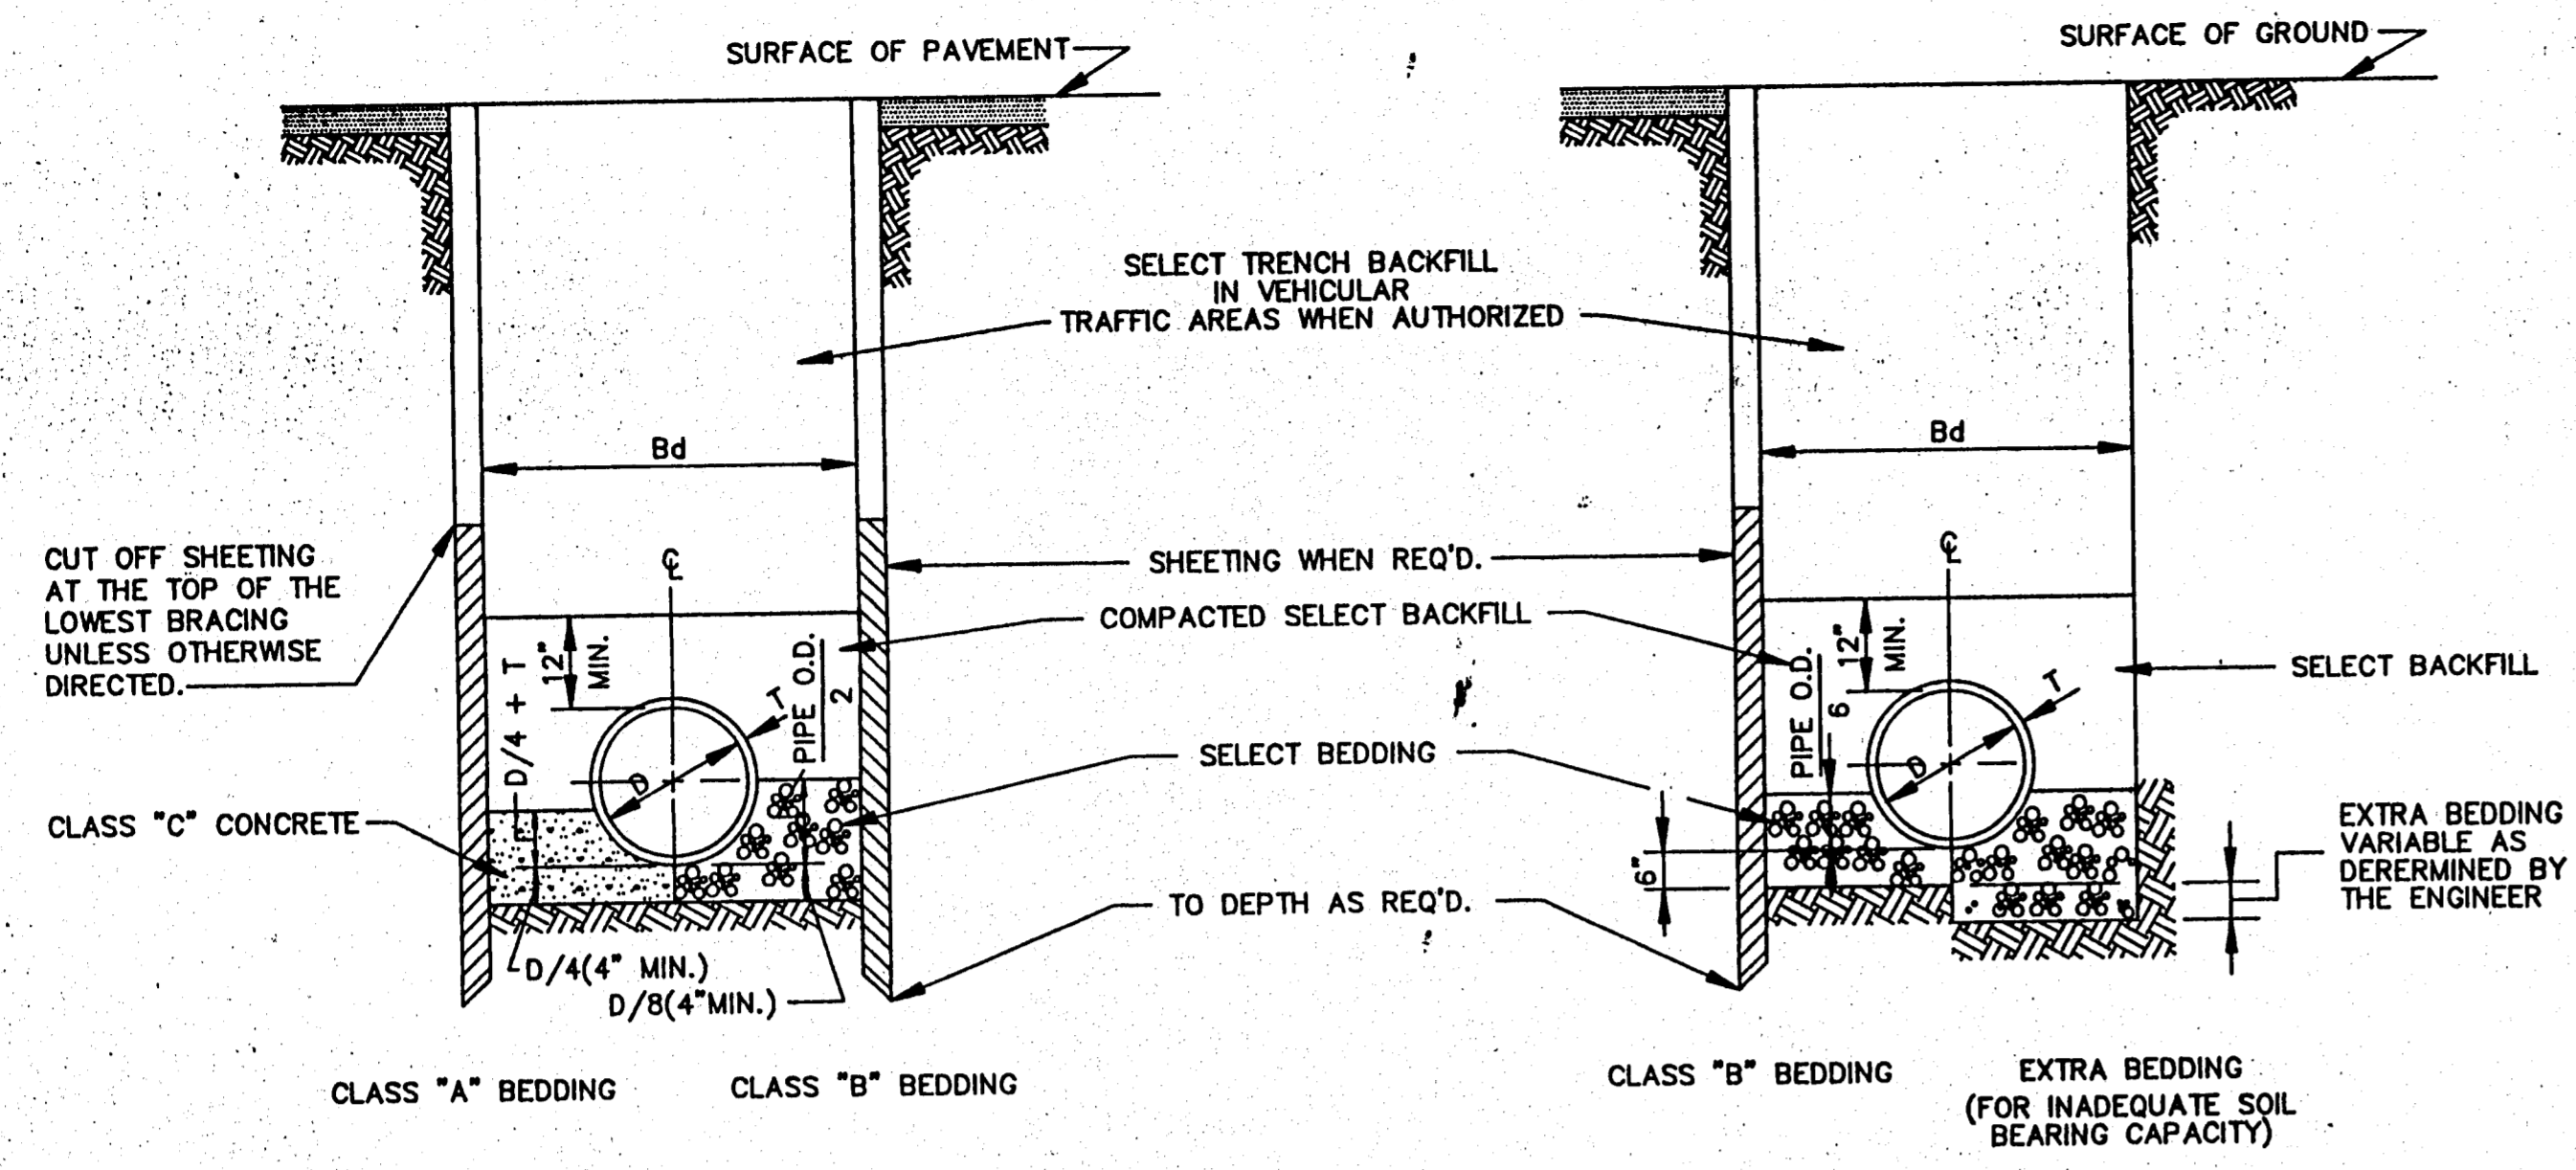

TYPICAL TRENCH DETAILS (FORCE MAIN)

CLASS "A" BEDDING
 MATERIAL SHALL BE CLASS "C" CONCRETE CRADLES. THE PIPE SHALL BE LAID ON CONCRETE SADDLES CONSTRUCTED TO PROVIDE VERTICAL AND LATERAL SUPPORT FOR THE PIPE WHILE THE CRADLE IS BEING PLACED. PIPE SUPPORTS OF WOOD BLOCKS, LOOSE BRICK, ETC., WILL NOT BE PERMITTED. THE CRADLE SHALL BE POURED AFTER THE JOINTS HAVE BEEN MADE, CARE BEING TAKEN TO PREVENT MOVEMENT OF THE PIPE. WHENEVER THE CONTRACTOR PLACES CONCRETE OUTSIDE THE DIMENSIONS SHOWN ON THE DRAWINGS, THE COST OF SUCH CONCRETE WILL BE AT THE CONTRACTOR'S EXPENSE.

CLASS "B" BEDDING
 MATERIAL SHALL BE SELECT BEDDING AS SPECIFIED. MATERIAL SHALL BE CAREFULLY PLACED AND THOROUGHLY COMPACTED BY TAMPING.

CLASS "C" BEDDING (STANDARD BEDDING)
 MATERIAL SHALL BE THE SAME AS FOR CLASS "B" BEDDING AND SHALL BE PLACED AS SHOWN BY STANDARD DETAILS FOR THE TYPE OF PIPE USED.

CLASS "A" BEDDING CLASS "B" BEDDING CLASS "B" BEDDING EXTRA BEDDING (FOR INADEQUATE SOIL BEARING CAPACITY)
 BEDDING FOR VITRIFIED CLAY, CONCRETE & ABS PIPE


TYPICAL TRENCH DETAILS
 N.T.S.

TABLE "A"
 PIPE SIZE

CARRIER PIPE (INCHES)	CASING PIPE	
	DIA (INCHES)	STEEL PIPE WALL THICK
8	16	1/4"
10	20	5/16"
12	24	3/8"
14 & 16	30	1/2"
18	36	1/2"
24	36	1/2"
30	54	1/2"
36	54	1/2"
42	66	SEE TABLE "B"
48	72	"
54	78	"
60	84	"
66	96	"
72	108	"
84	120	"
96	144	"


TABLE "B"
 GAGES OF LINER PLATE FOR CONTINUOUS LOAD-CARRYING STRUCTURES

NOMINAL DIA. (INCHES)	HEIGHT OF COVER (FEET)											
	2-5	6-10	11-15	16-20	21-25	26-30	31-35	36-40	41-45	46-50	51-55	56-60
48	12	12	12	12	12	12	12	12	10	8	7	10
54	12	12	12	12	12	12	12	12	10	8	7	10
60	12	12	12	12	12	12	12	12	10	8	7	10
66	12	12	12	12	12	12	12	10	8	7	5	5
72	12	12	12	12	12	12	10	8	7	5	5	5
78	12	12	12	12	10	8	7	5	5	5	5	5
84	12	12	12	10	8	7	5	5	5	5	5	5
96	12	10	10	10	8	7	5	5	5	5	5	5
108	10	10	10	10	8	7	5	5	5	5	5	5
120	10	10	10	8	7	5	5	5	5	5	5	5
144	8	8	8	8	5	5	5	5	5	5	5	5

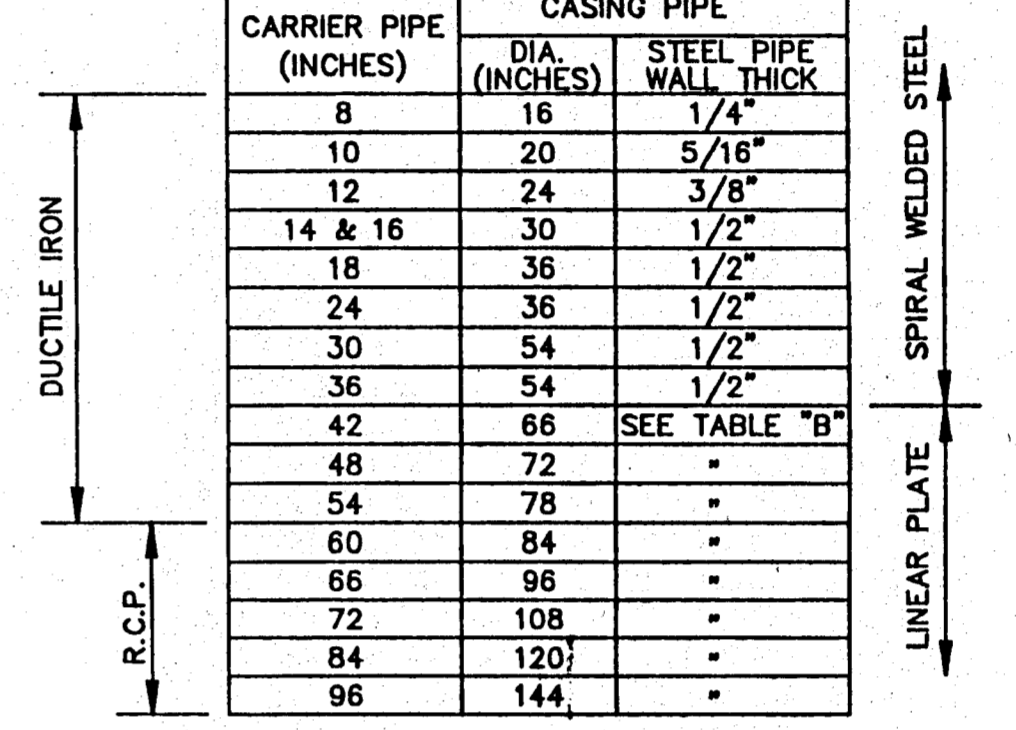


MIN. THICKNESS FOR LINER PLATE CASING IN RAILROAD CROSSING-10 GAGE


CASING PIPE
 SIZE AND THICKNESS OF PIPE FOR RAILROAD & HIGHWAY CROSSING

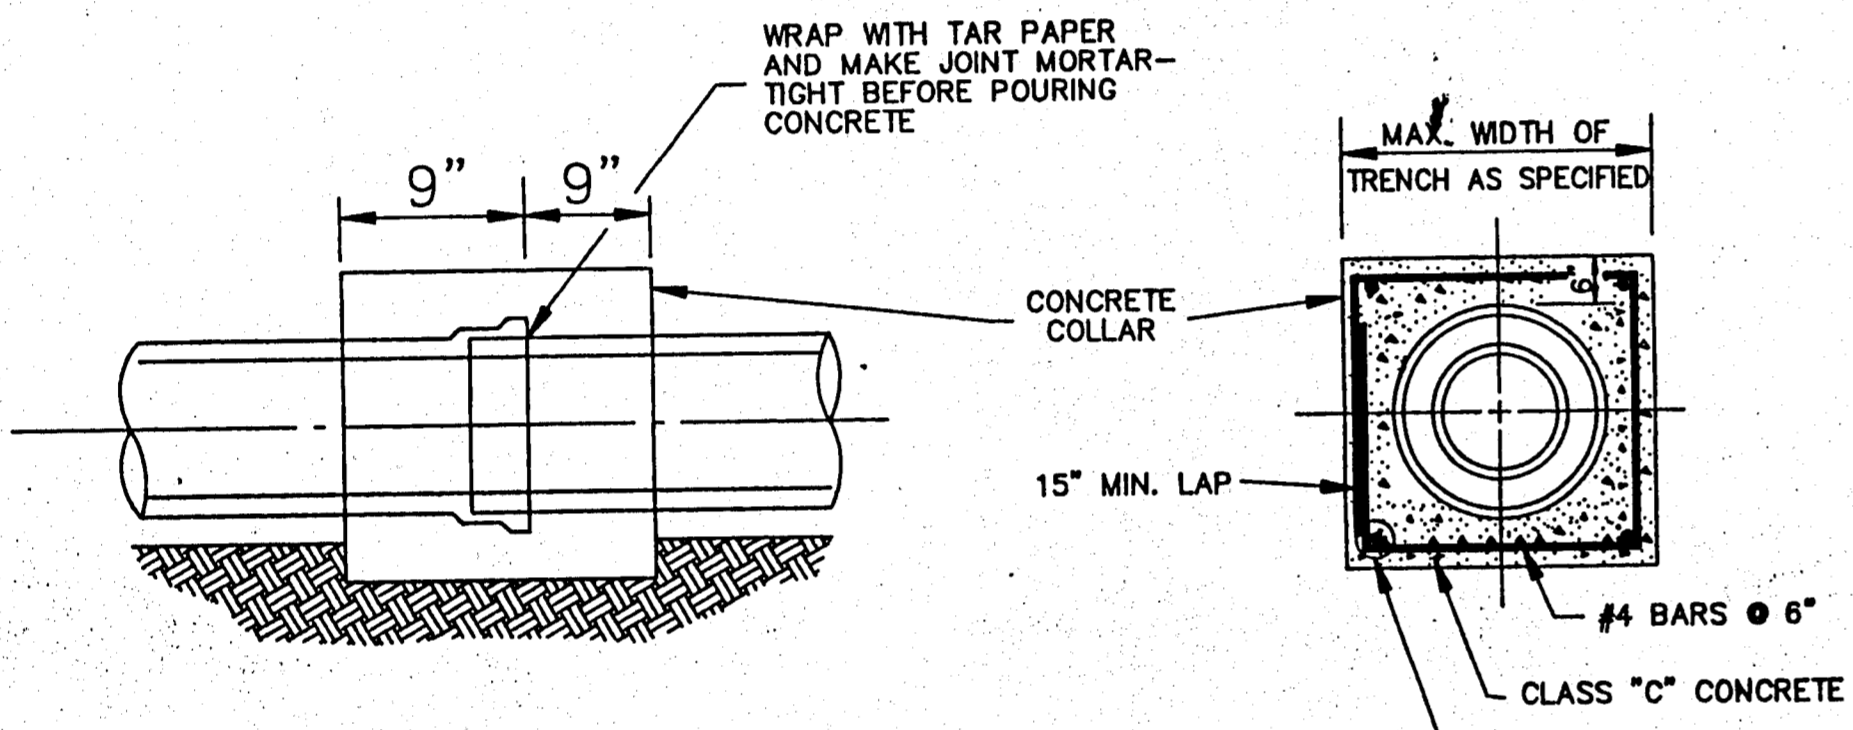


TYPICAL DETAIL OF CONCRETE COLLAR
 N.T.S.

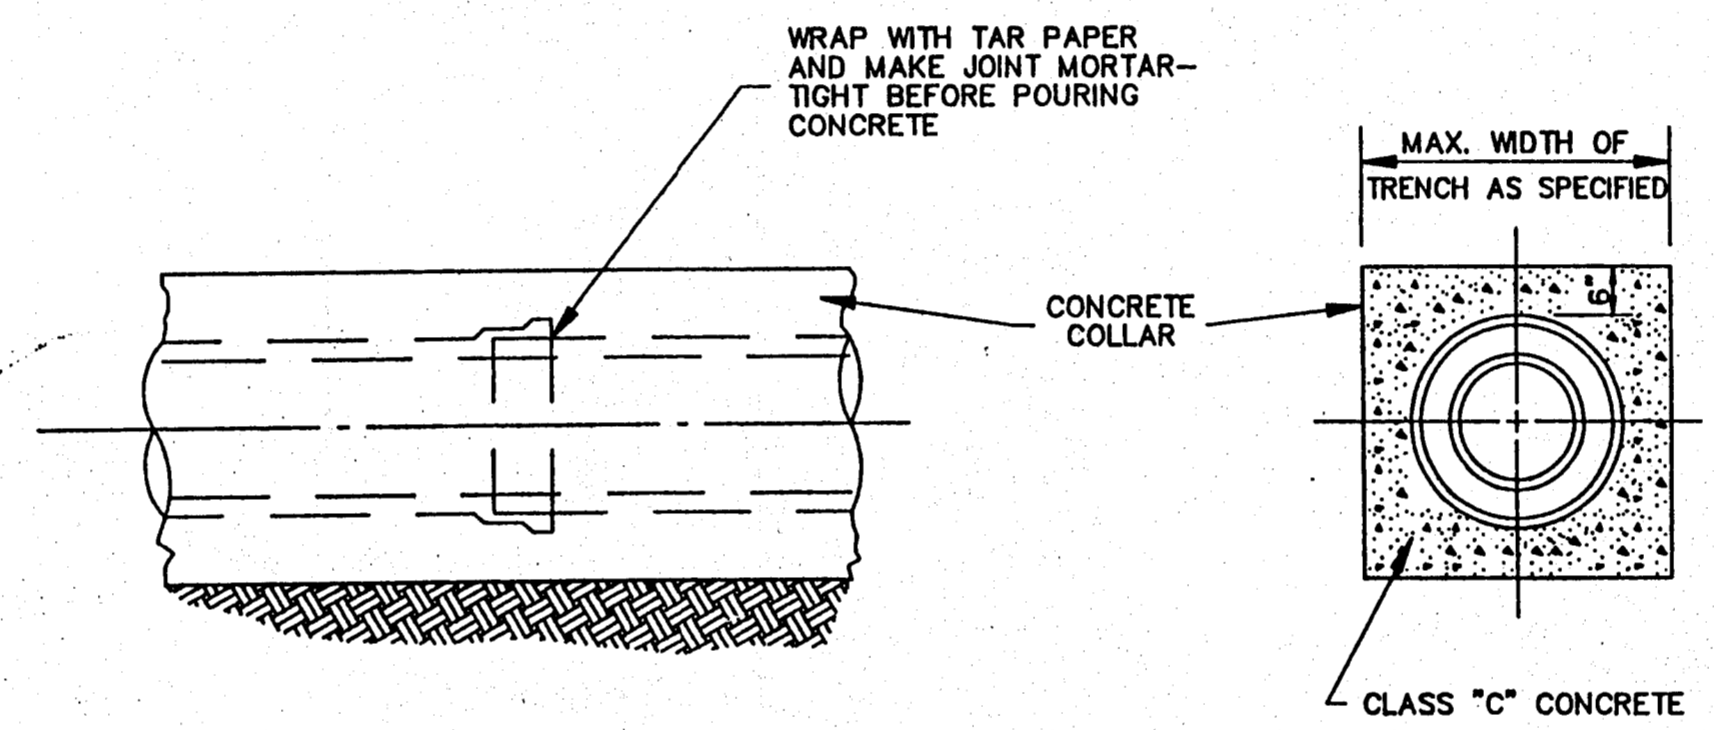


TYPICAL DETAIL OF CONCRETE ENCASEMENT
 N.T.S.

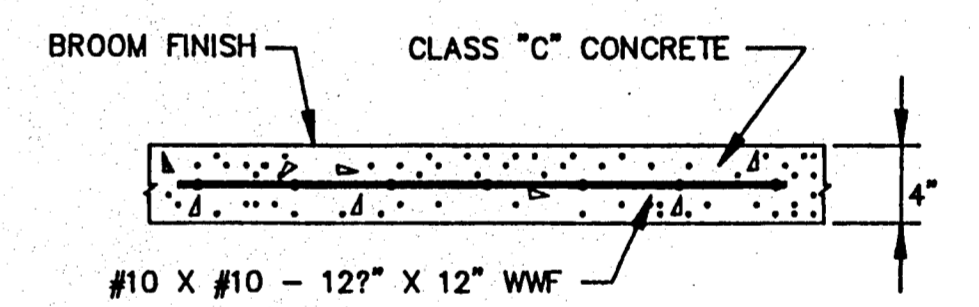


TYPICAL CONC. DRIVEWAY AND SIDEWALK REPAIR

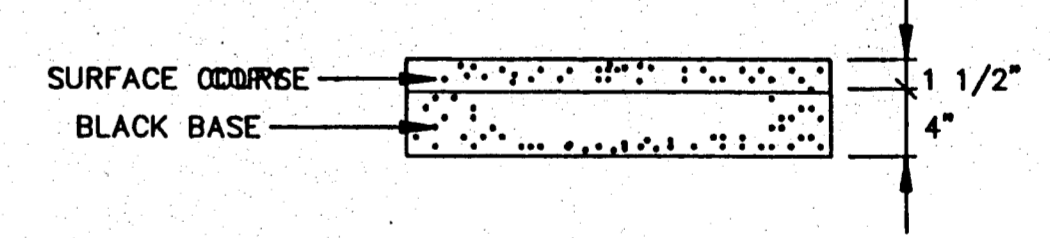

TYPICAL ASPHALT DRIVEWAY REPAIR

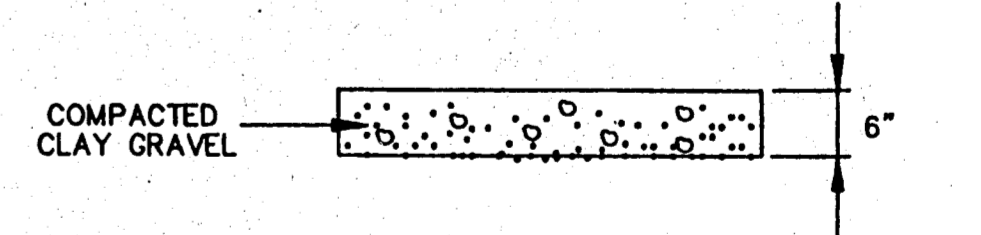


TYPICAL GRAVEL DRIVEWAY REPAIR

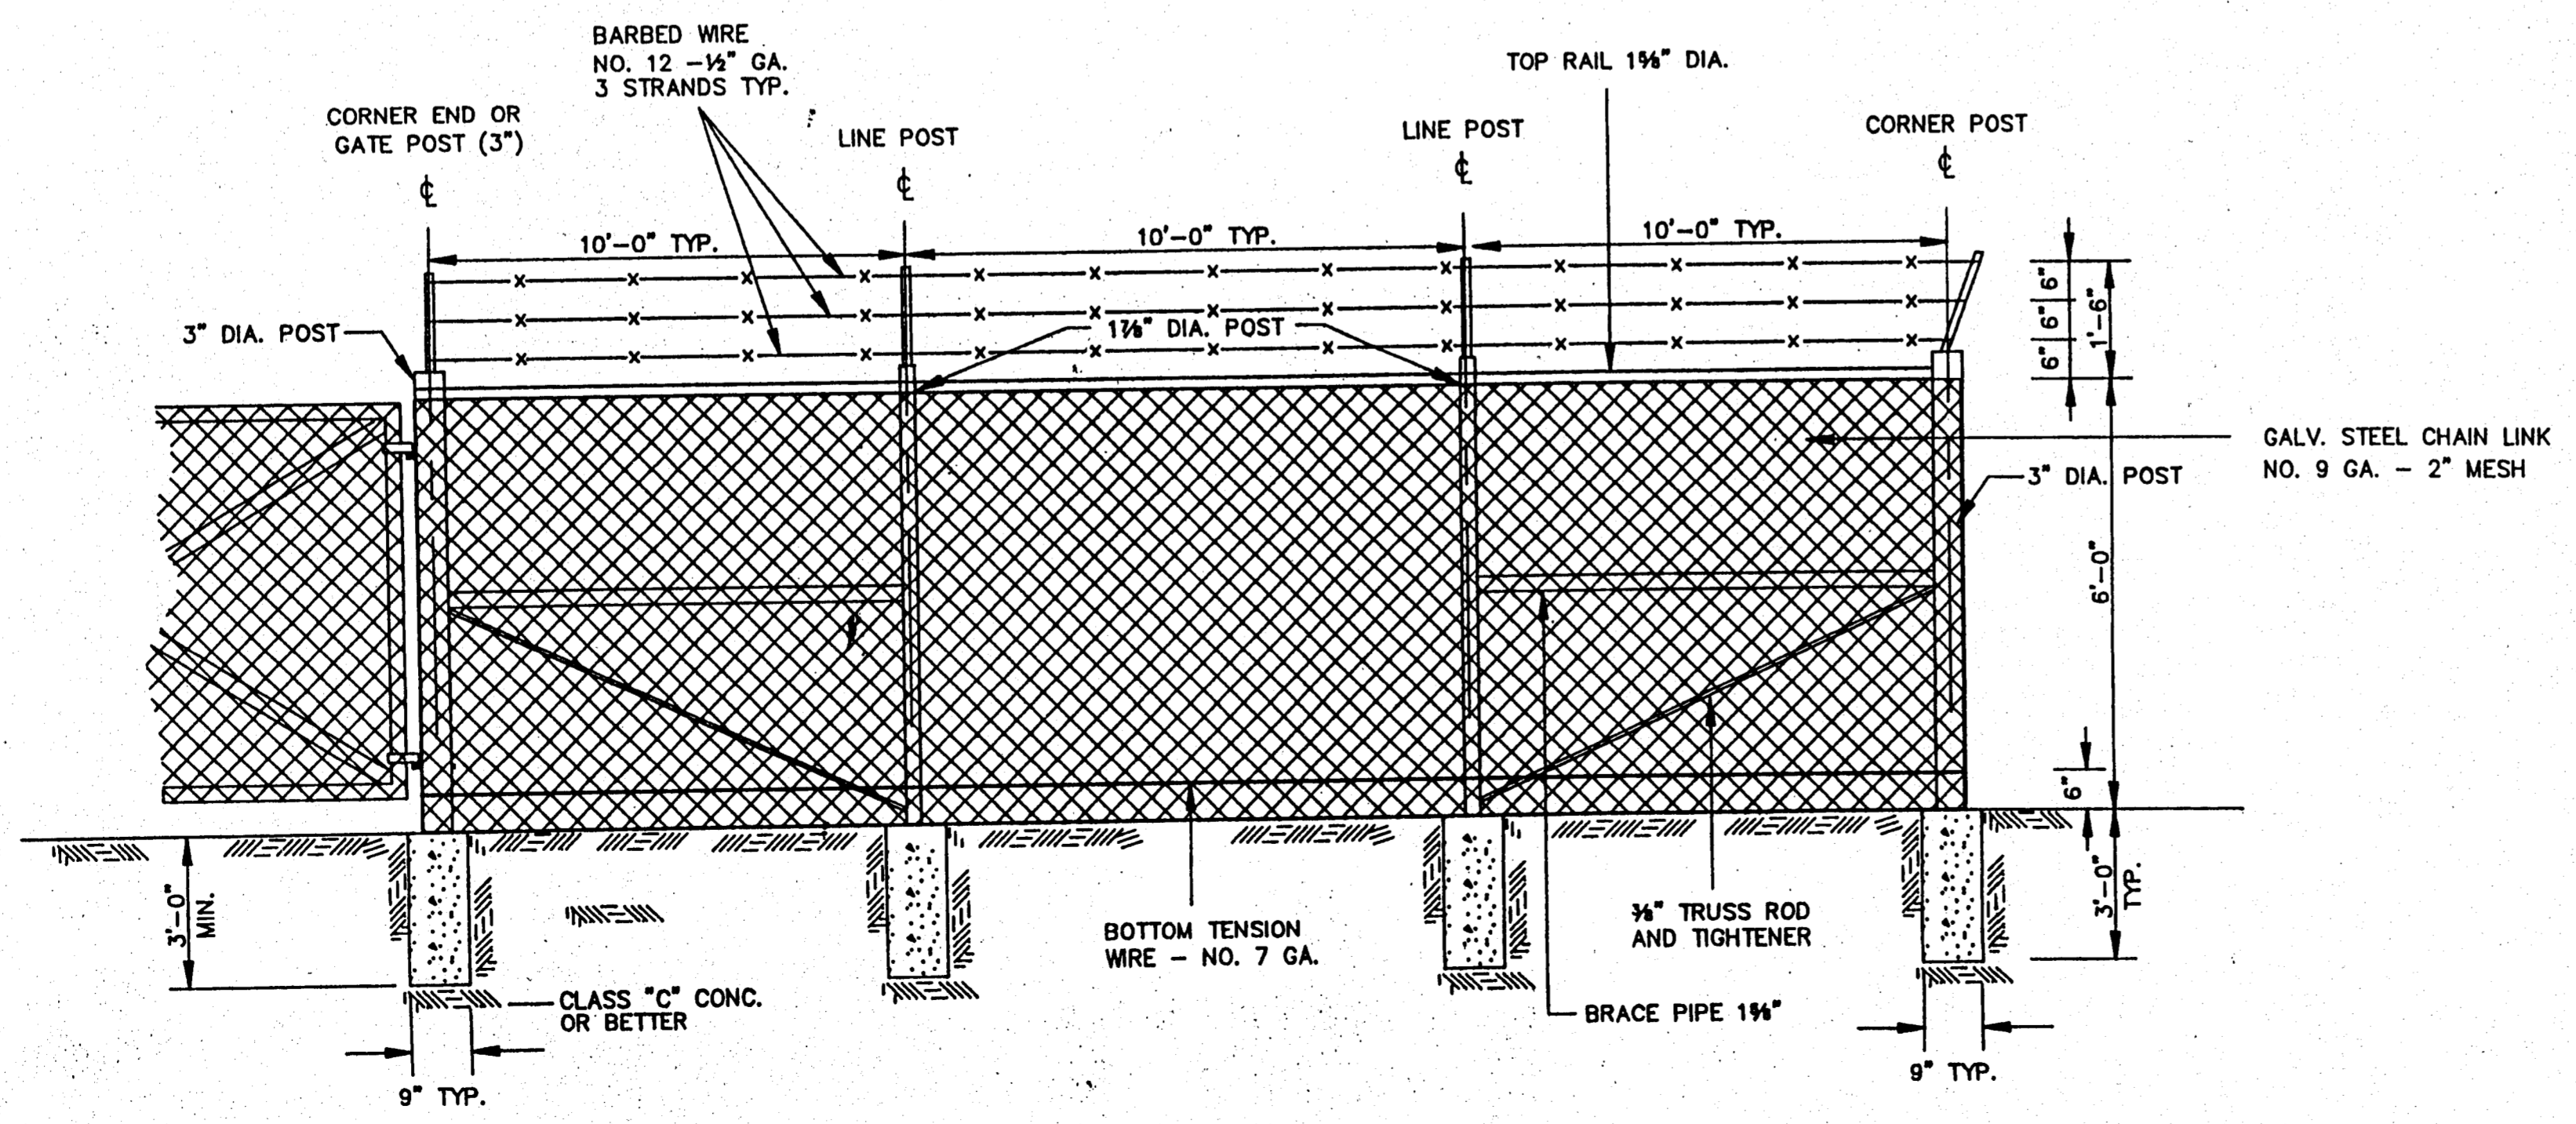

CHAIN LINK FENCE DETAIL
 N.T.S.


CITY OF RIDGELAND, MS.
STANDARD DETAILS

DSGN:			DRAWING NO.
DRWN:			OF
CHKD:			
SCALE:			

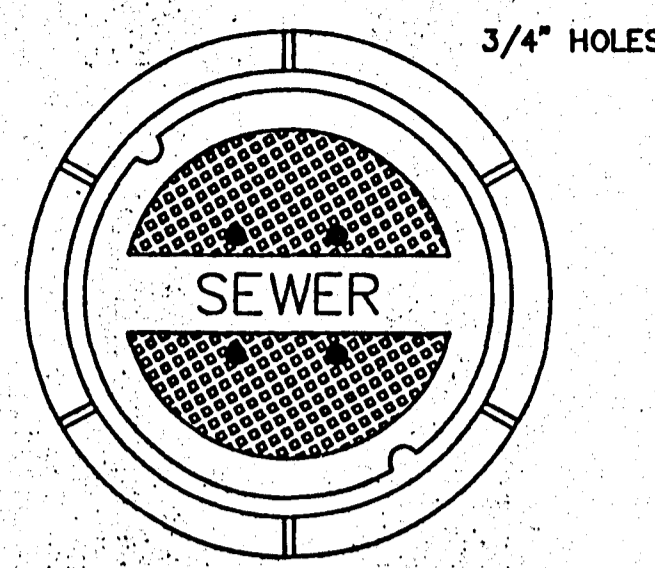


TOP PLAN OF COVER

FRAME & COVER WEIGHT 420 LBS.

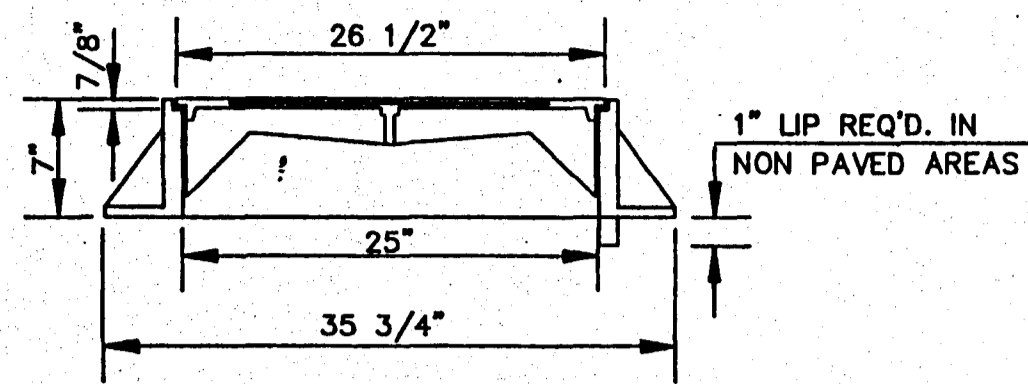

SECTION

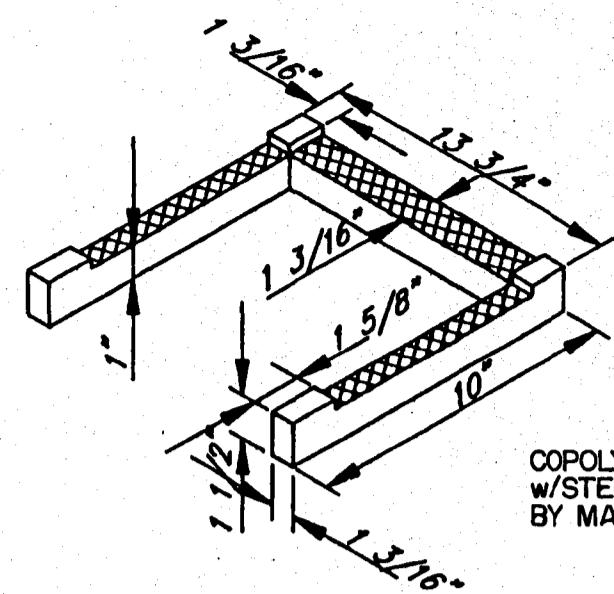


DETAIL 'B'

COPOLYMER-POLYPROPYLENE PLASTIC W/STEEL REINFORCED MANUFACTURED BY MA INDUSTRIES OR APPROVED EQUAL


STANDARD MANHOLE FRAME AND COVER

N.T.S.

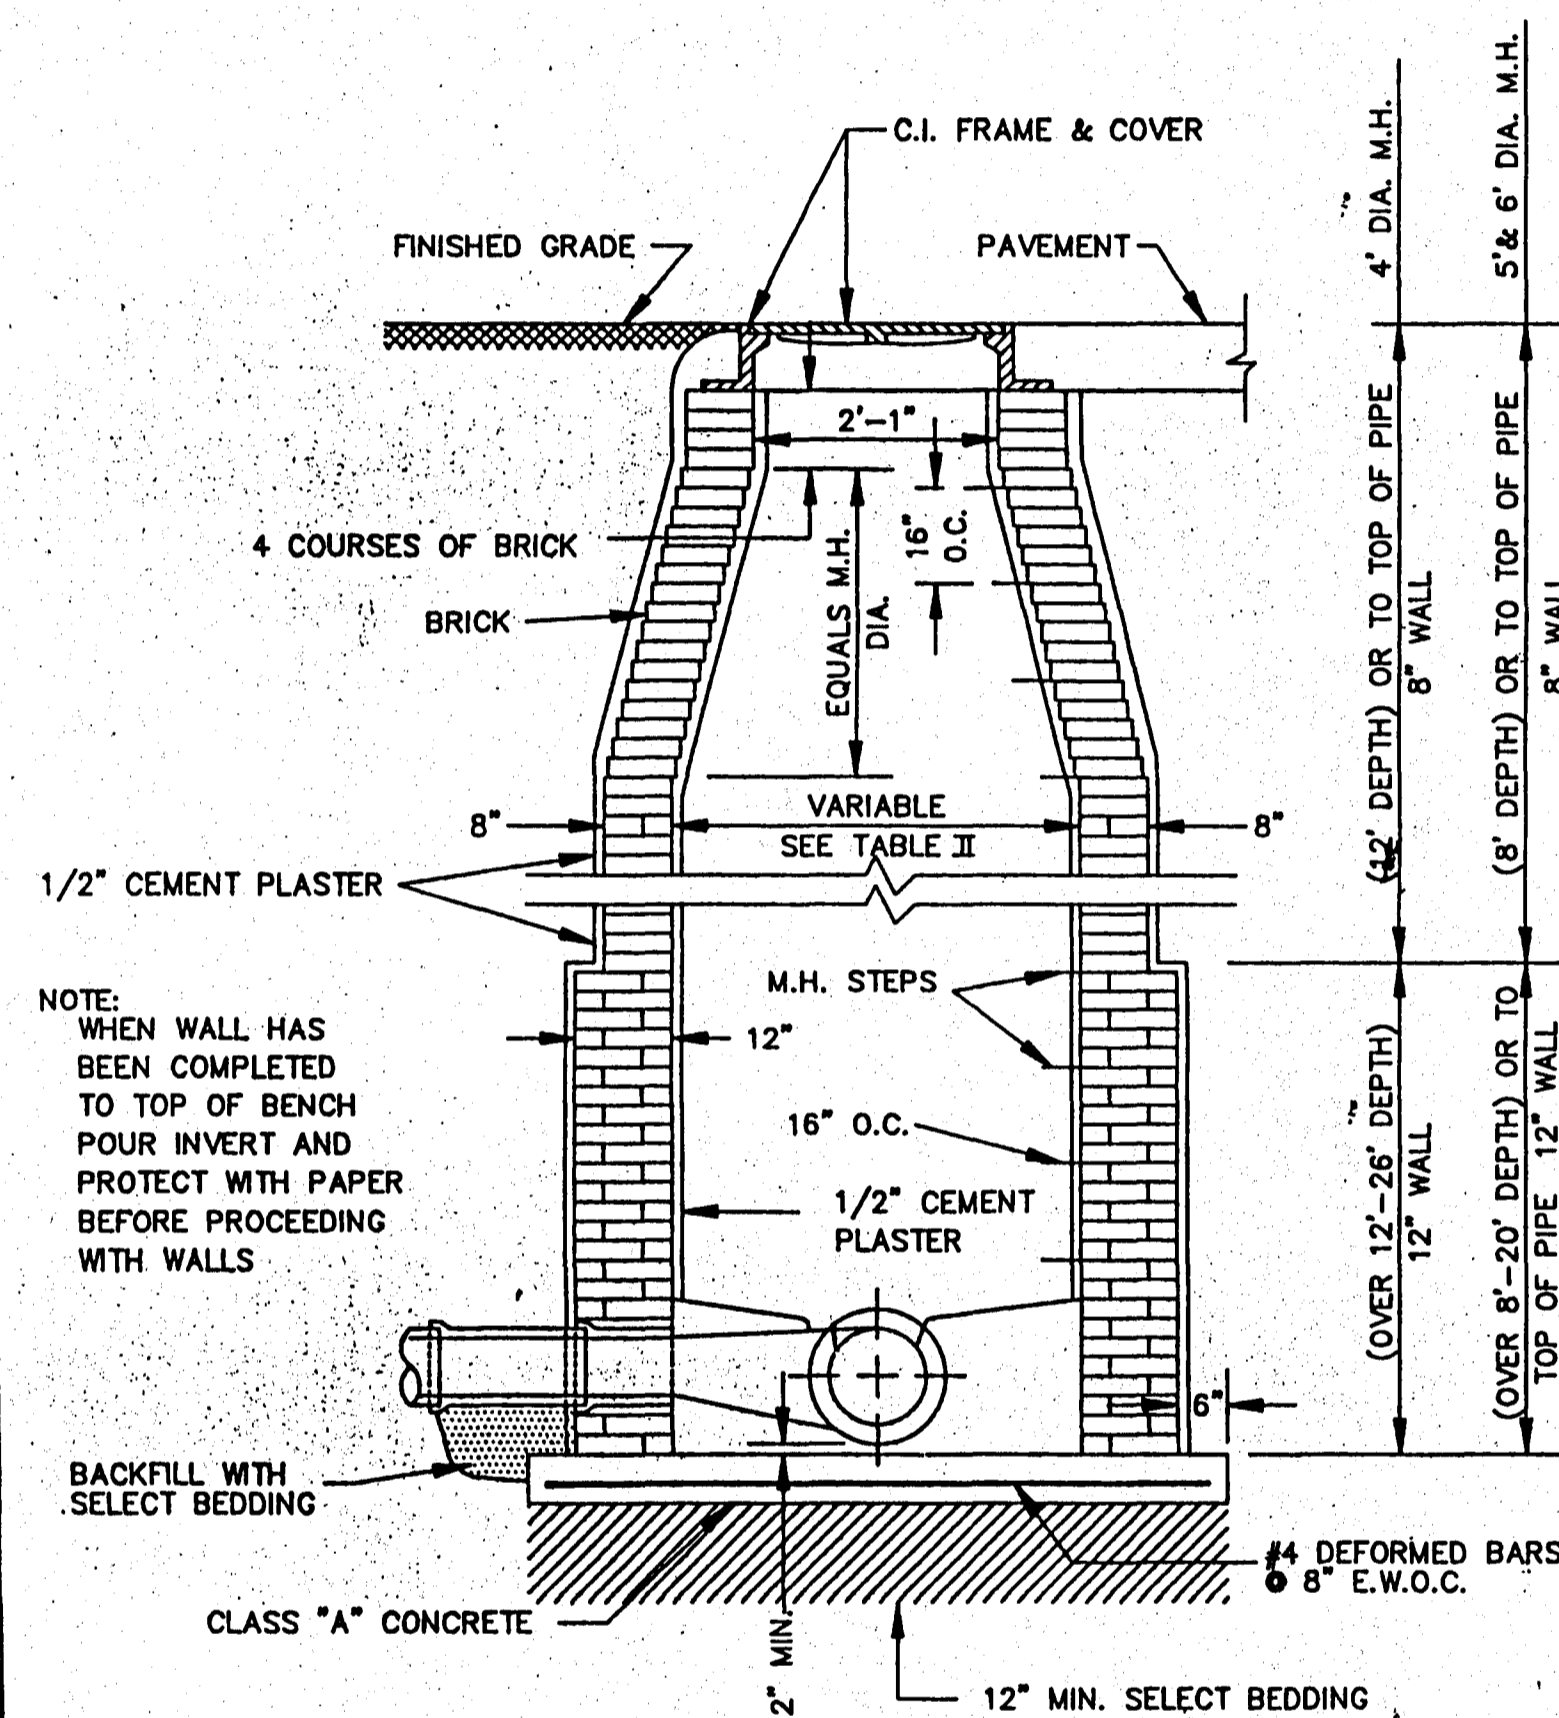


STANDARD BRICK MANHOLE

N.T.S.

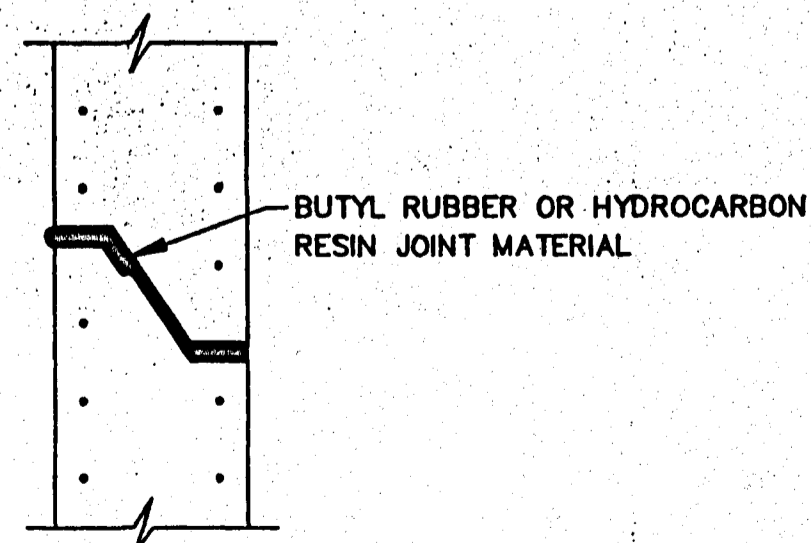


TYPICAL PRECAST CONCRETE MANHOLE JOINT DETAIL

N.T.S.

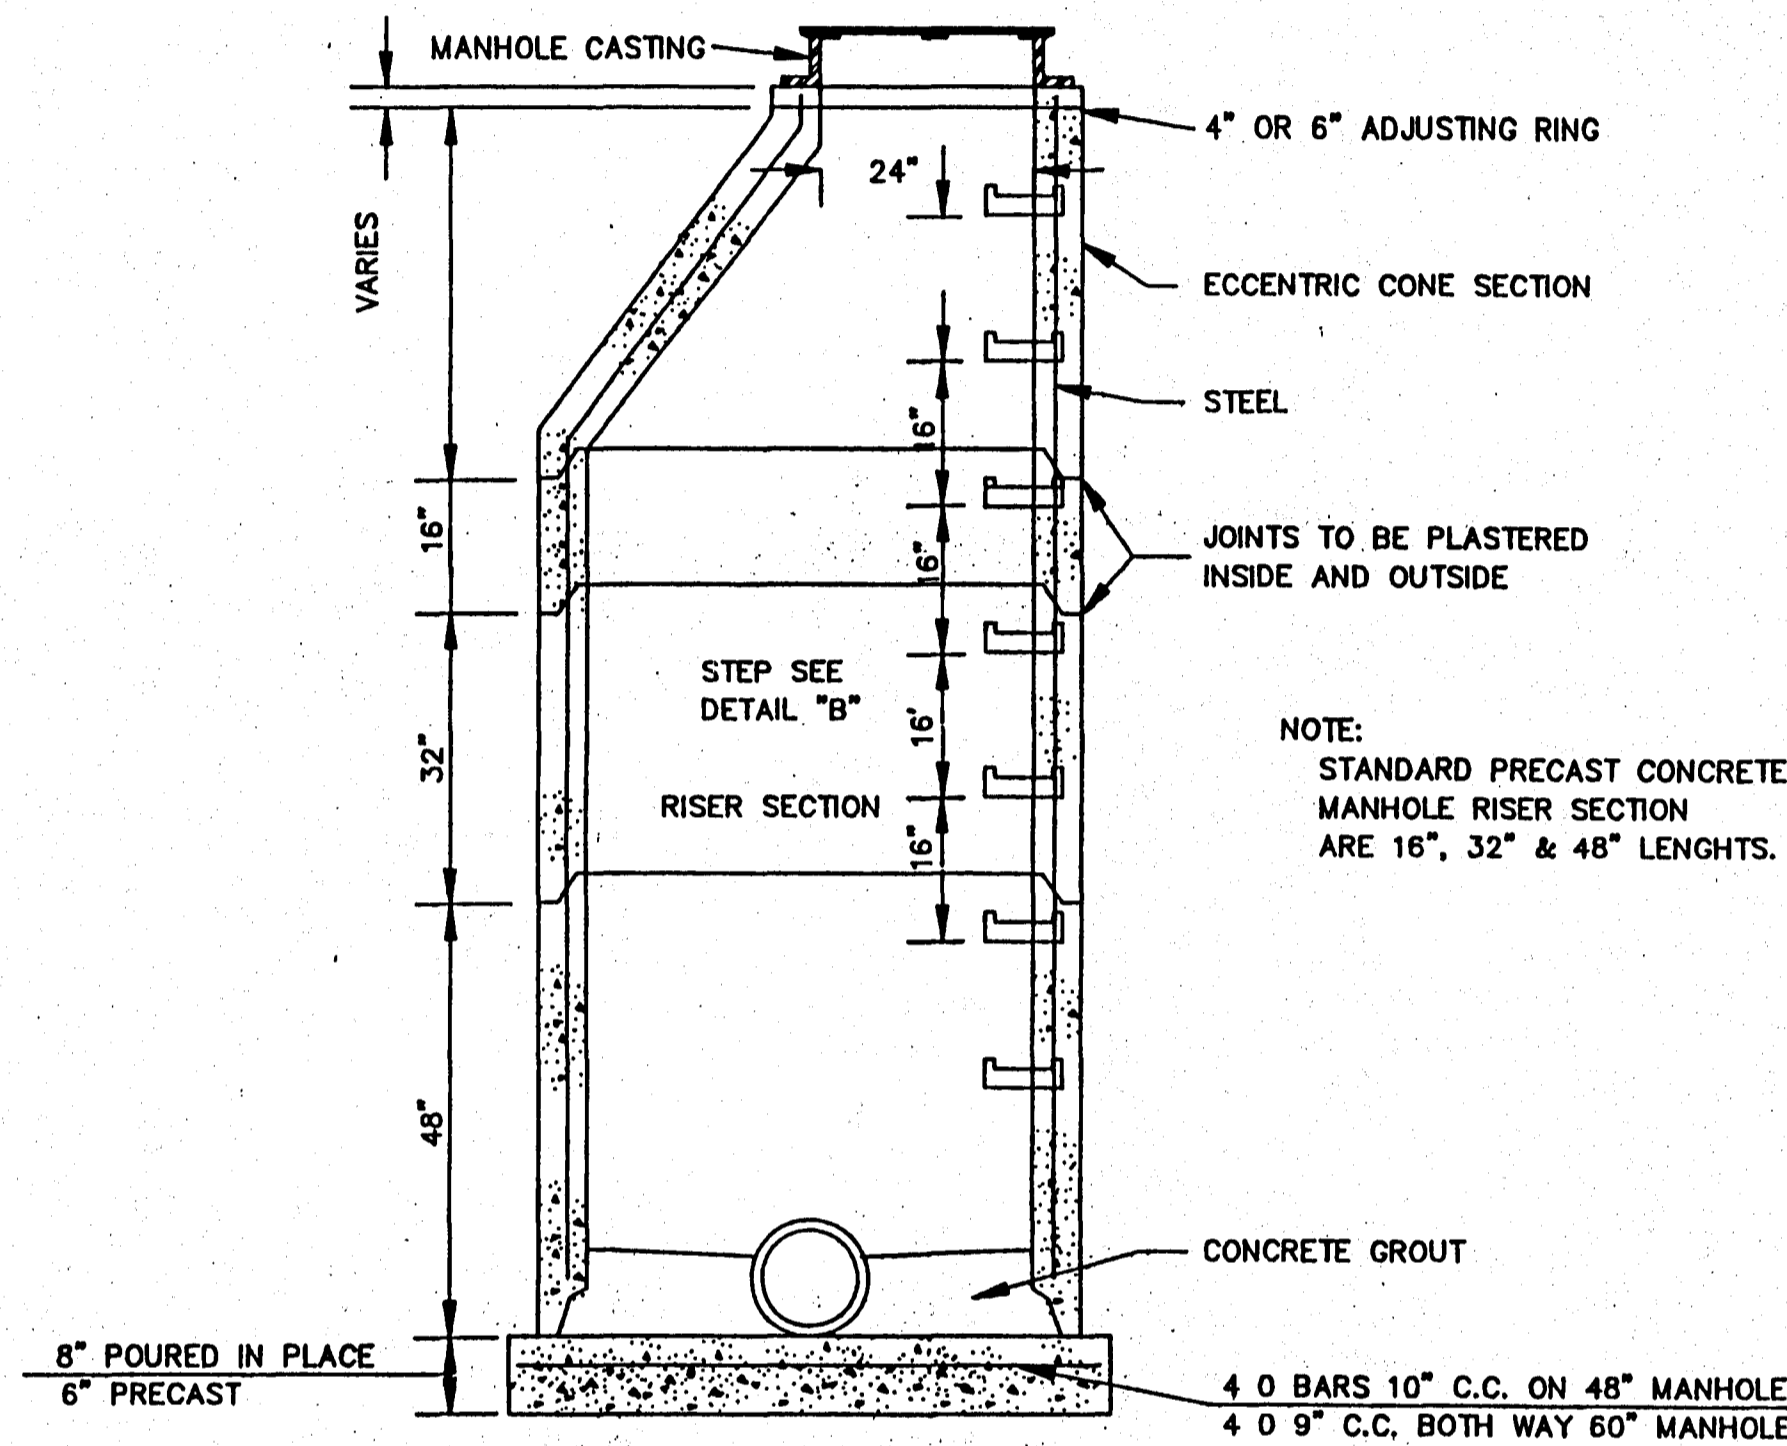


SECTION OF PRECAST CONCRETE MANHOLE

N.T.S.

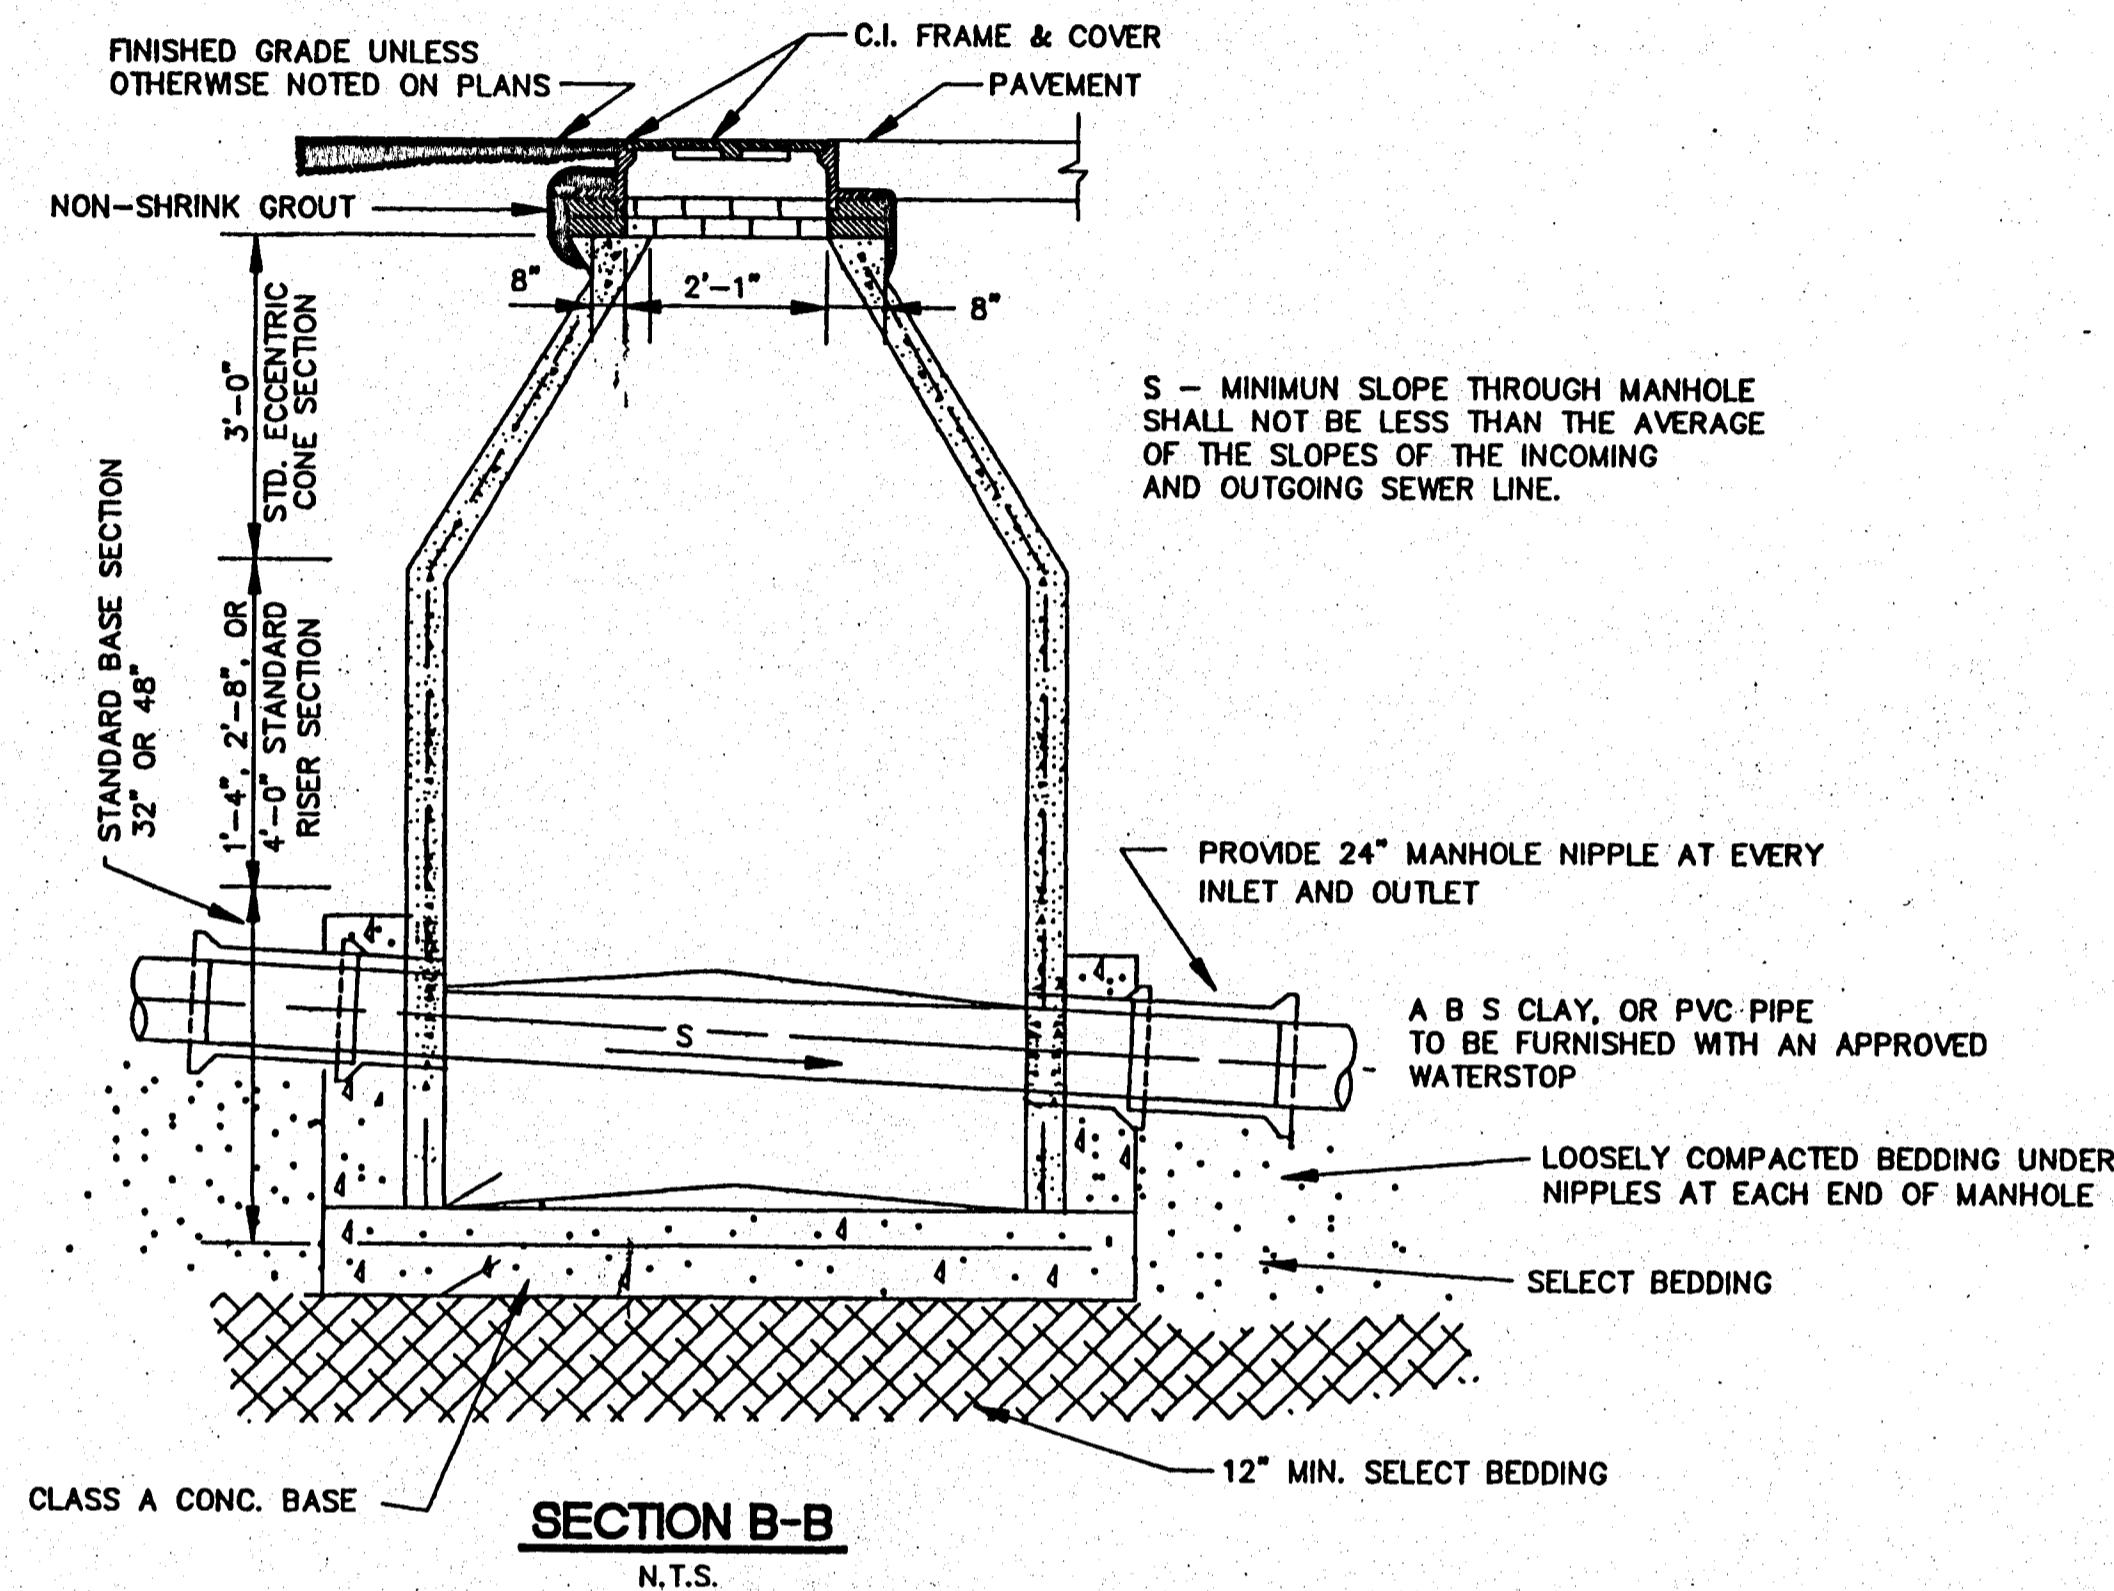

SECTION B-B


N.T.S.

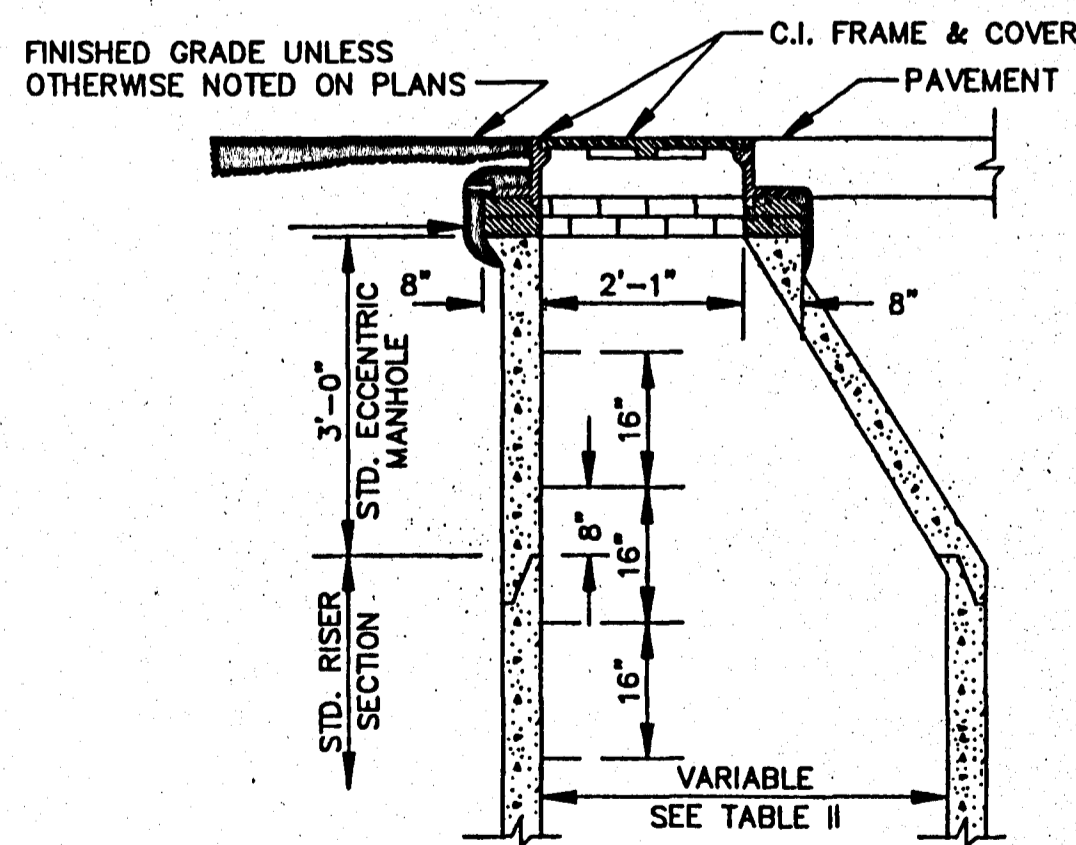

STANDARD ECCENTRIC CONE FOR ALL DIAMETER MANHOLES


N.T.S.

NOTE: DETAILS FOR RISER & BASE SECTIONS ARE SAME AS SHOWN IN SECTIONS A-A B-B.

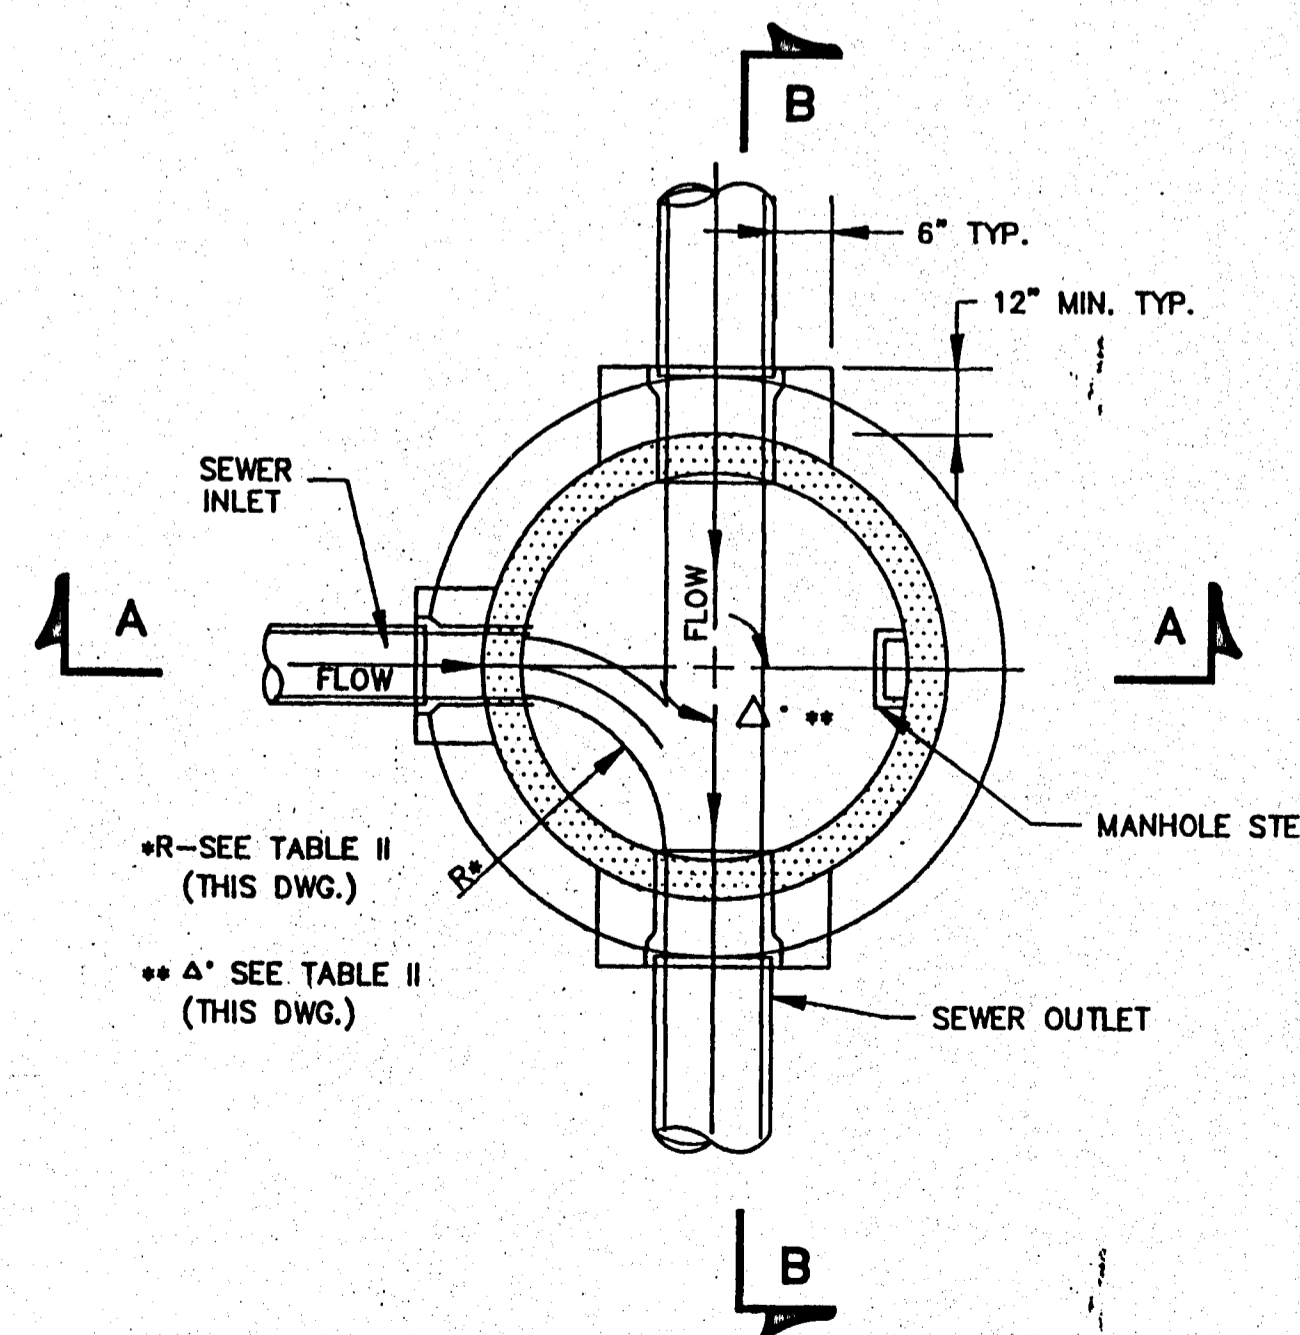

SECTIONAL PLAN STANDARD MANHOLE

N.T.S.

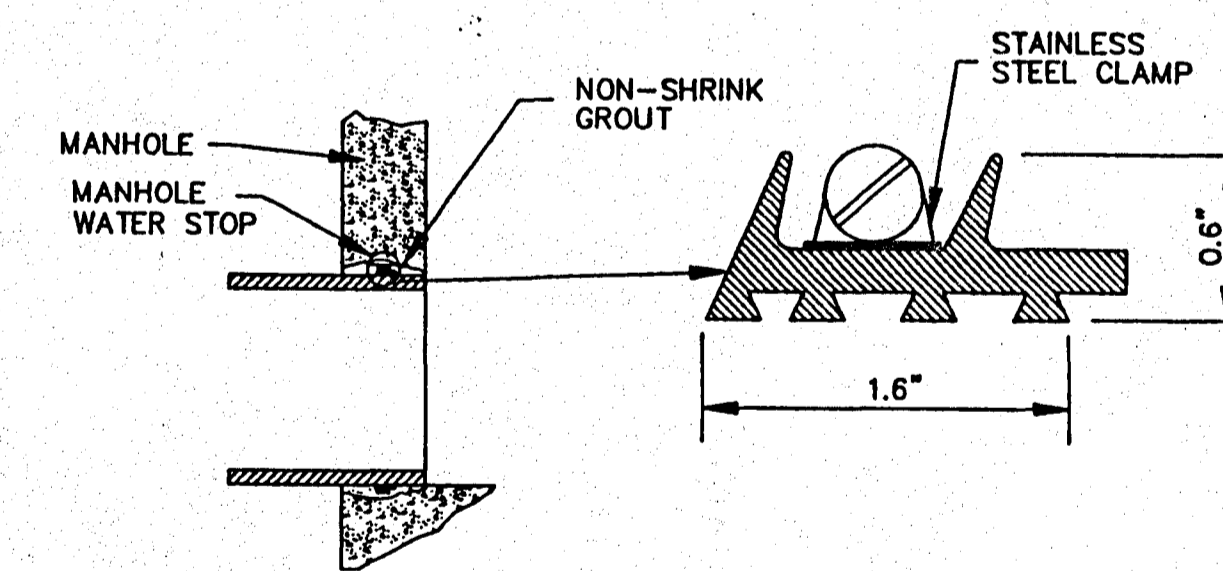

TYPICAL MANHOLE WATER STOP FOR ABS, CLAY OR PVC PIPE

EXISTING AND "STRADDLE" MANHOLES N.T.S.

CITY OF RIDGELAND, MS.

STANDARD DETAILS

DSGN:		THE CITY OF RIDGELAND	DRAWING NO.
DRWN:			OF
CHKD:			
SCALE:			