


TYPICAL BOOSTER STATION / VALVE INSTALLATION

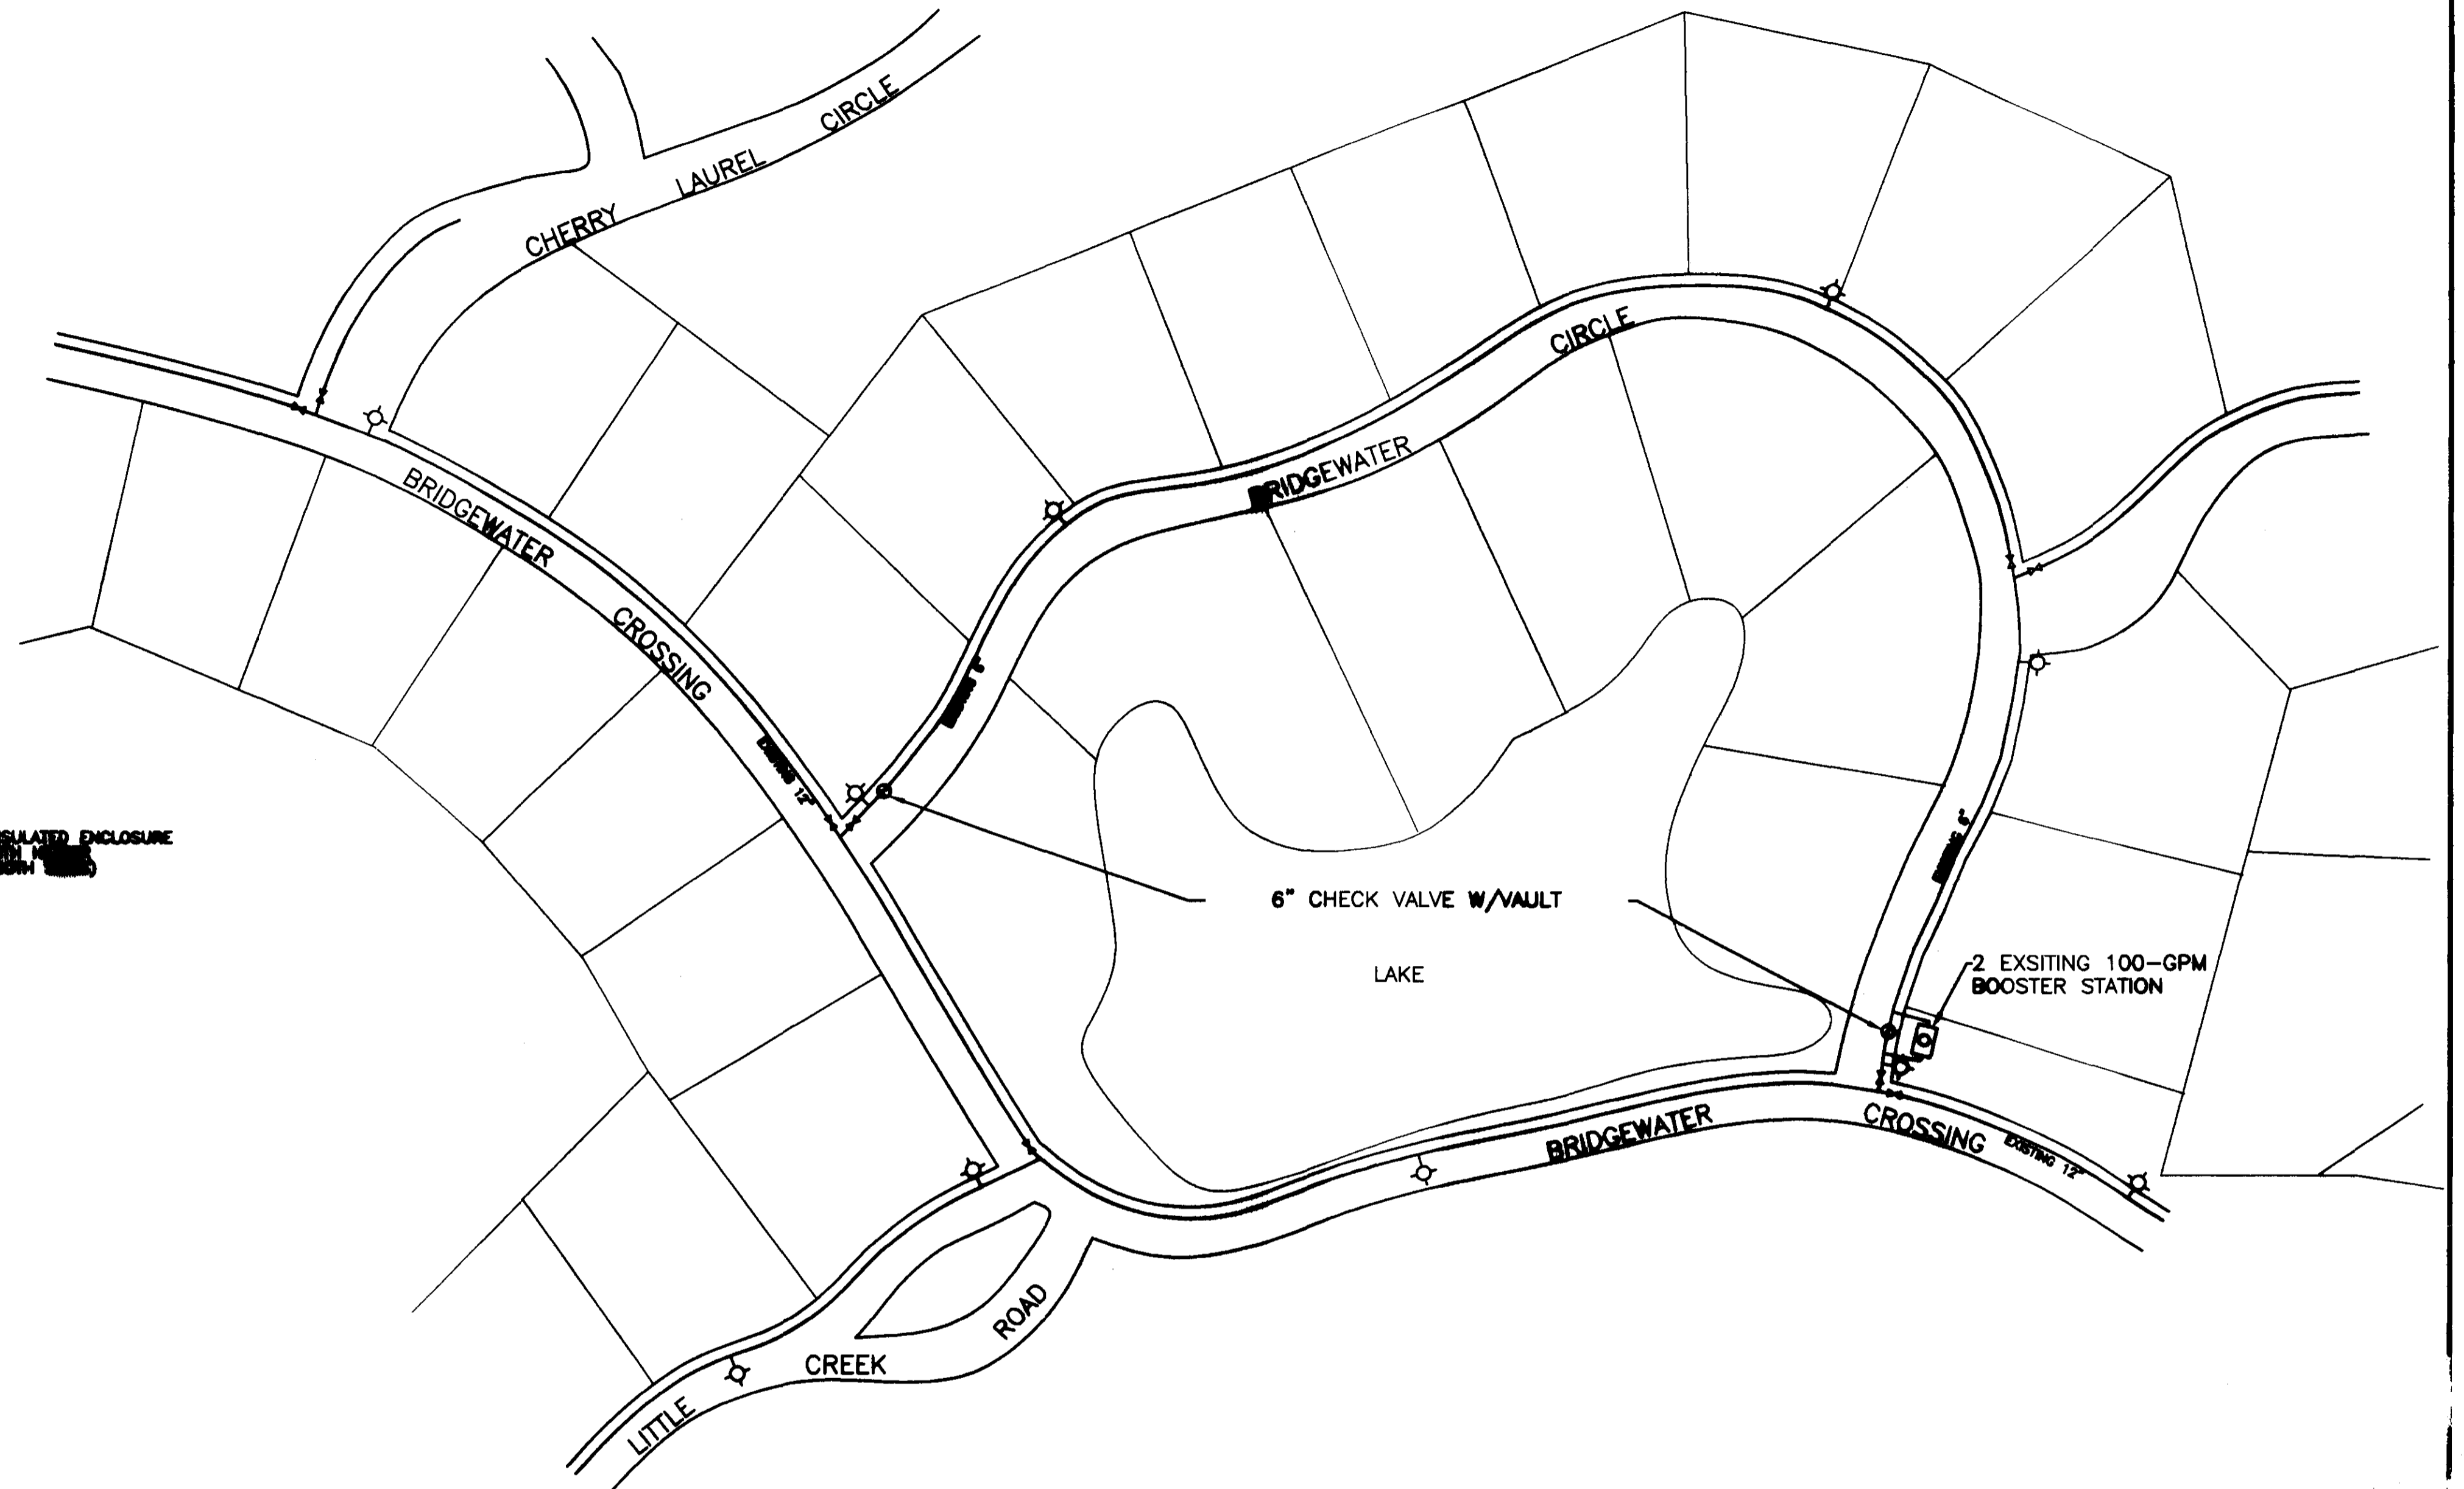

PLAN VIEW-OVERALL LAYOUT

RECORD DRAWING 3-13-00

PWP-00226

DCI **DIVERSIFIED CONSULTANTS, INC.**
 CONSULTING ENGINEERS ... CITY, COUNTY, AND REGIONAL PLANNERS
 395 EDGEWOOD TERRACE
 JACKSON, MS 39206

This document, and the ideas and designs incorporated herein, as an instrument of professional services, is the property of DIVERSIFIED CONSULTANTS, INC. and is not to be used, in whole or part, for any other project without the written authority of DIVERSIFIED CONSULTANTS, INC.

100-GPM BOOSTER PUMPING STATION
BRIDGEWATER SUBDIVISION - RIDGELAND, MISSISSIPPI

NO.	DATE	BY
1	03-02-99	A.A.J.
2		
3		
4		
5		
6		

DATE: N.T.S.
 DATE: 01/25/99
 APPROVED BY: M.J.A.
 DESIGNED BY: A.U.J.
 CHECKED BY: M.J.A.
 TRACED BY:

SHEET TITLE
PLAN/DETAIL
 FILE NAME: BRIDGWTR.DWG
 SHEET NO. **2**