


Estimated Sewer Line Location
Estimated Water Line Location

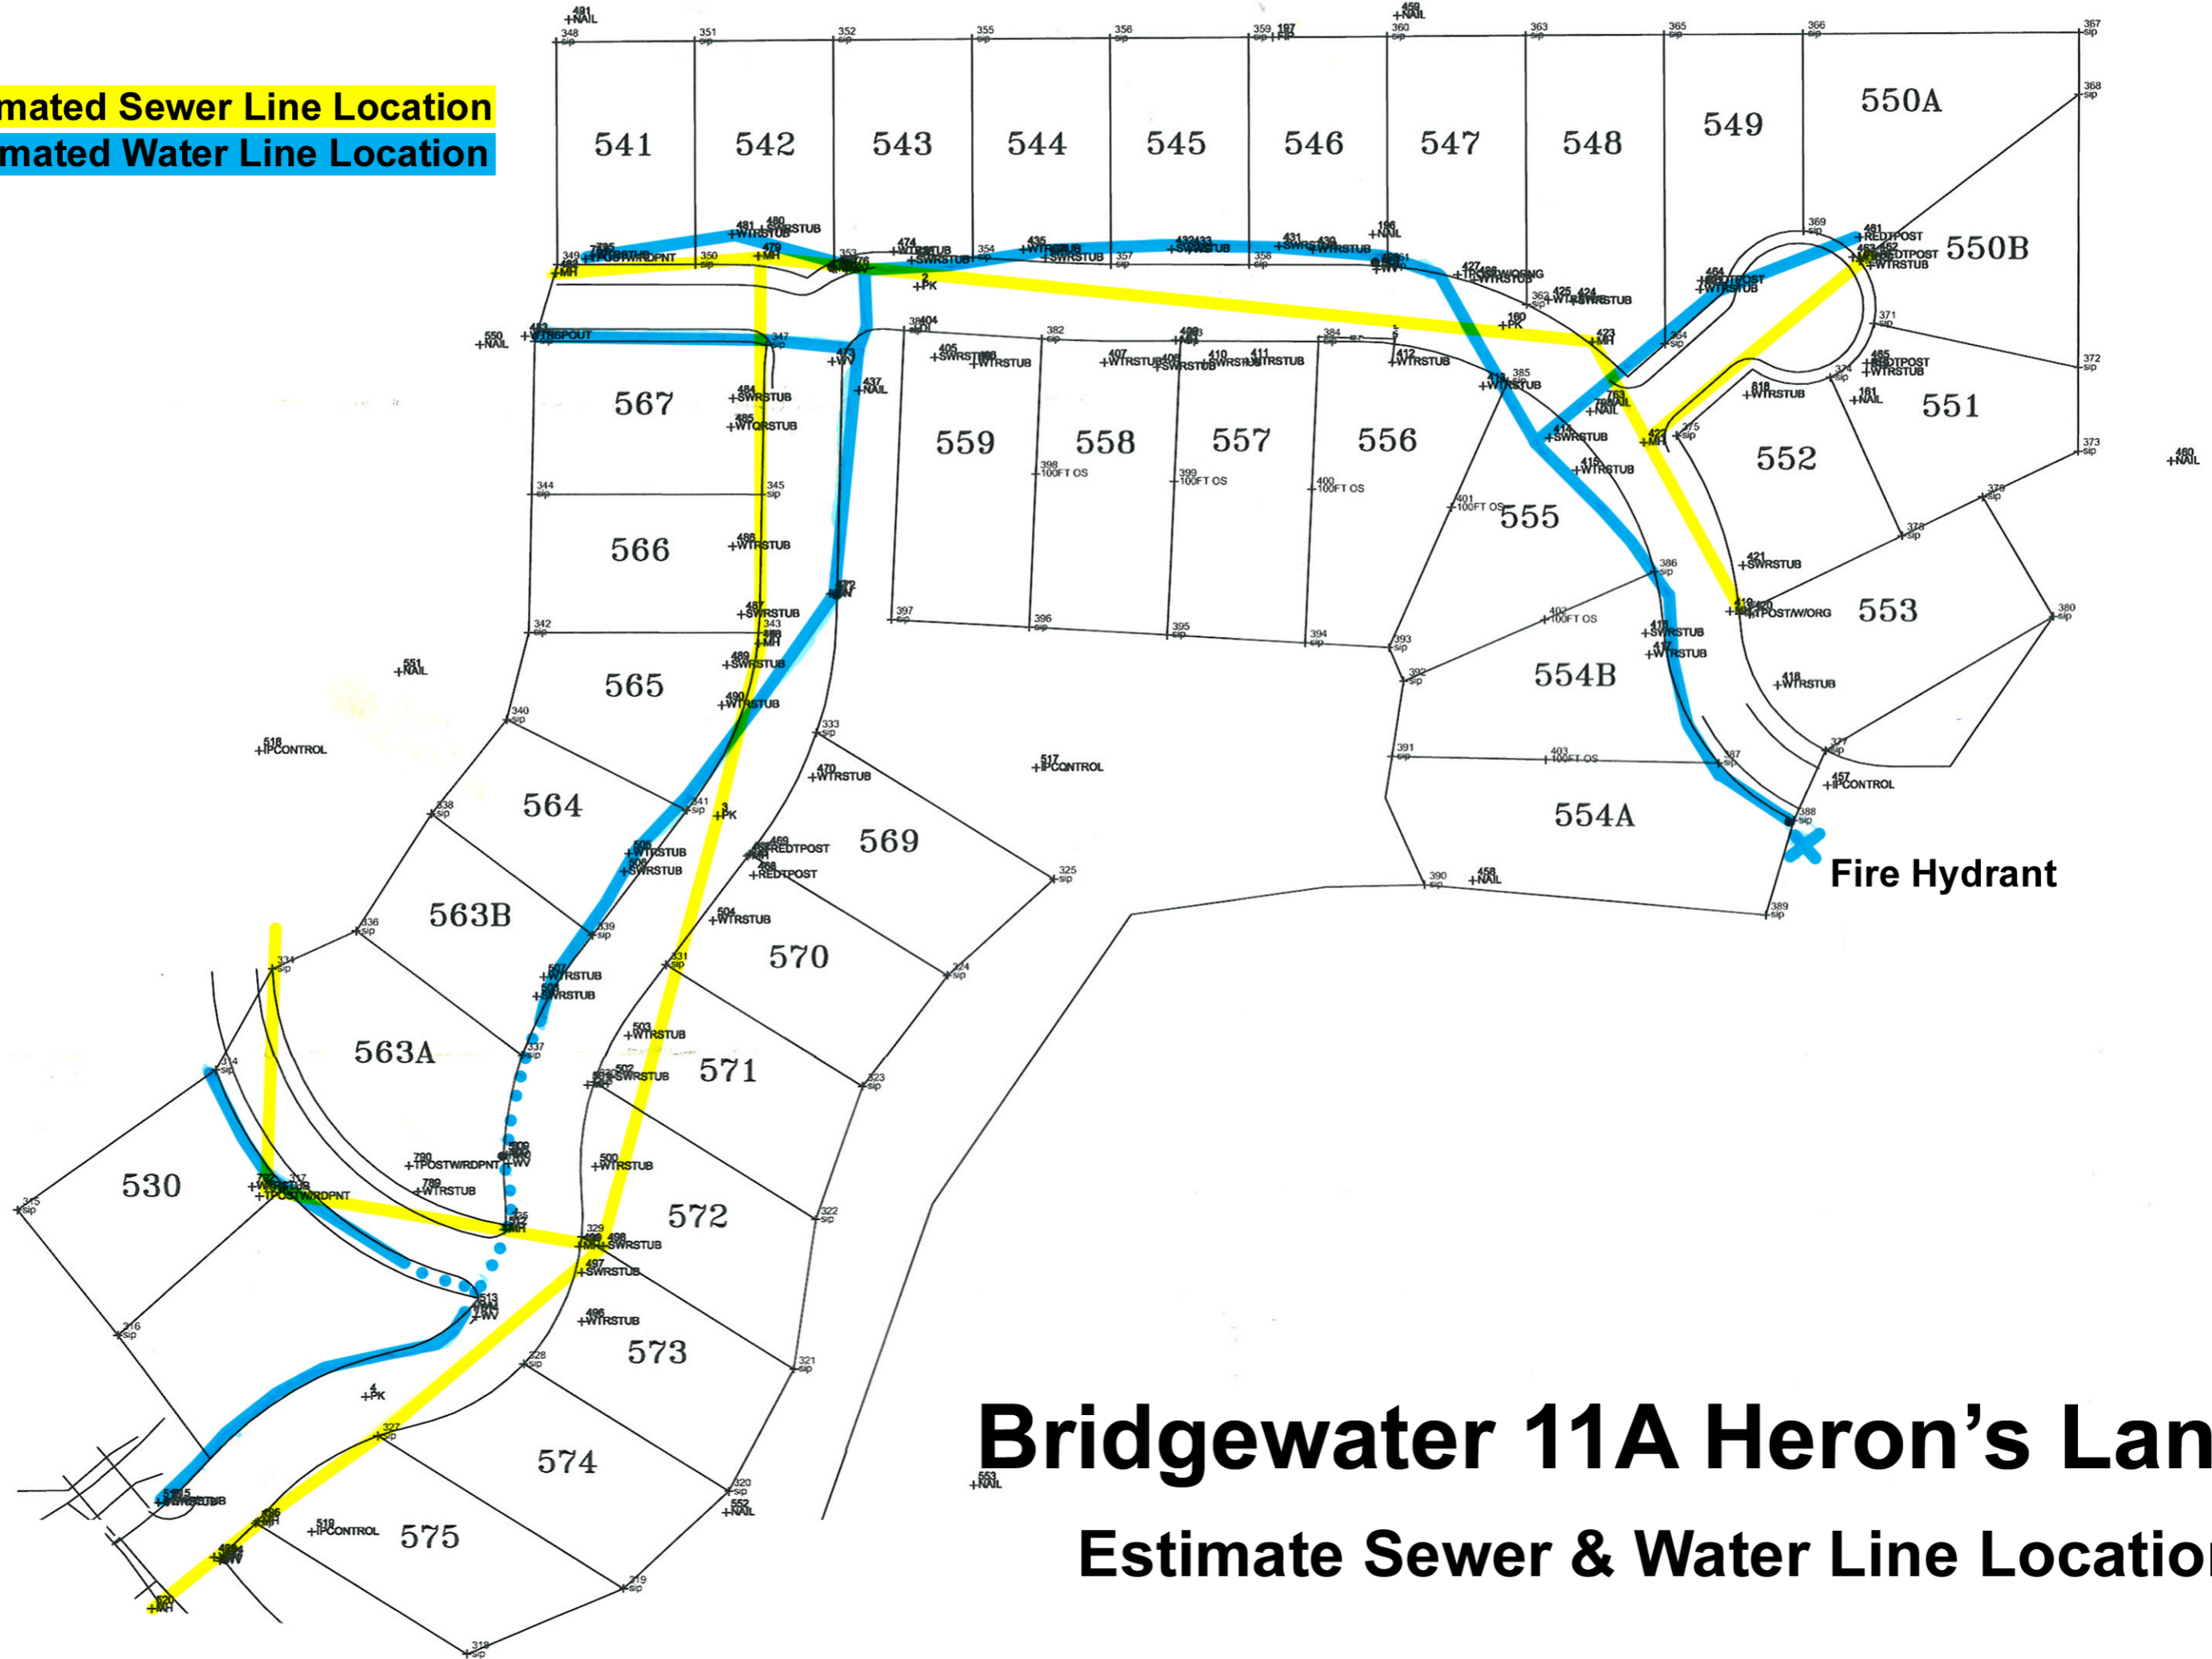

Bridgewater 11A Heron's Landing
Estimate Sewer & Water Line Locations