


- NOTES:**
1. WATER SERVICES SHALL BE 3/4" SERVICE TUBING (CL. 200) WITH TRACER WIRE.
  2. SEWER SERVICES SHALL BE 6" P.V.C. (SDR 26).
  3. ALL WATER MAINS UNDER STREET SHALL BE ENCASED WITH STEEL CASING.
  4. WATER AND SEWER SERVICES SHALL HAVE A MINIMUM SEPARATION OF 10'.
  5. VALVES SHALL BE INSTALLED WITH ANCHOR COUPLINGS. NO MEG-LUG RESTRAINTS WILL BE ALLOWED FOR VALVE INSTALLATION.

| LOT NO.         | SEWER SERVICE |            | WATER SERVICE |            | GATE VALVE |            |
|-----------------|---------------|------------|---------------|------------|------------|------------|
|                 | NORTHING      | EASTING    | NORTHING      | EASTING    | NORTHING   | EASTING    |
| 1               | 1069807.21    | 2337842.58 | 1069972.25    | 2337738.22 |            |            |
| 2               | 1069987.27    | 2337635.84 | 1069994.66    | 2337712.94 | 1069996.92 | 2337714.43 |
| 3               | 1069981.19    | 2337625.36 | 1069911.45    | 2337603.25 |            |            |
| 4               | 1069804.37    | 2337703.80 | 1069880.25    | 2337624.71 |            |            |
| 5               | 1069699.97    | 2337828.53 | 1069789.61    | 2337727.28 |            |            |
| 6               | 1069330.31    | 2337944.13 | 1069277.66    | 2337754.07 |            |            |
| 7               | 1069263.81    | 2337735.90 | 1069242.50    | 2337688.14 |            |            |
| 8               | 1069169.94    | 2337689.91 | 1069225.17    | 2337683.21 | 1069222.58 | 2337682.07 |
| 9               | 1069161.23    | 2337694.67 | 1069151.78    | 2337765.12 |            |            |
| 10              | 1069229.25    | 2337984.83 | 1069138.97    | 2337791.87 |            |            |
| 11              | 1068899.50    | 2338160.33 | 1068778.13    | 2337997.13 |            |            |
| 12              | 1068762.73    | 2337977.20 | 1068708.05    | 2337846.58 |            |            |
| 13              | 1068622.24    | 2337840.60 | 1068661.35    | 2337827.27 | 1068673.76 | 2337831.09 |
| 14              | 1068610.45    | 2337855.34 | 1068610.74    | 2337916.07 |            |            |
| 15              | 1068719.41    | 2338054.29 | 1068619.06    | 2337931.51 |            |            |
| 16              | 1068806.76    | 2338207.90 | 1068740.29    | 2338083.06 |            |            |
| 17              | 1068584.46    | 2338509.67 | 1068437.33    | 2338420.90 |            |            |
| 18              | 1068409.98    | 2338406.85 | 1068314.30    | 2338303.33 |            |            |
| 19              | 1068238.10    | 2338323.39 | 1068275.52    | 2338298.54 | 1068274.15 | 2338306.18 |
| 20              | 1068235.39    | 2338347.81 | 1068246.60    | 2338417.63 |            |            |
| 21              | 1068414.93    | 2338491.86 | 1068266.95    | 2338426.27 |            |            |
| 22              | 1068556.46    | 2338590.50 | 1068426.10    | 2338508.08 |            |            |
| 23              | 1068617.24    | 2339043.63 | 1068404.98    | 2339013.69 |            |            |
| 24              | 1068340.32    | 2339005.61 | 1068384.55    | 2339003.40 |            |            |
| 25              | 1068292.59    | 2339071.86 | 1068304.36    | 2339025.41 | 1068315.45 | 2339017.00 |
| 26              | 1068293.20    | 2339083.45 | 1068388.50    | 2339122.71 |            |            |
| 27              | 1068439.85    | 2339128.36 | 1068581.03    | 2339137.23 |            |            |
| 28              | 1068653.57    | 2339141.02 | 1068607.23    | 2339133.20 |            |            |
| 29              | 1068855.73    | 2339156.90 | 1068718.47    | 2339055.77 |            |            |
| 30              | 1068676.98    | 2338814.61 | 1068713.55    | 2339025.29 |            |            |
| 31              | 1068669.33    | 2338781.96 | 1068656.86    | 2338566.66 | 1068712.77 | 2339042.90 |
| 32              | 1068787.76    | 2338354.27 | 1068666.19    | 2338537.47 |            |            |
| 33              | 1068818.07    | 2338322.09 | 1068976.19    | 2338216.37 | 1068663.61 | 2338546.25 |
| 34              | 1069005.58    | 2338203.36 | 1068990.31    | 2338206.96 |            |            |
| 35              | 1069370.86    | 2338030.84 | 1069382.36    | 2338024.68 | 1068929.04 | 2338243.60 |
| 36              | 1069646.44    | 2337919.66 | 1069401.39    | 2338013.66 |            |            |
| 37              | 1069703.78    | 2337924.04 | 1069711.61    | 2337923.66 | 1069679.64 | 2337916.27 |
| Hidden Oaks Dr. |               |            |               |            | 1069773.46 | 2337927.82 |
|                 |               |            |               |            | 1070009.65 | 2338090.09 |

| Revisions |          |                      |     | Project No. | Designed By |
|-----------|----------|----------------------|-----|-------------|-------------|
| #         | Date     | Nature               | By  | M-2227      | R.C.M.      |
| 1         | 11-18-14 | RESPONSE TO COMMENTS | RCM |             |             |
| 2         | 3-16-15  | RESPONSE TO COMMENTS | RCM |             |             |
| 3         | 11-4-15  | AS-BUILT DRAWINGS    | SJS |             |             |
|           |          |                      |     | Date        | Drawn By    |
|           |          |                      |     | 3/2/15      | D.P.        |
|           |          |                      |     | Scale       | Checked By  |
|           |          |                      |     | SEE ABOVE   | R.C.M.      |

# BRIDGEWATER 11 ADDITION

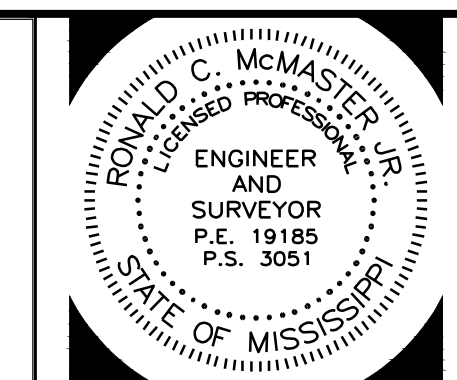

WATER AND SEWER LAYOUT