


Revisions				
#	Date	Nature	By	Appt.

Project No.	M-2350	Designed By	R.C.M.
Date	10-26-16	Drawn By	D.P.
Scale	SEE ABOVE	Checked By	R.C.M.

# BRIDGEWATER 11D

**McMASTER & ASSOCIATES, INC.**  
CIVIL ENGINEERS & LAND SURVEYORS

212 WATERFORD SQUARE  
SUITE 300  
MADISON, MS 39110  
601.605.1090

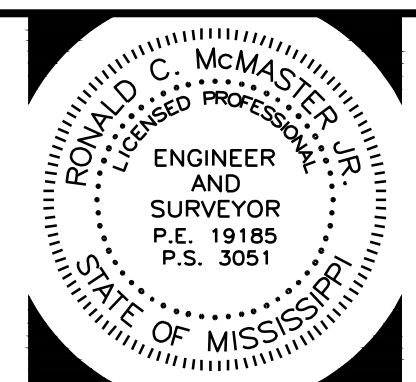

AS-BUILT DRAWING

## 7-R