


CONSTRUCTION PLANS FOR BRIDGEWATER IV

CITY OF RIDGELAND
MADISON COUNTY, MISSISSIPPI

AS-BUILT⁷⁹ PLANS
1-29-99


A DEVELOPMENT BY GIDEON - CHOTARD DEVELOPERS

525 THOMASTOWN DRIVE RIDGELAND, MS 39157 601-853-2556

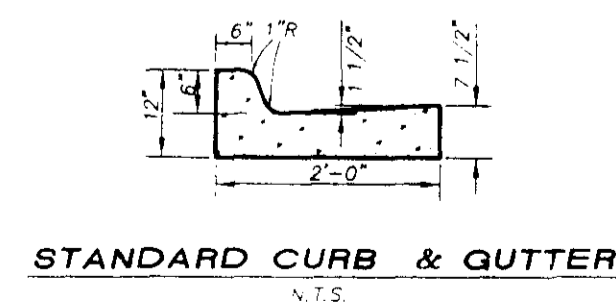


STANDARD CURB & GUTTER
N.T.S.

PREPARED
BY
ROBERT B. BARNES
CIVIL ENGINEER
&
LAND SURVEYOR
4 OLD RIVER PLACE
JACKSON, MISSISSIPPI 39202
TELEPHONE (601) 353-7878

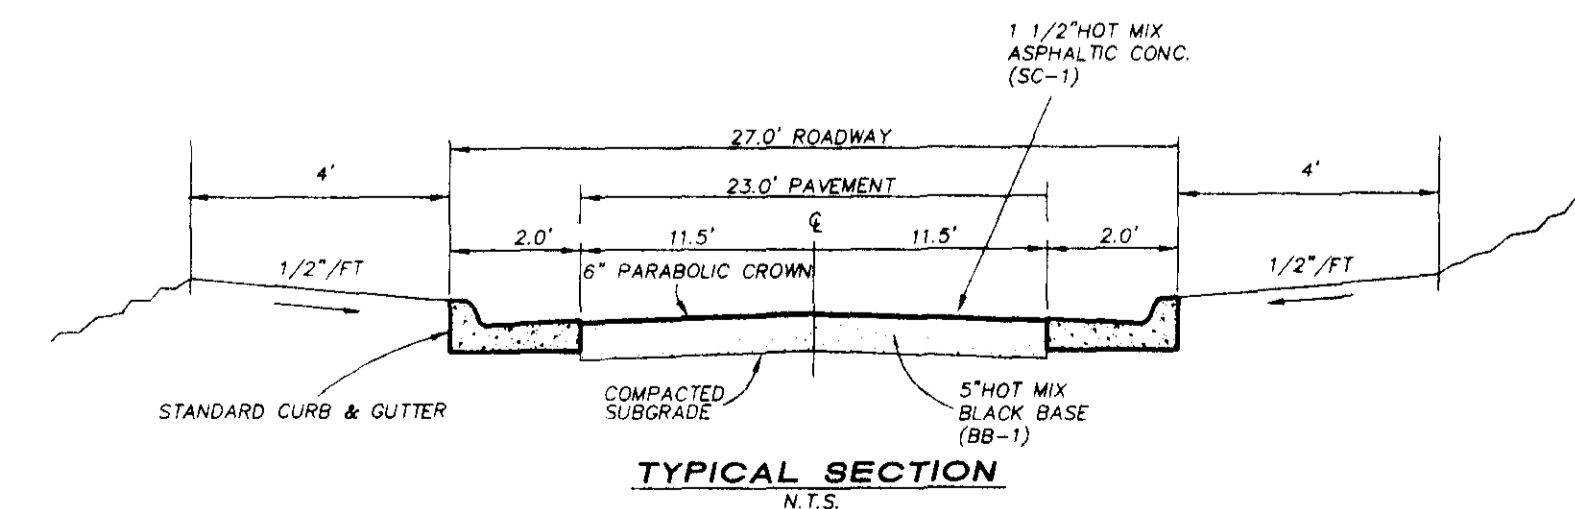

PWP-00222

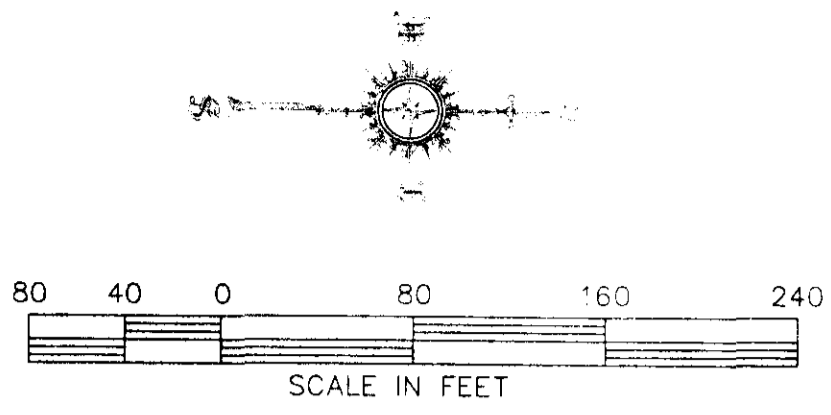

PRELIMINARY PLAT
BRIDGEWATER IV


DEVELOPER - GIDEON/CHOTARD DEVELOPERS, INC.
 DEVELOPERS' ADDRESS - 525 THOMASTOWN LANE - SUITE "D"
 RIDGELAND, MISSISSIPPI 39157
 DEVELOPERS' TELEPHONE - 601-853-2556

PRESENT ZONING - R2




THE PROPERTY SHOWN HEREON IS LOCATED
 IN ZONE "X" (OUTSIDE 500 YEAR FLOOD PLAIN)
 ACCORDING TO FLOOD INSURANCE RATE MAP
 COMMUNITY PANEL NUMBER 28089 C0320 D.
 DATED APRIL 15, 1994.



SURVEYED & MAPPED
 BY
ROBERT B. BARNES
 CIVIL ENGINEER
 &
 LAND SURVEYOR
 4 OLD RIVER PLACE
 JACKSON, MISSISSIPPI 39202
 JULY 1, 1998

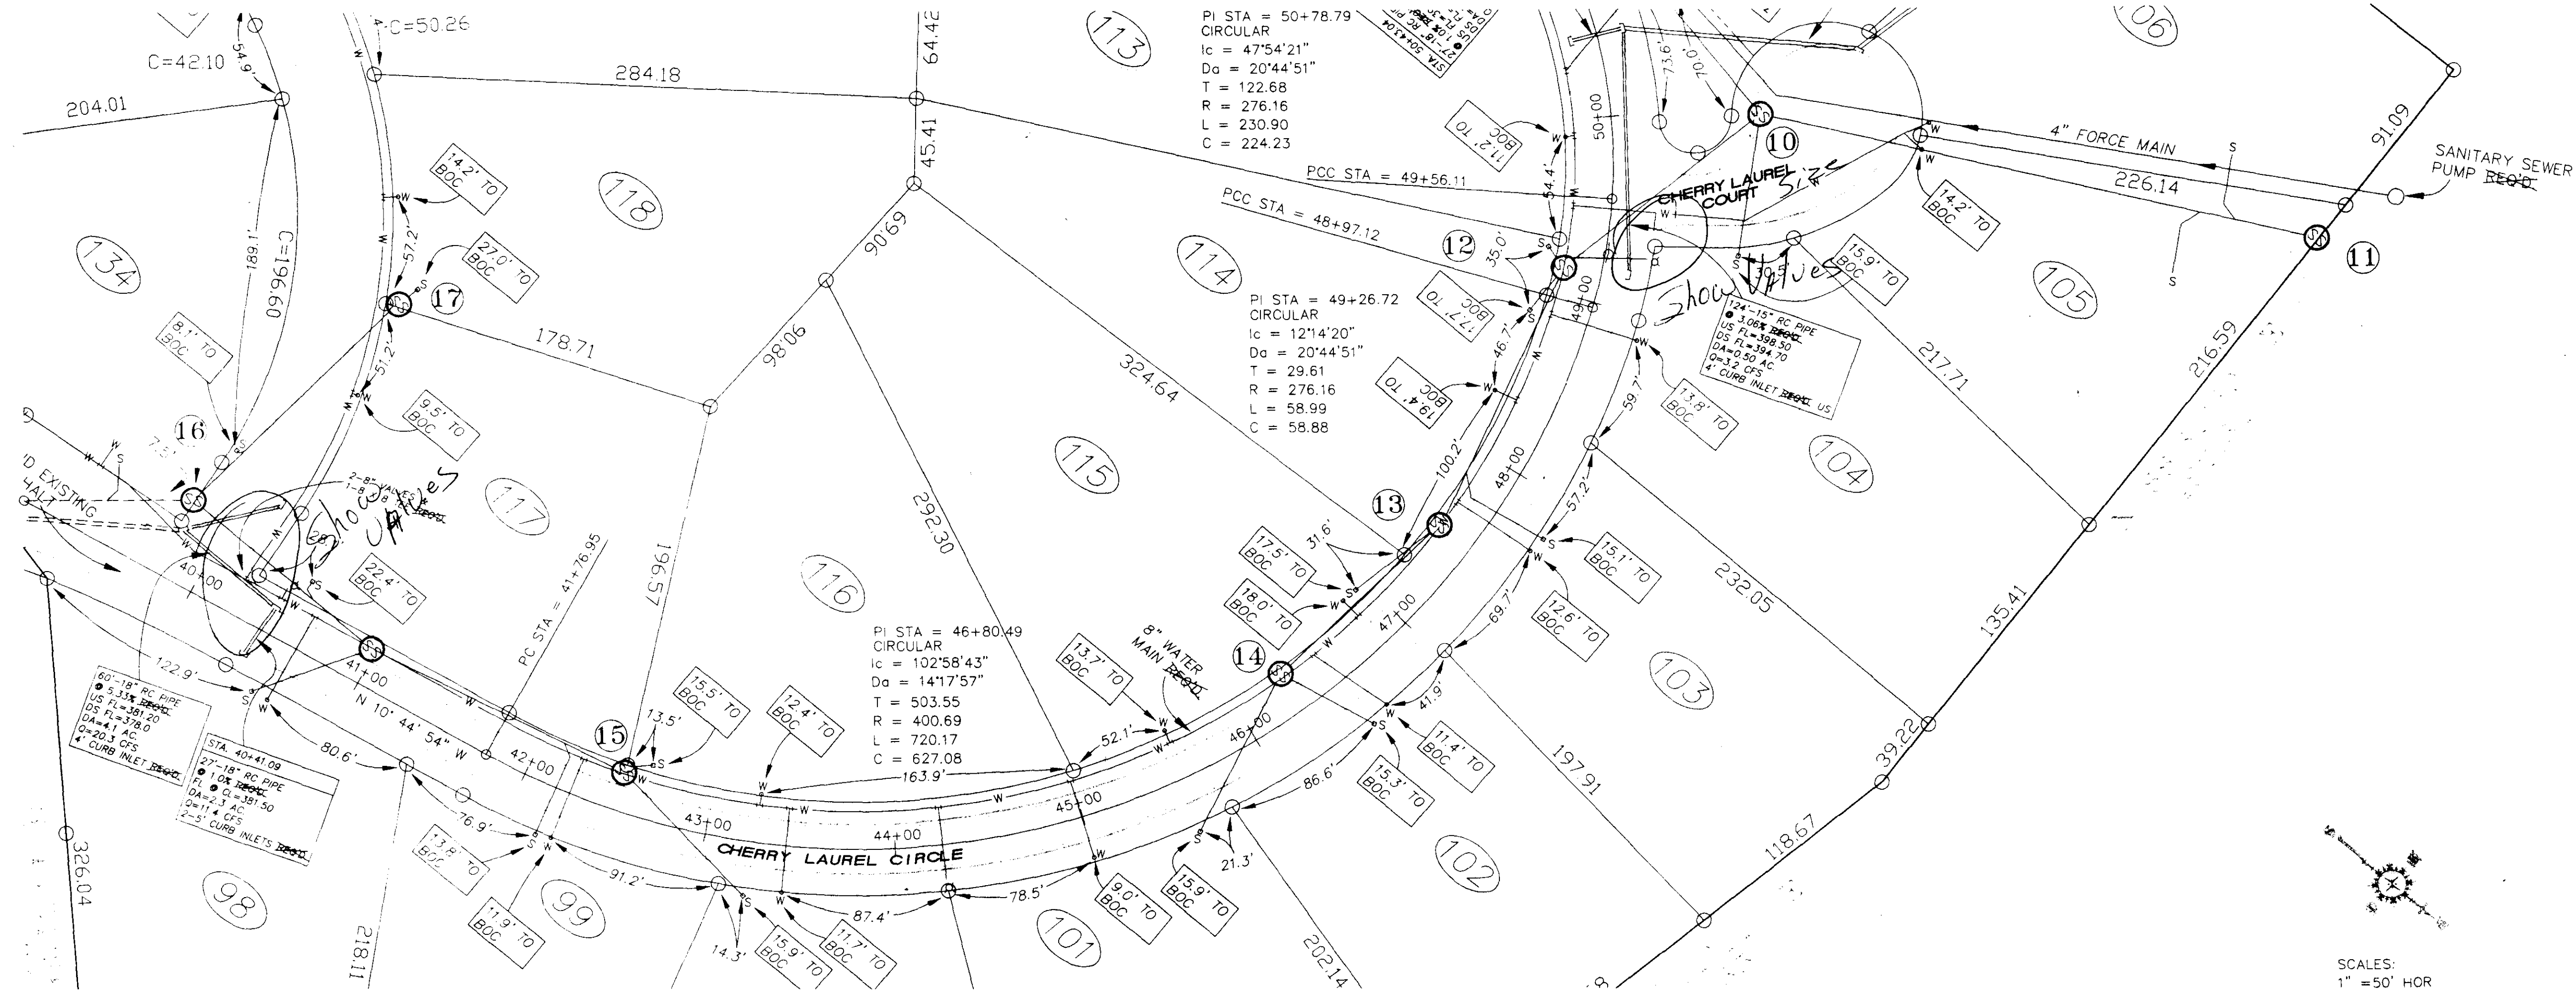


SCALES:
1" = 50' HOR
1" = 5' VER

ROBERT B. BARNES
CIVIL ENGINEER &
LAND SURVEYOR
4 OLD RIVER PLACE - SUITE "D"
JACKSON, MISSISSIPPI 39202

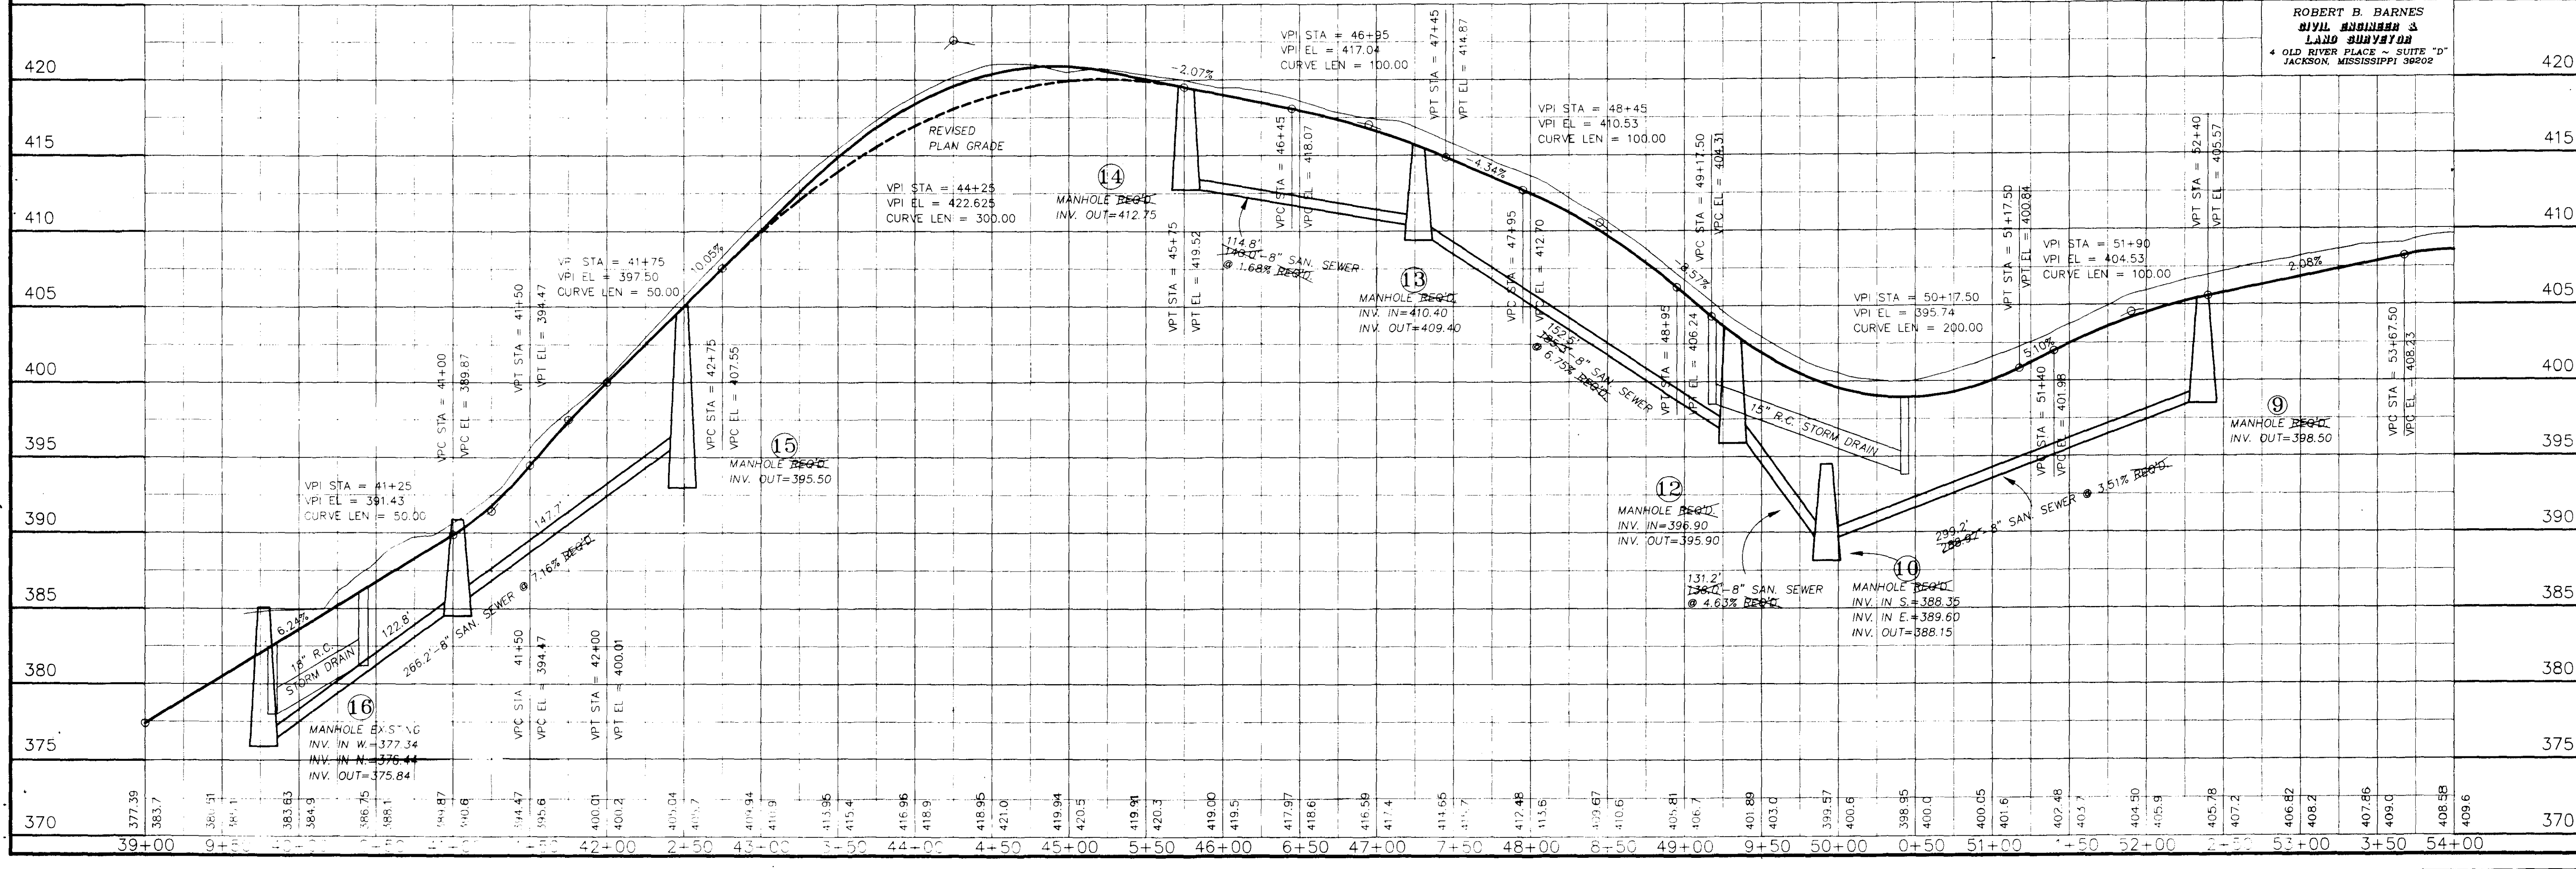

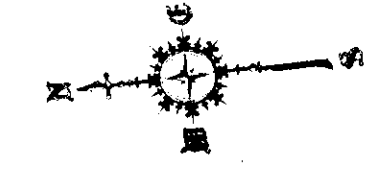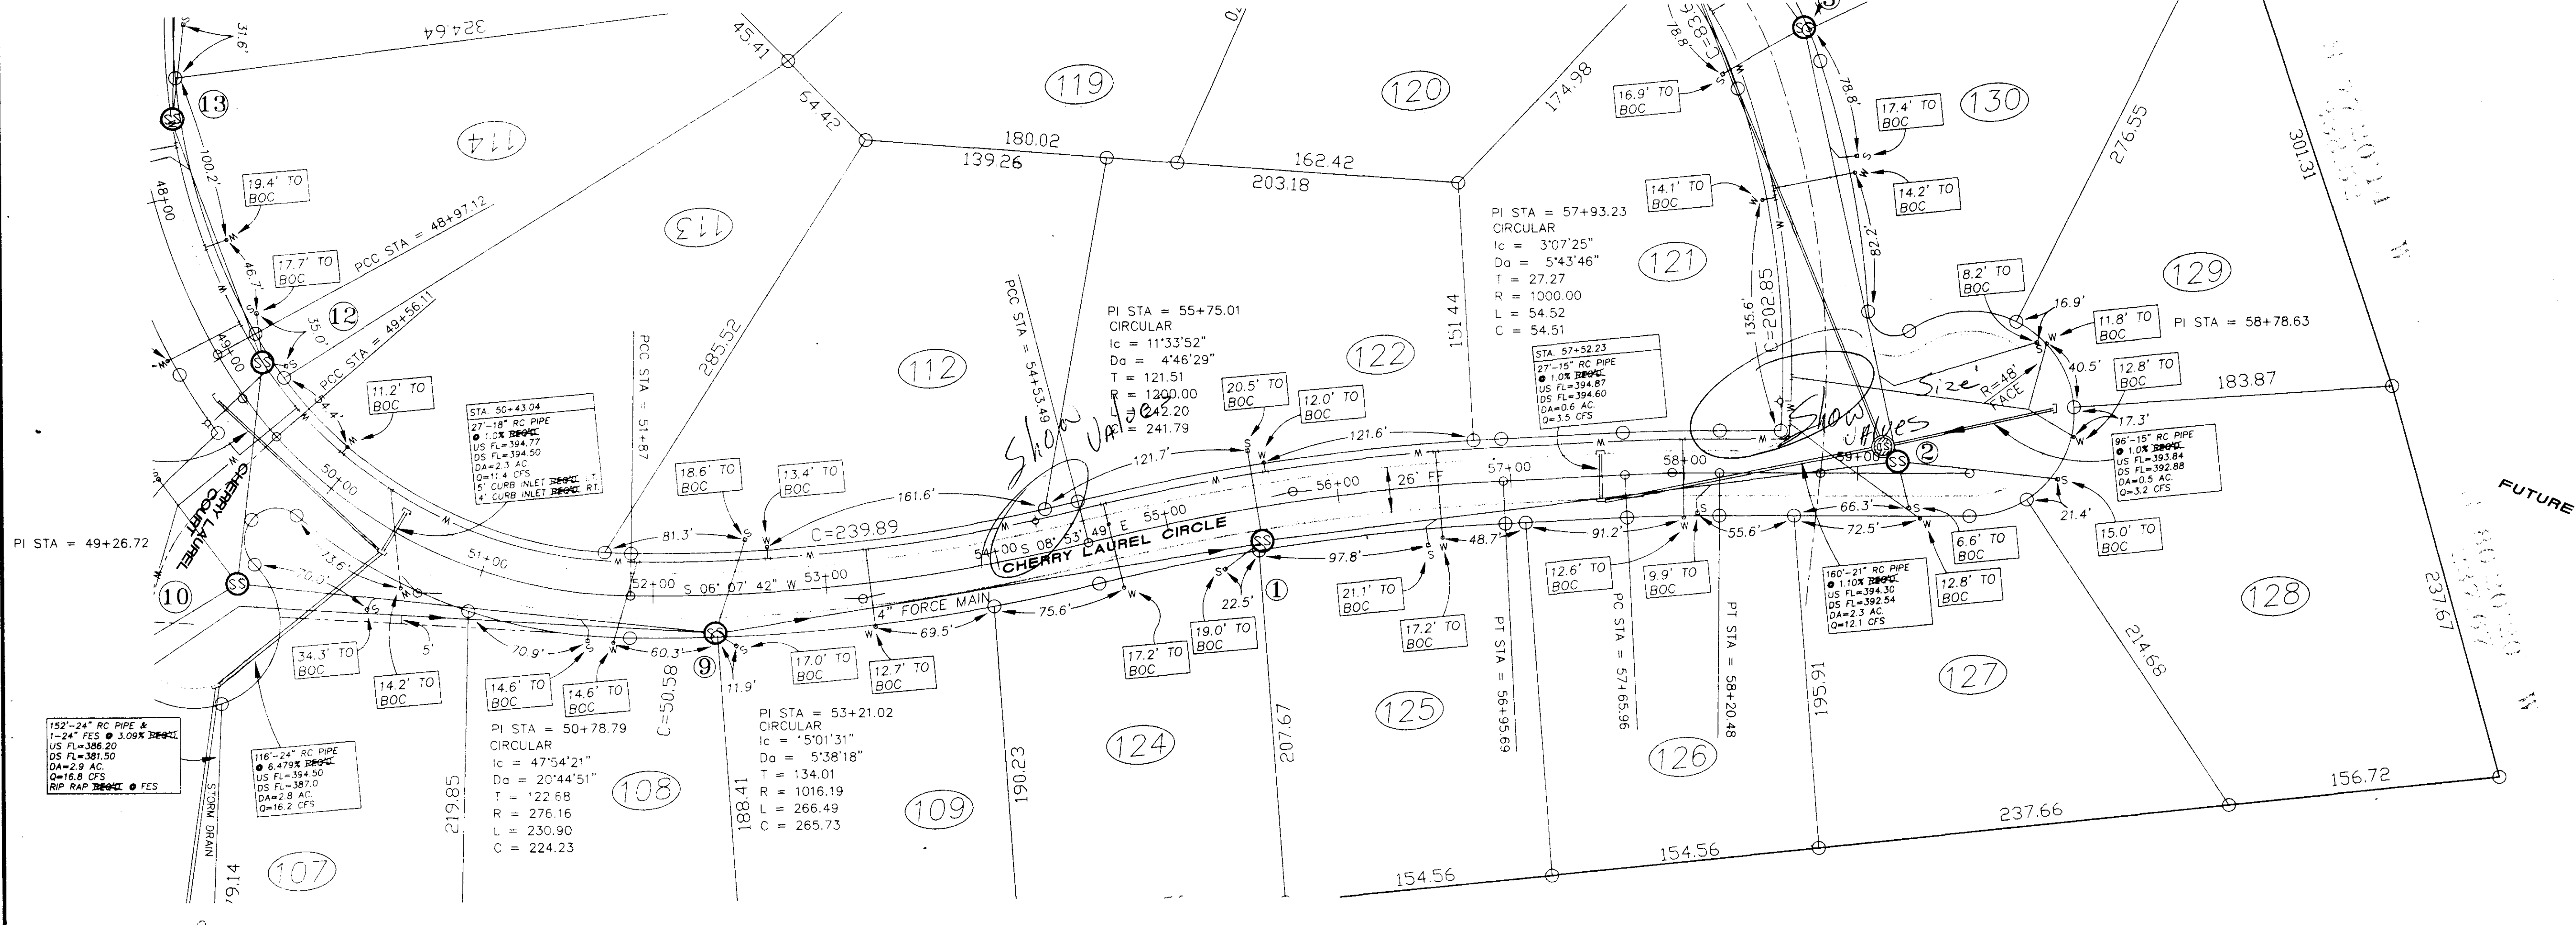

SCALES:
1" = 50' HOR
1" = 5' VER

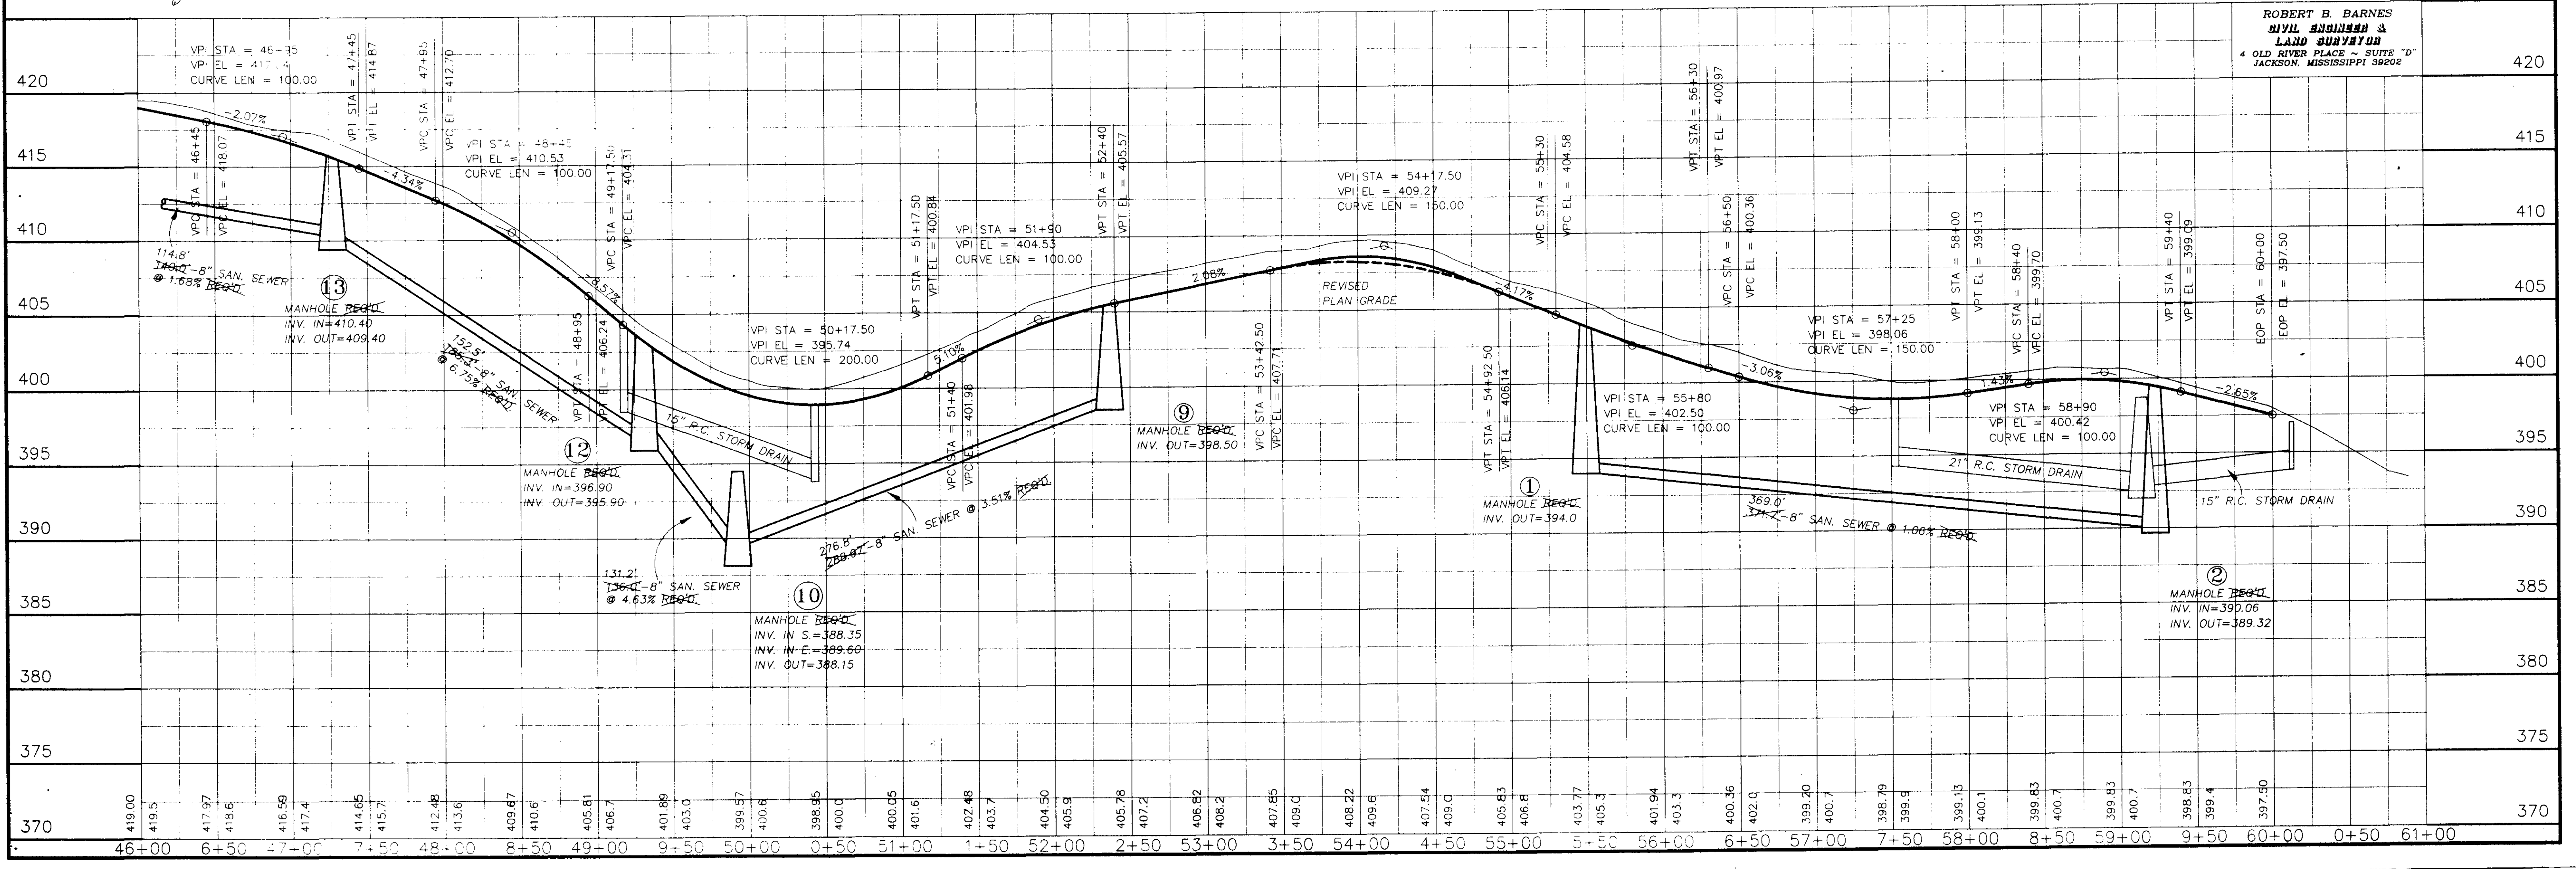

ROBERT B. BARNES
CIVIL ENGINEER &
LAND SURVEYOR
4 OLD RIVER PLACE - SUITE "D"
JACKSON, MISSISSIPPI 39202

420

415

410

405

400

395

390


385

380


375

370


46+00 6+50 7+00 7+50 8+00 8+50 8+50 9+00 9+50 10+00 
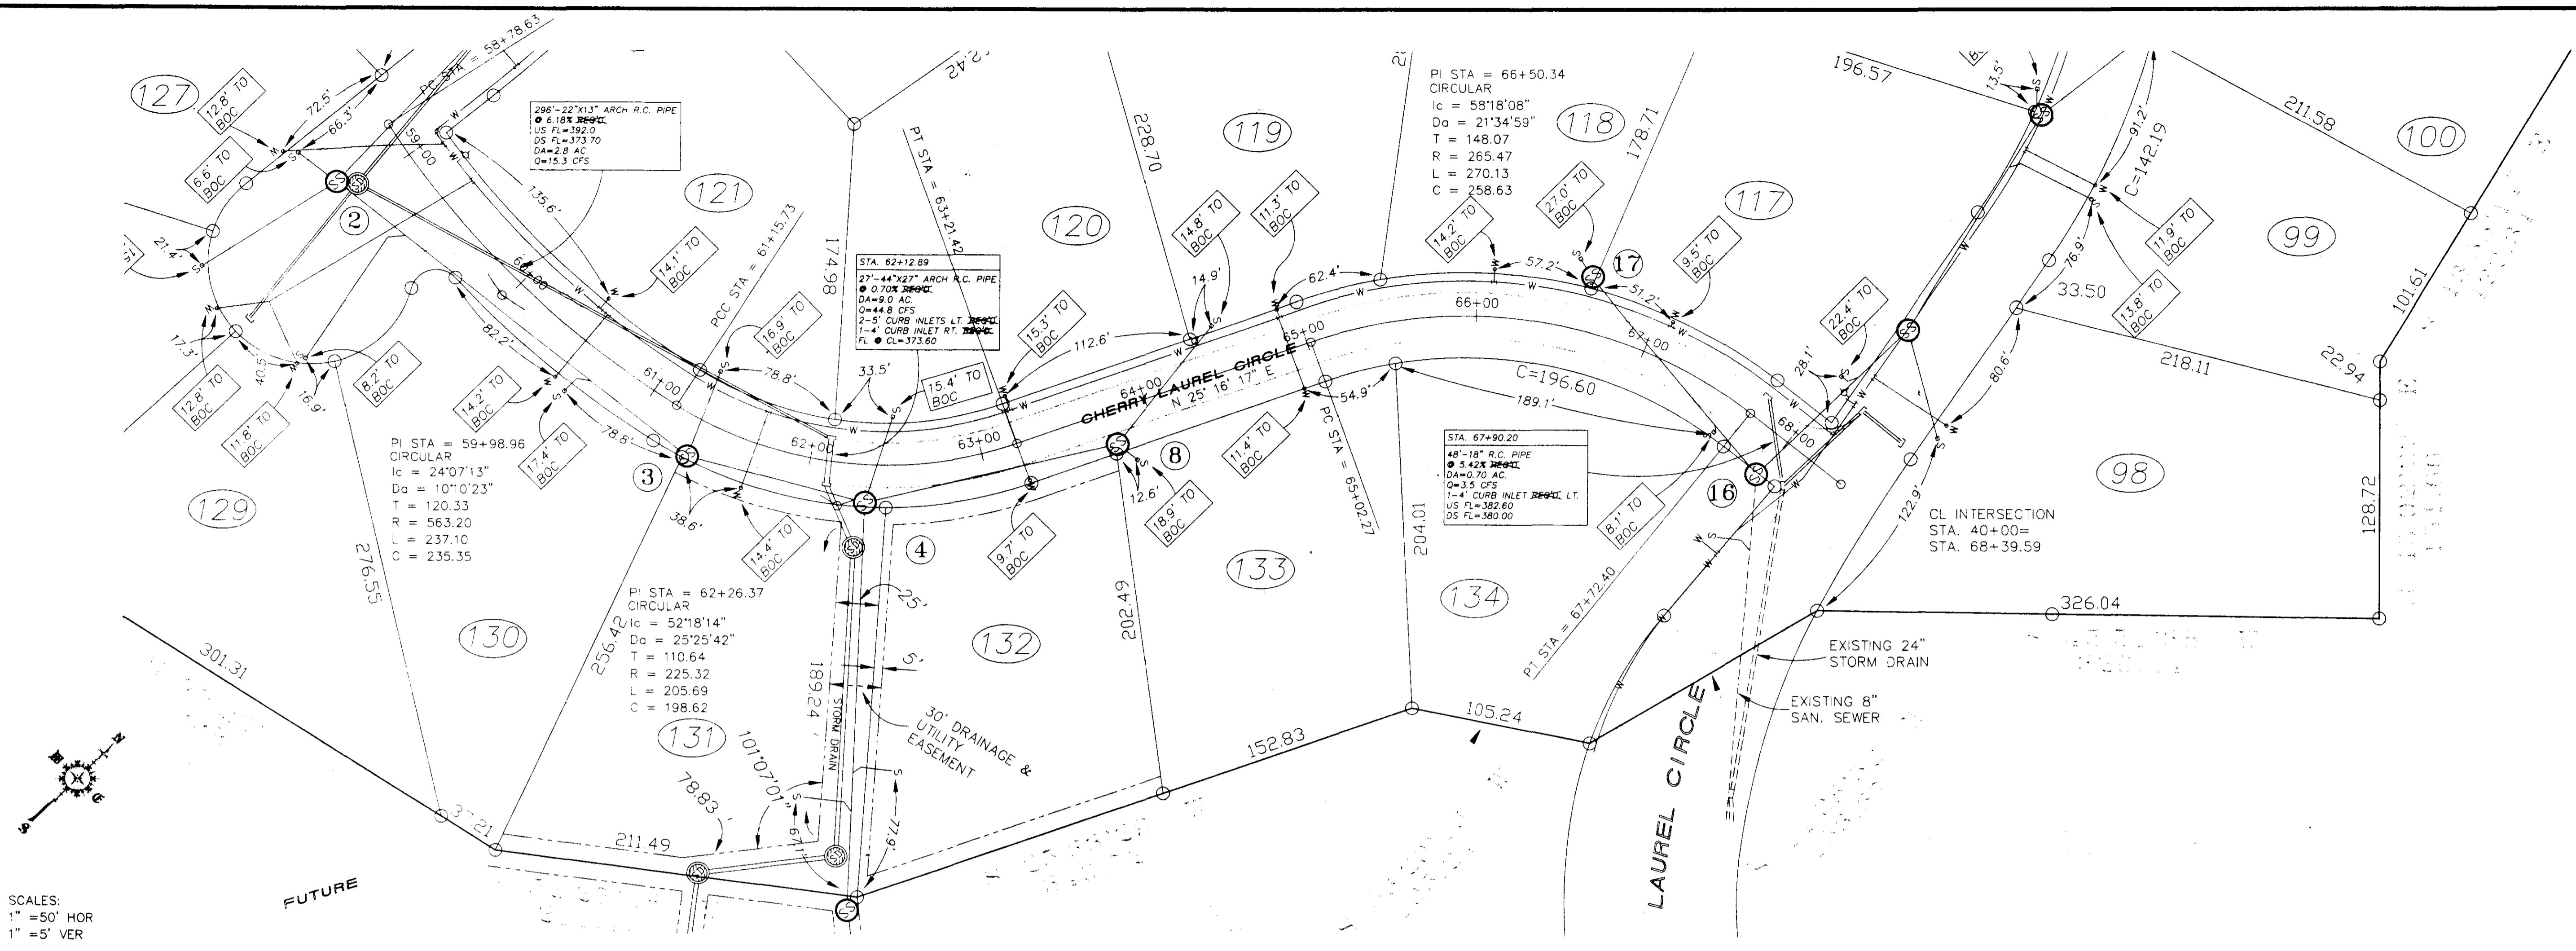


SCALES:
1" = 50' HOR
1" = 5' VER

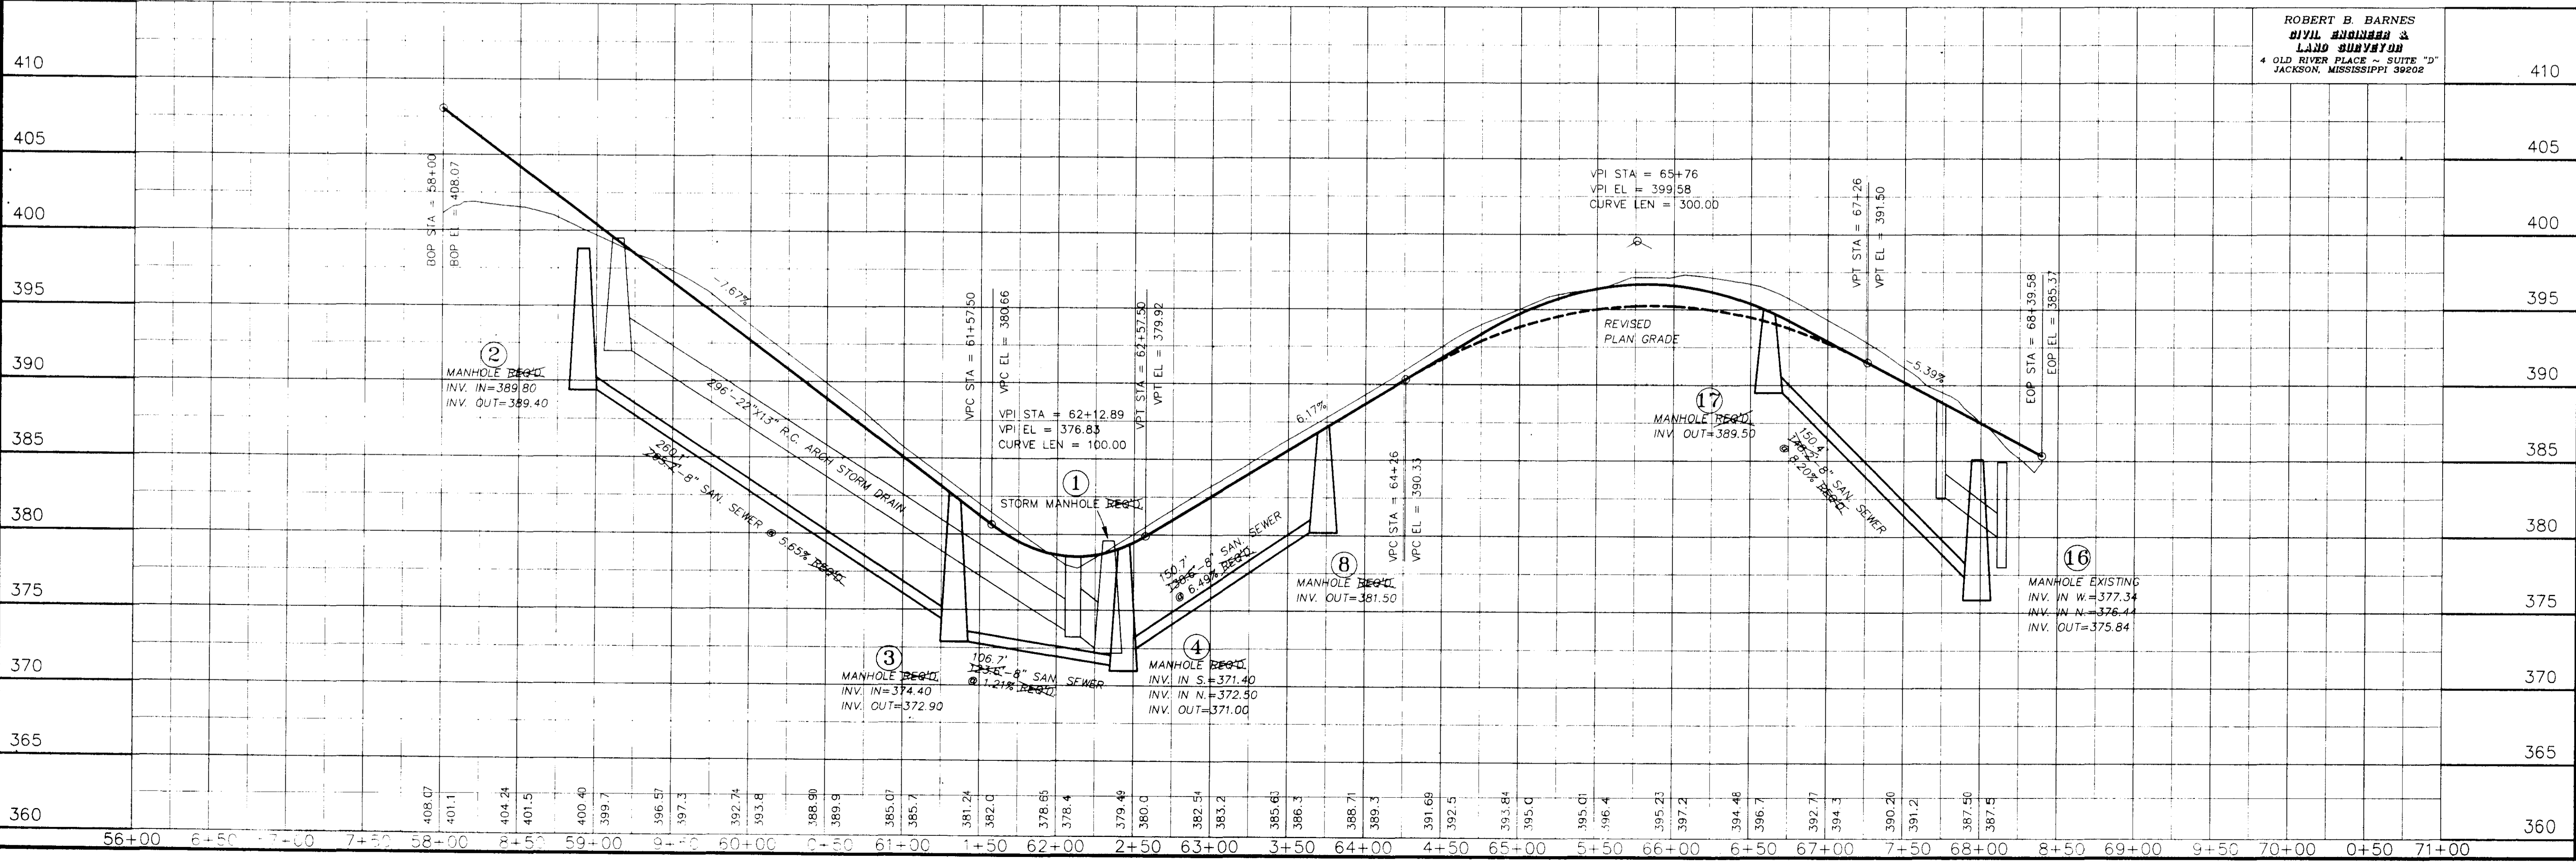


ROBERT B. BARNES
CIVIL ENGINEER &
LAND SURVEYOR
4 OLD RIVER PLACE - SUITE "D"
JACKSON, MISSISSIPPI 39202

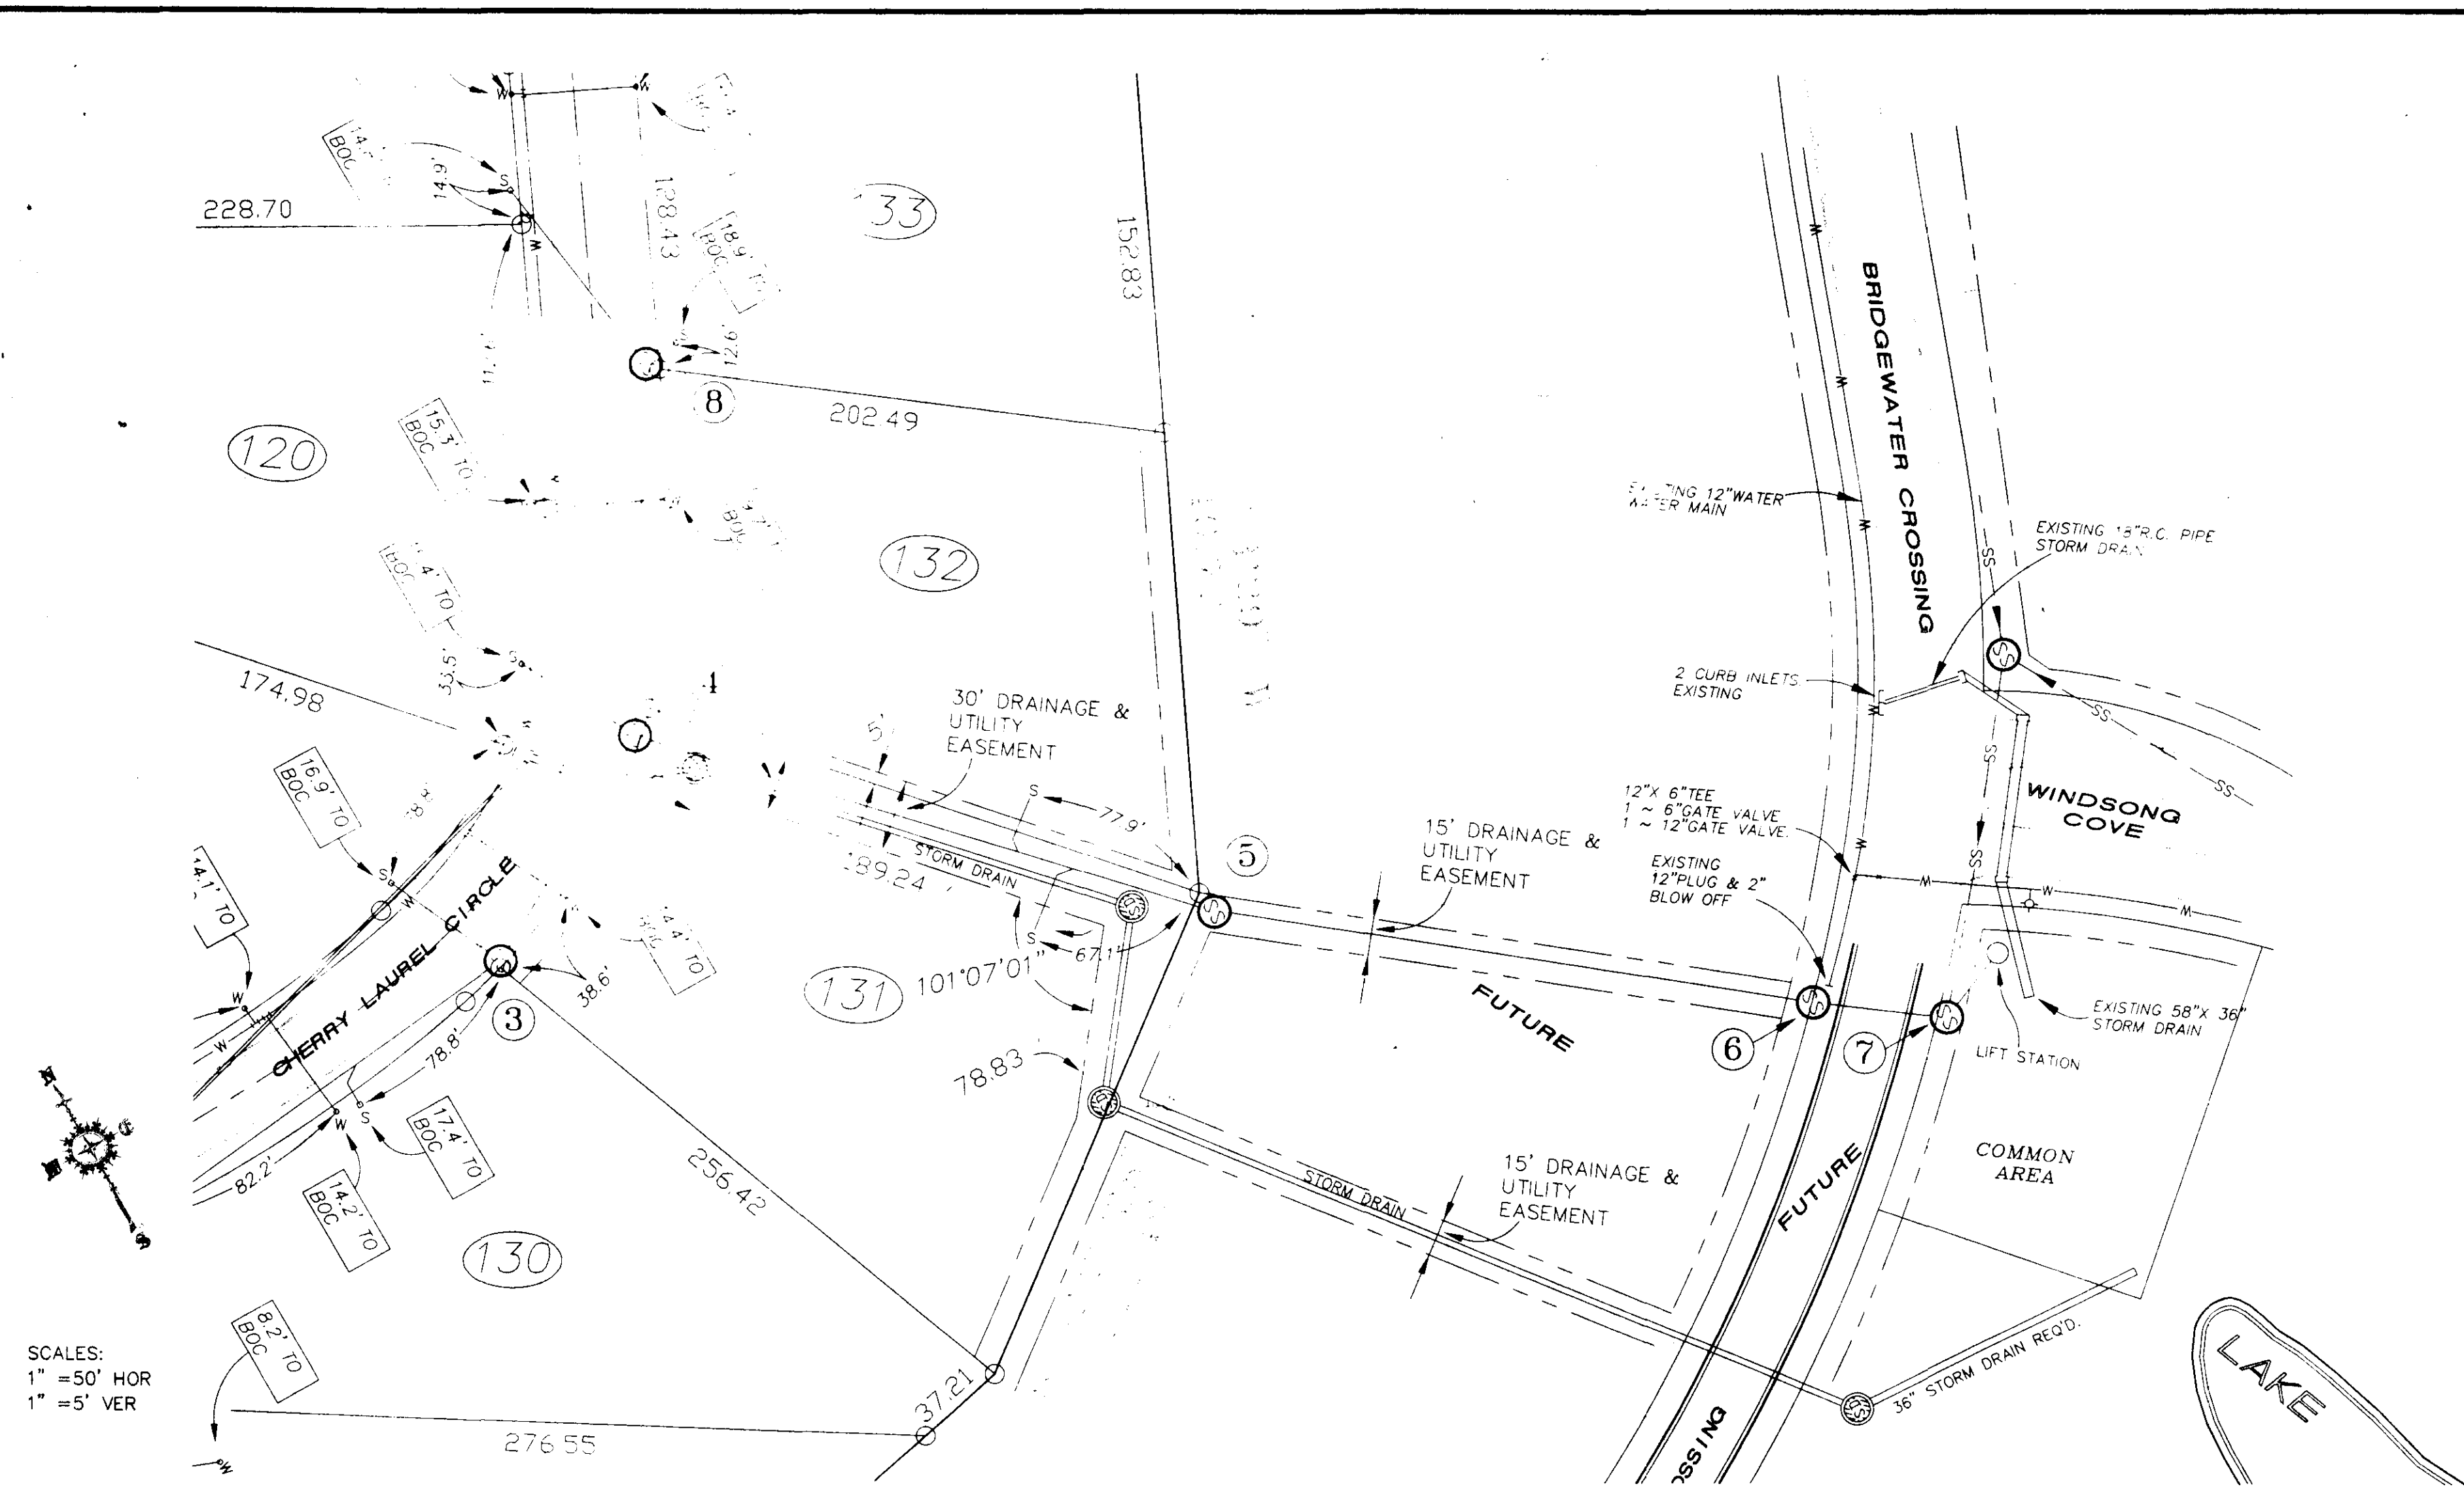


SCALES:
1" = 50' HOR
1" = 5' VER

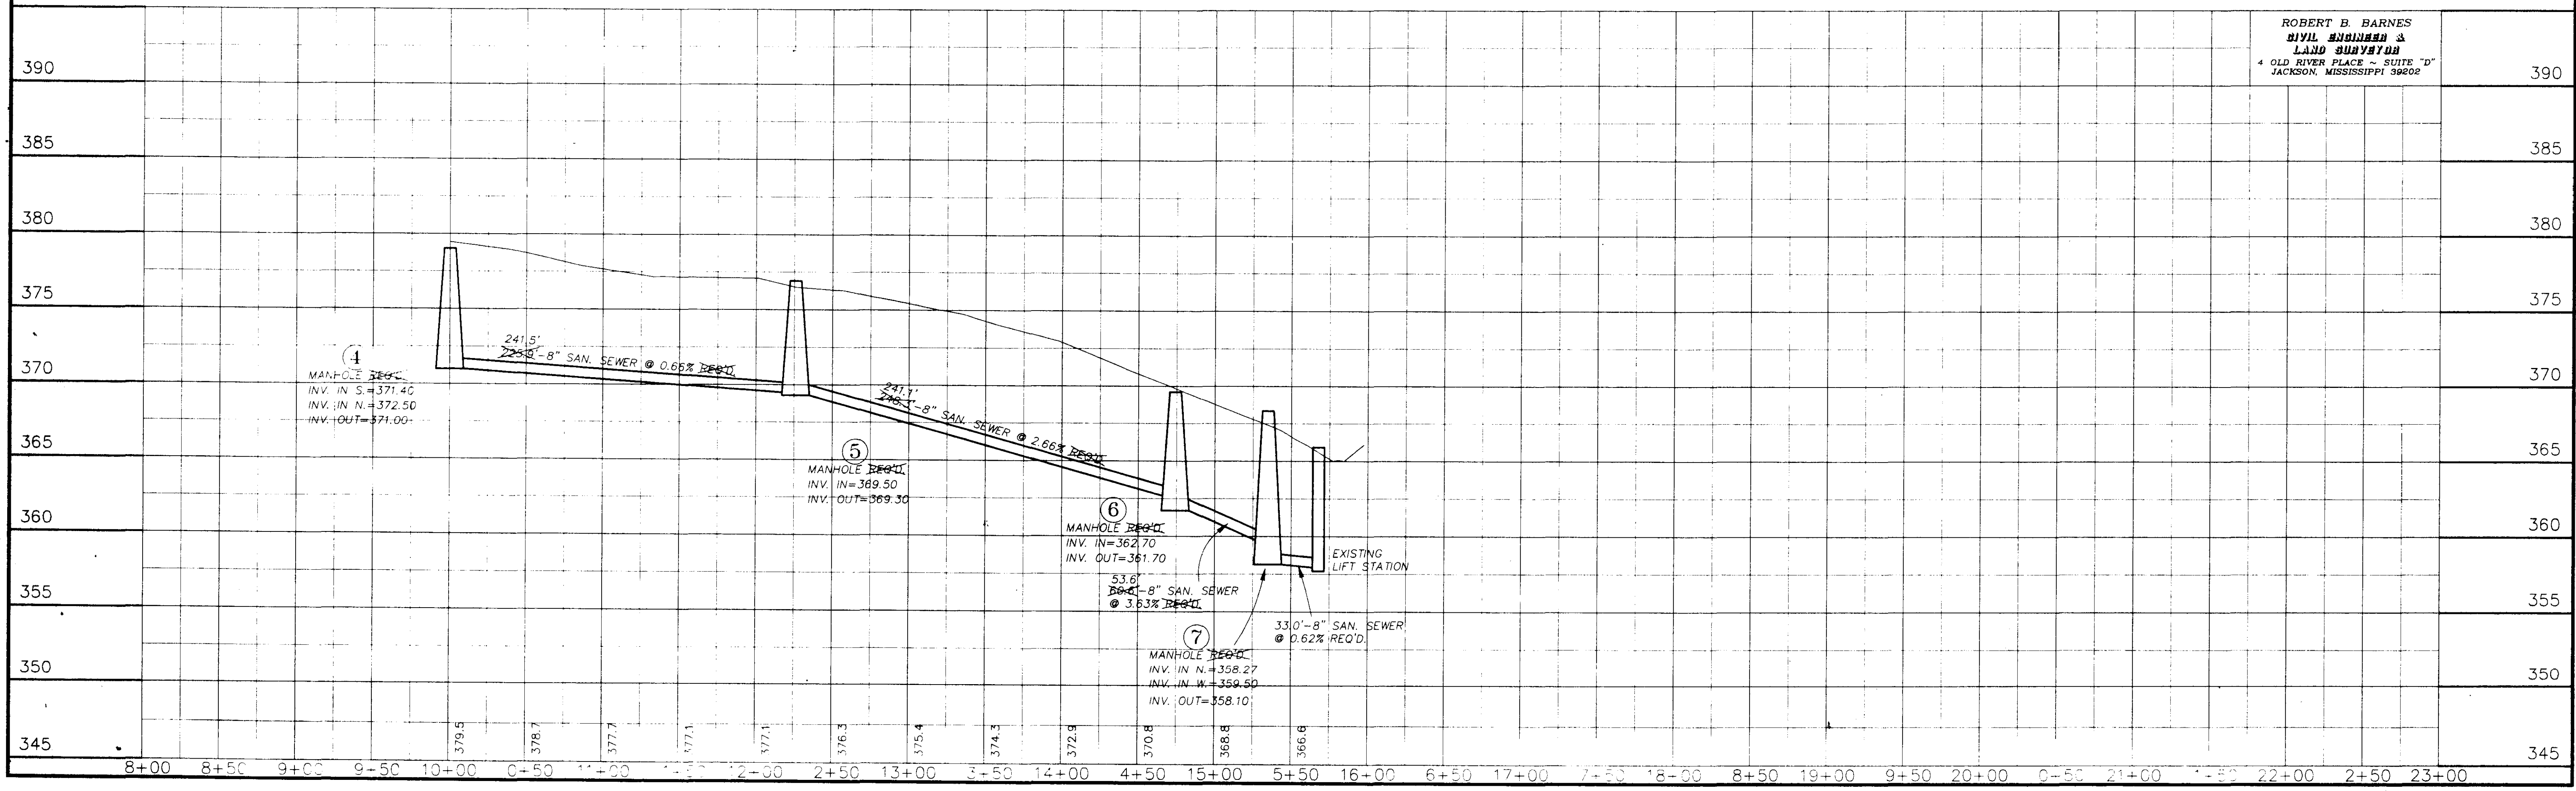


ROBERT B. BARNES
CIVIL ENGINEER &
LAND SURVEYOR
4 OLD RIVER PLACE - SUITE "D"
JACKSON, MISSISSIPPI 39202

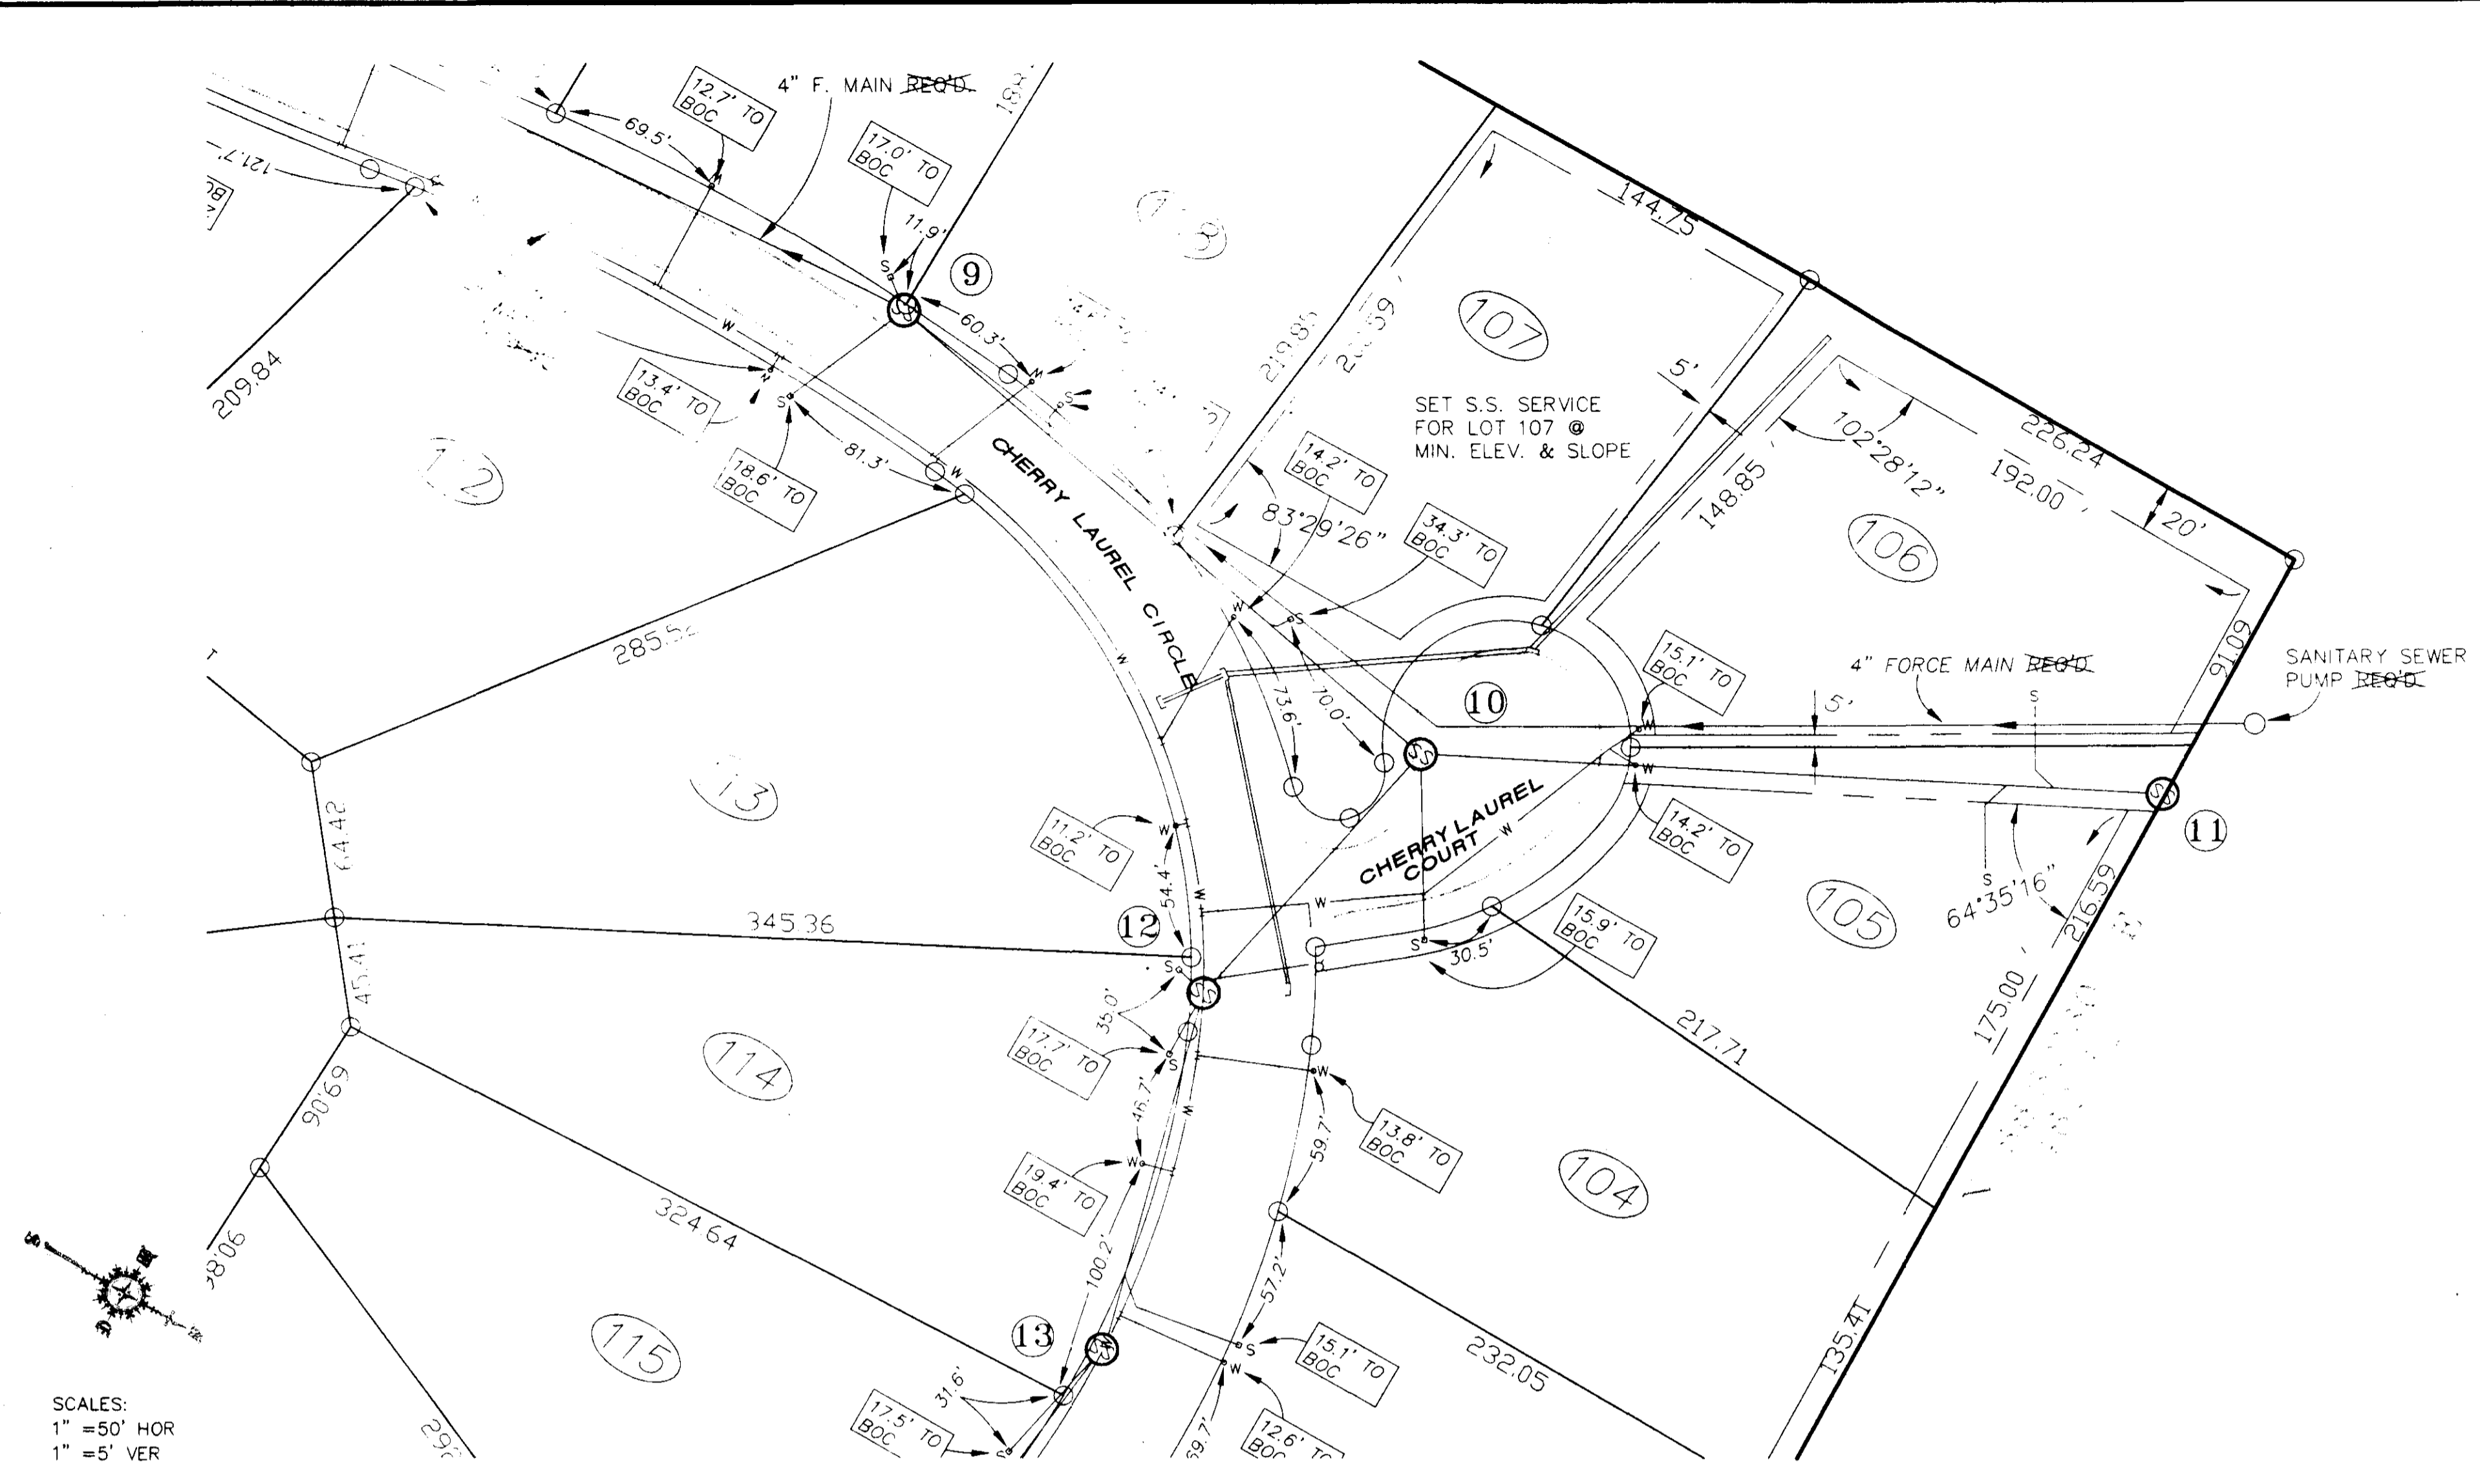


SCALES:
1" = 50' HOR
1" = 5' VER

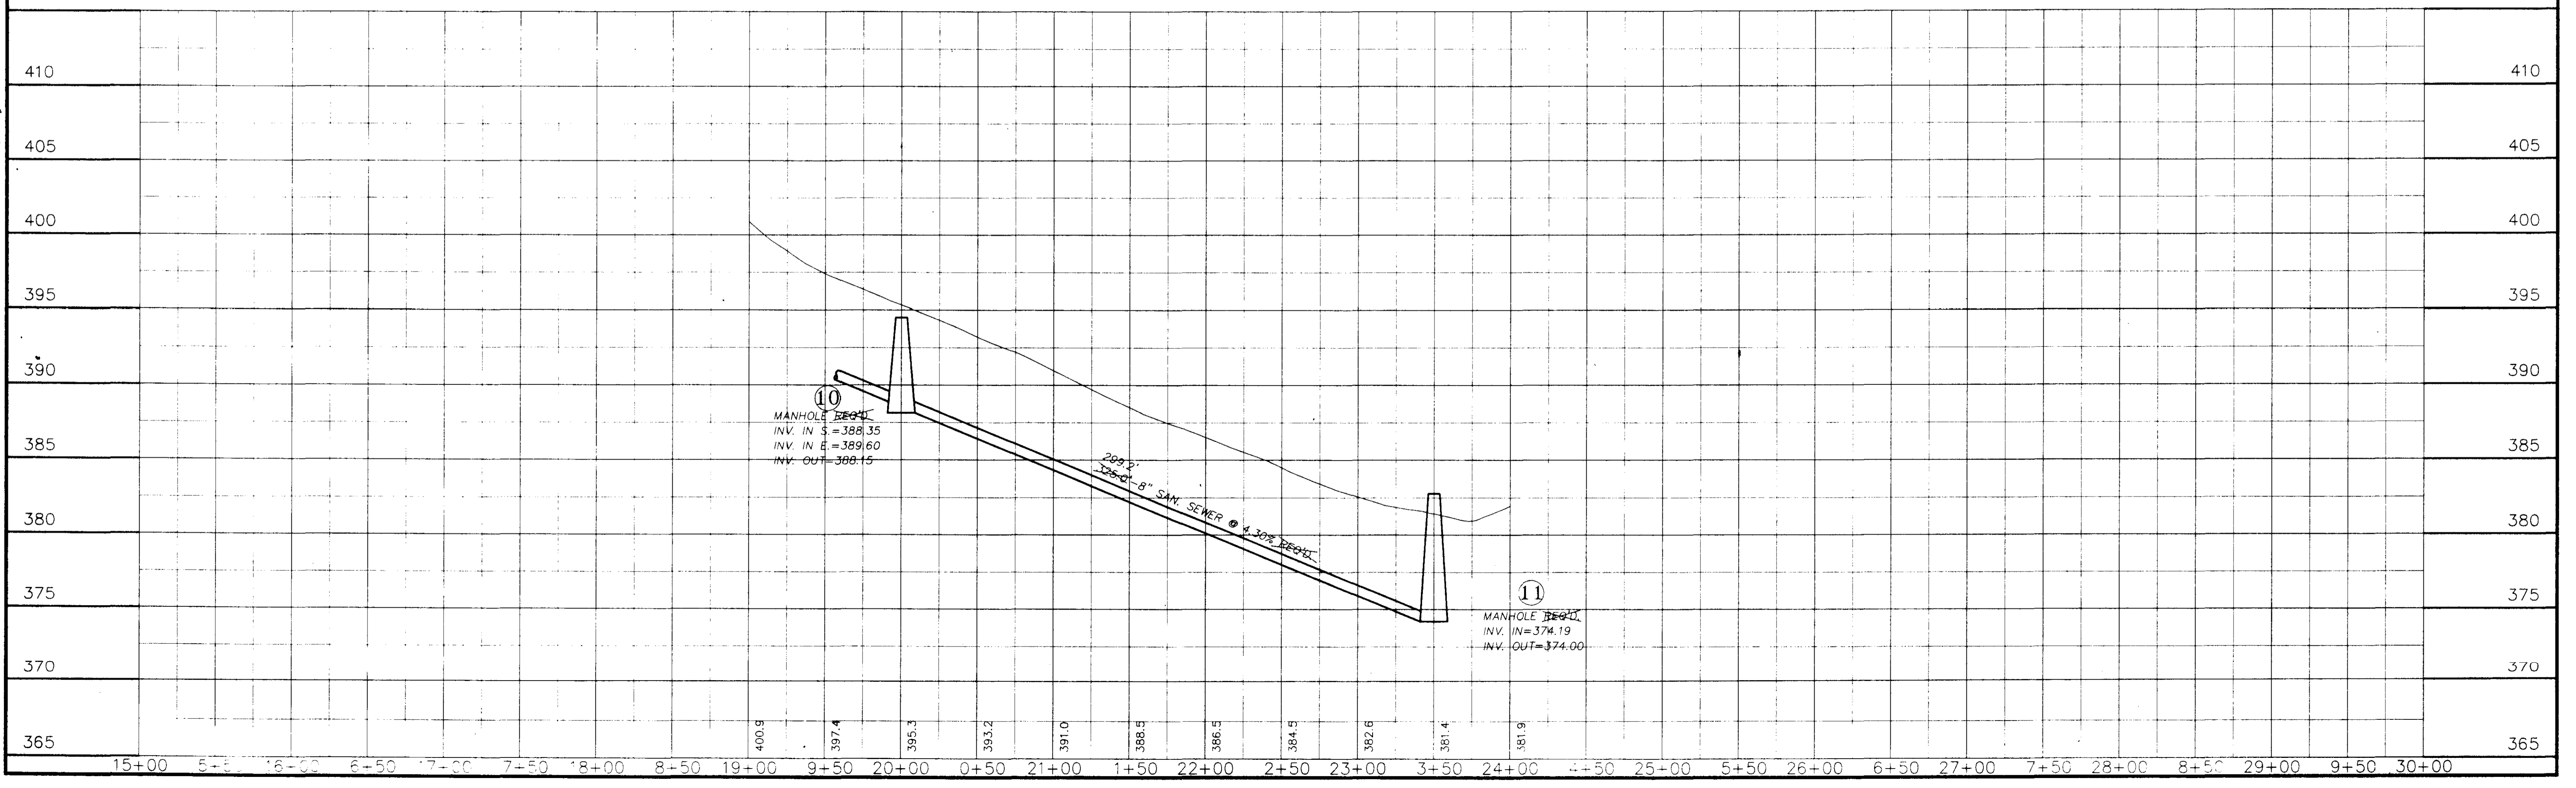

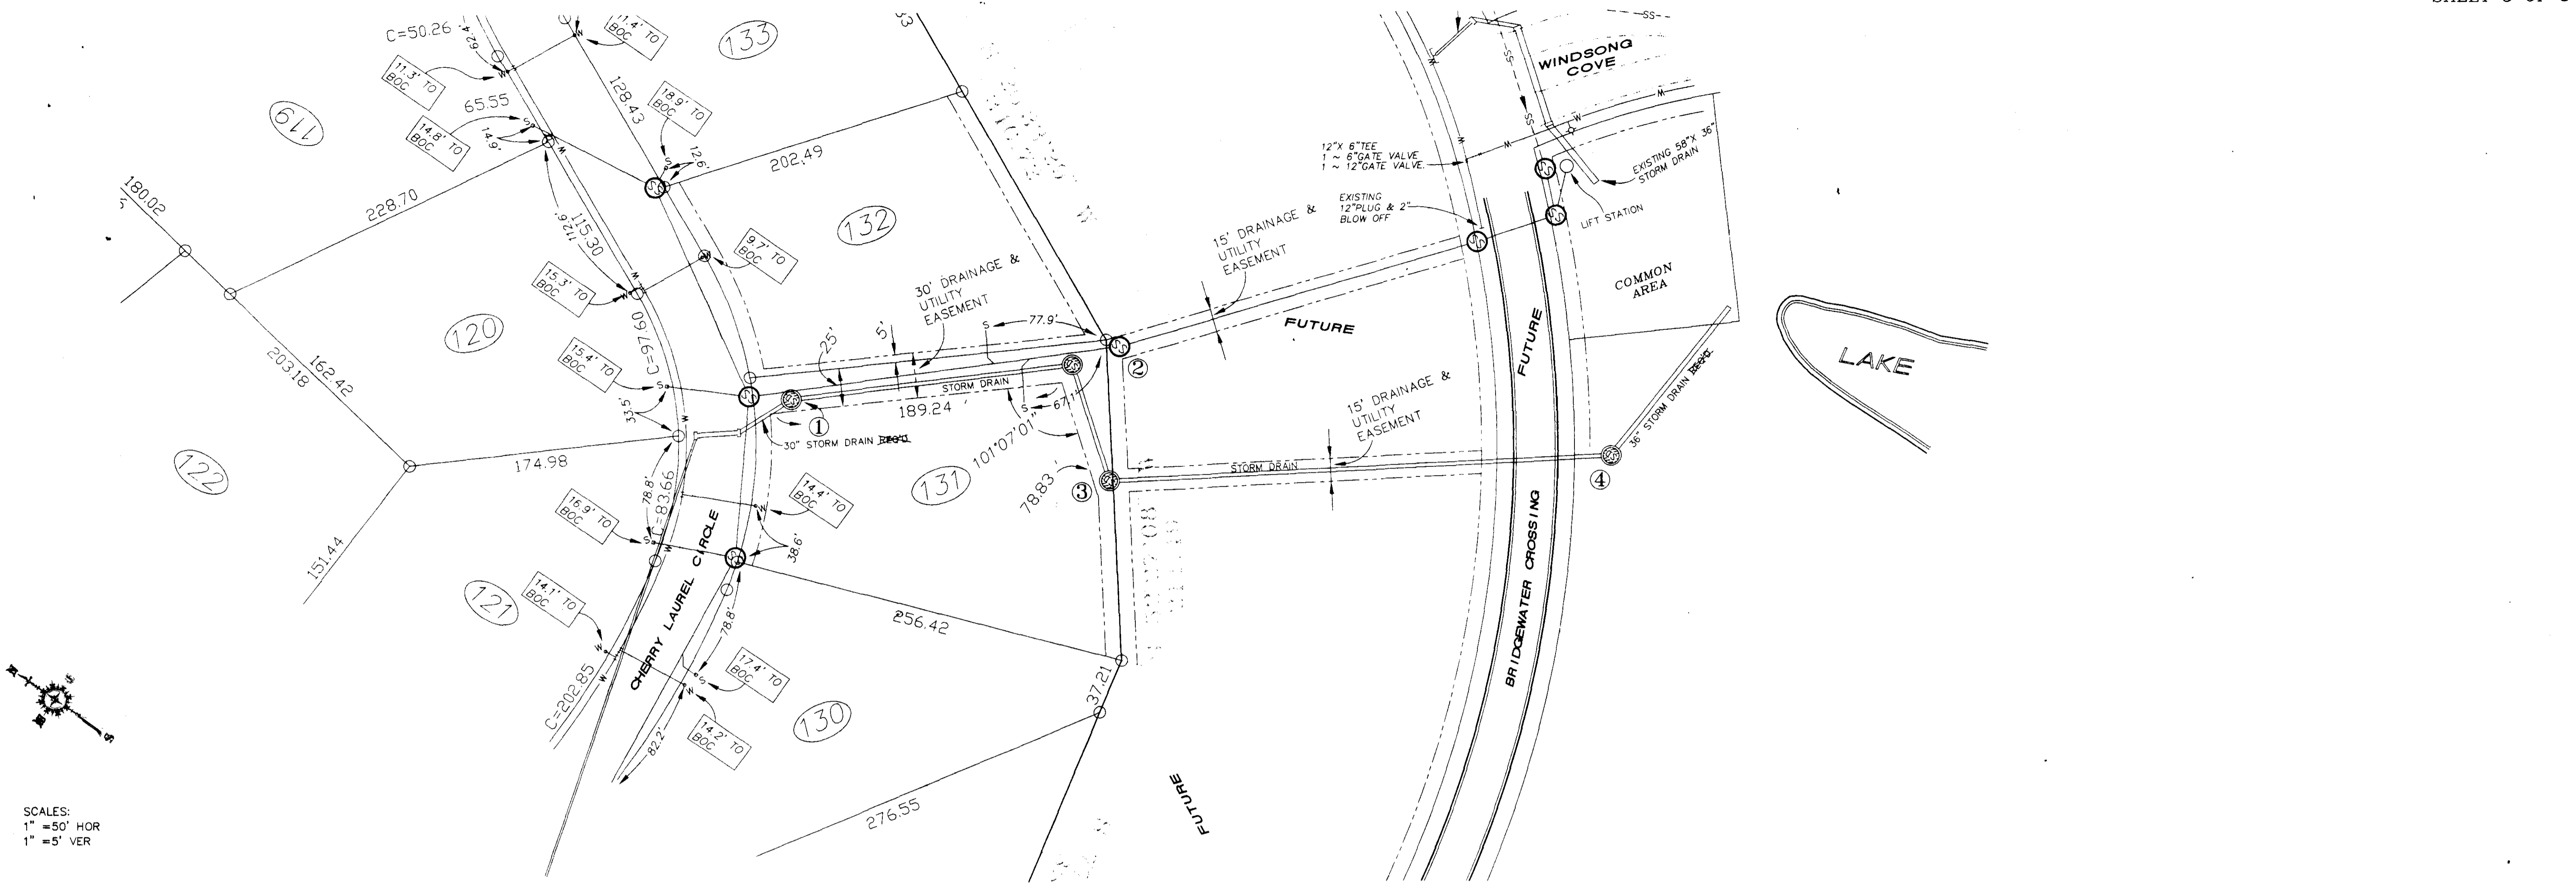

SCALES:
1" = 50' HOR
1" = 5' VER

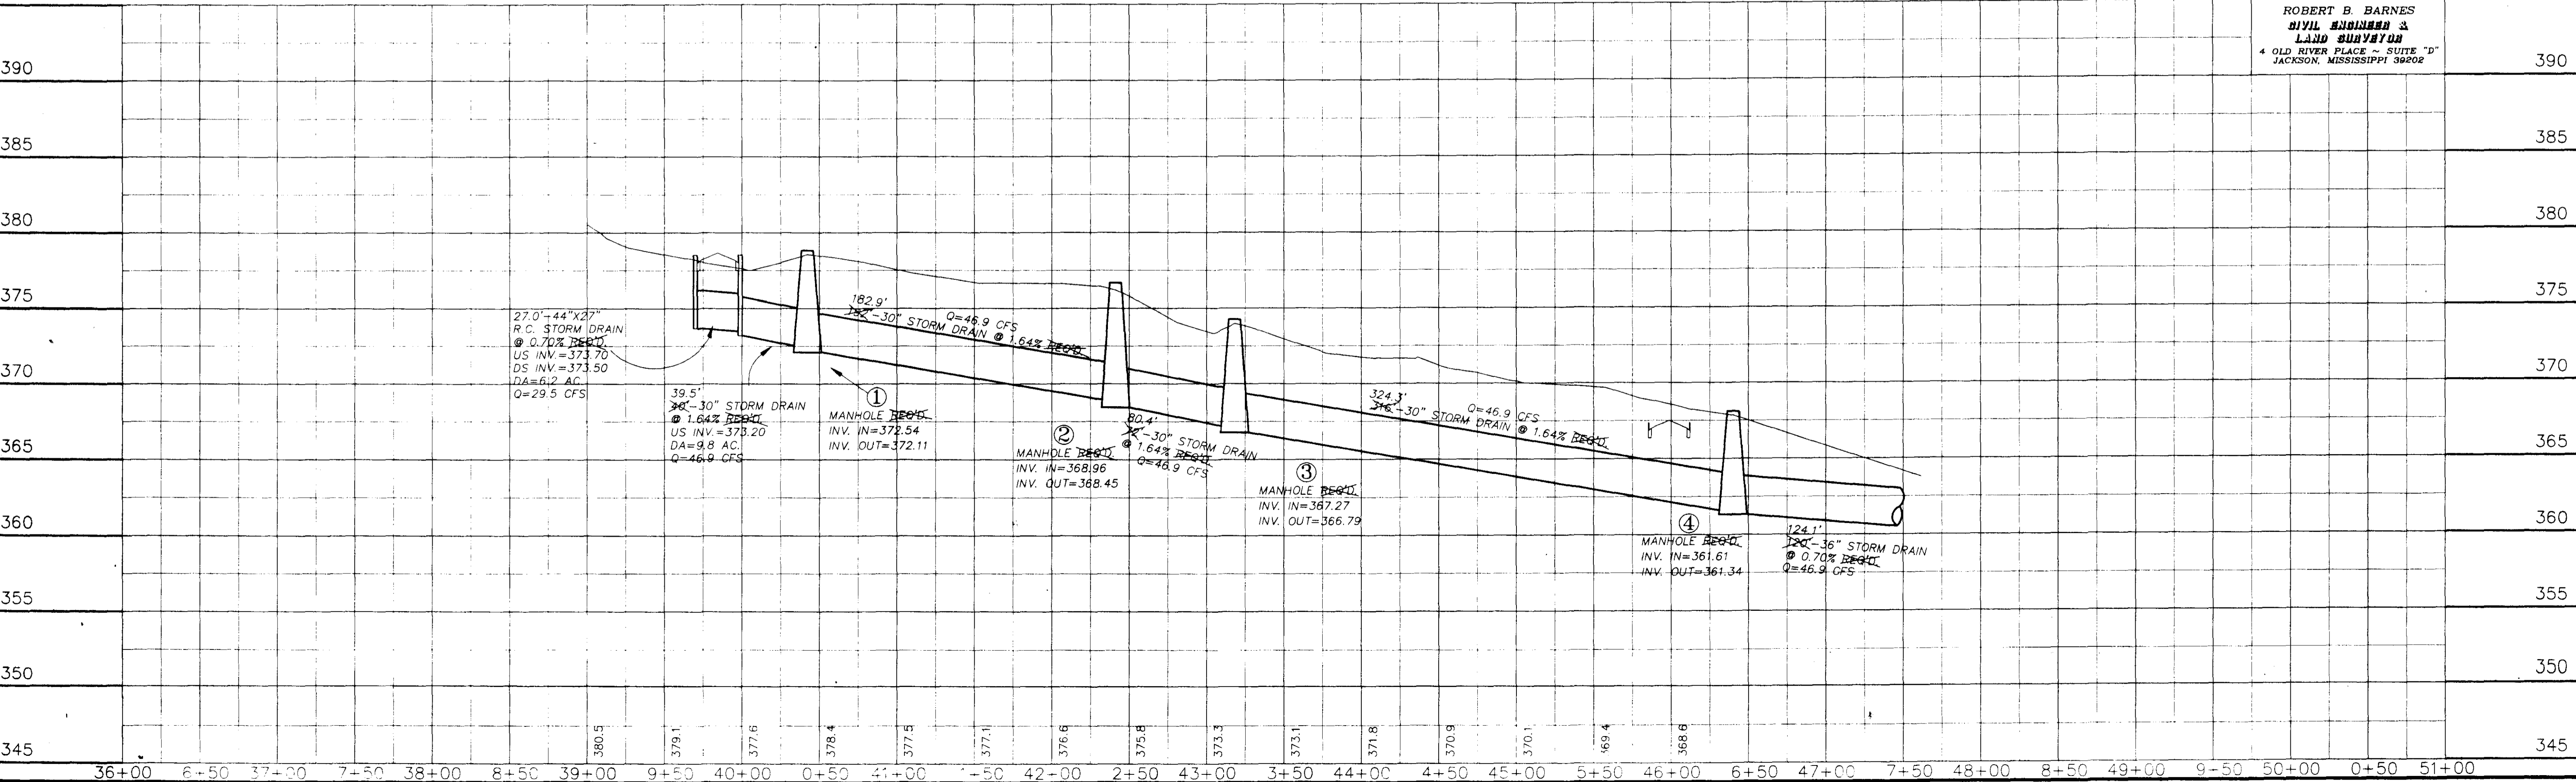

ROBERT B. BARNES
CIVIL ENGINEER &
LAND SURVEYOR
4 OLD RIVER PLACE - SUITE "D"
JACKSON, MISSISSIPPI 39202