


Revisions				
#	Date	Nature	By	App'd.

Project No.	M-2230	Designed By	R.C.M.
Date	10-7-16	Drawn By	D.P.
Scale	SEE ABOVE	Checked By	R.C.M.

# BRIDGEWATER 8 ADDITION

M:\Letterheads, Faxes & Labels\Logo\McMaster stamp - no border.jpg

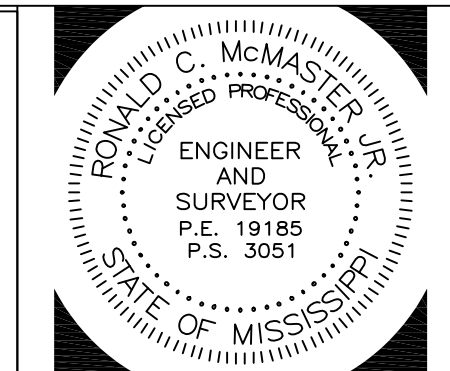

WATER & SEWER  
AS-BUILTS

**4-R**