


# CITY OF RIDGELAND, MISSISSIPPI

## SPECIAL ASSESSMENT IMPROVEMENTS PROJECT NO. 3 STREET & UTILITY IMPROVEMENTS

Mayor:  
Hite B. Wolcott

Mayor Pro Tem:  
Hilda Boyd

City Attorney:  
Milton Case

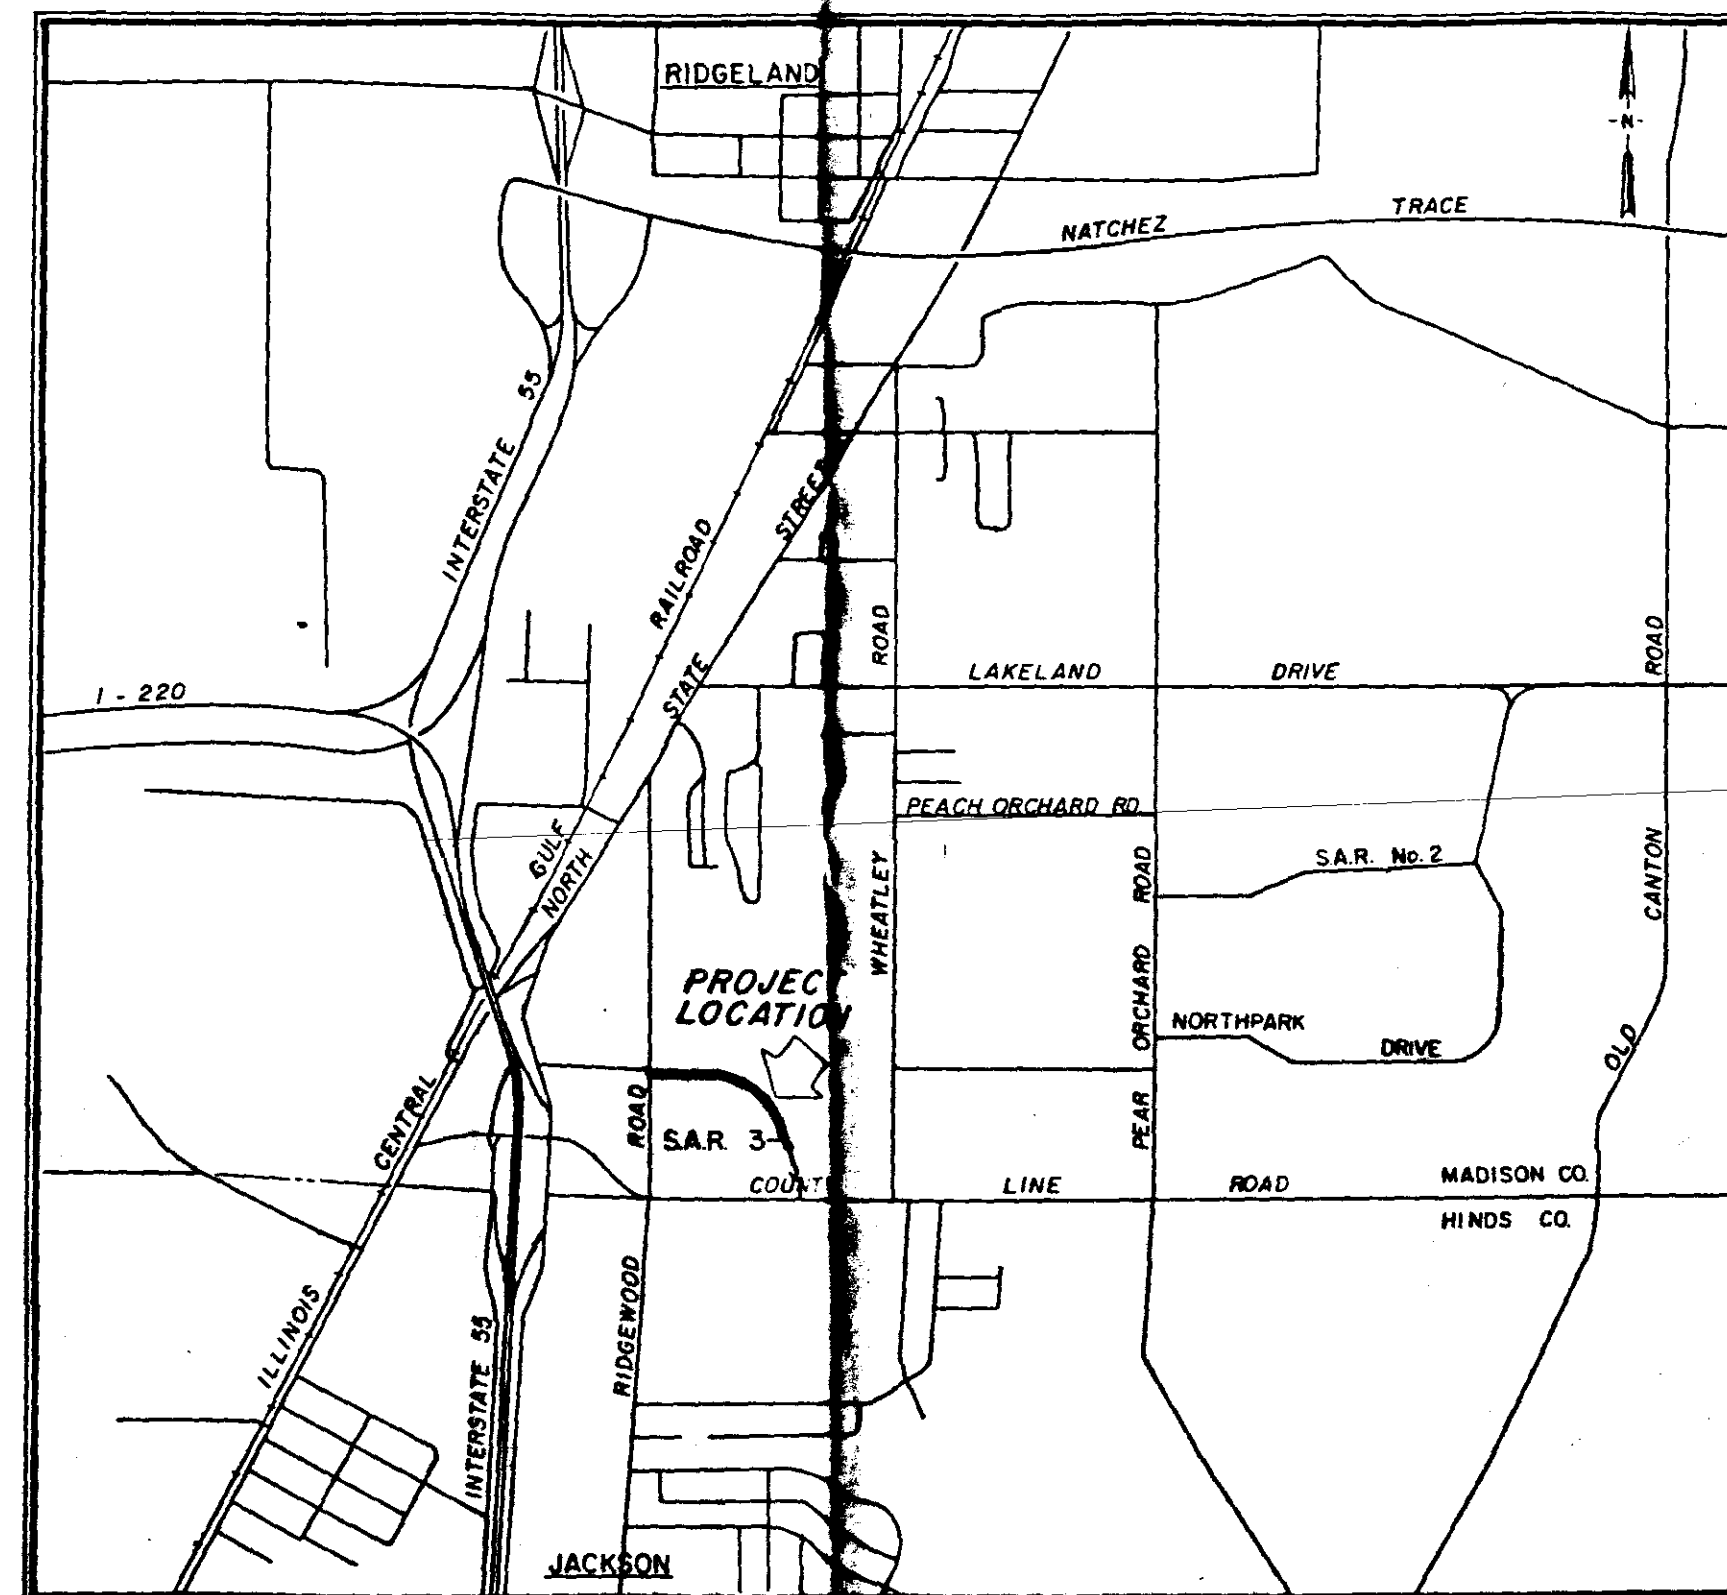


Aldermen:  
Al Bible  
Hilda Boyd  
Harvey Carr, Jr.  
Gene McGee  
Gilbert Sollek

Public Works Superintendent:  
Horace Ross

AUGUST 1985






JOE A. WAGGONER  
Civil Engineer  
Brandon / Jackson, Mississippi

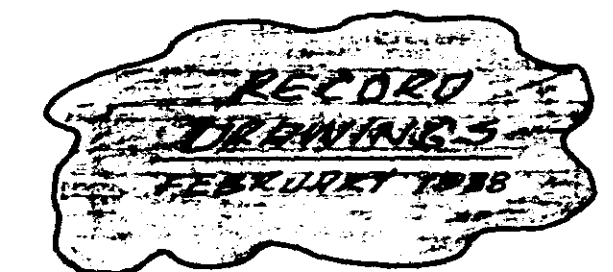

PWP-01911



DATE: \_\_\_\_\_  
 DRAWN BY: \_\_\_\_\_  
 CHECKED BY: \_\_\_\_\_  
 IN CHARGE: \_\_\_\_\_

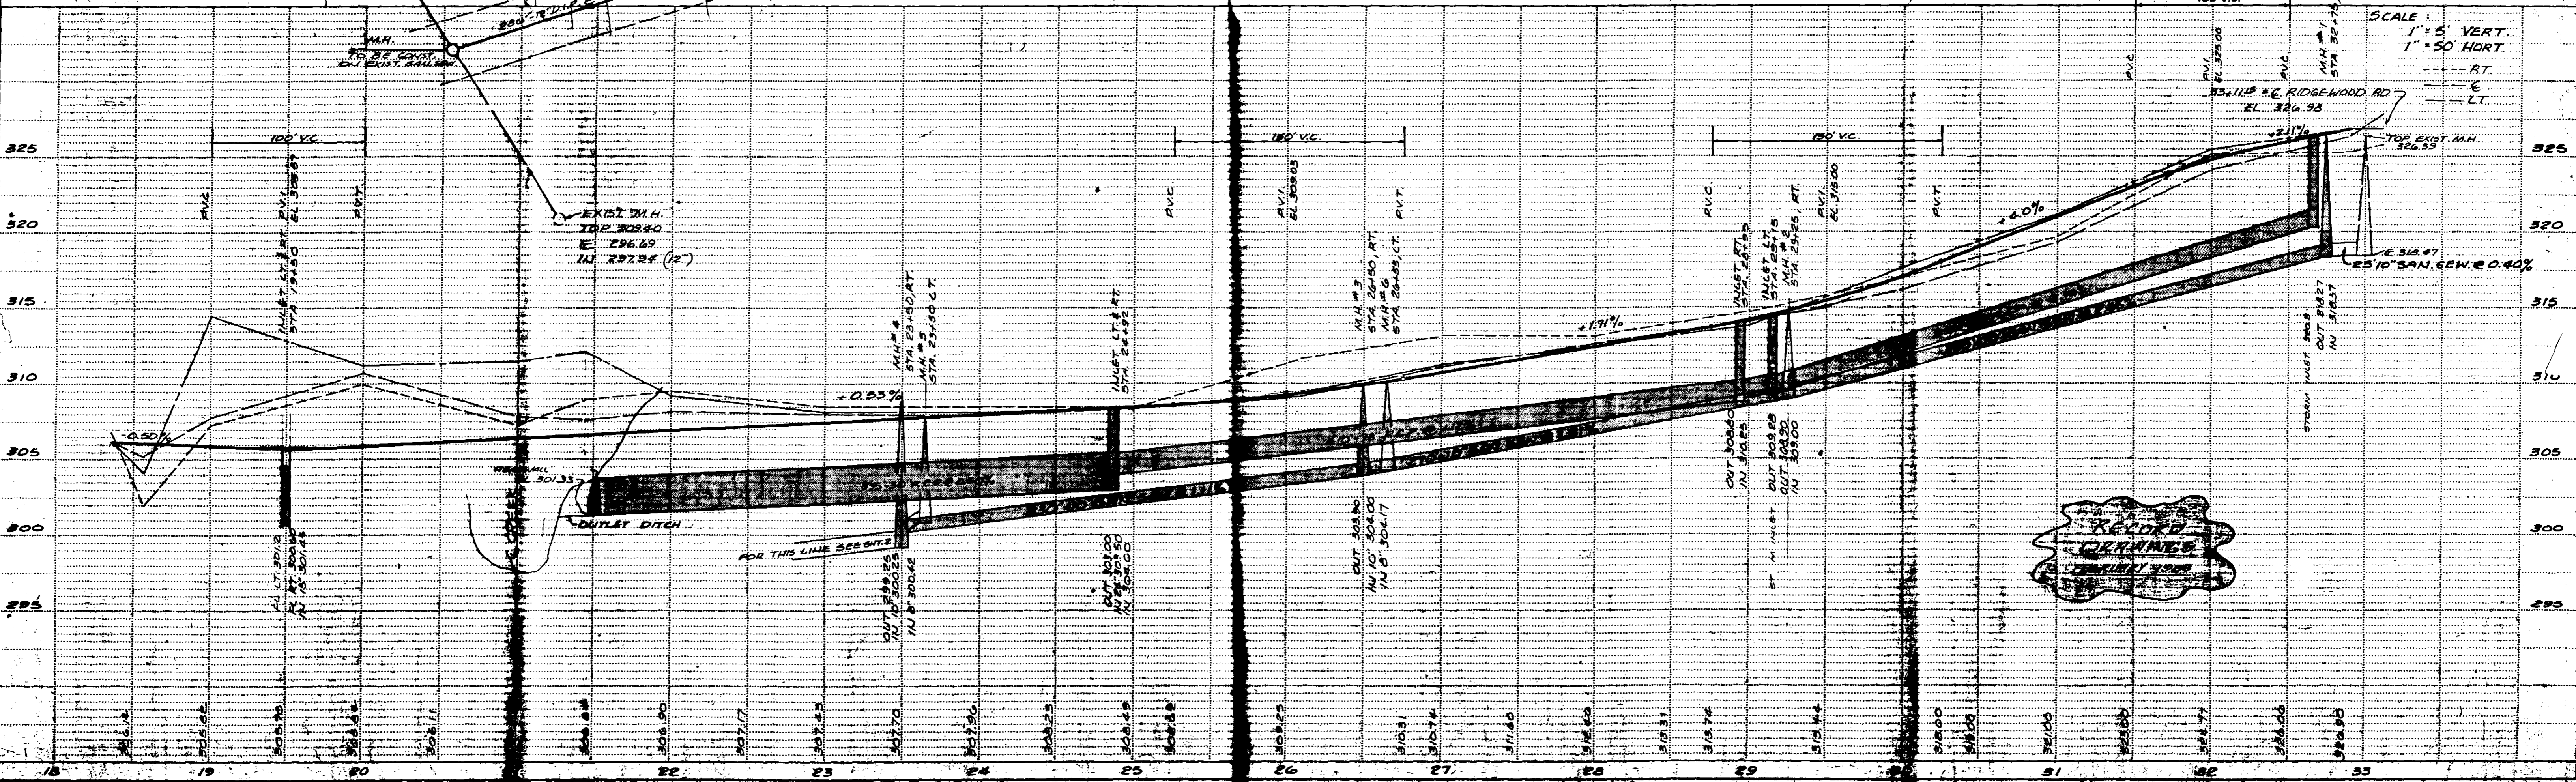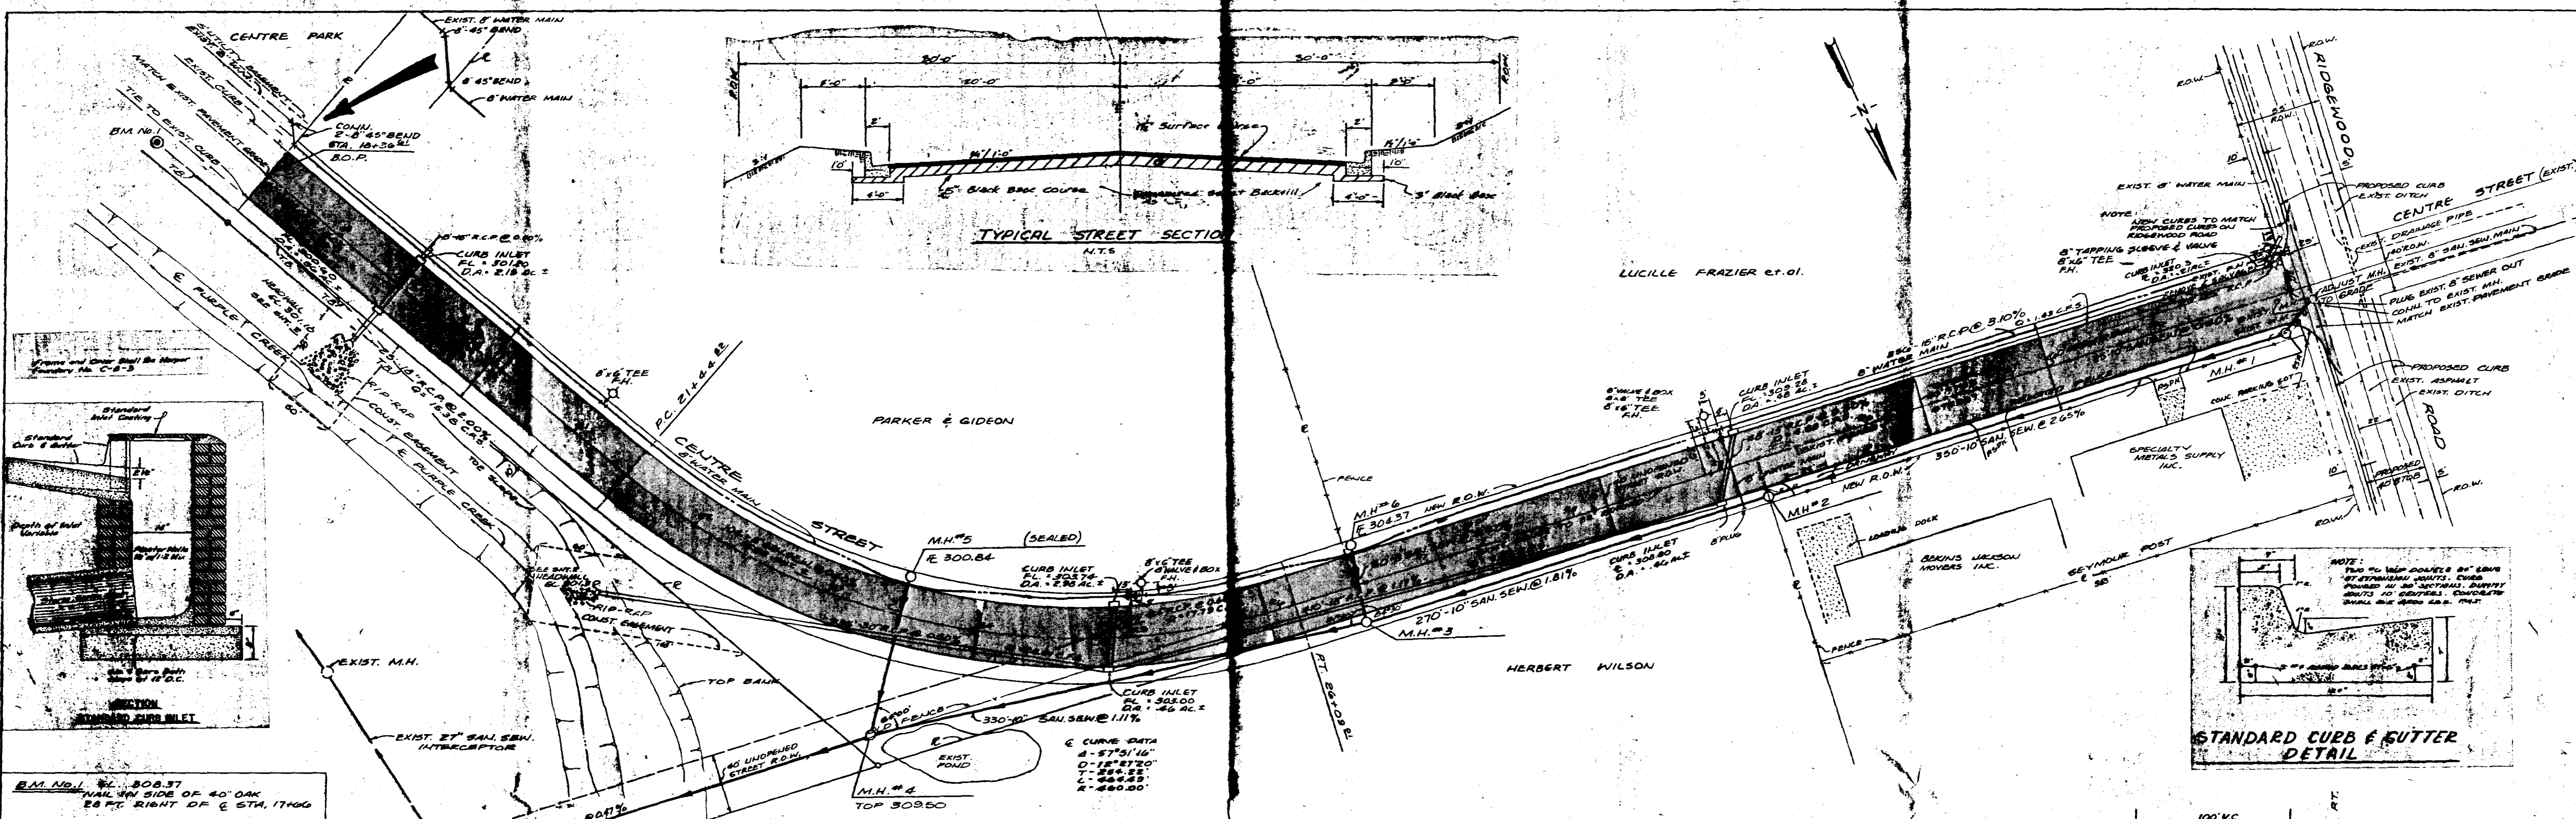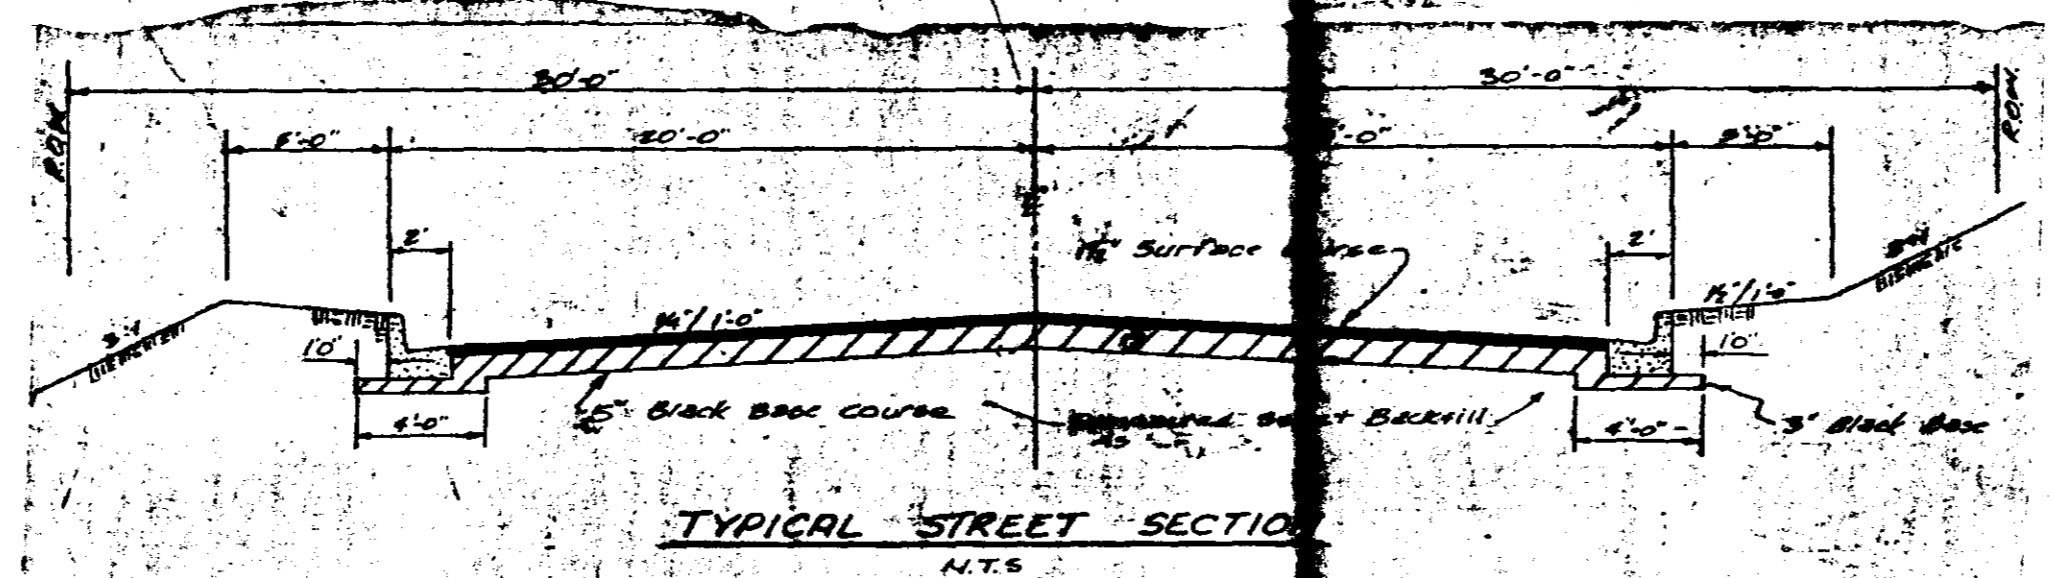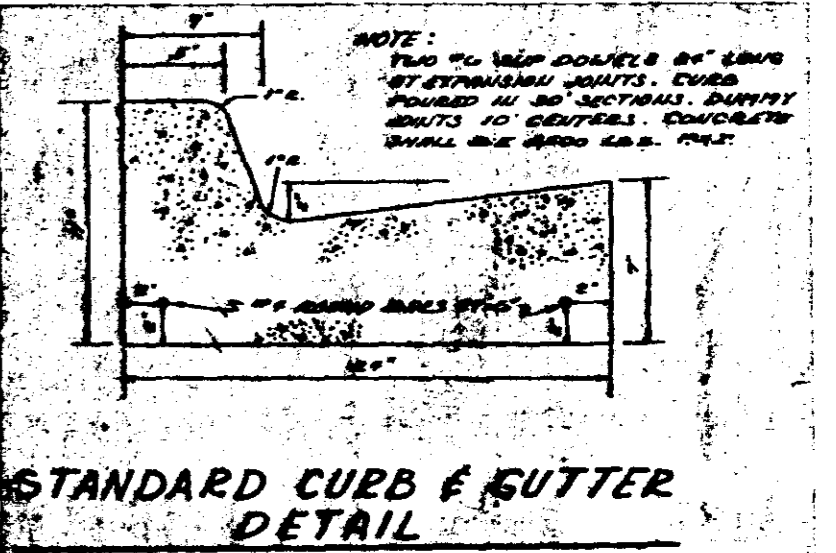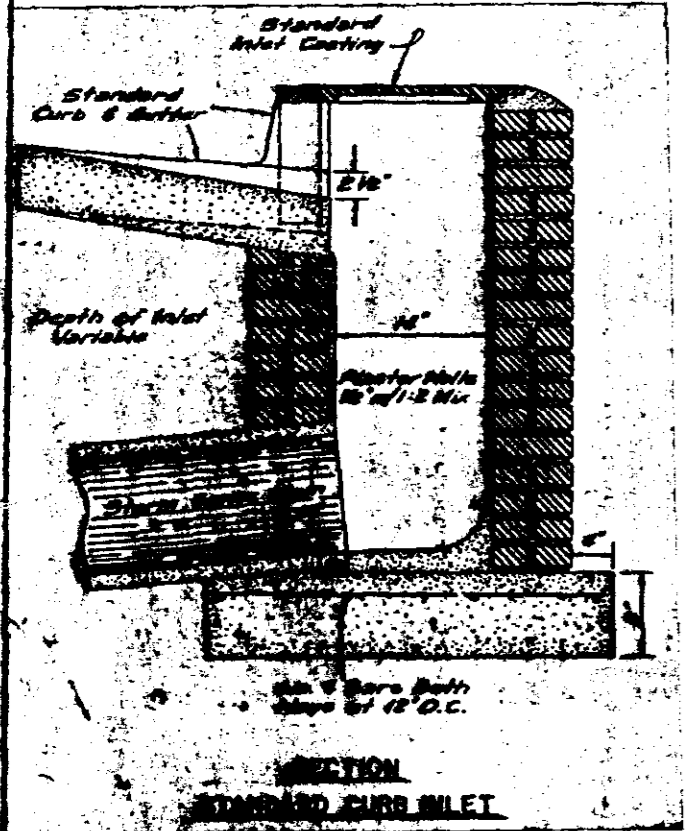

PROFILE  
 SURVEYED  
 GRADES CHECKED  
 M.F. 11/18/00  
 M.F. 11/18/00  
 STRUCTURE PROVIDED

PLATE 1 SINGLE PLAN  
 PROFILE



SPECIAL ASSESSMENT IMPROVEMENT No. 5

JOE A. WAGGONER  
 CIVIL ENGINEER




DATE: \_\_\_\_\_  
 BY: \_\_\_\_\_  
 SURVEYED: \_\_\_\_\_  
 PLOTTED: \_\_\_\_\_  
 CHECKED: \_\_\_\_\_  
 DATE: \_\_\_\_\_  
 NO. \_\_\_\_\_

DATE: \_\_\_\_\_  
 BY: \_\_\_\_\_  
 SURVEYED: \_\_\_\_\_  
 PLOTTED: \_\_\_\_\_  
 CHECKED: \_\_\_\_\_  
 DATE: \_\_\_\_\_  
 NO. \_\_\_\_\_

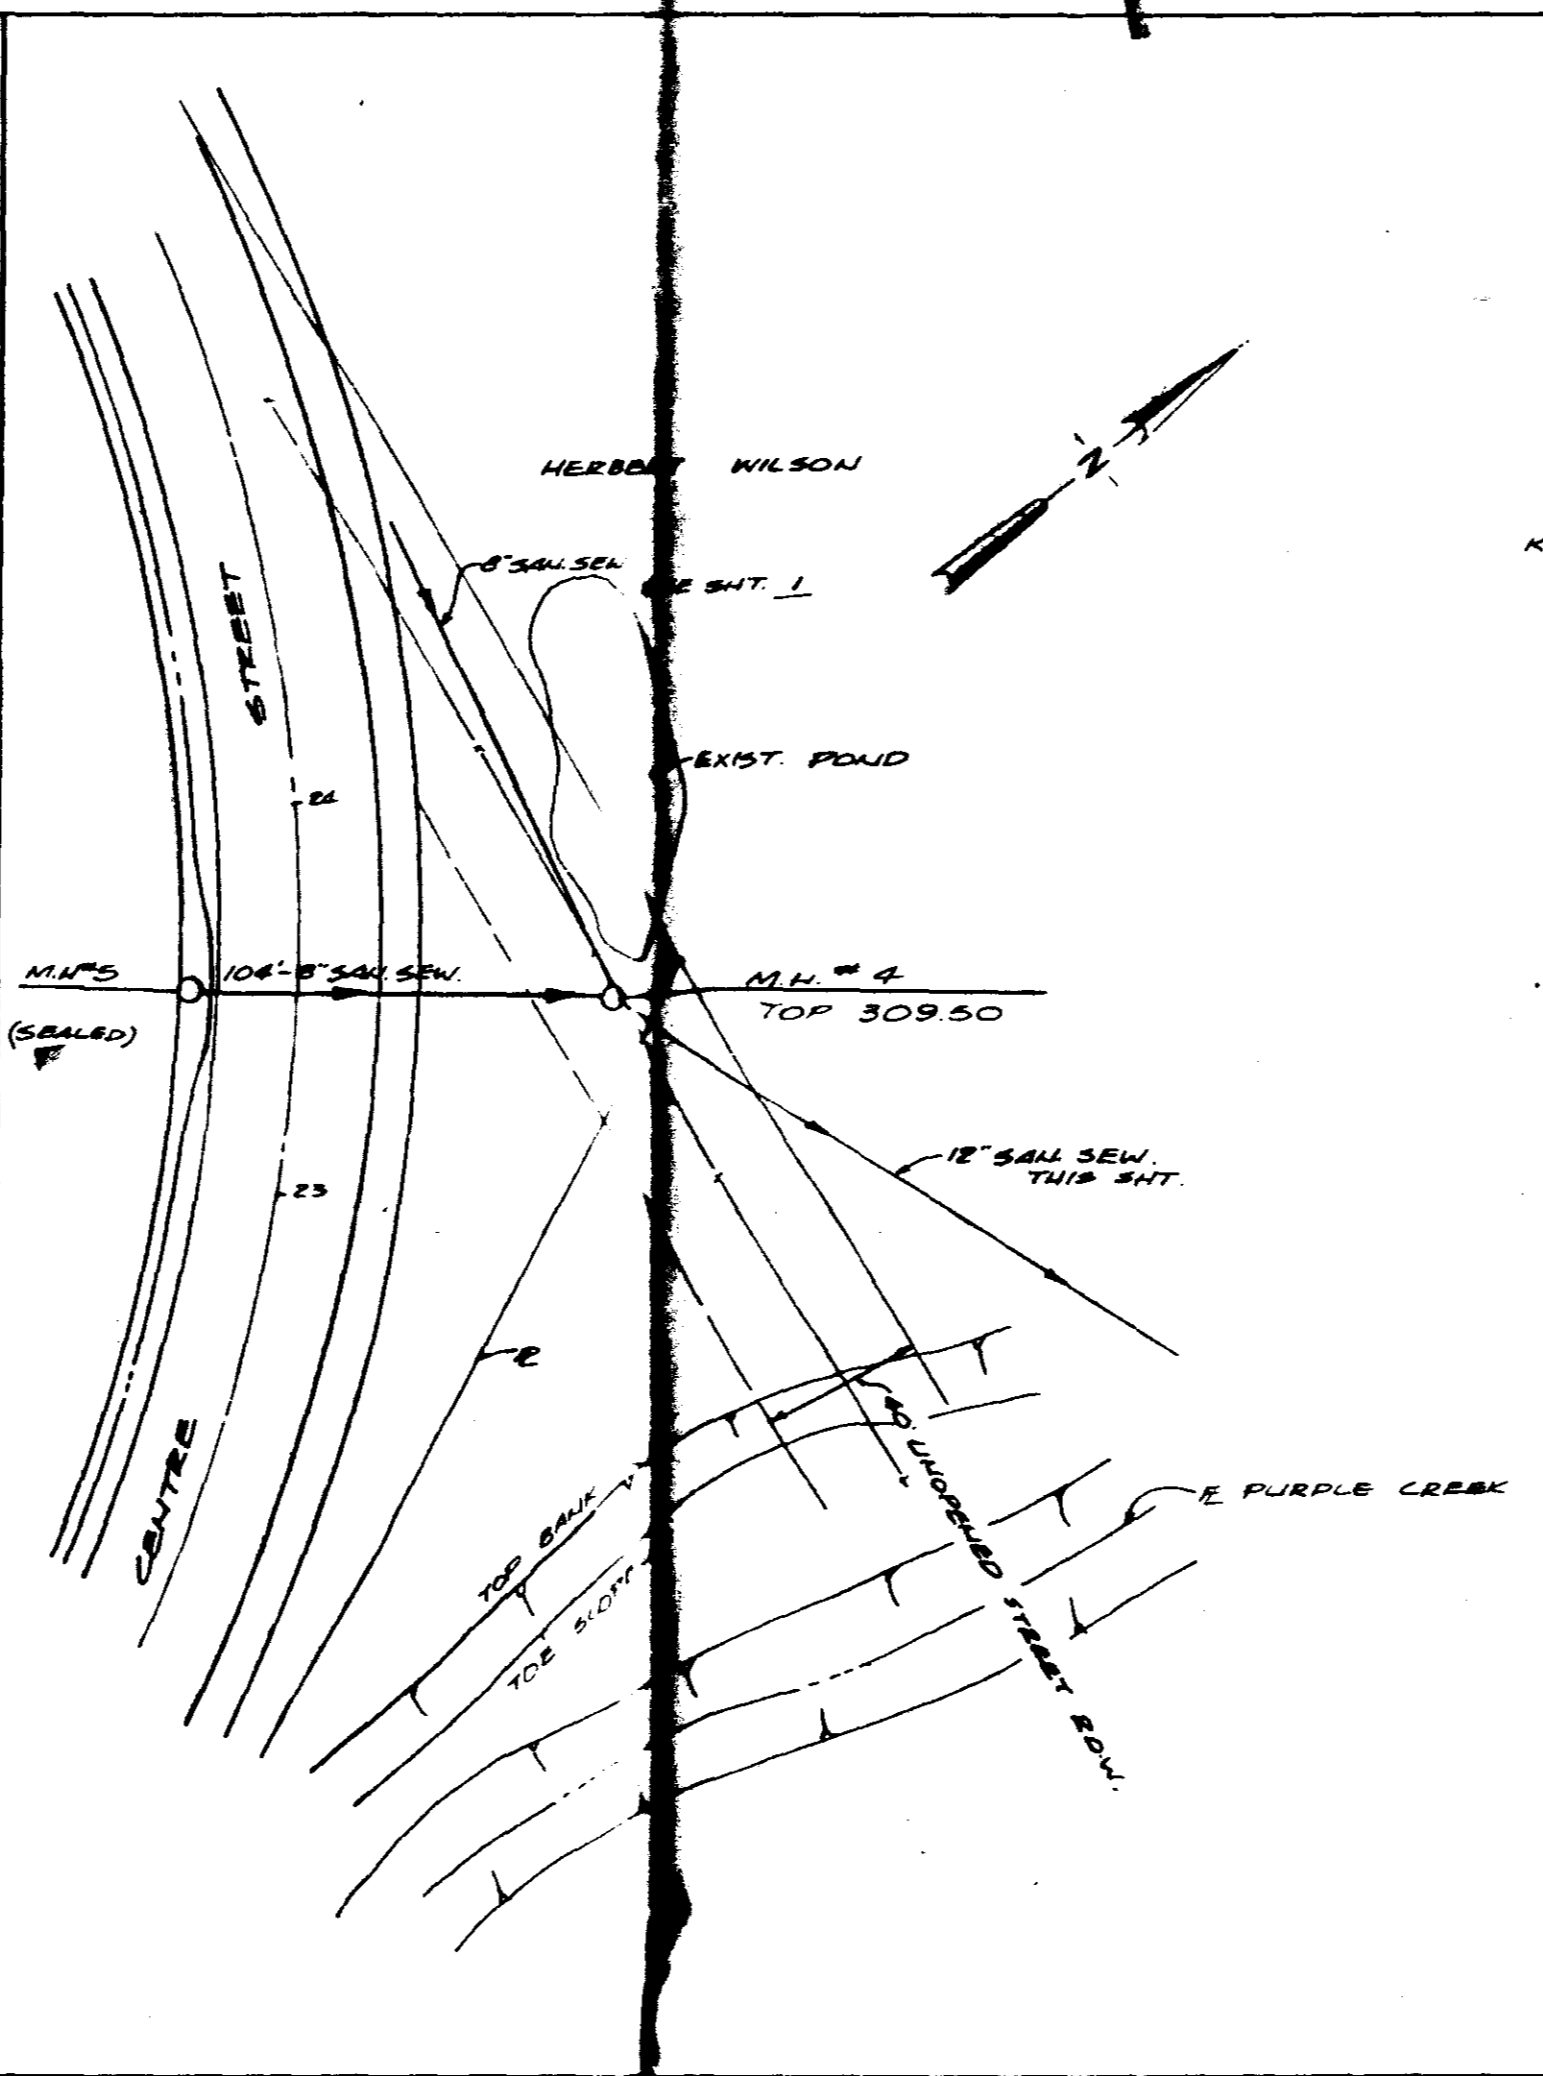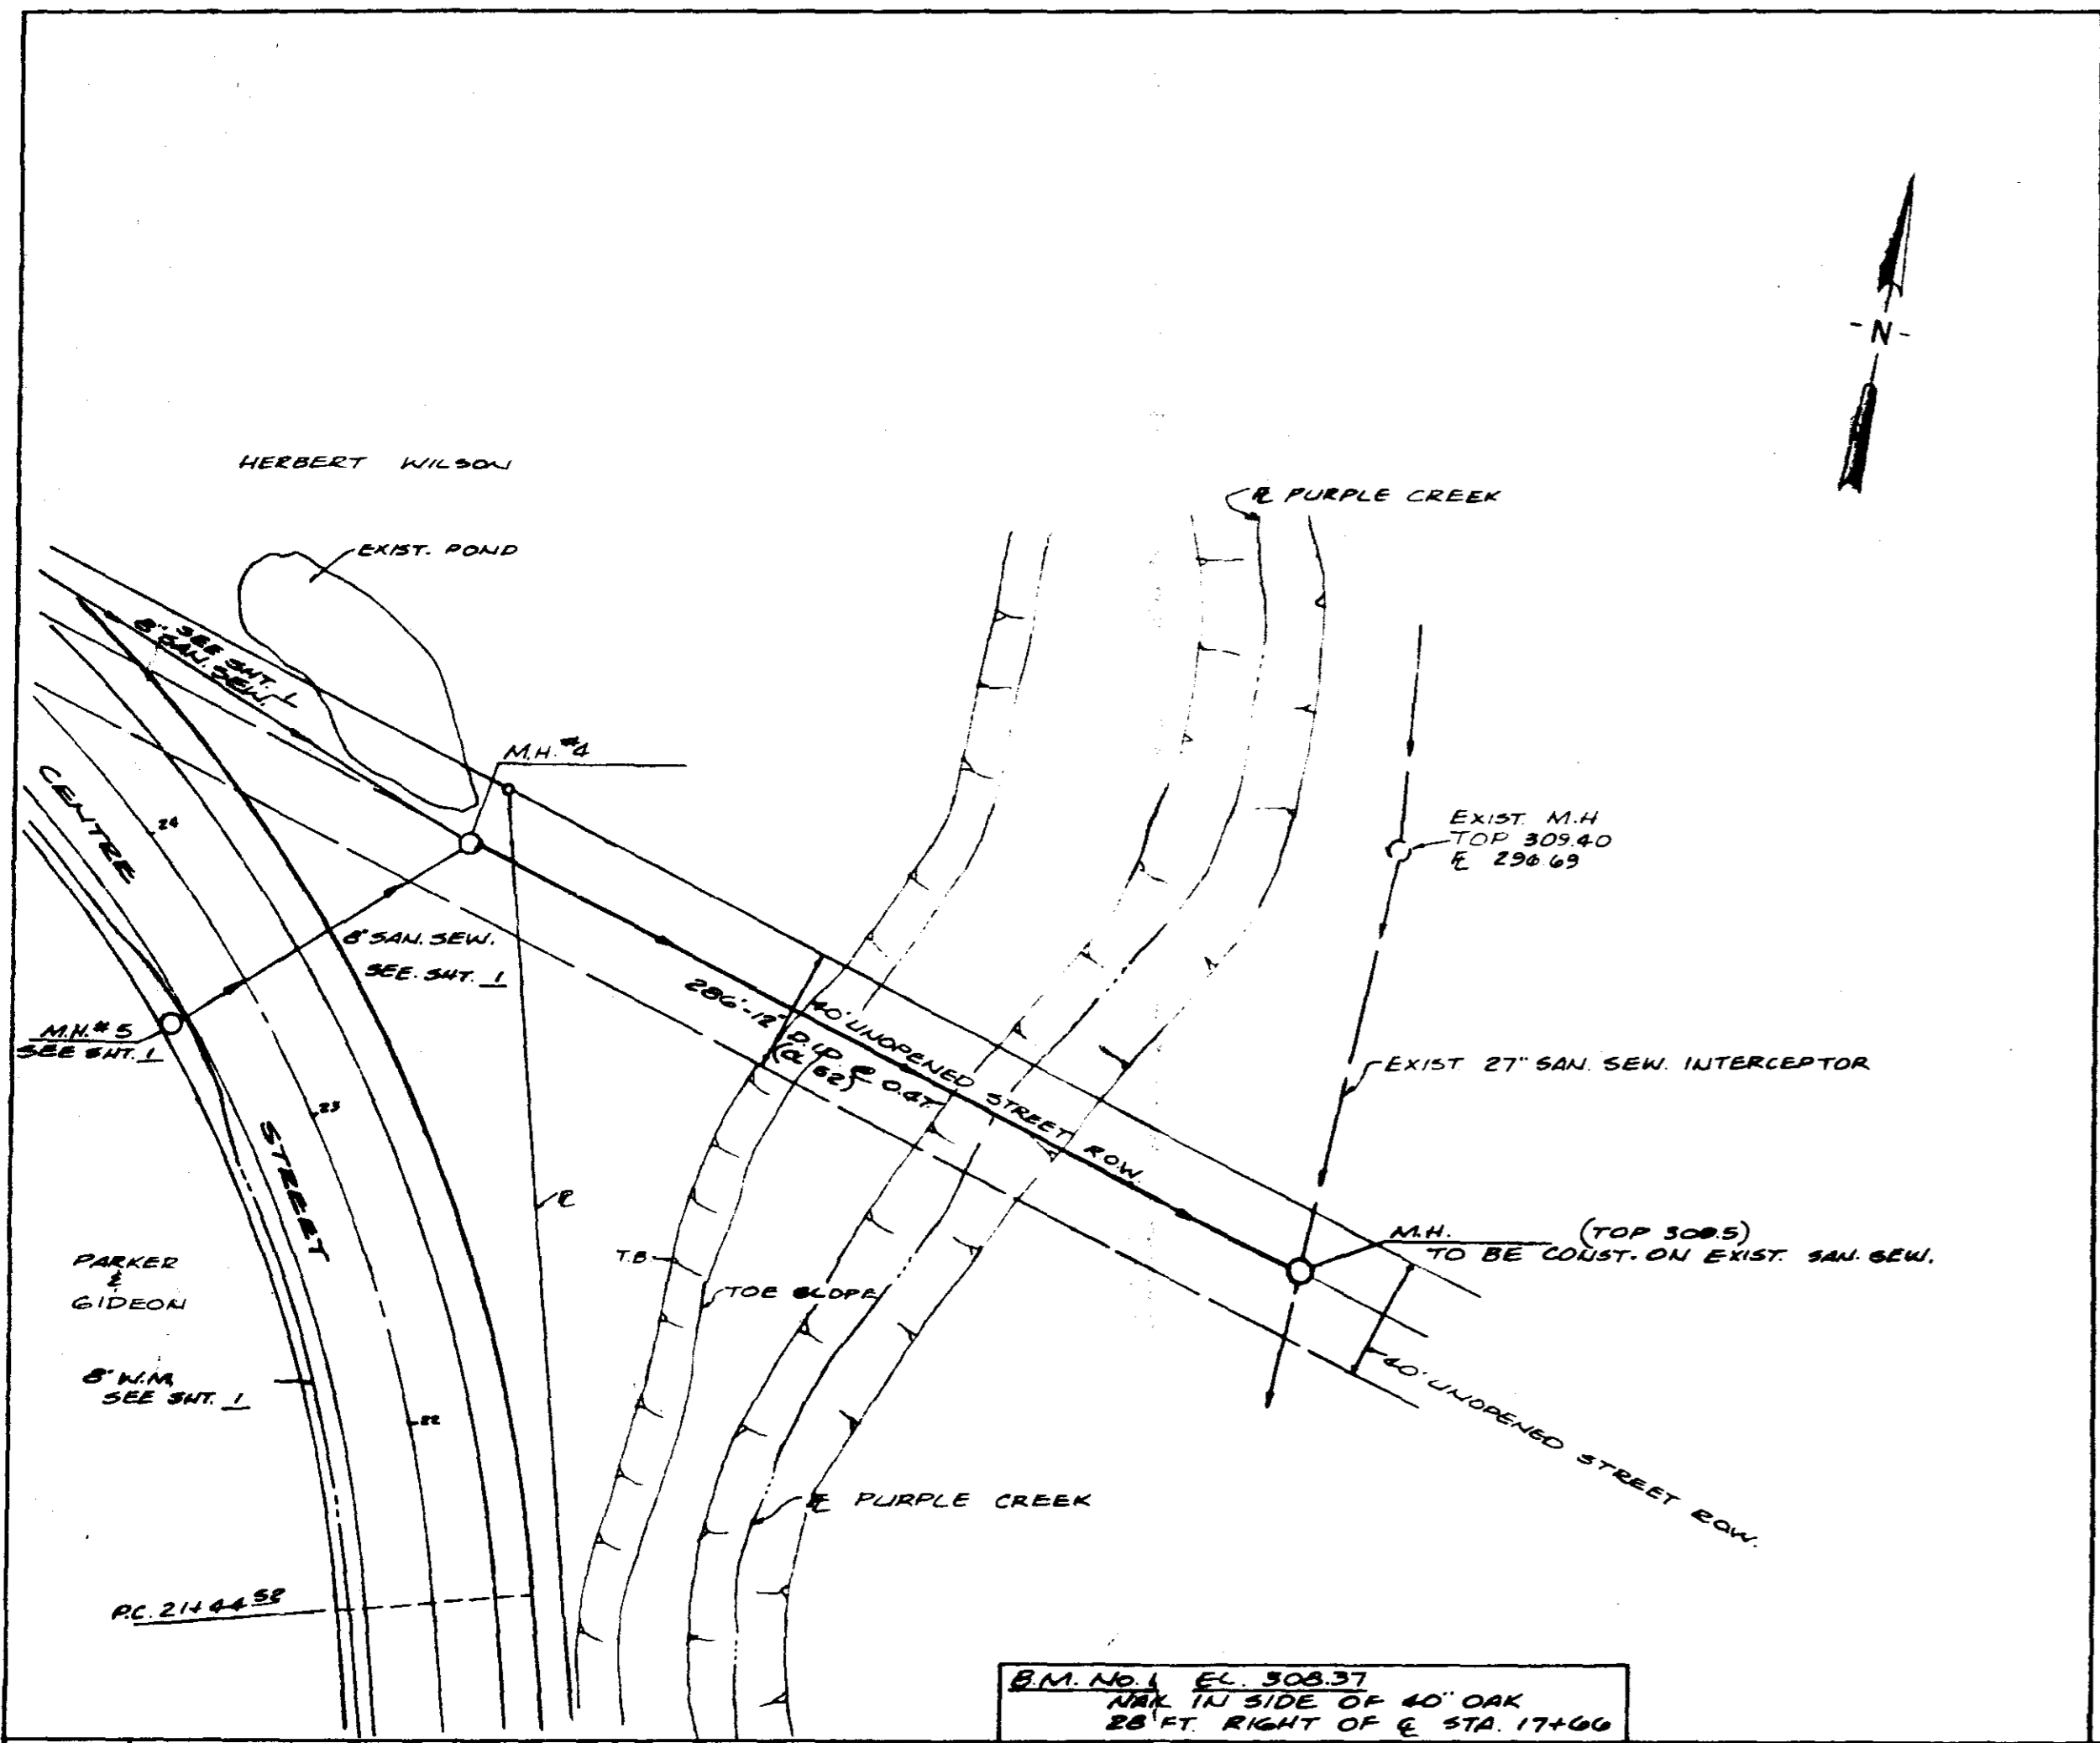

B.M. NO. 1 EL. 308.37  
 NAK IN SIDE OF 40' OAK  
 28' FT. RIGHT OF C. STA. 17+00

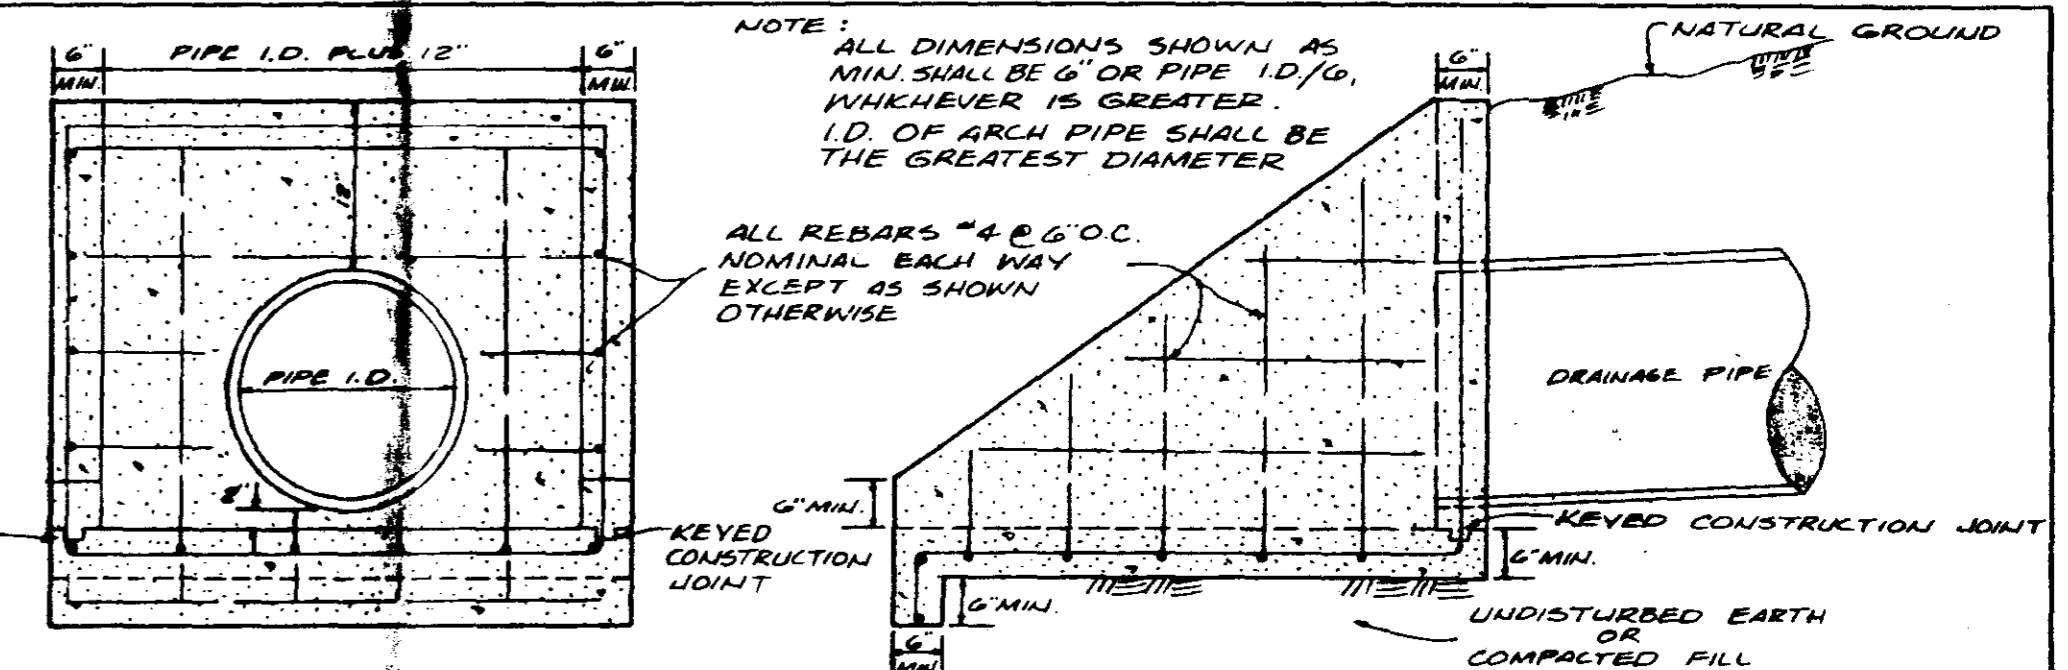

HEADWALL DETAIL  
 N.T.S.



RECORD  
 DRAWING  
 FEBRUARY 1988