
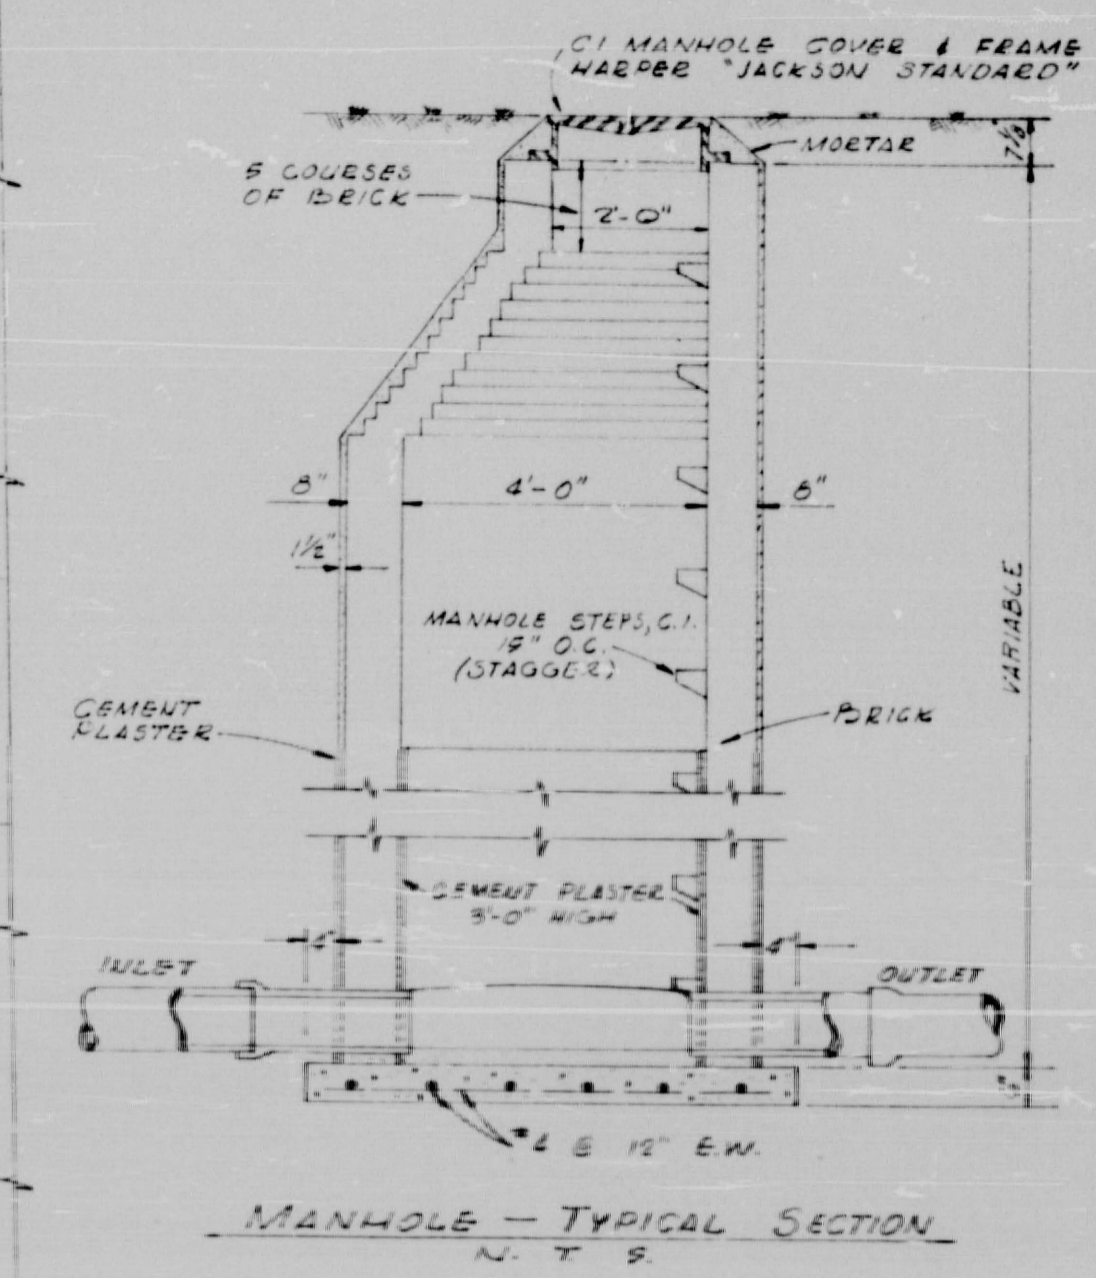



SCALE: 1" = 50' HORIZ.
1" = 5' VERT.

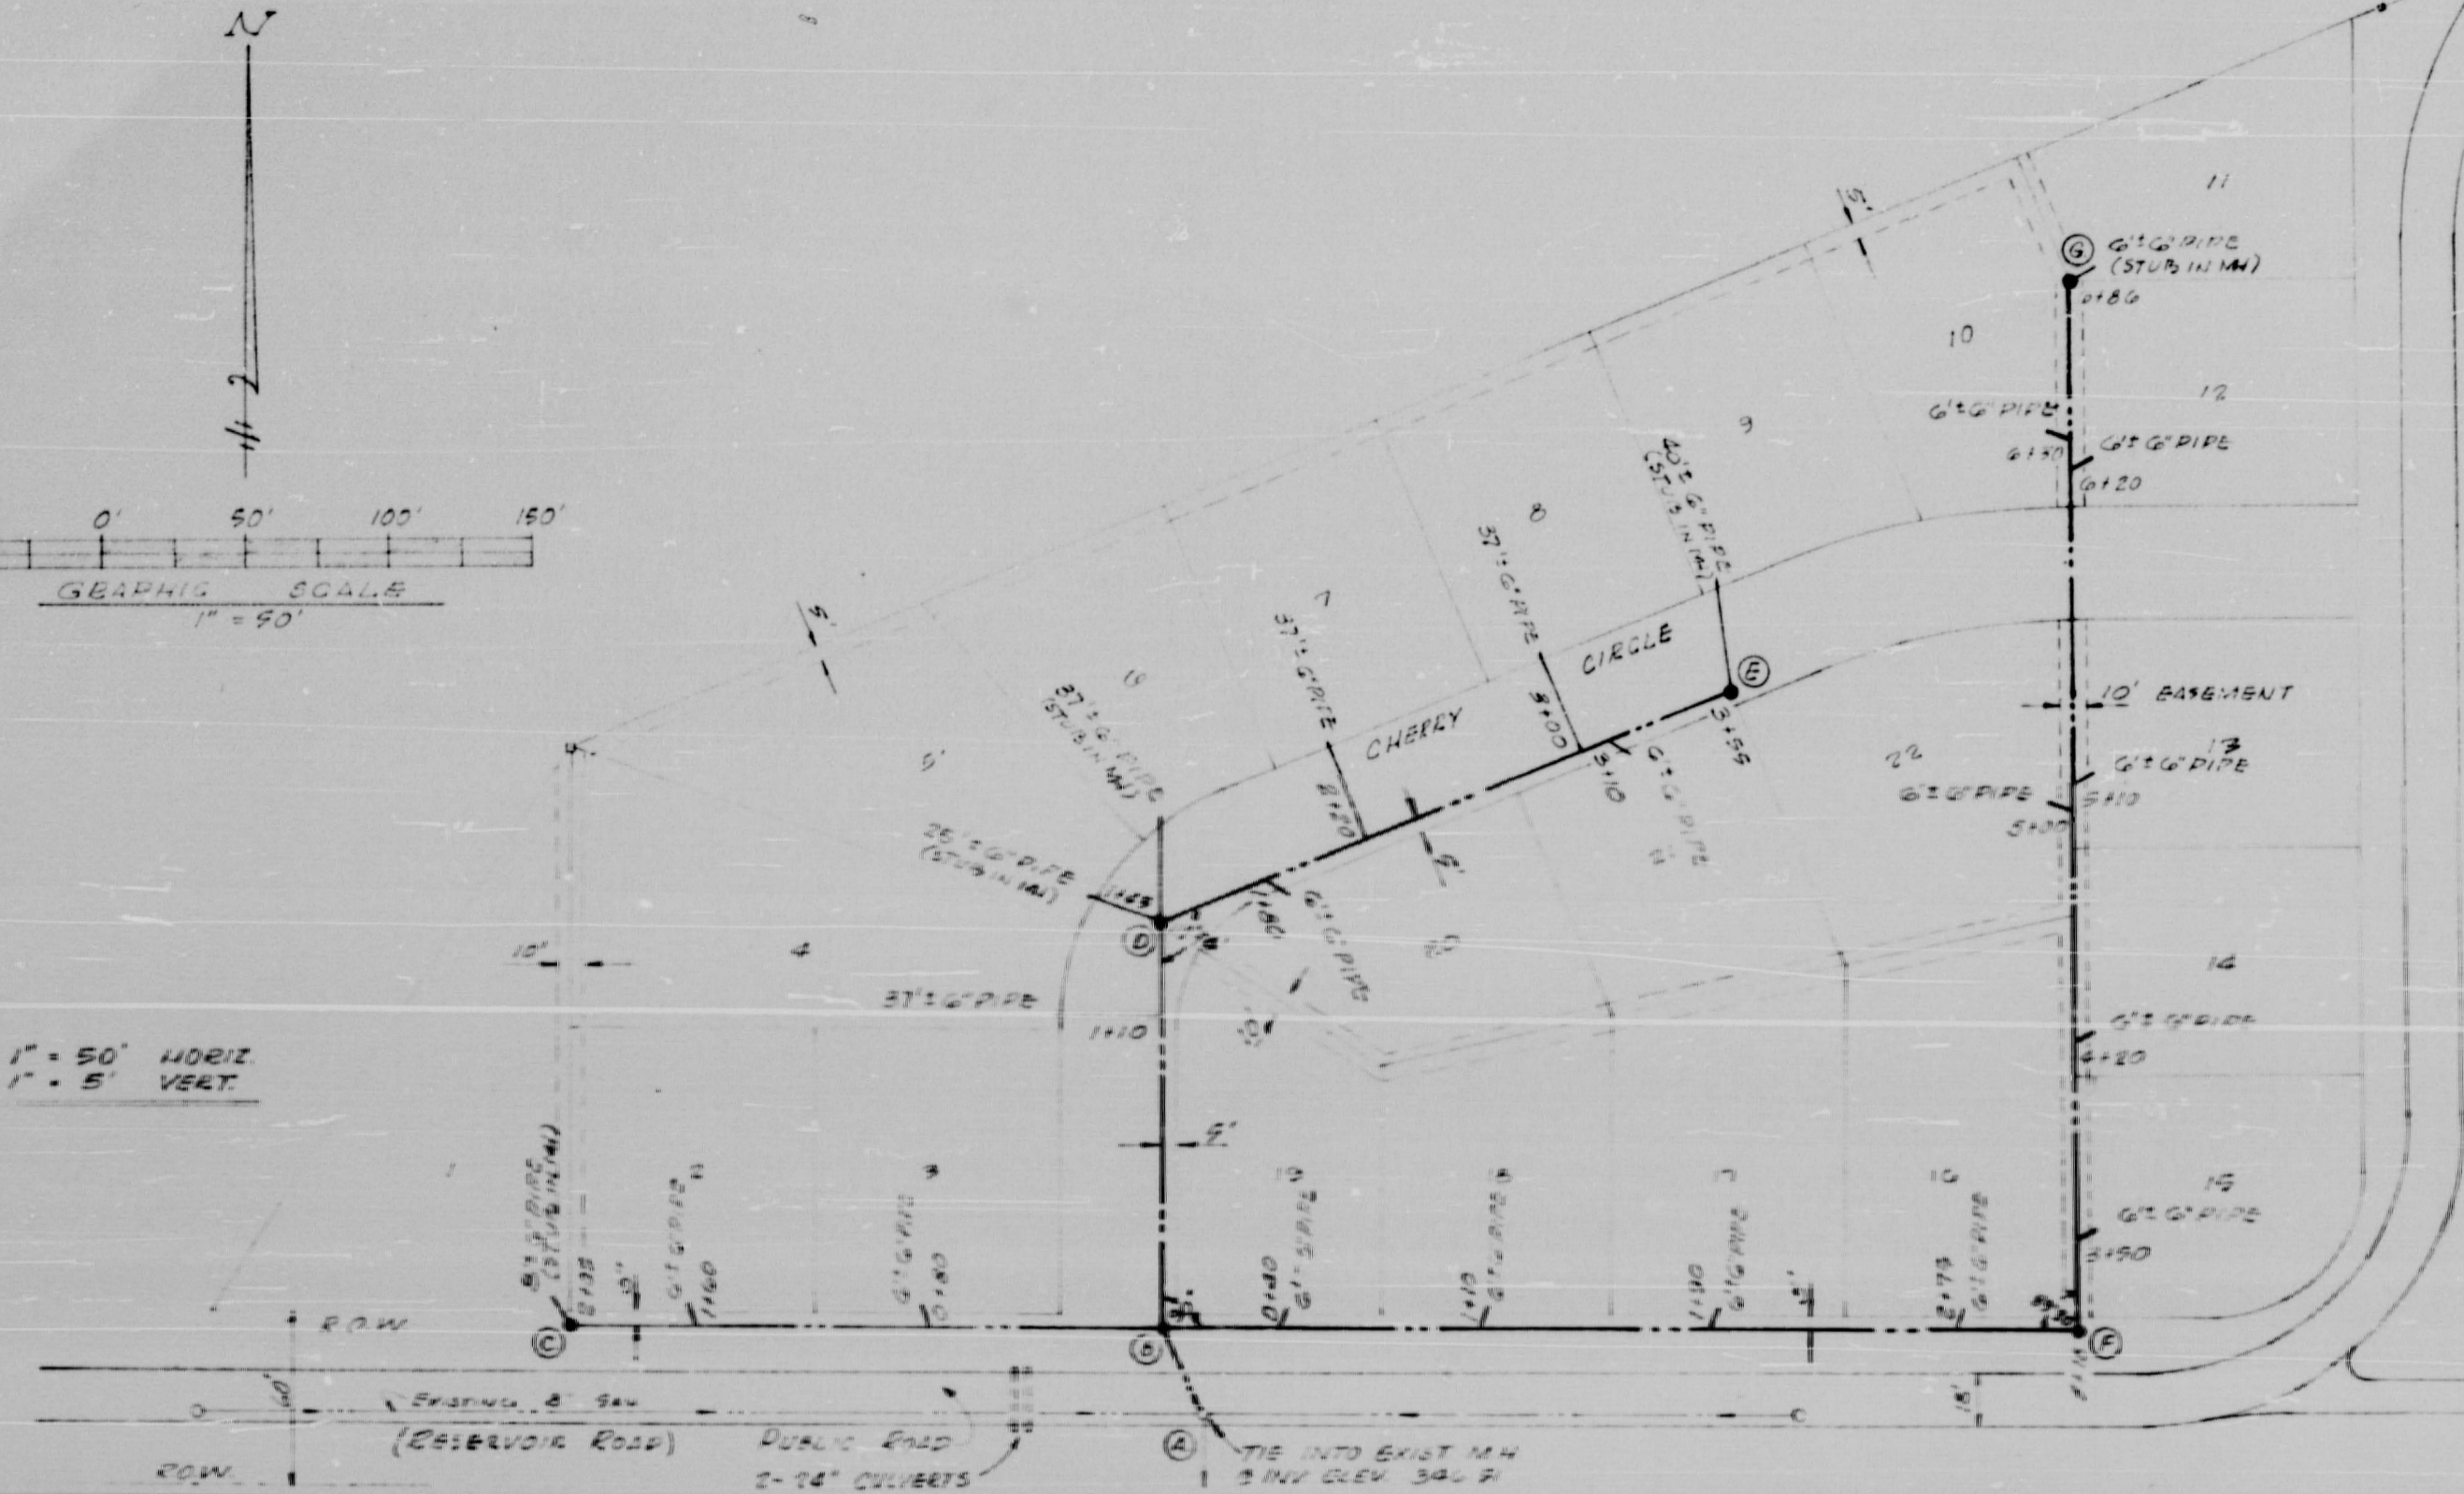

NOTE: CONTRACTOR SHALL PROTECT EXISTING WATER MAIN ALONG RESERVOIR ROAD.

MANHOLE - TYPICAL SECTION
N. T. S.

DATE: DECEMBER 4 1970

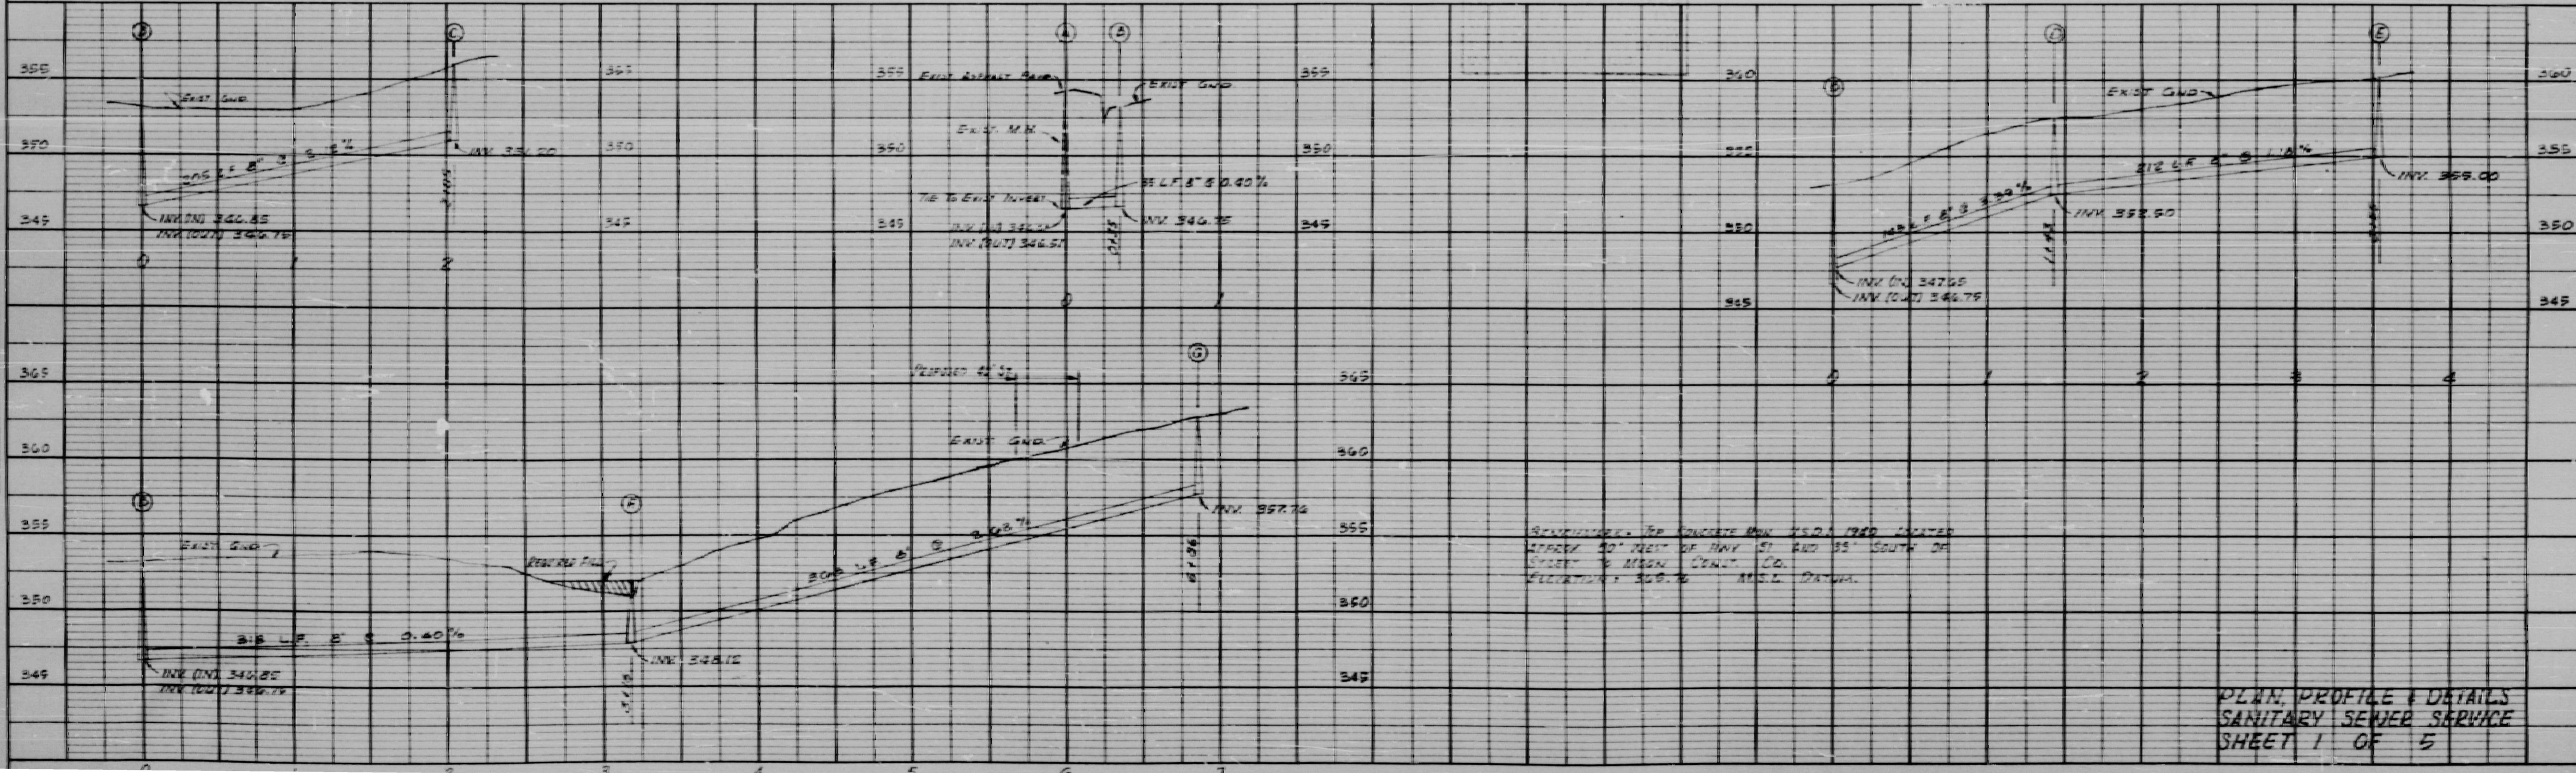

BENCHMARK: 10" CONCRETE MON. 15.01.1960 LOCATED APPROX 50' WEST OF HWY 51 AND 35' SOUTH OF STREET TO MORGAN CONCRETE CO. ELEVATION: 356.42 M.S.L. DRAWN.