
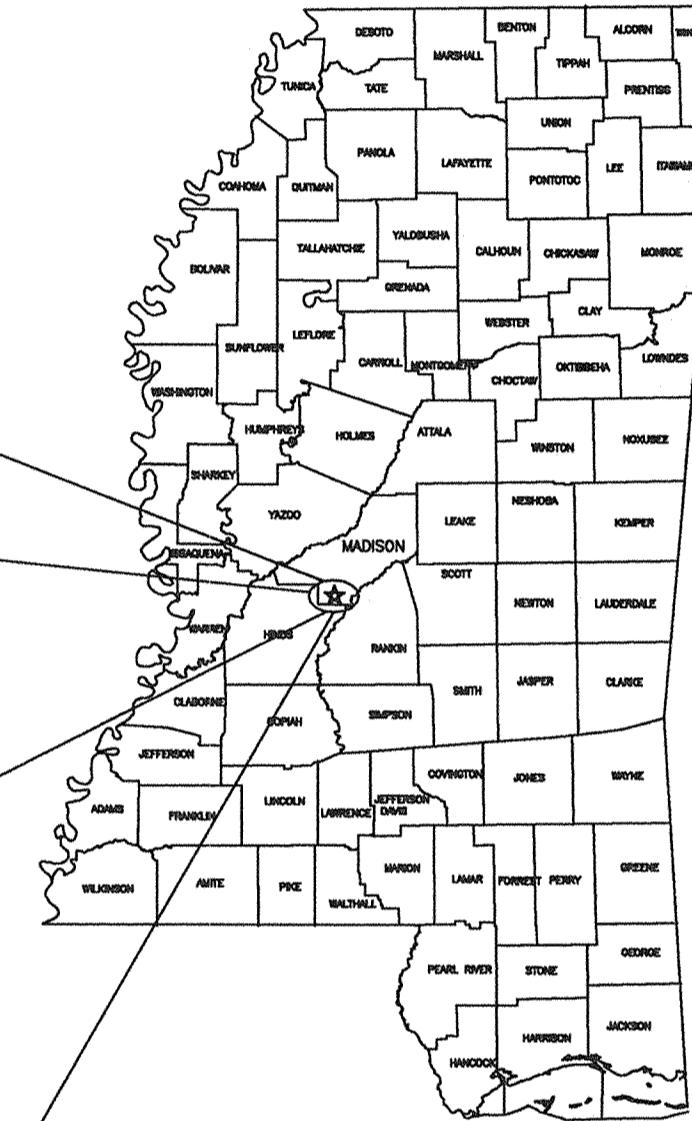


COLE ROAD WATER DISTRIBUTION IMPROVEMENTS PHASE "II" CITY OF RIDGELAND, MISSISSIPPI

INDEX TO DRAWINGS	
SHEET NO.	TITLE
G.1	COVER SHEET
G.2	VICINITY MAP & GENERAL NOTES
P1.0	PLAN VIEW SHEET
CD.1	CONSTRUCTION DETAILS
CD.2	CONSTRUCTION DETAILS

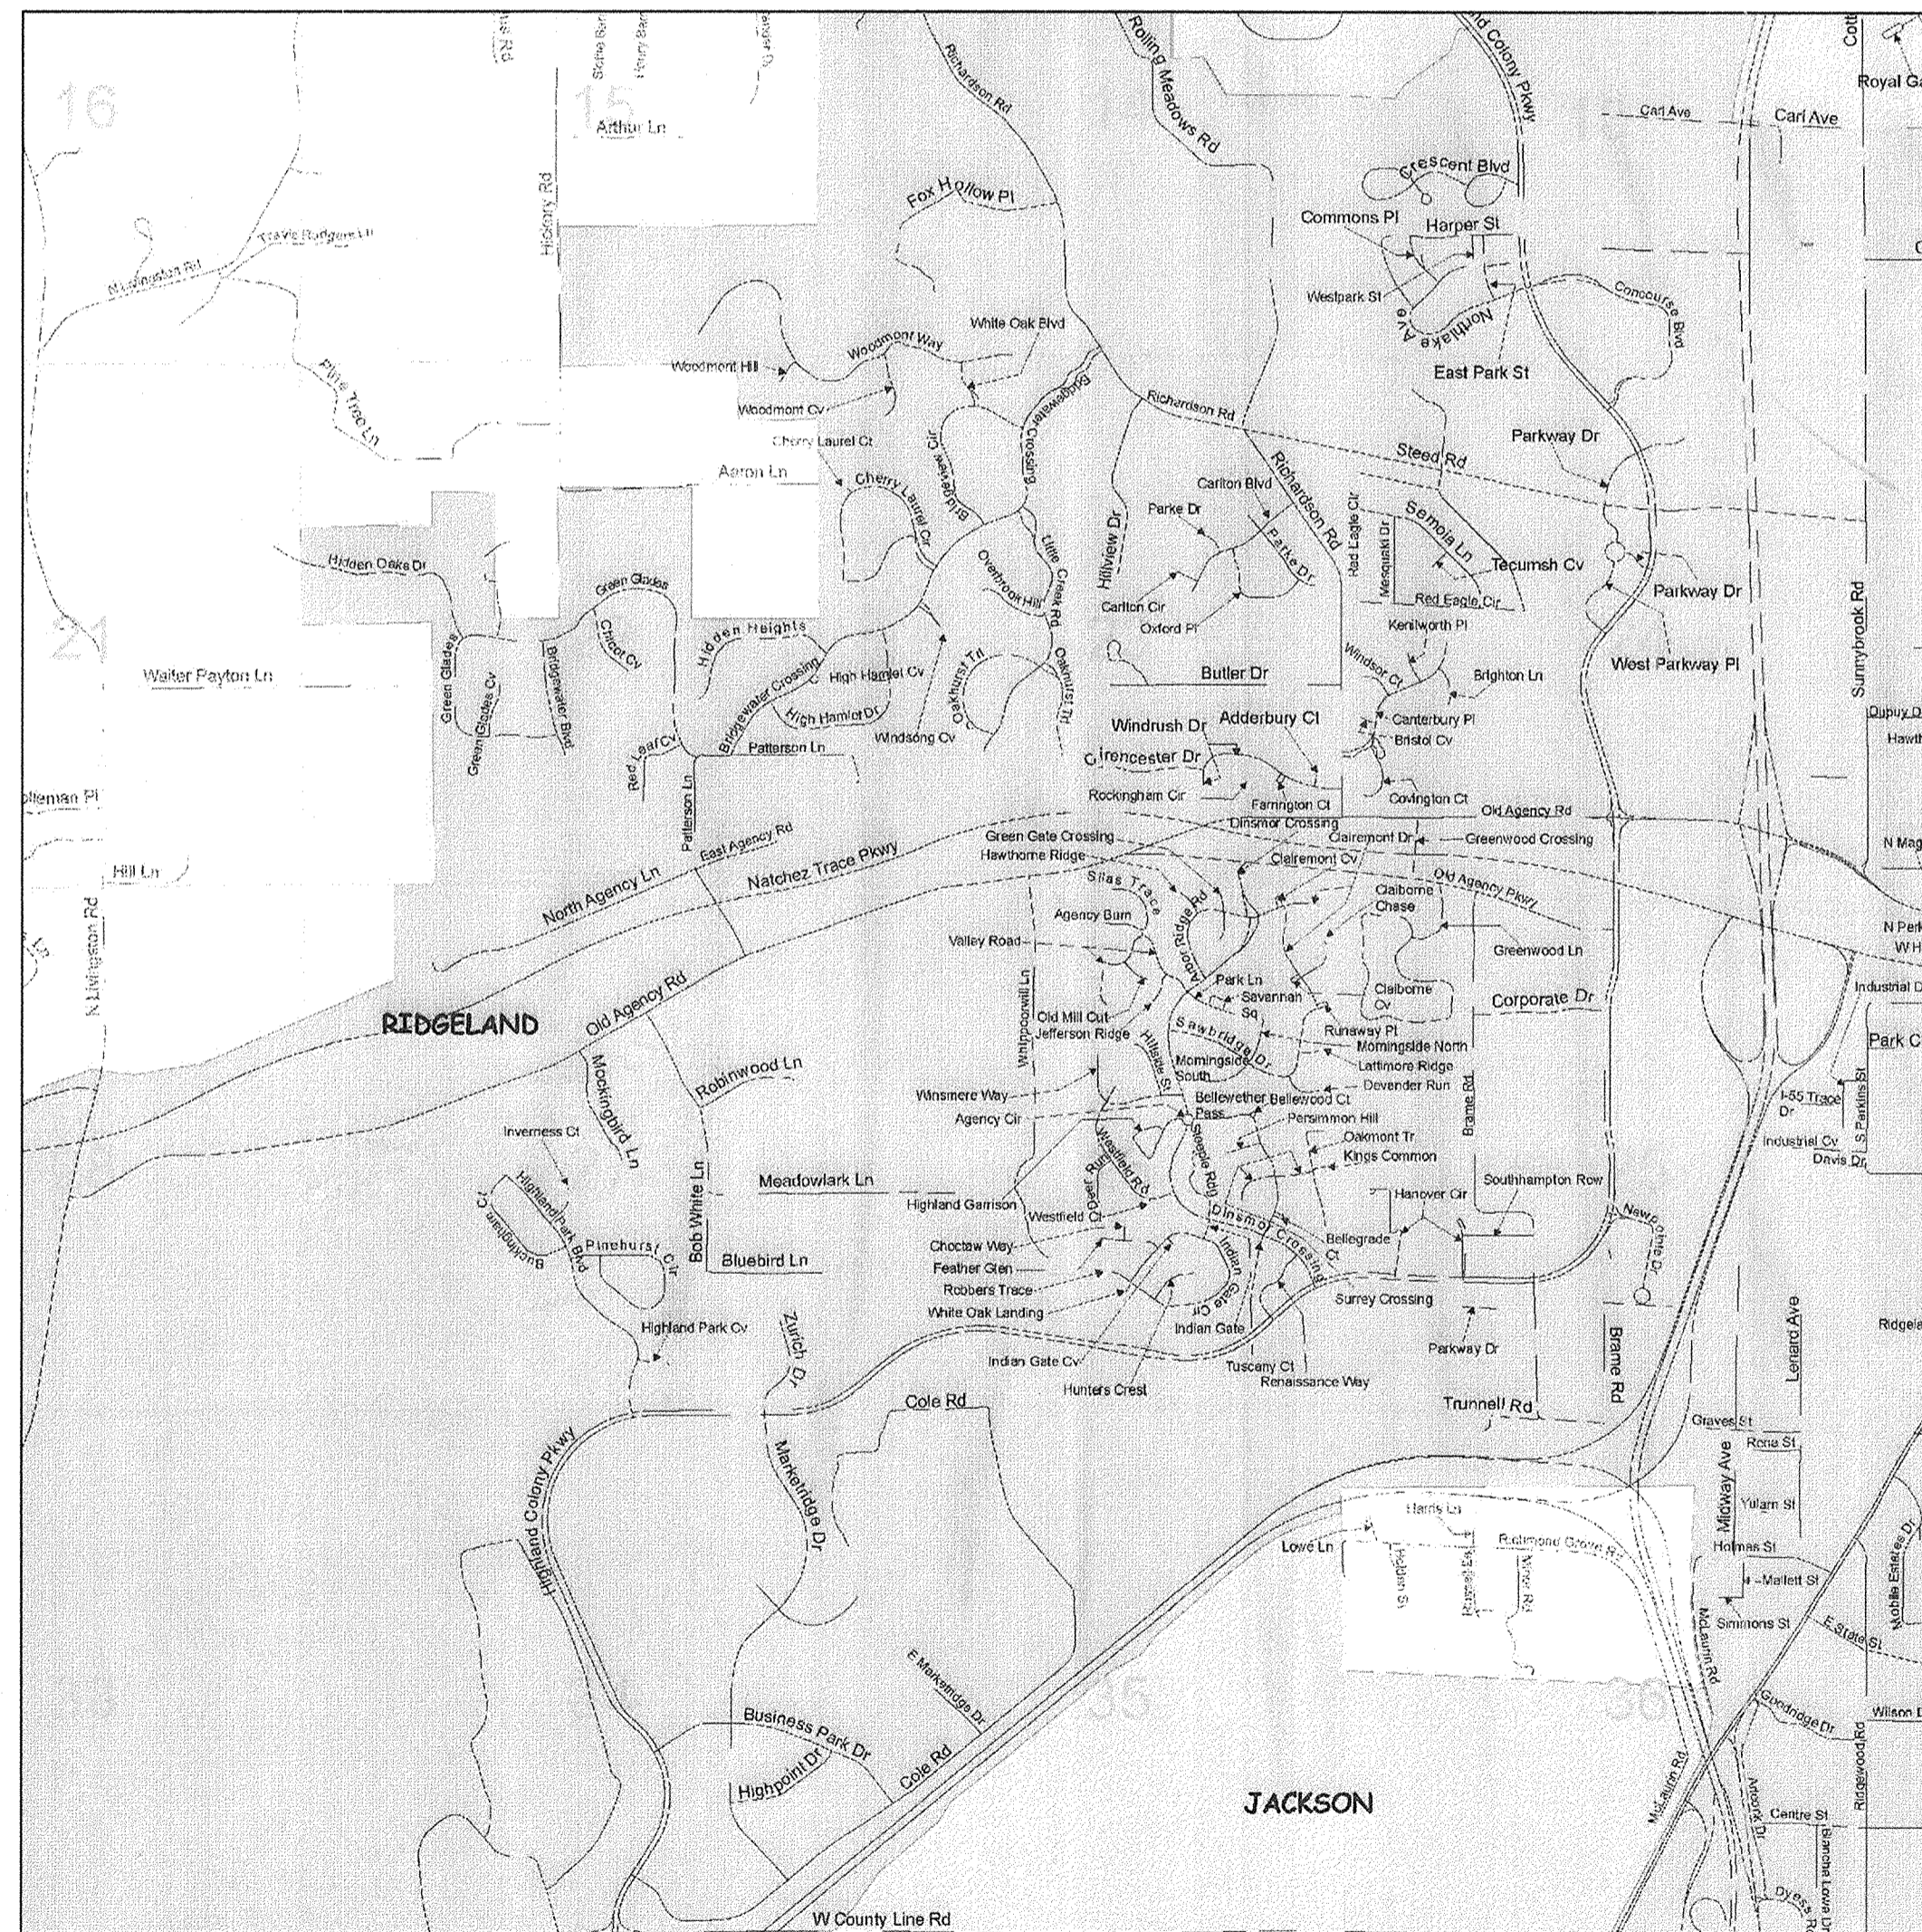

MAYOR:
GENE F. MCGEE


BOARD OF ALDERMAN:
GERALD STEEN, AT-LARGE
KEN HEARD, WARD 1
CHUCK GAUTIER, WARD 2
KEVIN HOLDER, WARD 3
BRIAN RAMSEY, WARD 4
SCOTT JONES, WARD 5
WESLEY HAMLIN, WARD 6

PUBLIC WORKS DIRECTOR:
MIKE McCOLLUM

VICINITY MAP
NOT TO SCALE
November 2009
WEI #: W08011

**COLE ROAD
WATER DISTRIBUTION IMPROVEMENTS
PHASE "II"
CITY OF RIDGELAND, MISSISSIPPI**

DRAWING REVISIONS		
NO.	REMARKS	DATE

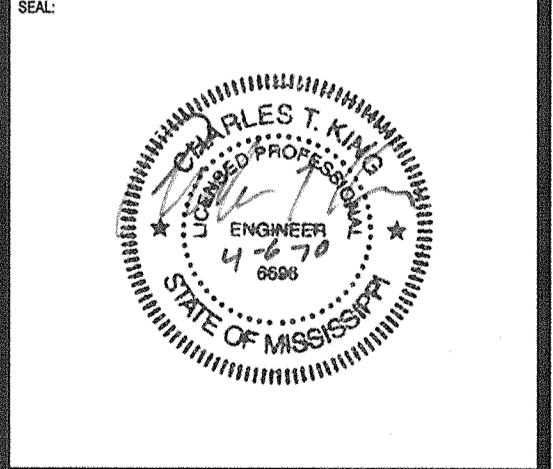

DRAWN BY:	CWB	SCALE:	N.T.S.
DESIGNED BY:	CTK	DATE:	November 2009
CHECKED BY:	CTK	PROJECT:	W08011

Cover Sheet

G.1

