

CITY OF RIDGELAND  
MADISON COUNTY, MS

WIDENING OF EAST  
COUNTY LINE ROAD

STP-7305-00(003)

RIDGELAND CITY OFFICIALS

MAYOR

GENE F. McGEE

BOARD OF ALDERMEN

- KEN HEARD, WARD 1
- CHUCK GAUTIER, WARD 2
- MIKE CROOK, WARD 3
- LARRY ROBERTS, WARD 4
- SCOTT JONES, WARD 5
- LINDA DAVIS TRUNZLER, WARD 6
- GERALD STEEN, AT-LARGE

CITY ATTORNEY

JERRY MILLS

DIRECTOR OF PUBLIC WORKS


MIKE McCOLLUM

ASST. DIRECTOR OF PUBLIC WORKS

BEN MAYS

CITY ENGINEER

DAVID E. WILLIAMS, P.E.

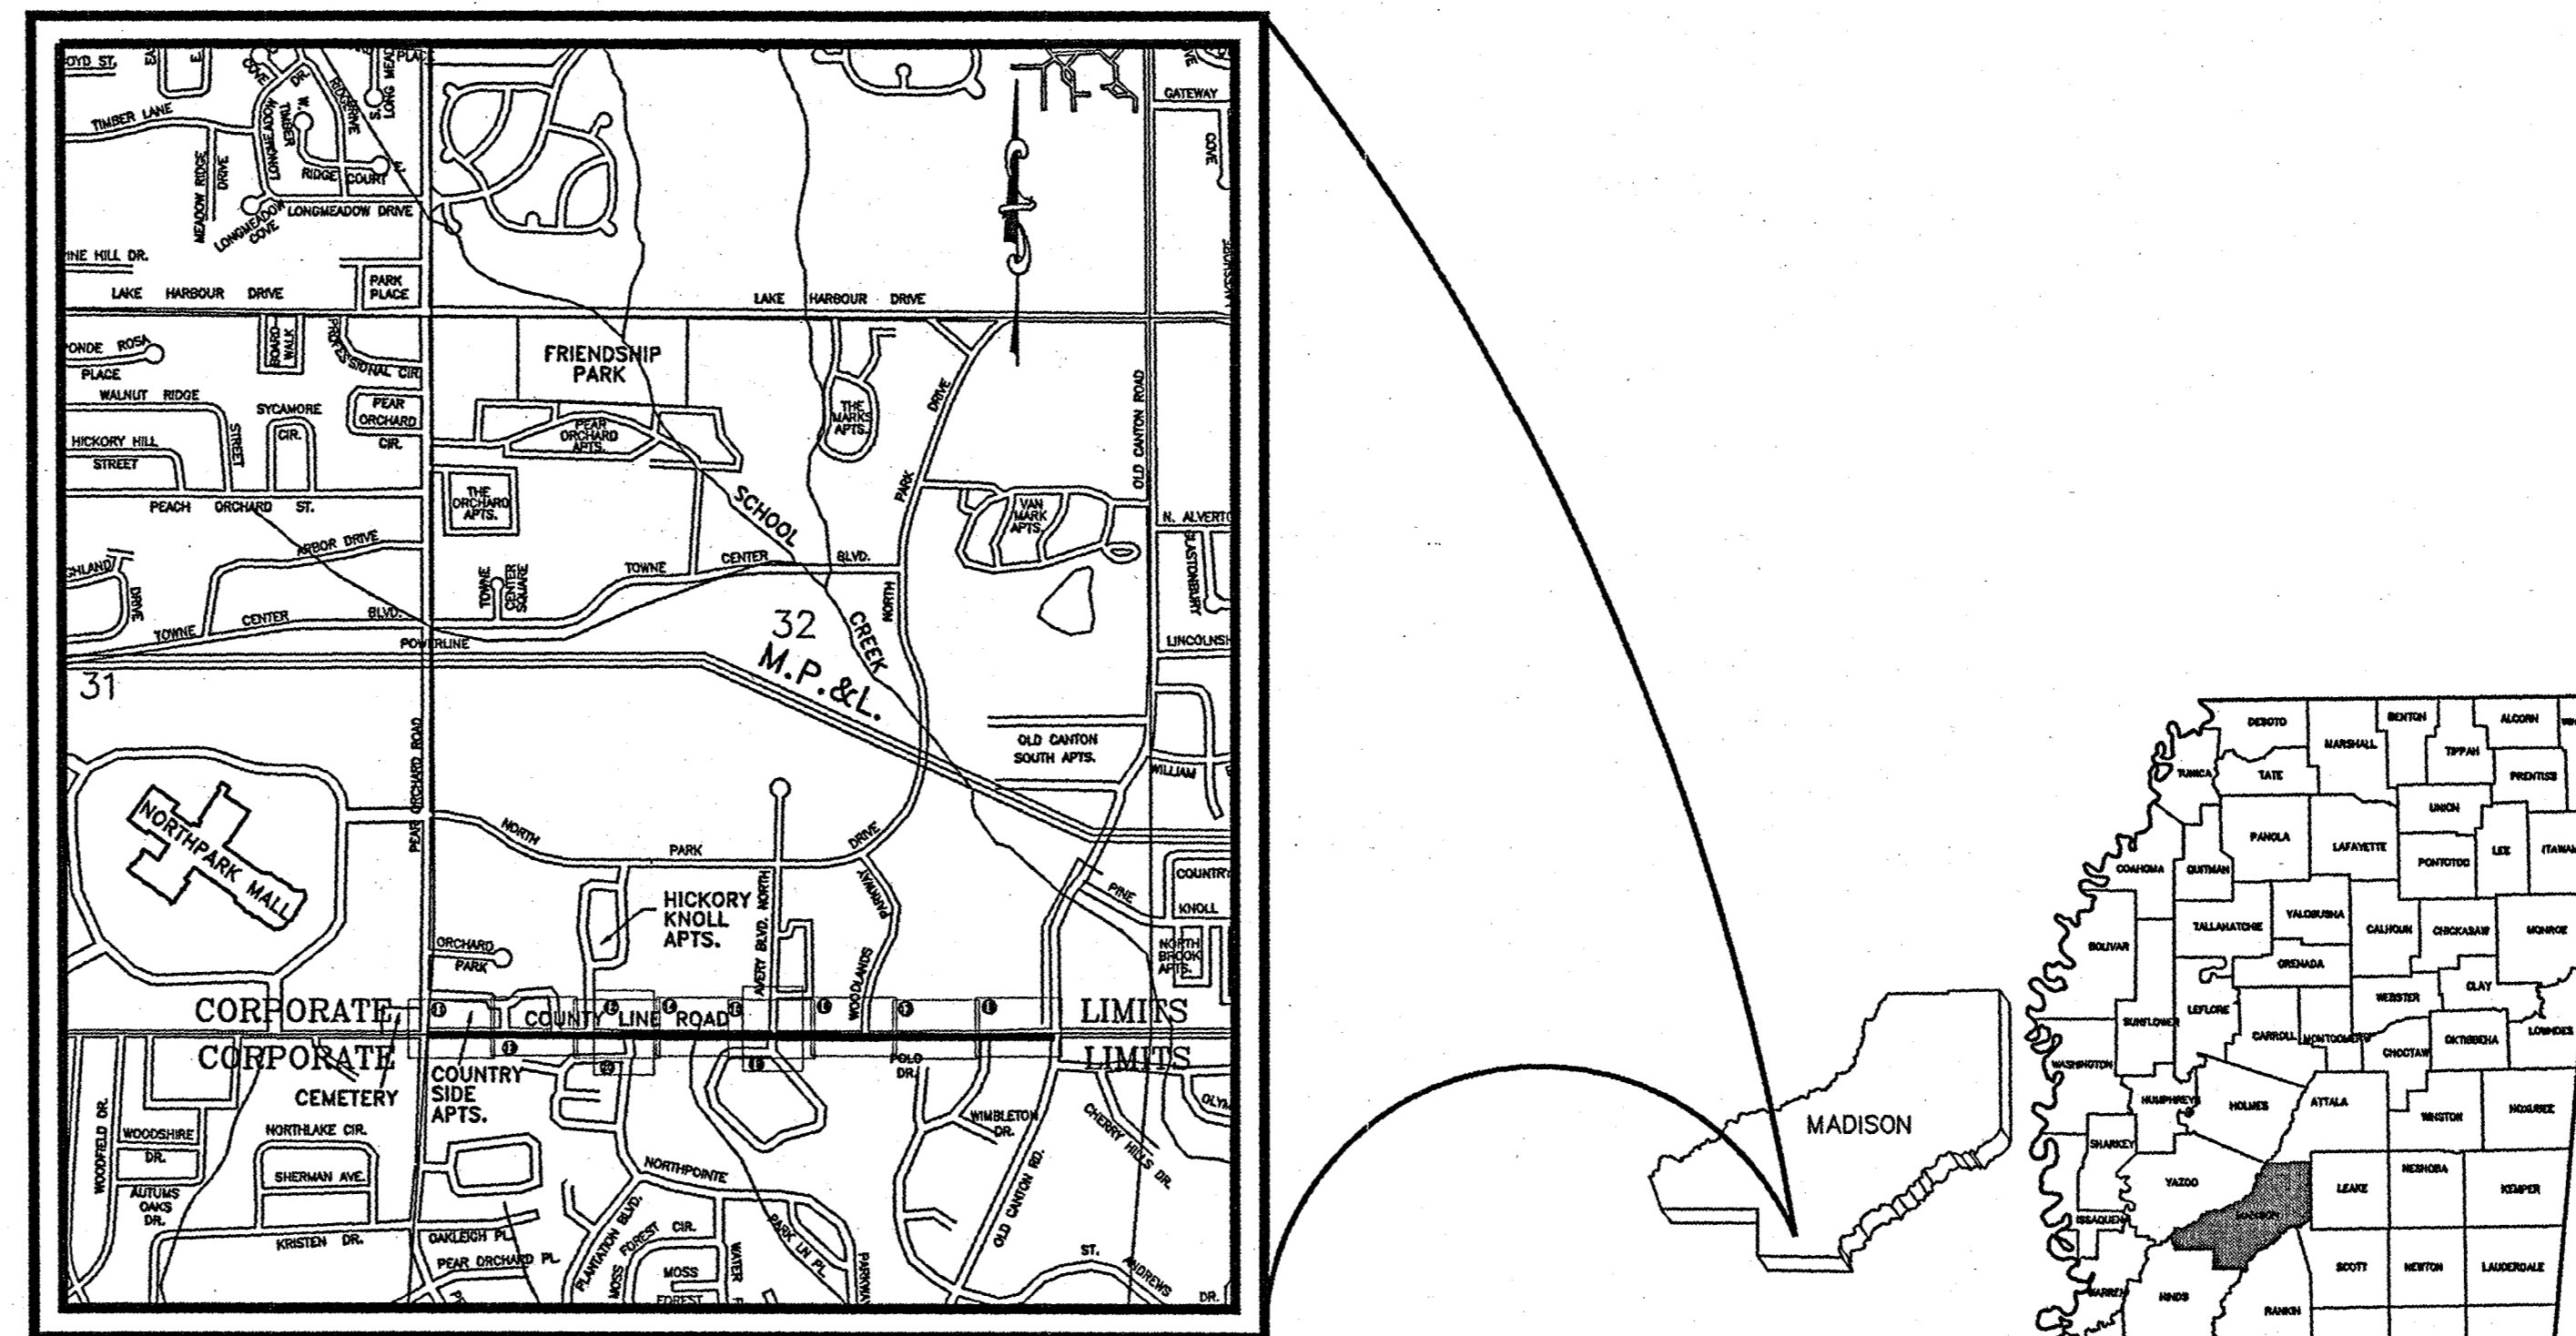

VICINITY MAP

PWP-05060

DESIGN SPEED= 45MPH
PROJECTED:
ADT (1996)= 21,000 (MDOT)
ADT (2016)= 38,000 (MDOT)


ENVIRONMENTAL PERMITS		
P.E. NO. TYPE	REQUIRED BY	
	YES	NO
N.W. (WATERS OF U.S.)	<input type="checkbox"/>	<input checked="" type="checkbox"/> <i>SW</i>
N.W. (WETLANDS)	<input type="checkbox"/>	<input checked="" type="checkbox"/> <i>PE</i>
G.P.	<input type="checkbox"/>	<input checked="" type="checkbox"/> <i>PE</i>
404	<input type="checkbox"/>	<input checked="" type="checkbox"/> <i>PE</i>
STORMWATER	<input checked="" type="checkbox"/>	<input type="checkbox"/> <i>PE</i>

CITY OF RIDGELAND  
WIDENING OF EAST  
COUNTY LINE ROAD WEI# T94-148A

LENGTH DATA

LENGTH OF PROJECT	4,600.54 FT	0.871 MI
LENGTH OF BRIDGES	00.00 FT	0.000 MI
LENGTH OF PROJECT (NET)		0.871 MI
LENGTH OF EXCEPTIONS	0.00 FT	0.000 MI
		0.871 MI

MAY 2005  
WEI #T94-148A

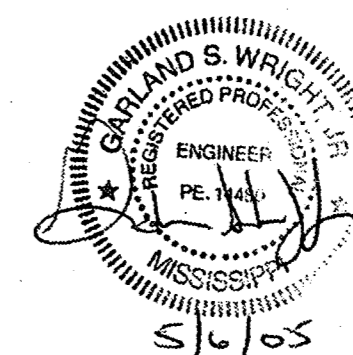

APPROVED: *[Signature]* 5/6/05  
PROJECT ENGINEER DATE


APPROVED: *[Signature]*  
MAYOR, CITY OF RIDGELAND DATE









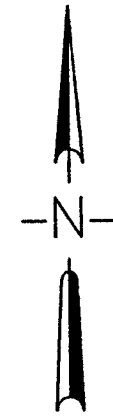


- NOTE:
1. ANY RECONSTRUCTION OF THE DRIVEWAY ENTRANCE @ STA. 58+00 RT. SHALL BE DONE IN-KIND(BRICK/CONC.) (COST ABSORBED)
  2. EROSION CONTROL ON PLAN IS MINIMUM CONTROL REQ'D. ADDITIONAL EROSION CONTROL TO BE DETERMINED BY ENGINEER. (SEE SHEET 51 FOR DETAILS)
  3. MILLING AND OVERLAY REQ'D. STA. 56+70 TO STA. 61+00. (SEE SHEET 23 FOR DETAILS)
  4. SIDEWALK ON SOUTH SIDE TO MATCH EXISTING GROUND LINE WITH 2% SLOPE BEING THE MAXIMUM LEFT OR RIGHT TO FIELD CONDITIONS.


UTILITIES

- TELEPHONE — T — BELL SOUTH TELECOMMUNICATIONS, INC.  
830 RIDGEWOOD ROAD, RIDGELAND MS., 39157
- POWER — P — ENTERGY  
P.O. BOX 50, MADISON, MS. 39130-0550
- GAS — G — MISSISSIPPI VALLEY GAS  
2736 BAILEY AVENUE, JACKSON, MS., 39213
- TELEVISION — TV — CAPITAL CABLEVISION  
415 CEDARS OF LEBNON ROAD, JACKSON, MS., 39206
- WATER — W — CITY OF RIDGELAND (NORTH OF PROJECT CENTERLINE)  
CITY OF JACKSON (SOUTH OF PROJECT CENTERLINE)
- SAN. SEWER — S — CITY OF RIDGELAND (NORTH OF PROJECT CENTERLINE)  
CITY OF JACKSON (SOUTH OF PROJECT CENTERLINE)



NOTE:  
THE LOCATION OF THE UNDERGROUND UTILITIES SHOWN ON PLANS ARE BASED ON THE BEST INFORMATION AVAILABLE TO THE ENGINEER. THESE LOCATIONS ARE ONLY CONSIDERED APPROXIMATE. THE ENGINEER DOES NOT GUARANTEE THEIR ACCURACY AND THAT ALL UTILITIES ARE SHOWN. THE CONTRACTOR SHALL BE RESPONSIBLE FOR MAKING ANY INDEPENDENT INVESTIGATIONS, INCLUDING ANY SUBSURFACE INVESTIGATIONS, AS MAY BE NECESSARY.

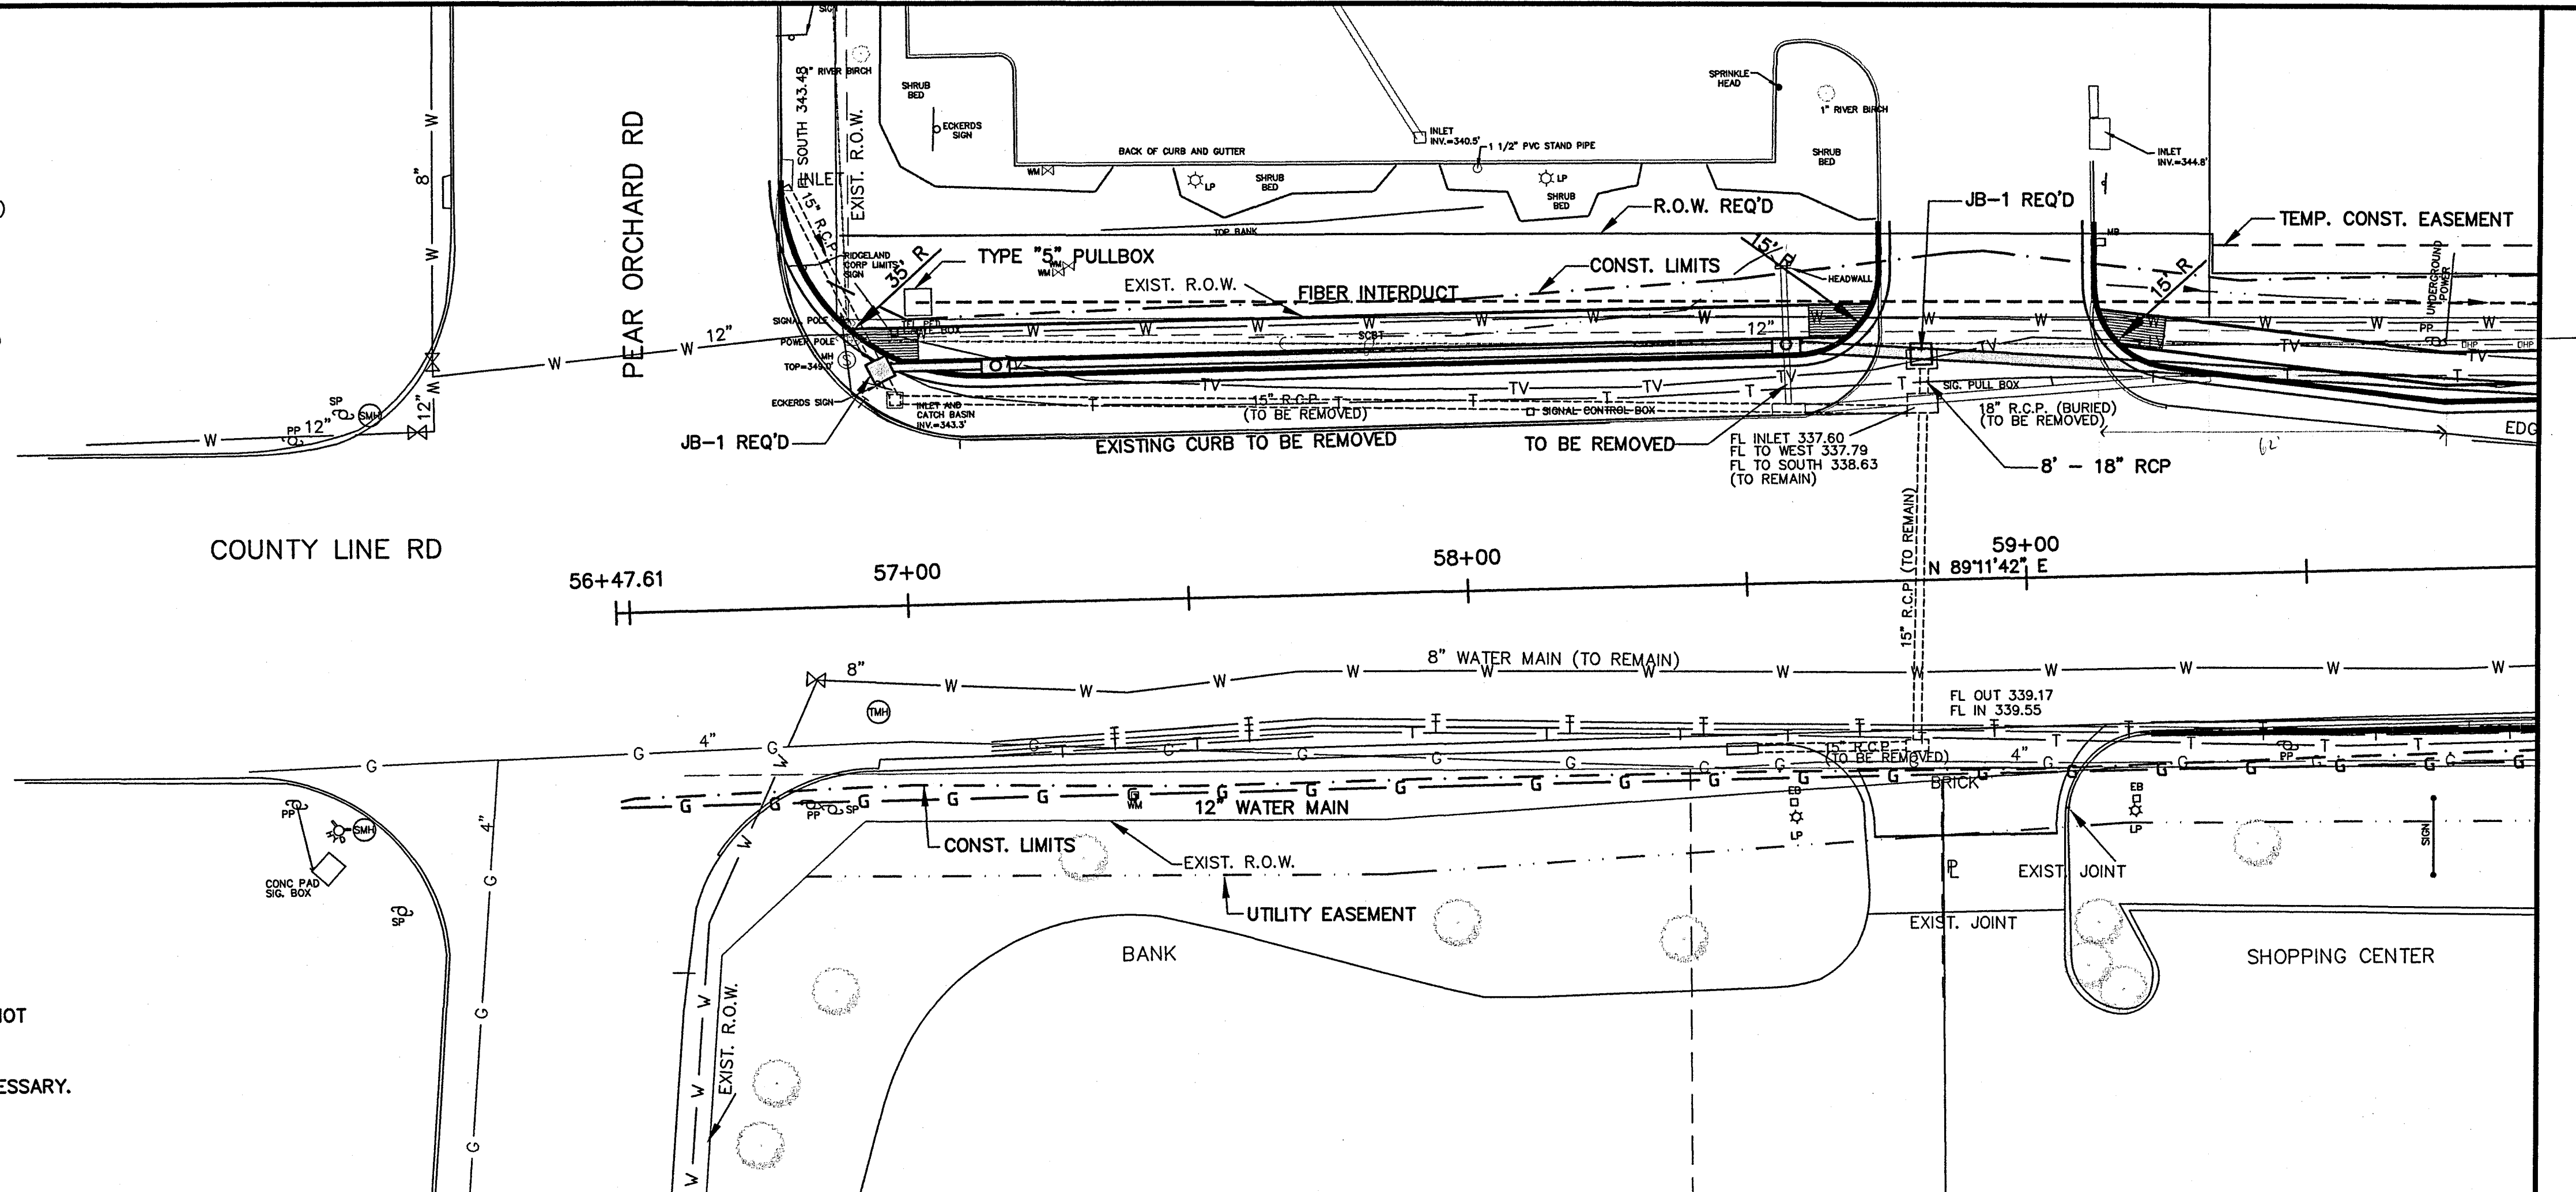

STA. 56+95.64 LT. OFFSET 42' JB-1 REQ'D FL IN = 343.30 FL OUT = 343.20	STA. 57+16.18 LT. SINGLE TYPE "A" INLET REQ'D. I.C. = 348.36 FL IN = 342.80 FL OUT = 342.70	STA. 58+57.43' LT. SINGLE TYPE "A" INLET REQ'D I.C. = 347.79 FL IN = EXISTING NORTH FL IN = 337.80 FL OUT = 337.50	STA. 58+82 LT. OFFSET 42' JB-1 REQ'D FL IN (WEST) = 337.00 FL IN (SOUTH) = 337.70 FL OUT = 336.90
--	---	---	--

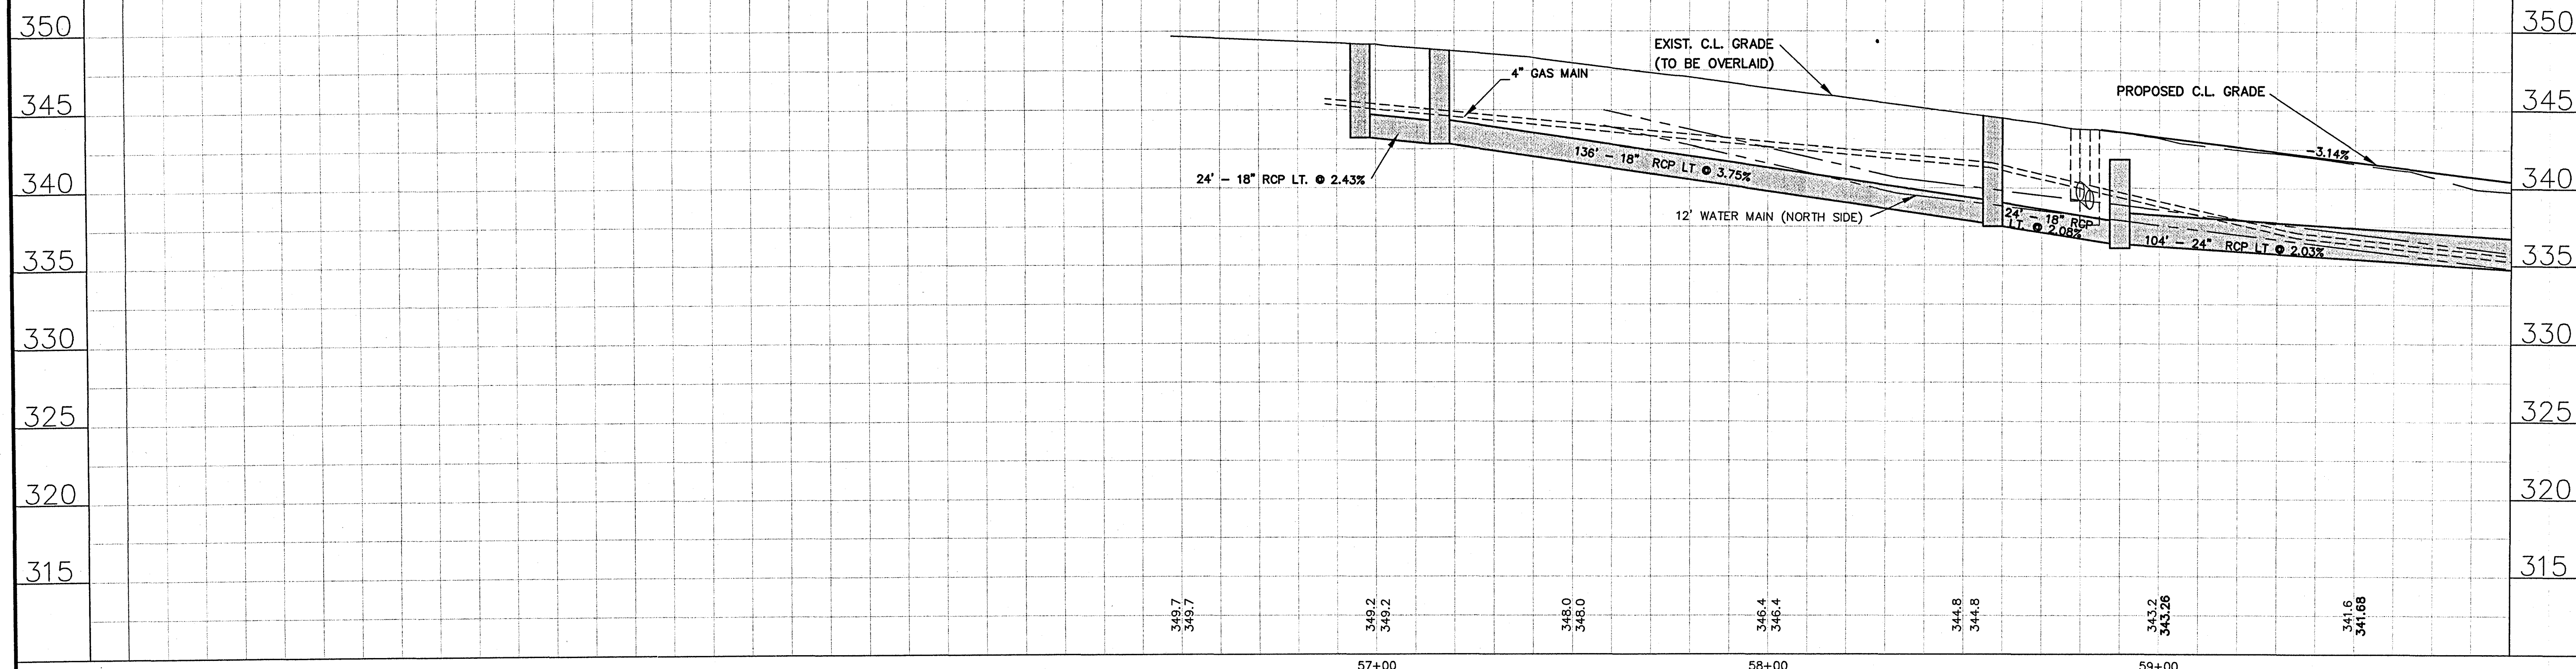



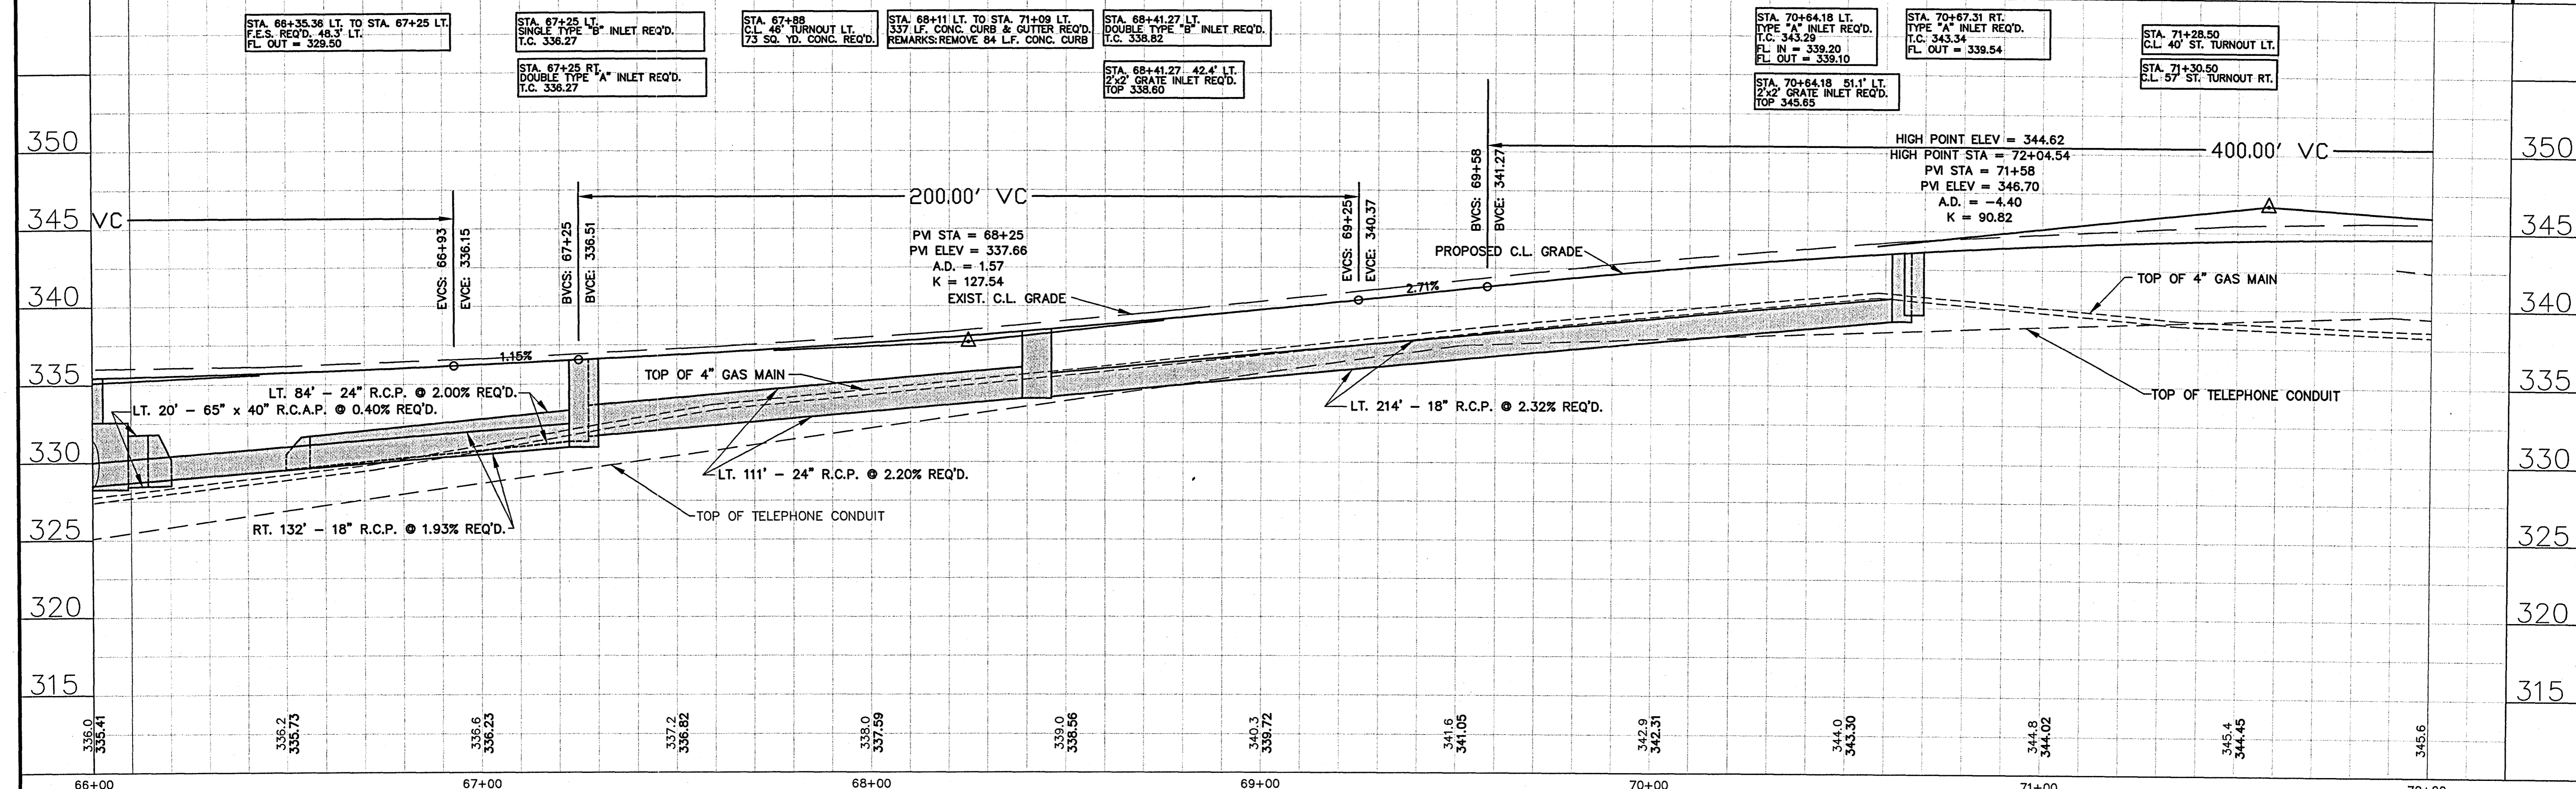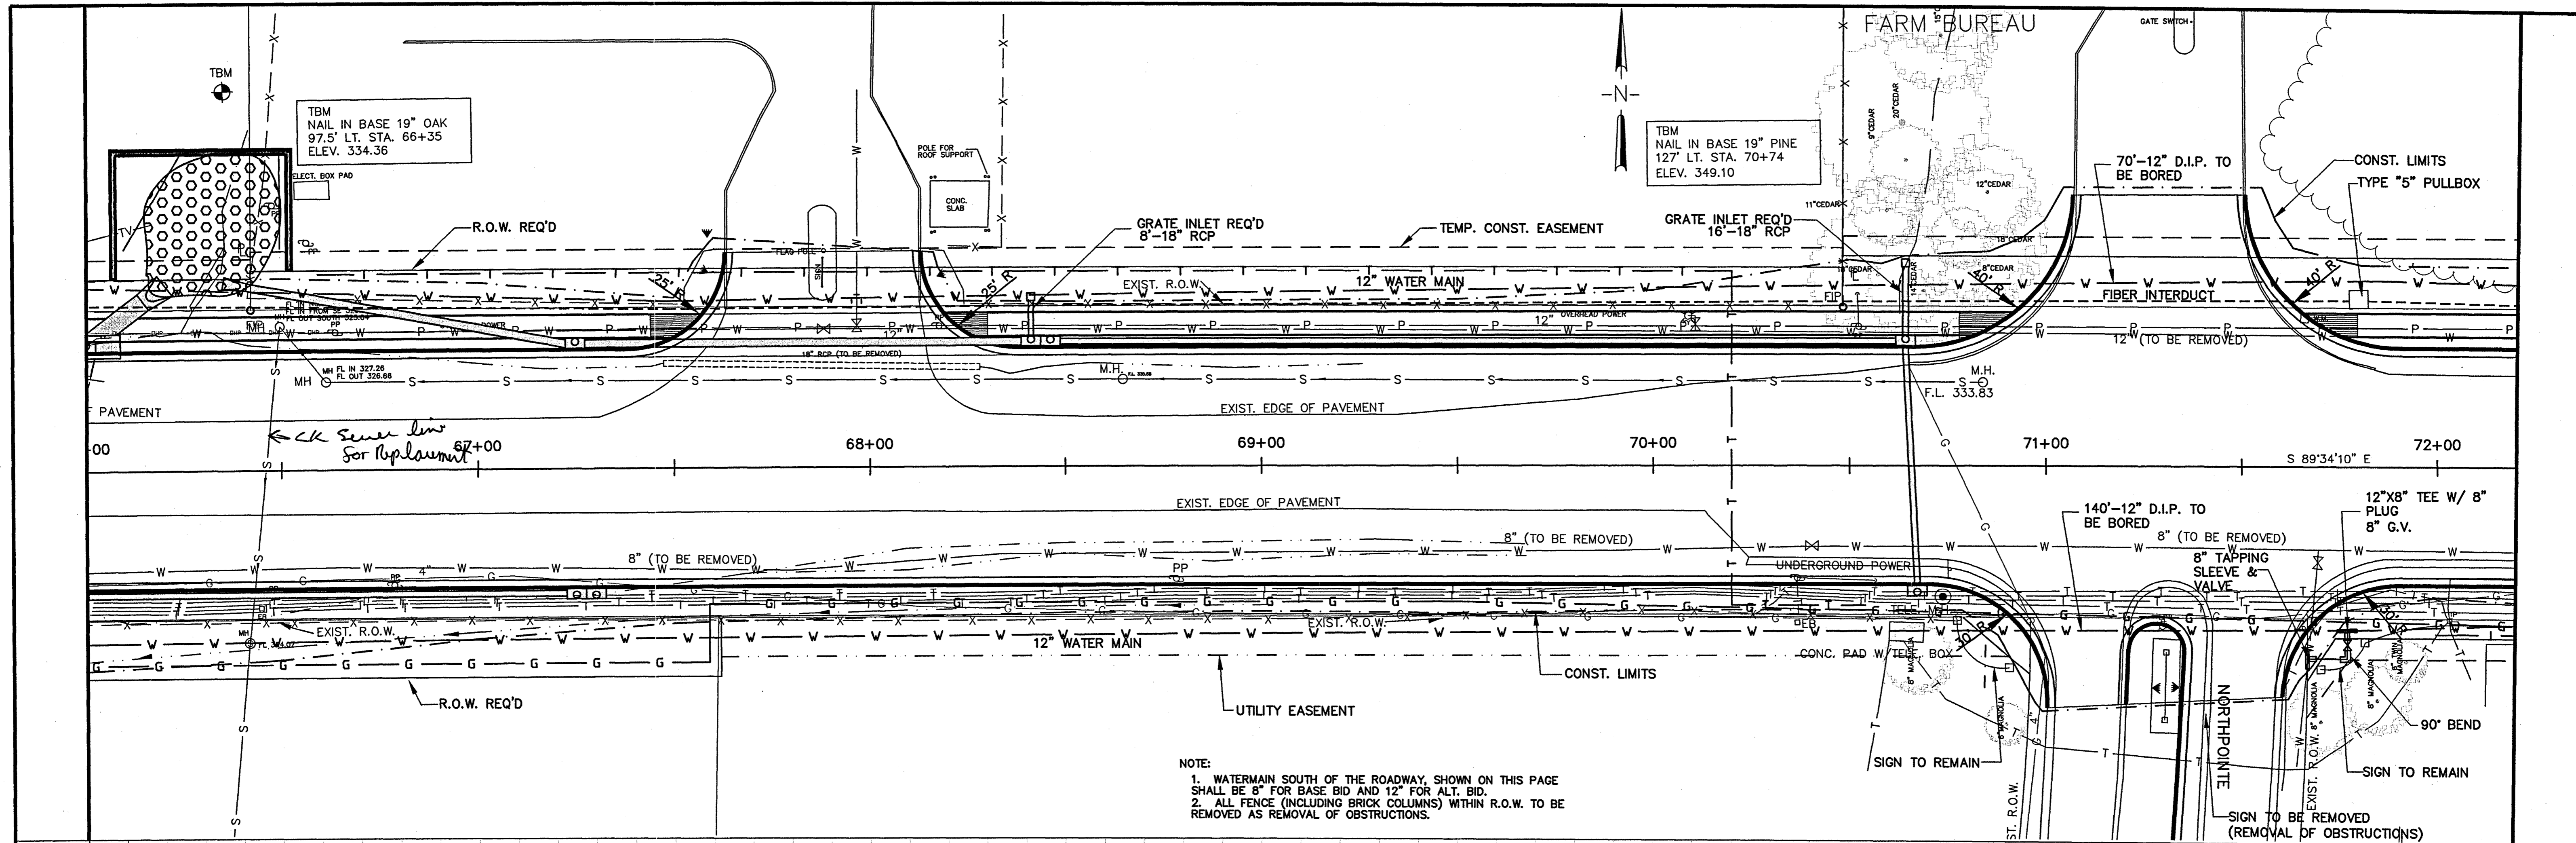

NO.	DATE	REVISIONS	BY	DESIGNED BY	DATE	HORIZ. SCALE	VERT. SCALE	PROJECT	CLIENT	PROJECT NO.	SHEET NUMBER
				SW	2-02-05	1"=20'	1"=5'	T94-148	CITY OF RIDGELAND WIDENING OF EAST COUNTY LINE ROAD STP-7305-00-(003)	143-A LEFLEURS SQUARE JACKSON, MS 39211 601-355-9526 FAX 601-352-3945	9




FARM BUREAU

POND

106' LT. STA. 74+70  
ELEV. 343.35


TYPE 75" PULLBOX

N

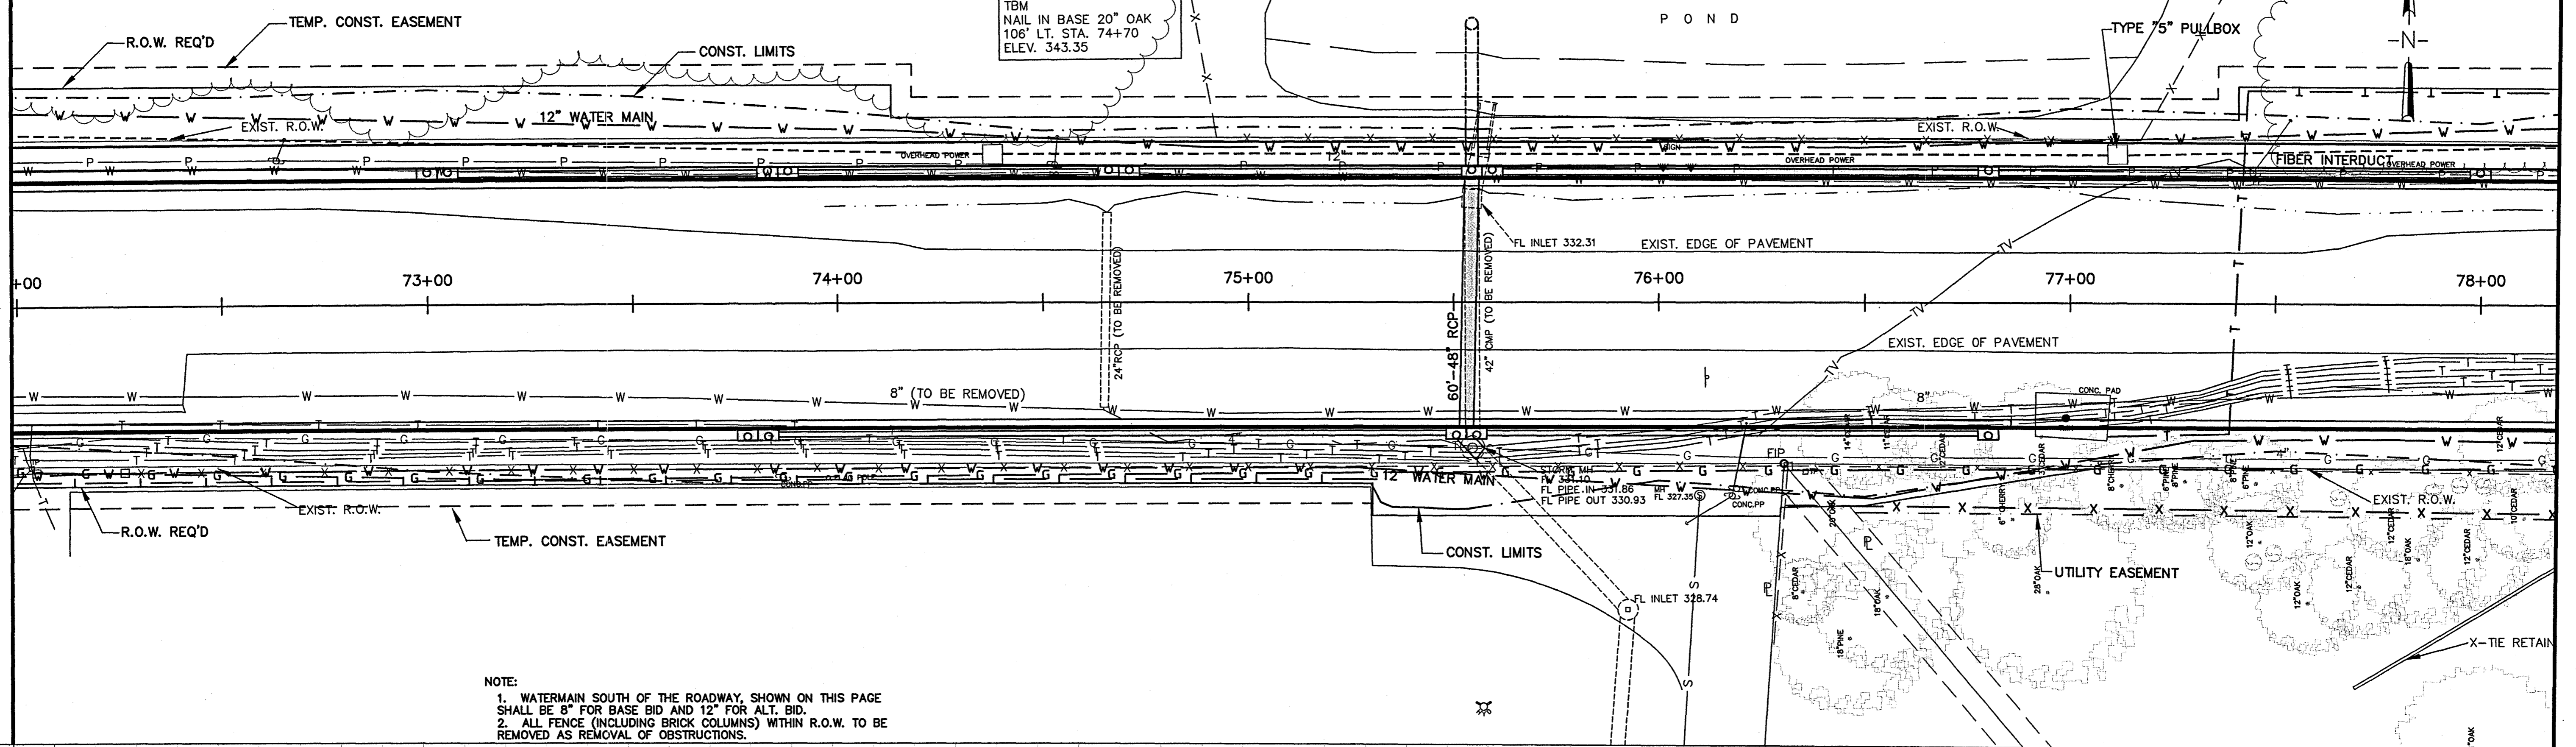


NOTE:  
 1. WATERMAIN SOUTH OF THE ROADWAY, SHOWN ON THIS PAGE SHALL BE 8" FOR BASE BID AND 12" FOR ALT. BID.  
 2. ALL FENCE (INCLUDING BRICK COLUMNS) WITHIN R.O.W. TO BE REMOVED AS REMOVAL OF OBSTRUCTIONS.

STA. 73+02.50 LT. DOUBLE TYPE "A" INLET REQ'D. I.C. 343.85 FL. OUT = 339.76	STA. 73+80.50 RT. DOUBLE TYPE "A" INLET REQ'D. I.C. 342.70 FL. OUT 338.40	STA. 73+85.50 LT. DOUBLE TYPE "A" INLET REQ'D. I.C. 342.82 FL. IN = 338.63 FL. OUT = 338.53	STA. 74+68.50 LT. DOUBLE TYPE "A" INLET REQ'D. I.C. 341.23 FL. IN = 337.24 FL. OUT = 337.14	STA. 75+53.14 RT. DOUBLE TYPE "C" INLET REQ'D. I.C. 340.83 EXTEND EXIST. 48" PIPE 7 L.F. CONC. COLLAR REQ'D. REMARKS: REMOVE EXIST. M.H. FL. IN (15") = 332.93 FL. IN (48") = 331.03 FL. OUT (48") = 330.93	STA. 75+54.50 LT. DOUBLE TYPE "C" INLET REQ'D. I.C. 340.64 FL. IN (18") = 334.31 FL. IN (36") = 333.11 FL. OUT (48") = 332.31	STA. 76+80 RT. TYPE "A" INLET REQ'D. I.C. 342.03 FL. OUT = 337.30	STA. 76+80 LT. SINGLE TYPE "A" INLET REQ'D. I.C. 342.03 FL. IN = 338.04 FL. OUT = 337.94	STA. 78+00 LT. SINGLE TYPE "A" INLET REQ'D. I.C. 343.97 FL. OUT = 339.88
---	---	--	--	--	---	---	---	--

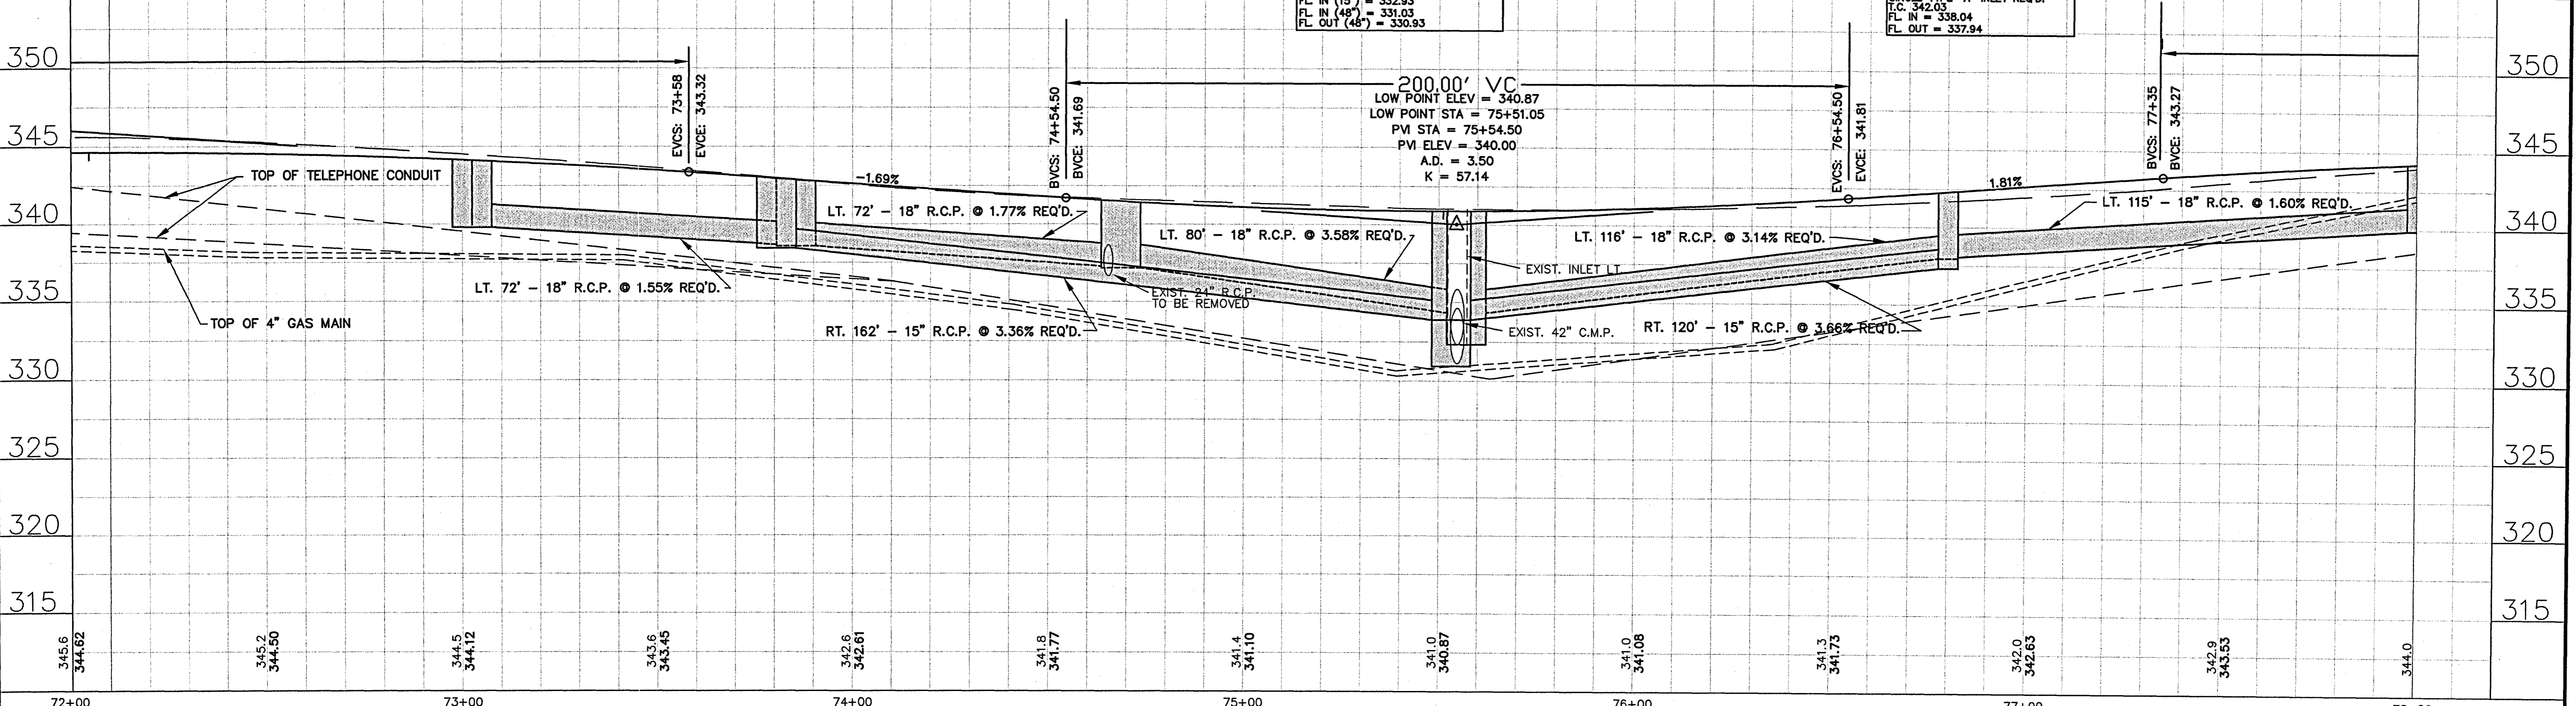




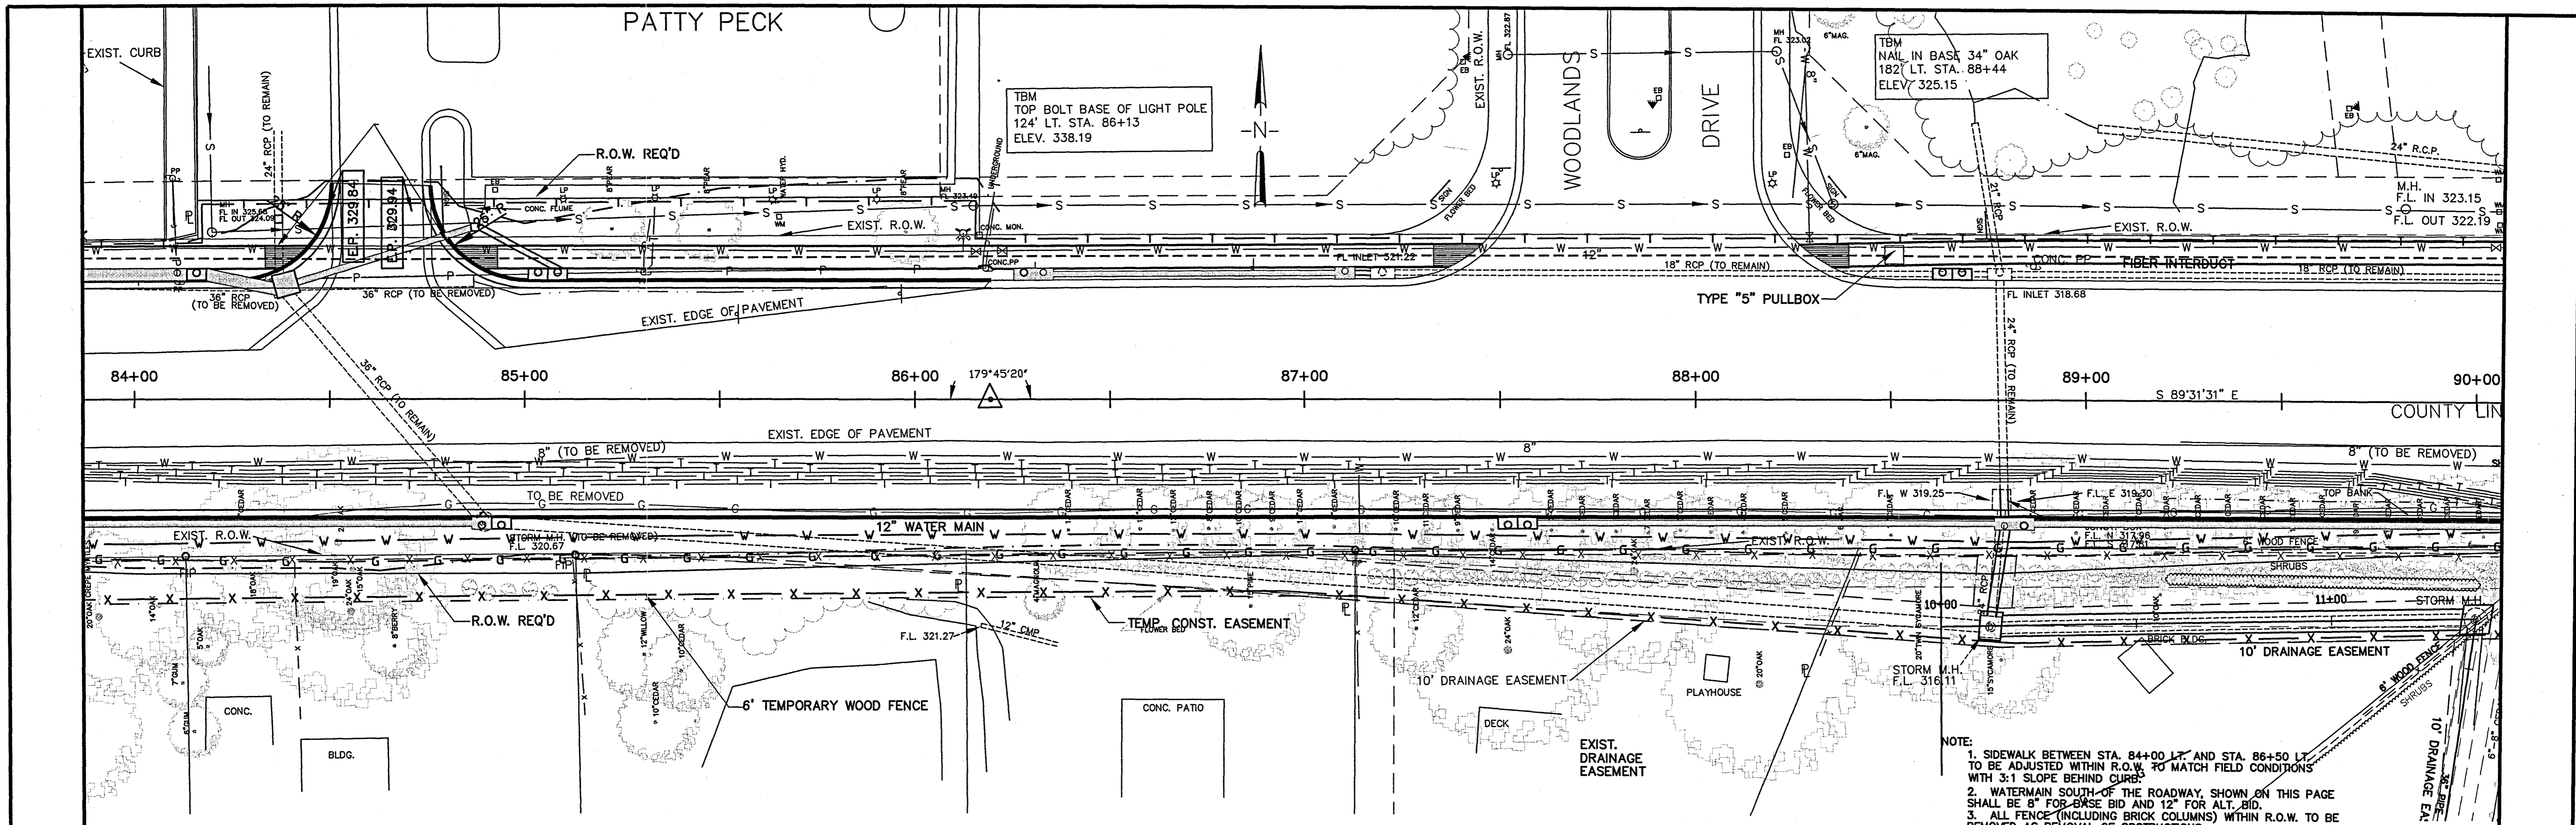



NOTE:  
 1. SIDEWALK BETWEEN STA. 84+00 LT. AND STA. 86+50 LT. TO BE ADJUSTED WITHIN R.O.W. TO MATCH FIELD CONDITIONS WITH 3:1 SLOPE BEHIND CURBS.  
 2. WATERMAIN SOUTH OF THE ROADWAY, SHOWN ON THIS PAGE SHALL BE 8" FOR BASE BID AND 12" FOR ALT. BID.  
 3. ALL FENCE (INCLUDING BRICK COLUMNS) WITHIN R.O.W. TO BE REMOVED AS REMOVAL OF OBSTRUCTIONS.

STA. 84+13.56 LT. DOUBLE TYPE "B" INLET REQ'D. T.C. 320.21 FL IN = 324.11 FL OUT = 323.62	STA. 84+35 LT. JB-1 6"x6"x5" REQ'D. REMOVE EXISTING JB & GRATE TIE IN TO EXISTING 36" TO BE COST ABSORBED	STA. 84+37.01 45.5' LT. 2' X 2' GRATE INLET REQ'D. TOP 329.00 REMARKS: INLET REQ'D. ON EXIST. PIPE	STA. 84+91.54 RT. DOUBLE TYPE "B" INLET REQ'D. T.C. 328.04 FL IN = 328.04 FL OUT = 327.82	STA. 85+05.92 LT. DOUBLE TYPE "A" INLET REQ'D. T.C. 327.82 FL OUT = 323.82	STA. 86+30.36 LT. DOUBLE TYPE "A" INLET REQ'D. T.C. 326.42 FL OUT = 322.05	STA. 87+10.34 LT. SINGLE TYPE "A" INLET REQ'D. T.C. 325.23 FL IN = 321.36 FL OUT = 321.31	STA. 87+54.60 RT. DOUBLE TYPE "A" INLET REQ'D. T.C. 324.73 FL OUT = 320.73	STA. 87+89 CL. 58" ST. TURNOUT LT.	STA. 89+55.92 LT. DOUBLE TYPE "A" INLET REQ'D. ON EXIST. PIPE T.C. 323.90 REMARKS: REMOVE 30 LF. CONC CURB; (TO BE COST ABSORBED)	STA. 88+81.85 RT. DOUBLE TYPE "B" INLET REQ'D. T.C. 323.92 REMARKS: EXTEND 24' R.C.P. 7 LF. REMOVE EXIST. STORM M.H. REMOVE 27 LF. 24" R.C.P. FL IN (18") = 319.63 FL IN (24") = 319.63 FL OUT = 317.17
---	---	--	---	--	--	---	--	------------------------------------	---	---

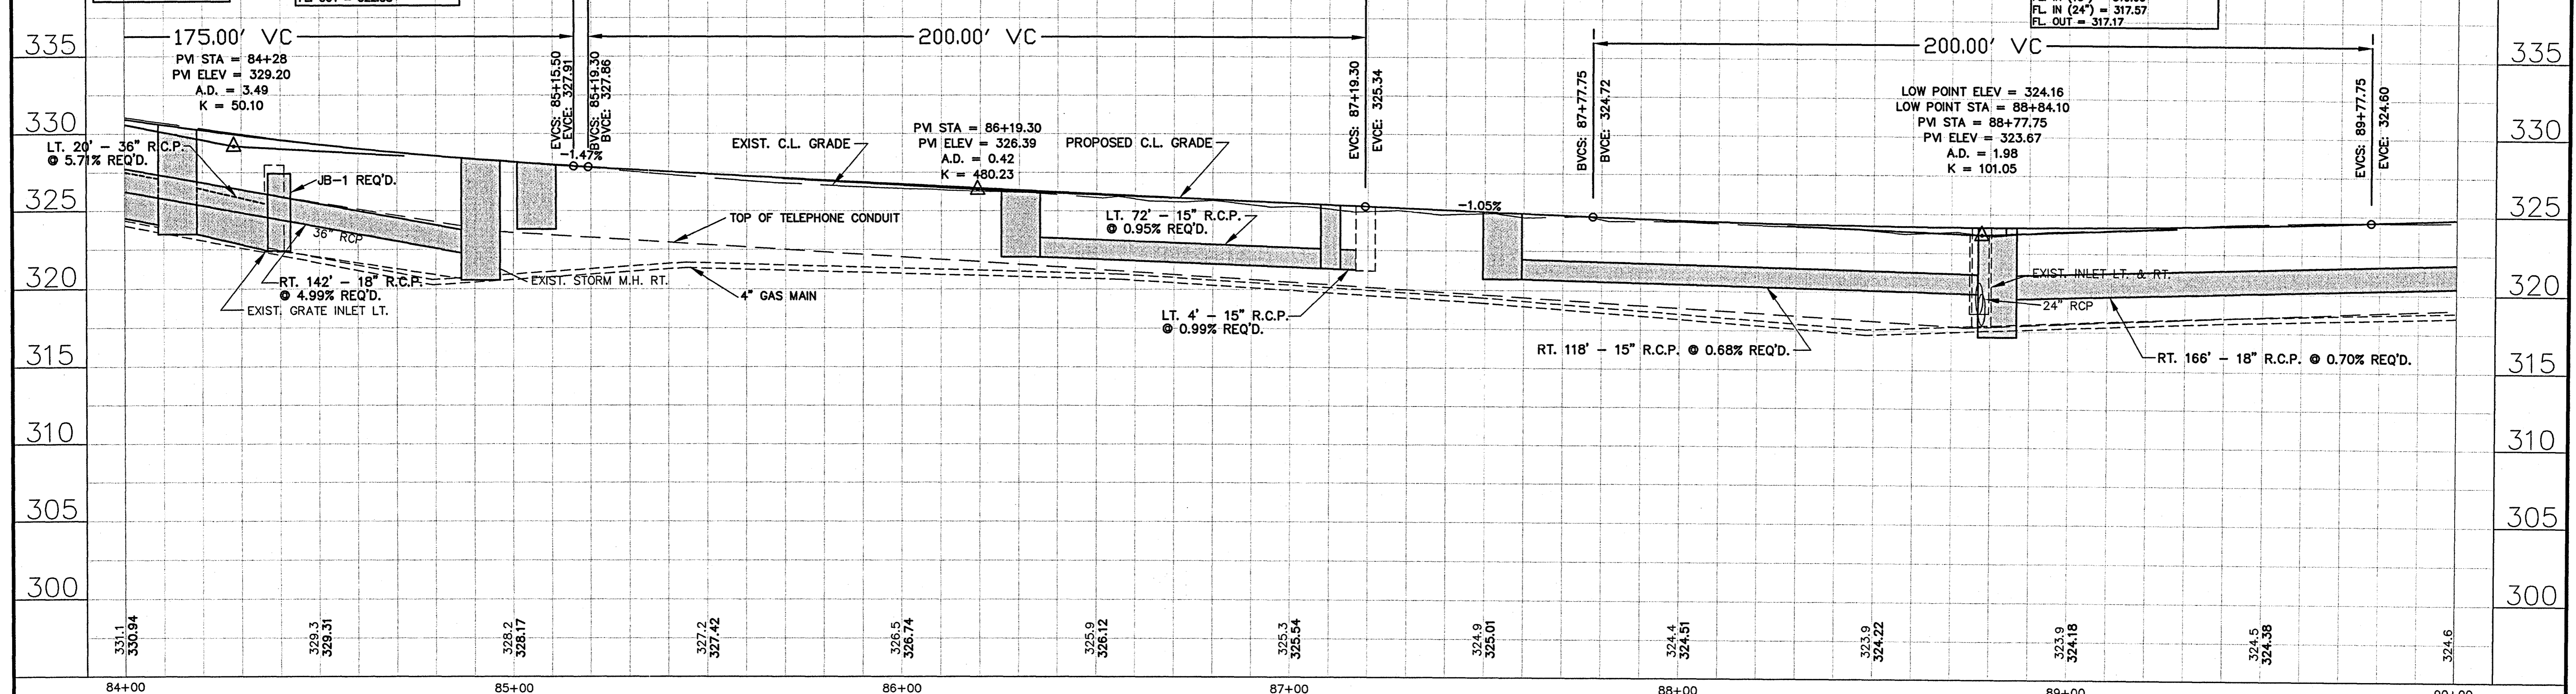





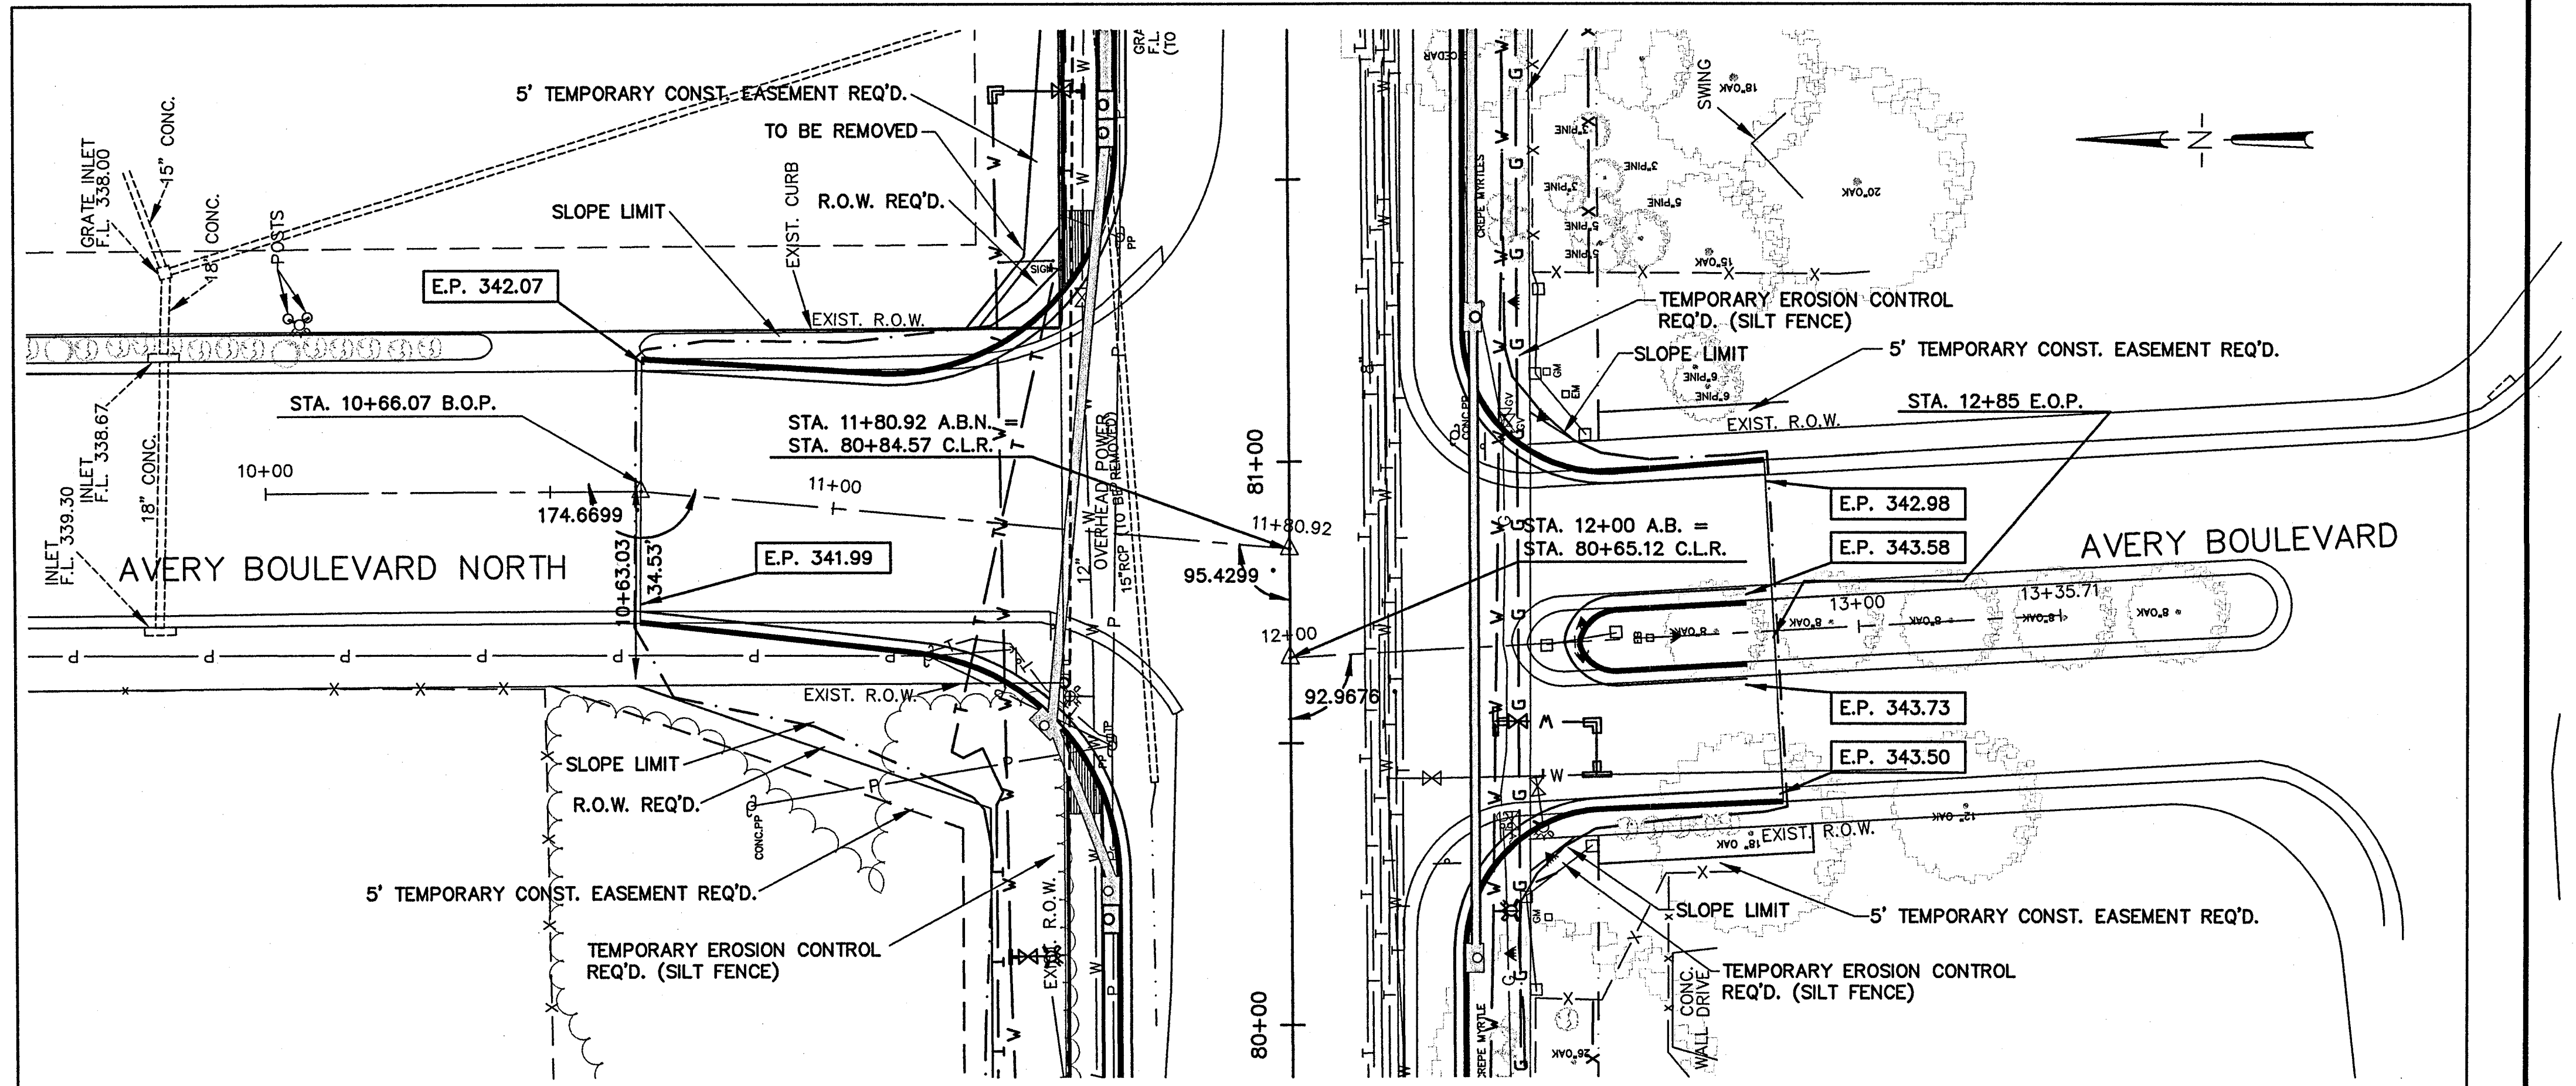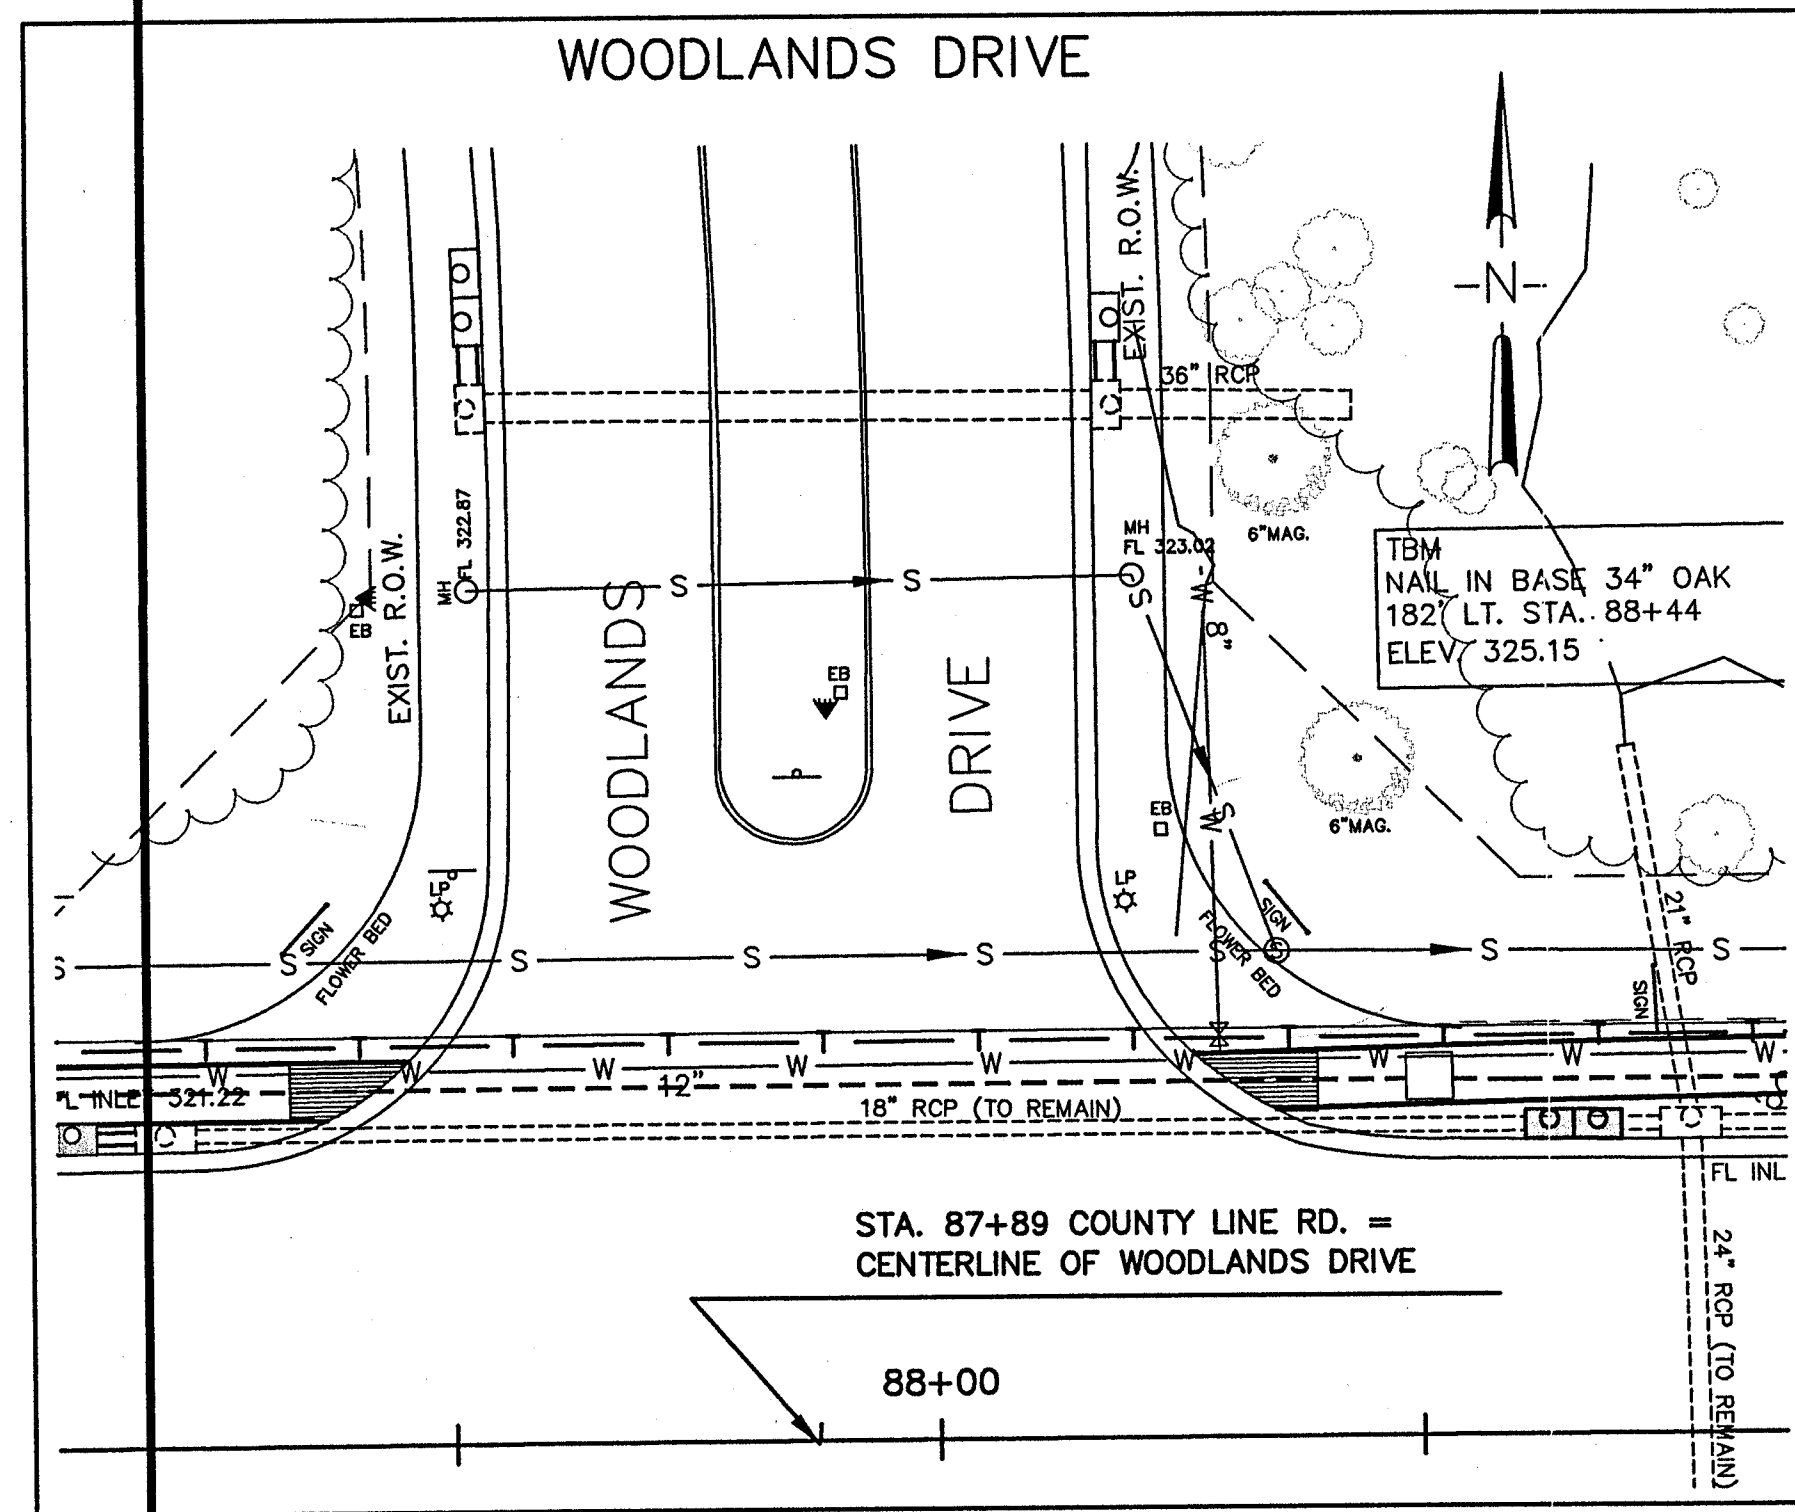

STA. 87+52.62 105' LT.  
DOUBLE TYPE "A" INLET REQ'D.  
I.C. 325.71  
4 LF. 24" R.C.P. REQ'D.  
REMARKS: F.L. IS EXIST. PIPE  
REMOVE 10 LF. CONC. CURB  
REMOVE & REPAIR 30 LF. CONC. CURB  
(COST ABSORBED)



STA. 88+18.14 105' LT.  
TYPE "A" INLET REQ'D.  
I.C. 325.58  
4 LF. 24" R.C.P. REQ'D.  
REMARKS: F.L. IS EXIST. PIPE  
REMOVE 5 LF. CONC. CURB  
REMOVE & REPAIR 20 LF. CONC. CURB  
(COST ABSORBED)

STA. 10+66.07 LT. TO STA. 11+05 LT.  
41 LF. CONC. CURB & GUTTER REQ'D.  
REMARKS: REMOVE 41 LF. CONC. CURB

STA. 10+66.07 RT. TO STA. 11+17 RT.  
56 LF. CONC. CURB & GUTTER REQ'D.  
REMARKS: REMOVE 49 LF. CONC. CURB


AVERY BOULEVARD NORTH

AVERY BOULEVARD

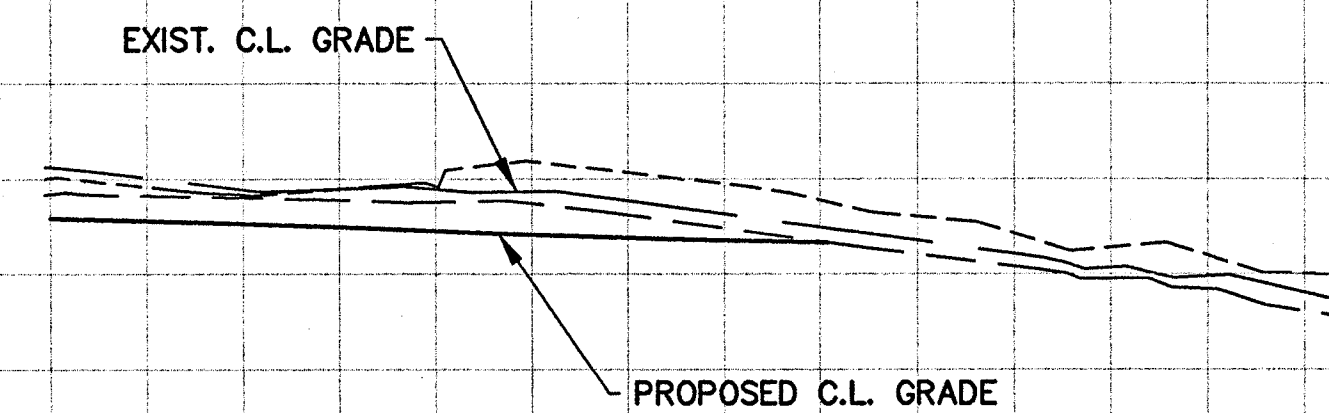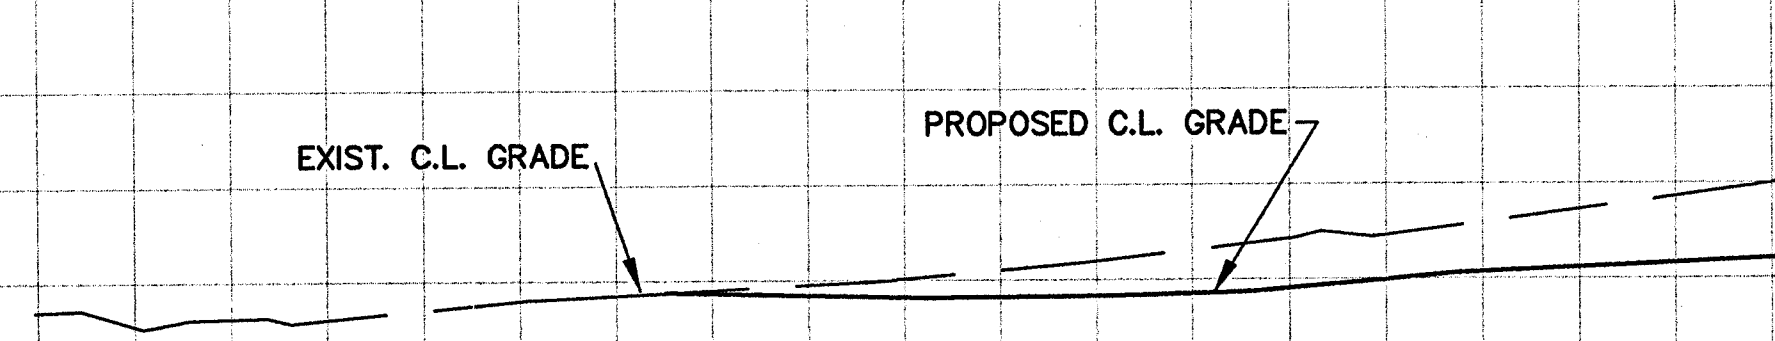


331.3      342.0      342.1      342.3      342.7      343.8      345.2      344.8      348.0      343.5


96+00      10+00      11+00      12+00      13+00

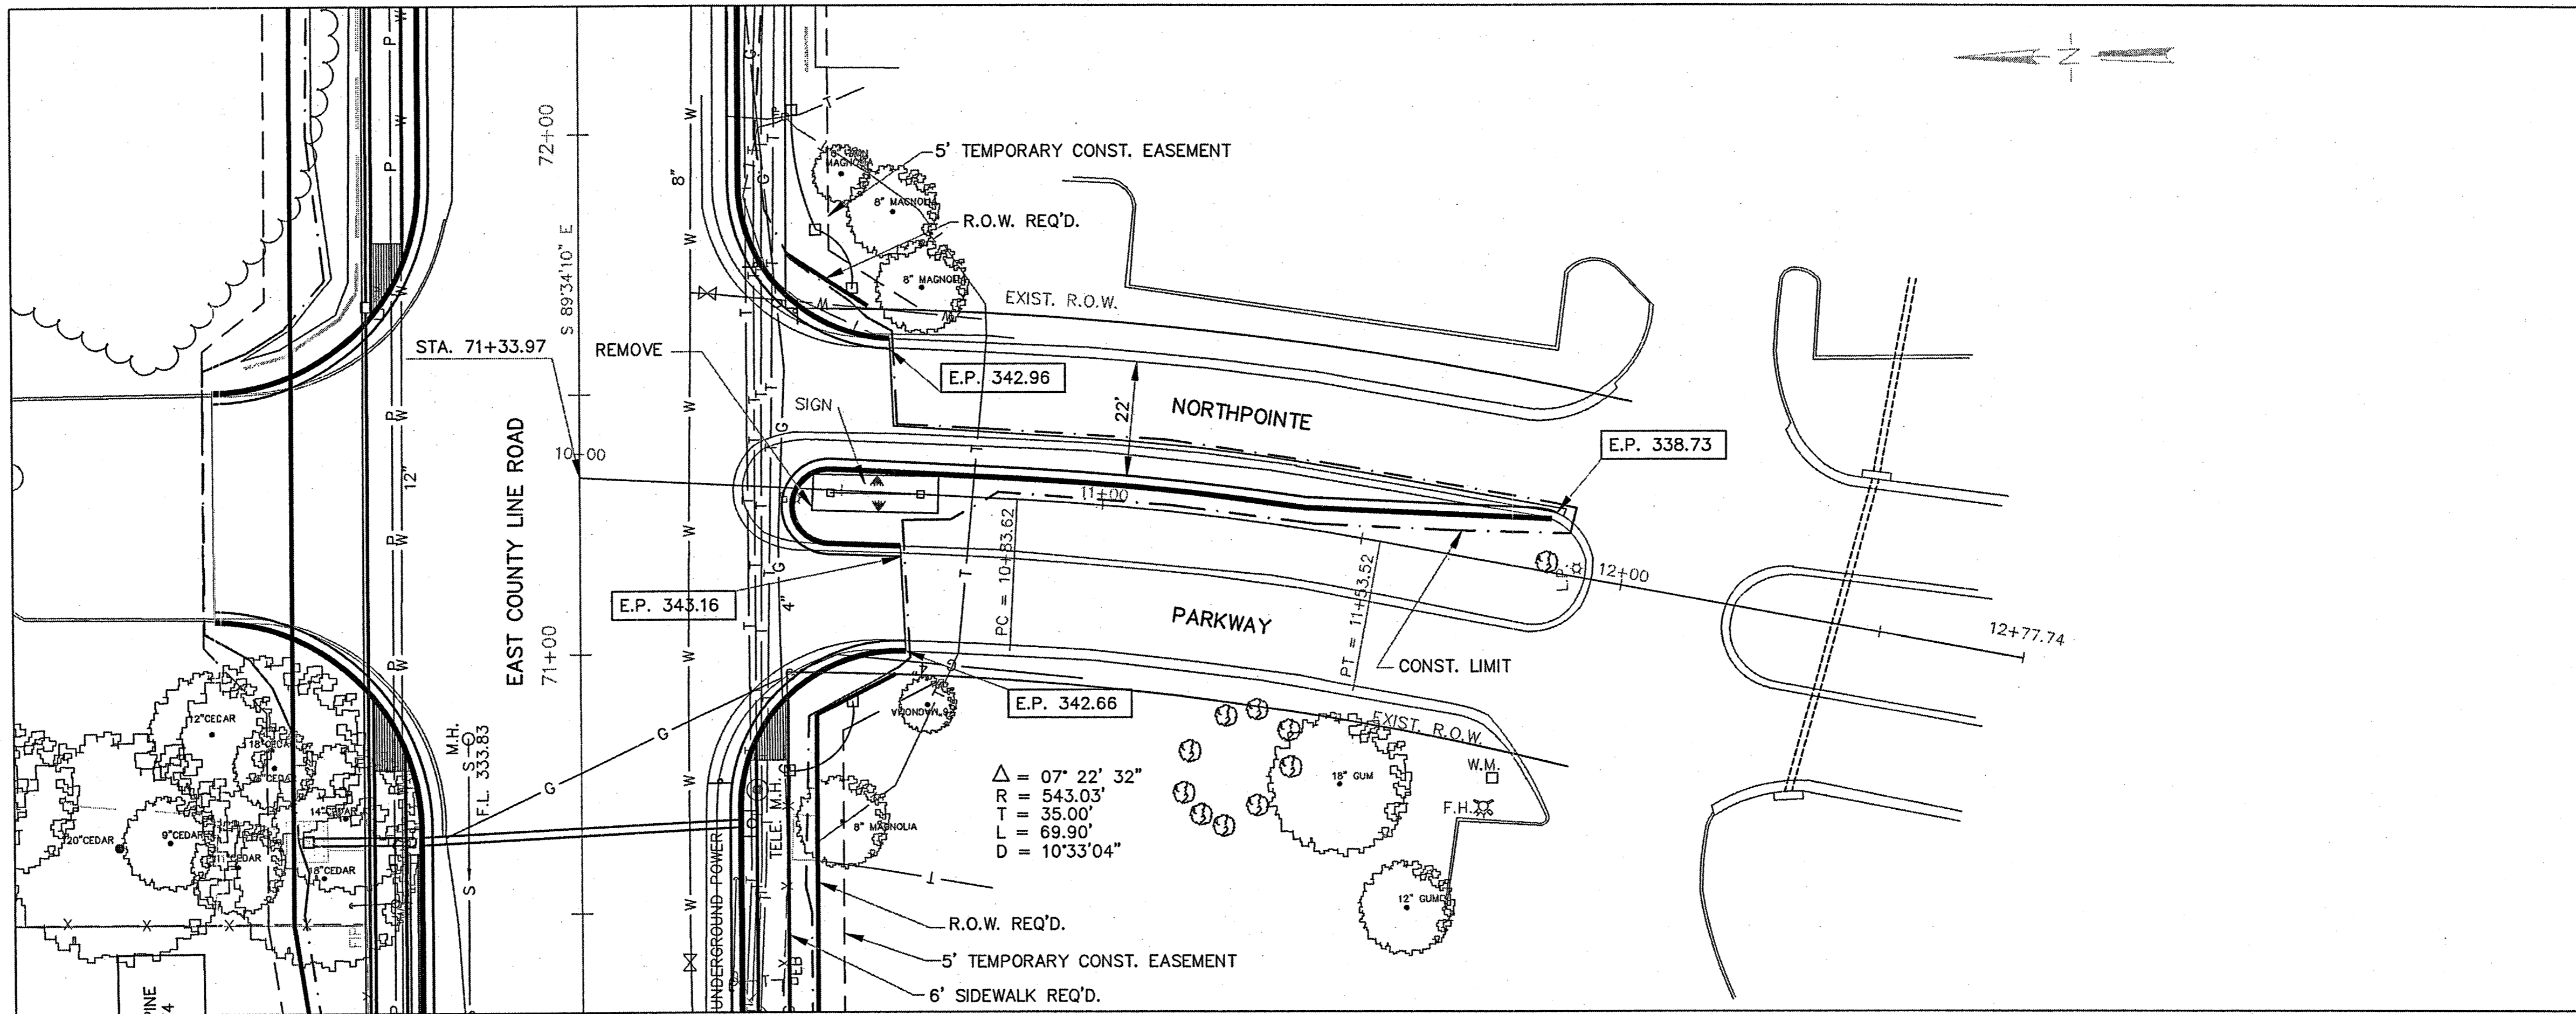

STA. 10+70 LT. TO STA. 11+85 T.  
 116 LF. CONC. CURB & GUTTER REQ'D.  
 REMARKS: REMOVE 125 LF. CONC. CURB

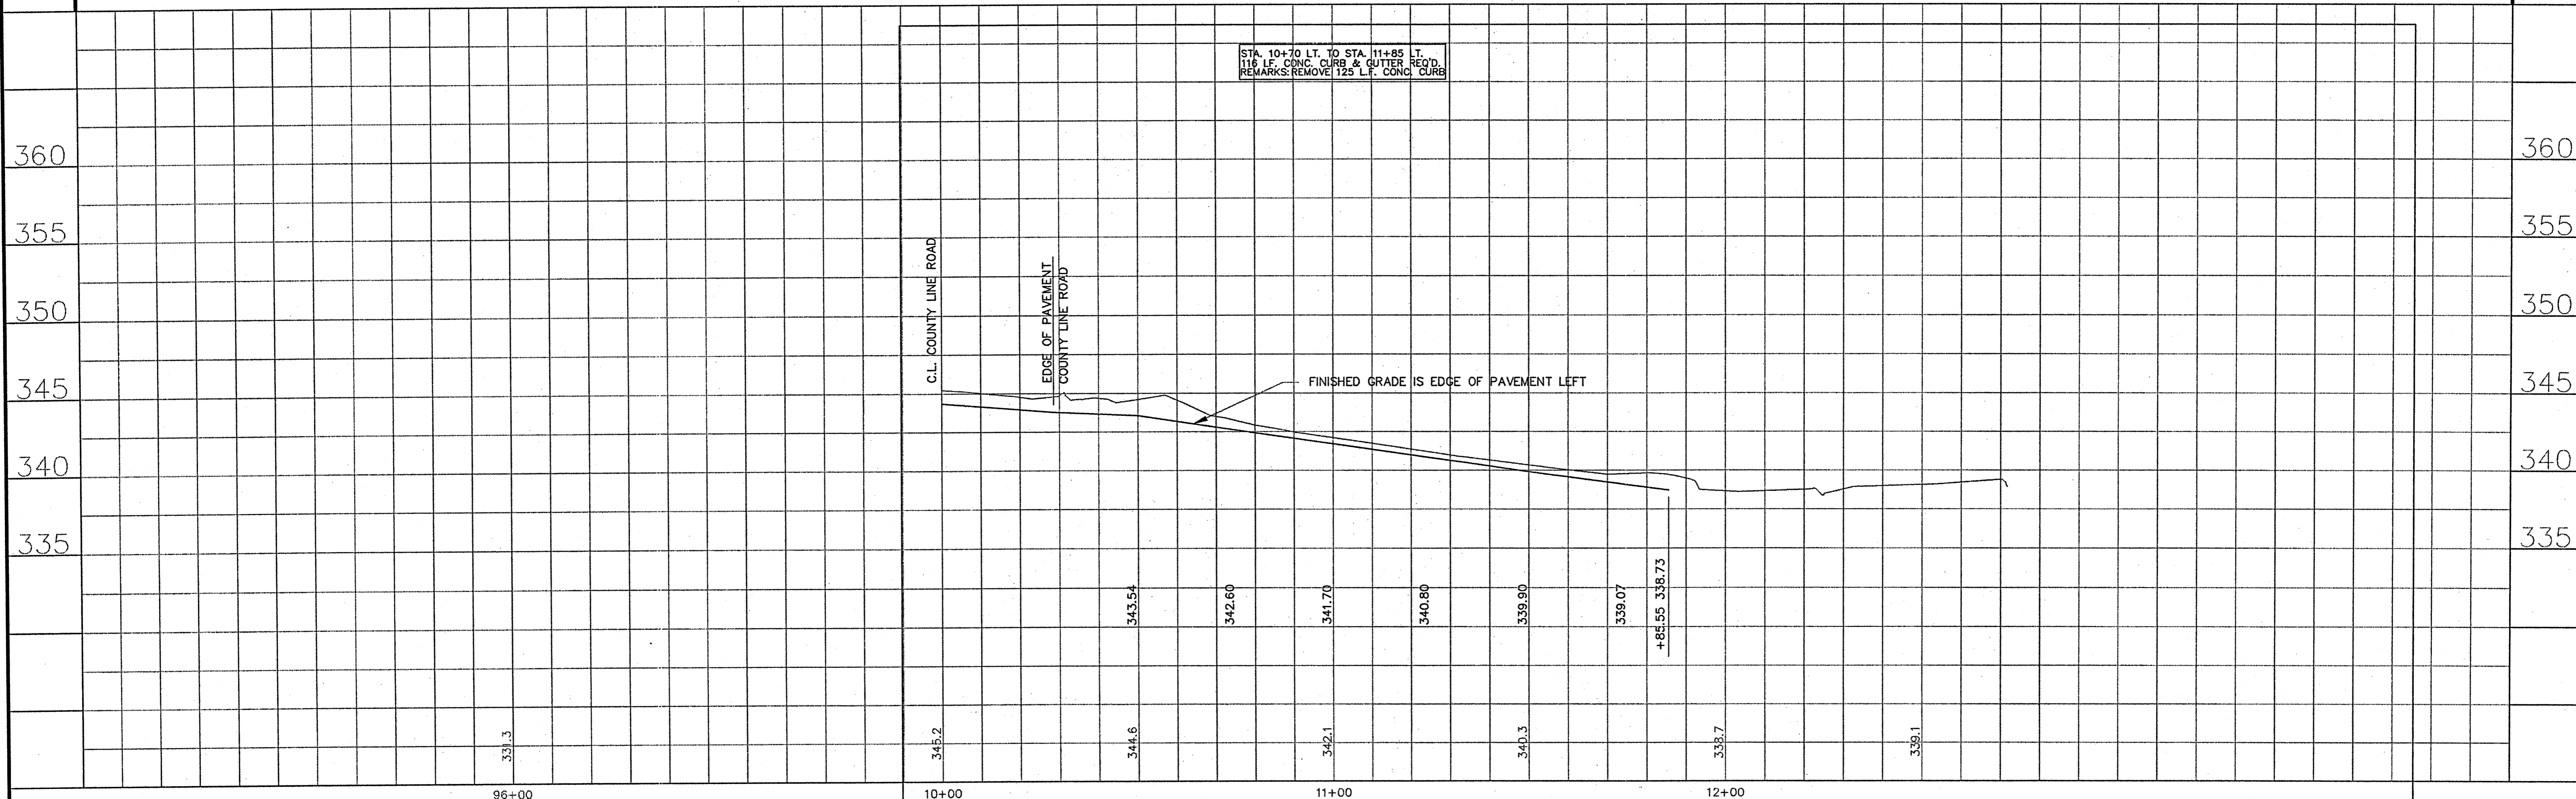

NO. DATE	REVISIONS	DESIGNED BY:	DATE:	PROJ. SCALE:	143-A LEFLEURS SQUARE JACKSON, MS 39211 601-355-9326 FAX 601-352-3945	CITY OF RIDGELAND <b>WIDENING OF EAST COUNTY LINE ROAD</b> STP-7305-00(003)	<b>NORTHPOINTE PARKWAY</b> (STATION 10+00 TO 12+00)	SHEET NUMBER: <b>16</b>
		BY:	PROJECT:	VERT. SCALE:				
		SW	T94-148	1"=5'				

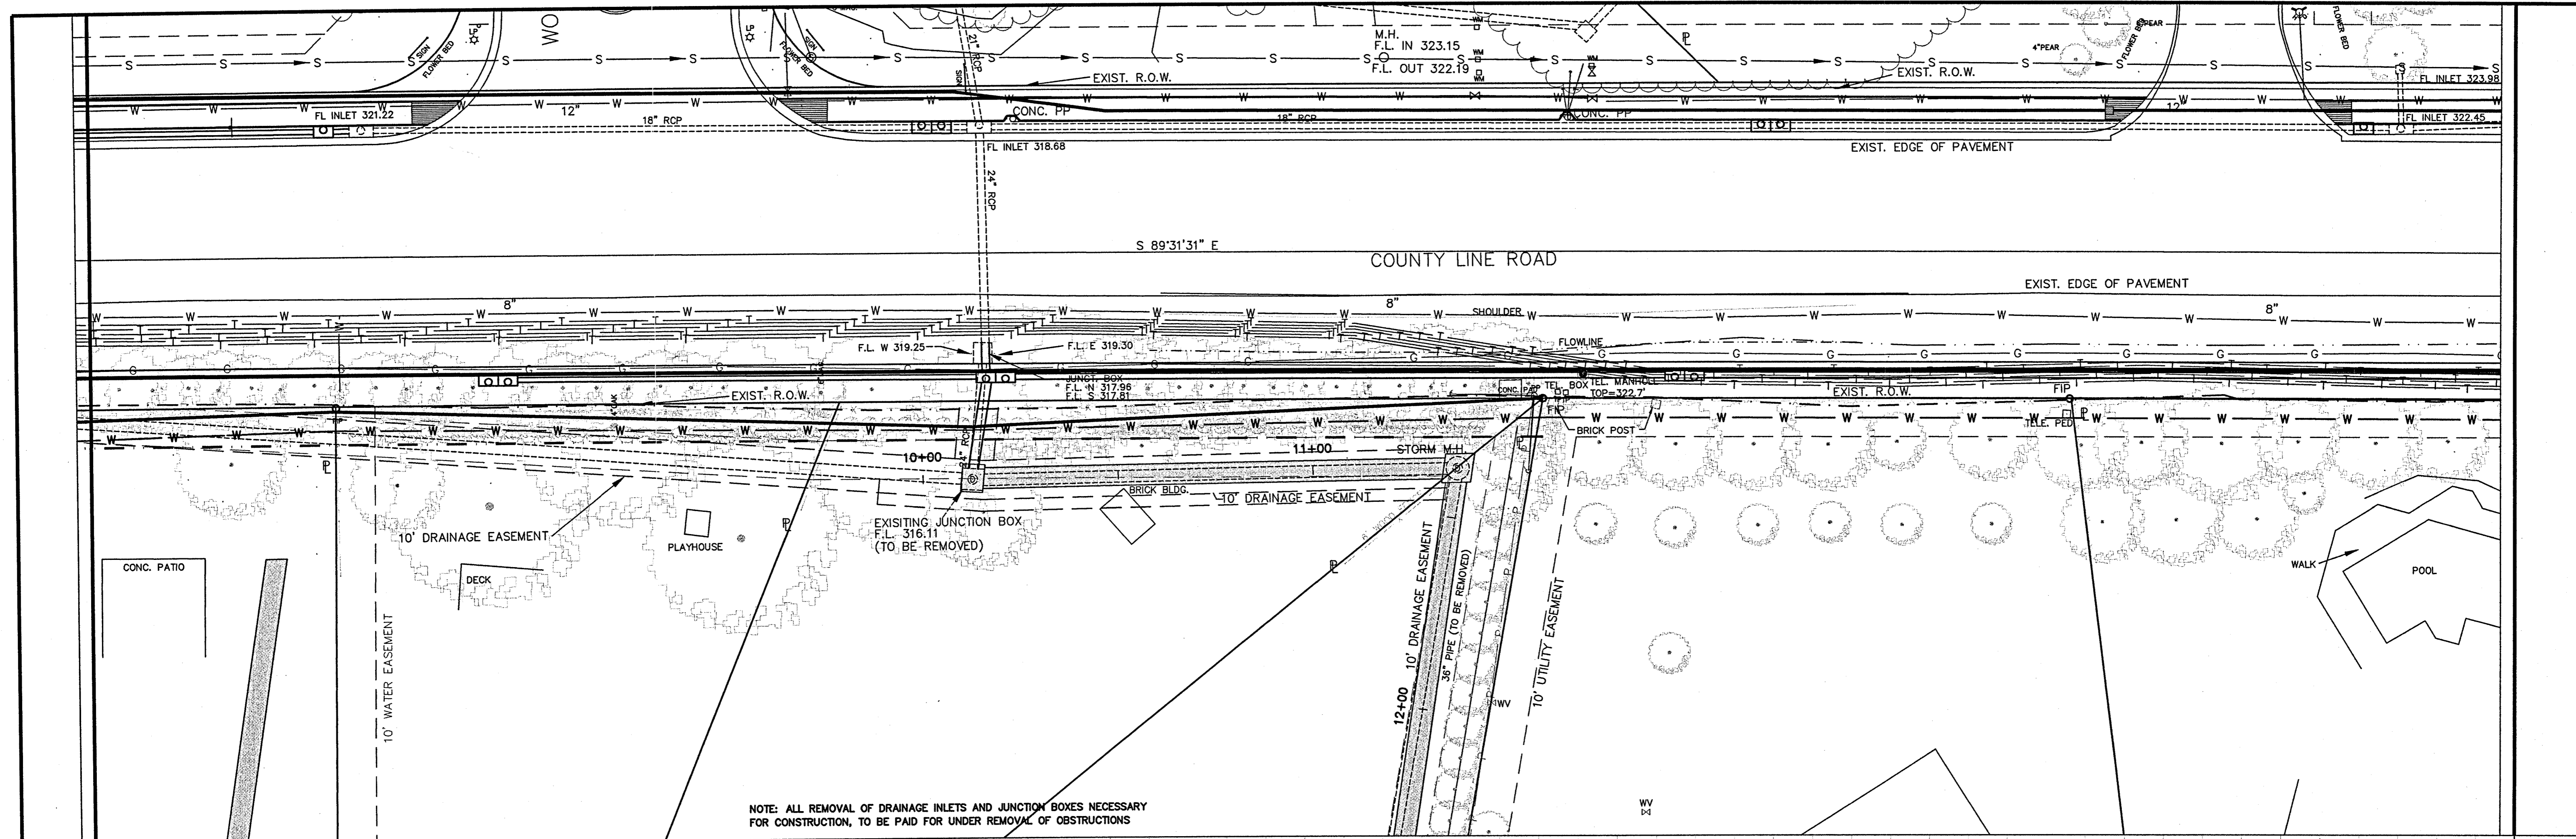


NOTE: ALL REMOVAL OF DRAINAGE INLETS AND JUNCTION BOXES NECESSARY FOR CONSTRUCTION, TO BE PAID FOR UNDER REMOVAL OF OBSTRUCTIONS

STA. 14+90.9  
REPLACE EXISTING JB  
I.C. = 319.20  
F.L. = 316.00


STA. 11+38  
REPLACE EXISTING JB  
I.C. = 317.65  
F.L. = 314.20

330  
325  
320  
315  
310  
305  
300  
295

330  
325  
320  
315  
310  
305  
300  
295

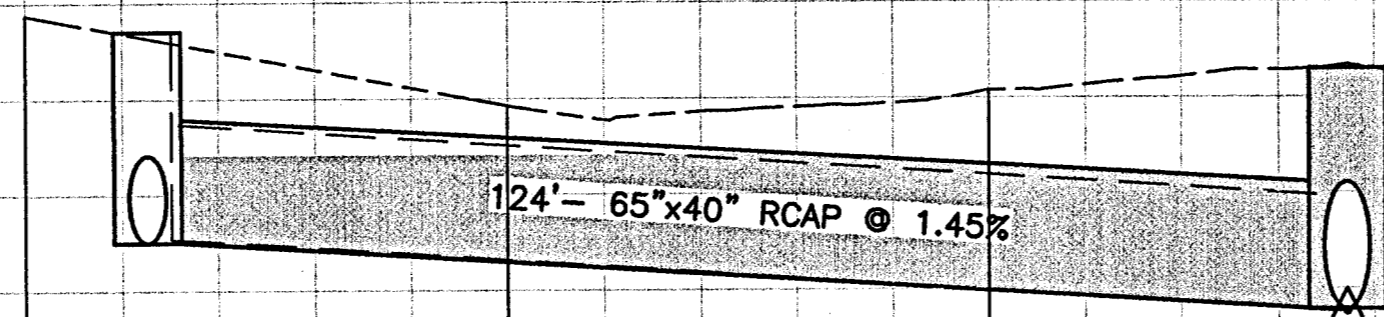



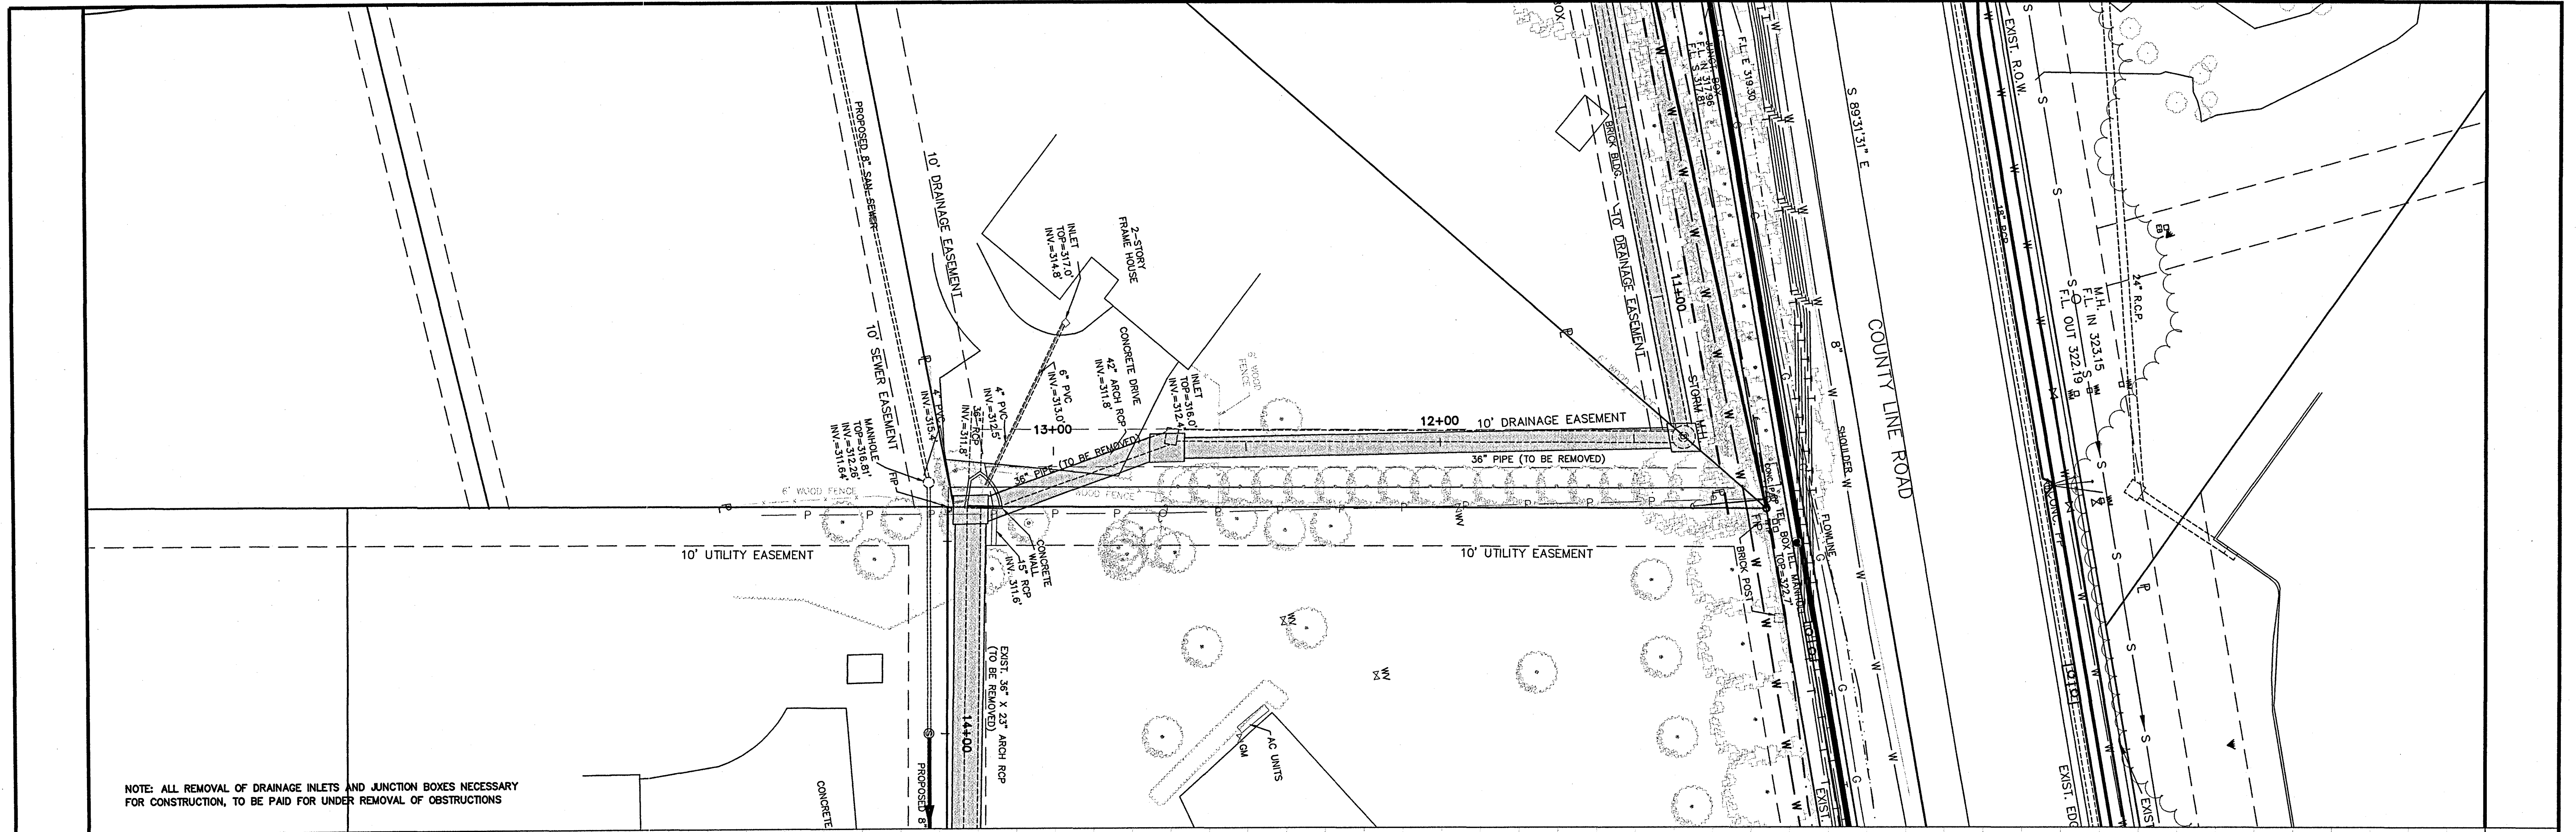


NOTE: ALL REMOVAL OF DRAINAGE INLETS AND JUNCTION BOXES NECESSARY FOR CONSTRUCTION, TO BE PAID FOR UNDER REMOVAL OF OBSTRUCTIONS


STA. 11+38  
REPLACE EXISTING JB  
I.C. = 316.20  
F.L. = 311.00

STA. 12+72  
REPLACE EXISTING GRATE INLET  
I.C. = 316.20  
F.L. = 312.00

STA. 11+38  
REPLACE EXISTING JB  
I.C. = 317.85  
F.L. = 314.20

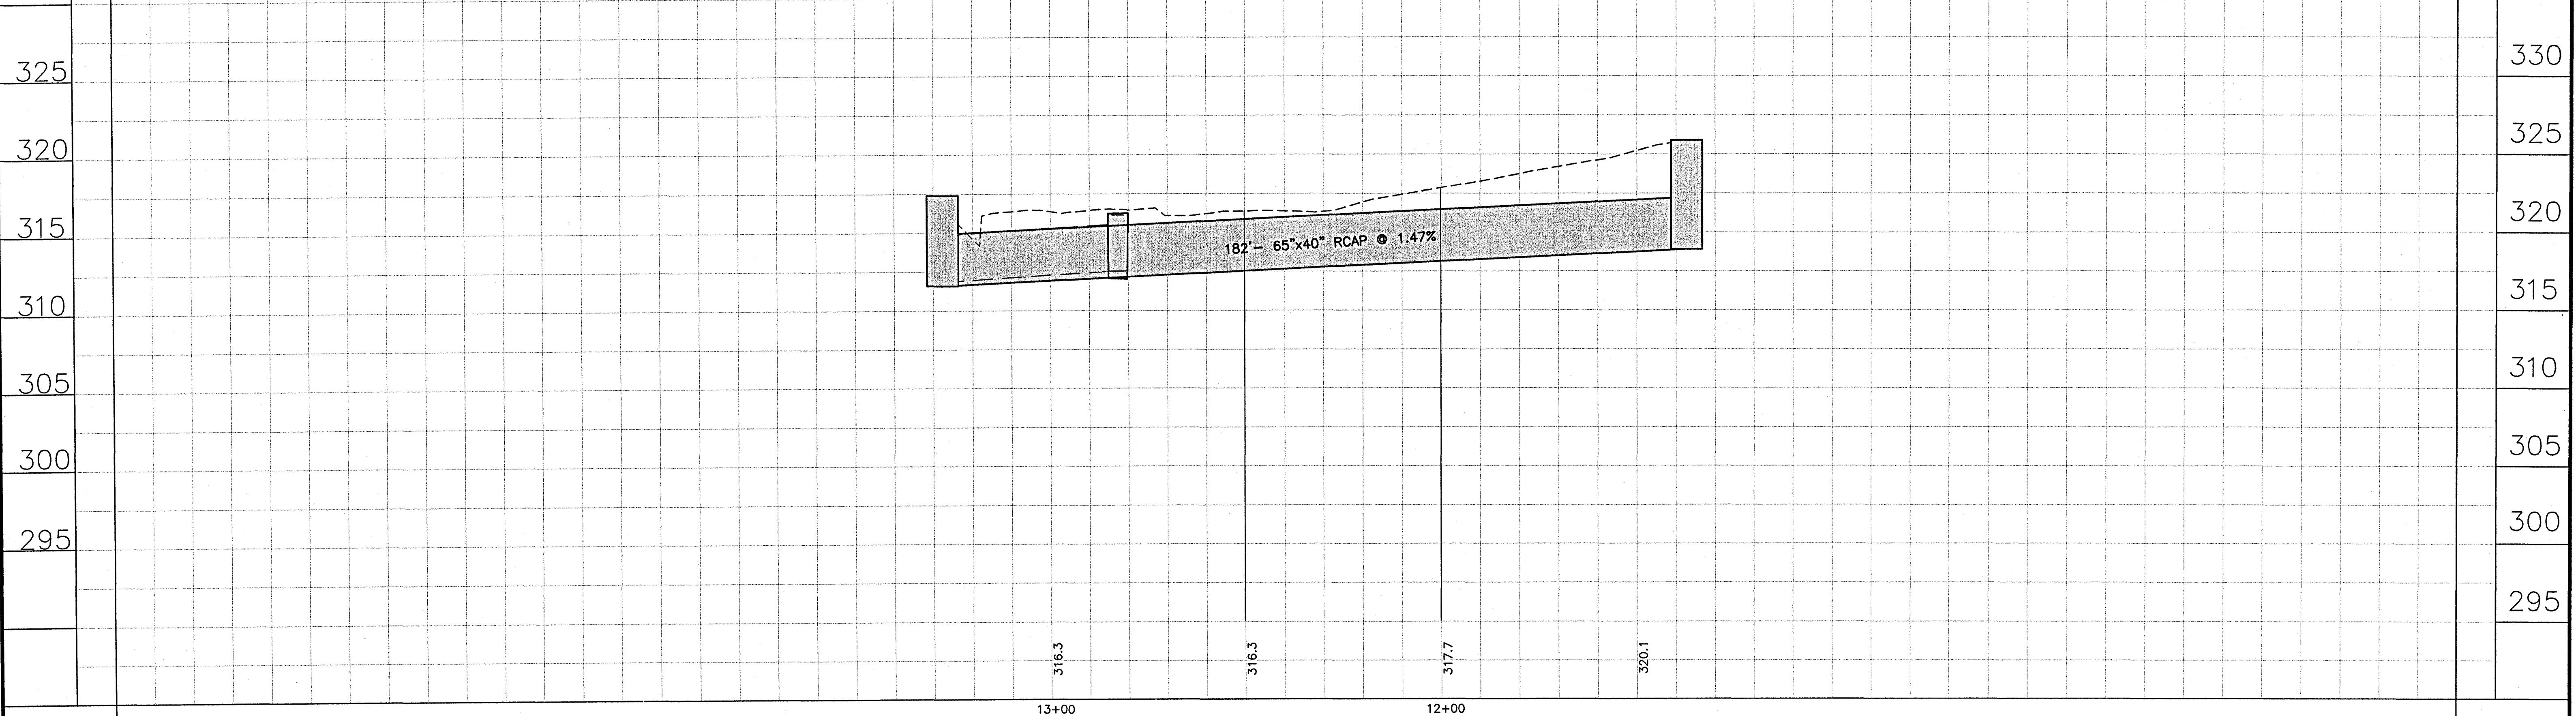



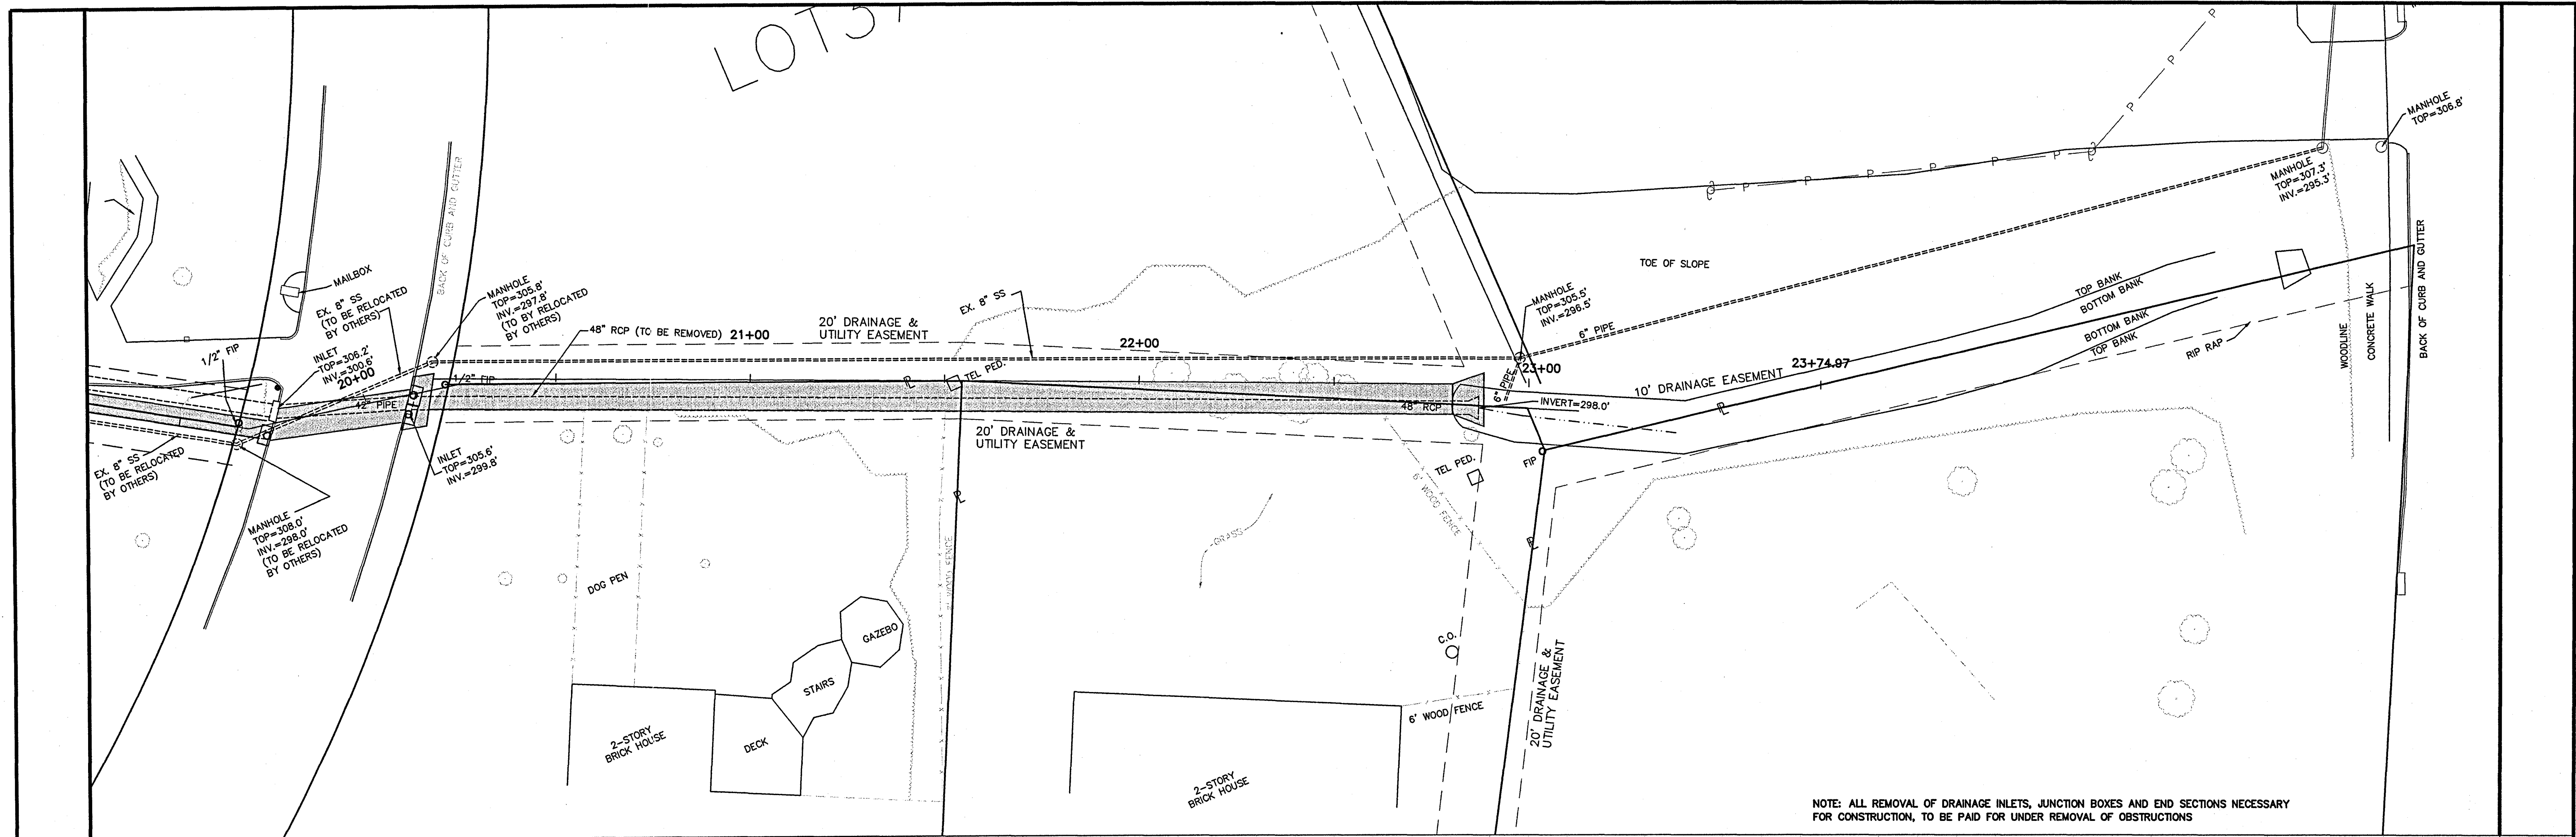


NOTE: ALL REMOVAL OF DRAINAGE INLETS, JUNCTION BOXES AND END SECTIONS NECESSARY FOR CONSTRUCTION, TO BE PAID FOR UNDER REMOVAL OF OBSTRUCTIONS



STA. 19+72.00  
REPLACE EXISTING CURB INLET  
W/ TYPE "C" DOUBLE INLET  
I.C. = 306.20  
IN = 300.60  
OUT = 300.50

STA. 20+12.00  
REPLACE EXISTING CURB INLET  
W/ TYPE "C" DOUBLE INLET  
I.C. = 305.60  
IN = 299.80  
OUT = 299.70

STA. 22+79.00  
REPLACE EXISTING 48" FES  
W/ 88" 54" FES  
FL = 298.00

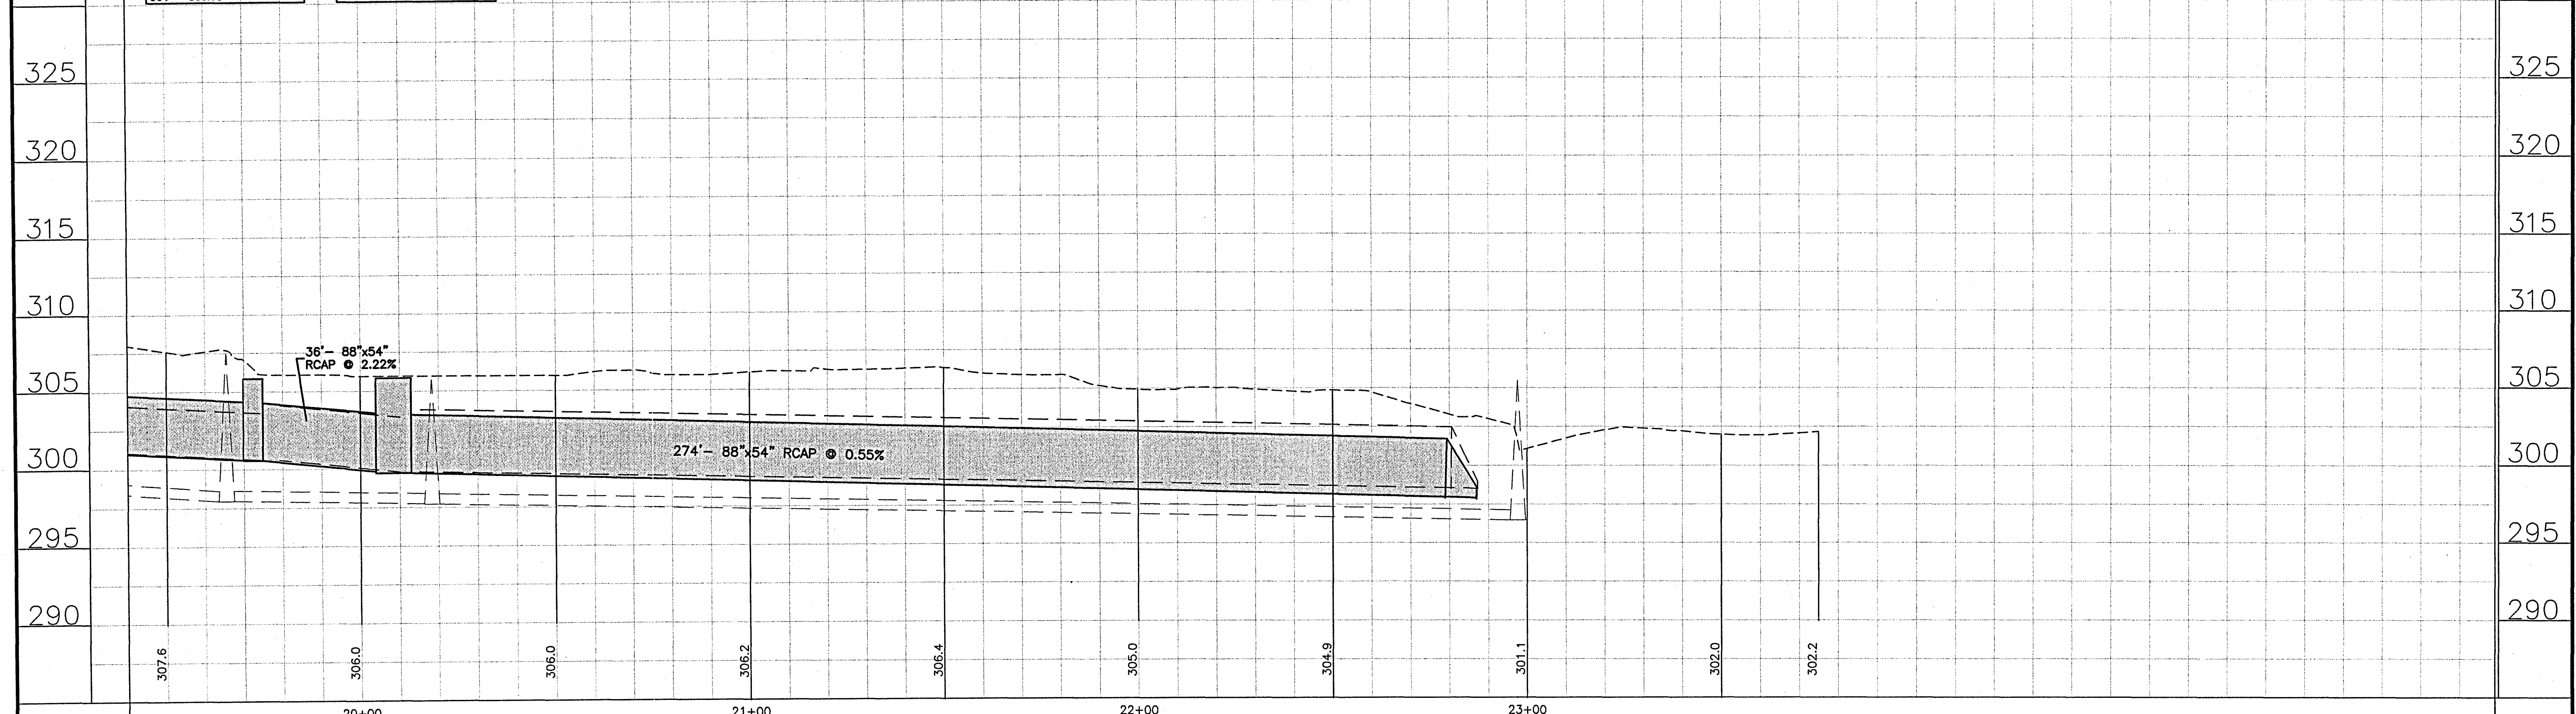



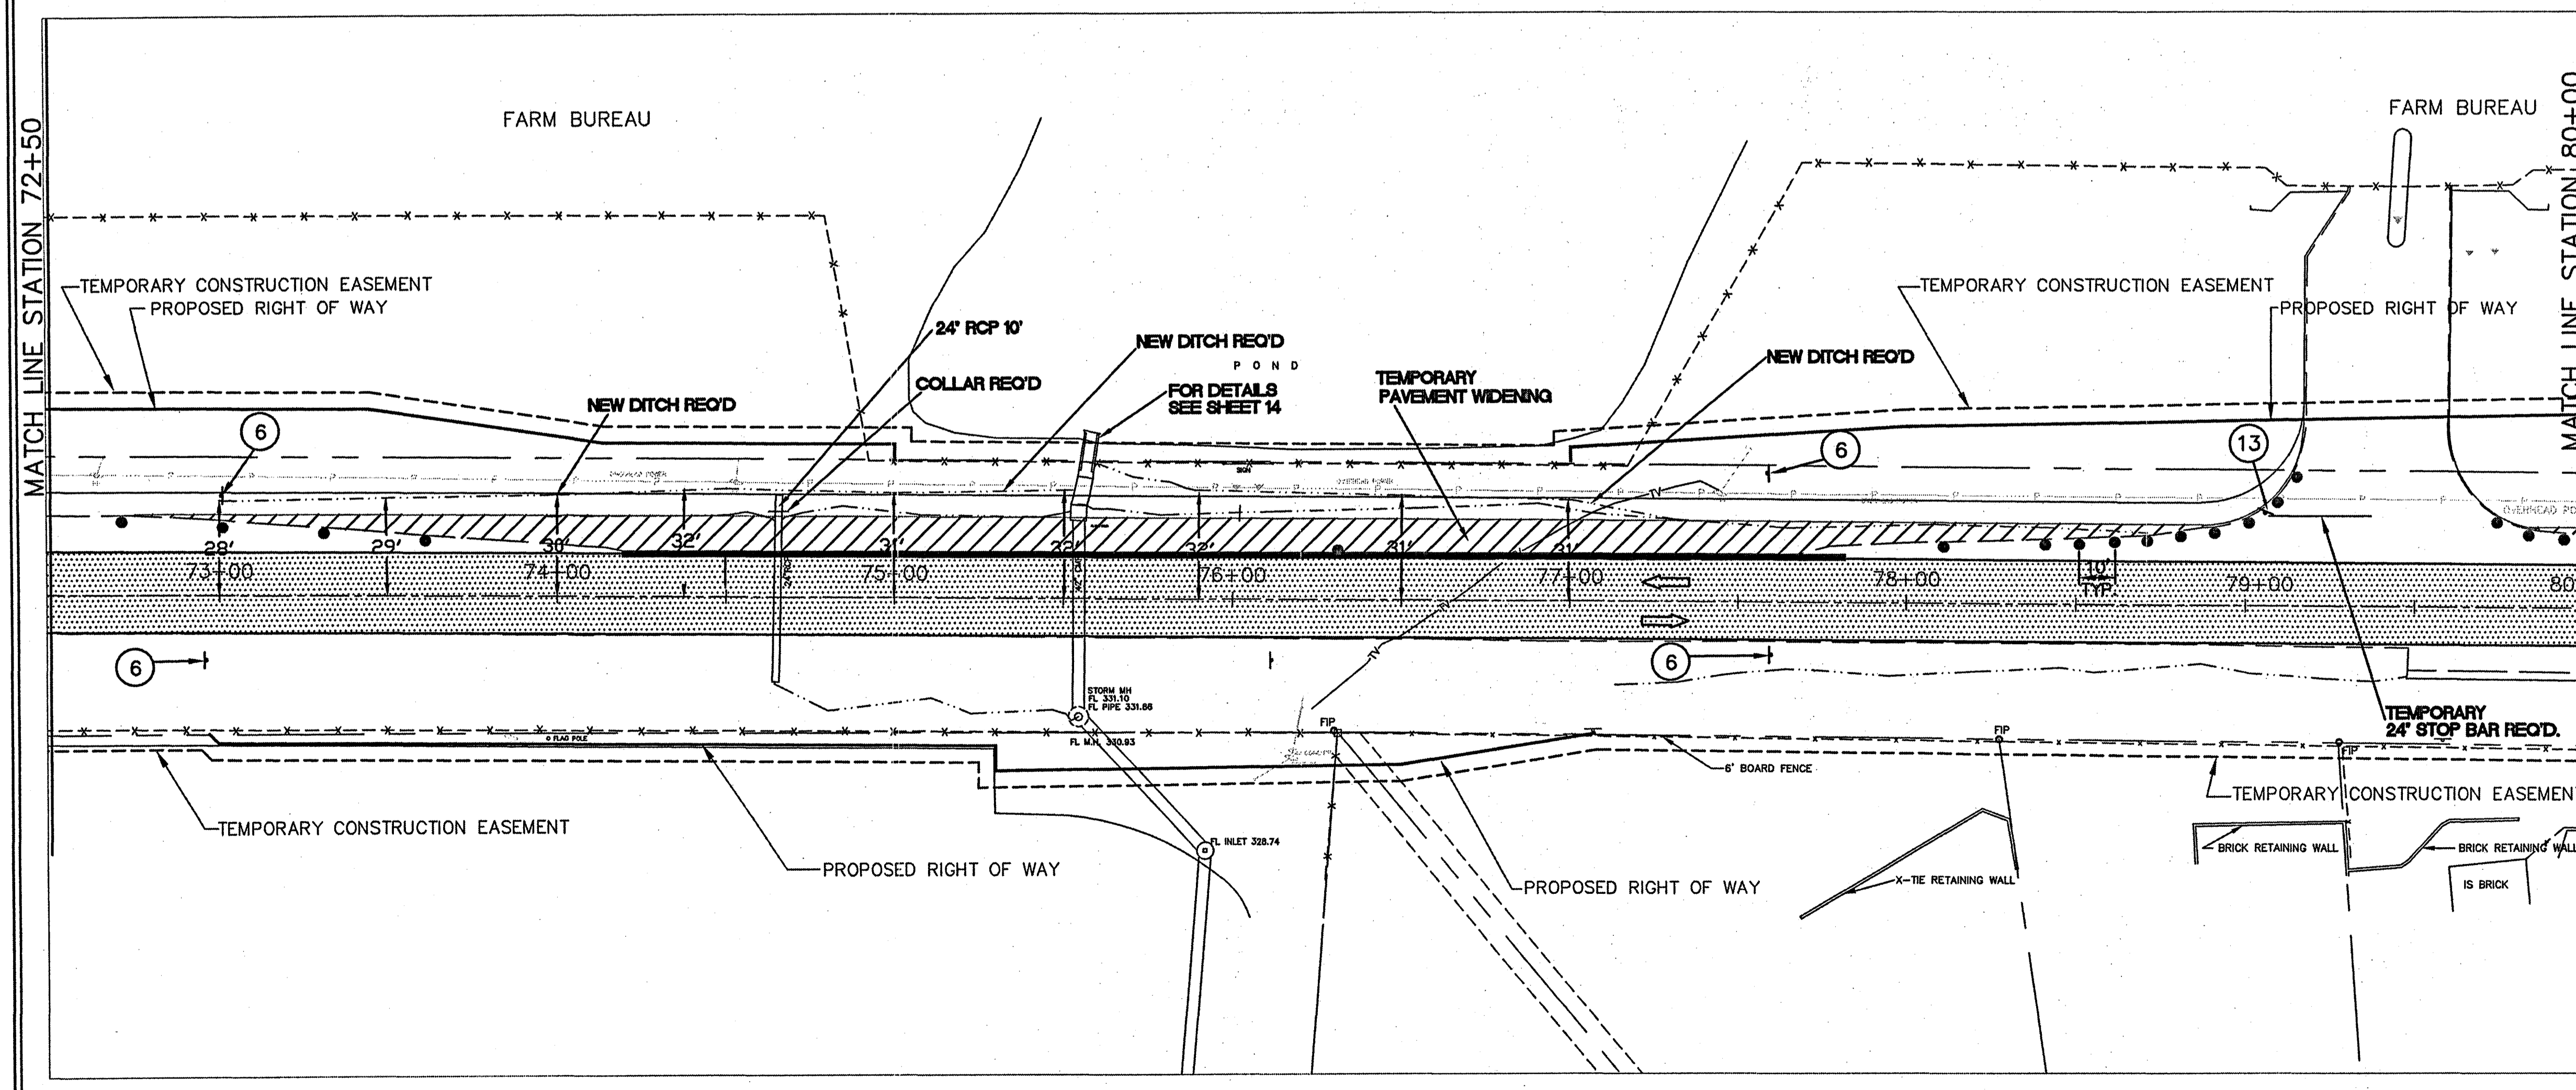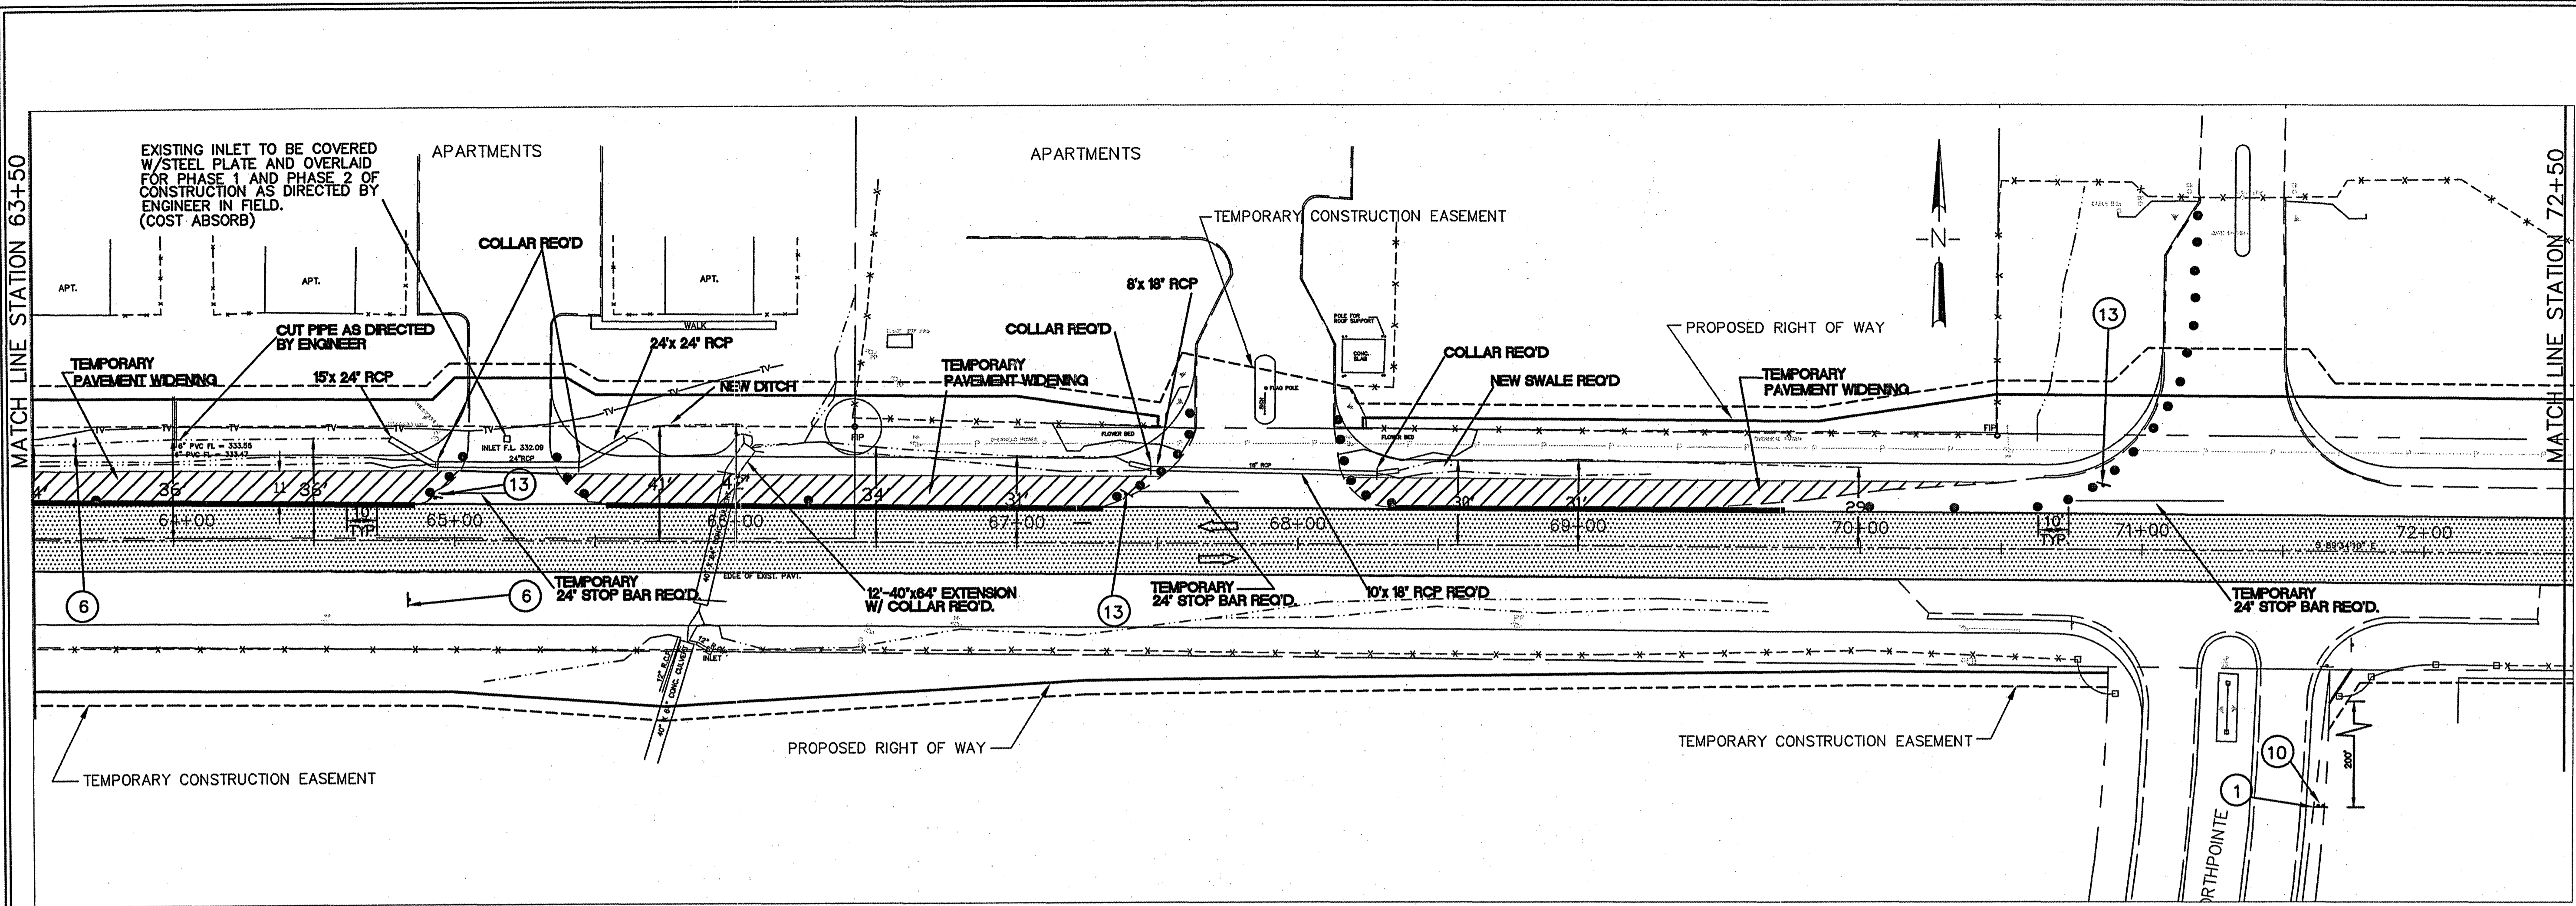

CONSTRUCTION SIGN SCHEDULE		
SIGN NUMBER	MUTCD NUMBER	DESCRIPTION
1		TYPE III BARRICADE
2	M4-10L	DETOUR ARROW LEFT
3	W20-1	ROAD WORK 200 FEET
4	W20-1	ROAD WORK 400 FEET
5	W20-1	ROAD WORK 600 FEET
6	W6-3	TWO WAY TRAFFIC
7	W13-1	ADVISING SPEED PLATE (30 MPH)
8	W4-2(L)	LANE REDUCTION TRANSITION SIGN (RIGHT)
9	G20-2A	END ROAD WORK
10	W20-1	ROAD WORK AHEAD
11	W9-2	LANE ENDS MERGE LEFT
12	G20-1	ROAD WORK NEXT 0.9 MILES
13	R1-1	STOP
14	R1-2	YIELD
15	W20-3	ROAD CLOSED
16	R4-1	DO NOT PASS

**NOTE:**  
1. FOR DETAILS AND GENERAL NOTES SEE SHEET  
2. EXISTING STRIPING TO REMAIN DURING THIS PHASE



CITY OF RIDGELAND  
**WIDENING OF EAST**  
**COUNTY LINE ROAD**  
 STP-7305-00(003)

DRAWING REVISIONS		
NO.	REMARKS	DATE

DRAWN BY: \_\_\_\_\_ SCALE: 1" = 30'  
 DESIGNED BY: \_\_\_\_\_ DATE: 2-03-05  
 CHECKED BY: SW PROJECT: TR-148  
 DRAWING TITLE:

**TRAFFIC CONTROL PHASE 1**

CITY OF RIDGELAND  
**WIDENING OF EAST**  
**COUNTY LINE ROAD**  
STP-7305-00(003)

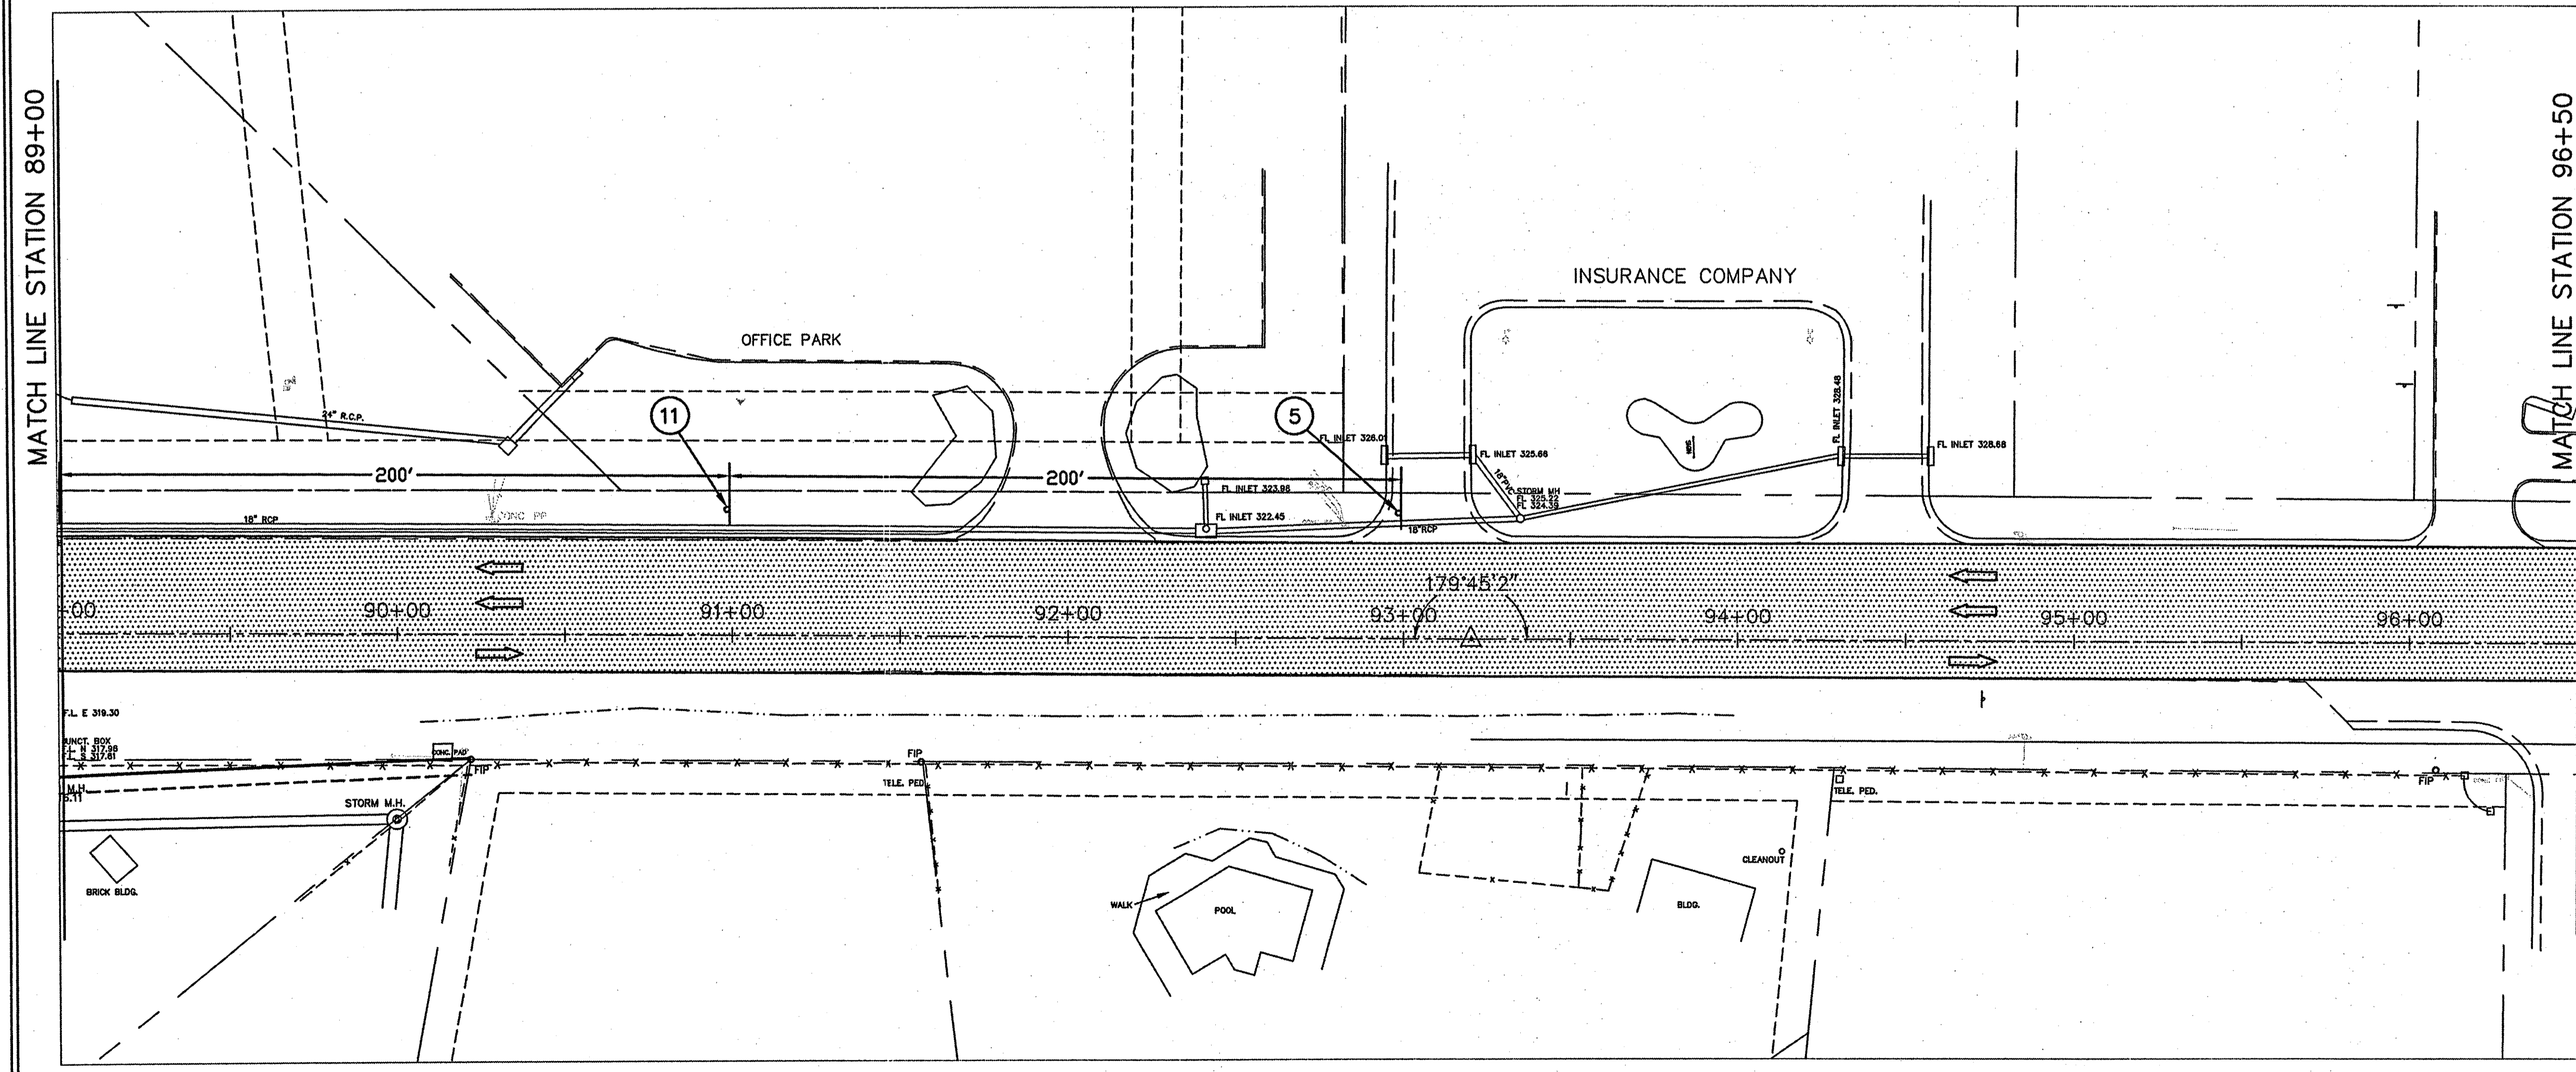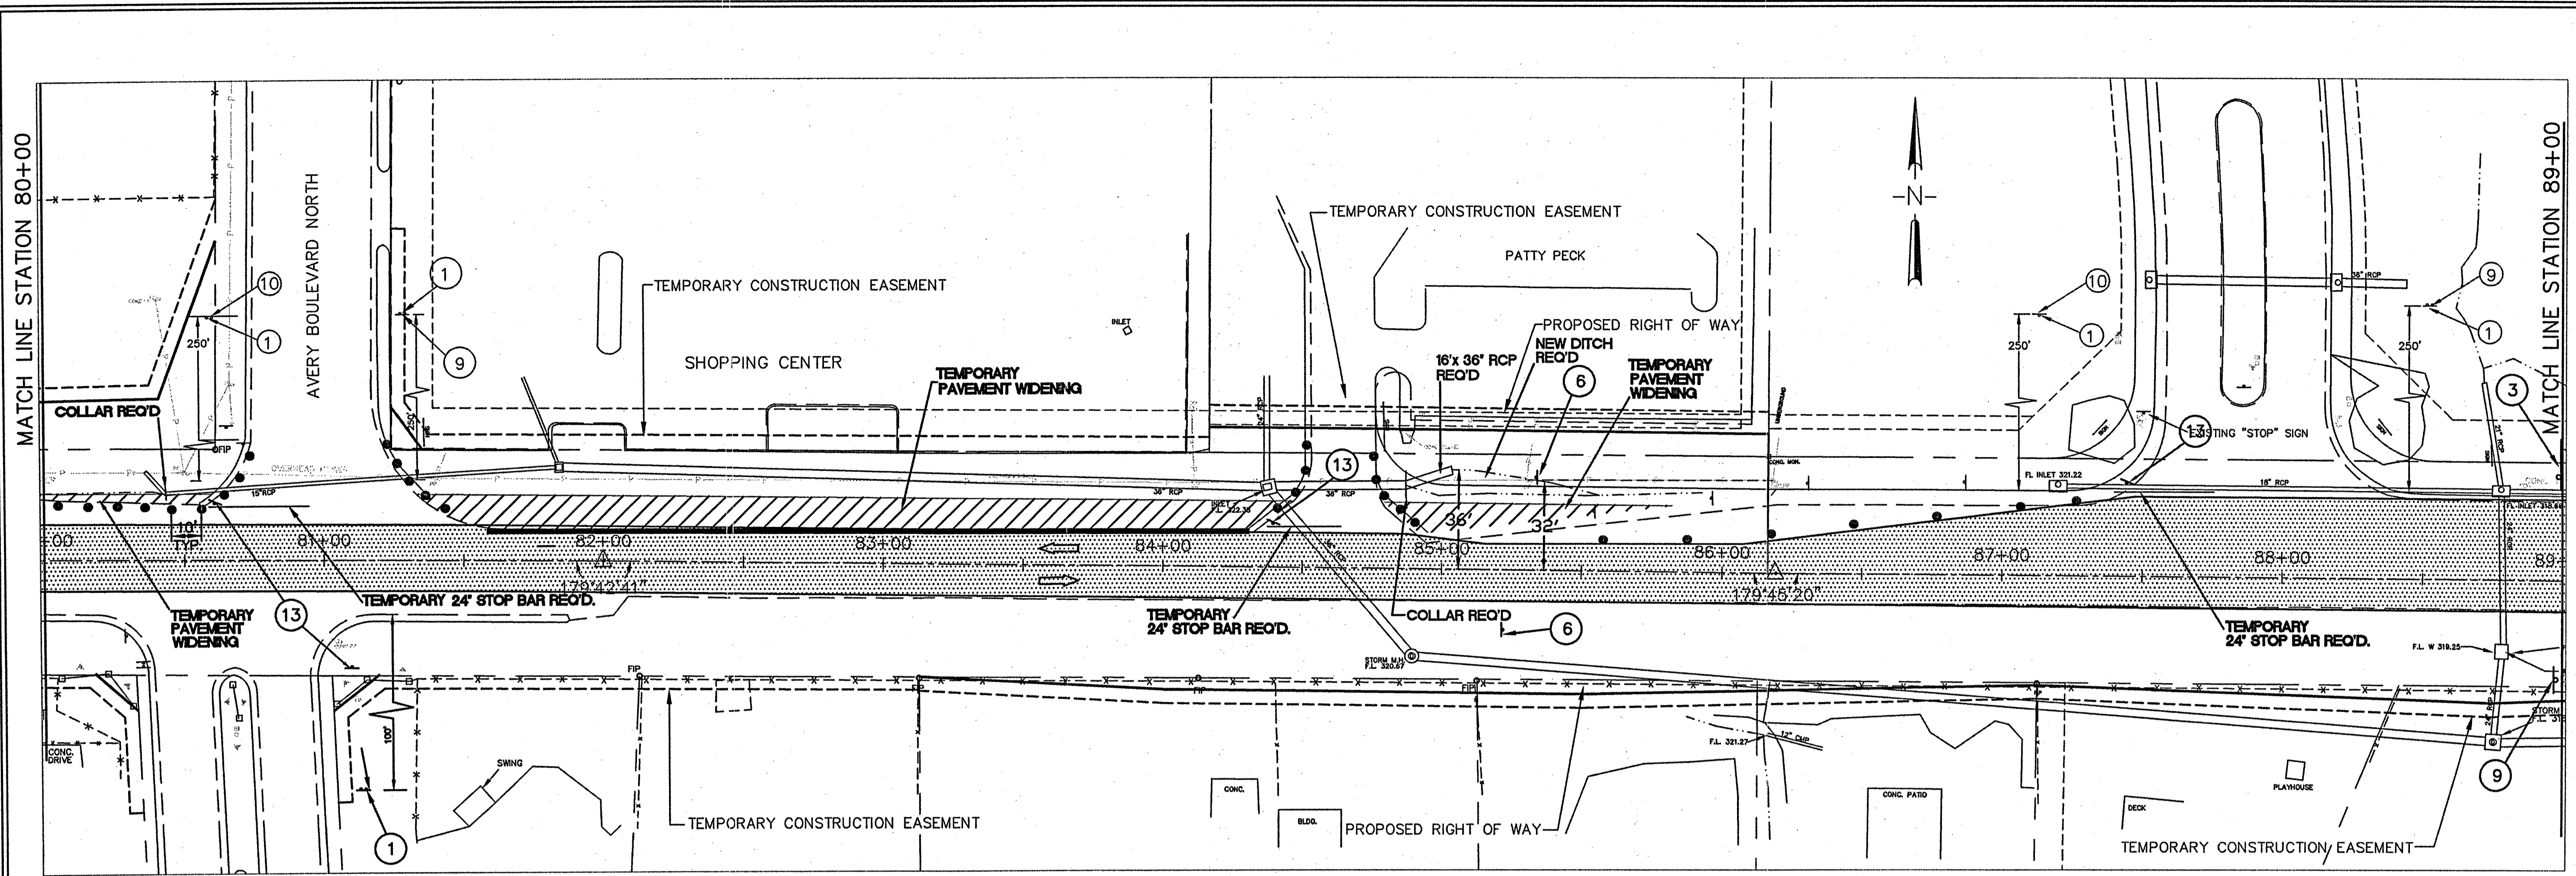

CONSTRUCTION SIGN SCHEDULE		
SIGN NUMBER	MUTCD NUMBER	DESCRIPTION
1		TYPE III BARRICADE
2	M4-10L	DETOUR ARROW LEFT
3	W20-1	ROAD WORK 200 FEET
4	W20-1	ROAD WORK 400 FEET
5	W20-1	ROAD WORK 600 FEET
6	W6-3	TWO WAY TRAFFIC
7	W13-1	ADVISING SPEED PLATE (30 MPH)
8	W4-2(L)	LANE REDUCTION TRANSITION SIGN (RIGHT)
9	G20-2A	END ROAD WORK
10	W20-1	ROAD WORK AHEAD
11	W9-2	LANE ENDS MERGE LEFT
12	G20-1	ROAD WORK NEXT 0.9 MILES
13	R1-1	STOP
14	R1-2	YIELD
15	W20-3	ROAD CLOSED
16	R4-1	DO NOT PASS
17		TYPICAL END OF ROAD MARKER

**NOTE:**  
1. FOR DETAILS AND GENERAL NOTES SEE SHEET  
2. EXISTING STRIPING TO REMAIN DURING THIS PHASE

DRAWING REVISIONS		
NO.	REMARKS	DATE



DESIGNED BY: SW DATE: 2-23-05  
CHECKED BY: SW PROJECT: TR-148  
DRAWING TITLE:  
**TRAFFIC CONTROL PHASE 1**







CITY OF RIDGELAND  
**WIDENING OF EAST**  
**COUNTY LINE ROAD**  
STP-7305-00(003)

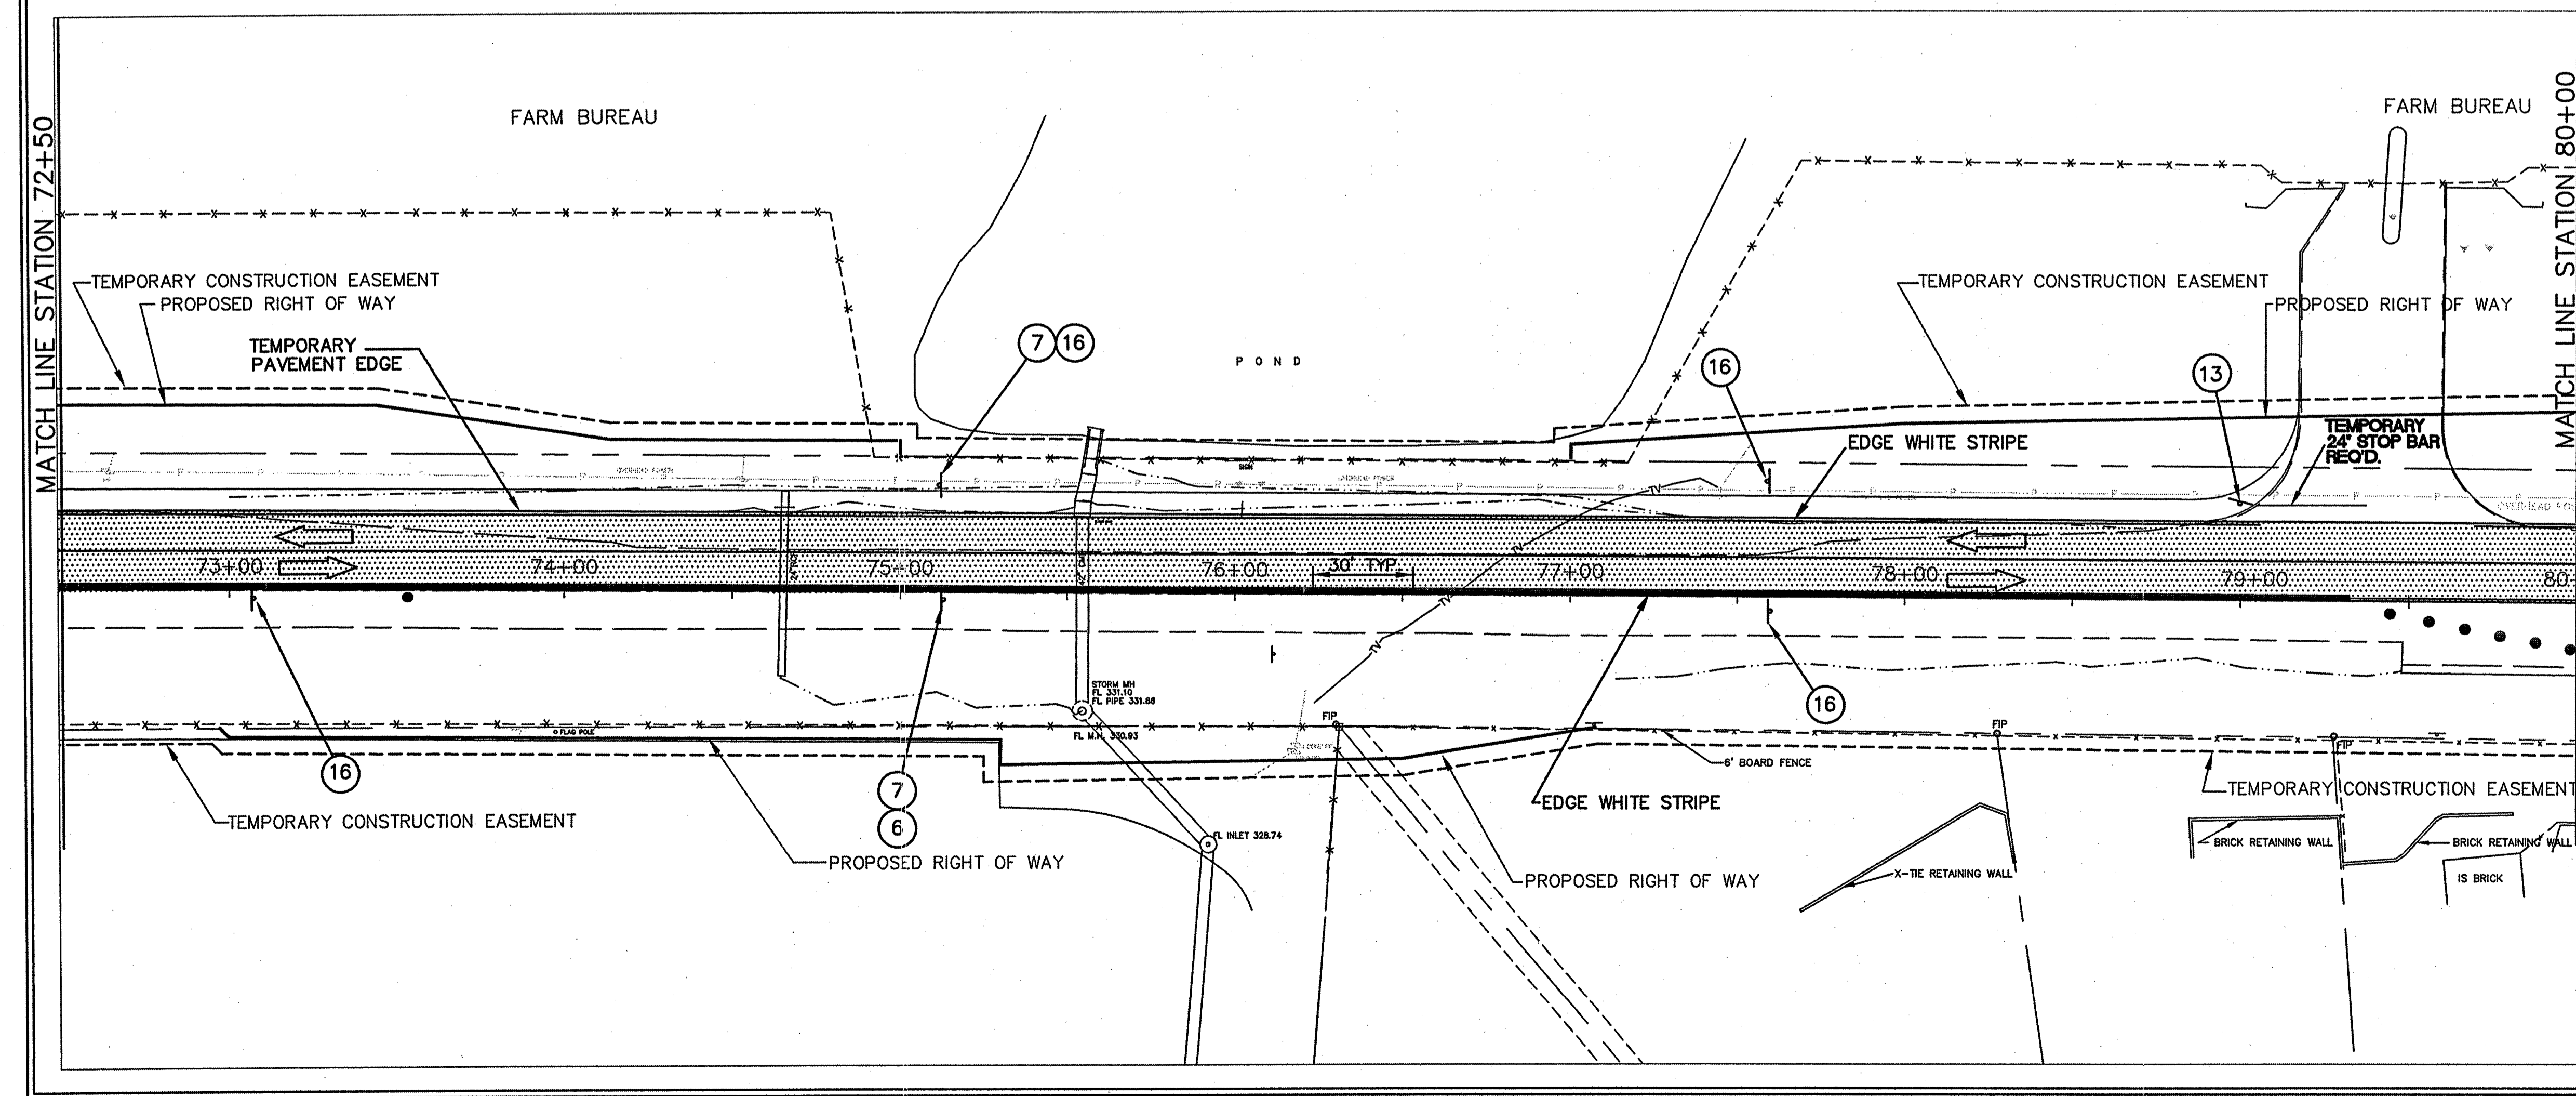
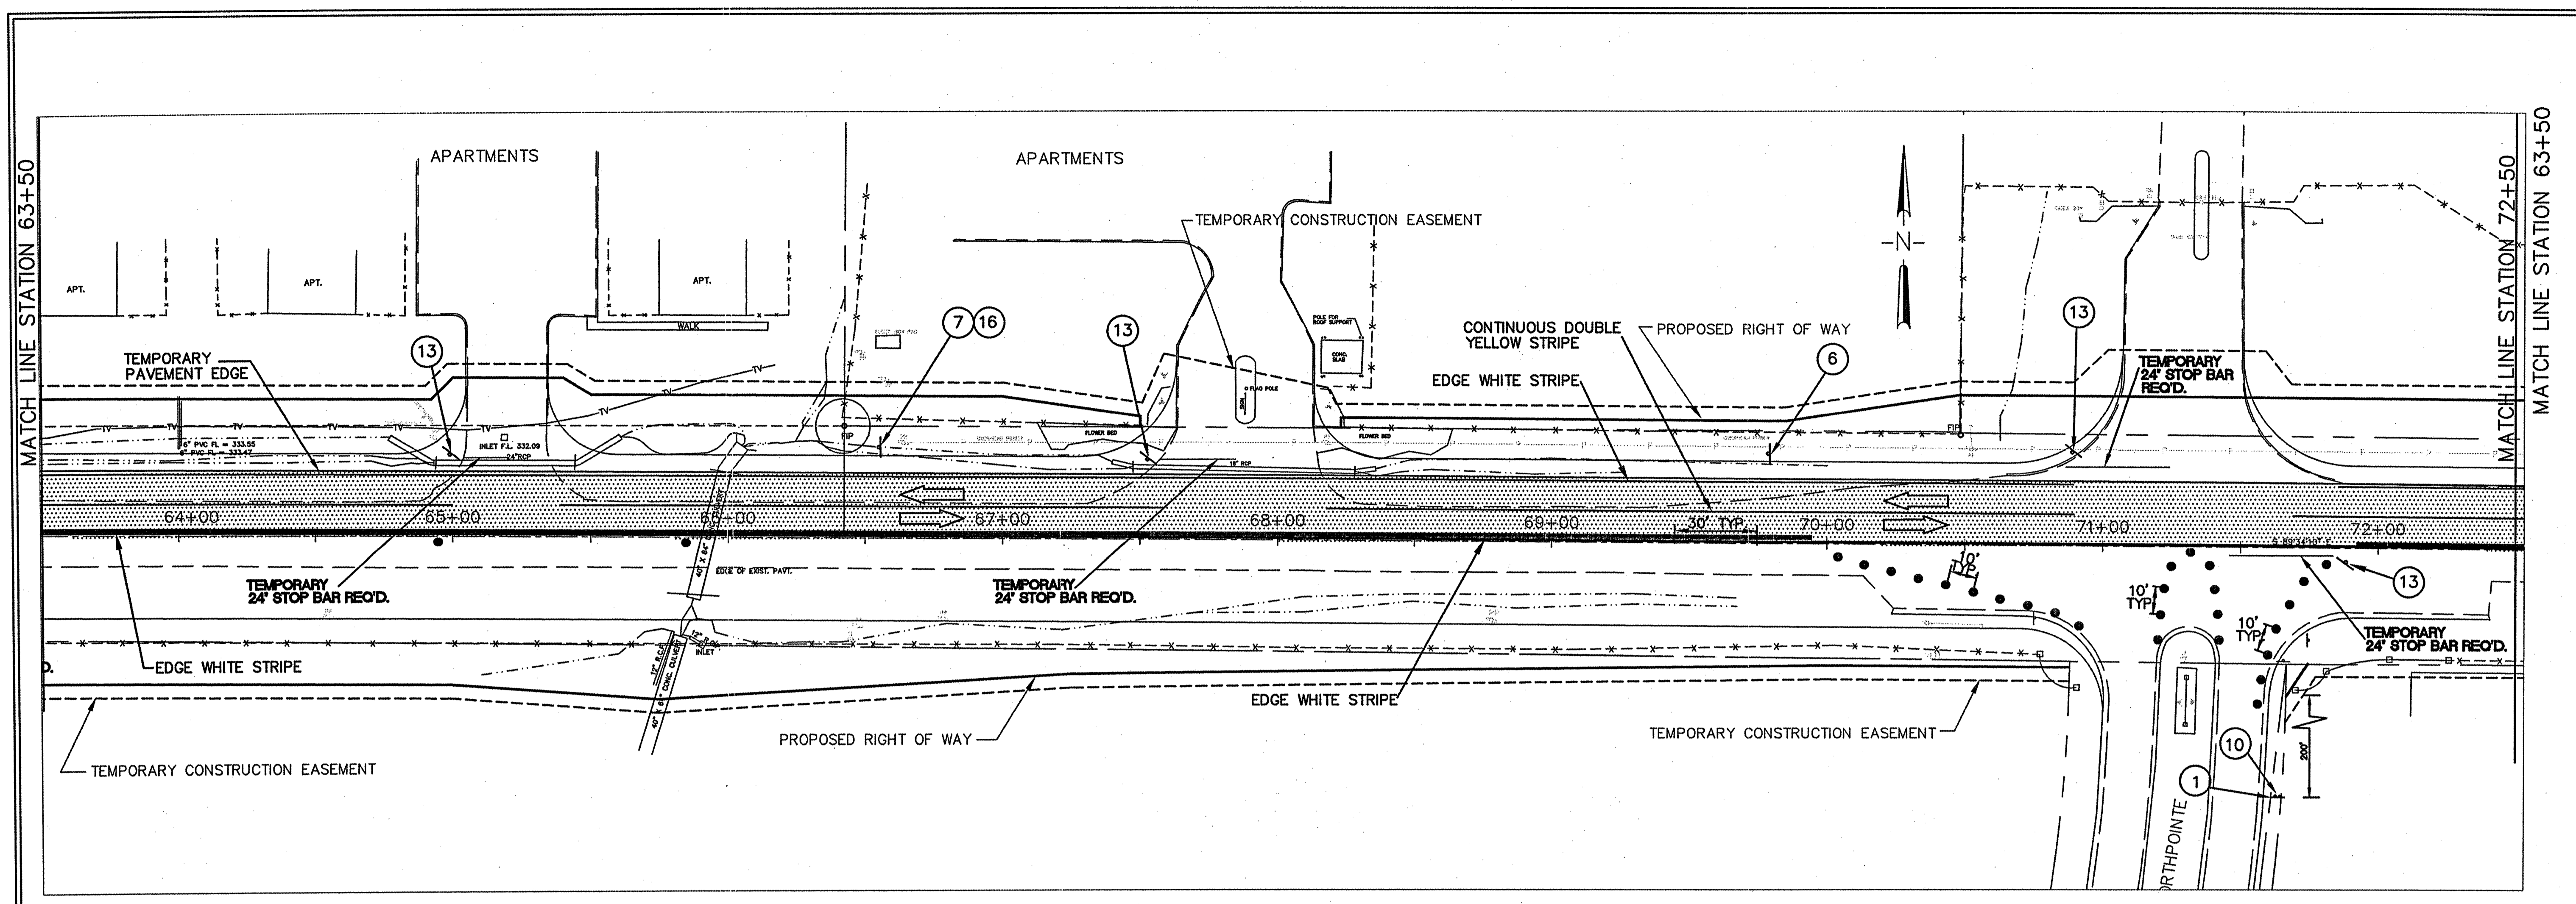


CONSTRUCTION SIGN SCHEDULE		
SIGN NUMBER	MUTCD NUMBER	DESCRIPTION
1		TYPE III BARRICADE
2	M4-10L	DETOUR ARROW LEFT
3	W20-1	ROAD WORK 200 FEET
4	W20-1	ROAD WORK 400 FEET
5	W20-1	ROAD WORK 600 FEET
6	W6-3	TWO WAY TRAFFIC
	W13-1	ADVISING SPEED PLATE (30 MPH)
	W4-2(L)	LANE REDUCTION TRANSITION SIGN (RIGHT)
	G20-2A	END ROAD WORK
	W20-1	ROAD WORK AHEAD
	W9-2	LANE ENDS MERGE LEFT
	G20-1	ROAD WORK NEXT 0.9 MILES
	R1-1	STOP
	R1-2	YIELD
	W20-3	ROAD CLOSED
	R4-1	DO NOT PASS

1. FOR DETAILS AND GENERAL NOTES SEE SHEET

DRAWING REVISIONS		
NO.	REMARKS	DATE

CITY OF RIDGELAND  
**WIDENING OF EAST**  
**COUNTY LINE ROAD**  
STP-7305-00(003)

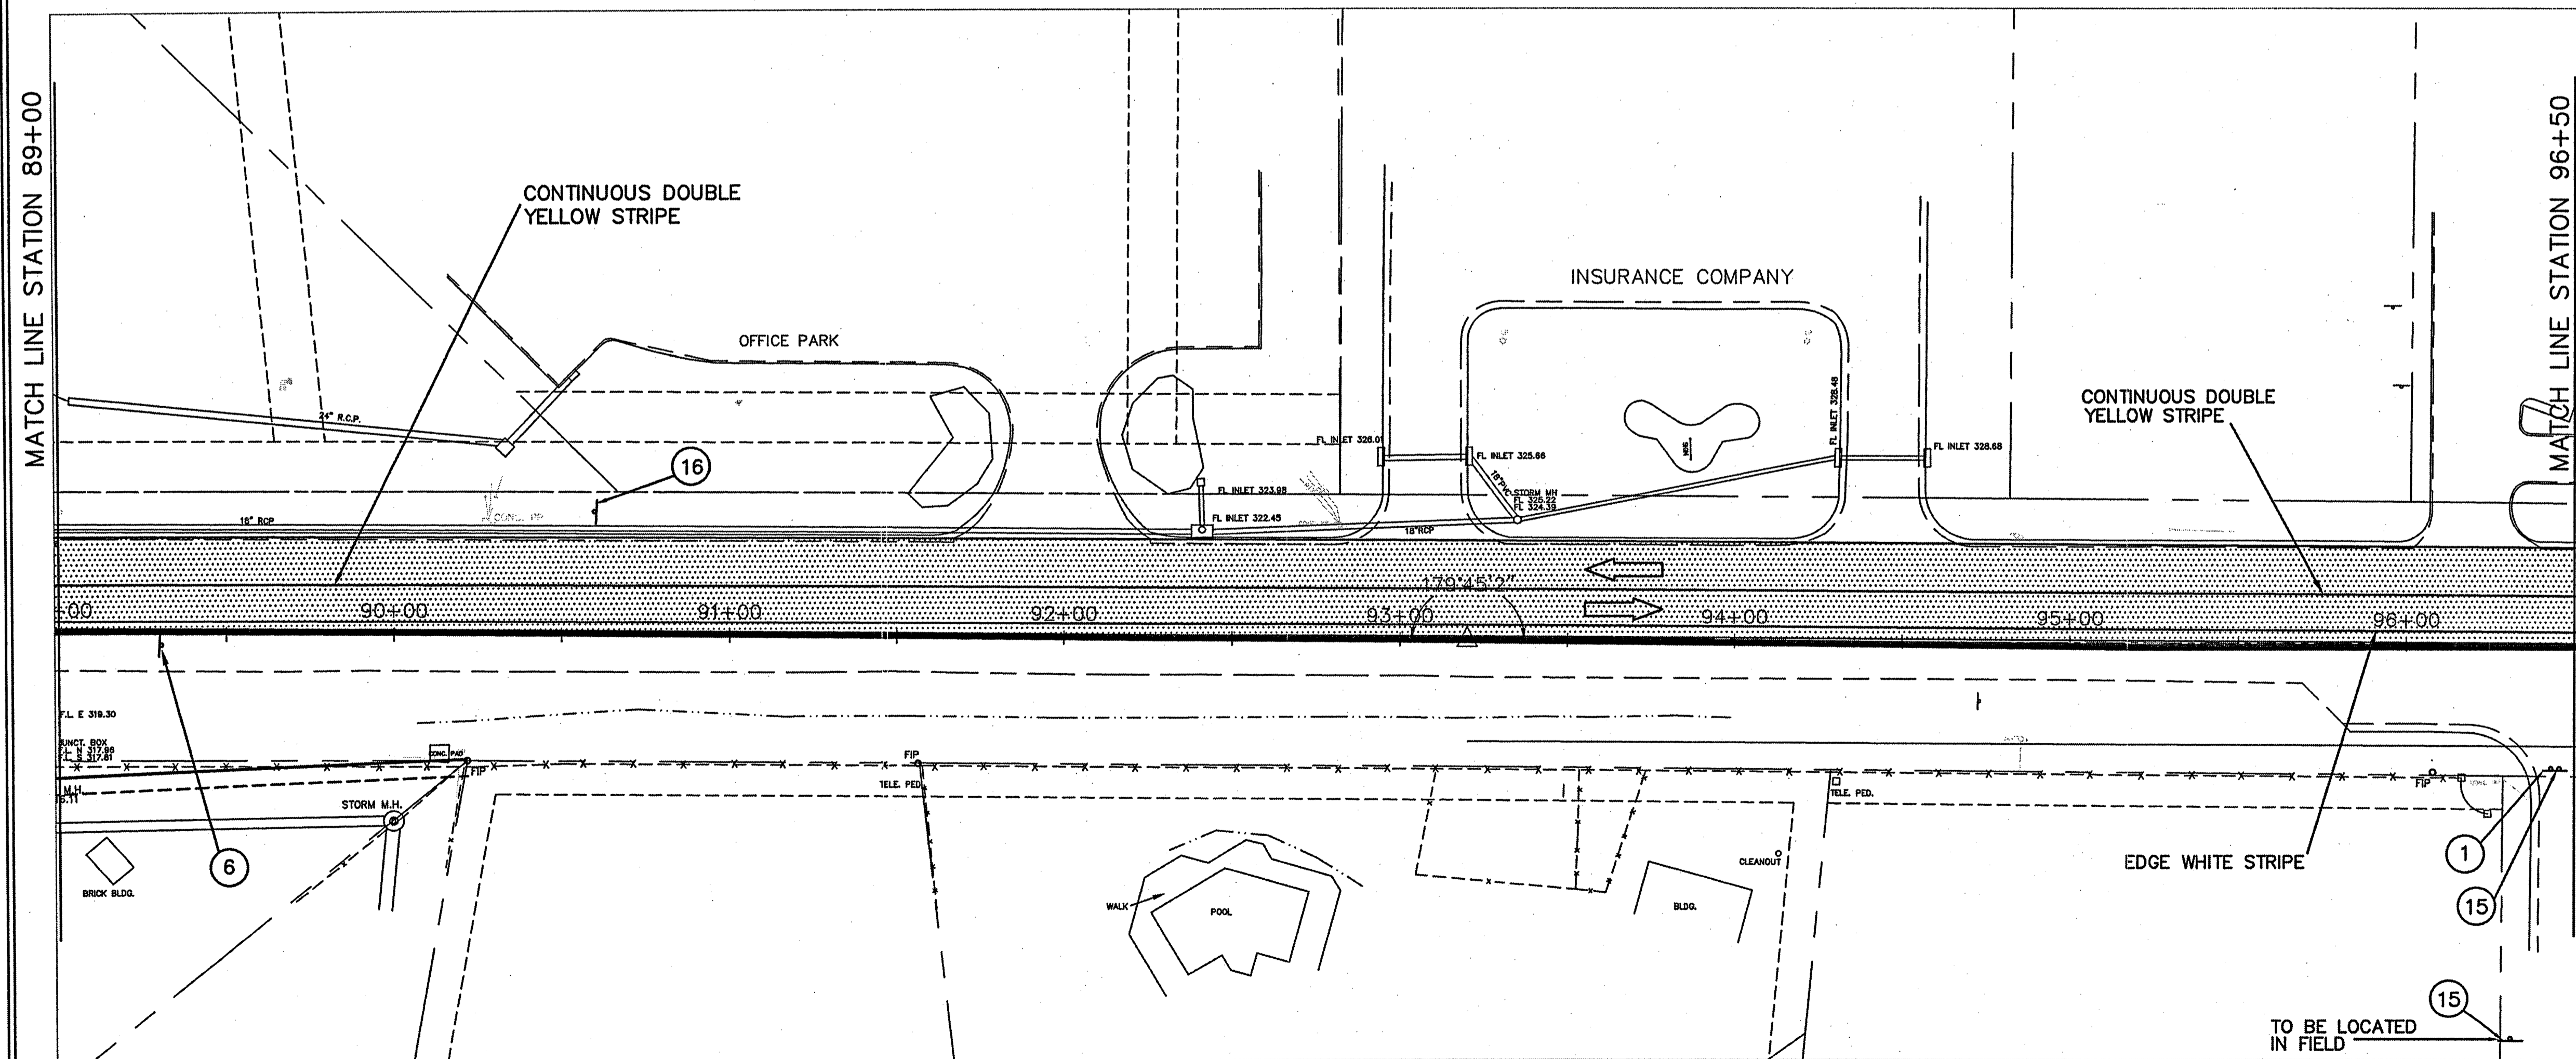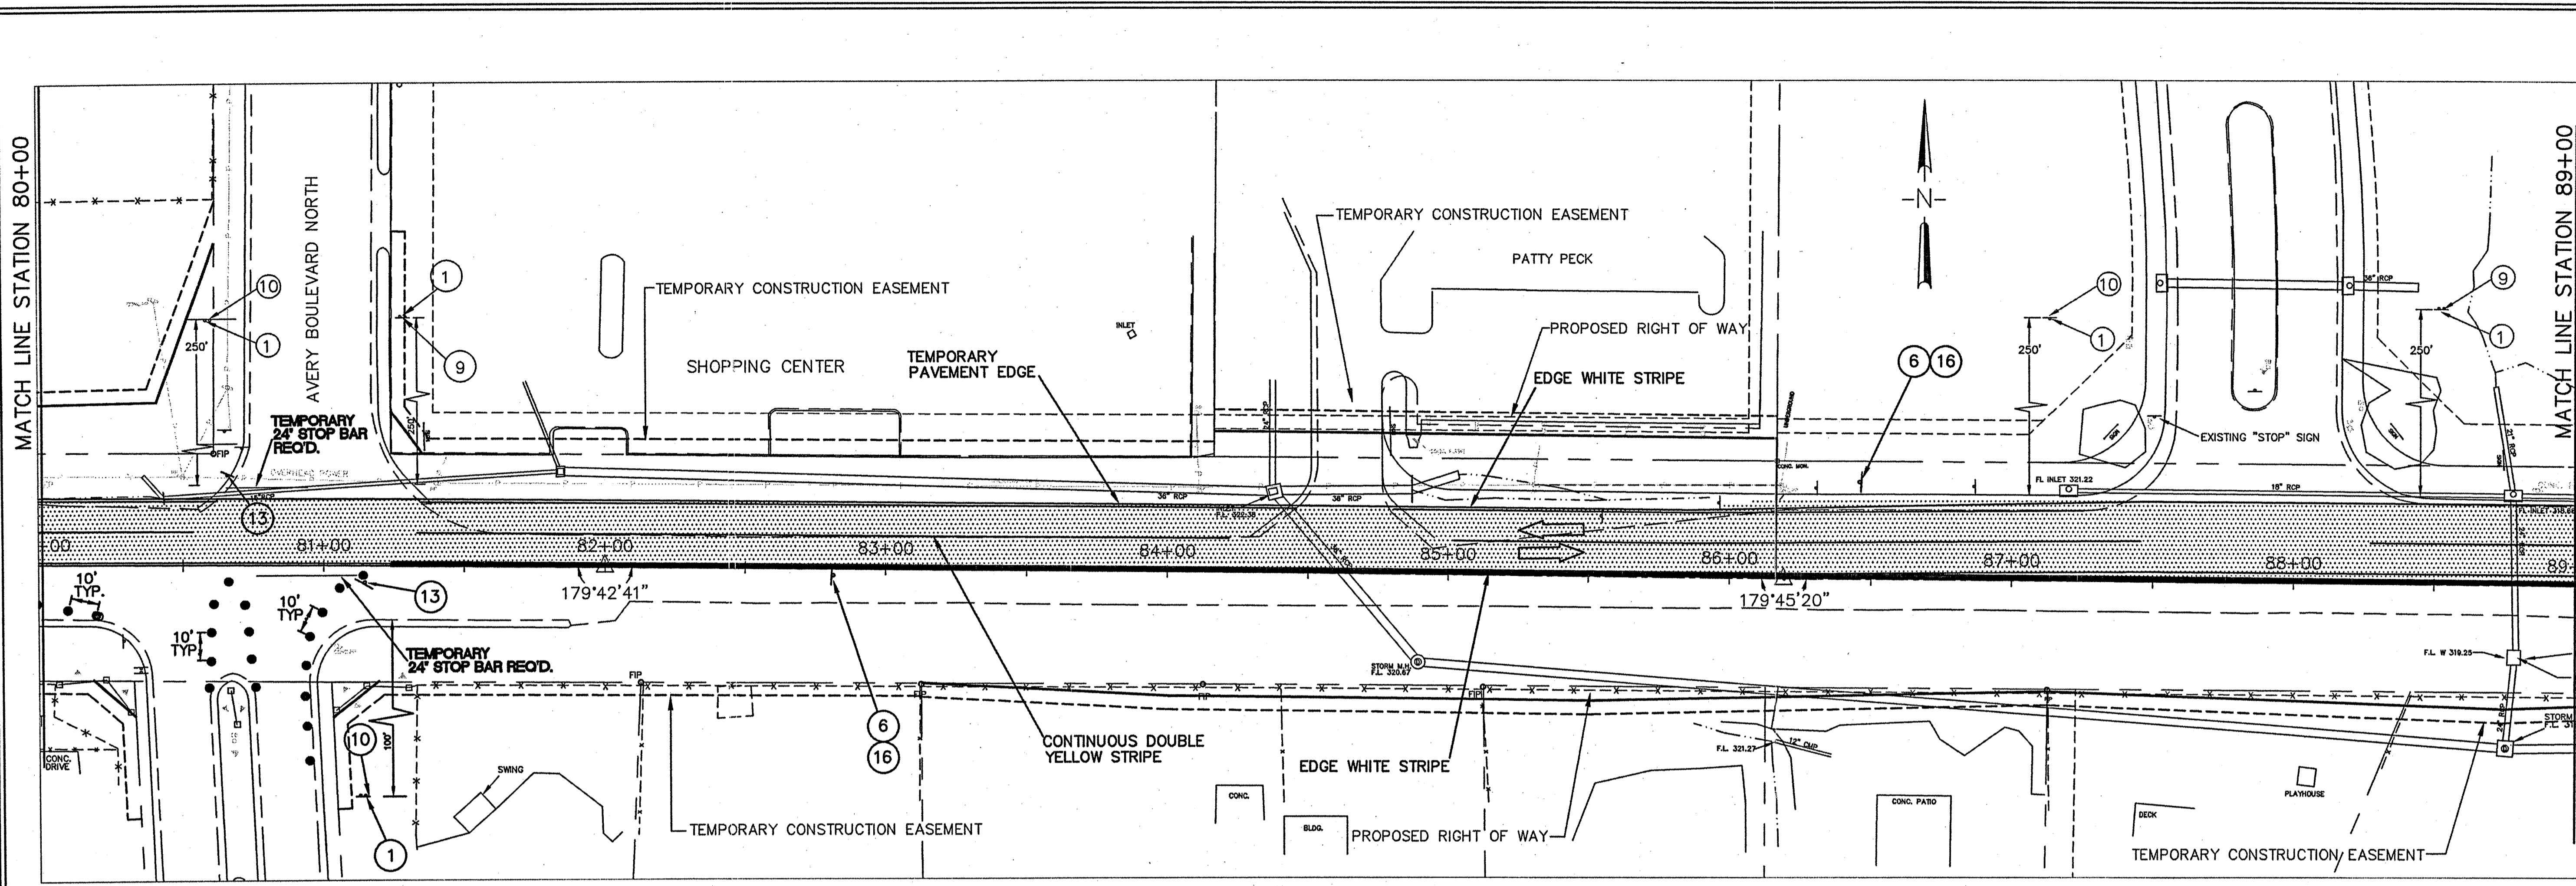

CONSTRUCTION SIGN SCHEDULE		
SIGN NUMBER	MUTCD NUMBER	DESCRIPTION
1		TYPE III BARRICADE
2	M4-10L	DETOUR ARROW LEFT
3	W20-1	ROAD WORK 200 FEET
4	W20-1	ROAD WORK 400 FEET
5	W20-1	ROAD WORK 600 FEET
6	W6-3	TWO WAY TRAFFIC
7	W13-1	ADVISING SPEED PLATE (30 MPH)
8	W4-2(L)	LANE REDUCTION TRANSITION SIGN (RIGHT)
9	G20-2A	END ROAD WORK
10	W20-1	ROAD WORK AHEAD
11	W9-2	LANE ENDS MERGE LEFT
12	G20-1	ROAD WORK NEXT 0.9 MILES
13	R1-1	STOP
14	R1-2	YIELD
15	W20-3	ROAD CLOSED
16	R4-1	DO NOT PASS
17		TYPICAL END OF ROAD MARKER

**NOTE:**  
1. FOR DETAILS AND GENERAL NOTES SEE SHEET

DRAWING REVISIONS		
NO.	REMARKS	DATE



DRAWN BY: \_\_\_\_\_  
DESIGNED BY: \_\_\_\_\_  
CHECKED BY: \_\_\_\_\_  
DATE: 2-03-05  
PROJECT: 734-149

**TRAFFIC CONTROL PHASE 2**





CITY OF RIDGELAND  
**WIDENING OF EAST**  
**COUNTY LINE ROAD**  
STP-7305-00(003)

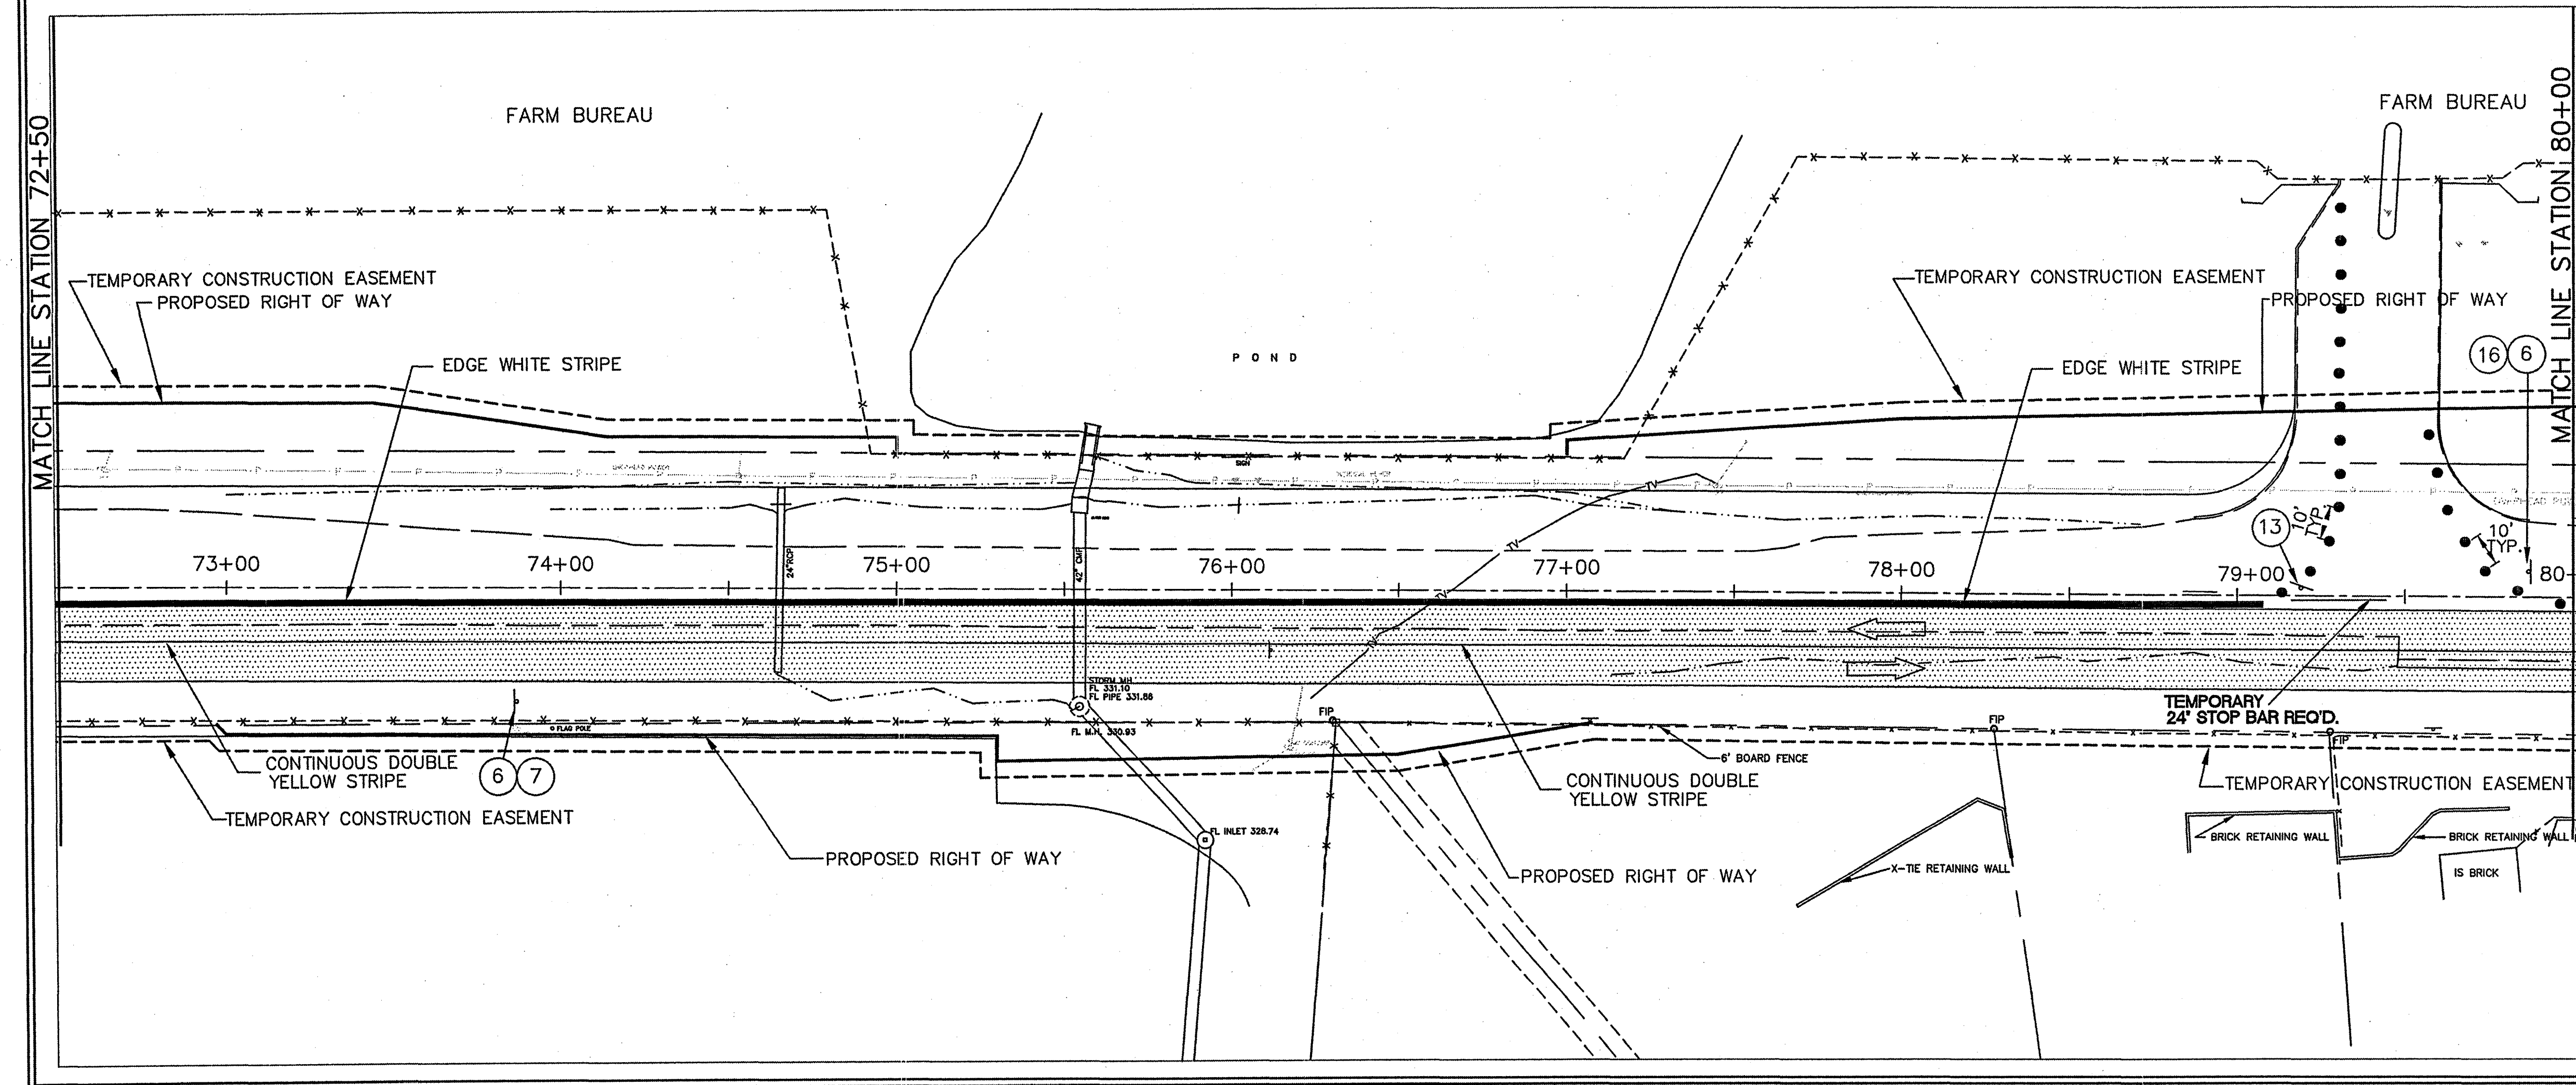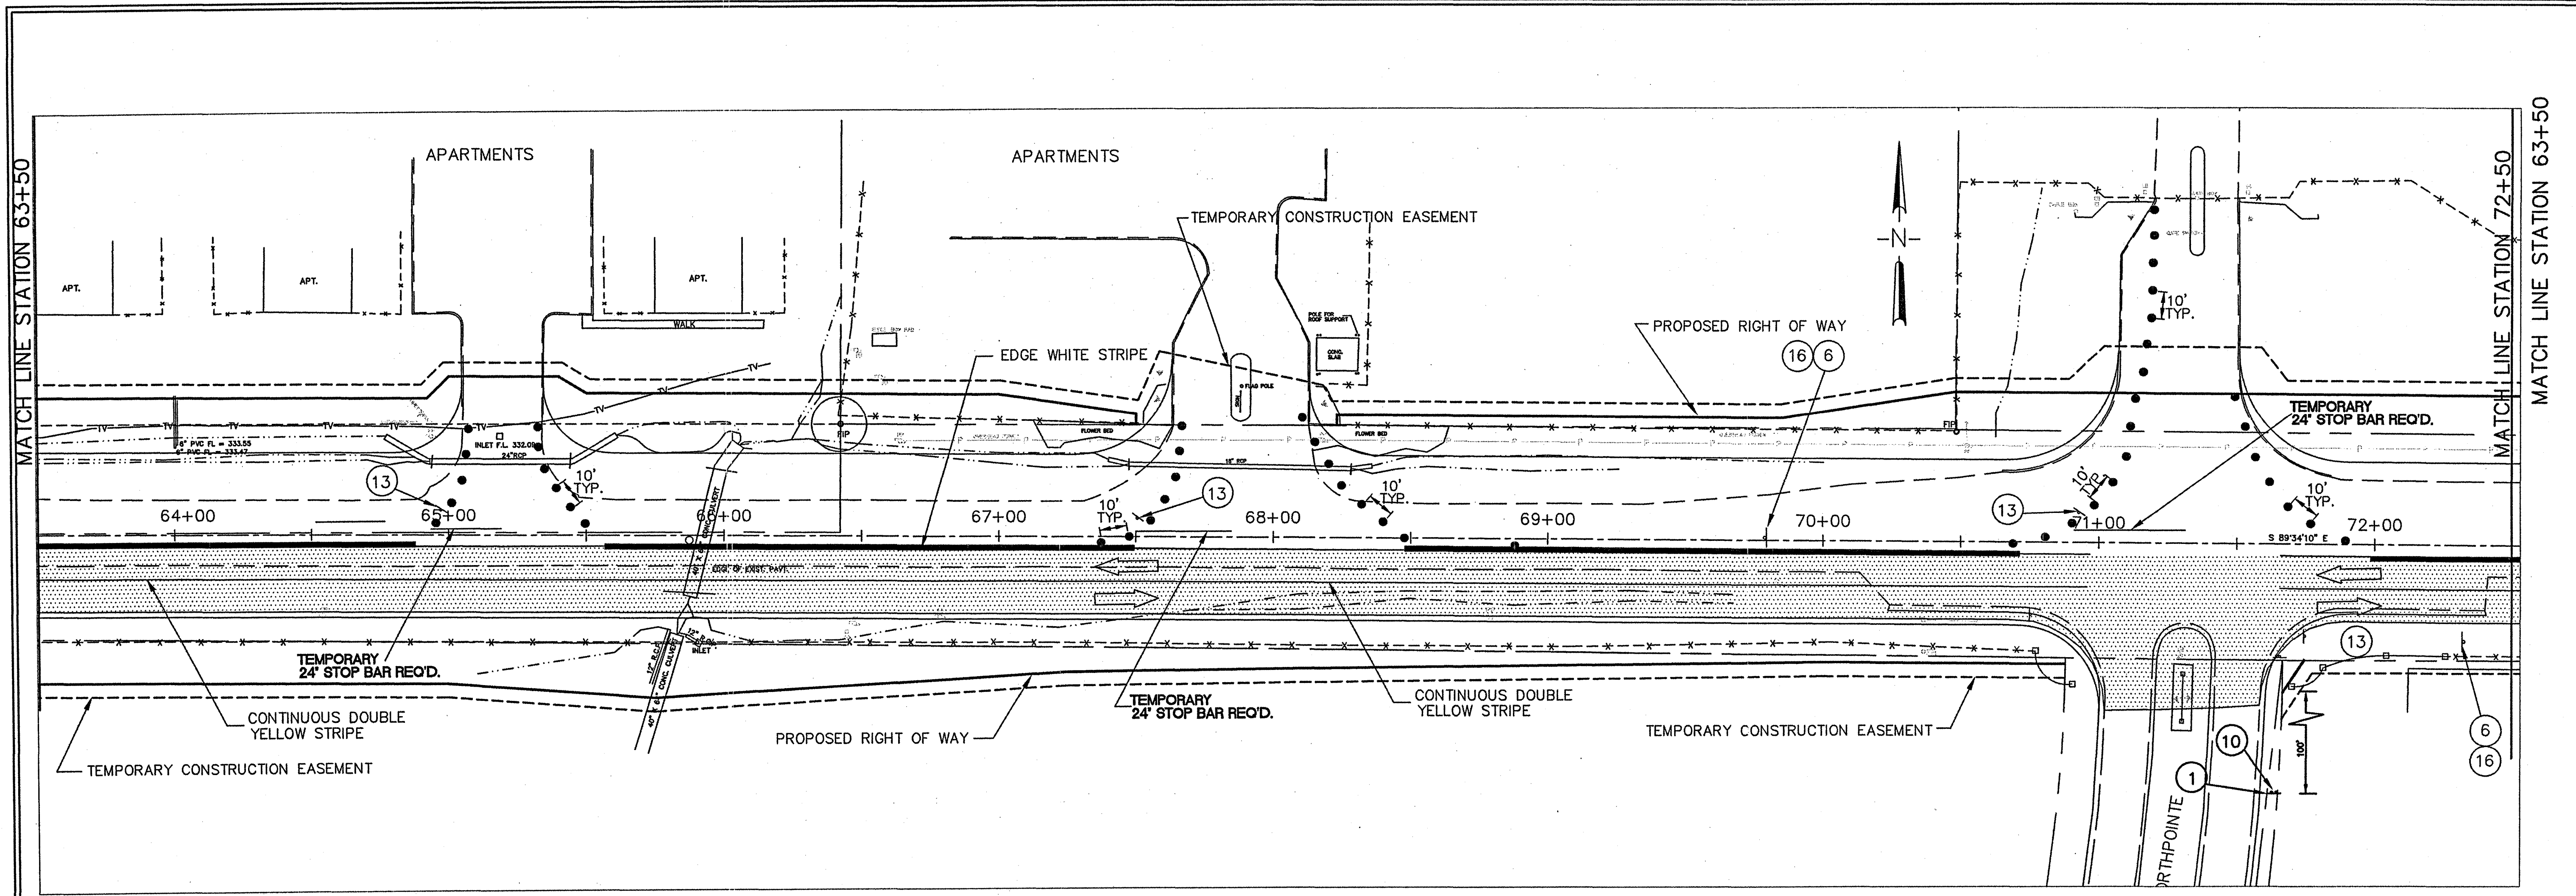

CONSTRUCTION SIGN SCHEDULE		
SIGN NUMBER	MUTCD NUMBER	DESCRIPTION
1		TYPE III BARRICADE
2	M4-10L	DETOUR ARROW LEFT
3	W20-1	ROAD WORK 200 FEET
4	W20-1	ROAD WORK 400 FEET
5	W20-1	ROAD WORK 600 FEET
6	W6-3	TWO WAY TRAFFIC
	W13-1	ADVISING SPEED PLATE (30 MPH)
	W4-2(L)	LANE REDUCTION TRANSITION SIGN (RIGHT)
	G20-2A	END ROAD WORK
	W20-1	ROAD WORK AHEAD
	W9-2	LANE ENDS MERGE LEFT
	G20-1	ROAD WORK NEXT 0.9 MILES
	R1-1	STOP
	R1-2	YIELD
	W20-3	ROAD CLOSED
	R4-1	DO NOT PASS



1. FOR DETAILS AND GENERAL NOTES SEE SHEET

DRAWING REVISIONS		
NO.	REMARKS	DATE

DRAWN BY: \_\_\_\_\_ SCALE: 1" = 30'  
DESIGNED BY: \_\_\_\_\_ DATE: 5-03-05  
CHECKED BY: SW PROJECT: 734-148  
DRAWING TITLE:

**TRAFFIC CONTROL PHASE 3**

CITY OF RIDGELAND  
**WIDENING OF EAST  
COUNTY LINE ROAD**  
STP-7305-00(003)

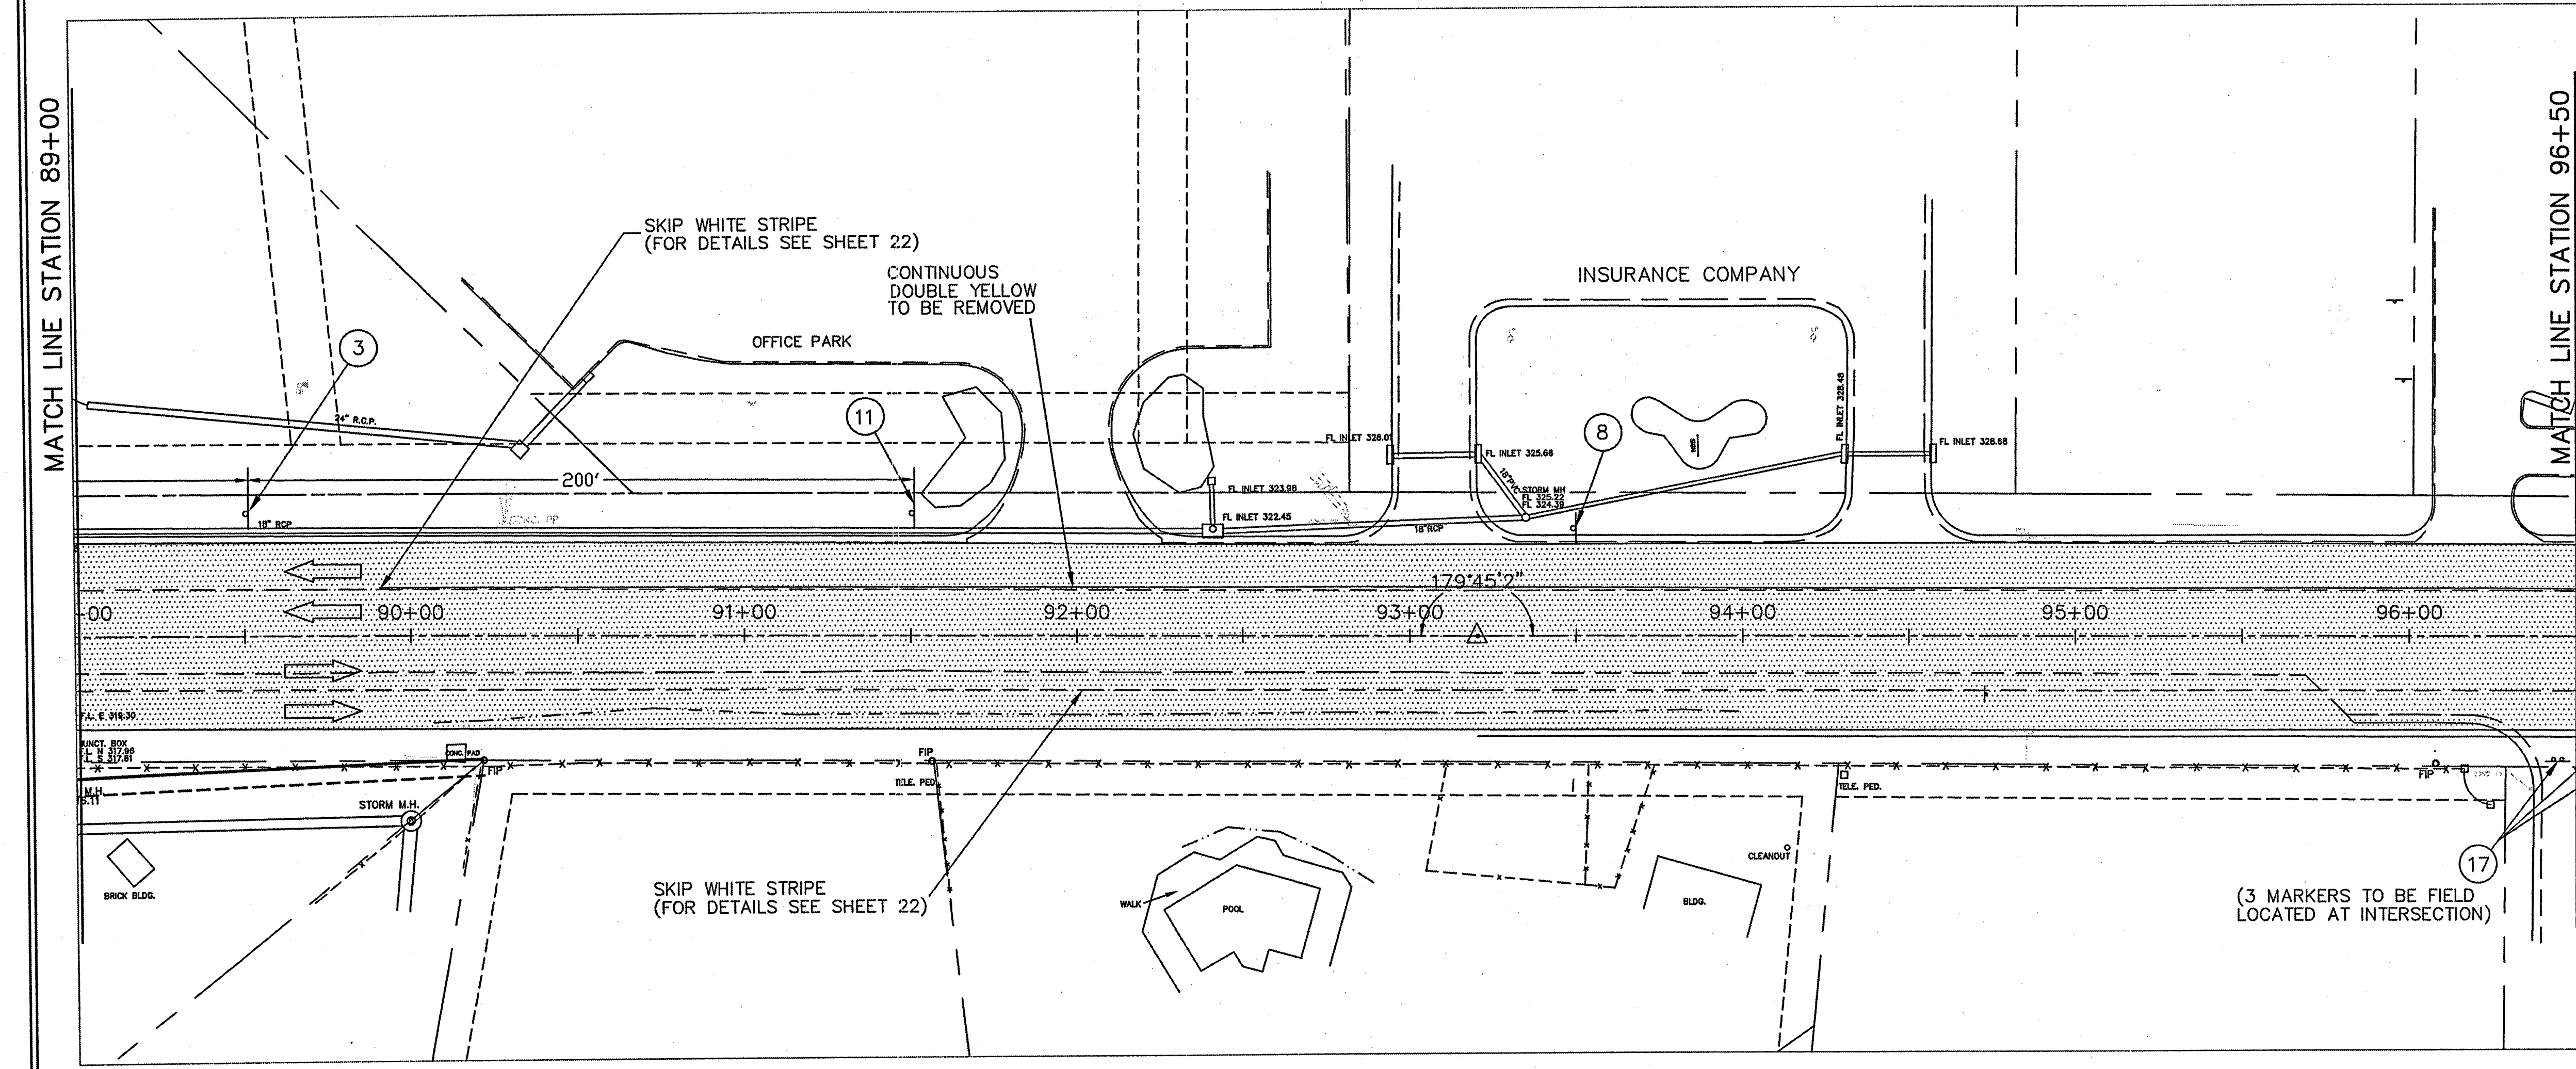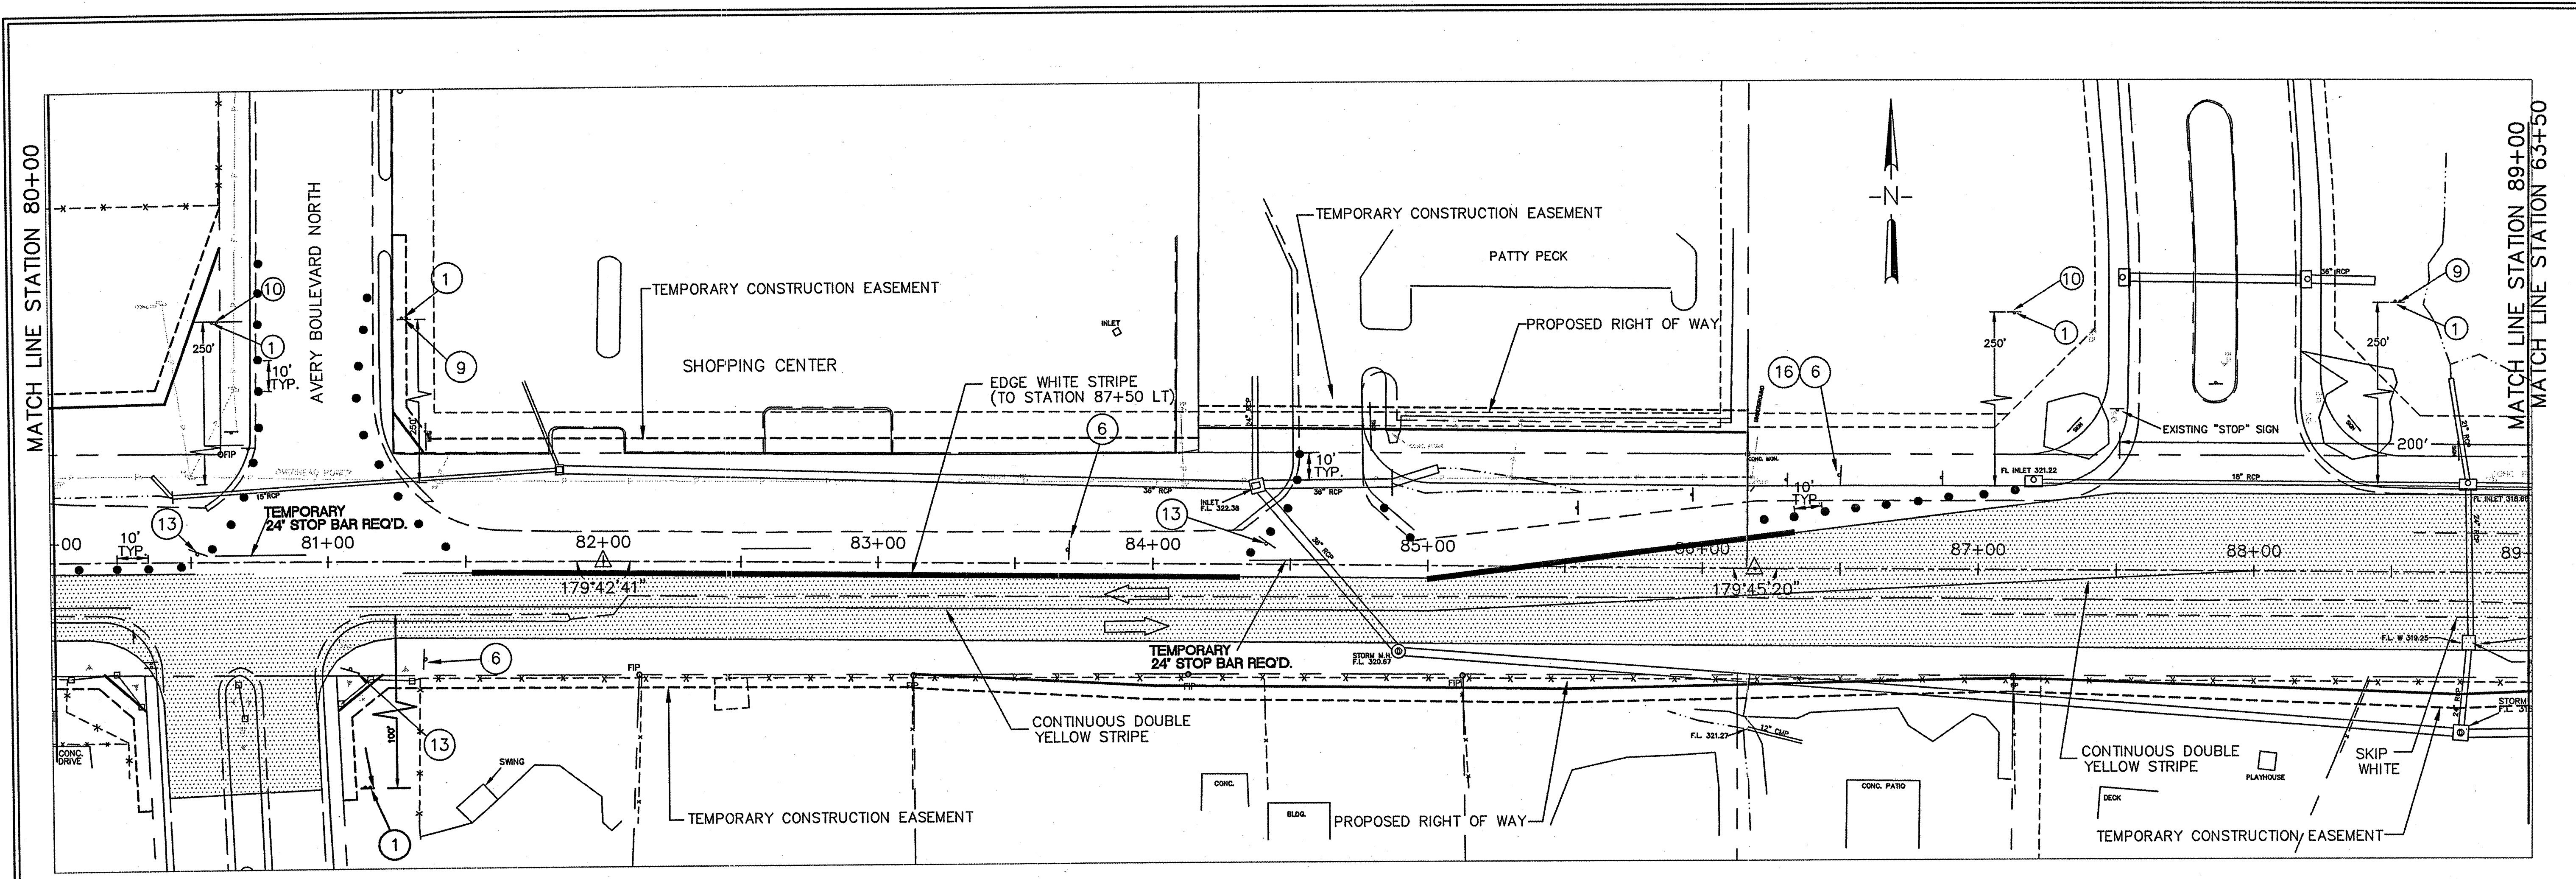

CONSTRUCTION SIGN SCHEDULE		
SIGN NUMBER	MUTCD NUMBER	DESCRIPTION
1		TYPE III BARRICADE
2	M4-10L	DETOUR ARROW LEFT
3	W20-1	ROAD WORK 200 FEET
4	W20-1	ROAD WORK 400 FEET
5	W20-1	ROAD WORK 600 FEET
6	W6-3	TWO WAY TRAFFIC
7	W13-1	ADVISING SPEED PLATE (30 MPH)
8	W4-2(L)	LANE REDUCTION TRANSITION SIGN (RIGHT)
9	G20-2A	END ROAD WORK
10	W20-1	ROAD WORK AHEAD
11	W9-2	LANE ENDS MERGE LEFT
12	G20-1	ROAD WORK NEXT 0.9 MILES
13	R1-1	STOP
14	R1-2	YIELD
15	W20-3	ROAD CLOSED
16	R4-1	DO NOT PASS
17		TYPICAL END OF ROAD MARKER


**NOTE:**  
1. FOR DETAILS AND GENERAL NOTES SEE SHEET

DRAWING REVISIONS		
NO.	REMARKS	DATE

DRAWN BY: \_\_\_\_\_ SCALE: 1" = 30'  
DESIGNED BY: \_\_\_\_\_ DATE: 2-03-08  
CHECKED BY: SW PROJECT: TR-148  
DRAWING TITLE:

**TRAFFIC CONTROL  
PHASE 3**

CITY OF RIDGELAND  
**WIDENING OF EAST  
COUNTY LINE ROAD**  
STP-7305-00(003)

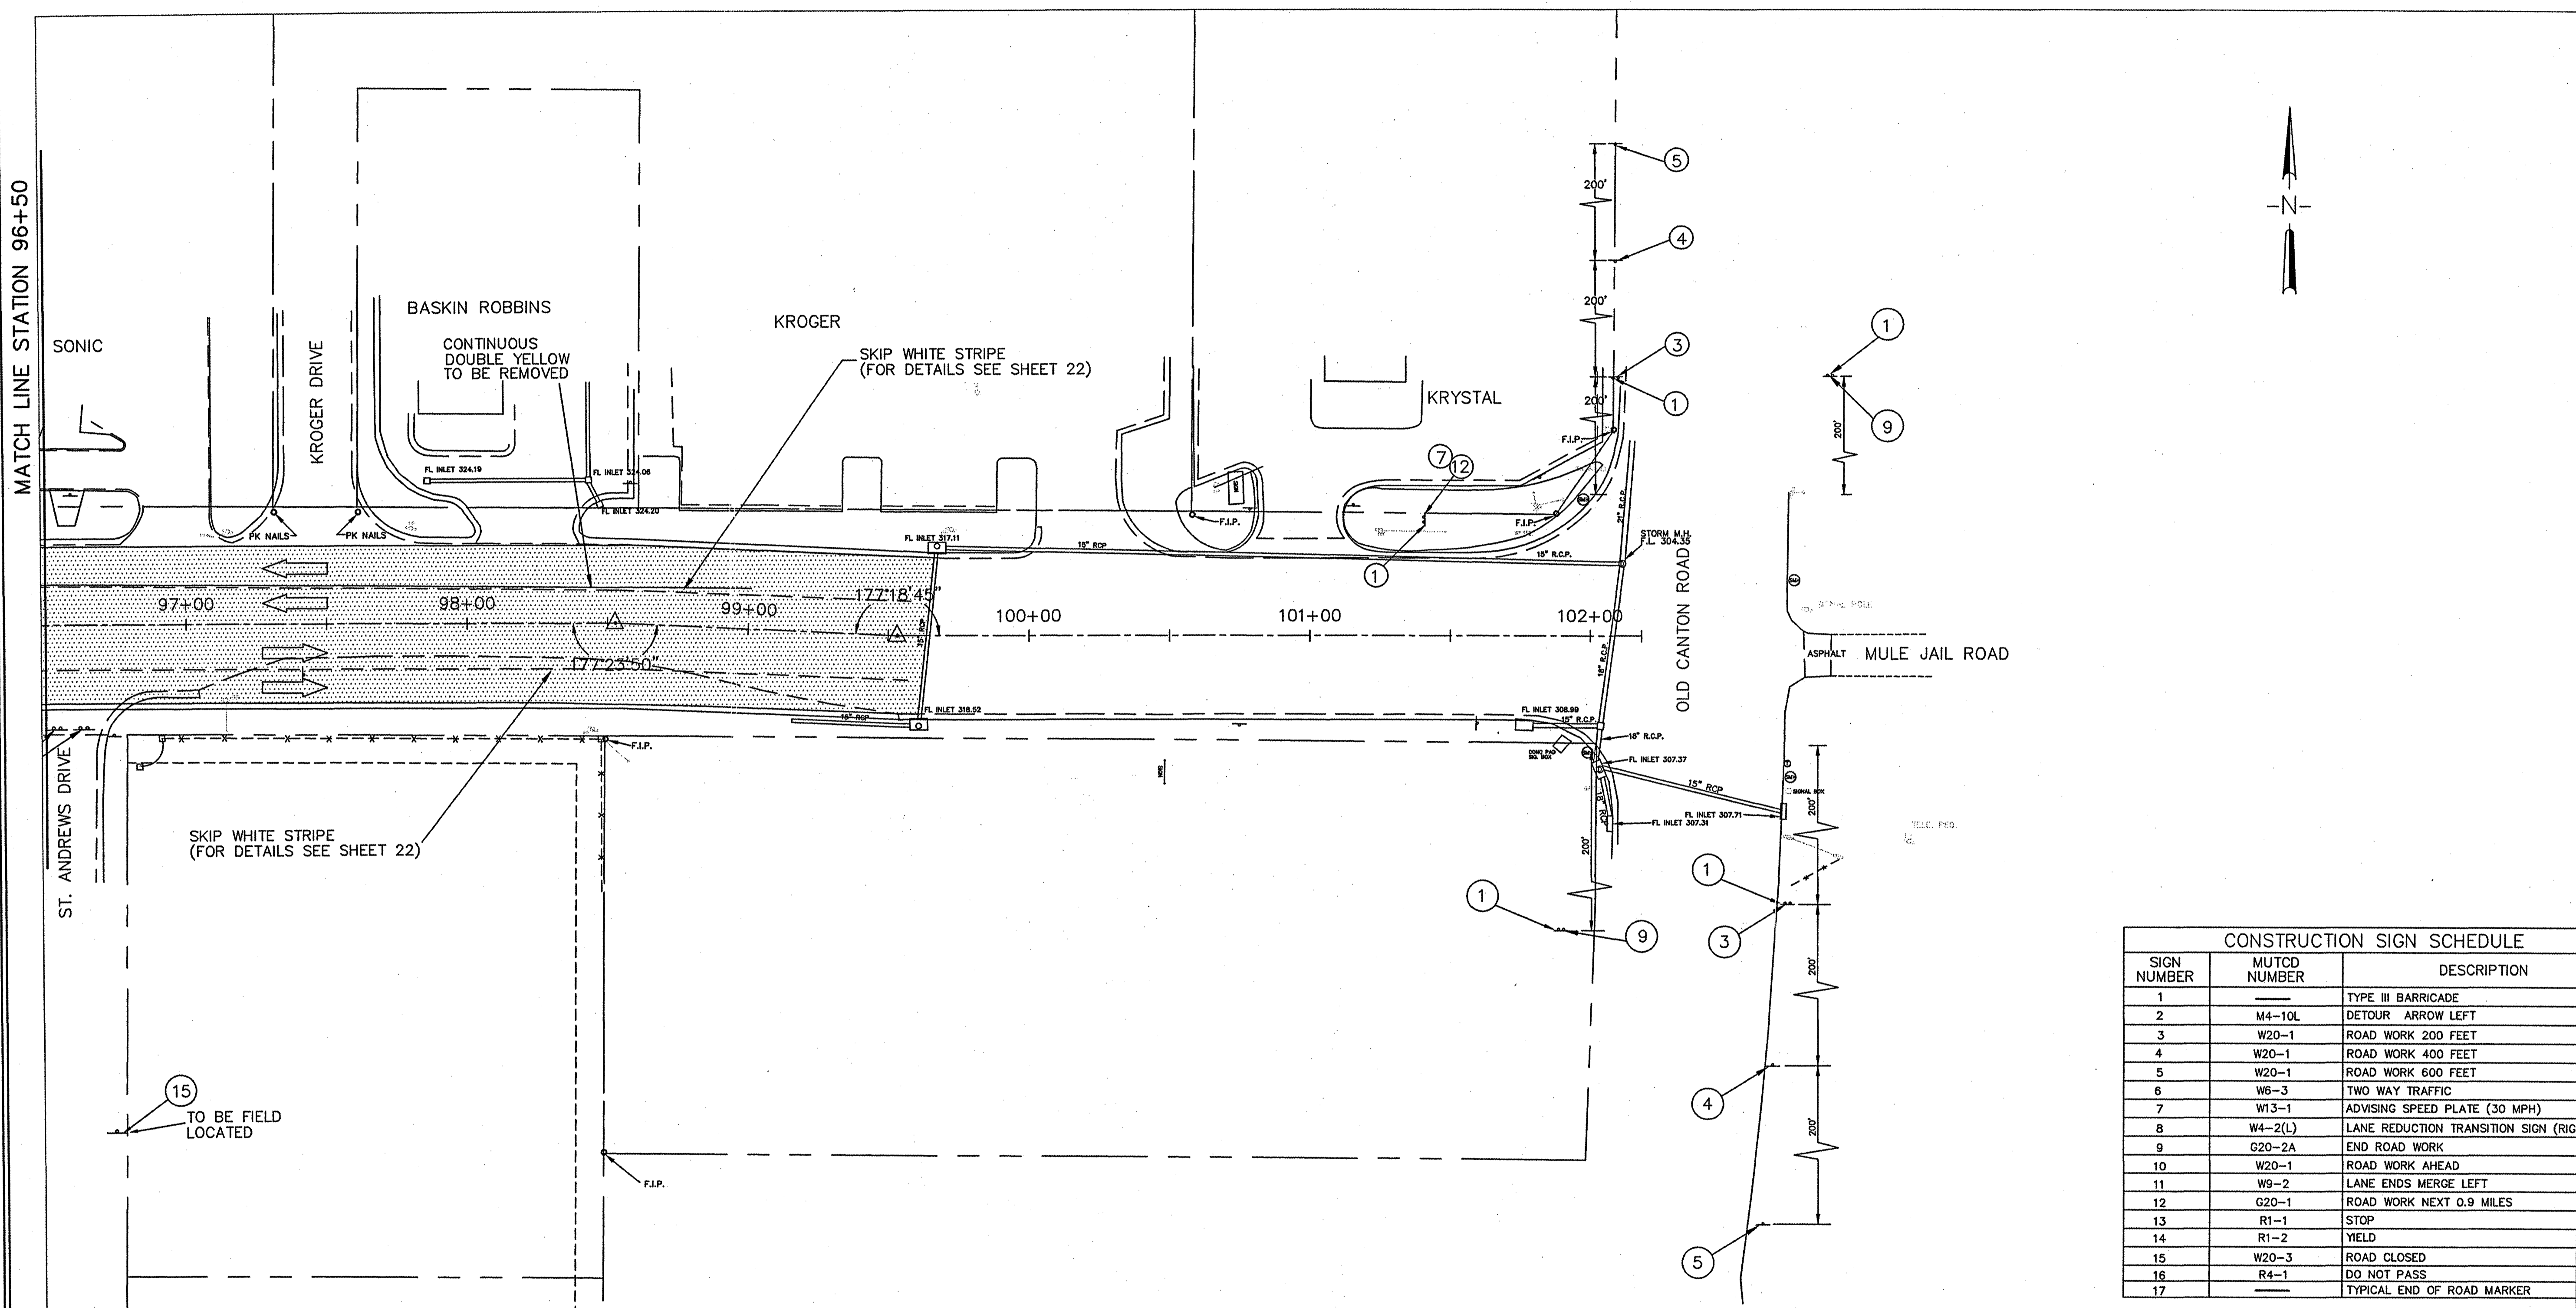

CONSTRUCTION SIGN SCHEDULE		
SIGN NUMBER	MUTCD NUMBER	DESCRIPTION
1		TYPE III BARRICADE
2	M4-10L	DETOUR ARROW LEFT
3	W20-1	ROAD WORK 200 FEET
4	W20-1	ROAD WORK 400 FEET
5	W20-1	ROAD WORK 600 FEET
6	WB-3	TWO WAY TRAFFIC
7	W13-1	ADVISING SPEED PLATE (30 MPH)
8	W4-2(L)	LANE REDUCTION TRANSITION SIGN (RIGHT)
9	G20-2A	END ROAD WORK
10	W20-1	ROAD WORK AHEAD
11	W9-2	LANE ENDS MERGE LEFT
12	G20-1	ROAD WORK NEXT 0.9 MILES
13	R1-1	STOP
14	R1-2	YIELD
15	W20-3	ROAD CLOSED
16	R4-1	DO NOT PASS
17		TYPICAL END OF ROAD MARKER

**NOTE:**  
1. FOR DETAILS AND GENERAL NOTES SEE SHEET

DRAWING REVISIONS		
NO.	REMARKS	DATE



DRAWN BY: \_\_\_\_\_ SCALE: 1" = 30'  
DESIGNED BY: \_\_\_\_\_ DATE: 2-03-09  
CHECKED BY: SW PROJECT: 104-148  
DRAWING TITLE:

**TRAFFIC CONTROL  
PHASE 3**






CITY OF RIDGELAND  
**WIDENING OF EAST  
COUNTY LINE ROAD**  
STP-7305-00(003)

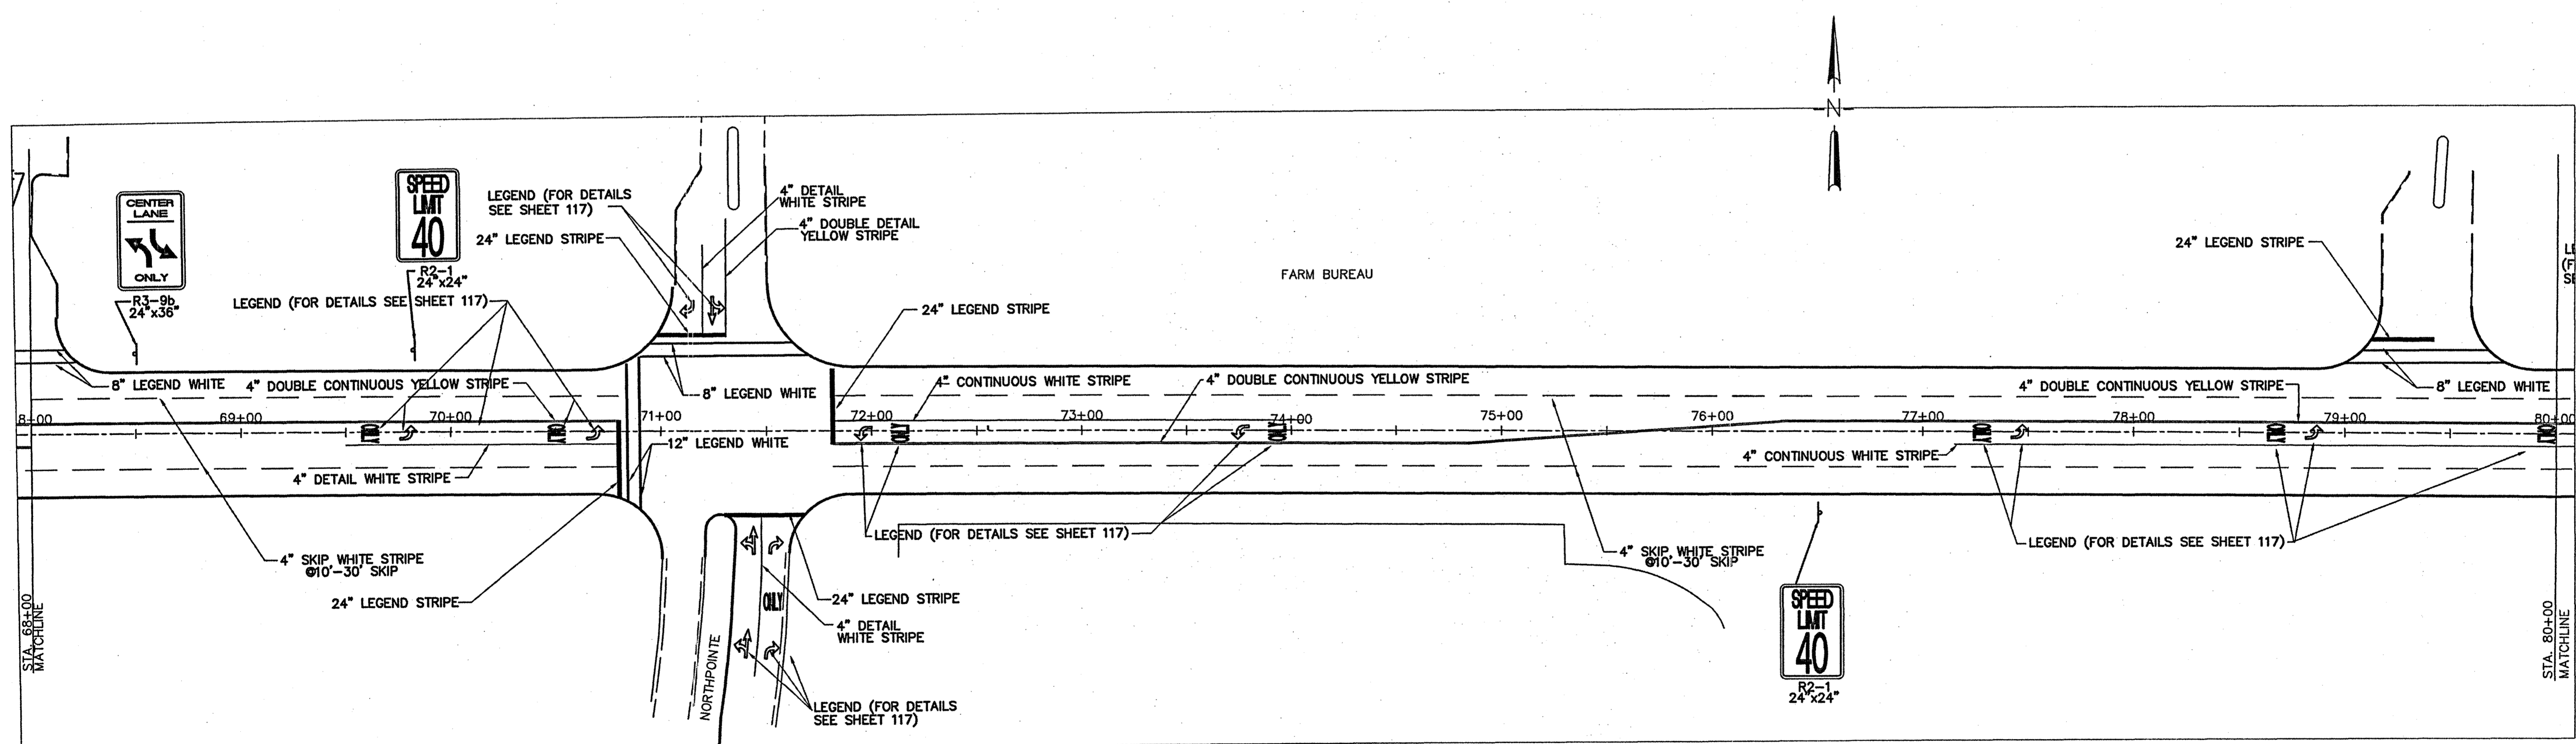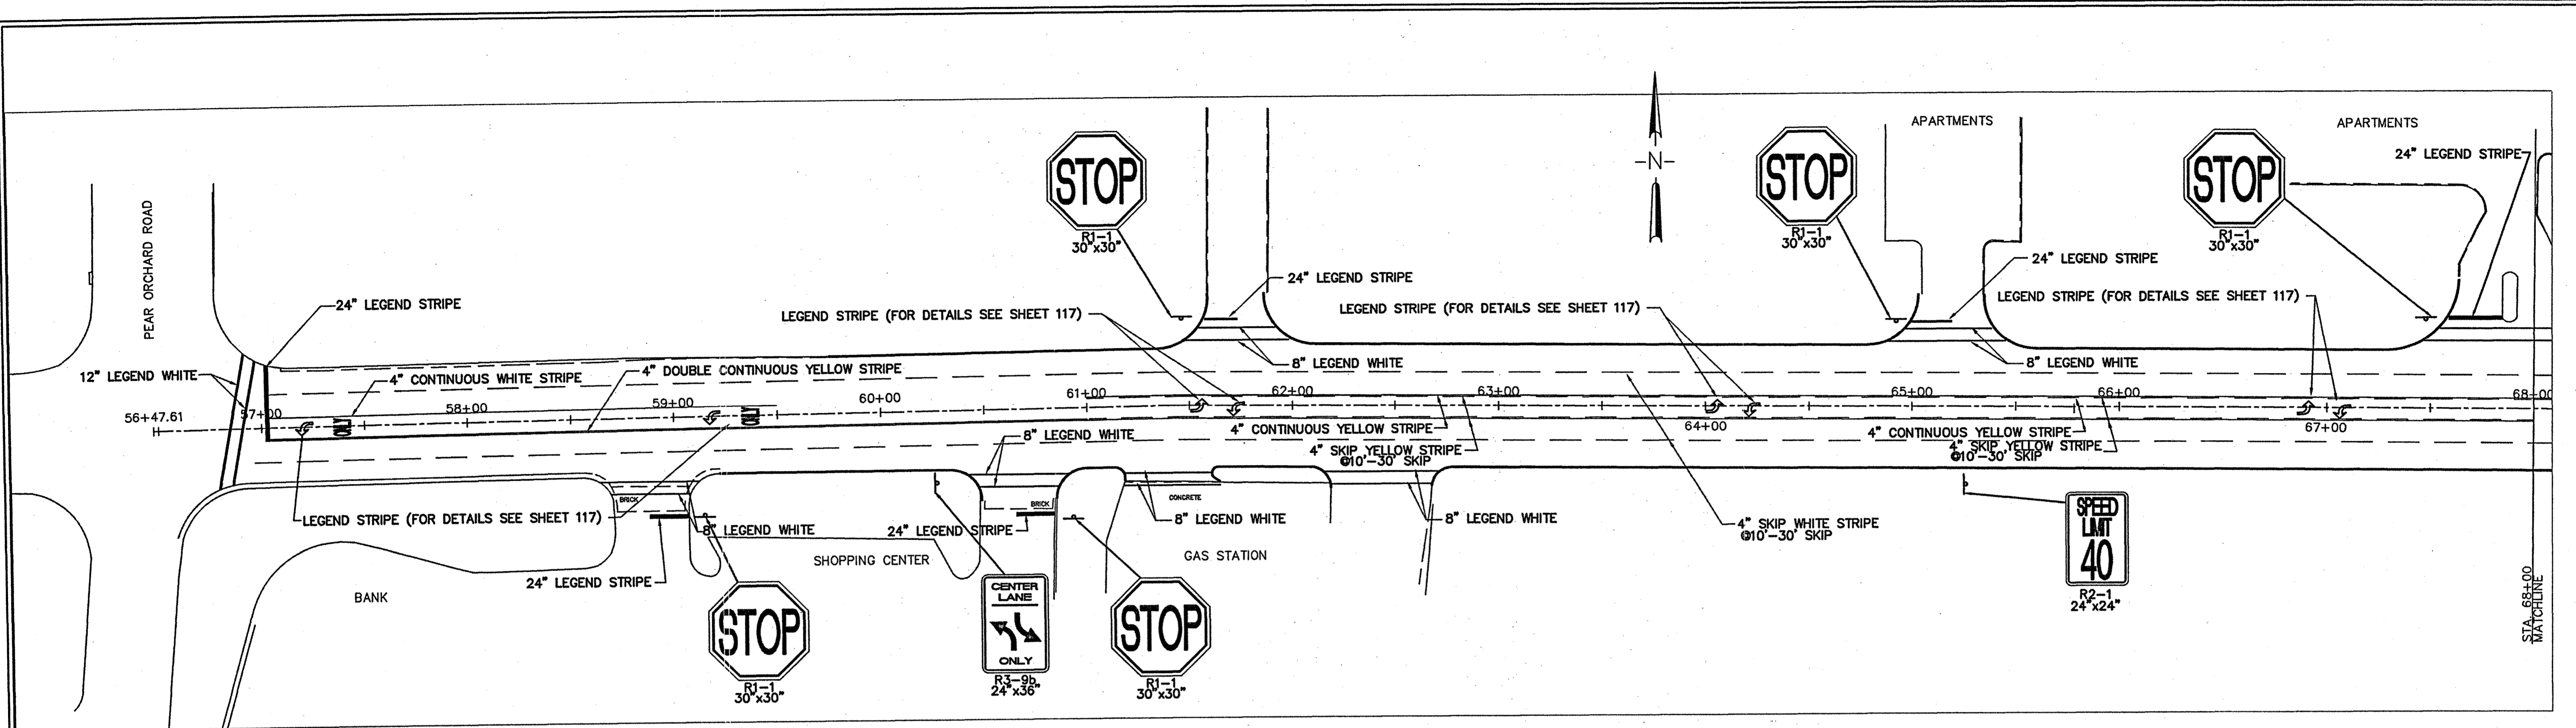

NOTE:

1. ALL SIGNS AND PAVEMENT MARKINGS ARE TO CONFORM TO THE MANUAL ON UNIFORM TRAFFIC CONTROL DEVICES (MUTCD), (1988 EDITION AND ALL SUBSEQUENT REVISIONS).
2. SEE SHEET 113 FOR ADDITIONAL DETAILS ON PAVEMENT MARKINGS AND REFLECTIVE PAVEMENT MARKERS.
3. MINIMUM HEIGHT FOR SIGNS IS 7 FT.
4. STOP SIGNS SHALL BE LOCATED FOR MAXIMUM VISIBILITY AND SHALL BE PLACED SO THAT, AT LEAST, MINIMUM STOPPING SIGHT DISTANCE IS PROVIDED. STOP SIGNS SHOULD BE ERRECTED AT THE POINT WHERE THE VEHICLE IS TO STOP OR AS NEAR THERE TO AS POSSIBLE WITHIN THE LIMITS OF 6 FT. MINIMUM AND 50 FT. MAXIMUM FROM THE INTERSECTING PAVEMENT EDGES.
5. STOP LINES SHALL BE LOCATED AT THE DESIRED STOPPING POINT WITHIN THE LIMITS OF 4 FT. MINIMUM AND 30 FT. MAXIMUM FROM THE INTERSECTING PAVEMENT EDGES.

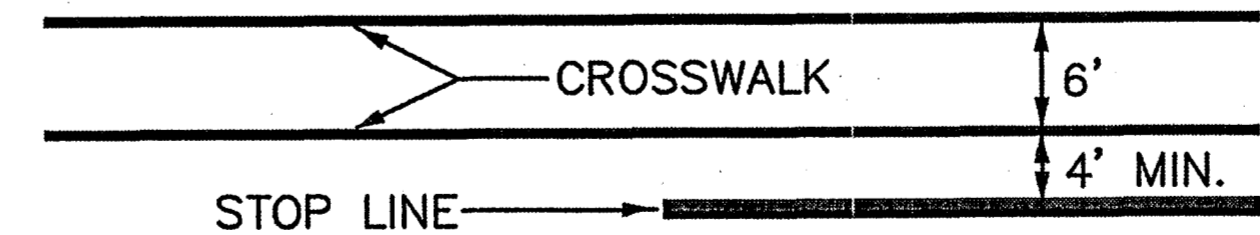

CROSSWALK/STOP LINE DETAIL

DRAWING REVISIONS		
NO.	REMARKS	DATE

DRAWN BY:	SCALE: 1" = 40'
DESIGNED BY:	DATE: 5-03-05
CHECKED BY: SW	PROJECT: 194-148

**STRIPING  
AND  
SIGNAGE**














CITY OF RIDGELAND  
**WIDENING OF EAST  
COUNTY LINE ROAD**  
STP-7305-00(003)

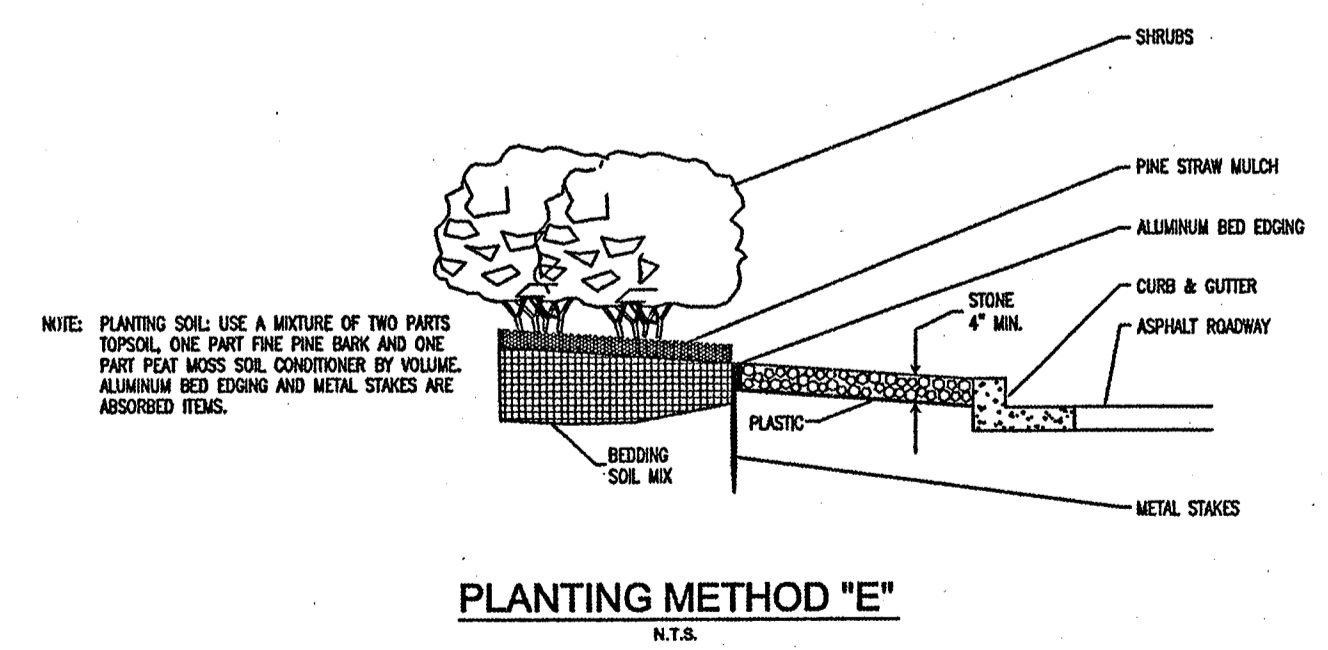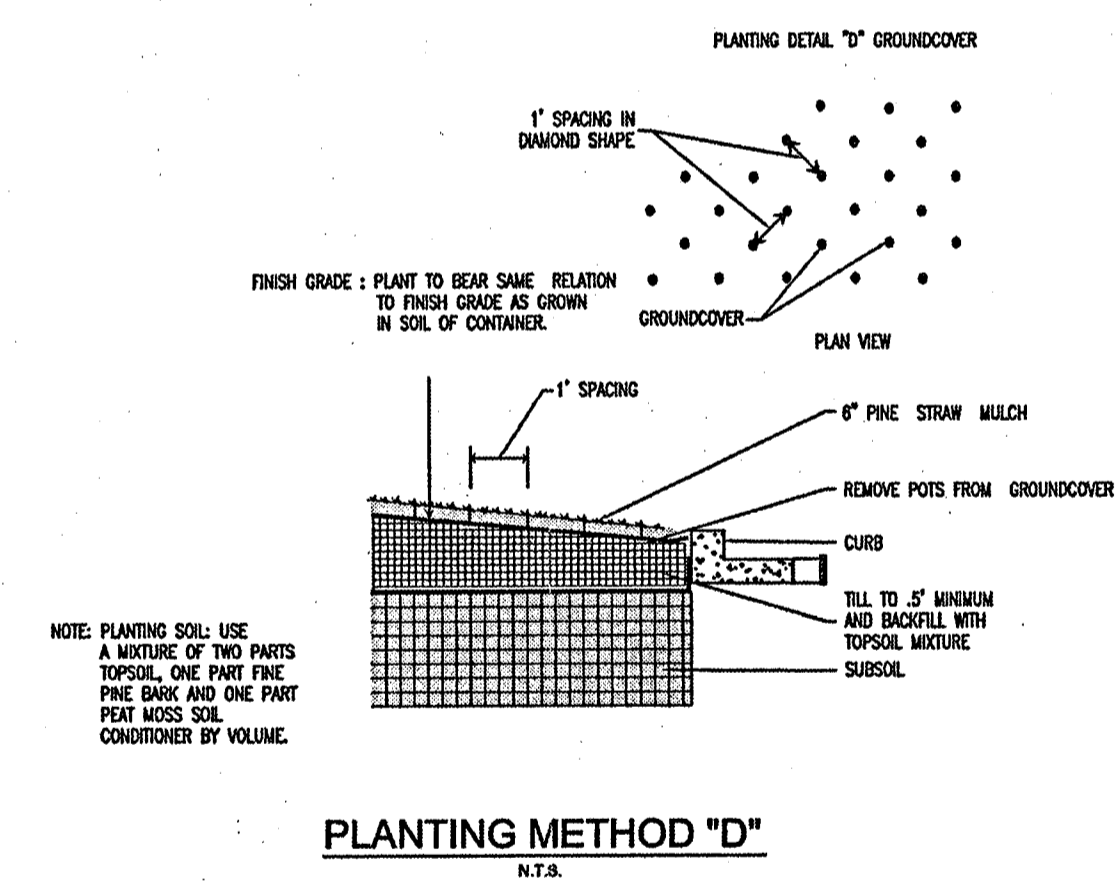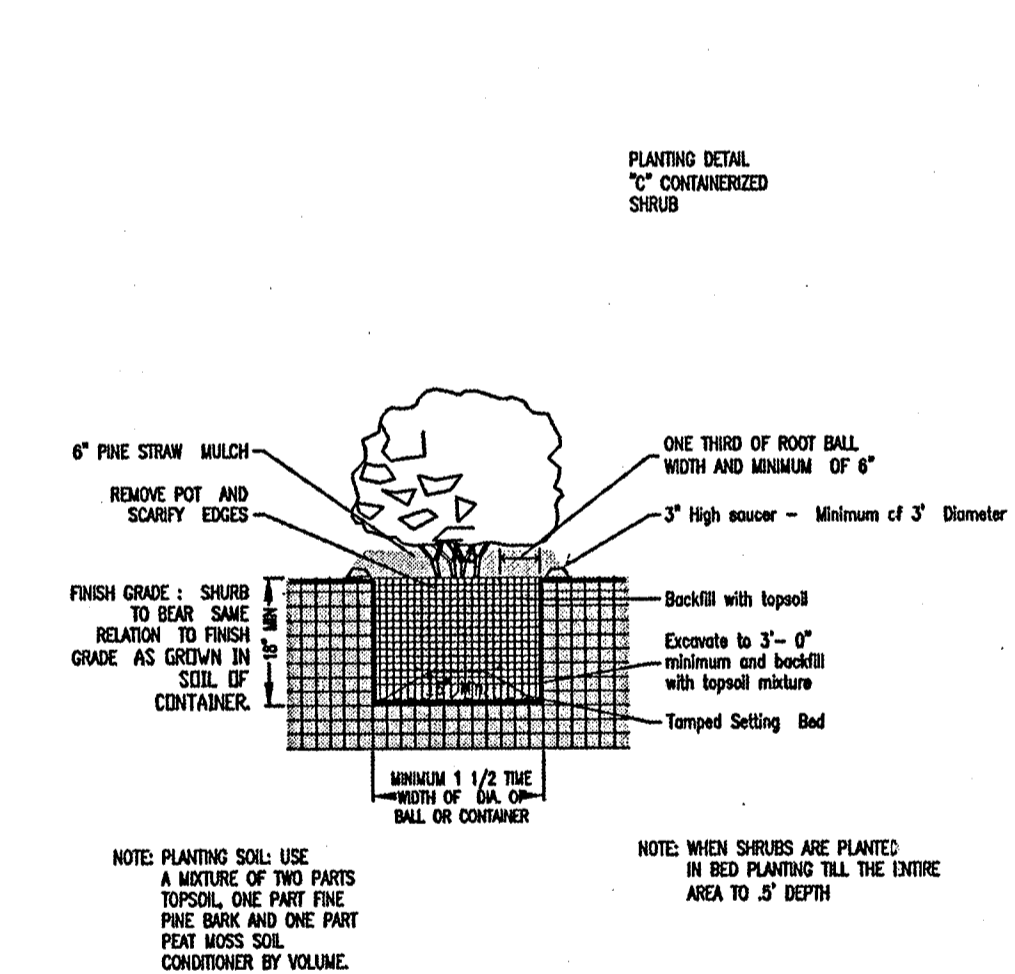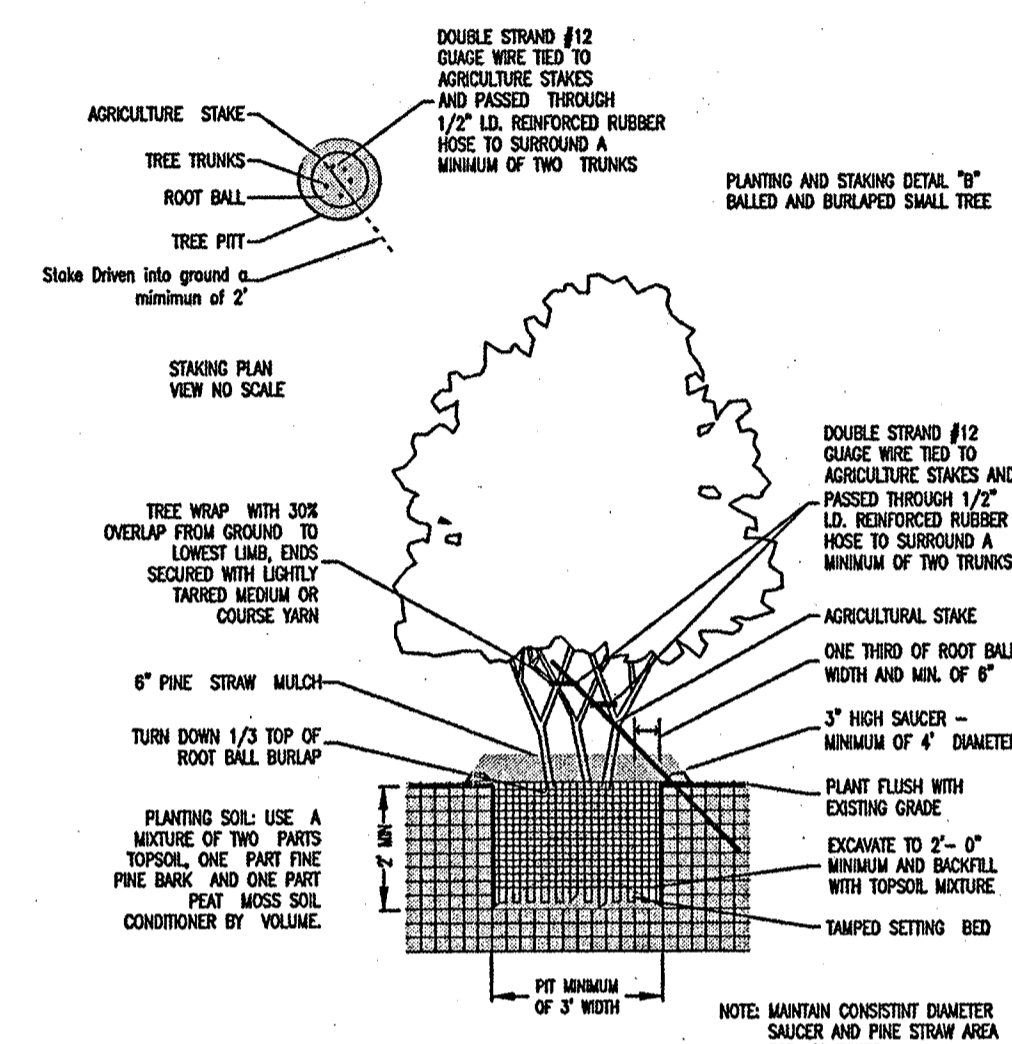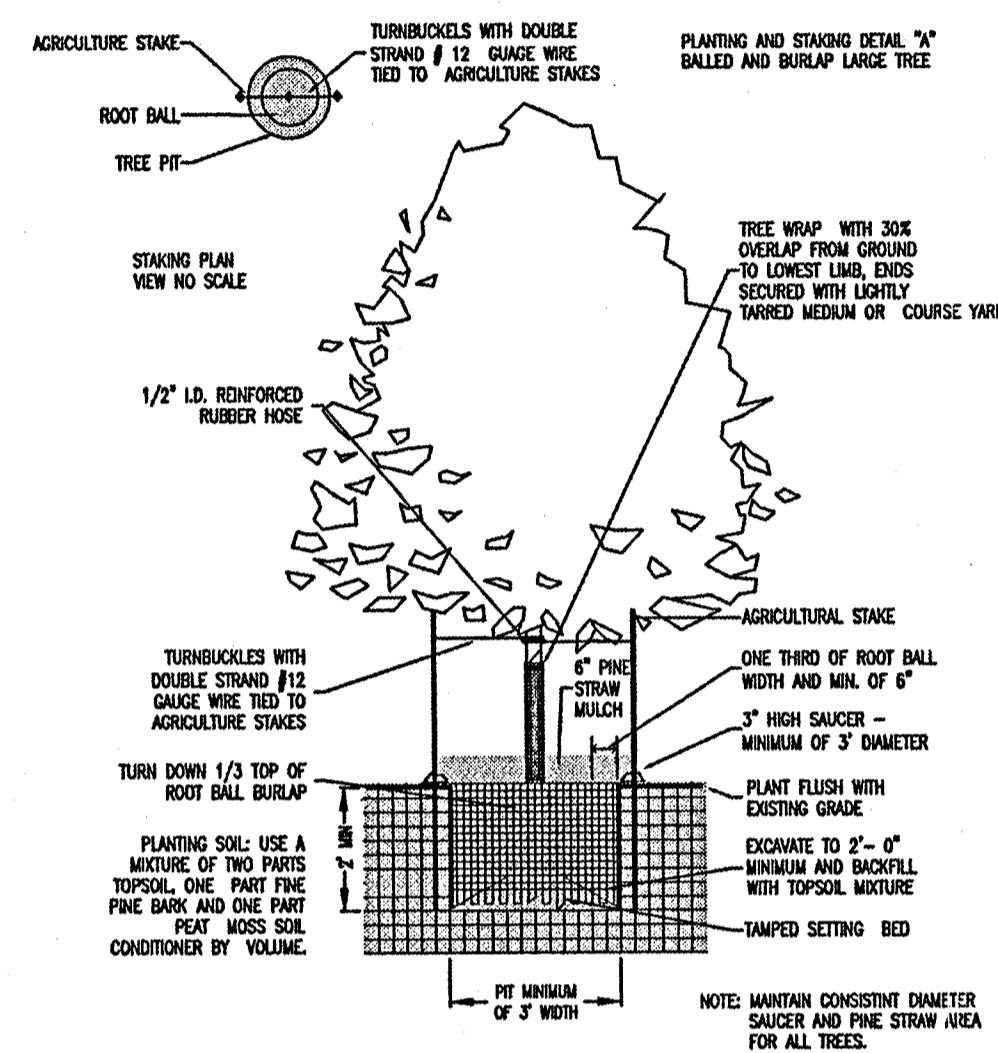


PLANT MATERIALS LIST							
TITLE		TOTALS NUMBER	COMMON NAME	SCIENTIFIC NAME	PLANTING DETAIL	SPACING	SIZE
TREES		138	PIN OAK	GUERCUS PALUSTRIS	A	AS NOTED ON PLAN	10 TO 12' HEIGHT, 1 1/2" TO 2" CALIPER
		64	CREPE MYRTLE	LARGERSTROEMIA INDICA	A	AS NOTED ON PLAN	8'-10'
SHRUBS		475	DWARF PFITZER JUNIPER	JUNIPERUS CHINENSIS' PFITZERANA'	C	5 GALLON 18" HEIGHT & SPREAD	
		72	FLORIDA JASMINE		C		

DRAWING REVISIONS		
NO.	REMARKS	DATE

SEAL:	
DRAWN BY:	SCALE:
DESIGNED BY:	DATE: 2-03-05
CHECKED BY: SW	PROJECT: 104-148
DRAWING TITLE:	



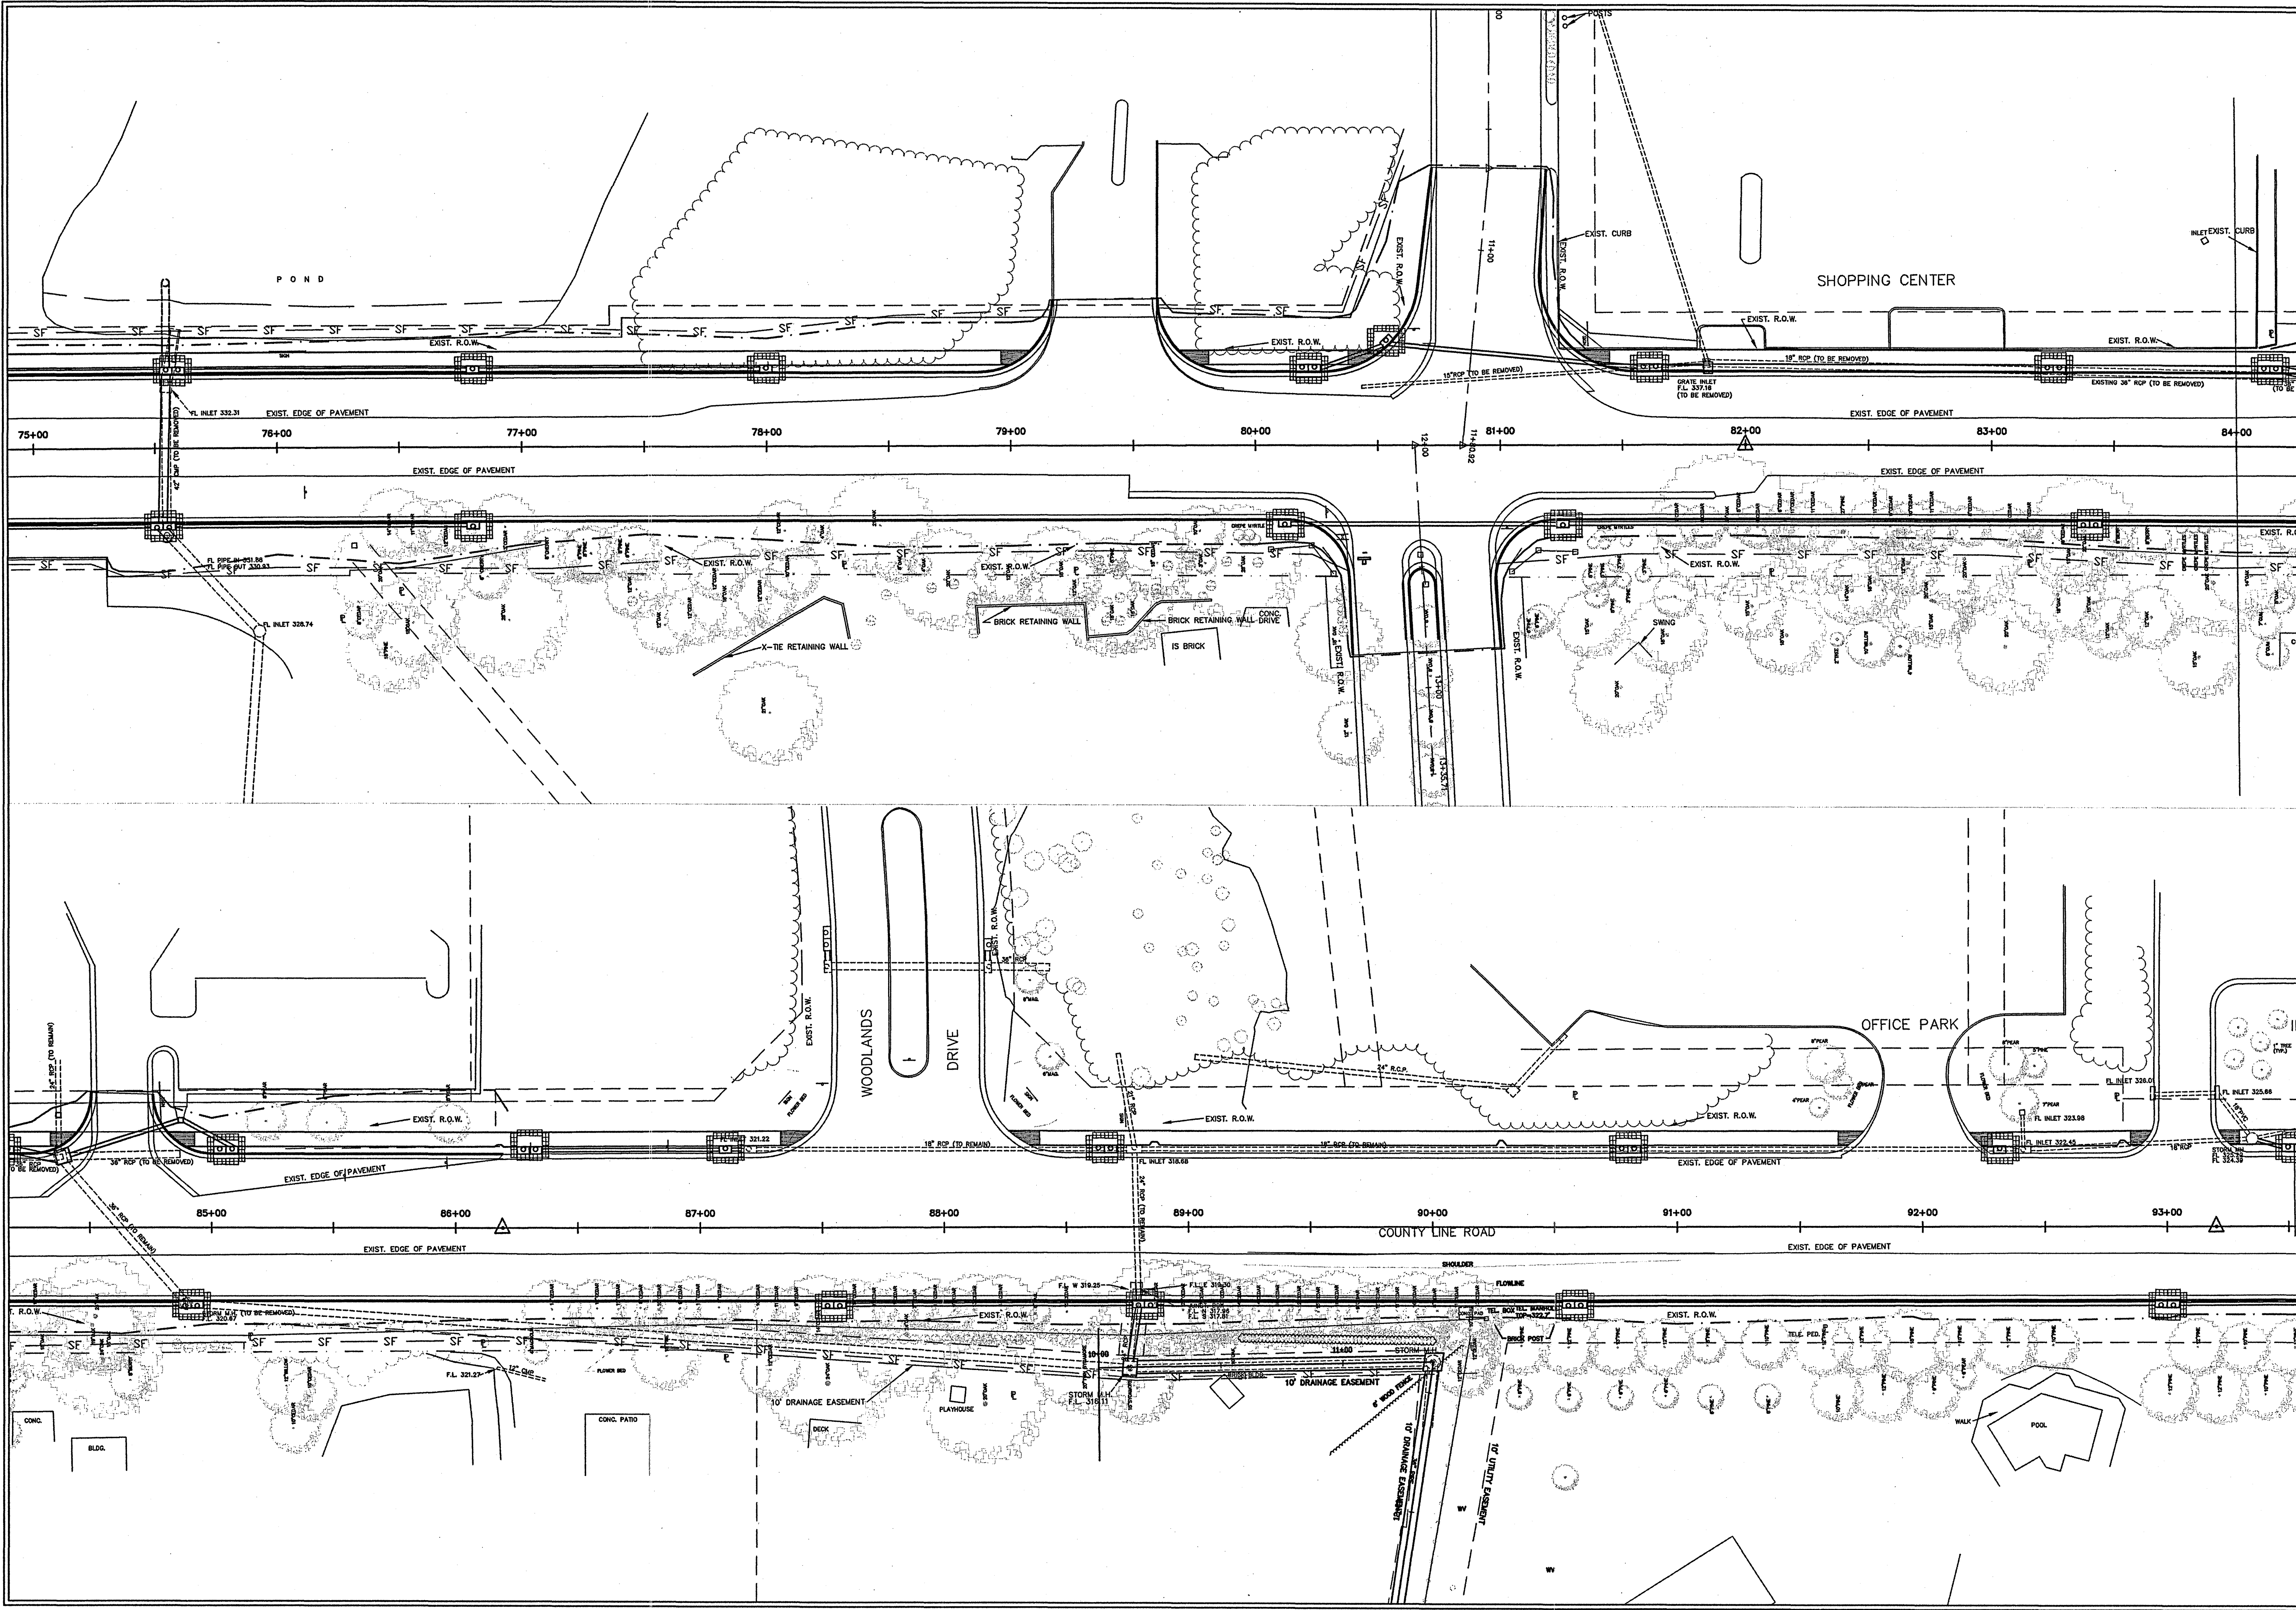

CITY OF RIDGELAND  
**WIDENING OF EAST  
COUNTY LINE ROAD**  
STP-7305-00(003)

DRAWING REVISIONS		
NO.	REMARKS	DATE


DRAWN BY: \_\_\_\_\_ SCALE: 1" = 30'  
 DESIGNED BY: \_\_\_\_\_ DATE: 2-03-05  
 CHECKED BY: SW PROJECT: 84148  
 DRAWING TITLE:  
**STORMWATER  
 POLLUTION  
 PREVENTION  
 PLAN**








- LEGEND**
- TYPE 1 PULLBOX
  - TYPE 2 PULLBOX
  - ▣ TYPE 3 PULLBOX
  - ▭ VEHICLE LOOP DETECTOR
  - CONDUIT RUN
  - S.C. SHIELDED CABLE

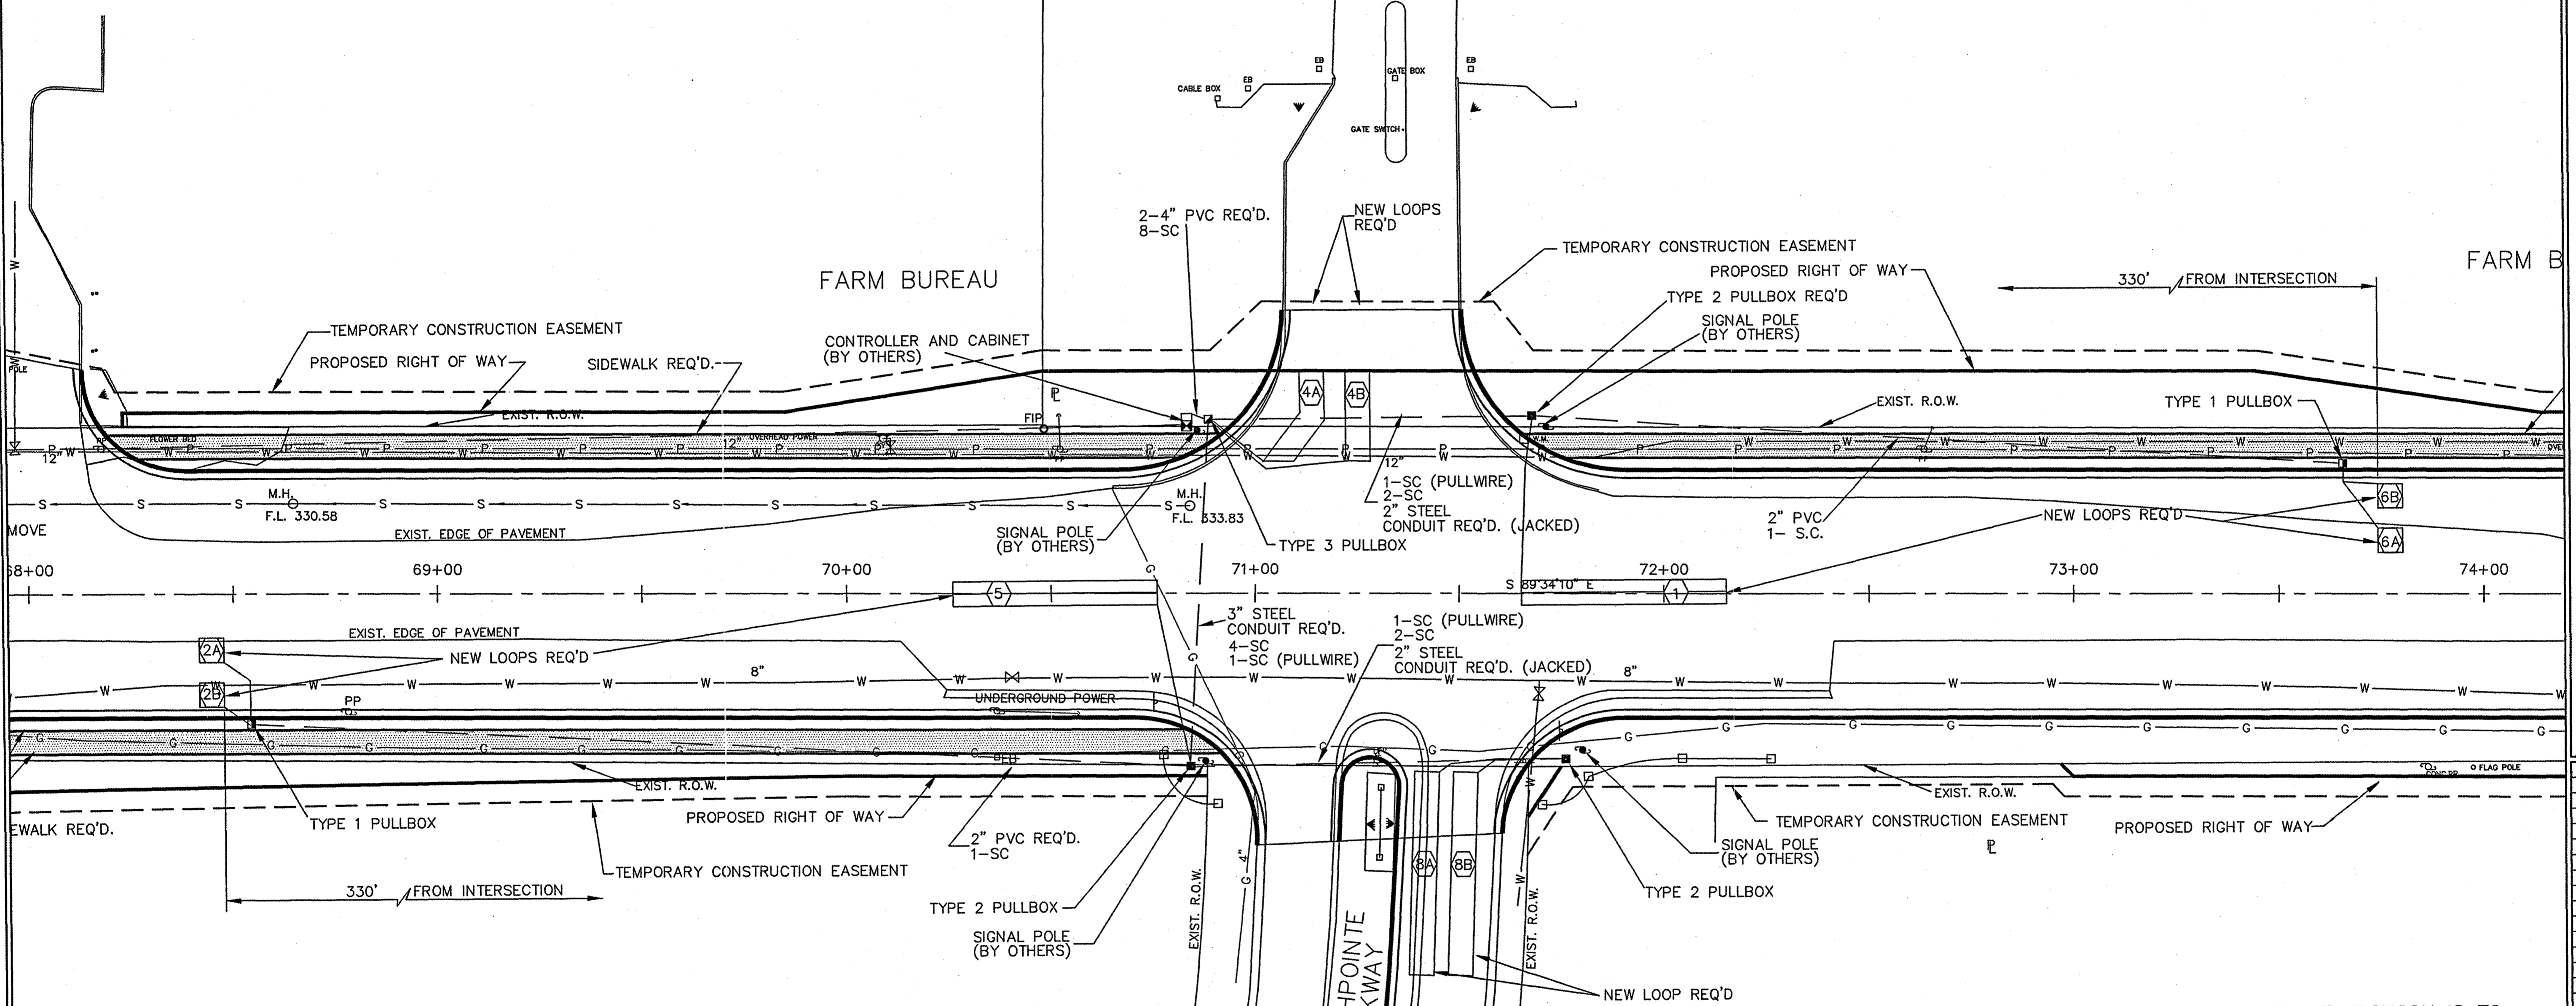

**DETECTOR ASSIGNMENT SUMMARY**

DETECTOR NUMBER	LOOP SIZE	NUMBER OF TURNS	PHASE CALLED	PRESENCE MODE	PULSE MODE
1	6'x 50'	2-4-2	1	X	
2A, 2B	6'x 6'	3	2		X
4A, 4B	6'x 22'	2	4	X	
5	6'x 50'	2-4-2	5	X	
6A, 6B	6'x 6'	3	6		X
8A, 8B	6'x 50'	2	8	X	

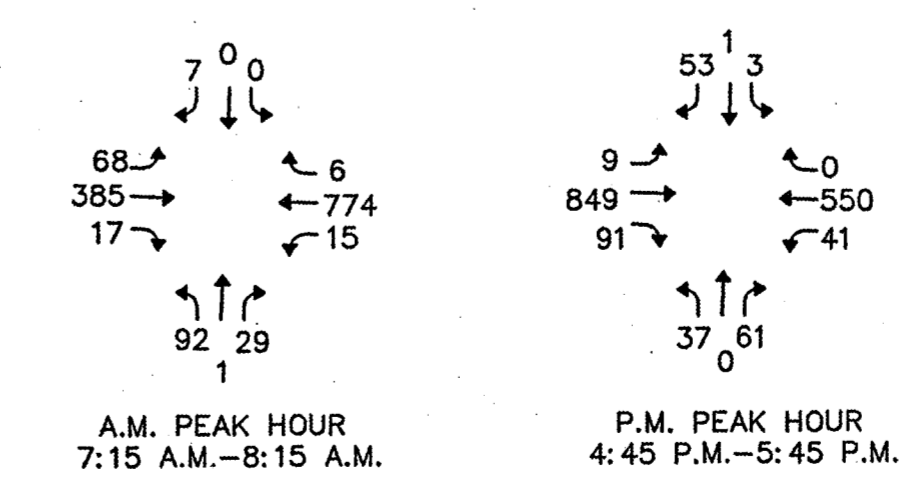

NOTE: THE CITY OF JACKSON IS TO CONSTRUCT A SIGNALIZED INTERSECTION UPON THE COMPLETION OF THIS PROJECT.

**CITY OF RIDGELAND**  
**WIDENING OF EAST**  
**COUNTY LINE ROAD**  
 STP-7305-00(003)

**DRAWING REVISIONS**

NO.	REMARKS	DATE

DRAWN BY: \_\_\_\_\_ SCALE: 1"= 20'  
 DESIGNED BY: \_\_\_\_\_ DATE: 2-03-05  
 CHECKED BY: SW PROJECT: 734-148  
**NORTHPOINTE PARKWAY TRAFFIC SIGNAL PLAN**  
 SHEET NUMBER: \_\_\_\_\_












CITY OF RIDGELAND  
**WIDENING OF EAST  
COUNTY LINE ROAD**  
STP-7305-00(003)

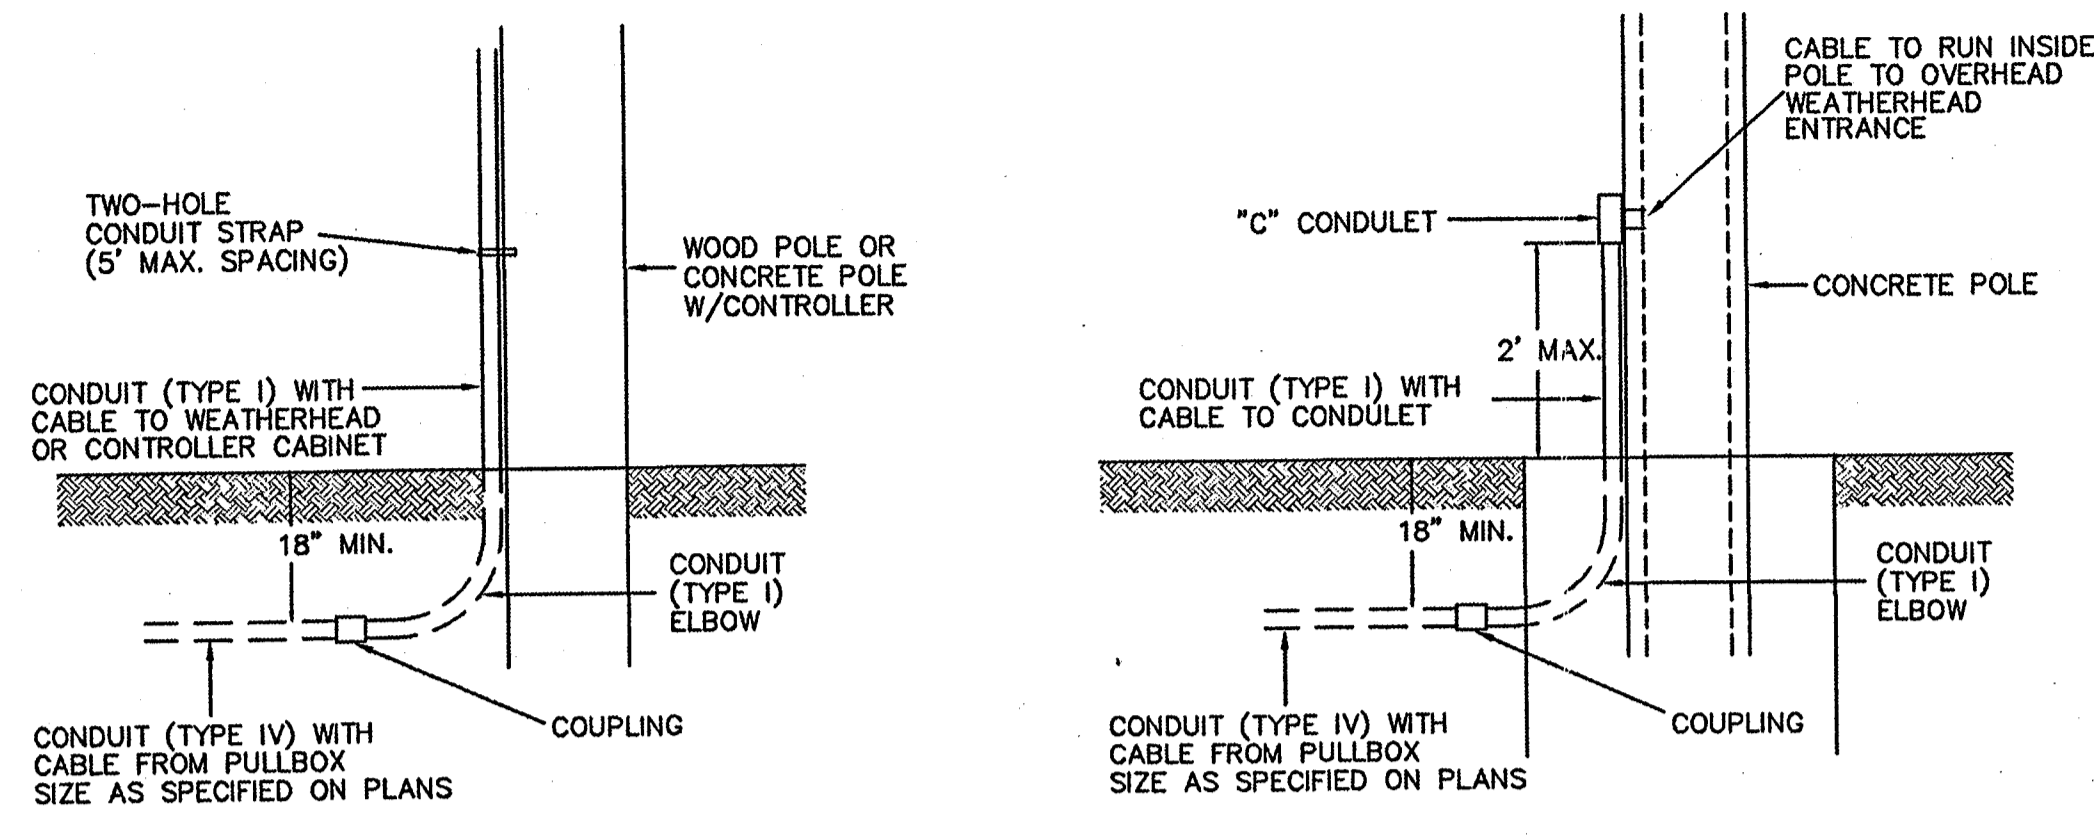

**CONDUIT DETAIL AT POLES**

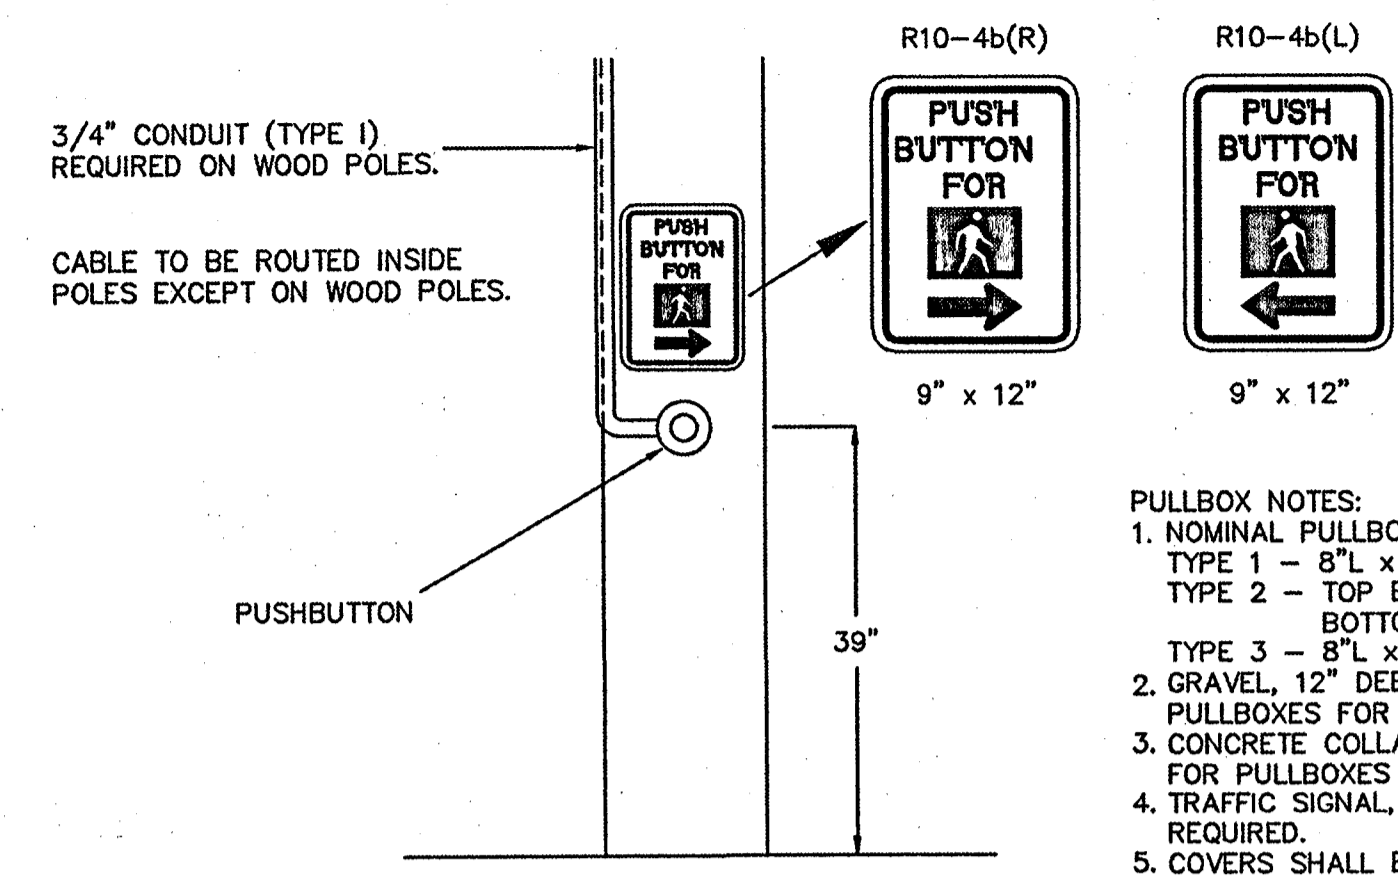


**PEDESTRIAN PUSH BUTTON AND SIGN INSTALLATION DETAIL**

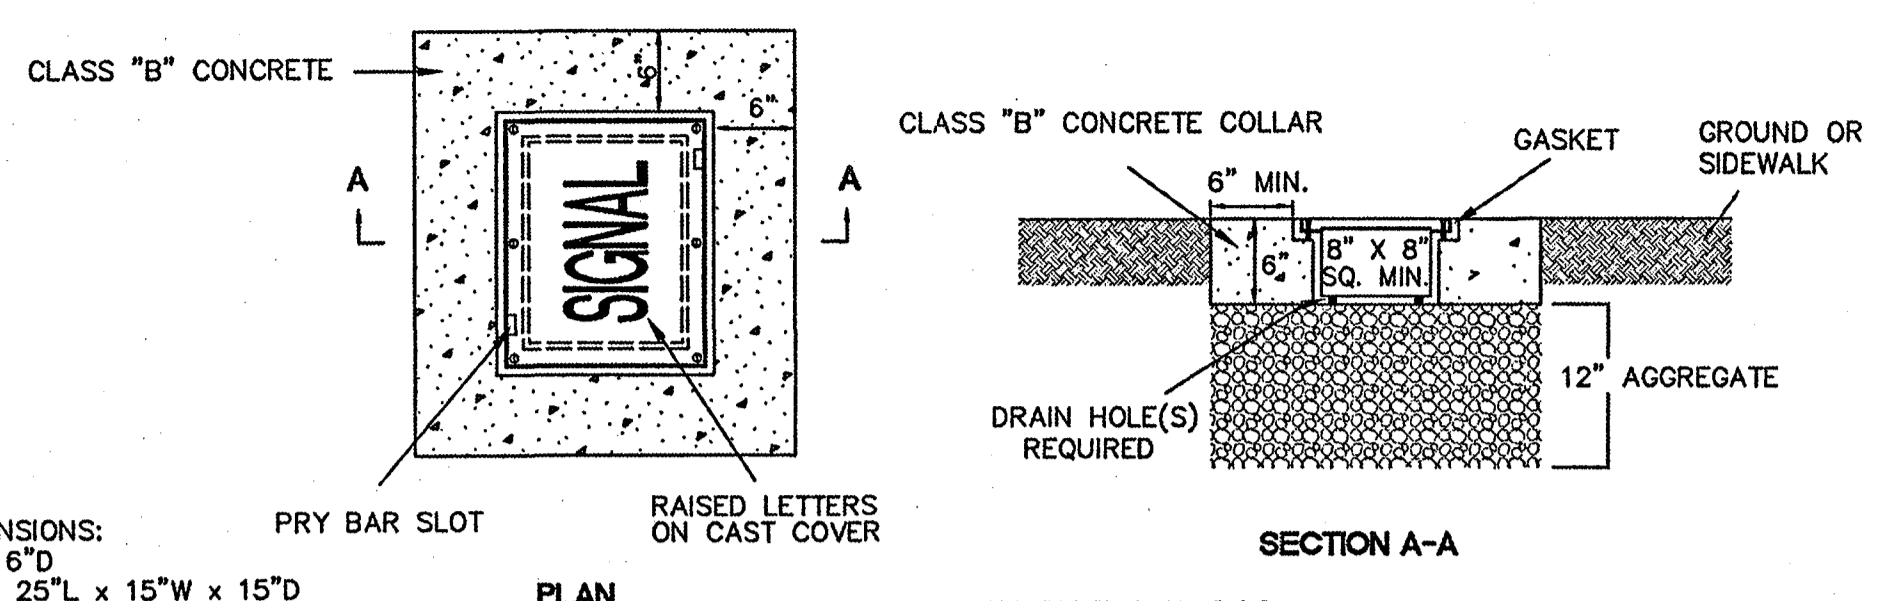


**TWO-PIECE PULLBOX (TYPE 1)**

- PULLBOX NOTES:**
1. NOMINAL PULLBOX DIMENSIONS:  
TYPE 1 - 8\"/>

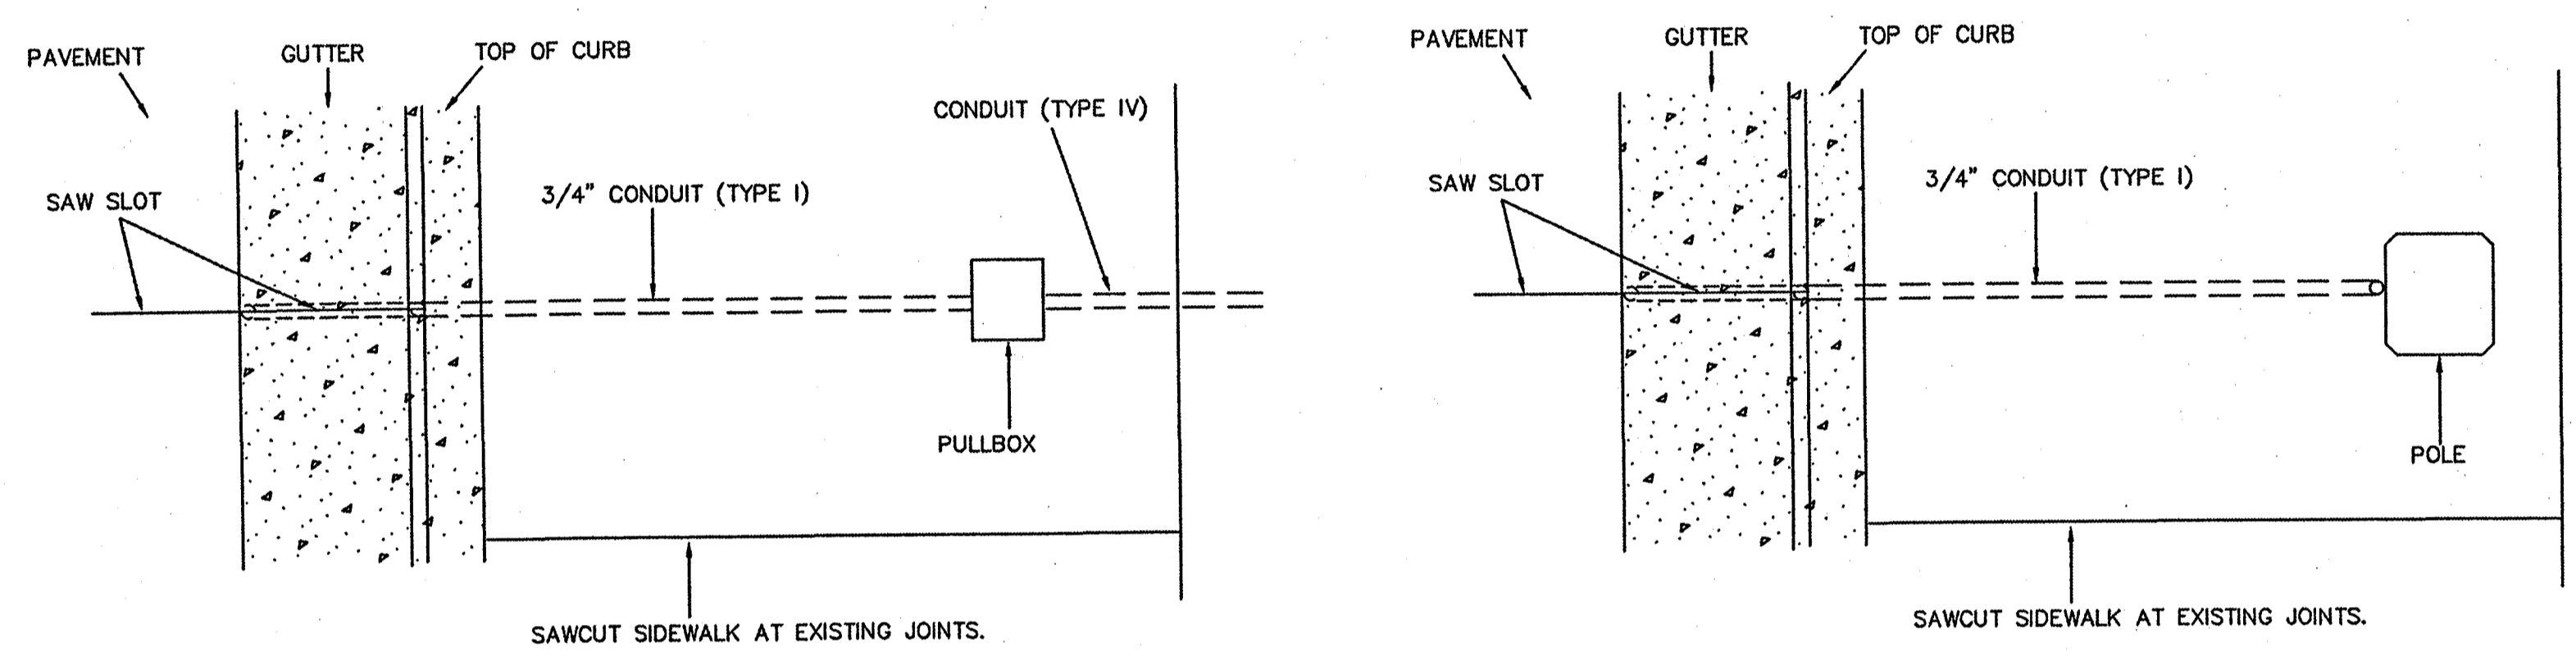


**PLAN VIEW - LOOP LEAD-IN CONDUIT**

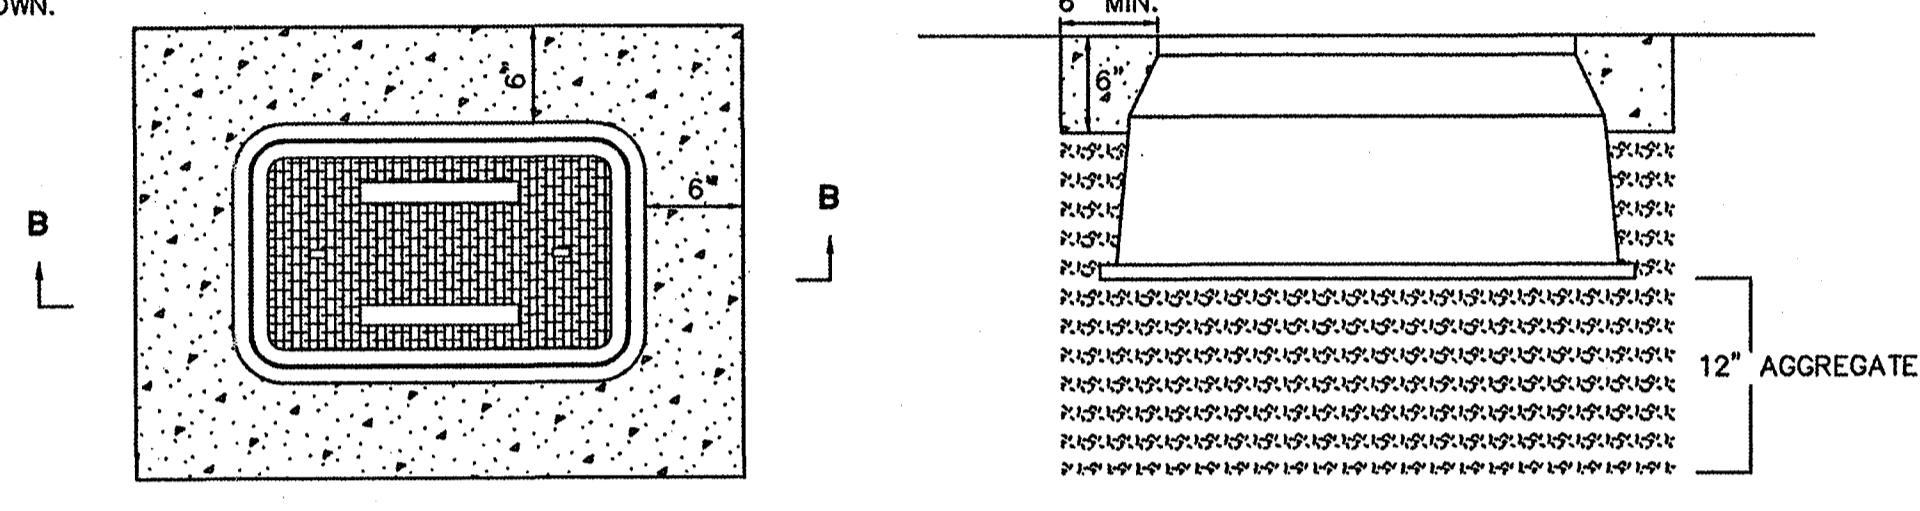


**TWO-PIECE PULLBOX (TYPE 2)**

PRECAST CLASS "B" CONCRETE, HIGH DENSITY POLYETHYLENE, COMPOSOLITE, OR APPROVED EQUAL

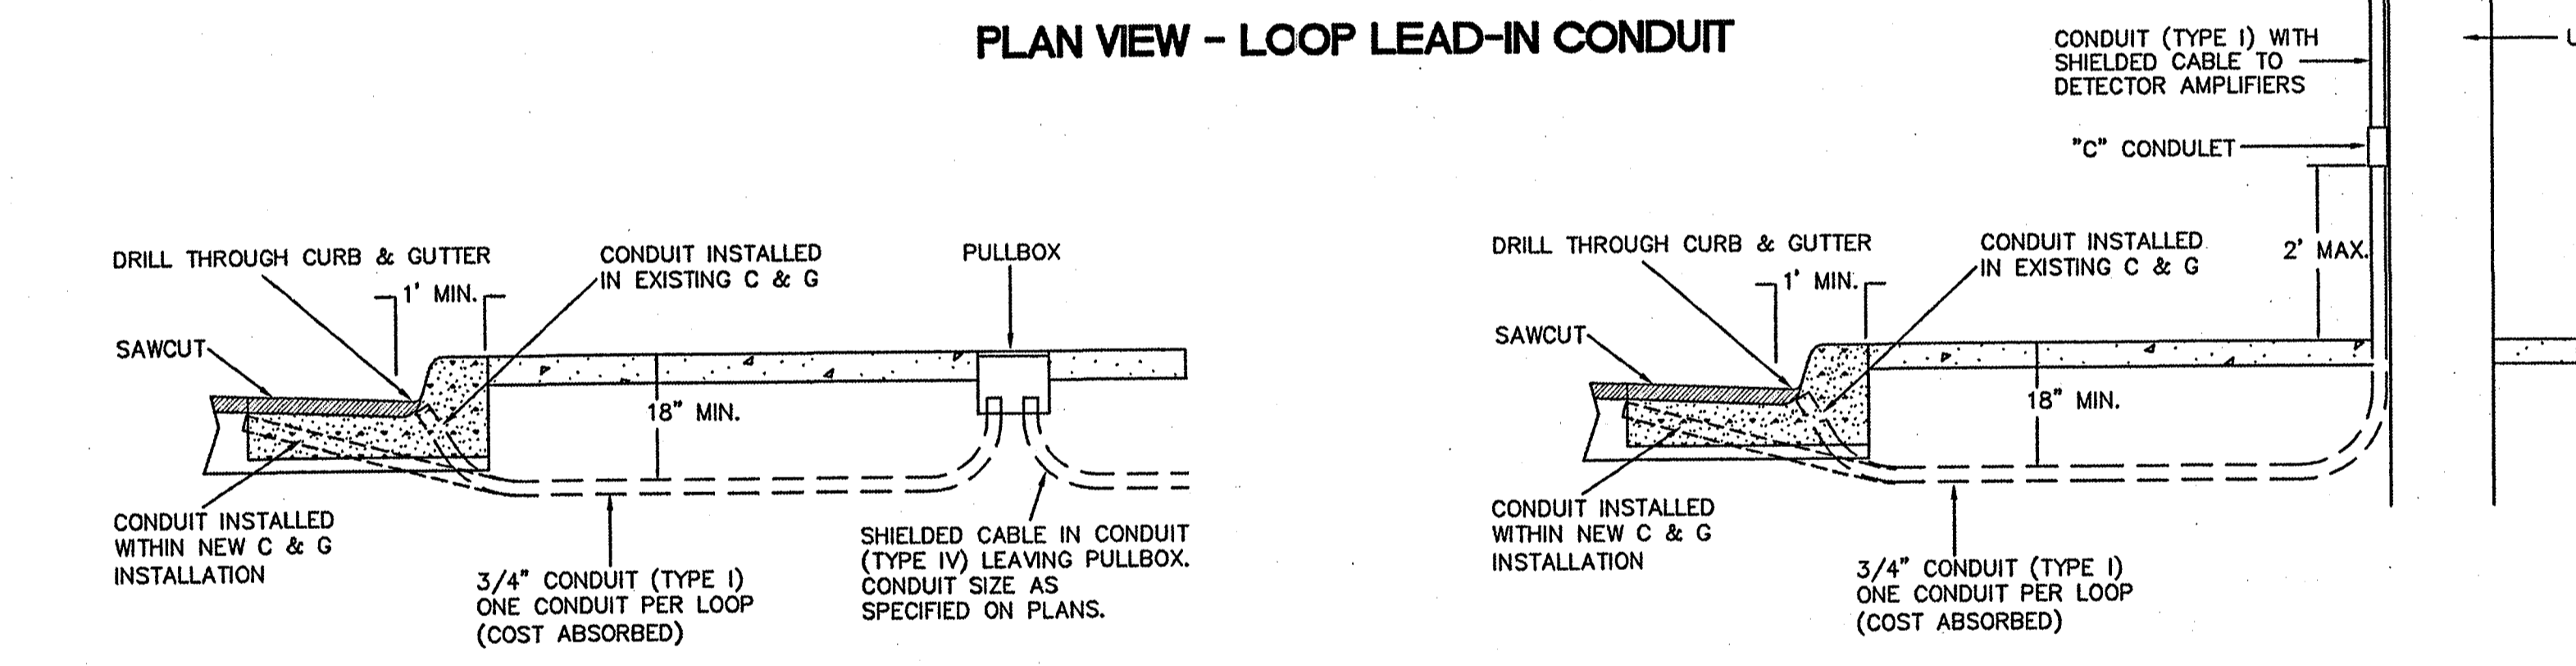


**TYPICAL SECTION IN GUTTER AND SIDEWALK**

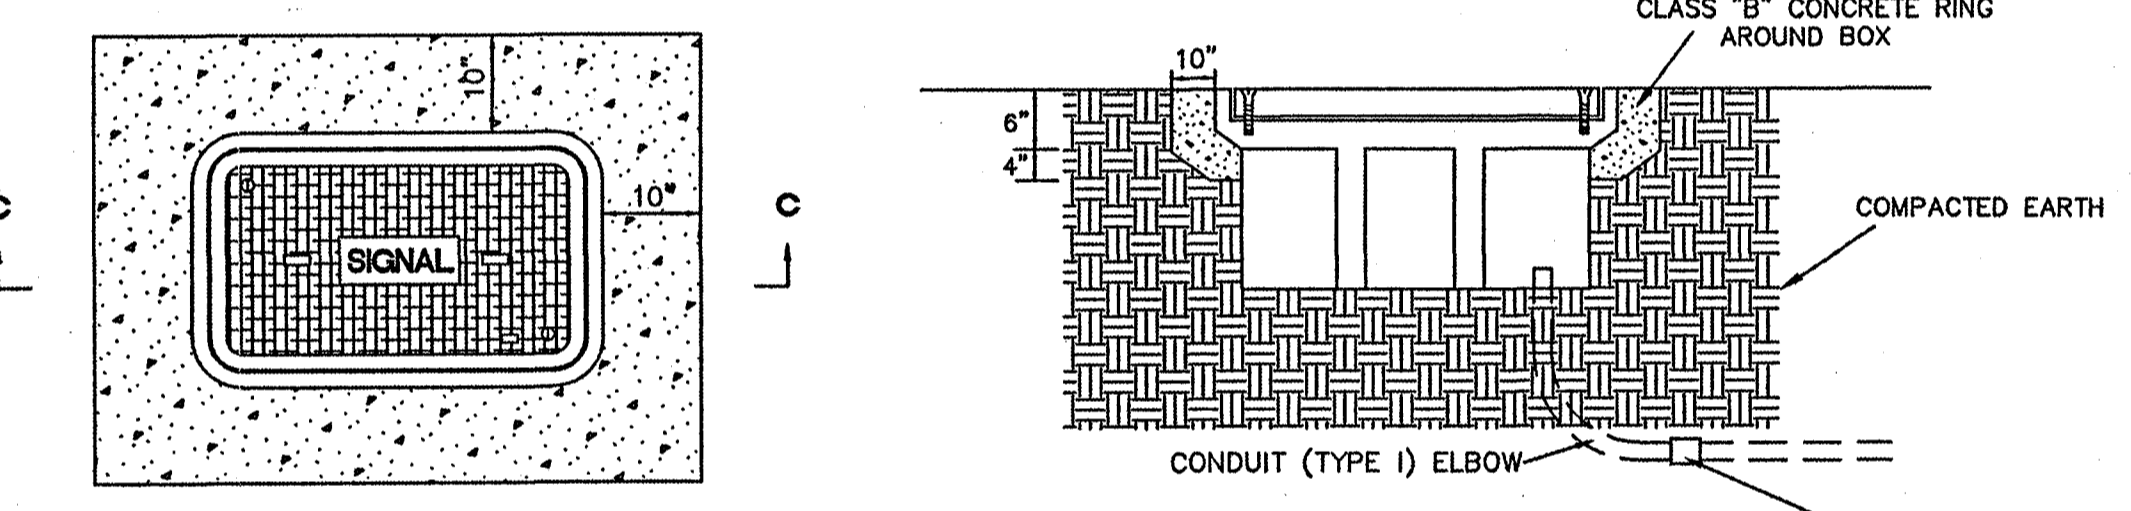


**TWO-PIECE PULLBOX (TYPE 3 MODIFIED)**

COMPOSOLITE OR APPROVED EQUAL

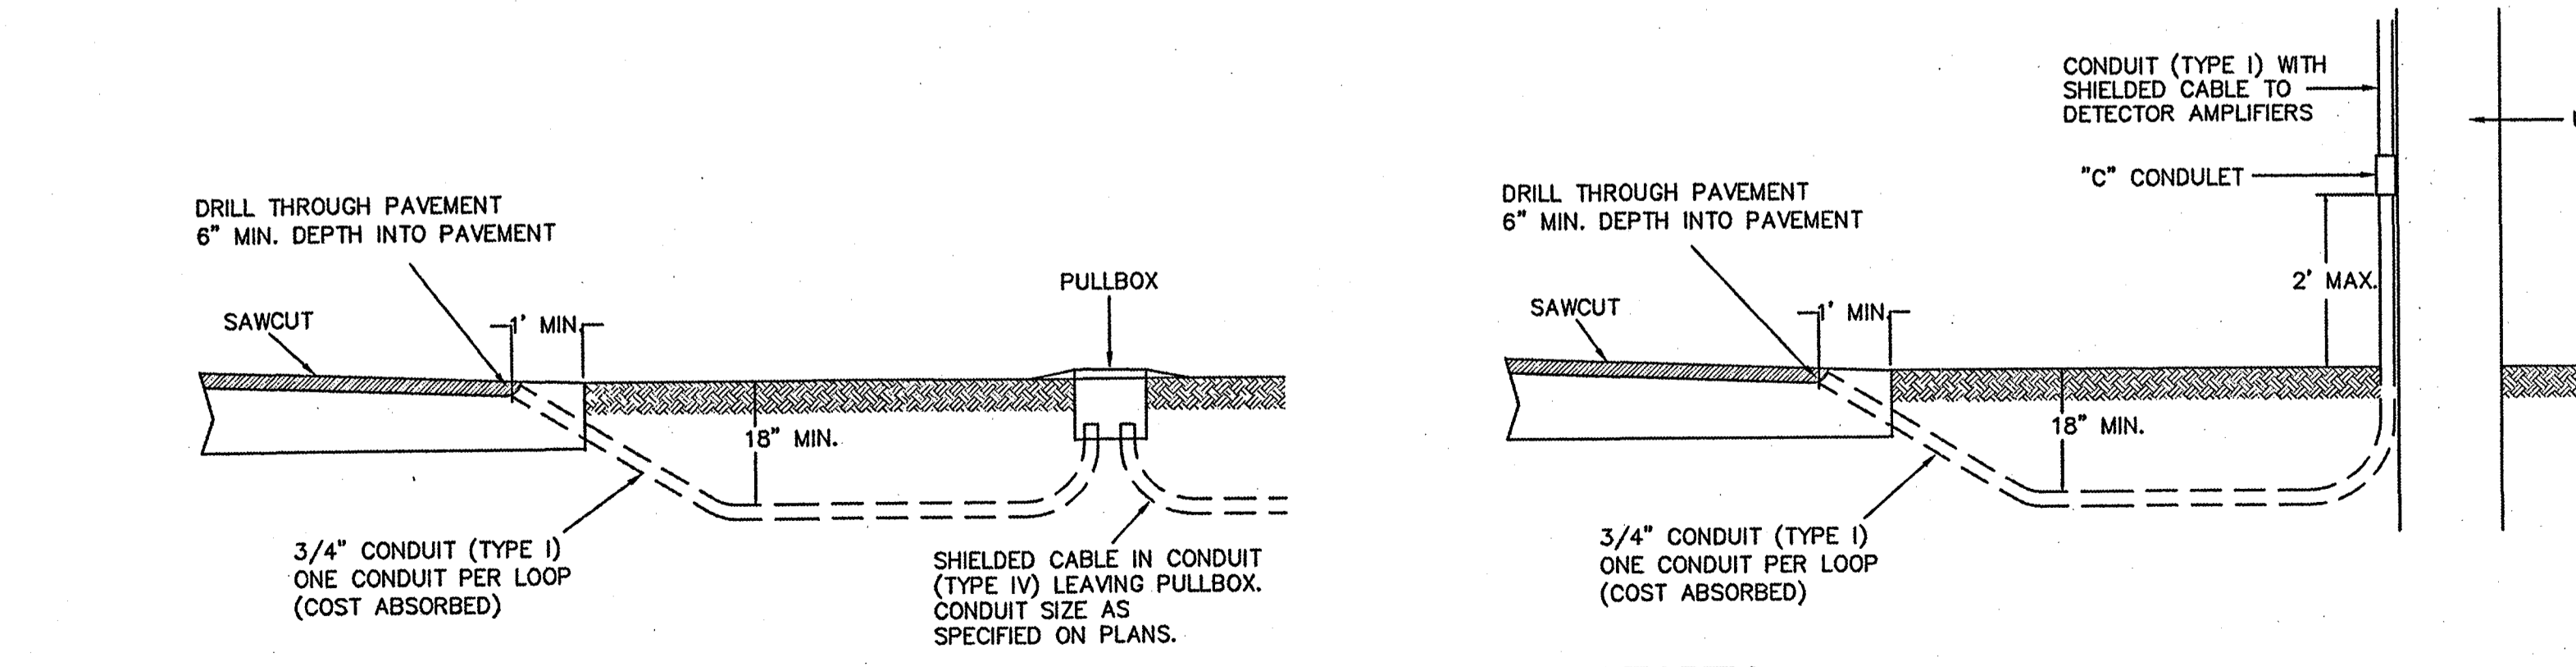

**TYPICAL SECTION IN EARTH**

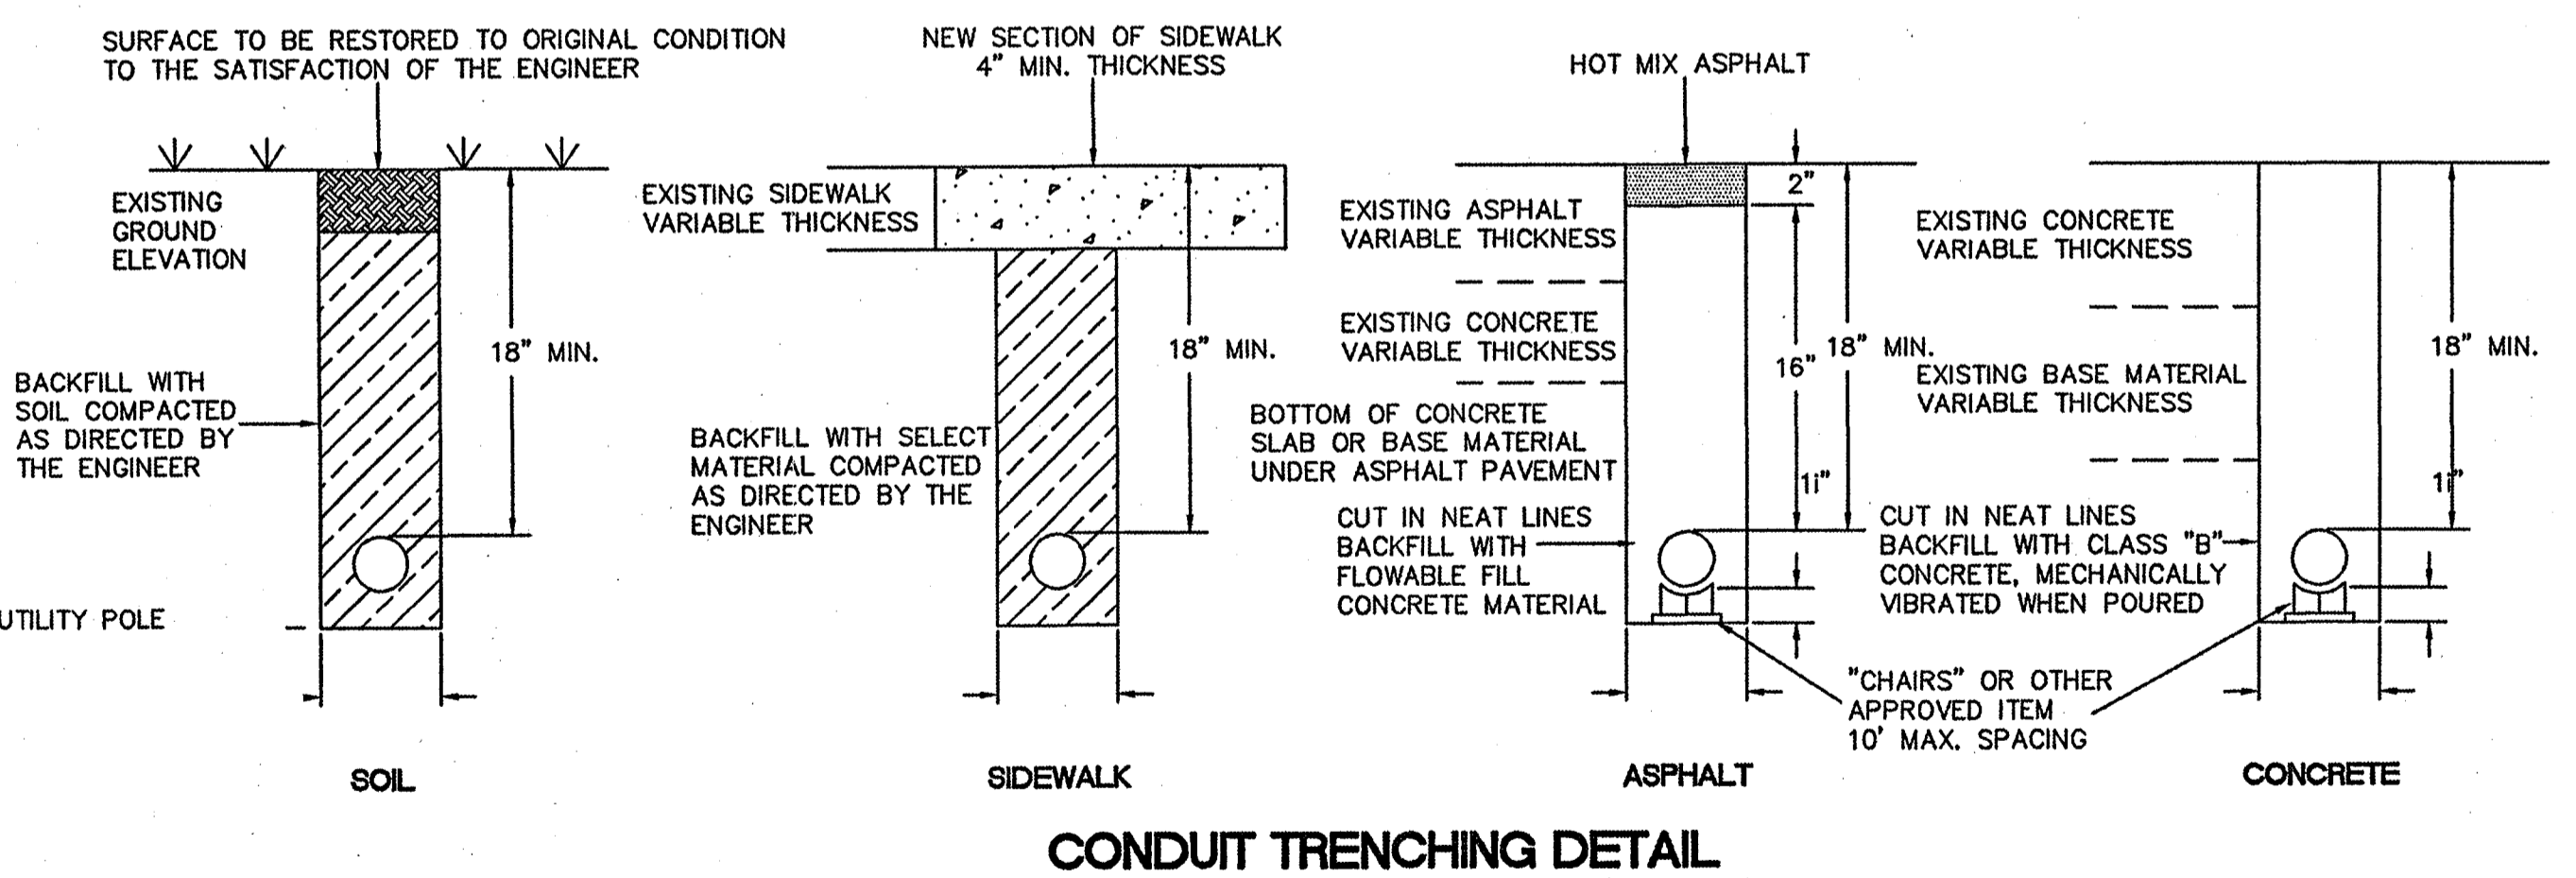

**CONDUIT TRENCHING DETAIL**

- NOTES:**
1. CONDUIT TO BE SEALED WITH DUCT SEALER ONCE CABLE IS INSTALLED.
  2. SAWCUT SIDEWALK AT EXISTING JOINTS AND REPLACE ENTIRE SECTION TO MATCH EXISTING MATERIAL. WHEN NEW SIDEWALK IS BEING CONSTRUCTED, CONDUIT, PULLBOX, AND POLE ARE TO BE INSTALLED BEFORE SIDEWALK IS POURED.
  3. TYPE I CONDUIT IS RIGID STEEL; TYPE IV CONDUIT IS PVC.
  4. CONDUIT MAY BE TRENCHED OR JACKED. ELECTRICAL SUBCONTRACTOR SHALL COORDINATE CONDUIT INSTALLATION WORK UNDER ROADWAY WITH ROADWAY CONSTRUCTION PHASING IN ORDER TO MINIMIZE JACKING.

DRAWING REVISIONS		
NO.	REMARKS	DATE

DRAWN BY:	SCALE: N.T.S.
DESIGNED BY:	DATE: 2-03-05
CHECKED BY: SW	PROJECT: 194-148

**CONDUIT,  
PULLBOX, AND  
PEDESTRIAN  
PUSHBUTTON**


















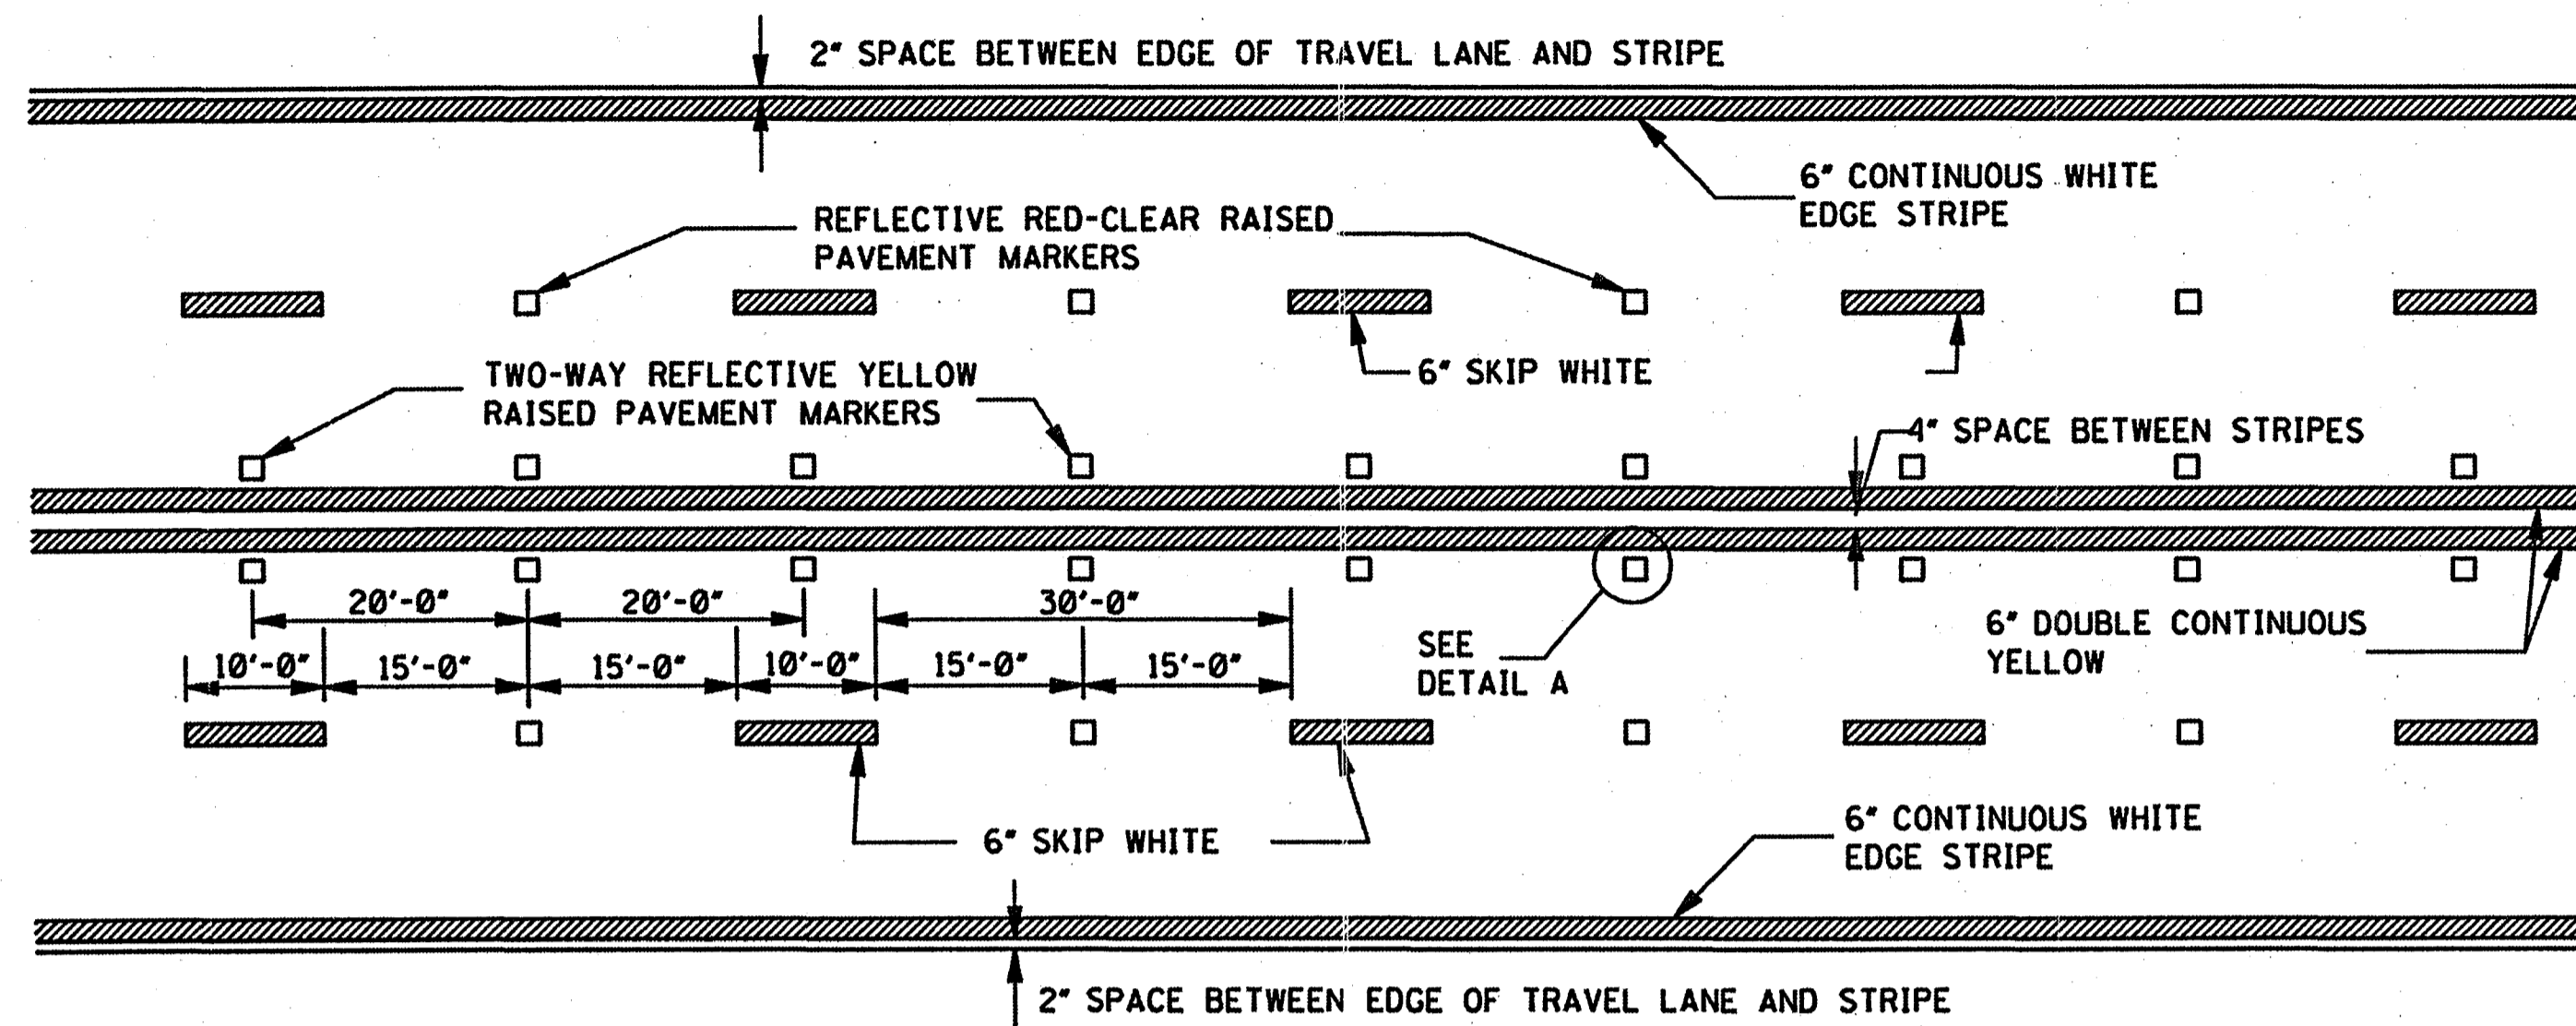

TYPICAL STRIPING AND RAISED PAVEMENT MARKERS FOR 4-LANE SECTION

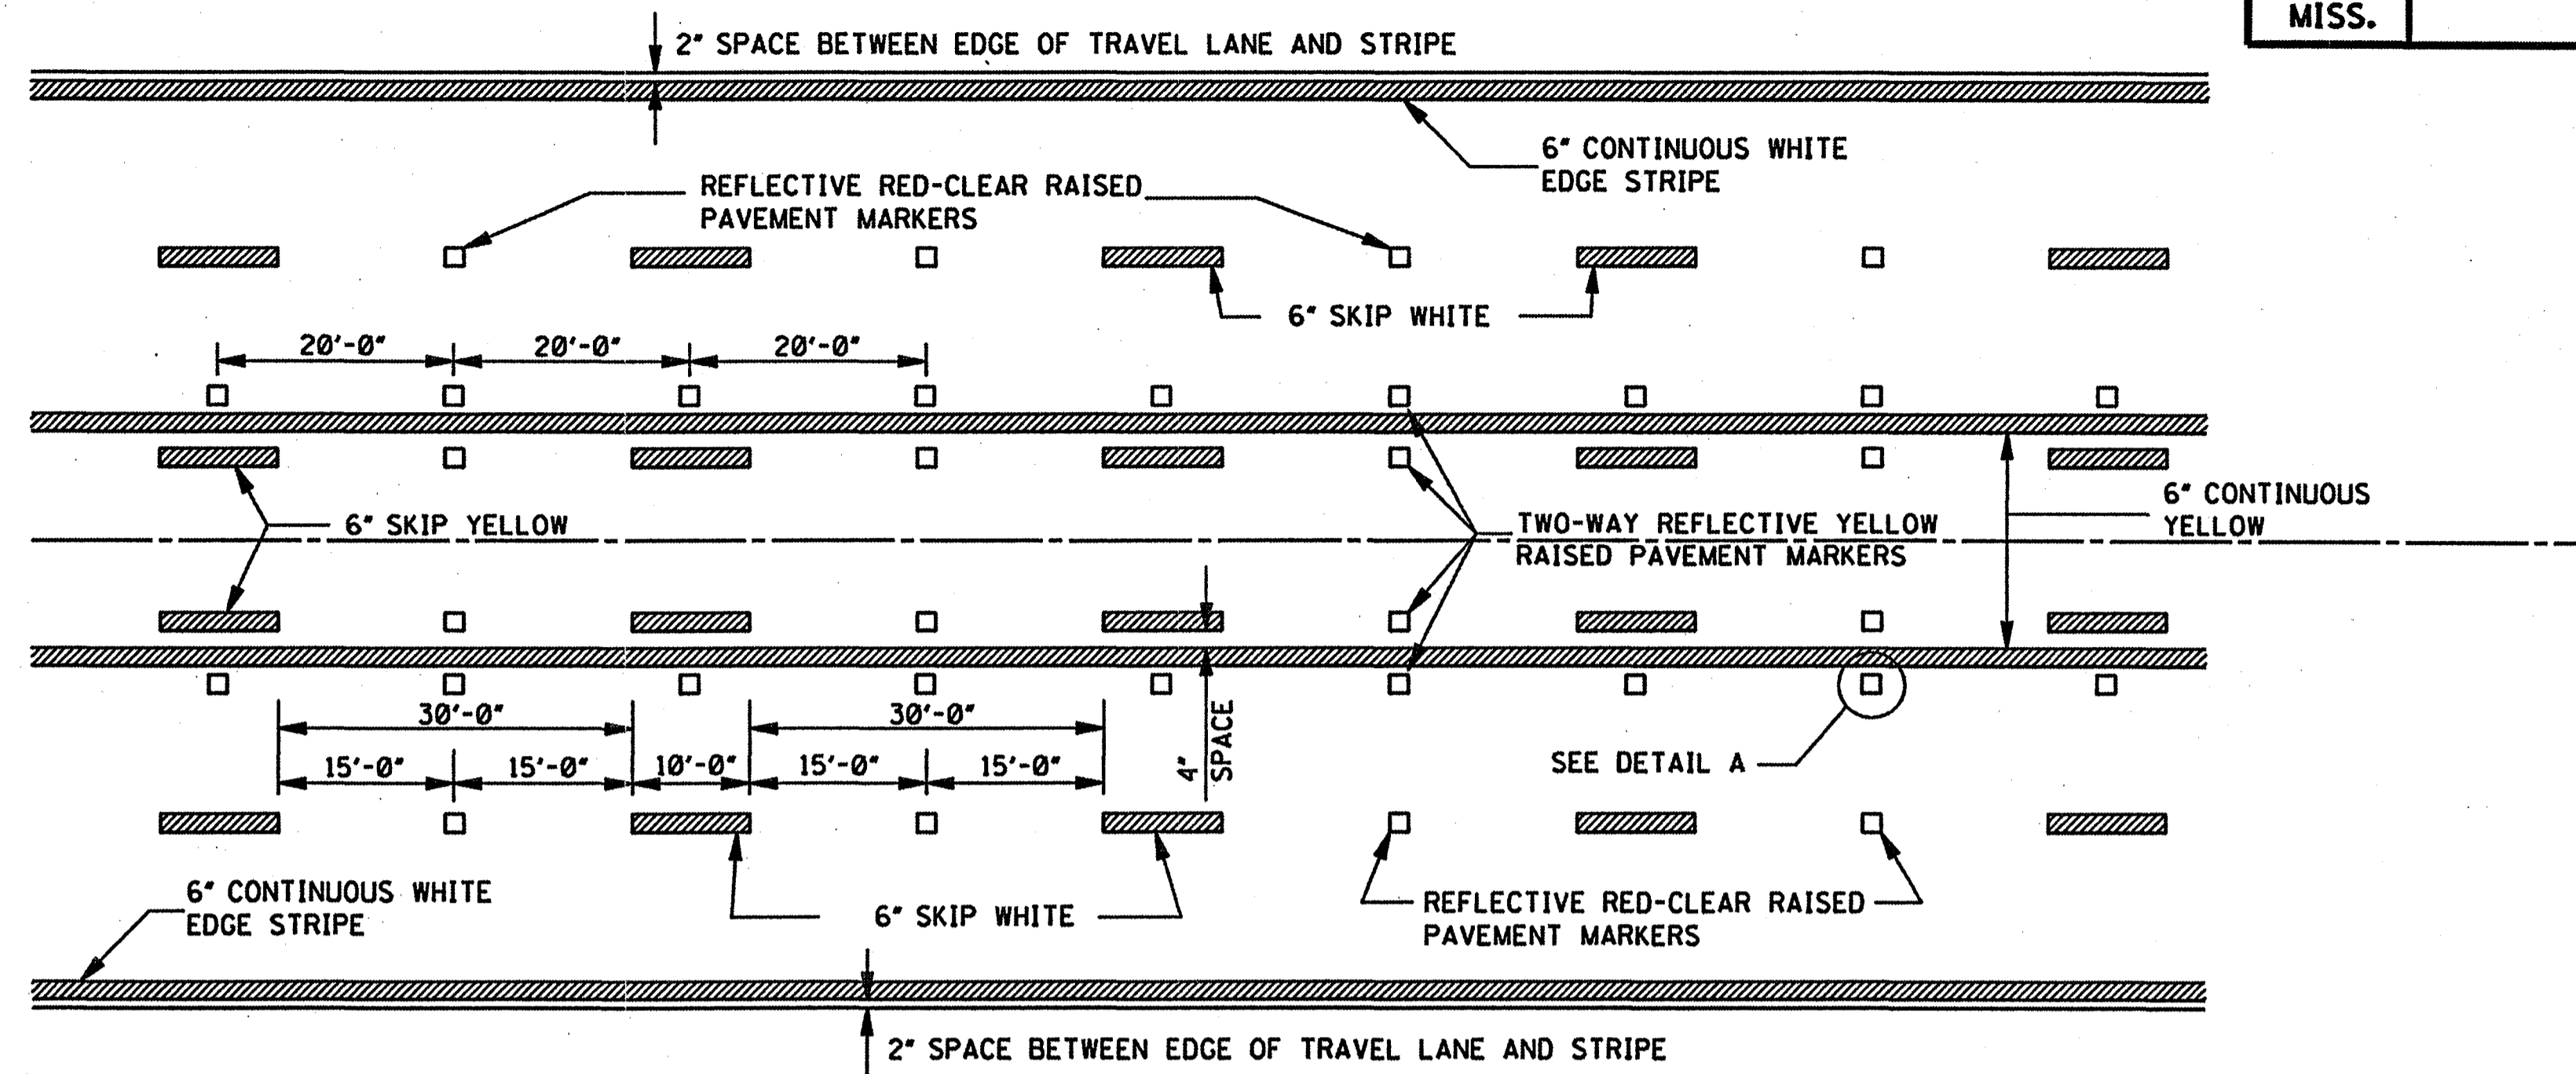


TYPICAL STRIPING AND RAISED PAVEMENT MARKERS FOR 5-LANE SECTION

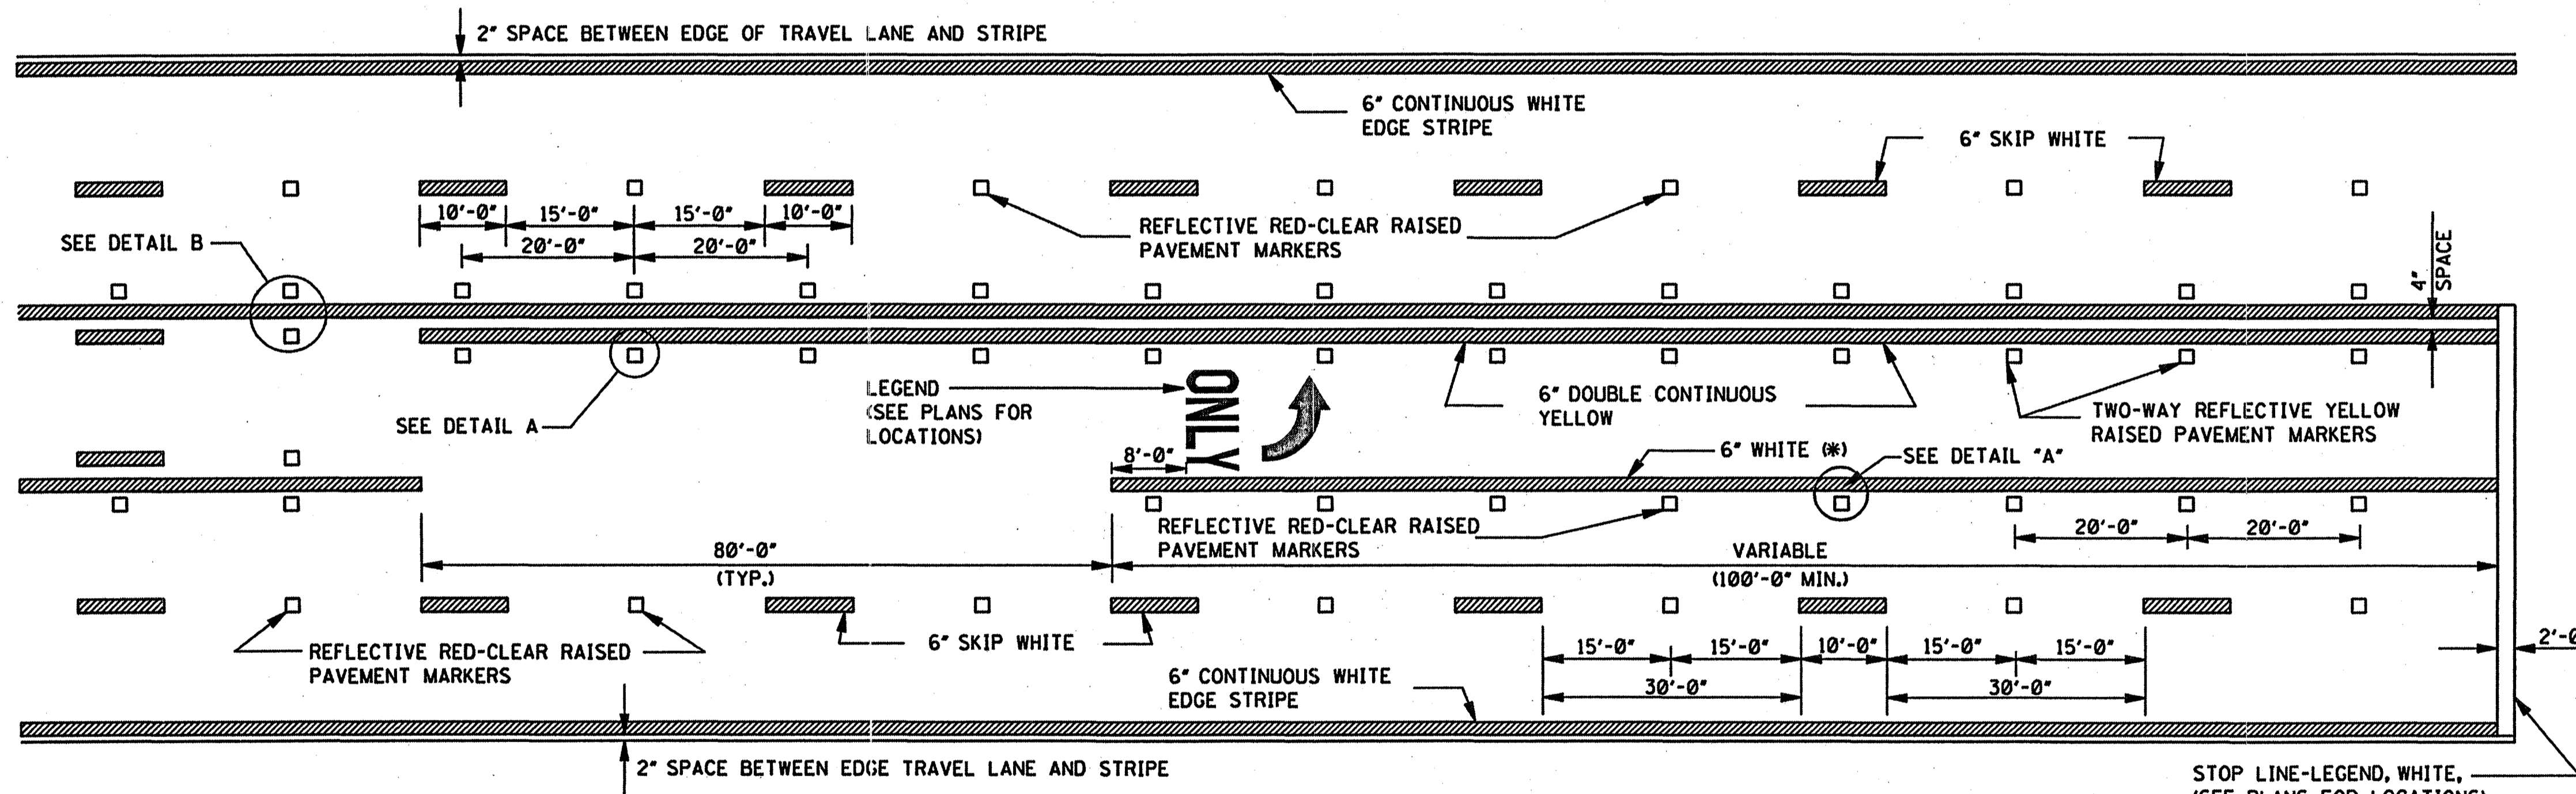


TYPICAL STRIPING AND RAISED PAVEMENT MARKERS AT LEFT TURN LANES

\*NOTE: USE DETAIL STRIPING IF LENGTH ≤ 150' AT THIS LOCATION, OTHERWISE USE CONTINUOUS STRIPING.

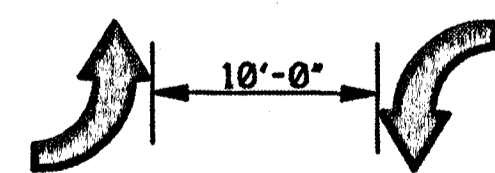


TYPICAL TWO-WAY ARROW INSTALLATION

- NOTES: 1. CONSIDER EACH SEGMENT OF CONTINUOUS TWO-WAY LEFT TURN LANE SEPARATELY.  
 2. IF SEGMENT IS LESS THAN 350', PLACE ONE SET OF ARROWS IN CENTER OF SEGMENT.  
 3. IF SEGMENT IS GREATER THAN 350', PLACE FIRST SET OF ARROWS 50' TO 100' FROM BEGINNING AND/OR END OF SEGMENT AND SPACE ADDITIONAL SETS OF ARROWS (250' O.C.).

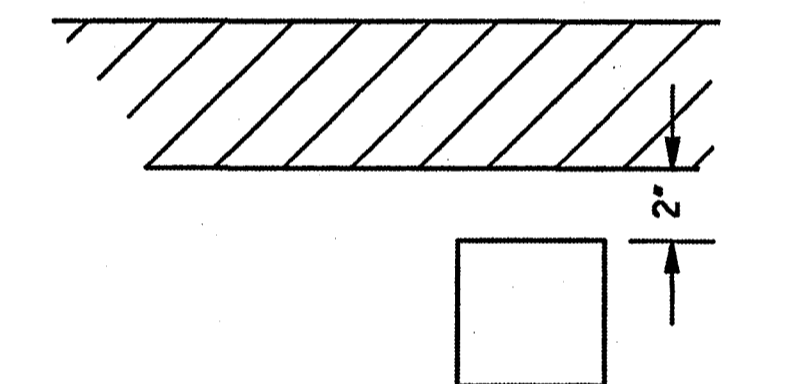

DETAIL A LATERAL PLACEMENT OF PAVEMENT MARKERS










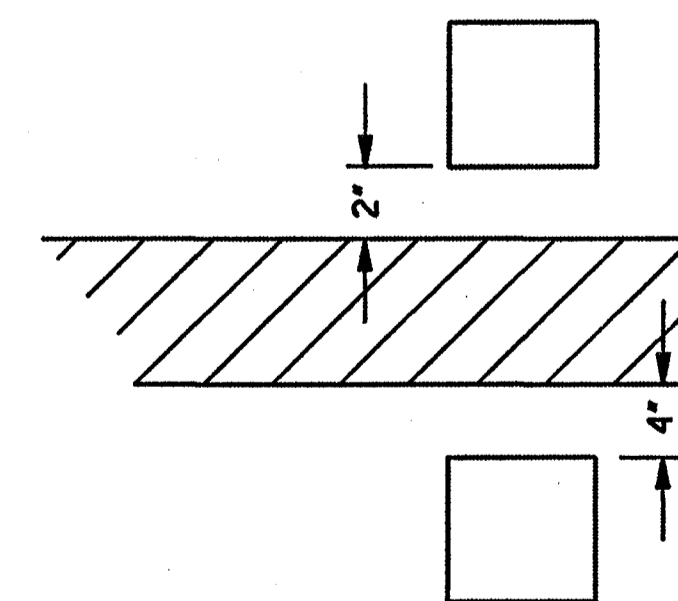


DETAIL B LATERAL PLACEMENT OF PAVEMENT MARKERS

GENERAL NOTE:

1. PAVEMENT MARKERS SHALL BE HIGH PERFORMANCE RAISED PAVEMENT MARKERS AS LISTED IN THE MDOT "APPROVED SOURCES OF MATERIALS".

MISSISSIPPI DEPARTMENT OF TRANSPORTATION ROADWAY DESIGN DIVISION STANDARD PLAN	
<b>PAVEMENT MARKING DETAILS FOR 4-LANE AND 5-LANE UNDIVIDED ROADWAYS</b>	
WORKING NUMBER PM-2	 SHEET NUMBER 121
ISSUE DATE: OCTOBER 1, 1998	

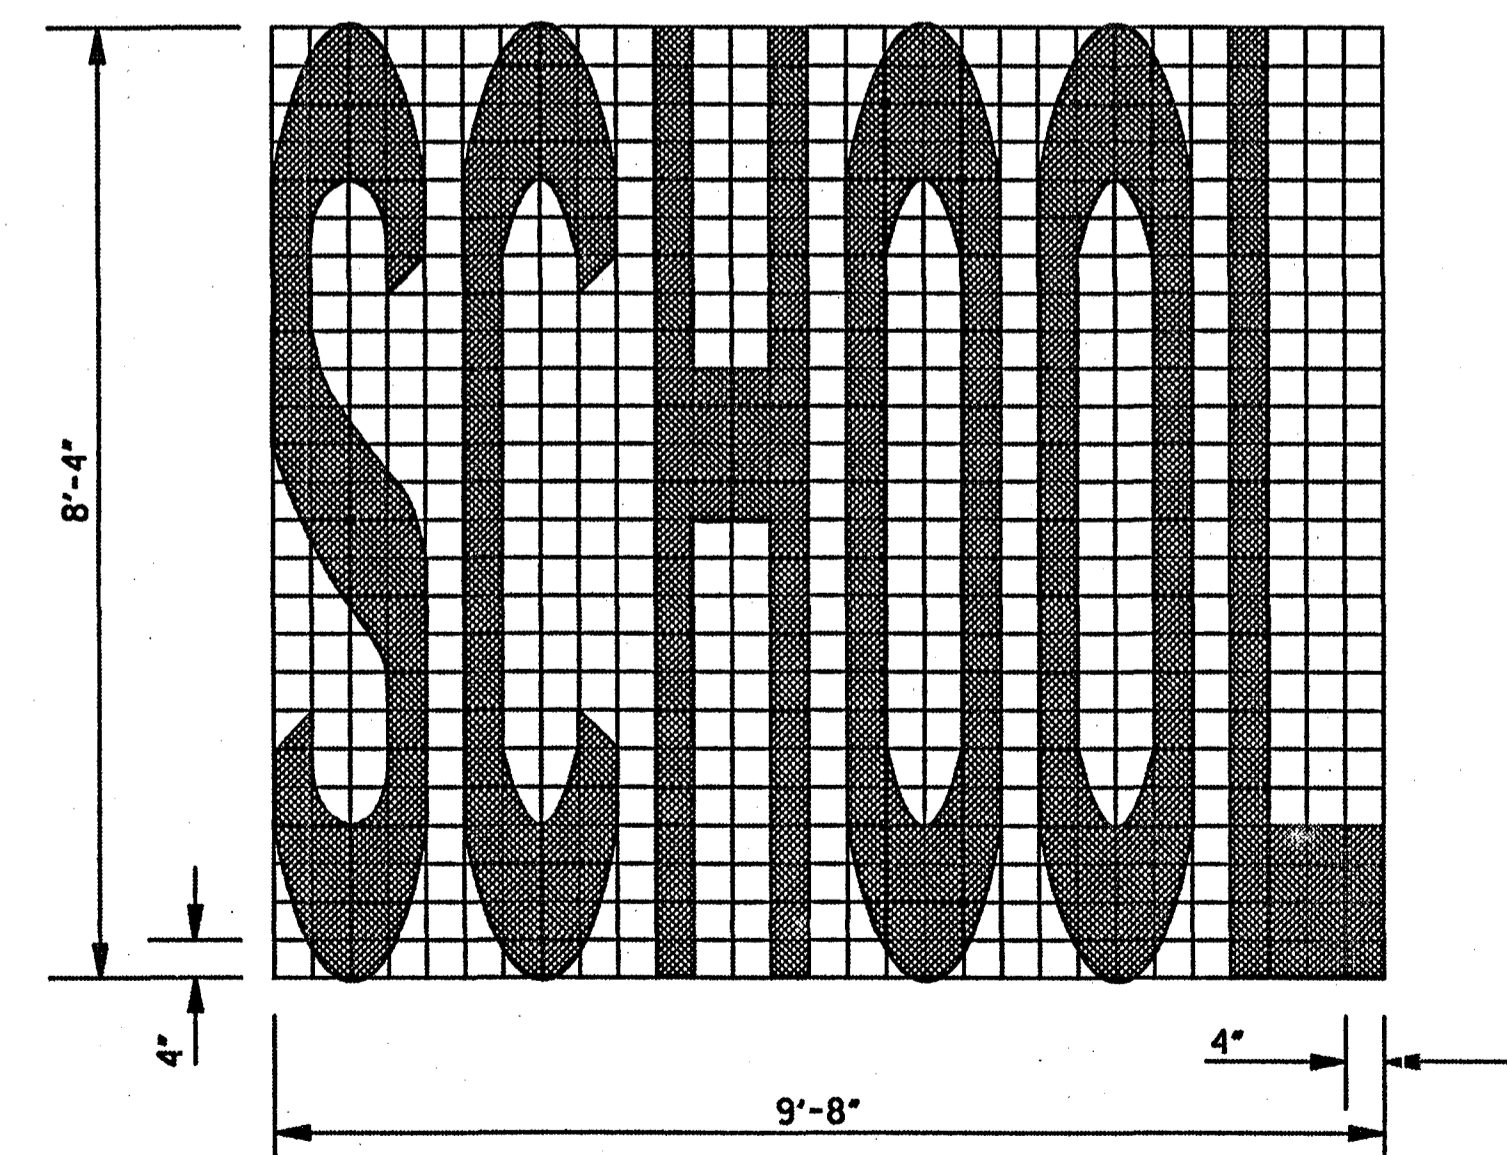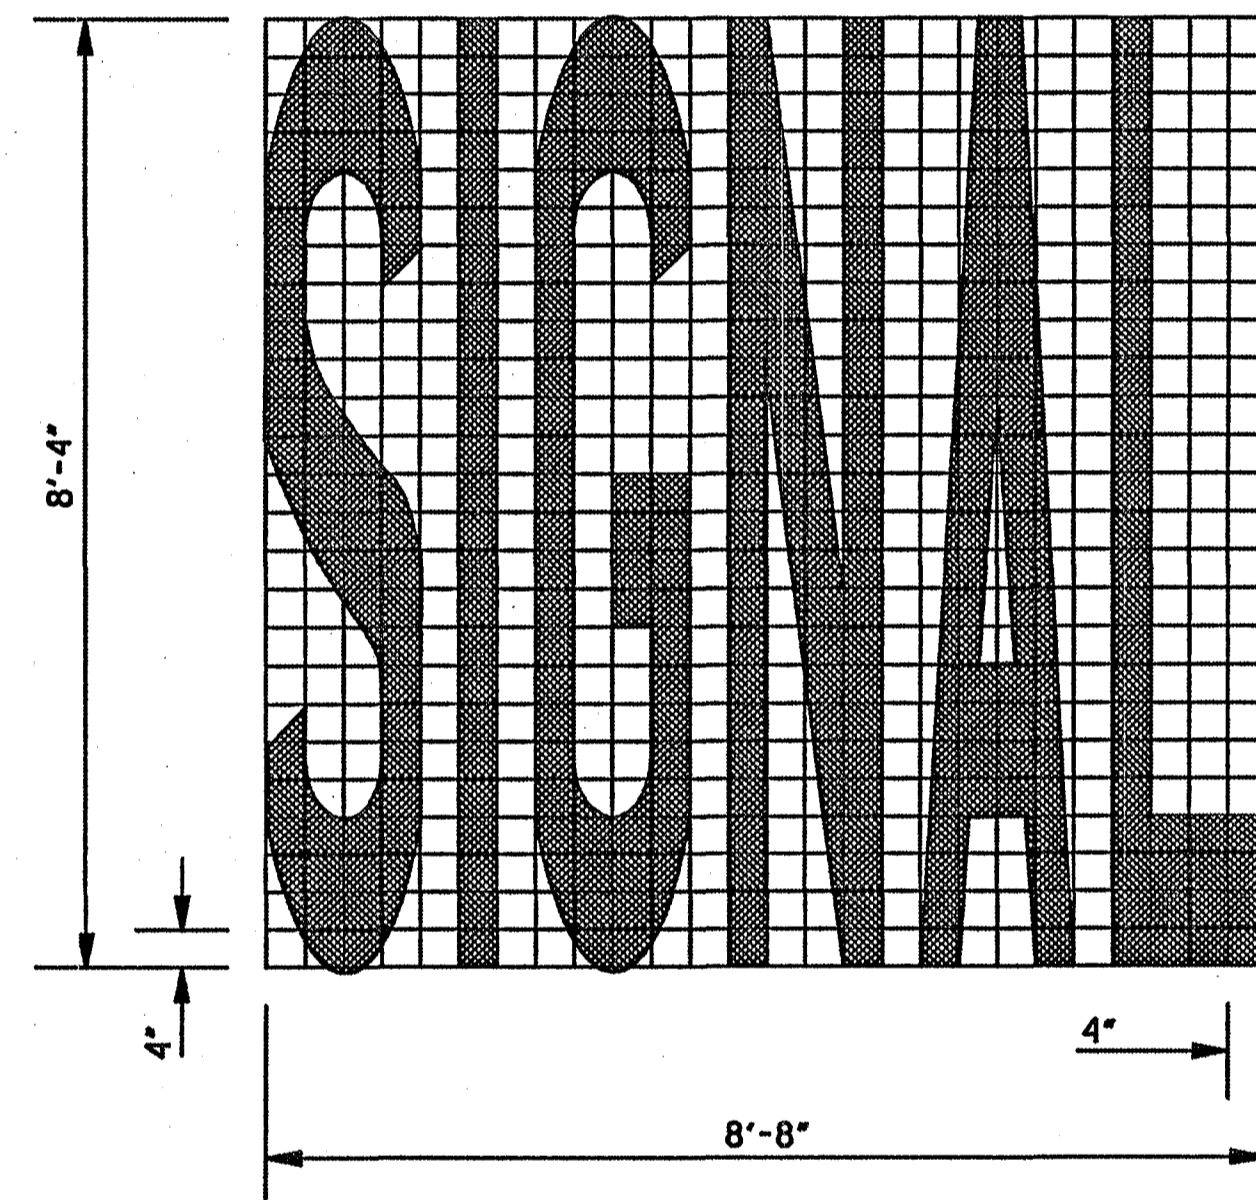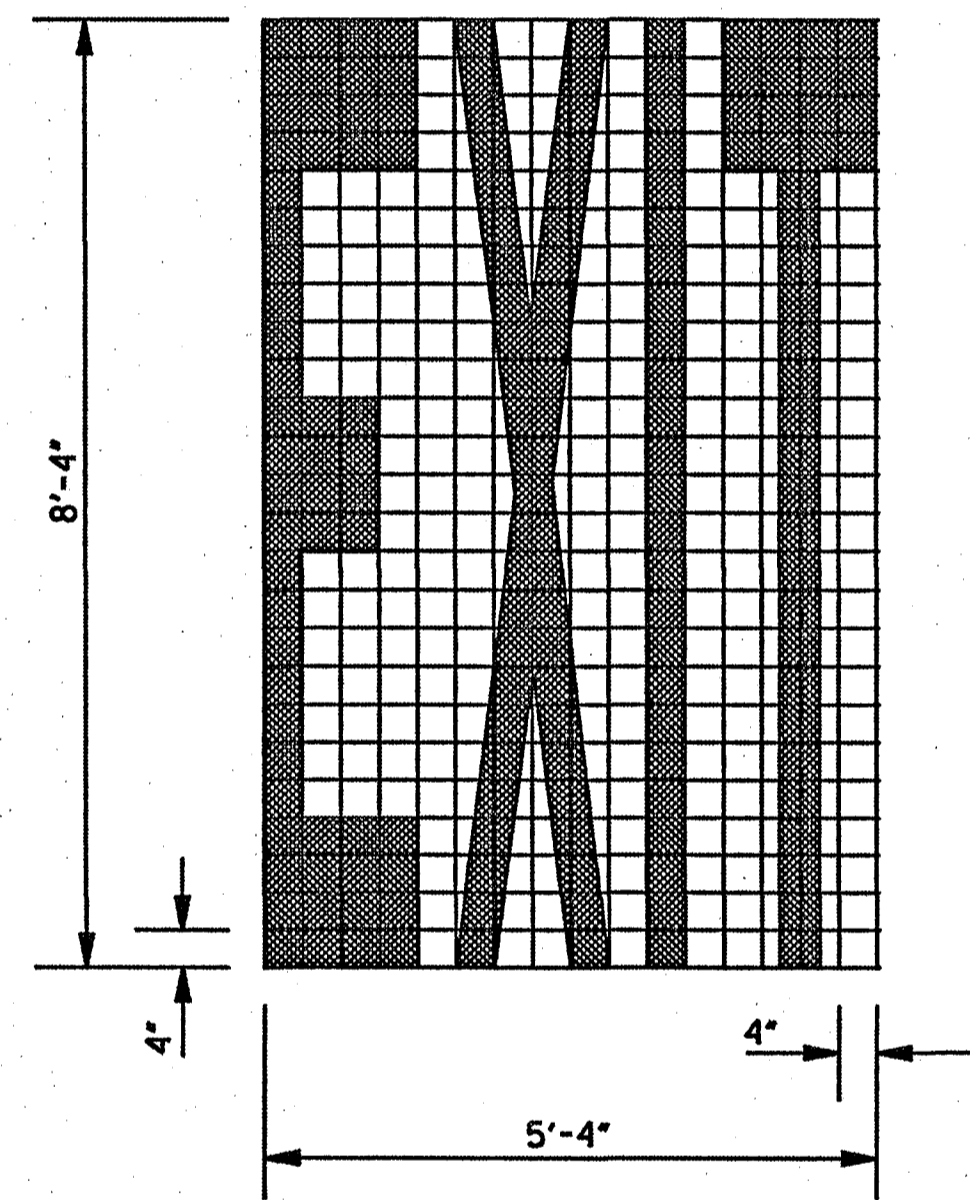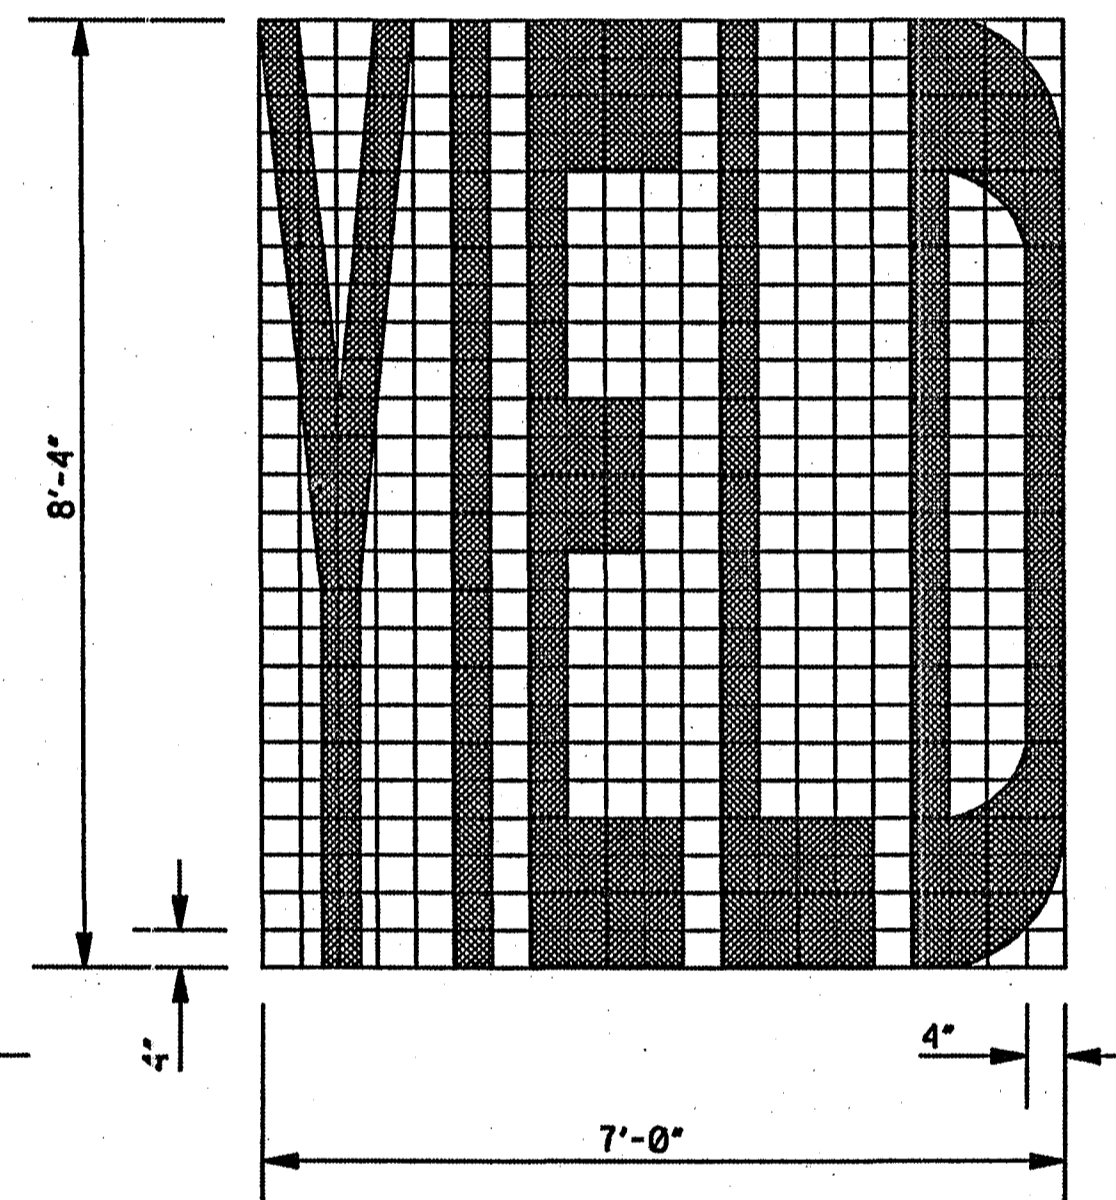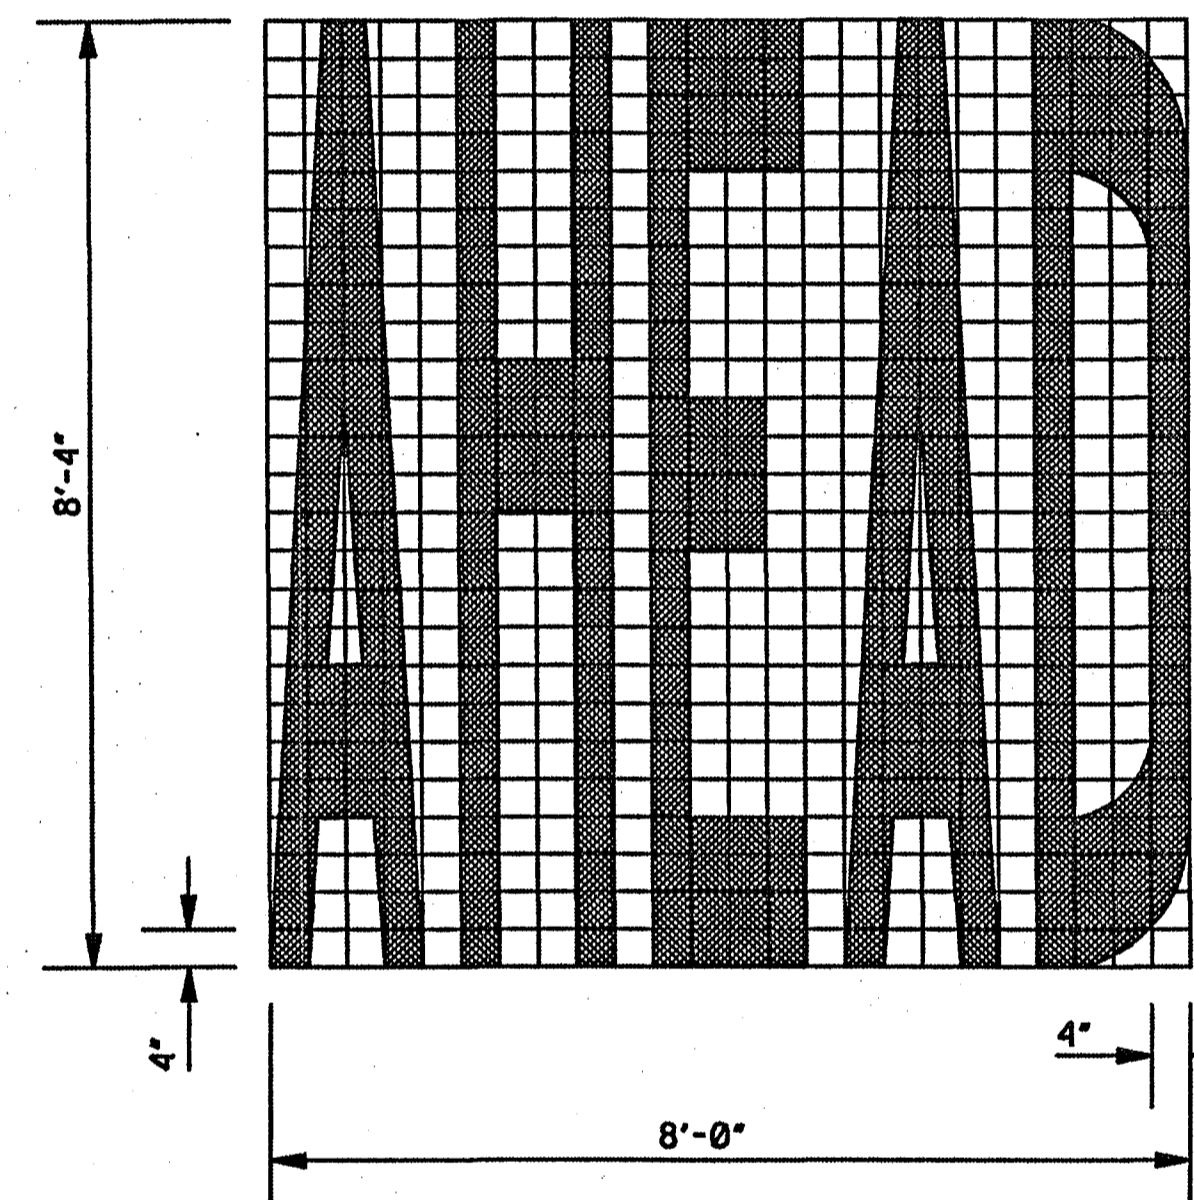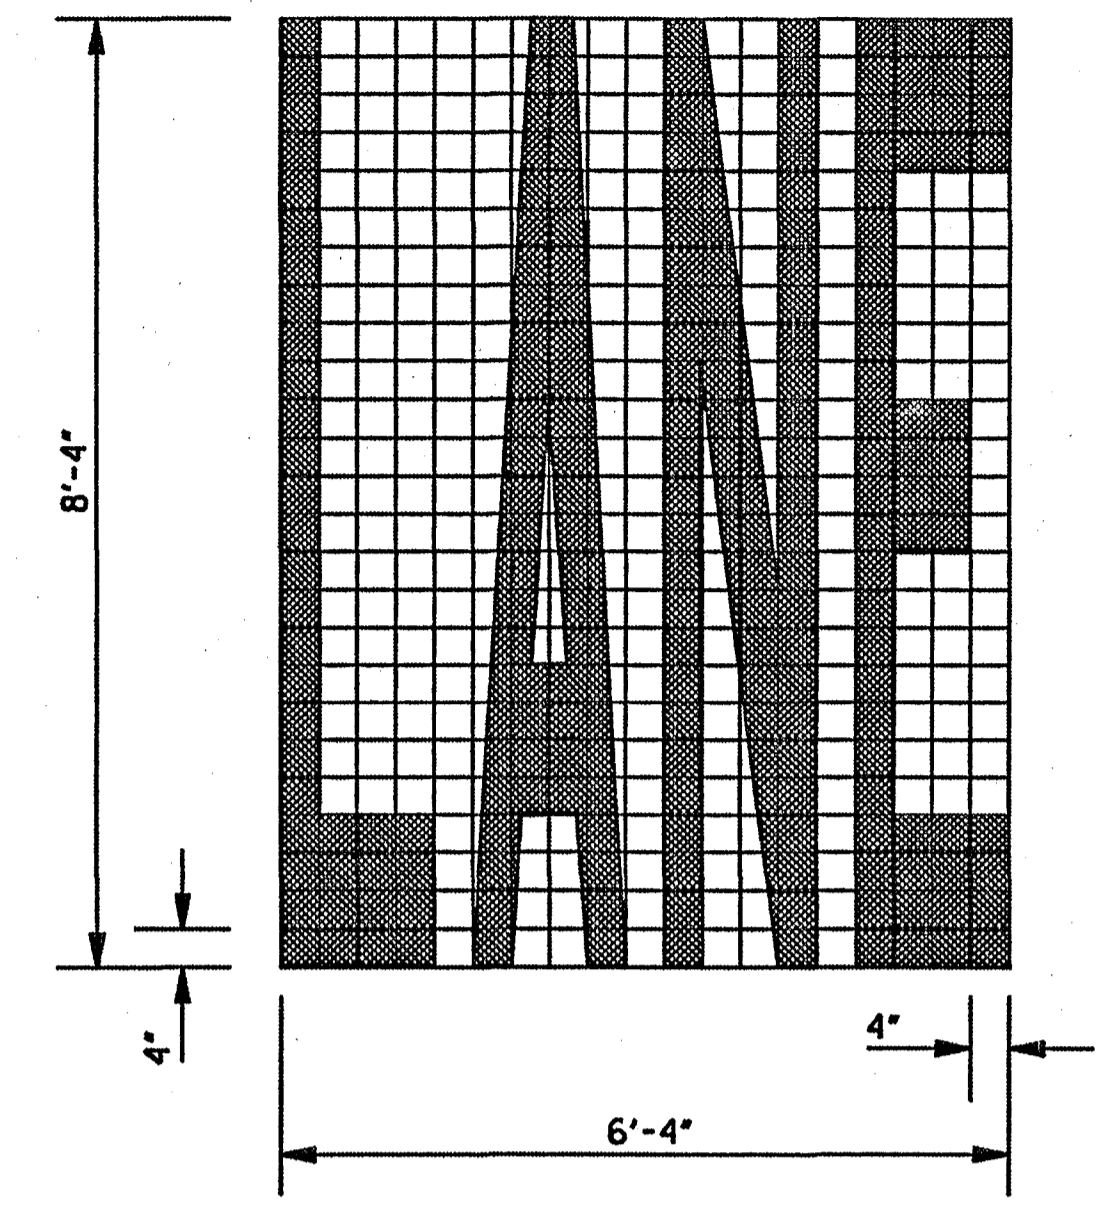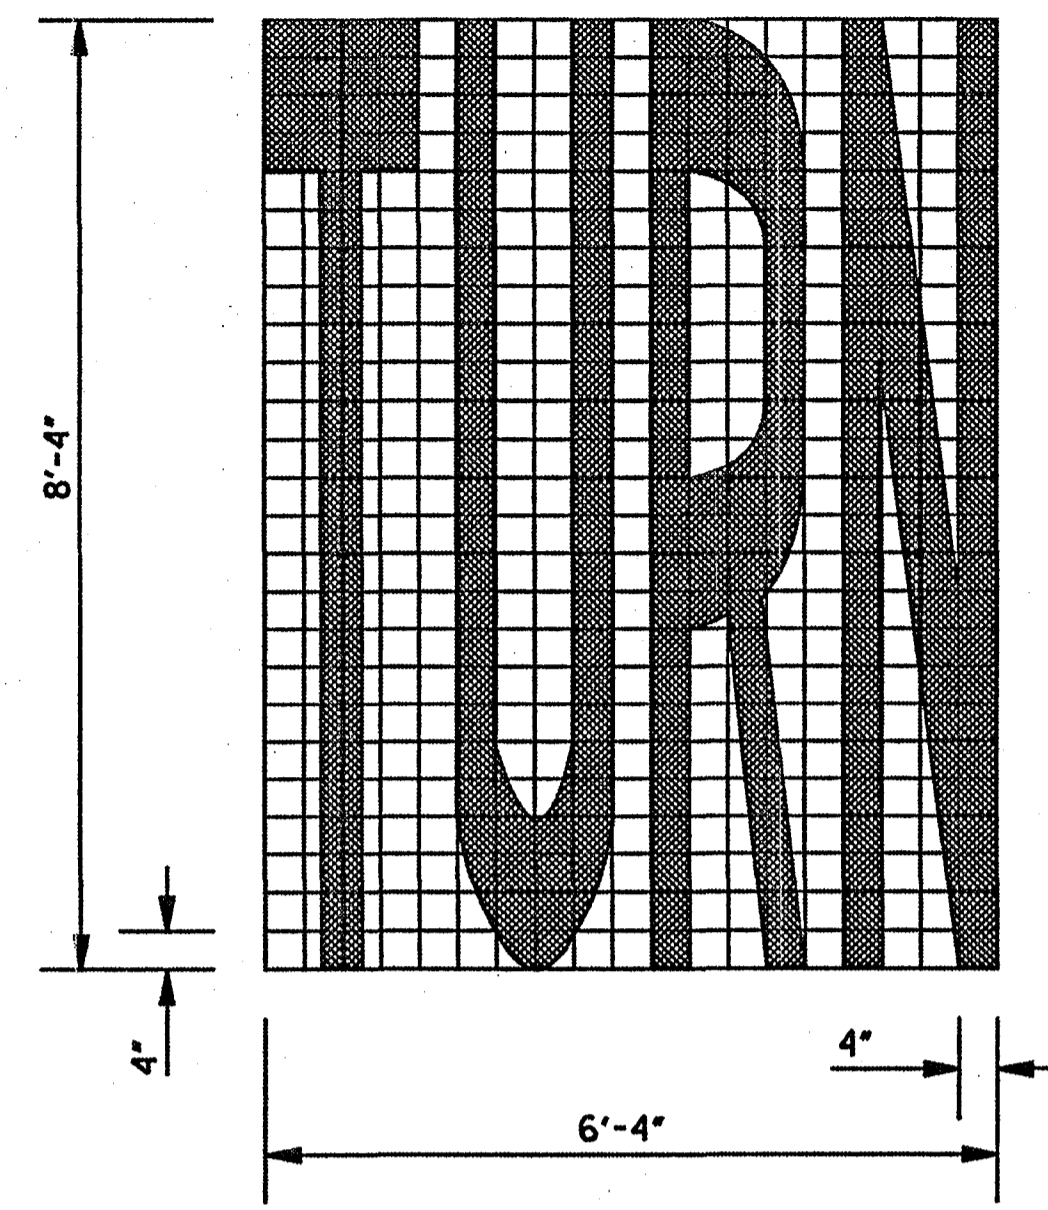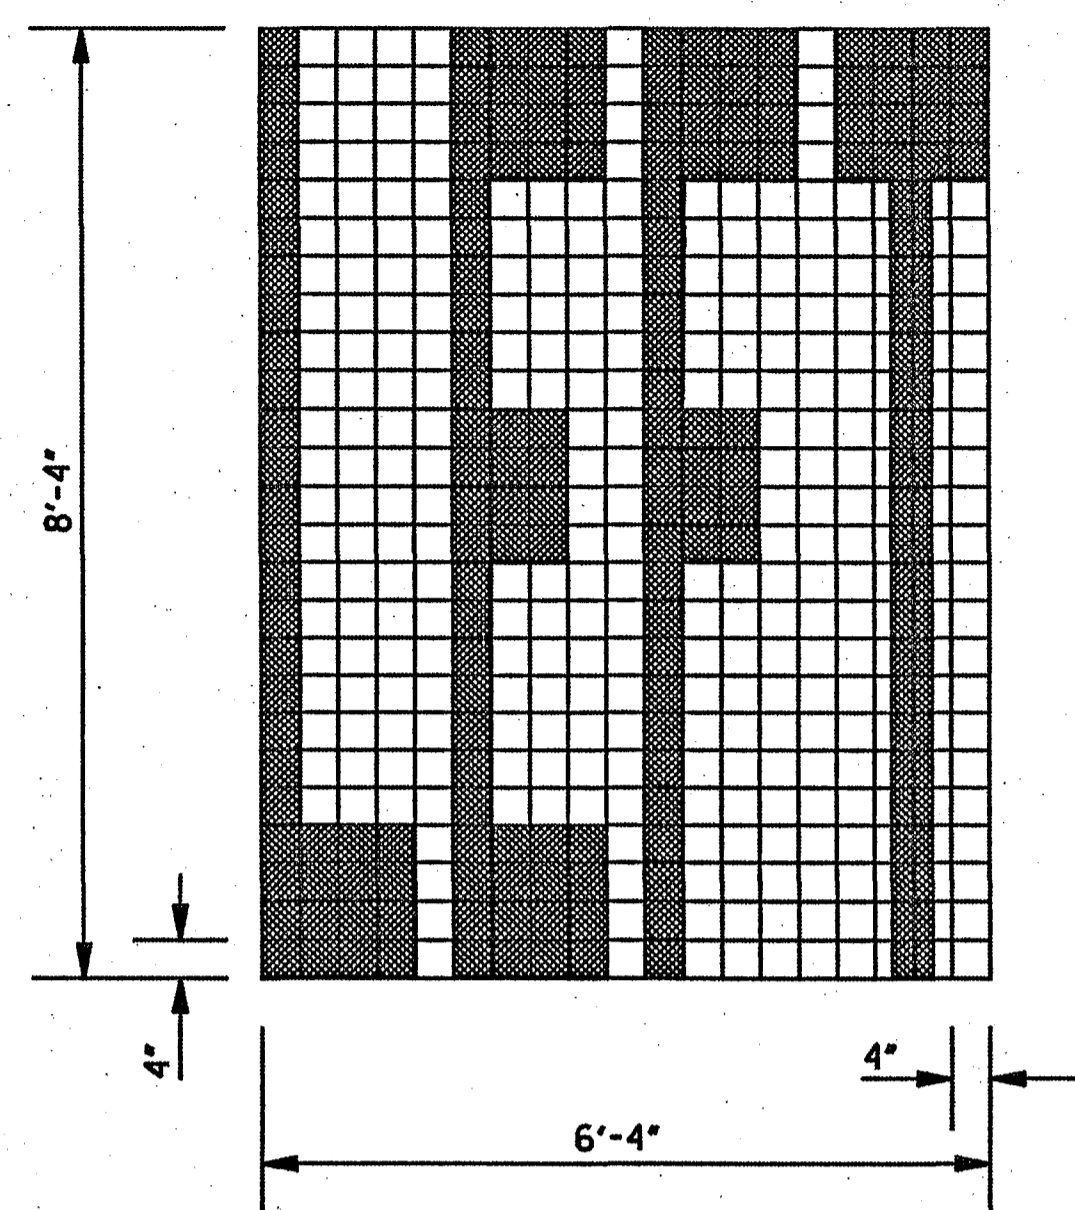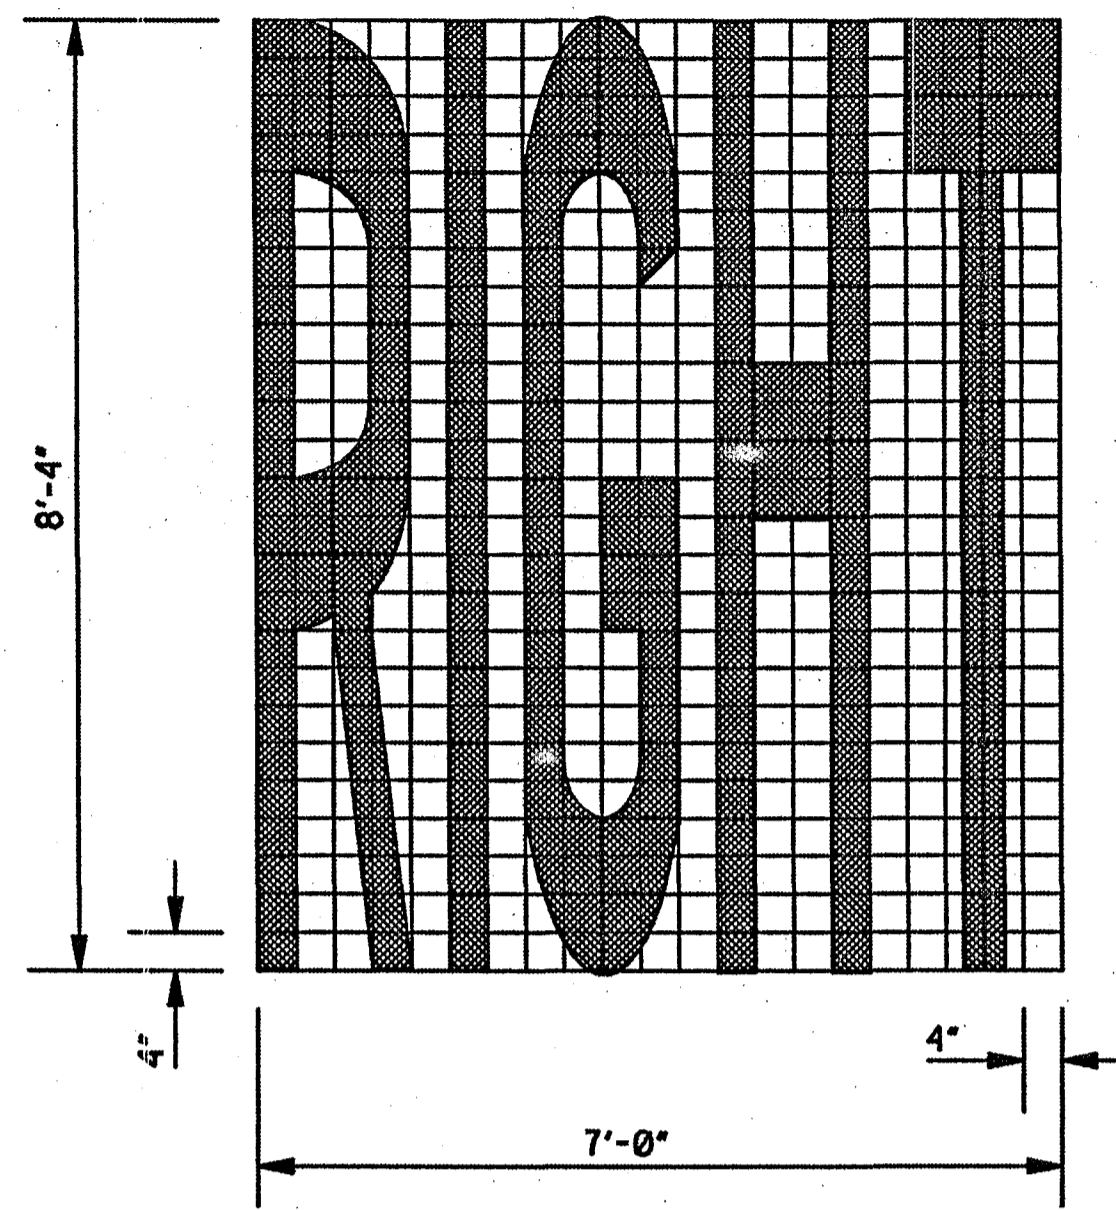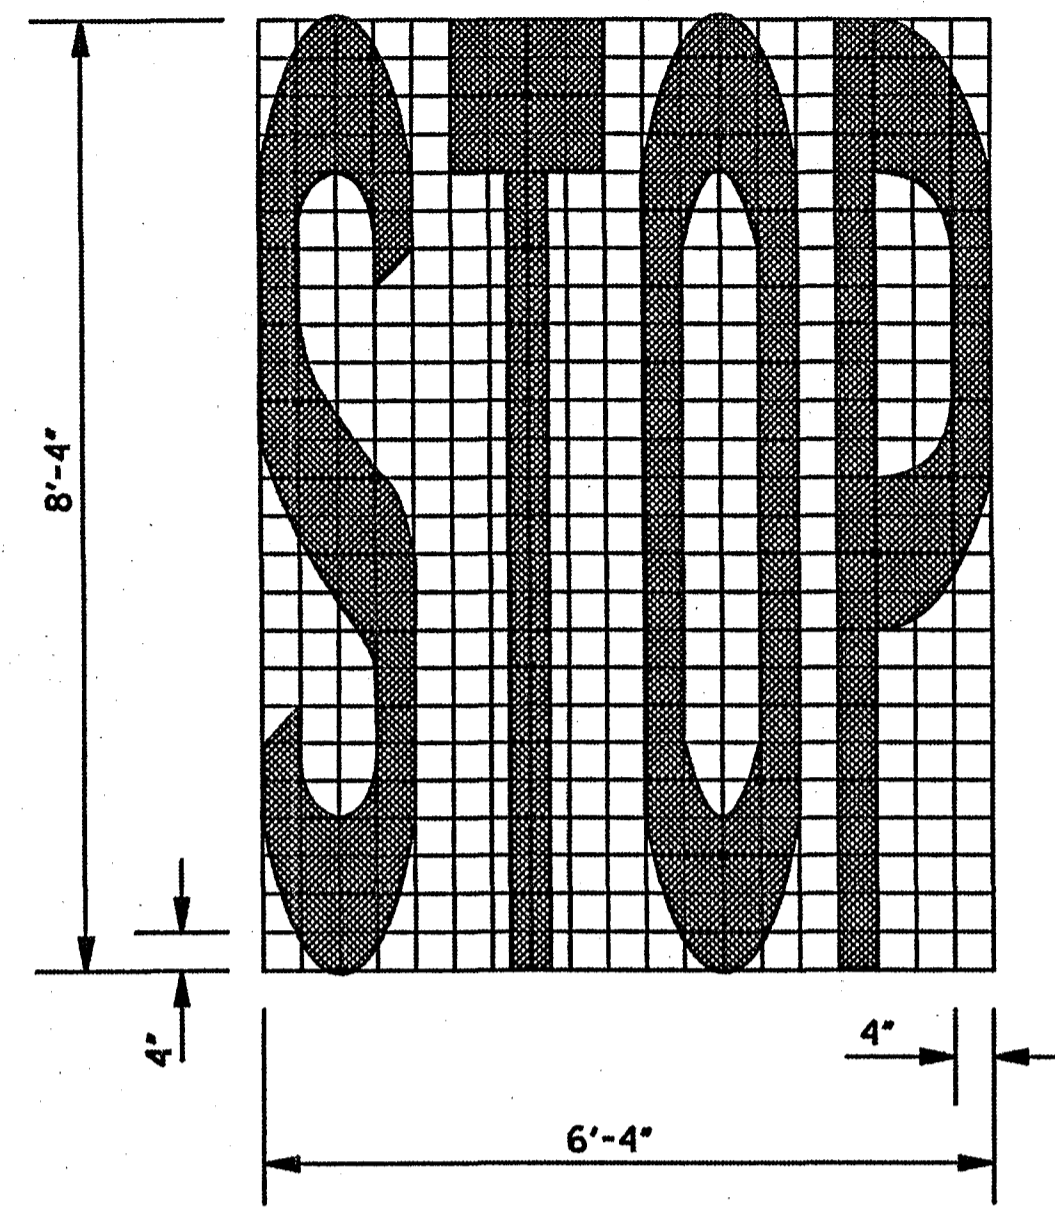


GENERAL NOTES:

- UNLESS OTHERWISE SHOWN ON THE PLANS, ALL PAVEMENT MARKING LEGENDS SHALL BE APPLIED USING HIGH PERFORMANCE MATERIALS.
- TWO HORIZONTAL GAPS (CAUSED BY TEMPLATE CONNECTORS) OF 1/2" OR LESS AND EXTENDING THE FULL WIDTH ARE PERMITTED IN EACH LETTER.
- FOR OTHER DETAILS, SEE THE MANUAL ON UNIFORM TRAFFIC CONTROL DEVICES.
- PAY QUANTITIES FOR PAVEMENT MARKING LEGENDS ARE AS FOLLOWS:



LEGEND	AREA (ft <sup>2</sup> )
STOP	24.6
RIGHT	28.6
LEFT	19.5
TURN	27.3
LANE	22.7
AHEAD	32.3
YIELD	26.8
EXIT	18.5
SIGNAL	32.5
SCHOOL	35.5

MISSISSIPPI DEPARTMENT OF TRANSPORTATION ROADWAY DESIGN DIVISION STANDARD PLAN	
<b>PAVEMENT MARKING LEGEND DETAILS</b>	
DATE	ISSUE DATE: OCTOBER 1, 1998
BY	
REVISION	




WORKING NUMBER  
PM-5  
SHEET NUMBER  
124




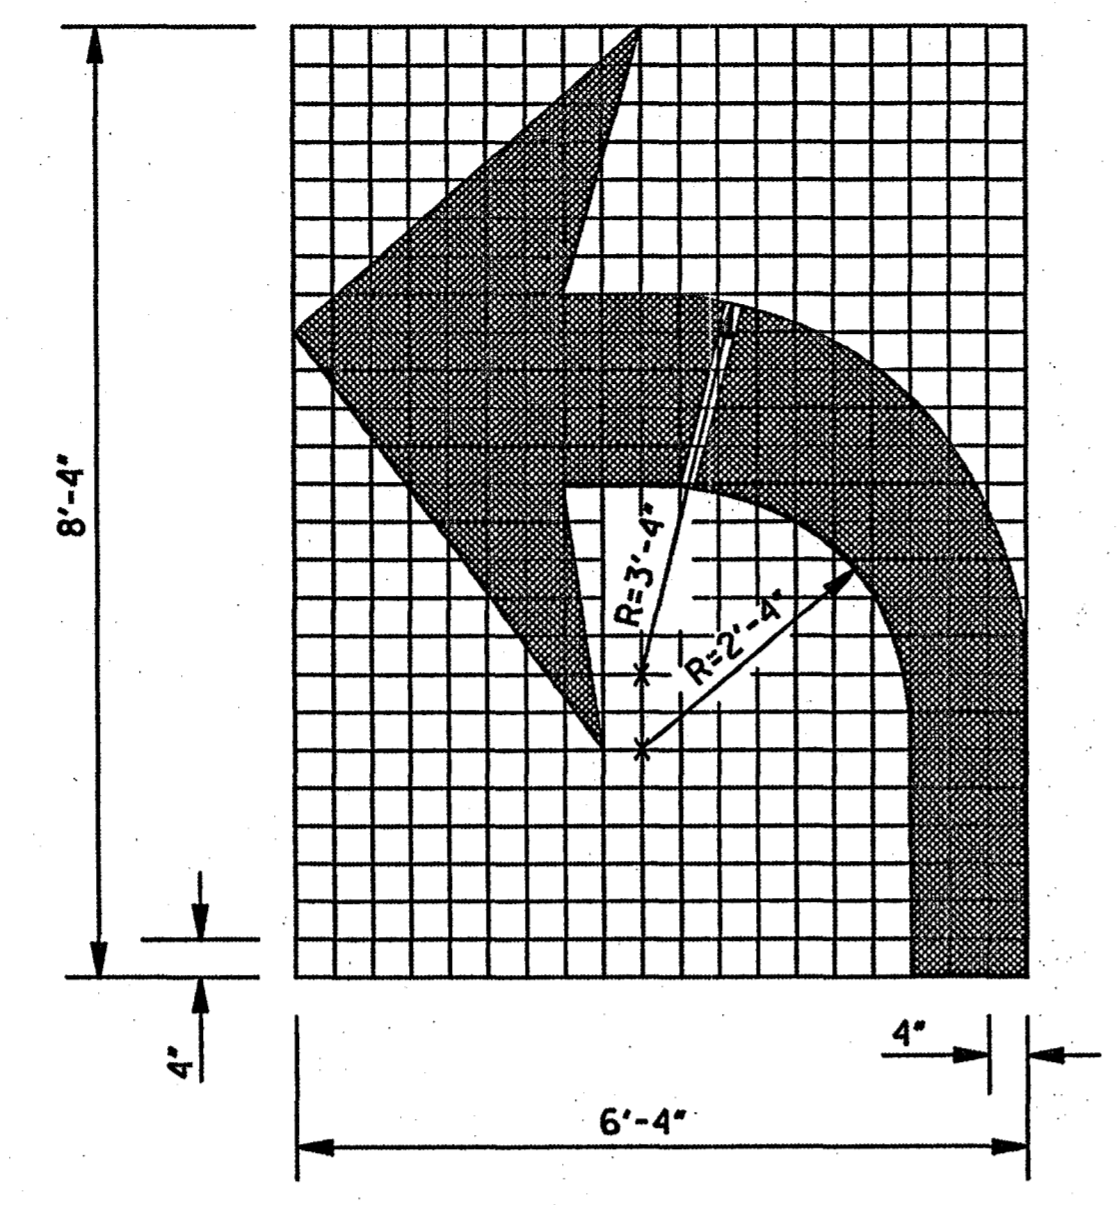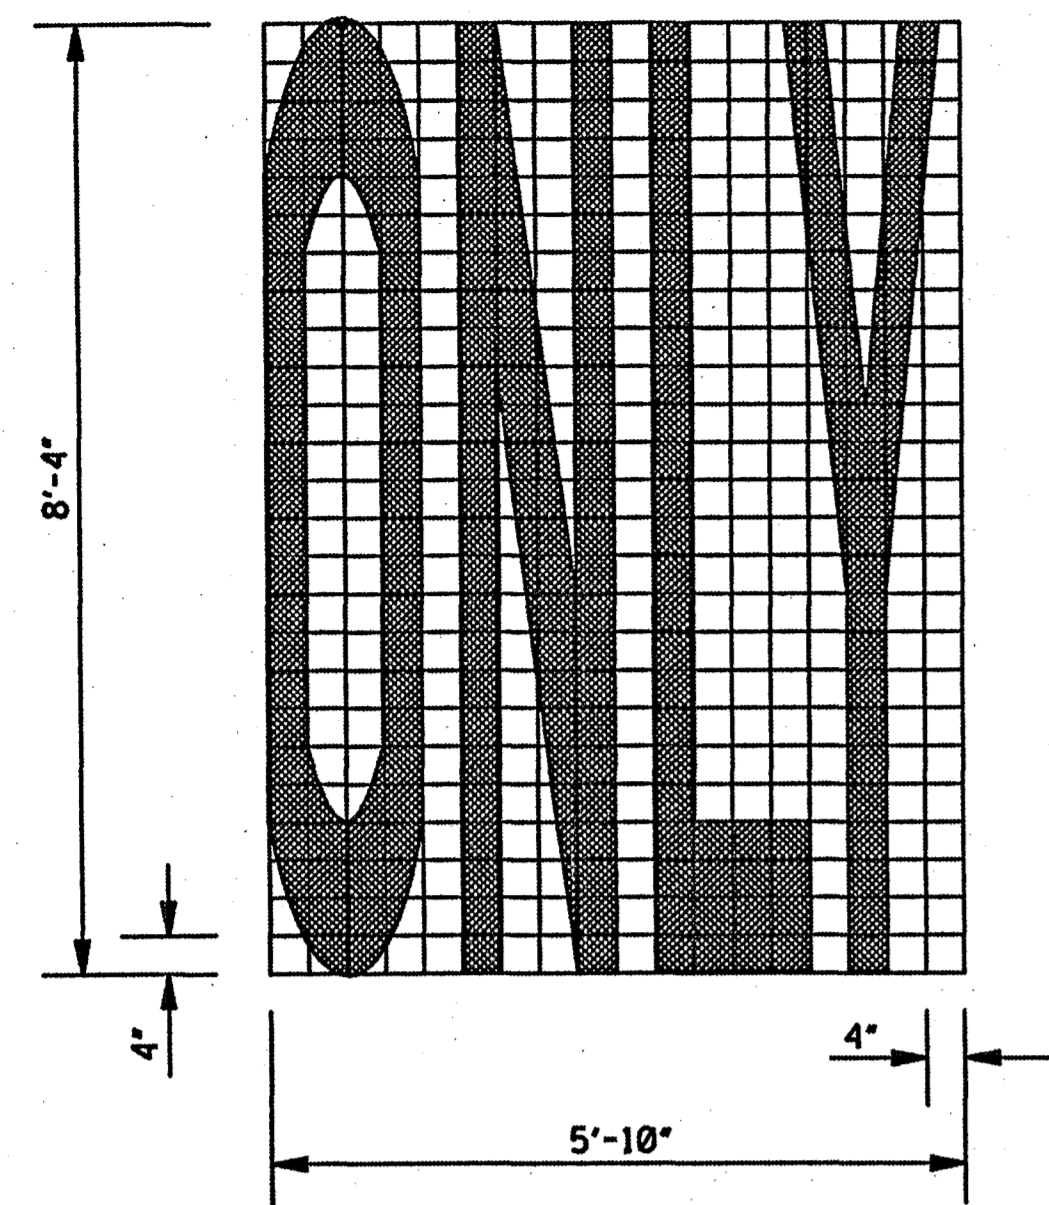

TURN ARROW

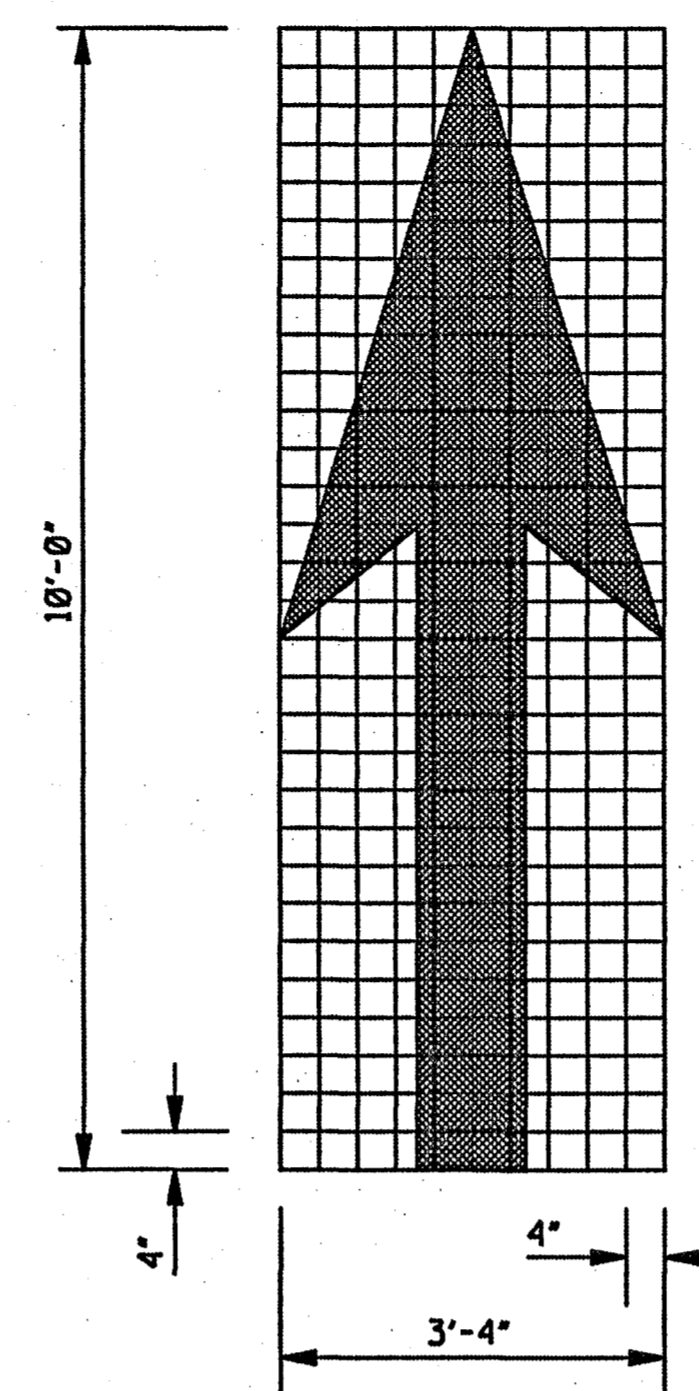

THRU ARROW

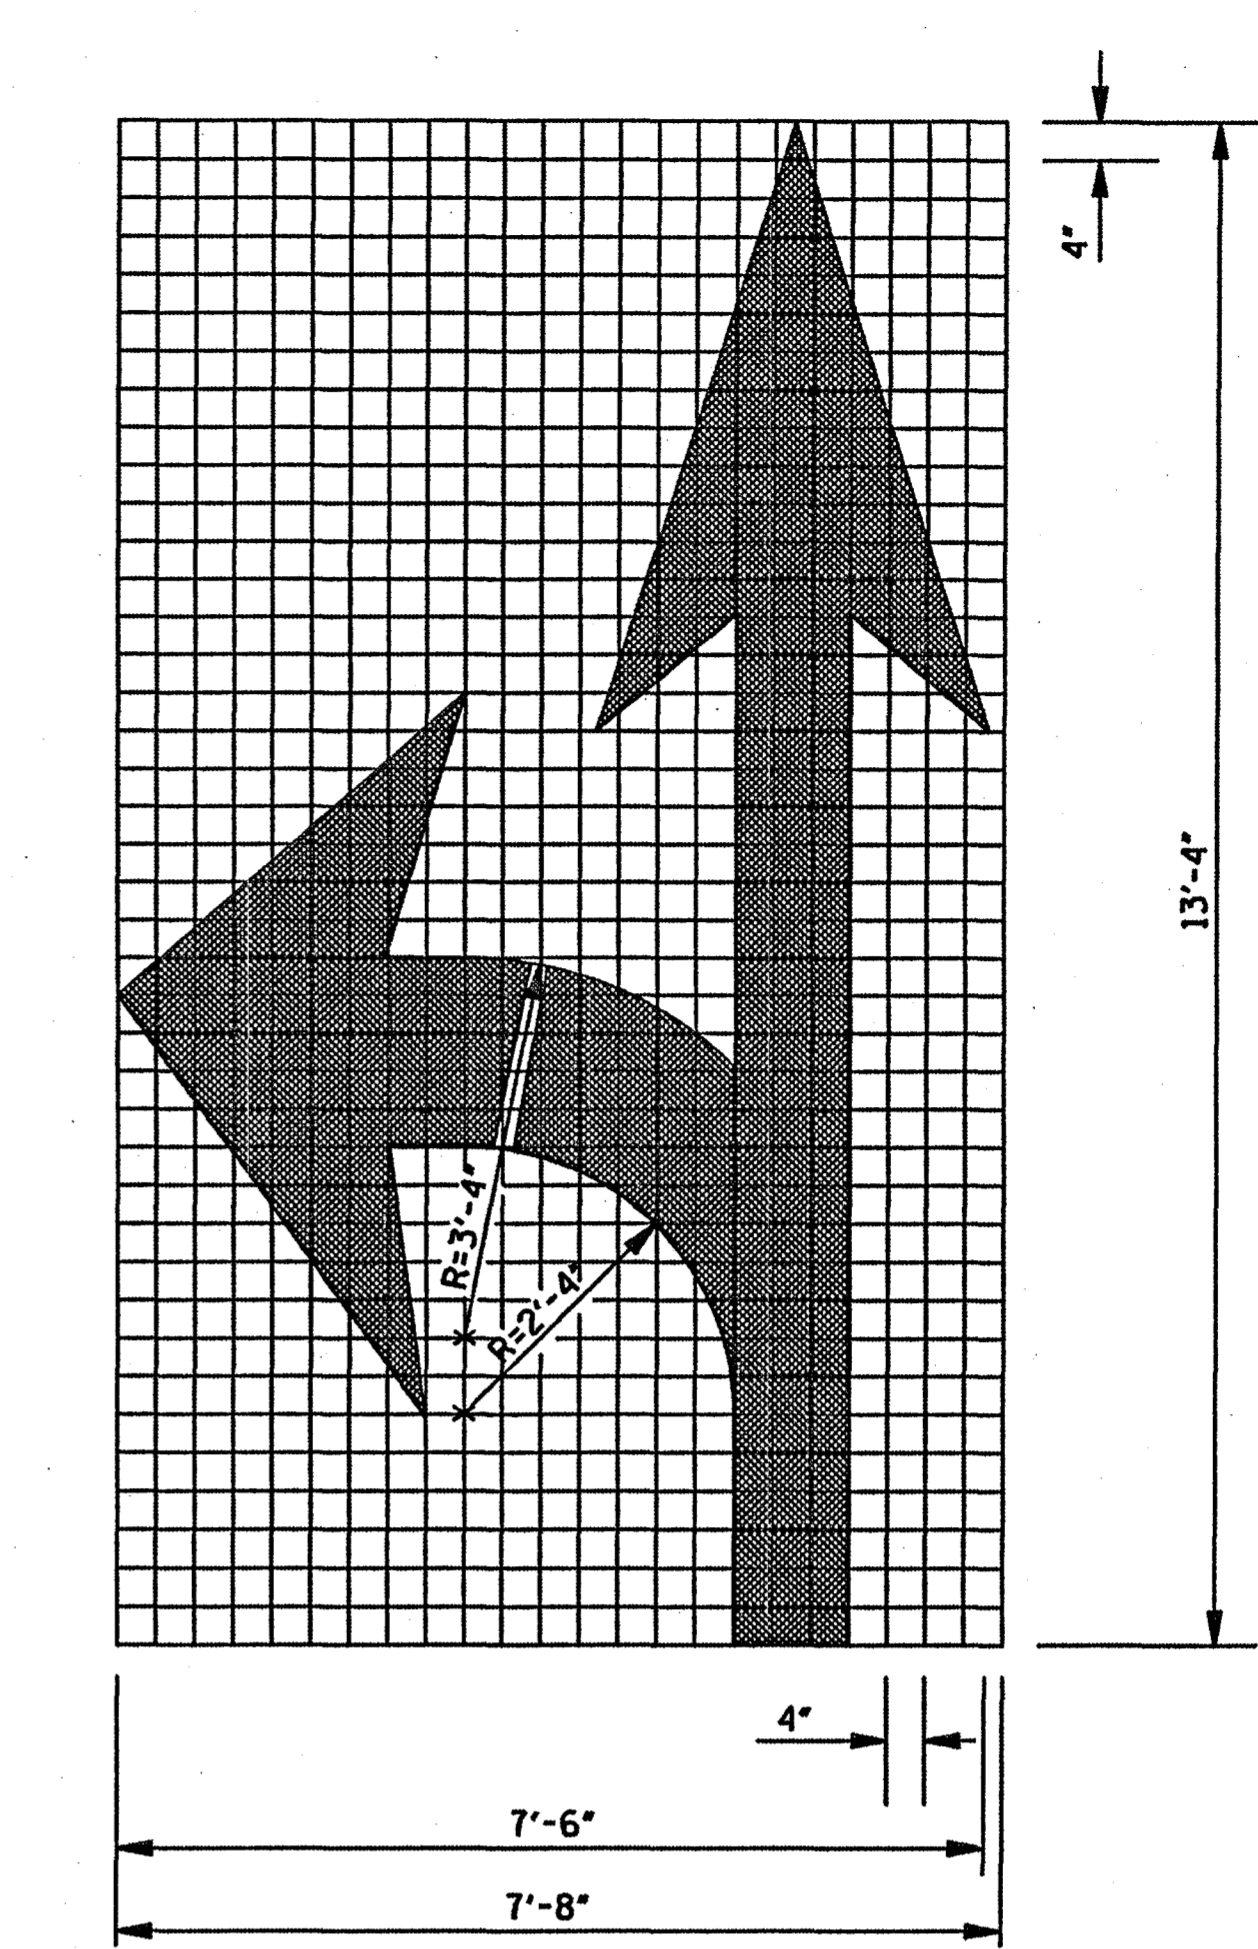


COMBINATION ARROW

GENERAL NOTES:

1. UNLESS OTHERWISE SHOWN ON THE PLANS, ALL PAVEMENT MARKING LEGENDS, INCLUDING TURN ARROWS, SHALL BE APPLIED USING HIGH PERFORMANCE MATERIALS.
2. TWO HORIZONTAL GAPS (CAUSED BY TEMPLATE CONNECTORS) OF 1/2" OR LESS AND EXTENDING THE FULL WIDTH ARE PERMITTED IN EACH LETTER.
3. FOR OTHER DETAILS, SEE THE MANUAL ON UNIFORM TRAFFIC CONTROL DEVICES.
4. PAY QUANTITIES FOR PAVEMENT MARKING LEGENDS ARE AS FOLLOWS:


PAY QUANTITIES	
LEGEND/SYMBOL	AREA (ft <sup>2</sup> )
ONLY	22.0
TURN ARROW	16.4
THRU ARROW	12.3
COMB. ARROW	27.5
1-WAY ARROW	24.3

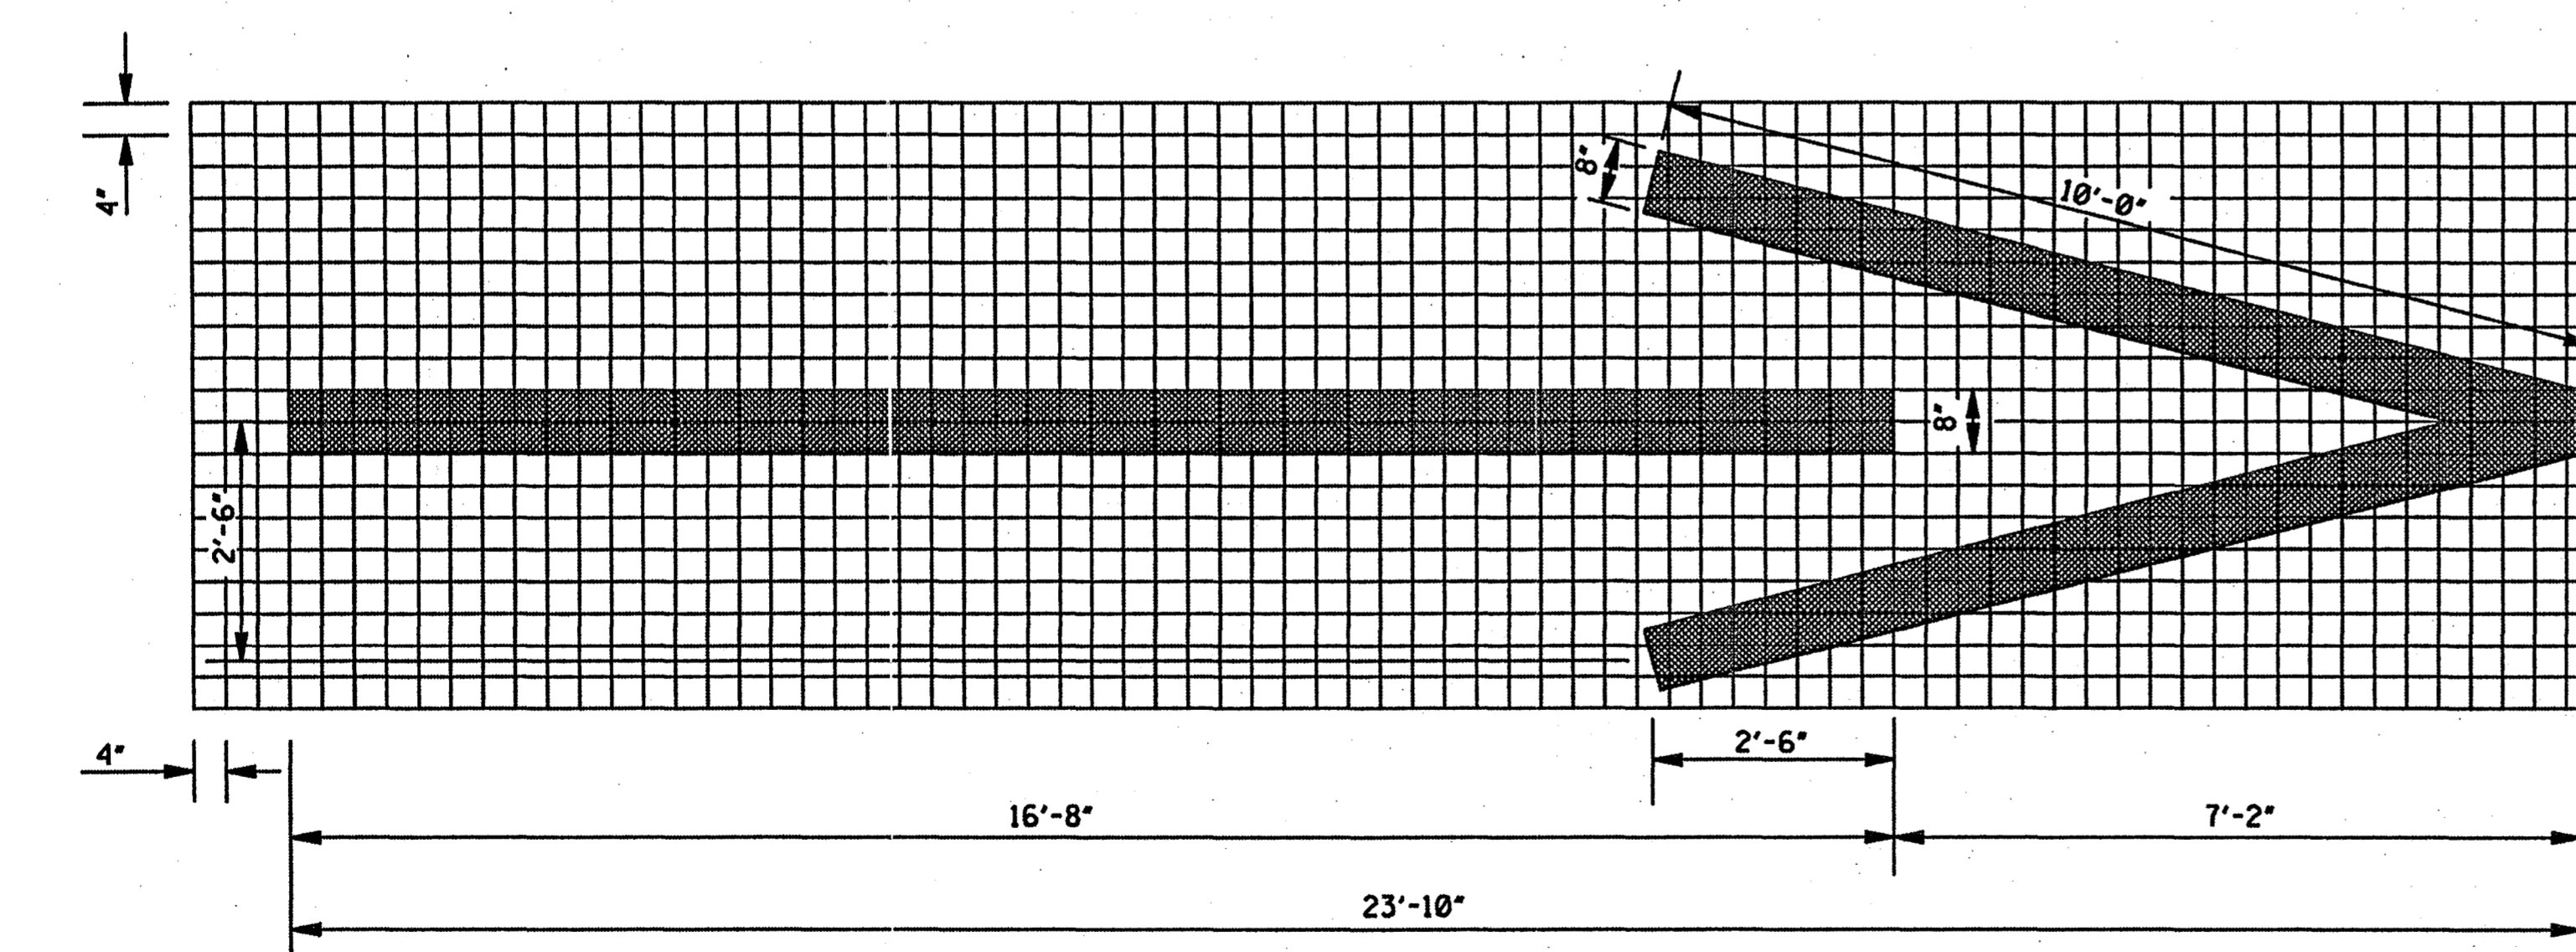

1-WAY ARROW







BY	MISSISSIPPI DEPARTMENT OF TRANSPORTATION ROADWAY DESIGN DIVISION STANDARD PLAN
REVISION	
DATE	ISSUE DATE: OCTOBER 1, 1998

**PAVEMENT MARKING  
LEGEND DETAILS**

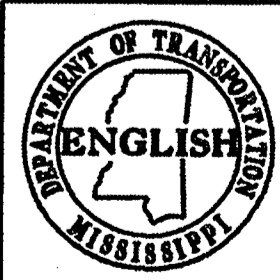

WORKING NUMBER  
PM-6

SHEET NUMBER  
125

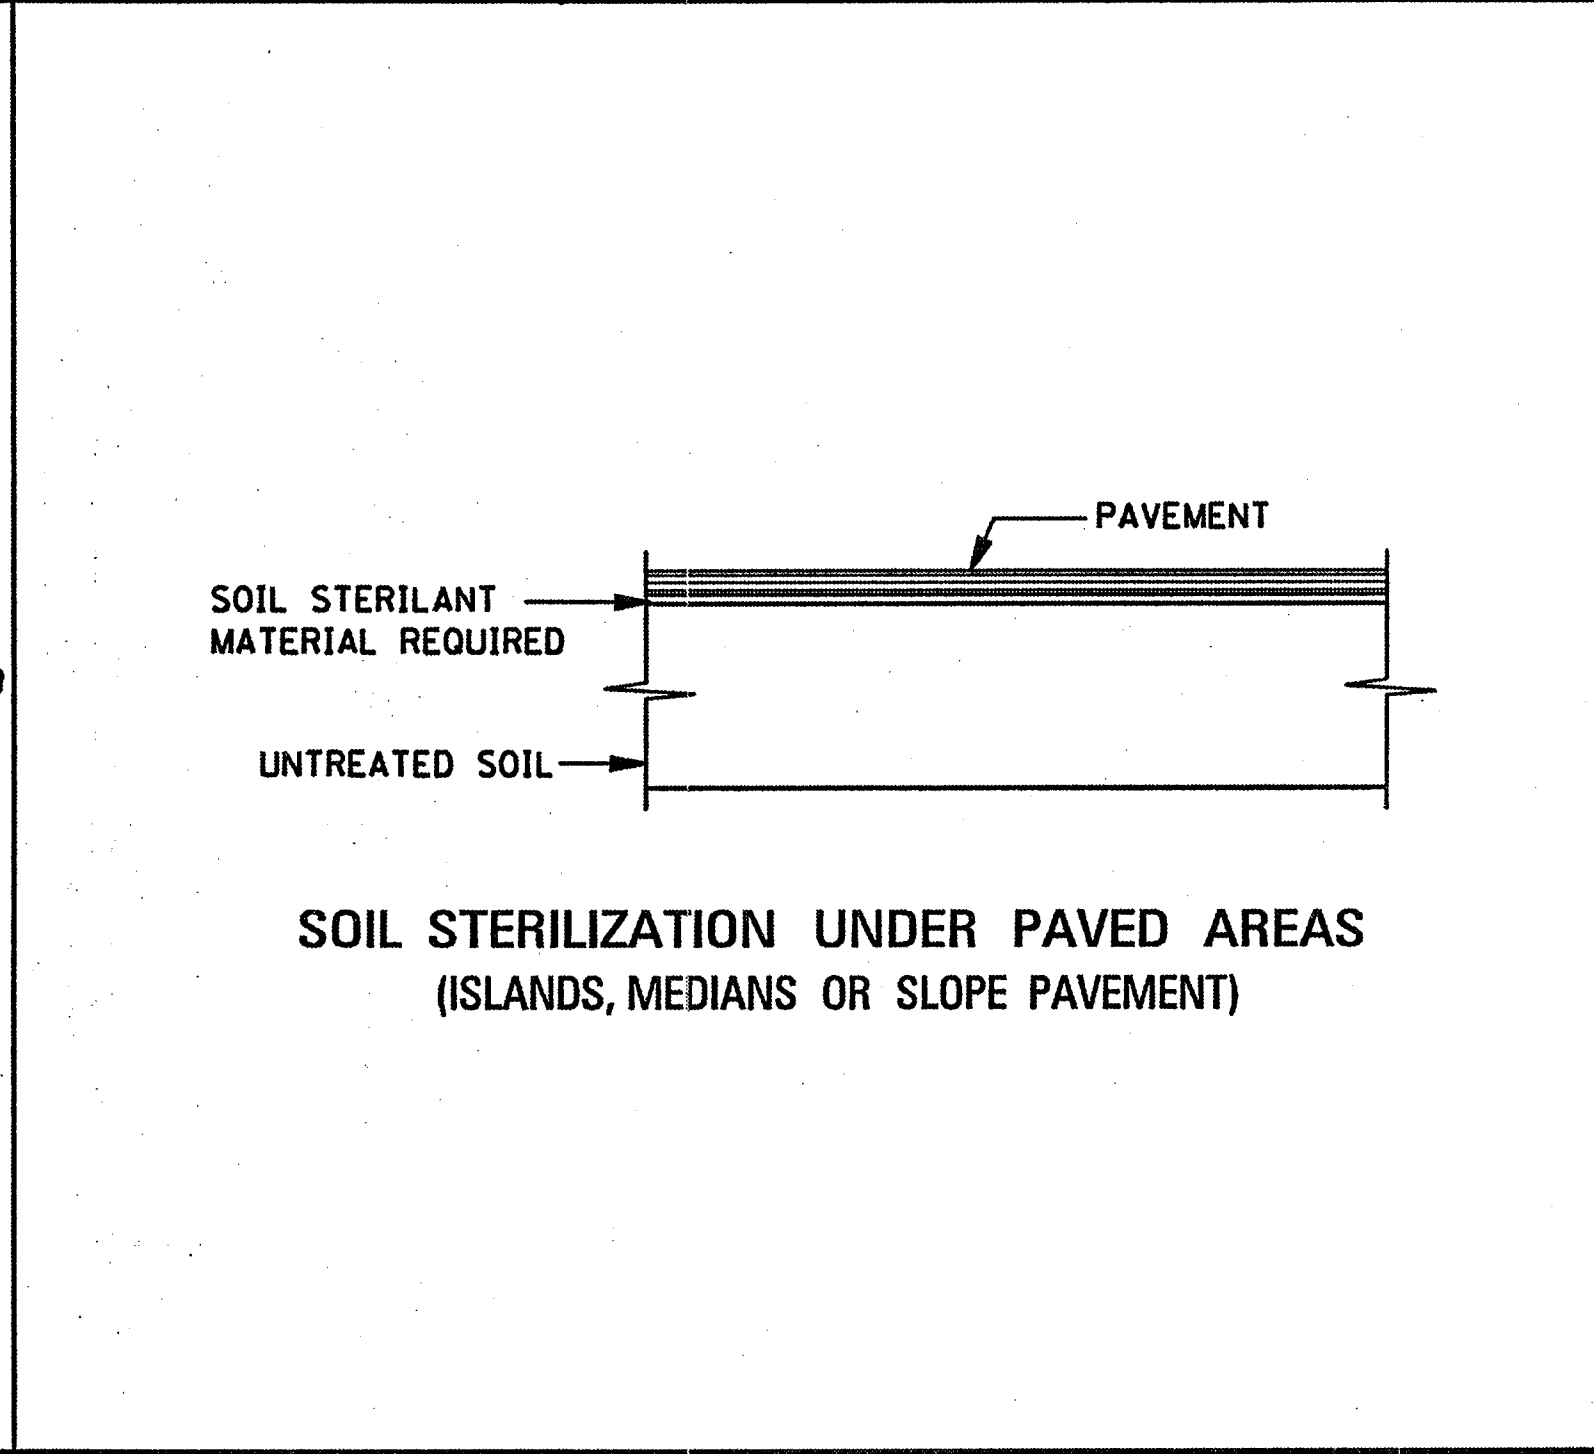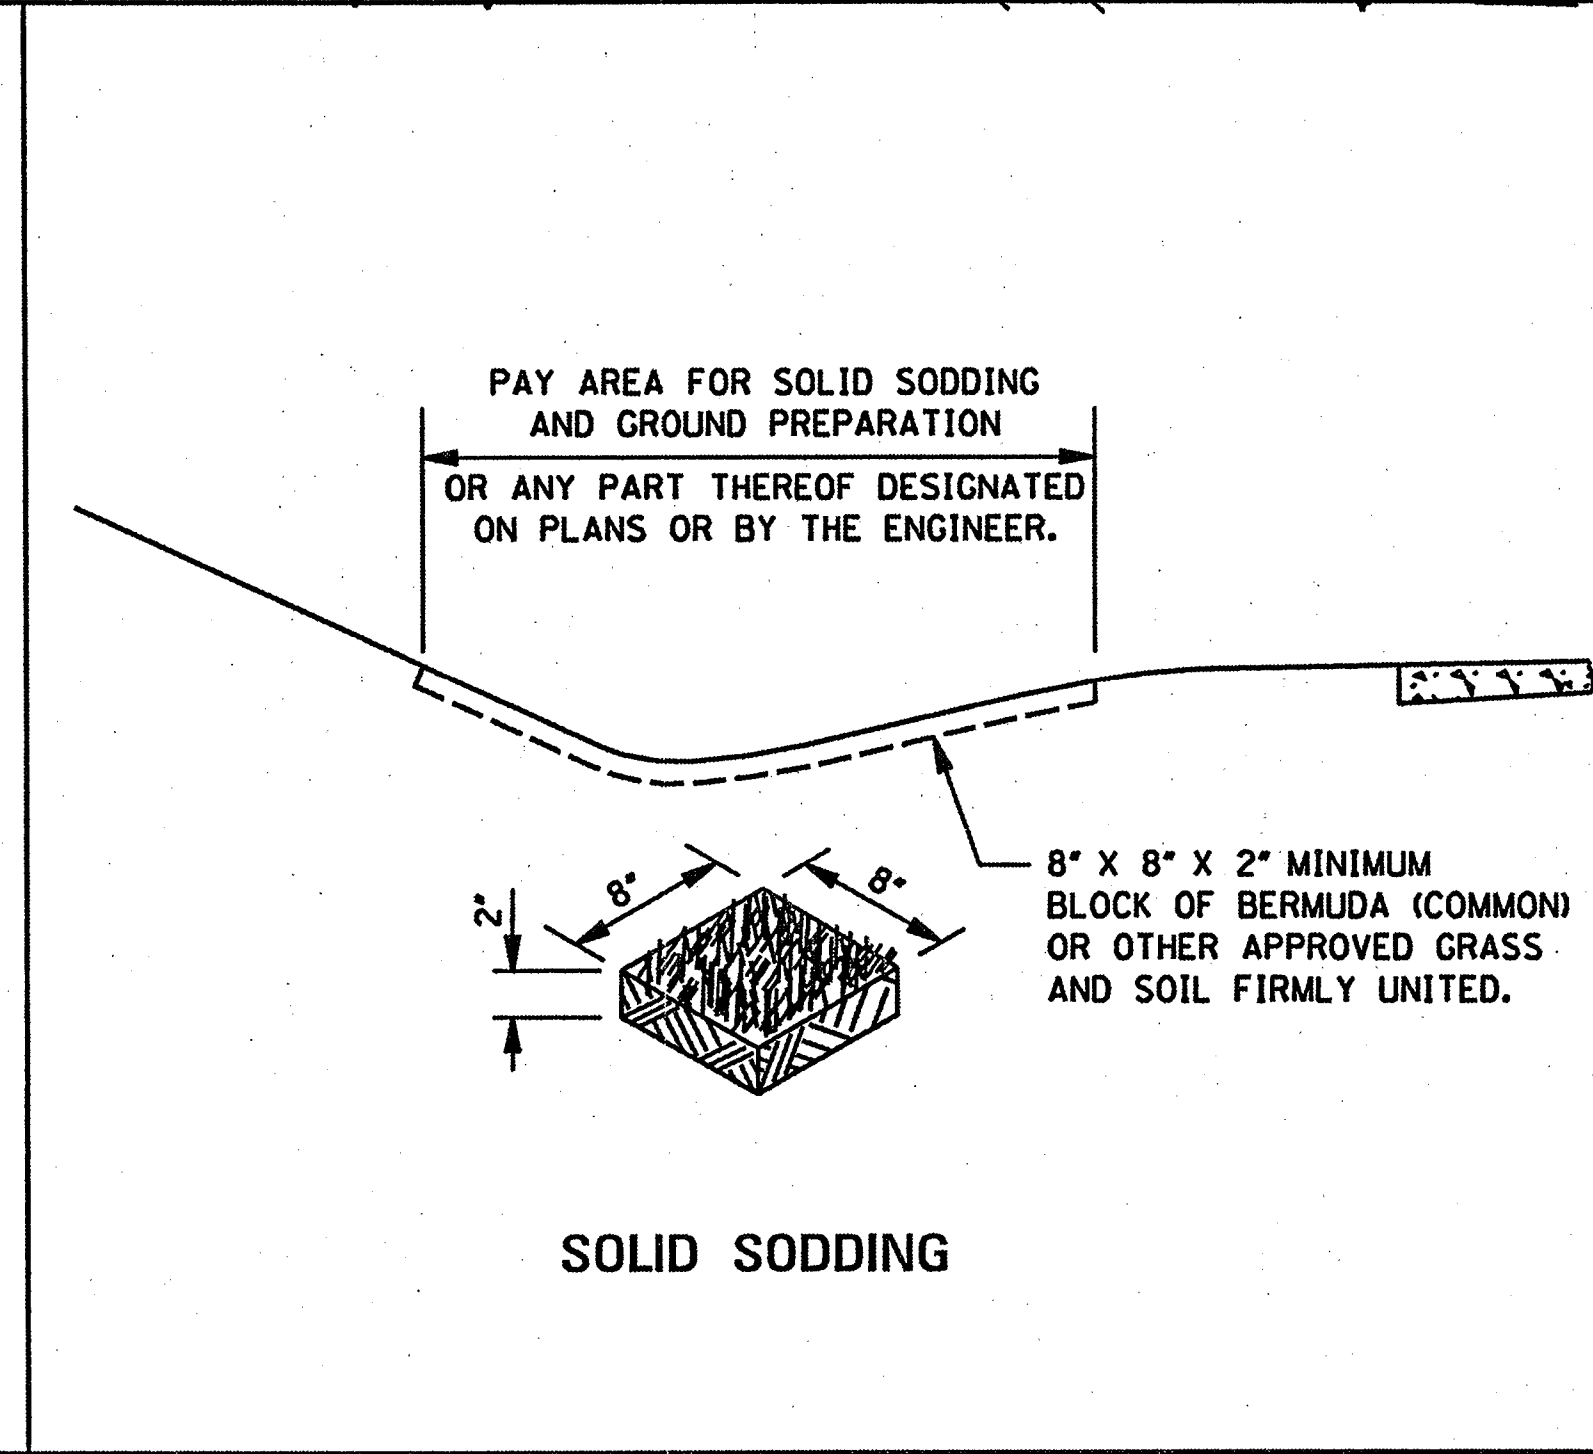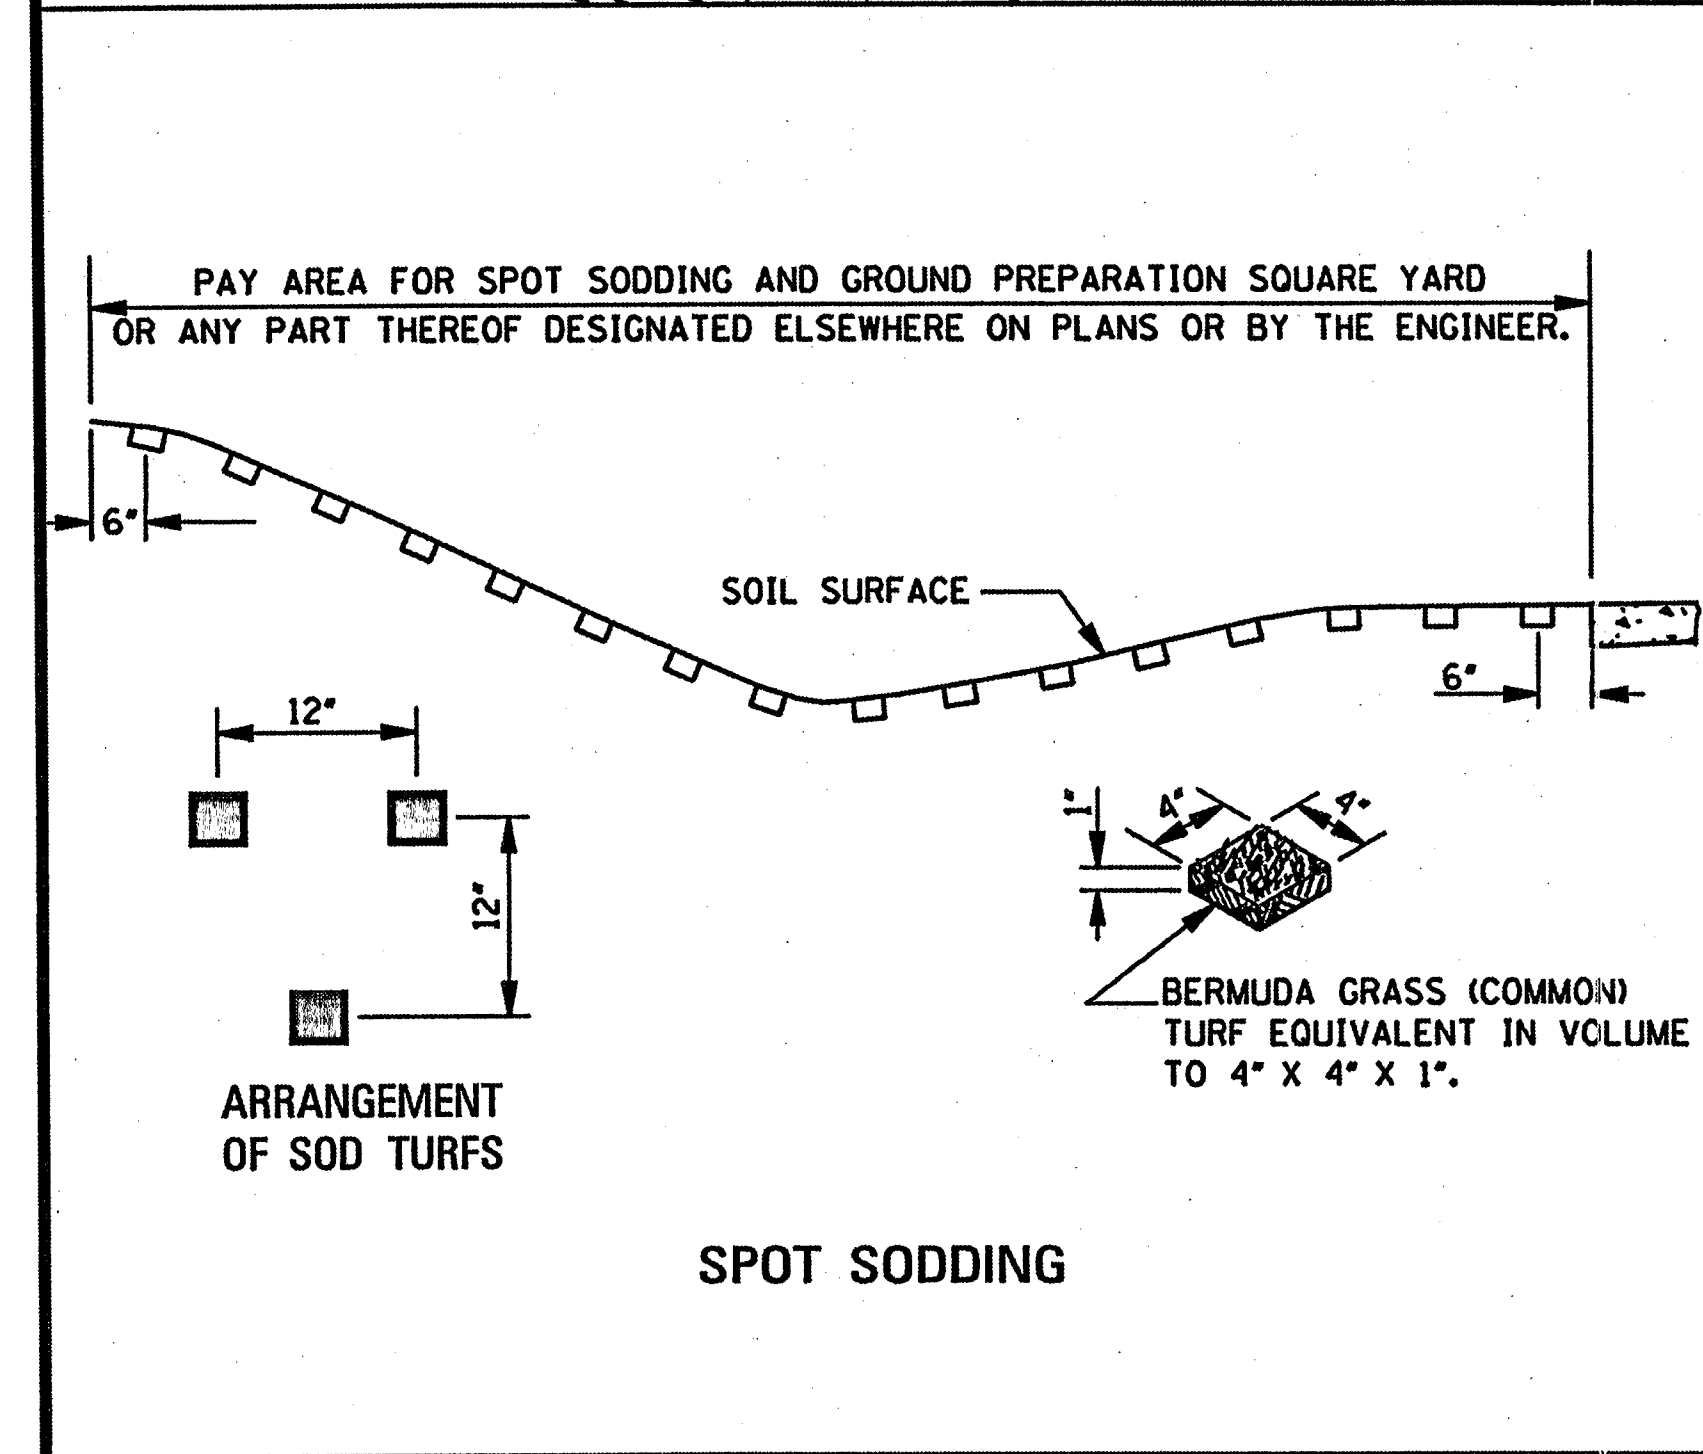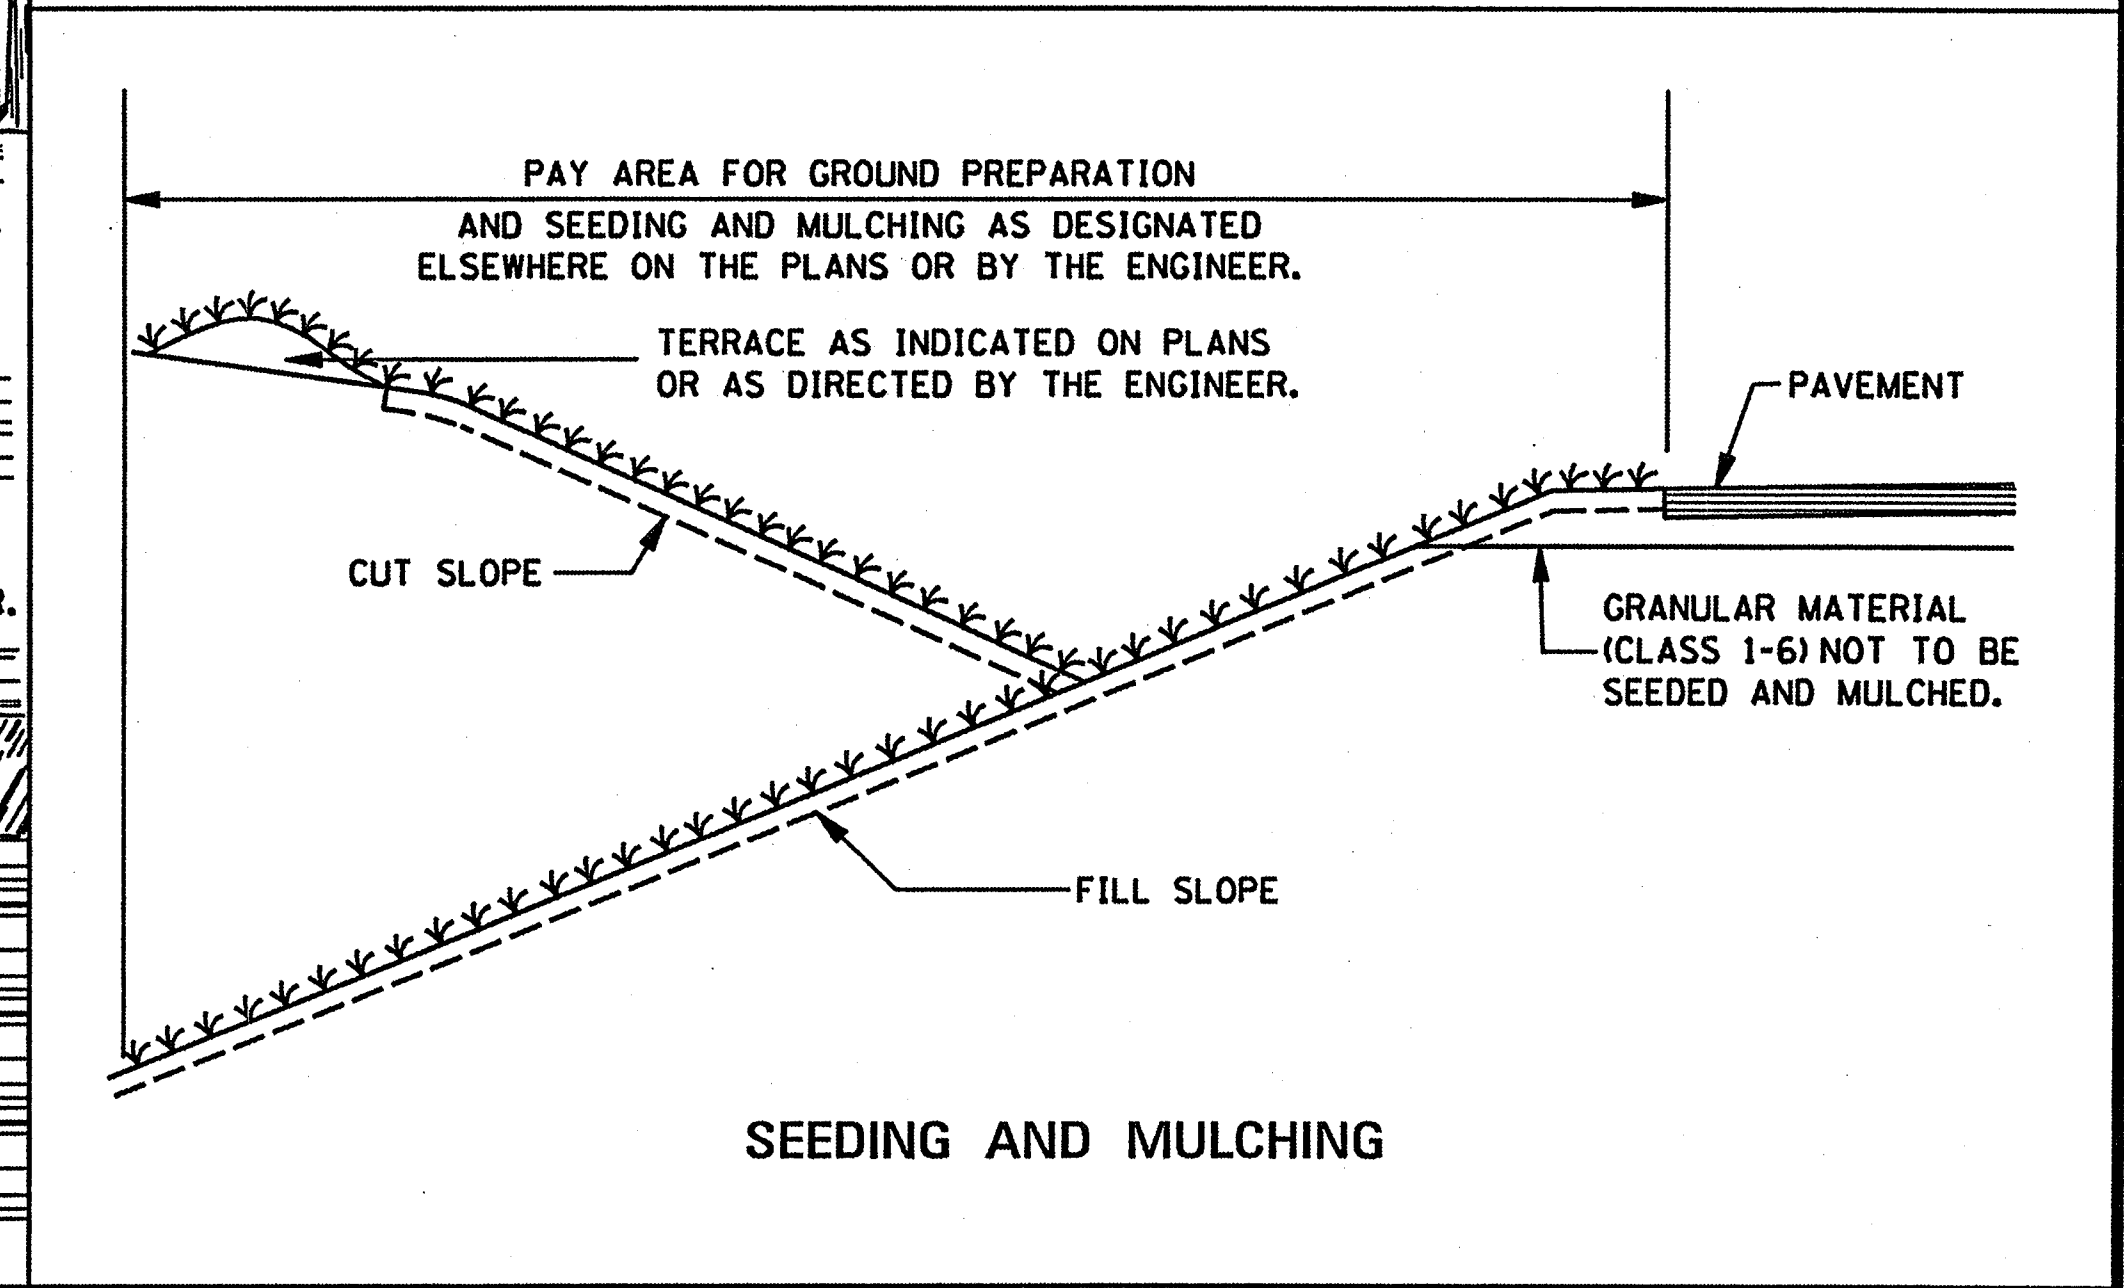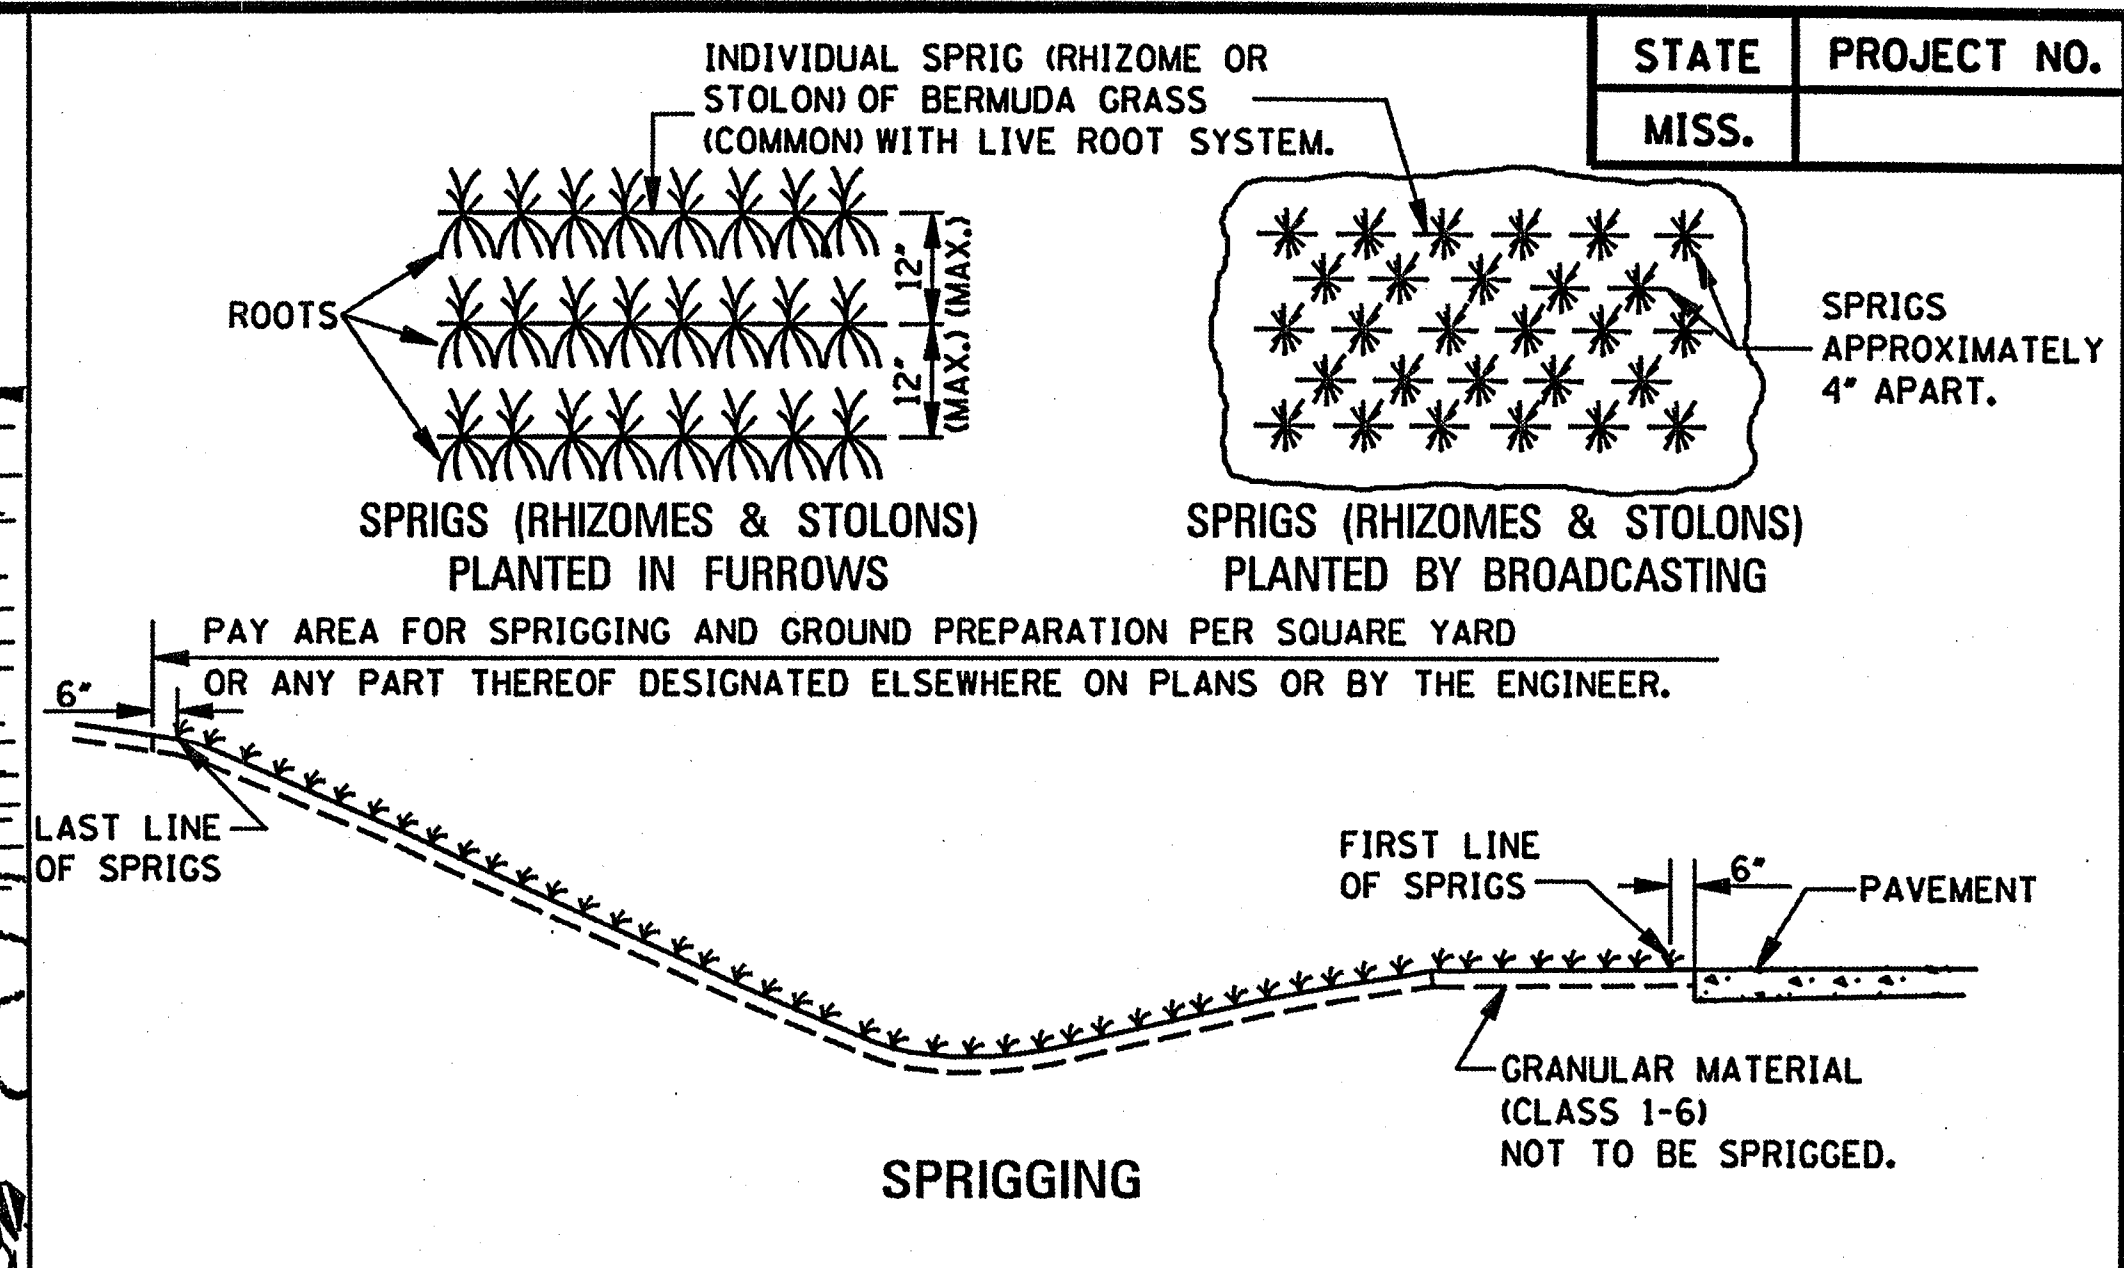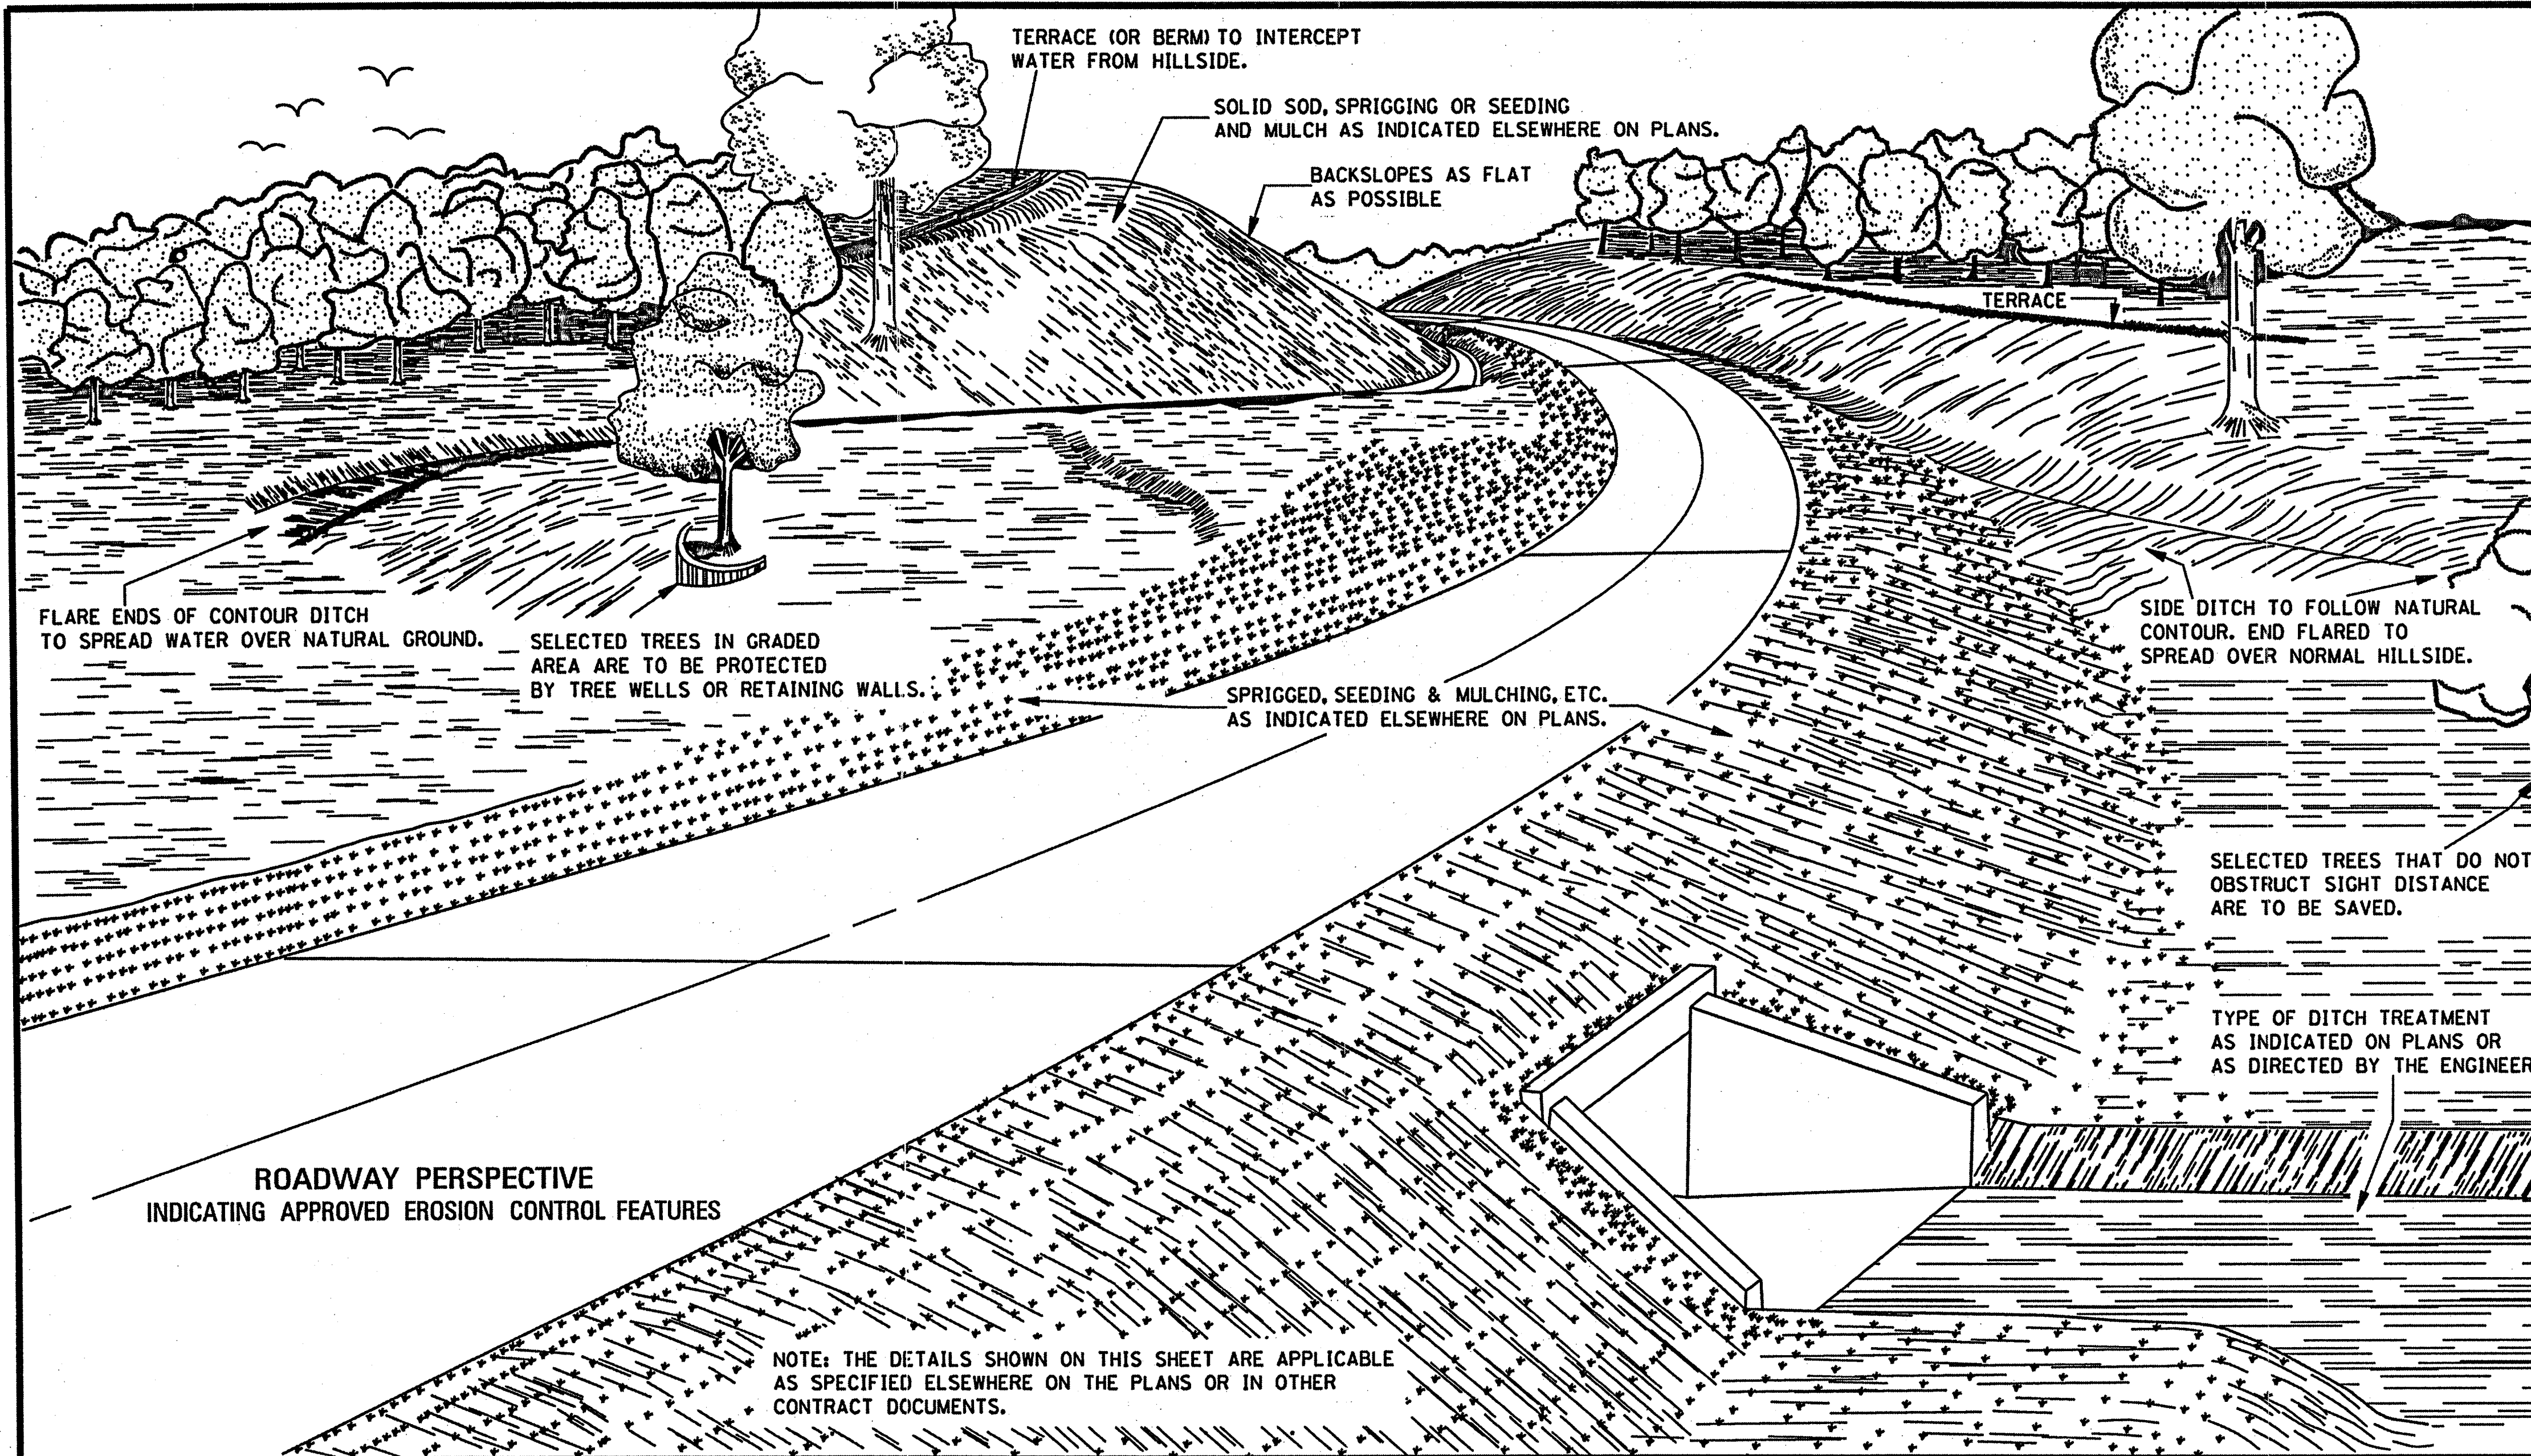

GENERAL NOTE:


1. LONGITUDINAL AND TRANSVERSE MEASUREMENTS FOR THE PAY AREA SHALL BE TAKEN ALONG THE SLOPES.

BY	MISSISSIPPI DEPARTMENT OF TRANSPORTATION ROADWAY DESIGN DIVISION STANDARD PLAN
REVISION	
DATE	ISSUE DATE: OCTOBER 1, 1998


**EROSION CONTROL**

WORKING NUMBER EC-1

SHEET NUMBER 140

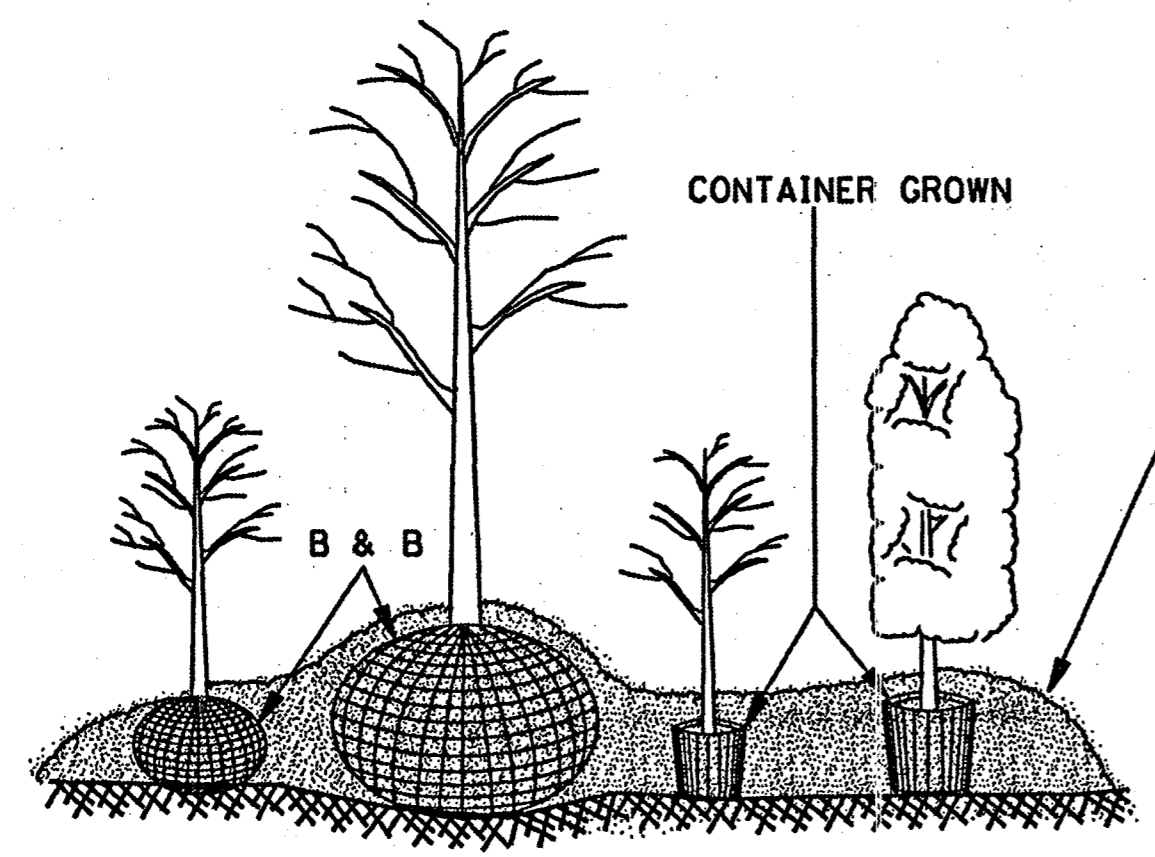


B & B AND CONTAINER GROWN PLANTS

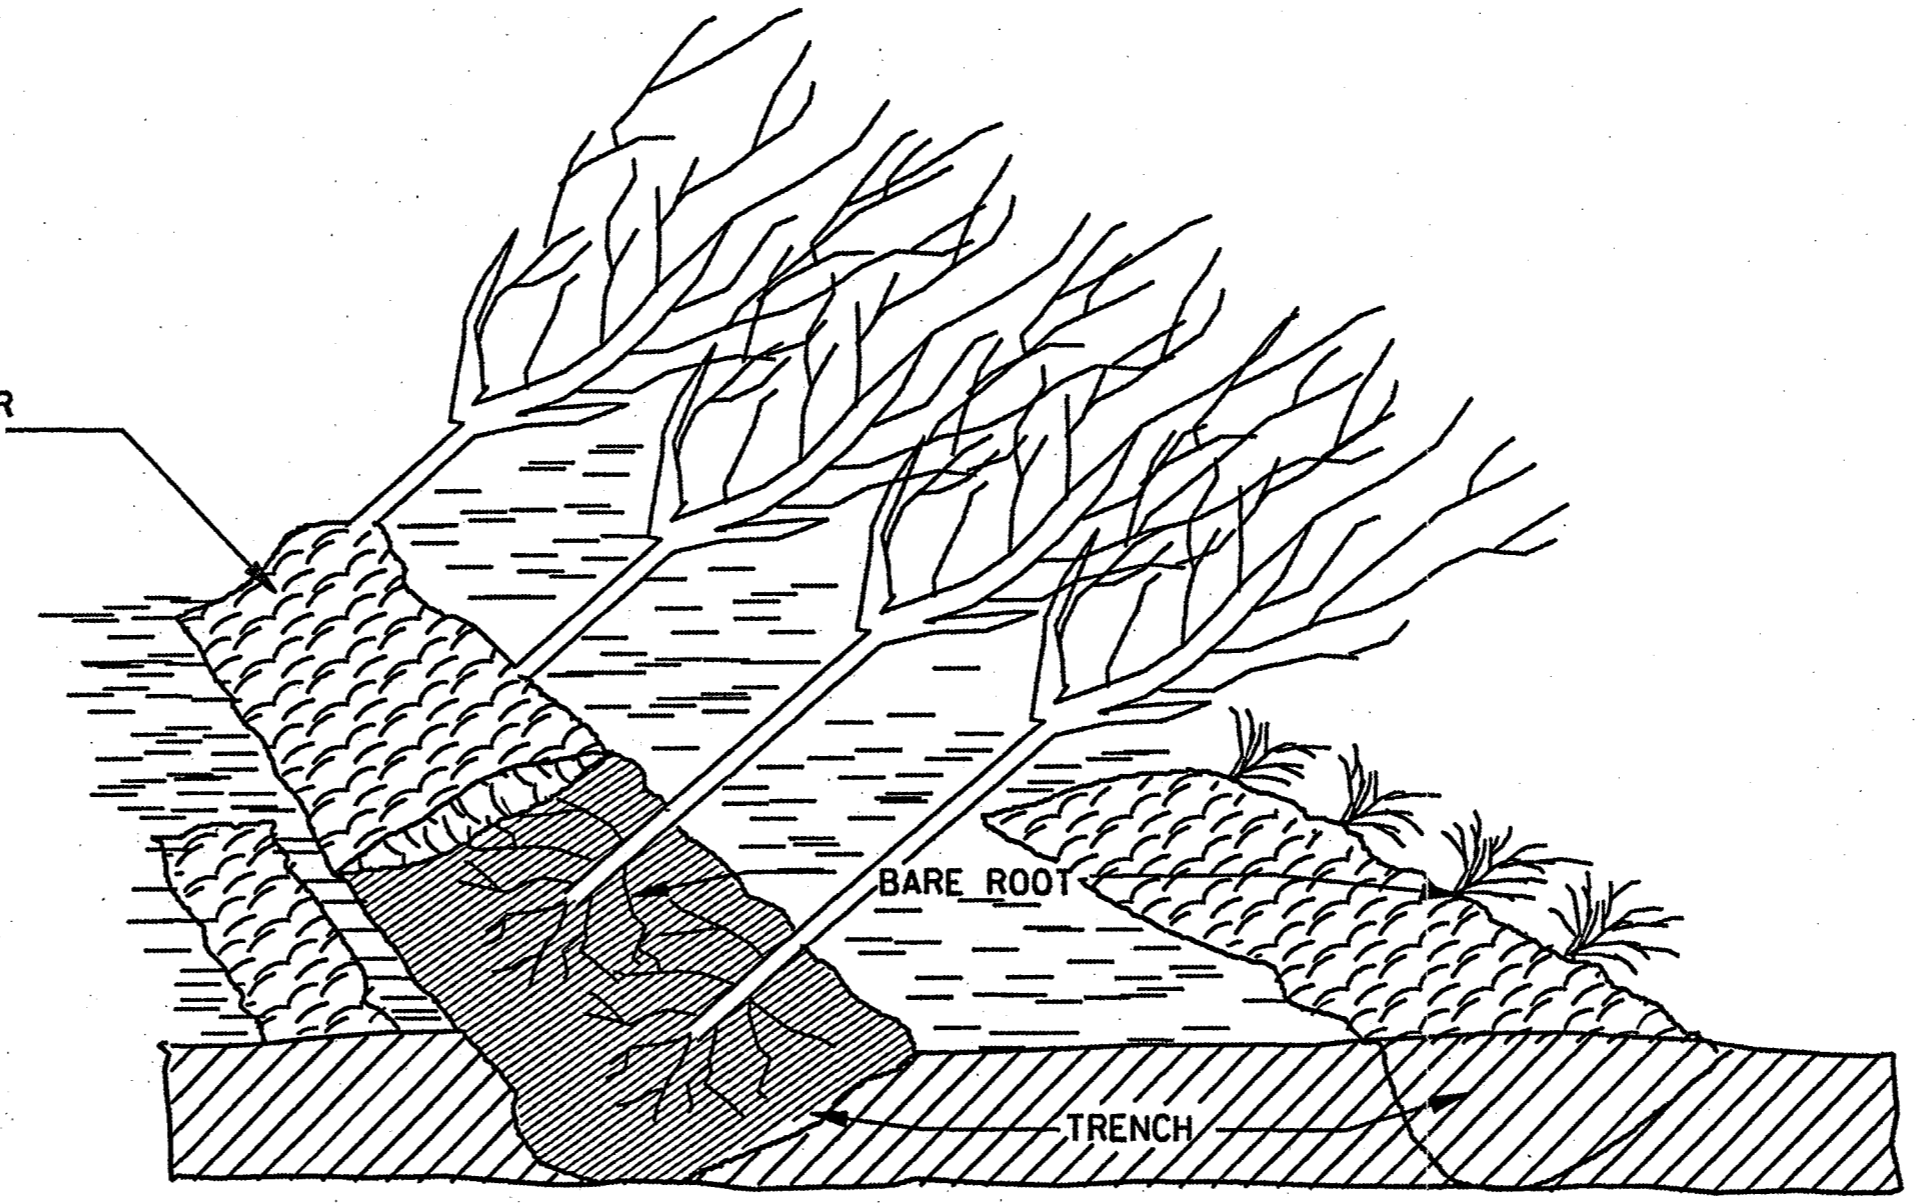


BARE ROOT PLANTS

NOTE: METHOD OF "HEELING IN" BEFORE PLANTING CONSISTS OF PLACING THE PLANTS IN A TRENCH AND COVERING THE ROOTS WITH DIRT. THIS MAY BE DONE ON TRUCK FOR EASE OF MOVEMENT. SAW DUST OR OTHER APPROVED MATERIAL MAY BE USED. ROOTS MUST BE KEPT MOIST AT ALL TIMES.

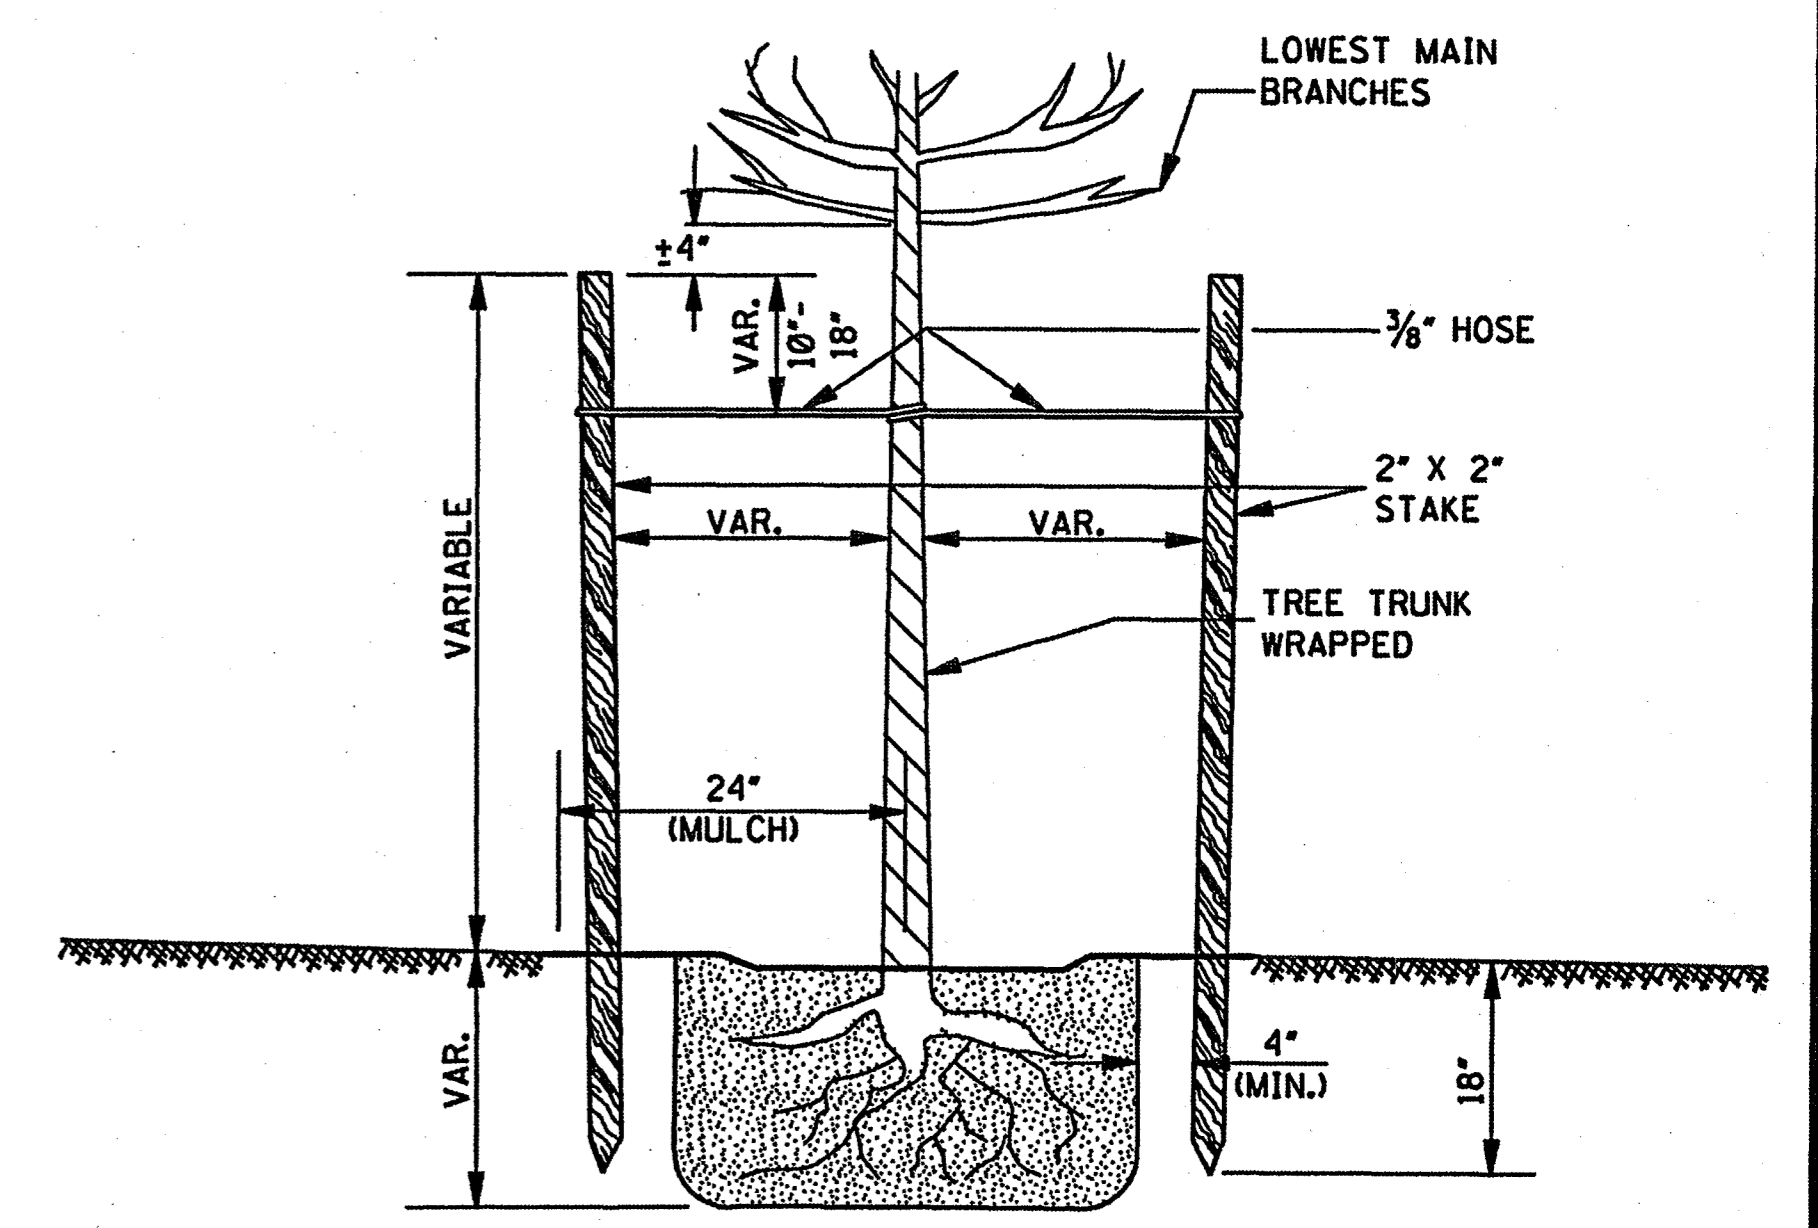

ELEVATION

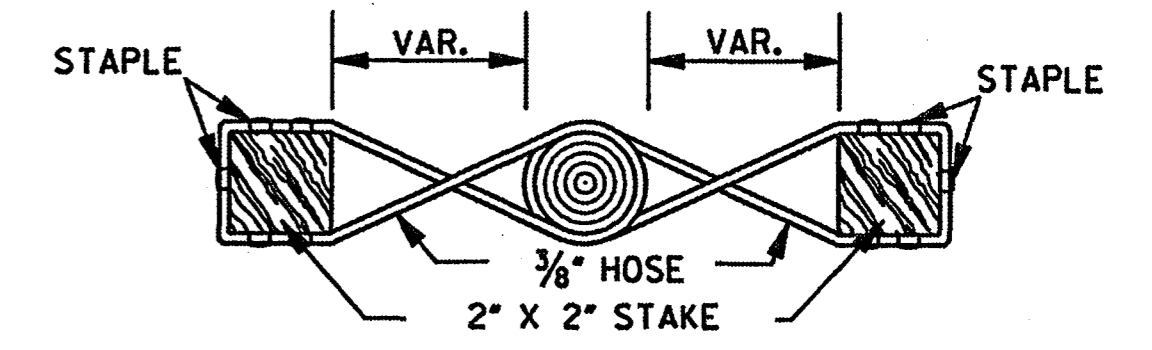


PLAN



DOUBLE VERTICAL STAKING METHOD

NOTE: ALL TREES SHALL BE STAKED OR GUYED. THE TRUNK OF ALL SMOOTH BARKED TREES SHALL BE WRAPPED. LARGE SHRUBS TO BE STAKED AND WRAPPED WHEN SPECIFIED ON PLANS.


ROOT PROTECTION ("HEELING-IN") DURING STORAGE

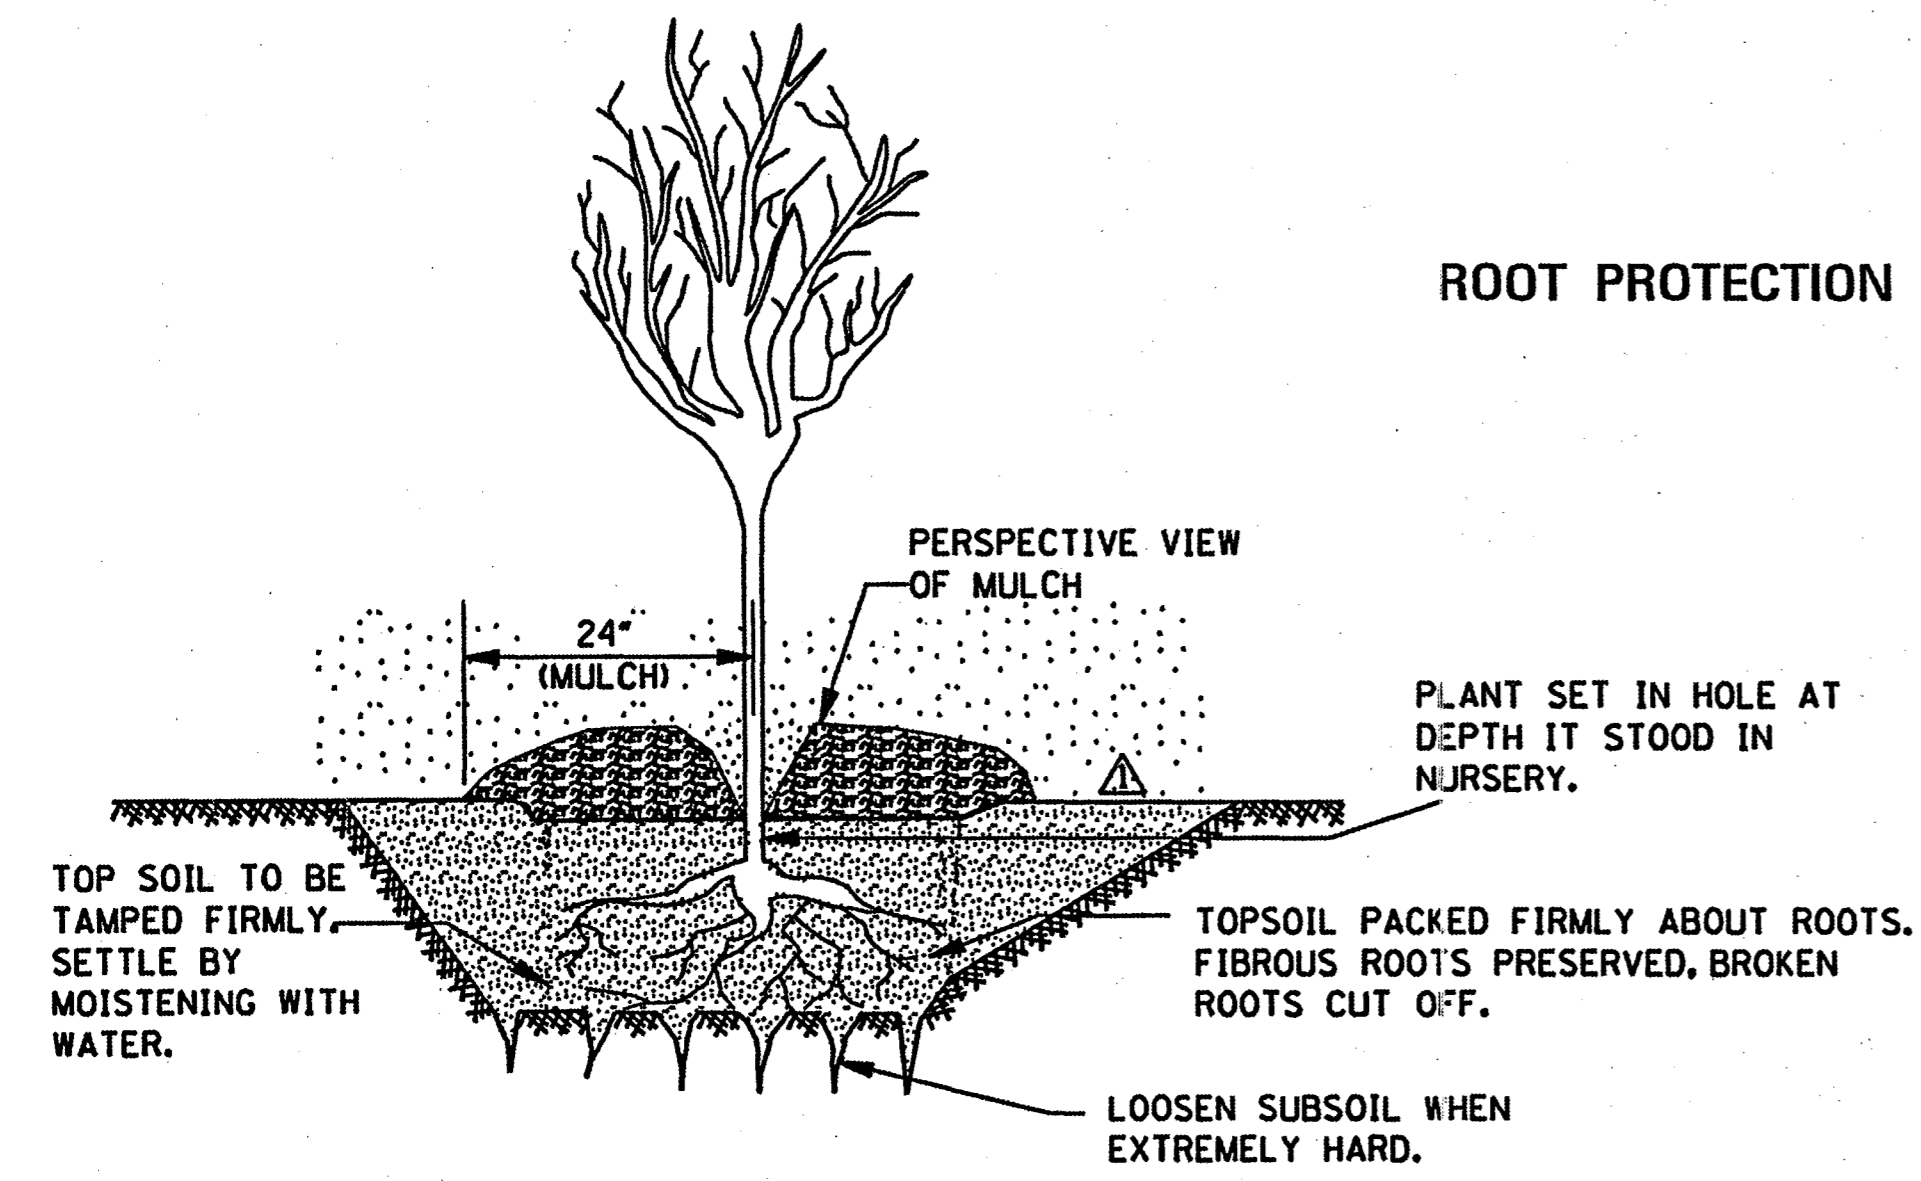


TREE AND SHRUB PLANTING (BARE ROOT)

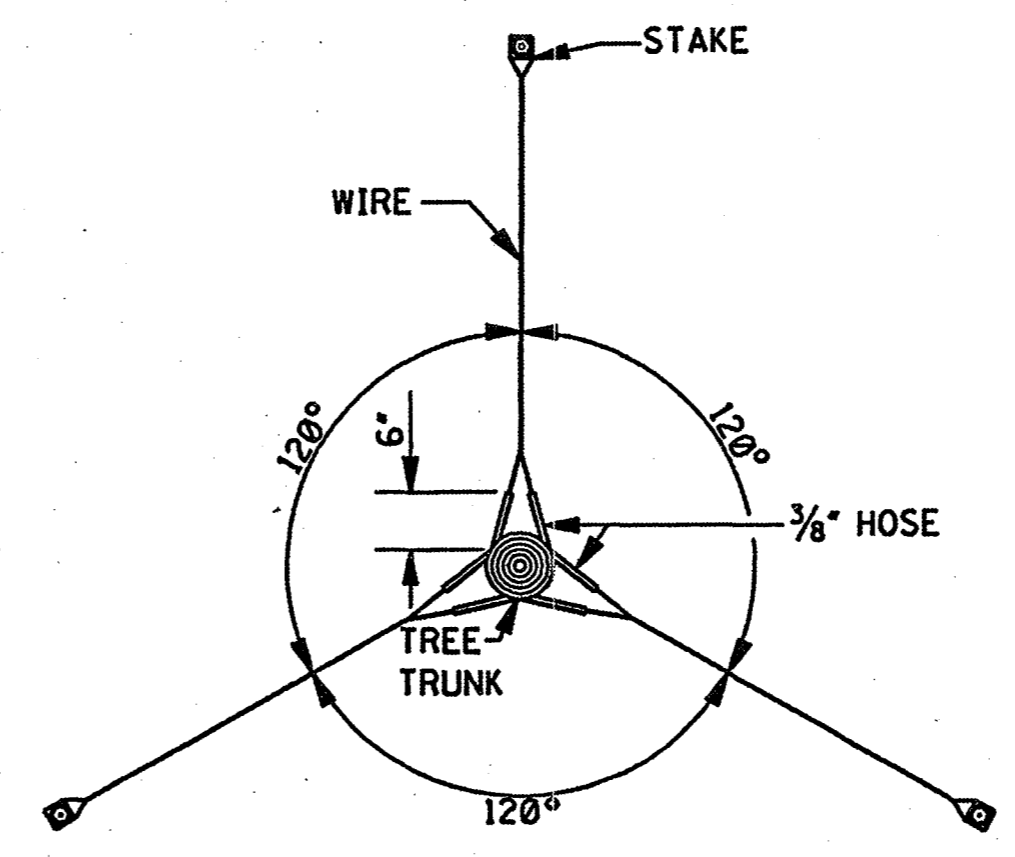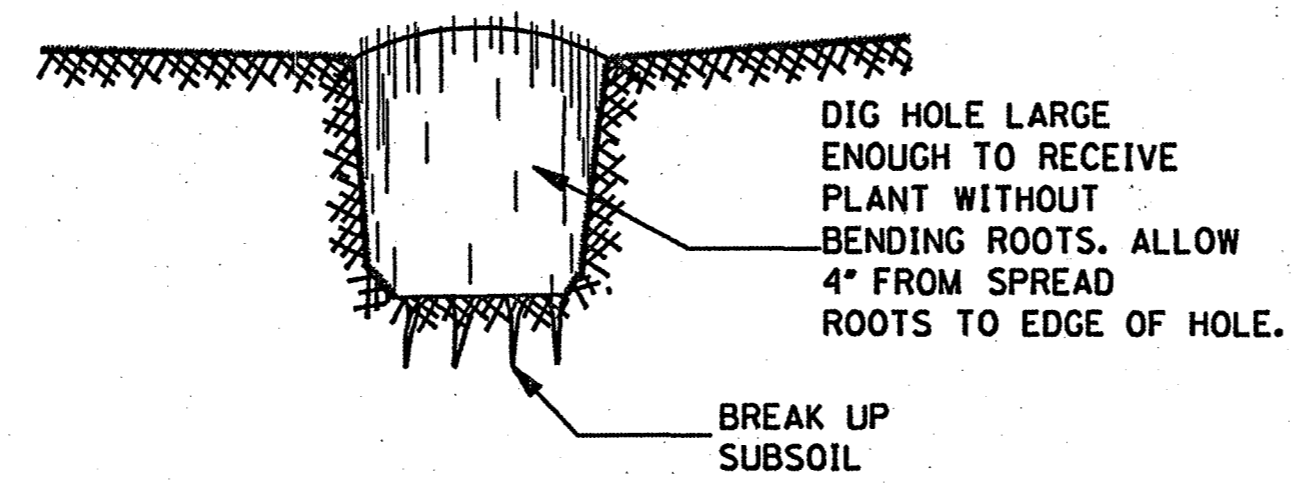

PLAN

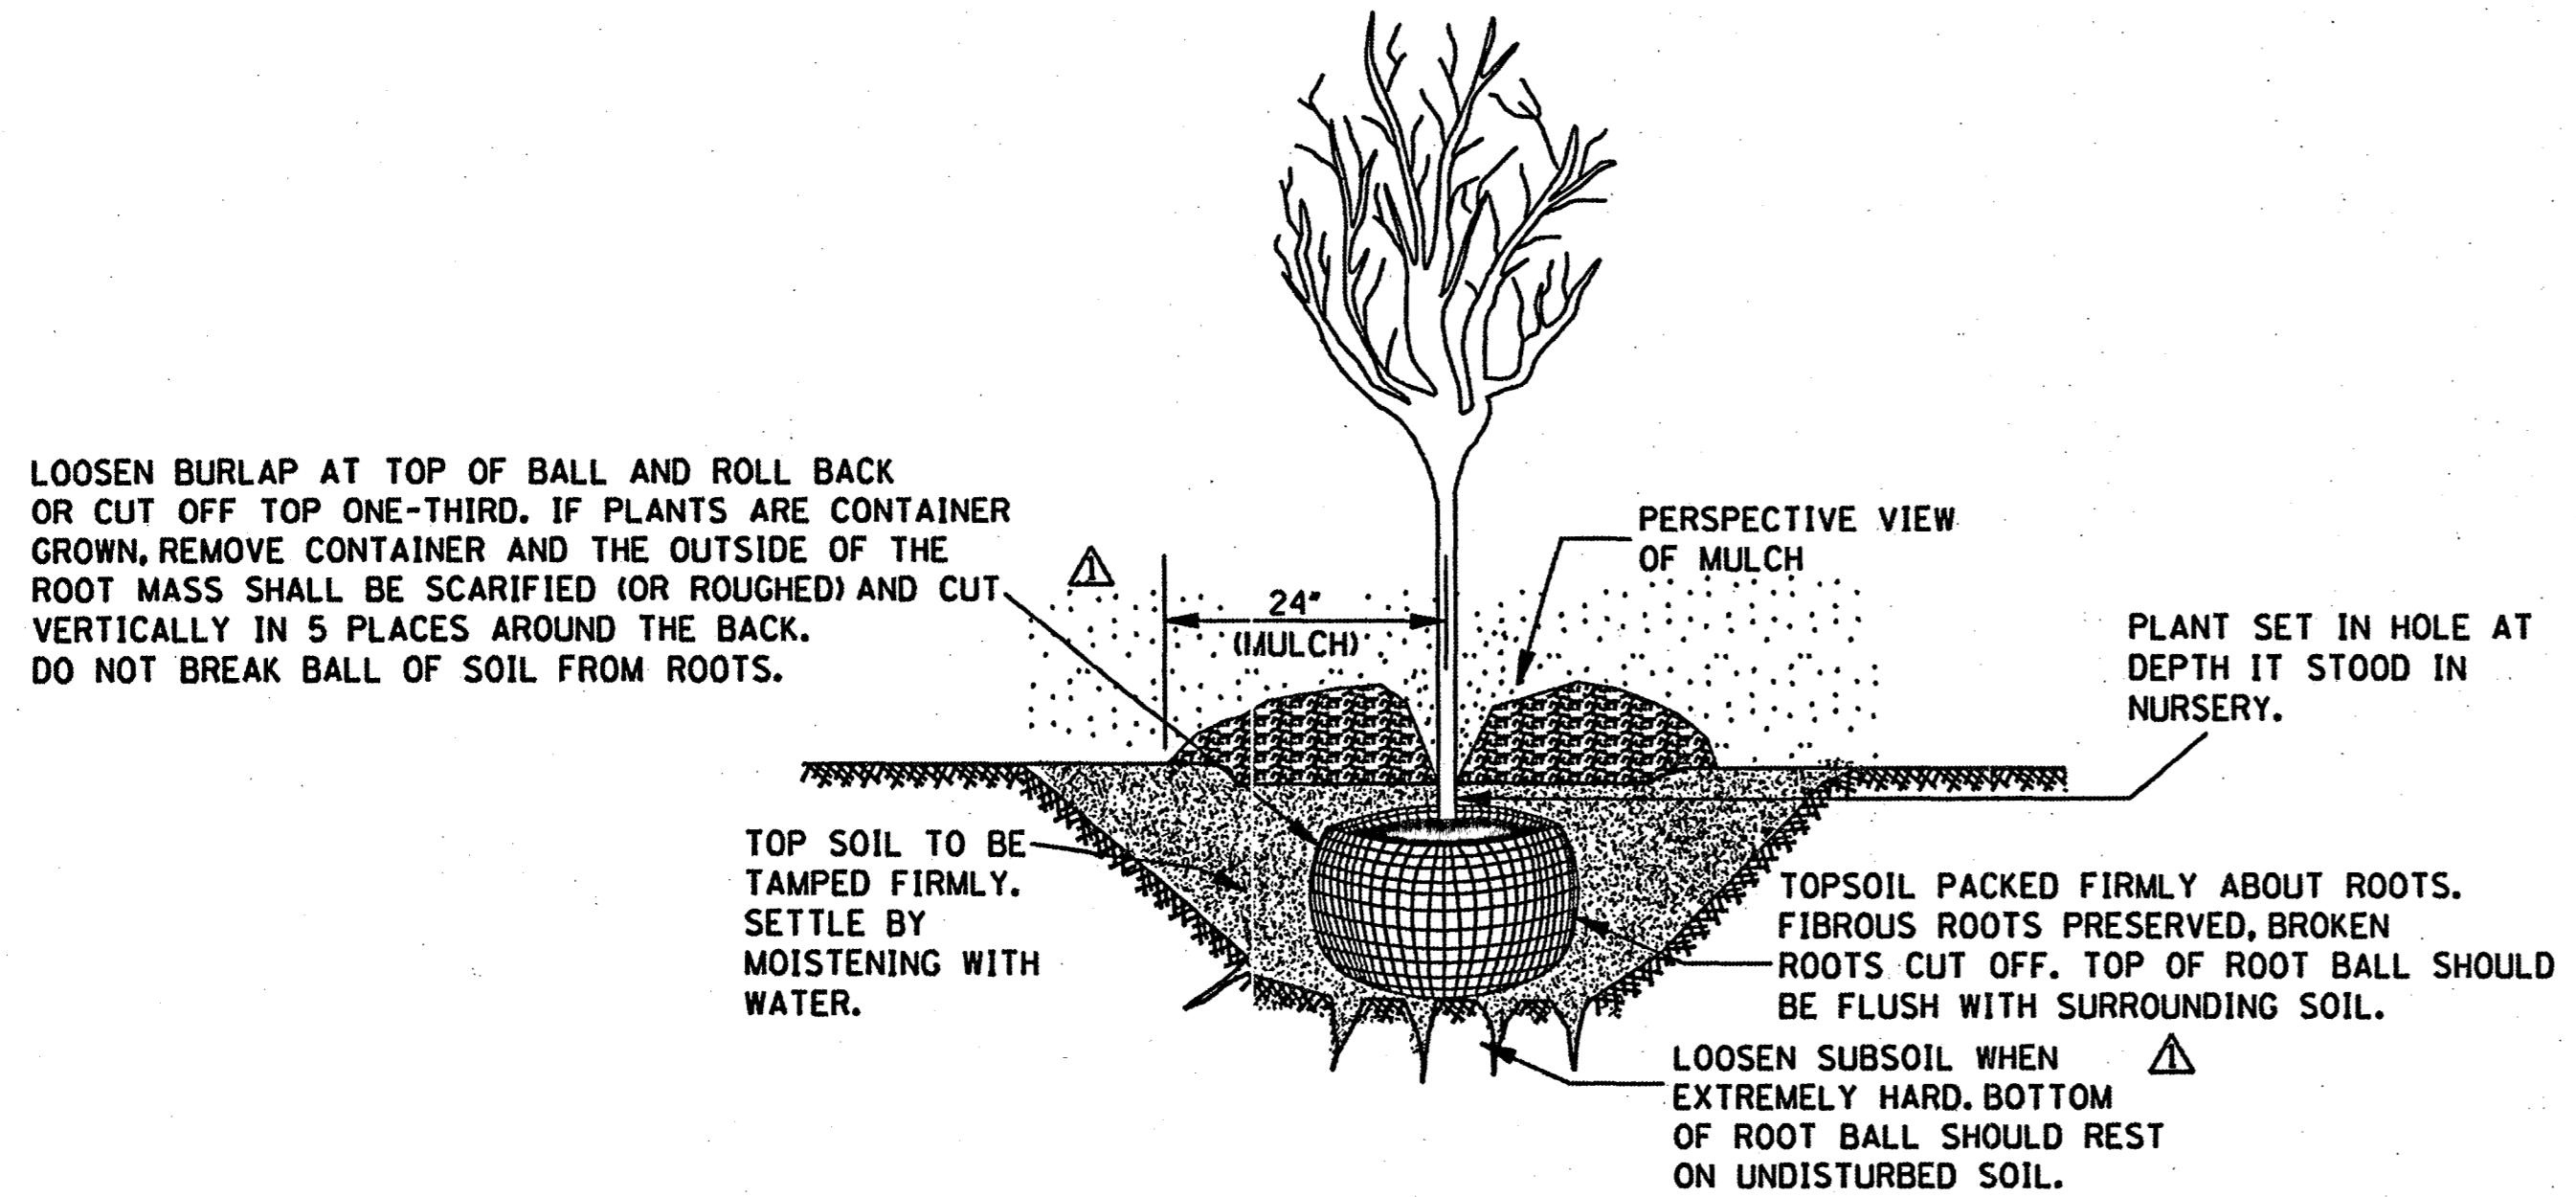

TREE AND SHRUB PLANTING (B & B OR CONTAINER GROWN)

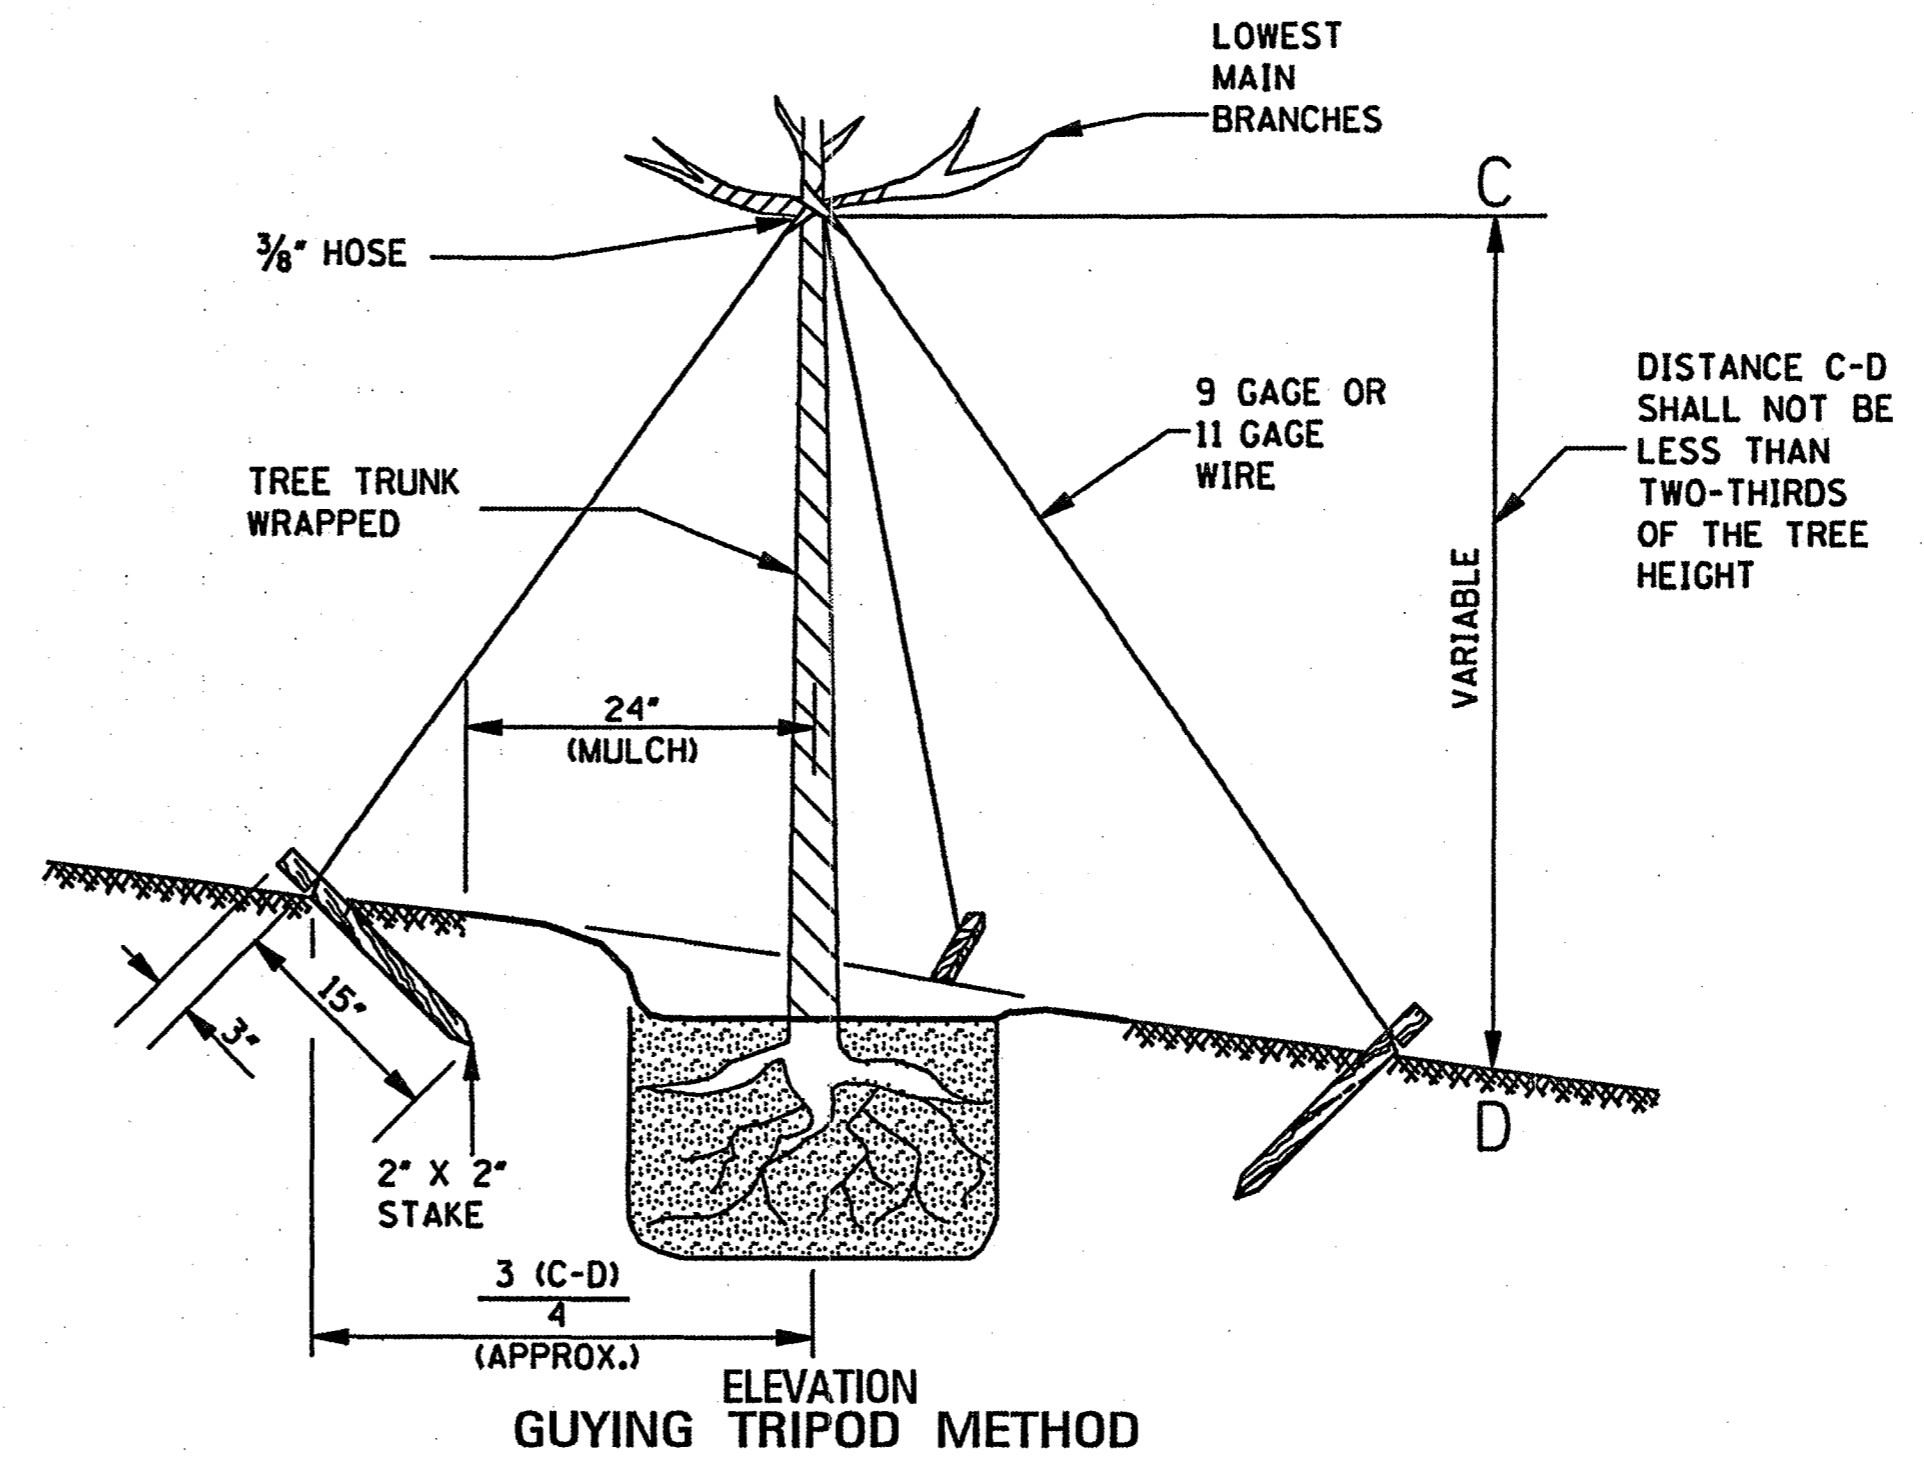


ELEVATION GUYING TRIPOD METHOD

GENERAL NOTES:


1. THE TYPE(S), RATE(S) OF APPLICATION AND PLACEMENT OF FERTILIZER AND MULCH SHALL BE IN ACCORDANCE WITH THE REQUIREMENTS OF THE PLANS AND SPECIFICATIONS.
2. TENSION IN GUY WIRES WILL BE SUCH AS TO ALLOW SOME SWAYING MOTION IN TREE.

MISSISSIPPI DEPARTMENT OF TRANSPORTATION ROADWAY DESIGN DIVISION STANDARD PLAN	
<b>TYPICAL PLANTING DETAILS FOR TREES &amp; SHRUBS</b>	
WORKING NUMBER PD-1	SHEET NUMBER 141
ISSUE DATE: OCTOBER 1, 1998	

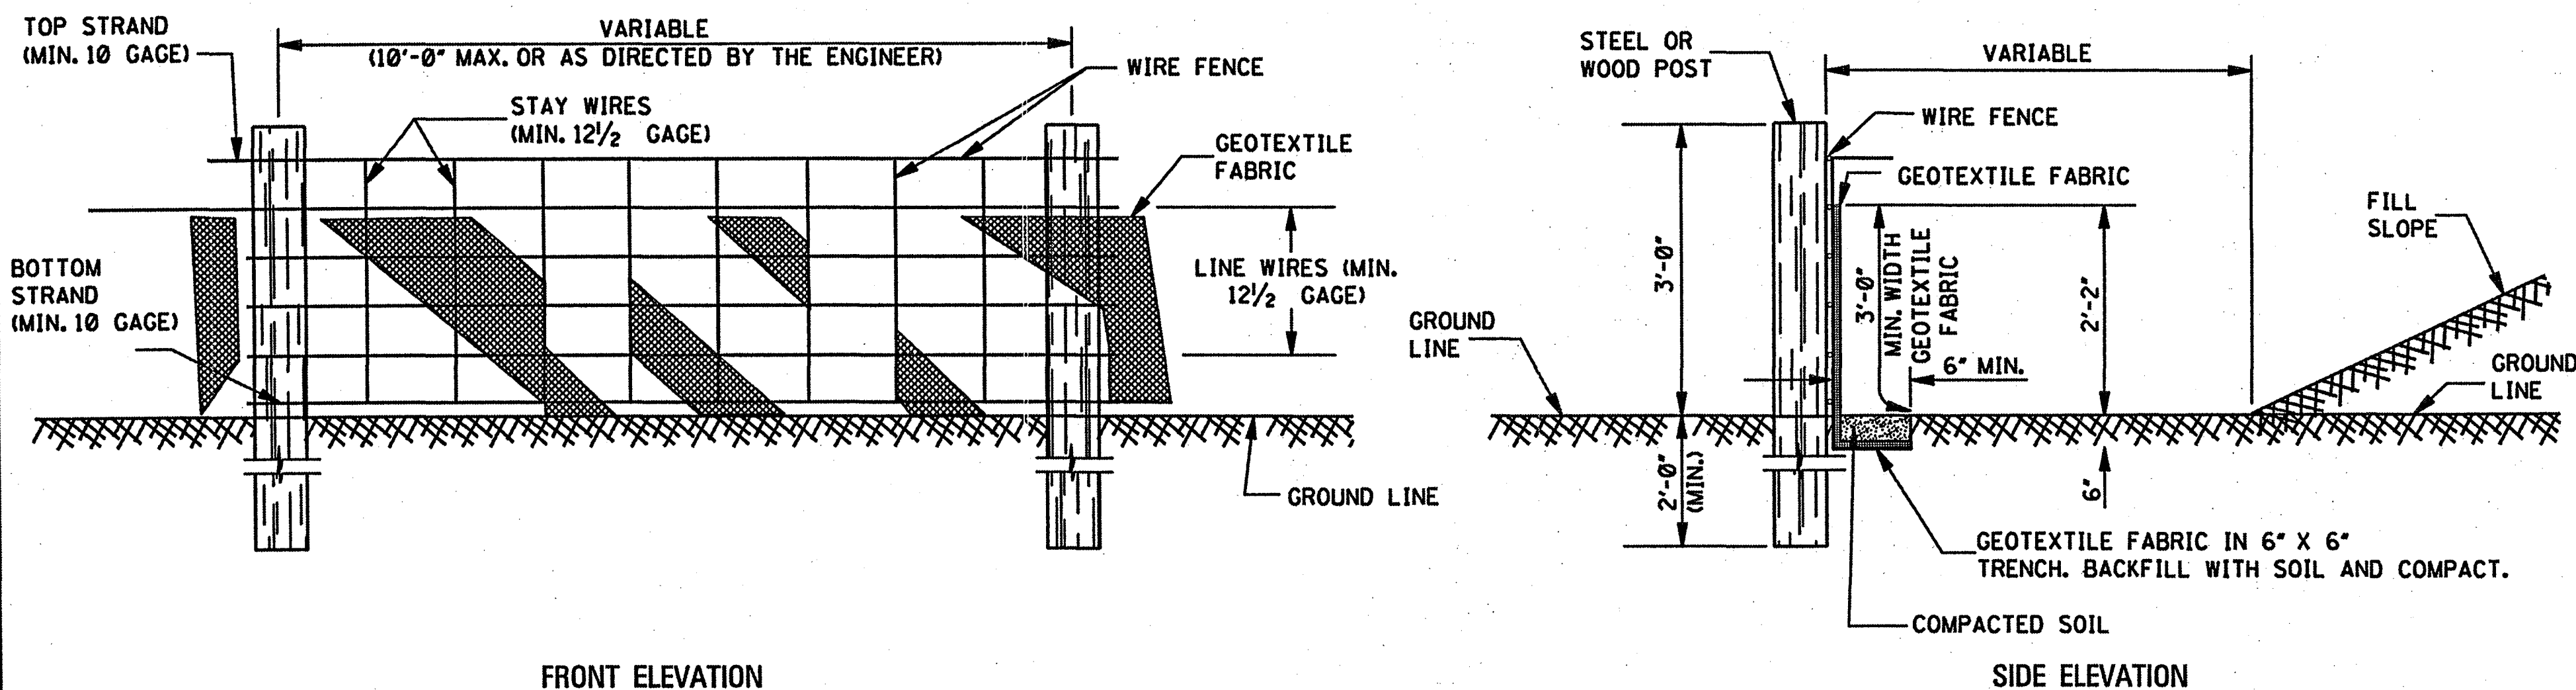


**TEMPORARY SILT FENCE**

- NOTES:
1. WIRE SHALL BE MINIMUM OF 32" IN WIDTH AND SHALL HAVE A MINIMUM OF 6 LINE WIRES WITH 12" STAY SPACING.
  2. GEOTEXTILE FABRIC SHALL BE A MINIMUM OF 36" IN WIDTH AND SHALL BE FASTENED ADEQUATELY TO THE WIRE AS DIRECTED BY THE ENGINEER.
  3. STEEL POST SHALL BE 5'-0" IN HEIGHT AND OF THE SELF-FASTENER ANGLE STEEL TYPE. WOOD POST SHALL BE A MINIMUM OF 5'-0" IN HEIGHT AND 3" OR MORE IN DIAMETER. WIRE FENCE SHALL BE FASTENED TO WOODEN POST WITH NOT LESS THAN 9 GAGE WIRE STAPLES 1" LONG.
  4. GEOTEXTILE FABRIC MEETING THE TYPE II MATERIAL REQUIREMENTS AND INSTALLED ACCORDING TO SPECIFICATIONS MAY BE USED WITHOUT WIRE FENCE.

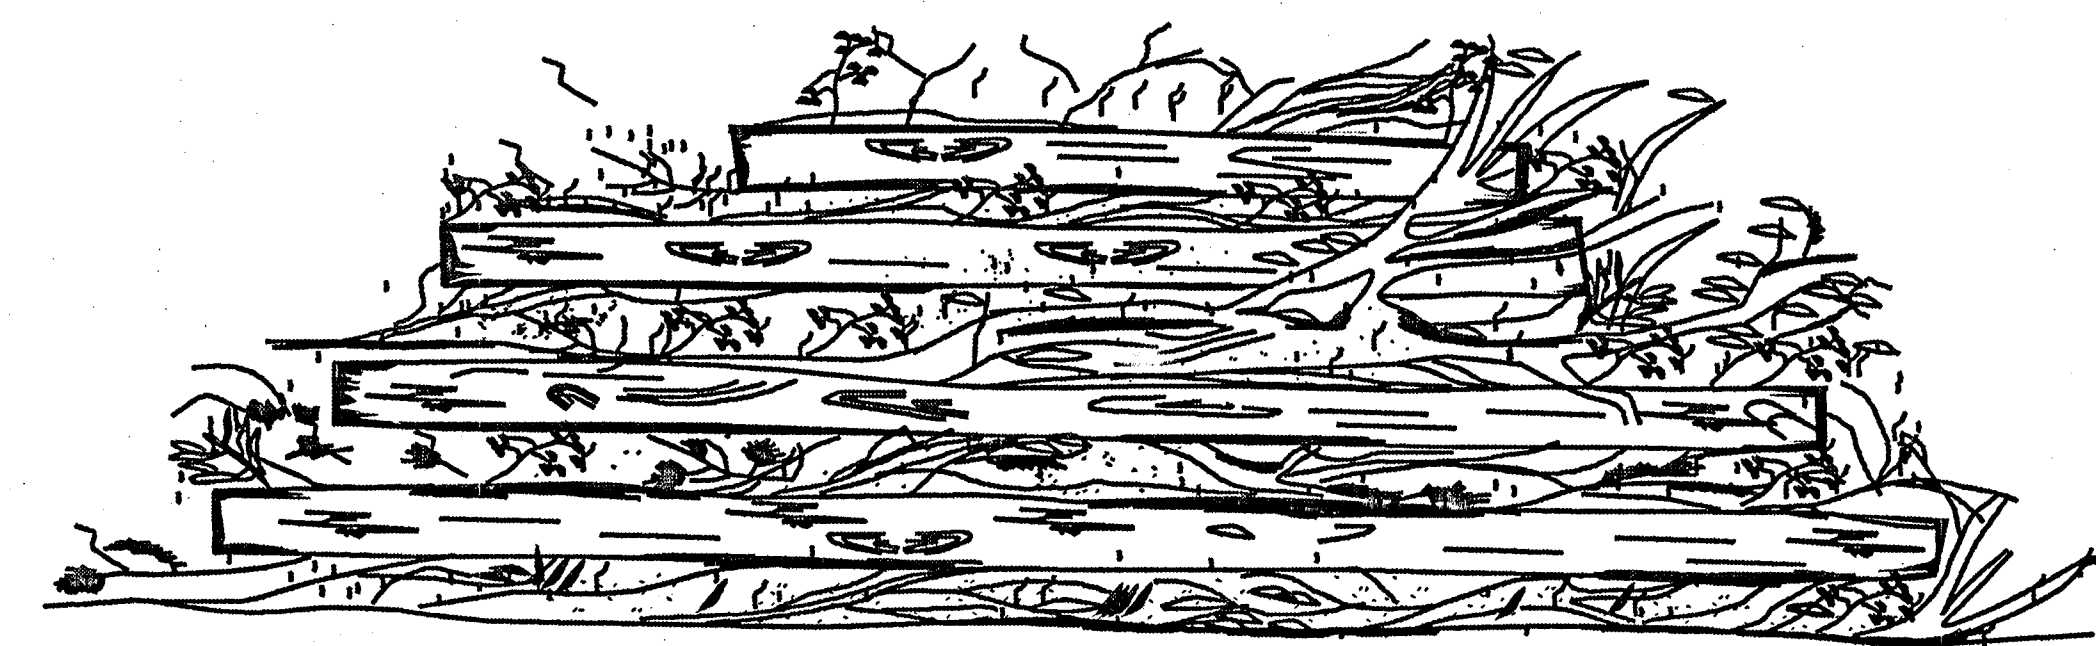

**FRONT ELEVATION**




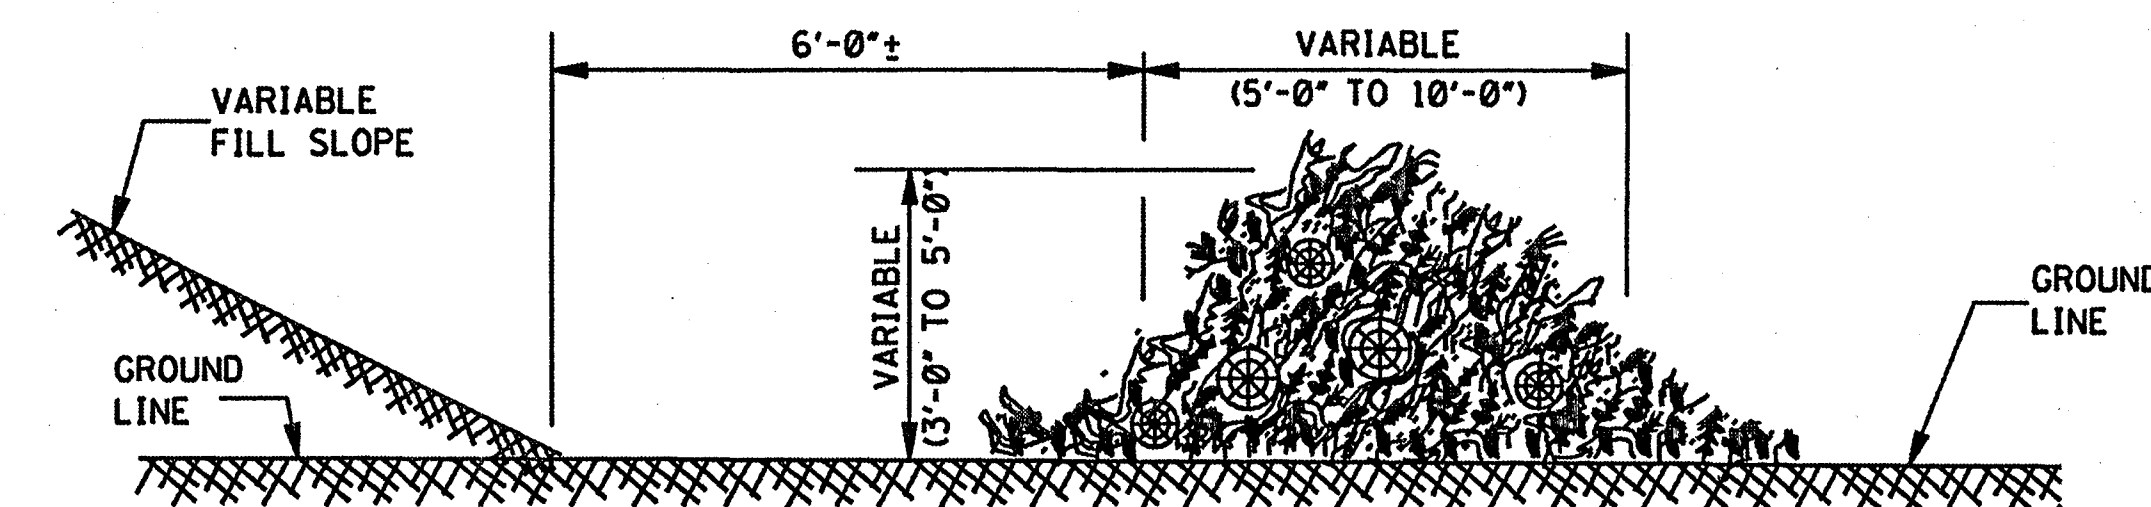


**TEMPORARY BRUSH BARRIER**

- NOTES:
1. BRUSH BARRIER TO BE USED WHERE NATURAL GROUND IS LEVEL OR SLOPING AWAY FROM PROJECT.
  2. PLACE BRUSH, LOG AND TREE LAPS APPROXIMATELY PARALLEL TO TOE OF FILL SLOPE WITH SOME OF THE HEAVIER MATERIALS BEING PLACED ON TOP TO PROPERLY SECURE THE BARRIER AS DETAILED AT LOCATIONS SHOWN ON PLANS OR AS DIRECTED BY THE ENGINEER.
  3. TO ALLOW WATER TO FLOW THROUGH BRUSH BARRIER, INTERMINGLE THE BRUSH, LOG AND TREE LAPS SO AS NOT TO FORM A SOLID DAM.

**GENERAL NOTES:**

1. THE CONTRACTOR SHALL BE REQUIRED TO FURNISH ALL MATERIALS AND PERFORM ALL WORK FOR THE PROPER INSTALLATION, MAINTENANCE AND REMOVAL OF TEMPORARY EROSION CONTROL MEASURES NECESSARY TO CONTROL SILTATION.
2. TEMPORARY BRUSH BARRIERS SHALL BE USED AS REQUIRED BUT WILL NOT BE MEASURED FOR SEPARATE PAYMENT.
3. THE USE OF TEMPORARY EROSION CONTROL MEASURES OTHER THAN TEMPORARY BRUSH BARRIERS WILL ONLY BE REQUIRED AND MEASURED FOR SEPARATE PAYMENT WHEN APPROPRIATE PAY ITEM(S) IS INCLUDED IN THE BID SCHEDULE OF THE PROPOSAL.

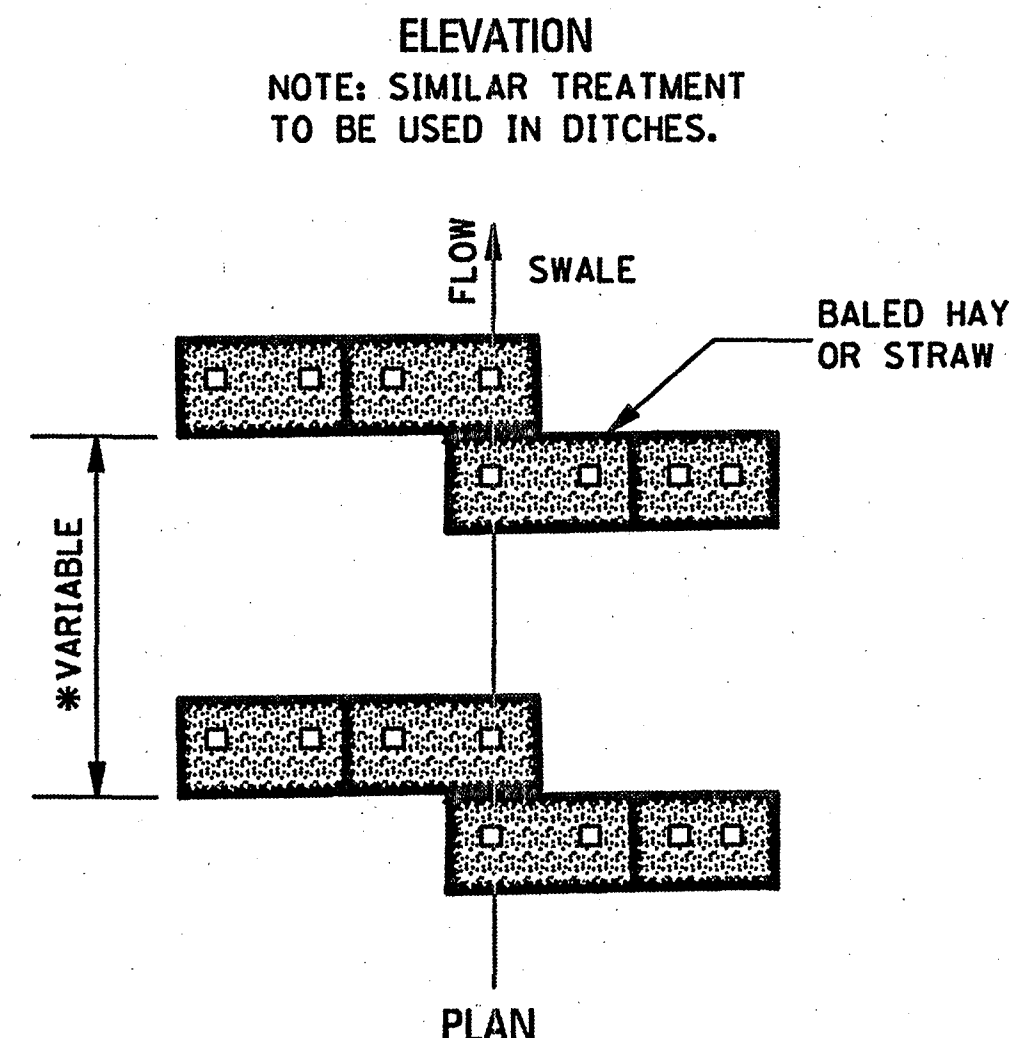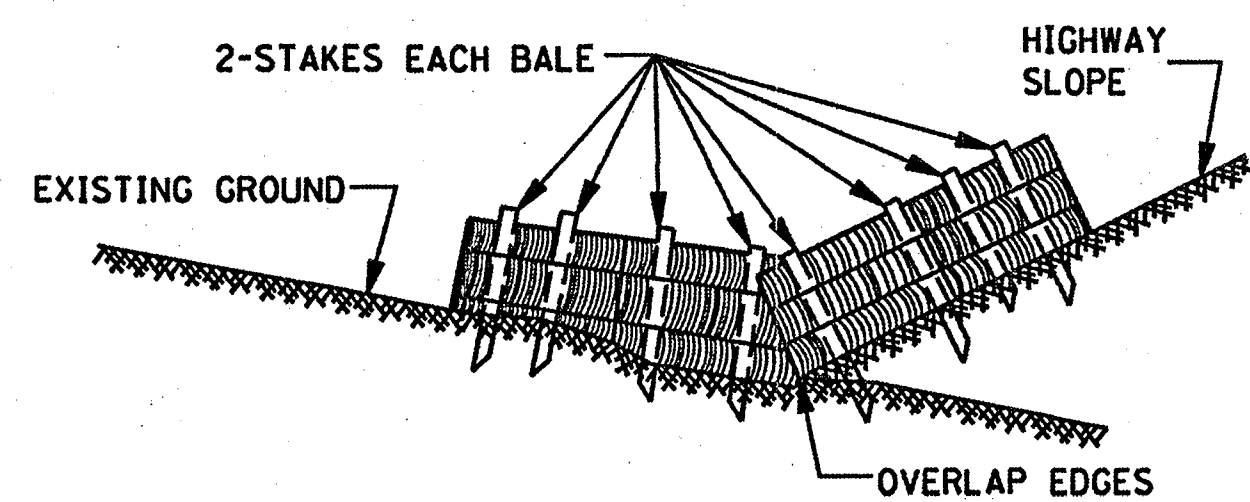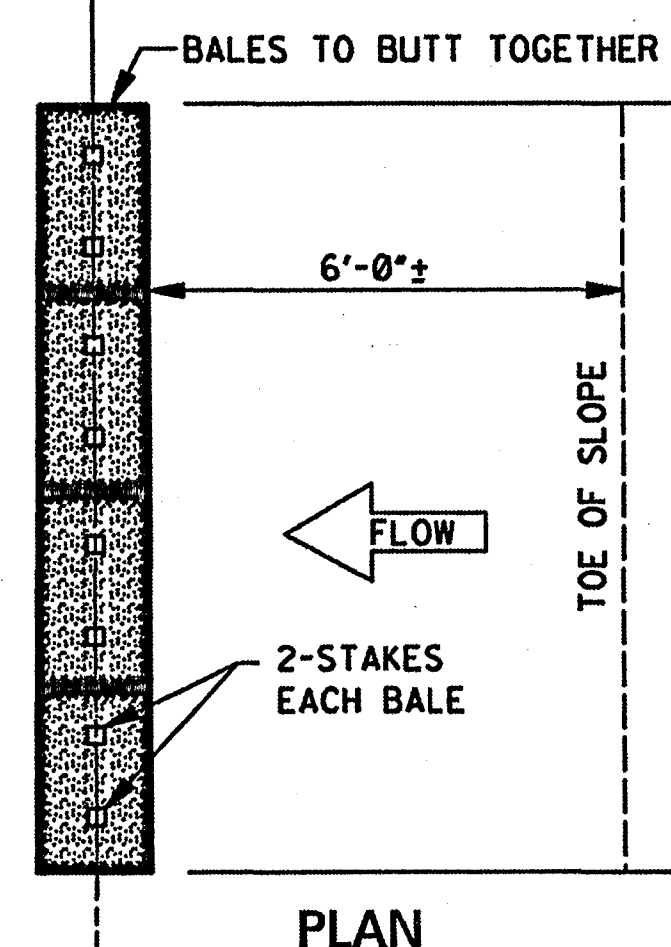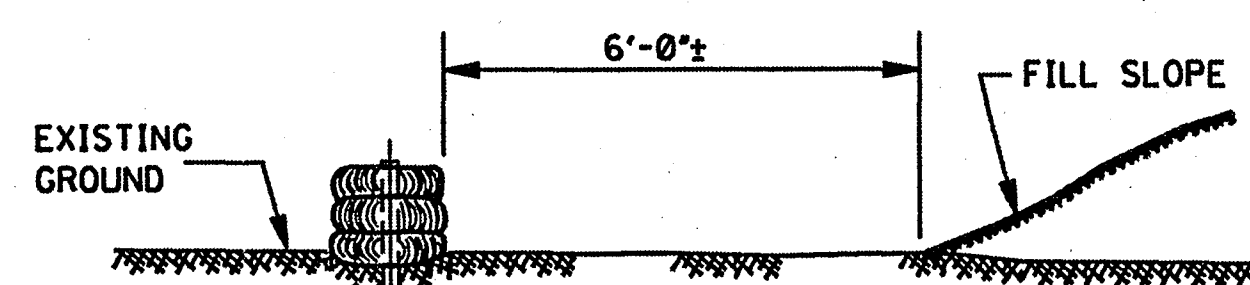


FALL OF DITCH (%)	DISTANCE* (ft)
0 - 1	100'
1 - 2	50'
>2	25'


**TEMPORARY EROSION CHECKS USING HAY OR STRAW BALES**

NOTE: EMBED ALL BALES 3" MINIMUM INTO GROUND AND STAKE (2" X 2" X 36") SECURELY.


RIP RAP WHERE SPECIFIED OR AS DESIGNATED BY THE ENGINEER.

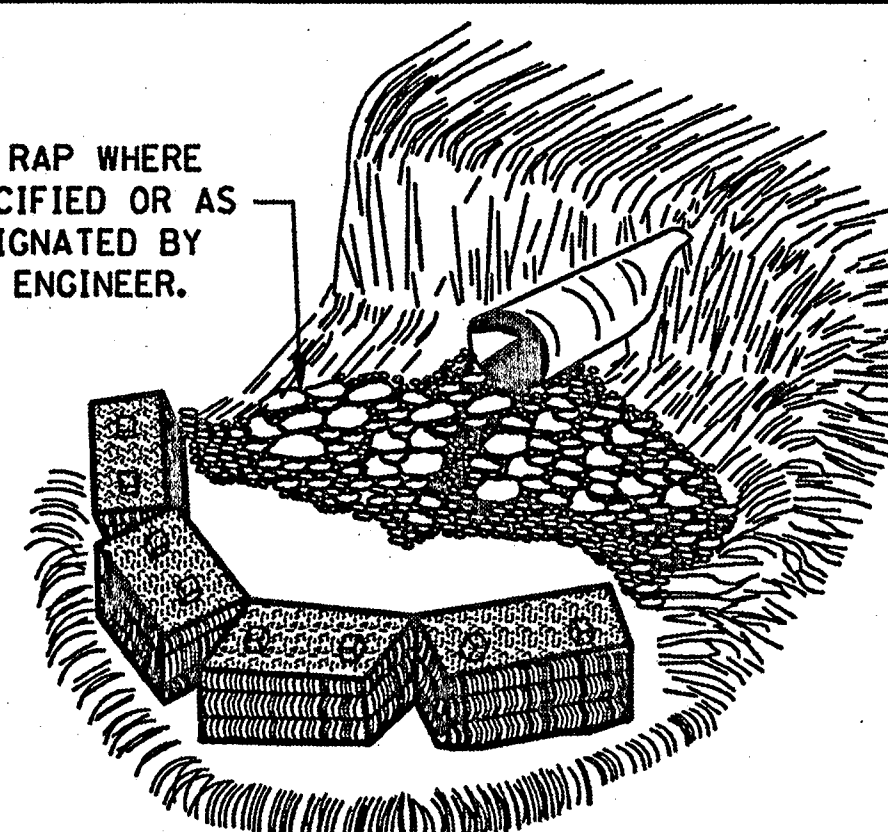


**CULVERT**

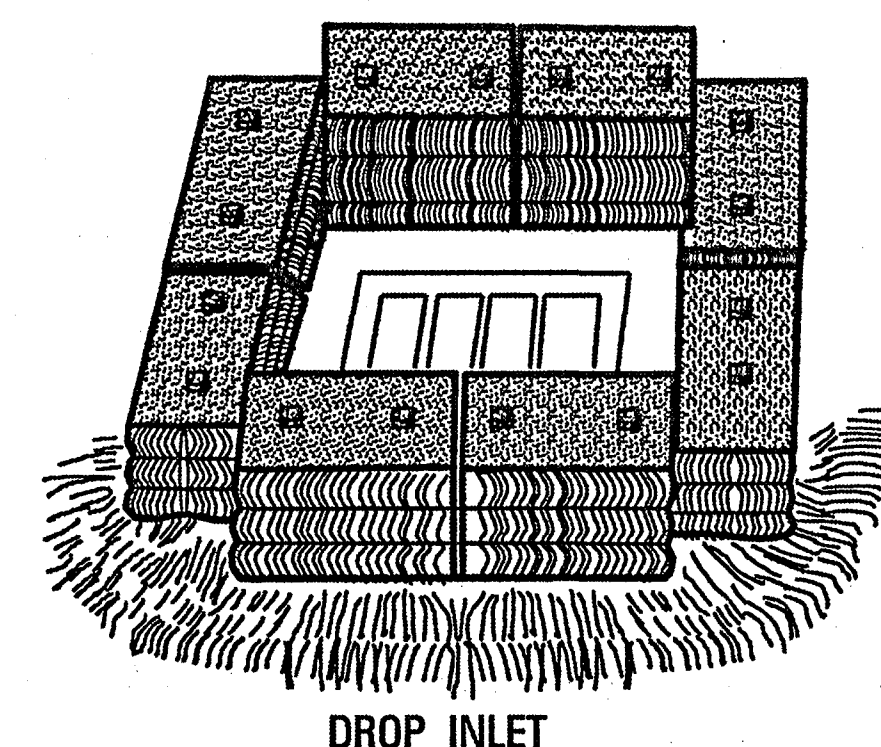


MISSISSIPPI DEPARTMENT OF TRANSPORTATION ROADWAY DESIGN DIVISION STANDARD PLAN	
<b>TYPICAL TEMPORARY EROSION CONTROL MEASURES</b> (SILT FENCE, HAY BALES & BRUSH BARRIER)	
REVISION	WORKING NUMBER TEC-1
DATE	SHEET NUMBER 142
ISSUE DATE: OCTOBER 1, 1998	

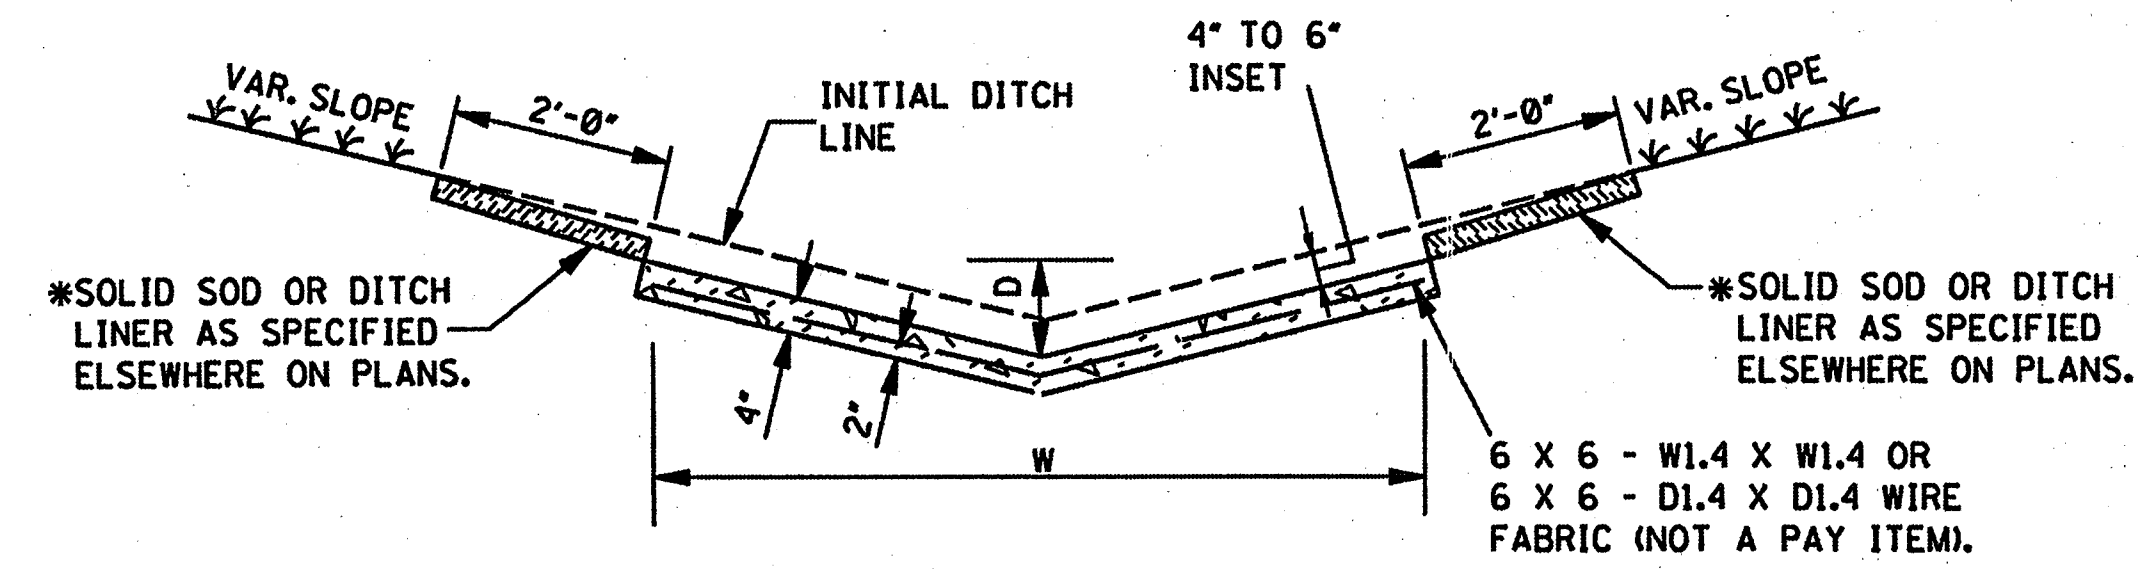


"V" TYPE SECTION

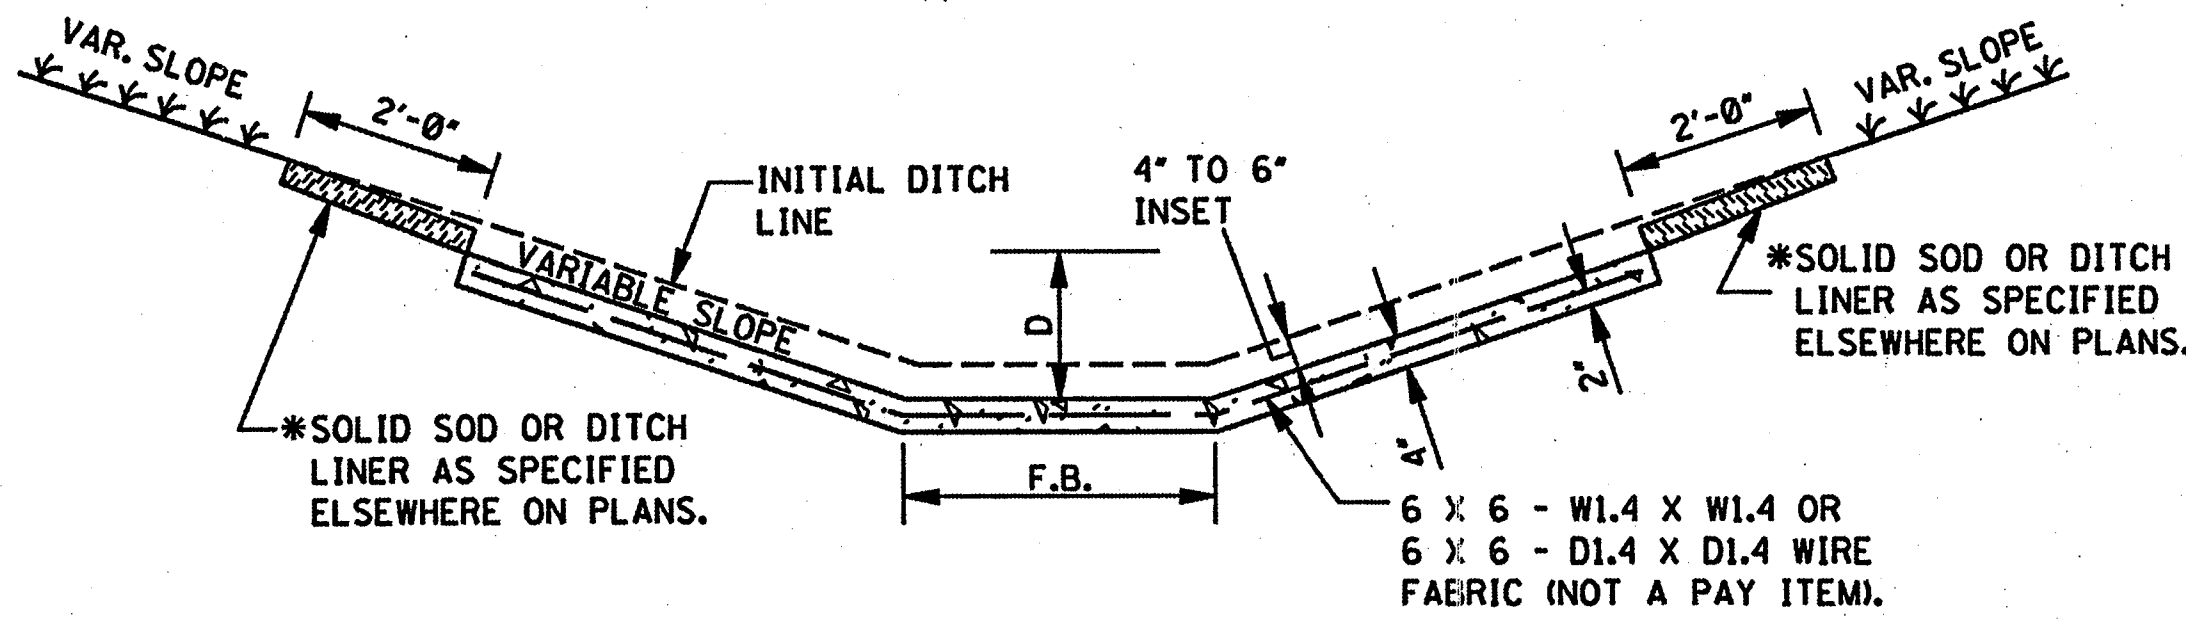

FLAT BOTTOM SECTION

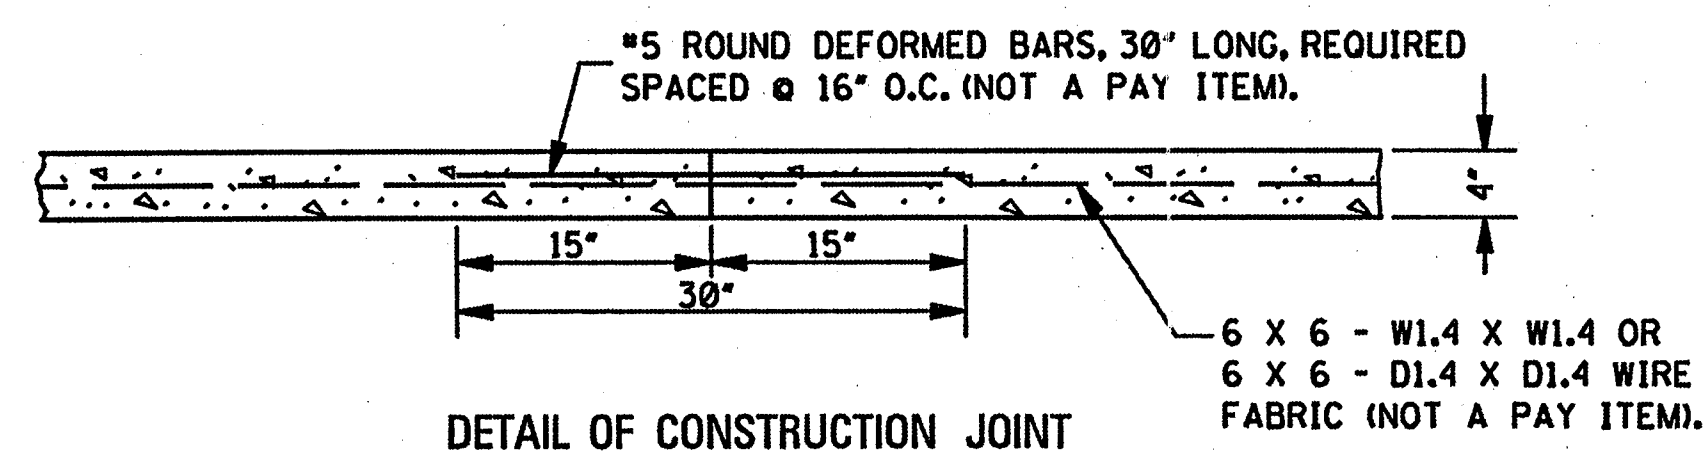


DETAIL OF CONSTRUCTION JOINT

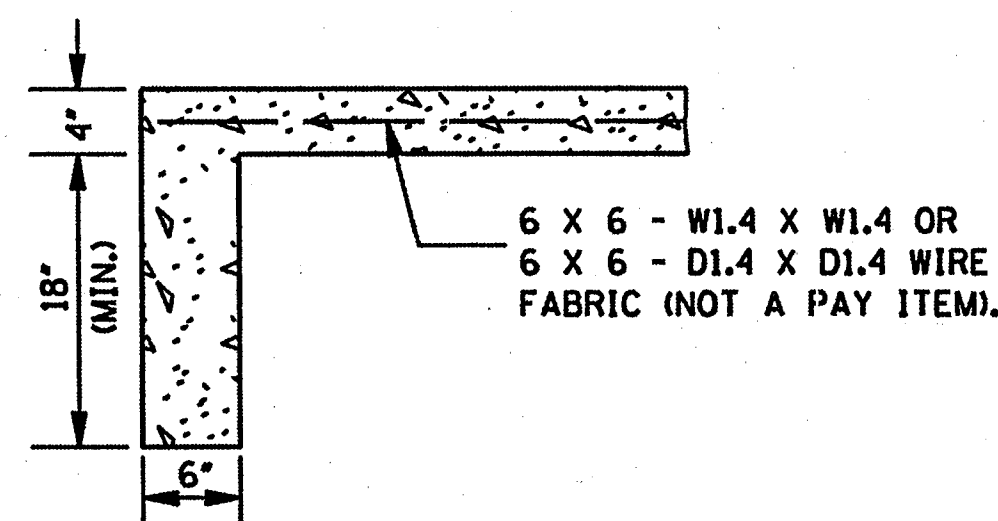

DETAIL OF TOE WALL  
NOTE: TOE WALL REQUIRED UPSTREAM AND DOWNSTREAM.


**CONCRETE PAVED DITCH**

- NOTES:
- CONCRETE PAVED DITCHES SHALL BE GROOVED AT 20'-0" INTERVALS. THE GROOVES SHALL BE CUT TO A DEPTH OF NOT LESS THAN 1".
  - DIMENSIONS D & W ARE AS FOLLOWS:  
D(MINIMUM) = 6"  
D(NOMINAL) = 9"  
W(MINIMUM) = 24"
  - CHAIR SUPPORTS FOR THE WIRE MESH WILL NOT BE REQUIRED. HOWEVER, THE CONTRACTOR SHALL PLACE THE WIRE MESH IN A SATISFACTORY AND WORKMANLIKE MANNER TO ENSURE THAT THE FINAL POSITION IS REASONABLY NEAR THE POSITION INDICATED.
  - CENTER ROW OF STAPLES MAY BE OMITTED ON DITCH LINER.

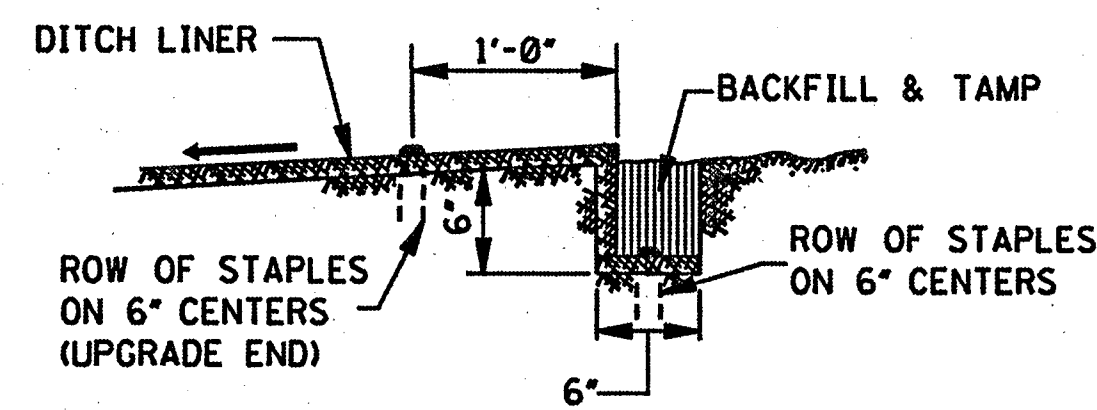


**ANCHOR TRENCH DETAIL**

NOTE: ANCHOR TRENCH REQUIRED AT THE BEGINNING AND ENDING OF EACH AREA TO BE COVERED, EXCEPT DOWNSTREAM END ADJOINING A STRUCTURE.

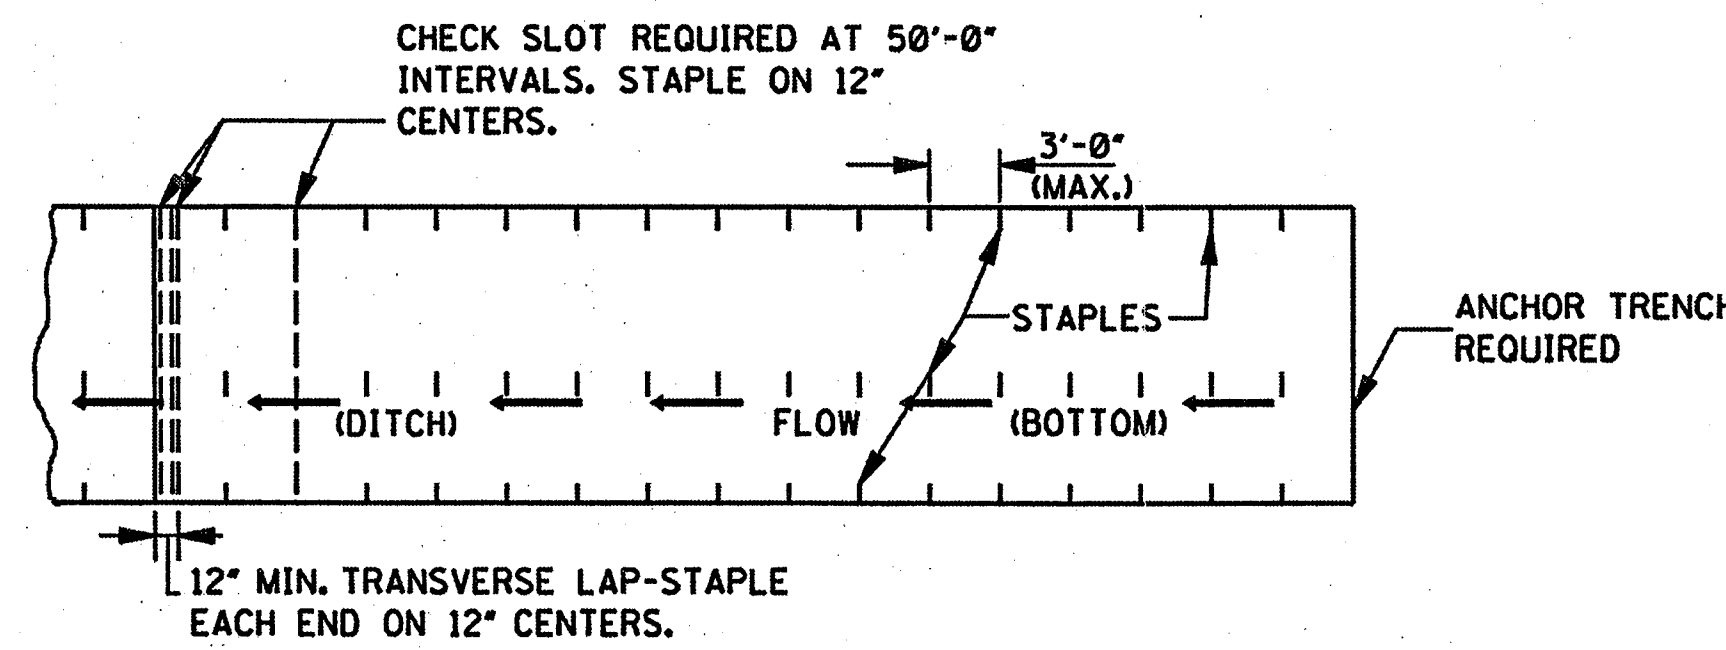


PLAN

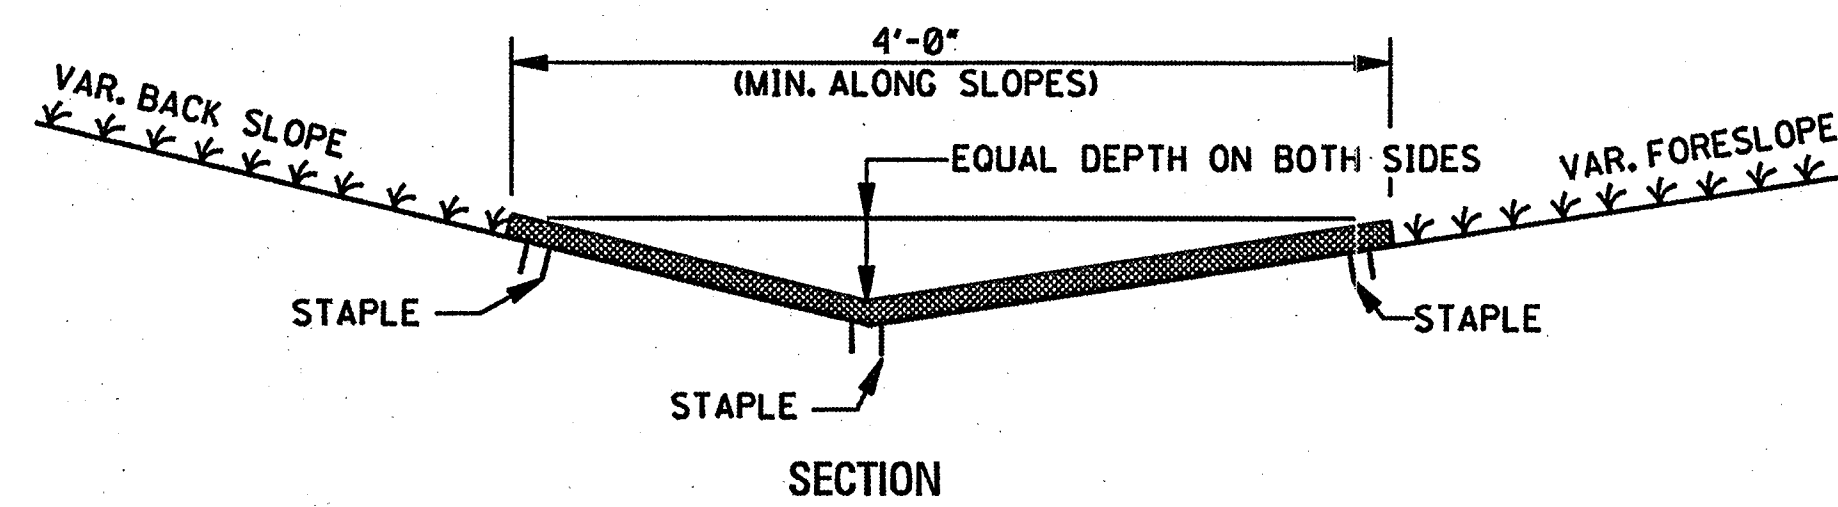


SECTION

**DITCH LINER TREATMENT**  
(EXCELSIOR BLANKET, JUTE MESH OR EROSION CONTROL FABRIC)

NOTE: DITCHES TREATED WITH DITCH LINER WILL BE VEGETATED PRIOR TO TREATMENT, UNLESS OTHERWISE INDICATED.

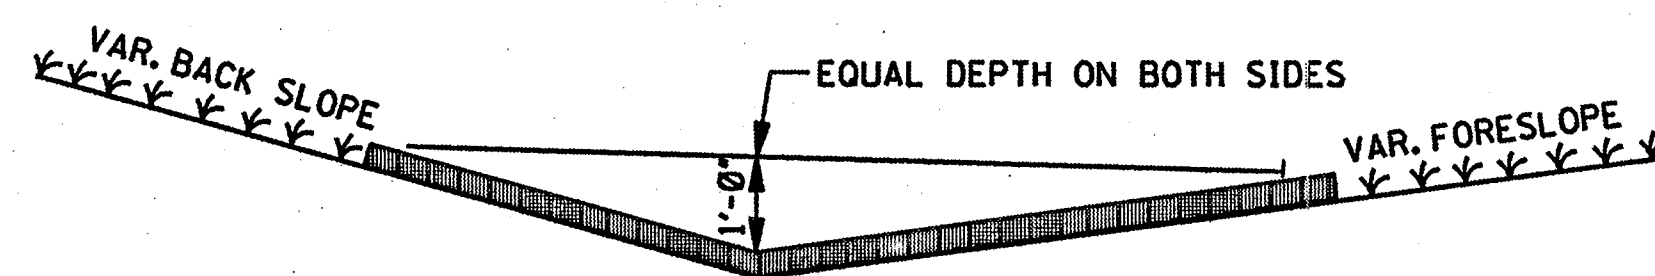


SECTION

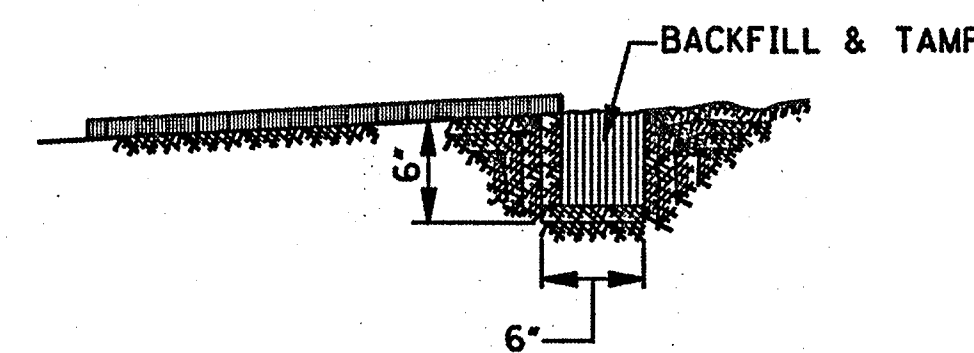


SLOT DETAIL

**BITUMINOUS TREATED ROVING**

NOTE: UPGRADE AND DOWNGRADE ENDS OF THE BITUMINOUS TREATED ROVING SHALL BE BURIED IN A 6" MINIMUM VERTICAL SLOT AND THE SOIL TAMPED FIRMLY AGAINST IT.

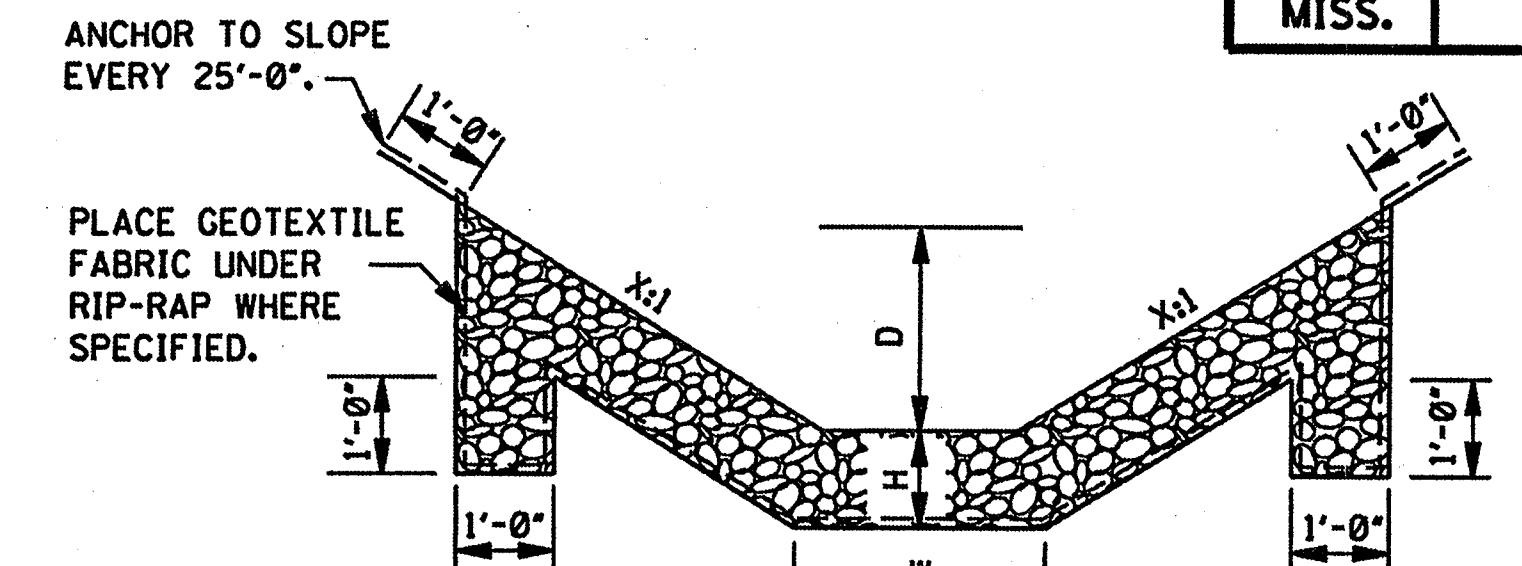


FLAT BOTTOM SECTION

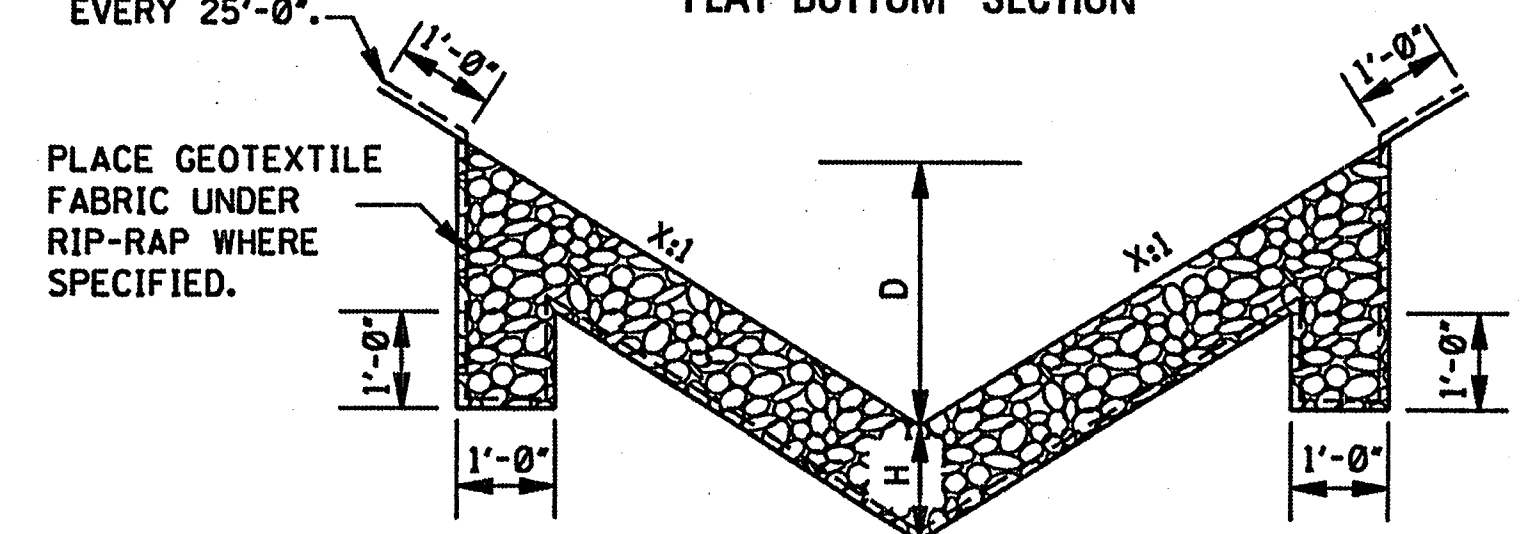


"V" TYPE SECTION  
**RIP-RAP TREATMENT**

- NOTES:
- DIMENSIONS D, W AND X ARE VARIABLE AND ARE SHOWN ELSEWHERE ON THE PLANS.
  - THE RIP-RAP SIZE AND MINIMUM DEPTH "H" FOR RIP-RAP TREATMENT ARE AS FOLLOWS.

RIP-RAP SIZE & MINIMUM DEPTH "H"	
H (in)	RIP-RAP SIZE (lbs)
12"	100
18"	300

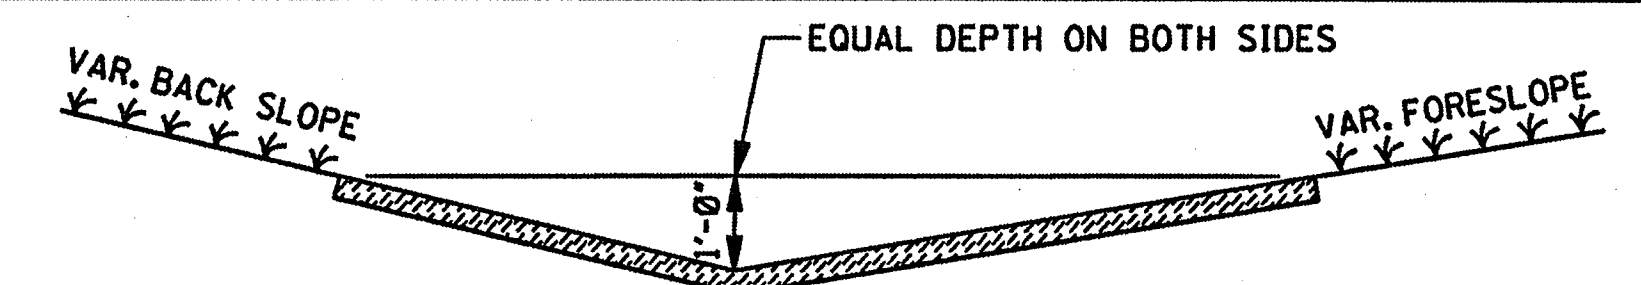




**SOLID SOD TREATMENT**

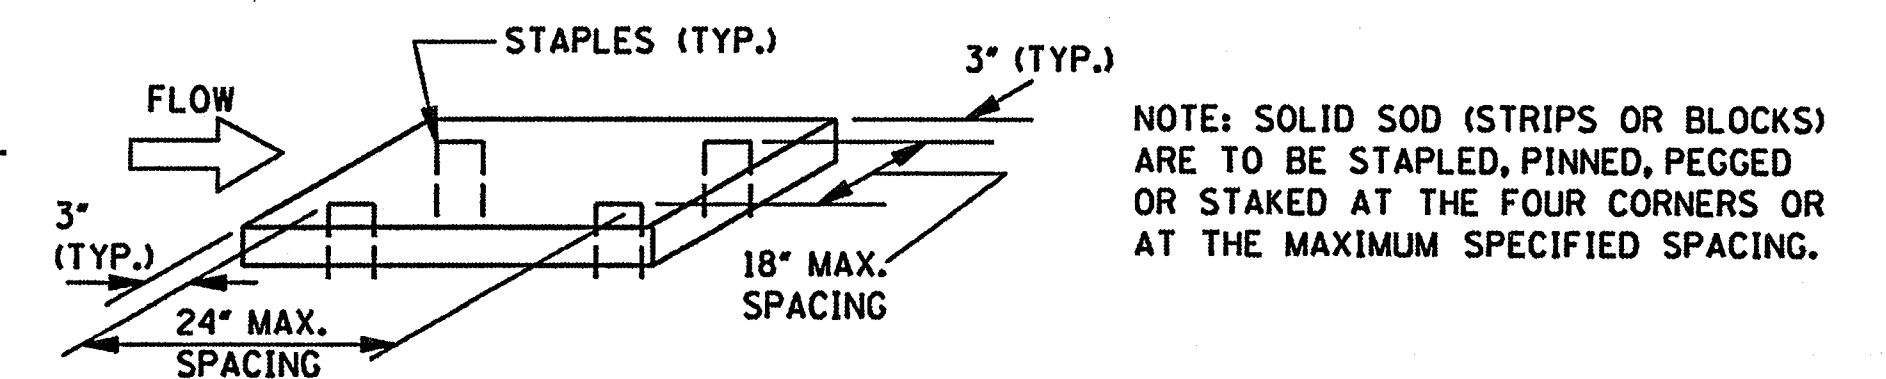

- GENERAL NOTE:
- FOR LOCATION OF APPROPRIATE DITCH TREATMENTS, SEE PLAN SHEETS AS DENOTED BY THE FOLLOWING LEGEND OR AS DIRECTED BY THE ENGINEER:


- DITCH LINER
- BITUMINOUS TREATED ROVING
- SOLID SOD
- CONCRETE PAVED DITCH
- RIP-RAP

MISSISSIPPI DEPARTMENT OF TRANSPORTATION ROADWAY DESIGN DIVISION STANDARD PLAN	
<b>DETAILS OF TYPICAL DITCH TREATMENTS</b>	
REVISION	BY
DATE	DATE
ISSUE DATE: OCTOBER 1, 1998	
MISSISSIPPI DEPARTMENT OF TRANSPORTATION ENGLISH	
WORKING NUMBER DT-1	
SHEET NUMBER 145	

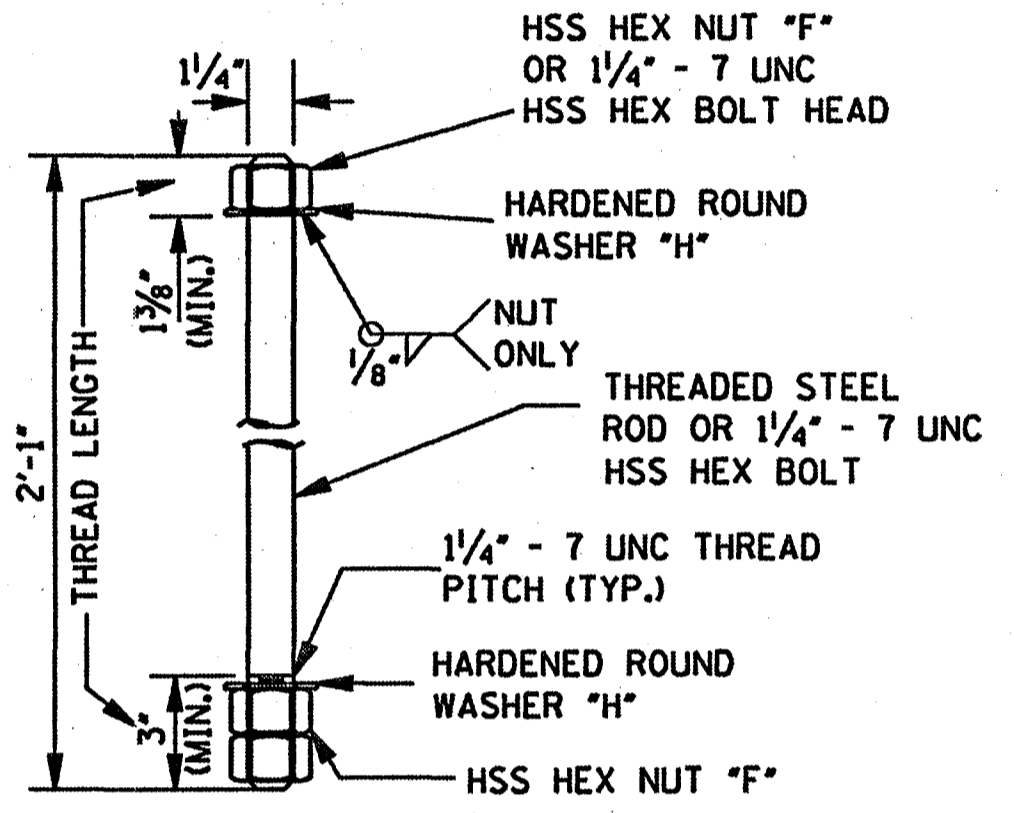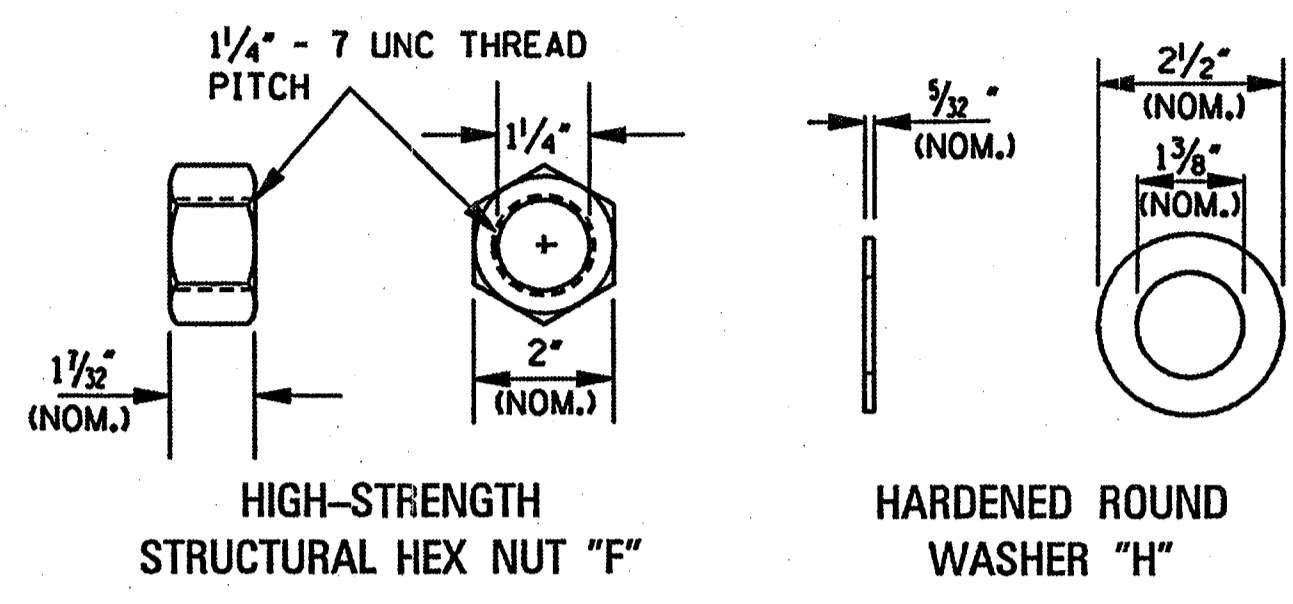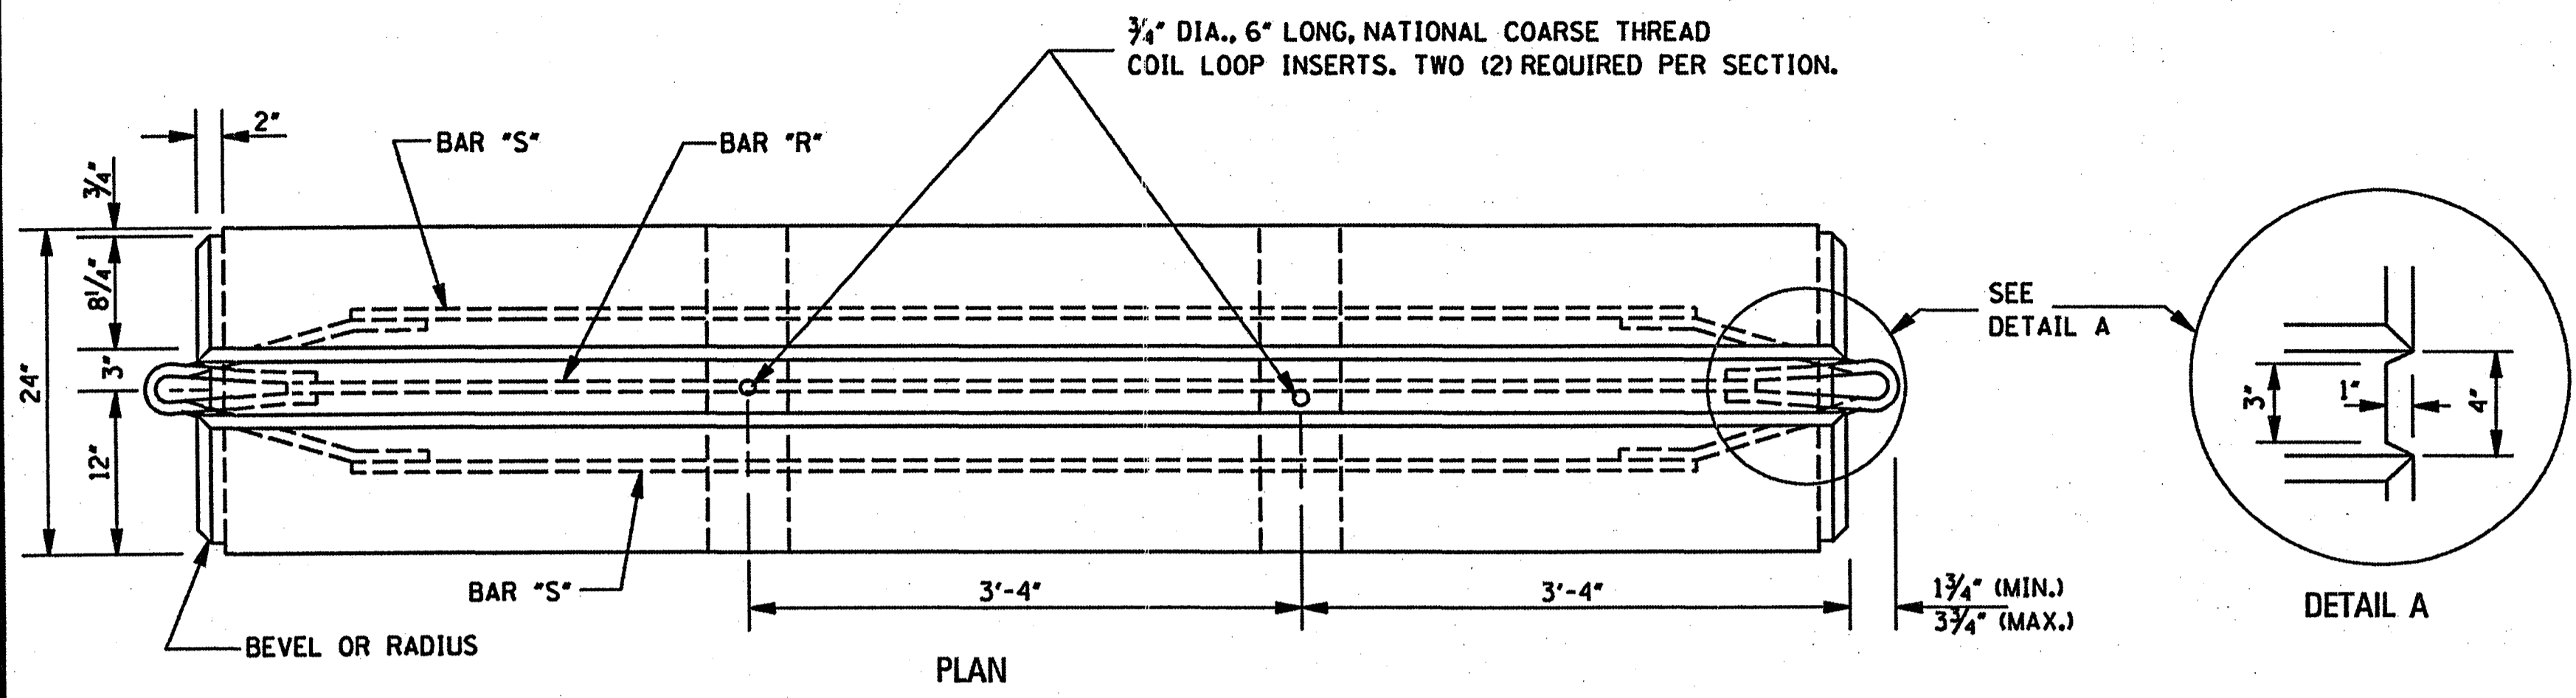


**ANCHOR STUD CONNECTOR DETAILS**

NOTE: ALTERNATE METHODS OF CONNECTING PRECAST BARRIERS, SUCH AS J-HOOKS, MAY BE SUBSTITUTED IF APPROVED BY THE ENGINEER.

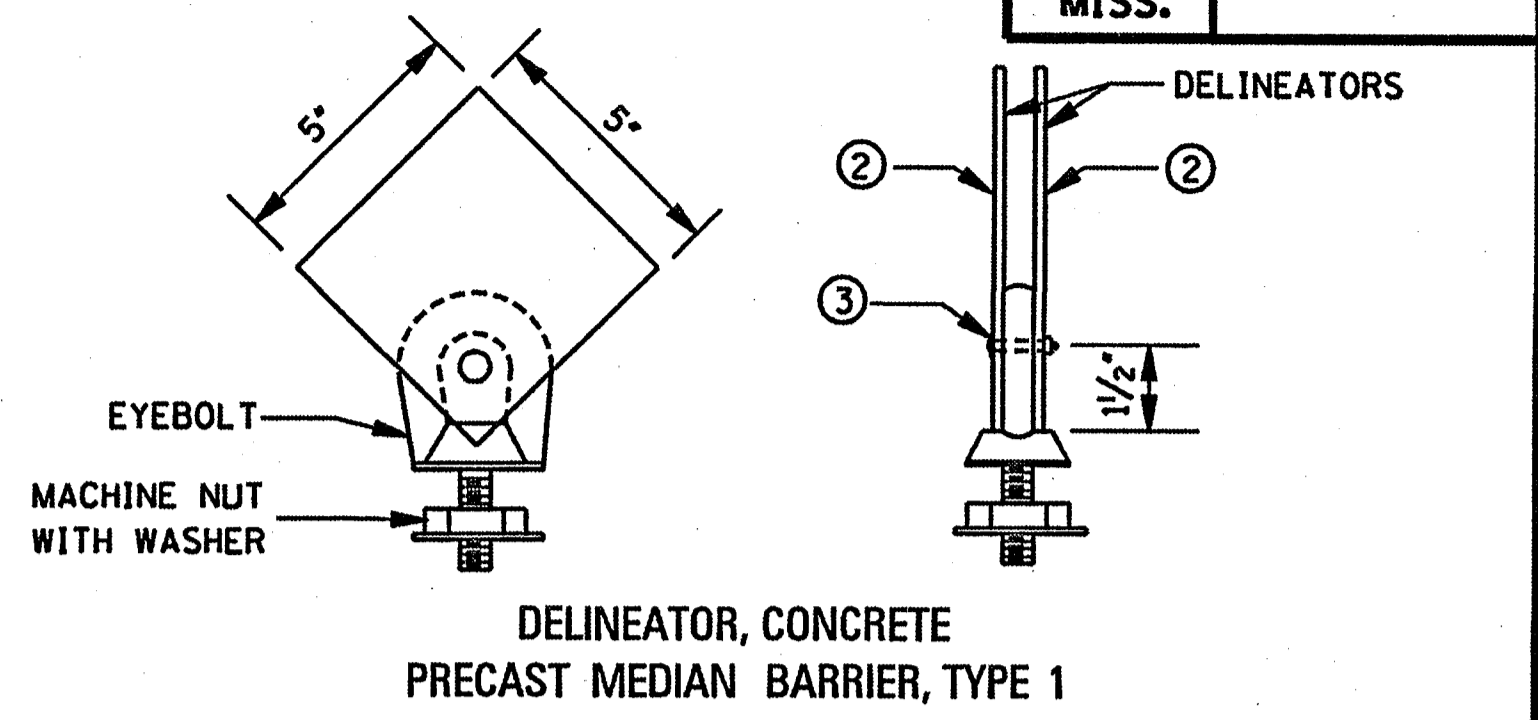

- DELINEATORS SHALL BE REQUIRED UNLESS INDICATED OTHERWISE ON THE PLANS. THIS ITEM WILL NOT BE MEASURED SEPARATELY, BUT WILL BE INCLUDED UNDER PAYMENT FOR PRECAST CONCRETE BARRIER.
- DELINEATORS SHALL BE ENCAPSULATED LENS REFLECTIVE SHEETING ON ALUMINUM SHEET, 0.080" THICK, OR SHEET STEEL, 14 GAGE, WHICH IS GALVANIZED.
- ALUMINUM OR STAINLESS STEEL SLOTTED ROUND HEAD MACHINE SCREW, NO. 10, 1 1/2" LONG, 2-WASHERS AND 1-HEX HEAD NUT (COMMERCIAL QUALITY)
- THE DELINEATORS SHALL BE INSTALLED FACING TRAFFIC WITH YELLOW ON THE LEFT AND WHITE ON THE RIGHT, UNLESS OTHERWISE SPECIFIED.
- SPACINGS OF DELINEATORS: TANGENT SECTION - 20'-0". CURVED SECTION - 10'-0".
- OPTIONAL DELINEATORS, WHICH ARE ON THE MISSISSIPPI DEPARTMENT OF TRANSPORTATION "LIST OF APPROVED MATERIALS", WILL BE ACCEPTED.

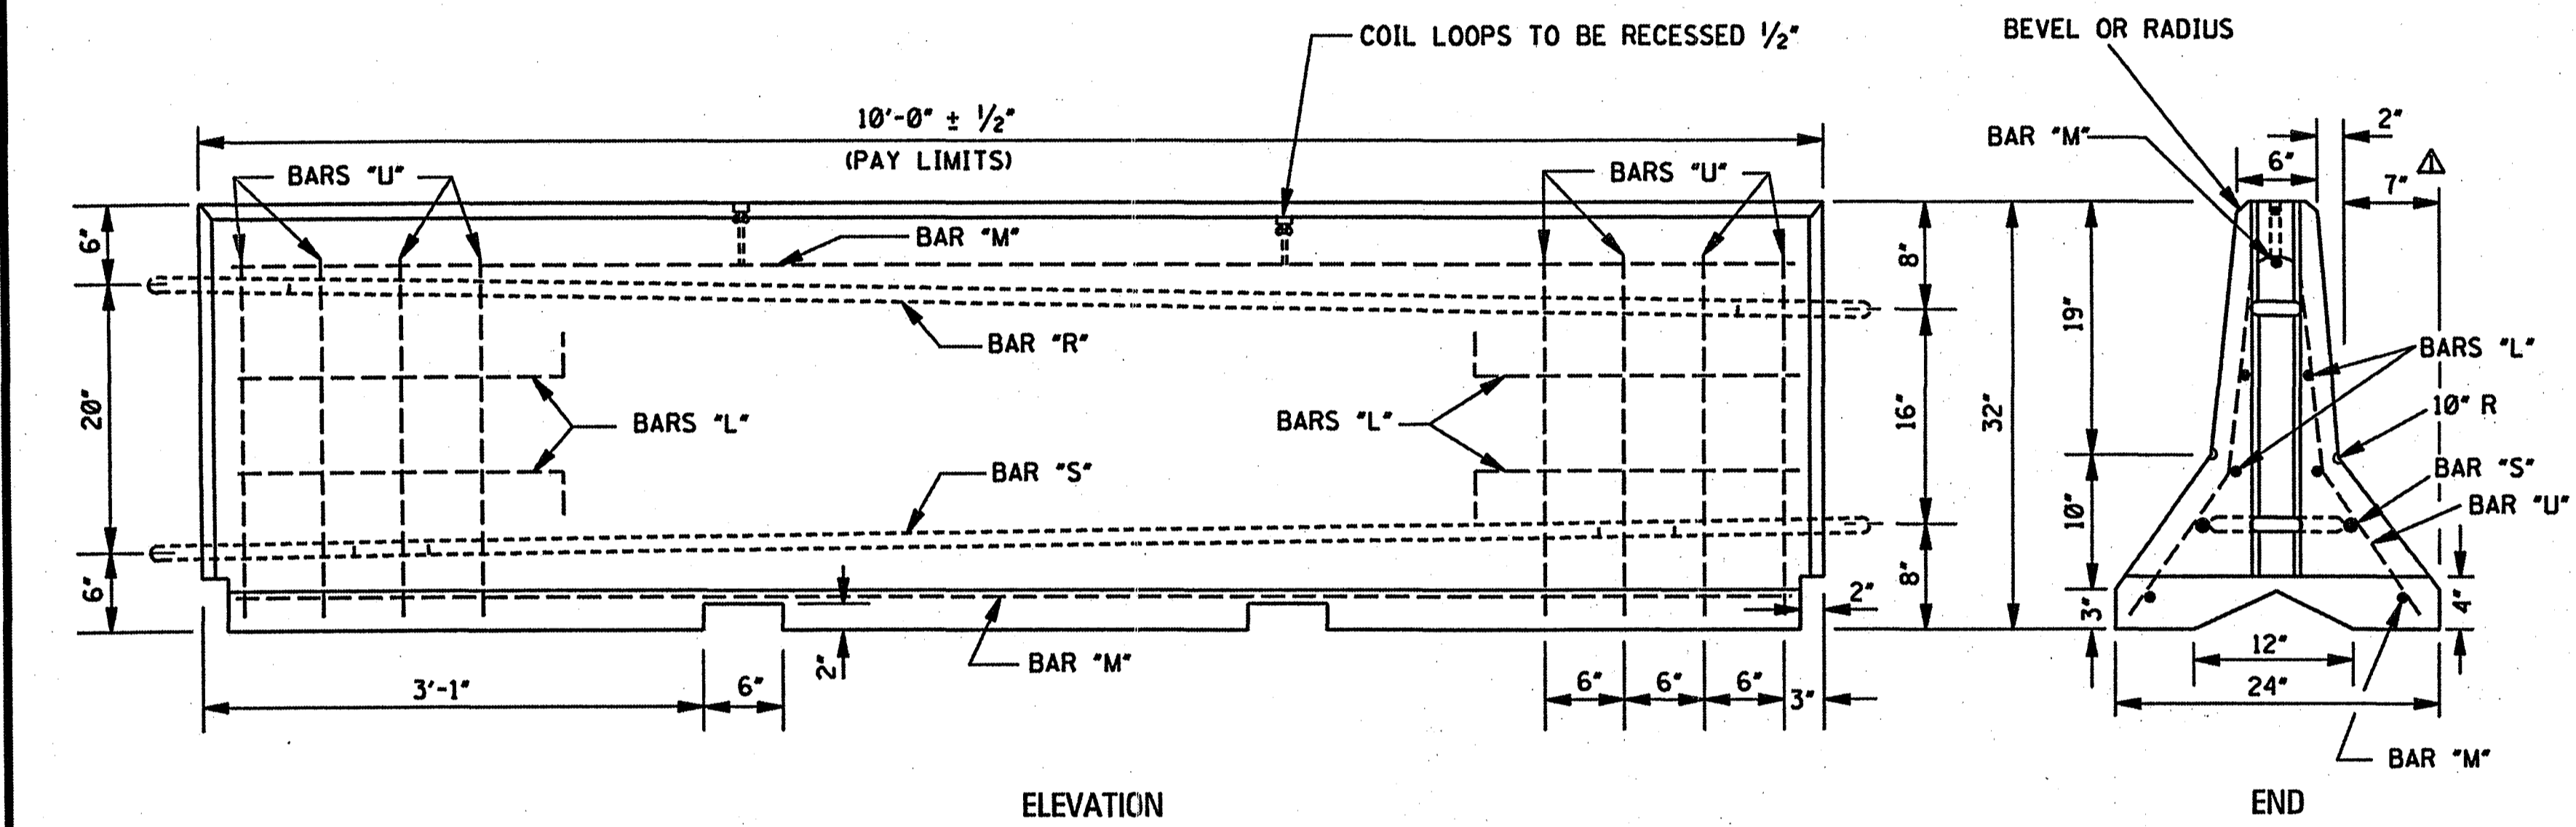


**PRECAST CONCRETE MEDIAN BARRIER**

**GENERAL NOTES:**


- LIFTING DEVICES AND ATTACHMENTS TO BARRIER SECTIONS SHALL BE AS APPROVED BY THE ENGINEER.
- PLACE ALL STEEL REINFORCEMENT 2" MINIMUM FROM OUTSIDE FACE OF WALL, EXCEPT AS OTHERWISE SHOWN.
- THE ANCHOR STUD CONNECTOR SHALL CONFORM TO AASHTO M 314, GRADE 55. THE HSS HEX NUTS AND THE HARDENED ROUND WASHERS SHALL MEET THE REQUIREMENTS OF ASTM A 325.
- CONCRETE SHALL BE CLASS "B" (CLASS 1 FINISH). REINFORCING STEEL SHALL MEET THE REQUIREMENTS OF AASHTO M 31.
- STEEL RODS SHALL MEET THE REQUIREMENTS OF ASTM A 36.
- CONNECTOR RODS, CONNECTOR PINS, NUTS AND WASHERS SHALL BE GALVANIZED MEETING THE REQUIREMENTS OF AASHTO M 111.

APPROXIMATE QUANTITIES FOR 10' BARRIER			
WEIGHT (lbs.)	REINF. STEEL (lbs.)	STEEL RODS (lbs.)	CONCRETE (yd <sup>3</sup> )
3875	104	18	0.931

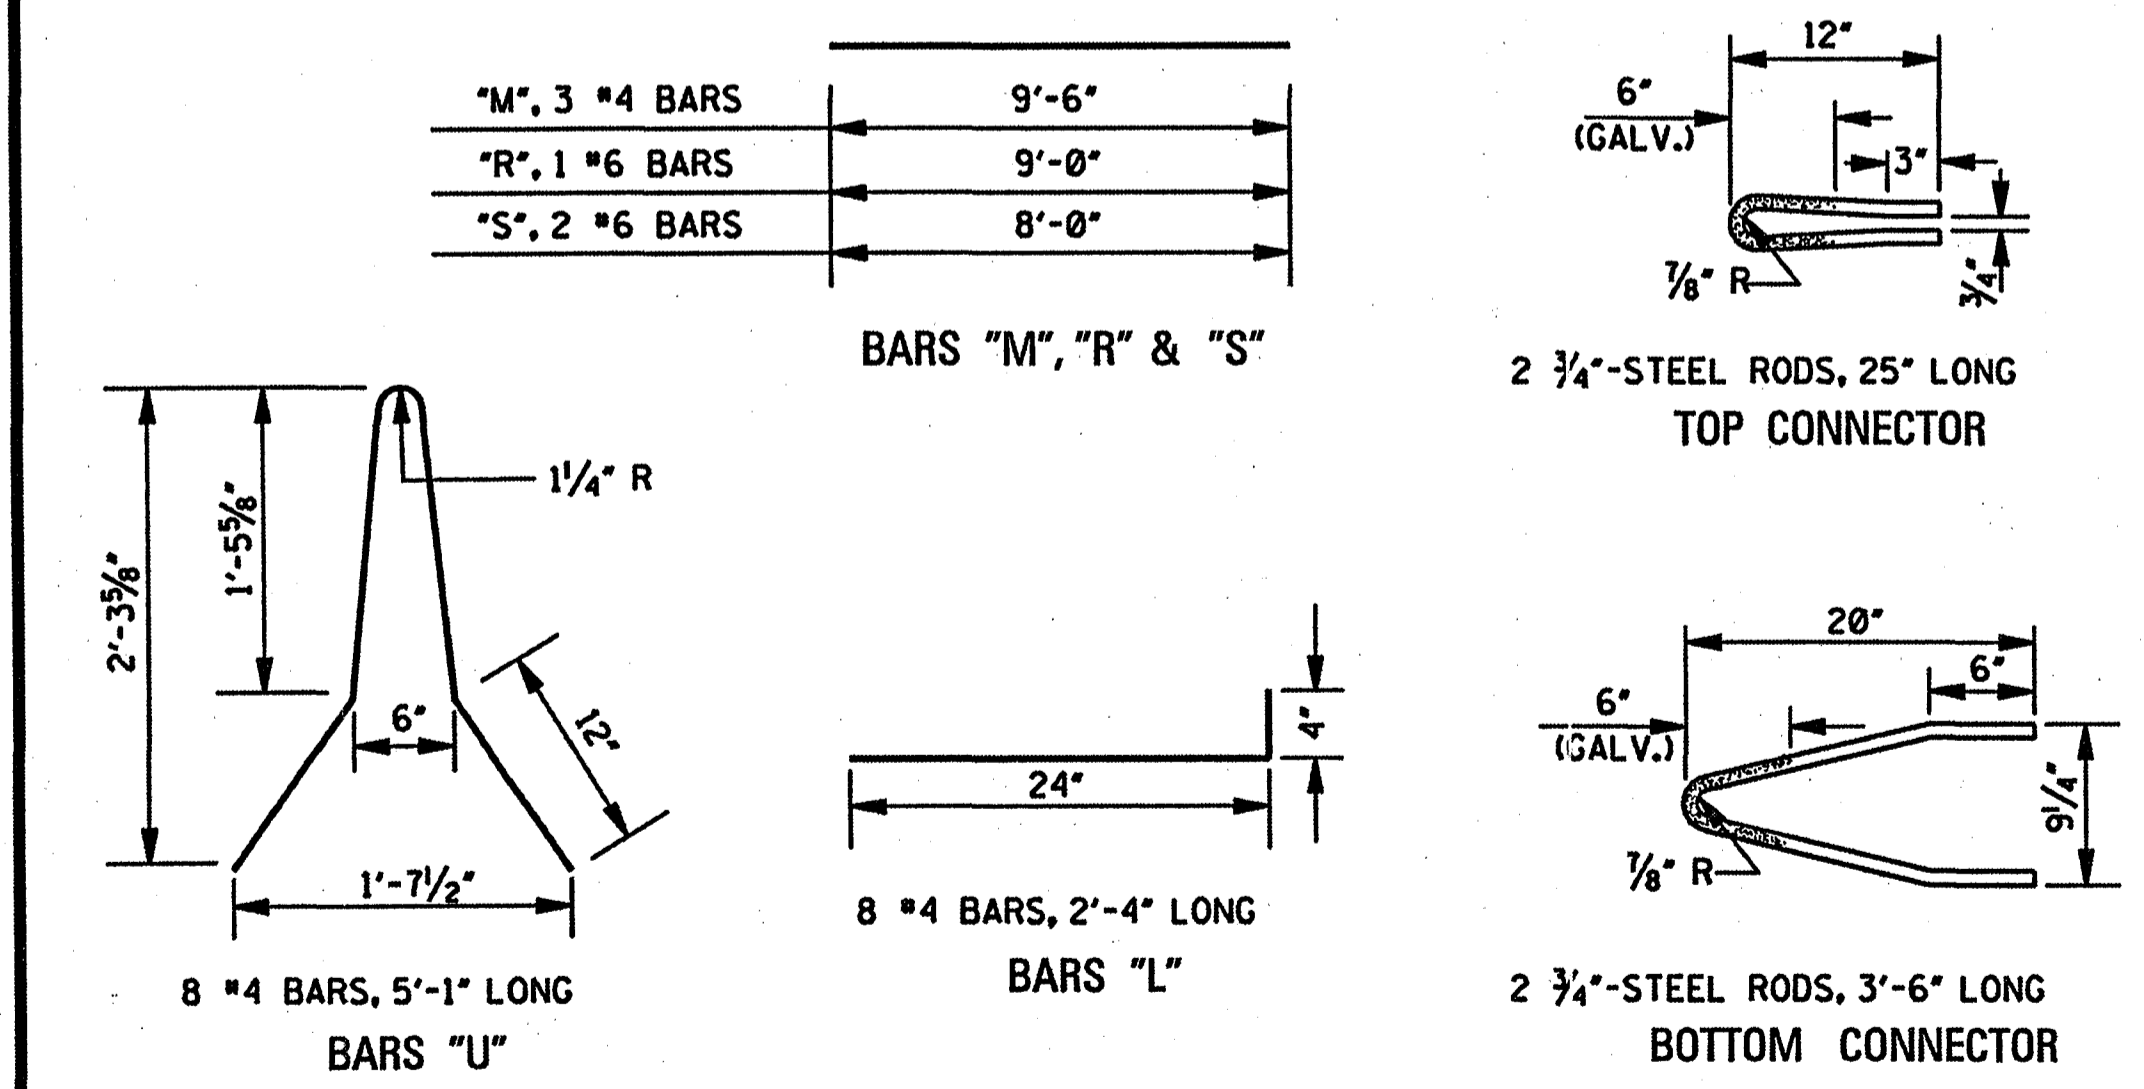

**BAR AND ROD DETAILS**

NOTE: WHERE STEEL ROD GALVANIZATION IS SHOWN ABOVE, GALVANIZE AFTER BENDING.

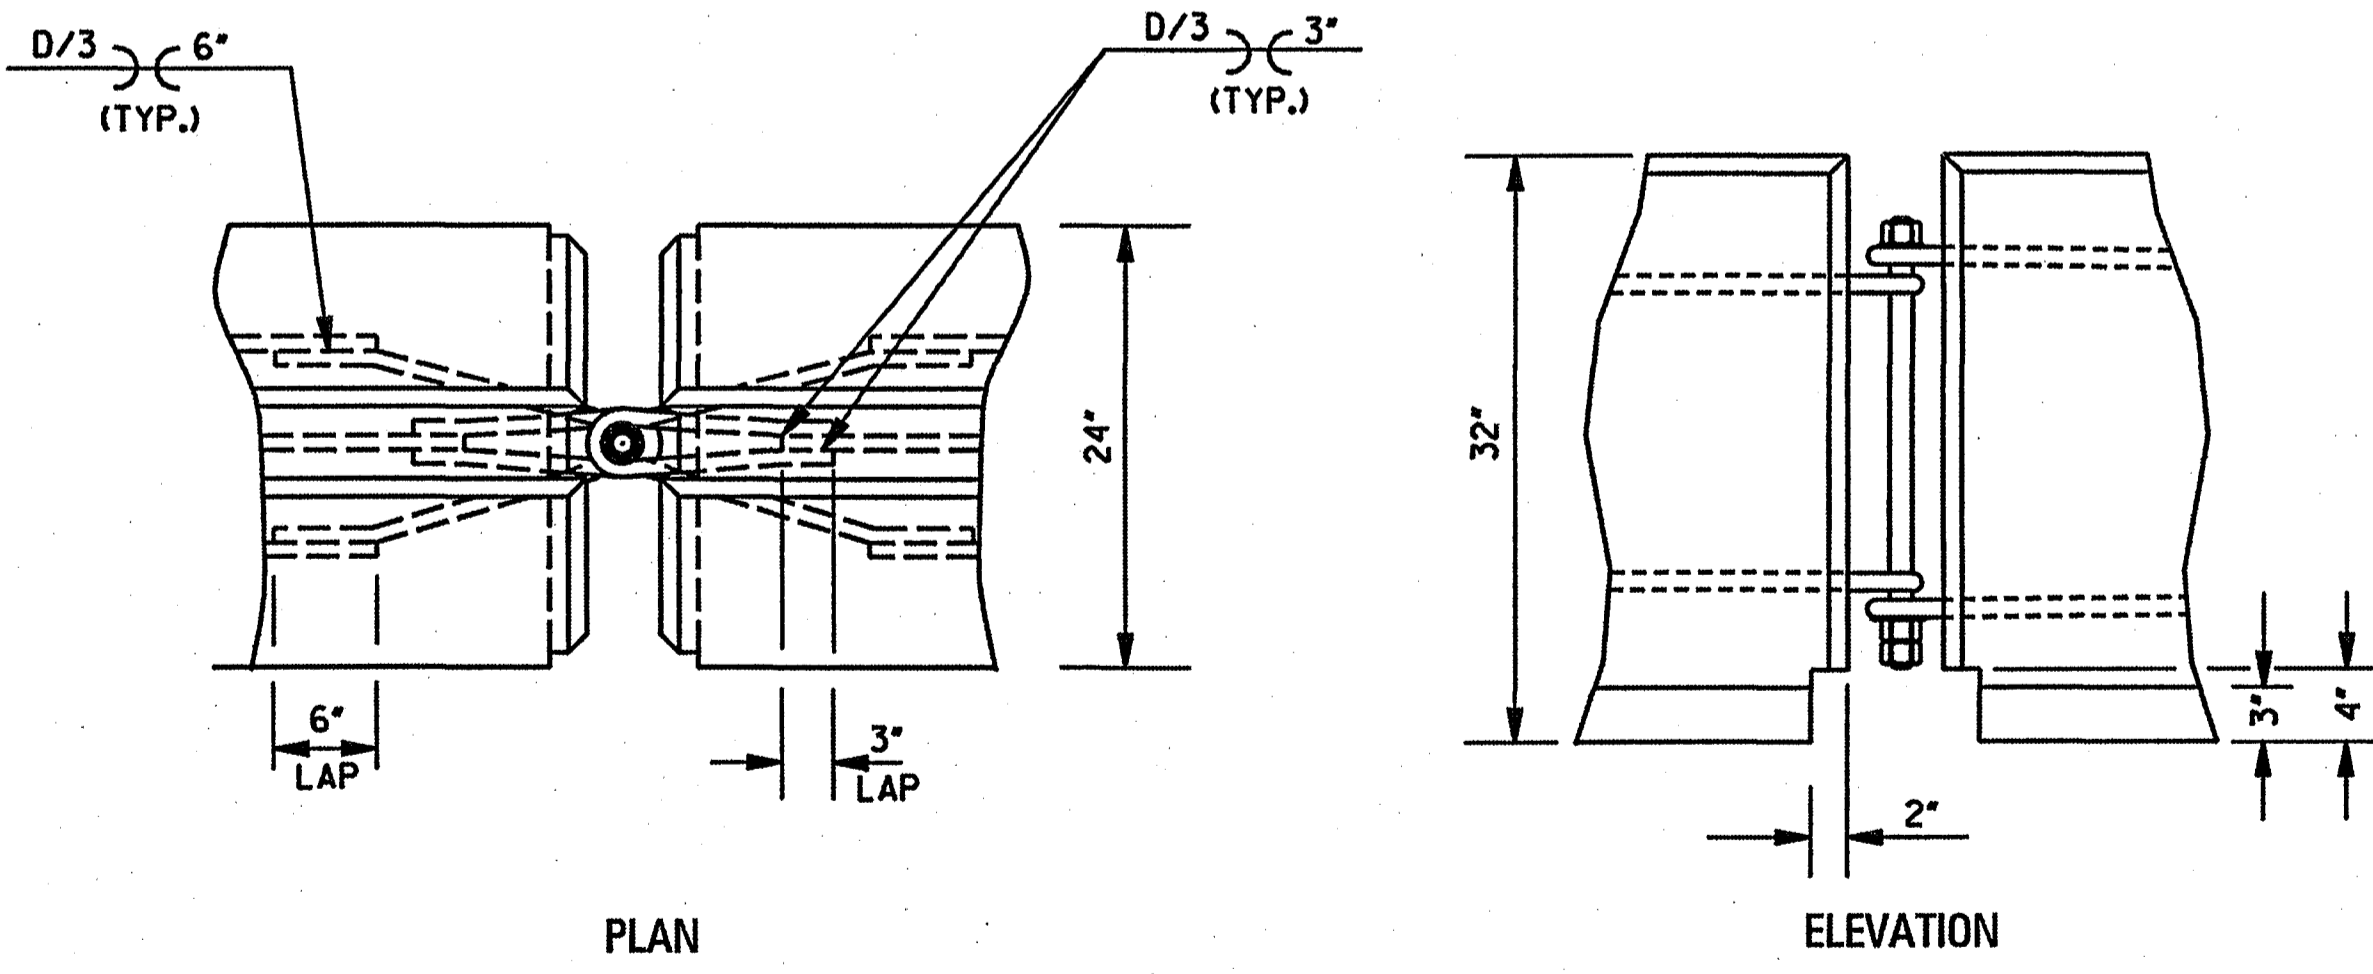

**BARRIER CONNECTION DETAIL**

MISSISSIPPI DEPARTMENT OF TRANSPORTATION ROADWAY DESIGN DIVISION STANDARD PLAN		
<b>MEDIAN BARRIER: CONCRETE (PRECAST)</b>		
DATE	ISSUE DATE: OCTOBER 1, 1998	WORKING NUMBER MB-2A SHEET NUMBER 205

SIGN NUMBER	R1-1	R1-101	R1-2	R1-102	R2-1	R2-101	R2-102	R2-104	R3-1	R3-2	R3-3	R3-4	R3-5	R4-103
ALUMINUM (6061-T6) SIGN BLANK THICKNESS	0.080"	0.125"	0.125"	0.125"	0.080"	0.125"	0.125"	0.125"	0.080"	0.080"	0.080"	0.080"	0.080"	0.125"
LEGEND														
LETTER & NUMERAL SERIES	12" SERIES "C"	16" SERIES "C"	3" SERIES "C"	5" SERIES "C"	4" SERIES "E"	8" SERIES "E"	8" SERIES "D"	8" SERIES "C"	8" SERIES "C"	8" SERIES "C"	6" SERIES "D"	6" SERIES "D"	6" SERIES "D"	8" SERIES "D"
WIDTH OF BORDER INSIDE	3/8" WHITE	1/4" WHITE	5/8" RED	1/2" RED	3/8" BLACK	1/4" BLACK	1/4" BLACK	1/4" BLACK	1/4" BLACK	1/4" BLACK	3/8" BLACK	3/8" BLACK	3/8" BLACK	1/4" BLACK
WIDTH OF BORDER OUTSIDE	3/8" WHITE	1/4" WHITE	3/8" WHITE	1/2" WHITE	3/8" WHITE	3/4" WHITE	3/4" WHITE	3/4" WHITE	3/4" WHITE	3/4" WHITE	3/8" WHITE	3/8" WHITE	3/8" WHITE	3/4" WHITE
SIZE (WIDTH X HEIGHT)	36" OCTAGON	48" OCTAGON	36" EQUIL. TRIANGLE	60" EQUIL. TRIANGLE	24" X 30"	48" X 60"	48" X 48"	48" X 48"	30" X 30"	30" X 30"	24" X 24"	30" X 30"	30" X 36"	48" X 60"
COLORS COPY	WHITE	WHITE	RED	RED	BLACK	BLACK	BLACK	BLACK	BLACK & RED	BLACK & RED	BLACK	BLACK & RED	BLACK	BLACK
COLORS BACKGROUND	RED	RED	WHITE	WHITE	WHITE	WHITE	WHITE	WHITE	WHITE	WHITE	WHITE	WHITE	WHITE	WHITE
REFLECTORIZATION	ALL	ALL	ALL	ALL	B'GROUND	B'GROUND	BACKGROUND	BACKGROUND	BACKGROUND, CIRCLE, & DIAGONAL	BACKGROUND, CIRCLE, & DIAGONAL	BACKGROUND	BACKGROUND, CIRCLE, & DIAGONAL	BACKGROUND	BACKGROUND
NUMBER OF POSTS FOR MOUNTING	1	1	1	1	1	1	---	---	1	1	1	1	1	1
NUMBER OF HOLES TO BE PUNCHED (3/8" DIA.)	2	4	2	4	2	6	4	4	2	2	2	2	2	6
PUNCHING DISTANCE FROM EACH VERTICAL EDGE	18" (VERT. CENTER)	10"	18" (VERT. CENTER)	20"	12" (VERT. CENTER)	10"	10"	10"	15" (VERT. CENTER)	15" (VERT. CENTER)	12" (VERT. CENTER)	15" (VERT. CENTER)	15" (VERT. CENTER)	10"
PUNCHING DISTANCE FROM TOP EDGE	3"; 33"	10"; 38"	2"; 26"	3"; 27"	3"; 27"	4"; 30"; 56"	4"; 44"	4"; 44"	3"; 27"	3"; 27"	3"; 21"	3"; 27"	3"; 33"	4"; 30"; 56"


SIGN NUMBER	R4-7	R4-107	R4-8	R5-1	R5-101	R5-1a	R6-1L, R6-1R	R6-2L, R6-2R	R8-104	R11-101
ALUMINUM (6061-T6) SIGN BLANK THICKNESS	0.080"	0.125"	0.080"	0.080"	0.125"	0.125"	0.125"	0.080"	0.125"	0.125"
LEGEND										
LETTER & NUMERAL SERIES	R=1/2"	R=2/4"	R=1/2"	R=1/8"	R=3"	R=2/4"	R=1/2"	R=1/2"	R=2/4"	R=3"
WIDTH OF BORDER INSIDE	3/8" BLACK	3/8" BLACK	3/8" BLACK	1" WHITE	1" WHITE	1" WHITE	1/2" WHITE	3/8" BLACK	3/8" BLACK	1/4" BLACK
WIDTH OF BORDER OUTSIDE	3/8" WHITE	3/8" WHITE	3/8" WHITE	WHITE OUTSIDE BORDER	WHITE OUTSIDE BORDER	WHITE OUTSIDE BORDER	1/2" WHITE	3/8" WHITE	3/8" WHITE	1/4" WHITE
SIZE (WIDTH X HEIGHT)	24" X 30"	36" X 48"	24" X 30"	30" X 30"	42" X 42"	42" X 36"	36" X 12"	18" X 24"	48" X 36"	48" X 60"
COLORS COPY	BLACK	BLACK	BLACK	WHITE	WHITE	WHITE	BLACK (WHITE ARROW)	BLACK	BLACK	BLACK
COLORS BACKGROUND	WHITE	WHITE	WHITE	RED	RED	RED	BLACK	WHITE	WHITE	WHITE
REFLECTORIZATION	BACKGROUND	BACKGROUND	BACKGROUND	ALL	ALL	ALL	ARROW & BORDER	BACKGROUND	BACKGROUND	BACKGROUND
NUMBER OF POSTS FOR MOUNTING	1	1	1	1	1	1	1	1	2	1
NUMBER OF HOLES TO BE PUNCHED (3/8" DIA.)	2	4	2	2	4	4	2	2	4	6
PUNCHING DISTANCE FROM EACH VERTICAL EDGE	12" (VERT. CENTER)	5"	12" (VERT. CENTER)	15" (VERT. CENTER)	8"	8"	18" (VERT. CENTER)	9" (VERT. CENTER)	10"	10"
PUNCHING DISTANCE FROM TOP EDGE	3"; 27"	4"; 44"	3"; 27"	3"; 27"	4"; 38"	3"; 33"	1/2"; 10/2"	3"; 21"	6"; 30"	4"; 30"; 56"

GENERAL NOTES:

















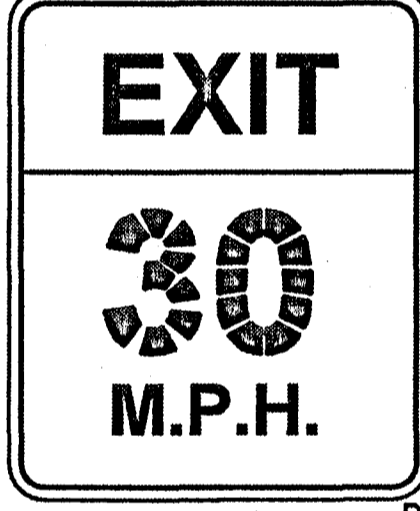
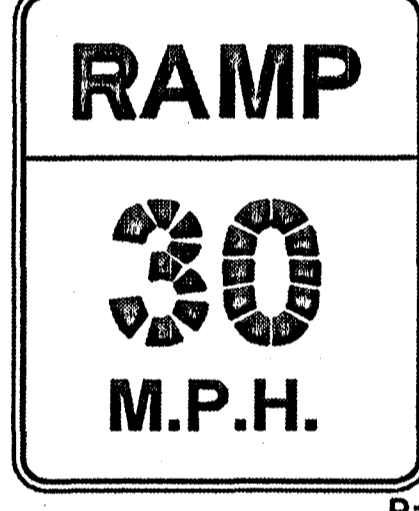
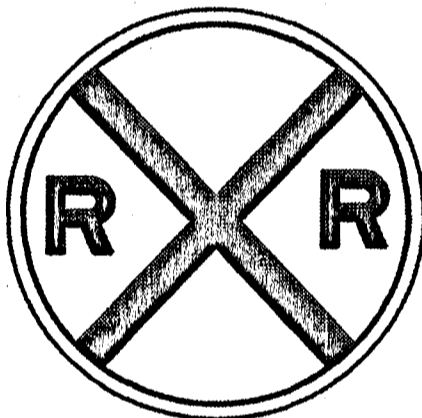
- THE QUANTITIES LISTED ON THE SUMMARY OF QUANTITIES SHEET FOR THE SIGNS SHOWN ON THIS SHEET WILL BE USED AS THE BASIS FOR FINAL PAYMENT, EXCEPT WHERE SIGNS ARE MODIFIED FROM THAT SHOWN.
- THE SPEED LIMITS REQUIRED ON SIGNS R2-1 AND R2-101 WILL BE SHOWN ON INDIVIDUAL PLAN SHEETS.

BY	MISSISSIPPI DEPARTMENT OF TRANSPORTATION ROADWAY DESIGN DIVISION STANDARD PLAN
REVISION	
DATE	ISSUE DATE: OCTOBER 1, 1998

**STANDARD  
ROADSIDE SIGNS**



WORKING NUMBER  
SN-3A  
SHEET NUMBER  
223

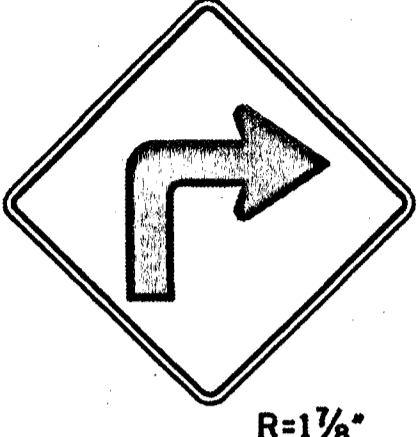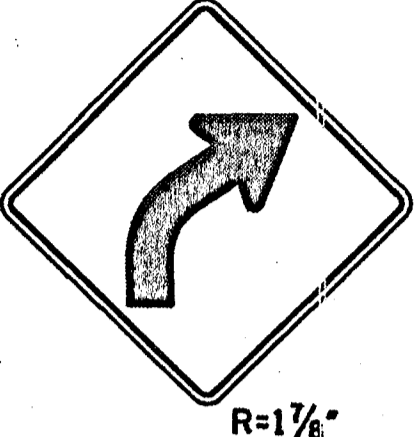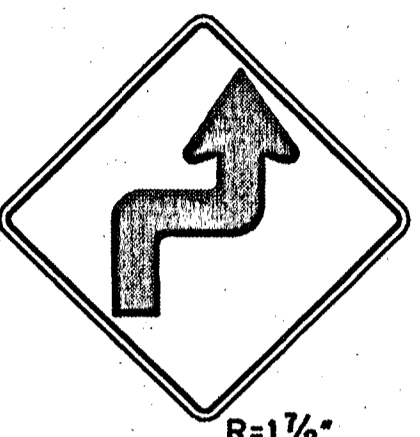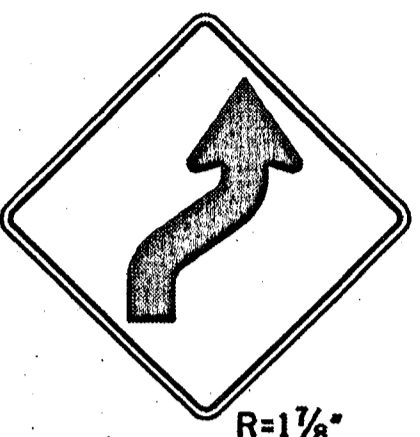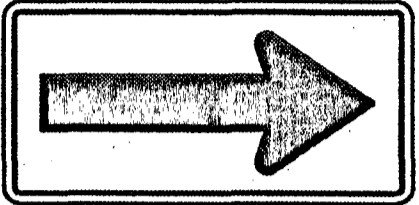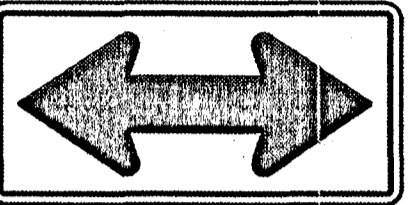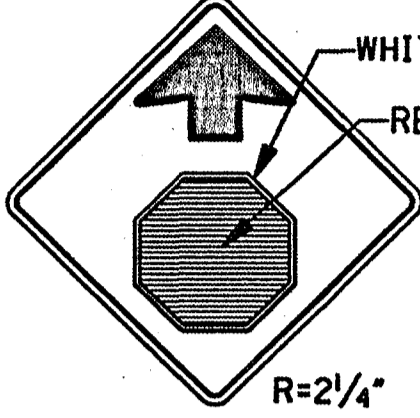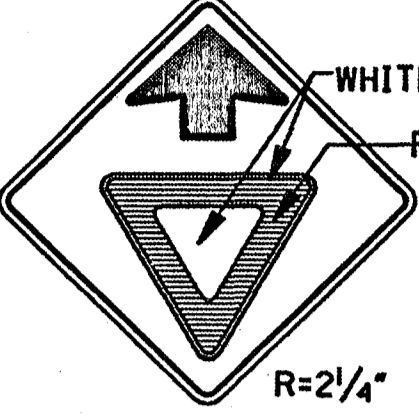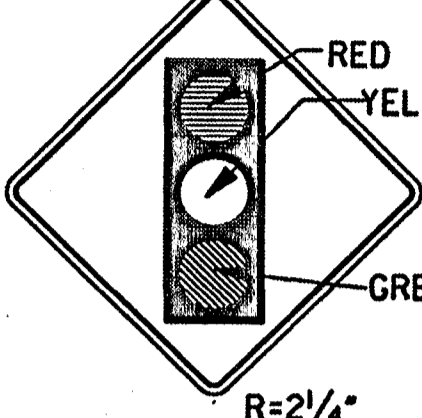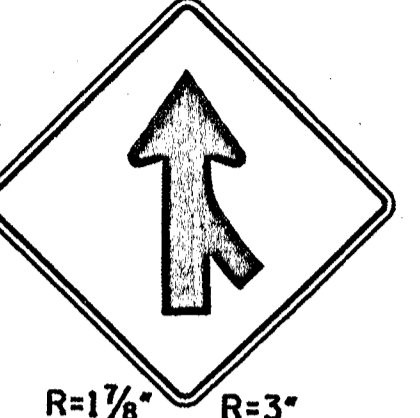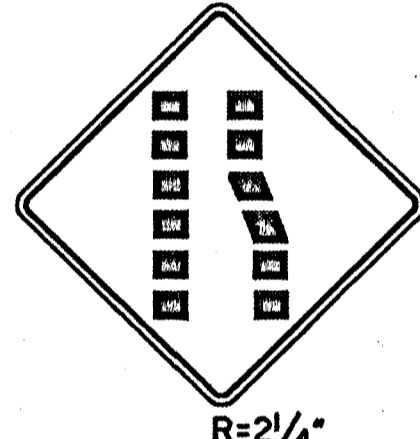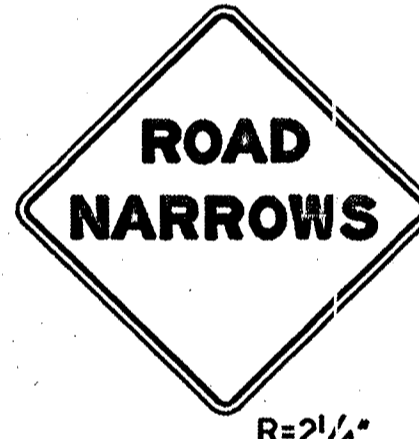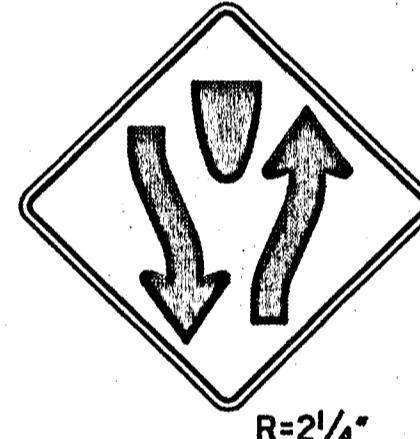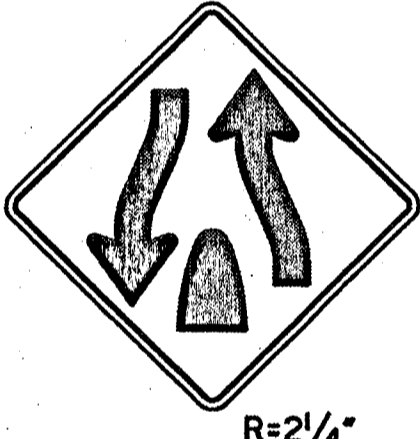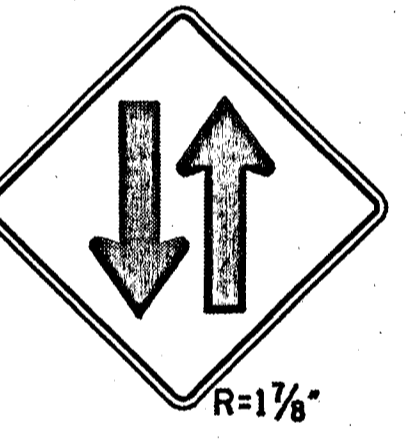
SIGN NUMBER	W1-1L W1-1R	W1-2L W1-2R	W1-3L W1-3R	W1-4L W1-4R	W1-6L W1-6R	W1-7	W3-1a	W3-2a	W3-3	W4-1L W4-1R	W4-101L W4-101R
ALUMINUM (6061-T6) SIGN BLANK THICKNESS	0.125"	0.125"	0.125"	0.125"	0.125"	0.125"	0.125"	0.125"	0.125"	0.125"	0.125"
LEGEND	 R=1 1/8"	 R=1 1/8"	 R=1 1/8"	 R=1 1/8"	 R=1 1/8"	 R=1 1/8"	 R=2 1/4"	 R=2 1/4"	 R=2 1/4"	 R=1 1/8" R=3"	
LETTER & NUMERAL SERIES											
WIDTH OF BORDER INSIDE	3/4" BLACK	3/4" BLACK	3/4" BLACK	3/4" BLACK	3/4" BLACK	3/4" BLACK	3/4" BLACK	3/4" BLACK	3/4" BLACK	3/4" BLACK	1/4" BLACK
WIDTH OF BORDER OUTSIDE	1/2" YELLOW	1/2" YELLOW	1/2" YELLOW	1/2" YELLOW	1/2" YELLOW	1/2" YELLOW	5/8" BLACK 5/8" YELLOW	5/8" BLACK 5/8" YELLOW	5/8" BLACK 5/8" YELLOW	1/2" YELLOW	3/4" YELLOW
SIZE (WIDTH X HEIGHT)	30" X 30"	30" X 30"	30" X 30"	30" X 30"	48" X 24"	48" X 24"	36" X 36"	36" X 36"	36" X 36"	30" X 30"	48" X 48"
COLORS COPY	BLACK	BLACK	BLACK	BLACK	BLACK	BLACK	BLACK	BLACK	BLACK	BLACK	BLACK
COLORS BACKGROUND	YELLOW	YELLOW	YELLOW	YELLOW	YELLOW	YELLOW	YELLOW	YELLOW	YELLOW	YELLOW	YELLOW
REFLECTORIZATION	BACKGROUND	BACKGROUND	BACKGROUND	BACKGROUND	BACKGROUND	BACKGROUND	BACKGROUND & SYMBOL	BACKGROUND & SYMBOL	BACKGROUND & "LIGHTS"	BACKGROUND	BACKGROUND
NUMBER OF POSTS FOR MOUNTING	1	1	1	1	2	2	1	1	1	1	1
NUMBER OF HOLES TO BE PUNCHED (3/8" DIA.)	2	2	2	2	4	4	2	2	2	2	4
PUNCHING DISTANCE FROM EACH VERT. EDGE	VERT. CENTER	VERT. CENTER	VERT. CENTER	VERT. CENTER	6"	6"	VERT. CENTER	VERT. CENTER	VERT. CENTER	VERT. CENTER	14 1/2" FROM VERT. CENTER
PUNCHING DISTANCE FROM TOP EDGE	15" FROM HORIZ. CENTER	15" FROM HORIZ. CENTER	15" FROM HORIZ. CENTER	15" FROM HORIZ. CENTER	3"; 21"	3"; 21"	18" FROM HORIZ. CENTER	18" FROM HORIZ. CENTER	18" FROM HORIZ. CENTER	15" FROM HORIZ. CENTER	14 1/2" FROM HORIZ. CENTER
SIGN NUMBER	W4-2	W5-1	W6-1	W6-2	W6-3	W13-1	W13-2	W13-3	W10-1	W10-101	
ALUMINUM (6061-T6) SIGN BLANK THICKNESS	0.125"	0.125"	0.125"	0.125"	0.125"	0.080"	0.125"	0.125"	0.125"	0.125"	
LEGEND	 R=2 1/4"	 R=2 1/4"	 R=2 1/4"	 R=2 1/4"	 R=1 1/8"	 R=1 1/2"	 R=3"	 R=3"			
LETTER & NUMERAL SERIES		6" SERIES "D"				8" SERIES "E" 3" SERIES "E"	8" SERIES "E" 16" SERIES "E" 6" SERIES "E" (SEE NOTE)	8" SERIES "E" 16" SERIES "E" 6" SERIES "E" (SEE NOTE)	8" SERIES "E" 10" SERIES "E"		
WIDTH OF BORDER INSIDE	3/8" BLACK	3/8" BLACK	3/8" BLACK	3/8" BLACK	3/8" BLACK	3/8" BLACK	1 1/4" BLACK	1 1/4" BLACK	3/4" BLACK	1 1/4" BLACK	
WIDTH OF BORDER OUTSIDE	5/8" YELLOW	5/8" YELLOW	5/8" YELLOW	5/8" YELLOW	5/8" YELLOW	5/8" YELLOW	3/4" BLACK 3/4" YELLOW	3/4" BLACK 3/4" YELLOW	3/4" BLACK 3/4" YELLOW	3/4" BLACK 3/4" YELLOW	
SIZE (WIDTH X HEIGHT)	36" X 36"	36" X 36"	36" X 36"	36" X 36"	30" X 30"	18" X 18"	48" X 60"	48" X 60"	36" DIAMETER	48" DIAMETER	
COLORS COPY	BLACK	BLACK	BLACK	BLACK	BLACK	BLACK	BLACK	BLACK	BLACK	BLACK	
COLORS BACKGROUND	YELLOW	YELLOW	YELLOW	YELLOW	YELLOW	YELLOW	YELLOW	YELLOW	YELLOW	YELLOW	
REFLECTORIZATION	BACKGROUND	BACKGROUND	BACKGROUND	BACKGROUND	BACKGROUND	BACKGROUND	BACKGROUND	BACKGROUND	BACKGROUND	BACKGROUND	
NUMBER OF POSTS FOR MOUNTING	1	1	1	1	Δ 1	1	1	1	1	1	
NUMBER OF HOLES TO BE PUNCHED (3/8" DIA.)	2	2	2	2	2	2	6	6	2	4	
PUNCHING DISTANCE FROM EACH VERT. EDGE	VERT. CENTER	VERT. CENTER	VERT. CENTER	VERT. CENTER	VERT. CENTER	9" (VERT. CENTER)	10"	10"	15"	15" (VERT. CENTER)	
PUNCHING DISTANCE FROM TOP EDGE	18" FROM HORIZ. CENTER	18" FROM HORIZ. CENTER	18" FROM HORIZ. CENTER	18" FROM HORIZ. CENTER	15" FROM HORIZ. CENTER	3"; 15"	4"; 30"; 56"	4"; 30"; 56"	3"; 33"	5"; 43"	

GENERAL NOTES:




- THE QUANTITIES LISTED ON THE SUMMARY OF QUANTITIES SHEET FOR THE SIGNS SHOWN ON THIS SHEET WILL BE USED AS THE BASIS FOR FINAL PAYMENT, EXCEPT WHERE SIGNS ARE MODIFIED FROM THAT SHOWN.
- SIGNS W13-2 AND W13-3- THE STROKE WIDTH OF THE LETTER AND NUMERALS SHALL BE WIDENED TO 20% OF THE LETTER OR NUMERAL HEIGHT.
- THE SPEEDS REQUIRED ON SIGNS W13-1, W13-2 AND W13-3 WILL BE SHOWN ON INDIVIDUAL PLAN SHEETS.

MISSISSIPPI DEPARTMENT OF TRANSPORTATION ROADWAY DESIGN DIVISION STANDARD PLAN	
<b>STANDARD ROADSIDE SIGNS</b>	
WORKING NUMBER SN-3B	SHEET NUMBER 224
ISSUE DATE: OCTOBER 1, 1998	




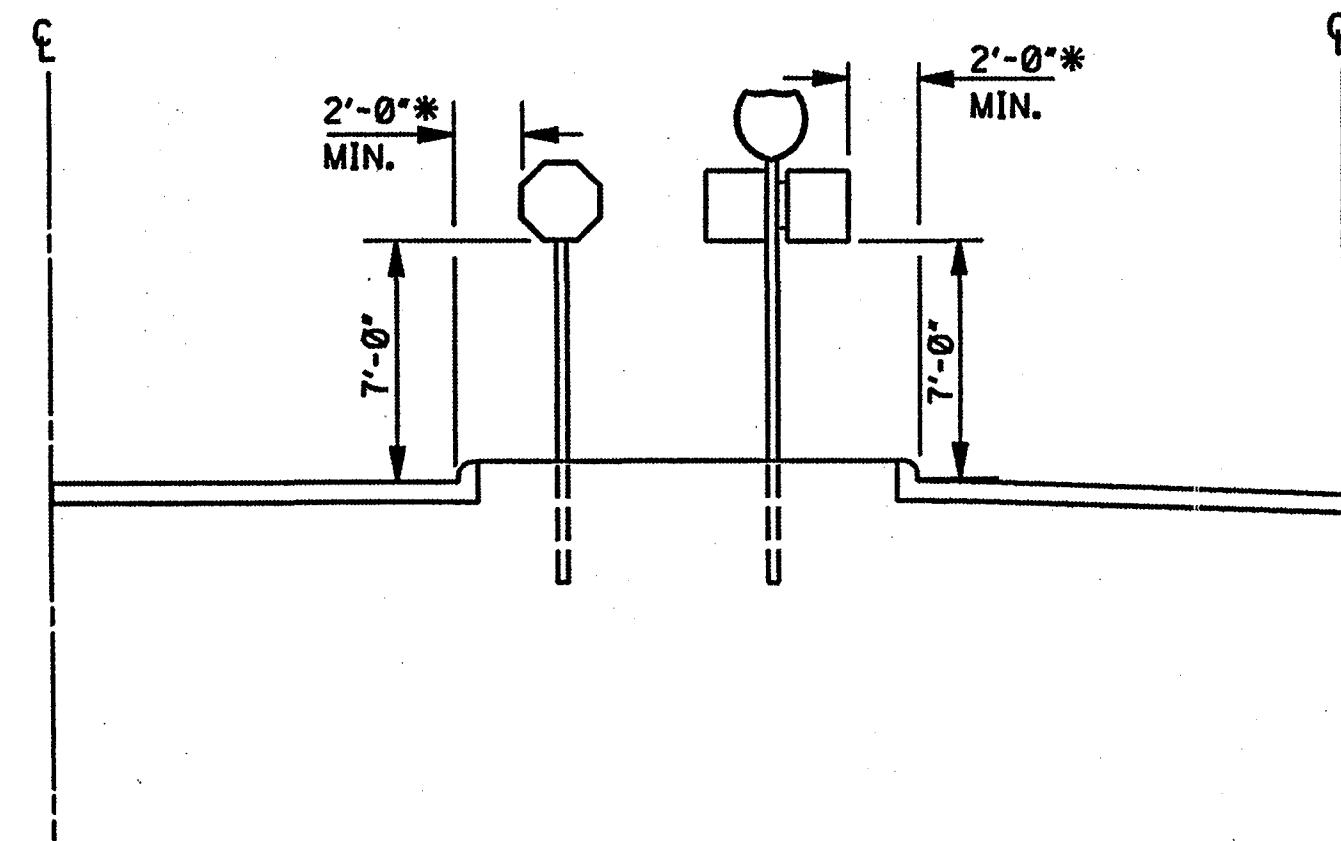


TYPICAL INSTALLATION IN ISLANDS OFF OF (OR ADJACENT TO) INTERSTATE MAIN FACILITY

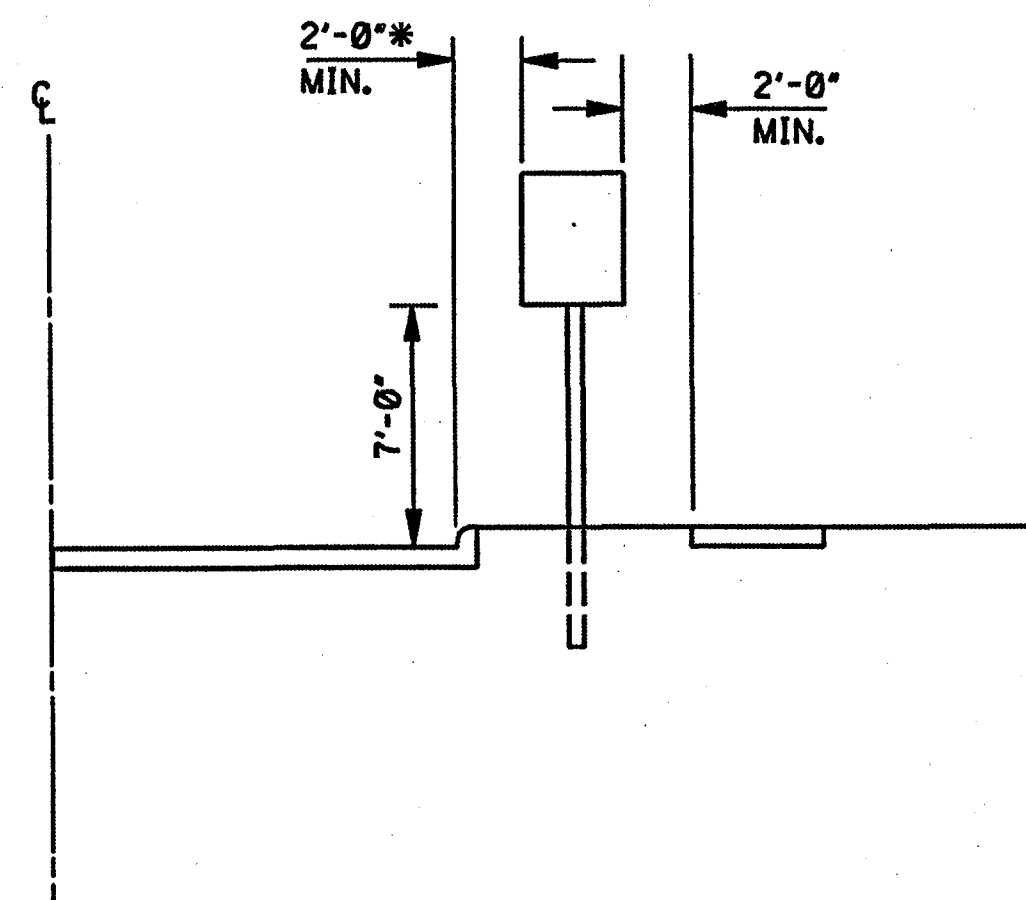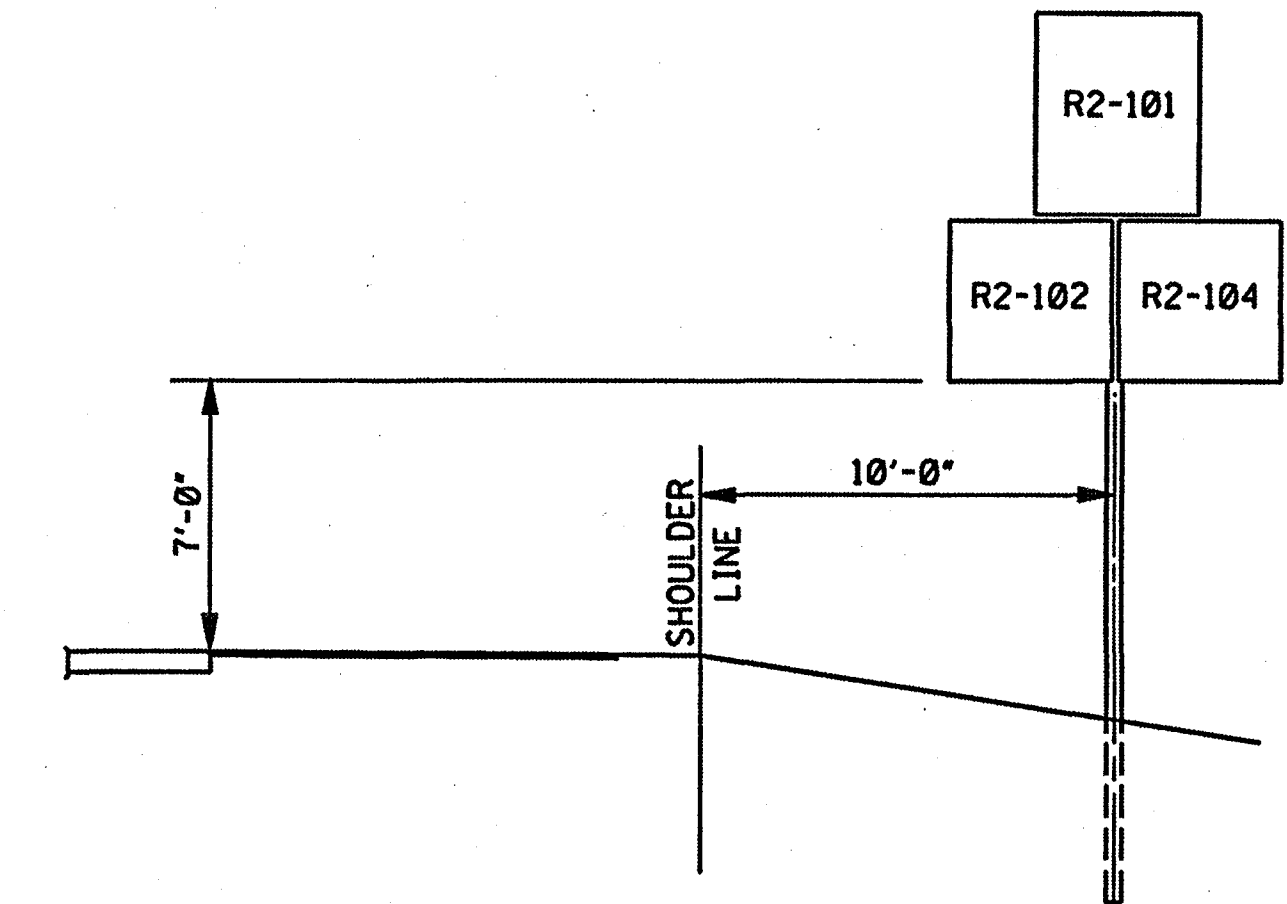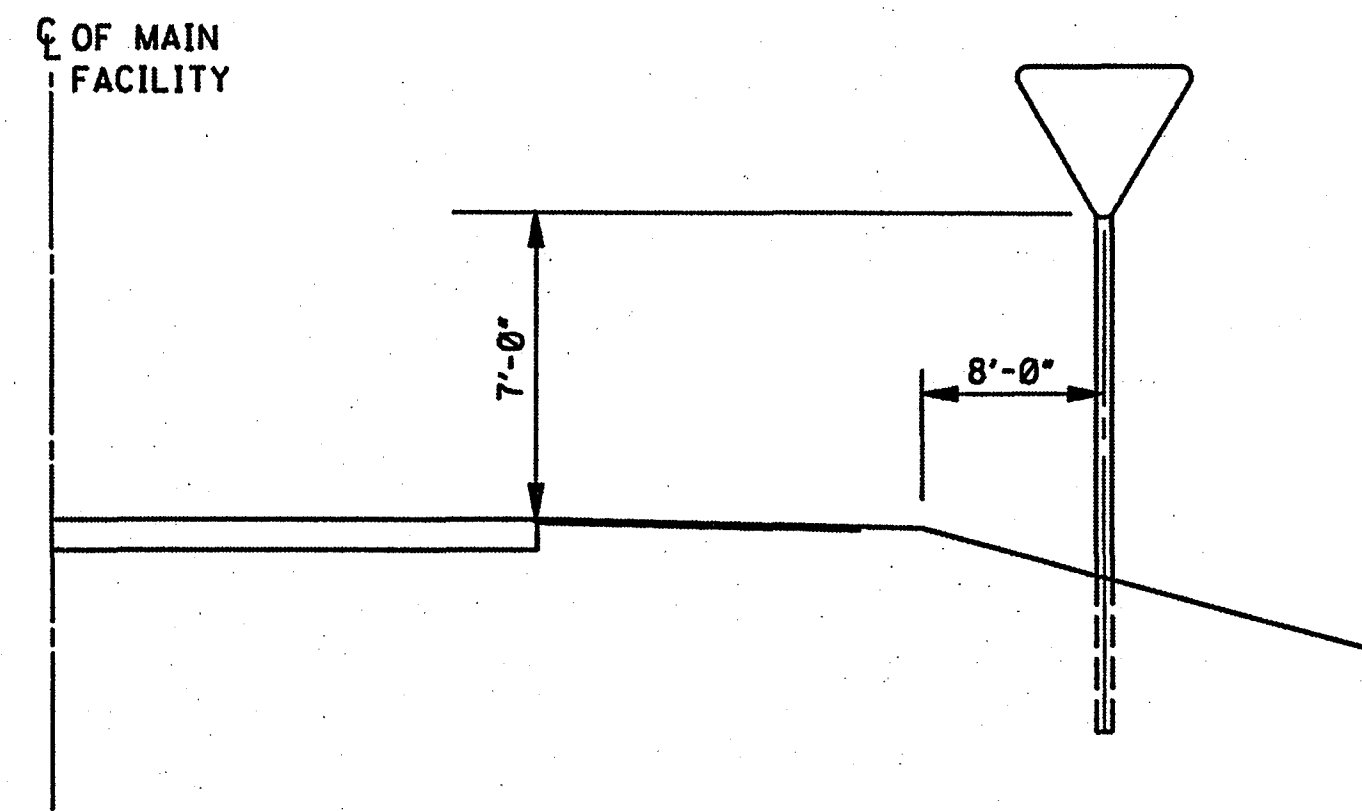


TYPICAL INSTALLATION ALONG FRONTAGE ROAD, RAMP OR STREET WHERE THERE IS NOT A USABLE SHOULDER





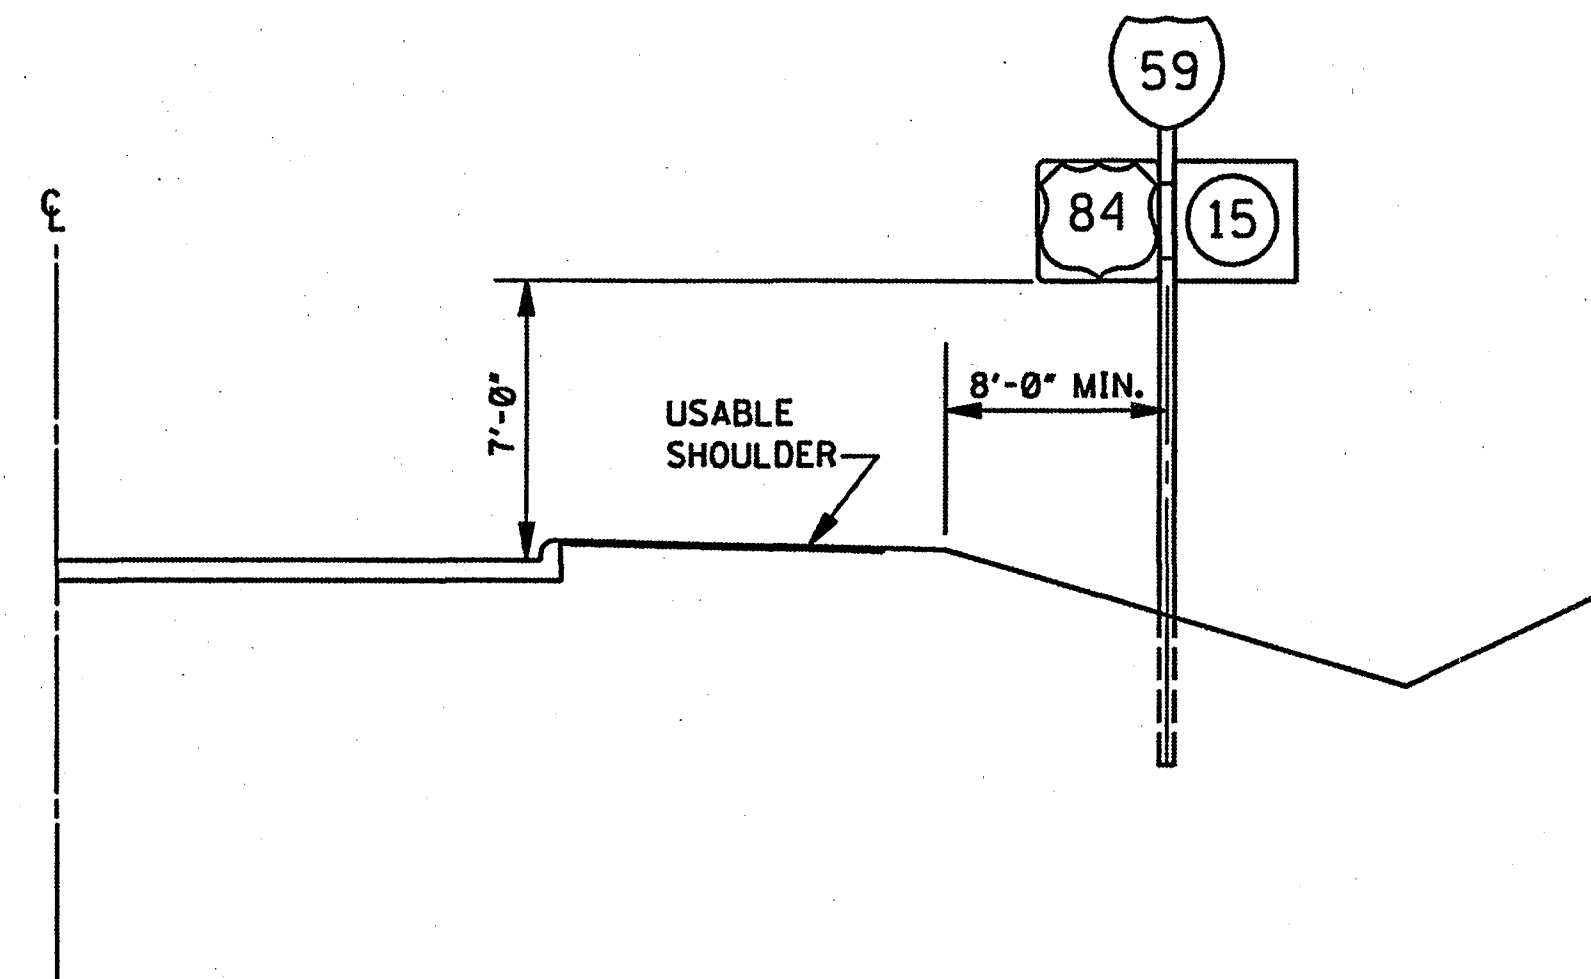


TYPICAL INSTALLATION ALONG THE INTERSTATE MAIN FACILITY AND ALONG RAMPS, FRONTAGE ROADS AND HIGHWAYS

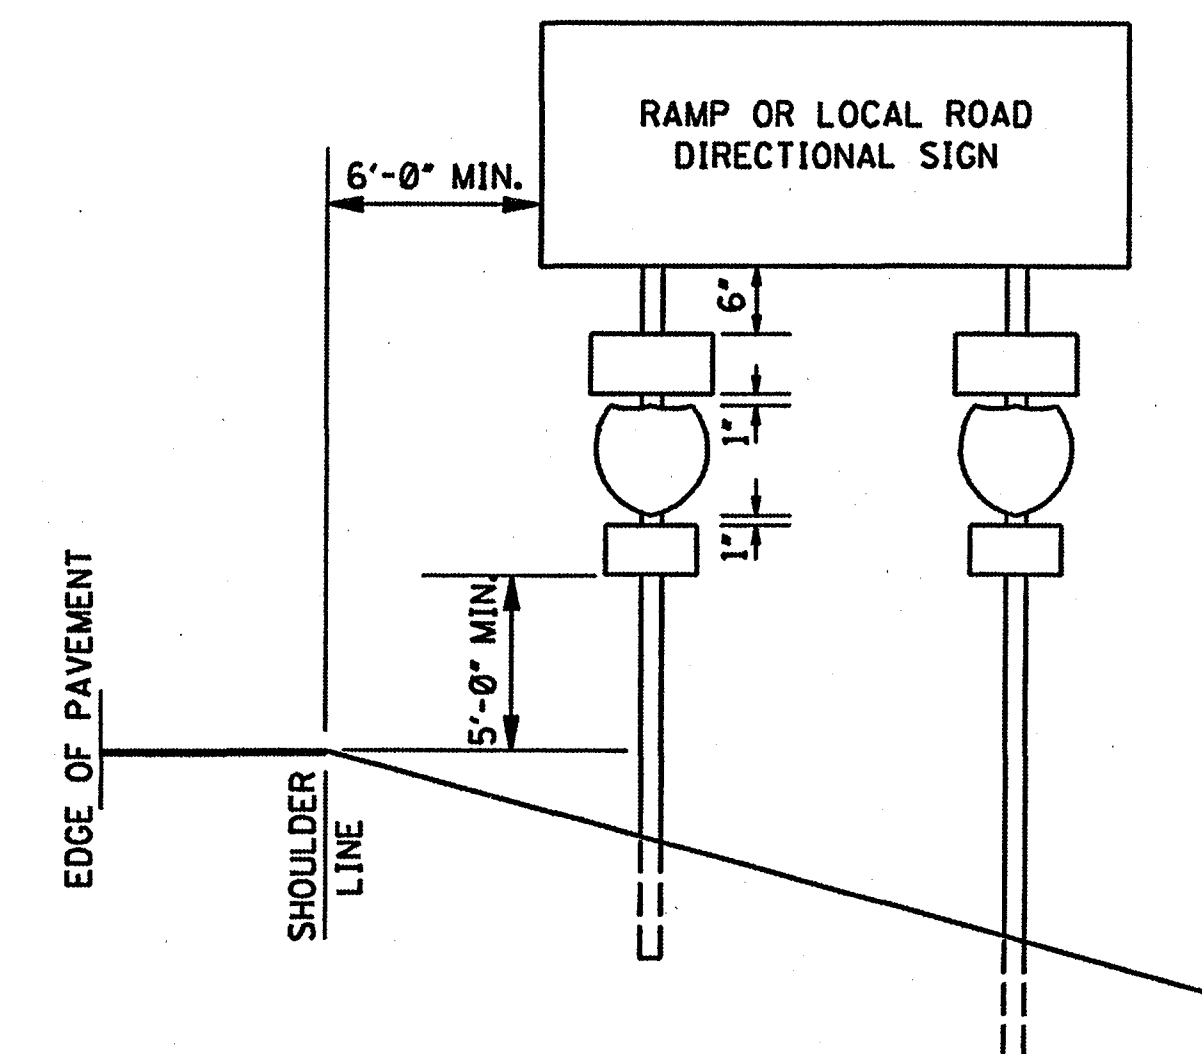


\* NOTE: THE 2'-0" MINIMUM OFFSET APPLIES ONLY TO STANDARD SIGNS MOUNTED ON U-SECTION POSTS. ALL STANDARD SIGNS MOUNTED ON PIPE WILL BE OFFSET A MINIMUM OF 4'-0". RAMP DESTINATION SIGNS WILL BE OFFSET 4'-0" FROM SHOULDERS.


BY		MISSISSIPPI DEPARTMENT OF TRANSPORTATION ROADWAY DESIGN DIVISION STANDARD PLAN	
REVISION		<p align="center"><b>STANDARD ROADSIDE SIGN ASSEMBLY AND INSTALLATION</b></p> 	
DATE			
ISSUE DATE:		OCTOBER 1, 1998	
		WORKING NUMBER SN-4	
		SHEET NUMBER 225	

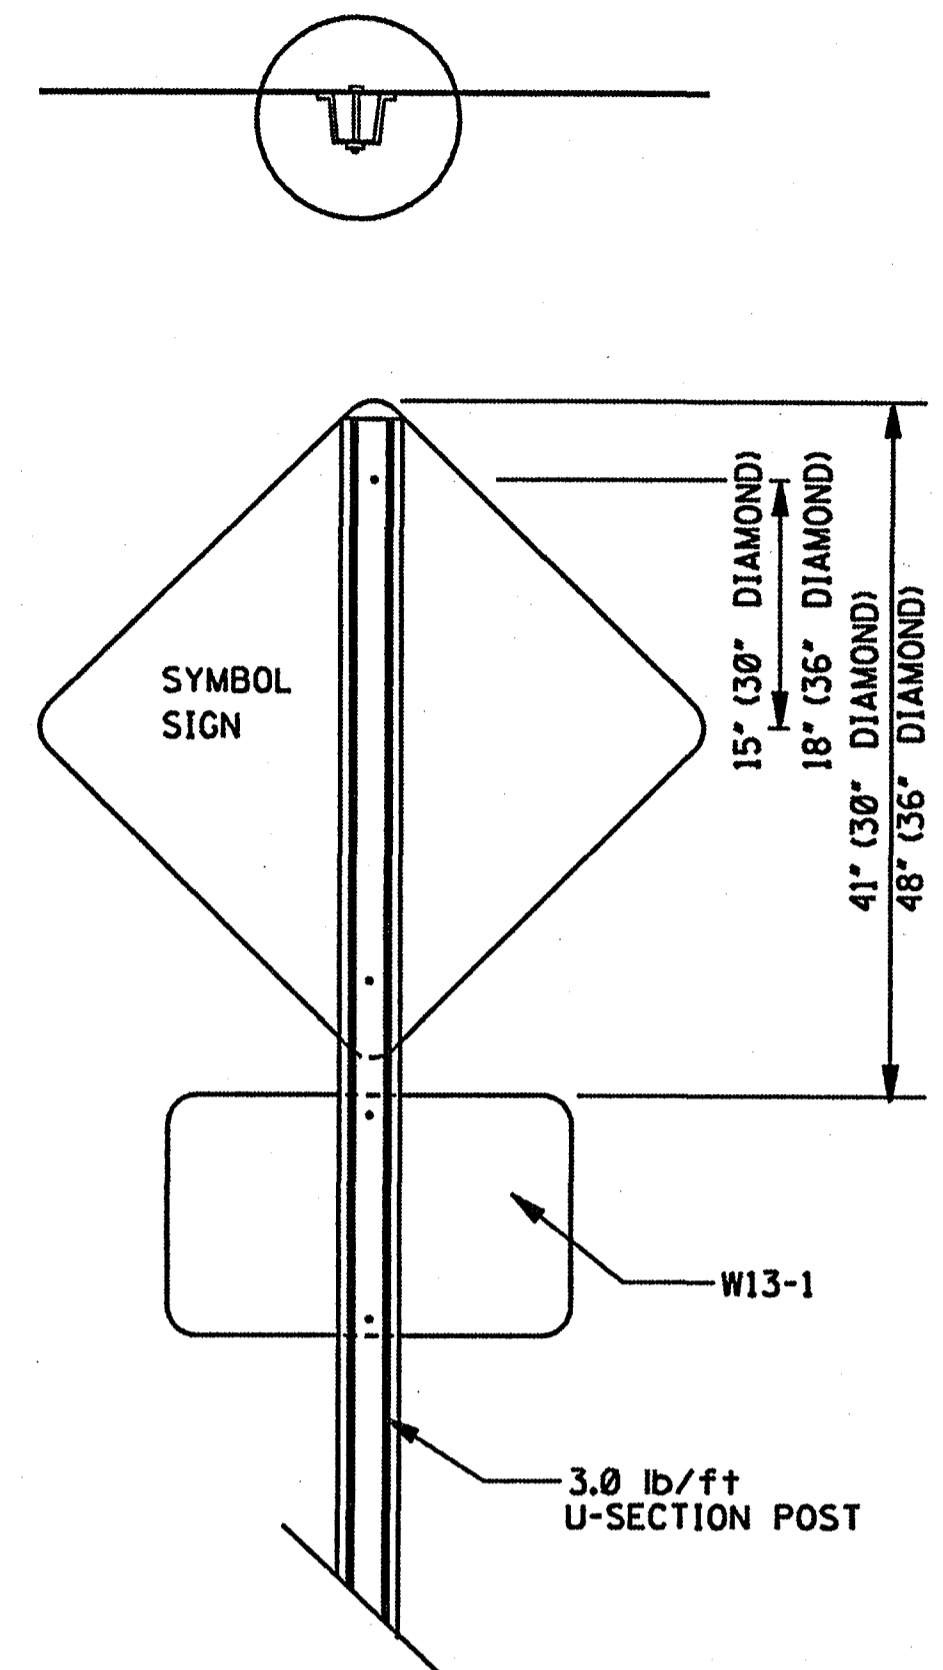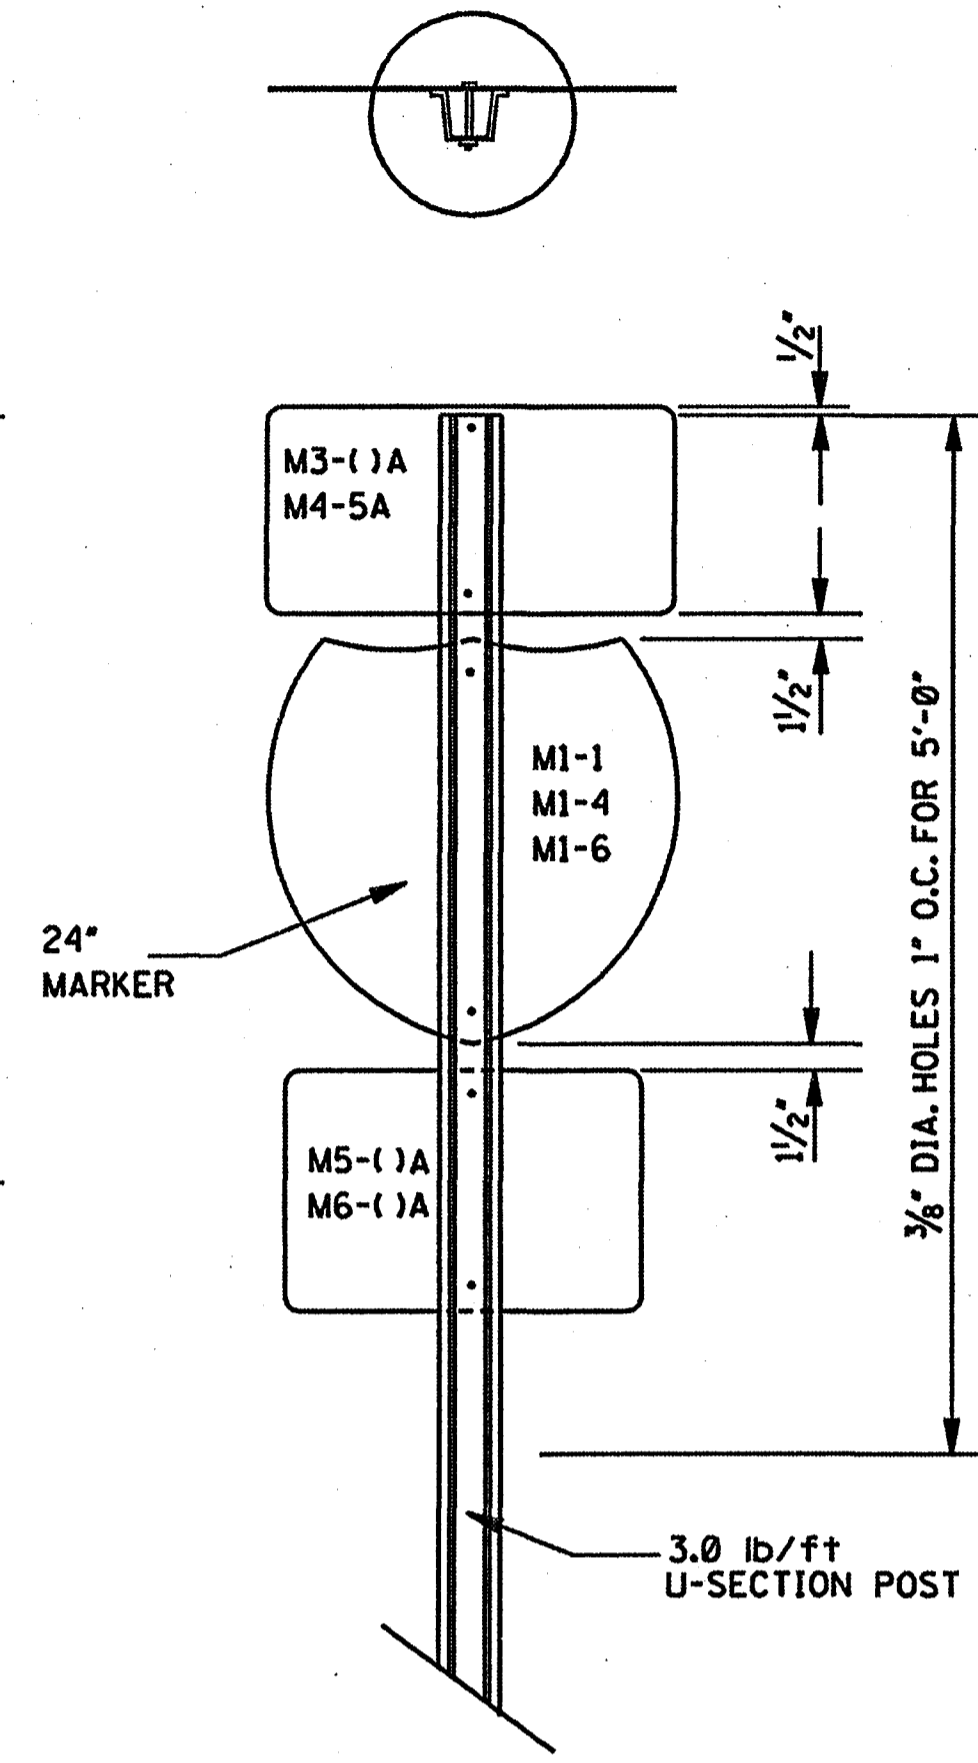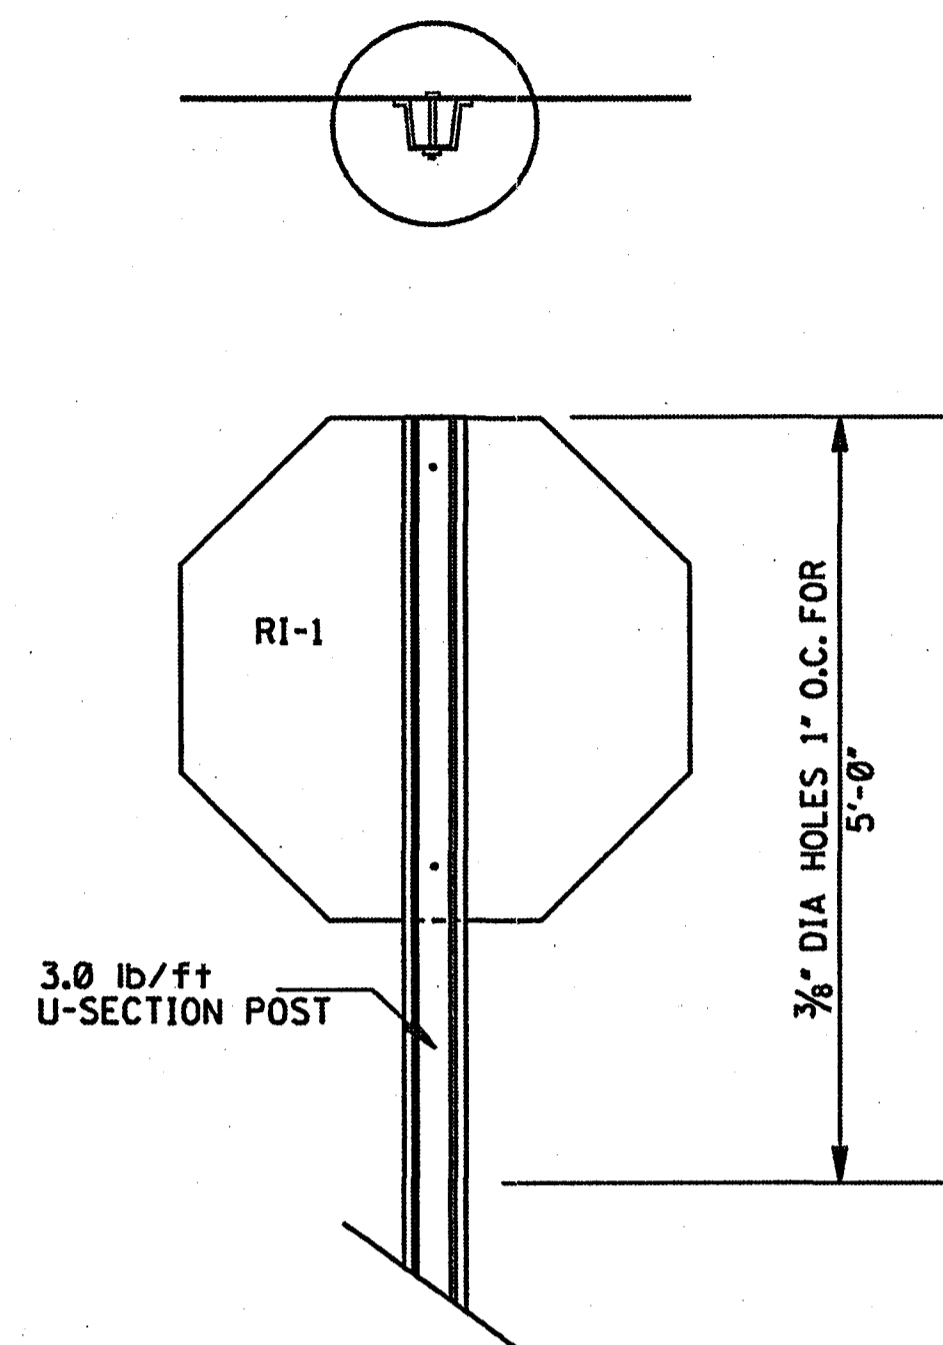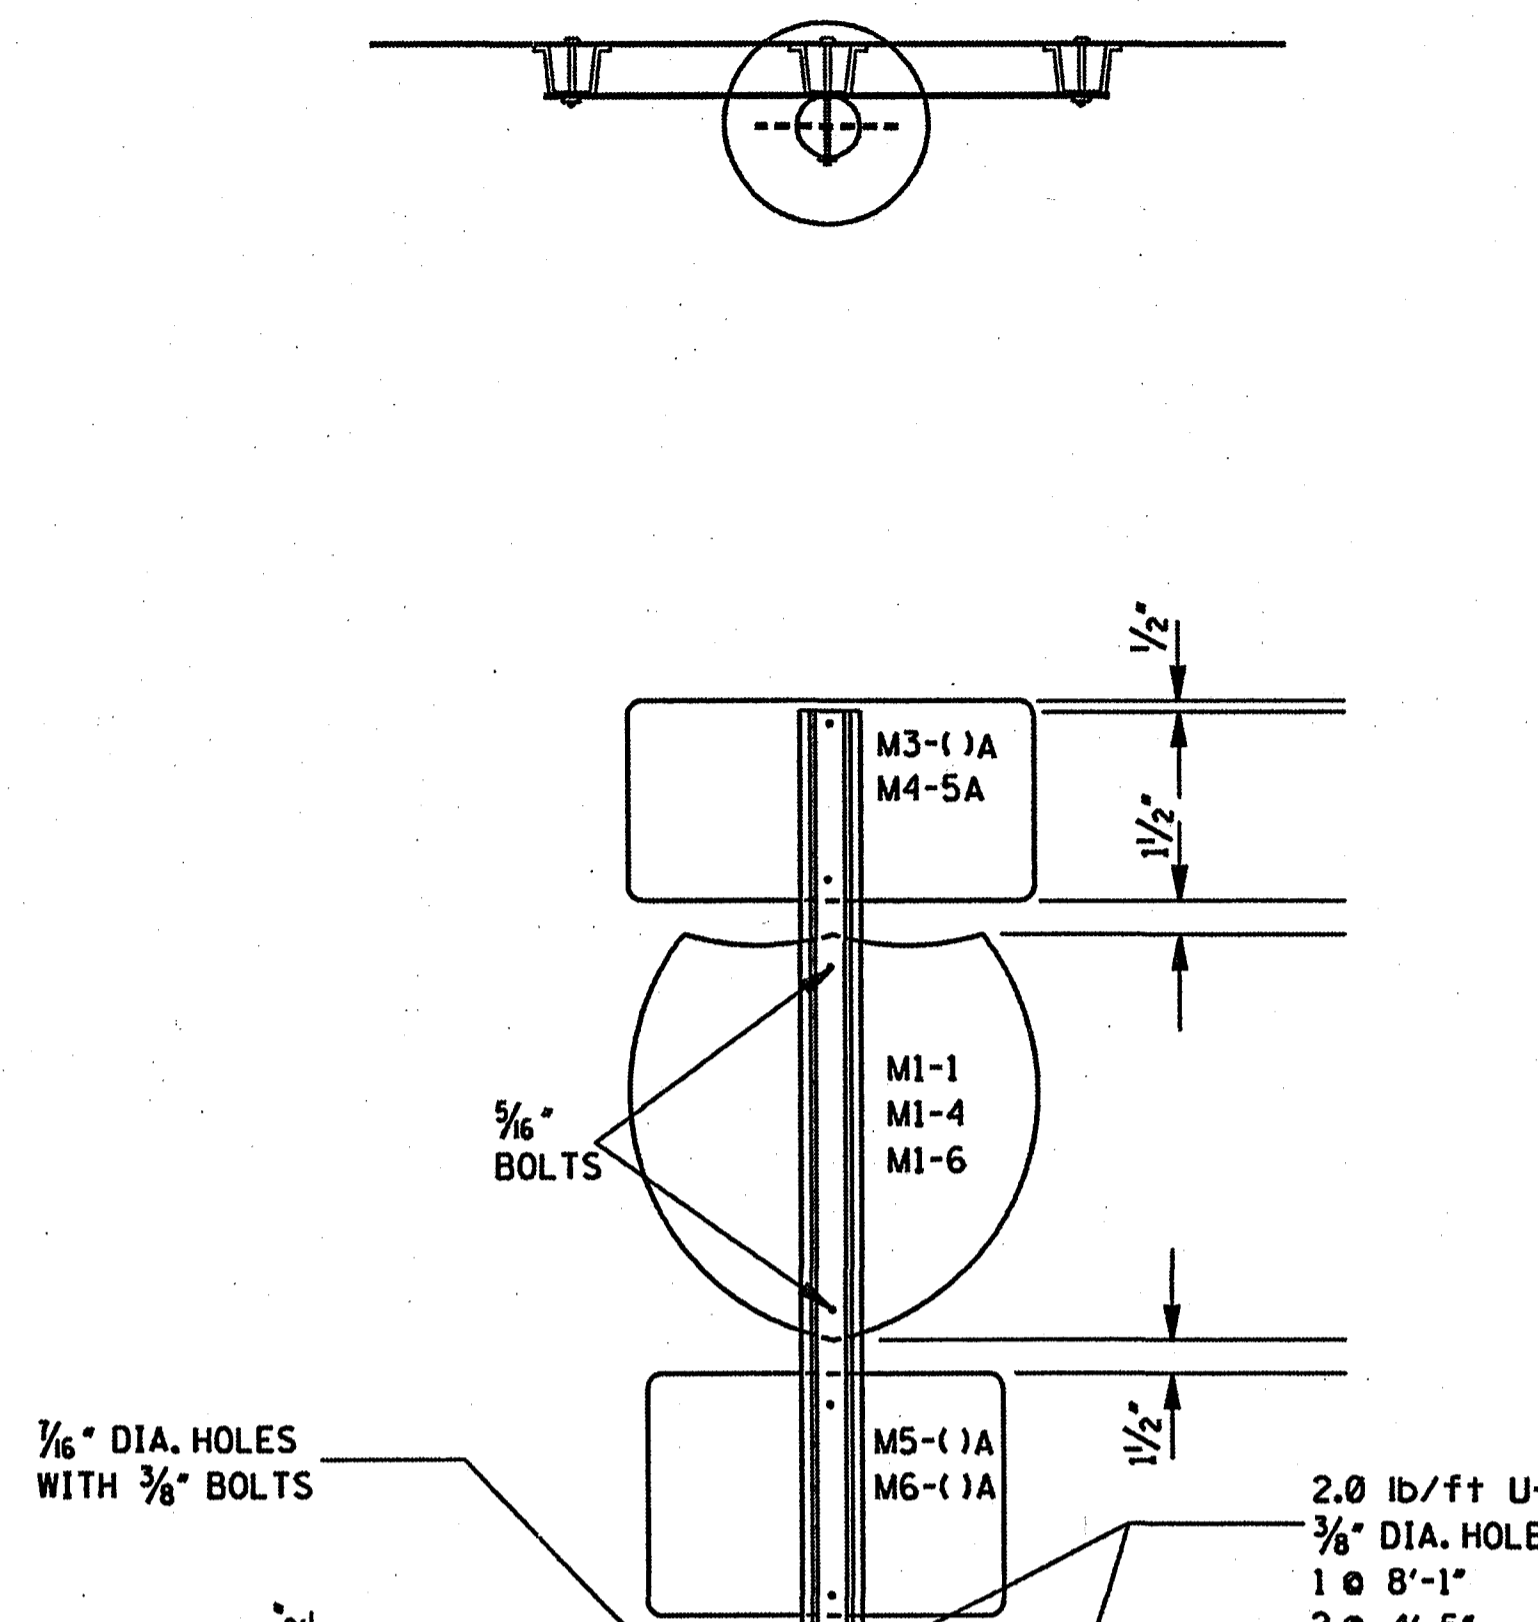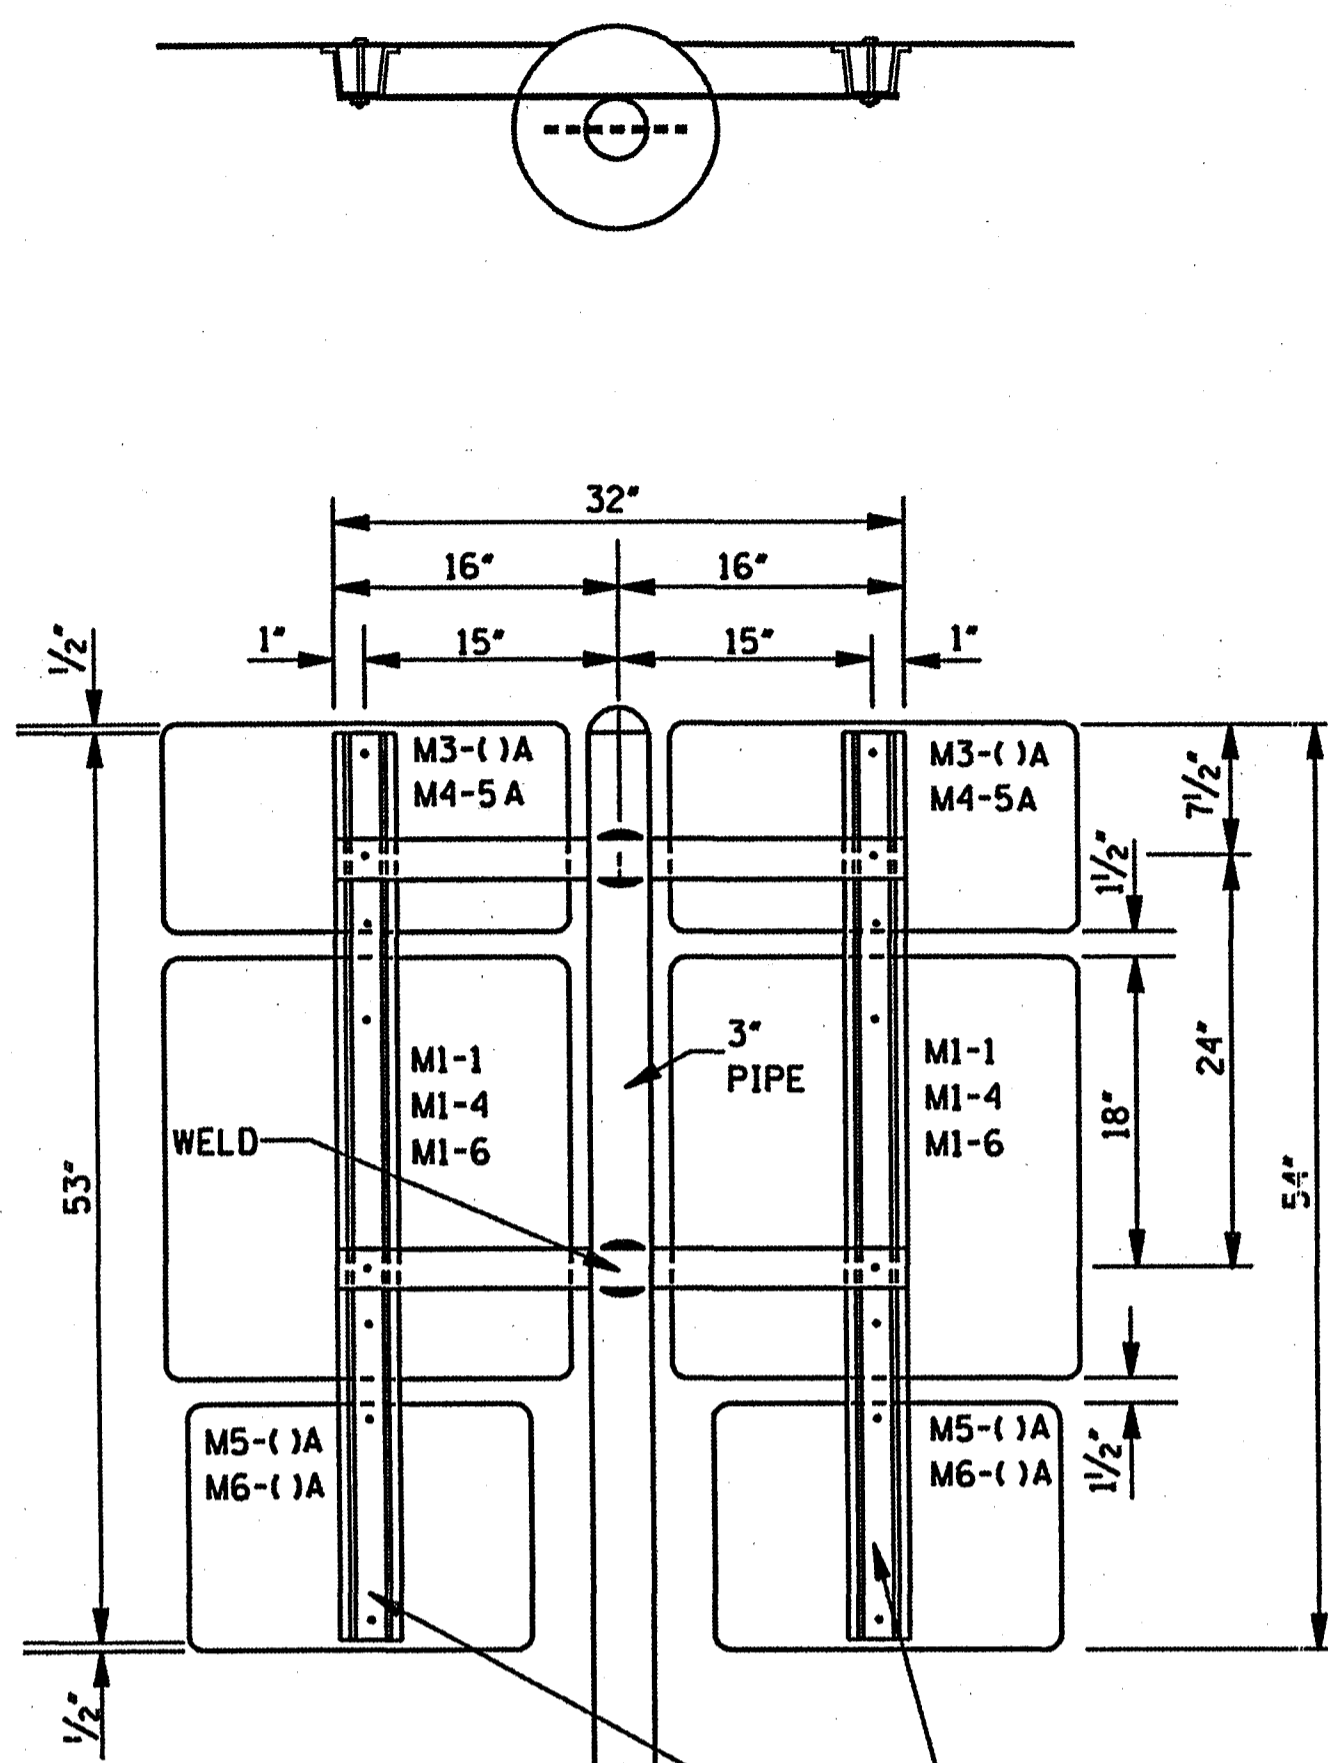

TYPICAL ASSEMBLY OF "FLAT TOPPED" REGULATORY OR WARNING SIGN MOUNTED ON A SINGLE U-SECTION POST

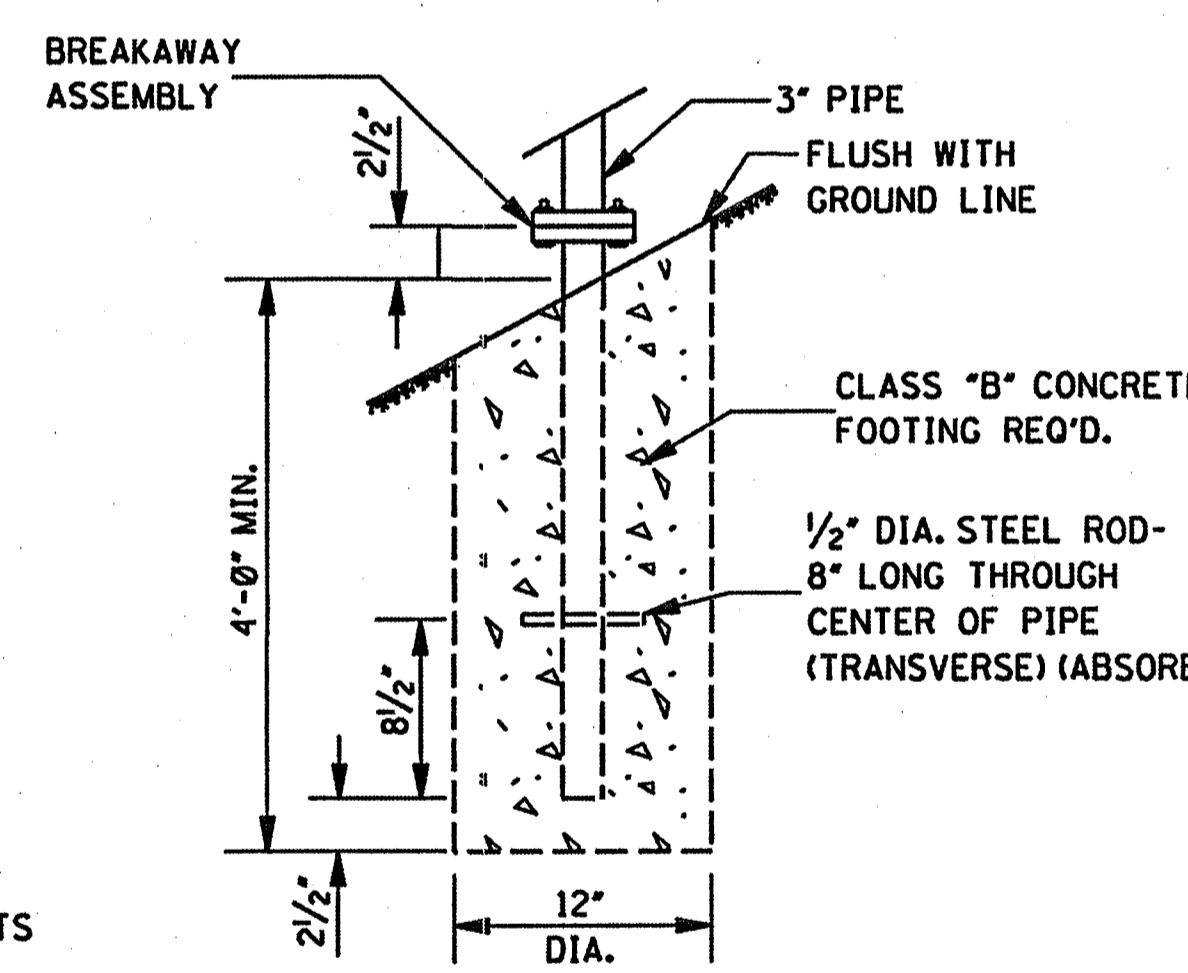


FOOTING DETAIL FOR 3" PIPE

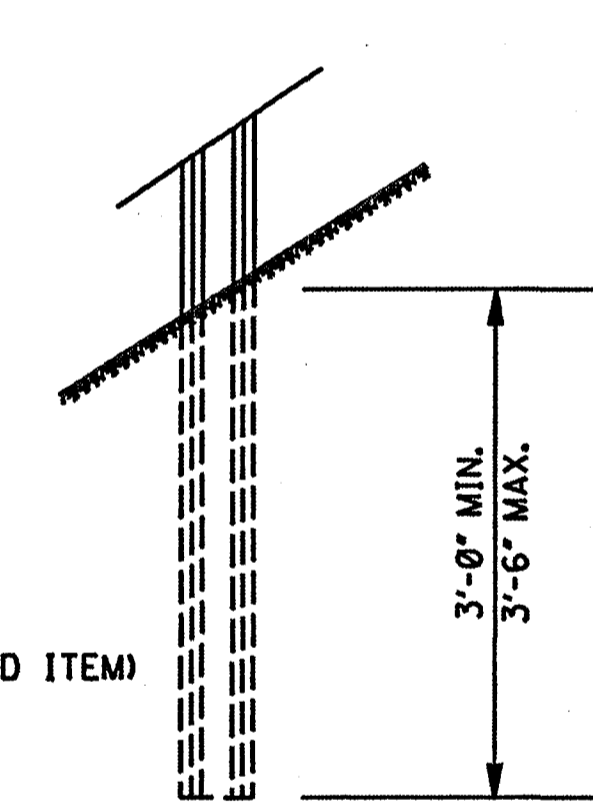


FOOTING DETAIL FOR U-SECTION POSTS

GENERAL NOTES:

- UNLESS OTHERWISE SPECIFIED, HORIZONTAL BRACES ARE 1/8" X 2 1/2" X VARIABLE LENGTH FLAT STEEL BARS. BARS ARE WELDED TO PIPE AS SHOWN. WHEN FABRICATION IS COMPLETE, POST SHALL BE GALVANIZED AS PER SECTION 630 OF THE STANDARD SPECIFICATION.
- HOLES IN FLAT BARS ARE 3/8" DIAMETER.
- SIGNS ARE FASTENED TO FLAT BARS AND U-SECTION POST WITH 3/8" BOLTS, WITH FLAT WASHER AND LOCK-NUTS.
- GROUND PLATE NOT REQUIRED ON U-SECTION POST.

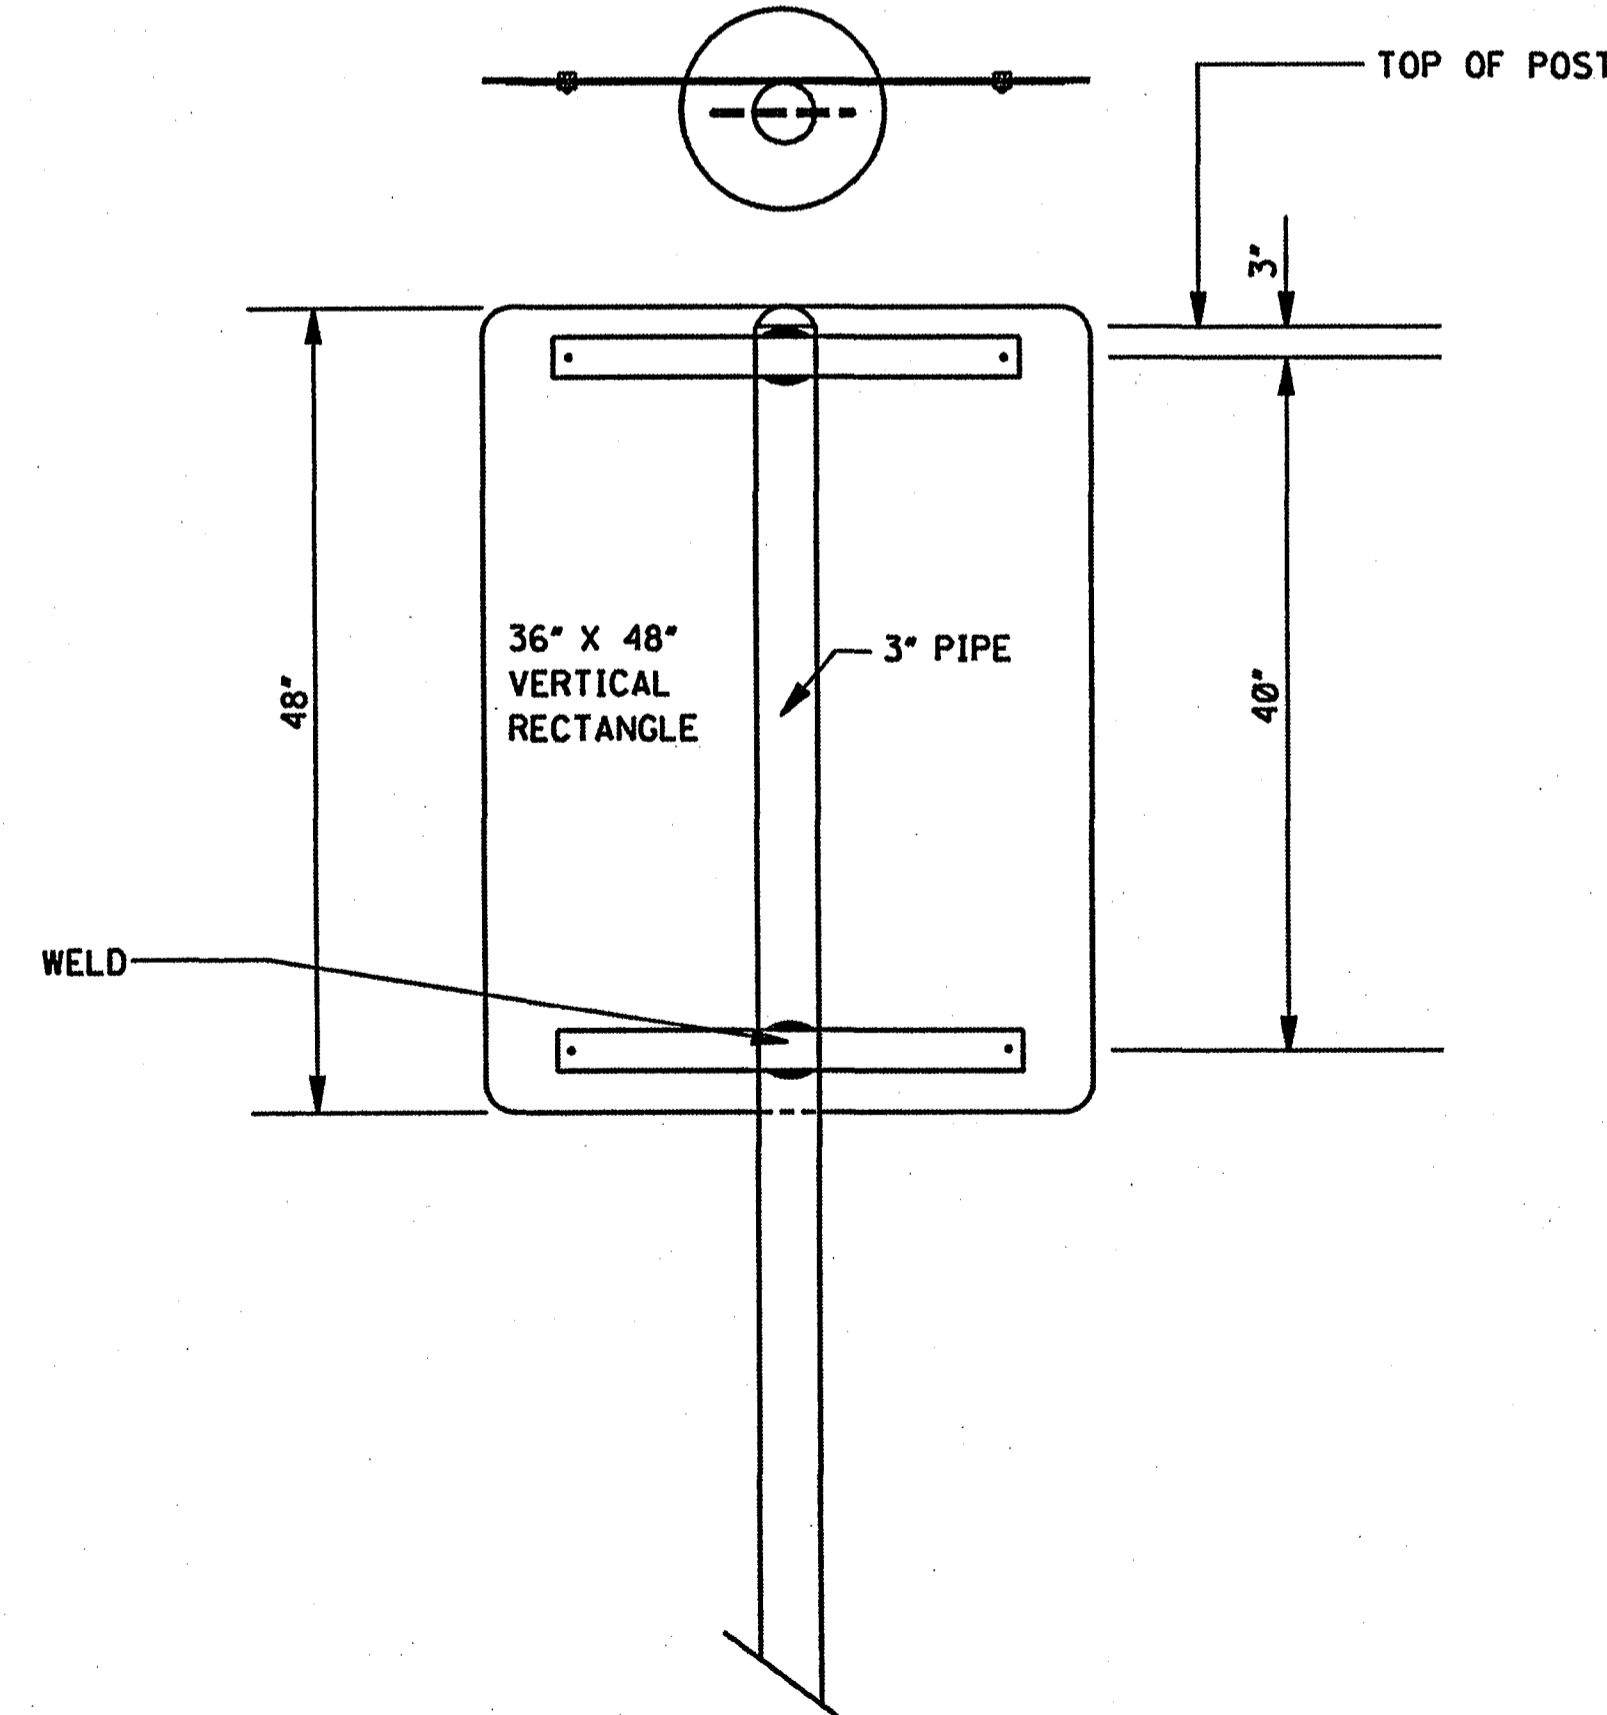

BY		MISSISSIPPI DEPARTMENT OF TRANSPORTATION	
REVISION		ROADWAY DESIGN DIVISION	
DATE		STANDARD PLAN	
		<b>STANDARD ROADSIDE SIGN ASSEMBLY AND INSTALLATION</b>	
		WORKING NUMBER SN-4A	
		SHEET NUMBER 226	
		ISSUE DATE: OCTOBER 1, 1998	

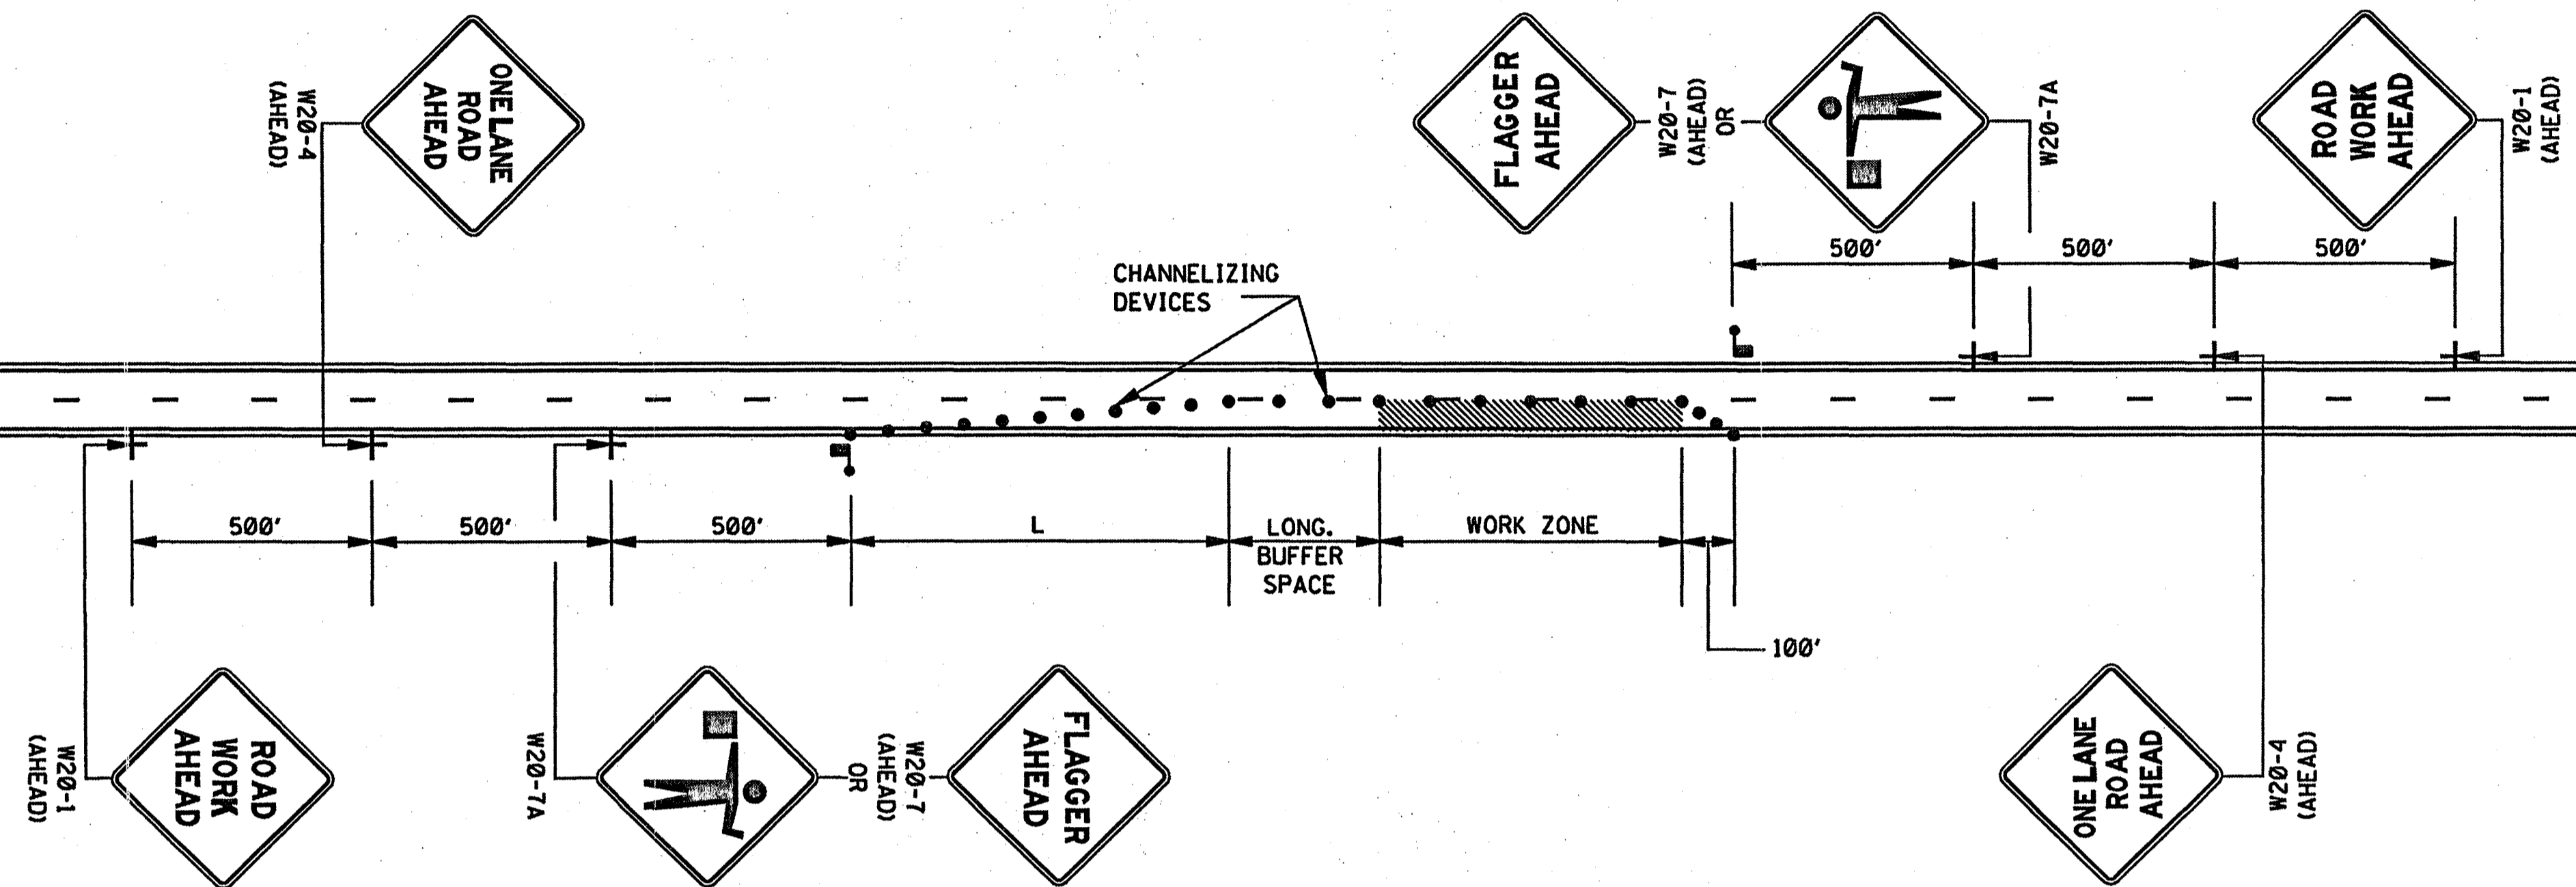

- LEGEND
- FLAGGER
  - CHANNELIZING DEVICES

GENERAL NOTES:


1. THE LOCATION OF CHANNELIZING DEVICES AND THE WORK AREA LAYOUT SHALL BE BASED ON THE CRITERIA IN THE FOLLOWING TABLE:

POSTED SPEED AND/OR DESIGN SPEED	MAXIMUM CHANNELIZING DEVICE SPACING (ft)		MINIMUM LONGITUDINAL BUFFER SPACE (ft)	TAPER † RATES
	TAPER	ALONG LANE LINE & WORK ZONE		
mph				
≤40	40	80	170	27:1
45	45	90	220	45:1
50	50	100	280	50:1
55	55	110	335	55:1
60	60	120	415	60:1
65	65	130	485	65:1
70	70	140	575	70:1

† NOTE: TAPER RATES ARE DETERMINED USING THE FOLLOWING EQUATIONS:  
 $L = WS$  FOR SPEEDS OF 45 mph OR GREATER  
 $L = WS^2/60$  FOR SPEEDS OF 40 mph OR LESS  
 WHERE: L = MINIMUM LENGTH OF TAPER IN FEET  
 W = WIDTH OF OFFSET (USUALLY LANE WIDTH) IN FEET  
 S = DESIGN SPEED OR 85TH PERCENTILE SPEED IN MILES PER HOUR


2. ALL CHANNELIZING DEVICES SHALL BE A MINIMUM OF 24" IN HEIGHT.
3. ALL TRAFFIC CONTROL ITEMS SHOWN ON THIS SHEET WILL NOT BE MEASURED FOR SEPARATE PAYMENT. THIS WORK IS TO BE INCLUDED IN THE PRICE BID FOR MAINTENANCE OF TRAFFIC.
4. DIAMOND SHAPED TRAFFIC CONTROL SIGNS SHALL BE A MINIMUM OF 48" x 48".
5. WHEN THERE IS NO EXISTING HAZARD OR AT THE END OF THE WORK DAY, ALL SIGNS SHALL BE COVERED OR REMOVED AND ALL CHANNELIZING DEVICES SHALL BE MOVED TO THE SHOULDER EDGE.
6. WHERE THE WORK ZONE IS STATIONARY, THE W20-7 (500 FT.) SIGN OR THE W20-7A SIGN TOGETHER WITH THE W20-7 (500 FT.) SUPPLEMENTAL PLATE SHOULD BE USED TO INDICATE THE DISTANCE TO THE FLAGGER.

MISSISSIPPI DEPARTMENT OF TRANSPORTATION ROADWAY DESIGN DIVISION STANDARD PLAN	
<b>TRAFFIC CONTROL PLAN WITH FLAGGER (ONE-LANE CLOSURE OF TWO-WAY TRAFFIC)</b>	
WORKING NUMBER TCP-1	 SHEET NUMBER 250
ISSUE DATE: OCTOBER 1, 1998	

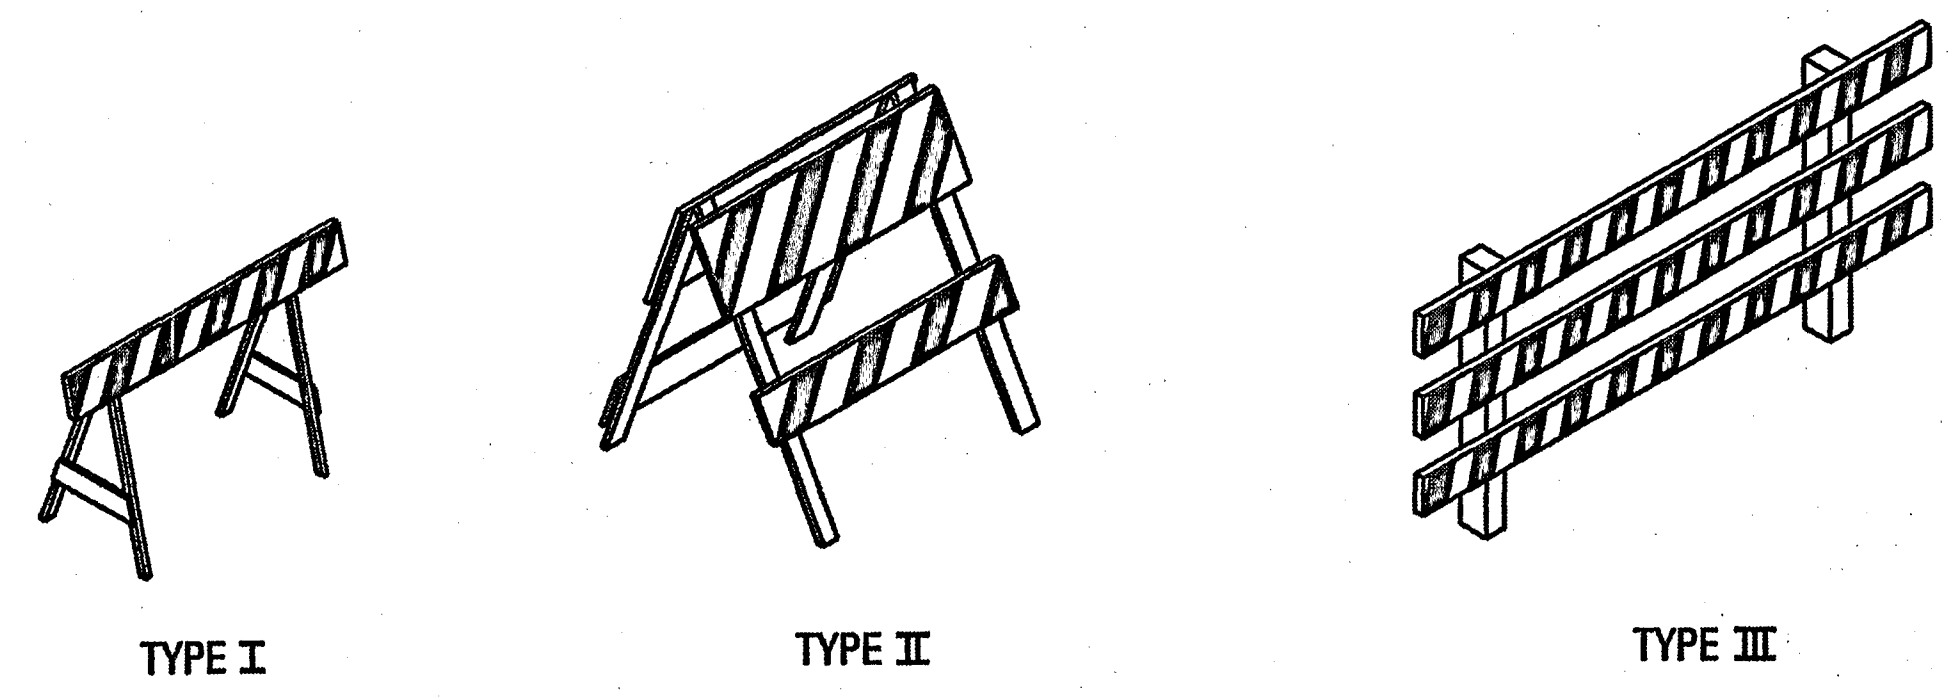


**STANDARD BARRICADES**

1. A TYPE I BARRICADE CONSISTS OF ONE (1) HORIZONTAL RAIL SUPPORTED BY A DEMOUNTABLE FRAME OR A LIGHT "A" FRAME. A TYPE I BARRICADE NORMALLY WOULD BE USED ON CONVENTIONAL ROADS OR URBAN STREETS AND ARTERIALS.
2. A TYPE II BARRICADE CONSISTS OF TWO (2) HORIZONTAL RAILS ON A LIGHT "A" FRAME. TYPE II BARRICADES ARE INTENDED FOR USE ON EXPRESSWAYS AND FREEWAYS AND OTHER HIGH-SPEED ROADWAYS.
3. TYPE I AND TYPE II BARRICADES ARE INTENDED FOR USE WHERE THE HAZARD IS RELATIVELY SMALL AS, FOR EXAMPLE, ON CITY STREETS, OR FOR THE MORE OR LESS CONTINUOUS DELIMITING OF A RESTRICTED ROADWAY, OR FOR TEMPORARY DAYTIME USE.
4. A TYPE III BARRICADE CONSISTS OF THREE (3) HORIZONTAL RAILS SUPPORTED BY FIXED POSTS, A RIGID SKID, A HEAVY DEMOUNTABLE FRAME OR A HEAVY, HINGED "A" FRAME.
5. TYPE III BARRICADES ARE INTENDED FOR USE ON CONSTRUCTION AND MAINTENANCE PROJECTS AS WING BARRICADES AND AT ROAD CLOSURES, WHERE THEY MUST REMAIN IN PLACE FOR EXTENDED PERIODS.
6. THE MARKING FOR BARRICADE RAILS SHALL BE ORANGE AND WHITE (SLOPING DOWNWARD AT AN ANGLE OF 45° IN THE DIRECTION TRAFFIC IS TO PASS).
7. DO NOT PLACE SANDBAGS OR OTHER DEVICES TO PROVIDE MASS ON THE BOTTOM RAIL THAT WILL BLOCK VIEW OR RAIL FACE.
8. FOR ADDITIONAL INFORMATION OR DETAILS, SEE MUTCD, LATEST EDITION.

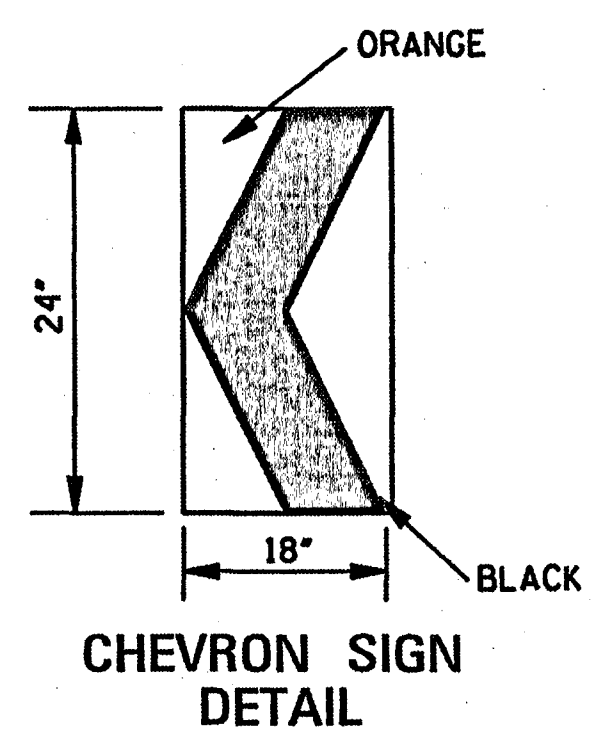

1. A CHEVRON SIGN CONSISTS OF A BLACK CHEVRON TYPE MARKING ON AN ORANGE BACKGROUND AND SHALL POINT IN THE DIRECTION OF TRAFFIC FLOW.
2. THE CHEVRON SIGN SHALL BE MOUNTED ON FIXED POST OR RIGID SKID.
3. CHEVRON SIGNS MAY BE USED TO SUPPLEMENT OTHER STANDARD DEVICES WHERE ONE OR MORE LANES ARE CLOSED FOR CONSTRUCTION OR MAINTENANCE. THEY SHALL BE PLACED APPROXIMATELY 2'-0" BEHIND THE LANE TRANSITION STRIPE.

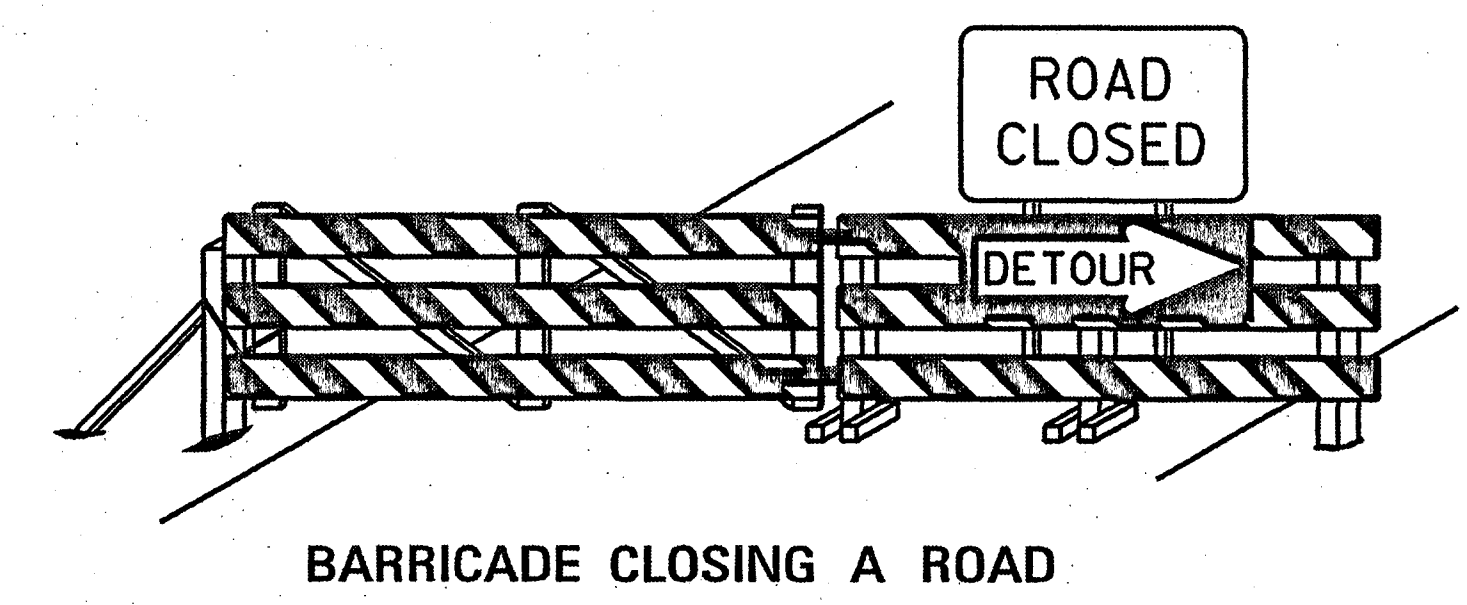


**BARRICADE CLOSING A ROAD**


**BARRICADE CHARACTERISTICS**

	I	II	III
WIDTH OF RAIL **	8" MIN. - 12" MAX.	8" MIN. - 12" MAX.	8" MIN. - 12" MAX.
LENGTH OF RAIL **	24" MIN.	24" MIN.	48" MIN.
WIDTH OF STRIPE *	6"	6"	6"
HEIGHT	36" MIN.	36" MIN.	60" MIN.
NUMBER OF REFLECTORIZED RAIL FACES	2 (ONE EACH DIRECTION)	4 (TWO EACH DIRECTION)	3 IF FACING TRAFFIC IN ONE DIRECTION 6 IF FACING TRAFFIC IN TWO DIRECTIONS
TYPE OF FRAME	LIGHT	LIGHT "A" FRAME	POST OR SKID

\* 1. FOR RAILS LESS THAN 36" LONG, 4" WIDE STRIPES MAY BE USED.  
 \*\* 2. BARRICADES INTENDED FOR USE ON EXPRESSWAYS, FREEWAYS AND OTHER HIGH SPEED ROADWAYS, SHALL HAVE A MINIMUM OF 270 in<sup>2</sup> OF REFLECTIVE AREA FACING TRAFFIC.

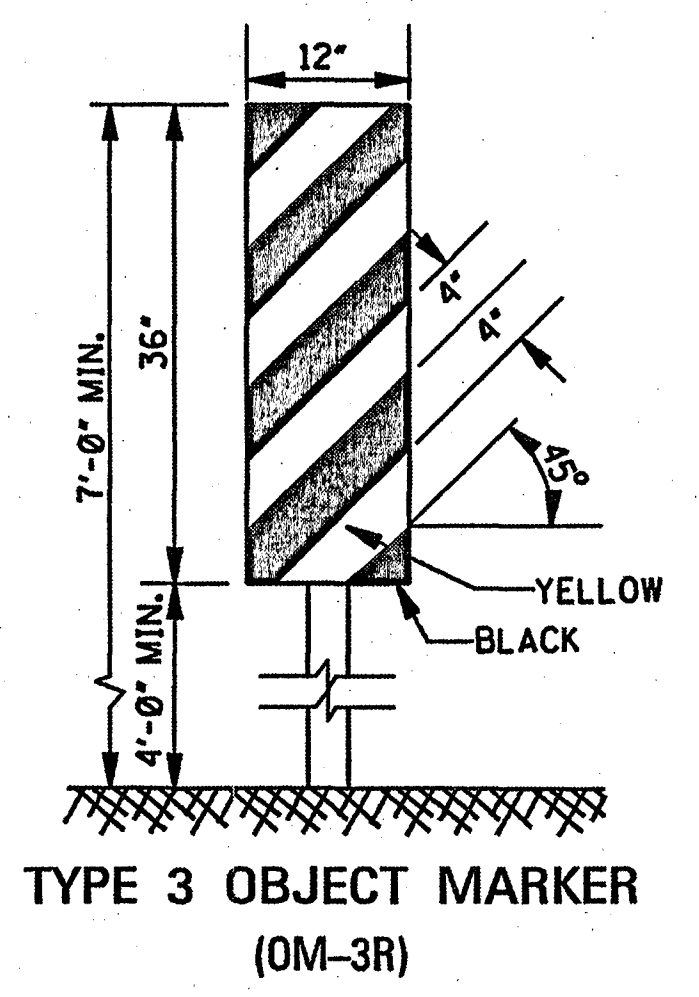


1. TYPE 3 OBJECT MARKERS SHALL BE USED AT ALL EXPOSED BRIDGE ABUTMENTS AND AT OTHER LOCATIONS AS DEEMED NECESSARY BY THE ENGINEER.
2. THE OM-3R IS SHOWN. THE OM-3L IS SIMILAR EXCEPT THE STRIPES SLOPE DOWNWARD FROM THE UPPER LEFT SIDE TO THE LOWER RIGHT SIDE AND SHALL BE PLACED ON THE LEFT SIDE OF THE OBJECT.
3. THE INSIDE EDGE OF THE MARKER SHALL BE IN LINE WITH THE INNER EDGE OF THE OBSTRUCTION.

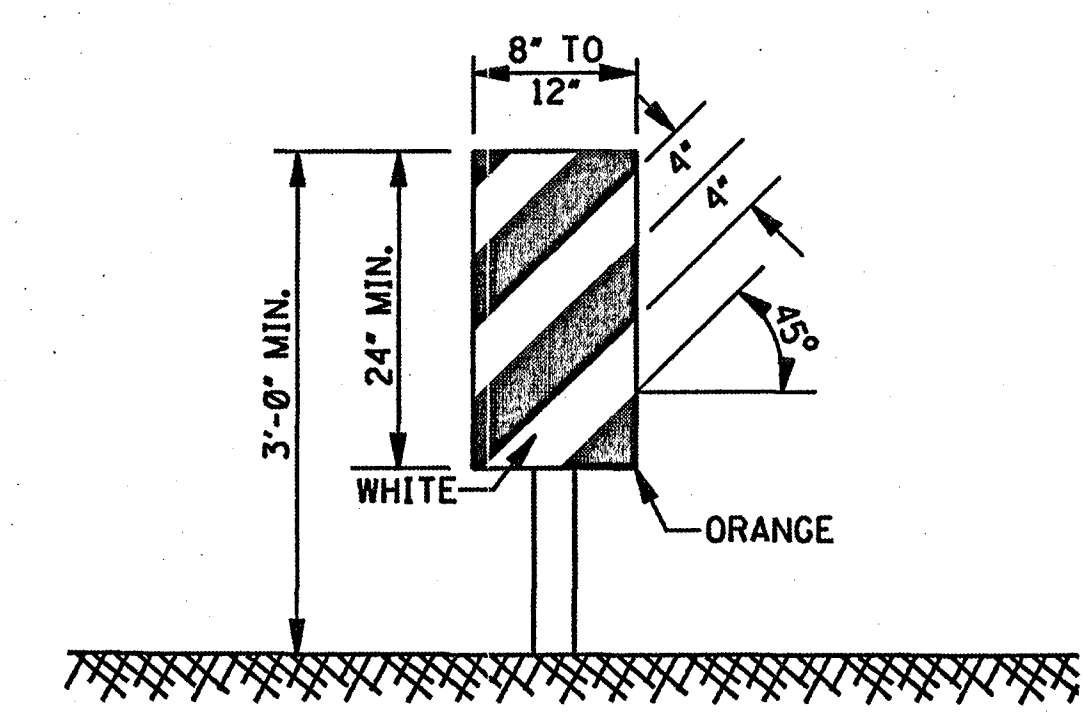

**VERTICAL PANEL**


1. VERTICAL PANELS CONSIST OF AT LEAST ONE PANEL 8" TO 12" IN WIDTH AND A MINIMUM OF 24" IN HEIGHT.
2. THE DIAGONAL STRIPES SHALL SLOPE DOWNWARD IN THE DIRECTION THAT TRAFFIC IS TO PASS THE PANEL. THE PANELS SHALL BE MOUNTED WITH THE TOP A MINIMUM OF 36" ABOVE THE ROADWAY ON A SINGLE LIGHTMASS POST.
3. VERTICAL PANELS USED ON EXPRESSWAYS, FREEWAYS AND OTHER HIGH-SPEED ROADWAYS SHALL HAVE A MINIMUM OF 270 in<sup>2</sup> OF RETROREFLECTIVE AREA FACING TRAFFIC.
4. FOR TWO-WAY TRAFFIC OPERATIONS, BACK-TO-BACK PANELS SHALL BE USED.

- GENERAL NOTES:**
1. MARKINGS ON ALL DEVICES SHOWN ON THIS SHEET SHALL BE HIGH INTENSITY REFLECTIVE SHEETING.
  2. THE TRAFFIC CONTROL PLAN WILL LIST THE VARIOUS TRAFFIC CONTROL DEVICES REQUIRED FOR EACH PROJECT.

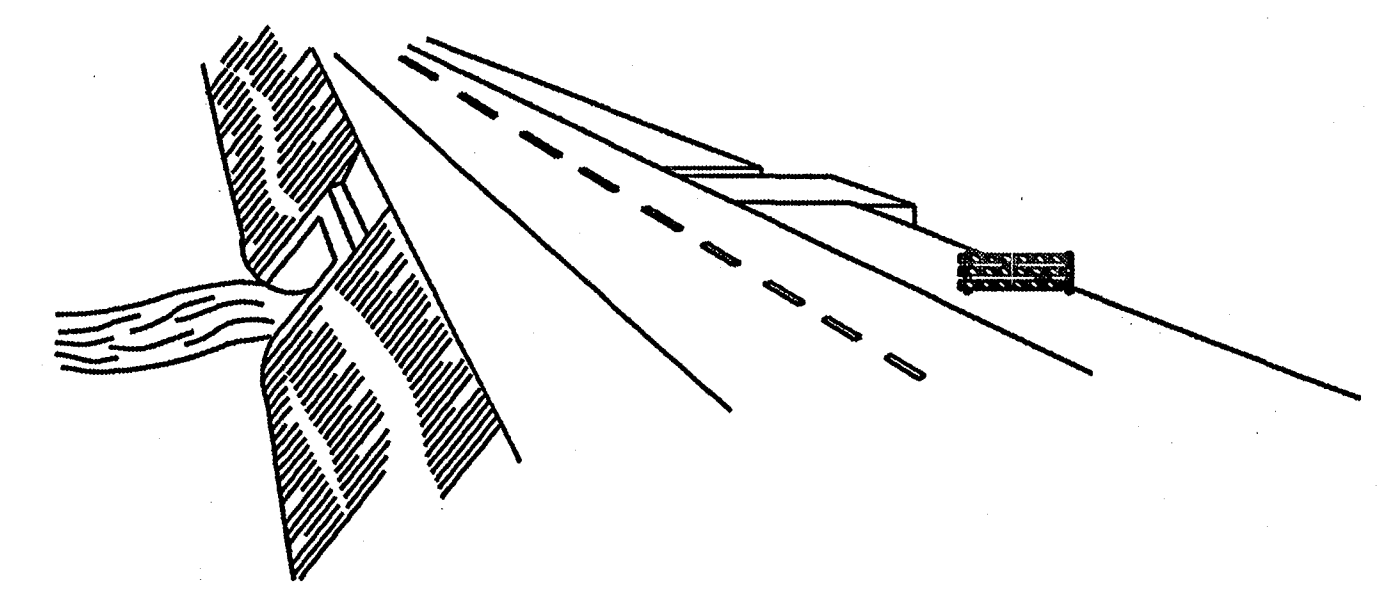

**WING BARRICADES**

1. WING BARRICADES ARE TYPE III BARRICADES ERECTED ON THE SHOULDER ON ONE OR BOTH SIDES OF THE PAVEMENT TO GIVE THE SENSATION OF A NARROWING OR RESTRICTED ROADWAY. WING BARRICADES MAY BE USED AS A MOUNTING FOR THE ADVANCE WARNING SIGNS OR FLASHERS.
2. WING BARRICADES SHOULD BE USED:
  - A. IN ADVANCE OF A CONSTRUCTION PROJECT EVEN WHEN NO PART OF THE ROADWAY IS ACTUALLY CLOSED.
  - B. IN ADVANCE OF ALL BRIDGE OR CULVERT WIDENING OPERATIONS.

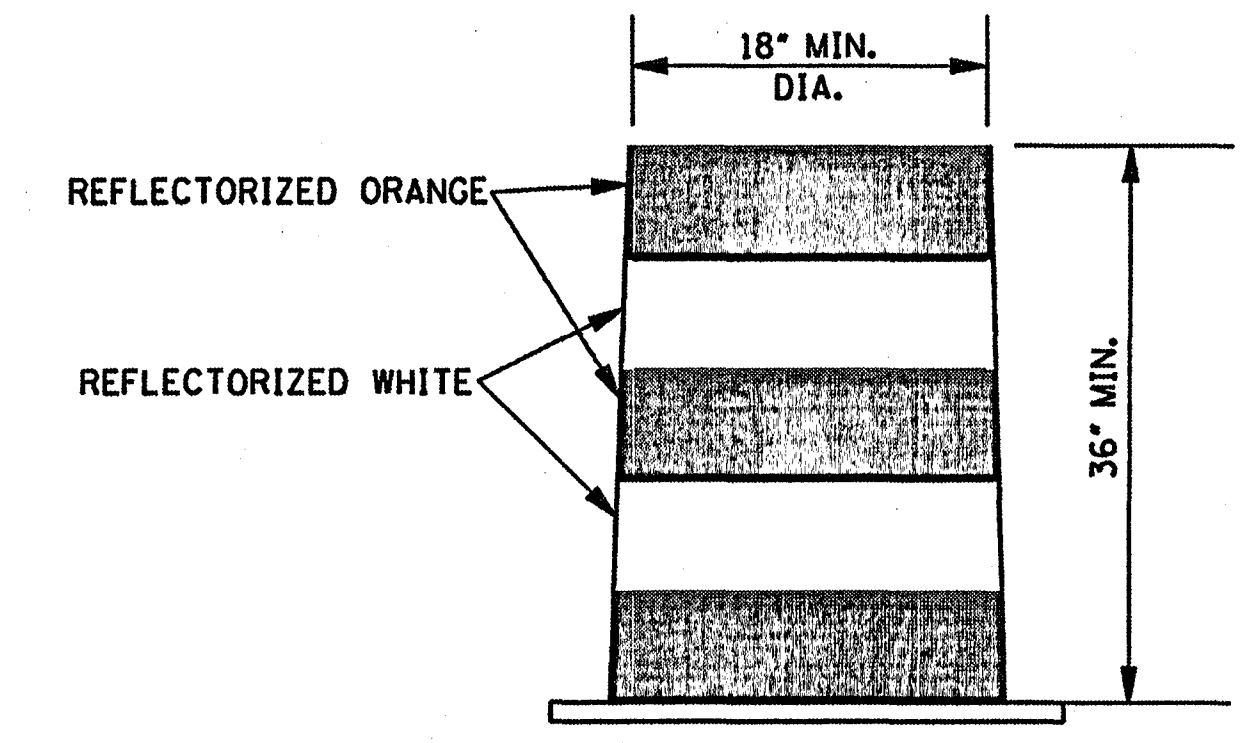


**PLASTIC DRUM STRIPING DETAIL**


1. PLASTIC DRUMS SHALL BE ON END AND USED AS AN EXPEDIENT METHOD FOR TRAFFIC CHANNELIZATION. THE COLOR AND MARKING OF DRUMS SHALL BE CONSISTENT WITH MARKING STANDARDS FOR BARRICADE. THE PREDOMINANT COLOR ON DRUMS SHALL BE ORANGE WITH FOUR (4) REFLECTORIZED, HORIZONTAL, CIRCUMFERENTIAL STRIPES (2 ORANGE & 2 WHITE) 6" WIDE.
2. DRUMS SHOULD NEVER BE PLACED IN THE ROADWAY WITHOUT WARNING SIGNS.
3. WHERE PRACTICAL PLASTIC DRUMS SHALL BE PLACED NO CLOSER THAN 3'-0" FROM THE EDGE OF TRAVELED LANE.

MISSISSIPPI DEPARTMENT OF TRANSPORTATION ROADWAY DESIGN DIVISION STANDARD PLAN		
<b>HIGHWAY SIGN AND BARRICADE DETAILS FOR CONSTRUCTION PROJECTS</b>		
BY	DATE	WORKING NUMBER TCP-10 SHEET NUMBER 259
REVISION	ISSUE DATE: OCTOBER 1, 1998	

### MOBILE OPERATIONS ON MULTILANE ROAD $\Delta$

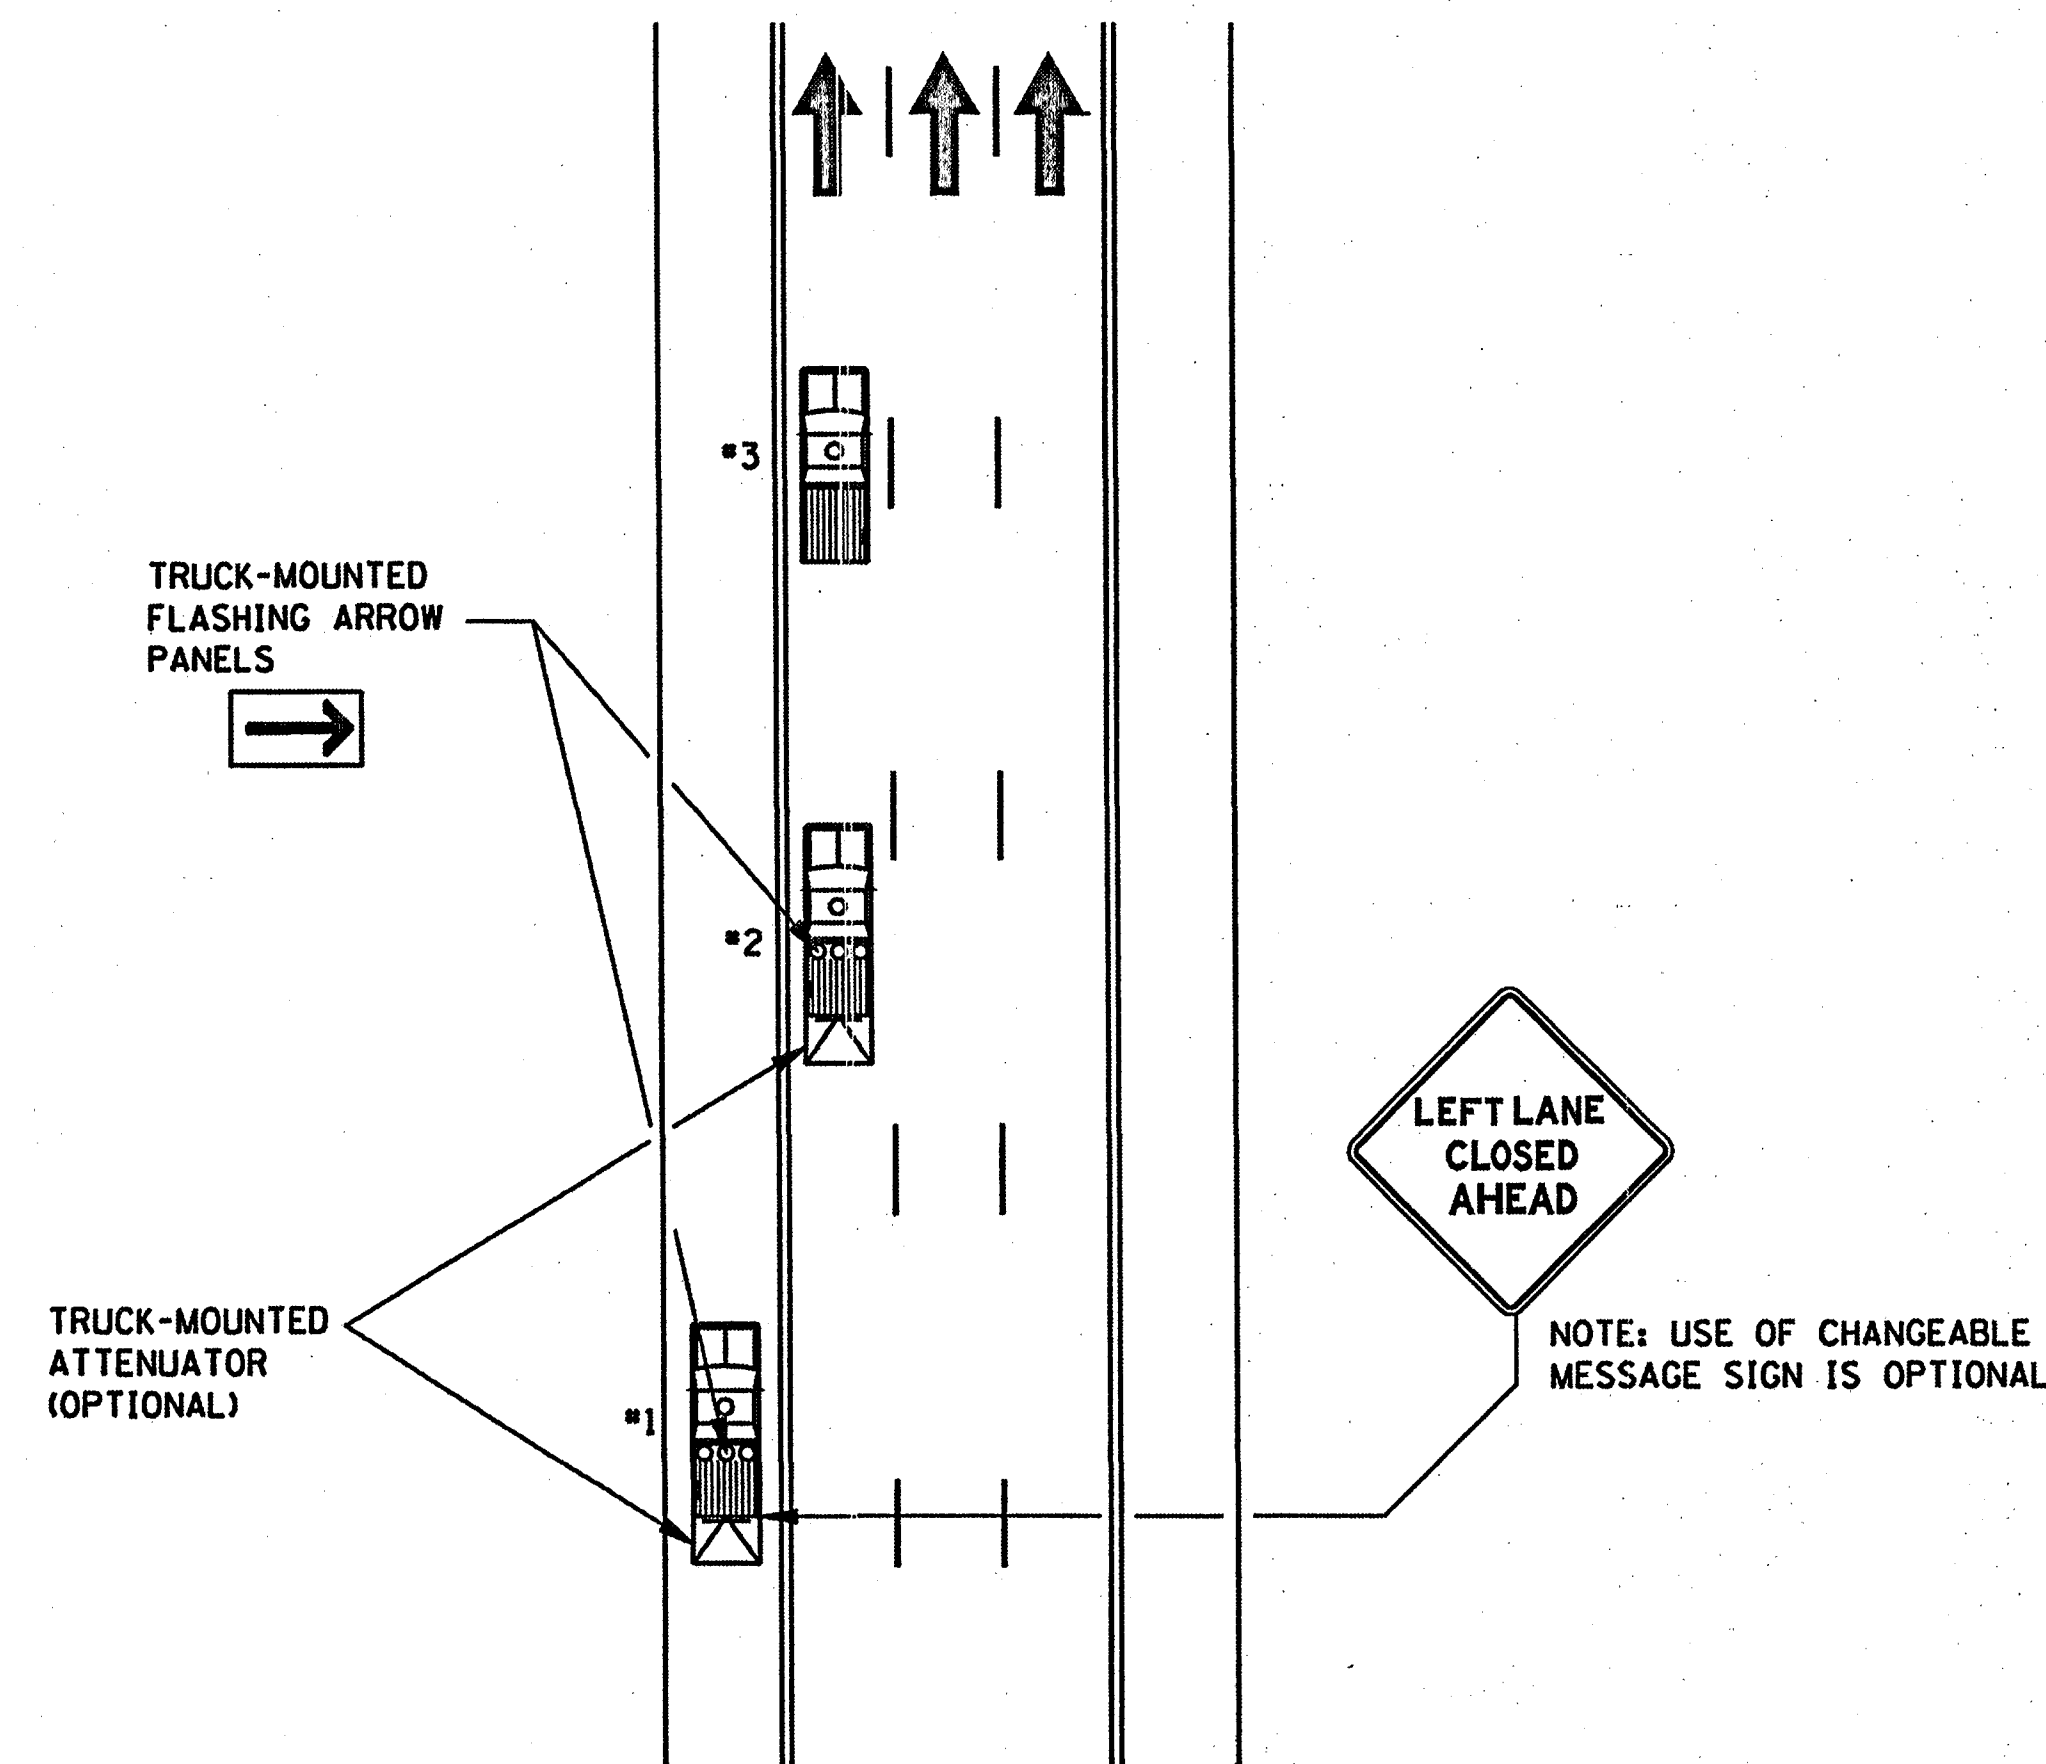

### MOBILE OPERATIONS ON TWO-LANE ROAD

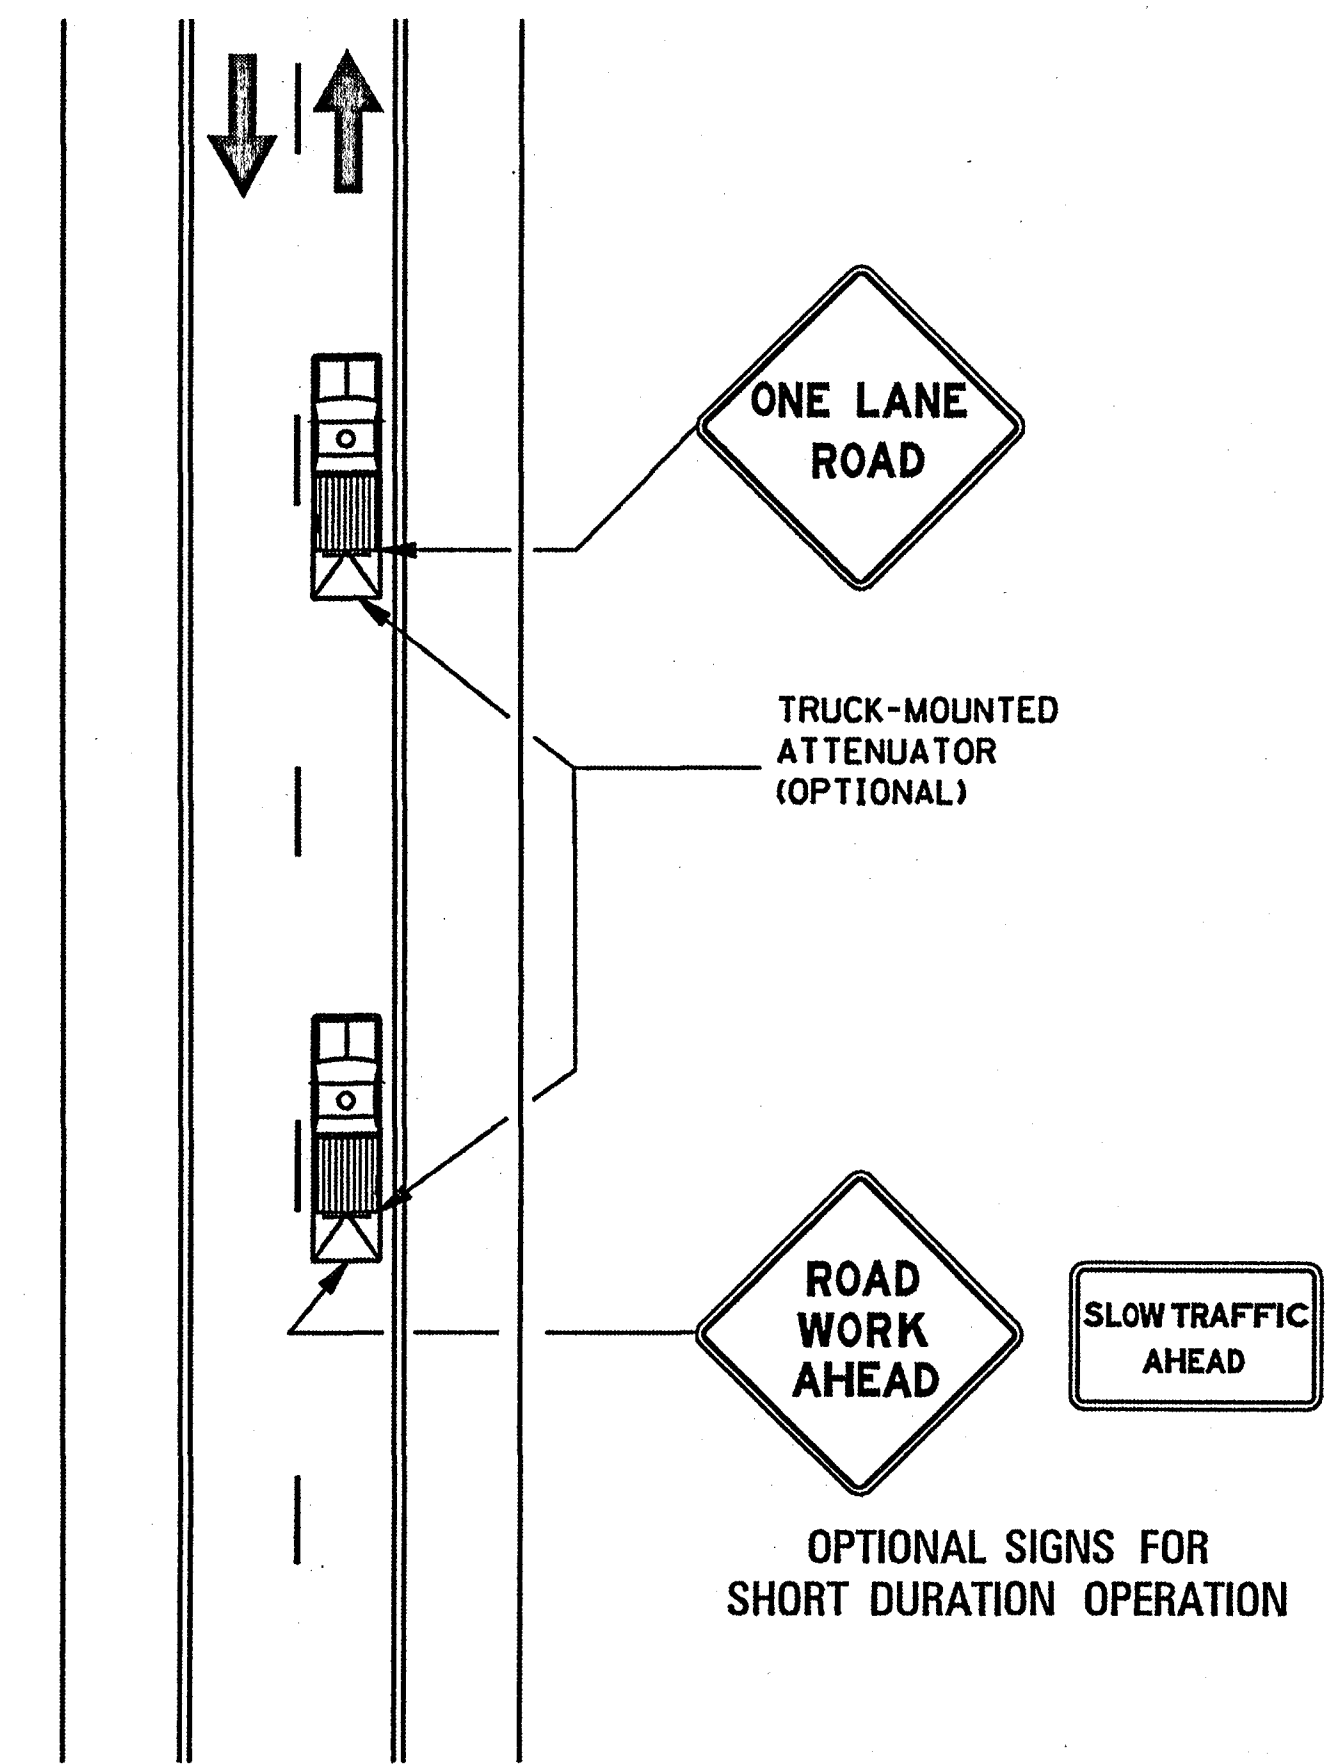

### MOBILE OPERATIONS ON MULTILANE ROAD

### MOBILE OPERATIONS ON TWO-LANE ROAD


**NOTES:**

- VEHICLES USED FOR THESE OPERATIONS SHOULD BE MADE HIGHLY VISIBLE WITH APPROPRIATE EQUIPMENT, SUCH AS FLASHING LIGHTS, ROTATING BEACONS, FLAGS, SIGNS, OR ARROW PANELS.
- PROTECTION VEHICLE #1 SHOULD BE EQUIPPED WITH AN ARROW PANEL. AN APPROPRIATE LANE CLOSURE SIGN SHOULD BE PLACED ON PROTECTION VEHICLE #1 SO AS NOT TO OBSCURE THE ARROW PANEL.
- PROTECTION VEHICLE #2 SHOULD BE EQUIPPED WITH AN ARROW PANEL AND TRUCK-MOUNTED ATTENUATOR (TMA).
- PROTECTION VEHICLE #1 SHOULD TRAVEL AT A VARYING DISTANCE FROM THE WORK OPERATION SO AS TO PROVIDE ADEQUATE SIGHT DISTANCE FOR TRAFFIC APPROACHING FROM THE REAR.
- WHEN ADEQUATE SHOULDER WIDTH IS NOT AVAILABLE, PROTECTION VEHICLE #1 SHOULD BE ELIMINATED.
- ON HIGH-SPEED ROADWAYS, A THIRD PROTECTION VEHICLE SHOULD BE USED (I.E., VEHICLE #1 ON THE SHOULDER (IF PRACTICAL), VEHICLE #2 IN THE CLOSED LANE, AND VEHICLE #3 IN THE CLOSED LANE).
- ARROW PANELS SHALL BE AS A MINIMUM TYPE B, 60" X 30" IN ACCORDANCE WITH THE CRITERIA PRESENTED IN THE MUTCD.
- WORK SHOULD NORMALLY BE DONE DURING OFF-PEAK HOURS.
- ALL TRAFFIC CONTROL ITEMS SHOWN ON THIS SHEET WILL NOT BE MEASURED FOR SEPARATE PAYMENT. THIS WORK IS TO BE INCLUDED IN THE PRICE BID FOR MAINTENANCE OF TRAFFIC.


**NOTES:**

- WHERE PRACTICAL AND WHEN NEEDED, THE WORK AND PROTECTION VEHICLES SHOULD PULL OVER PERIODICALLY TO ALLOW TRAFFIC TO PASS. IF THIS CAN NOT BE DONE FREQUENTLY, AS AN ALTERNATIVE, A "DO NOT PASS" SIGN MAY BE PLACED ON THE REAR OF THE VEHICLE BLOCKING THE LANE.
- THE DISTANCE BETWEEN THE WORK AND PROTECTION VEHICLES MAY VARY ACCORDING TO TERRAIN, PAINT DRYING TIME, AND OTHER FACTORS. PROTECTION VEHICLES ARE USED TO WARN TRAFFIC OF THE OPERATION AHEAD. WHENEVER ADEQUATE STOPPING SIGHT DISTANCE EXISTS TO THE REAR, THE PROTECTION VEHICLE SHOULD MAINTAIN THE MINIMUM DISTANCE AND PROCEED AT THE SAME SPEED AS THE WORK VEHICLE. THE PROTECTION VEHICLE SHOULD SLOW DOWN IN ADVANCE OF VERTICAL OR HORIZONTAL CURVES THAT RESTRICT SIGHT DISTANCE.
- ADDITIONAL PROTECTION VEHICLES TO WARN AND REDUCE THE SPEED OF ONCOMING OR OPPOSING TRAFFIC MAY BE USED. POLICE PATROL CARS MAY BE USED FOR THIS PURPOSE.
- A TRUCK-MOUNTED ATTENUATOR (TMA) SHOULD BE USED ON THE PROTECTION VEHICLE AND MAY BE USED ON THE WORK VEHICLE.
- THE WORK VEHICLE SHALL BE EQUIPPED WITH BEACONS, AND THE PROTECTION VEHICLES SHALL BE EQUIPPED WITH TWO HIGH-INTENSITY FLASHING LIGHTS MOUNTED ON THE REAR, ADJACENT TO THE SIGN. PROTECTION AND WORK VEHICLES SHOULD DISPLAY FLASHING OR ROTATING BEACONS BOTH FORWARD AND TO THE REAR.
- VEHICLE-MOUNTED SIGNS SHALL BE MOUNTED WITH THE BOTTOM OF THE SIGN LOCATED AT A MINIMUM HEIGHT OF 48" ABOVE THE PAVEMENT. SIGN LEGENDS SHALL BE COVERED OR TURNED FROM VIEW WHEN WORK IS NOT IN PROGRESS.
- ALL TRAFFIC CONTROL ITEMS SHOWN ON THIS SHEET WILL NOT BE MEASURED FOR SEPARATE PAYMENT. THIS WORK IS TO BE INCLUDED IN THE PRICE BID FOR MAINTENANCE OF TRAFFIC.



MISSISSIPPI DEPARTMENT OF TRANSPORTATION ROADWAY DESIGN DIVISION STANDARD PLAN	
<b>TRAFFIC CONTROL PLAN MOBILE OPERATIONS MULTILANE ROADS AND TWO-LANE ROADS</b>	
WORKING NUMBER TCP-11	
SHEET NUMBER 260	
ISSUE DATE:	OCTOBER 1, 1998

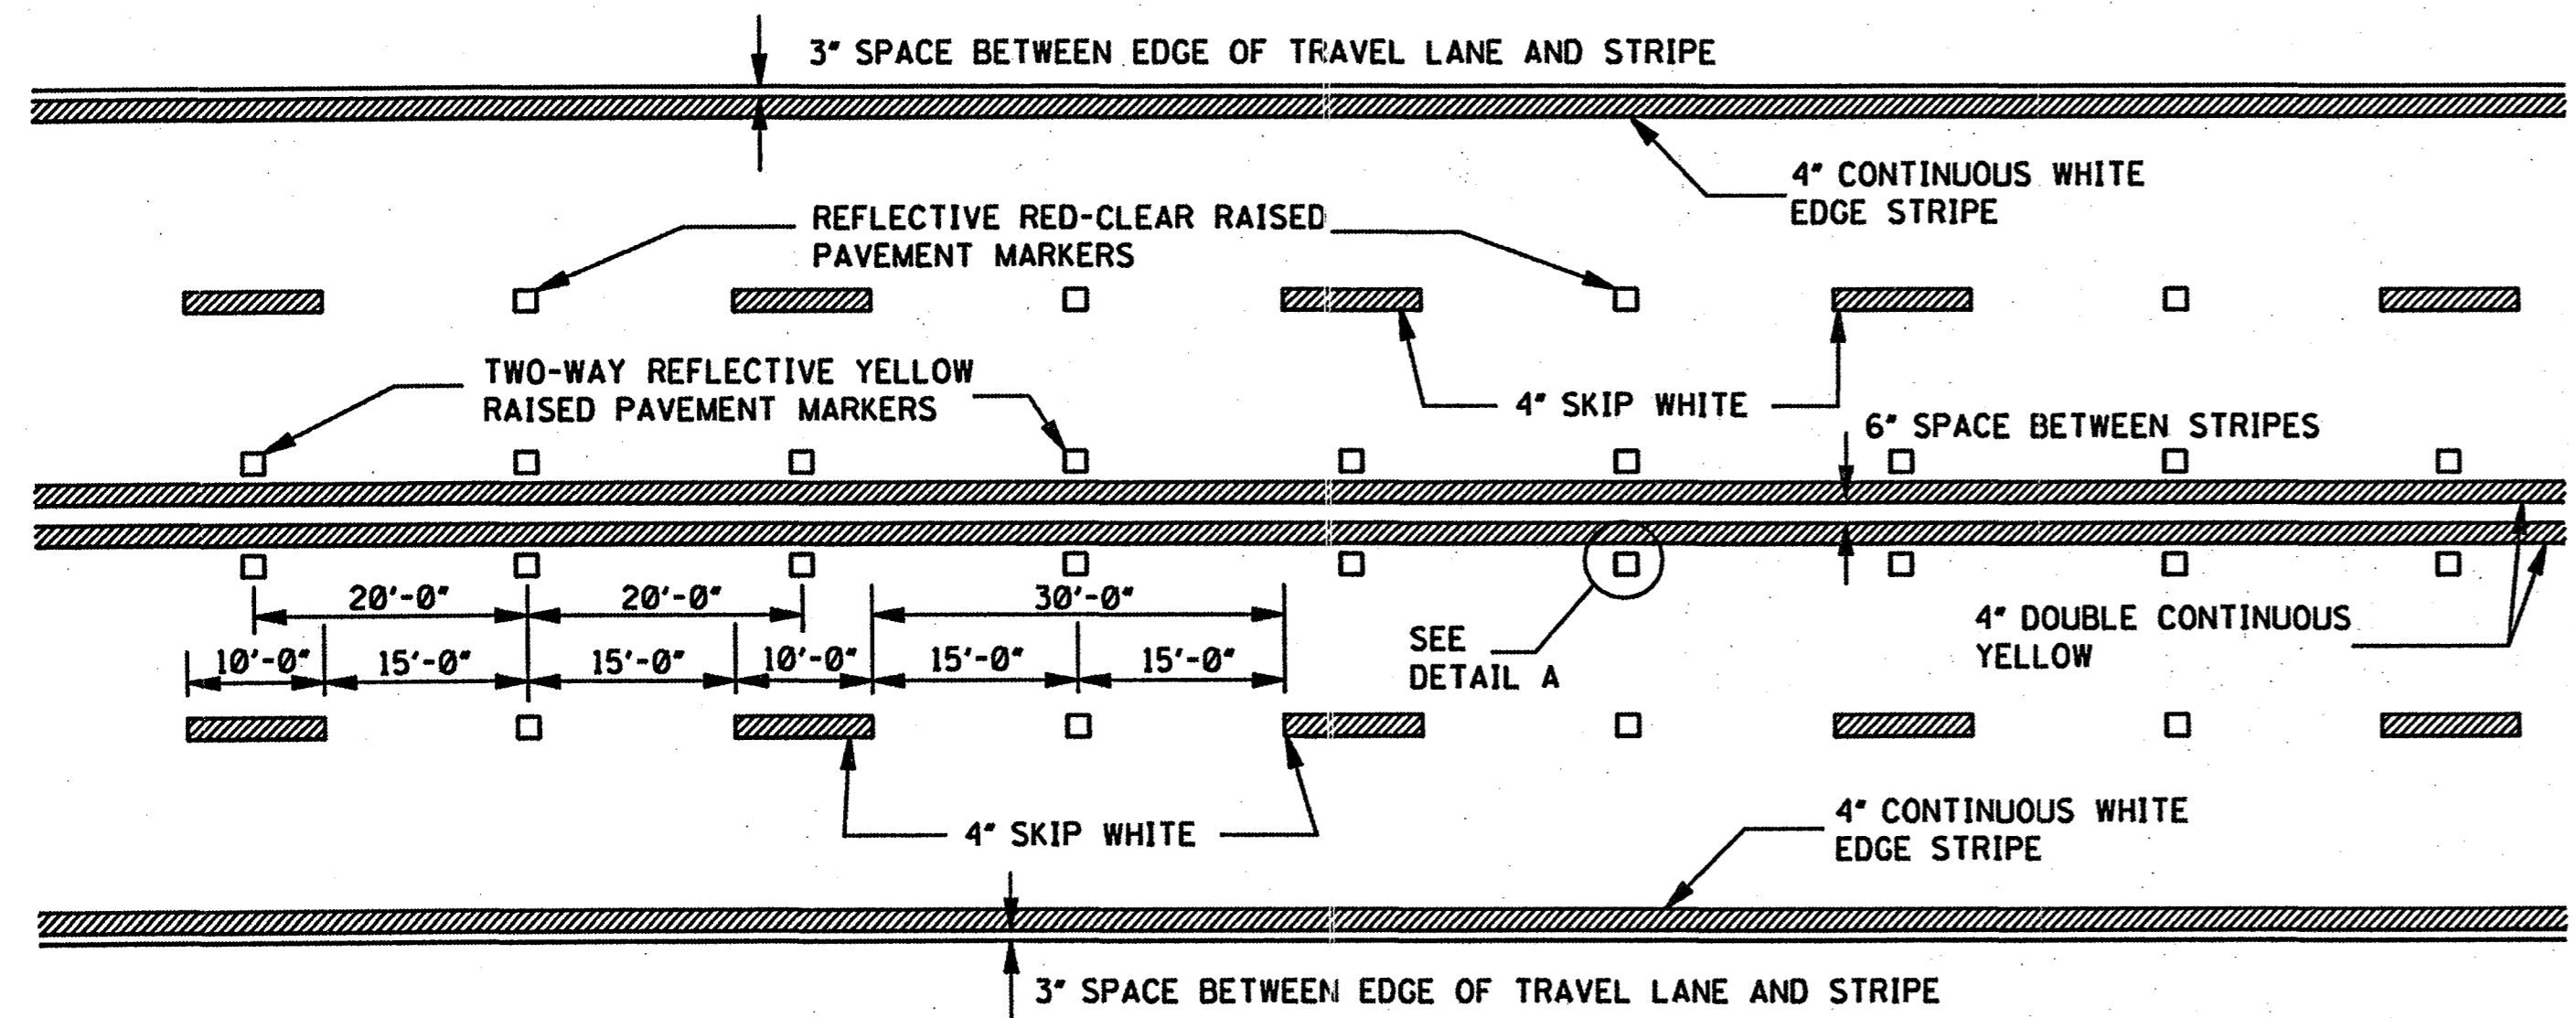

TYPICAL STRIPING AND RAISED PAVEMENT MARKERS FOR 4-LANE SECTION

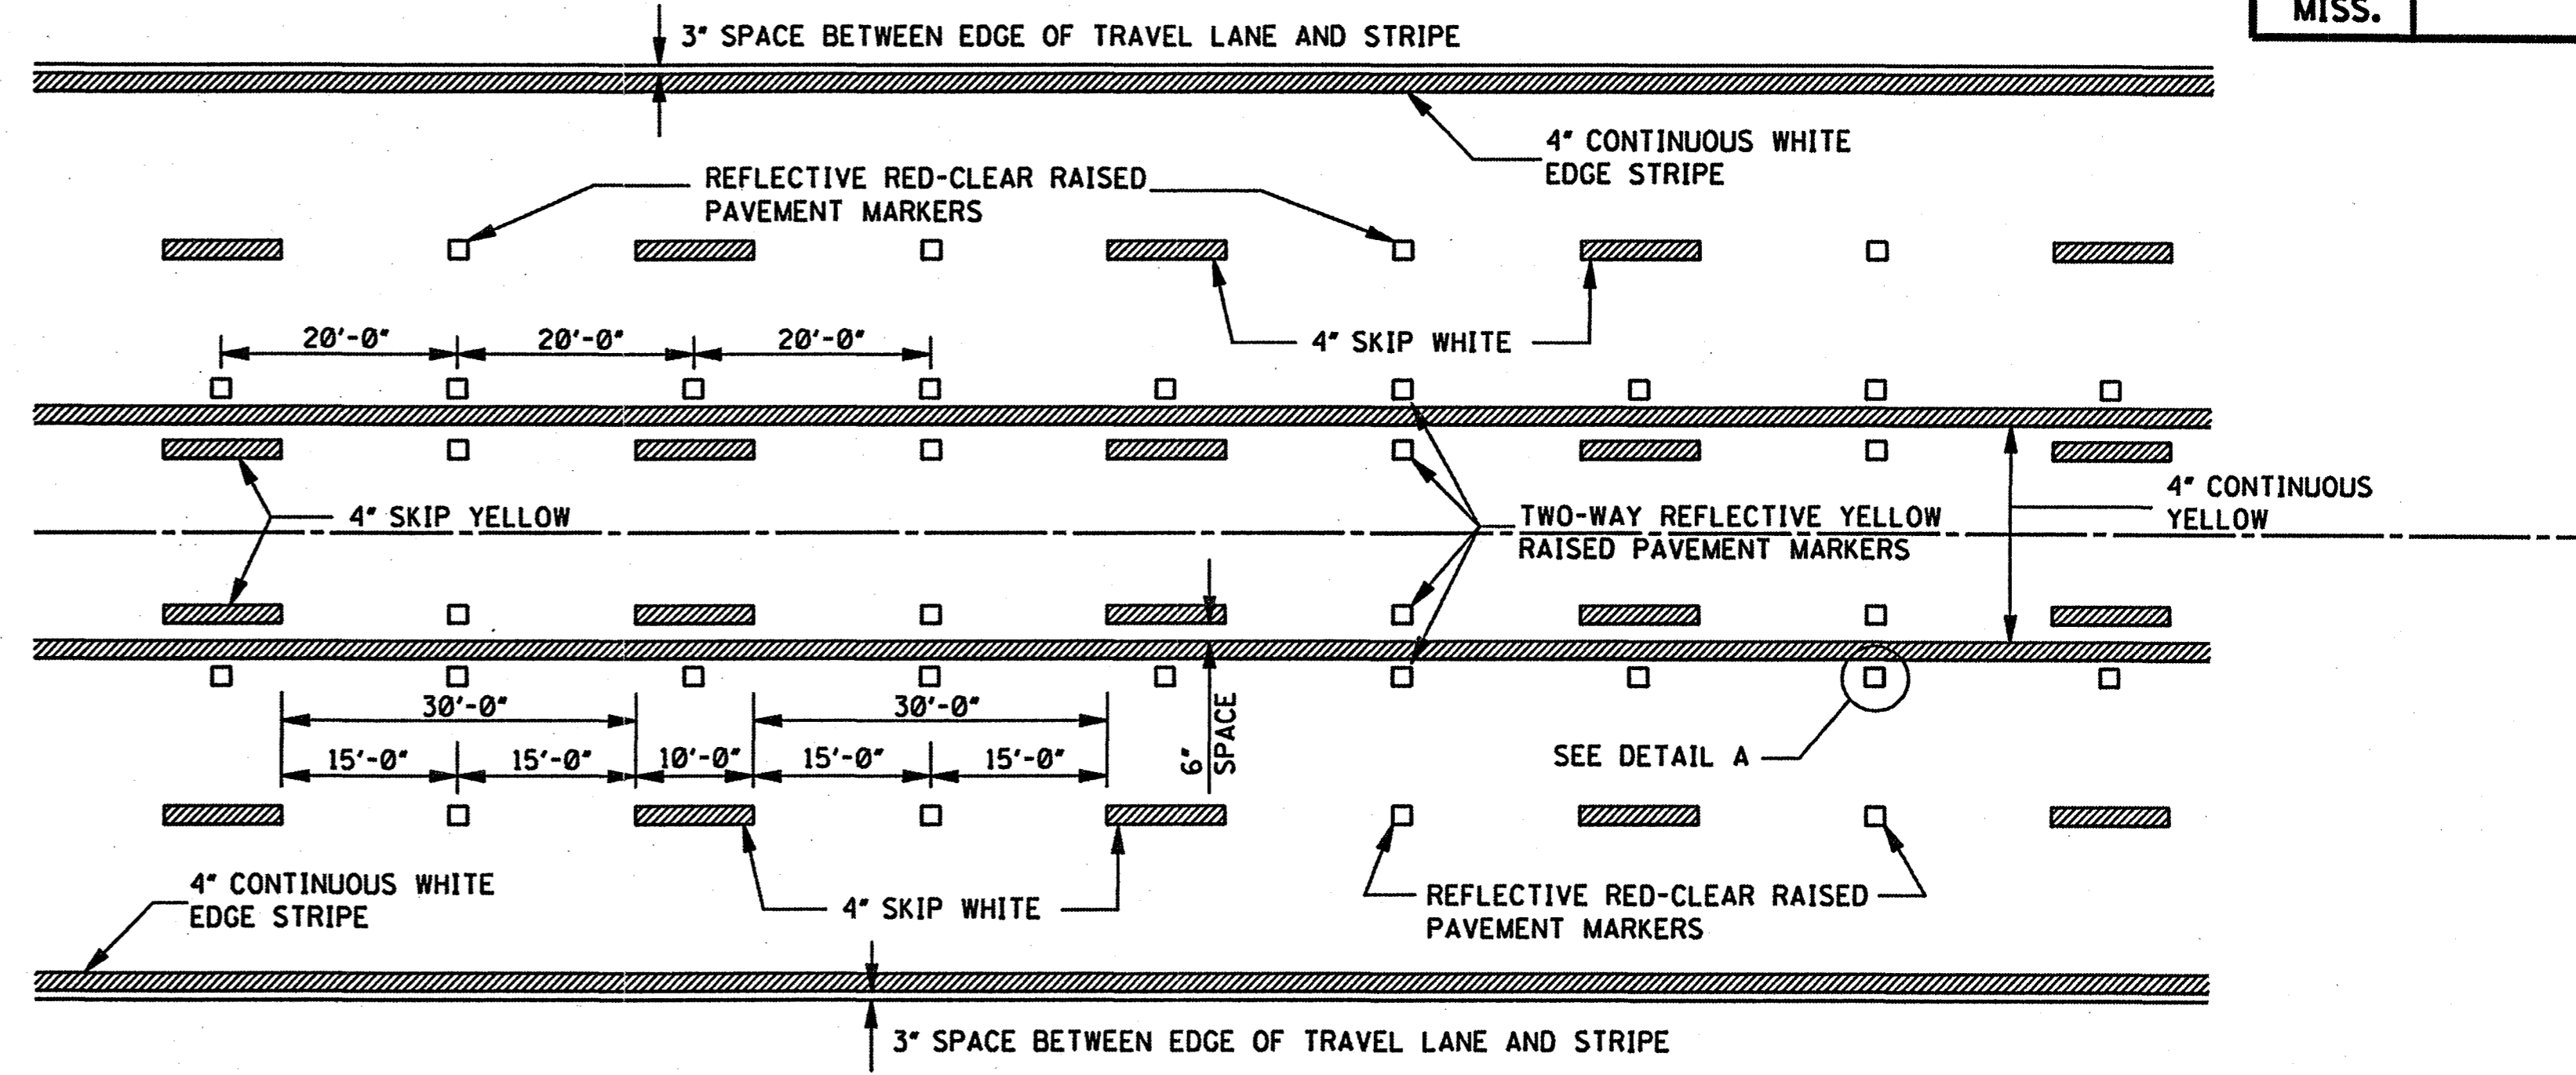


TYPICAL STRIPING AND RAISED PAVEMENT MARKERS FOR 5-LANE SECTION

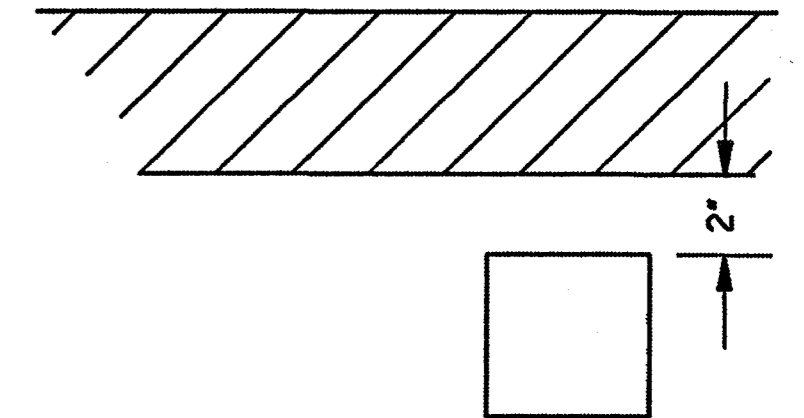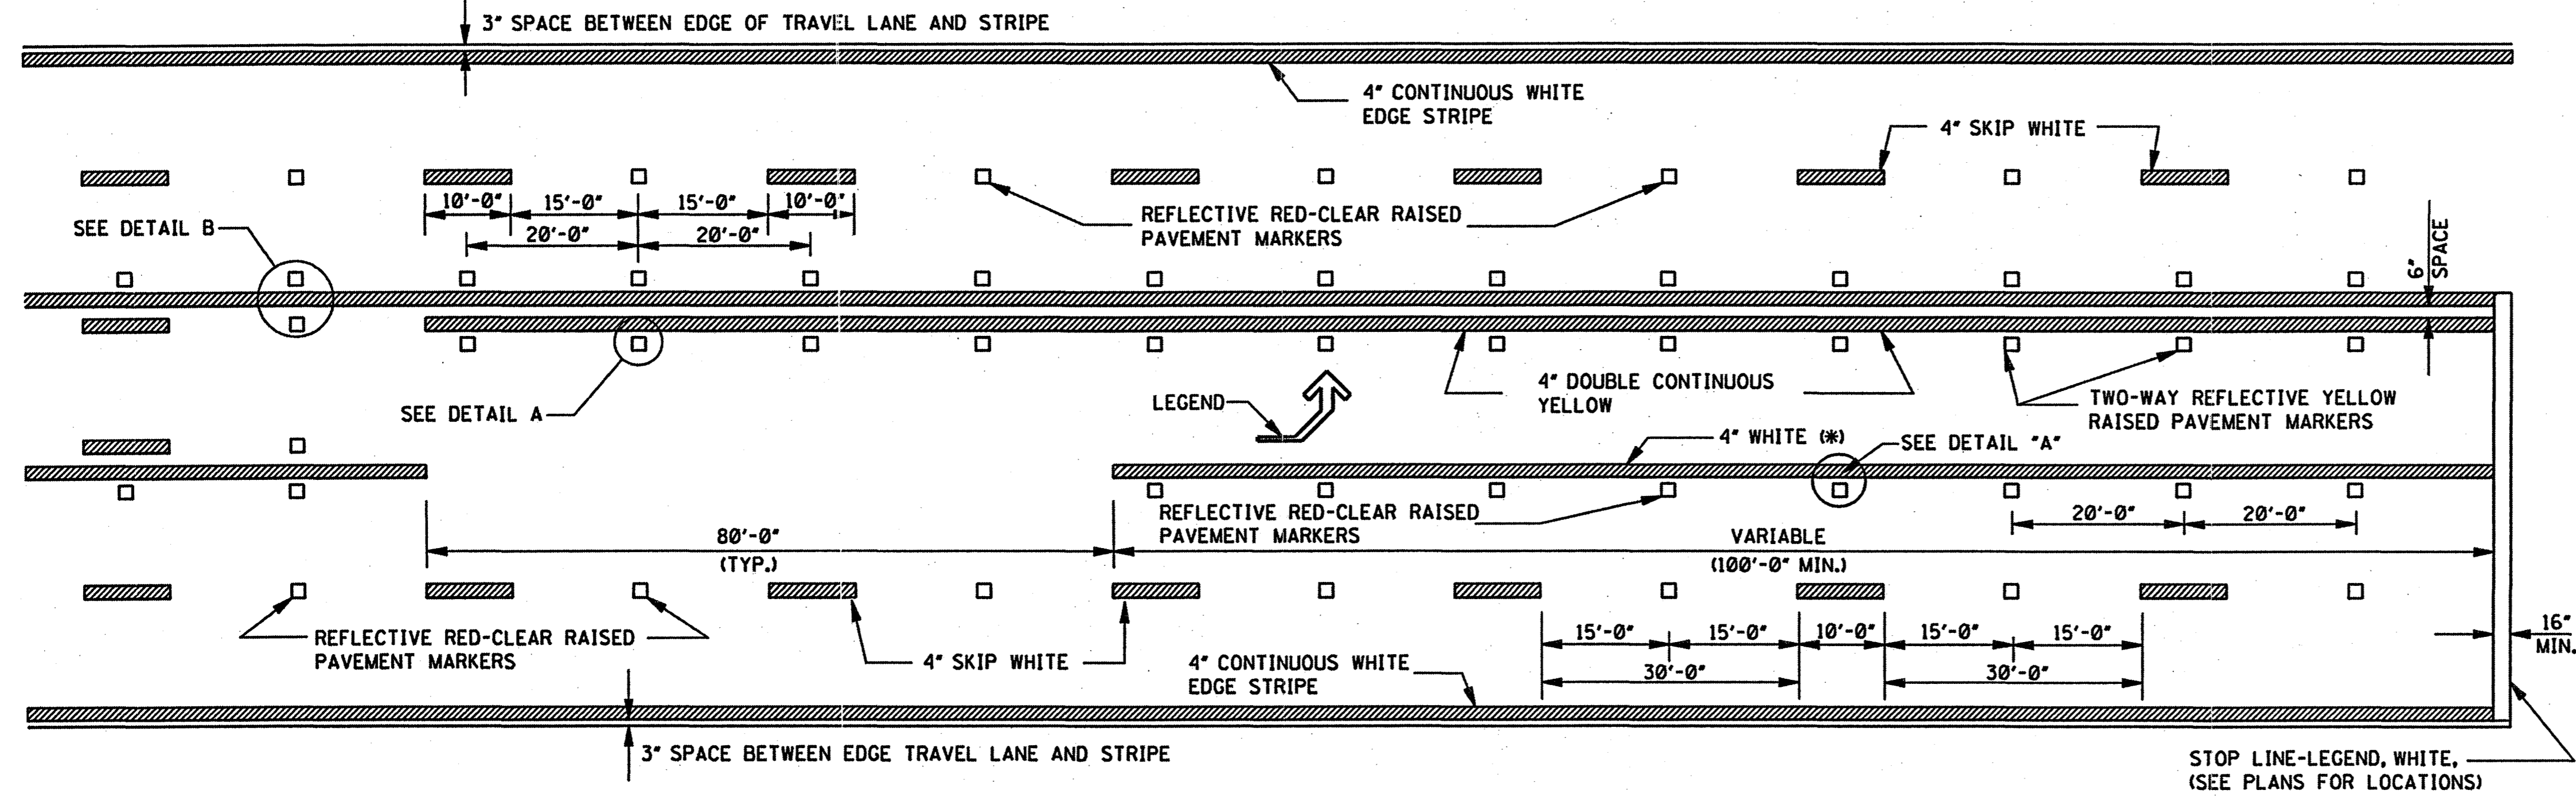

DETAIL A  
LATERAL PLACEMENT OF PAVEMENT MARKERS


- GENERAL NOTE:
1. PAVEMENT MARKERS SHALL BE HIGH PERFORMANCE RAISED PAVEMENT MARKERS AS LISTED IN THE MDOT "APPROVED SOURCES OF MATERIALS".
  2. REFLECTIVE RAISED PAVEMENT MARKERS TO BE USED IF TEMPORARY MARKINGS ARE TO REMAIN IN PLACE OVER 3 MONTHS
  3. TEMPORARY TURN ARROW TO BE PAID FOR AS TEMPORARY TRAFFIC STRIPE (LEGEND), ESTIMATED AT 10.9 SQ. FT. PER ARROW

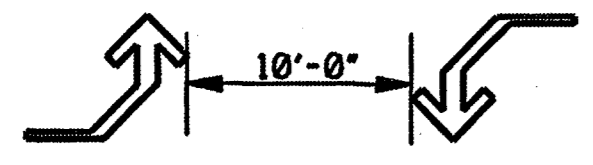


TYPICAL TWO-WAY ARROW INSTALLATION

- NOTES:
1. CONSIDER EACH SEGMENT OF CONTINUOUS TWO-WAY LEFT TURN LANE SEPARATELY.
  2. IF SEGMENT IS LESS THAN 350', PLACE ONE SET OF ARROWS IN CENTER OF SEGMENT.
  3. IF SEGMENT IS GREATER THAN 350', PLACE FIRST SET OF ARROWS 50' TO 100' FROM BEGINNING AND/OR END OF SEGMENT AND SPACE ADDITIONAL SETS OF ARROWS (250' O.C.).


TYPICAL STRIPING AND RAISED PAVEMENT MARKERS AT LEFT TURN LANES  
 \*NOTE: USE DETAIL STRIPING IF LENGTH ≤ 150' AT THIS LOCATION, OTHERWISE USE CONTINUOUS STRIPING.



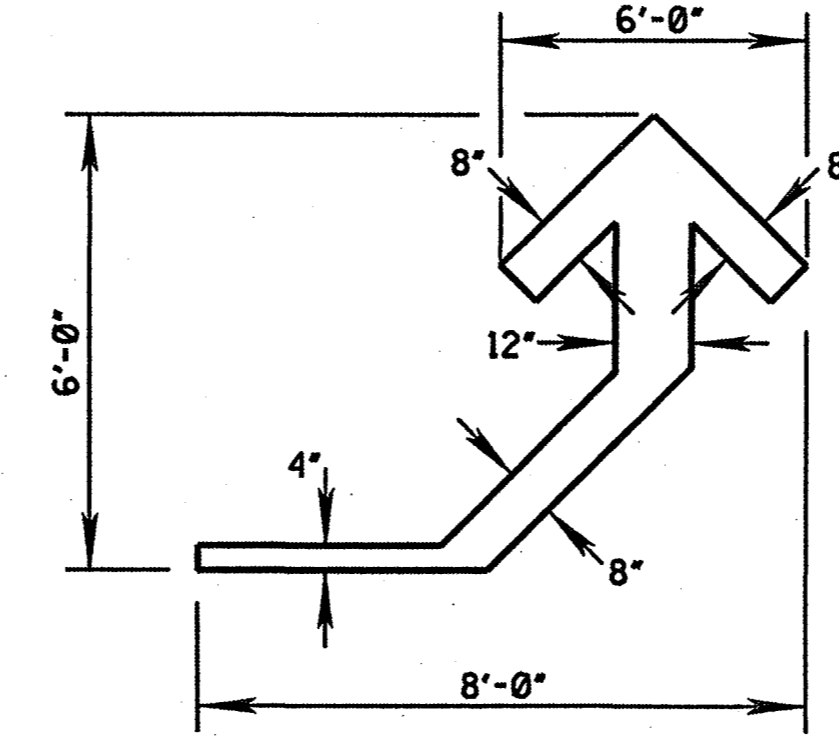


DETAIL OF TEMPORARY TURN ARROW

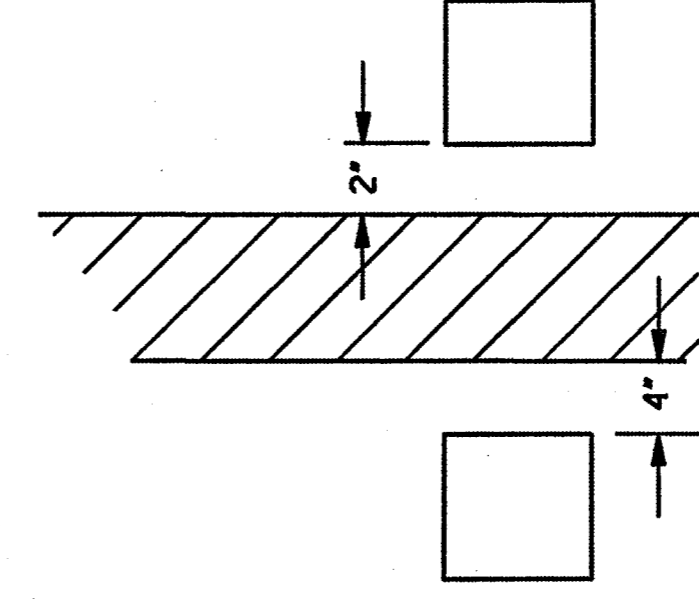

DETAIL B  
LATERAL PLACEMENT OF PAVEMENT MARKERS













BY		MISSISSIPPI DEPARTMENT OF TRANSPORTATION ROADWAY DESIGN DIVISION STANDARD PLAN	
REVISION		<b>TEMPORARY STRIPING FOR TRAFFIC CONTROL 4-LANE AND 5-LANE UNDIVIDED ROADWAYS</b>	
DATE		ISSUE DATE: DECEMBER 1, 1999	 WORKING NUMBER TCP-16 SHEET NUMBER 265

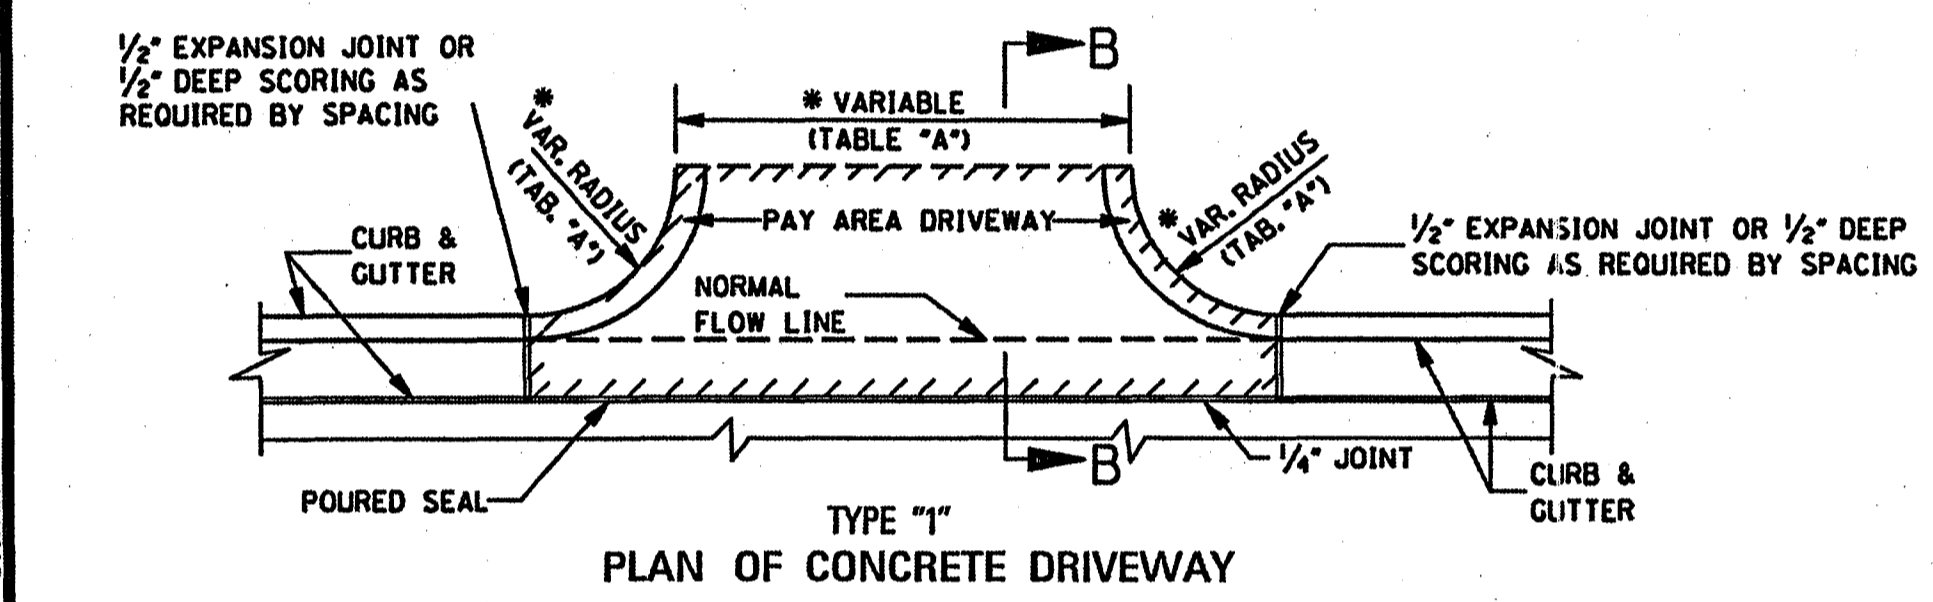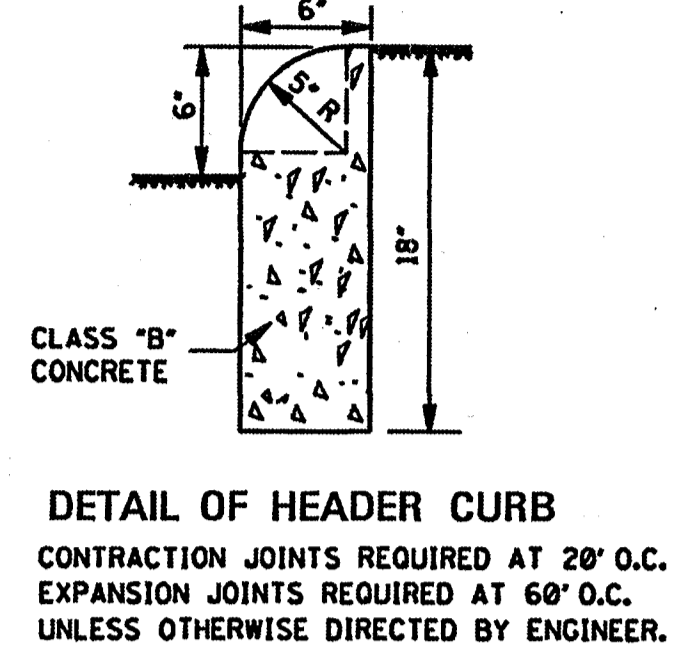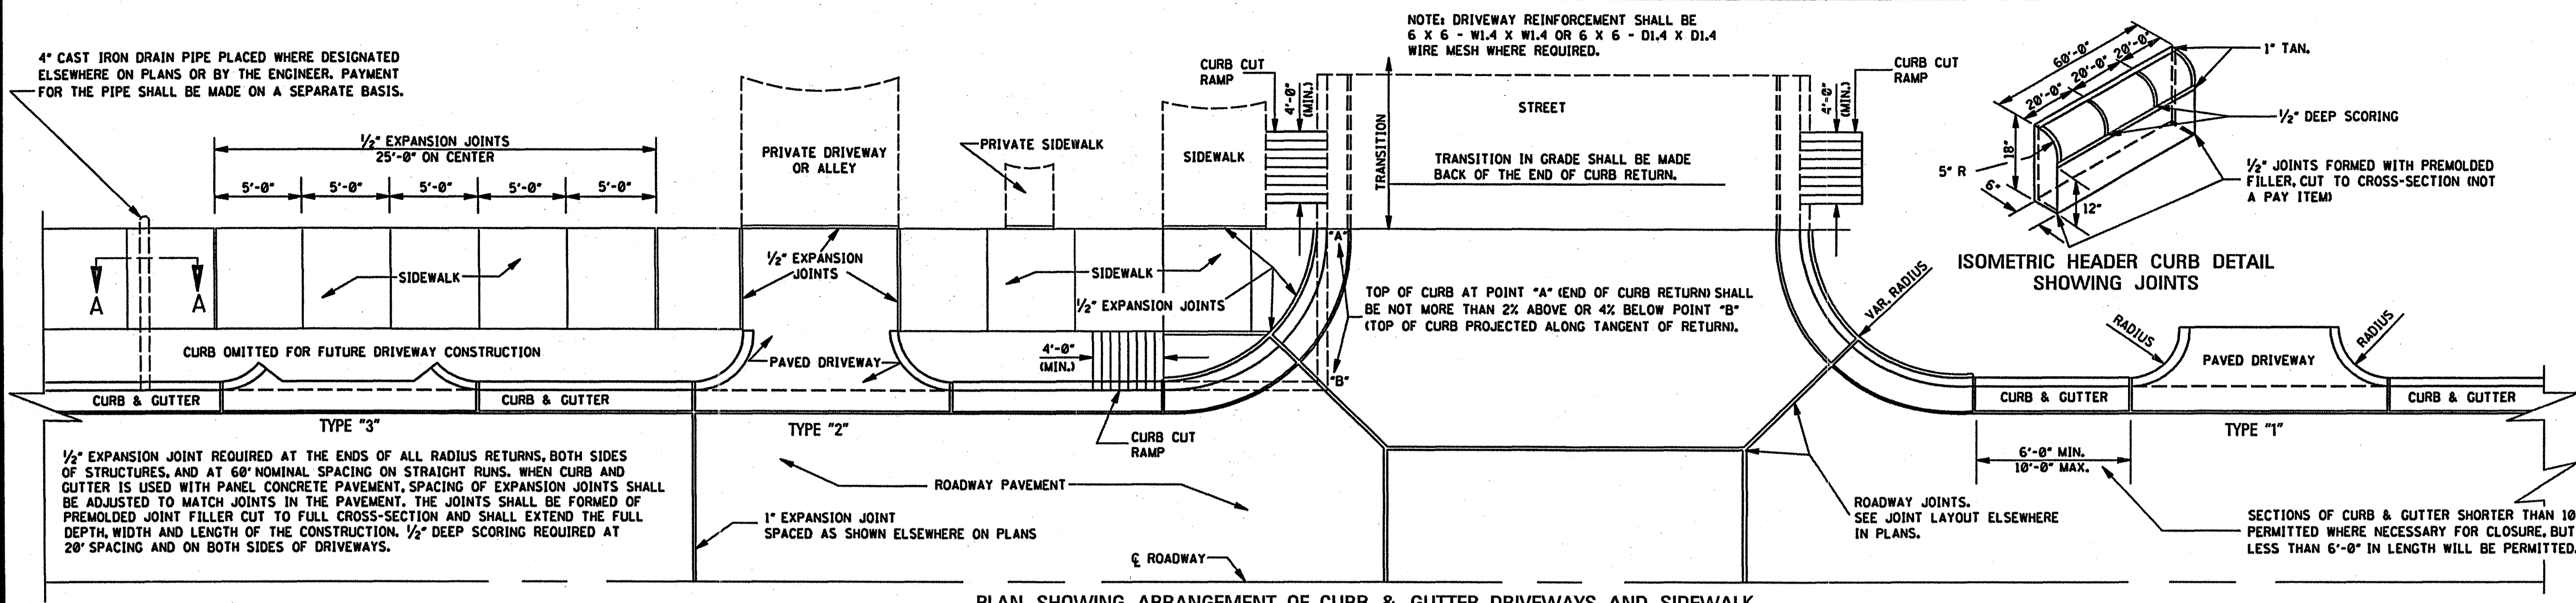

**\*TABLE \"A\"**

DRIVEWAY TYPE	DRIVEWAY WIDTH (ft)	CURB RETURN RADIUS (ft)
RESIDENTIAL	16'	3' - 10'
COMMERCIAL/ INDUSTRIAL	30' - 50'	5' - 30'

11.058 yd<sup>2</sup> FOR DRIVEWAY 16'-0" IN WIDTH.  
0.574 yd<sup>2</sup> FOR EACH ADDED OR SUBTRACTED FOOT OF WIDTH.  
NOTE: THIS DRIVEWAY AREA EXAMPLE IS COMPUTED ON THE BASIS OF 3'-0" RADIUS. PAYMENT FOR CURB RADIUS SHALL BE INCLUDED IN COMPENSATION FOR DRIVEWAY.

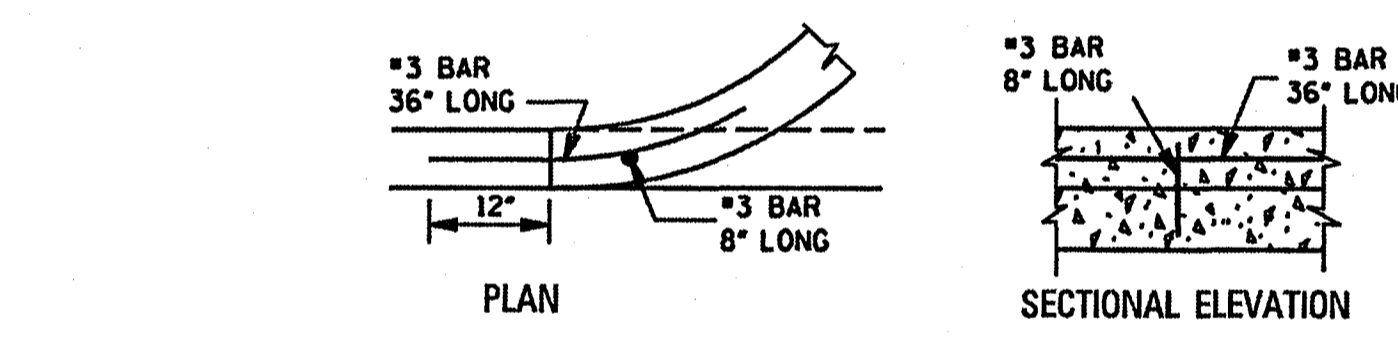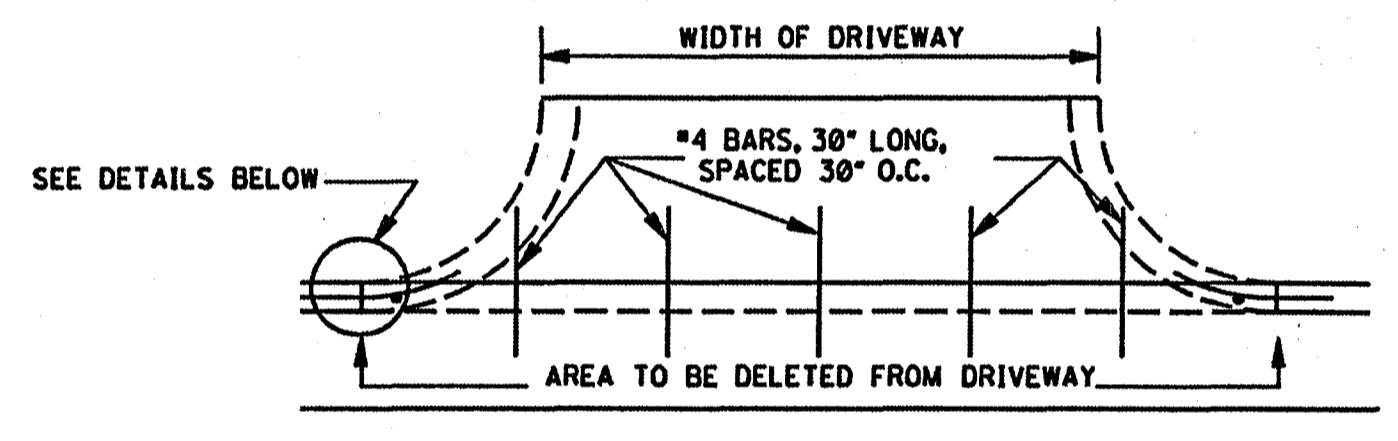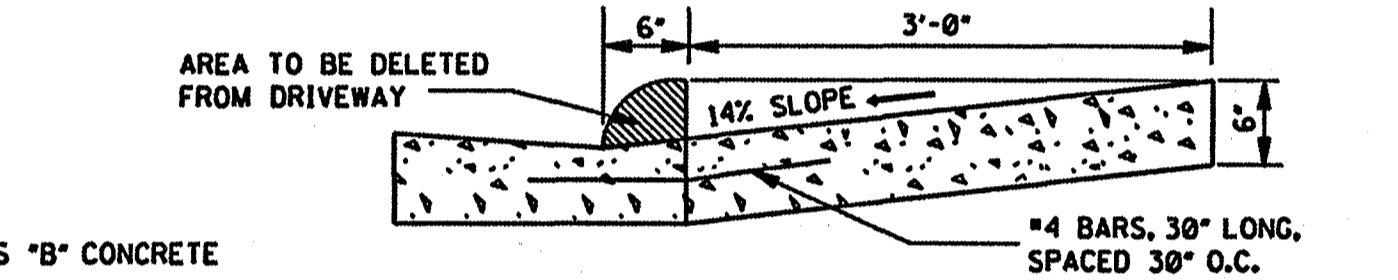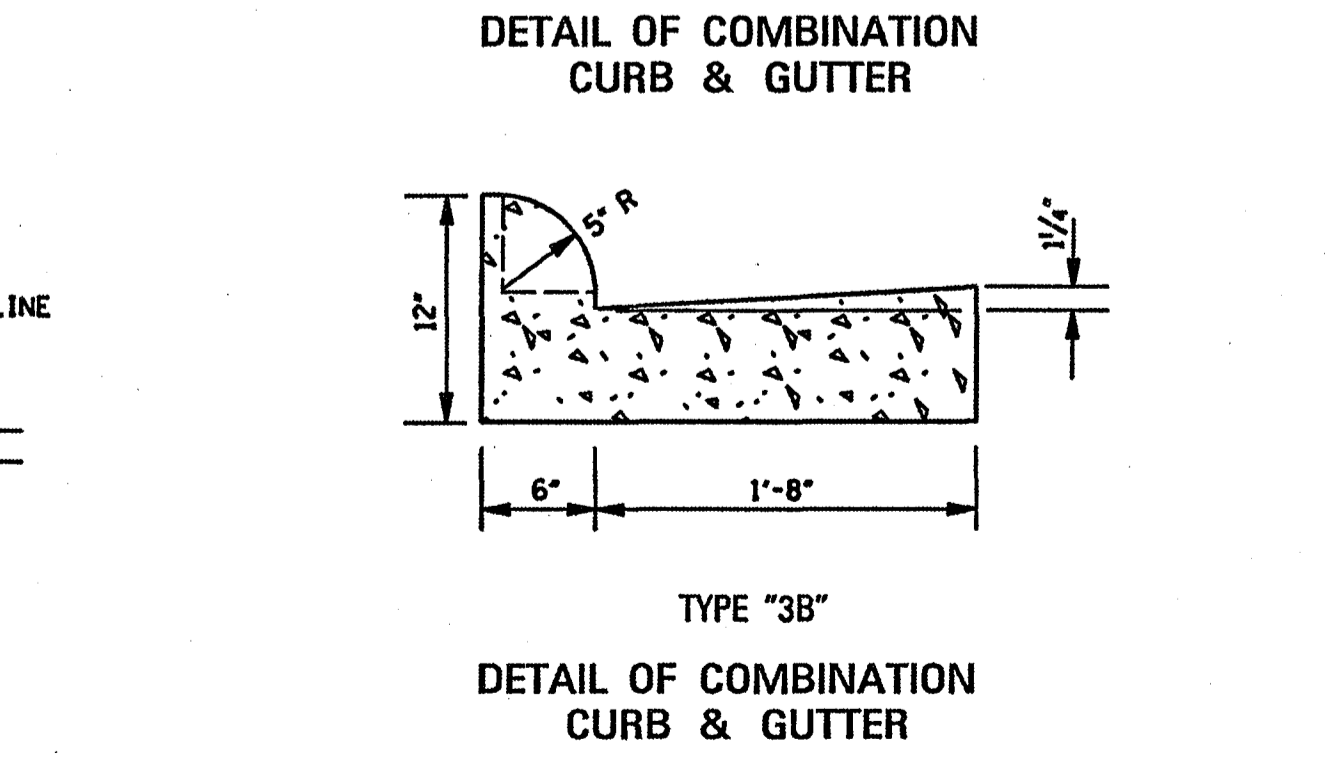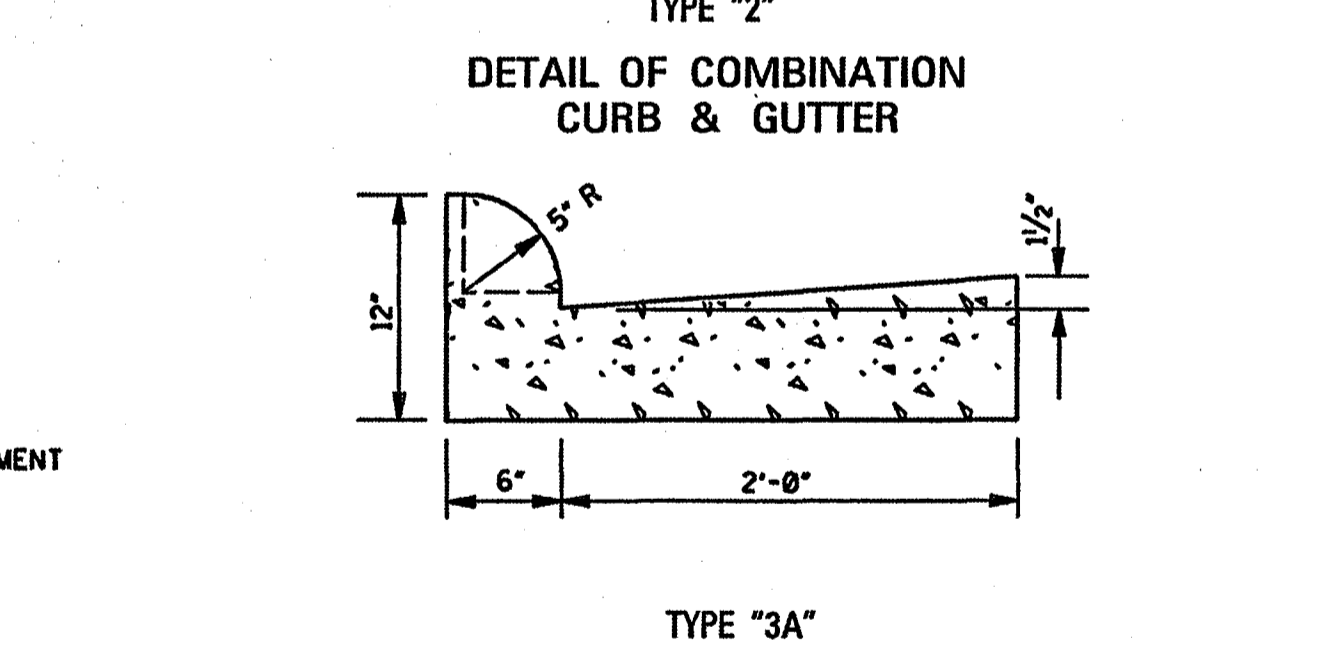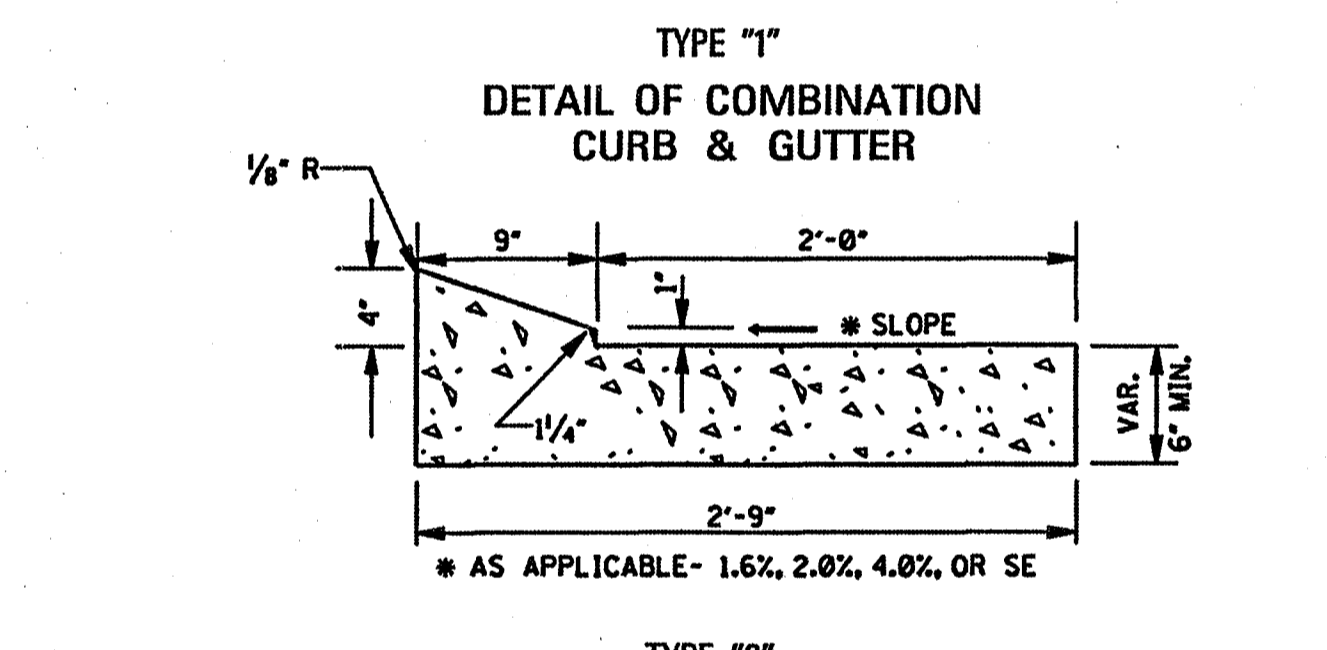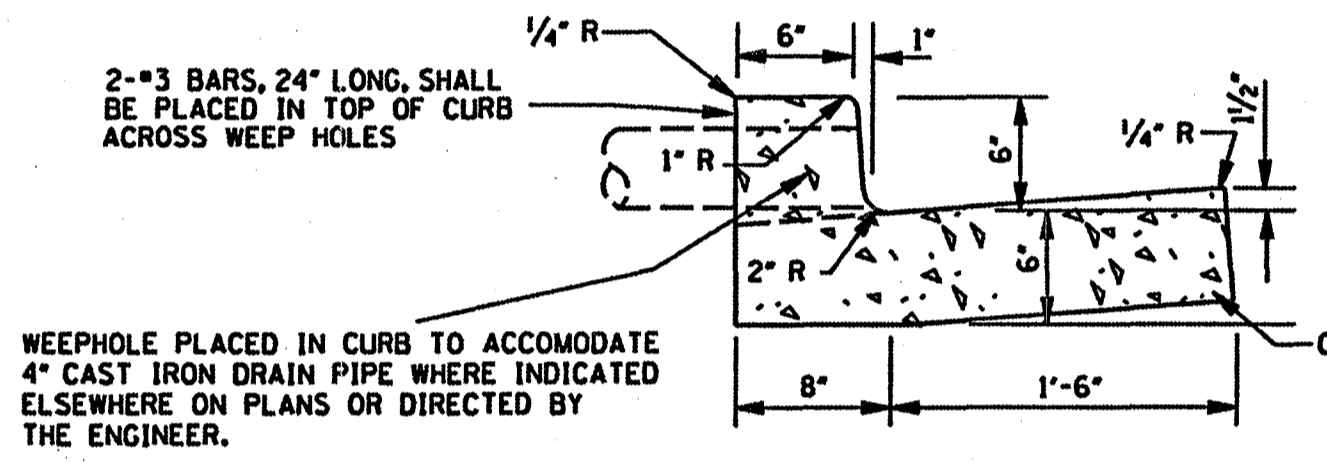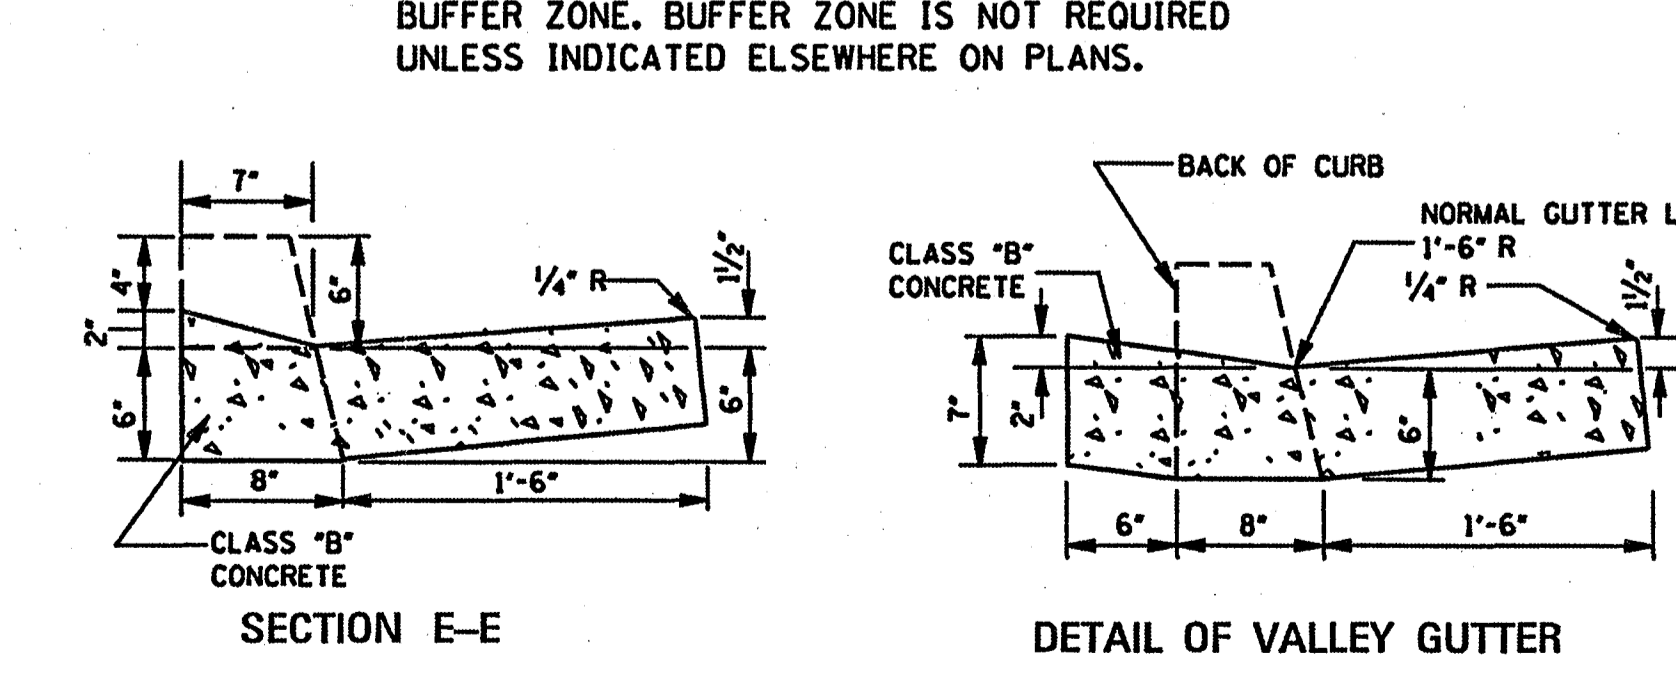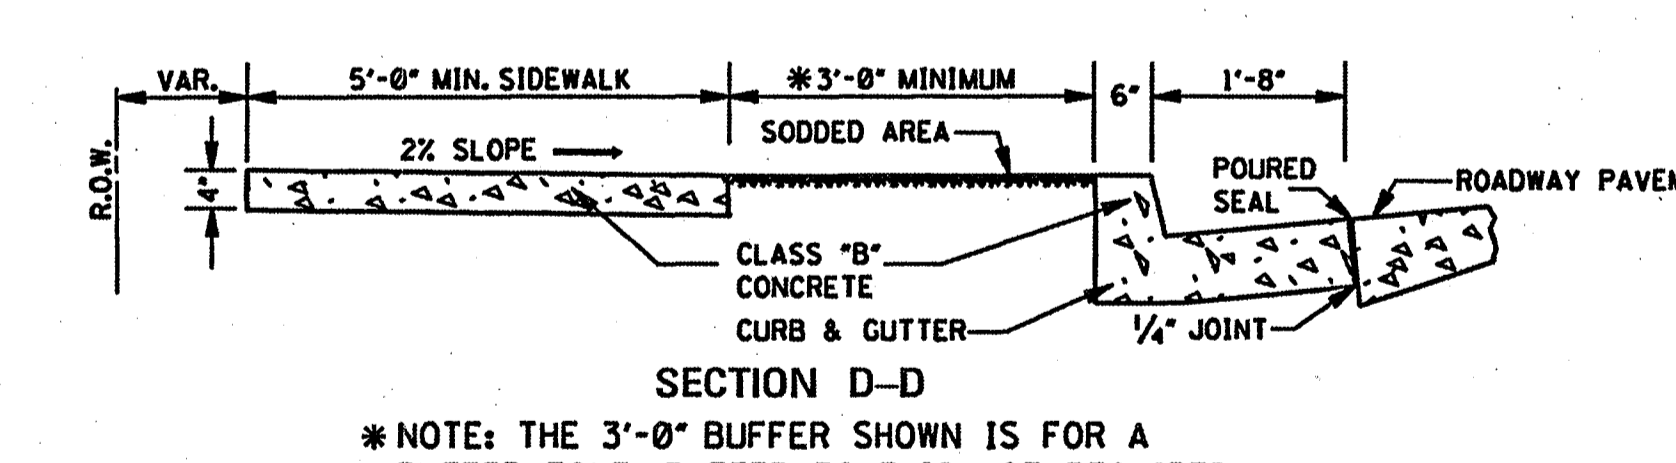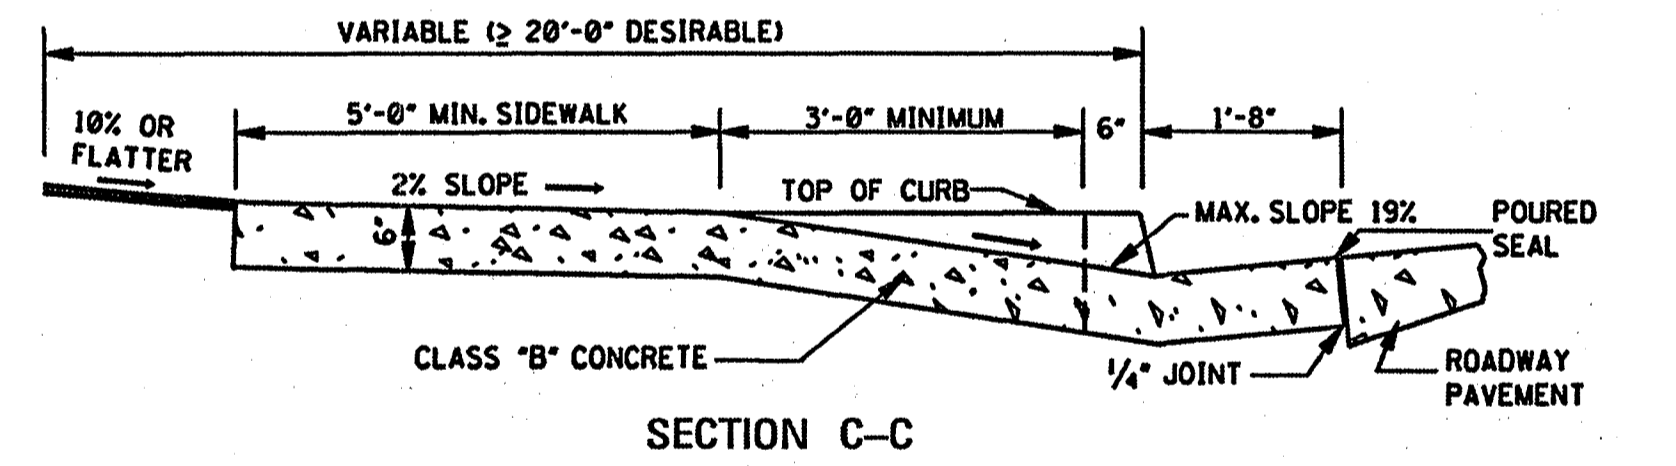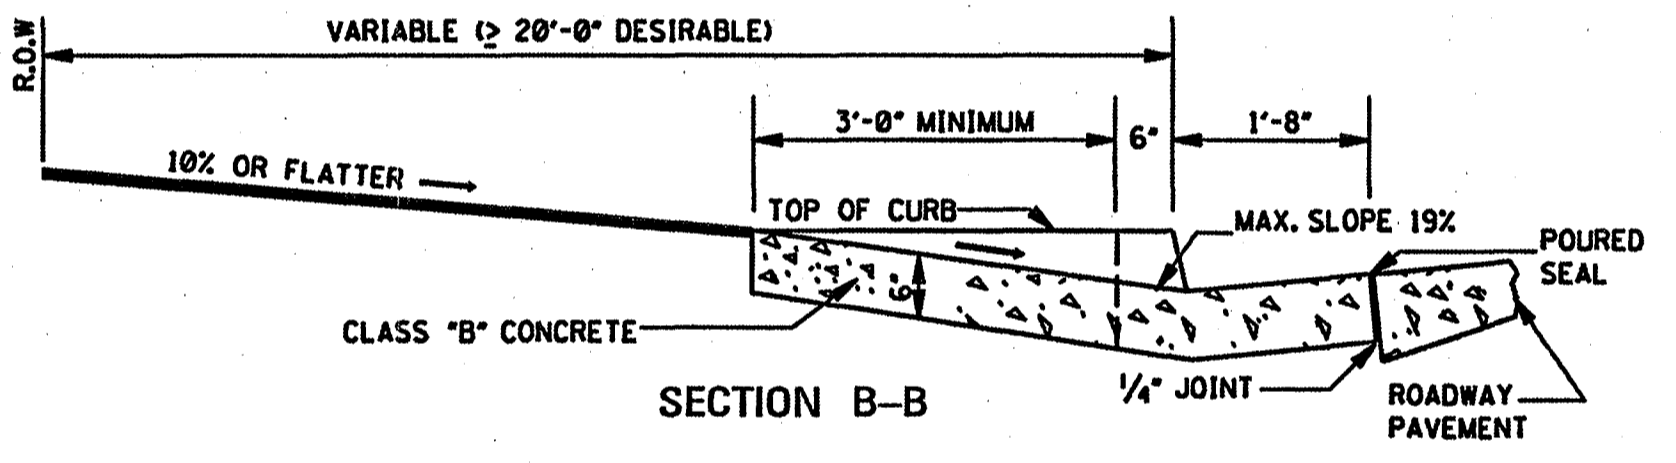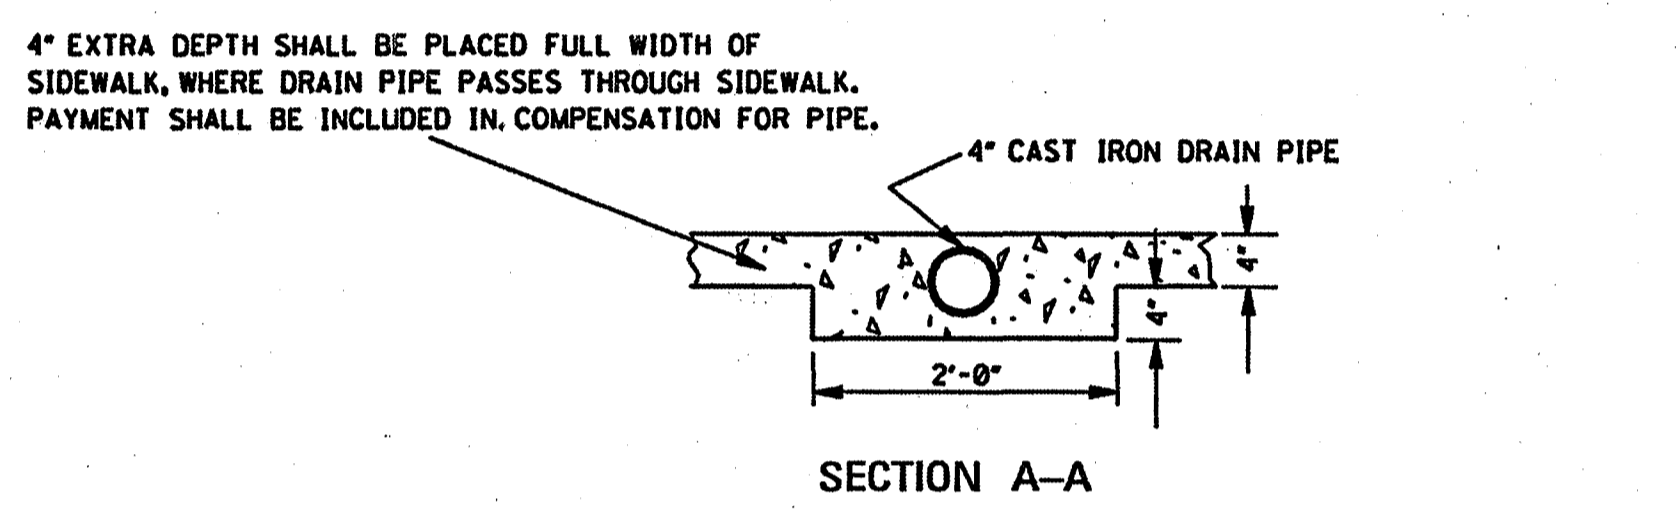

- GENERAL NOTES:**
1. THE STANDARD SPECIFICATIONS ADOPTED BY THE MISSISSIPPI DEPARTMENT OF TRANSPORTATION SHALL, UNLESS OTHERWISE SPECIFIED HEREIN, APPLY TO ALL ITEMS INCLUDED ON THIS DRAWING.
  2. TRANSVERSE CONTRACTION JOINTS ARE REQUIRED AT 20' ON CENTER FOR ALL CONCRETE DRIVEWAYS THAT EXTEND PAST THE END OF THE CURB RETURN. A 1/2" WIDE EXPANSION JOINT IS REQUIRED AT THE END OF THE CURB RETURN AND AT 60' ON CENTER THROUGHOUT THE LENGTH OF THE DRIVEWAY. A LONGITUDINAL CONTRACTION JOINT IS REQUIRED FOR ALL DRIVEWAYS EXCEEDING 20' IN WIDTH.
  3. SEE SHEET CCR-1 FOR DETAILS OF CURB-CUT RAMPS.

MISSISSIPPI DEPARTMENT OF TRANSPORTATION  
ROADWAY DESIGN DIVISION  
STANDARD PLAN

**DRIVEWAYS,  
CURB & GUTTER  
& SIDEWALK**


WORKING NUMBER SD-1  
SHEET NUMBER 287

ISSUE DATE: OCTOBER 1, 1998


**CORRUGATED STEEL AND ALUMINUM PIPE (ROUND)  
H-20 LOADING**

PIPE DIAMETER (in)	MINIMUM COVER FROM TOP OF PIPE TO TOP OF SUBGRADE (in)	MAXIMUM FILL HEIGHT ABOVE TOP OF PIPE (ft)				
		SHEET THICKNESS (in)				
		0.064 STEEL 0.060 ALUM. 16 GAGE	0.079 STEEL 0.075 ALUM. 14 GAGE	0.109 STEEL 0.105 ALUM. 12 GAGE	0.138 STEEL 0.135 ALUM. 10 GAGE	0.168 STEEL 0.164 ALUM. 8 GAGE
		2 1/2" x 1/2" CORRUGATED STEEL / CORRUGATED ALUMINUM RIVETED, WELDED OR HELICAL		3" x 1" OR 5" x 1" CORRUGATED STEEL / CORRUGATED ALUMINUM RIVETED, WELDED, HELICAL OR BOLTED		2 1/2" x 1/2" CORRUGATED ALUMINUM RIVETED OR HELICAL
12"	12"	84' / - / 45'	91' / - / 45'	- / - / 78'	- / - / 81'	- / - / 84'
15"	12"	67' / - / -	73' / - / -	- / - / -	- / - / -	- / - / -
18"	12"	56' / - / 30'	61' / - / 30'	- / - / 52'	- / - / 54'	- / - / 56'
24"	12"	42' / - / 22'	46' / - / 22'	59' / - / 39'	- / - / 41'	- / - / 42'
30"	12"	34' / - / 18'	36' / - / 18'	47' / - / 31'	- / - / 32'	- / - / 34'
36"	12"	28' / 48' / 15'	30' / 60' / 15'	39' / 78' / 26'	41' / 89' / 27'	- / 101' / 28'
42"	12"	31' / 41' / -	43' / 51' / 26'	46' / 64' / 43'	48' / 71' / 43'	50' / 79' / 44'
48"	12"	27' / 36' / -	37' / 45' / -	45' / 57' / 40'	46' / 61' / 41'	47' / 66' / 43'
54"	12"	- / 32' / -	33' / 40' / -	43' / 52' / 35'	44' / 55' / 37'	45' / 59' / 38'
60"	12"	- / 29' / -	- / 36' / -	43' / 49' / -	43' / 51' / 33'	44' / 54' / 34'
66"	12"	- / 26' / -	- / 33' / -	42' / 47' / -	43' / 49' / 30'	43' / 51' / 31'
72"	12"	- / 24' / -	- / 30' / -	- / 44' / -	41' / 47' / -	43' / 49' / 29'
78"	12"	- / 22' / -	- / 28' / -	- / 41' / -	- / 46' / -	39' / 47' / -
84"	12"	- / 21' / -	- / 26' / -	- / 38' / -	- / 45' / -	35' / 46' / -
90"	12"	- / 19' / -	- / 24' / -	- / 35' / -	- / 43' / -	- / 45' / -
96"	12"	- / 18' / -	- / 22' / -	- / 33' / -	- / 40' / -	- / 44' / -
102"	24"	- / 17' / -	- / 21' / -	- / 31' / -	- / 38' / -	- / 42' / -
108"	24"	- / - / -	- / 20' / -	- / 30' / -	- / 35' / -	- / 39' / -
114"	24"	- / - / -	- / 19' / -	- / 28' / -	- / 34' / -	- / 37' / -
120"	24"	- / - / -	- / - / -	- / 27' / -	- / 32' / -	- / 35' / -


NOTE: THE AVERAGE INSIDE DIAMETER SHALL NOT VARY MORE THAN ONE (1) PERCENT OR 1/2", WHICHEVER IS GREATER, FROM THE NOMINAL DIAMETER WHEN MEASURED ON THE INSIDE CREST OF THE CORRUGATIONS (AASHTO M 36M/M 36 & AASHTO M 196M/M 196).

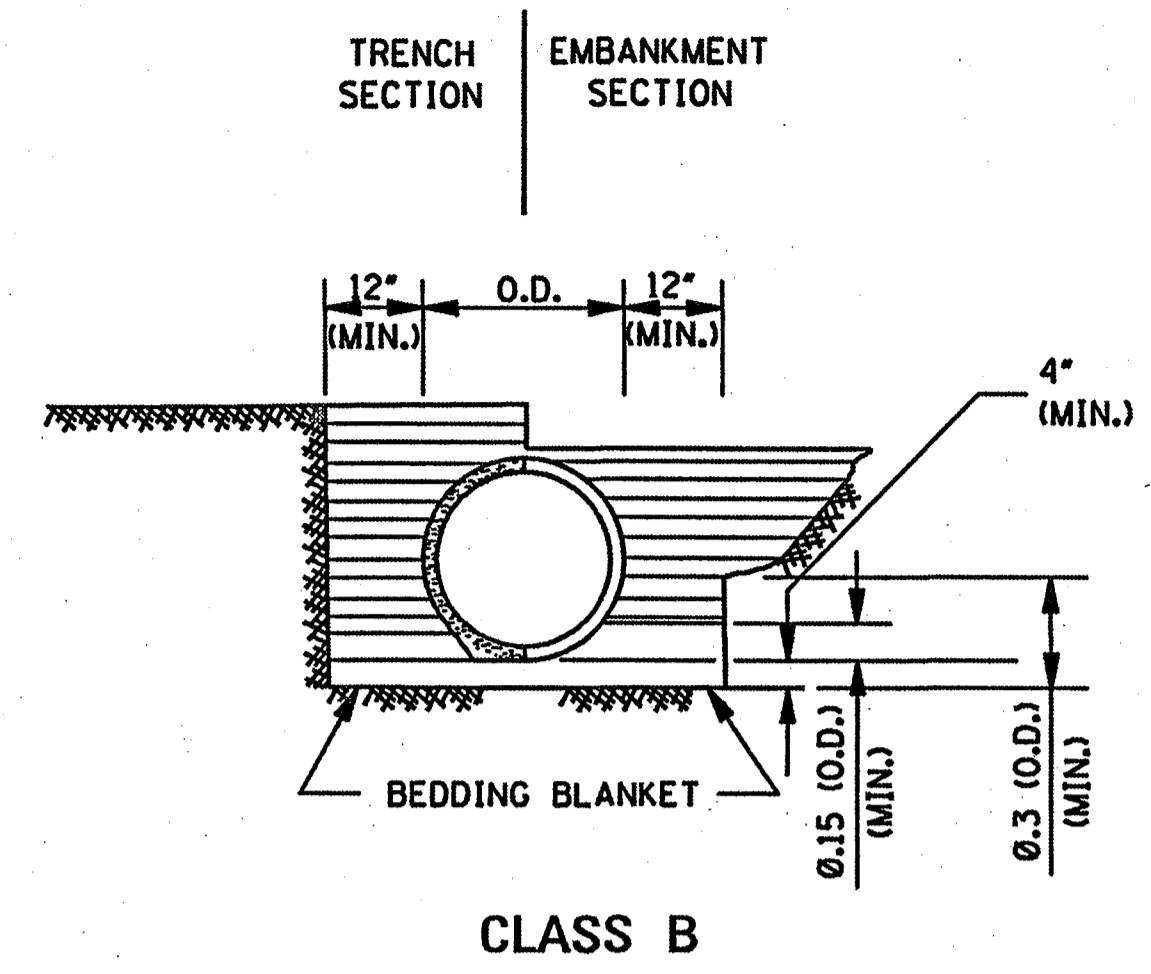

CLASS B

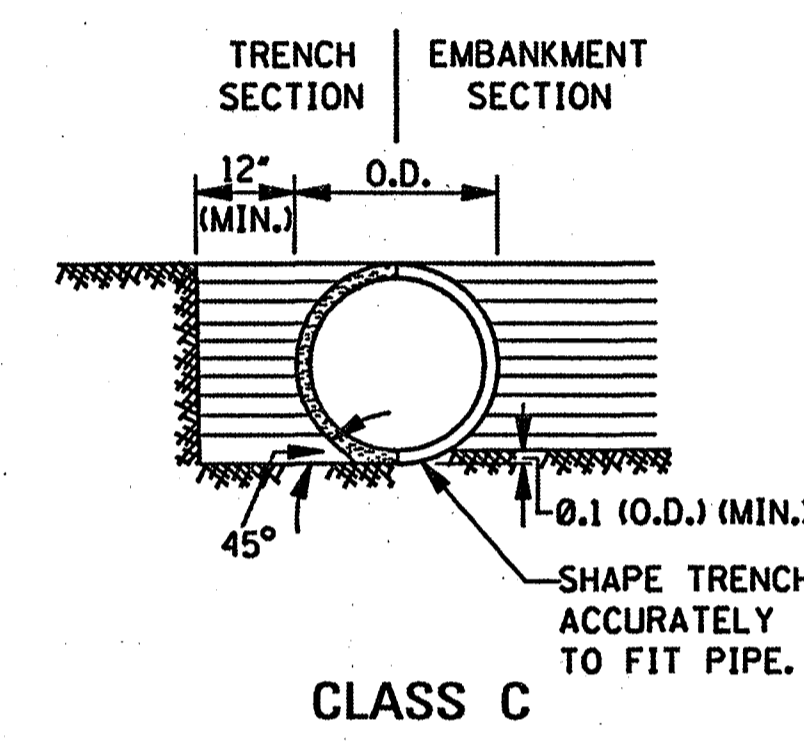

CLASS C

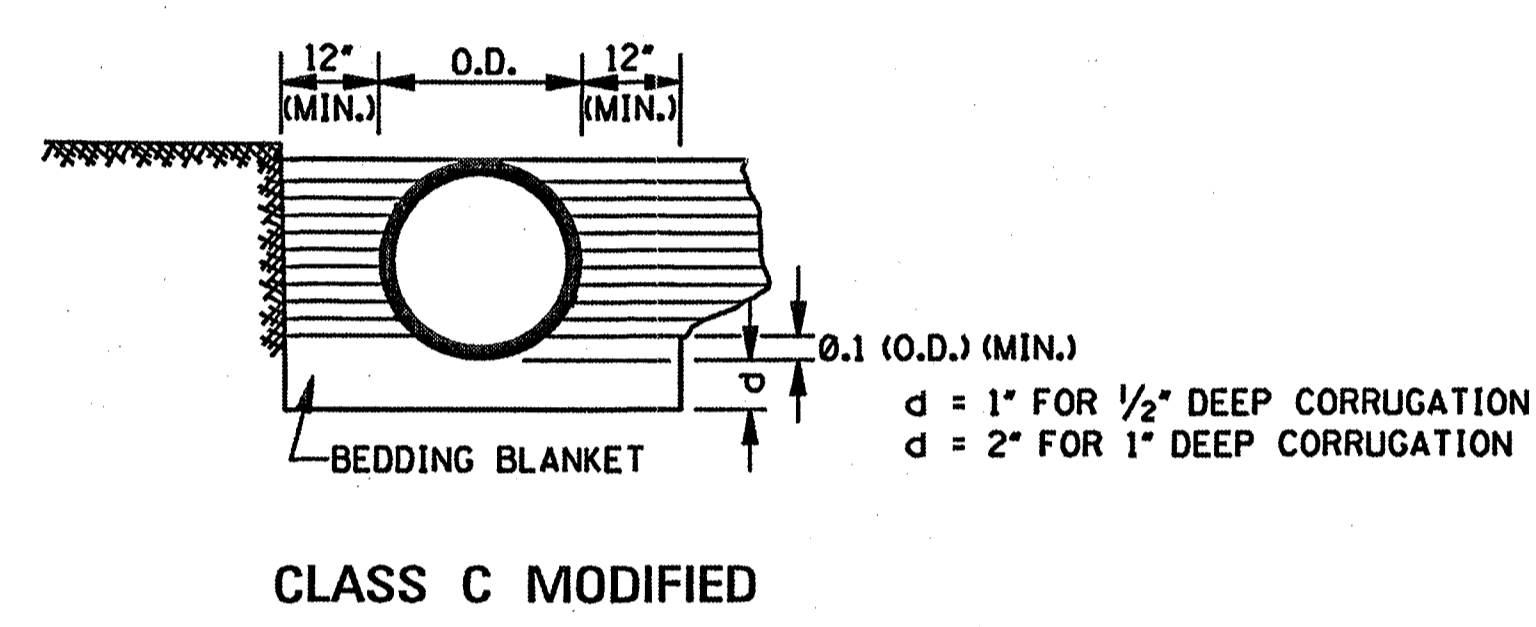

CLASS C MODIFIED

**MAXIMUM HEIGHT OF FILL OVER REINFORCED CONCRETE PIPE**

CLASS OF PIPE	TYPE OF BACKFILL	MAXIMUM COVER (ft)	
		CLASS "C" BEDDING	CLASS "B" BEDDING
III	NORMAL	16'	-
IV	NORMAL	23'	28'
V	NORMAL	30'	36'
IV	IMPERFECT	-	90'
V	IMPERFECT	-	115'

NOTE: CLASS OF PIPE AND BEDDING TO BE CONSISTENT THROUGHOUT THE PIPE LENGTH.

**MAXIMUM HEIGHT OF FILL OVER CLASS 2 NONREINFORCED CONCRETE PIPE, PERFORATED AND/OR PLAIN, FOR UNDERDRAINS**


PIPE SIZE (in)	MAXIMUM COVER (ft)			
	BEDDING CLASS "C"/CLASS "B"			
	TRENCH	SAND & GRAVEL	DAMP CLAY	PROJECTING POSITIVE
4"	2.00'	*	*	34'/42'
6"	2.00'	*	*	25'/30'
8"	2.25'	*	16'/*	19'/24'
10"	2.50'	*	12'/20'	16'/19'
12"	2.75'	*	12'/18'	14'/17'

NOTES:  
 \* 1. INDICATES NO LIMIT OF FILL HEIGHT (130 lbs/ft<sup>3</sup>).  
 2. TRENCH WIDTH (B<sub>d</sub>) NO GREATER THAN 16" PLUS O.D.  
 3. FACTOR OF SAFETY IS 1.25 ON MINIMUM ULTIMATE STRENGTH.  
 4. MINIMUM COVER FOR HIGHWAY LOADS IS 18".  
 5. PERFORATED PIPE SHALL BE TYPE 1.


**CORRUGATED METAL PIPE ARCHES H-20 LOADING**

EQUIV. DIAMETER (in)	PIPE DIMENSION (SPAN X RISE) (in)	MINIMUM CORNER RADIUS (in)	MINIMUM COVER FROM TOP OF PIPE TO TOP OF SUBGRADE FOR 2 TONS/FT <sup>2</sup> (in)	STEEL		ALUMINUM			
				MINIMUM THICKNESS REQUIRED (in)	MAXIMUM FILL HEIGHT ABOVE TOP OF PIPE (ft) FOR THE FOLLOWING CORNER BEARING PRESSURE (tons/ft <sup>2</sup> )	MINIMUM THICKNESS REQUIRED (in)	MAXIMUM FILL HEIGHT ABOVE TOP OF PIPE (ft) FOR THE FOLLOWING CORNER BEARING PRESSURE (tons/ft <sup>2</sup> )		
								2 TONS/FT <sup>2</sup>	3 TONS/FT <sup>2</sup>
				2 1/2" x 1/2" CORRUGATION RIVETED, WELDED OR HELICAL		2 1/2" x 1/2" CORRUGATION RIVETED OR HELICAL			
15"	17" X 13"	3"	18"	0.064"	13'	15'+	0.060"	15'	-
18"	21" X 15"	3"	18"	0.064"	12'	15'+	0.060"	14'	-
24"	28" X 20"	3"	18"	0.064"	10'	15'	0.060"	10'	15'+
30"	35" X 24"	3"	18"	0.079"	9'	14'	0.060"	9'	14'
36"	42" X 29"	3 1/2"	18"	0.079"	9'	13'	0.075"	9'	13'
42"	49" X 33"	4"	18"	0.079"	8'	12'	0.105"	8'	12'
48"	57" X 38"	5"	18"	0.109"	8'	12'	0.135"	8'	12'
54"	64" X 43"	6"	18"	0.109"	8'	12'	0.135"	8'	12'
60"	71" X 47"	7"	18"	0.138"	8'	12'	0.164"	8'	12'
66"	77" X 52"	8"	18"	0.168"	8'	12'			
72"	83" X 57"	9"	18"	0.168"	9'	13'			
				5" X 1" OR 3" X 1" CORRUGATION RIVETED, WELDED OR HELICAL					
36"	40" X 31"	5"	18"	0.079"	12'	15'+			
42"	46" X 36"	6"	18"	0.079"	12'	15'+			
48"	53" X 41"	7"	18"	0.079"	12'	15'+			
54"	60" X 46"	8"	18"	0.079"	12'	15'+			
60"	66" X 51"	9"	18"	0.079"	12'	15'+			
66"	73" X 55"	12"	18"	0.079"	15'+	-			
72"	81" X 59"	14"	18"	0.079"	15'	-			
78"	87" X 63"	14"	18"	0.079"	14'	15'+			
84"	95" X 67"	16"	18"	0.109"	13'	15'+			
90"	103" X 71"	16"	24"	0.109"	12'	15'+			
96"	112" X 75"	18"	24"	0.109"	11'	15'+			

NOTES:  
 1. THE AVERAGE INSIDE DIAMETER SHALL NOT VARY MORE THAN ONE (1) PERCENT OR 1/2", WHICHEVER IS GREATER, FROM THE NOMINAL DIAMETER WHEN MEASURED ON THE INSIDE CREST OF THE CORRUGATIONS. (AASHTO M 36M/M 36 & AASHTO M 196M/M 196).  
 † 2. BEARING PRESSURES EXCEEDING 2 TONS/FT<sup>2</sup> REQUIRED FOR GIVEN FILL HEIGHT SHALL HAVE FOUNDATION MATERIALS INVESTIGATED TO DETERMINE BEARING CAPACITY.

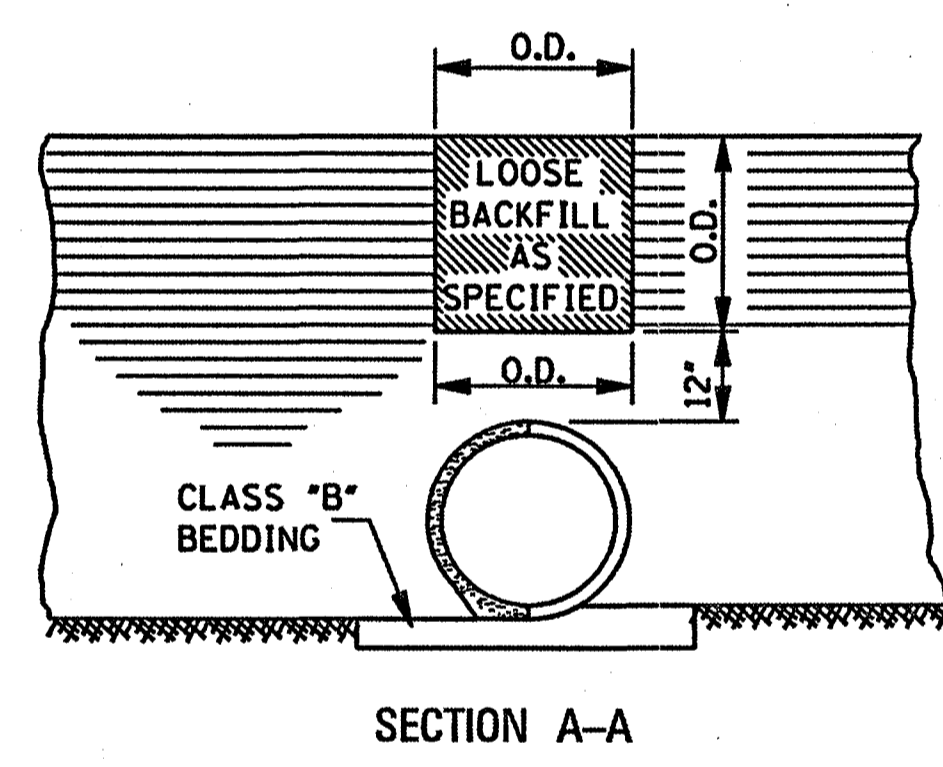

SECTION A-A

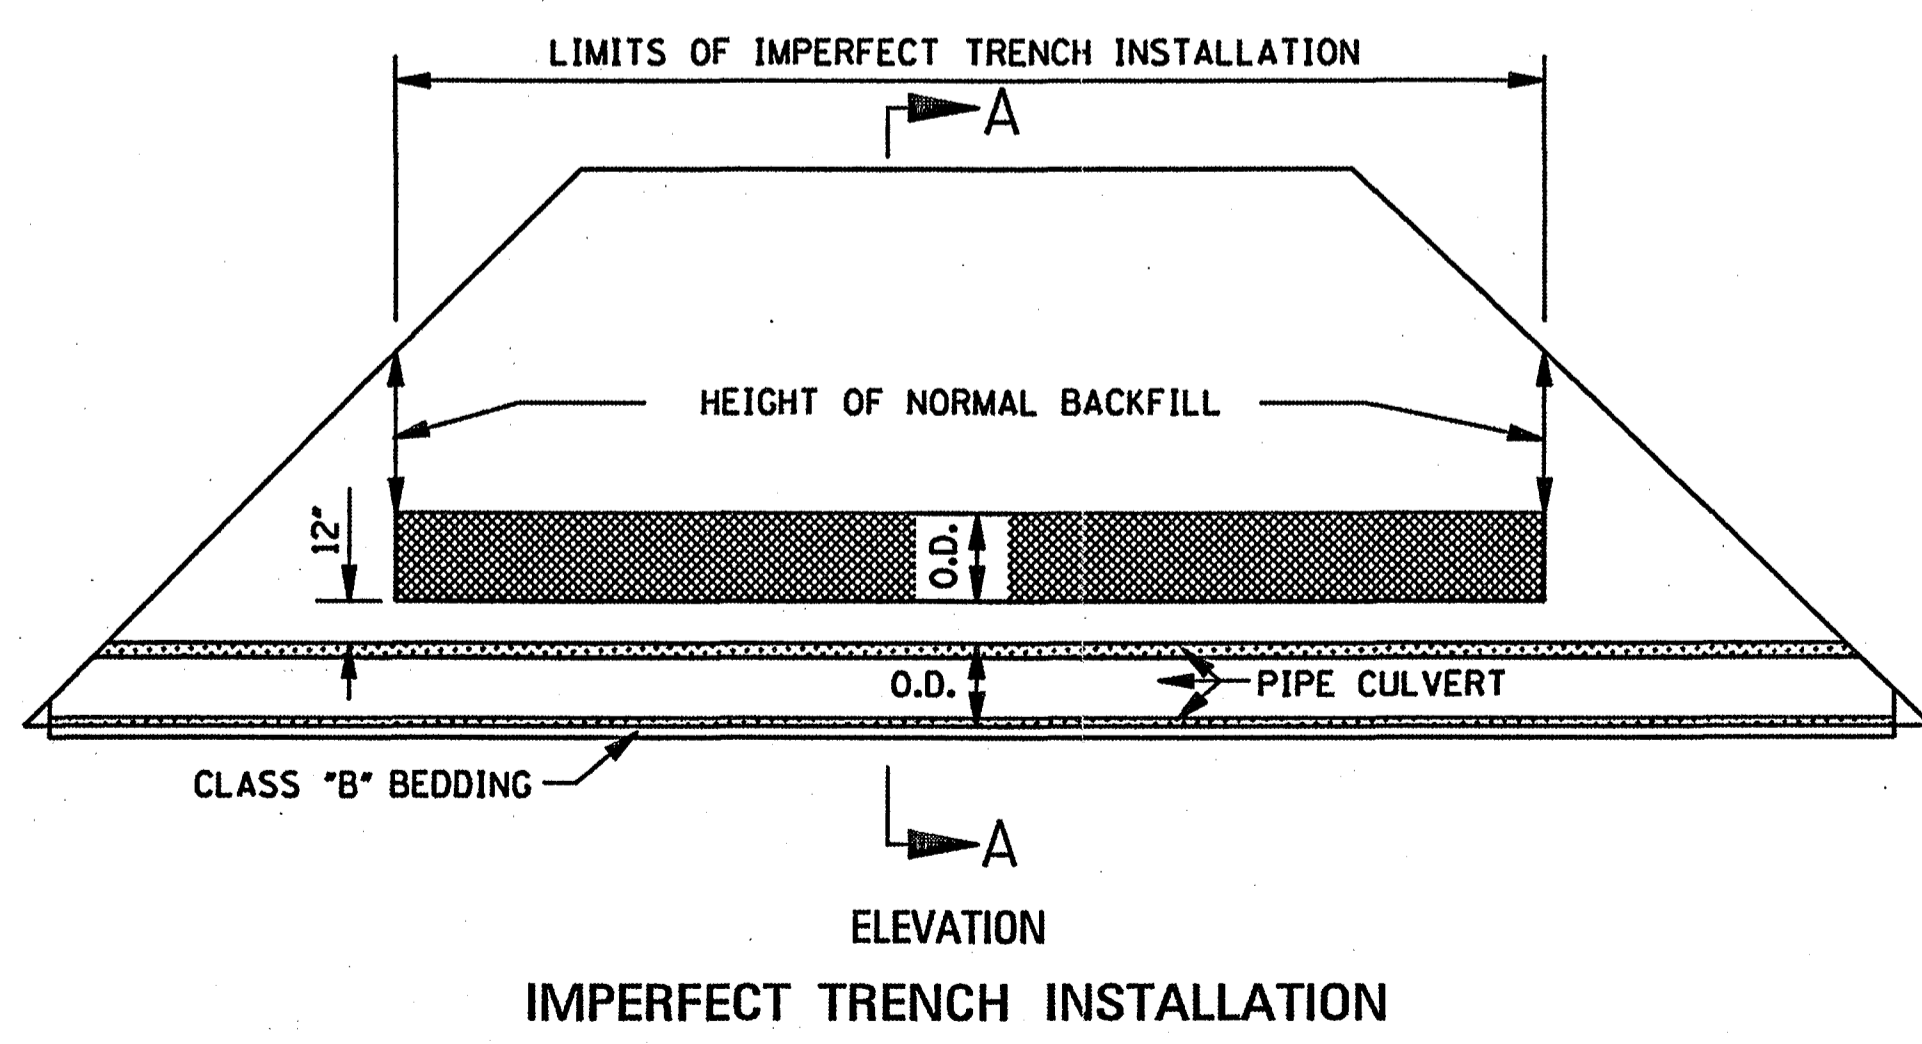


ELEVATION IMPERFECT TRENCH INSTALLATION


- GENERAL NOTES:
- MINIMUM SPACING BETWEEN MULTIPLE LINES OF PARALLEL PIPE SHALL BE THE DISTANCE REQUIRED FOR INSTALLING THE ADJACENT FLARED END SECTIONS OR AS SHOWN ON THE HEADWALL DRAWINGS FOR CONDUITS REQUIRING HEADWALLS.
  - UNLESS OTHERWISE INDICATED, THE TOP OF THE PIPE SHALL BE BELOW THE TOP OF THE SUBGRADE, AND A MINIMUM OF 12" OF COVER OVER THE TOP OF THE PIPE SHALL BE MAINTAINED BETWEEN THE SHOULDER LINES.
  - WHERE PRE-BED PIPE IS INSTALLED, FLARED END SECTIONS FROM OTHER MANUFACTURERS MAY BE JOINED TO PRE-BED PIPE PROVIDED A CONCRETE COLLAR IS PLACED AT THE CONTRACTORS EXPENSE AND A DEFORMATION TO THE PIPE'S FLOWLINE IS NOT EVIDENT ON FINAL PLACEMENT.

MISSISSIPPI DEPARTMENT OF TRANSPORTATION ROADWAY DESIGN DIVISION STANDARD PLAN		
<p align="center"><b>PIPE CULVERT INSTALLATION</b></p>		
REVISION	DATE	WORKING NUMBER PI-1 SHEET NUMBER 300
ISSUE DATE: OCTOBER 1, 1998		




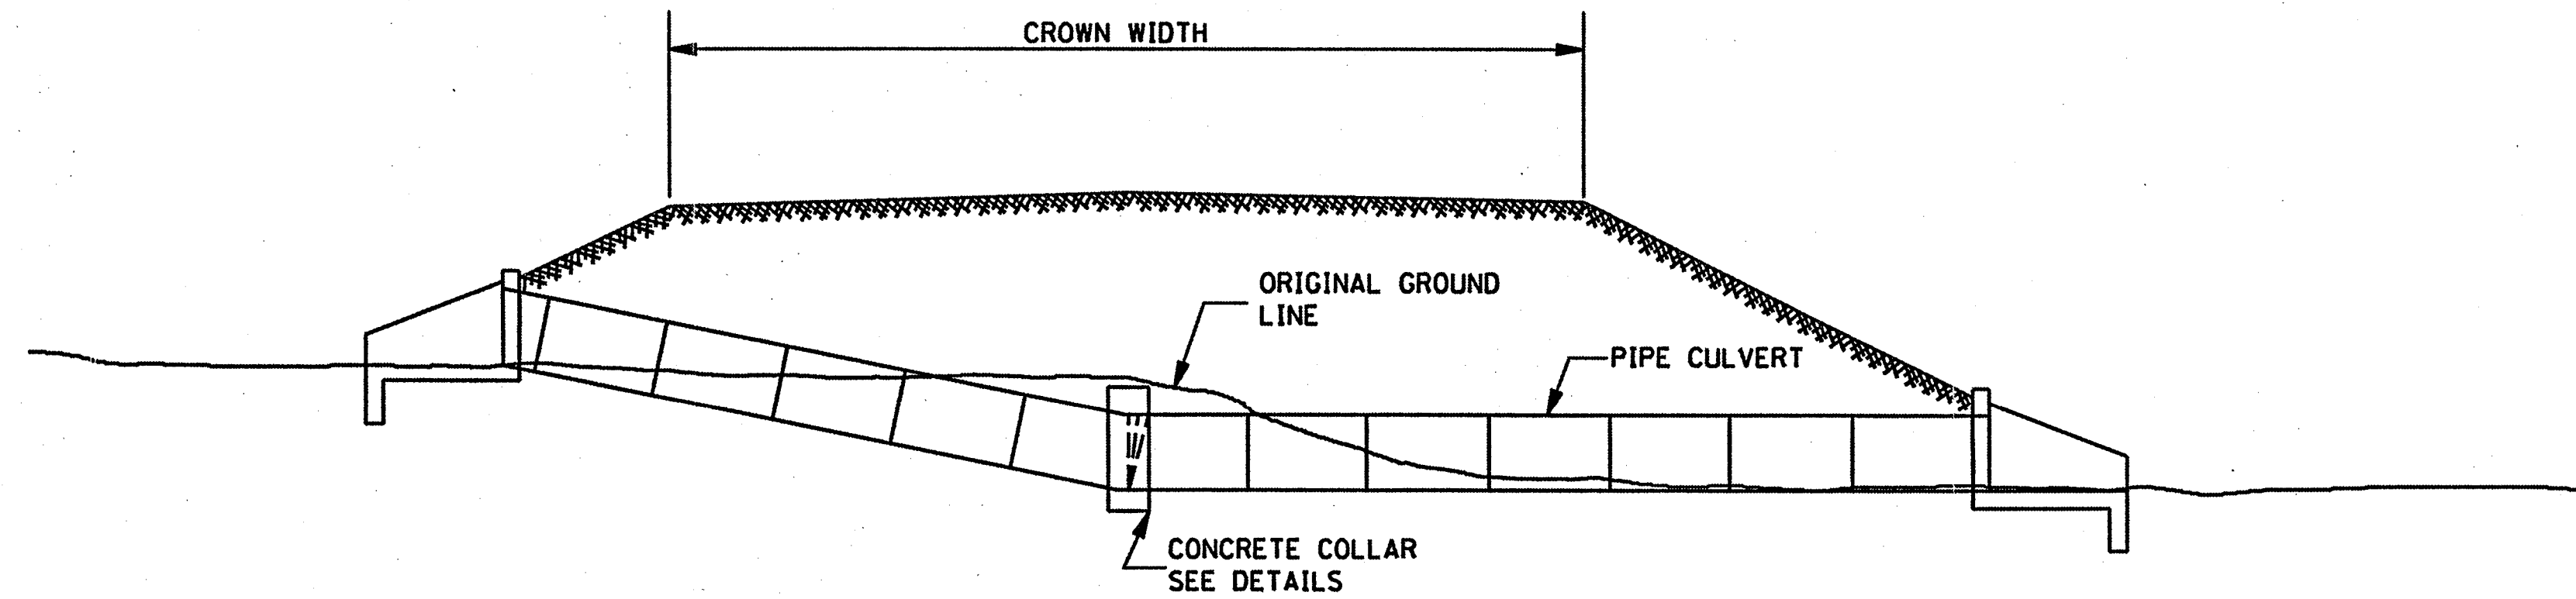

TYPICAL INSTALLATION FOR PIPE CULVERT WITH BROKEN FLOW LINE

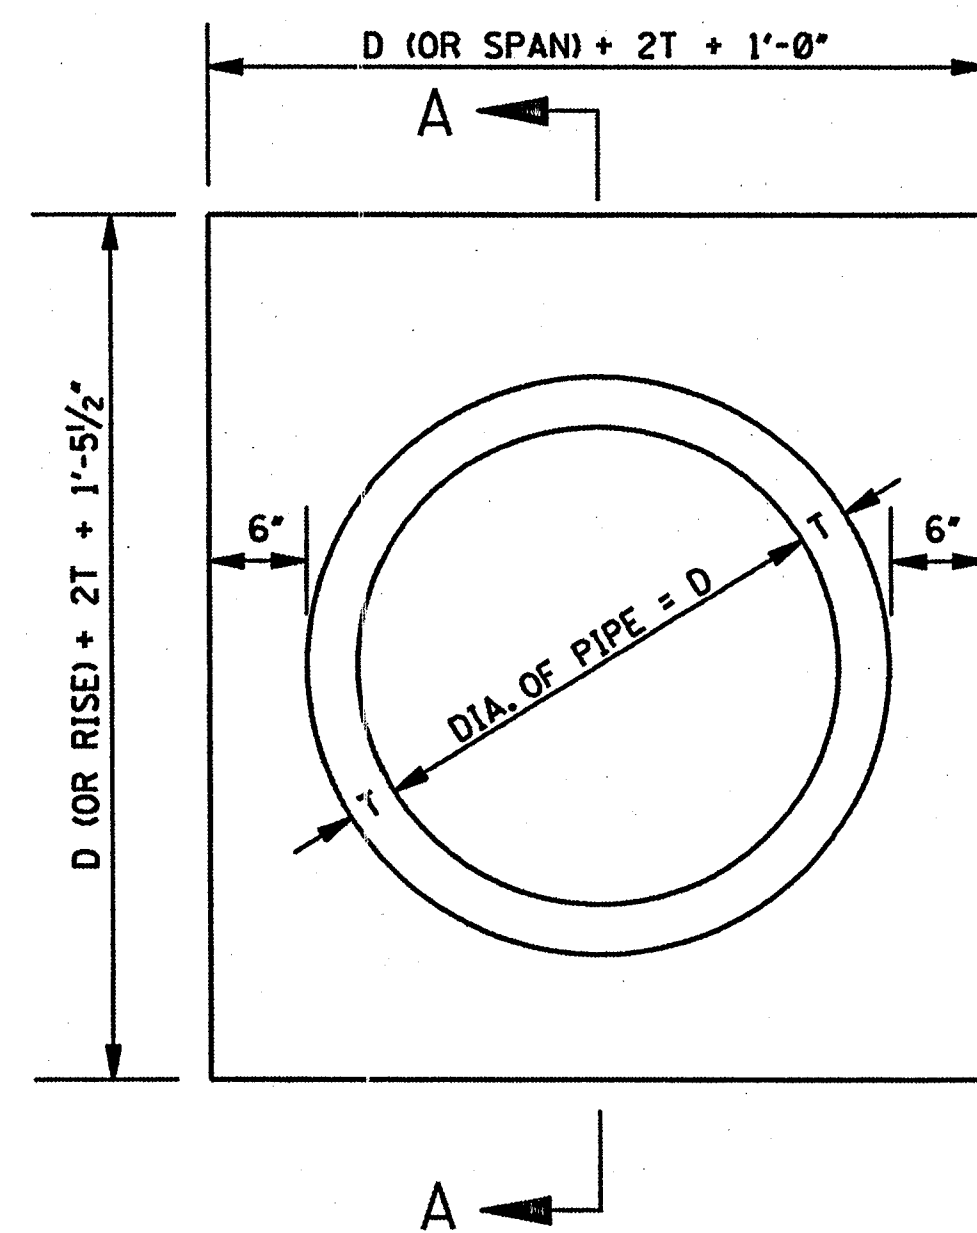

ELEVATION OF CONCRETE COLLAR  
NOTE: CIRCULAR PIPE IS SHOWN, ARCH PIPE IS SIMILAR.

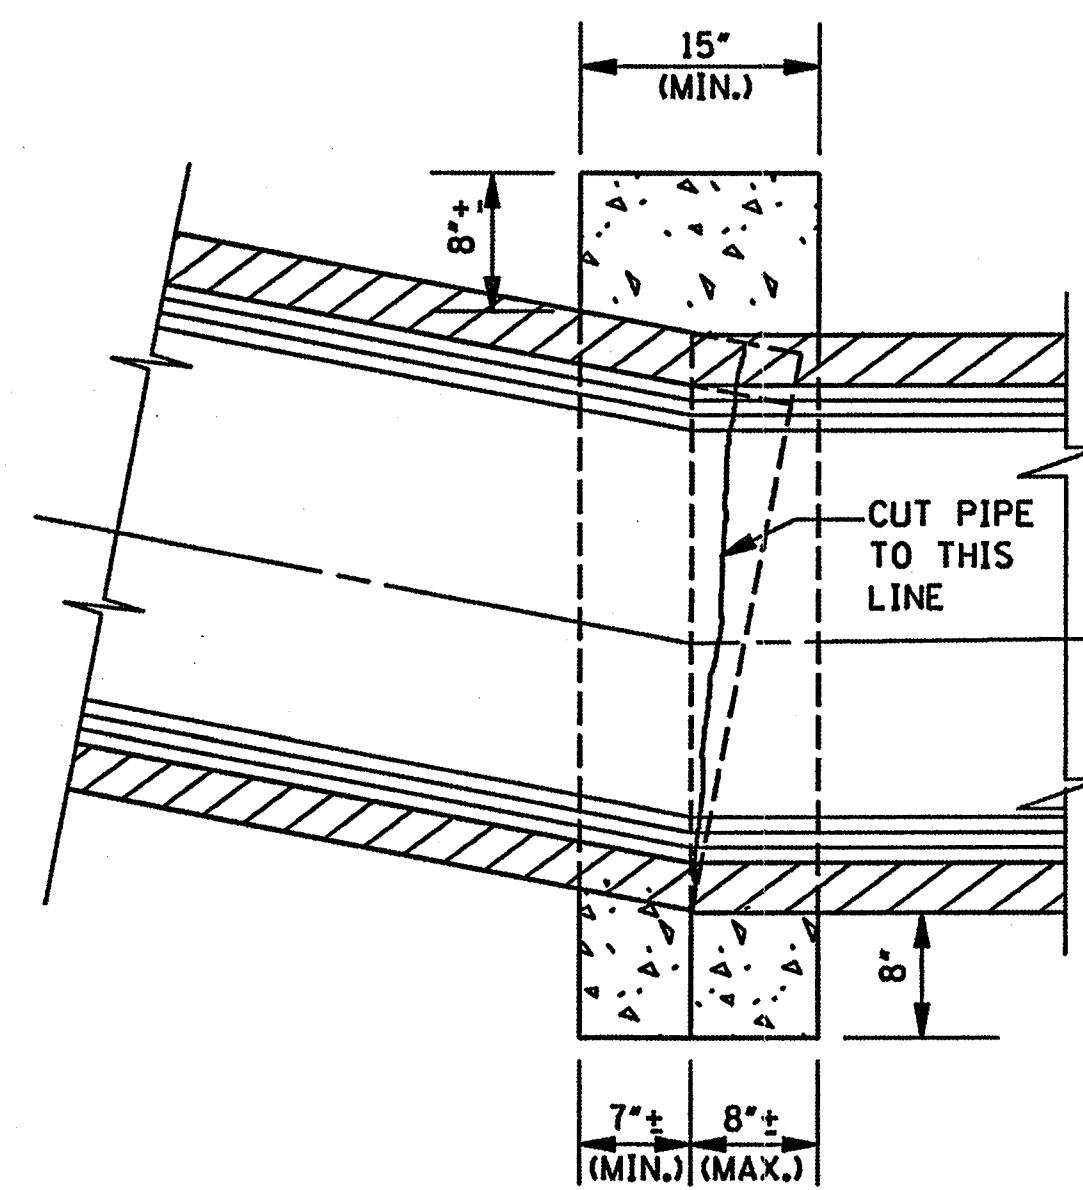



SECTION A-A

GENERAL NOTE:


- THE FOLLOWING QUANTITIES SHALL BE THE BASIS FOR PAYMENT UNLESS AUTHORIZED MODIFICATIONS ARE MADE:

QUANTITIES FOR CONCRETE COLLAR FOR PIPE CULVERTS			
CIRCULAR PIPE		ARCH PIPE	
DIA. OF PIPE	CLASS "B" CONCRETE (yd <sup>3</sup> )	SIZE OF PIPE	CLASS "B" CONCRETE (yd <sup>3</sup> )
12"	0.240		
15"	0.260	18 x 11	0.280
18"	0.320	22 x 13	0.310
24"	0.410	29 x 18	0.410
30"	0.510	36 x 23	0.490
36"	0.620	44 x 27	0.600
42"	0.730	51 x 31	0.690
48"	0.850	58 x 36	0.820
54"	0.980	65 x 40	0.920
60"	1.110	73 x 45	1.070
66"	1.248	88 x 54	1.366
72"	1.393		

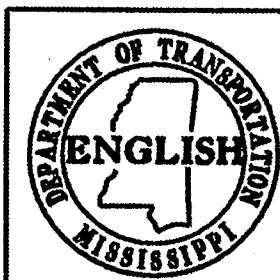
BY		MISSISSIPPI DEPARTMENT OF TRANSPORTATION ROADWAY DESIGN DIVISION STANDARD PLAN	
REVISION		<p style="text-align: center;"><b>CONCRETE PIPE COLLAR</b></p> 	
DATE			
ISSUE DATE:		OCTOBER 1, 1998	
		WORKING NUMBER PC-1	
		SHEET NUMBER 301	

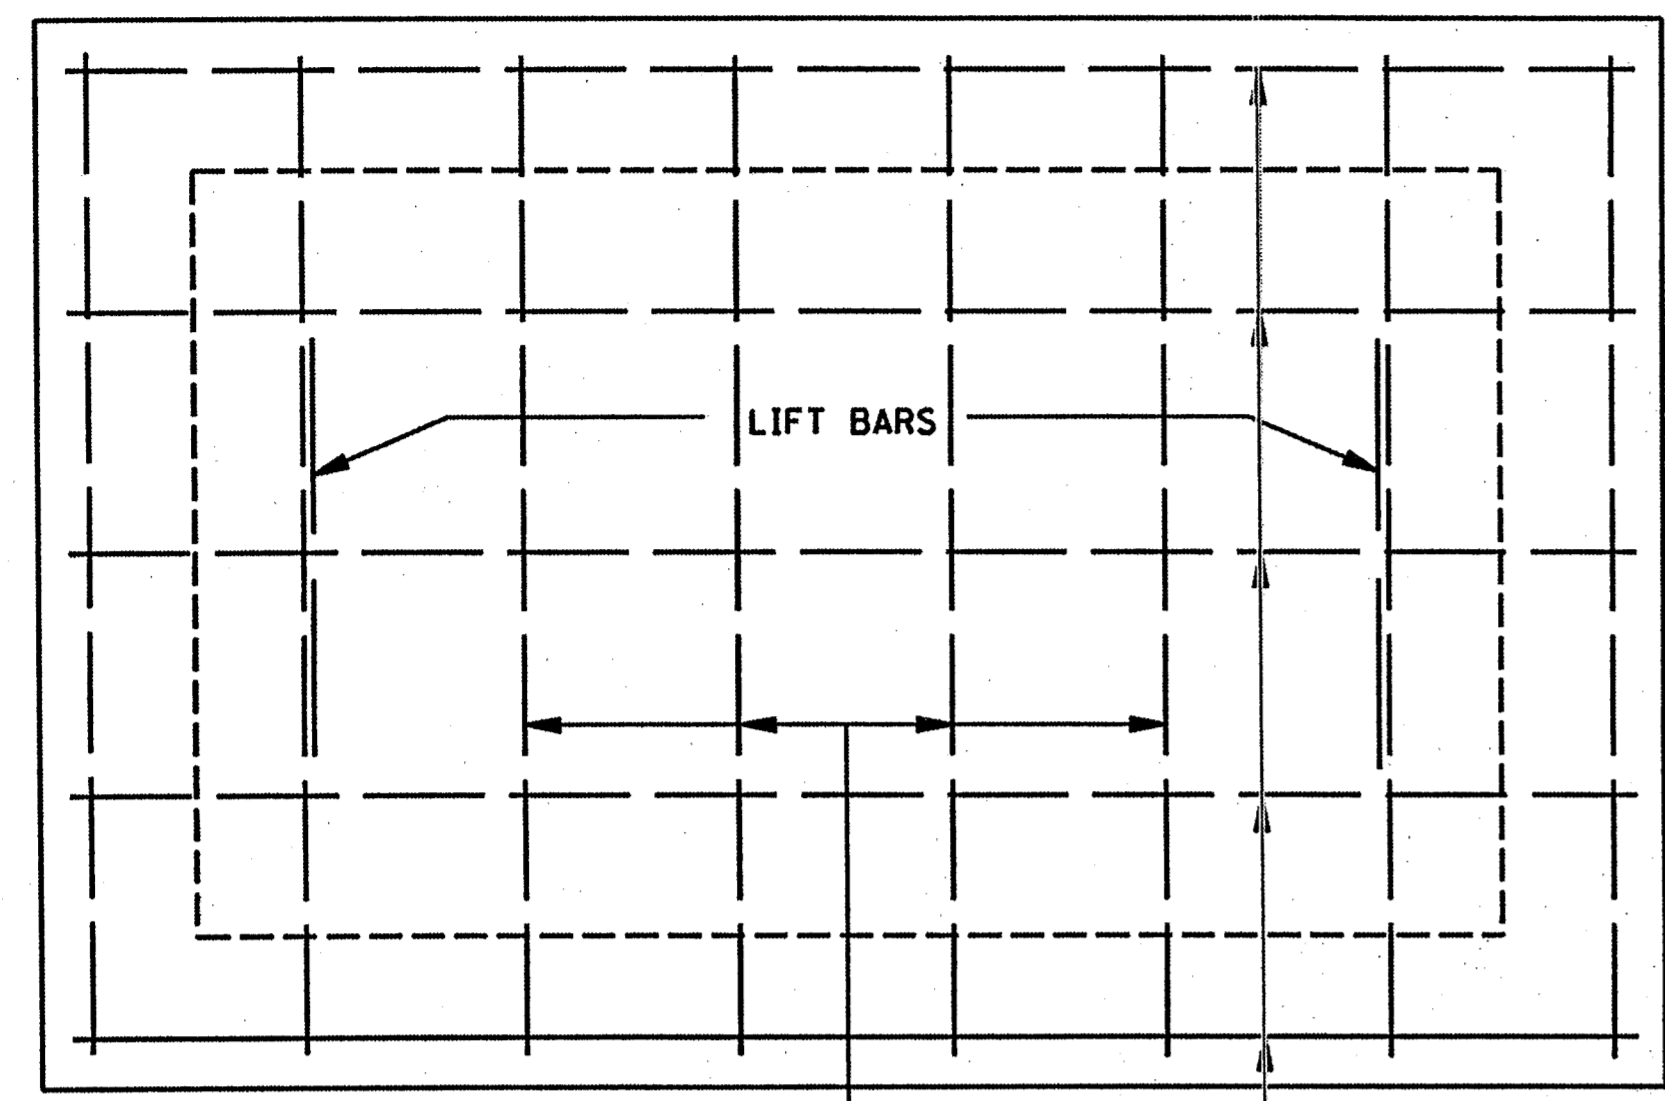


PLAN OF COVER

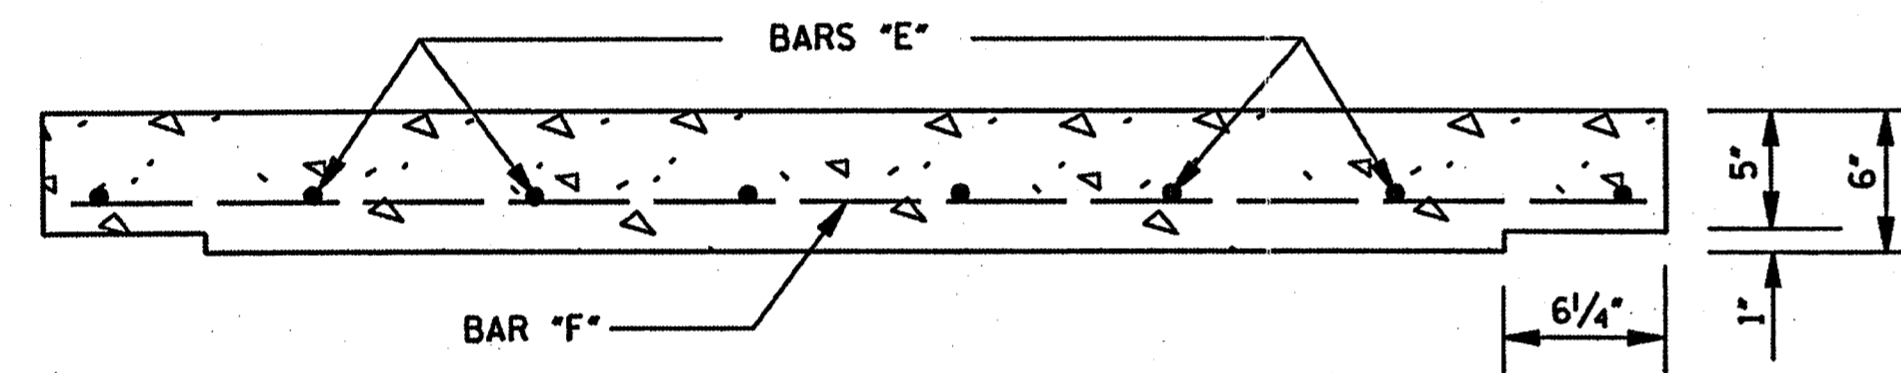


ELEVATION OF COVER

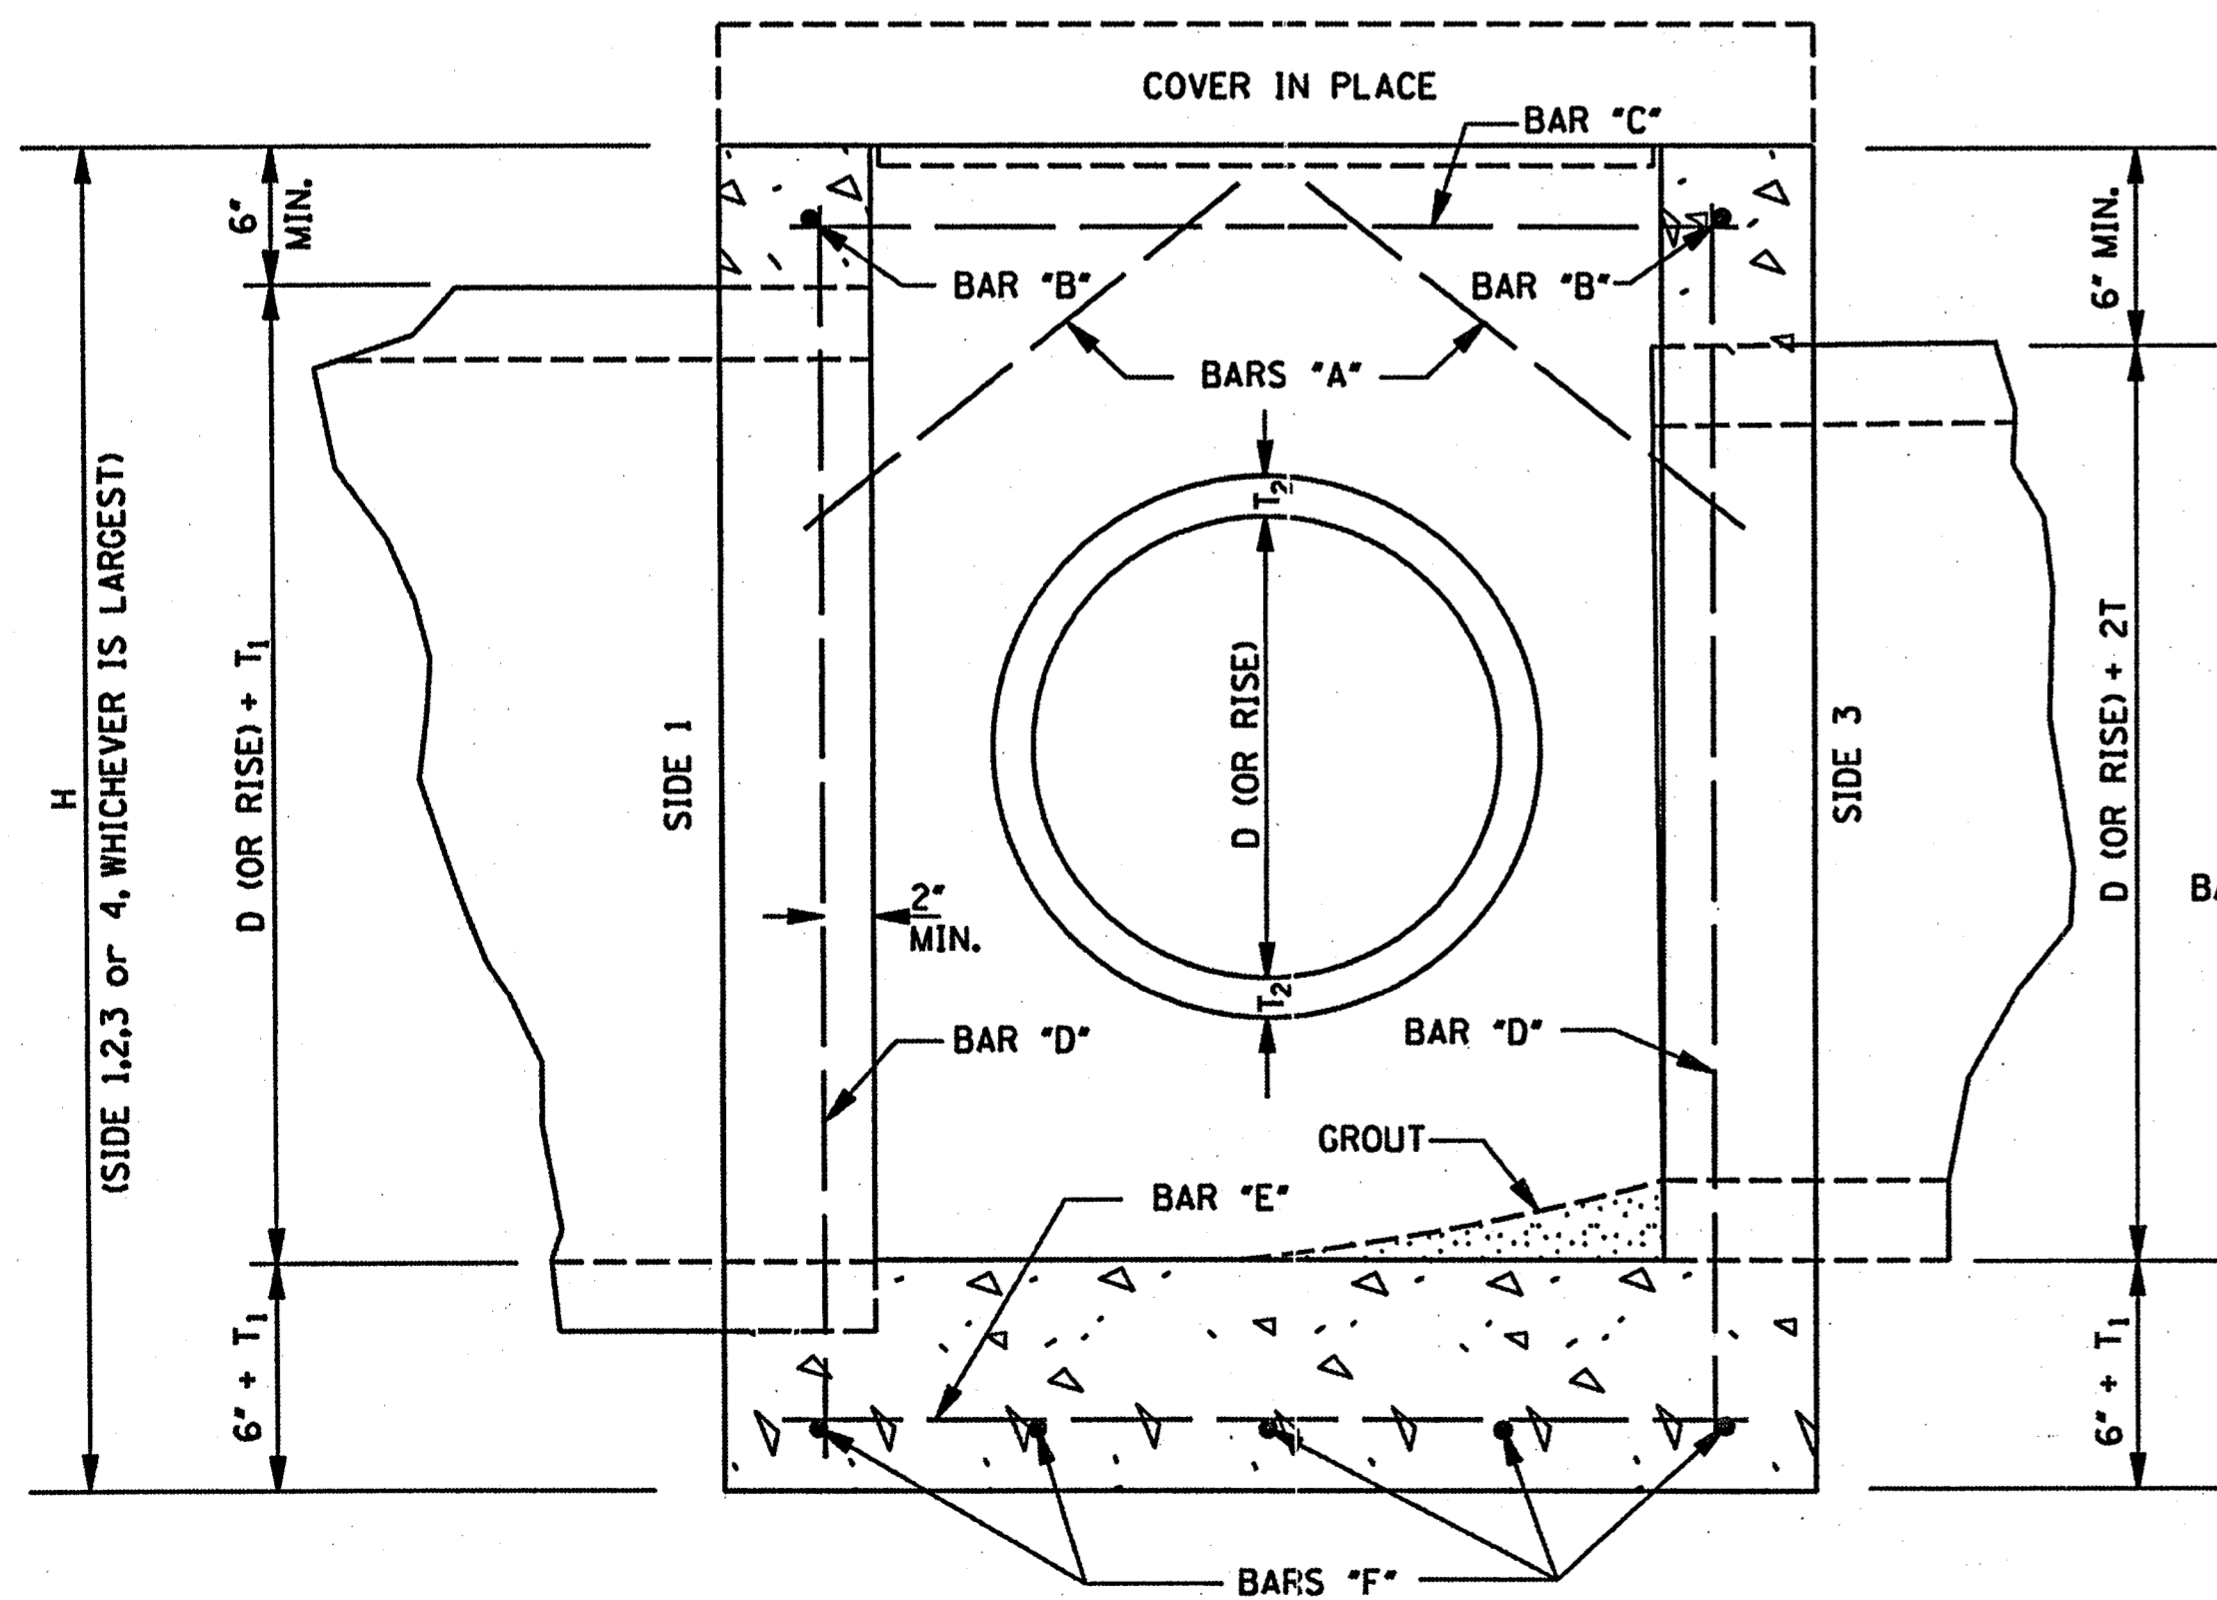

SECTION B-B

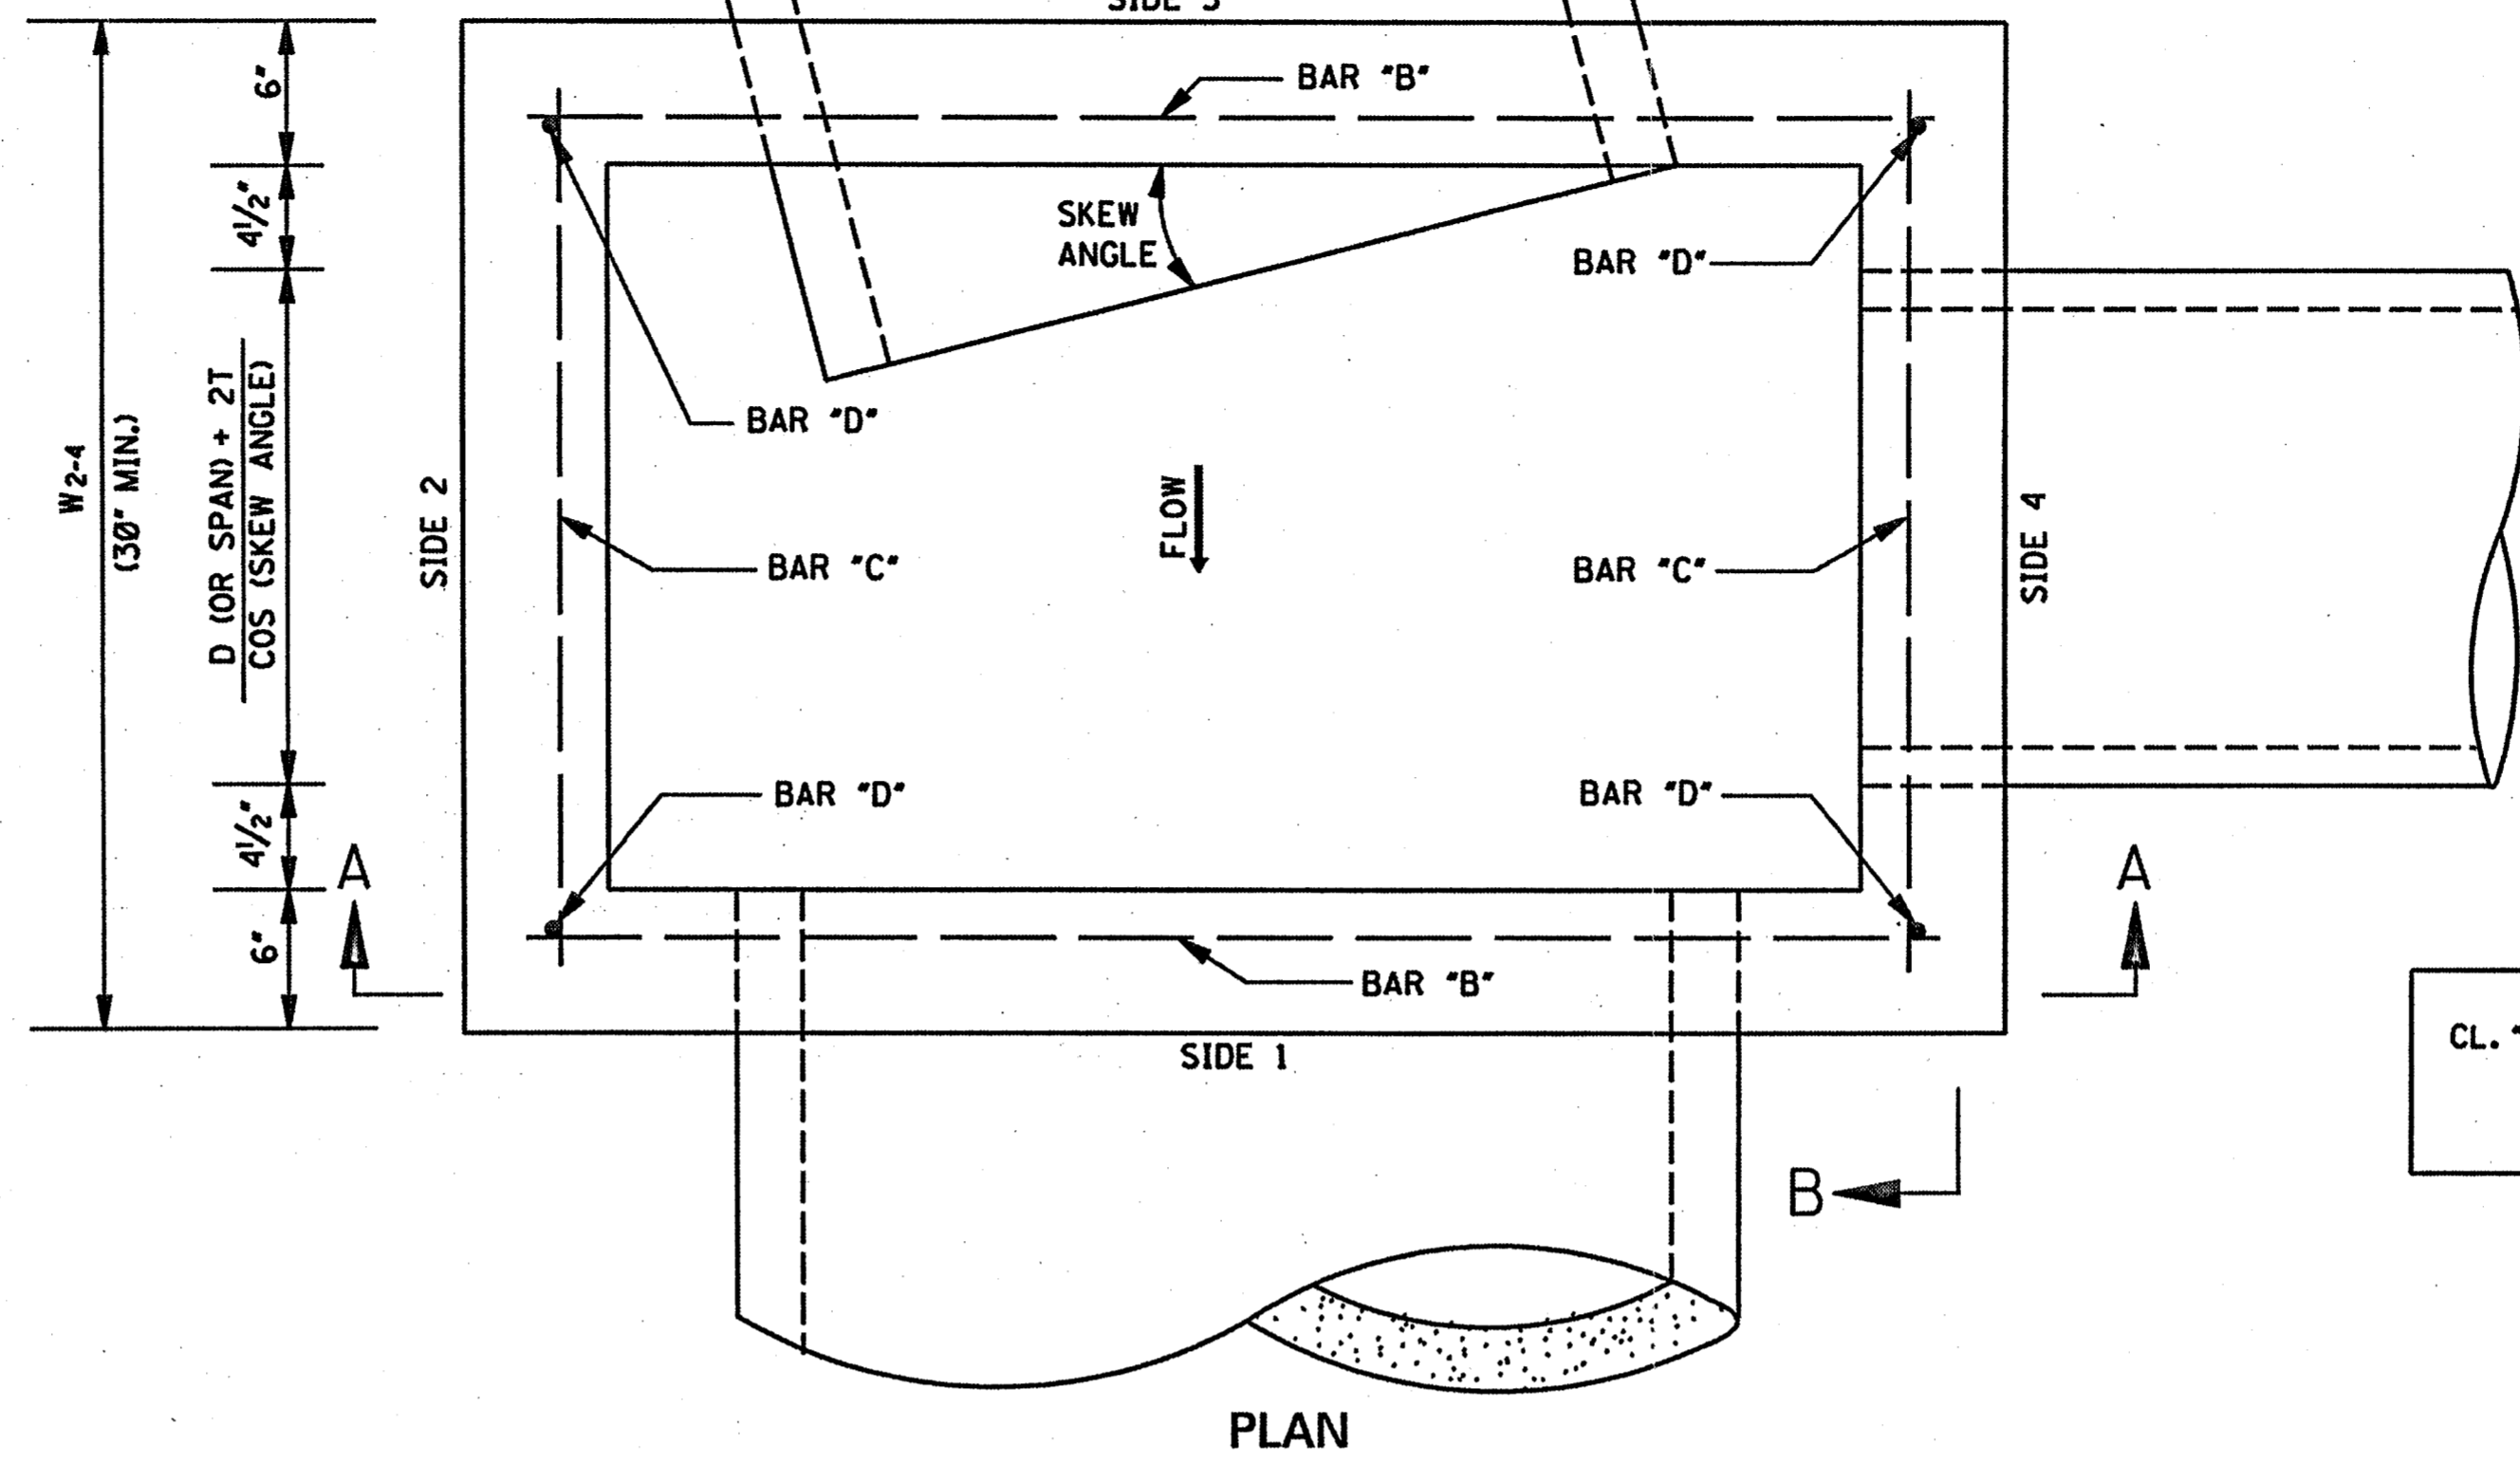

PLAN

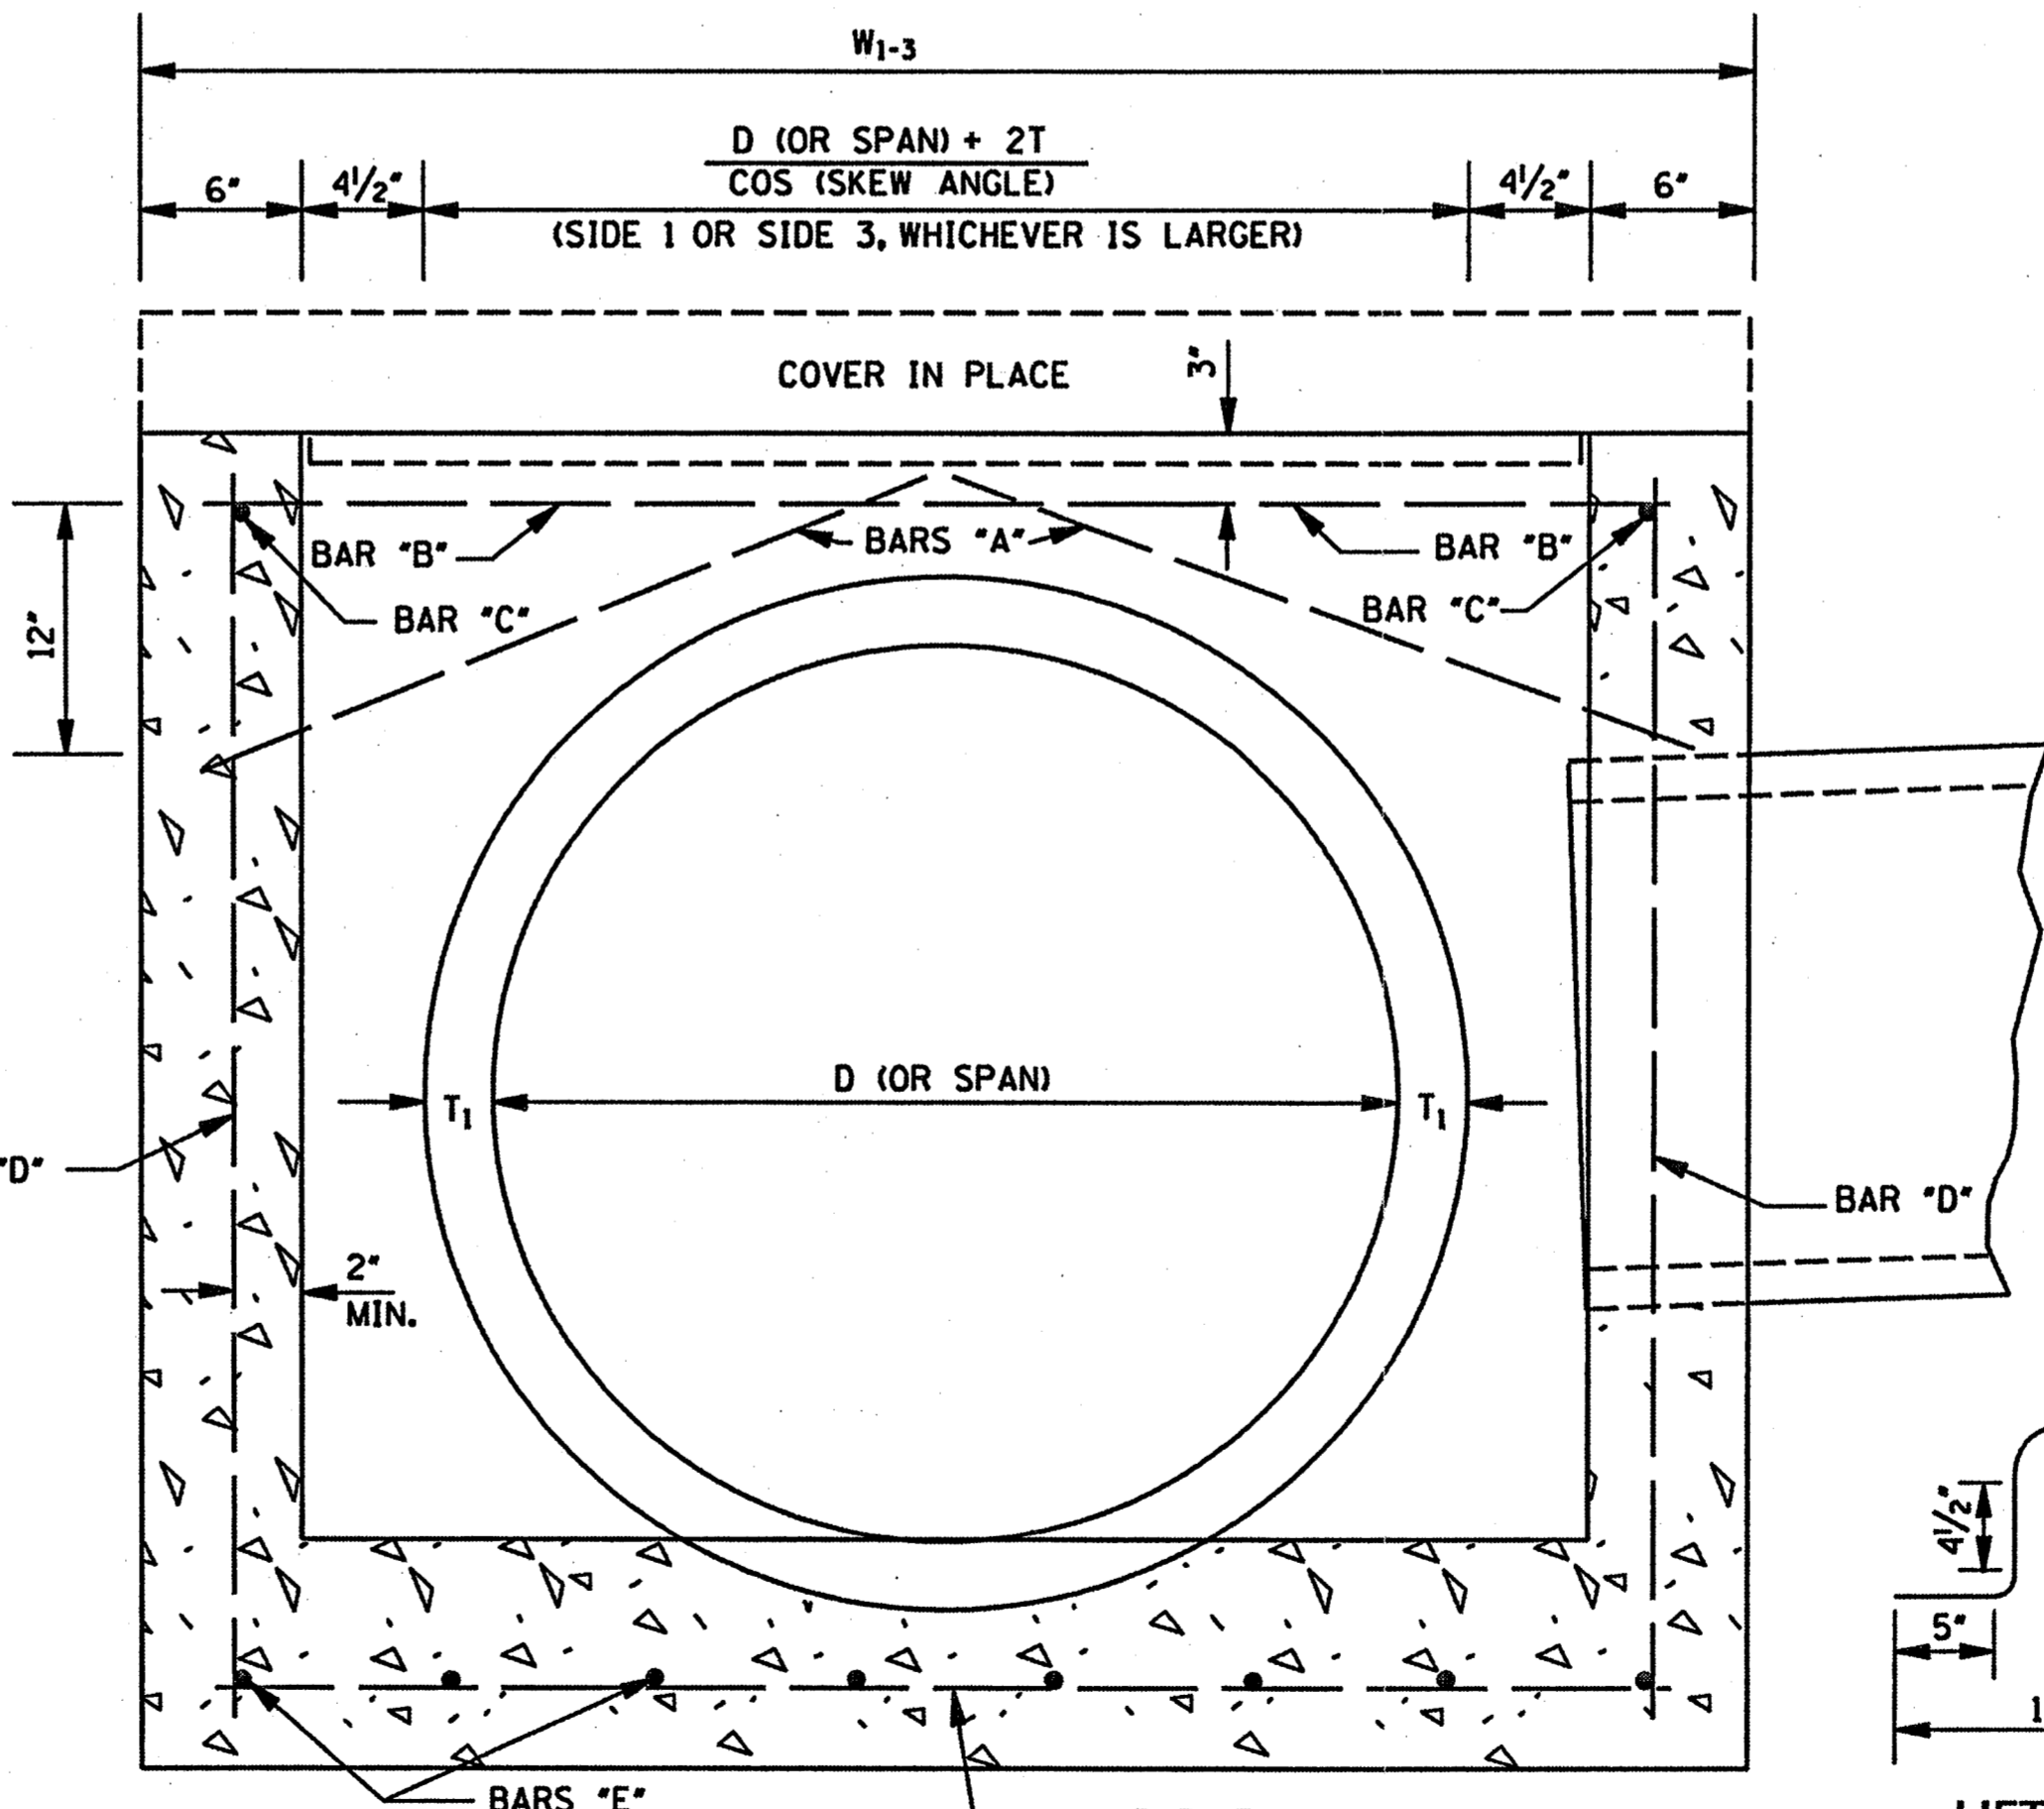

SECTION A-A


BAR	SIZE	NUMBER REQUIRED	LENGTH
A	#4	2 PER PIPE OPENING	$\sqrt{196 + \left(\frac{W^*}{2} + 2\right)^2}$
B	#4	2	$W_{1-3} - 6"$
C	#4	2	$W_{2-4} - 6"$
D	#4	4	$H - 6"$
E	#4	$2 \left[ \left( \frac{W_{1-3}}{9} \right)^{**} + 1 \right]$	$W_{2-4} - 4"$
F	#4	$2 \left[ \left( \frac{W_{2-4}}{9} \right)^{**} + 1 \right]$	$W_{1-3} - 4"$

NOTE: VARIABLES AND DESIGNATIONS ARE AS FOLLOWS:  
D (OR SPAN) = PIPE DIAMETER (OR SPAN)  
W<sub>1-3</sub> = WIDTH OF SIDE 1 & SIDE 3  
W<sub>2-4</sub> = WIDTH OF SIDE 2 & SIDE 4  
W\* = W<sub>1-3</sub> OR W<sub>2-4</sub> (SIDE OF ENTERING PIPE)  
\*\* = ROUND TO NEAREST WHOLE NUMBER

CL. "B" CONC. (yd<sup>3</sup>) = [(Q1 + Q2) / 46,656] - Σ PIPE OPENING DEDUCTIONS  
WHERE: Q1 = [5 \* W<sub>1-3</sub> \* W<sub>2-4</sub>] + [1 \* (W<sub>1-3</sub> - 12.5) \* W<sub>2-4</sub> - 12.5 \* 1] + [(1 + 6) \* W<sub>1-3</sub> \* W<sub>2-4</sub>]  
Q2 = 12 \* [H - (1 + 6)] \* [(W<sub>1-3</sub> - 12) + W<sub>2-4</sub>]


CIRCULAR PIPE			ARCH PIPE		
PIPE SIZE	T	PIPE OPENING DEDUCTION (yd <sup>3</sup> )	PIPE SIZE	T	PIPE OPENING DEDUCTION (yd <sup>3</sup> )
18"	2 1/2"	0.053	22" x 13"	2 1/2"	0.053
24"	3"	0.091	29" x 18"	3"	0.087
30"	3 1/2"	0.138	36" x 23"	3 1/2"	0.129
36"	4"	0.196	44" x 27"	4"	0.185
42"	4 1/2"	0.263	51" x 31"	4 1/2"	0.245
48"	5"	0.340	58" x 36"	5"	0.318
54"	5 1/2"	0.427	65" x 40"	5 1/2"	0.394
60"	6"	0.524	73" x 45"	6"	0.489
66"	6 1/2"	0.630			
72"	7"	0.747			



- GENERAL NOTES:
1. REINFORCING STEEL QUANTITIES TO BE COMPUTED FROM BAR LIST AND SHOWN ELSEWHERE ON THE PLANS.
  2. QUANTITIES FOR JUNCTION BOXES SHOWN ON THE PLANS WILL BE THE BASIS FOR PAYMENT UNLESS AUTHORIZED MODIFICATIONS ARE MADE.
  3. CONCRETE SHALL BE CLASS "B" AND REINFORCING STEEL SHALL BE DEFORMED BARS.
  4. SIDE 1 OF THE JUNCTION BOX WILL ALWAYS BE THE OUTFLOW SIDE.
  5. IF PIPES ARE SKEWED MORE THAN 15° OR IF SKEWED PIPES PRODUCE CONFLICTS WITH ANOTHER OPENING, THE PIPE SHALL BE BROKEN BACK TO THE WALL OF THE JUNCTION BOX.

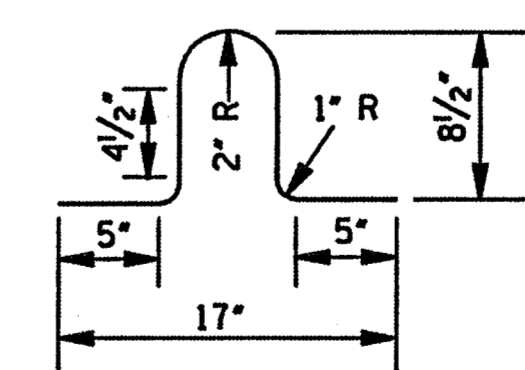

LIFT BAR

NOTE: LIFT BAR TO BE FABRICATED FROM A #4 BAR 30" LONG. TWO LIFT BARS ARE REQUIRED. REINFORCING STEEL FOR 2 LIFT BARS = 3.3 lbs.

BY		MISSISSIPPI DEPARTMENT OF TRANSPORTATION	
REVISION		ROADWAY DESIGN DIVISION	
DATE		STANDARD PLAN	
		<b>JUNCTION BOX FOR PIPE CULVERTS</b>	
			
		WORKING NUMBER JB-1	
		SHEET NUMBER 302	
		ISSUE DATE: OCTOBER 1, 1998	

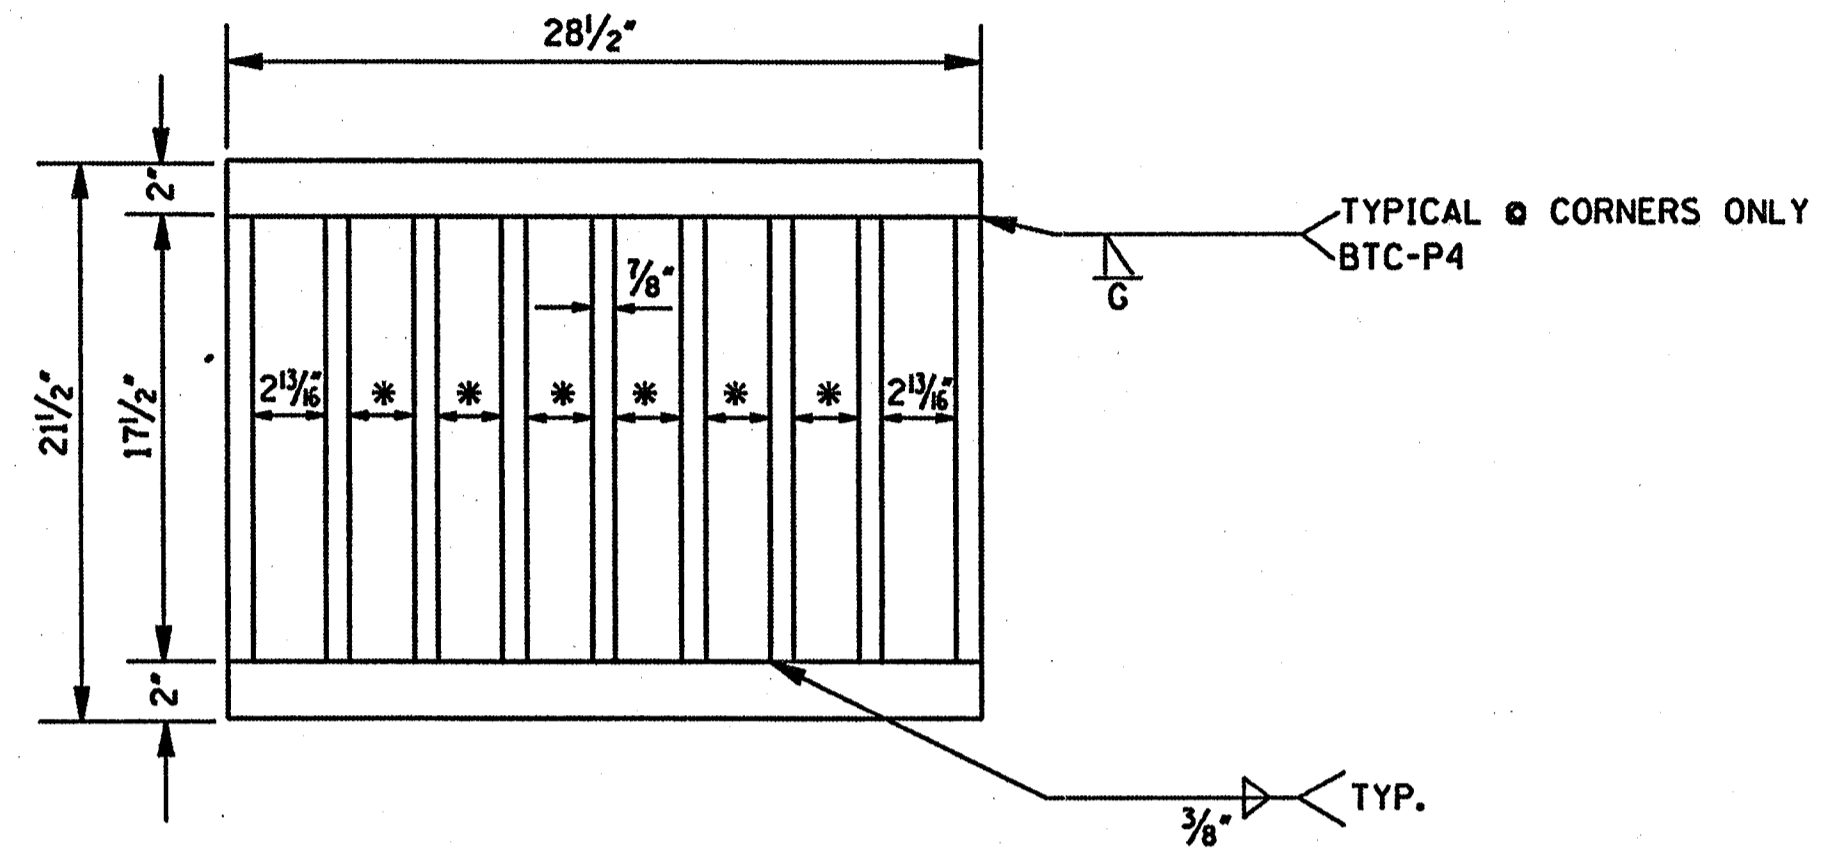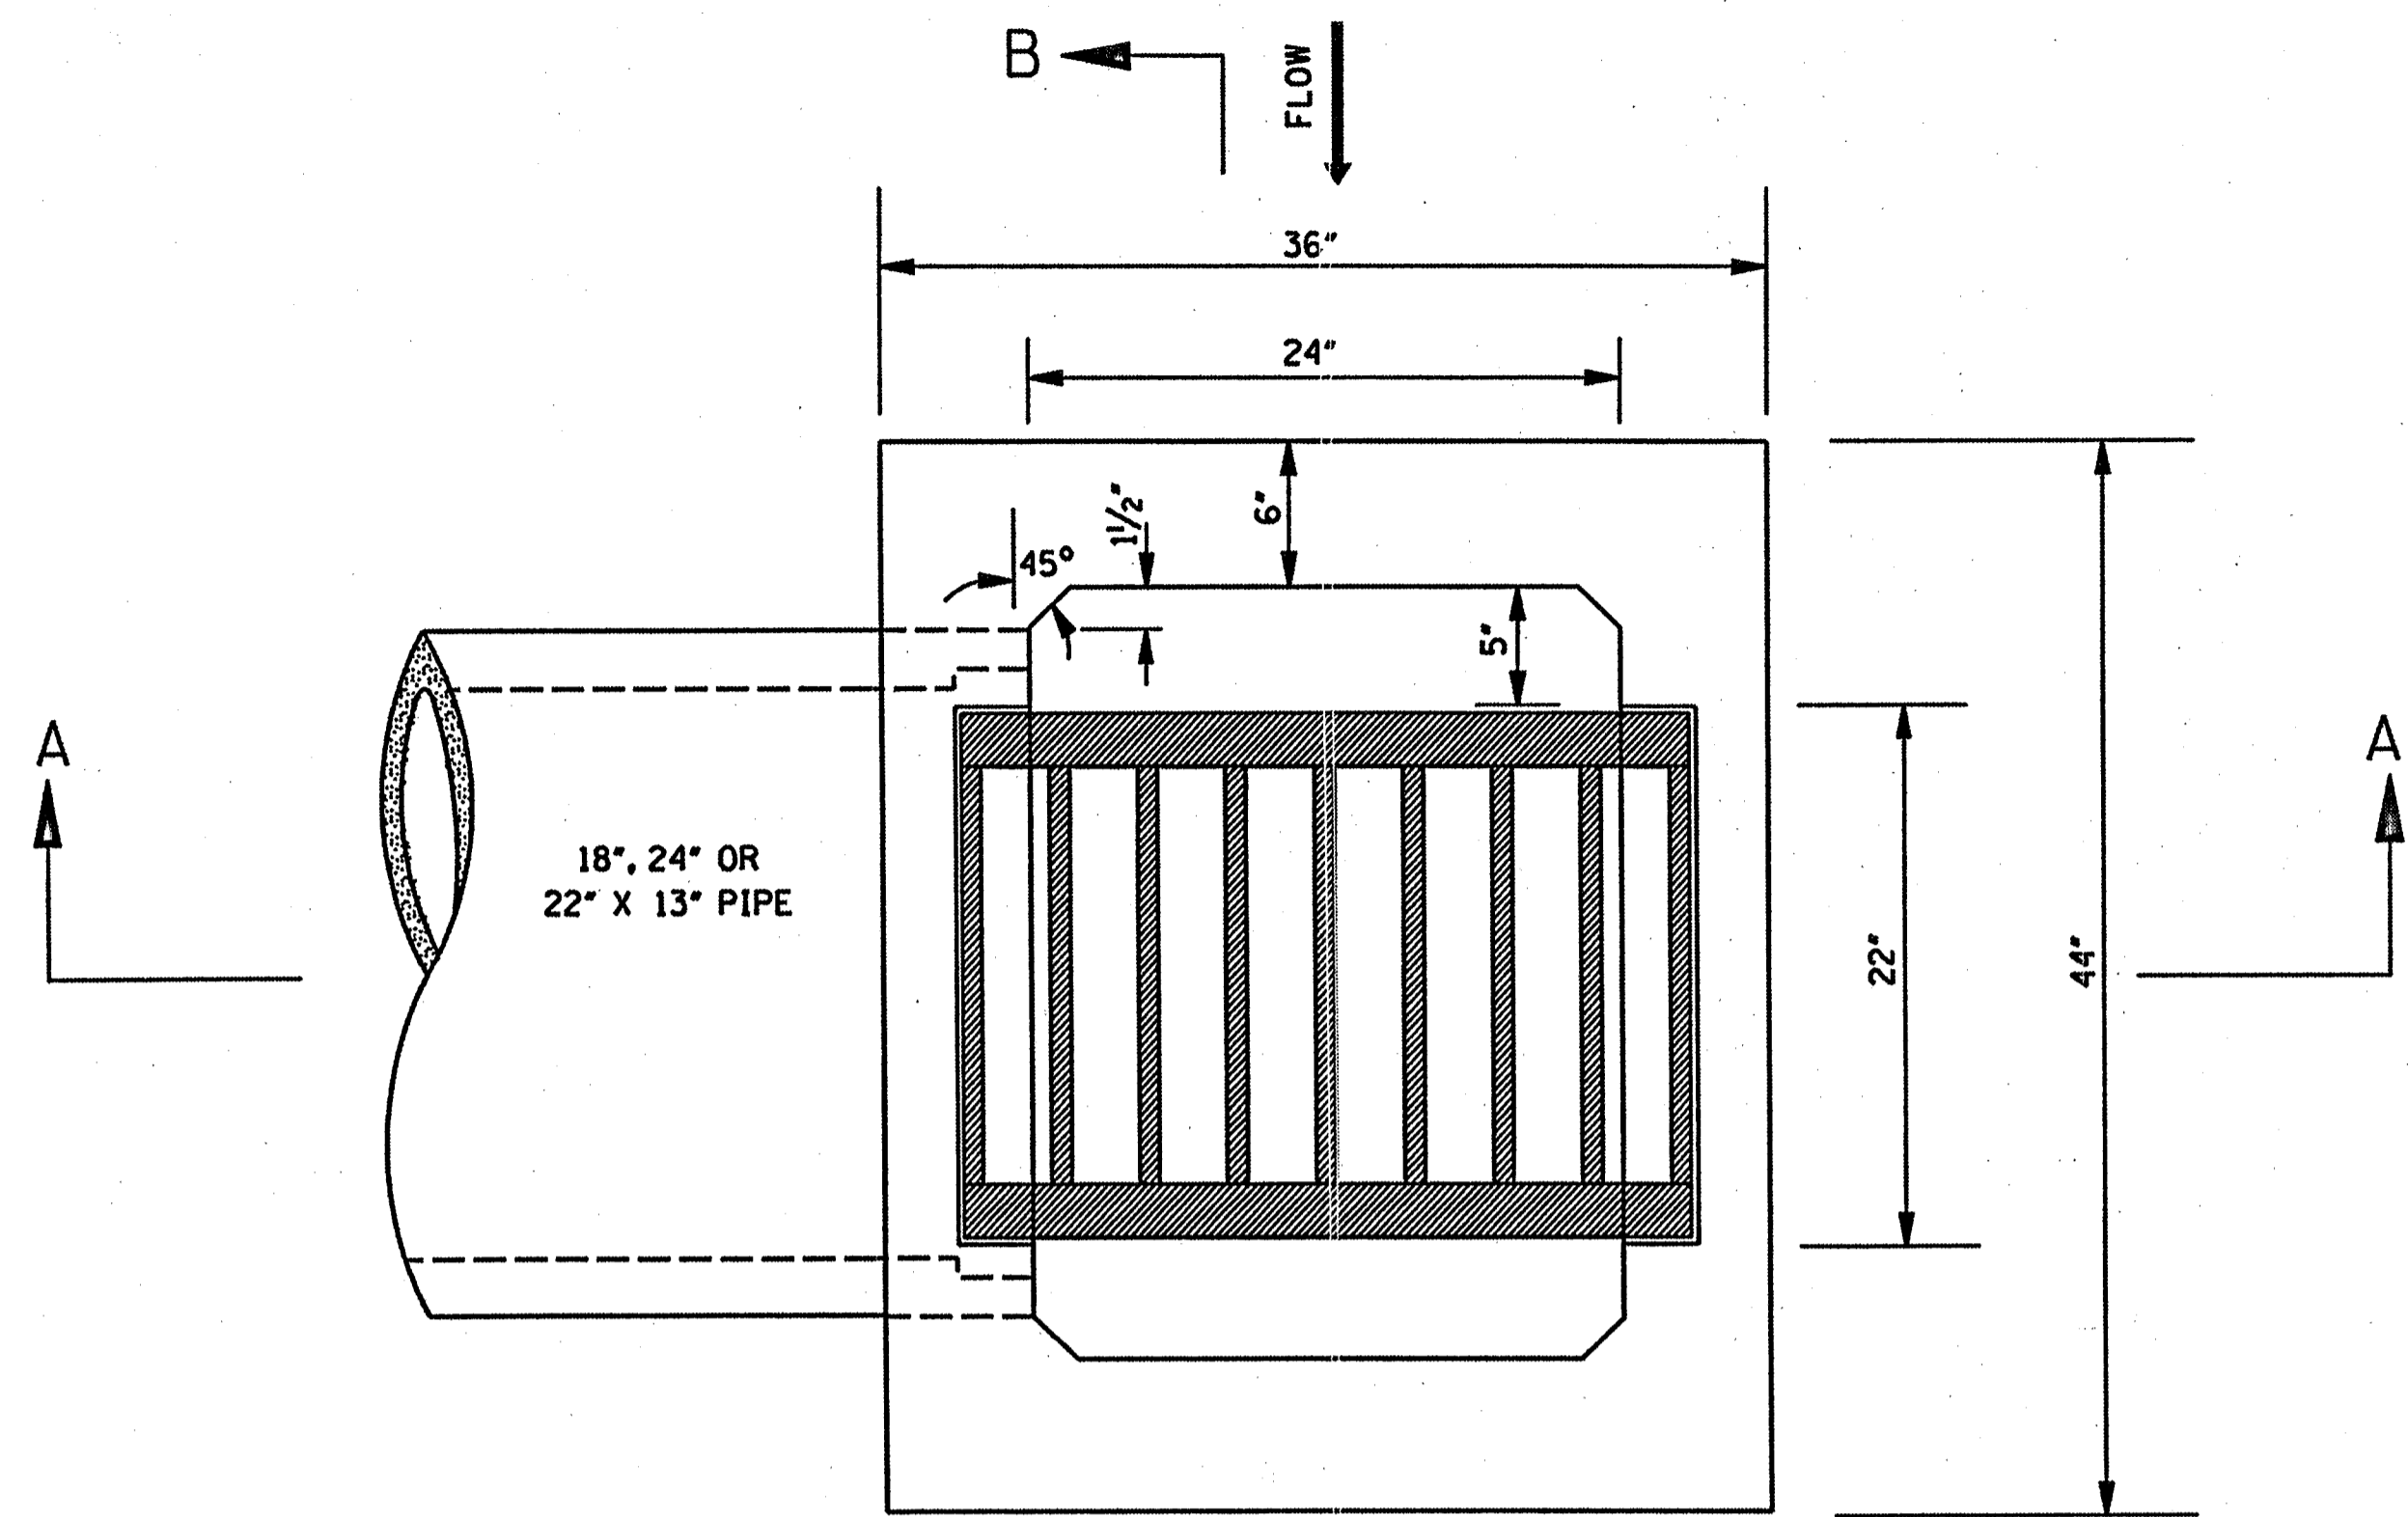

**PLAN OF GRATE NO.1**  
\* NOTE: TYPICAL SPACING 2 1/2"

**PLAN OF CONCRETE DIMENSIONS**


PIPE SIZE	MIN. DEPTH TO F.L.	QUANTITIES				T	PIPE OPENING DEDUCTION (yd <sup>3</sup> )
		MIN. DEPTH INLET		EACH ADDED FOOT			
		CONC. (yd <sup>3</sup> )	STEEL (lbs)	CONC. (yd <sup>3</sup> )	STEEL (lbs)		
18"	2.500'	0.670	48	0.211	10	2 1/2"	0.053
24"	3.042'	0.747	54	0.211	10	3"	0.091
22" x 13"	2.125'	0.591	46	0.211	10	2 1/2"	0.053

NOTE: ONE (1) PIPE OPENING DEDUCTED FROM INLET.


PIPE SIZE	BARS/SIZES			
	"A"	"B"	"C"	"D"
	NO. & LGTH.	NO. & LGTH.	NO. & LGTH.	NO. & LGTH.
18"	2 @ 1'-6"	6 @ 3'-2"	10 @ 2'-5"	10 @ 2'-6"
24"	2 @ 1'-6"	7 @ 3'-2"	10 @ 2'-5"	10 @ 3'-1"
22" x 13"	2 @ 1'-6"	6 @ 3'-2"	10 @ 2'-5"	10 @ 2'-4"

**GENERAL NOTES:**

- QUANTITIES SHOWN WILL BE THE BASIS OF PAYMENT UNLESS AUTHORIZED MODIFICATIONS ARE MADE.
- INLET:
  - THE INLET ON THIS DRAWING IS SHOWN AS THE ENTRANCE TO A PIPE CULVERT BUT MAY ALSO BE USED ON A CROSSDRAIN.
  - THE CONCRETE SHALL BE CLASS "B".
  - THE REINFORCEMENT SHALL BE SPACED A MAXIMUM OF 12" ON CENTER BOTH WAYS WITH A MINIMUM CLEARANCE OF 1" TO THE INSIDE OF THE INLET WALLS.
- GRATE:
  - THE CONTRACTOR HAS THE OPTION TO PROVIDE GRATE NO.1 OR GRATE NO.2 AS SHOWN ON SHEET IG-1.

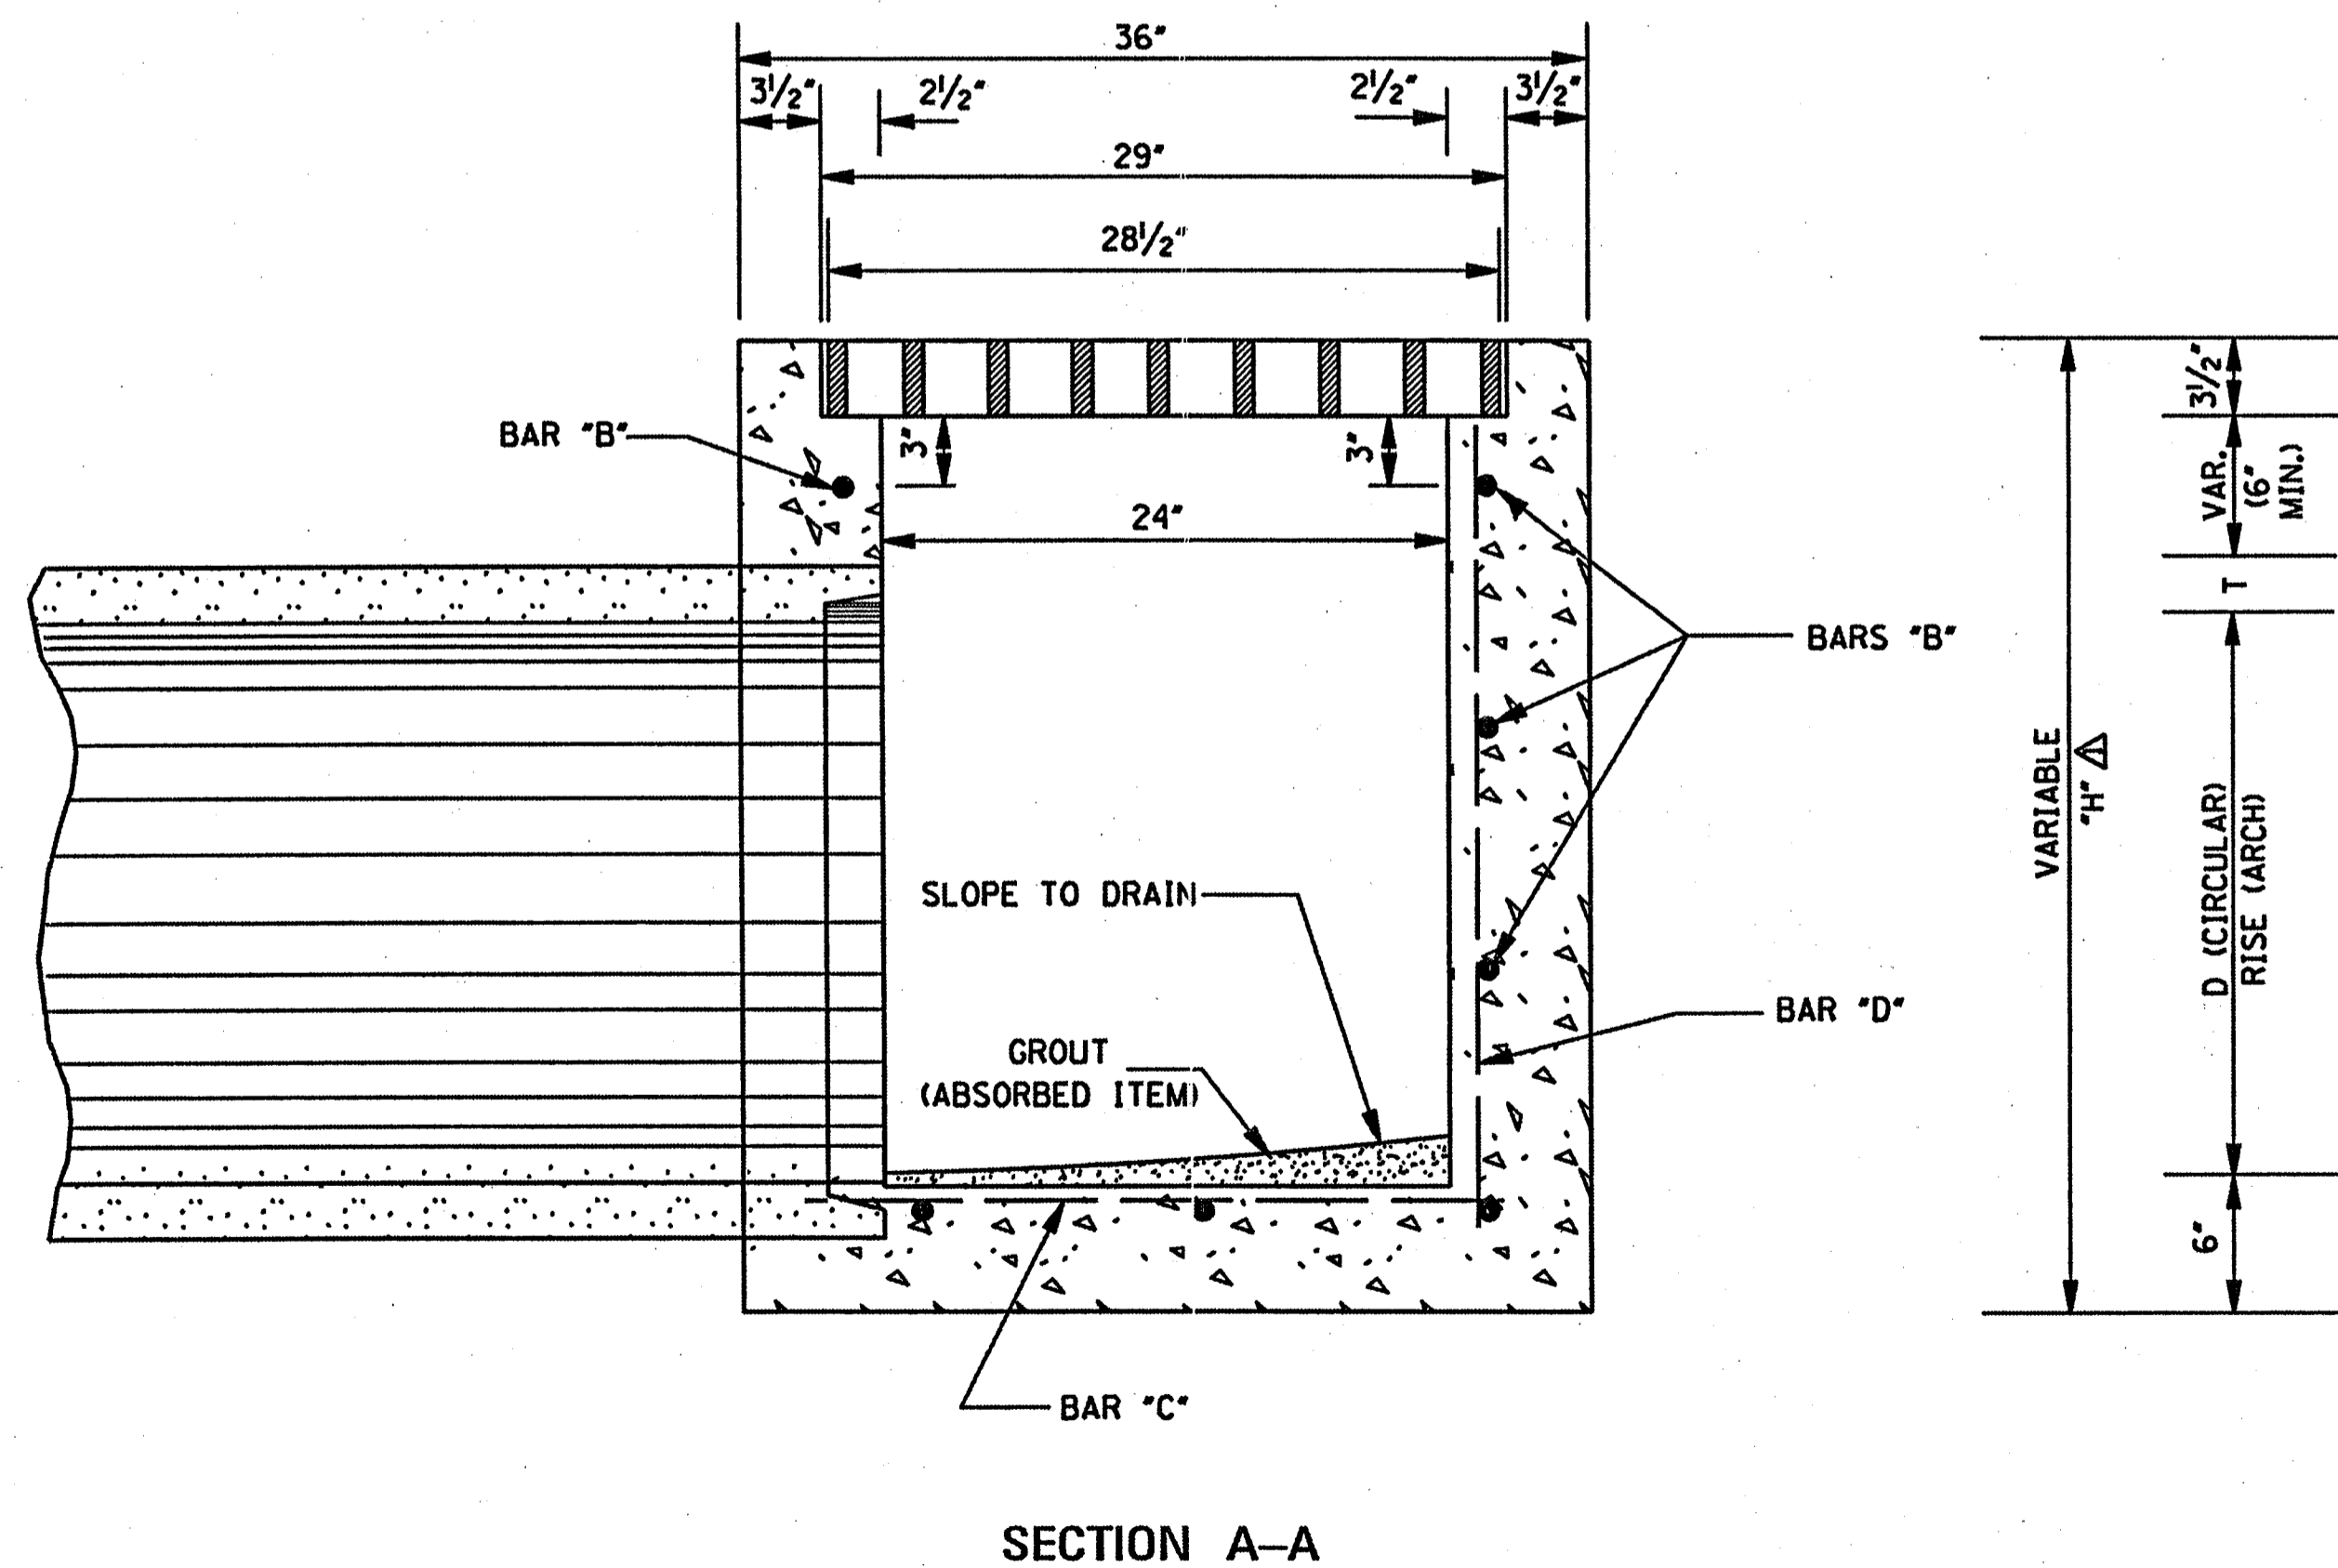

**SECTION A-A**

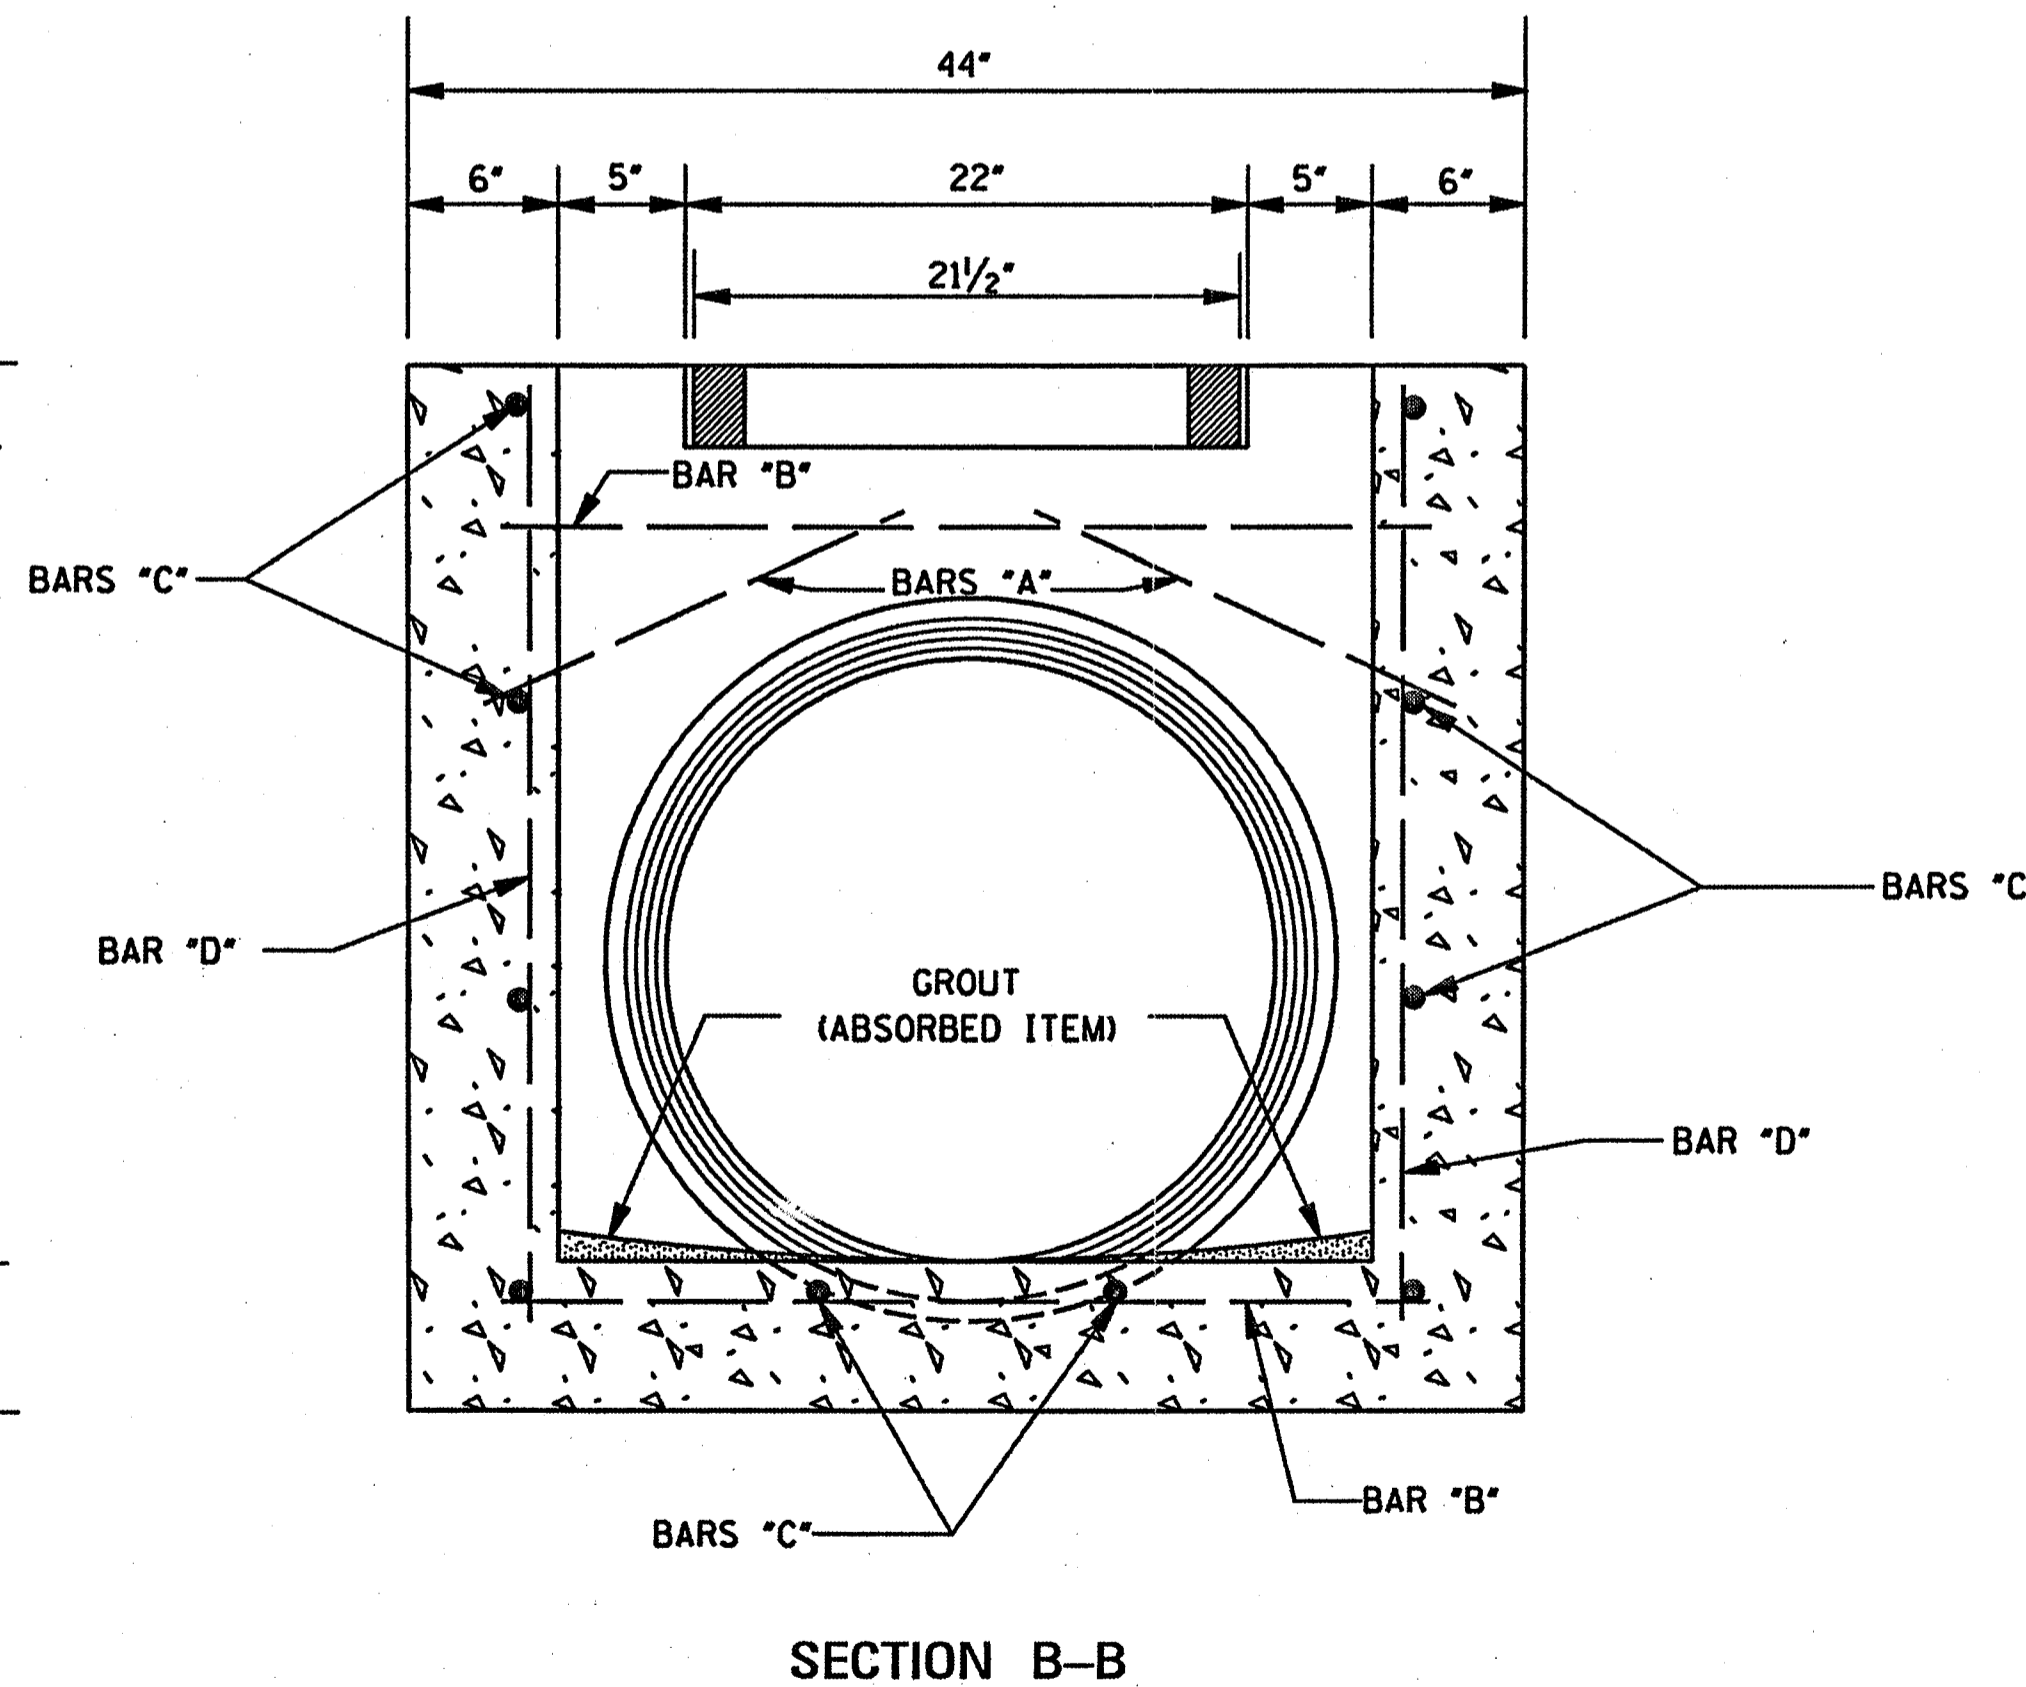

**SECTION B-B**

5-01-02	ADDED "H"	REVISION	BY	S.W.R.
DATE				

MISSISSIPPI DEPARTMENT OF TRANSPORTATION  
ROADWAY DESIGN DIVISION  
STANDARD PLAN




**TYPE I MEDIAN INLET**  
(24" PIPE AND UNDER)

WORKING NUMBER  
MI-1




SHEET NUMBER  
306

ISSUE DATE: OCTOBER 1, 1998

GRATE NO. 1

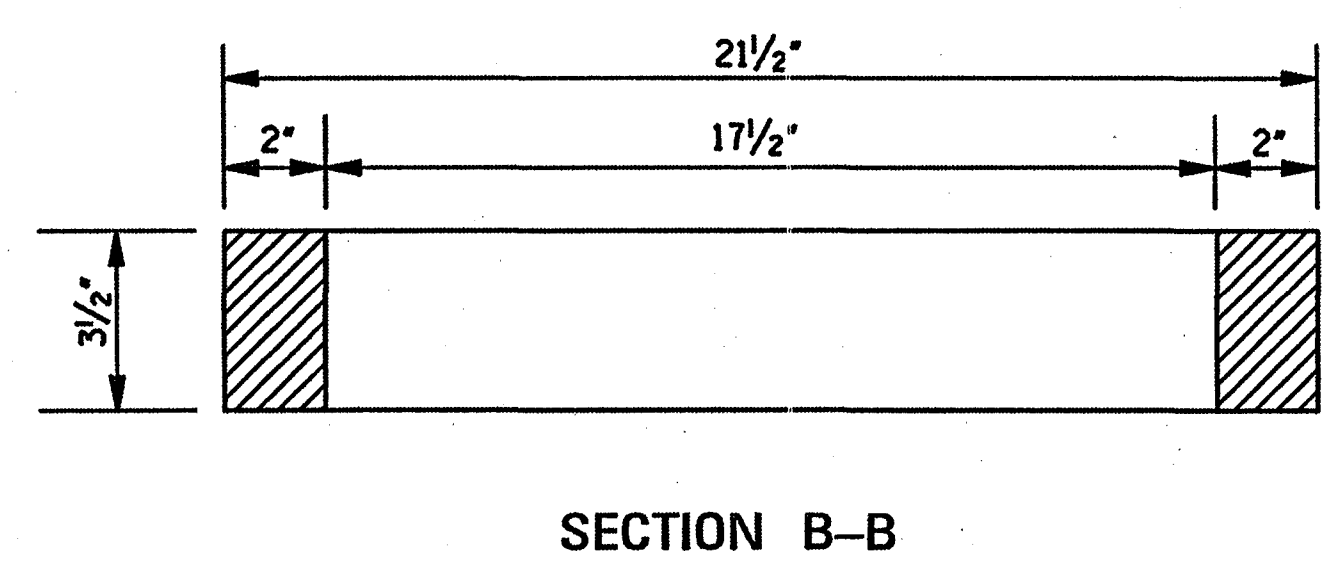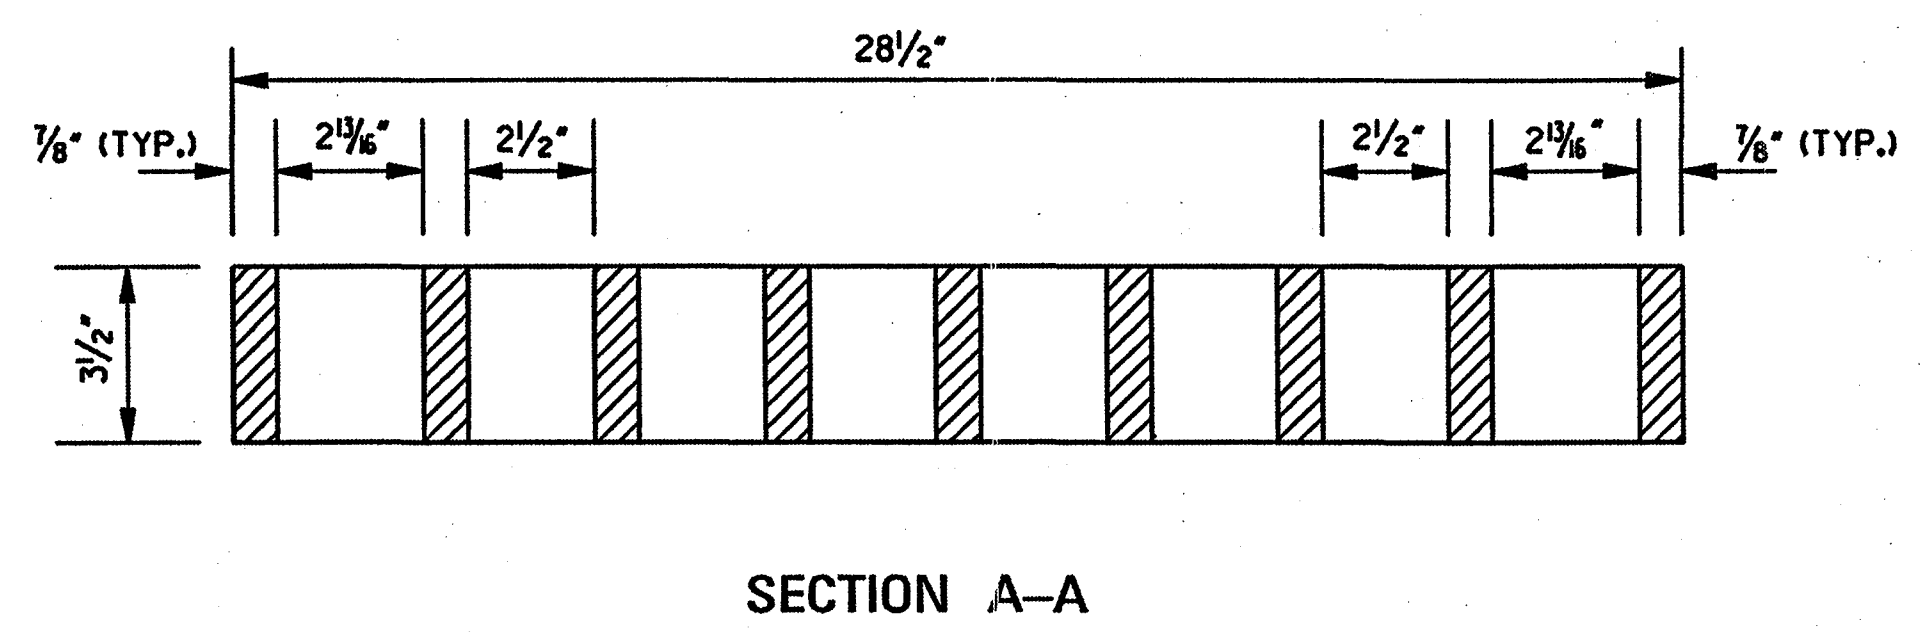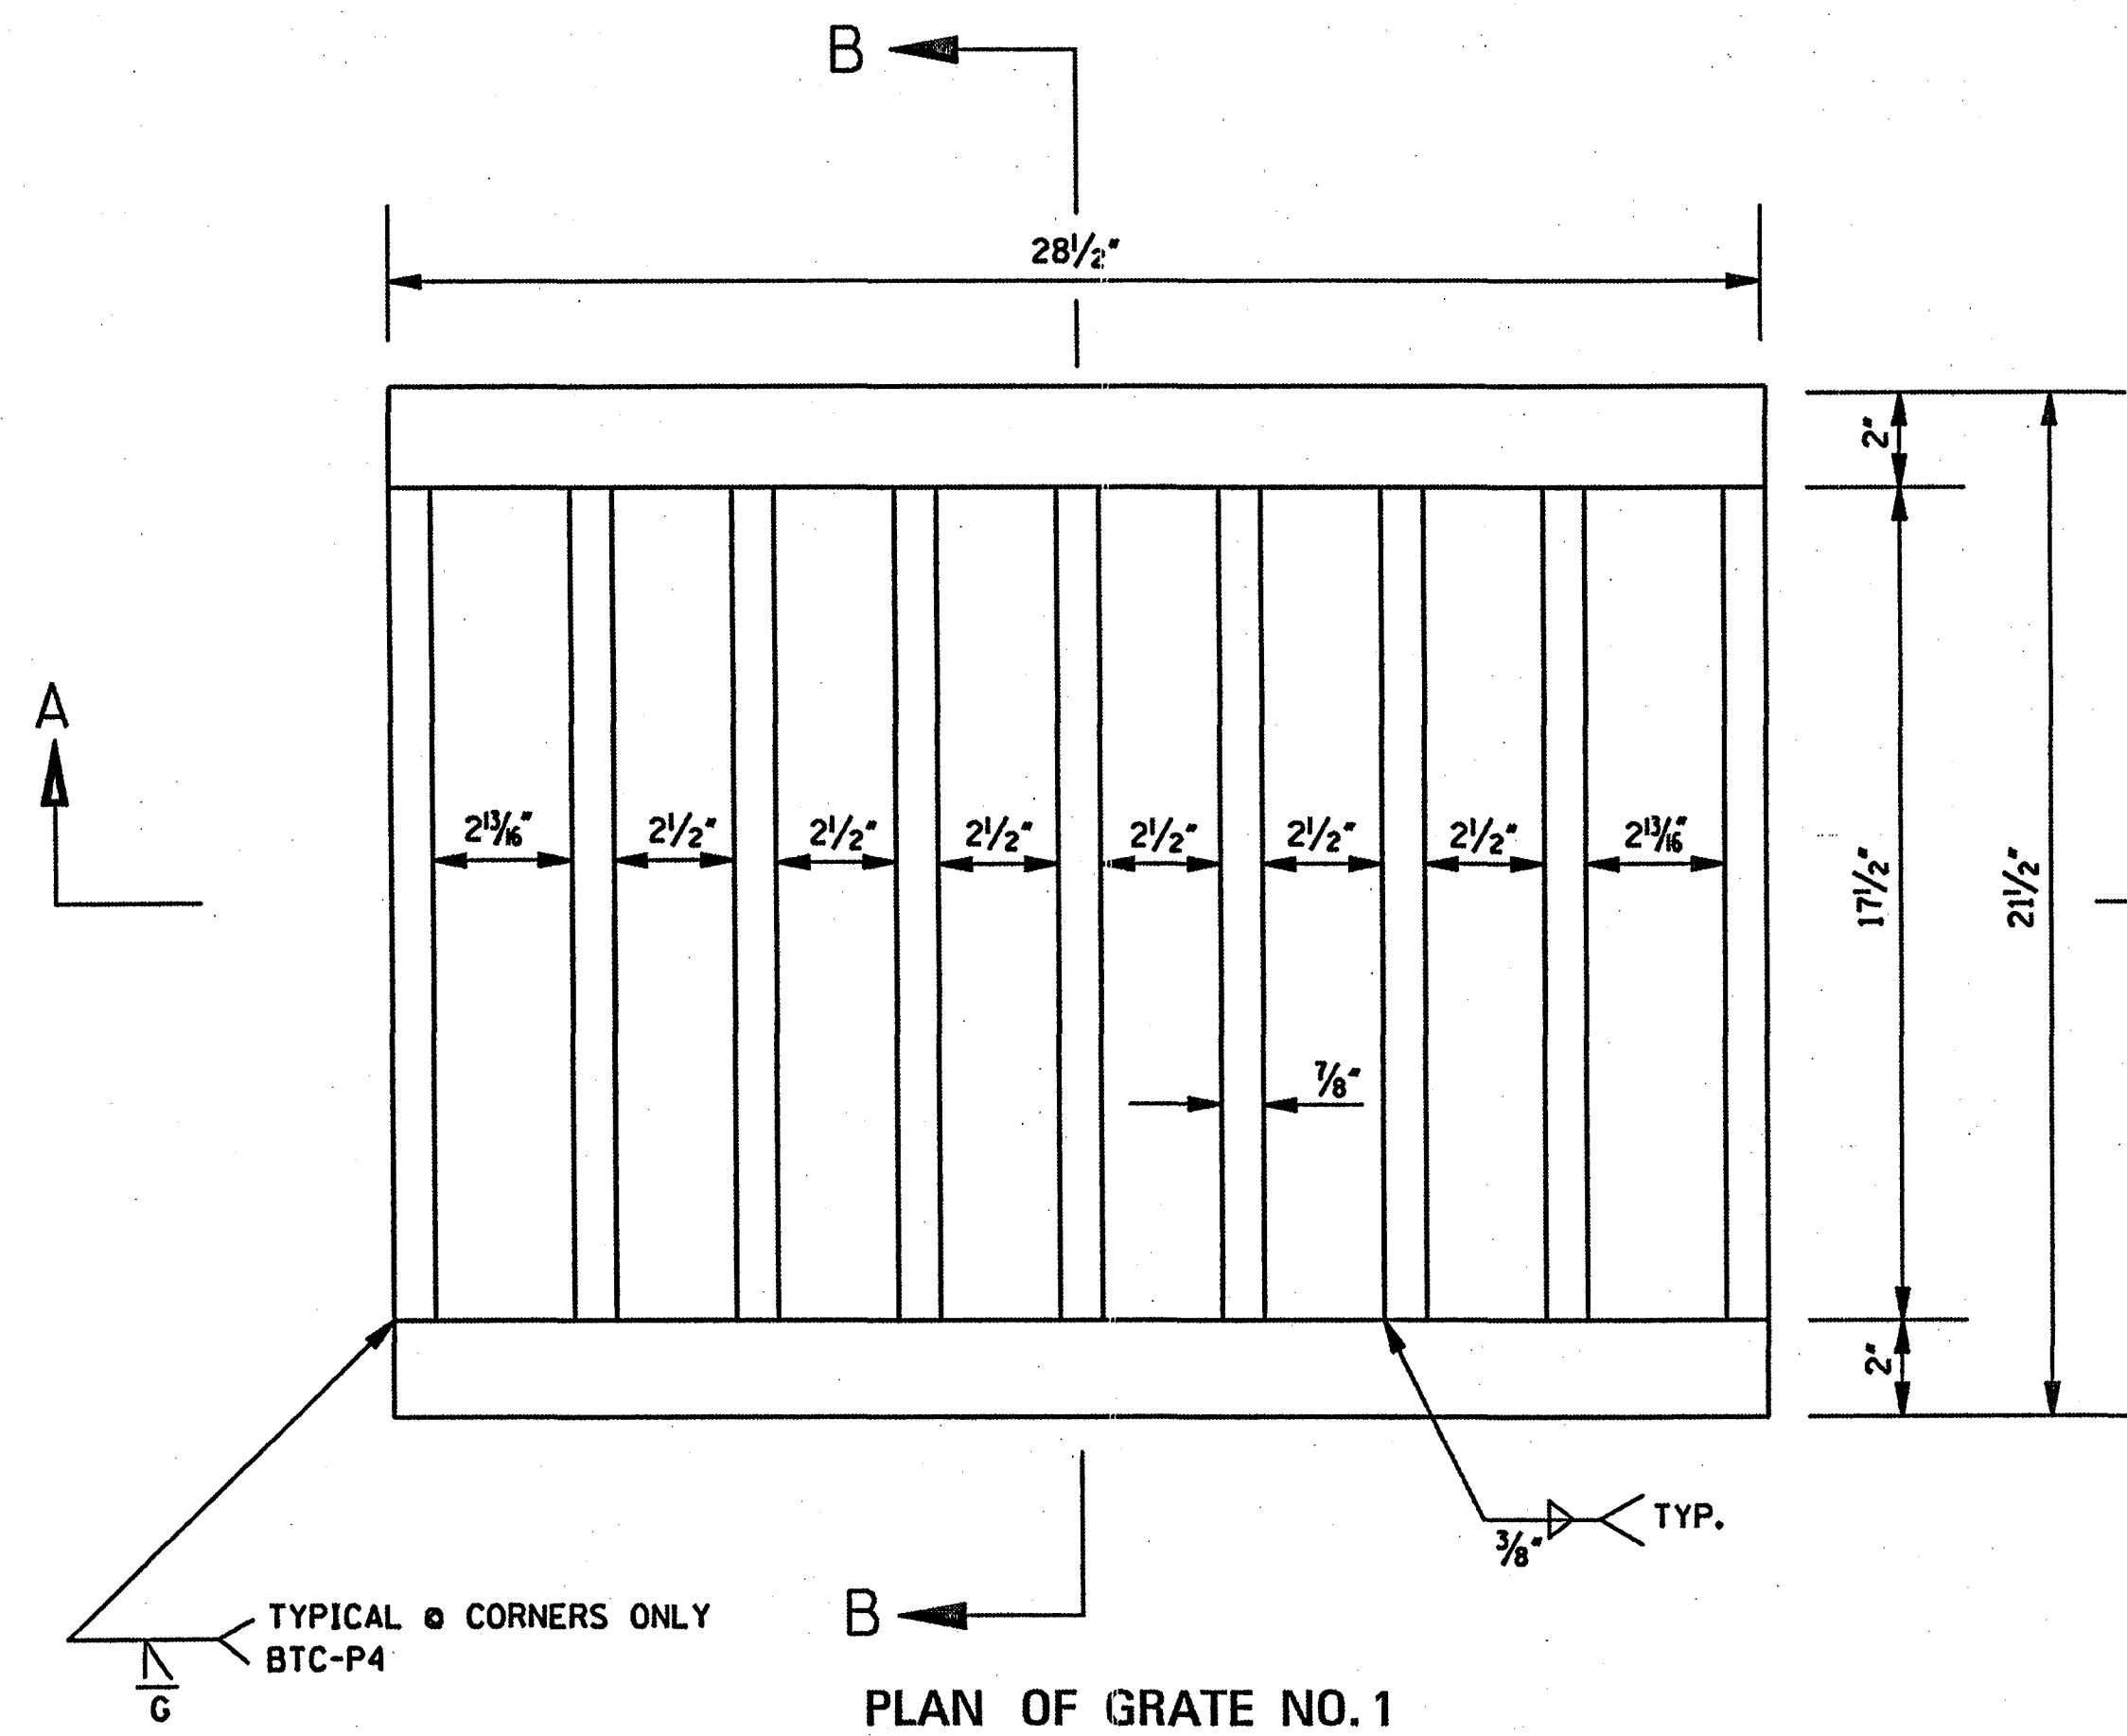


GRATE NO. 2

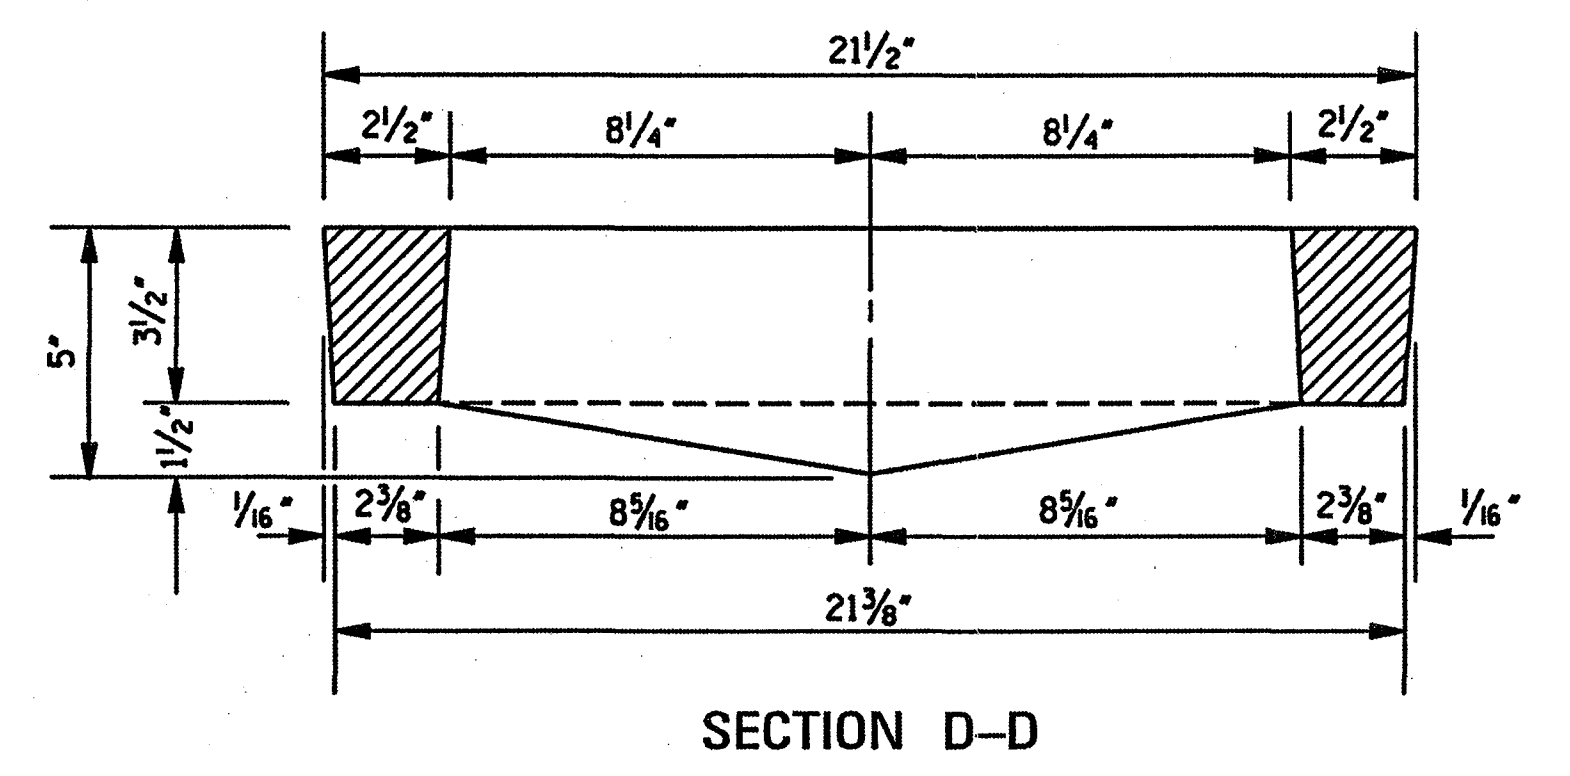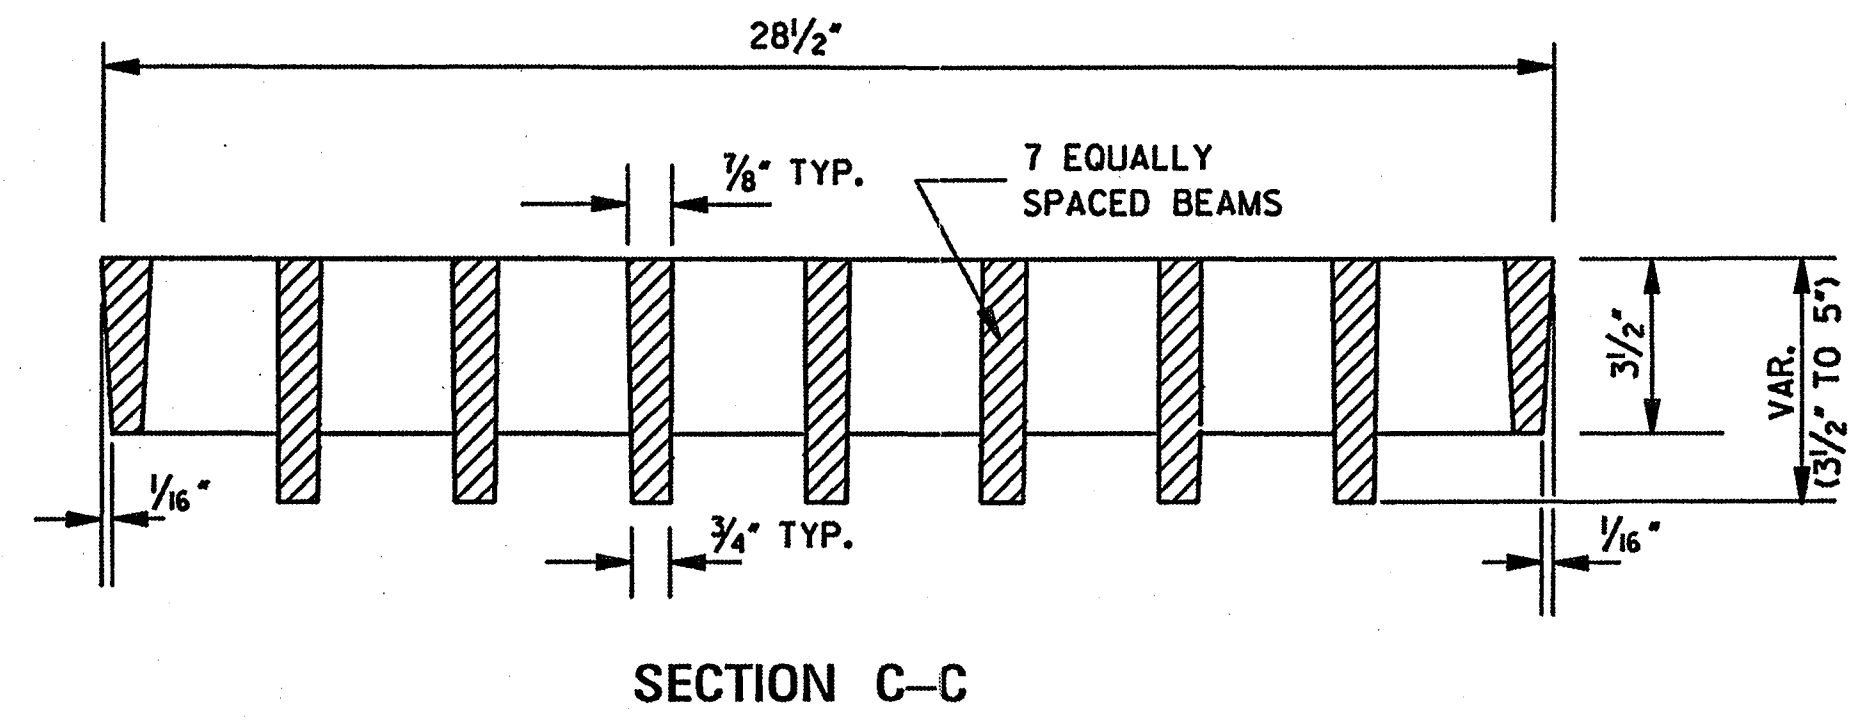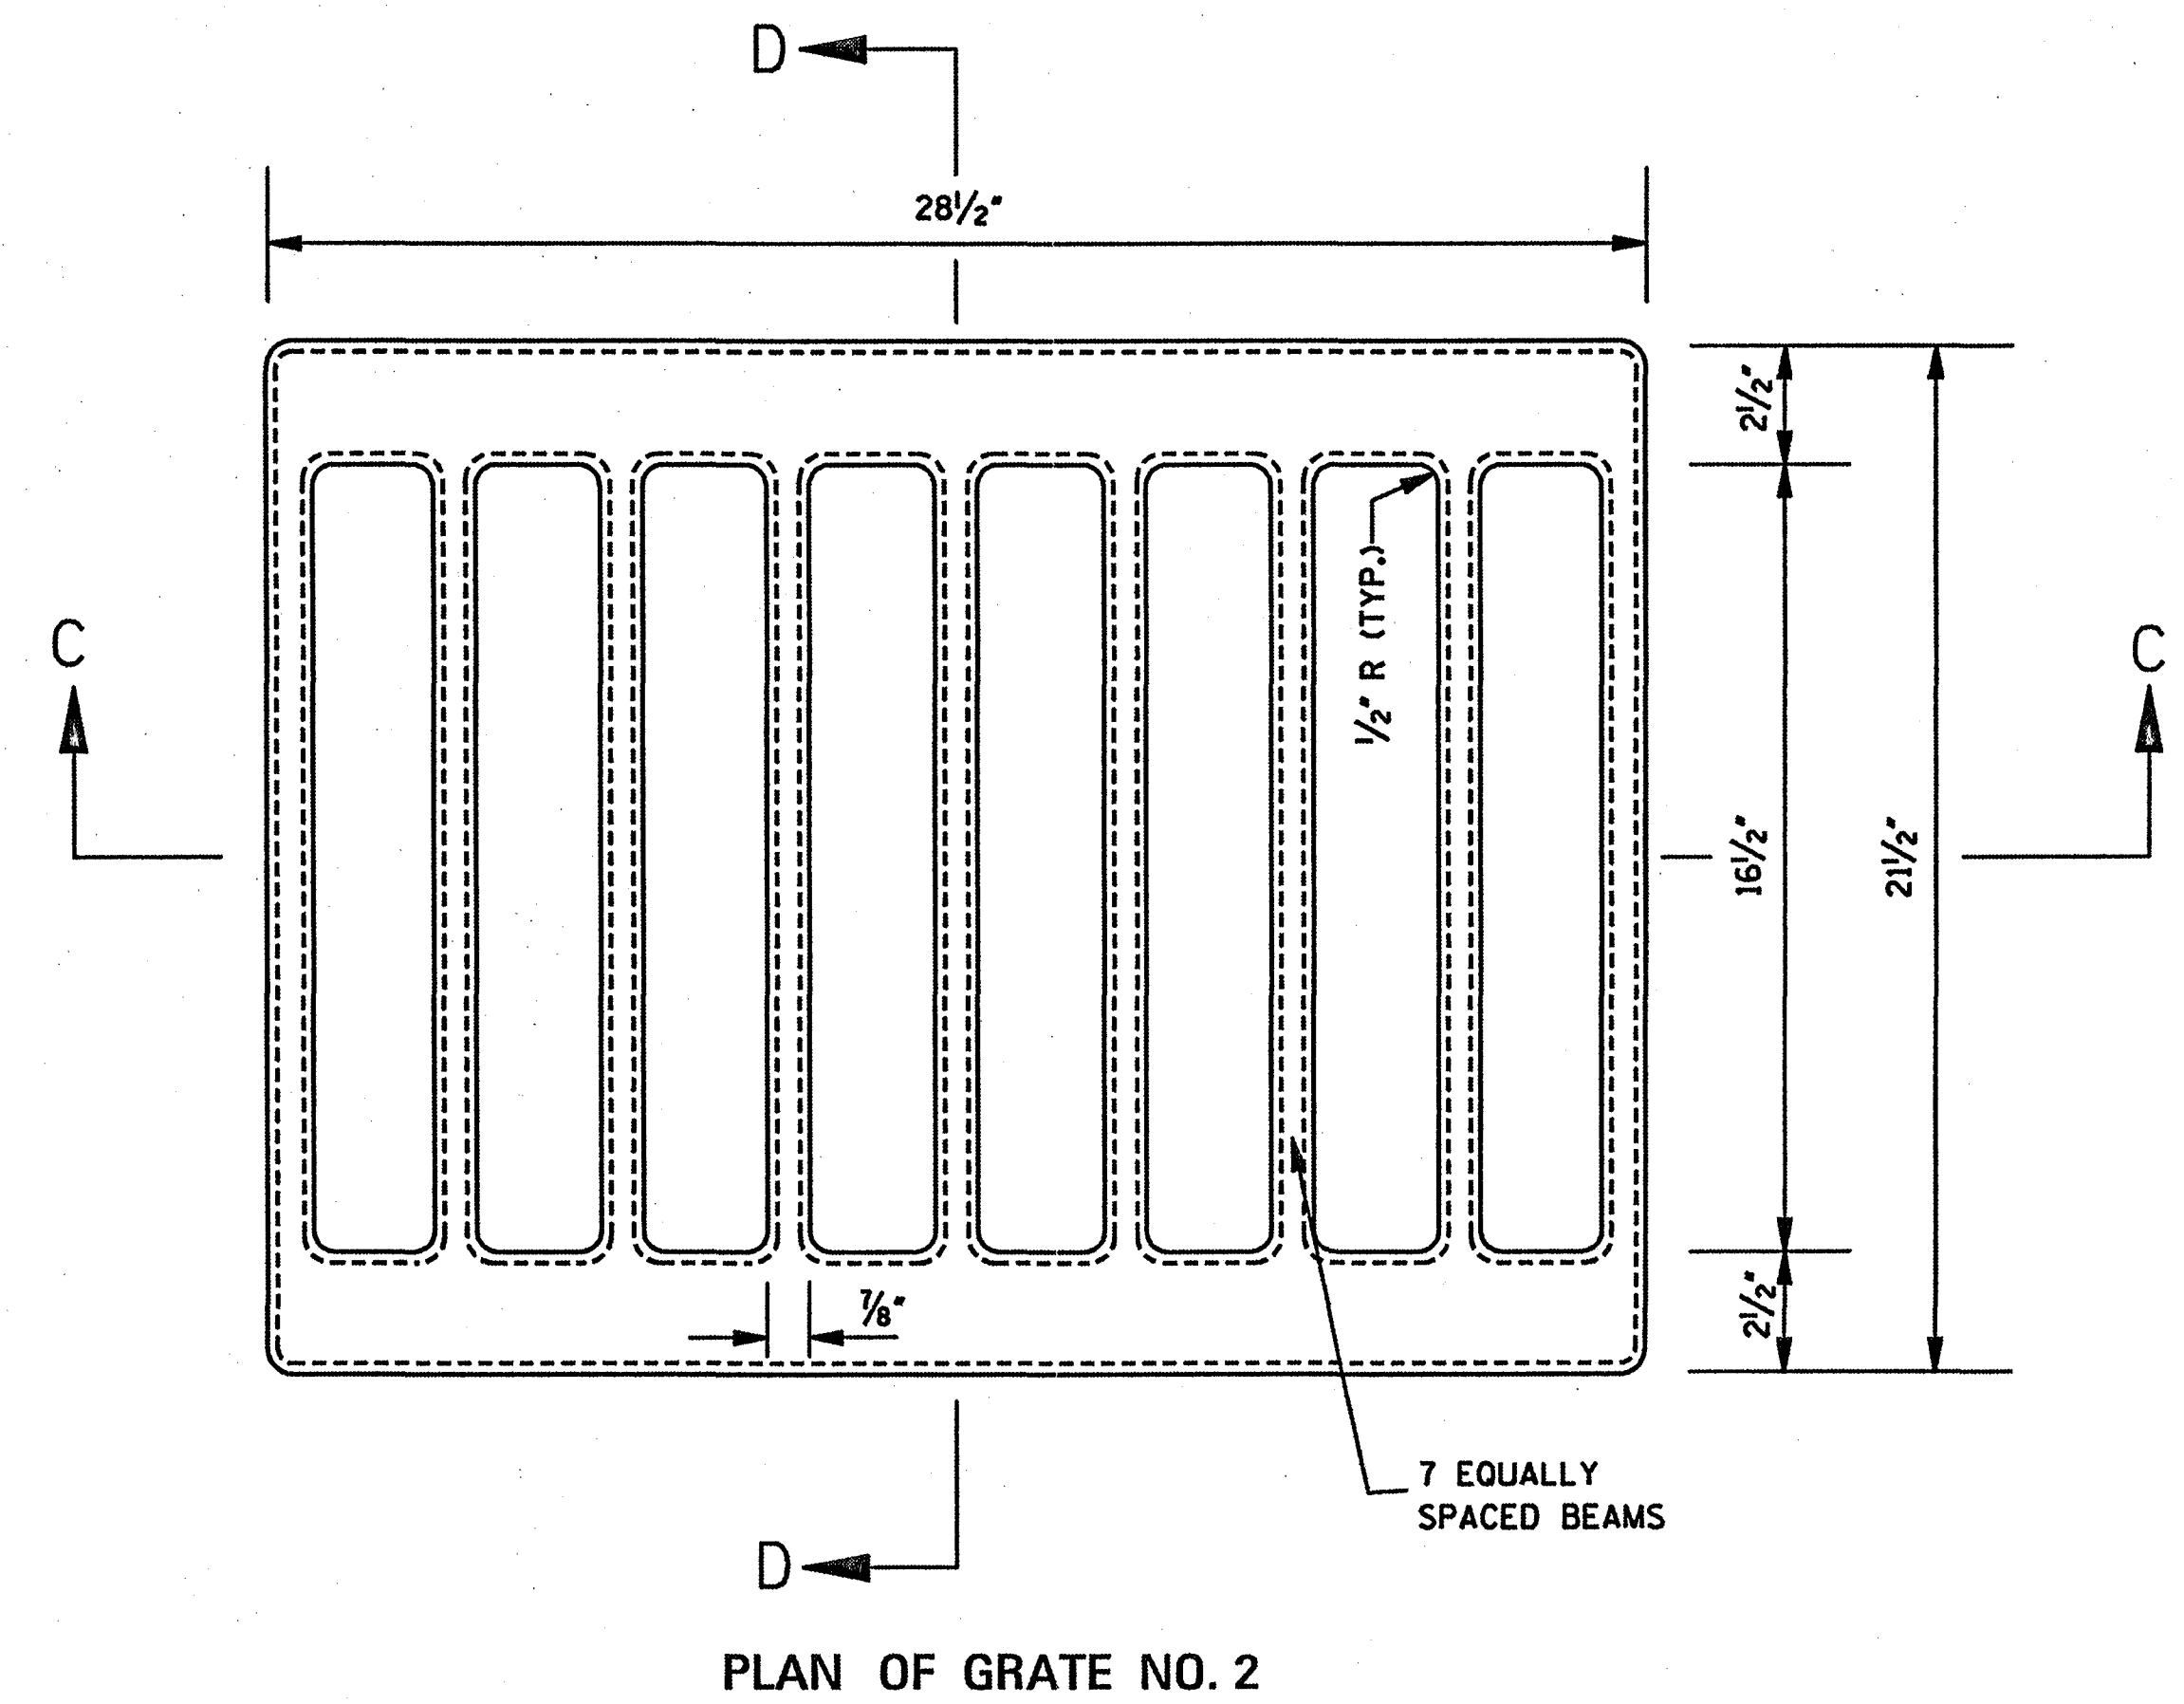


- GENERAL NOTES:
1. BASIS OF PAYMENT WILL BE 250 lbs OF GRATING FOR EITHER GRATE.
  2. GRATE NO.1  
THE GRATE MAY BE WELDED STEEL (ASTM A 588) OR STEEL CASTING (AASHTO M 192, CLASS 90). STEEL CASTING SHALL BE GALVANIZED (AASHTO M 111).
  3. GRATE NO.2  
THE GRATE SHALL BE DUCTILE IRON (ASTM A 536, GRADE 80-55-06).


BY		MISSISSIPPI DEPARTMENT OF TRANSPORTATION	
REVISION		ROADWAY DESIGN DIVISION	
DATE		STANDARD PLAN	
		<b>DETAILS OF GRATES FOR MEDIAN INLETS</b>	
		MISSISSIPPI DEPARTMENT OF TRANSPORTATION	
		ENGLISH	
		MISSISSIPPI	
		WORKING NUMBER	
		IG-1	
		SHEET NUMBER	
		314	
ISSUE DATE:		OCTOBER 1, 1998	

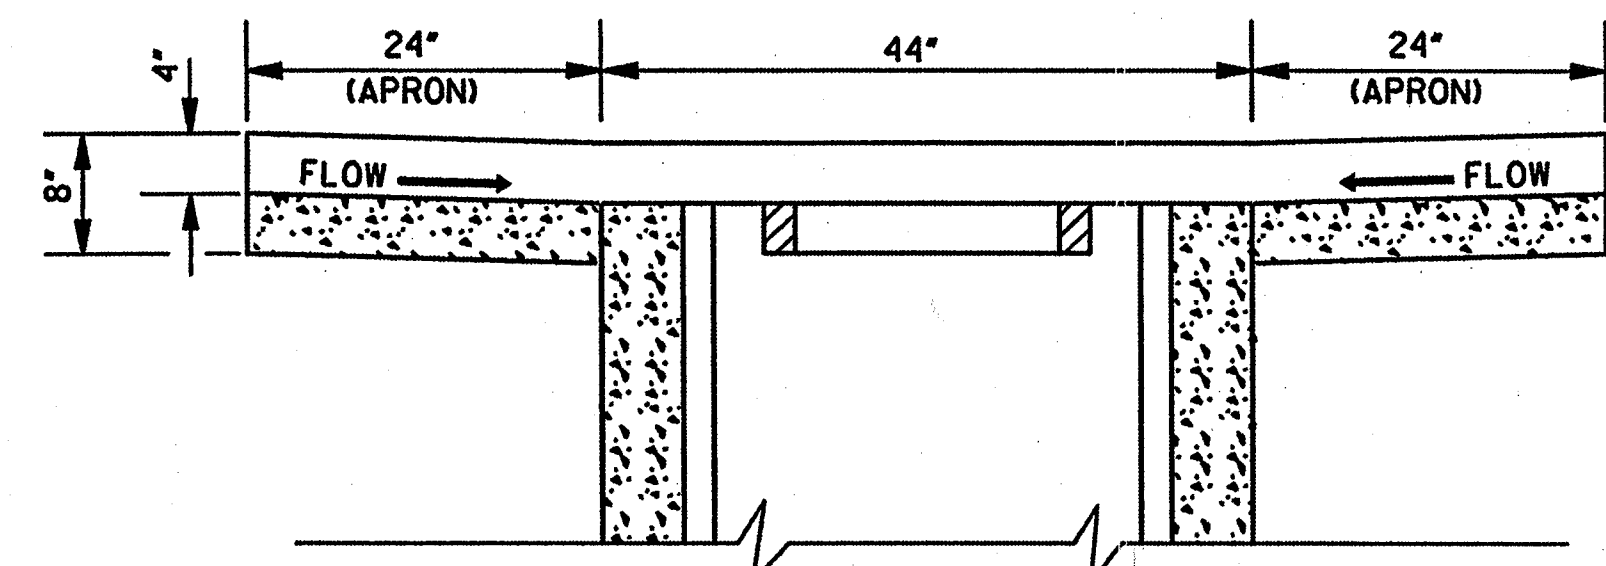

**SECTION A-A**  
NOTE: APRON REINFORCEMENT & SOLID SOD NOT SHOWN (SEE SECTION C-C).

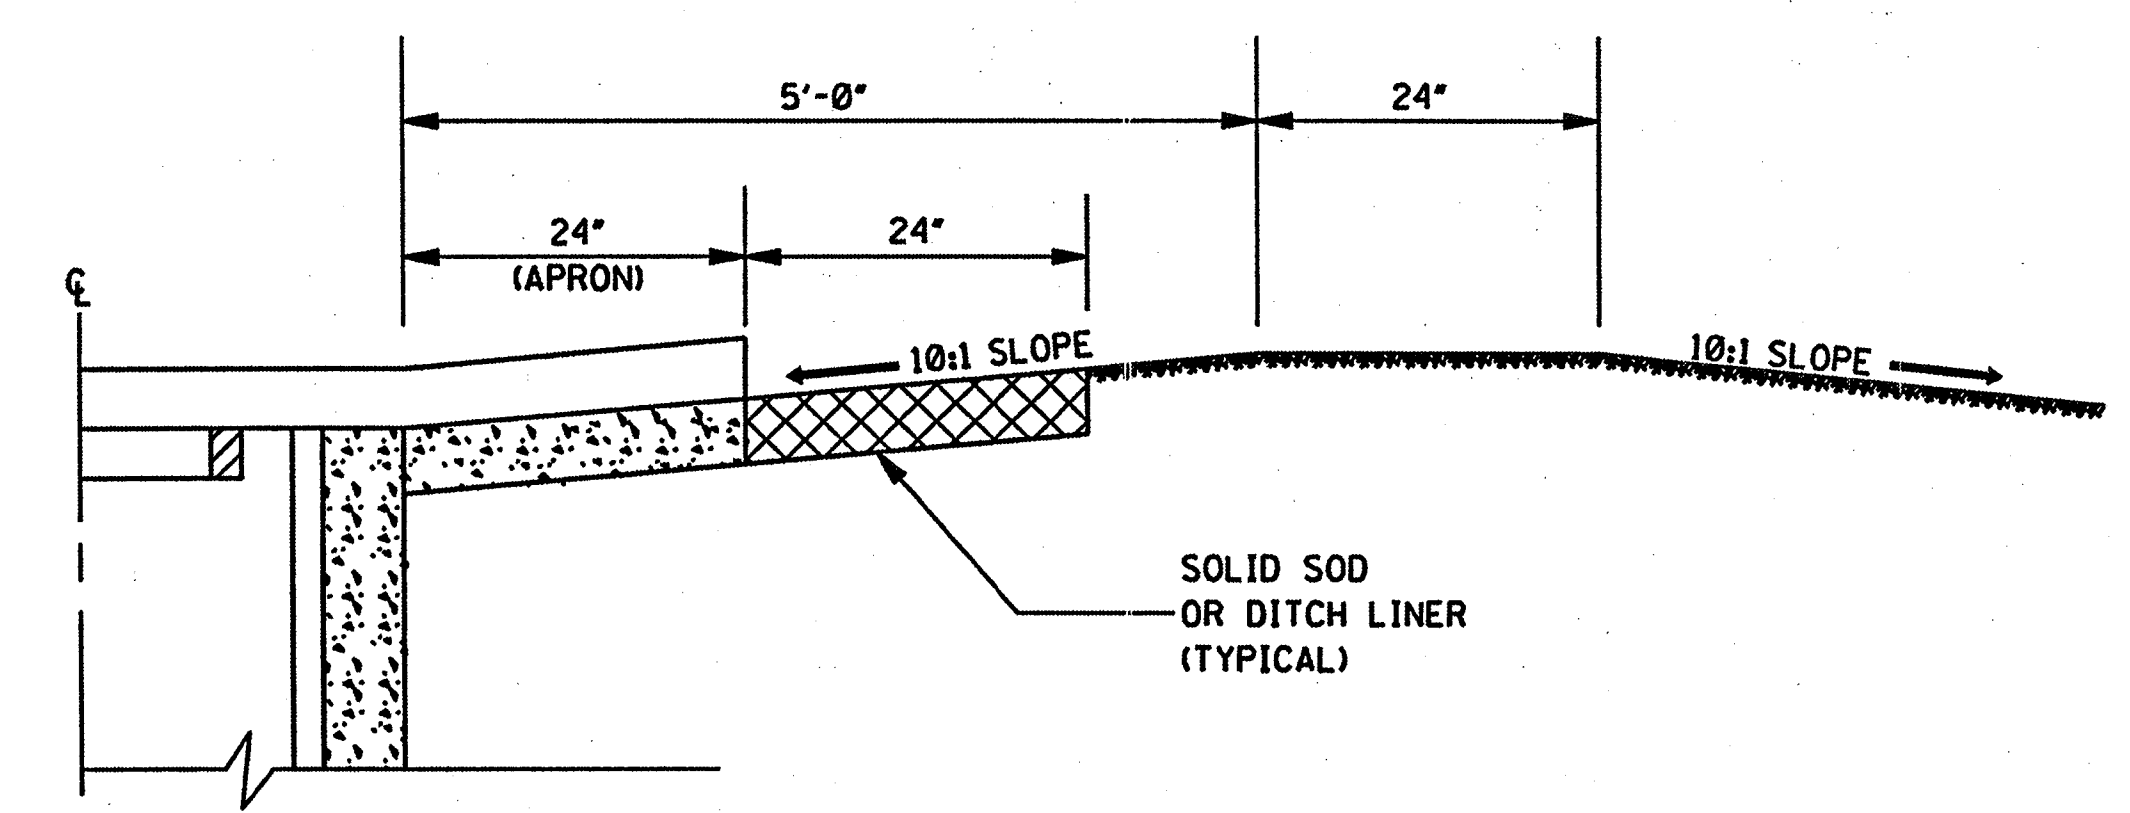


**HALF SECTION A-A SHOWING DITCH PLUG**

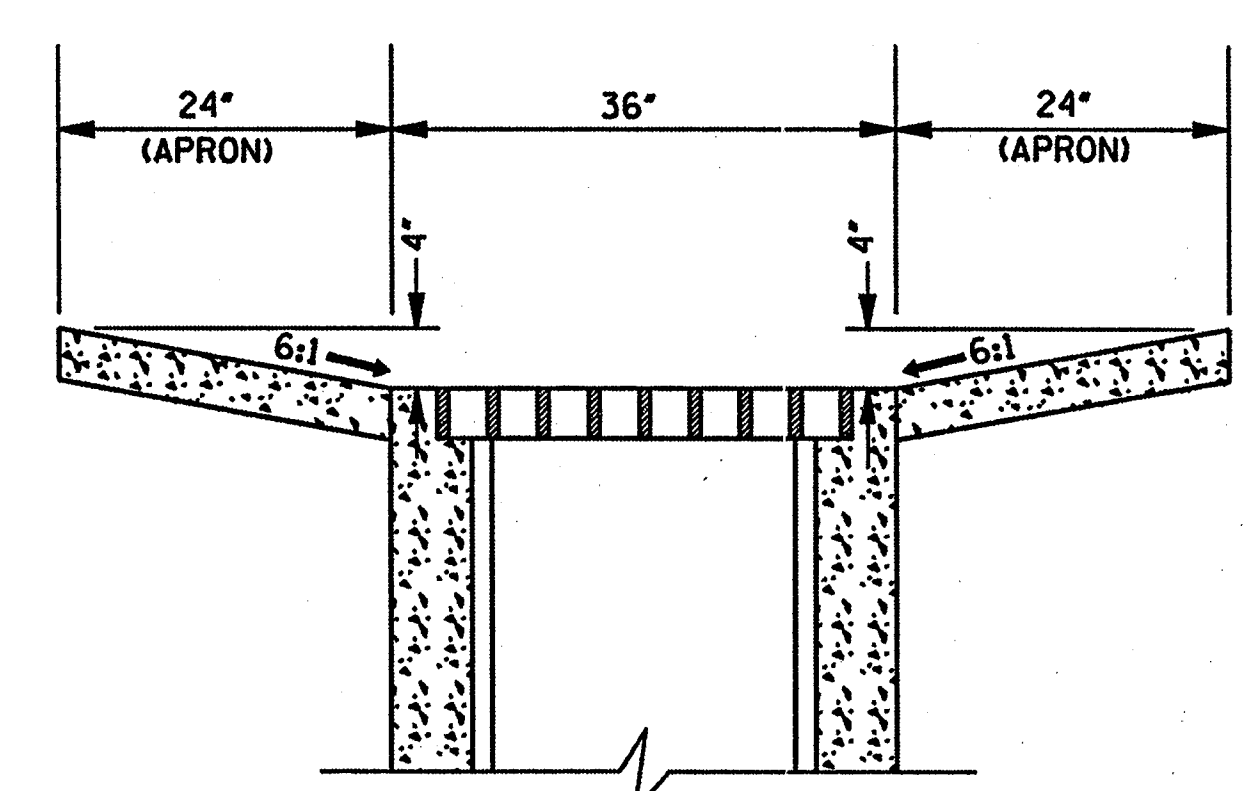


**SECTION B-B**  
NOTE: APRON REINFORCEMENT & SOLID SOD NOT SHOWN (SEE SECTION C-C).

TYPICAL #4 BARS, 30" LONG, SPACED 18" ON CENTER (REQUIRED WHERE PAVED DITCH IS USED. NOT A PAY ITEM).

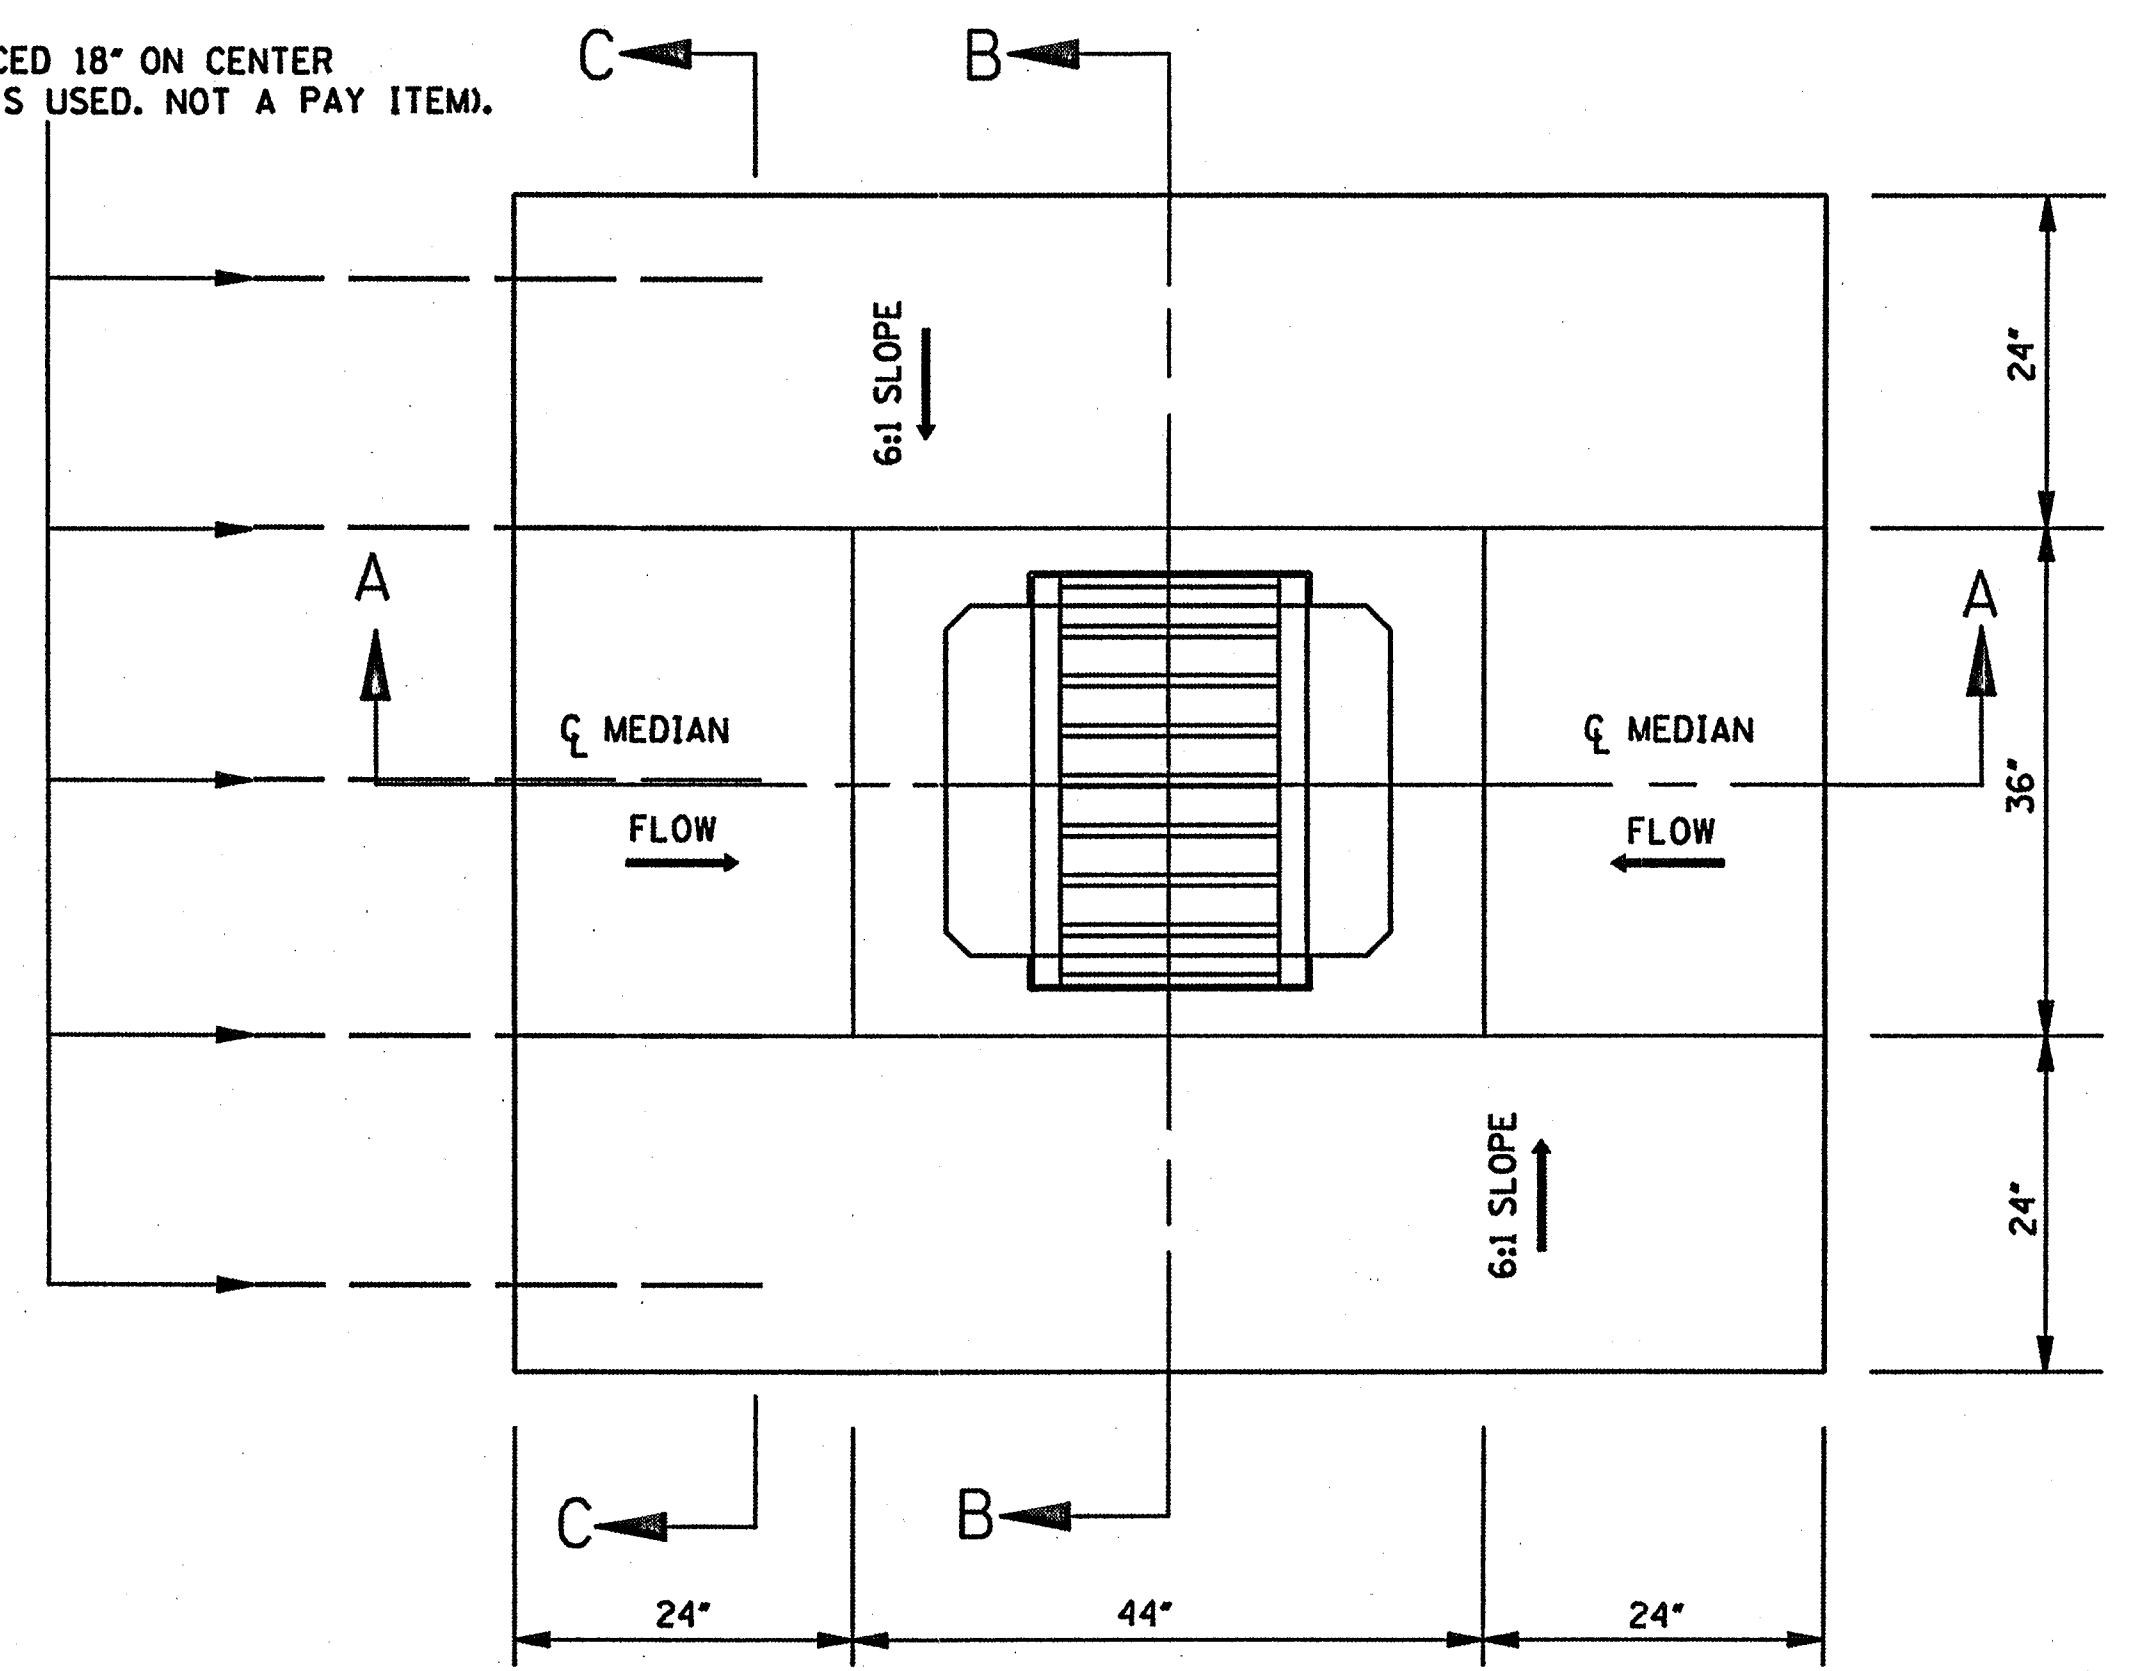

**PLAN OF INLET & PAVED APRON**

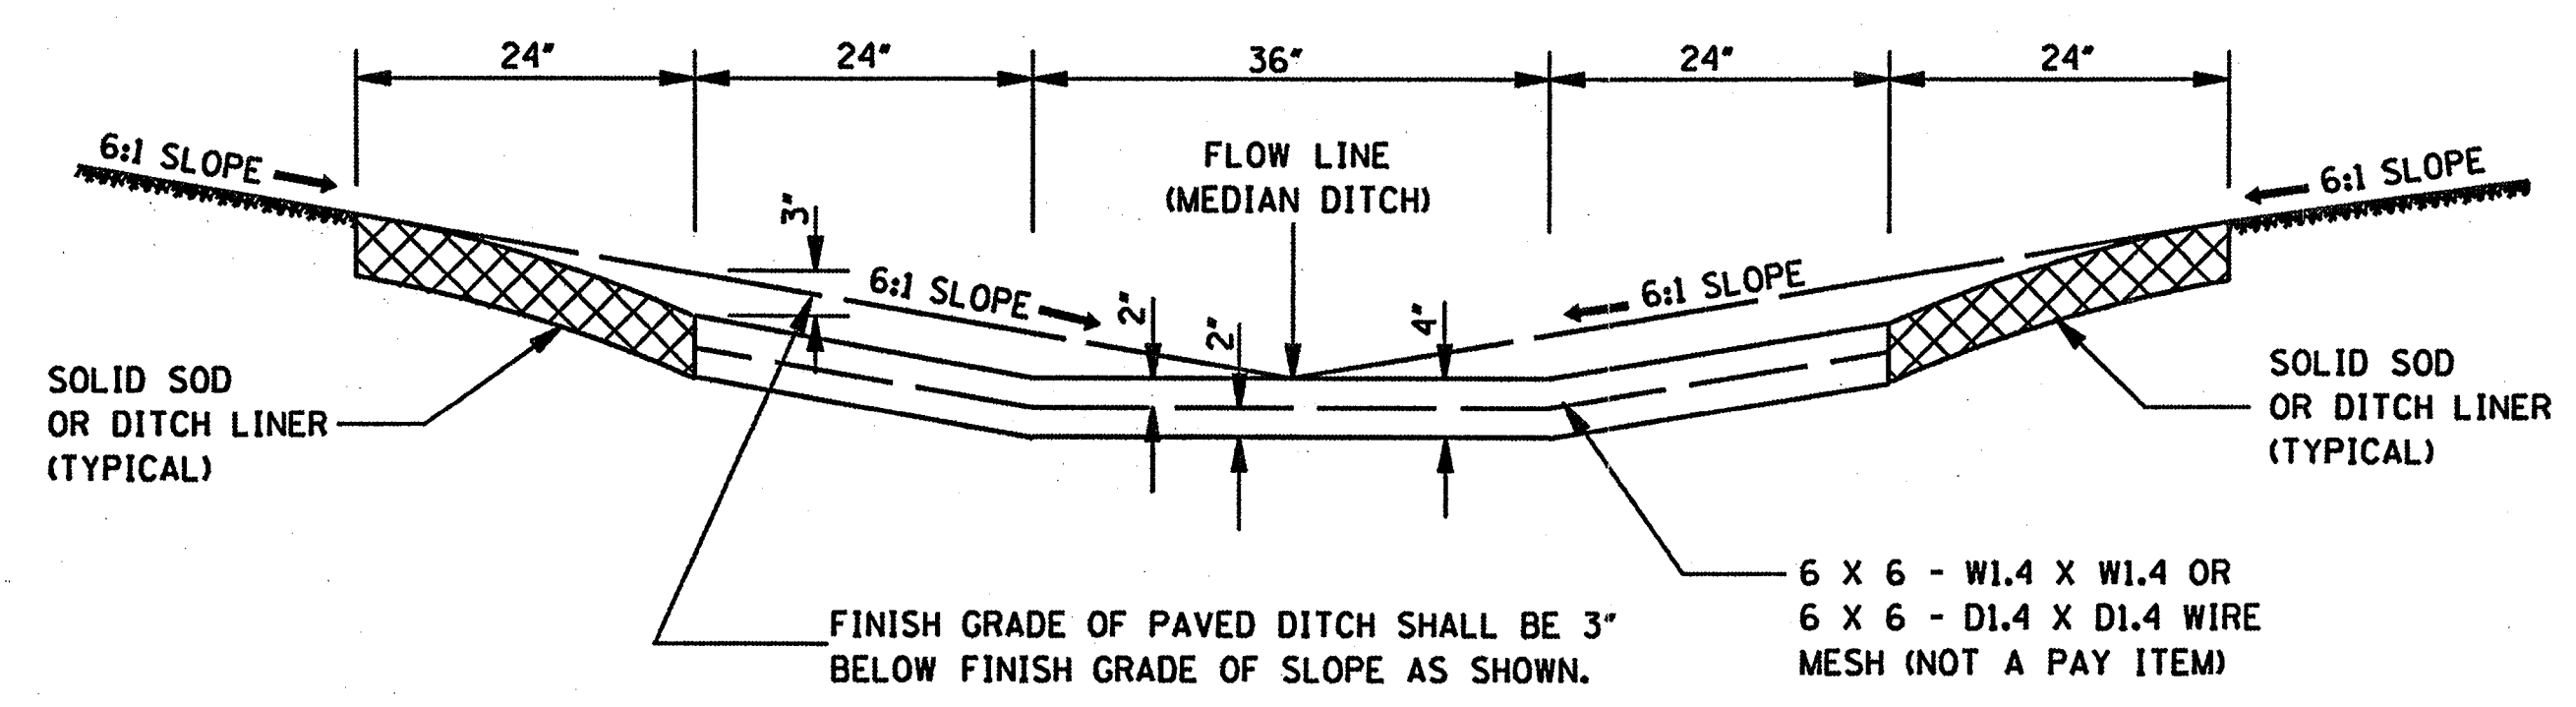

**SECTION C-C**


**GENERAL NOTES:**

1. CONSTRUCTION JOINTS TO BE TIED WITH 5 #4 BARS, 30" LONG, SPACED 18" ON CENTER, EXPANSION JOINT WILL NOT BE USED. CHAIR SUPPORTS FOR THE WIRE MESH WILL NOT BE REQUIRED. HOWEVER, THE CONTRACTOR SHALL PLACE THE WIRE MESH IN A SATISFACTORY AND WORKMANLIKE MANNER TO ENSURE THAT THE FINAL POSITION IS REASONABLY NEAR THE POSITION INDICATED.
2. PAVED APRON TO BE CONSTRUCTED AND PAID FOR IN ACCORDANCE WITH THE REQUIREMENTS FOR PAVED DITCHES.
3. 0.532 yd<sup>3</sup> CLASS "C" CONCRETE REQUIRED.
4. QUANTITY SHOWN WILL BE USED AS THE BASIS FOR FINAL PAYMENT UNLESS AUTHORIZED MODIFICATIONS ARE MADE.

MISSISSIPPI DEPARTMENT OF TRANSPORTATION ROADWAY DESIGN DIVISION STANDARD PLAN	
<b>PAVED INLET APRON AND MEDIAN DITCH PLUG</b>	
WORKING NUMBER PA-1	MISSISSIPPI DEPARTMENT OF TRANSPORTATION
SHEET NUMBER 318	ISSUE DATE: OCTOBER 1, 1998

### BELL AND SPIGOT END OPTION

NOTE: BELL-END ON DOWNSTREAM SECTION  
SPIGOT-END ON UPSTREAM SECTION.

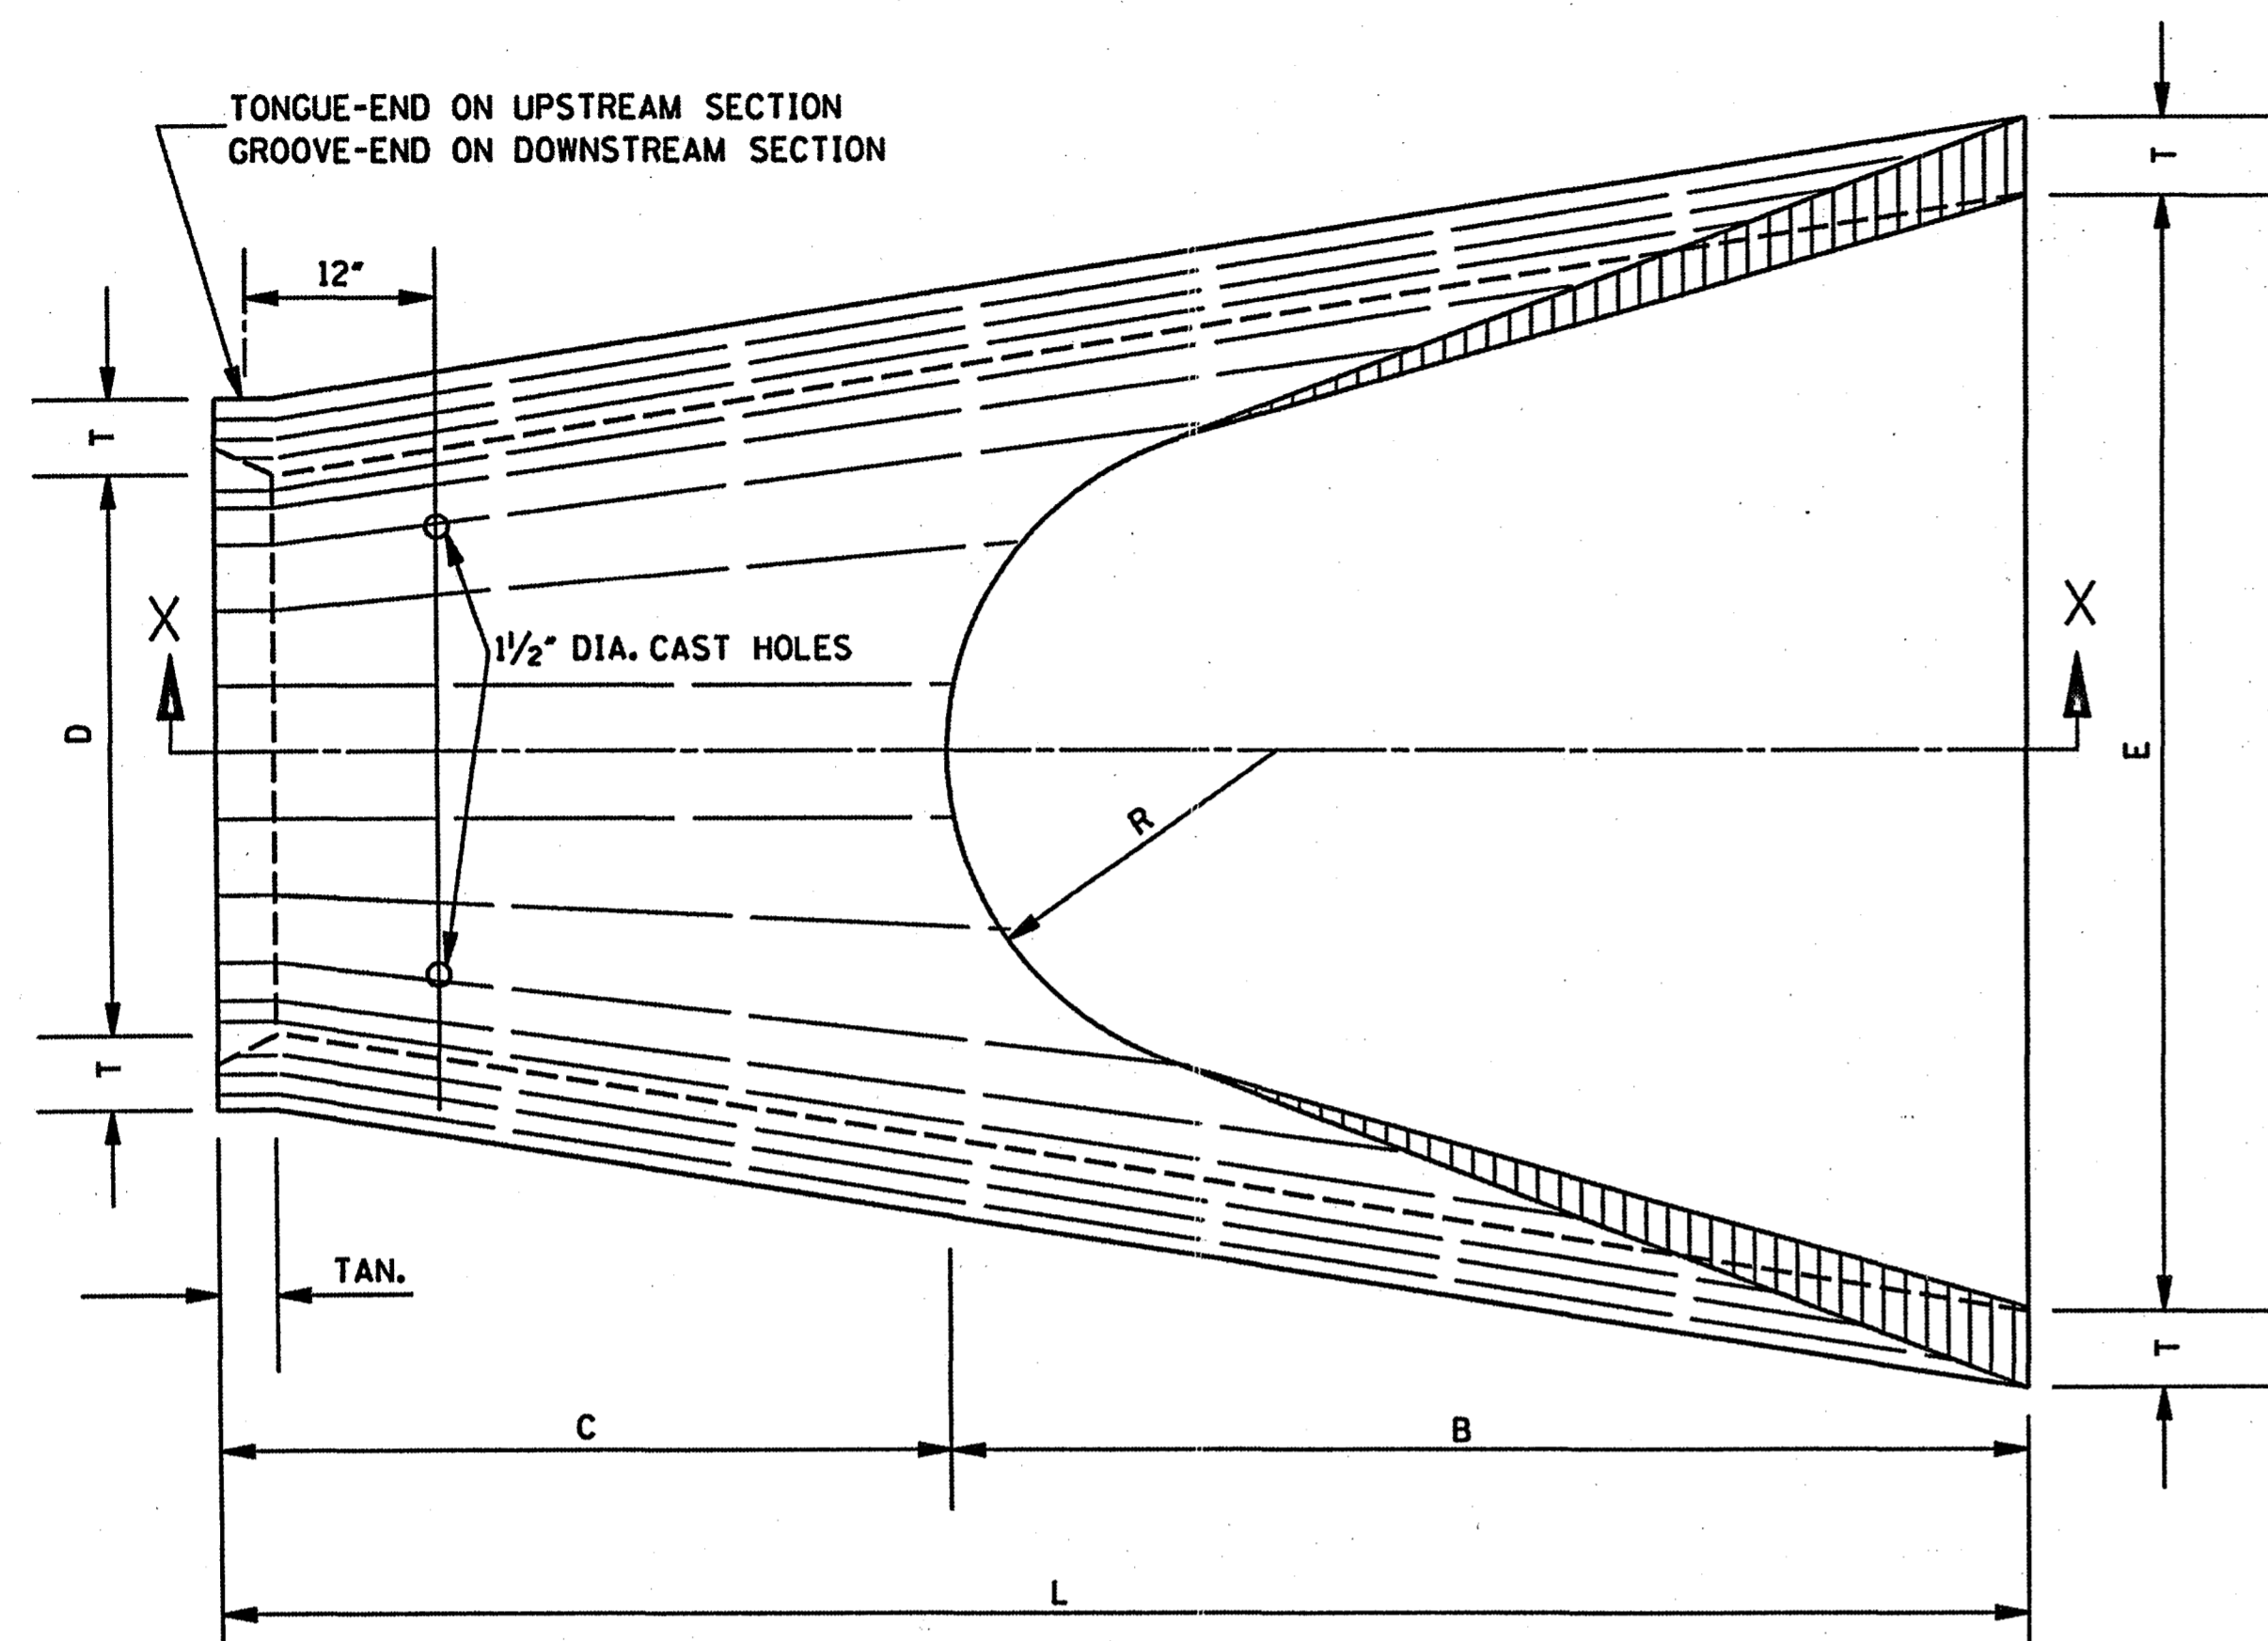


PLAN OF DOWNSTREAM END


D	T	H:V	A	B	C	E	L
15"	2 1/4"	3:1	6"	2'-3"	4'-1"	2'-8"	6'-1"
18"	2 1/2"	3:1	9"	2'-3"	3'-10"	3'-0"	6'-1"
24"	3"	3:1	10"	3'-8"	2'-6"	4'-0"	6'-2"
30"	3 1/2"	3:1	1'-0"	4'-6"	1'-8"	5'-0"	6'-2"
36"	4"	3:1	1'-3"	5'-3"	2'-11"	6'-0"	8'-2"
42"	4 1/2"	3:1	1'-9"	5'-3"	2'-11"	6'-6"	8'-2"
48"	5"	3:1	2'-0"	6'-0"	2'-2"	7'-0"	8'-2"
54"	5 1/2"	3:1	2'-4"	6'-6"	1'-10"	7'-6"	8'-4"
* 60"	6"	3:1	2'-10"	6'-6"	1'-10"	8'-0"	8'-4"
* 66"	6 1/2"	3:1	3'-4"	6'-6"	1'-10"	8'-6"	8'-4"
* 72"	7"	3:1	3'-10"	6'-6"	1'-10"	9'-0"	8'-4"

\* NOTE: SEE GENERAL NOTE 2.

0.056
0.063
0.083
0.102
0.123
0.134
0.145
0.156
0.167
0.177
0.188

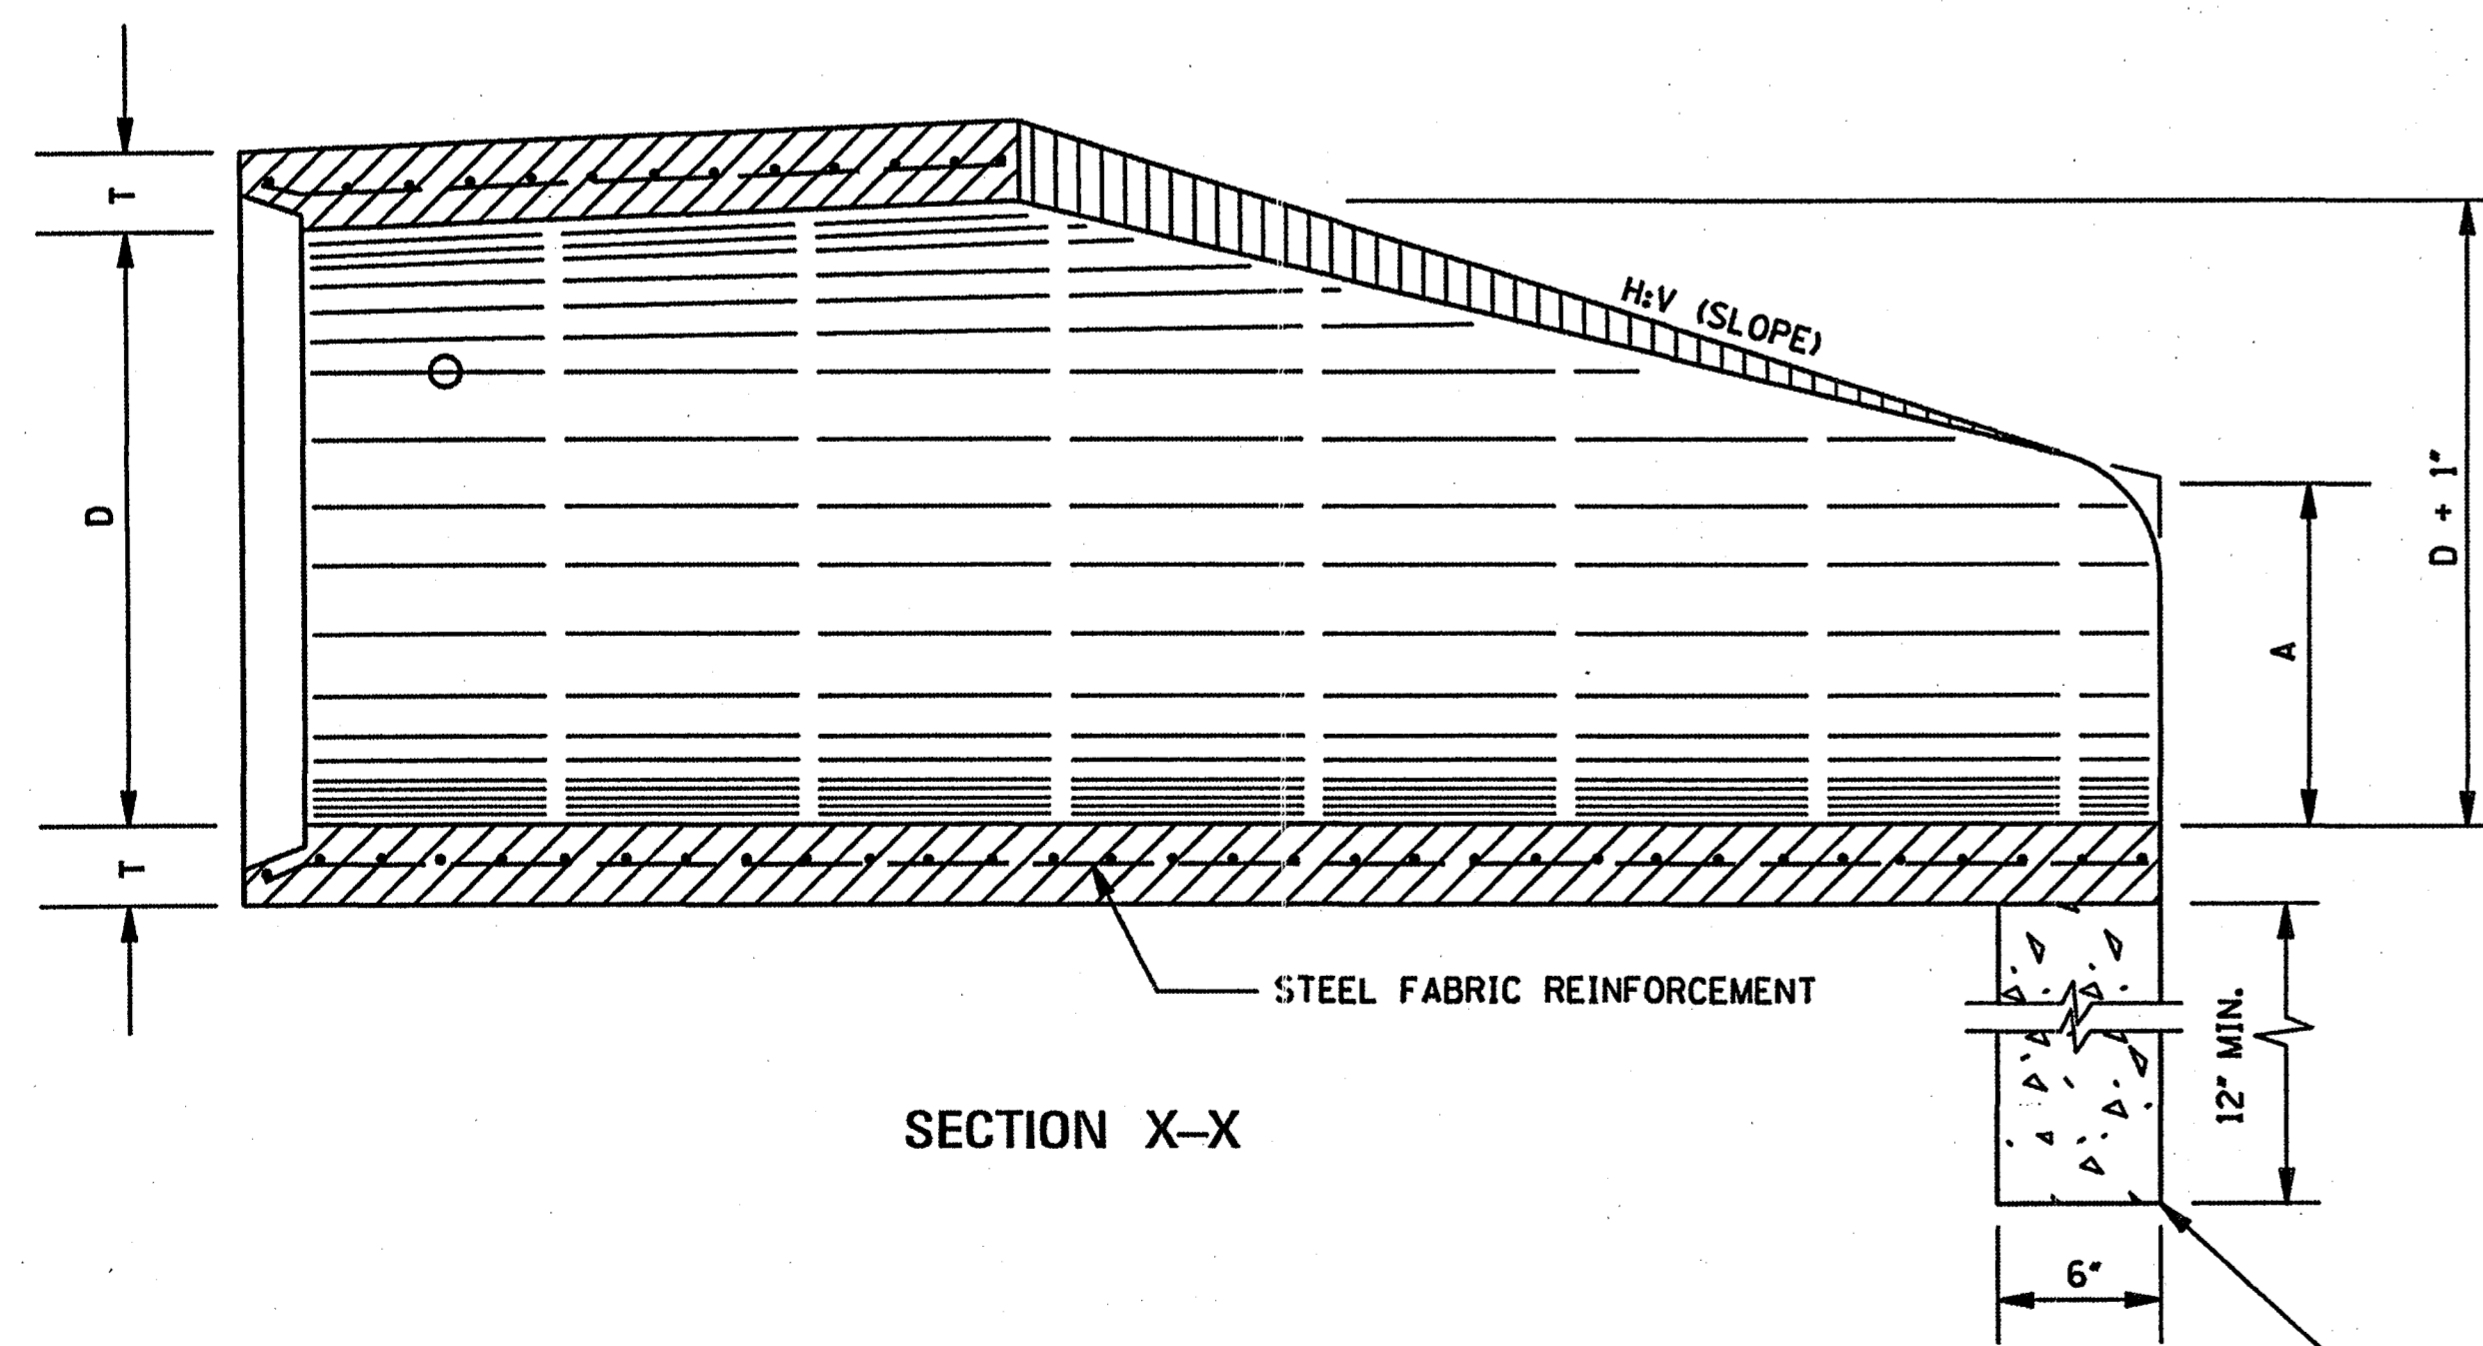

SECTION X-X

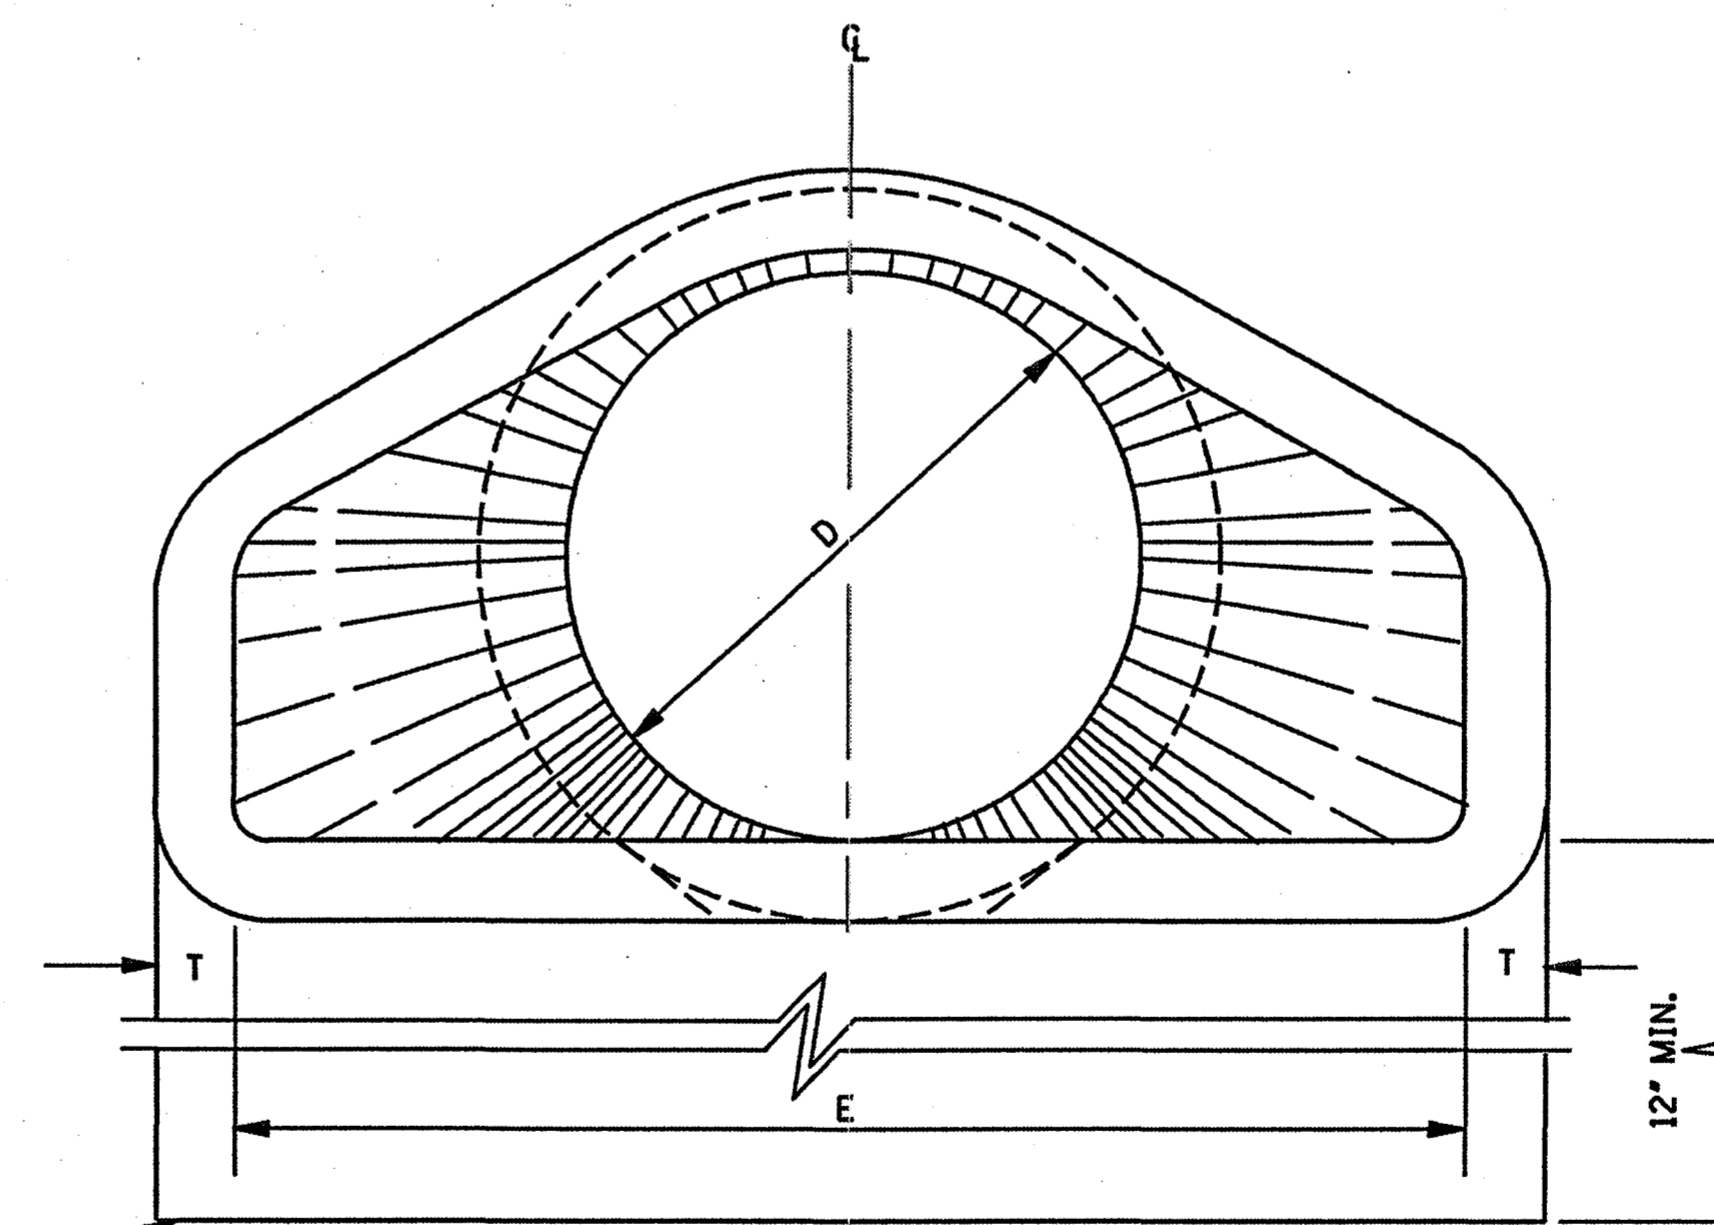

END ELEVATION

TOE WALL REQUIRED ON ALL DOWNSTREAM FLARED END SECTIONS. TOE WALL AT UPSTREAM END WILL BE CONSTRUCTED WHERE DIRECTED BY THE ENGINEER. TO BE PAID FOR AS CLASS "B" STRUCTURAL CONCRETE - MINOR STRUCTURES.

GENERAL NOTES:

1. REINFORCEMENT SHALL CONFORM TO THE REQUIREMENTS OF REINFORCED CONCRETE PIPE OF LIKE DIAMETER PER AASHTO M 170, TABLE 2, WALL B.
2. 2 - 1 1/2" DIA. CAST HOLES REQUIRED AS SHOWN TO ACCOMMODATE 2 - 1" DIA. TIE BOLTS, USED IN TIEING SECTION TO PIPE CULVERT.
3. LENGTH (L) OF A BELL-END OPTION MAY VARY BY A NOMINAL EXTENSION ON THE BELL END.
4. FLARED END SECTIONS ARE NOT TO BE USED INSIDE THE CLEAR ZONE.
5. ALL SIZES OF FLARED END SECTIONS FOR CIRCULAR CONCRETE PIPE MAY BE FURNISHED WITH EITHER BELL AND SPIGOT OR TONGUE AND GROOVE ENDS.


BY		MISSISSIPPI DEPARTMENT OF TRANSPORTATION ROADWAY DESIGN DIVISION STANDARD PLAN	
REVISION		<p align="center"><b>FLARED END SECTION FOR CONCRETE PIPE</b></p> <p align="center">WORKING NUMBER FE-1</p> <p align="center">SHEET NUMBER 328</p>	
DATE			
ISSUE DATE:		OCTOBER 1, 1998	

### BELL AND SPIGOT END OPTION TYPE I


NOTE: BELL-END ON DOWNSTREAM SECTION  
SPIGOT-END ON UPSTREAM SECTION.

FLARED END SECTION FOR CONCRETE ARCH PIPE										
EQUIV. SIZE	R	S	T	H:V	A	B	C	E	L	
18"	13 1/2"	22"	2 1/2"	3:1	7"	2'-3"	3'-9"	3'-0"	6'-0"	
24"	18"	28 1/2"	3"	3:1	8"	3'-3"	2'-9"	4'-0"	6'-0"	
30"	22 1/2"	36 1/4"	3 1/2"	3:1	10"	4'-0"	2'-0"	5'-0"	6'-0"	
36"	26 5/8"	43 3/4"	4"	3:1	10 3/8"	5'-0"	3'-0"	6'-0"	8'-0"	
42"	31 1/8"	51 1/8"	4 1/2"	3:1	1'-3 3/8"	5'-0"	3'-0"	6'-6"	8'-0"	
48"	36"	58 1/2"	5"	3:1	1'-9"	5'-0"	3'-0"	7'-0"	8'-0"	
54"	40"	65"	5 1/2"	3:1	2'-1 1/2"	5'-0"	3'-0"	7'-6"	8'-0"	
60"	45"	73"	6"	3:1	2'-2"	6'-3"	1'-9"	8'-0"	8'-0"	
72"	54"	88"	7"	3:1	2'-11"	6'-6"	1'-10"	10'-0"	8'-4"	

TOE WALL CONC. QUANTITY (yd <sup>3</sup> )
0.063
0.083
0.102
0.123
0.134
0.145
0.156
0.167
0.207

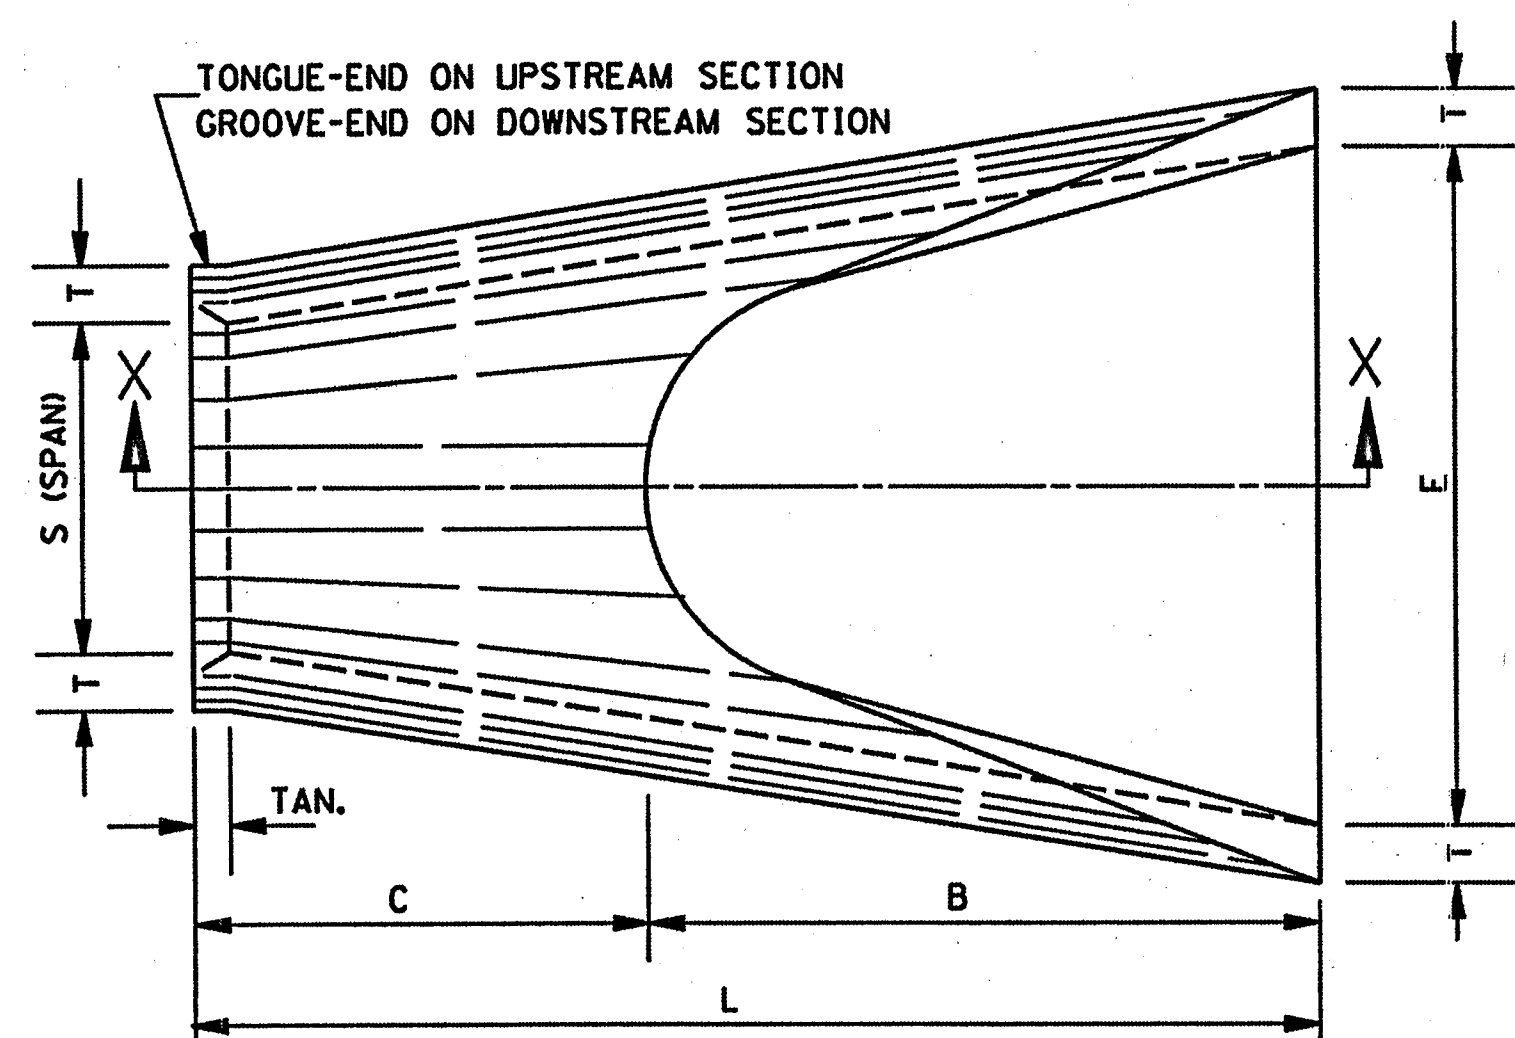

PLAN OF DOWNSTREAM END

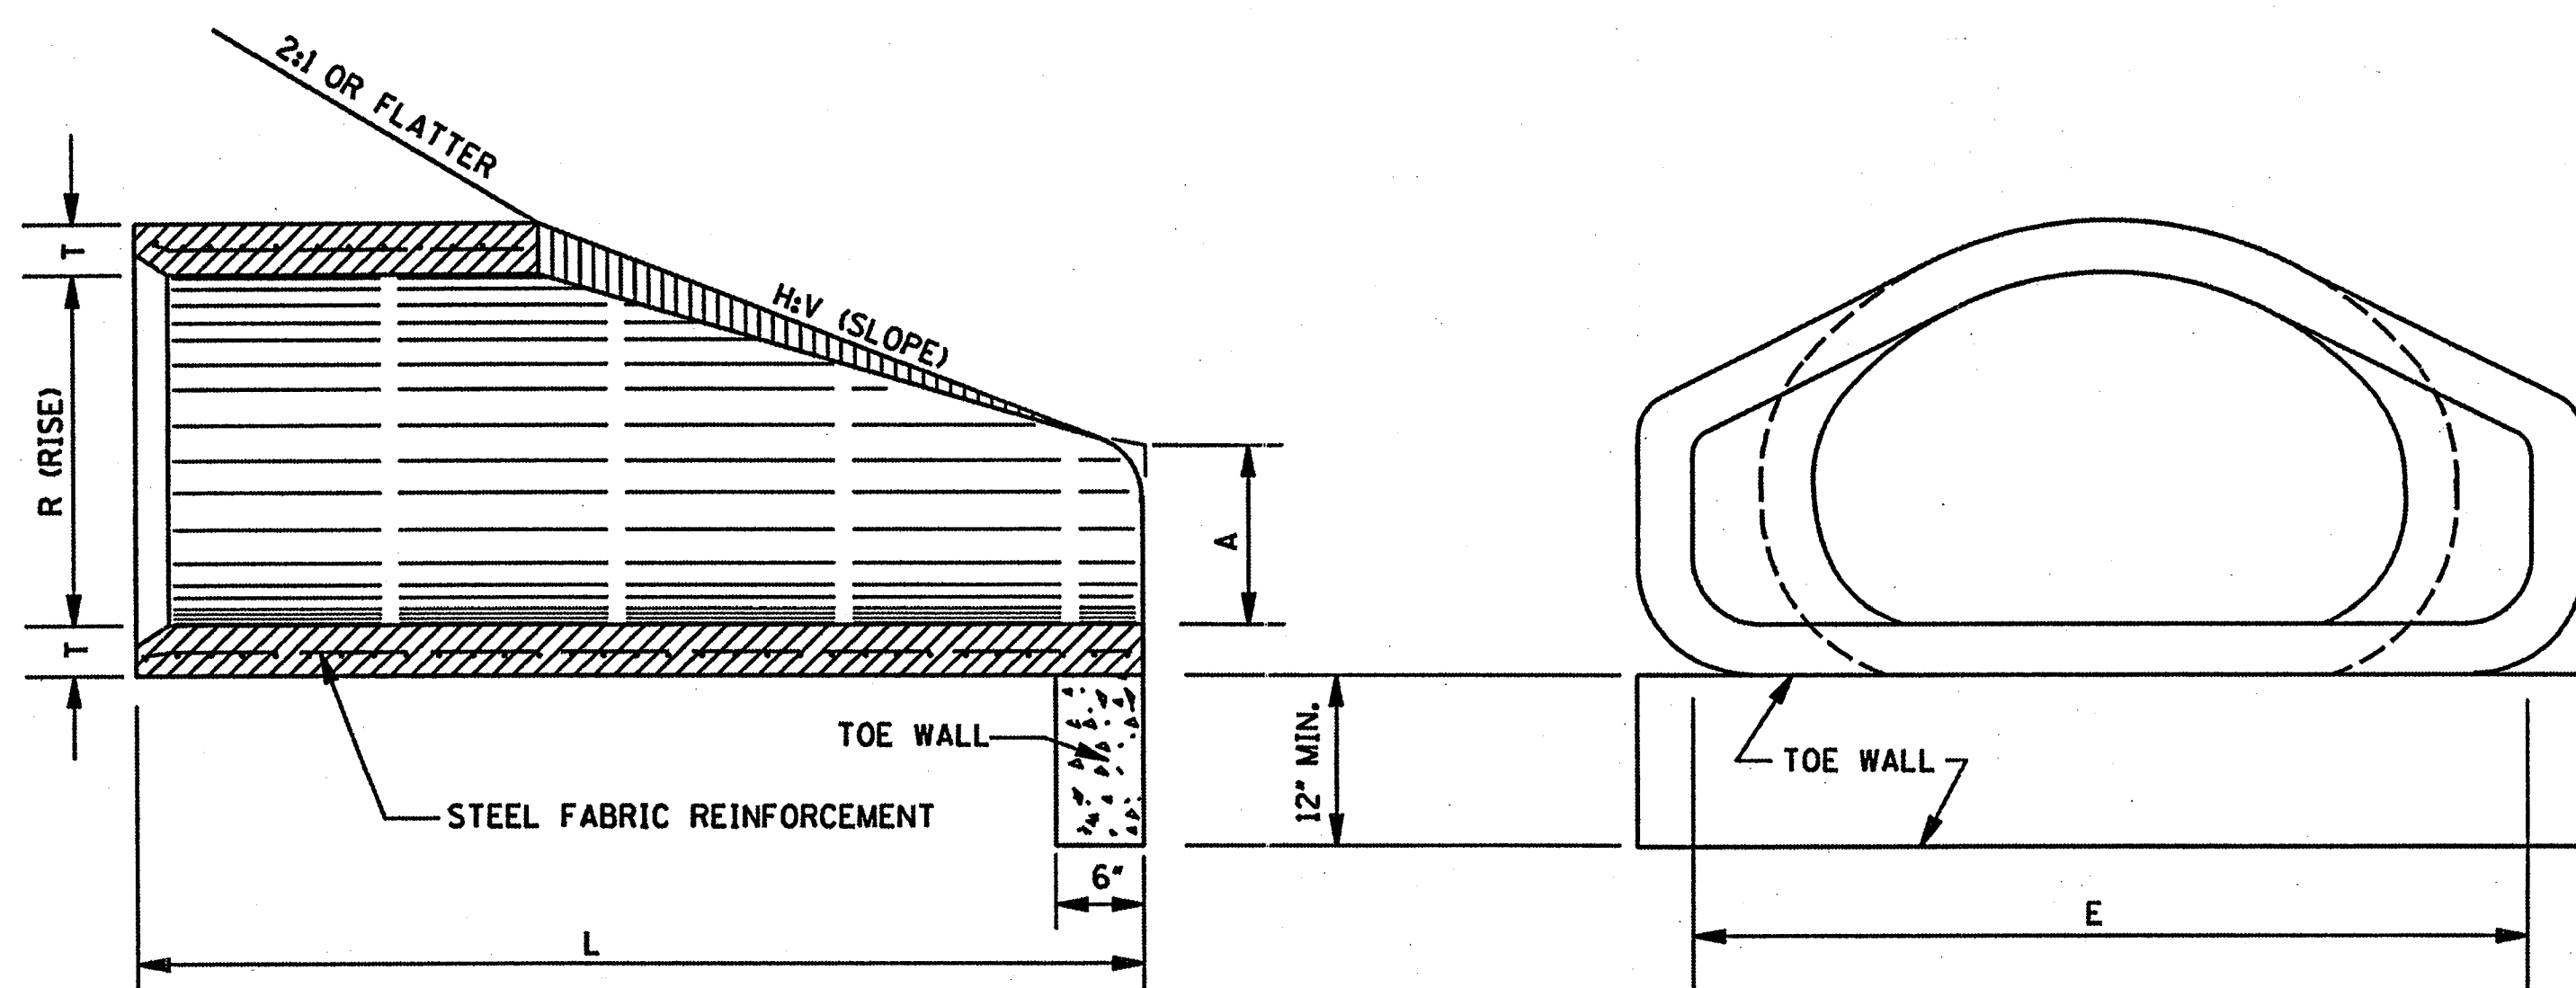

SECTION X-X

FRONT ELEVATION

**GENERAL NOTES:**

1. FLARED END SECTIONS ARE NOT TO BE USED INSIDE THE CLEAR ZONE.
2. UNLESS OTHERWISE DESIGNATED, EITHER TYPE I OR TYPE II MAY BE USED, PROVIDED THE SELECTED TYPE IS COMPATIBLE WITH THE CONFIGURATION OF THE PIPE TO WHICH IT IS TO BE ATTACHED.
3. ALL SIZES OF TYPE I AND TYPE II FLARED END SECTIONS FOR CONCRETE ARCH PIPE MAY BE FURNISHED WITH EITHER BELL AND SPIGOT OR TONGUE AND GROOVE ENDS.

4. REINFORCEMENT (SINGLE LINE) FOR FLARED END SECTION SHALL CONFORM TO REQUIREMENTS OF AASHTO M 206 FOR CLASS II ARCH PIPE.
5. TOE WALL REQUIRED ON ALL DOWNSTREAM FLARED END SECTIONS. TOE WALL AT UPSTREAM END WILL BE CONSTRUCTED WHERE DIRECTED BY THE ENGINEER. TO BE PAID FOR AS CLASS "B" STRUCTURAL CONCRETE-MINOR STRUCTURES.
6. FLARED END SECTIONS MUST MEET THE REQUIREMENTS FOR ARCH PIPE OF EITHER AASHTO M 206 OR ASTM C 506.


### BELL AND SPIGOT END OPTION TYPE II

NOTE: BELL-END ON DOWNSTREAM SECTION  
SPIGOT-END ON UPSTREAM SECTION.


FLARED END SECTION FOR CONC. ARCH PIPE-SHORT FLARE											
EQUIV. SIZE	R	S	T	H:V	A	B	C	E	L	GROOVE TONGUE	
18"	13 1/2"	22"	2 1/2"	3:1	7"	2'-3"	3'-9"	3'-0"	6'-0"	2 1/4"	
24"	18"	28 1/2"	3"	3:1	8"	3'-3"	2'-9"	4'-0"	6'-0"	3"	
30"	22 1/2"	36 1/4"	3 1/2"	3:1	10"	4'-0"	2'-0"	5'-0"	6'-0"	3 1/2"	
36"	26 5/8"	43 3/4"	4"	3:1	10 3/8"	5'-0"	3'-0"	6'-0"	8'-0"	4"	
42"	31 1/8"	51 1/8"	4 1/2"	3:1	1'-4 3/8"	5'-0"	3'-0"	6'-6"	8'-0"	4"	
48"	36"	58 1/2"	5"	3:1	1'-10"	5'-0"	3'-0"	7'-0"	8'-0"	5"	
54"	40"	65"	5 1/2"	3:1	2'-3"	5'-0"	3'-0"	7'-6"	8'-0"	5"	
60"	45"	73"	6"	3:1	2'-9"	5'-0"	3'-0"	8'-0"	8'-0"	5"	

TOE WALL CONC. QUANTITY (yd <sup>3</sup> )
0.063
0.083
0.102
0.123
0.134
0.145
0.156
0.167

NOTES: #1. EQUIVALENT 18" FLARED END SECTION SIMILAR TO TYPE I.  
2. DIMENSIONS A, B, C, E AND L MAY VARY 1"±.

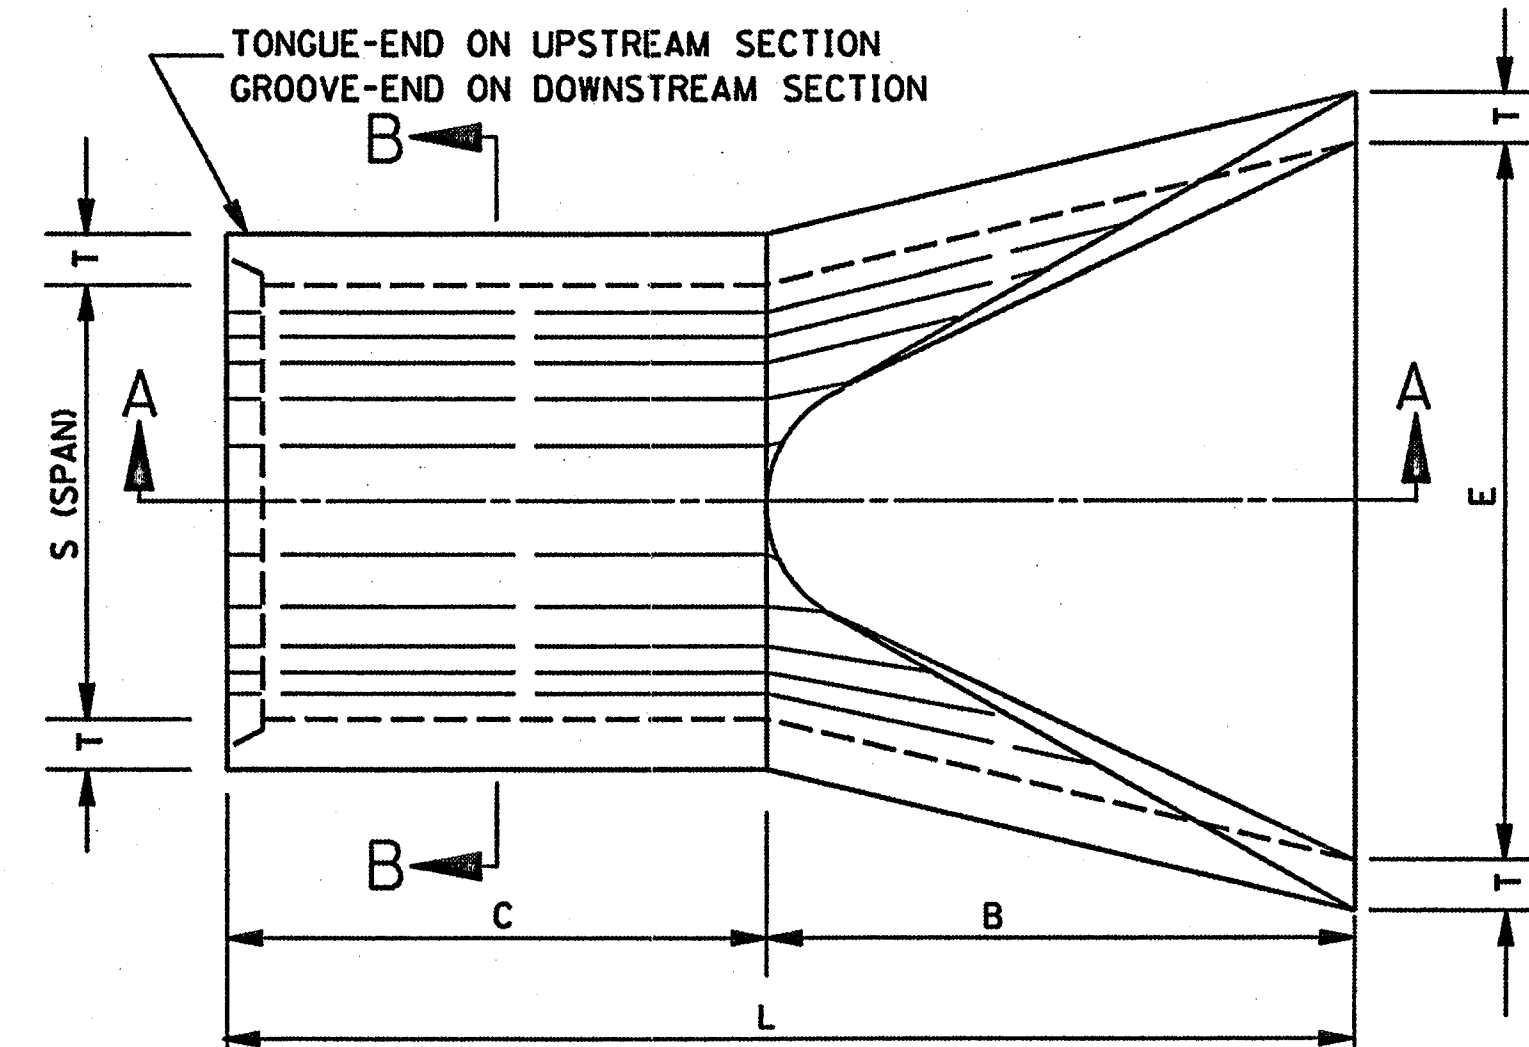

PLAN OF DOWNSTREAM END

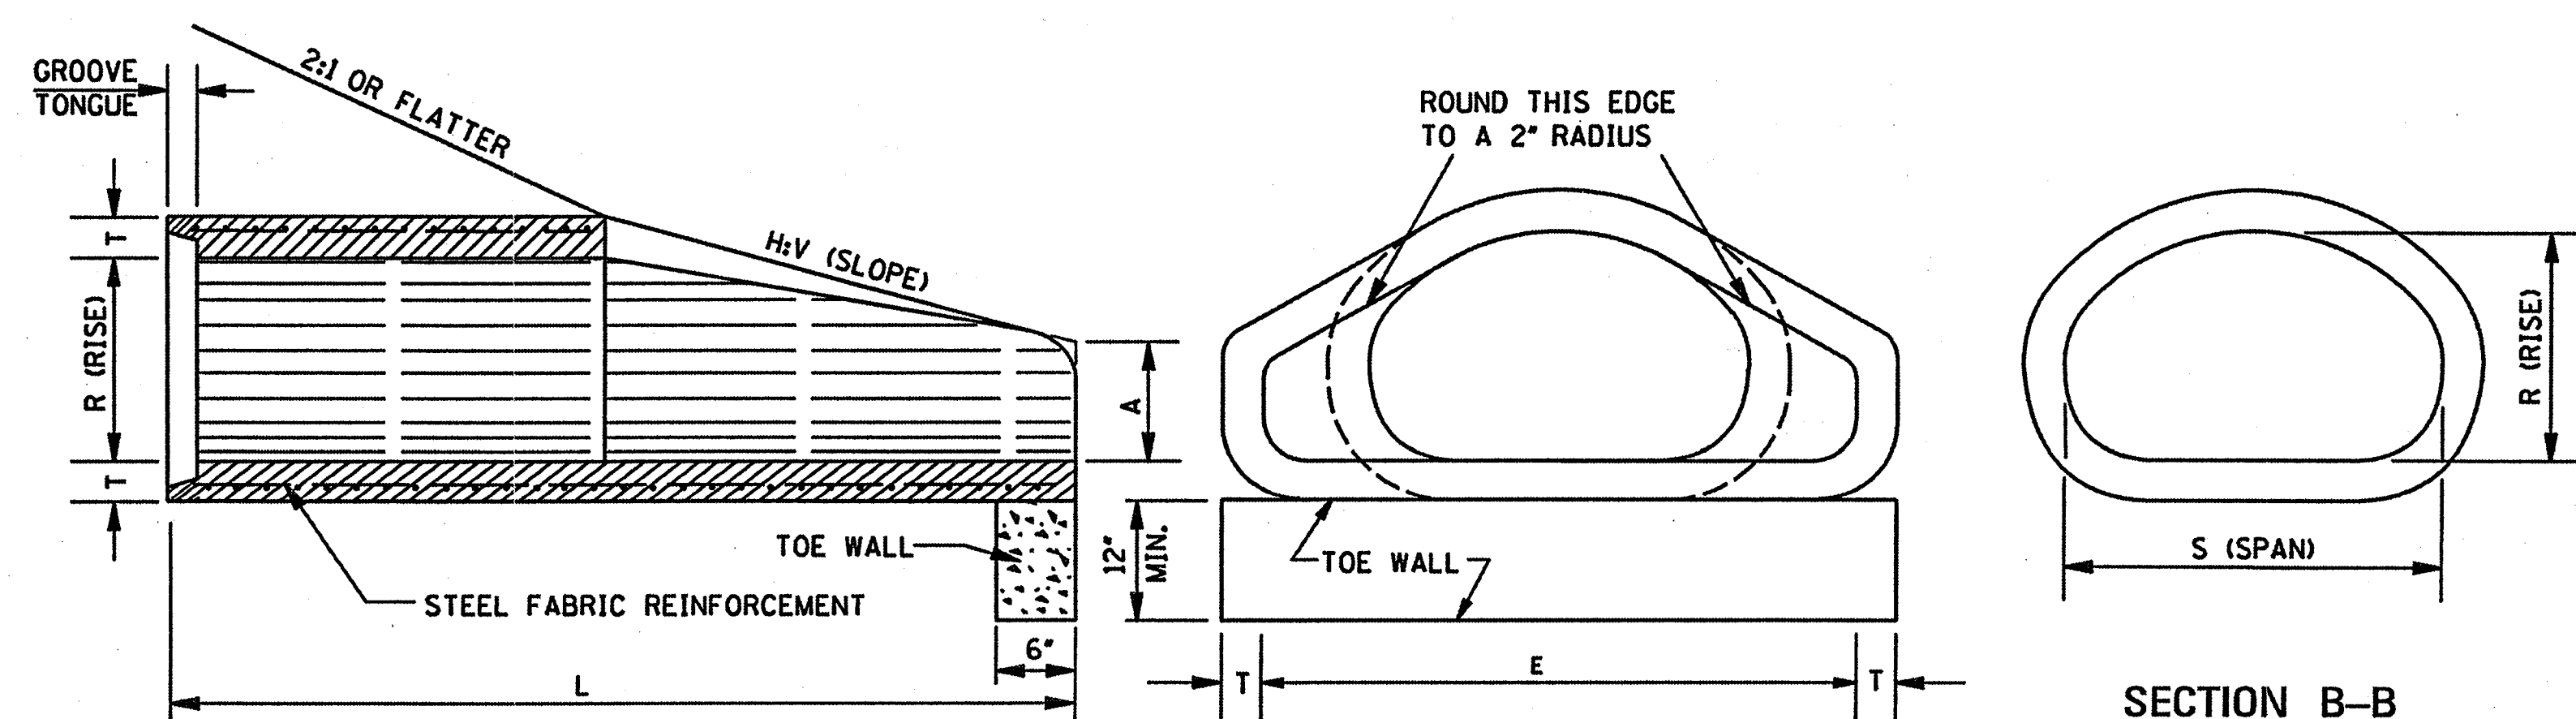


SECTION A-A

FRONT ELEVATION

SECTION B-B

MISSISSIPPI DEPARTMENT OF TRANSPORTATION  
ROADWAY DESIGN DIVISION  
STANDARD PLAN

### FLARED END SECTION FOR CONCRETE ARCH PIPE

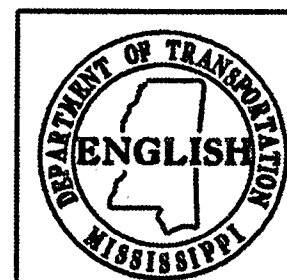

WORKING NUMBER  
FE-1A

SHEET NUMBER  
329

ISSUE DATE: OCTOBER 1, 1998