

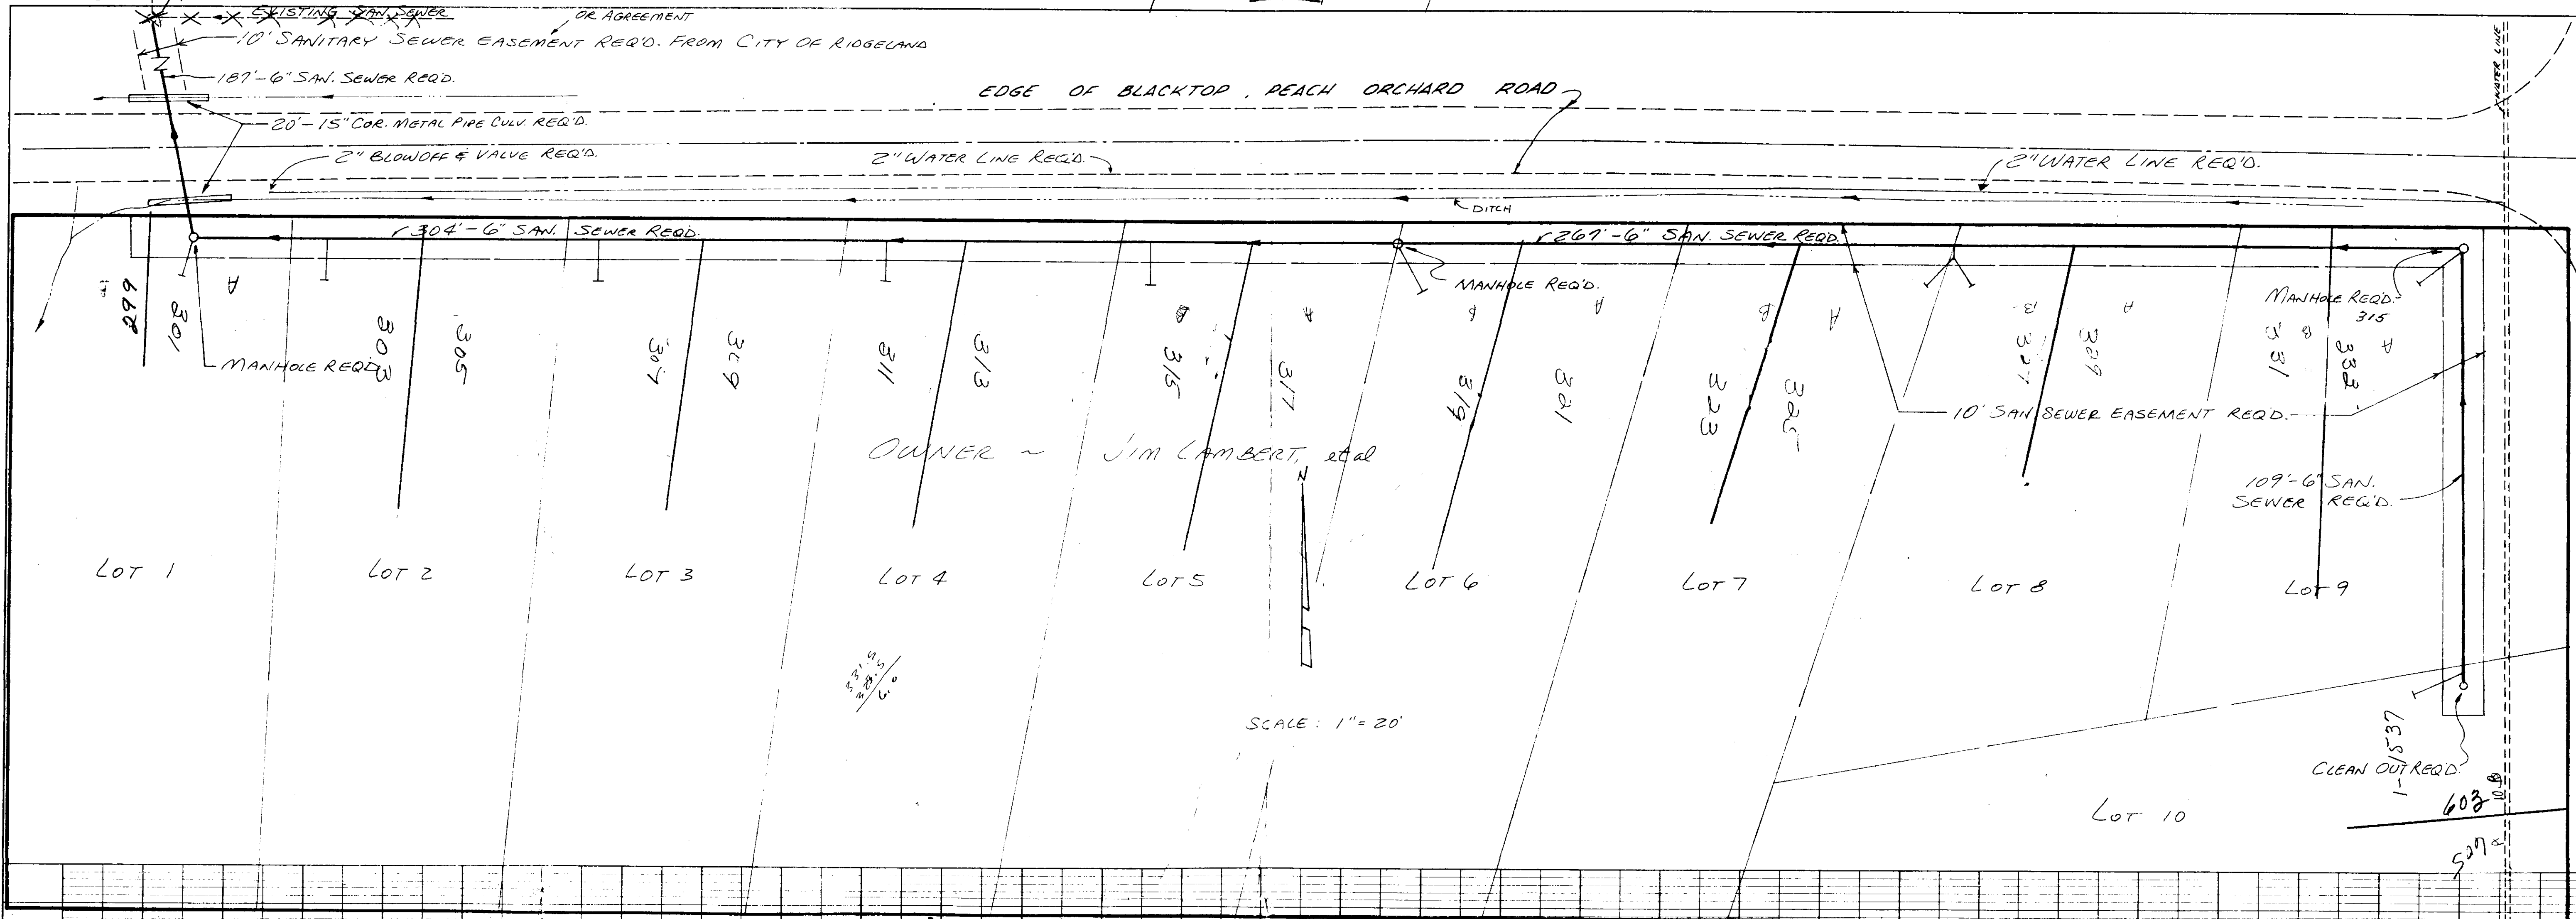


DATE	
BY	
REVISIONS	
NO.	
DESCRIPTION	
DATE	
BY	
NO.	
DESCRIPTION	
DATE	
BY	
REVISIONS	
NO.	
DESCRIPTION	
DATE	
BY	
NO.	
DESCRIPTION	
DATE	
BY	
NO.	
DESCRIPTION	
DATE	
BY	
NO.	
DESCRIPTION	
DATE	
BY	
NO.	
DESCRIPTION	

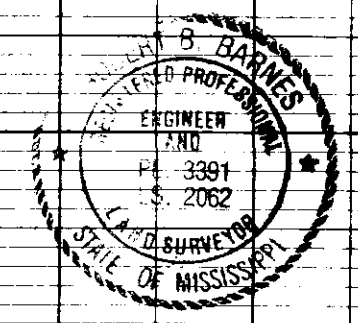

SCALE: 1" = 20'

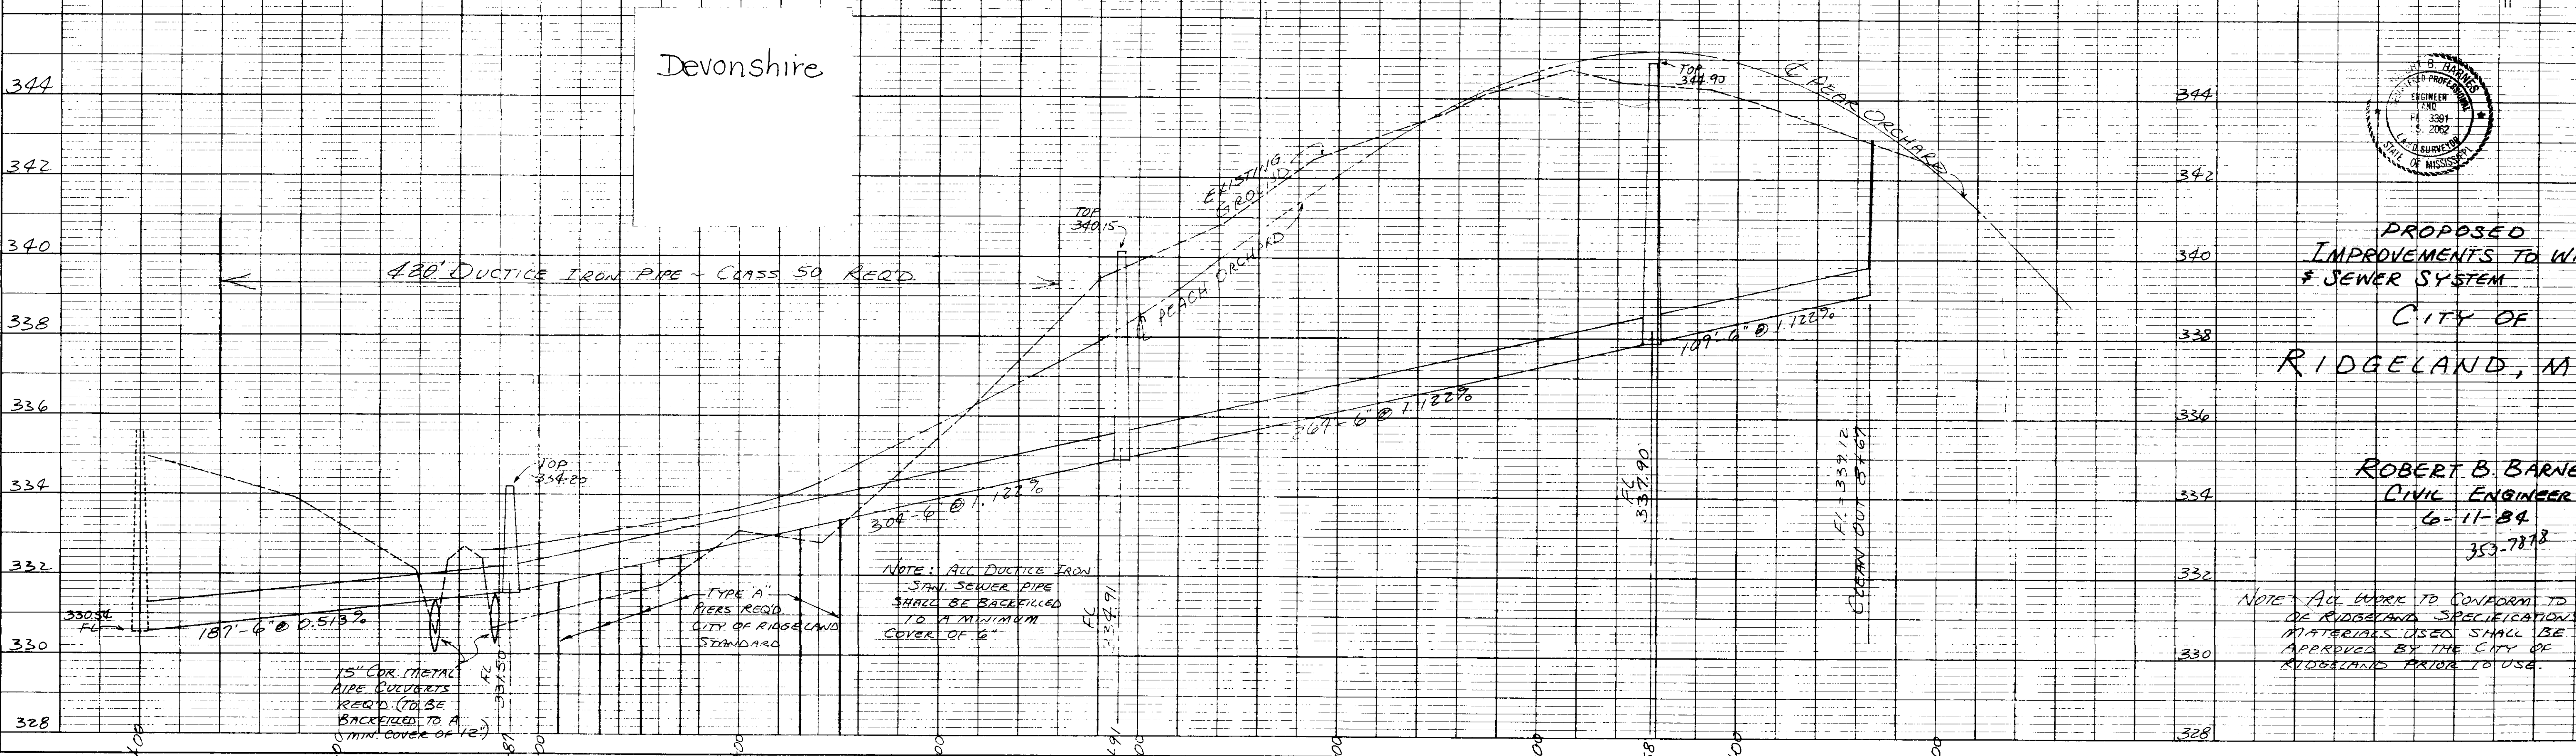

PROPOSED
IMPROVEMENTS TO WATER
& SEWER SYSTEM
CITY OF
RIDGELAND, MISS.

ROBERT B. BARNES
CIVIL ENGINEER
6-11-84
353-7878

NOTE: ALL WORK TO CONFORM TO CITY
OF RIDGELAND SPECIFICATIONS. ALL
MATERIALS USED SHALL BE
APPROVED BY THE CITY OF
RIDGELAND PRIOR TO USE.

PLATE 1 PLAN PROFILE O. P. R. & S. E. STANDARD
100% MAG AEROPROOF VULCAN—MADE AND PRINTED IN U. S. A.
EUGENE DIETZGEN CO.

PWP-00422