


EASTWOOD SUBDIVISION

RIDGELAND, MISSISSIPPI

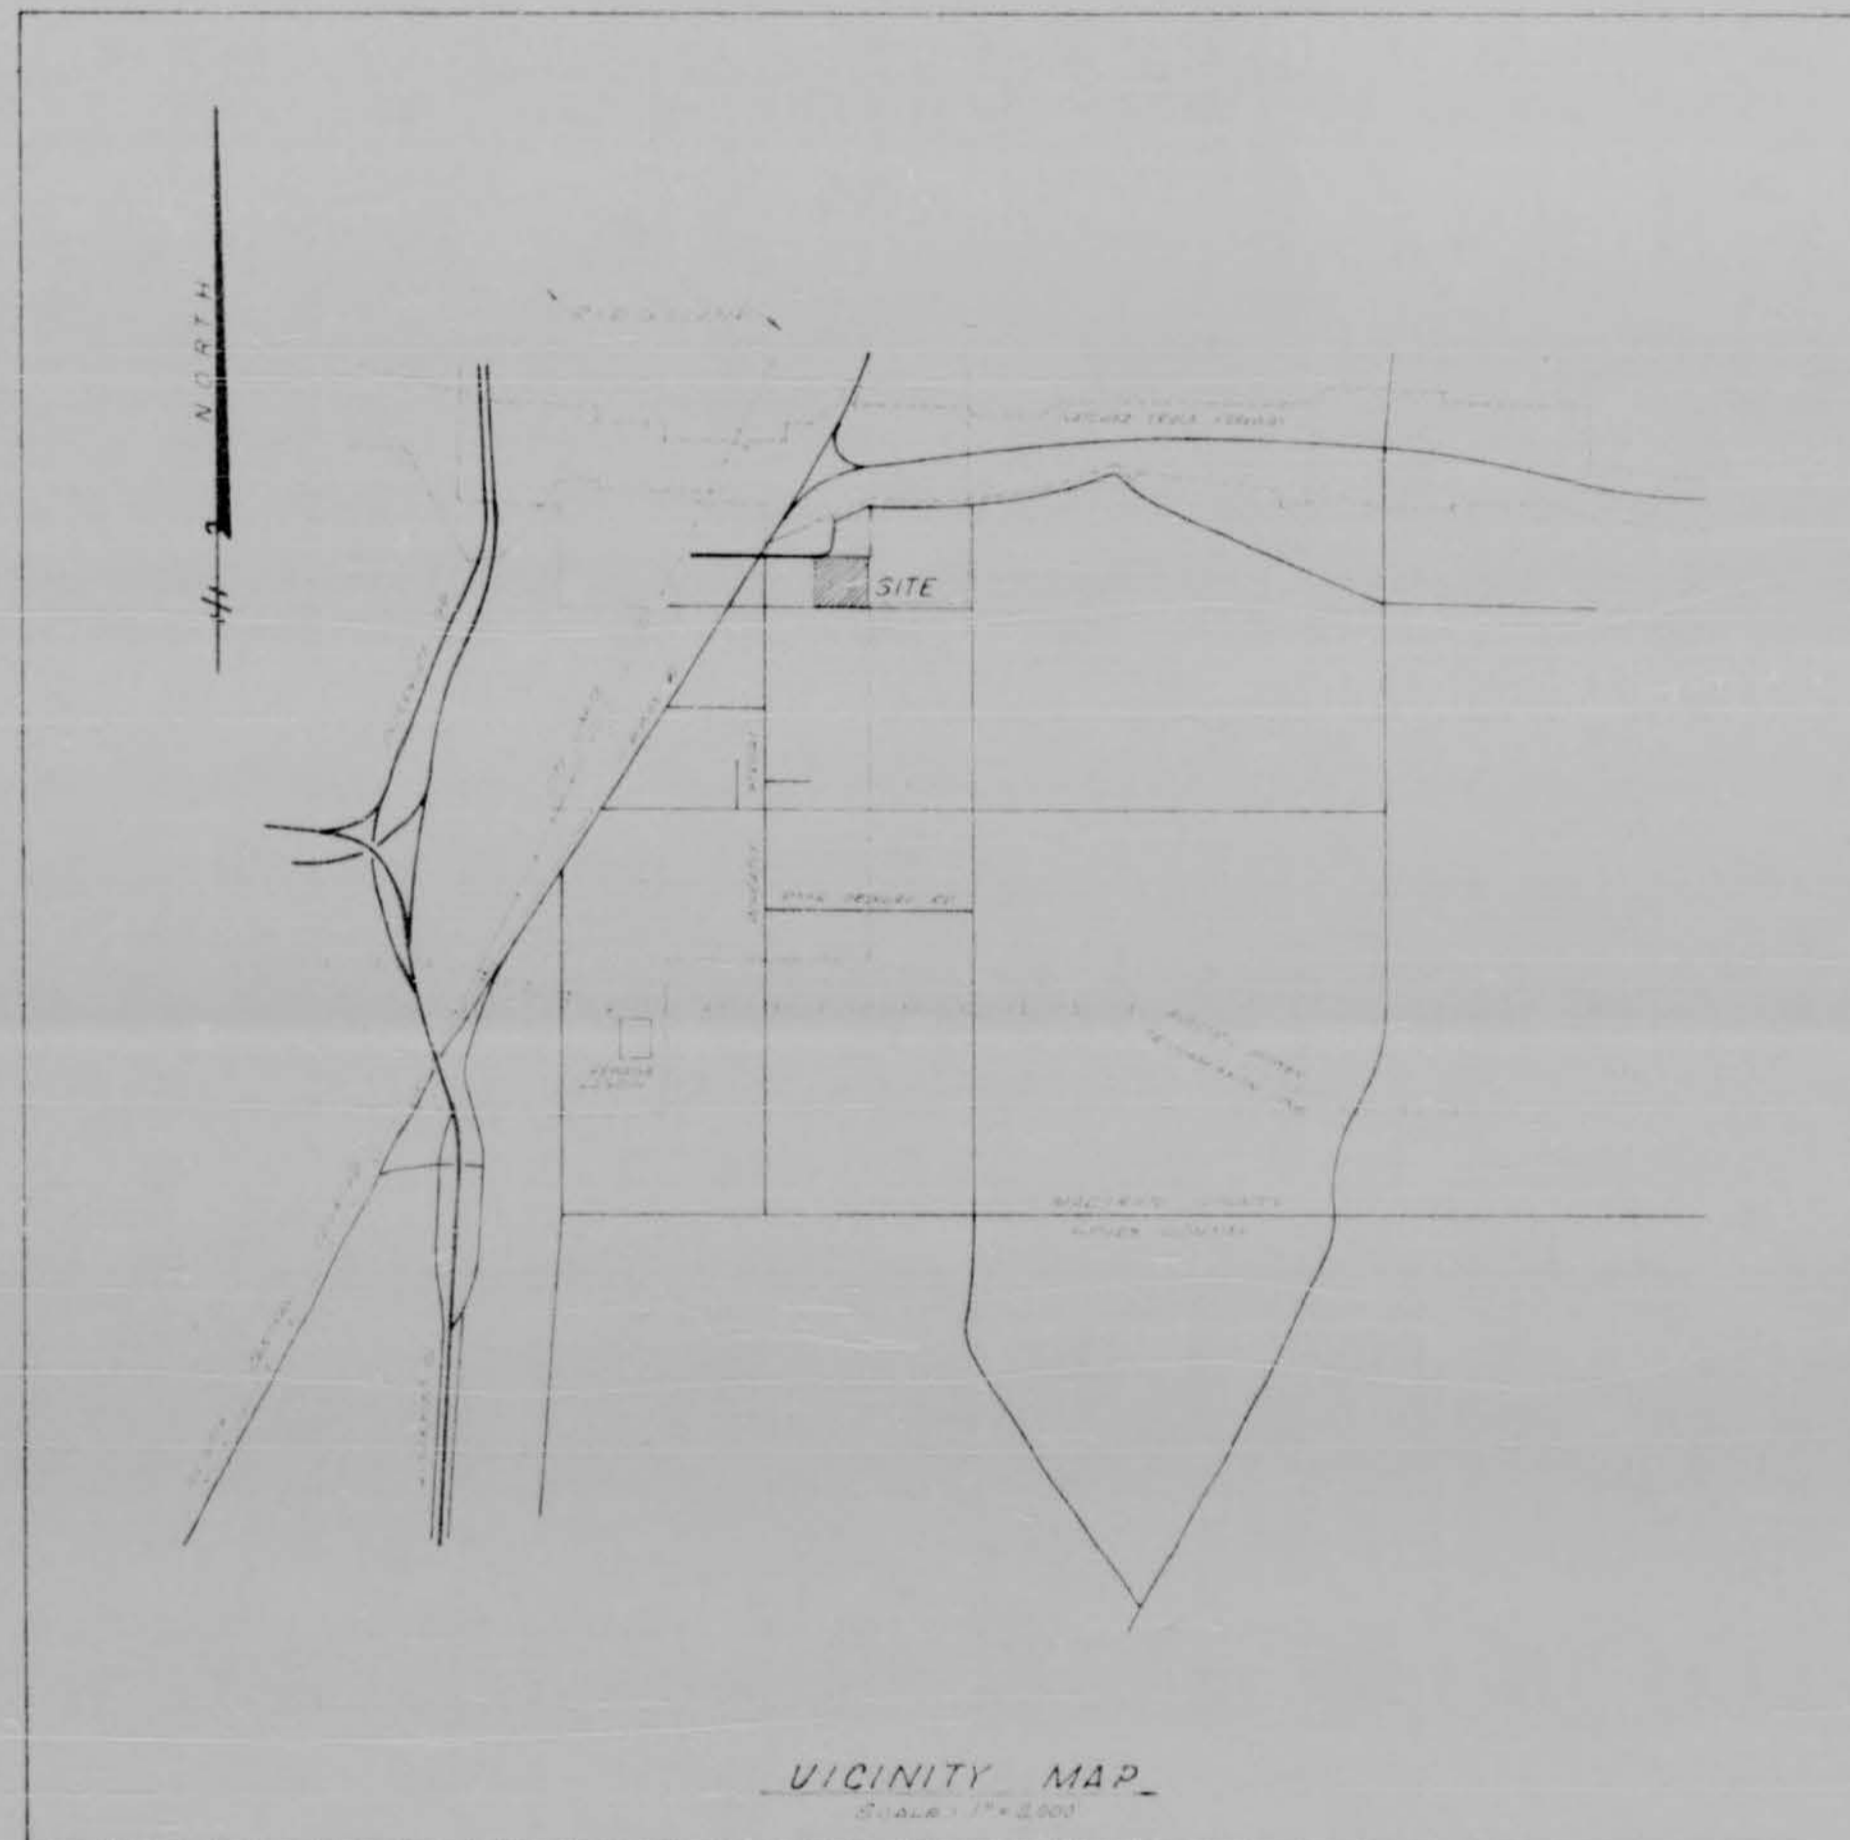

CITY BUILDERS INC. DEVELOPER
JOHNNY THORNTON, JR. PRESIDENT

MITCHELL ASSOCIATES
CONSULTING ENGINEERS
JACKSON, MISSISSIPPI




APPROVED 10-4-71
FOR SANITARY DESIGN ONLY
H. W. Benfield
Mississippi State Board of Architects, Engineers, and Surveyors

1501

DATE	
BY	
PROJECT	
DATE REVISION	
BY	
DESCRIPTION	
NO.	


DATE	
BY	
PROJECT	
DATE REVISION	
BY	
DESCRIPTION	
NO.	

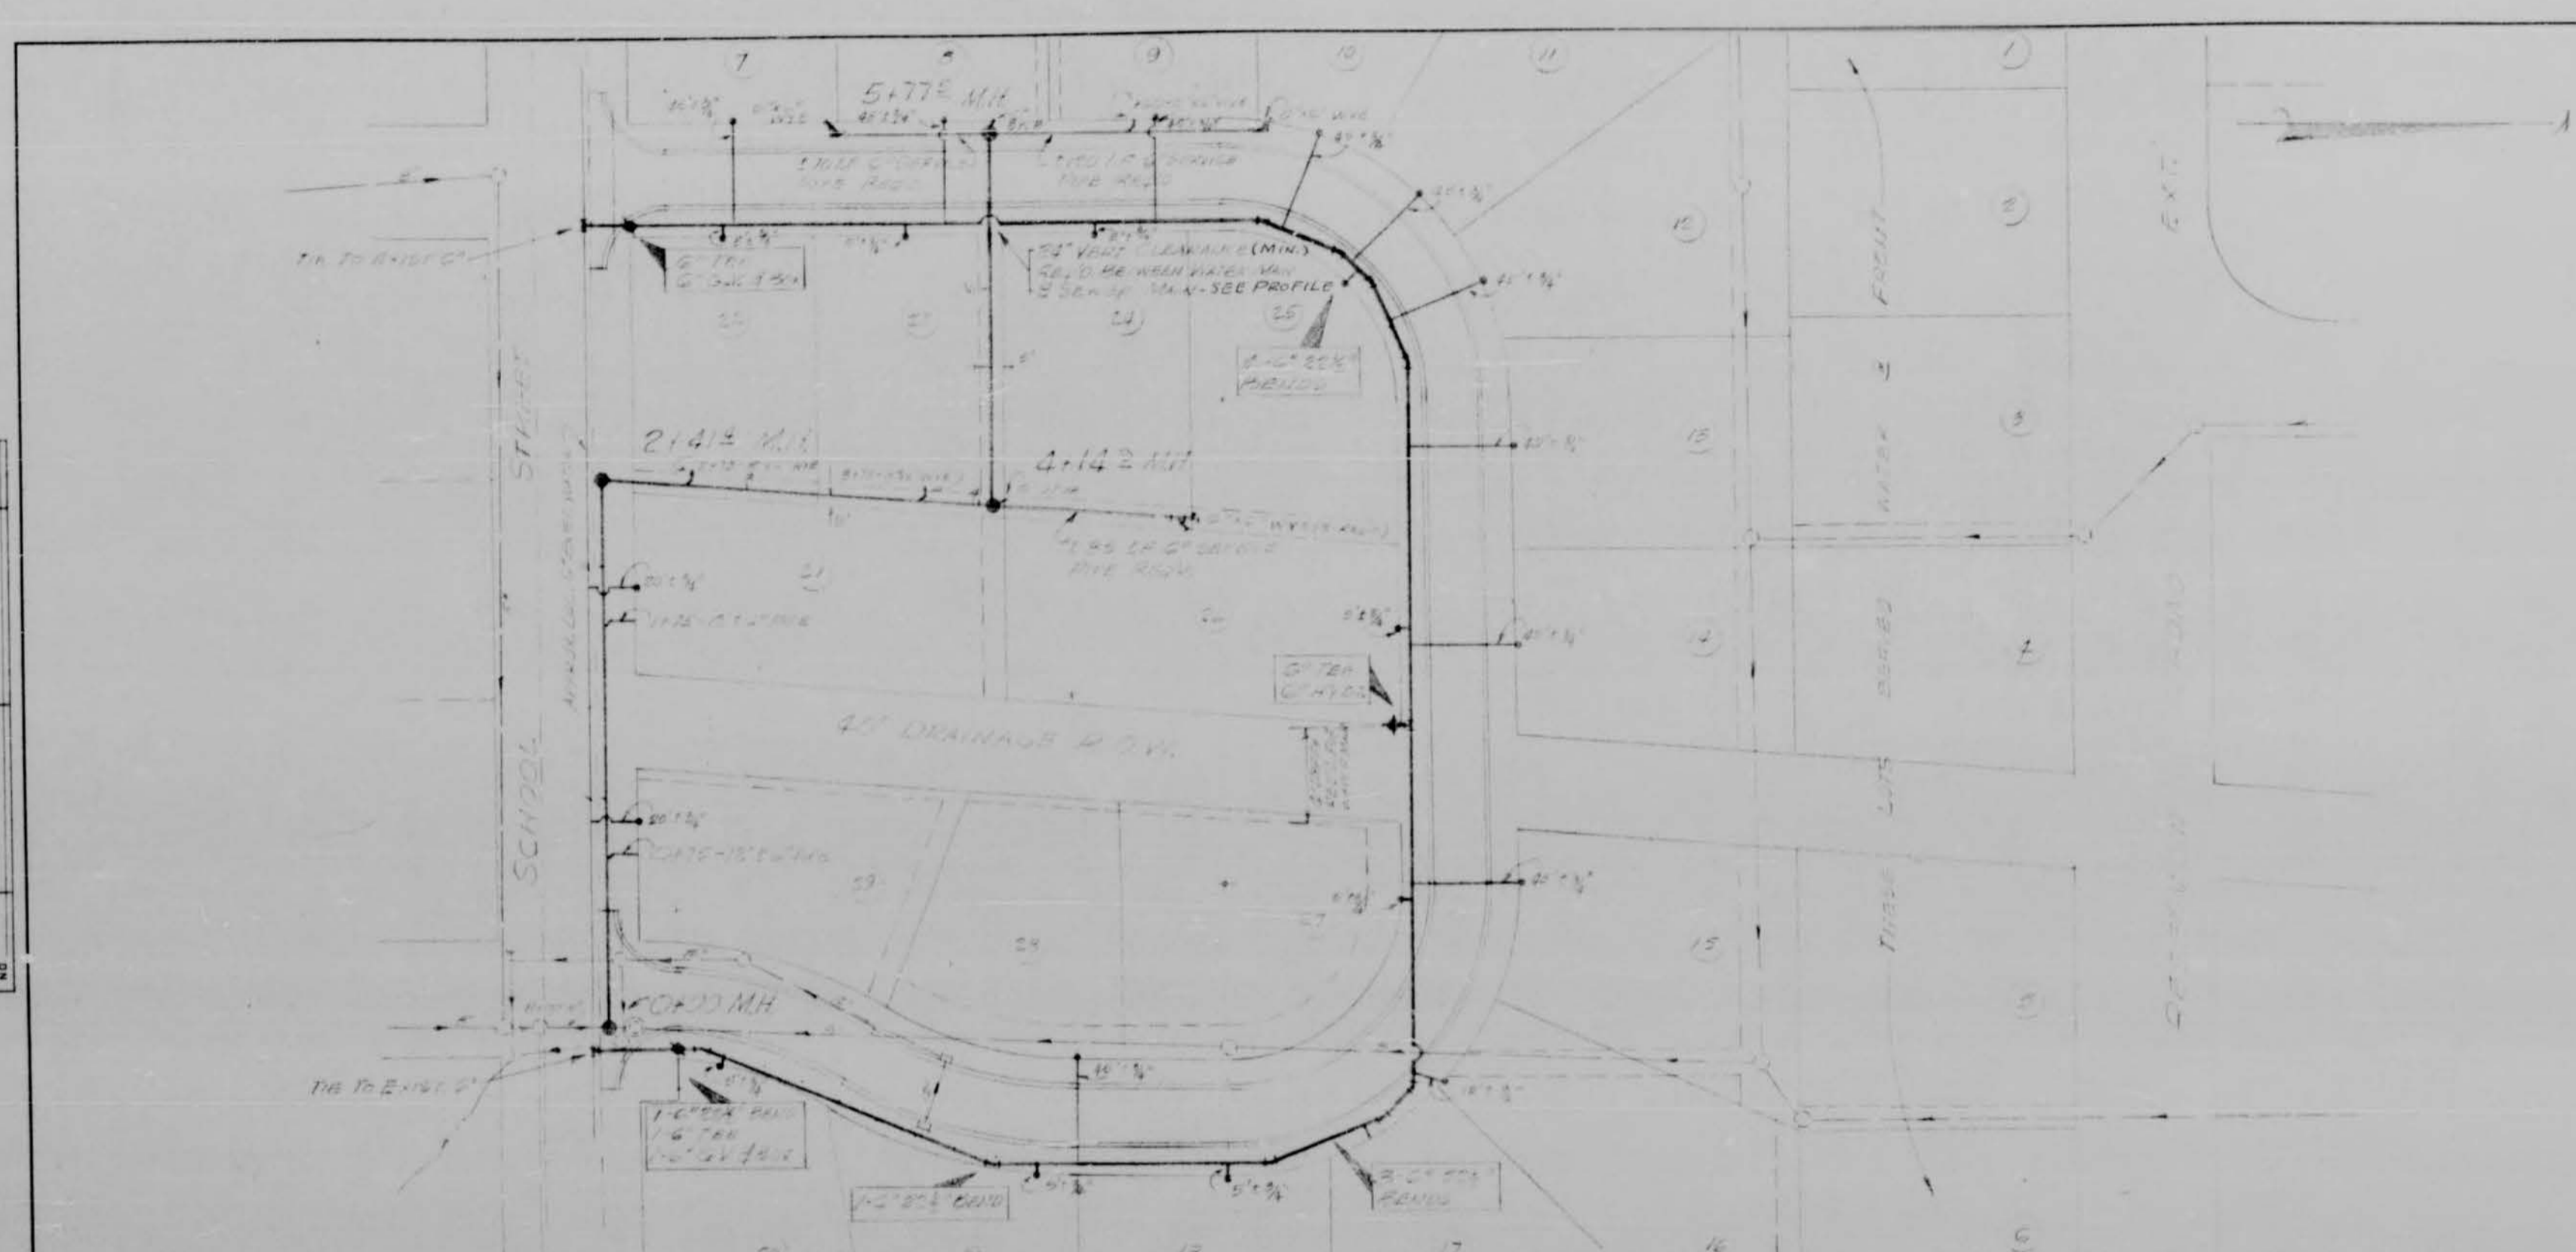

- GENERAL NOTES & SPECIFICATIONS**
1. THE CONTRACTOR SHALL BE RESPONSIBLE FOR OBTAINING ALL NECESSARY PERMITS FROM THE CITY OF CHICAGO AND THE STATE OF ILLINOIS.
 2. ALL WORK SHALL BE DONE IN ACCORDANCE WITH THE CITY OF CHICAGO SPECIFICATIONS FOR SEWERAGE AND SANITATION.
 3. THE CONTRACTOR SHALL MAINTAIN ACCESS TO ALL ADJACENT PROPERTIES AT ALL TIMES.
 4. ALL MATERIALS SHALL BE OF THE BEST QUALITY AND SHALL BE SUBJECT TO INSPECTION BY THE CITY ENGINEER.
 5. THE CONTRACTOR SHALL BE RESPONSIBLE FOR PROTECTING ALL EXISTING UTILITIES AND STRUCTURES.
 6. ALL WORK SHALL BE COMPLETED WITHIN THE SPECIFIED TIME FRAME.
 7. THE CONTRACTOR SHALL MAINTAIN A RECORD OF ALL WORK DONE AND SHALL SUBMIT THE SAME TO THE CITY ENGINEER UPON COMPLETION.
 8. THE CONTRACTOR SHALL BE RESPONSIBLE FOR OBTAINING ALL NECESSARY PERMITS FROM THE CITY OF CHICAGO AND THE STATE OF ILLINOIS.
 9. ALL WORK SHALL BE DONE IN ACCORDANCE WITH THE CITY OF CHICAGO SPECIFICATIONS FOR SEWERAGE AND SANITATION.
 10. THE CONTRACTOR SHALL MAINTAIN ACCESS TO ALL ADJACENT PROPERTIES AT ALL TIMES.
 11. ALL MATERIALS SHALL BE OF THE BEST QUALITY AND SHALL BE SUBJECT TO INSPECTION BY THE CITY ENGINEER.
 12. THE CONTRACTOR SHALL BE RESPONSIBLE FOR PROTECTING ALL EXISTING UTILITIES AND STRUCTURES.
 13. ALL WORK SHALL BE COMPLETED WITHIN THE SPECIFIED TIME FRAME.
 14. THE CONTRACTOR SHALL MAINTAIN A RECORD OF ALL WORK DONE AND SHALL SUBMIT THE SAME TO THE CITY ENGINEER UPON COMPLETION.

NOTICE

THIS DRAWING IS THE PROPERTY OF THE ENGINEER AND ARCHITECT. IT IS TO BE USED ONLY FOR THE PROJECT AND SITE SPECIFICALLY IDENTIFIED HEREON. ANY REUSE OR MODIFICATION OF THIS DRAWING WITHOUT THE WRITTEN CONSENT OF THE ENGINEER AND ARCHITECT IS STRICTLY PROHIBITED.

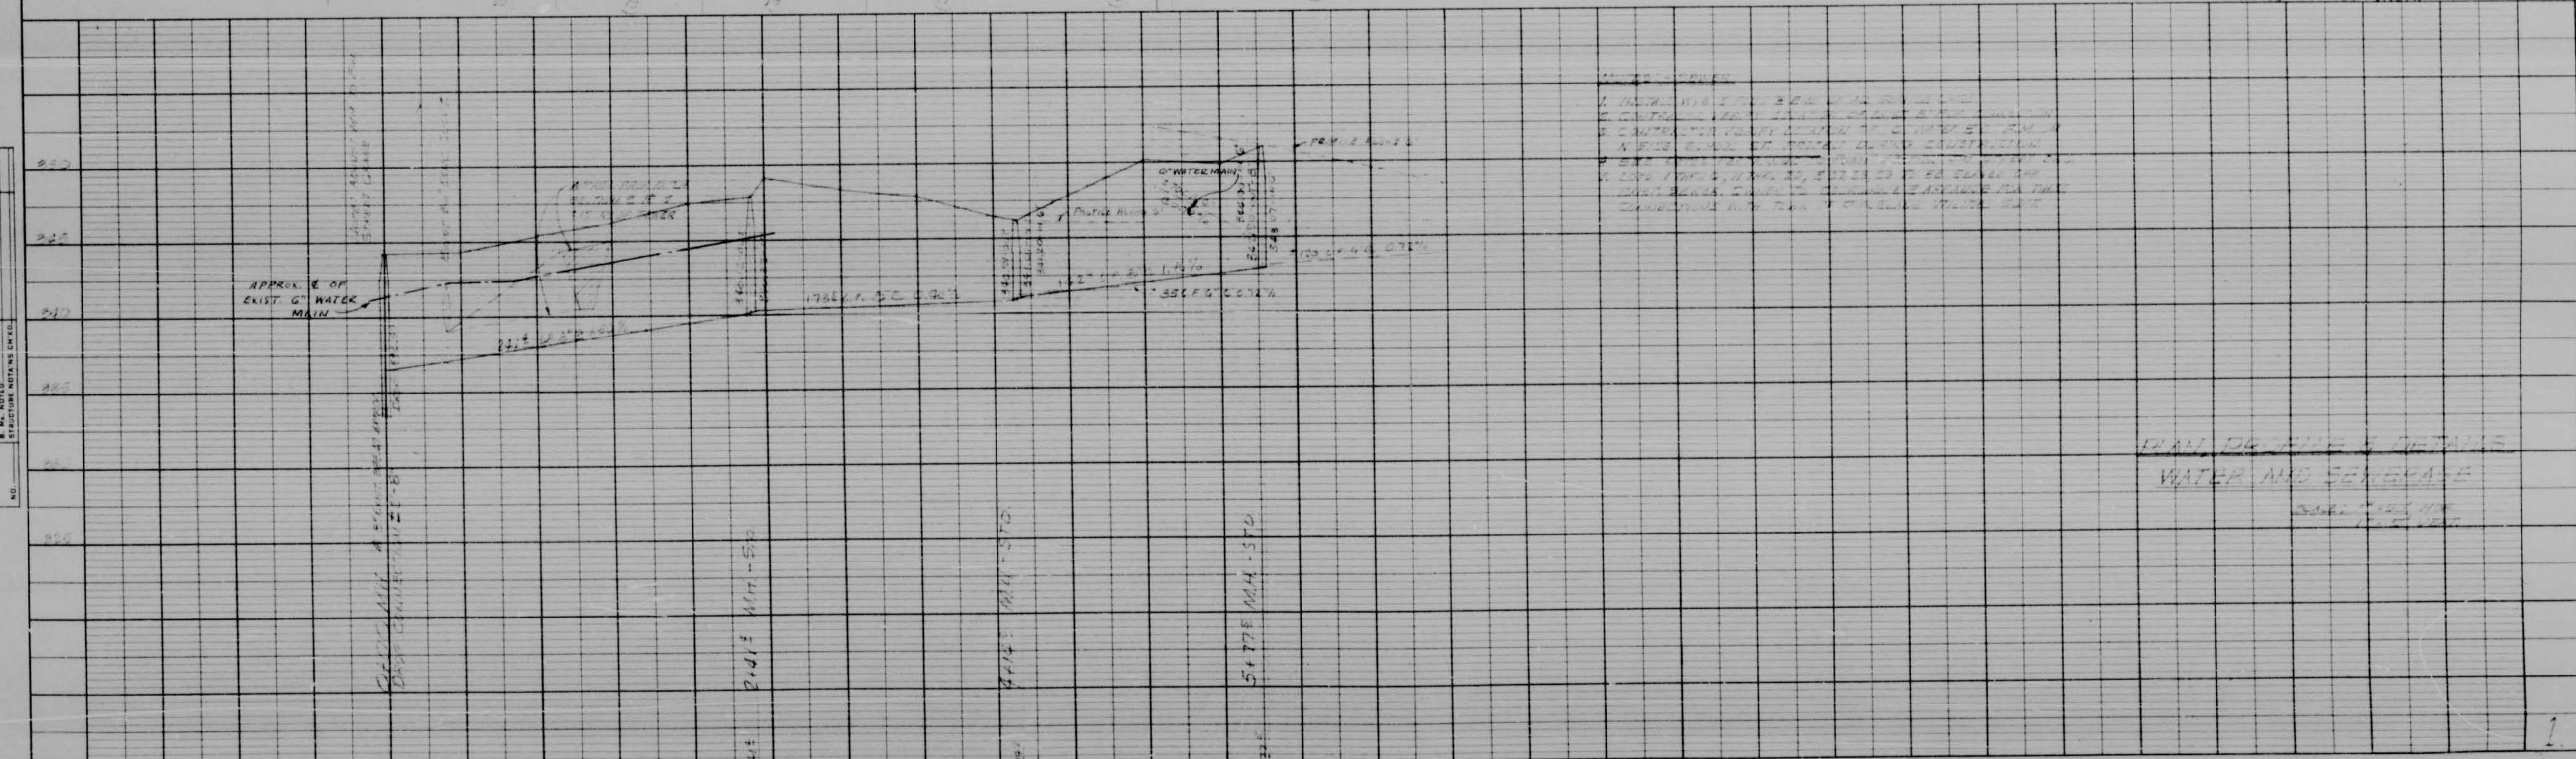

PLAN, PROFILE & DETAILS

WATER AND SEWERAGE

SCALE: 1" = 40'

