


# CITY OF RIDGELAND, MISSISSIPPI EAST SCHOOL STREET AND WHEATLEY STREET RECONSTRUCTION



*Mayor:*  
*Gene F. McGee*

*Mayor Pro Tem:*  
*Chuck Kobert*

*City Attorney:*  
*Jerry Mills*

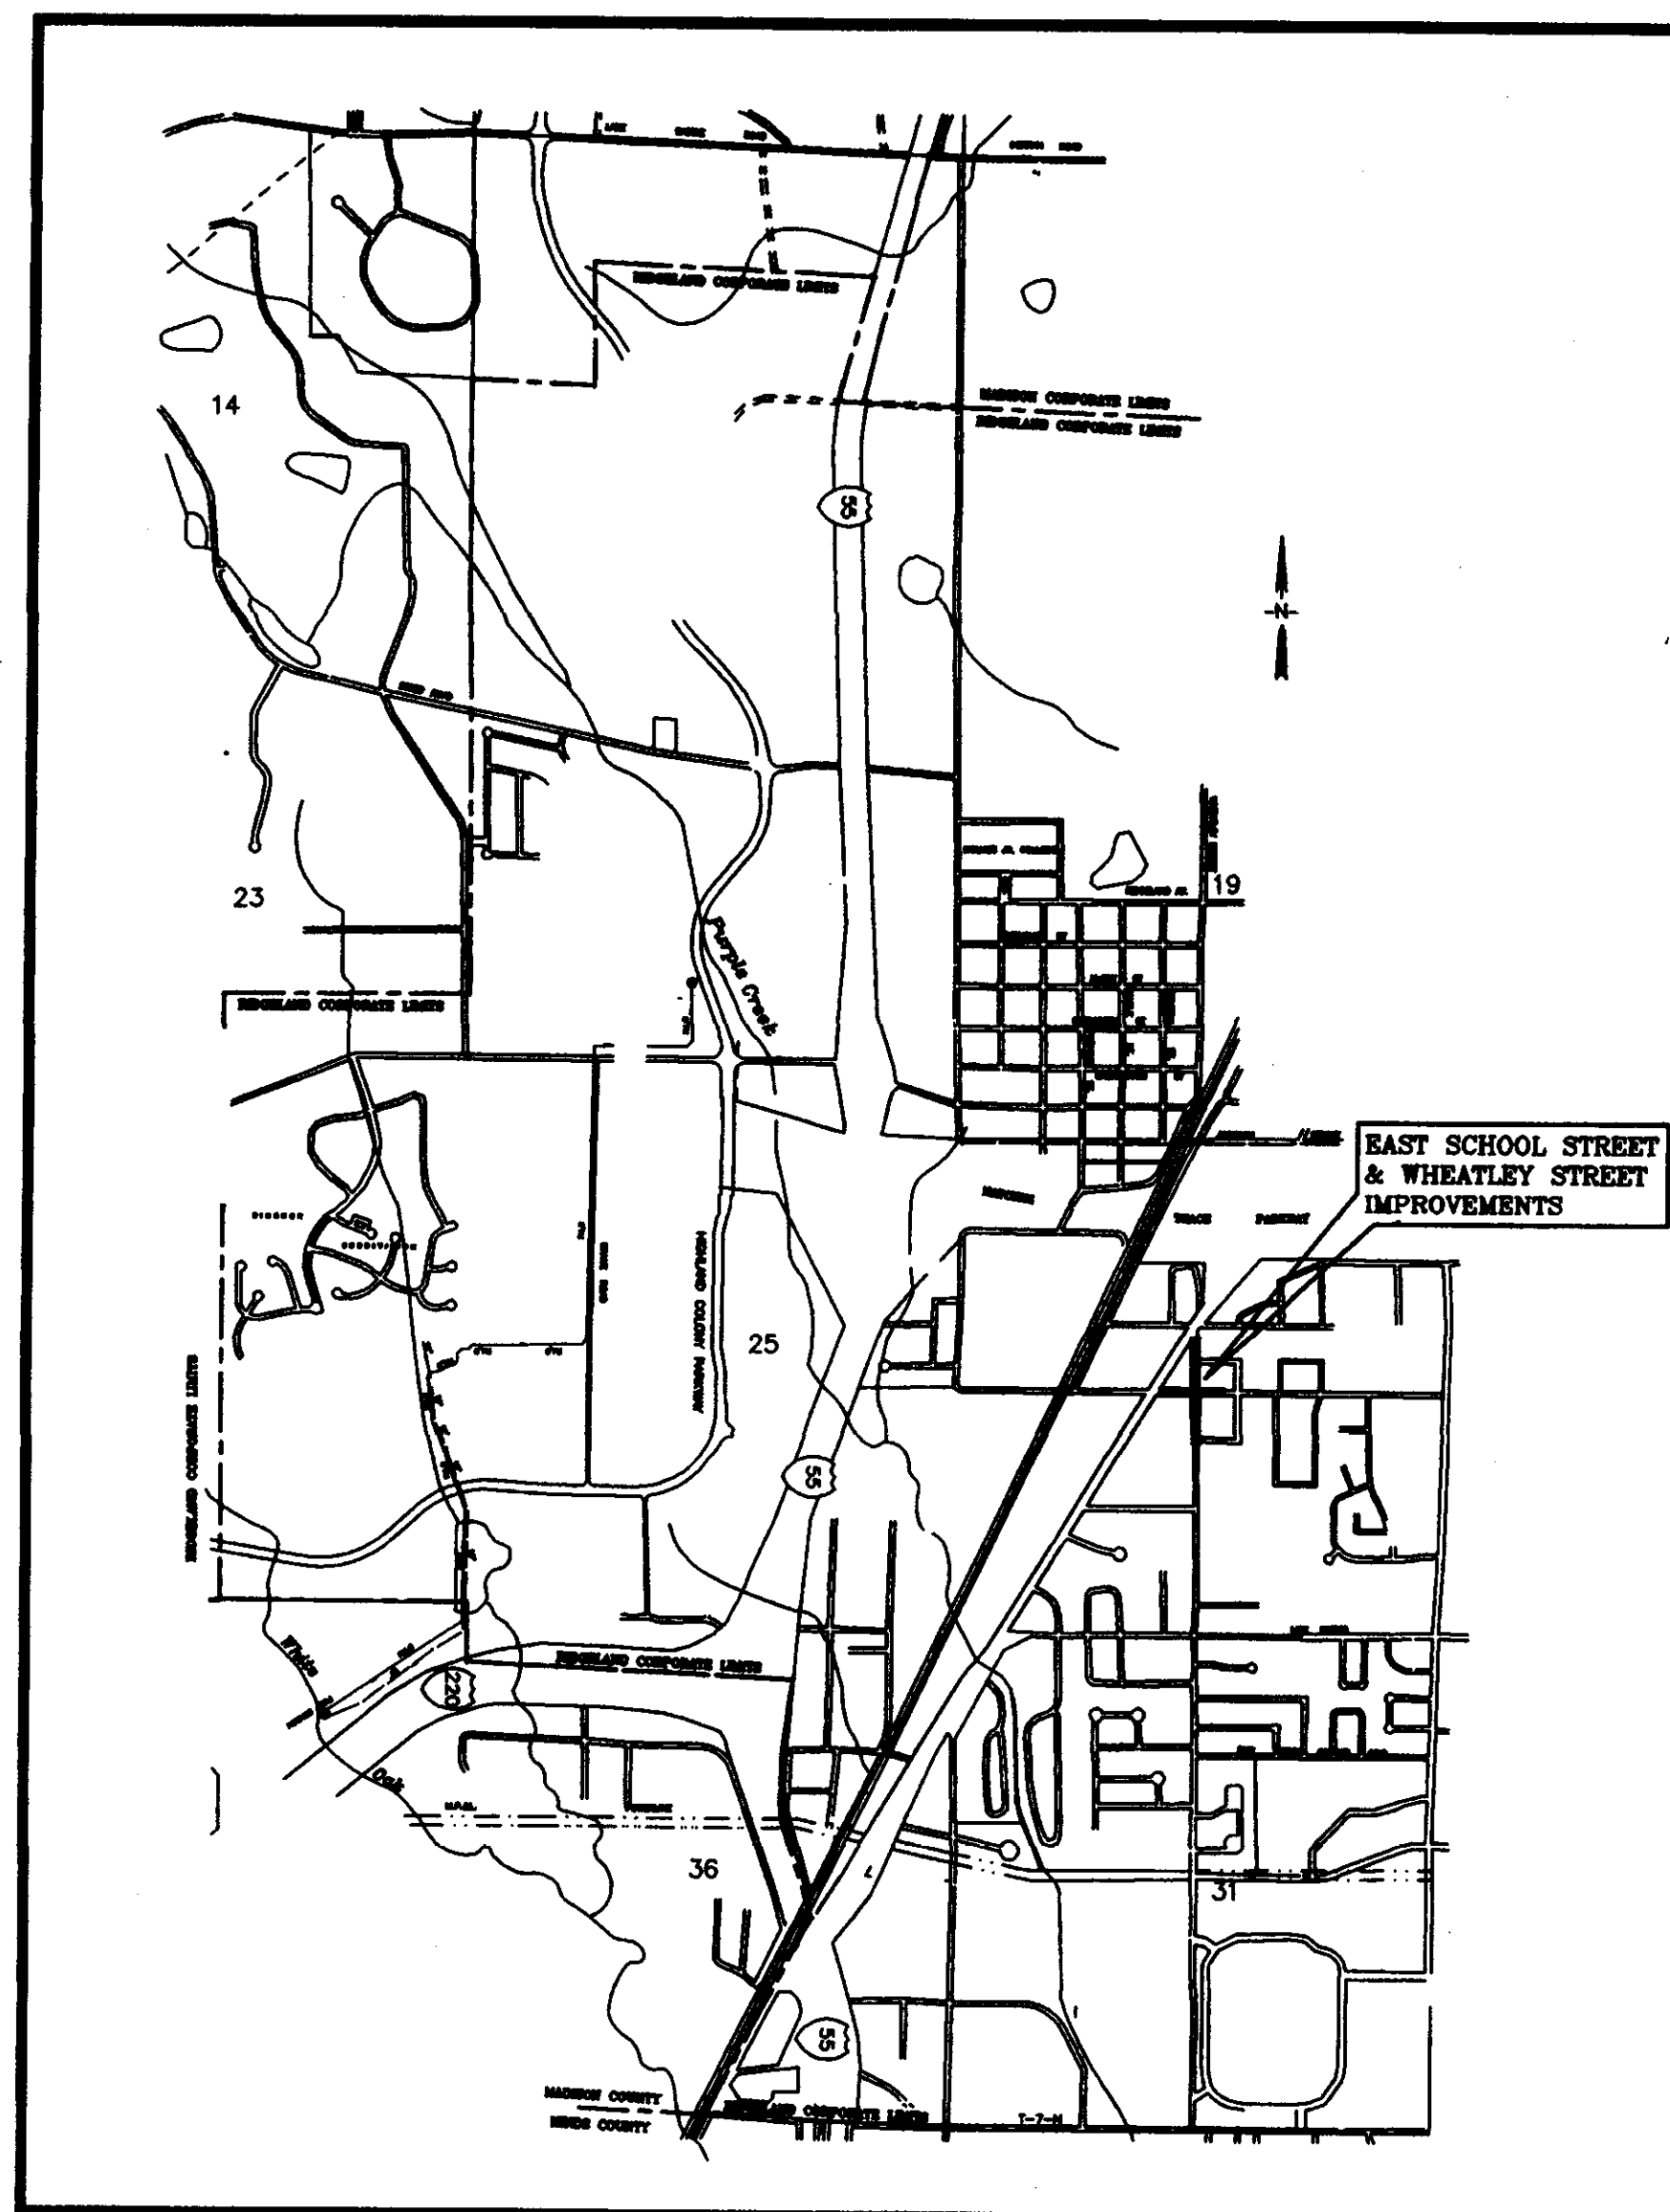

*Aldermen:*

*Brian Barcellona*  
*Joe Barlow*  
*Al Bible*  
*Harvey Carr, Jr.*  
*Linda Davis*  
*Chuck Kobert*  
*Daryl Smith*

*Public Works Director:*  
*Sam Vinson, P.E.*

*Asst. Public Works Director:*  
*Sid Hawthorne*

*City Clerk:*  
*Michael McPhearson*

*Fire Chief:*  
*Elmer Waits*


*Police Chief:*  
*Charles Newell*

*JANUARY 1996*

*WAGGONER ENGINEERING, INC.*  
*CONSULTING ENGINEERS*  
*Jackson / Pascagoula, Mississippi*

RECORD DRAWING  
FEBRUARY 1997

**PWP-01935**

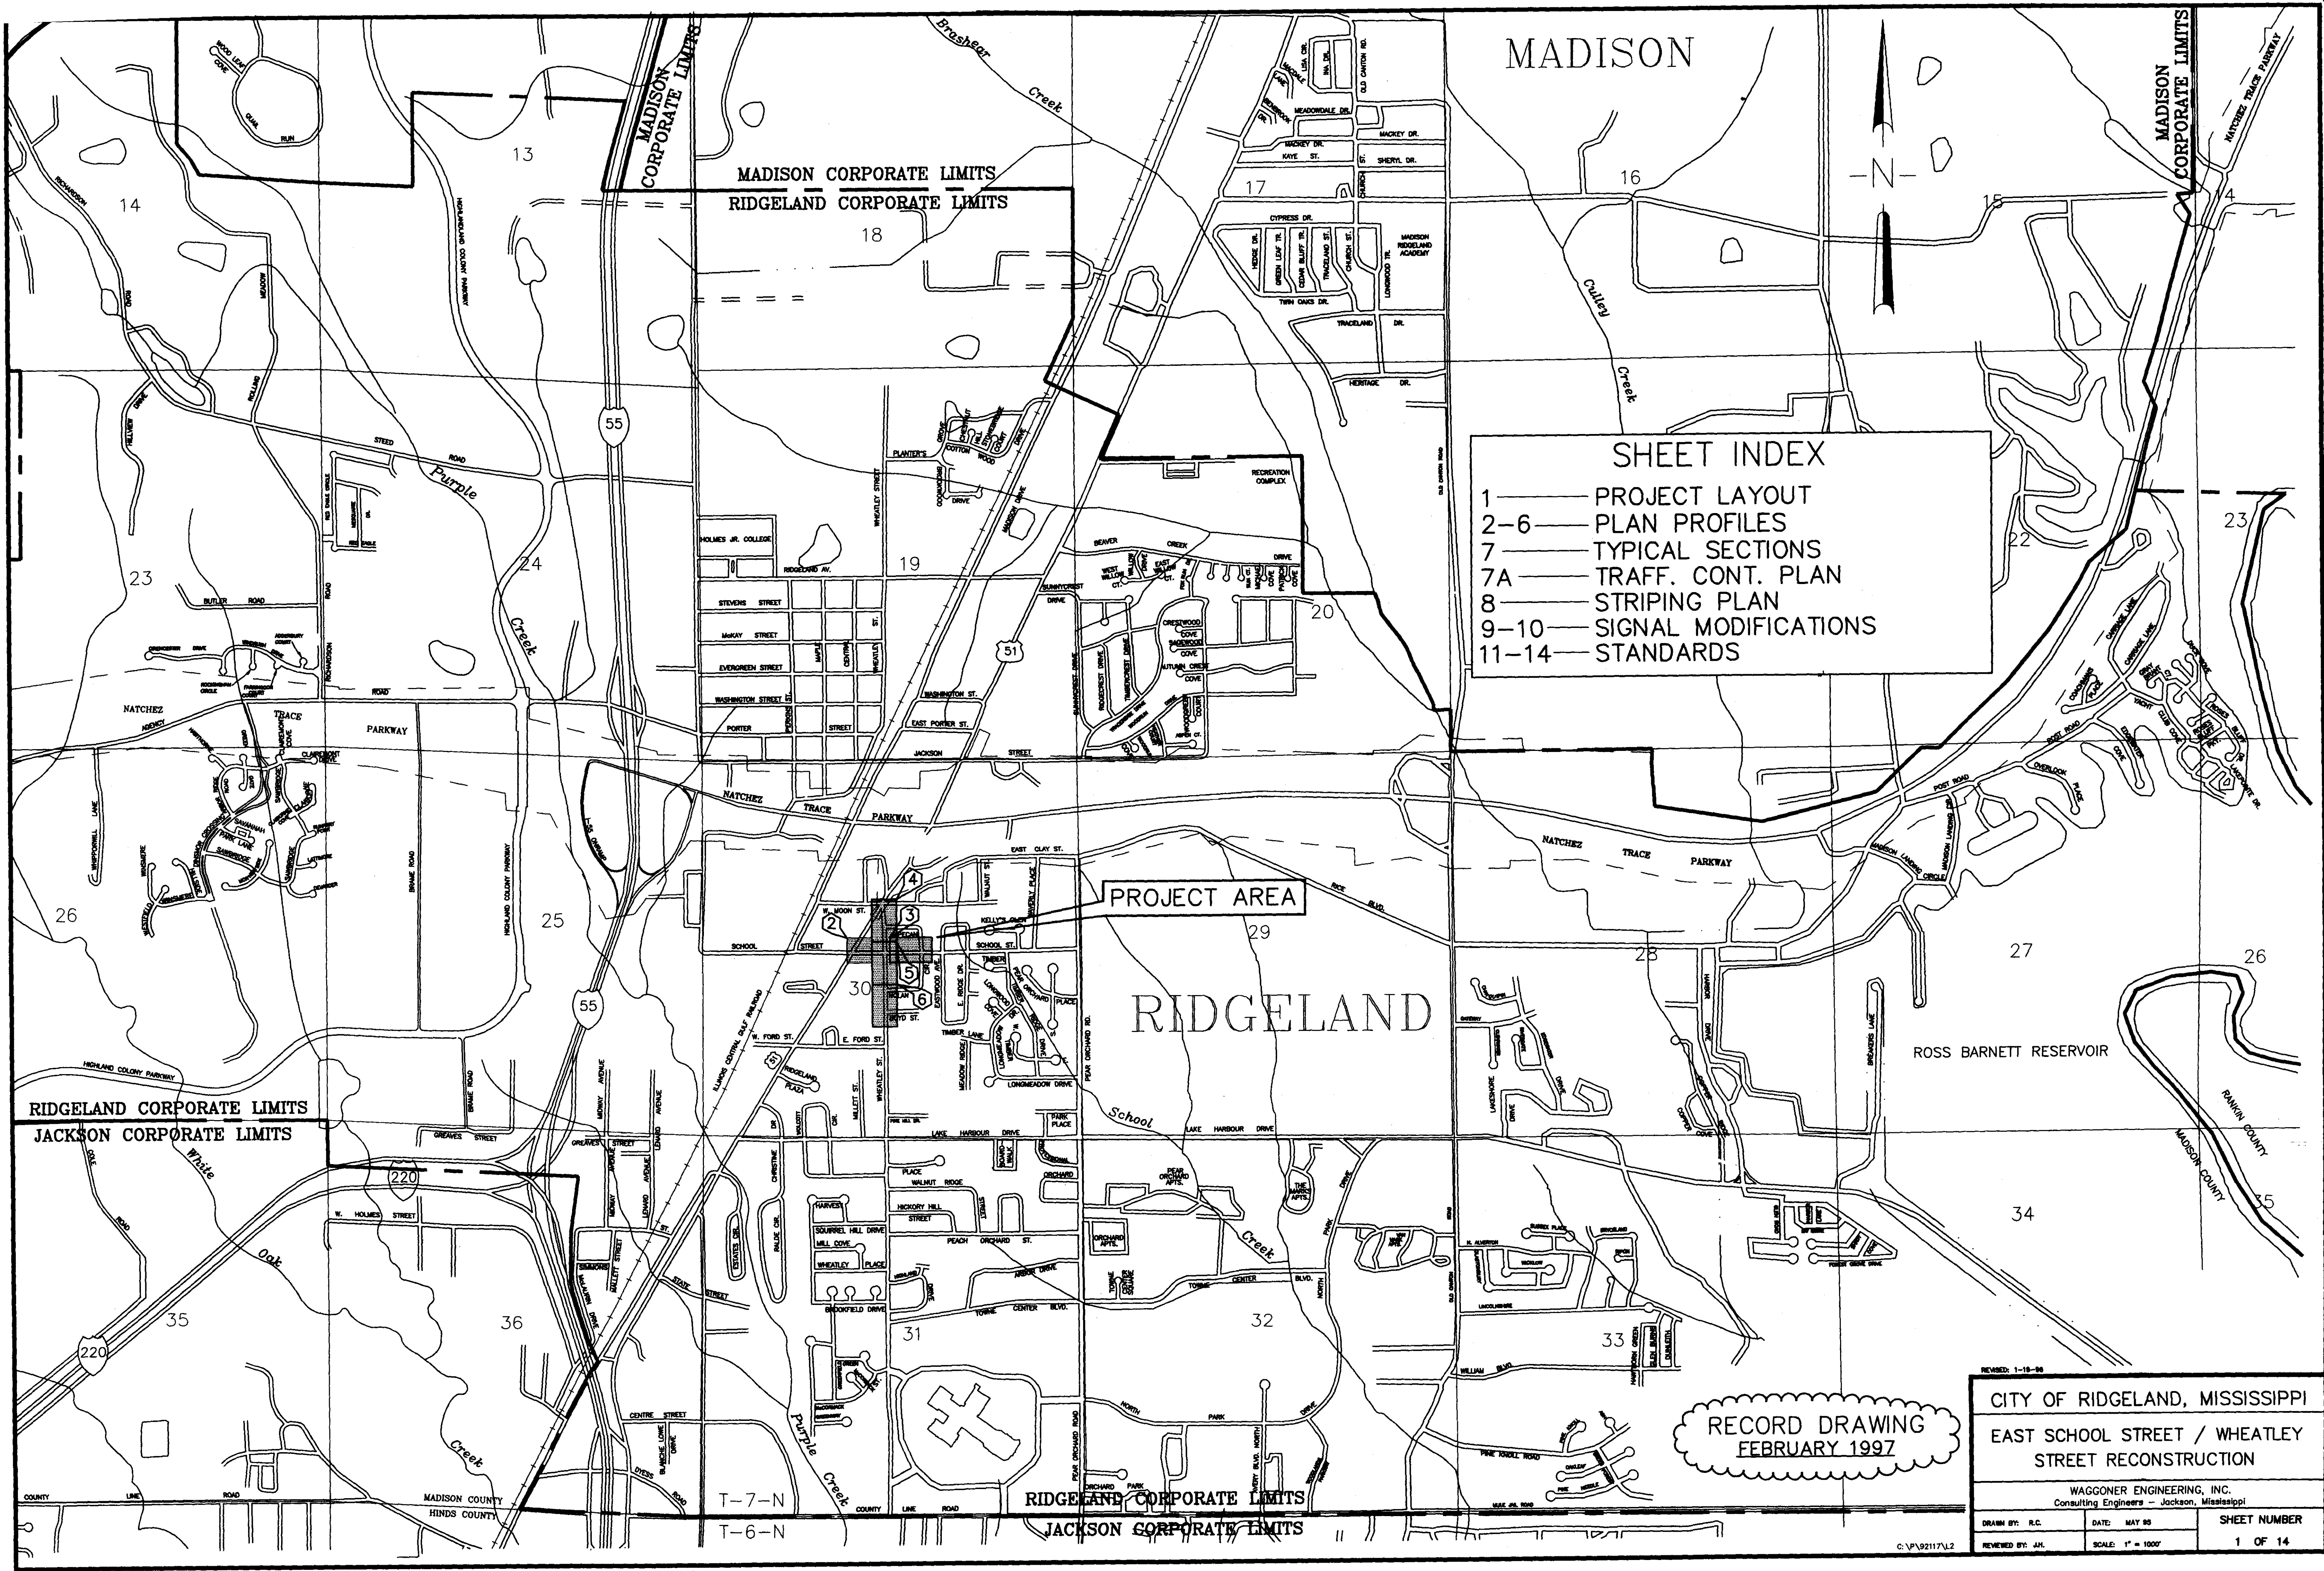

**SHEET INDEX**

1	PROJECT LAYOUT
2-6	PLAN PROFILES
7	TYPICAL SECTIONS
7A	TRAFF. CONT. PLAN
8	STRIPING PLAN
9-10	SIGNAL MODIFICATIONS
11-14	STANDARDS

**PROJECT AREA**

**RECORD DRAWING**  
FEBRUARY 1997

REVISIONS: 1-18-98  
**CITY OF RIDGELAND, MISSISSIPPI**  
**EAST SCHOOL STREET / WHEATLEY STREET RECONSTRUCTION**



WAGGONER ENGINEERING, INC.  
 Consulting Engineers - Jackson, Mississippi

DRAWN BY: R.C.	DATE: MAY 95	SHEET NUMBER
REVIEWED BY: J.H.	SCALE: 1" = 1000'	1 OF 14

C:\P\92117.L2



C:\P92117\SC1251.dwg, Jul 23 07:14:06 1997  
 HP DesignPlot 75504, HP DesignPlot-Plotter HP-GL/2 devices v3.1, AOT: 4.2 -By: HP

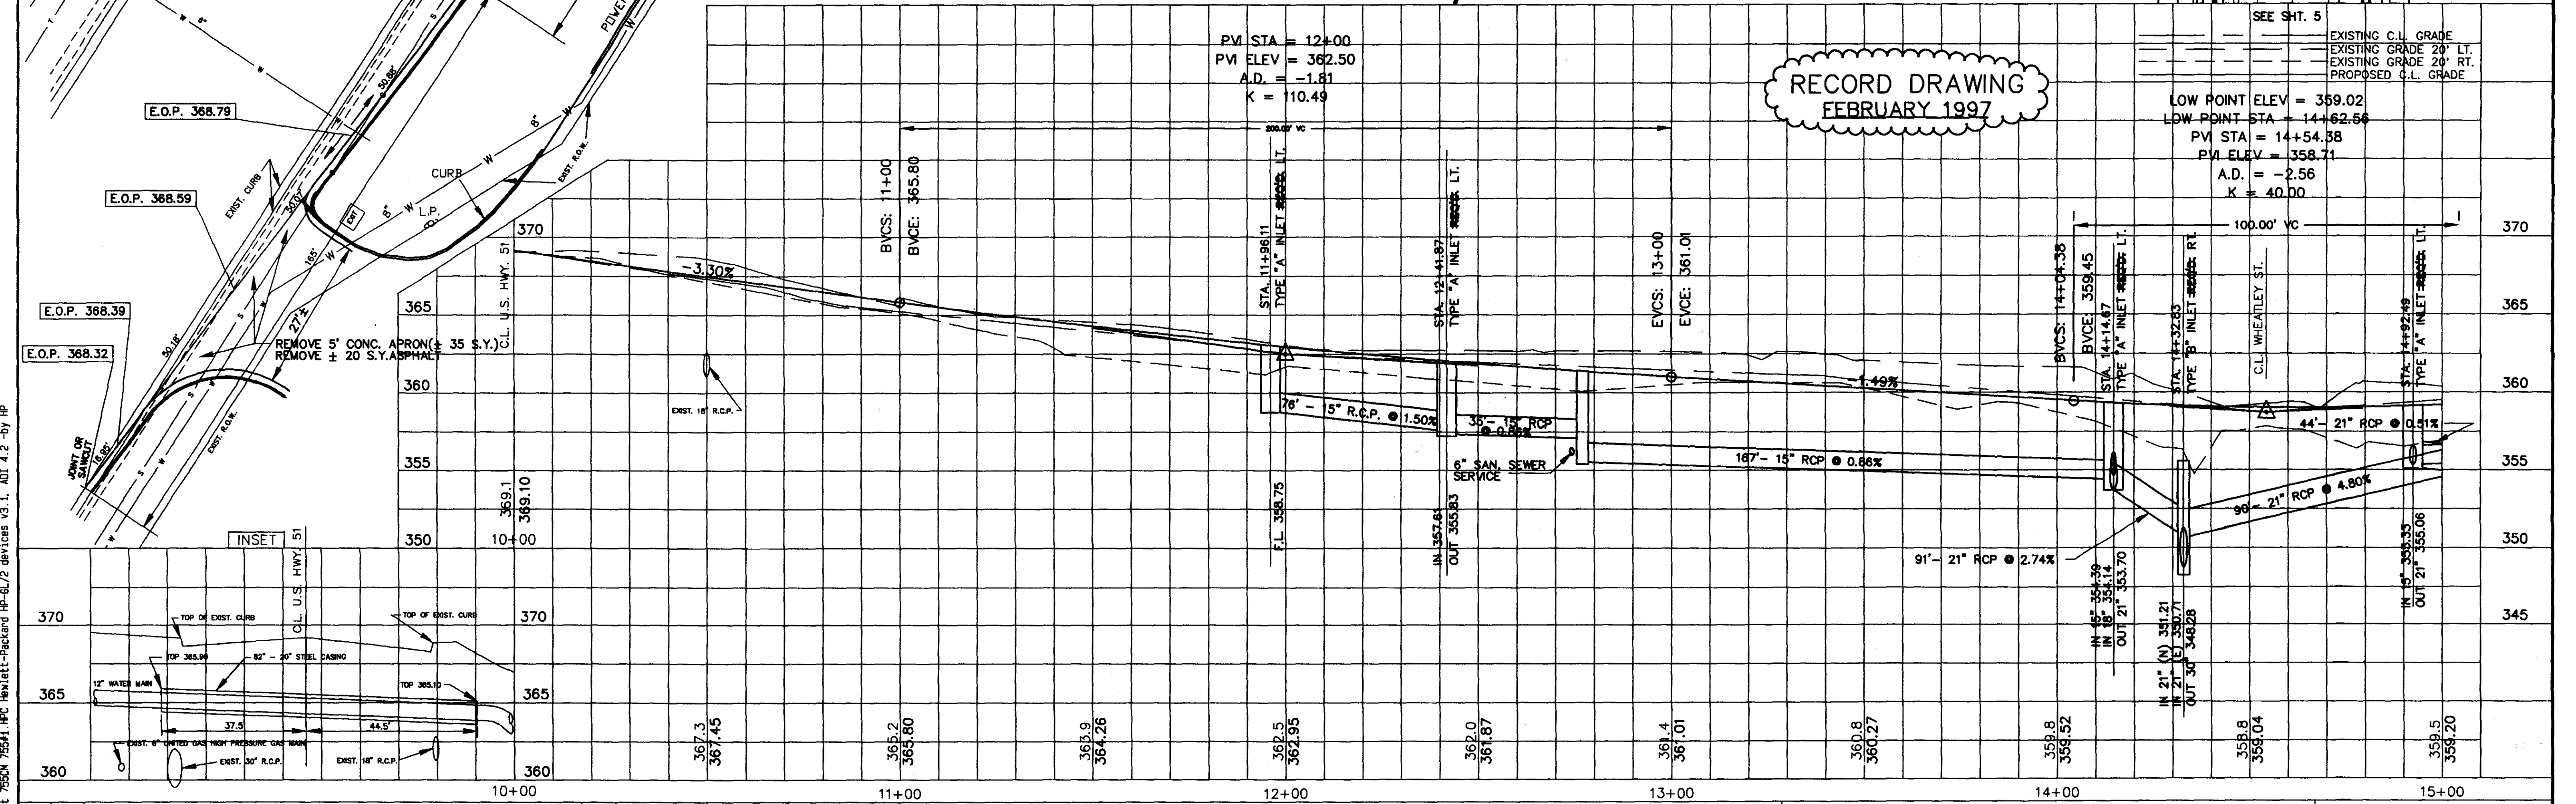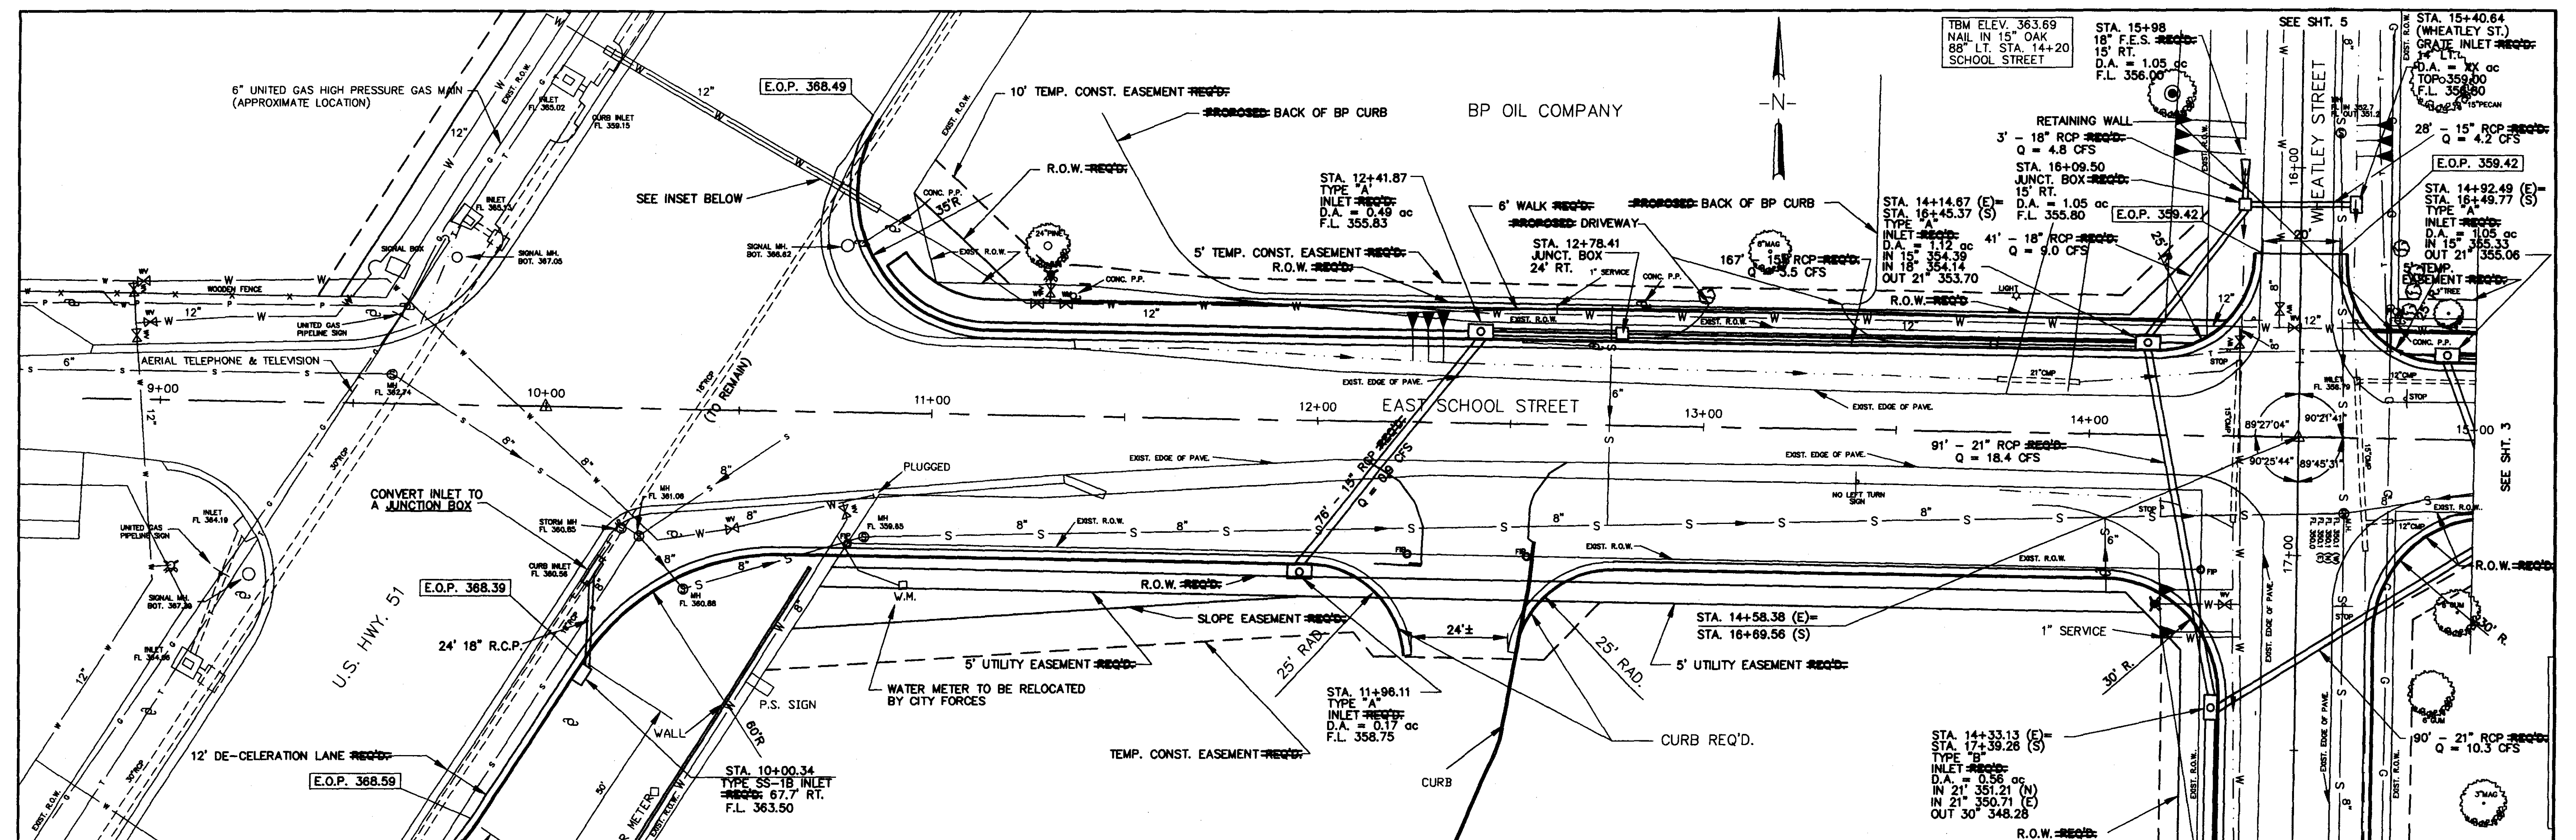

NO.	DATE	REVISIONS	BY

DESIGNED DATE  
 R.C. JAN. 96  
 SCALE  
 1" = 20' HORIZ.  
 1" = 5' VERT.

WACONER ENGINEERING INC. CONSULTING ENGINEERS  
 JACKSON, MISSISSIPPI

SCHOOL STREET IMPROVEMENTS

ACAD PATH ROUTE  
 C:\P92117\SC1251  
 W.E.I. JOB NO. 92117 SHEET NO. 2 OF 14


RECORD DRAWING  
 FEBRUARY 1997

EXISTING C.L. GRADE  
 EXISTING GRADE 20' LT.  
 EXISTING GRADE 20' RT.  
 PROPOSED C.L. GRADE


LOW POINT ELEV = 359.02  
 LOW POINT STA = 14+62.56  
 PVI STA = 14+54.38  
 PVI ELEV = 358.71  
 A.D. = -2.56  
 K = 40.00





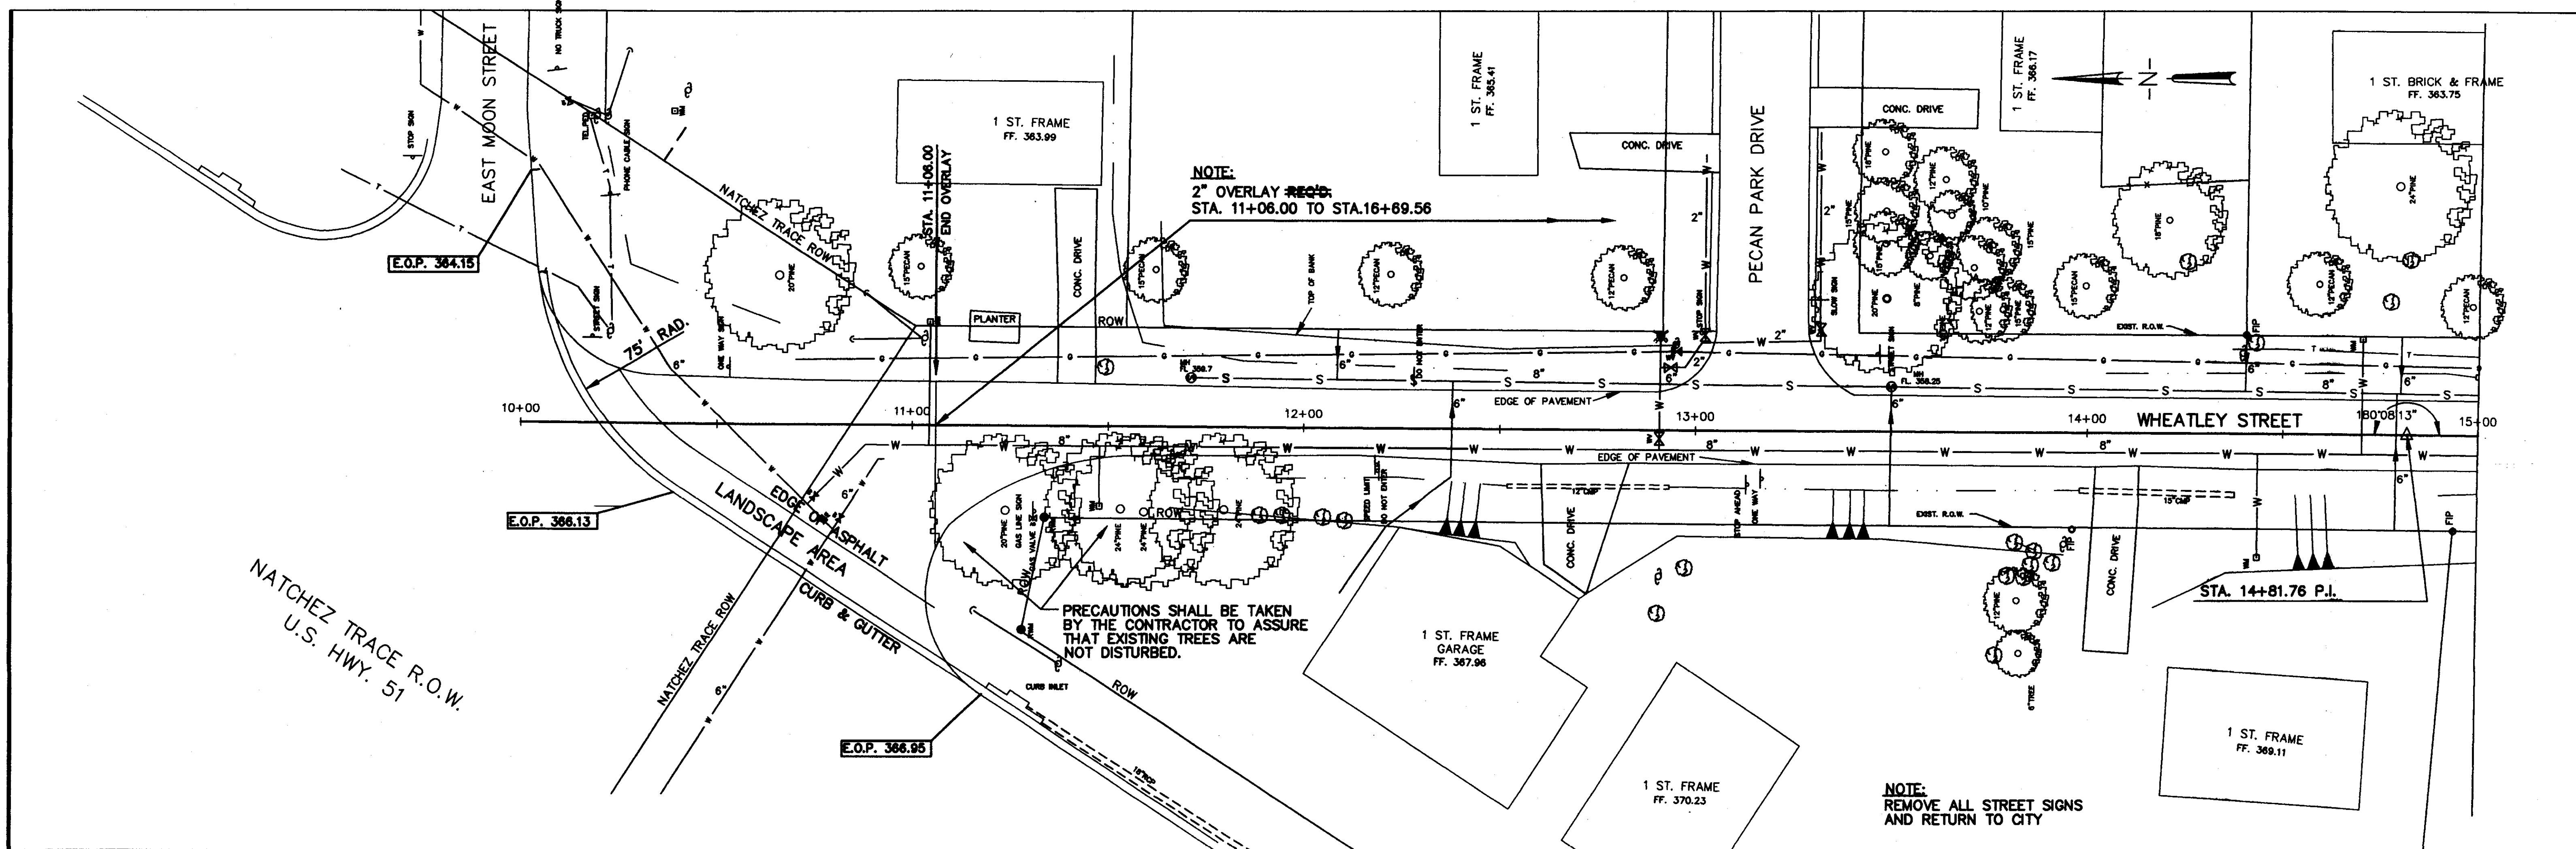


RECORD DRAWING  
FEBRUARY 1997

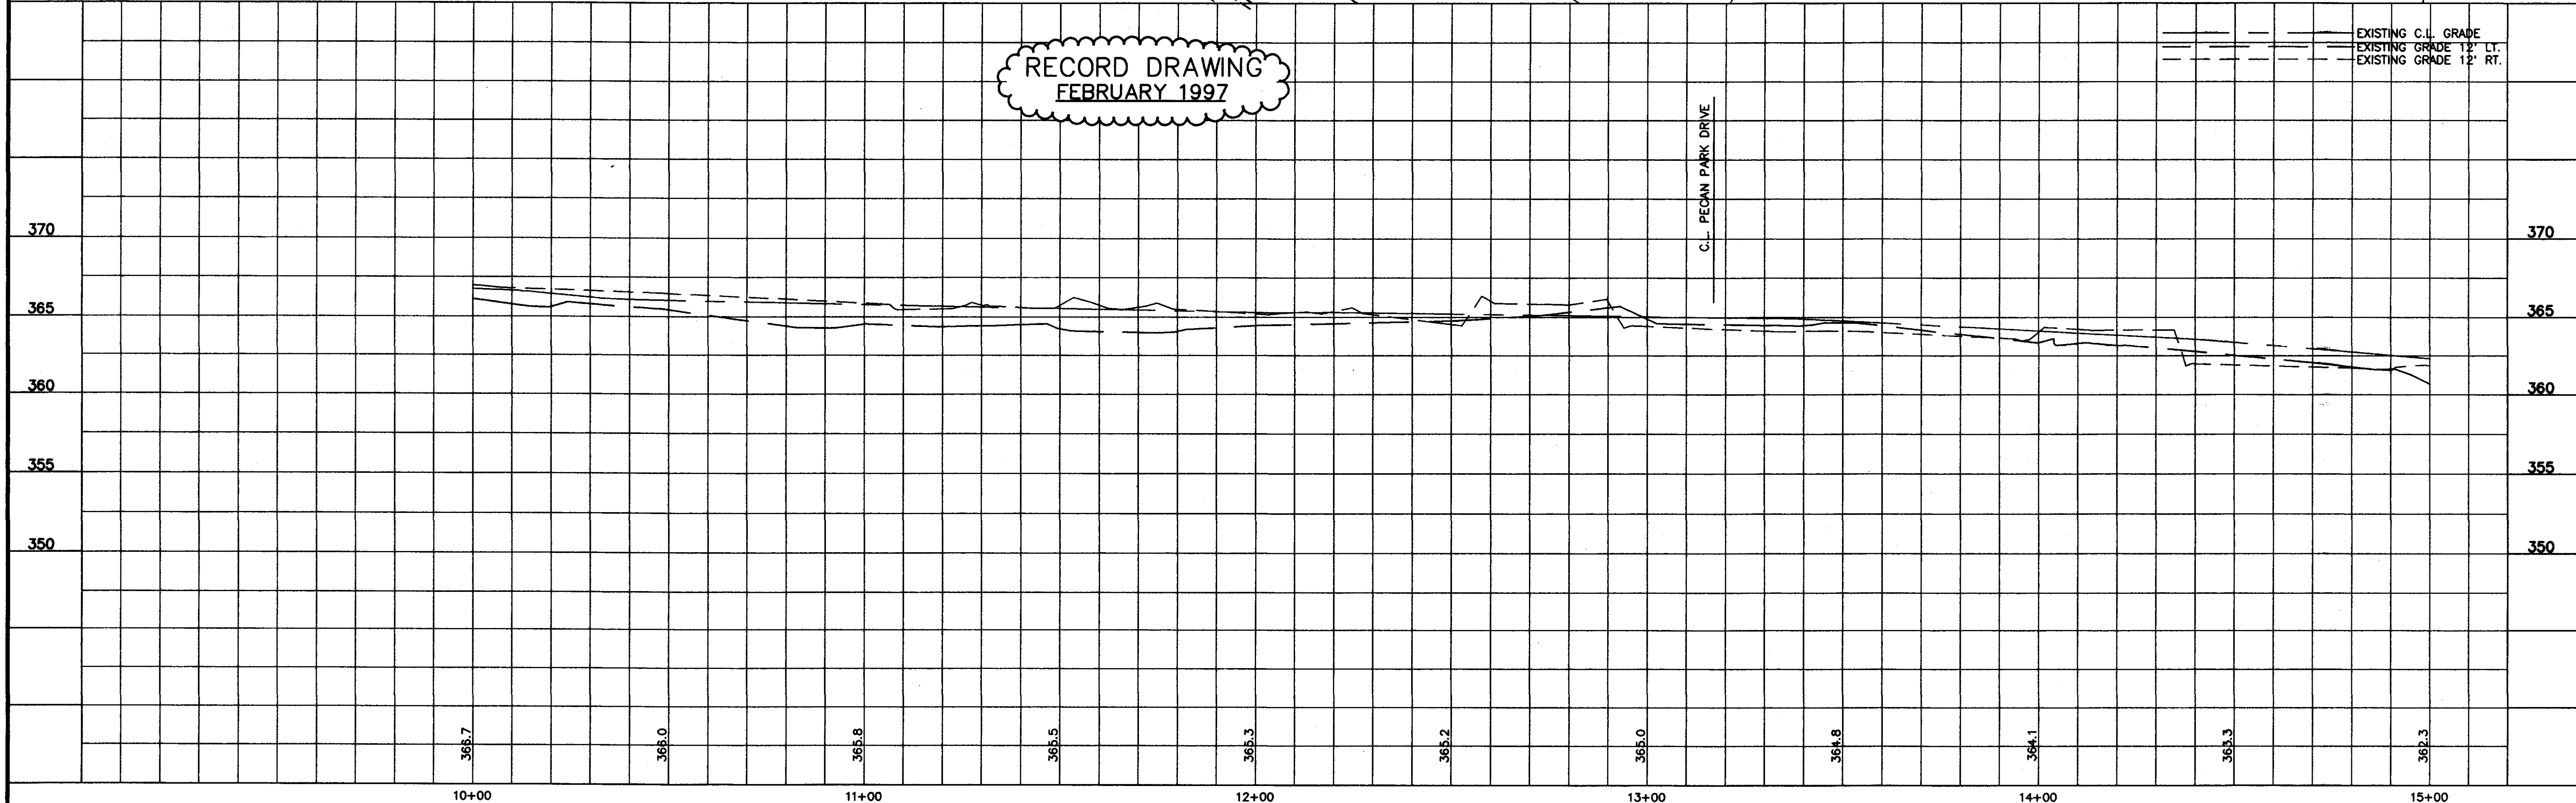


NO.	DATE	REVISIONS	BY	DESIGNED	DATE	WAGNER ENGINEERING INC. CONSULTING ENGINEERS JACKSON, MISSISSIPPI		SCHOOL STREET IMPROVEMENTS		ACAD PATH ROUTE C:\P\92117\WH125T	
				DRAWN	JAN. 98					W.E.I. JOB NO.	SHEET NO.
				R.C.	SCALE					92117	4 OF 14
					1" = 20' HORIZ. 1" = 5' VERT.						



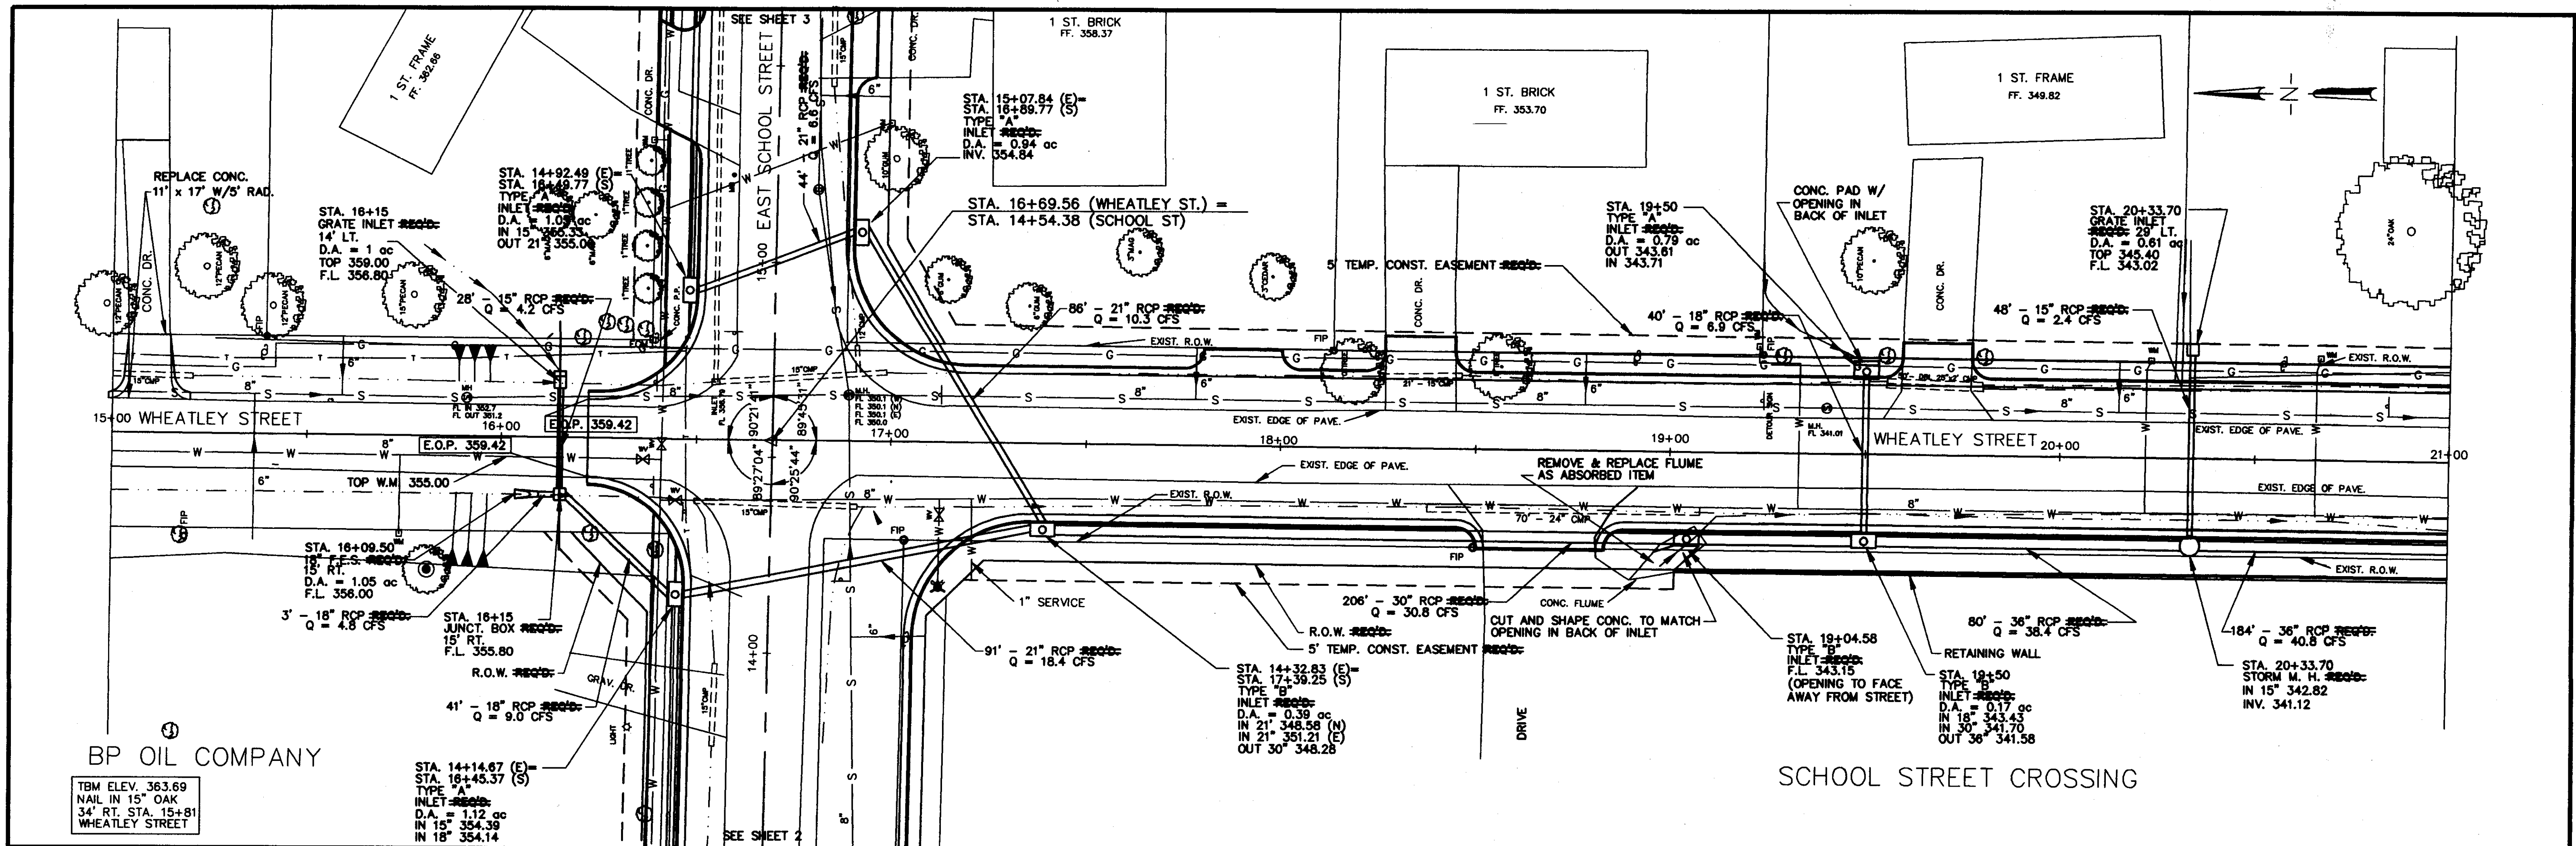


SCHOOL STREET CROSSING

RECORD DRAWING  
FEBRUARY 1997

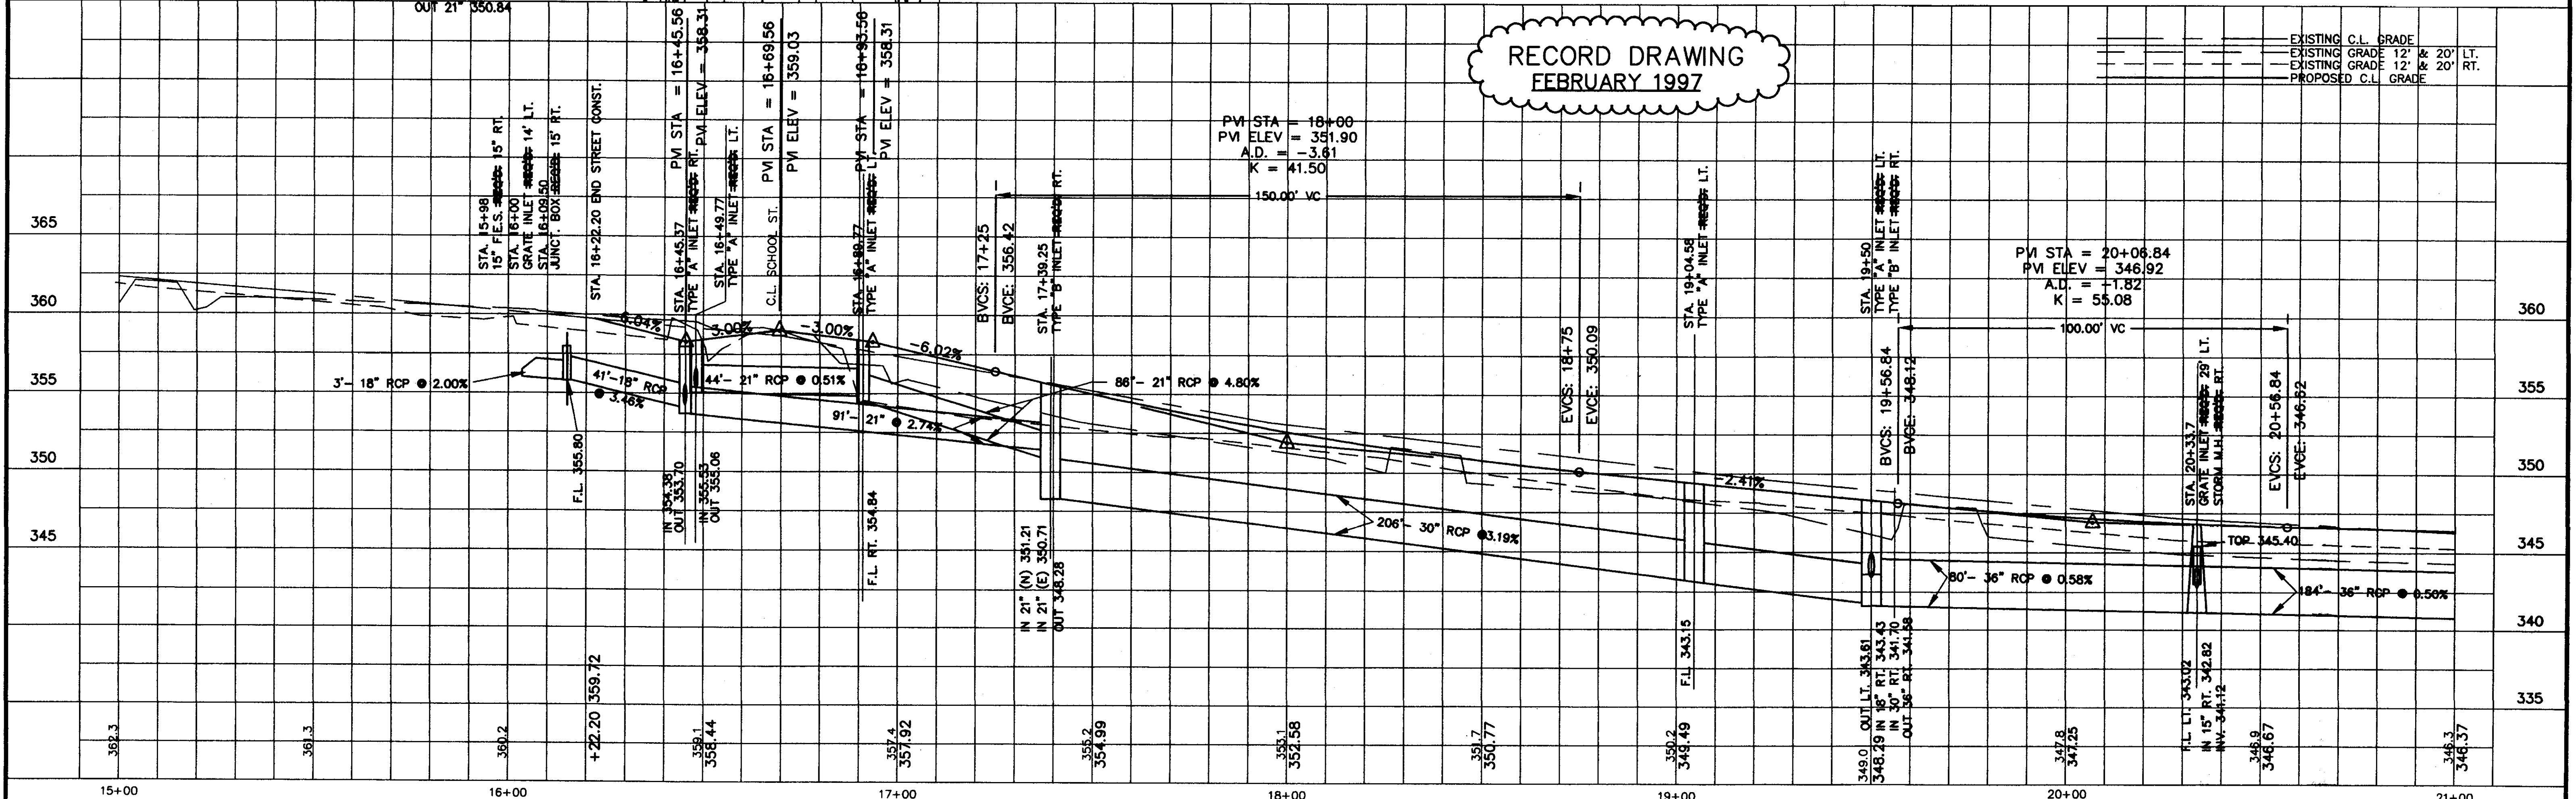


C:\P\92117\W22ST Mon Jul 28 08:25:54 1997  
HP DesignJet 755CN HP-GL/2 devices v3.1, AUI 4.2 -by HP

NO.	DATE	REVISIONS	DESIGNED	DATE	WAGGONER ENGINEERING INC. CONSULTING ENGINEERS JACKSON, MISSISSIPPI		SCHOOL STREET IMPROVEMENTS		ACAD PATH ROUTE C:\P\92117\W22ST	W.E.I. JOB NO. 92117	SHEET NO. 5 of 14
			DRAWN	JAN. 96							
			BY	SCALE							
			R.C.	1" = 20' HORIZ. 1" = 5' VERT.							

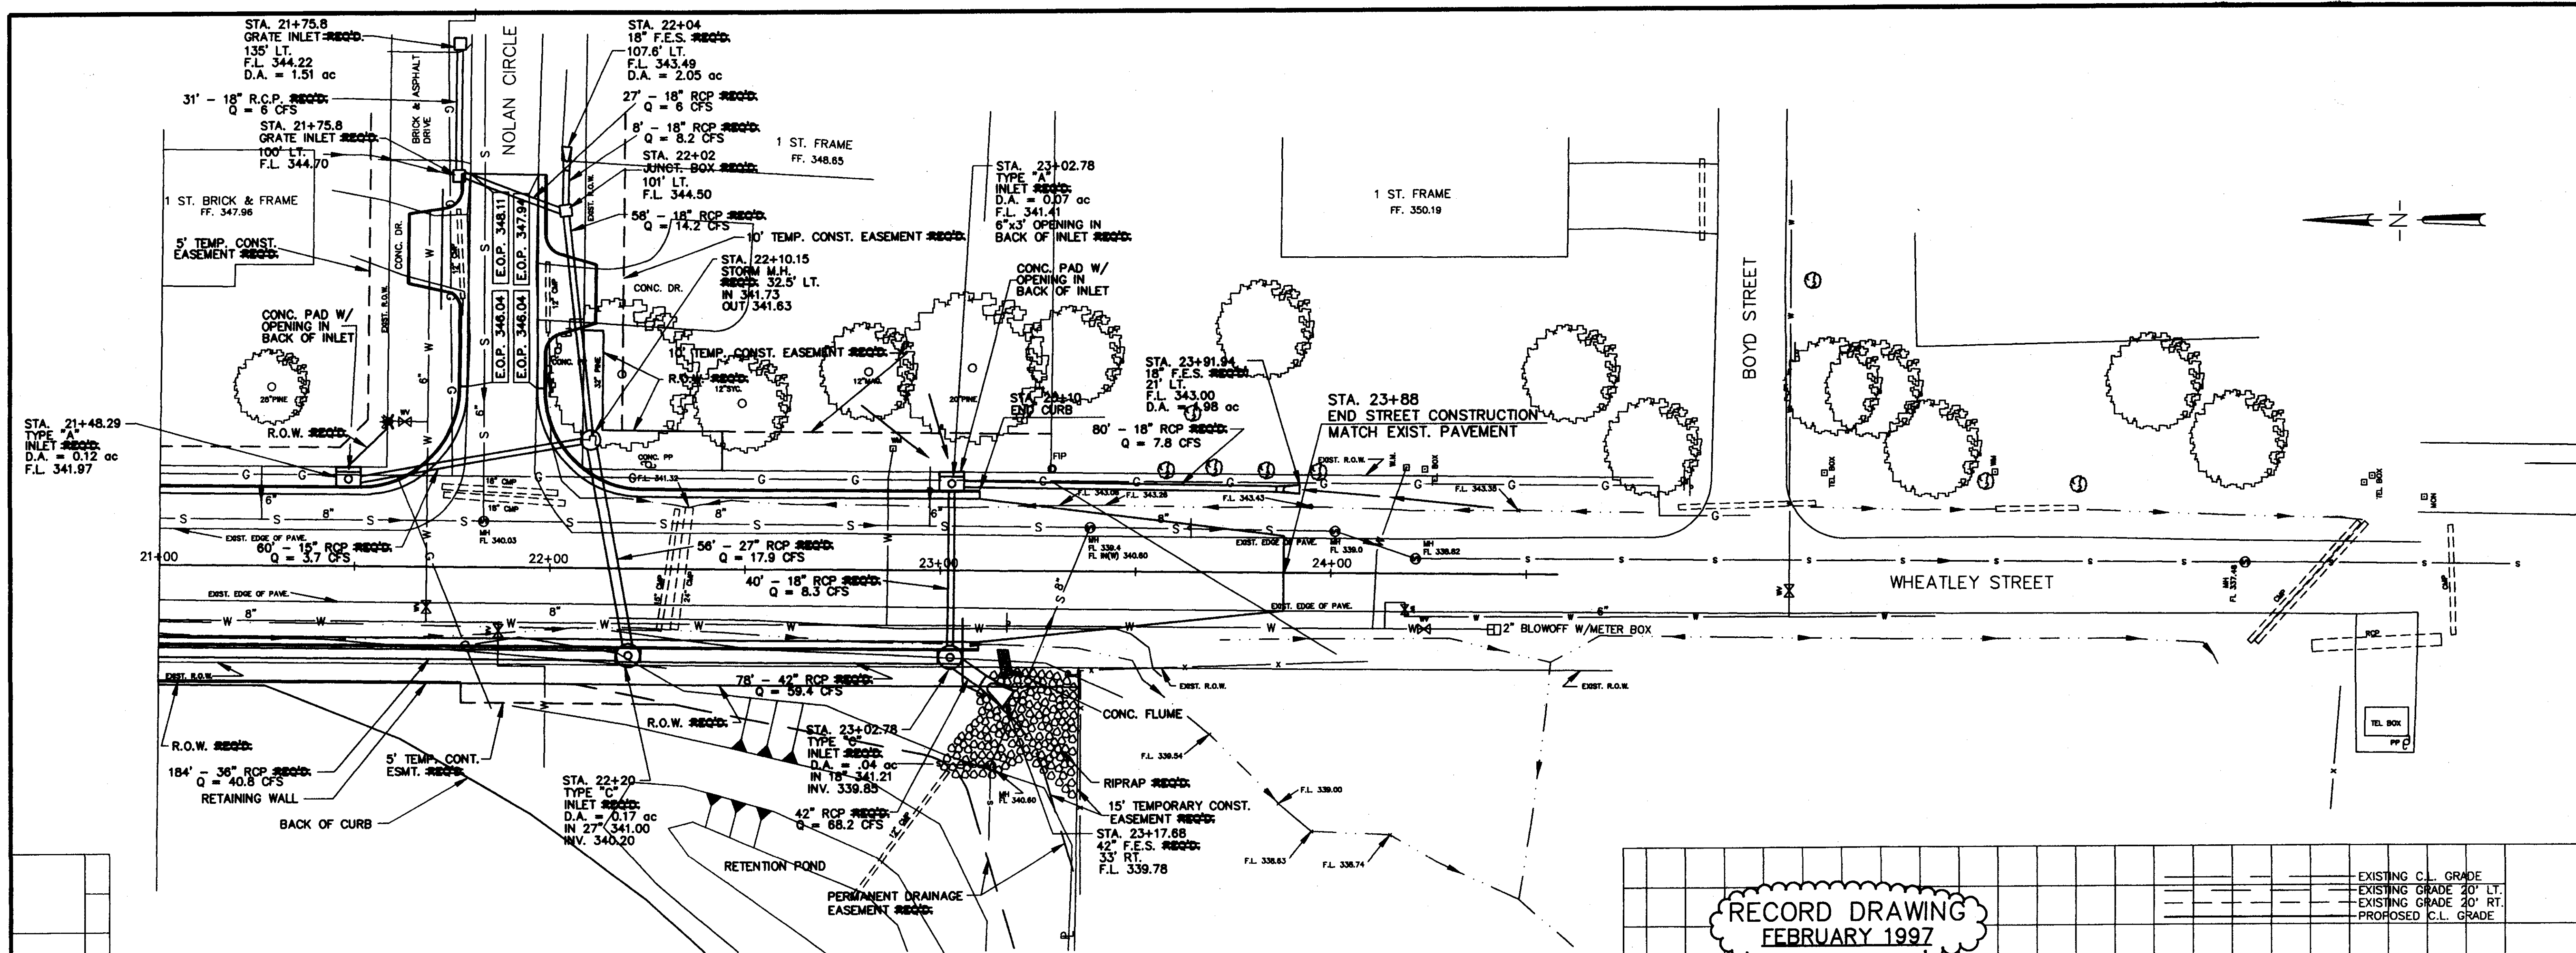

RECORD DRAWING  
FEBRUARY 1997

---	EXISTING C.L. GRADE
---	EXISTING GRADE 20' LT.
---	EXISTING GRADE 20' RT.
---	PROPOSED C.L. GRADE

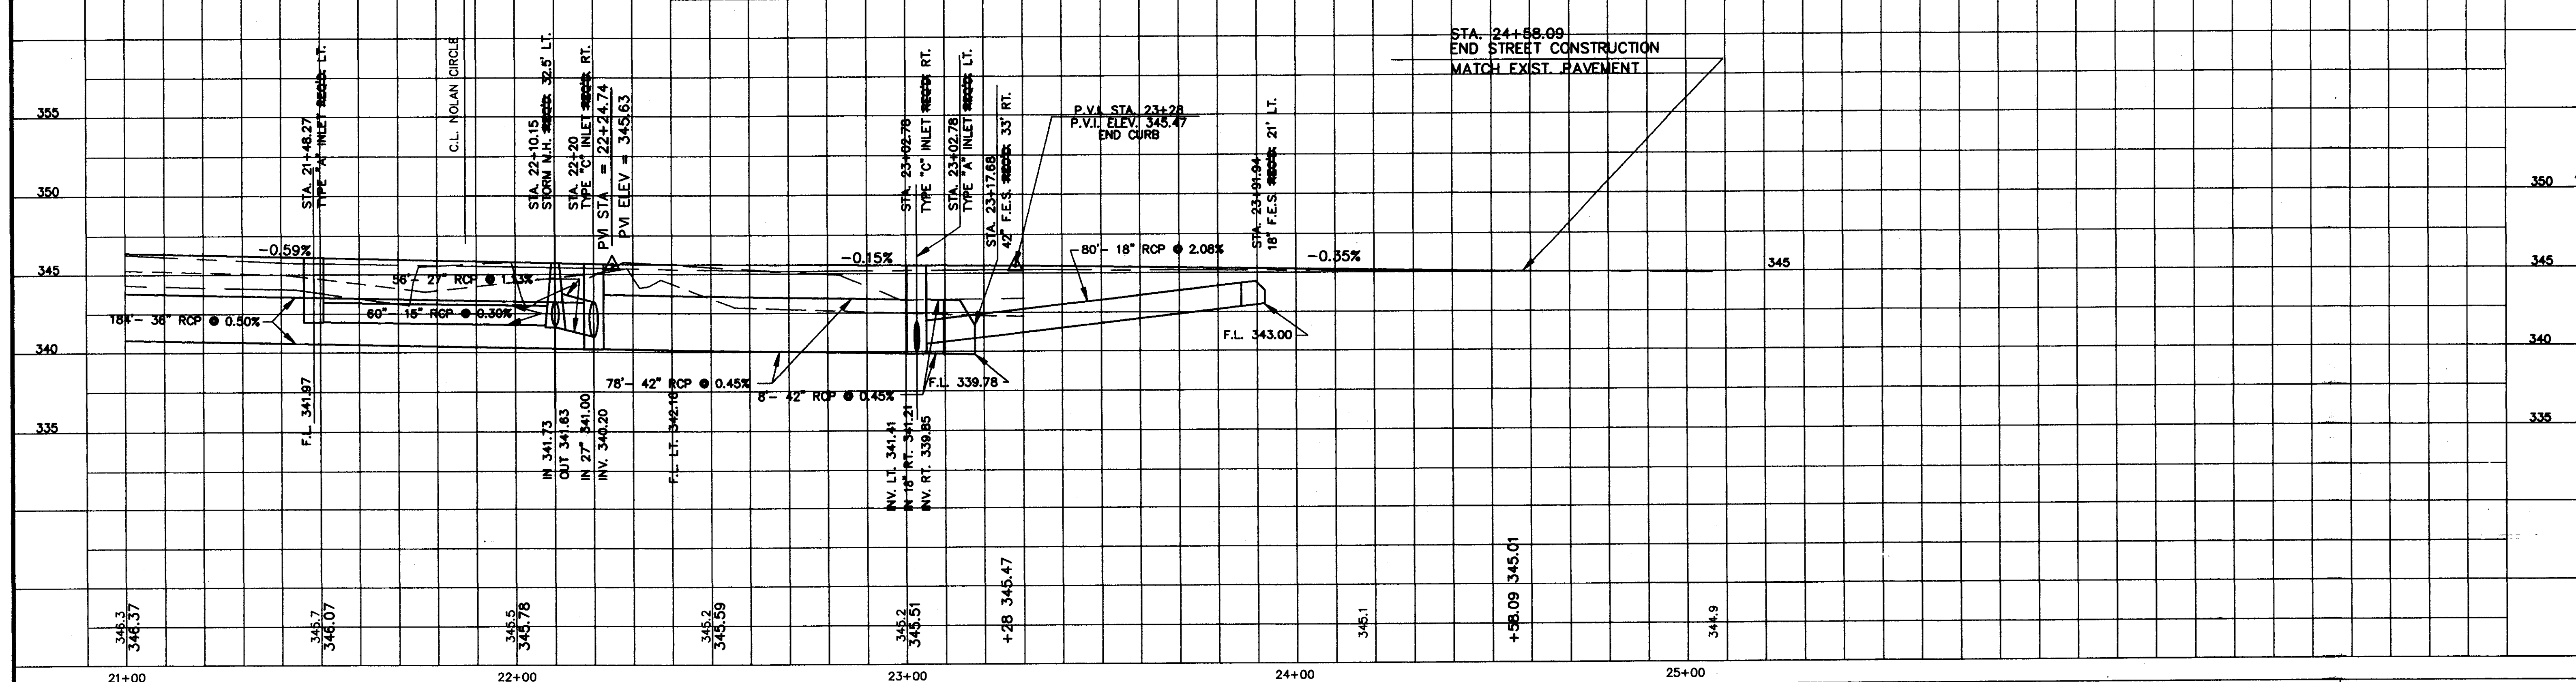

C:\P\92117\W325T Mod JUL 23 08:02:36 1997  
 HP Desig\out: 75504 75541.HPC Hewlett-Packard HP-GL/2 devices v3.1, ADI 4.2 -by HP

NO.	DATE	REVISIONS	BY


DESIGNED	DATE
DRAWN	JAN. 96
R.C.	SCALE
	1"=20' HORIZ.
	1"=5' VERT.

WAGNER ENGINEERING INC. CONSULTING ENGINEERS  
 JACKSON, MISSISSIPPI

ACAD PATH ROUTE	
C:\P\92117\W325T	
W.E.I. JOB NO.	SHEET NO.
92117	6 OF 14




NOTE: CONTRACTOR SHALL SLOPE INLET TOP TO MATCH SIDEWALK SLOPE WHERE APPLICABLE.

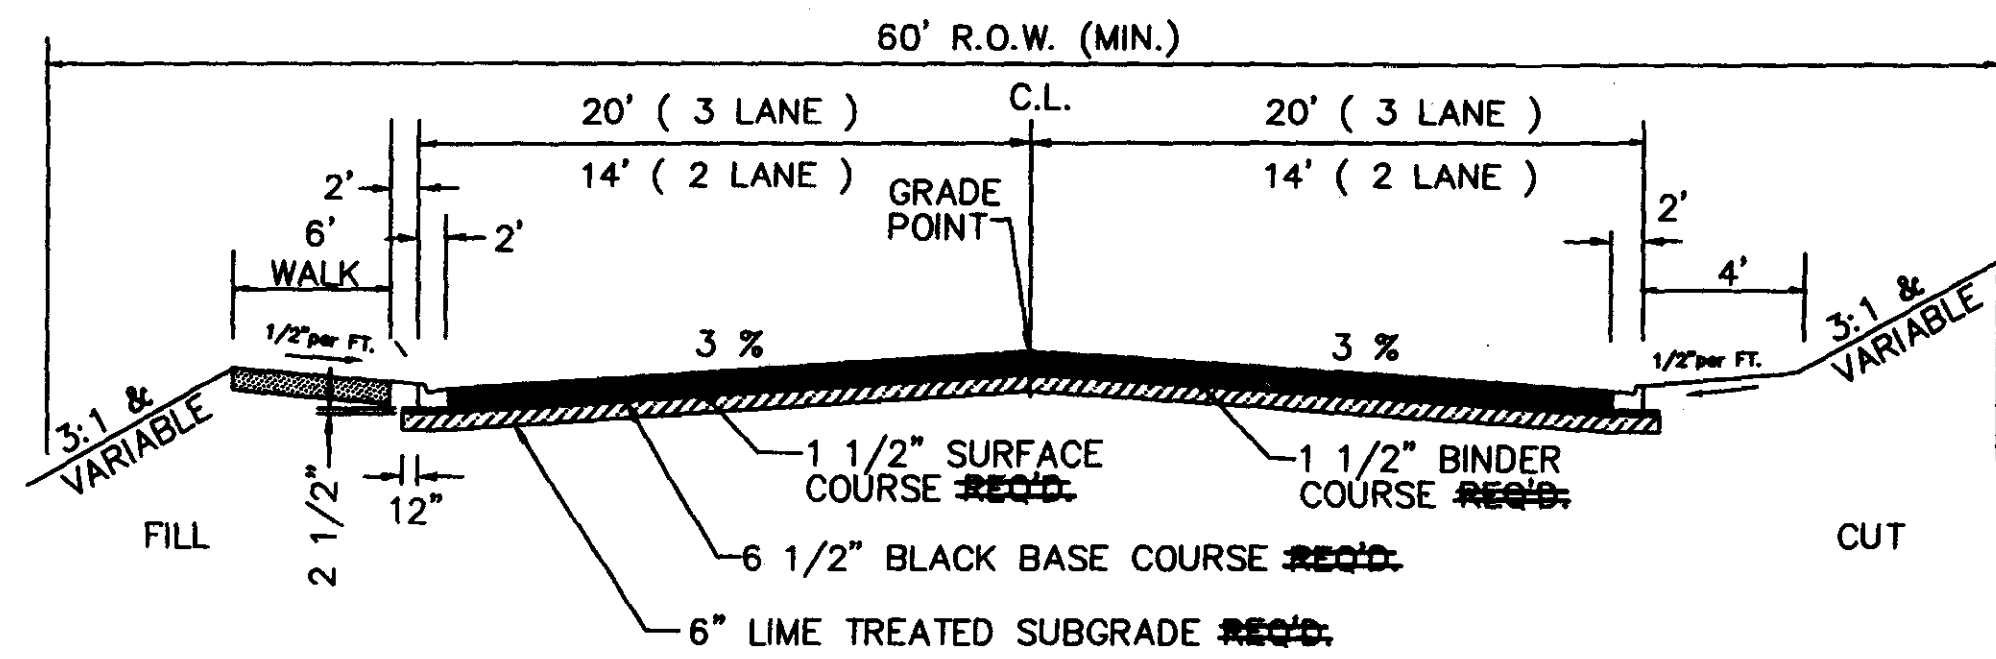


STA. 14+54.38 THRU 18+00  
SCHOOL STREET 2 LANE & 3 LANE  
N.T.S.


14+54 TO 15+81 ( 3 LANE )  
TRANSITION  
16+71 TO 17+10 ( 2 LANE )  
TRANSITION  
18+00

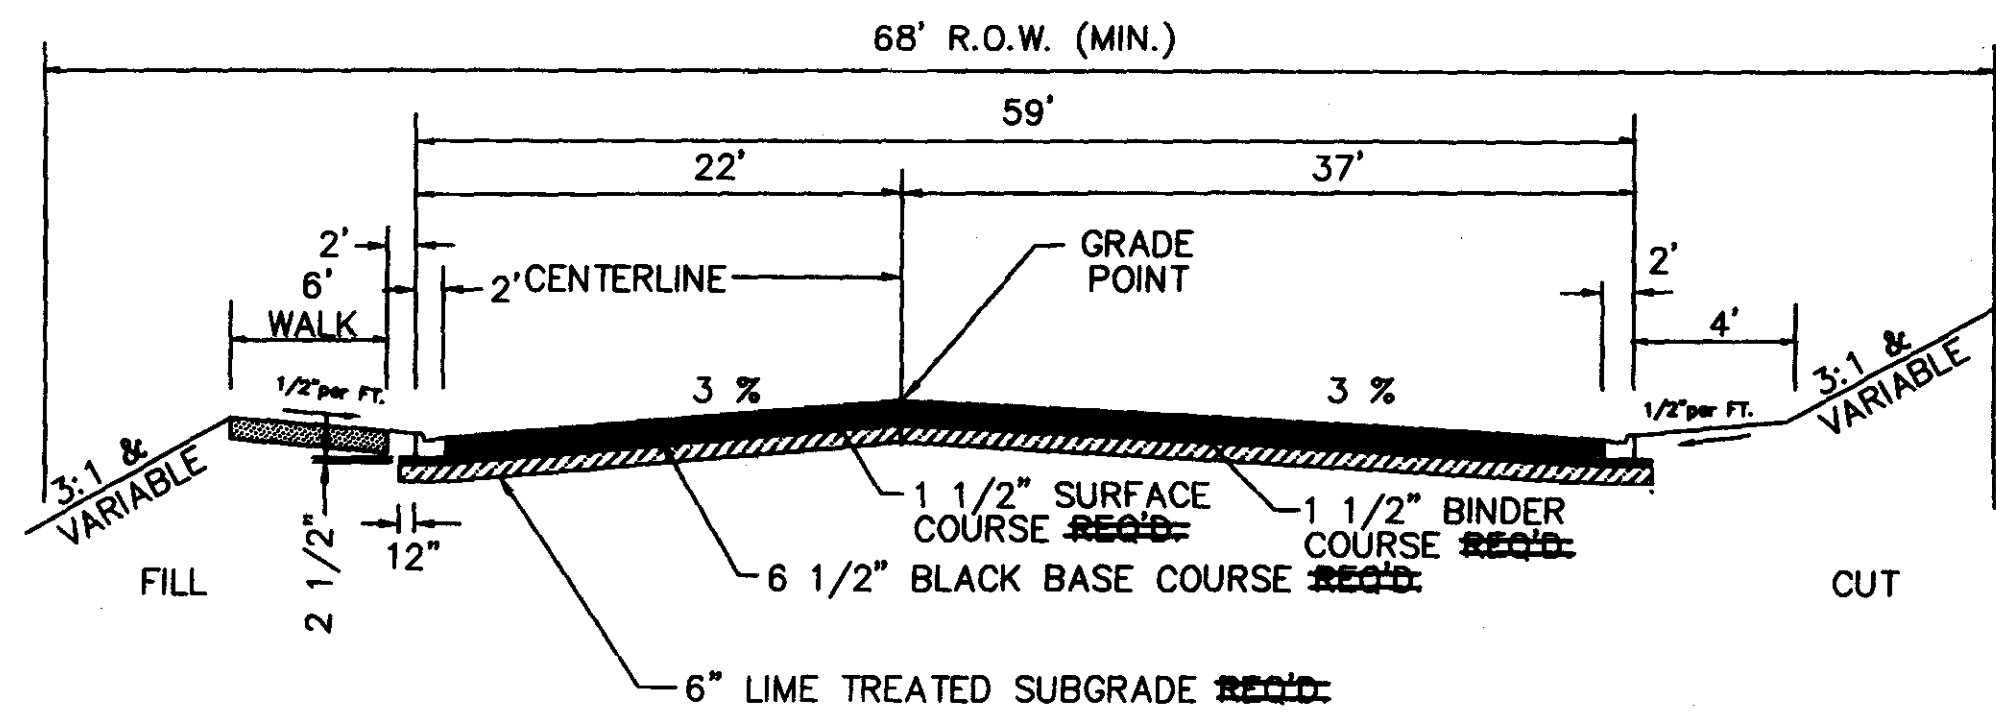


STA. 10+92.91 THRU 14+54.38  
SCHOOL STREET 5 LANE  
N.T.S.

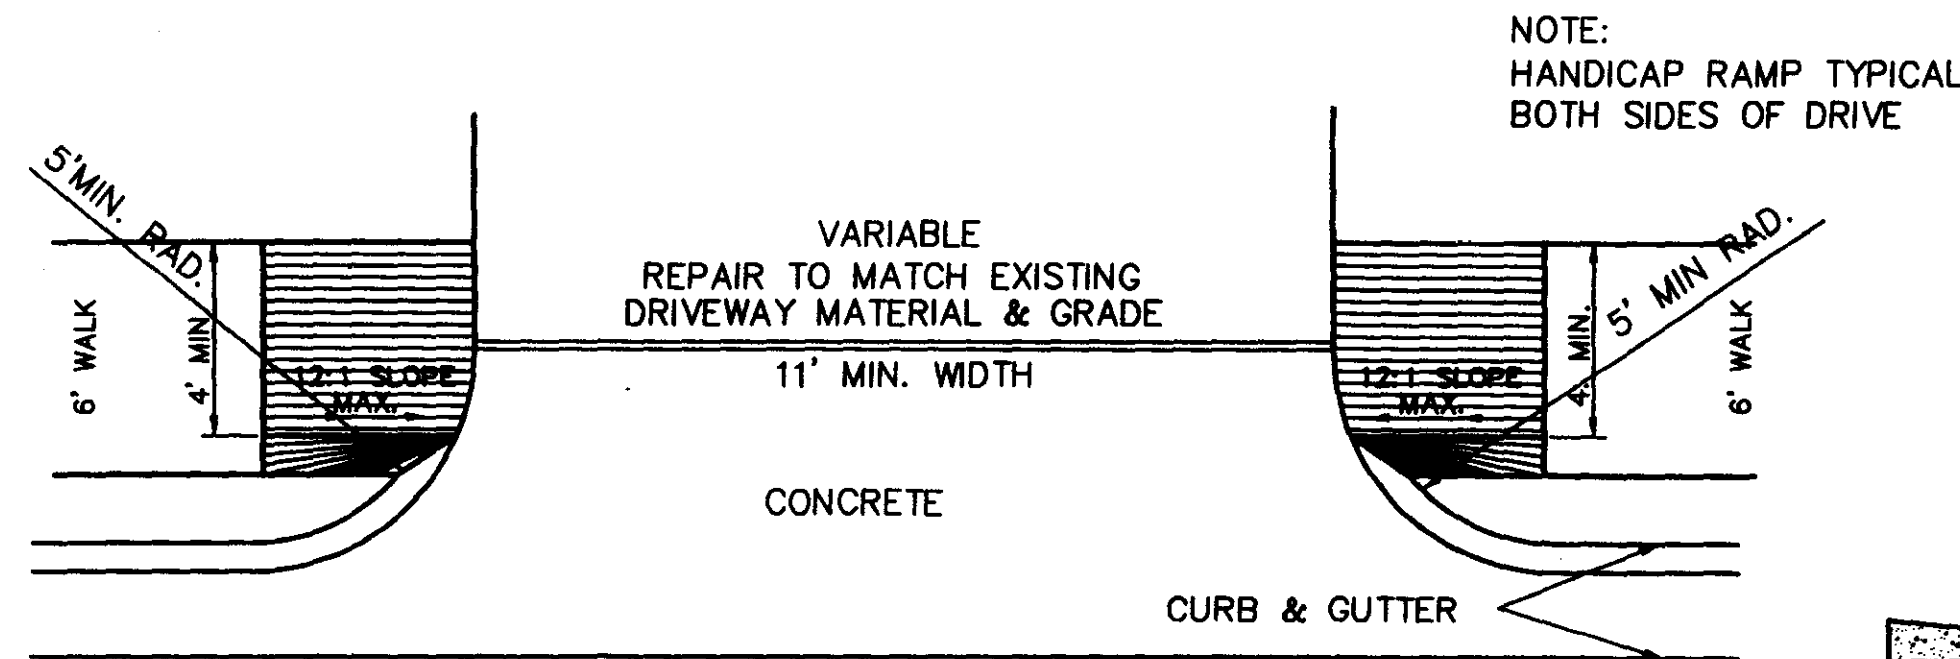

CONCRETE RAMP DETAIL  
N.T.S.

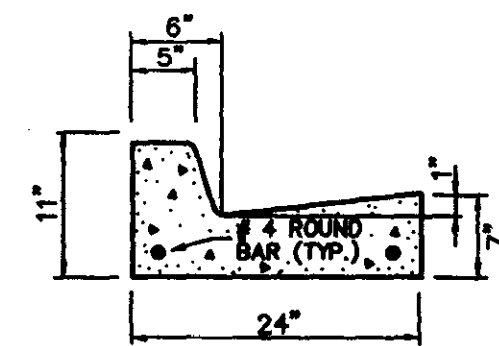


STANDARD CURB & GUTTER DETAIL  
N.T.S.

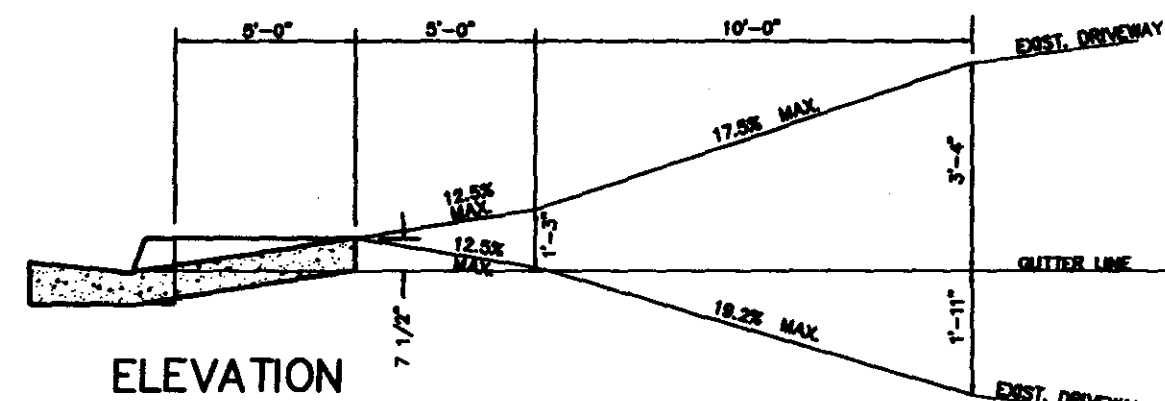


ELEVATION


RECORD DRAWING  
FEBRUARY 1997

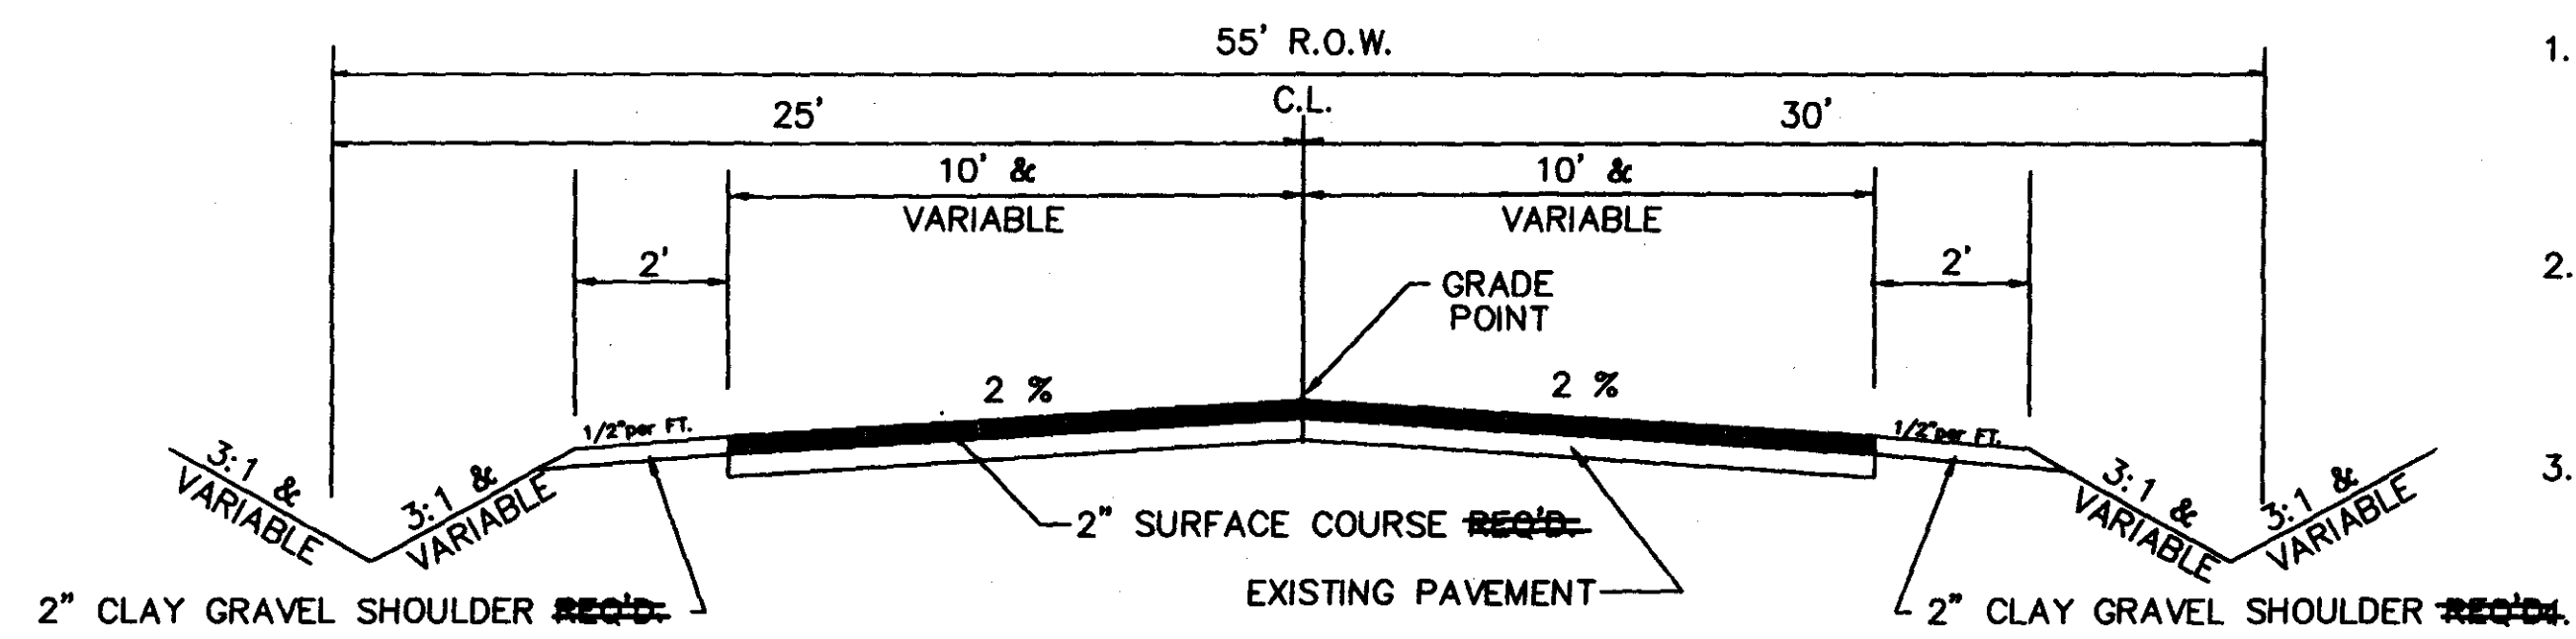


STA. 11+06.00 THRU 16+22.20  
WHEATLEY STREET 2 LANE OVERLAY  
N.T.S.

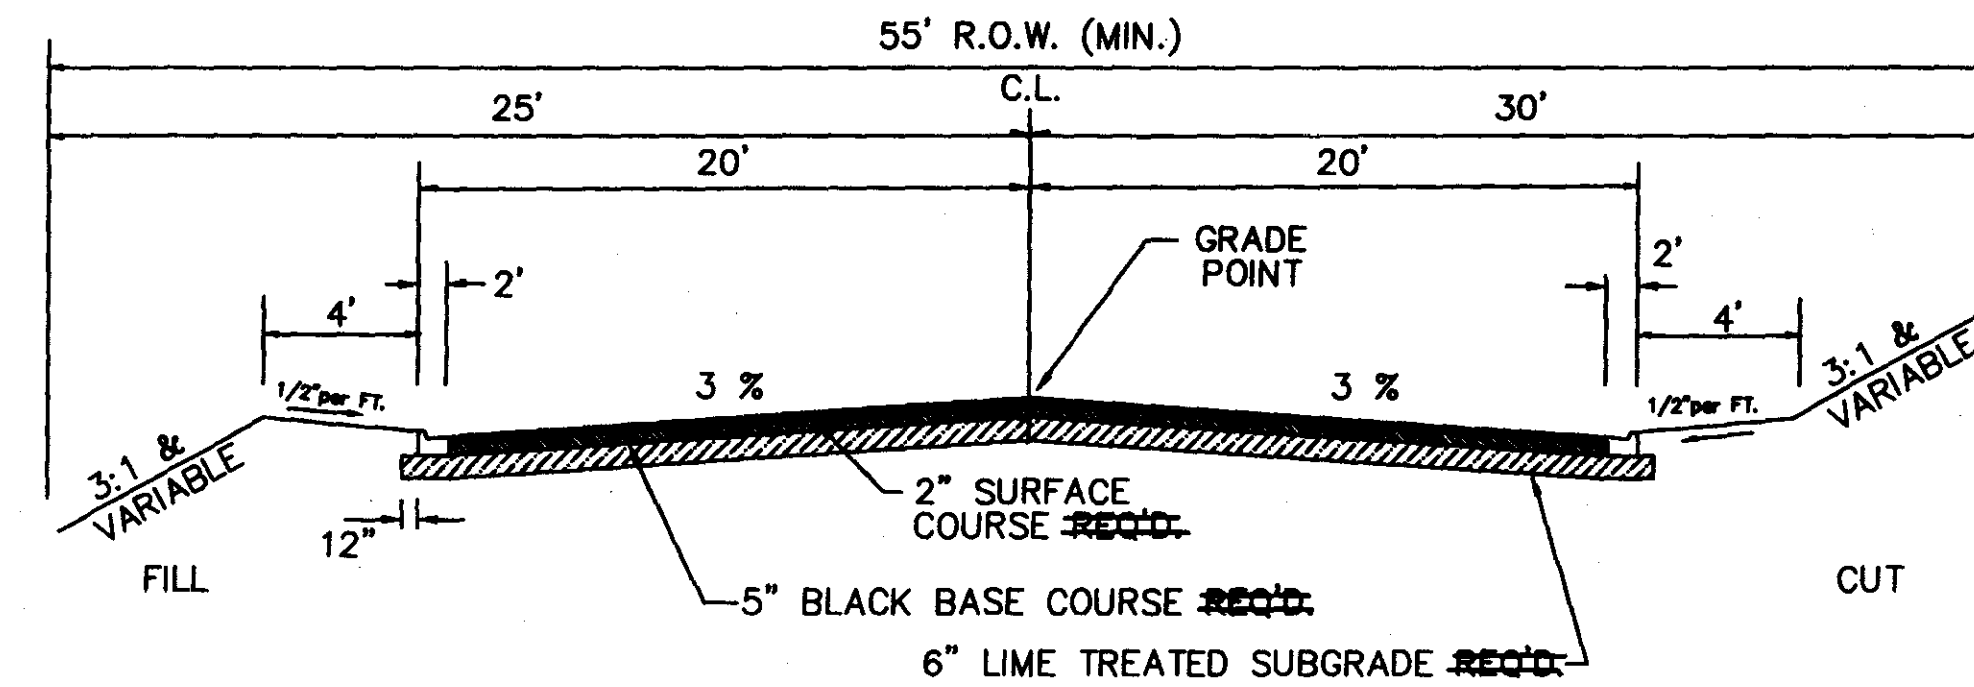

STA. 16+69.56 THRU 23+28  
WHEATLEY STREET 3 LANE  
N.T.S.

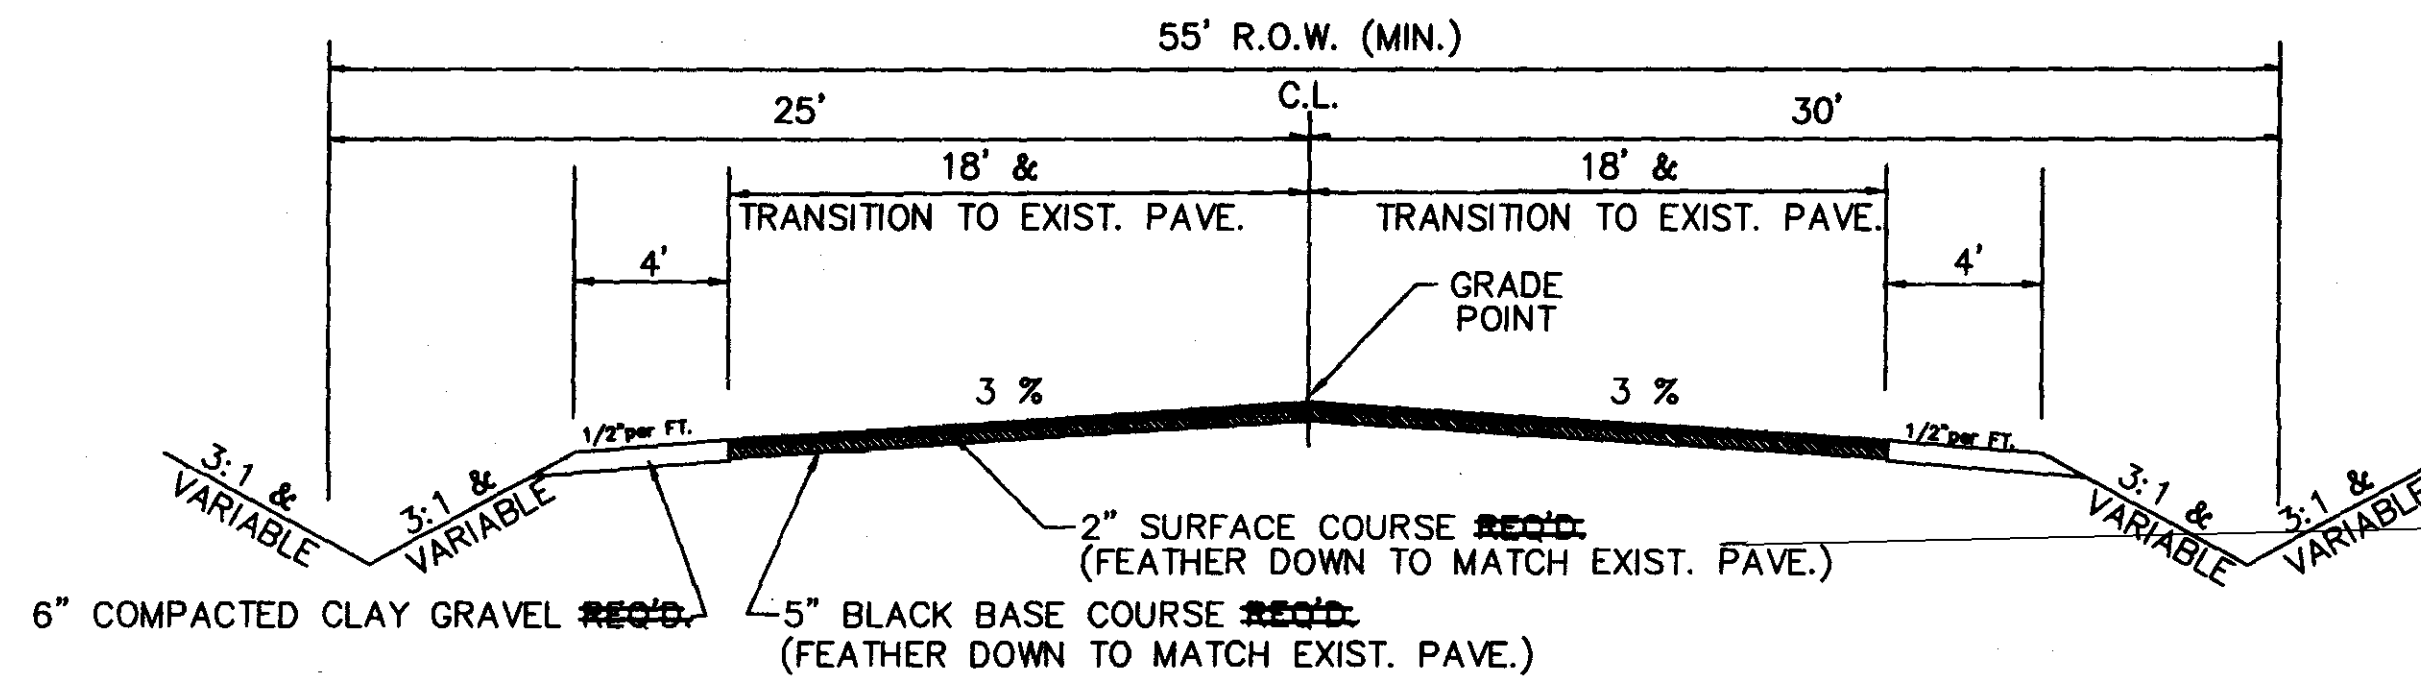

STA. 23+28 THRU 24+58.09  
WHEATLEY STREET TRANSITION  
N.T.S.

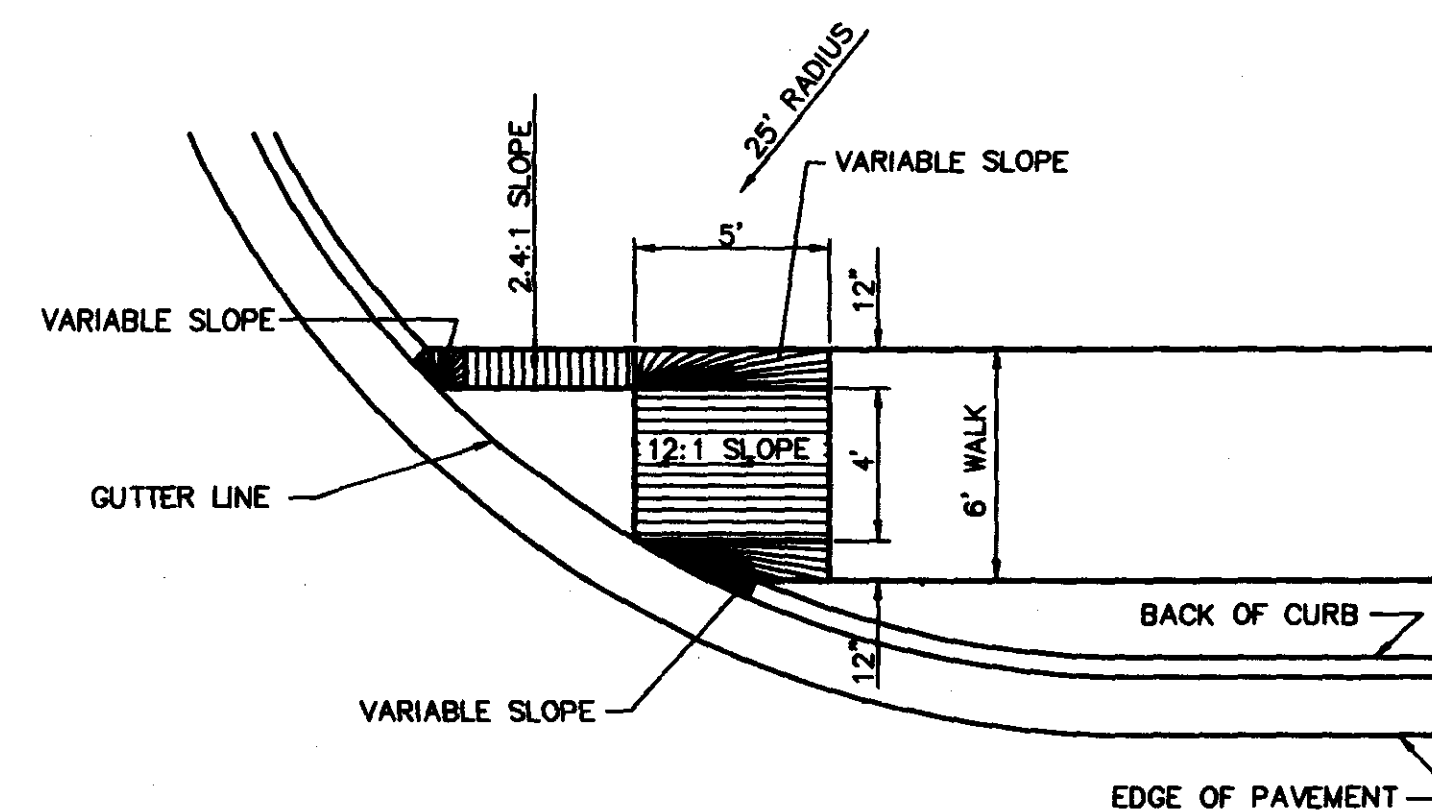

HANDICAP RAMP DETAIL  
N.T.S.

GENERAL CONSTRUCTION NOTES

- The existing utility locations shown on the Drawings are approximate only. The Contractor shall coordinate the location (horizontal and vertical) of existing utilities (power, telephone, gas, water, sewer, etc.) with the appropriate utility company before construction begins.
- Utility lines or service lines encountered during construction, whether shown on the Drawings or not, shall be protected by the Contractor and repairs necessary due to damage to same by the Contractor shall be at no additional cost to the Owner.
- The Contractor shall be responsible for verifying horizontal and vertical clearance requirements for utility service crossings before installation.
- The Contractor shall fertilize and seed all areas where the existing vegetation was removed or disturbed during construction and not required to be solid sodded, paved, graveled or landscaped.
- Unsuitable bedding, backfill or site subgrade material which may be encountered shall be excavated to the limits required and backfilled with acceptable material to the lines and grades shown on the Drawings.
- TBM's which are or may be in conflict with construction activities shall be relocated by Engineer prior to commencement of construction in the immediate area.
- The Engineer will stake the base line and control points necessary for the required construction staking of the project, one time only. Detailed construction staking will be by Contractor at no cost to the Owner.
- The Contractor shall be responsible for completing all sampling and testing of materials incorporated into the project and for submission of same to Engineer for review. Prior use test results, manufacturer's certificates, or proposed mix designs shall be submitted to the Engineer for review before incorporation into project. This shall include backfill, concrete, asphalt, steel, paint, piping, fencing materials, aggregates, seed and other items as specified by the Engineer. All testing shall be an absorbed cost item.
- Sanitary sewer, storm sewer and water main reach lengths may be varied during construction of project to conform to normal pipe joint lengths.
- Existing sanitary manhole tops, water valves, valve boxes, meters or other related appurtenances shall, when required, be adjusted to finished grade by Contractor as an absorbed cost of the work. Castings shall be salvaged for the Owner by the Contractor.
- Testing certifications shall state that the subject material meets the specified quality, grade, purity, class or weight, or that the subject material meets or exceeds the requirement of the applicable ASTM, AASHTO, MDOT or other standards. Certifications shall be submitted to the Engineer prior to incorporation of the subject material into the project.
- Existing fences shall be removed and replaced with the same type material as used for the original. Unless otherwise stated on the Bid Form, fence removal/replacement shall be an absorbed cost item.
- Traffic signs or delineators required under this Contract shall be constructed and installed in accordance with the Project Drawings and the MISSISSIPPI STANDARD SPECIFICATIONS FOR ROAD AND BRIDGE CONSTRUCTION, MDOT, 1990 EDITION as if said standards were written out herein in full. Measurement and Payment for traffic signs and delineators shall be as specified on the Bid Form. The reflective sheeting material used for construction of STOP signs shall be "Diamond Back" as manufactured by the 3-M Company.
- Traffic Control Plan shall be implemented only as it conforms with the requirements stated in Section J, Section 1, Project Supplemental General Conditions.
- Cut zones for sanitary sewer or water mains, where applicable, shall be measured from the original ground profile or proposed grade, whichever is less.
- Asphalt surface course(s) shall be placed a minimum of six (6) months after the asphalt base course(s) have been installed.

REVISED 1-18-96  
REVISED 1-20-95

CITY OF RIDGELAND, MISSISSIPPI

TYPICAL STREET SECTIONS

EAST SCHOOL STREET /  
WHEATLEY STREET RECONSTRUCTION


WAGGONER ENGINEERING, INC.  
Consulting Engineers - Jackson, Mississippi

DRAWN BY: A.R.P. & R.C. DATE: APRIL 95 SHEET NUMBER

REVIEWED BY: SCALE: AS SHOWN 7 OF 14

C:921171/VPSC2



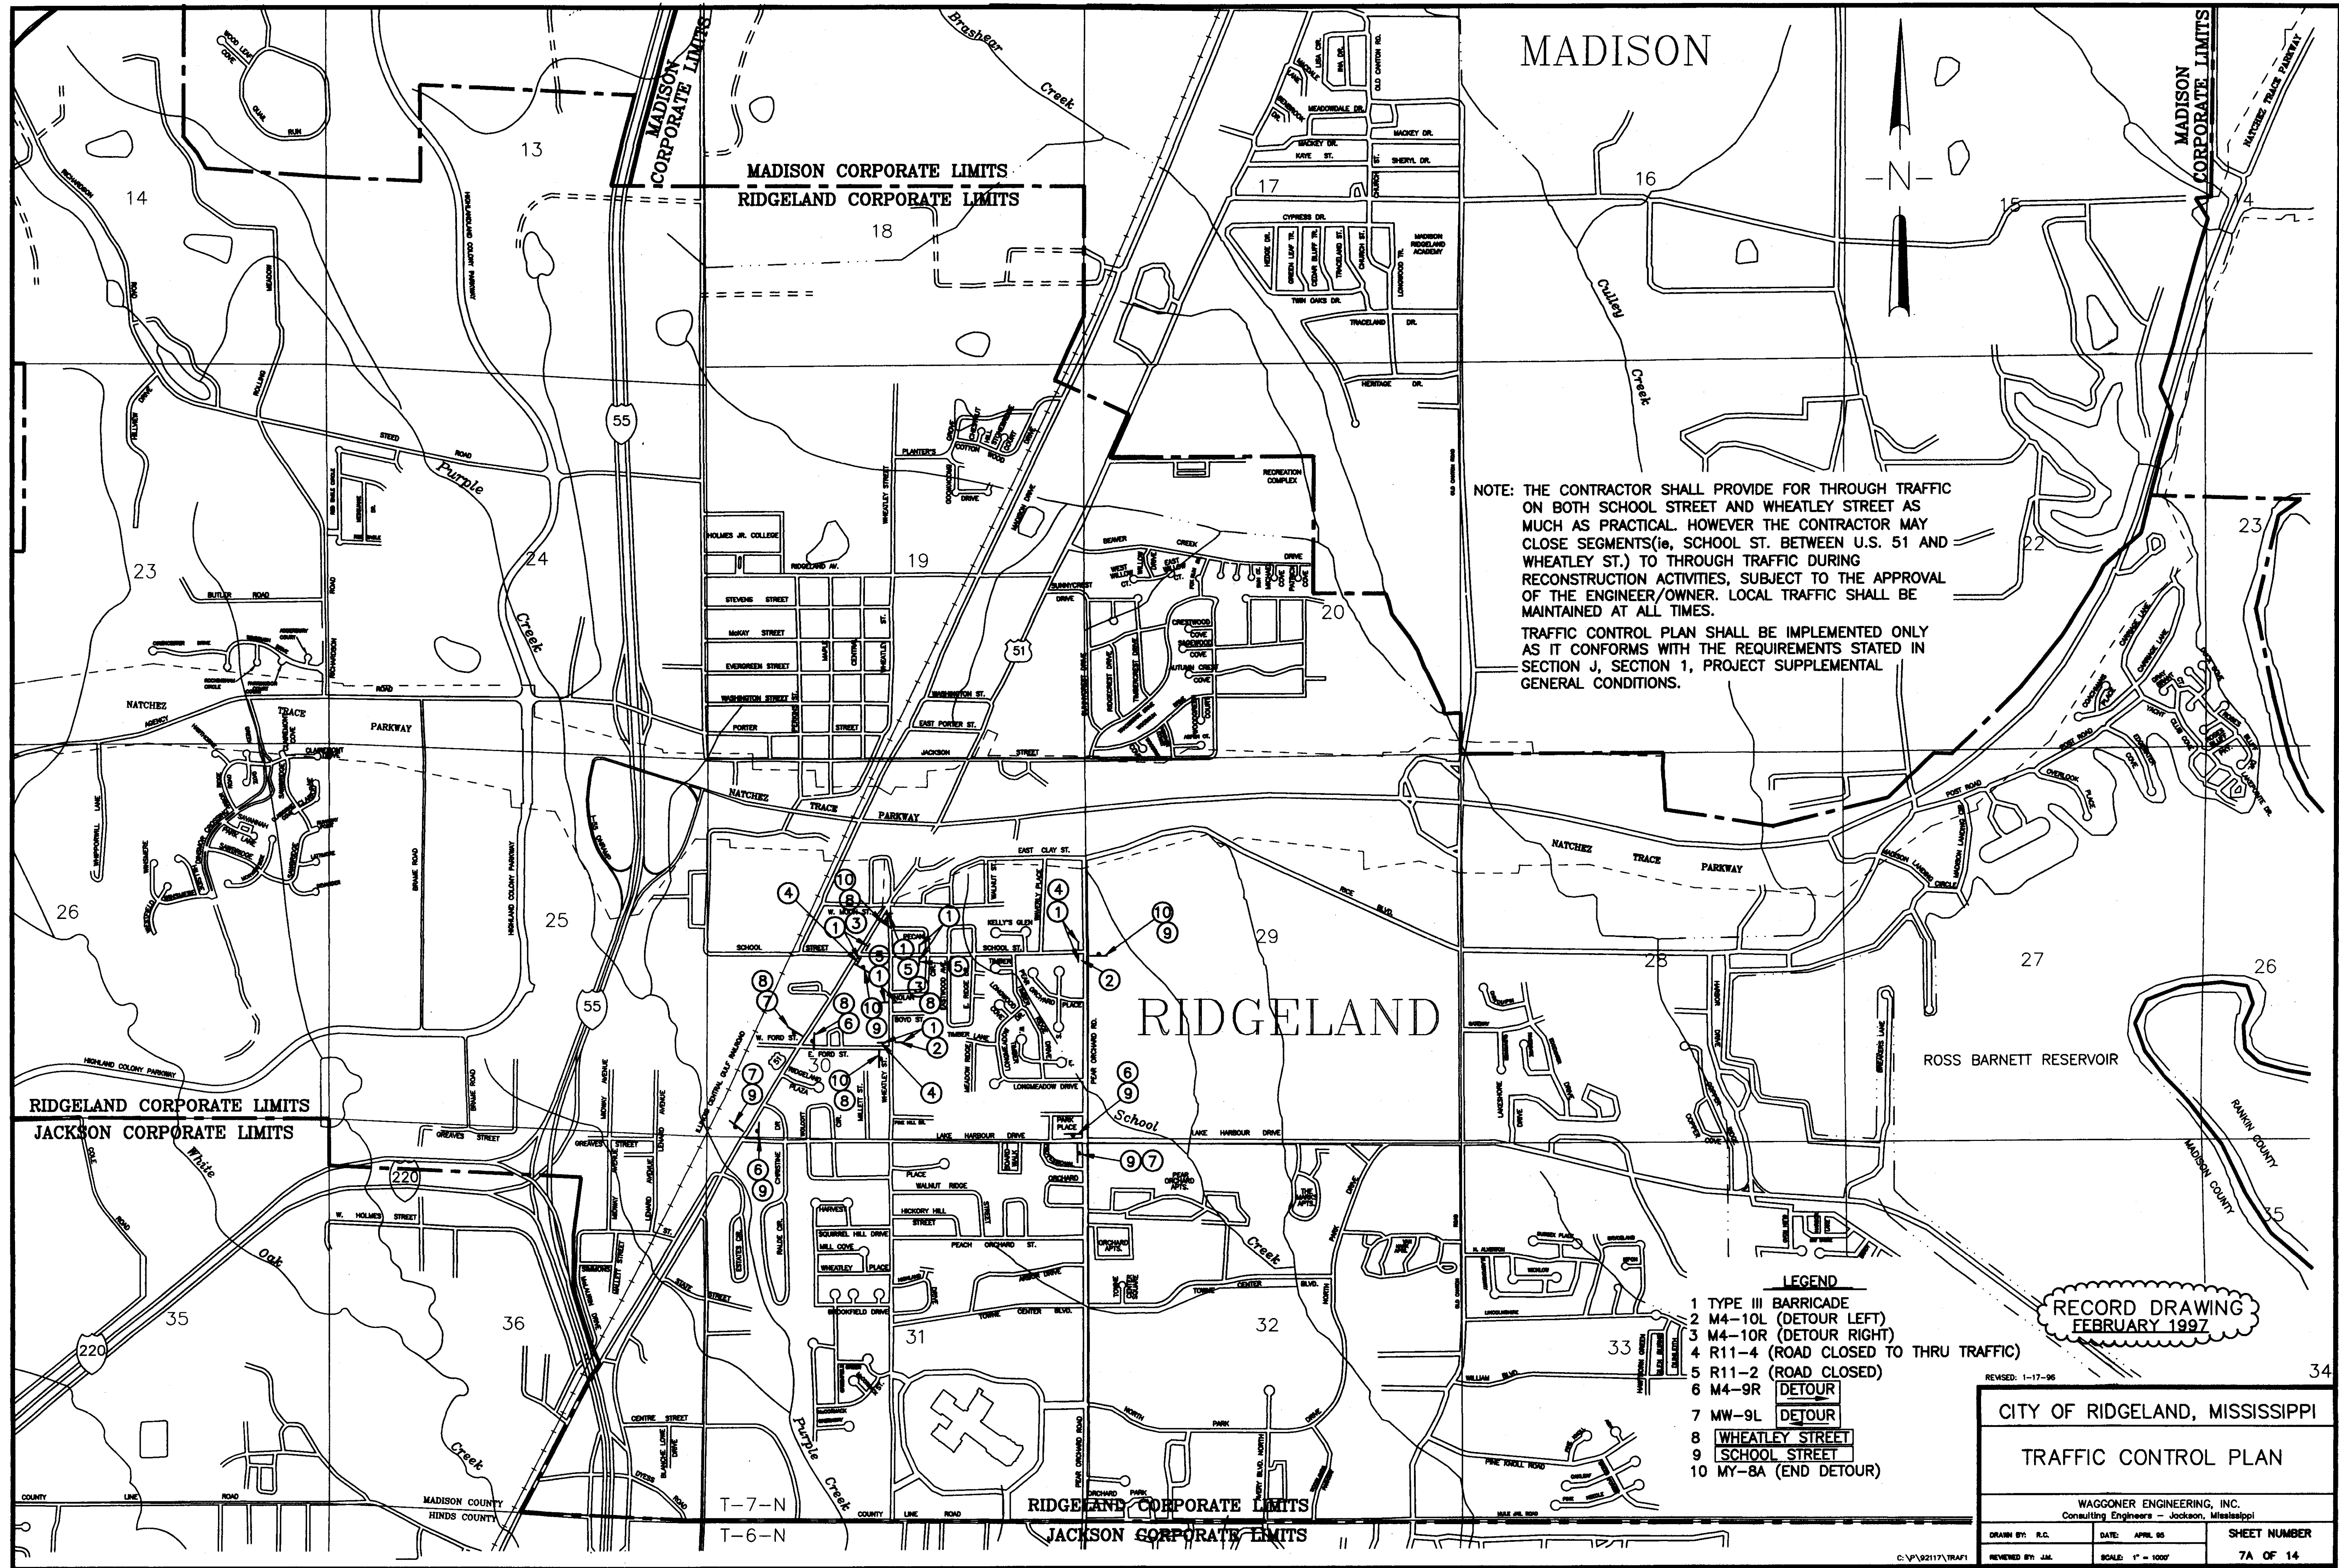

MADISON

MADISON CORPORATE LIMITS  
RIDGELAND CORPORATE LIMITS

NOTE: THE CONTRACTOR SHALL PROVIDE FOR THROUGH TRAFFIC ON BOTH SCHOOL STREET AND WHEATLEY STREET AS MUCH AS PRACTICAL. HOWEVER THE CONTRACTOR MAY CLOSE SEGMENTS (i.e. SCHOOL ST. BETWEEN U.S. 51 AND WHEATLEY ST.) TO THROUGH TRAFFIC DURING RECONSTRUCTION ACTIVITIES, SUBJECT TO THE APPROVAL OF THE ENGINEER/OWNER. LOCAL TRAFFIC SHALL BE MAINTAINED AT ALL TIMES.

TRAFFIC CONTROL PLAN SHALL BE IMPLEMENTED ONLY AS IT CONFORMS WITH THE REQUIREMENTS STATED IN SECTION J, SECTION 1, PROJECT SUPPLEMENTAL GENERAL CONDITIONS.

RIDGELAND

RIDGELAND CORPORATE LIMITS  
JACKSON CORPORATE LIMITS

ROSS BARNETT RESERVOIR

LEGEND

- 1 TYPE III BARRICADE
- 2 M4-10L (DETOUR LEFT)
- 3 M4-10R (DETOUR RIGHT)
- 4 R11-4 (ROAD CLOSED TO THRU TRAFFIC)
- 5 R11-2 (ROAD CLOSED)
- 6 M4-9R DETOUR
- 7 MW-9L DETOUR
- 8 WHEATLEY STREET
- 9 SCHOOL STREET
- 10 MY-8A (END DETOUR)

RECORD DRAWING  
FEBRUARY 1997

REVISED: 1-17-96

CITY OF RIDGELAND, MISSISSIPPI



TRAFFIC CONTROL PLAN

WAGGONER ENGINEERING, INC.  
Consulting Engineers - Jackson, Mississippi

DRAWN BY: R.C.	DATE: APRIL 95	SHEET NUMBER
REVIEWED BY: J.M.	SCALE: 1" = 1000'	7A OF 14

C:\P\2117\TRAF1

C:\P\9217\STRIP22 Mod Jul 23 11:39:53 1997  
 HP Desjardet 7556M 7556M HP-GL/2 devices v3.1. ADI 4.2 -by HP

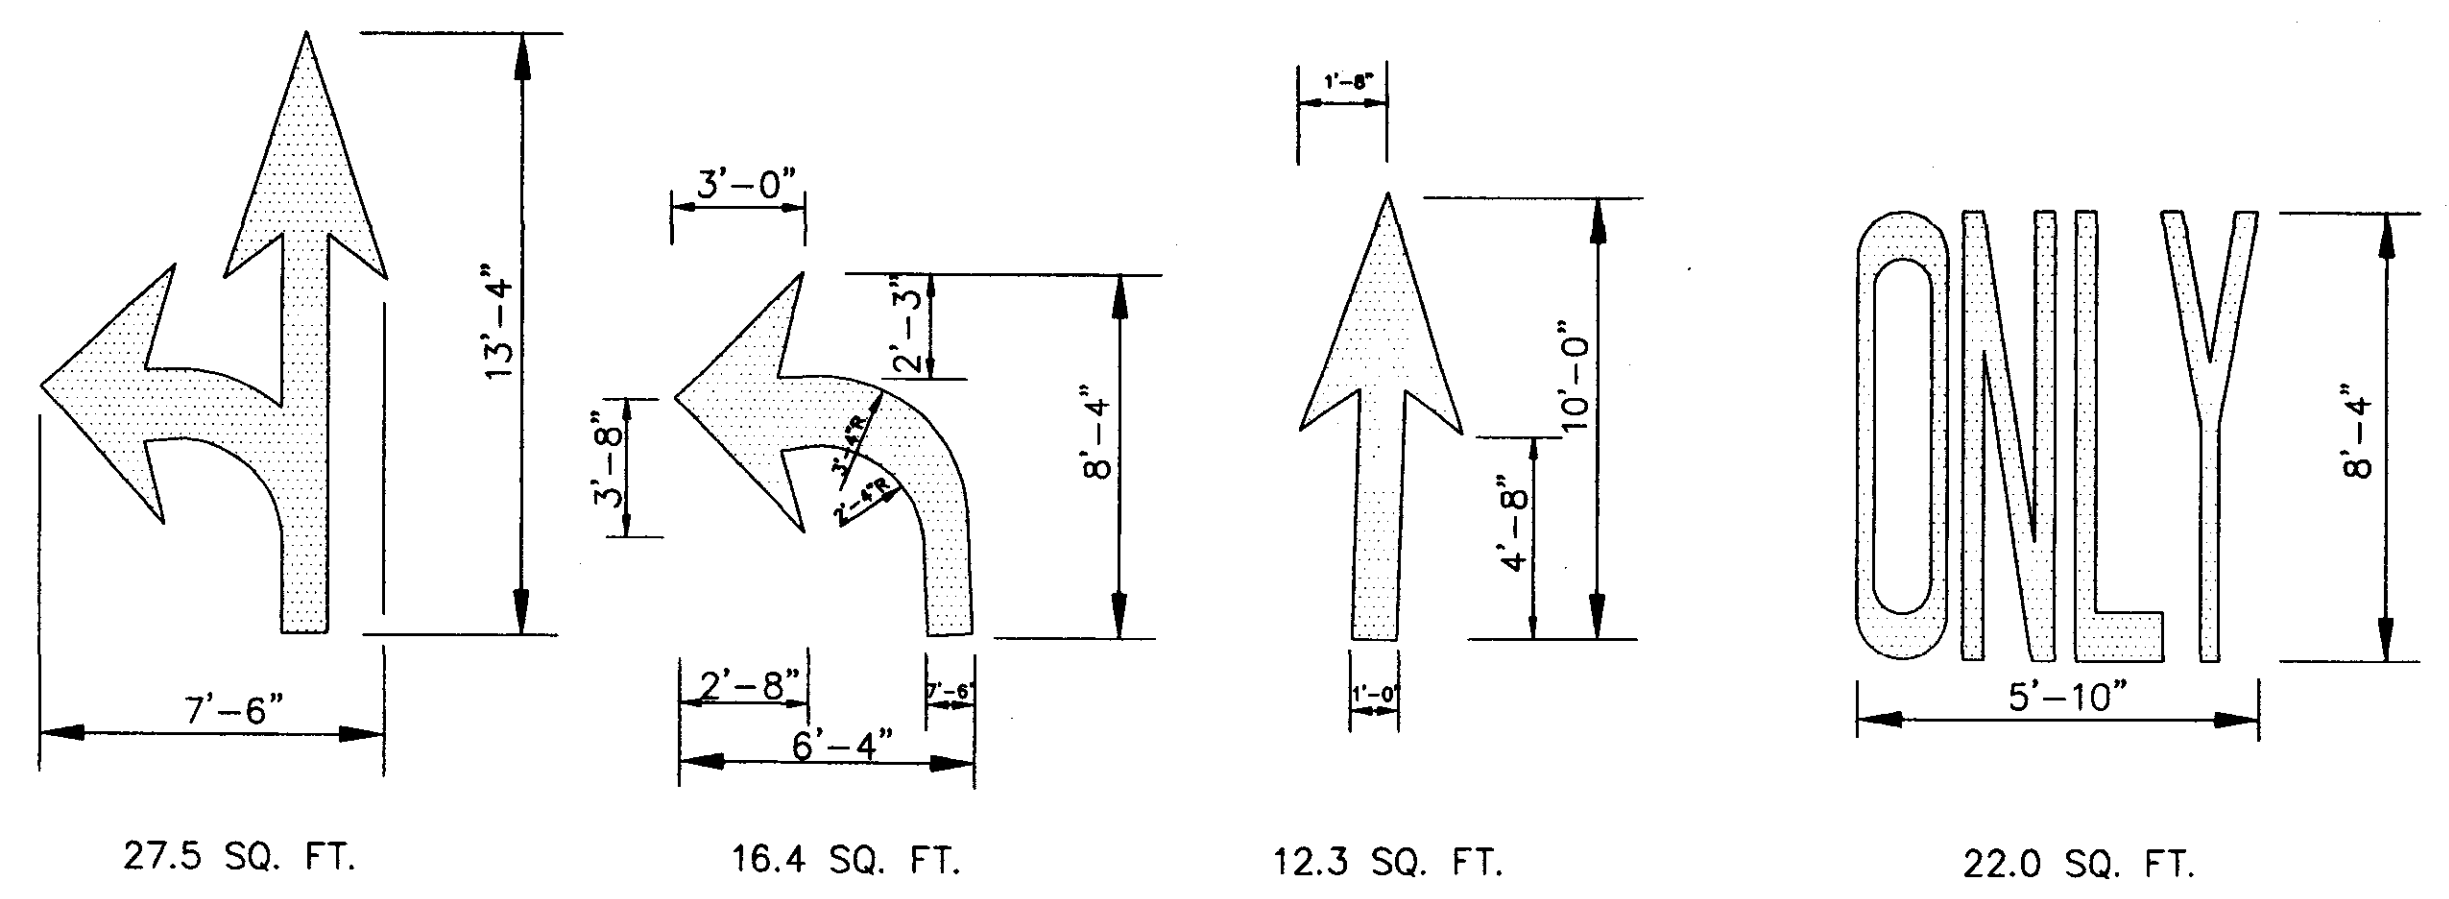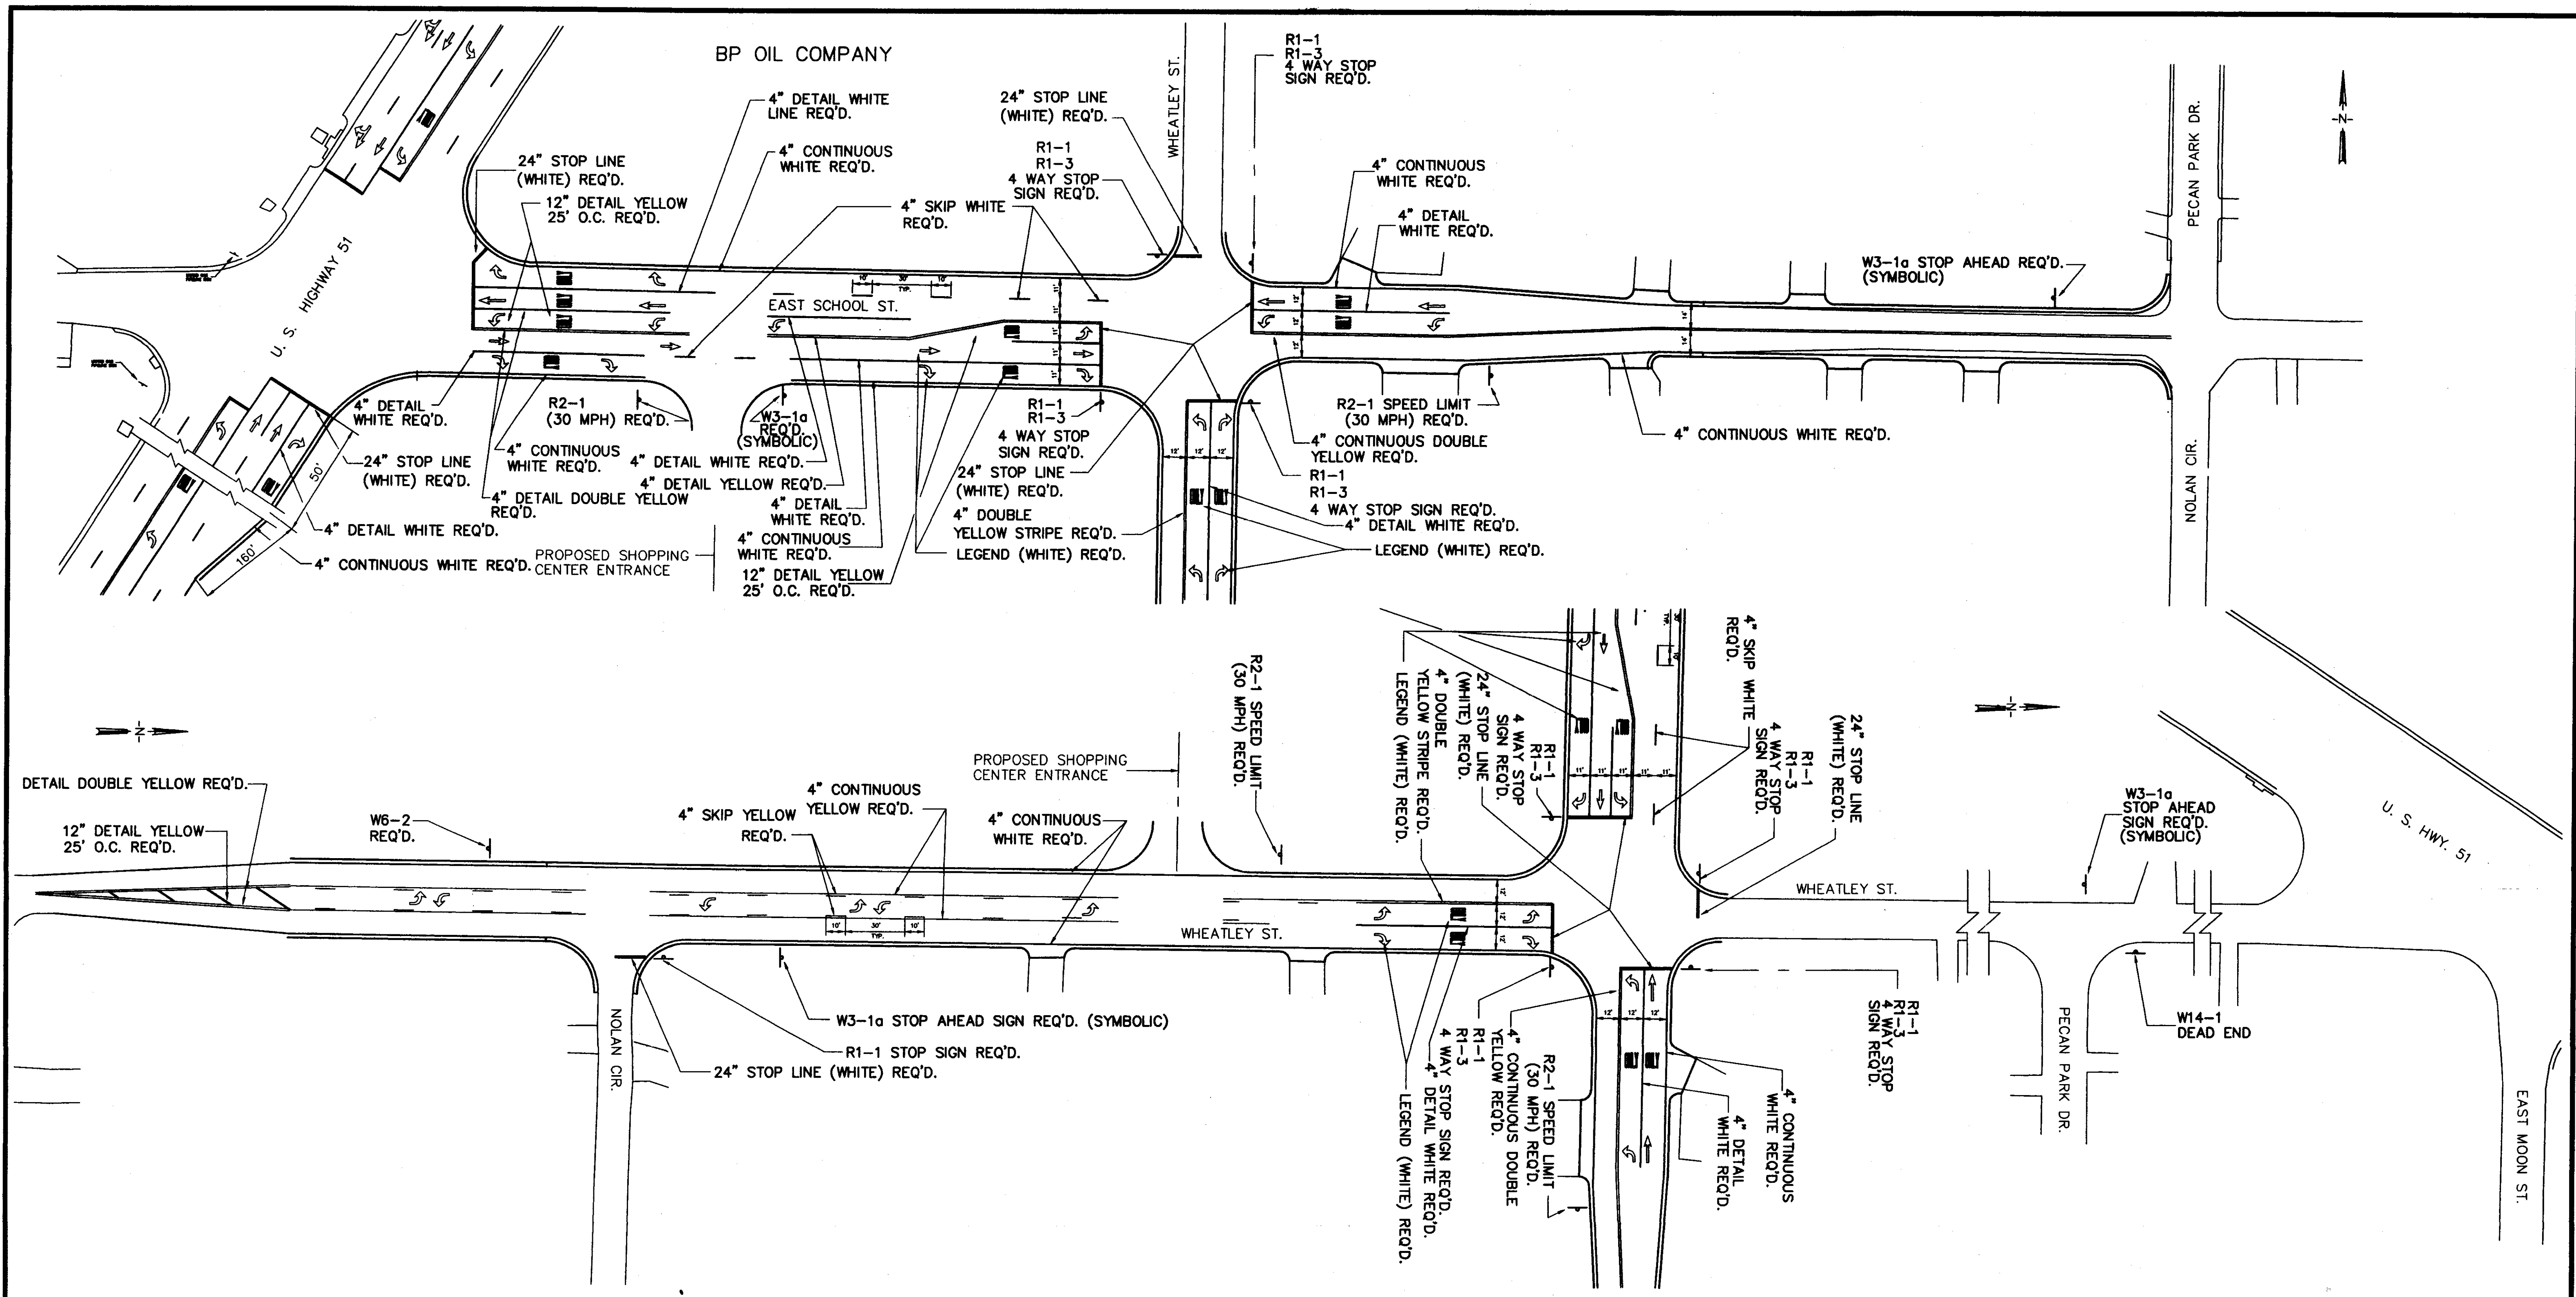

LEGEND DETAILS

- NOTES
1. ALL TEMPORARY CENTERLINE, LEGENDS AND STOP LINES ARE TO BE PAINT MEETING THE MINIMUM REQUIREMENTS AS SPECIFIED IN THE MISS. STANDARD SPECIFICATIONS FOR ROAD AND BRIDGE CONSTRUCTION, 1990 EDITION. NO EDGE STRIPE REQUIRED FOR THE TEMPORARY PHASE.
  2. ALL PERMANENT EDGE AND CENTERLINE STRIPING TO BE THERMOPLASTIC MEETING THE MINIMUM REQUIREMENTS AS SPECIFIED IN THE MISS. STANDARD SPECIFICATIONS FOR ROAD AND BRIDGE CONSTRUCTION, 1990 EDITION.
  3. ALL PERMANENT "LEGENDS" AND STOP LINES ARE TO BE 3M STAMARK OR APPROVED EQUAL.
  4. ALL TRAFFIC CONTROL REGULATORY AND WARNING SIGNS SHALL BE PLACED IN ACCORDANCE WITH THE MOST RECENTLY PUBLISHED MANUAL ON UNIFORM TRAFFIC CONTROL DEVICES.
  5. ALL R1-1 (STOP) SIGNS ARE TO HAVE A DIAMOND GRADE FINISH.  
ALL OTHER REGULATORY SIGNS ARE TO HAVE ENCAPSULATED LENS (HIGH INTENSITY) SHEETING AS SPECIFIED IN THE MISS. STANDARD SPECIFICATIONS FOR ROAD AND BRIDGE CONSTRUCTION.
  6. ALL PERMANENT TRAFFIC SIGNING SHALL BE PLACED PRIOR TO AND DURING THE PLACEMENT OF THE TEMPORARY STRIPING.

RECORD DRAWING  
 FEBRUARY 1997


CITY OF RIDGELAND			
SCHOOL STREET IMPROVEMENTS			
STRIPING PLAN			
WAGGONER ENGINEERING, INC. Consulting Engineers - Jackson, Mississippi			
DRAWN BY: J.W.P.	DATE: APRIL 95	SHEET NUMBER	
REVIEWED BY: B.W.	SCALE: 1" = 40'	8 OF 14	

9217/STRIP2(1)




DETECTOR ASSIGNMENT SUMMARY							COMMENTS
DETECTOR NUMBER	LOOP SIZE	PEDESTRIAN PUSH BUTTON	PHASE CALLED	DELAY TIME (SEC.)	PRESENCE MODE	PULSE MODE	
2A,2B	6'x 6'		6			X	EXIST. 1.7 SEC. WIRED IN SERIES TO SAME CHANNEL
2C	6'x 50'		1		X		10.0 SEC. DELAY
4A	6'x 50'		4		X		
4B	6'x 60'		4		X		
6A	6'x 50'		5		X		10.0 SEC. DELAY
6B,6C	6'x 6'		2			X	EXIST. 1.7 SEC. WIRED IN SERIES TO SAME CHANNEL
8A	6'x 50'		8		X		
8B	6'x 10'		8		X		12.0 SEC. DELAY

LOCATION	MAST ARM LENGTH	LOCATION ( FROM POLE - FT)		
		SIGNAL HEADS	EMERGENCY VEHICLE DETECTOR	SIGNS
SE QUADRANT	35'	0', 22', 33'	34'	15'
NE QUADRANT	50'	0', 22', 37', 47'	29.5'	18', 47'
SW QUADRANT	36'	25.5', 35.5'		31'

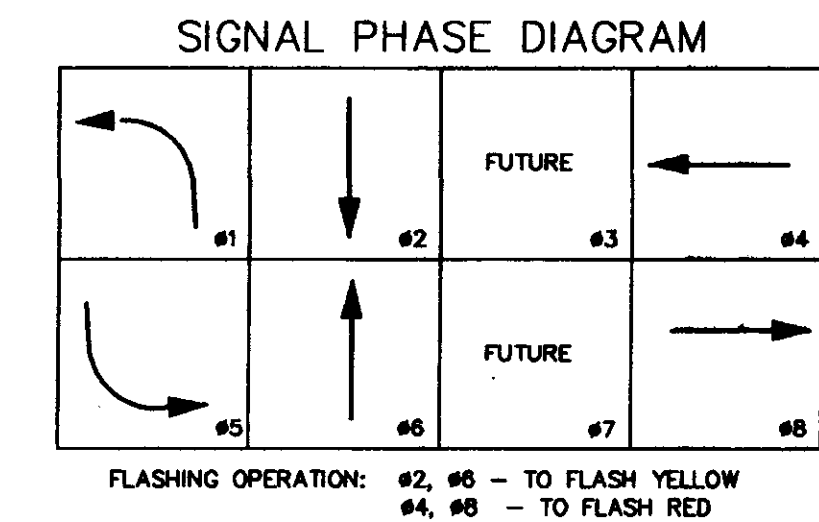


SIGNAL HEADS & SIGNS

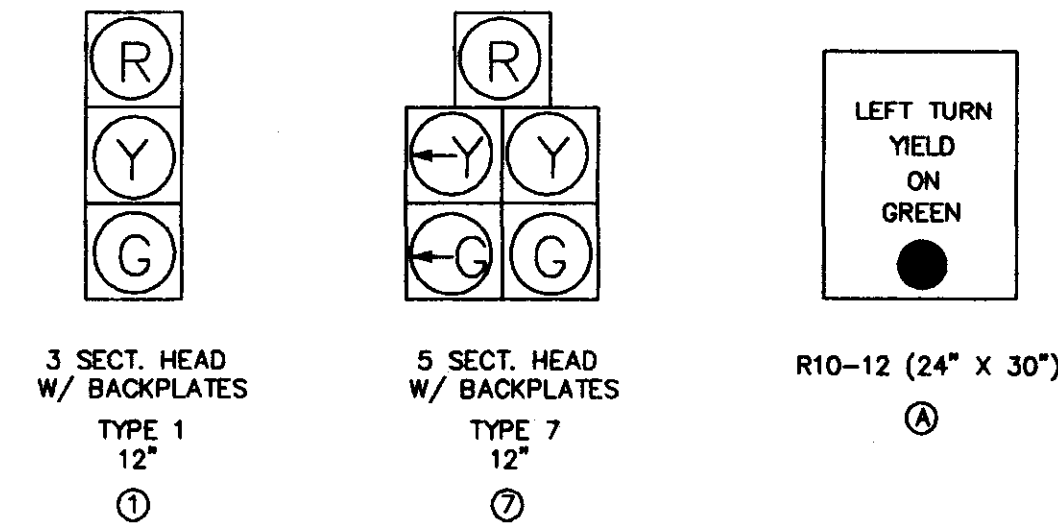

WEST SCHOOL STREET


RELOCATE EXIST. TYPE 1 SIGNAL HEADS AS SHOWN

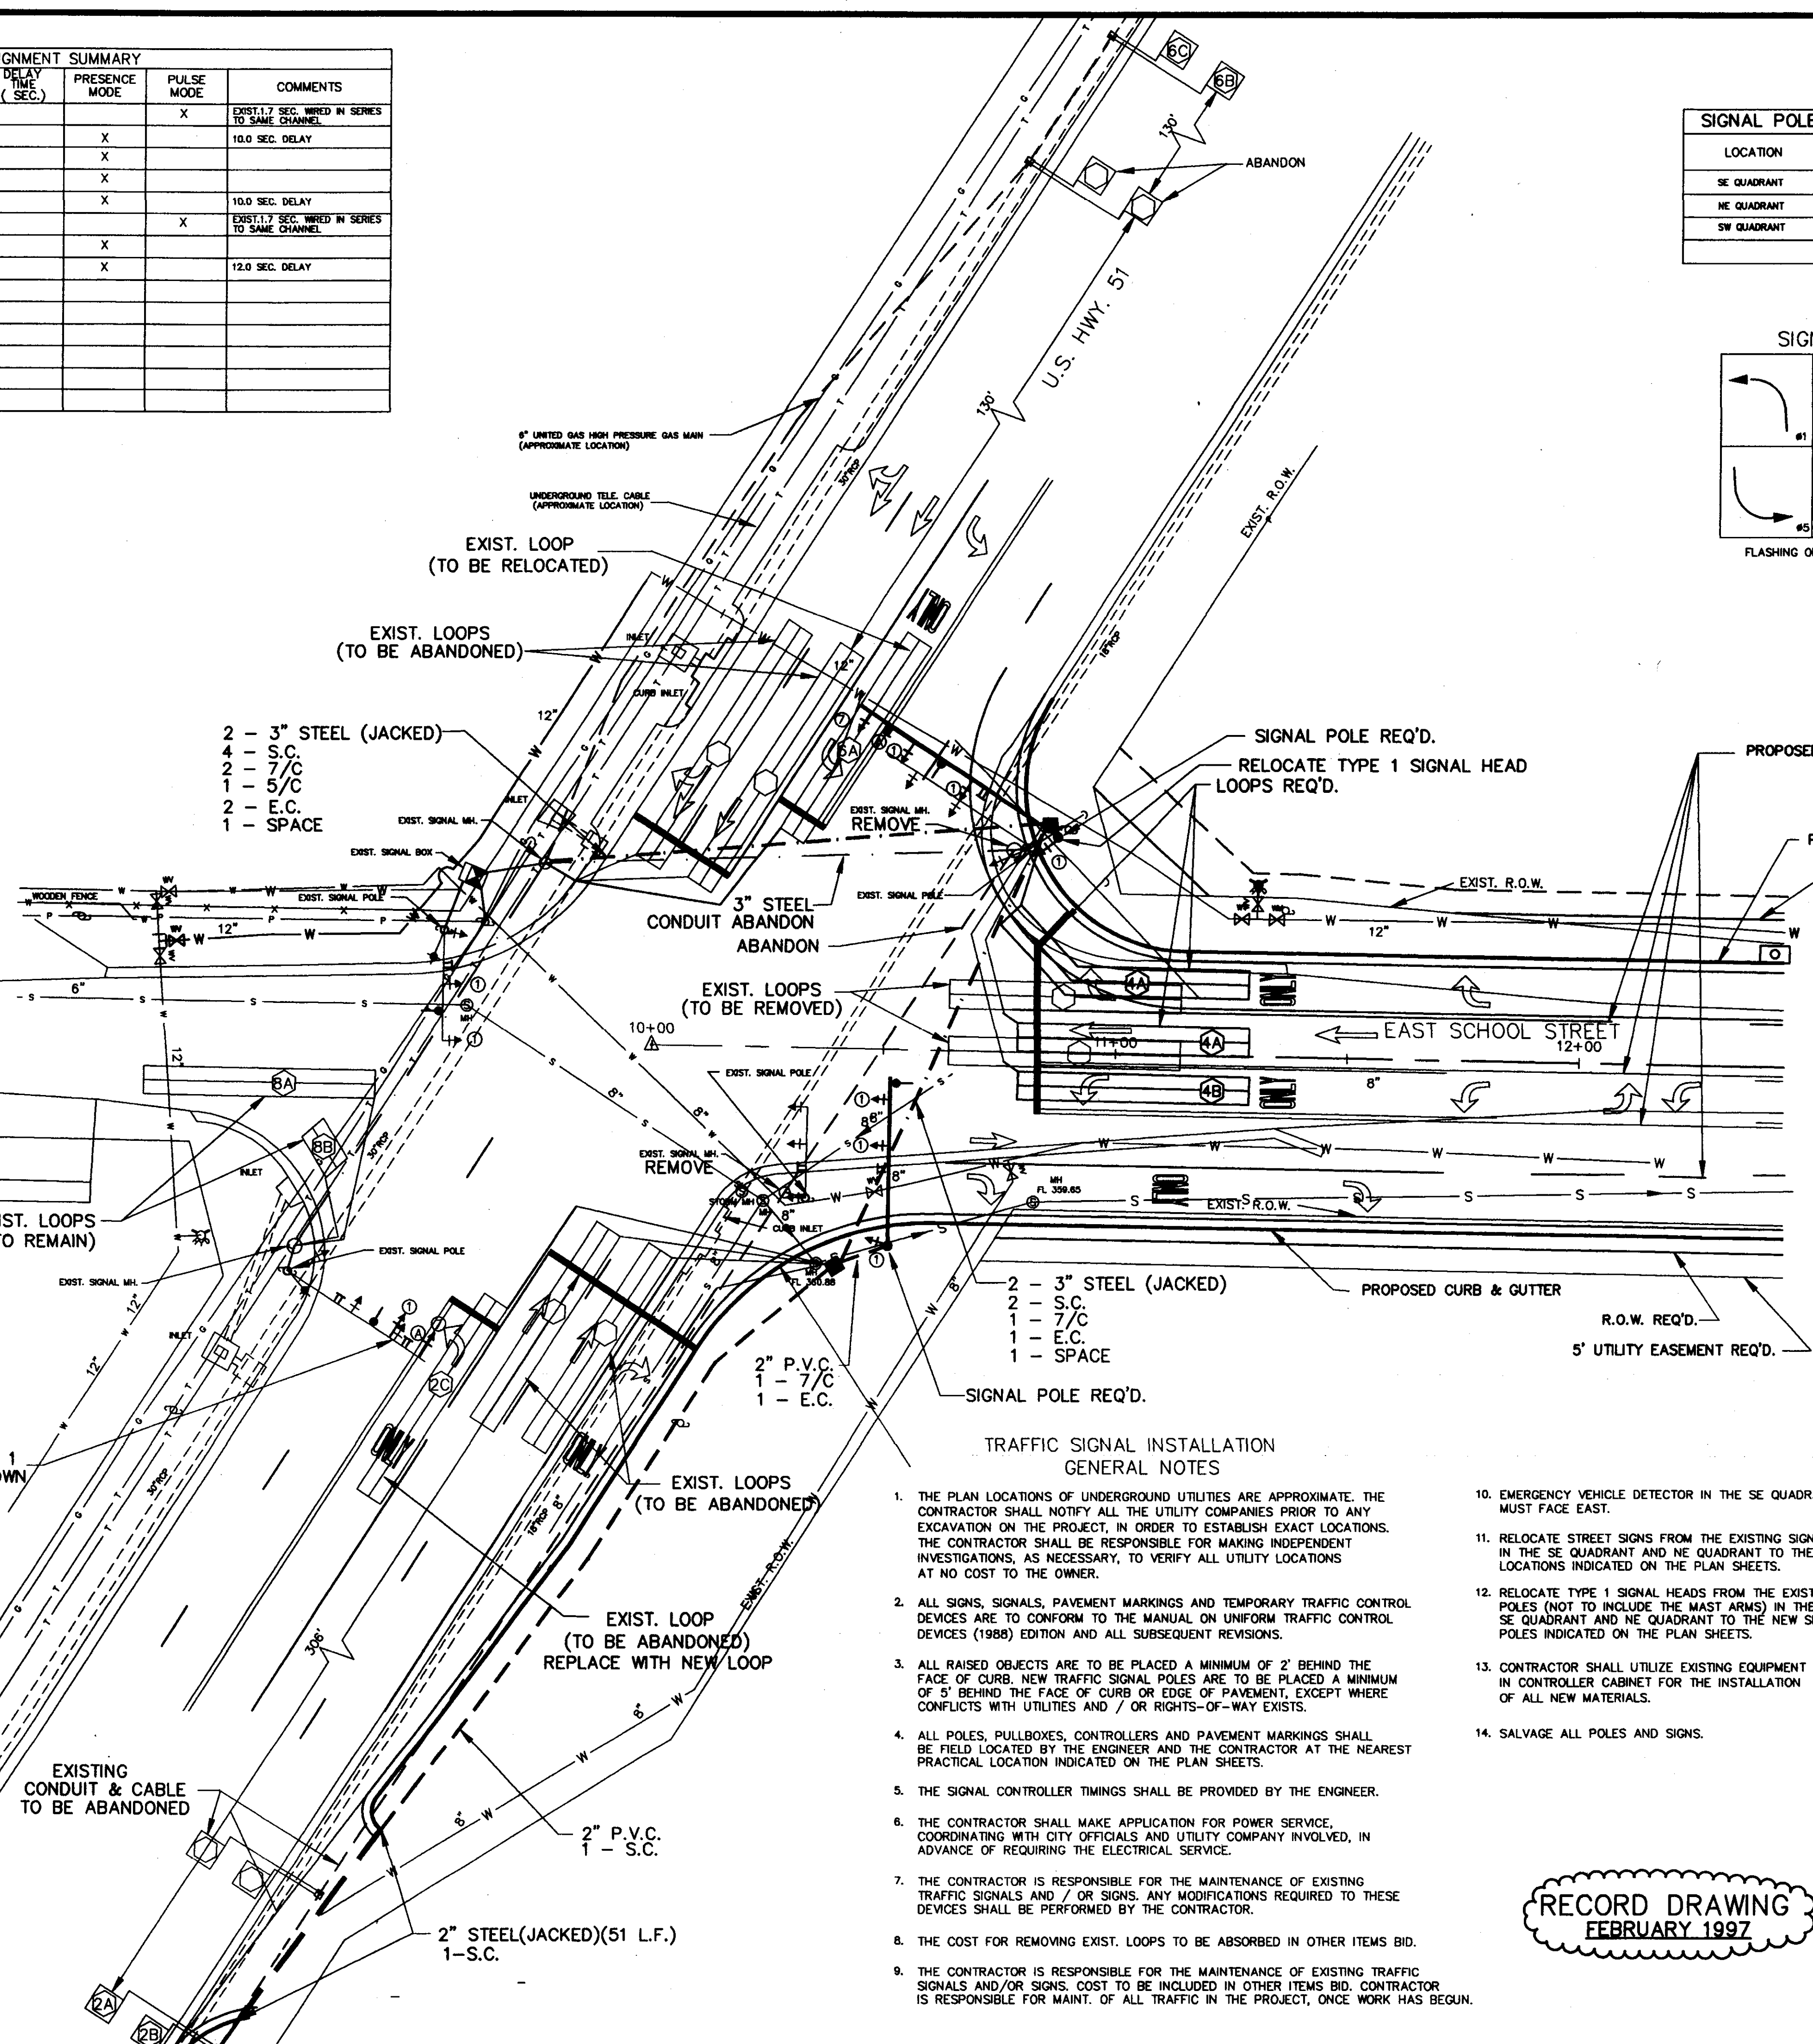

LEGEND

- CONTROLLER AND CABINET
- TYPE 1 PULLBOX
- TYPE 2 PULLBOX
- LUMINAIRE
- NEW MAST ARM POLE
- NEW PEDESTAL POLE
- EXISTING UTILITY POLE
- TRAFFIC SIGNAL HEAD w/ BACKPLATE
- NEW PEDESTRIAN SIGNAL
- OR — OVERHEAD SIGN / STREET NAME SIGN
- OR — VEHICLE LOOP DETECTOR
- P.B. PEDESTRIAN PUSHBUTTON
- 5/C 5 CONDUCTOR SIGNAL CABLE - AWG #14
- 7/C 7 CONDUCTOR SIGNAL CABLE - AWG #14
- S.C. SHIELDED CABLE ( 2 CONDUCTOR - AWG #14 )
- POW POWER CABLE ( 1 CONDUCTOR - AWG #6 )
- LUM STREET LIGHT CABLE AWG ( 1 CONDUCTOR - AWG #10 )
- CONDUIT RUN
- CONDUIT RUN ( JACKED )
- GUY ANCHOR
- EMERGENCY VEHICLE DETECTOR
- E.C. EMERGENCY VEHICLE CABLE ( 3 CONDUCTOR AWG #20 )

TURNING MOVEMENT COUNTS 1985

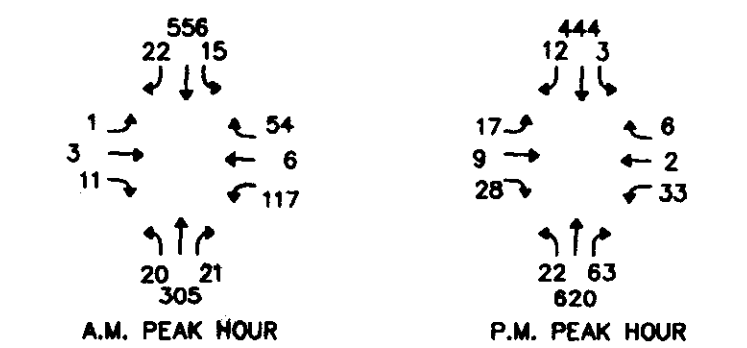

TRAFFIC SIGNAL INSTALLATION GENERAL NOTES

- THE PLAN LOCATIONS OF UNDERGROUND UTILITIES ARE APPROXIMATE. THE CONTRACTOR SHALL NOTIFY ALL THE UTILITY COMPANIES PRIOR TO ANY EXCAVATION ON THE PROJECT, IN ORDER TO ESTABLISH EXACT LOCATIONS. THE CONTRACTOR SHALL BE RESPONSIBLE FOR MAKING INDEPENDENT INVESTIGATIONS, AS NECESSARY, TO VERIFY ALL UTILITY LOCATIONS AT NO COST TO THE OWNER.
- ALL SIGNS, SIGNALS, PAVEMENT MARKINGS AND TEMPORARY TRAFFIC CONTROL DEVICES ARE TO CONFORM TO THE MANUAL ON UNIFORM TRAFFIC CONTROL DEVICES (1988) EDITION AND ALL SUBSEQUENT REVISIONS.
- ALL RAISED OBJECTS ARE TO BE PLACED A MINIMUM OF 2' BEHIND THE FACE OF CURB. NEW TRAFFIC SIGNAL POLES ARE TO BE PLACED A MINIMUM OF 5' BEHIND THE FACE OF CURB OR EDGE OF PAVEMENT, EXCEPT WHERE CONFLICTS WITH UTILITIES AND / OR RIGHTS-OF-WAY EXISTS.
- ALL POLES, PULLBOXES, CONTROLLERS AND PAVEMENT MARKINGS SHALL BE FIELD LOCATED BY THE ENGINEER AND THE CONTRACTOR AT THE NEAREST PRACTICAL LOCATION INDICATED ON THE PLAN SHEETS.
- THE SIGNAL CONTROLLER TIMINGS SHALL BE PROVIDED BY THE ENGINEER.
- THE CONTRACTOR SHALL MAKE APPLICATION FOR POWER SERVICE, COORDINATING WITH CITY OFFICIALS AND UTILITY COMPANY INVOLVED, IN ADVANCE OF REQUIRING THE ELECTRICAL SERVICE.
- THE CONTRACTOR IS RESPONSIBLE FOR THE MAINTENANCE OF EXISTING TRAFFIC SIGNALS AND / OR SIGNS. ANY MODIFICATIONS REQUIRED TO THESE DEVICES SHALL BE PERFORMED BY THE CONTRACTOR.
- THE COST FOR REMOVING EXIST. LOOPS TO BE ABSORBED IN OTHER ITEMS BID.
- THE CONTRACTOR IS RESPONSIBLE FOR THE MAINTENANCE OF EXISTING TRAFFIC SIGNALS AND/OR SIGNS. COST TO BE INCLUDED IN OTHER ITEMS BID. CONTRACTOR IS RESPONSIBLE FOR MAINT. OF ALL TRAFFIC IN THE PROJECT, ONCE WORK HAS BEGUN.
- EMERGENCY VEHICLE DETECTOR IN THE SE QUADRANT MUST FACE EAST.
- RELOCATE STREET SIGNS FROM THE EXISTING SIGNALS IN THE SE QUADRANT AND NE QUADRANT TO THE NEW LOCATIONS INDICATED ON THE PLAN SHEETS.
- RELOCATE TYPE 1 SIGNAL HEADS FROM THE EXISTING POLES (NOT TO INCLUDE THE MAST ARMS) IN THE SE QUADRANT AND NE QUADRANT TO THE NEW SIGNAL POLES INDICATED ON THE PLAN SHEETS.
- CONTRACTOR SHALL UTILIZE EXISTING EQUIPMENT IN CONTROLLER CABINET FOR THE INSTALLATION OF ALL NEW MATERIALS.
- SALVAGE ALL POLES AND SIGNS.


RECORD DRAWING  
FEBRUARY 1997

SIGNALIZATION  
SCHOOL ST. @ U.S. HWY. 51  
RIDGELAND, MISSISSIPPI


WAGGONER ENGINEERING, INC.  
Consulting Engineers - Jackson, Mississippi

DRAWN BY: DATE: APRIL 95 SHEET NUMBER: 9 OF 14  
REVIEWED BY: SCALE: 1" = 20'


C:\P\9217\5161 Wed Jul 23 10:56:21 1997  
HP DesignJet 7550N 755M1.HPC Hewlett-Packard HP-GL/2 devices v3.1, ADI 4.2 -by HP

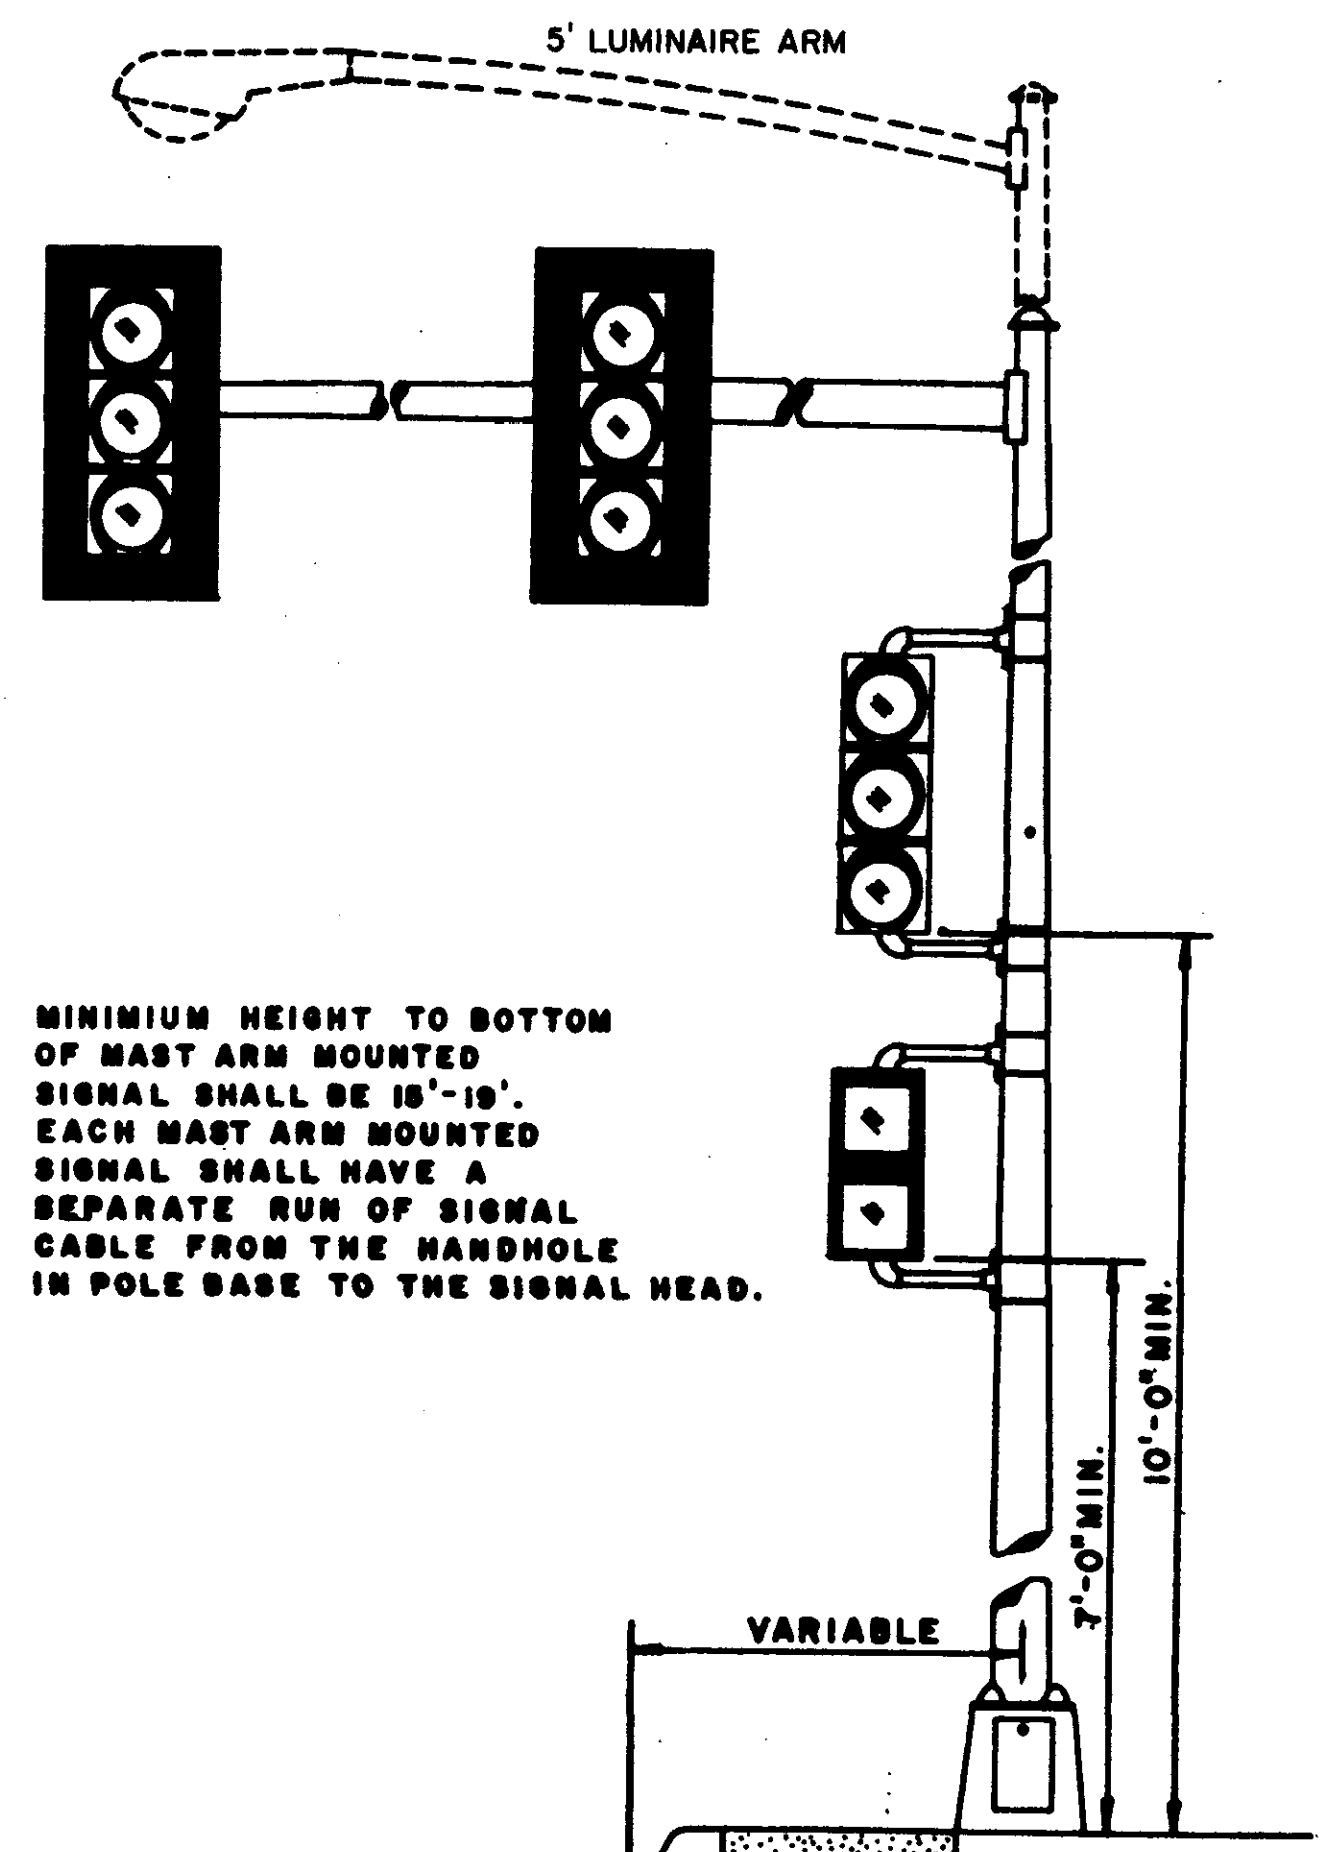


MINIMUM HEIGHT TO BOTTOM OF MAST ARM MOUNTED SIGNAL SHALL BE 18'-19". EACH MAST ARM MOUNTED SIGNAL SHALL HAVE A SEPARATE RUN OF SIGNAL CABLE FROM THE HANDHOLE IN POLE BASE TO THE SIGNAL HEAD.

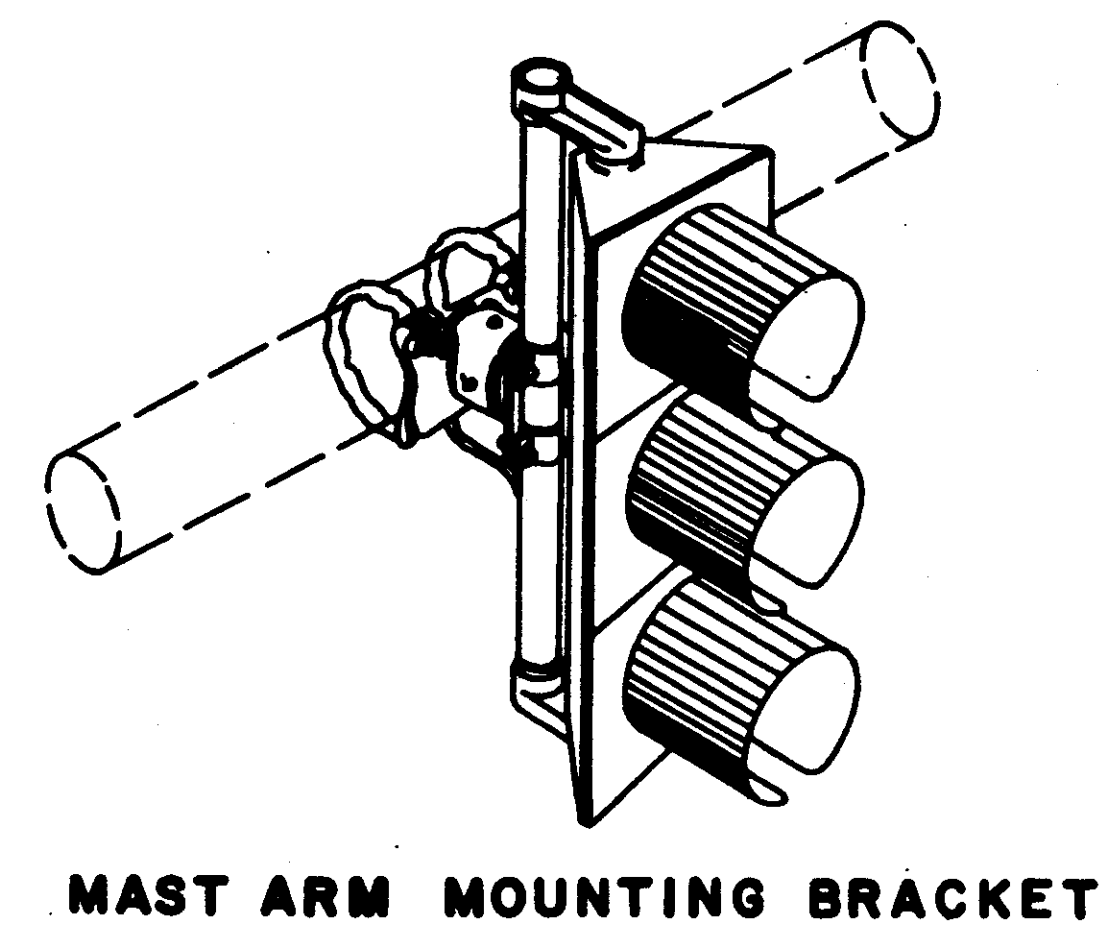


MAST ARM MOUNTING BRACKET

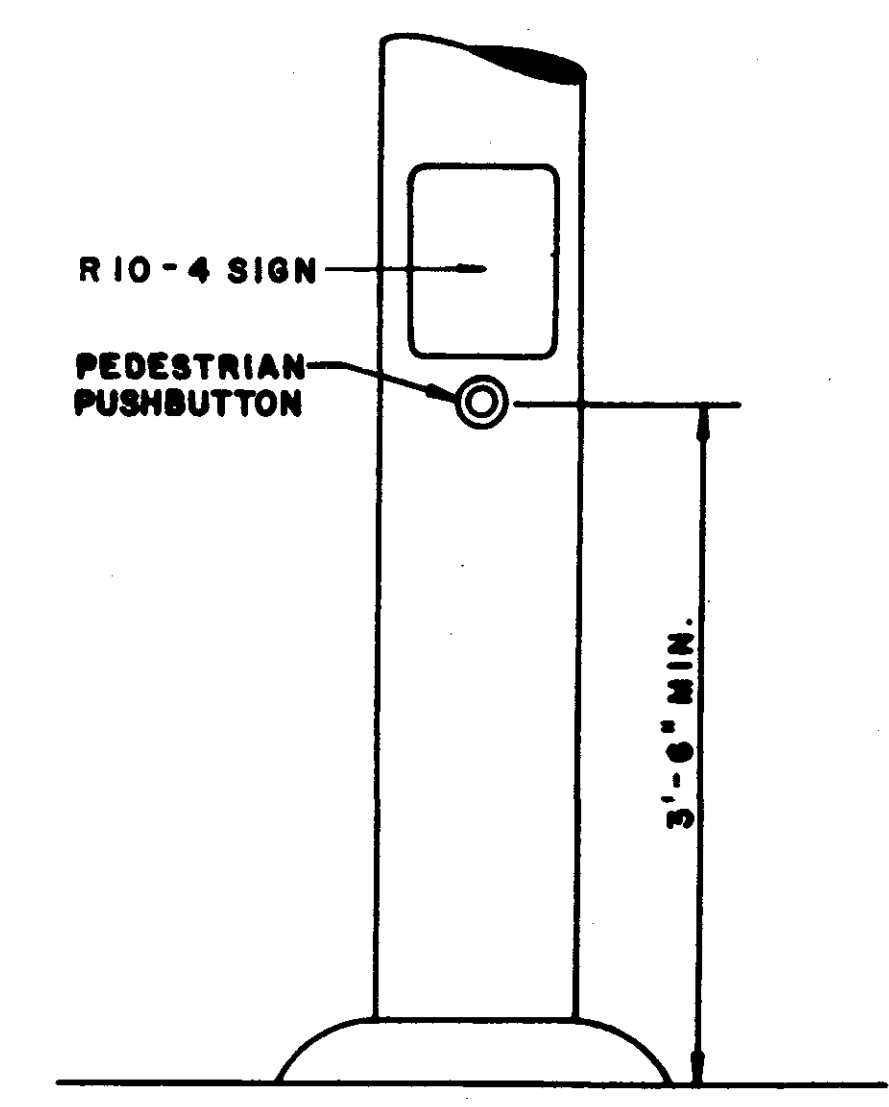



PEDESTRIAN PUSHBUTTON

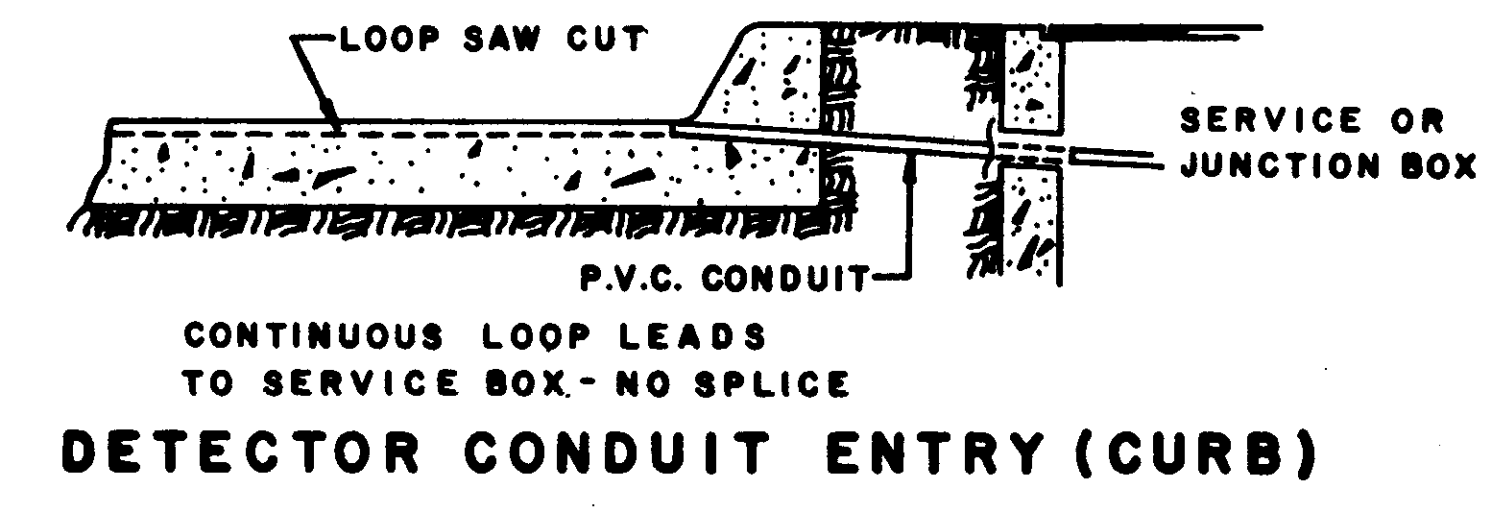


DETECTOR CONDUIT ENTRY (CURB)

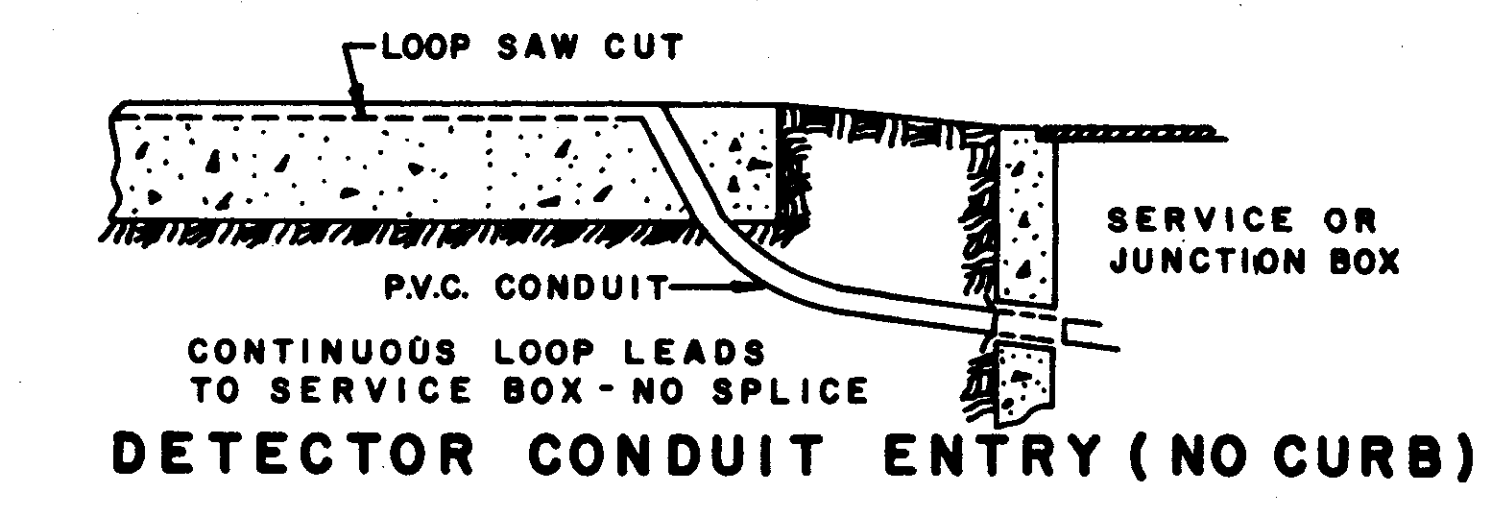


DETECTOR CONDUIT ENTRY (NO CURB)

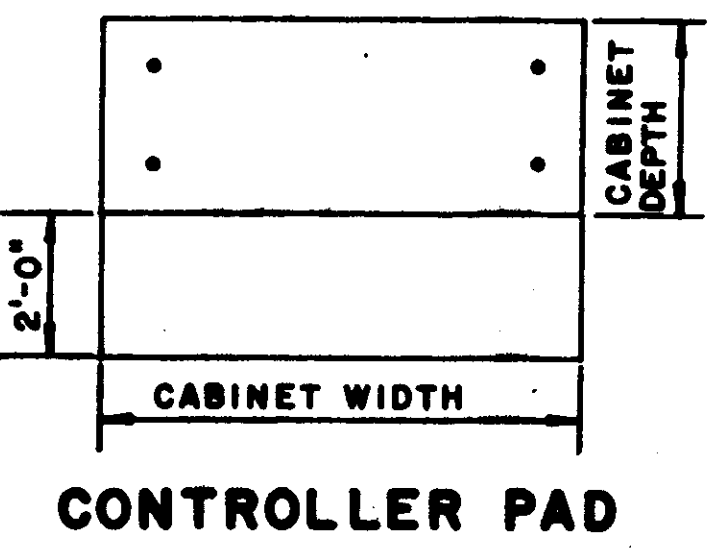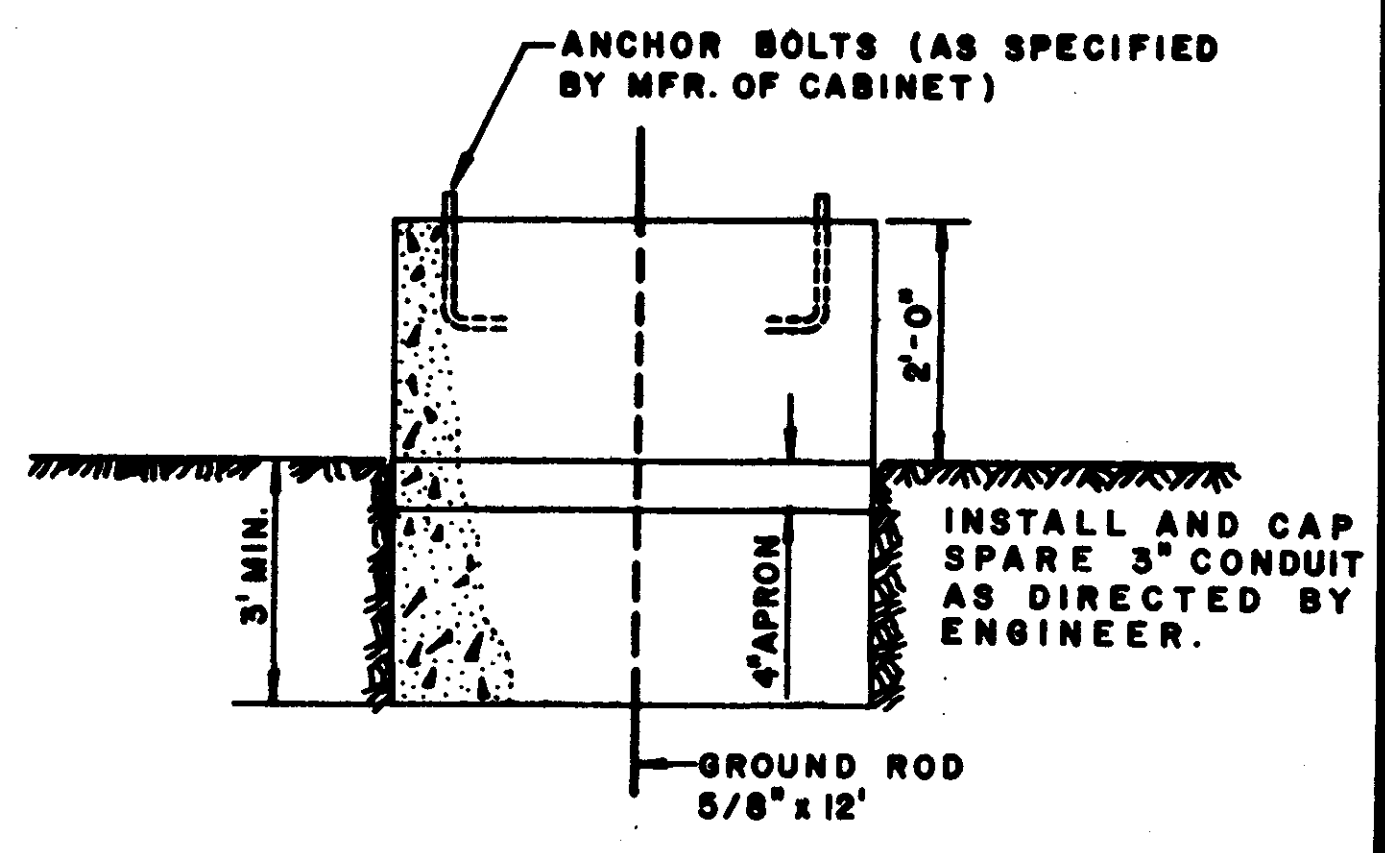

CONTROLLER PAD

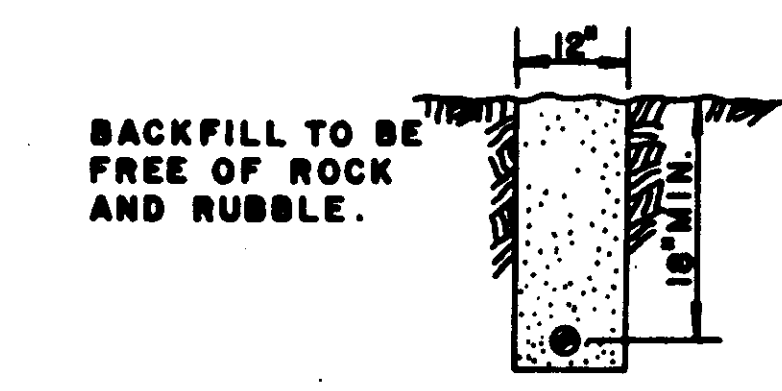


TRENCHING IN UNPAVED AREAS

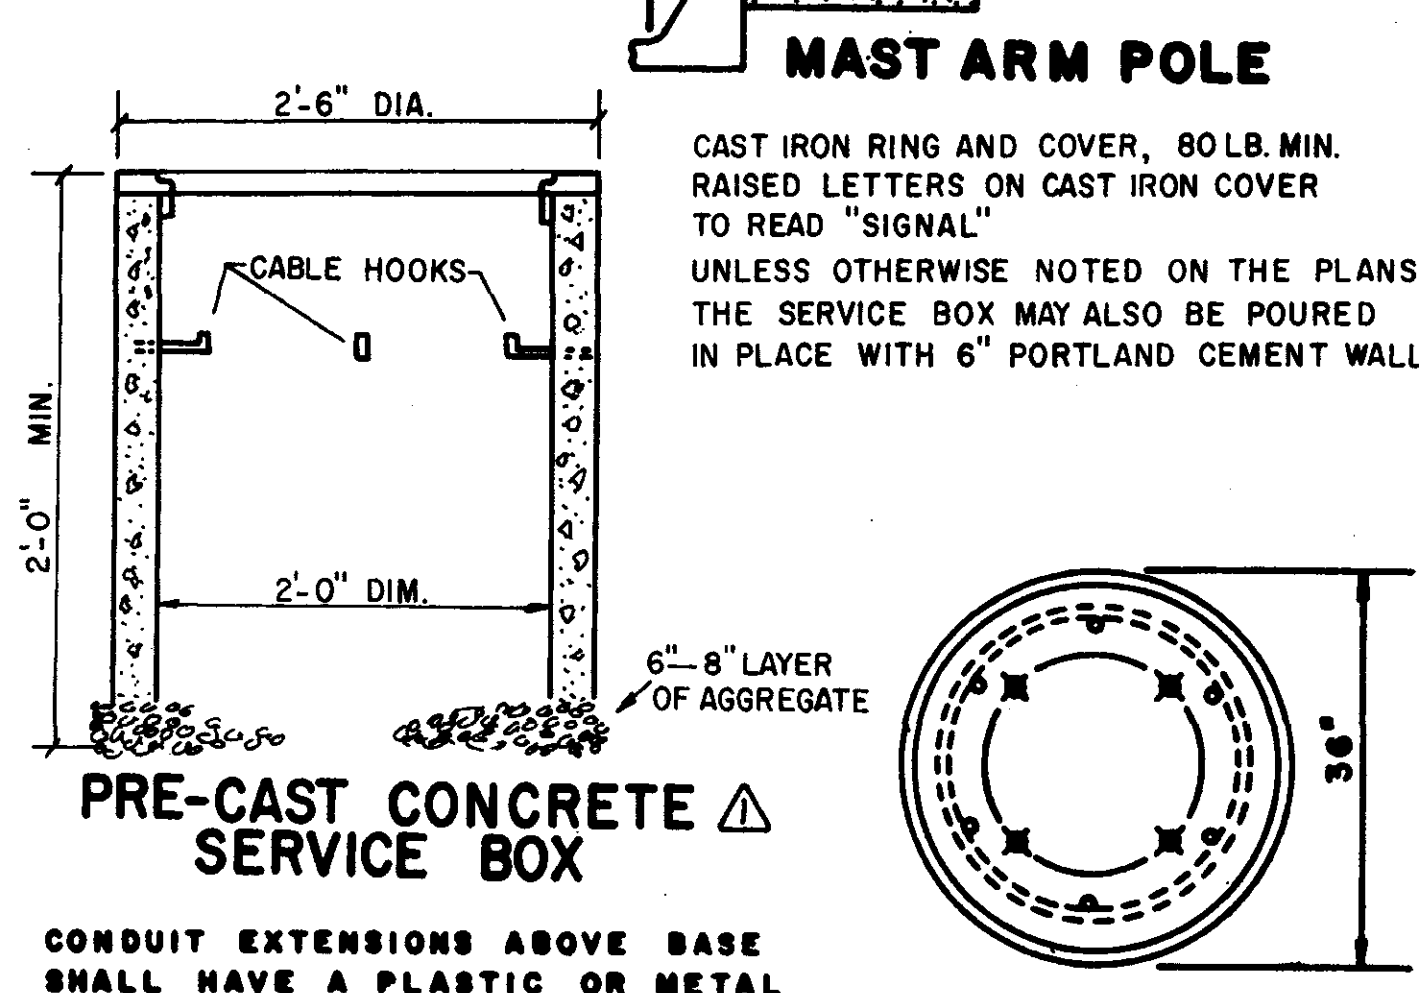


PRE-CAST CONCRETE SERVICE BOX

CONDUIT EXTENSIONS ABOVE BASE SHALL HAVE A PLASTIC OR METAL RIM BUSHING TO PREVENT THE CHAFING OF CABLES. TOP OF BASE SHALL NOT BE HIGHER THAN TOP OF SURFACE OR CURB.


MAST ARM POLE  
CAST IRON RING AND COVER, 80 LB. MIN. RAISED LETTERS ON CAST IRON COVER TO READ "SIGNAL" UNLESS OTHERWISE NOTED ON THE PLANS, THE SERVICE BOX MAY ALSO BE POURED IN PLACE WITH 6" PORTLAND CEMENT WALLS.

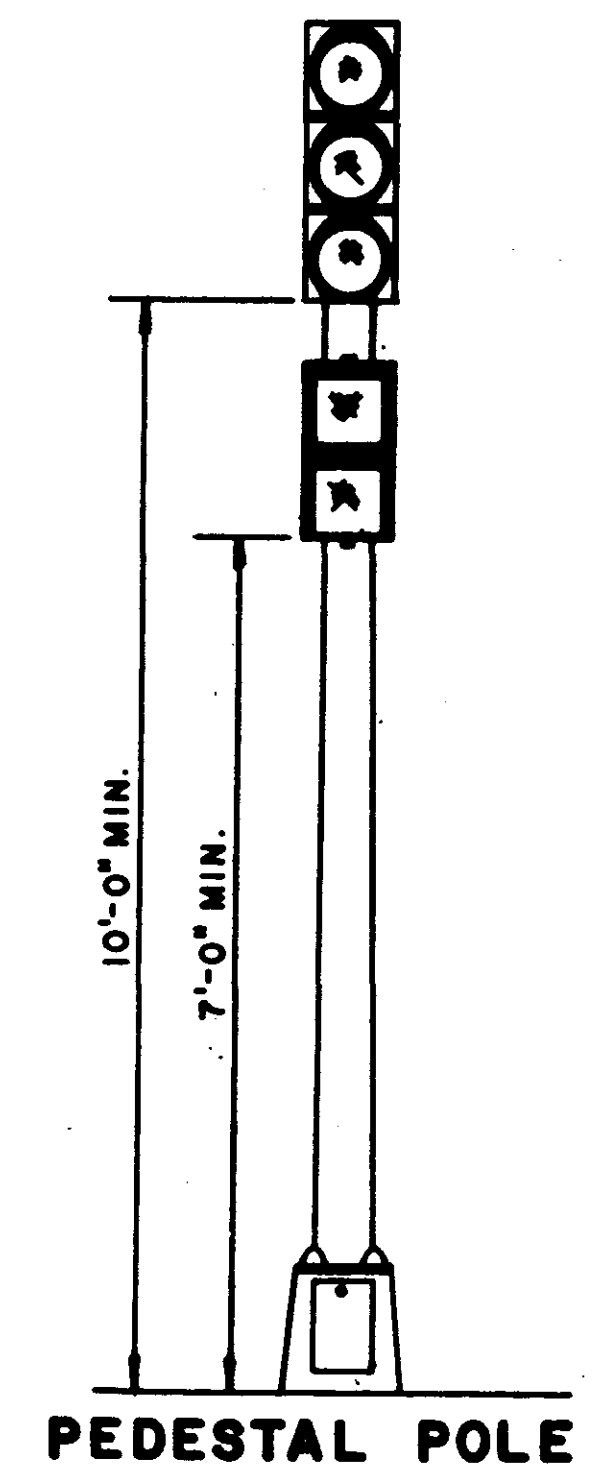

PEDESTAL POLE

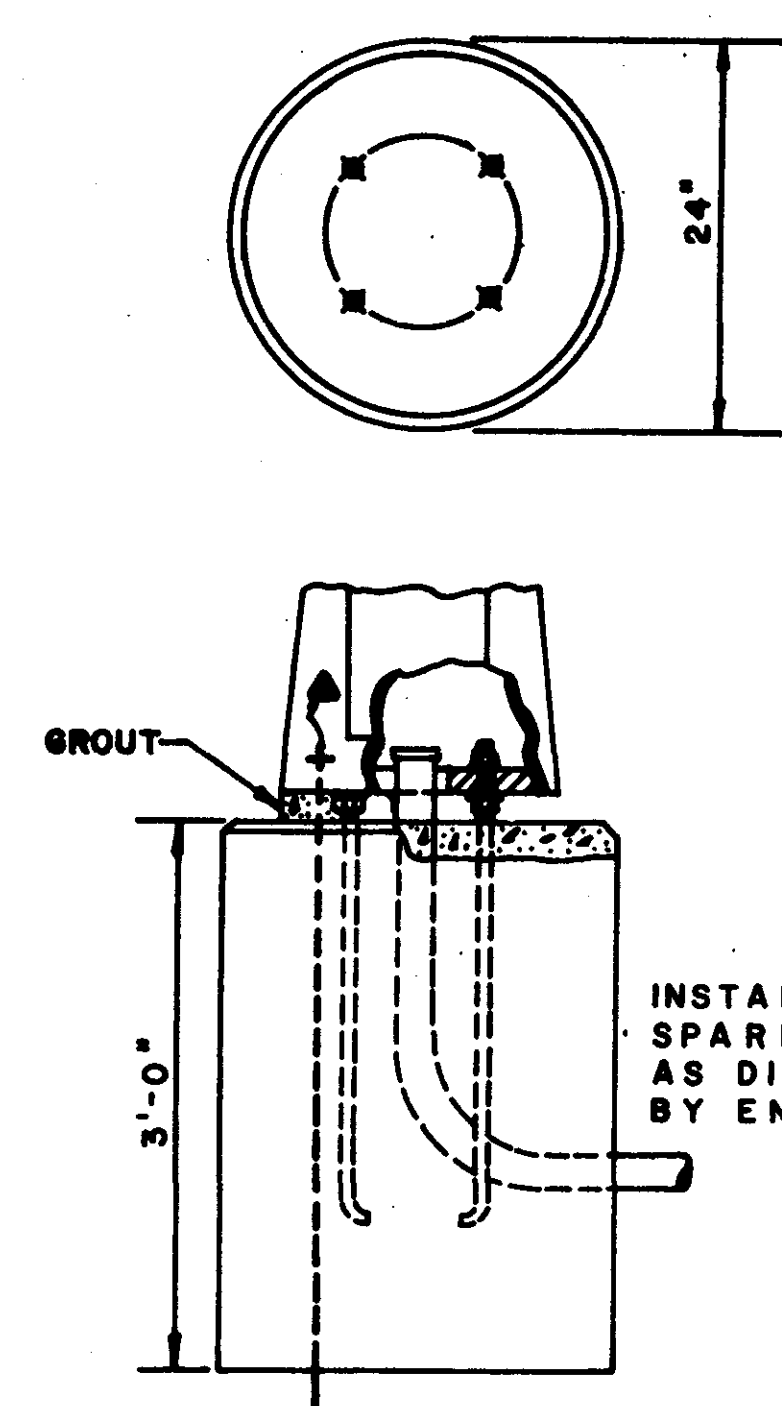

PEDESTAL POLE BASE

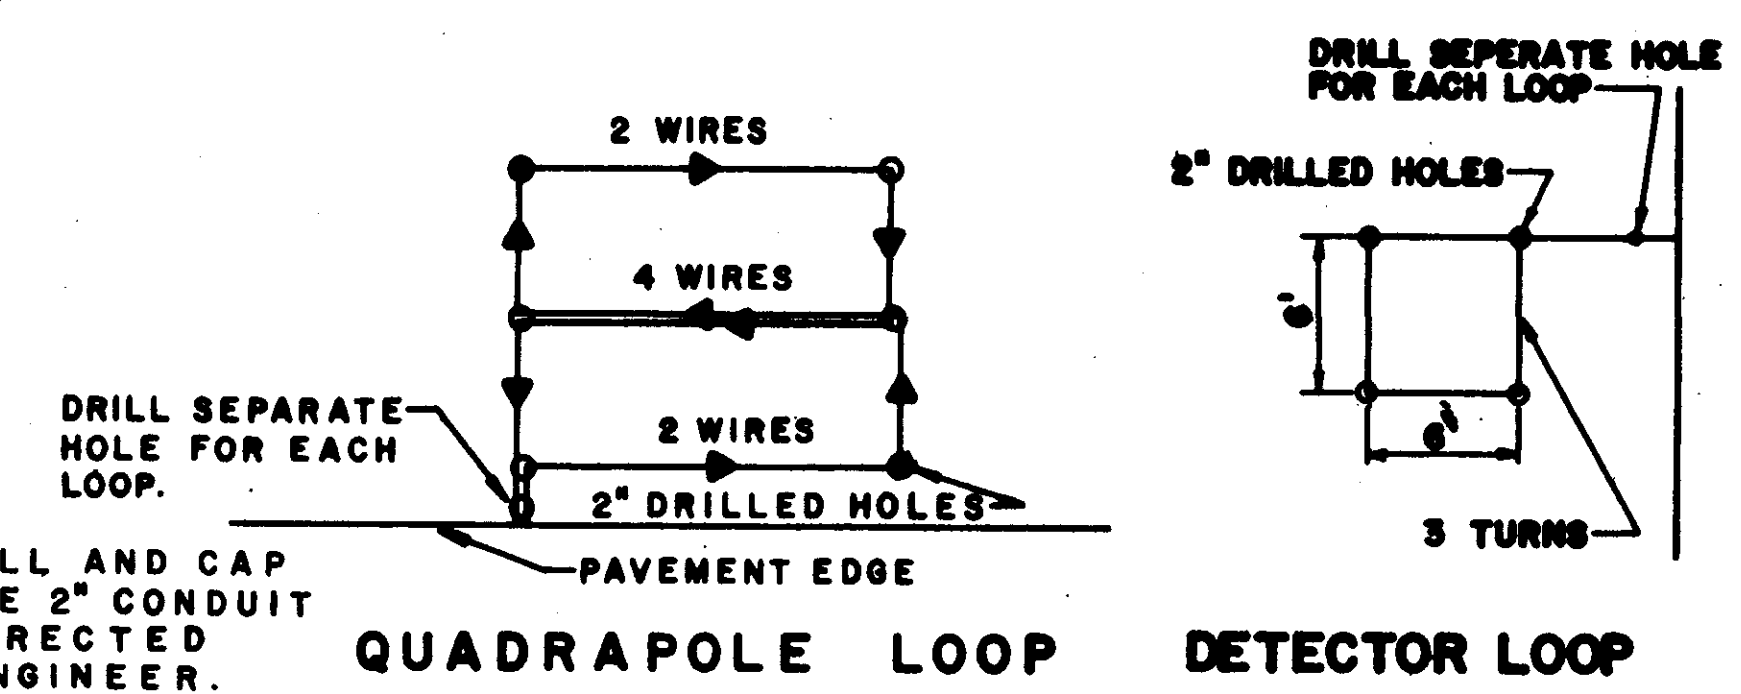

QUADRAPOLE LOOP DETECTOR LOOP

SLOTS IN PAVEMENT FOR LOOPS TO BE CUT A MINIMUM OF 3/8" WIDE AND 1-1/2" TO 2" DEEP. SLOTS TO BE FILLED WITH LOOP SEALANT MATERIAL APPROVED BY THE ENGINEER. THE CONNECTION OF THE LOOP WIRE WITH THE FEEDER CABLE SHALL BE MADE WITH A SOLDERED "WESTERN UNION" TYPE SPLICE, WRAPPED WITH WATERPROOF TAPE AND COATED WITH A WATER-TIGHT PROTECTIVE COVERING. FEEDER CABLE AND LOOP WIRE SHALL BE OF CONTINUOUS RUN WITH NO SPLICES.

NOTES:


THE ENGINEER IN CHARGE OF CONSTRUCTION SHALL STAKE ALL LOCATIONS FOR TRAFFIC SIGNAL POLES AND PEDESTALS TO BE INSTALLED. FINAL POSITIONS AND POINTING OF SIGNAL FACES TO BE DETERMINED IN THE FIELD.

TRAFFIC SIGNAL HEADS SHALL REMAIN COVERED DURING CONSTRUCTION UNTIL THE ENTIRE INSTALLATION IS IN PLACE AND IN OPERATION.


ALL WIRING INSTALLED SHALL CONFORM TO THE NATIONAL ELECTRICAL CODE AND LOCAL ORDINANCES AND REQUIREMENTS.

THE POWER COMPANY SHOULD BE NOTIFIED IN ADVANCE AS TO WHEN THE SIGNAL SYSTEM NEED BE ENERGIZED.


THE TRAFFIC SIGNAL SYSTEM SHALL BE COMPLETE AND THE CONTRACTOR SHALL FURNISH AND INSTALL ALL EQUIPMENT NECESSARY FOR THE SATISFACTORY OPERATION OF ELECTRICAL APPARATUS AND FOR THE COMPLETE OPERATION OF THE TRAFFIC SIGNAL SYSTEM WHETHER SPECIFICALLY MENTIONED OR NOT.

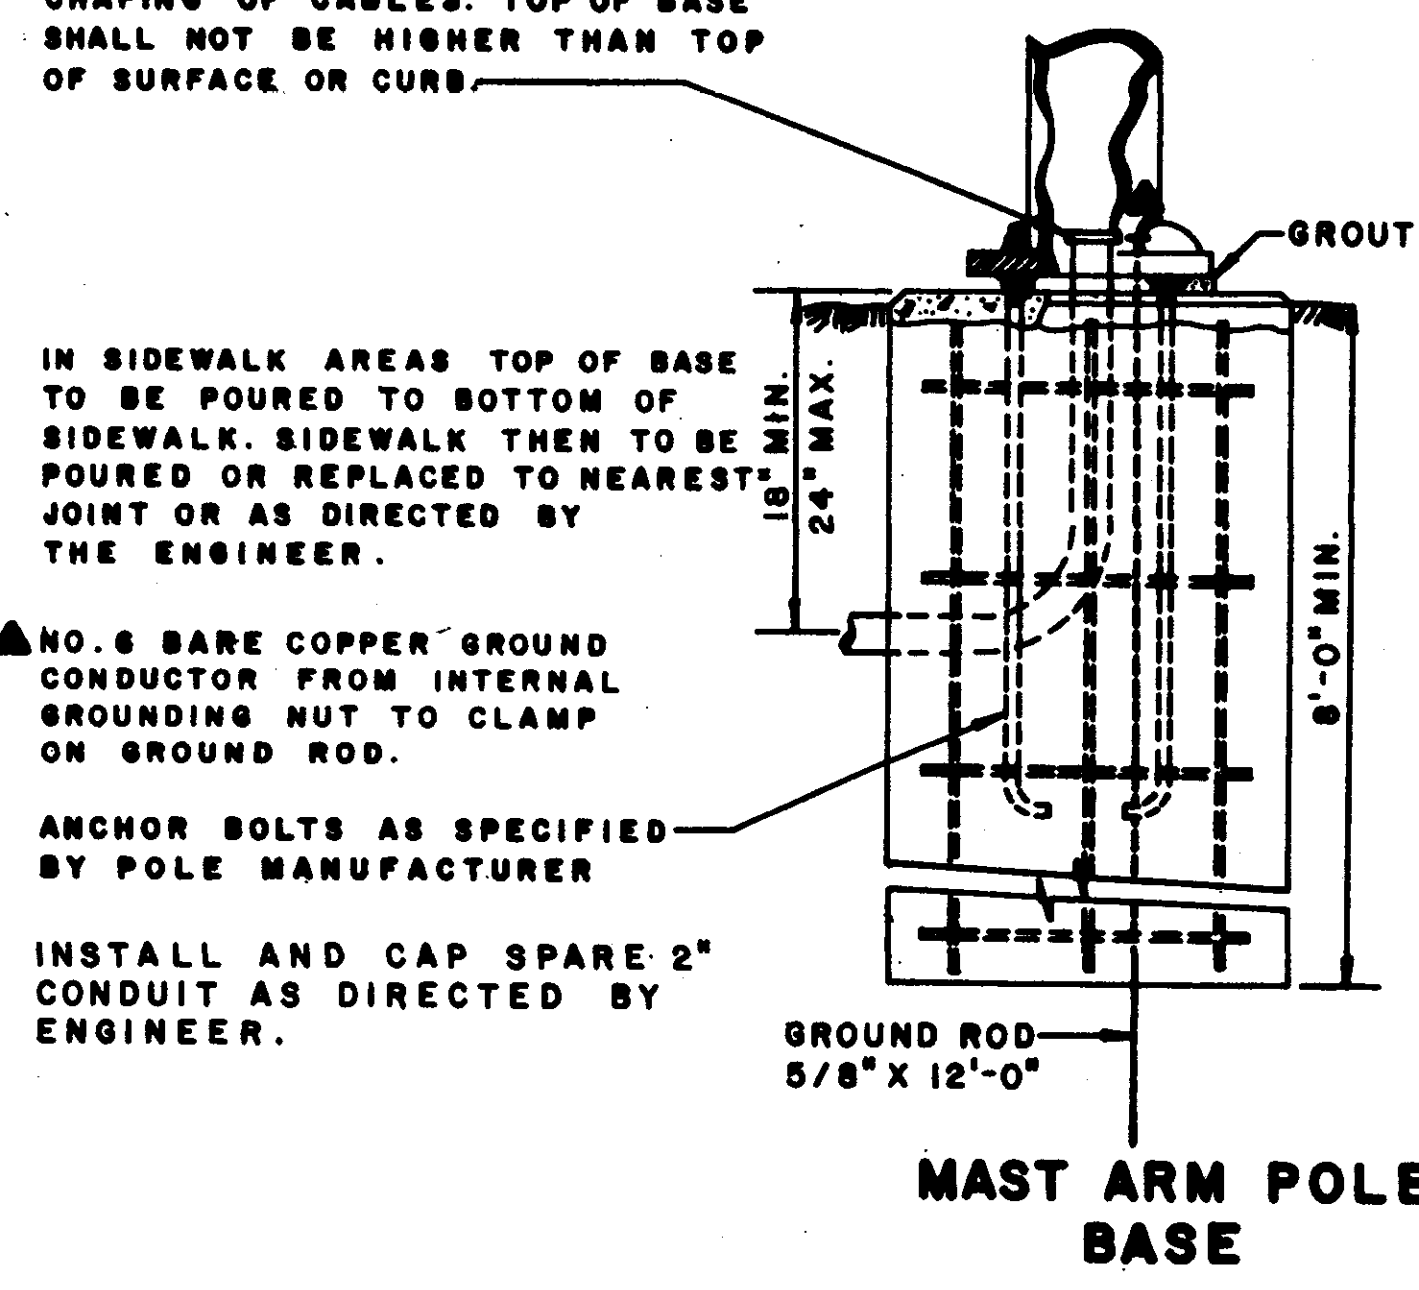

MAST ARM POLE BASE

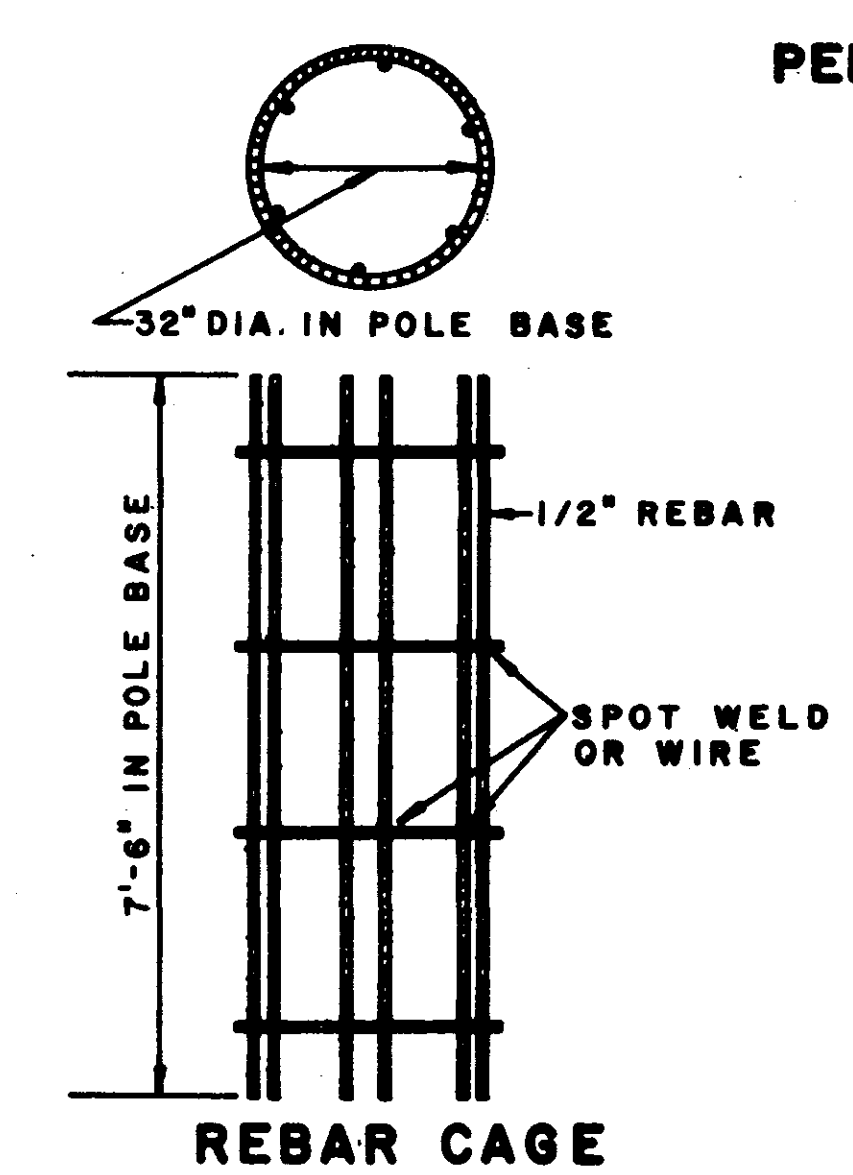


REBAR CAGE

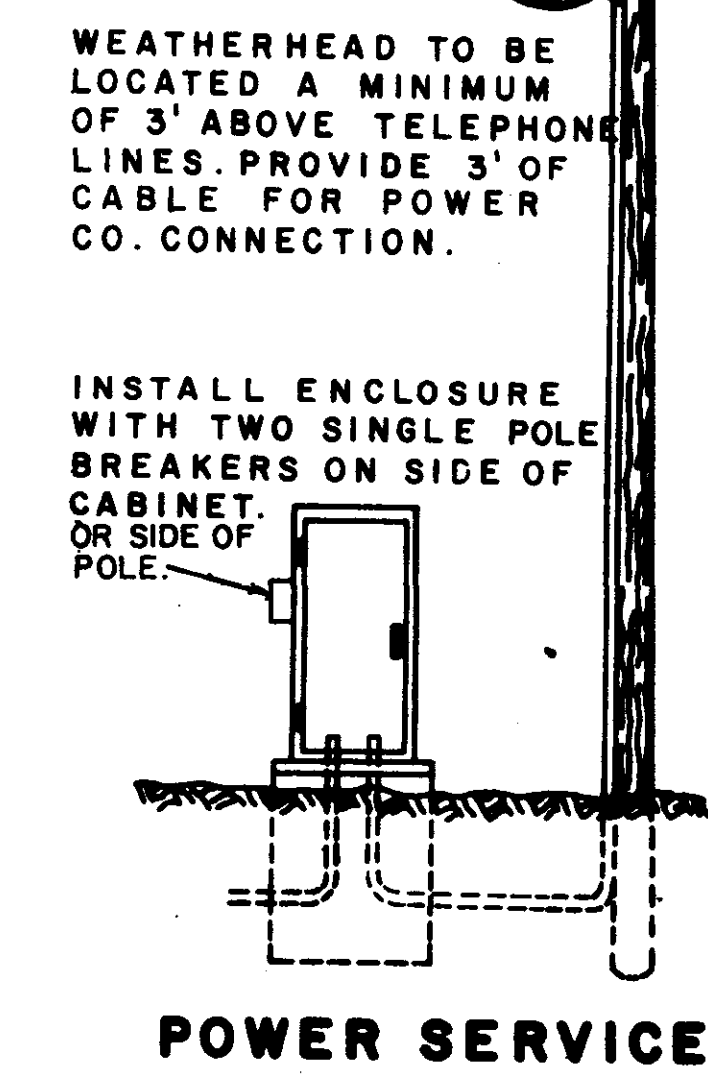


POWER SERVICE

JUNCTION BOX MATERIAL SPECIFICATIONS  
Cast Iron, ASTM A-48, hot dipped galvanized ASTM A-153;  
Cast Aluminum, ASTM B-108-62T, S670-T6;  
Welded Aluminum, Alcoa 6061-T6;

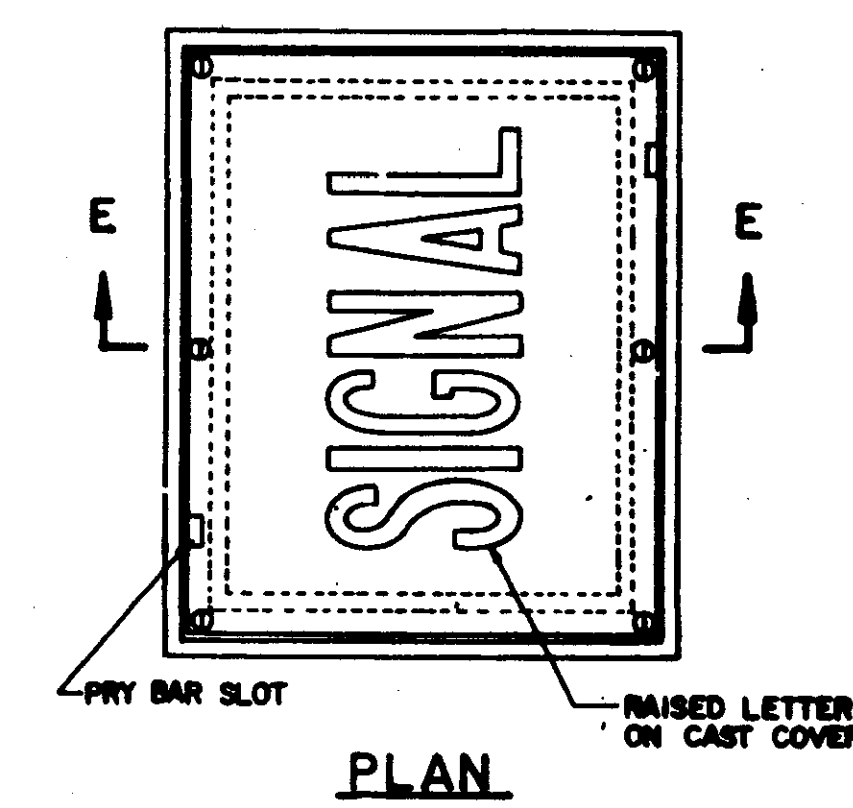

PLAN

JUNCTION BOX MINIMUM HAND HOLE OPENING SHALL BE 144 SQ. IN.

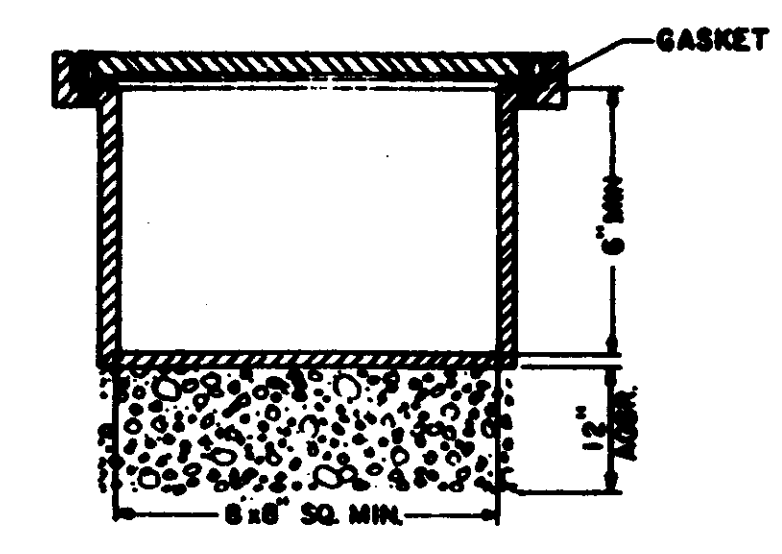


SECTION E


RECORD DRAWING  
FEBRUARY 1997

CITY OF RIDGELAND		
TRAFFIC SIGNAL INSTALLATION		
DETAIL SHEET		
WAGGONER ENGINEERING CO. INC. Consulting Engineers - Jackson / Brandon, Ms.		
DRAWN BY: T.D.L.	DATE: APRIL 95	SHEET NO.
CHECKED BY: M.L.	SCALE: 1"=20'	13 OF 14
APPROVED BY: J.A.W.		




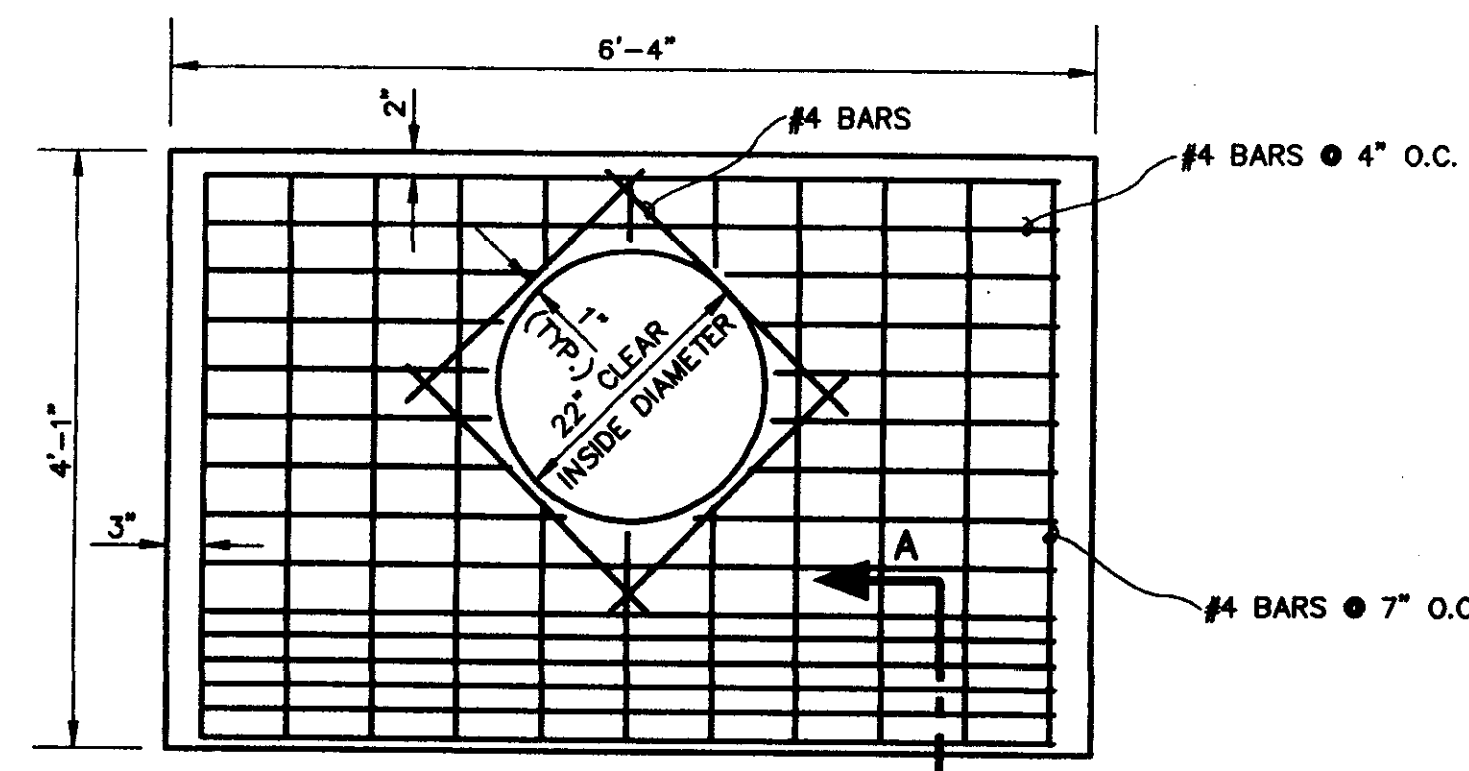


PLAN

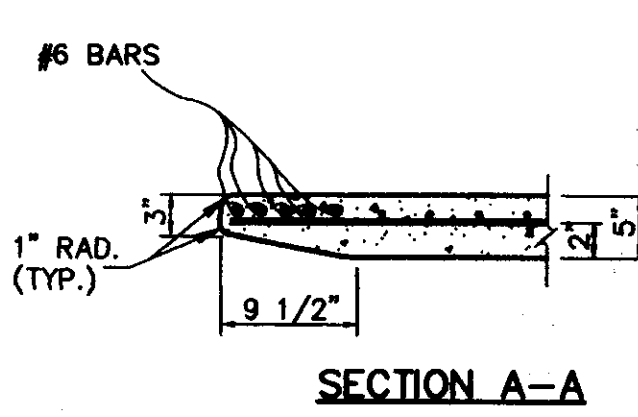

SECTION A-A

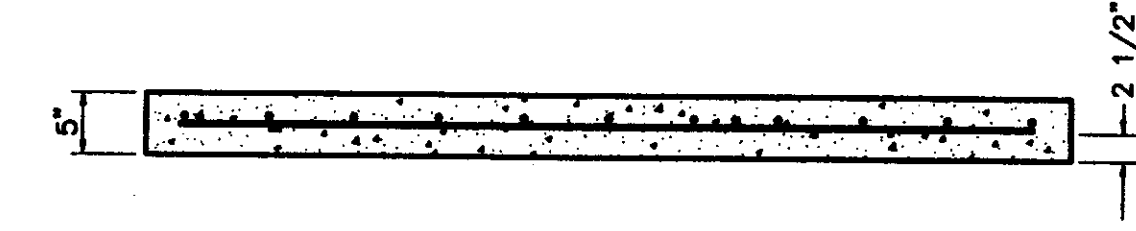


ELEVATION  
INLET TOP

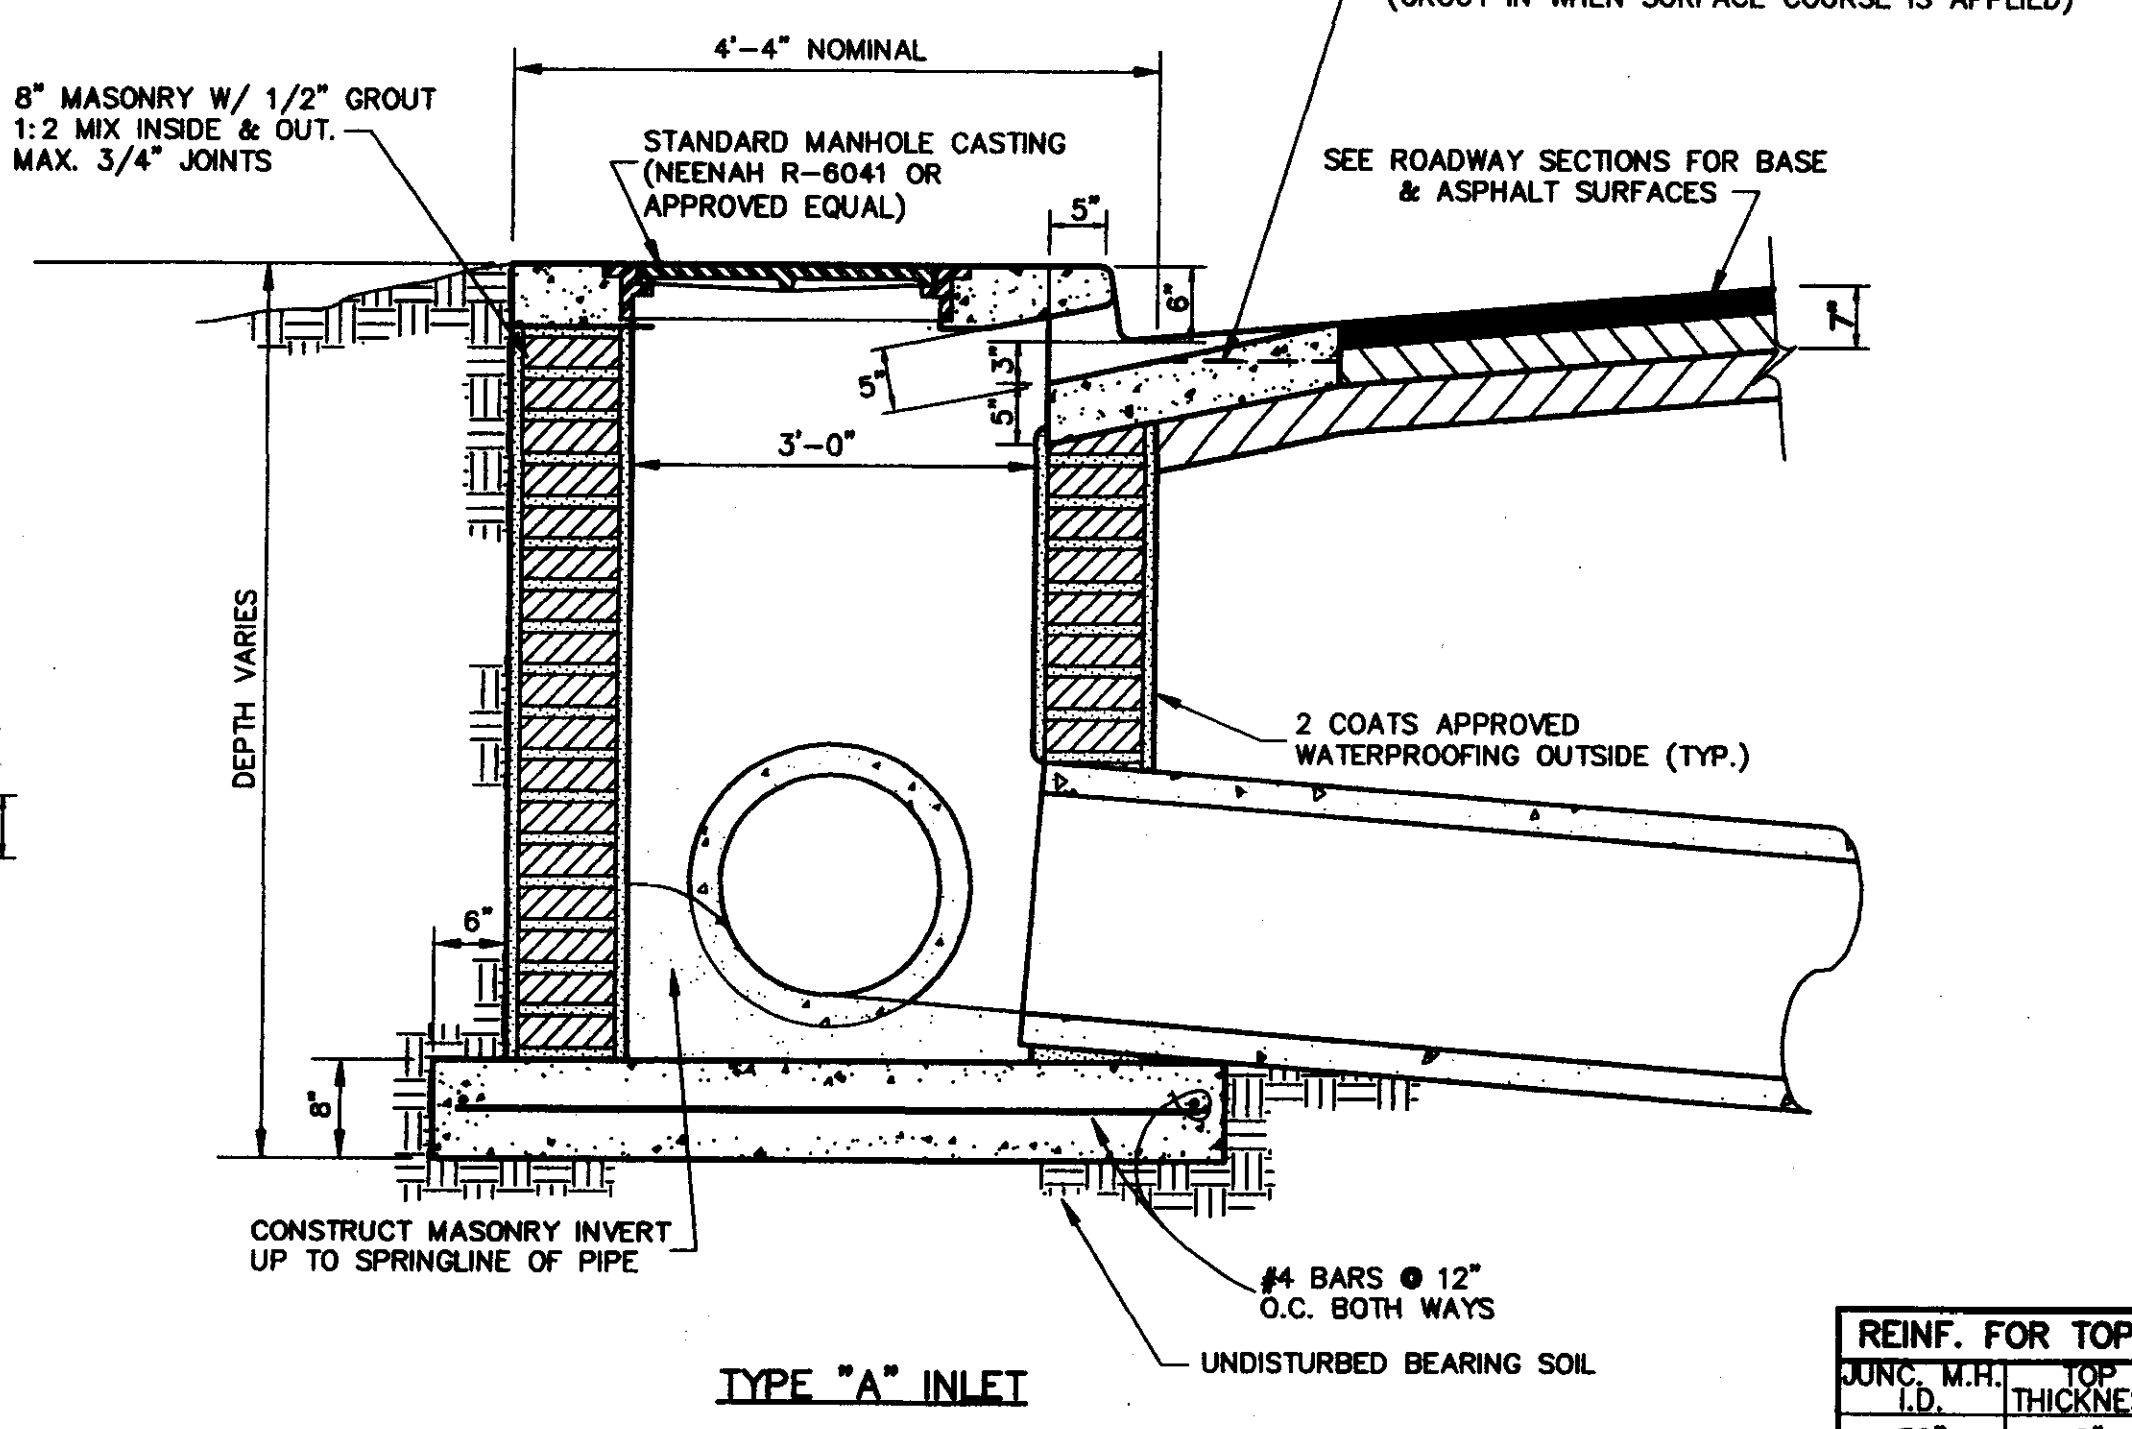


TYPE "A" INLET


JUNC. M.H. I.D.	TOP THICKNESS	TOP REIN.	BOTTOM REIN.
72"	8"	#4 @ 12" O.C.	#6 @ 6" O.C.
84"	9"	#4 @ 10" O.C.	#6 @ 5" O.C.
96"	10"	#5 @ 8" O.C.	#6 @ 4" O.C.
120"	12"	#6 @ 8" O.C.	#8 @ 4" O.C.

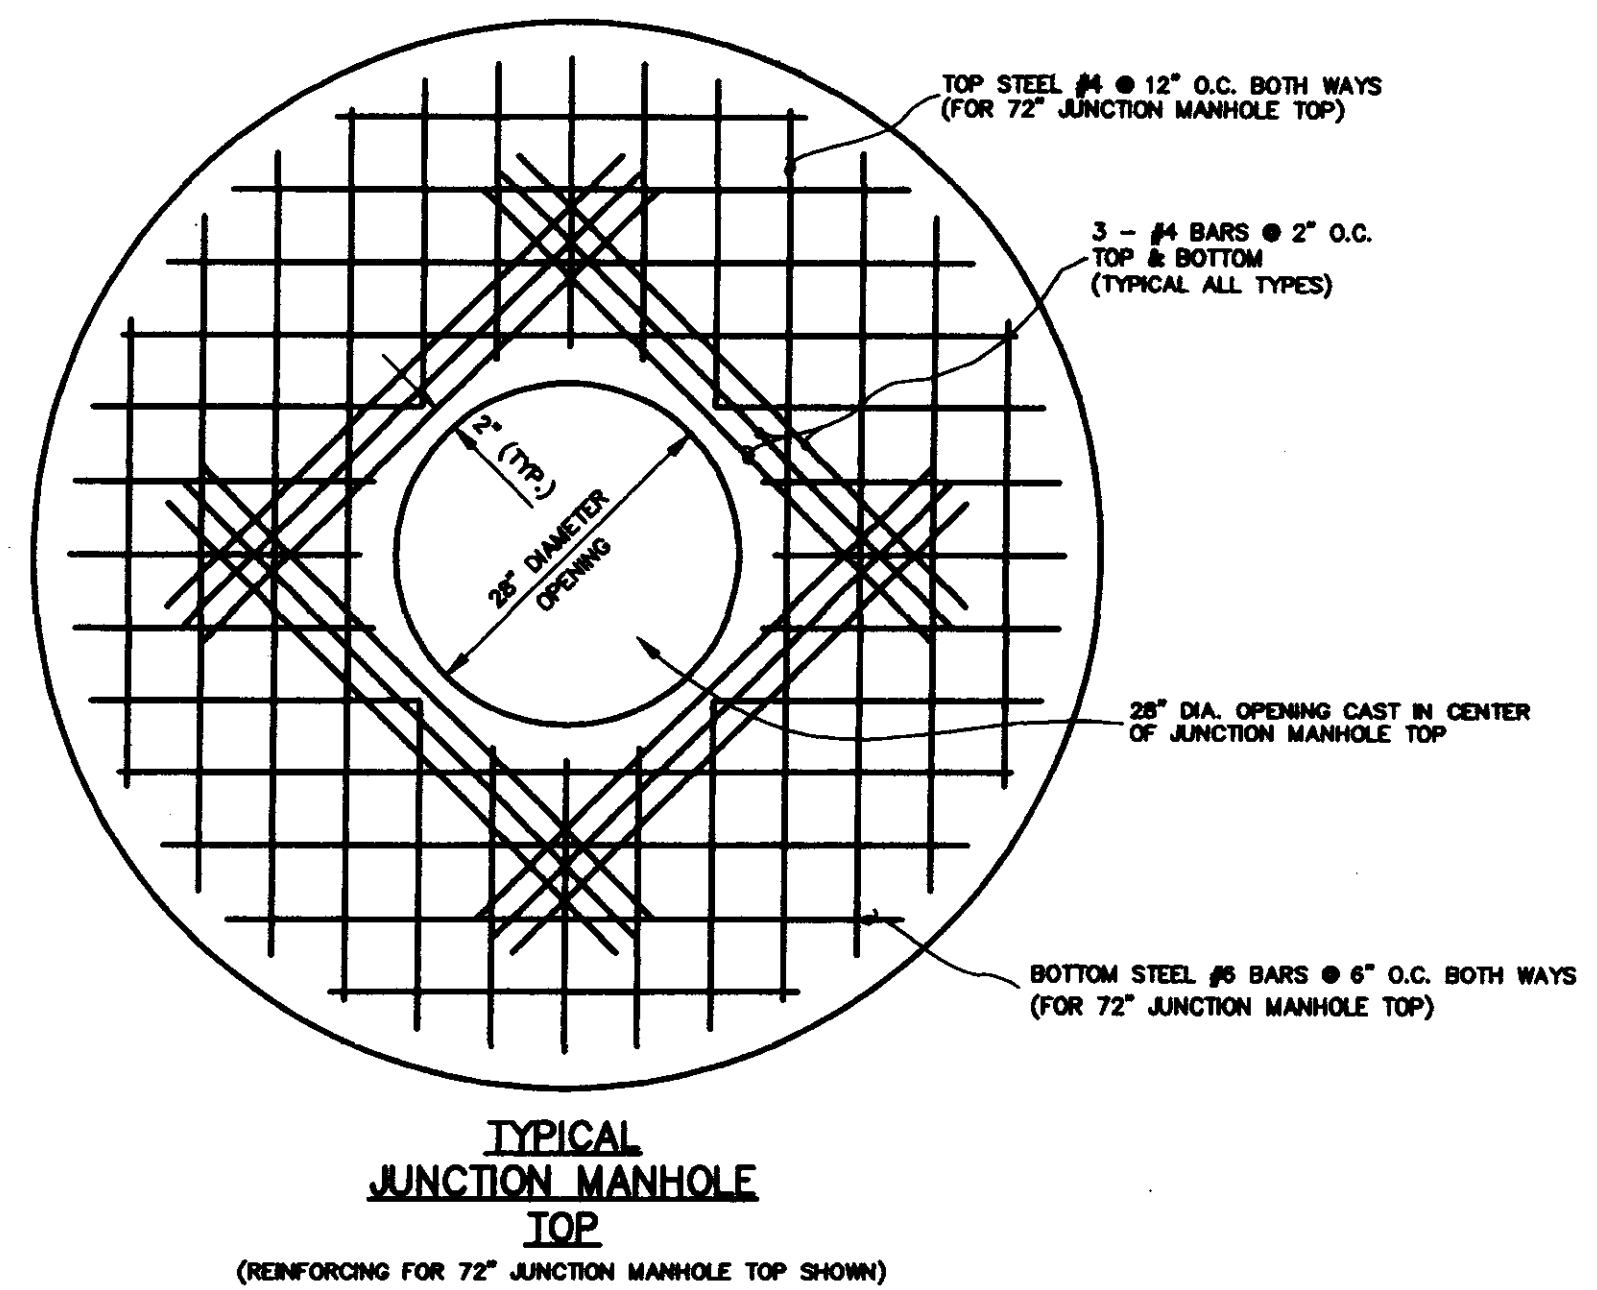

TYPICAL  
JUNCTION MANHOLE  
TOP  
(REINFORCING FOR 72" JUNCTION MANHOLE TOP SHOWN)

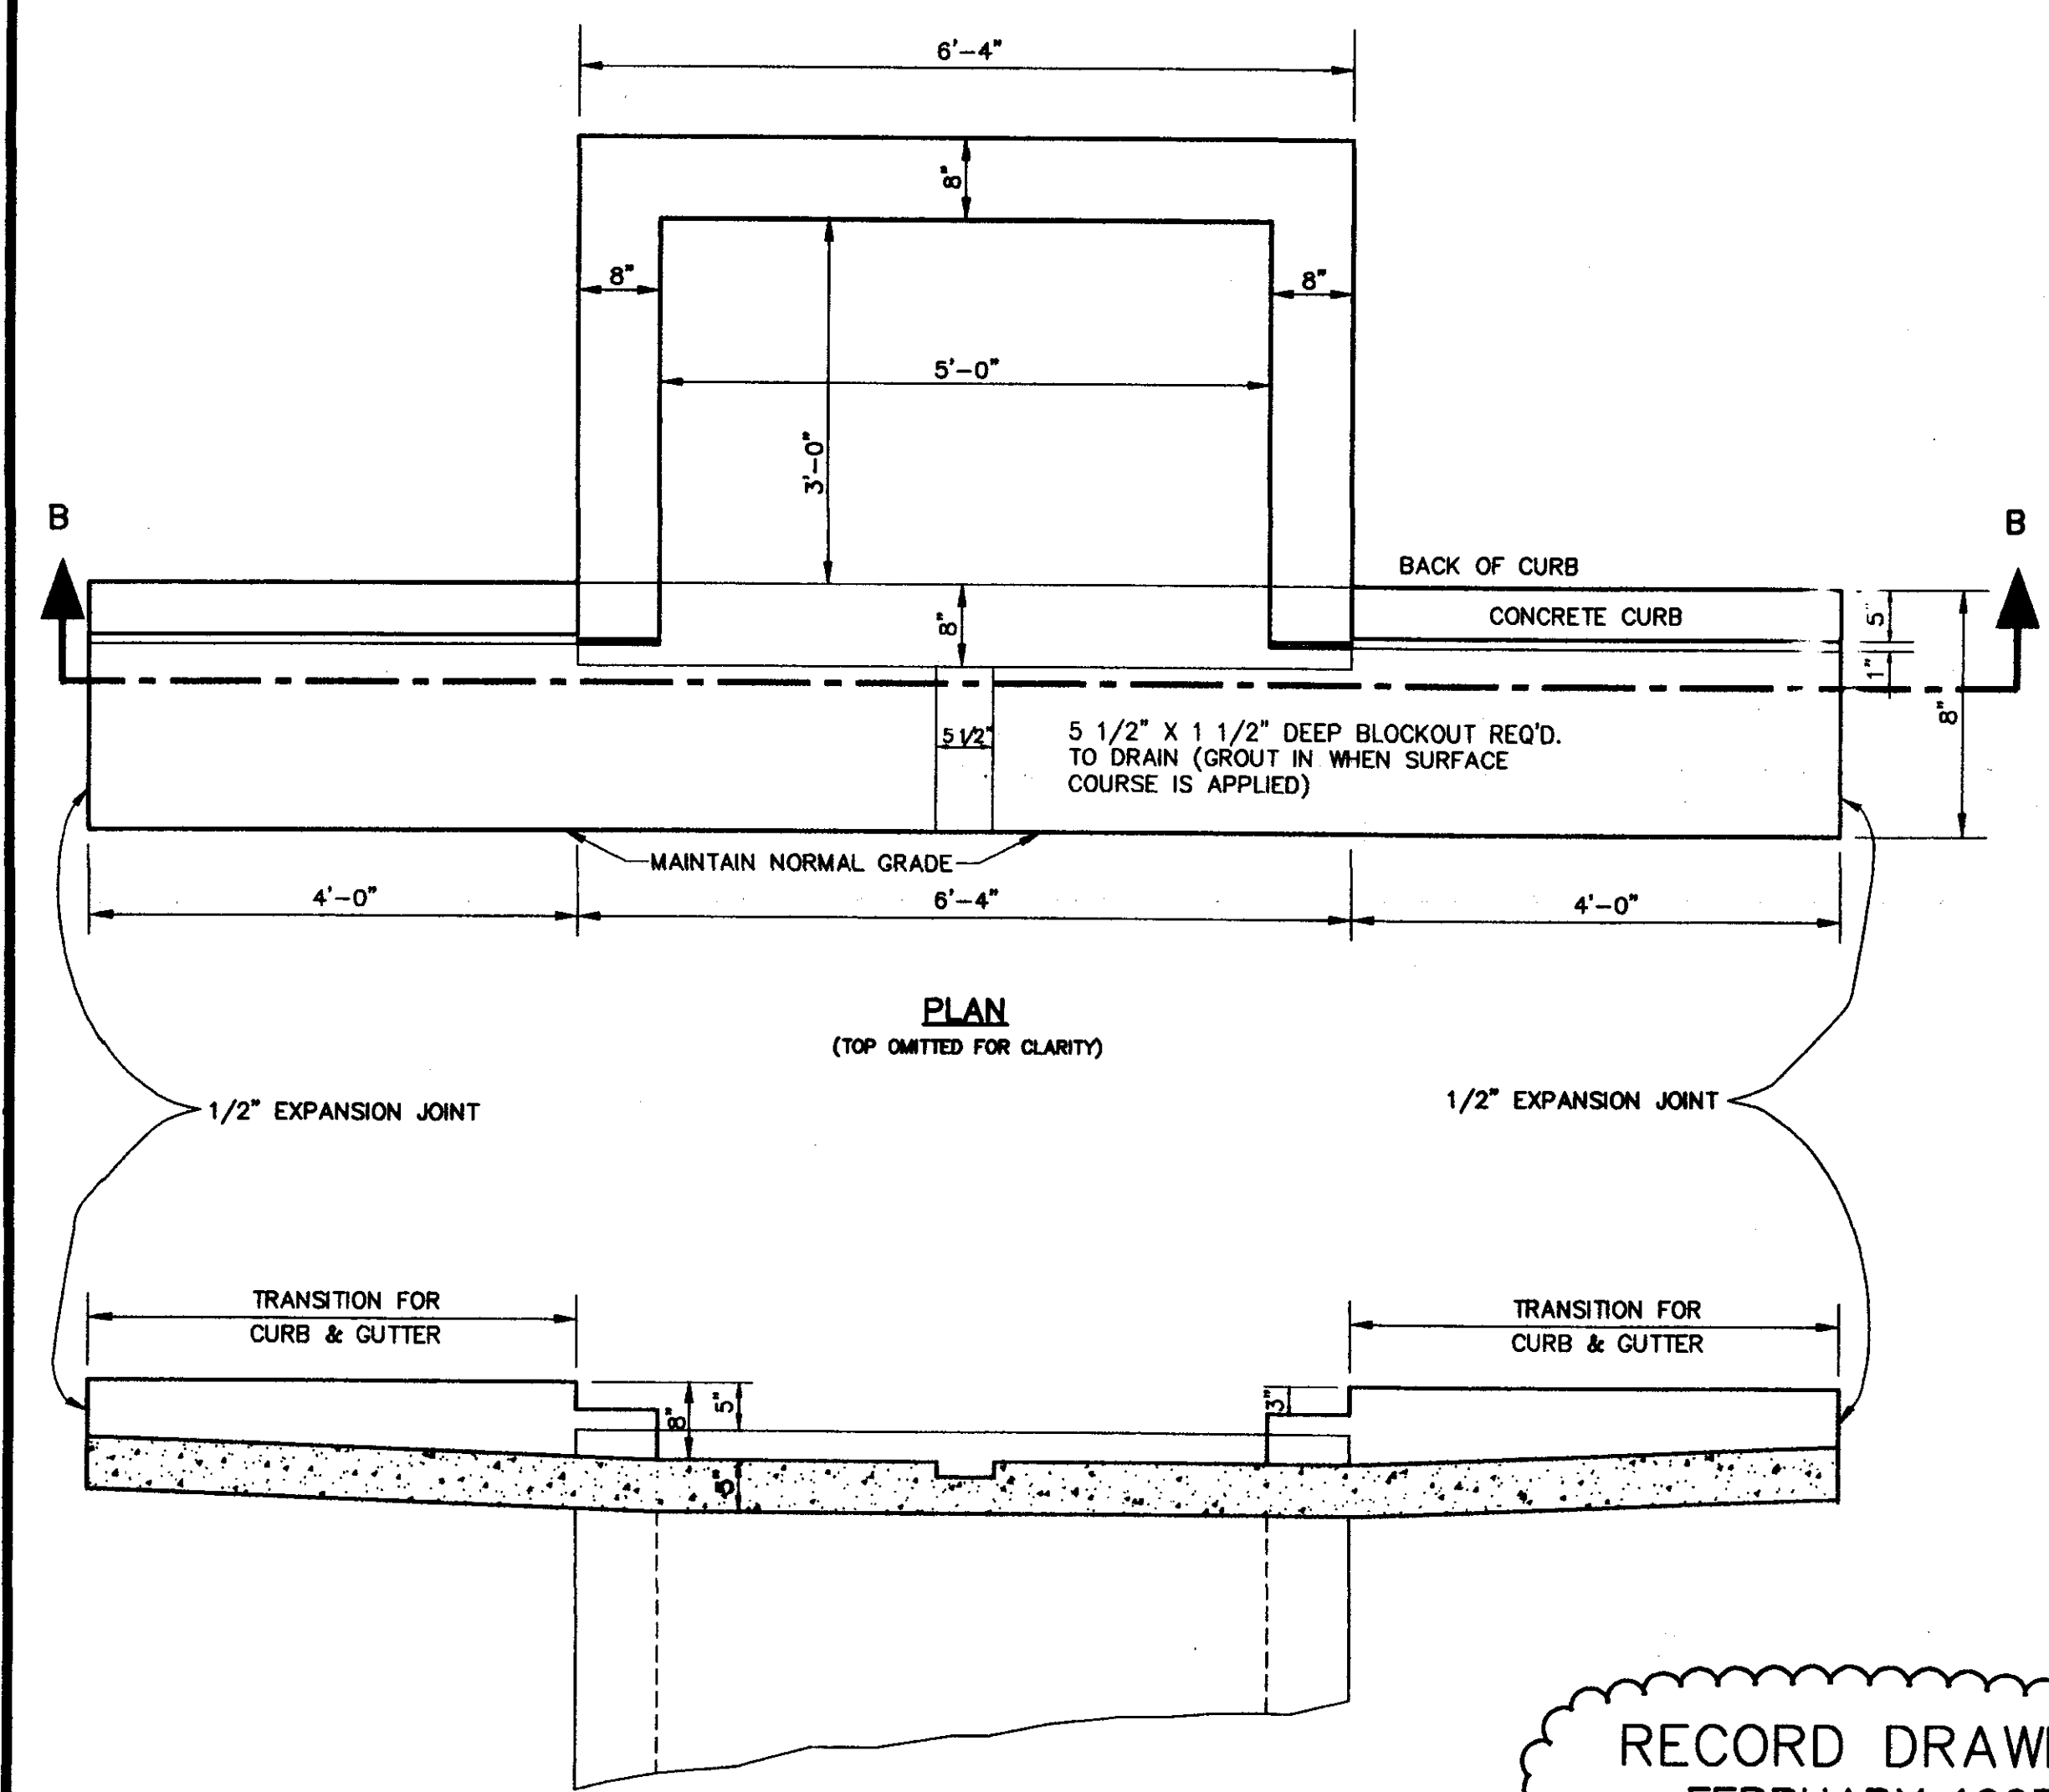


SECTION B-B  
CURB INLET

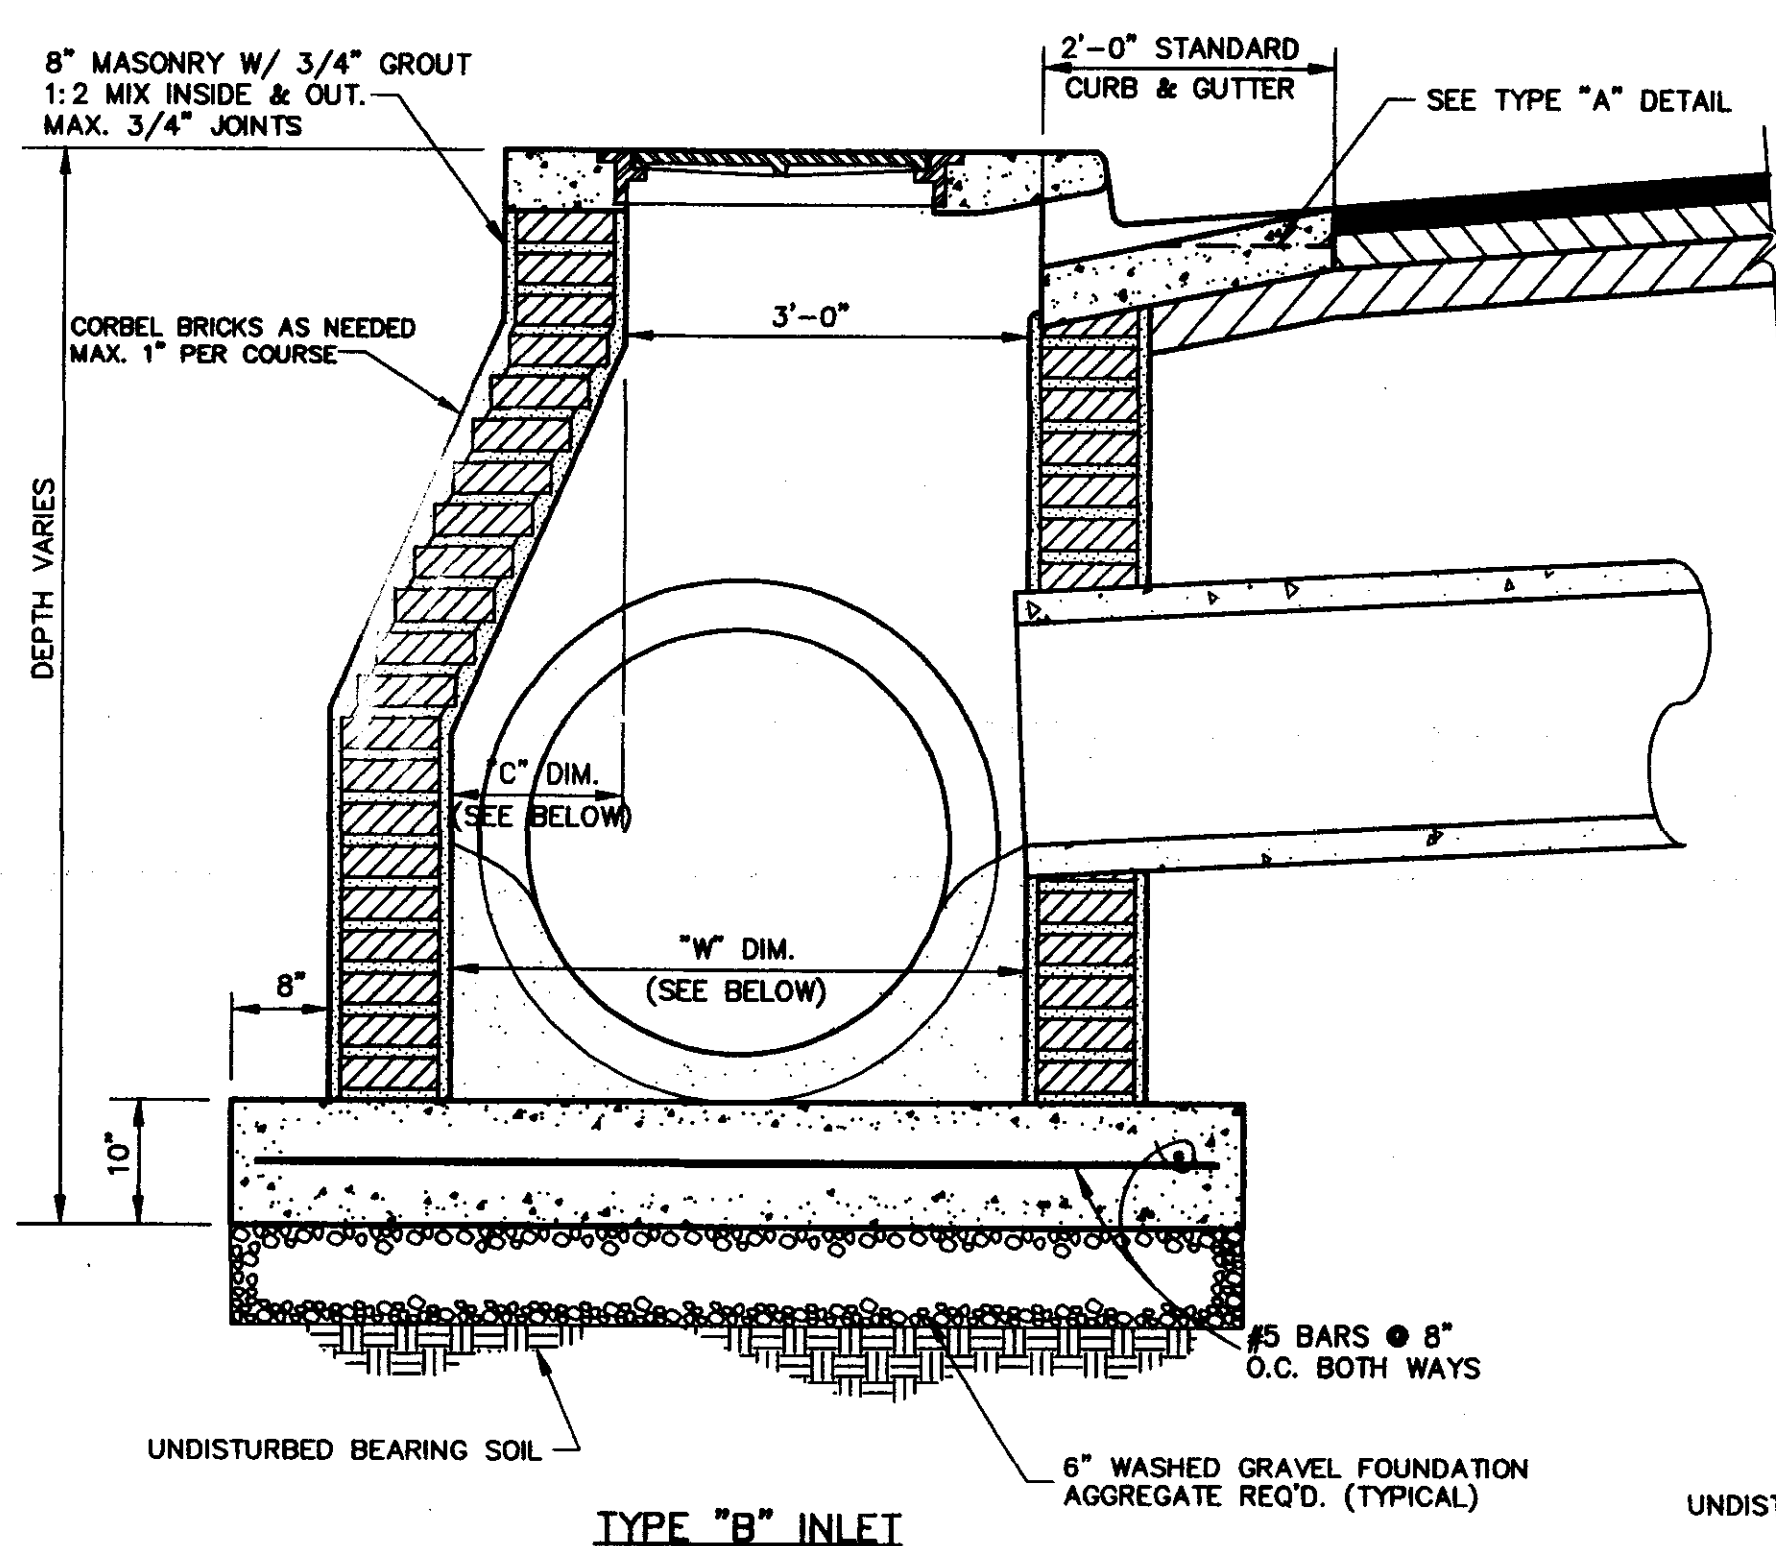

TYPE "B" INLET

PIPE I.D.	PIPE O.D.	DIM. "W"	DIM. "C"	MIN. COURSES CORBELLED
24"	33"	37"	4"	4
27"	36"	40"	4"	4
30"	39 1/2"	44"	8"	8
36"	45 1/2"	50"	14"	14

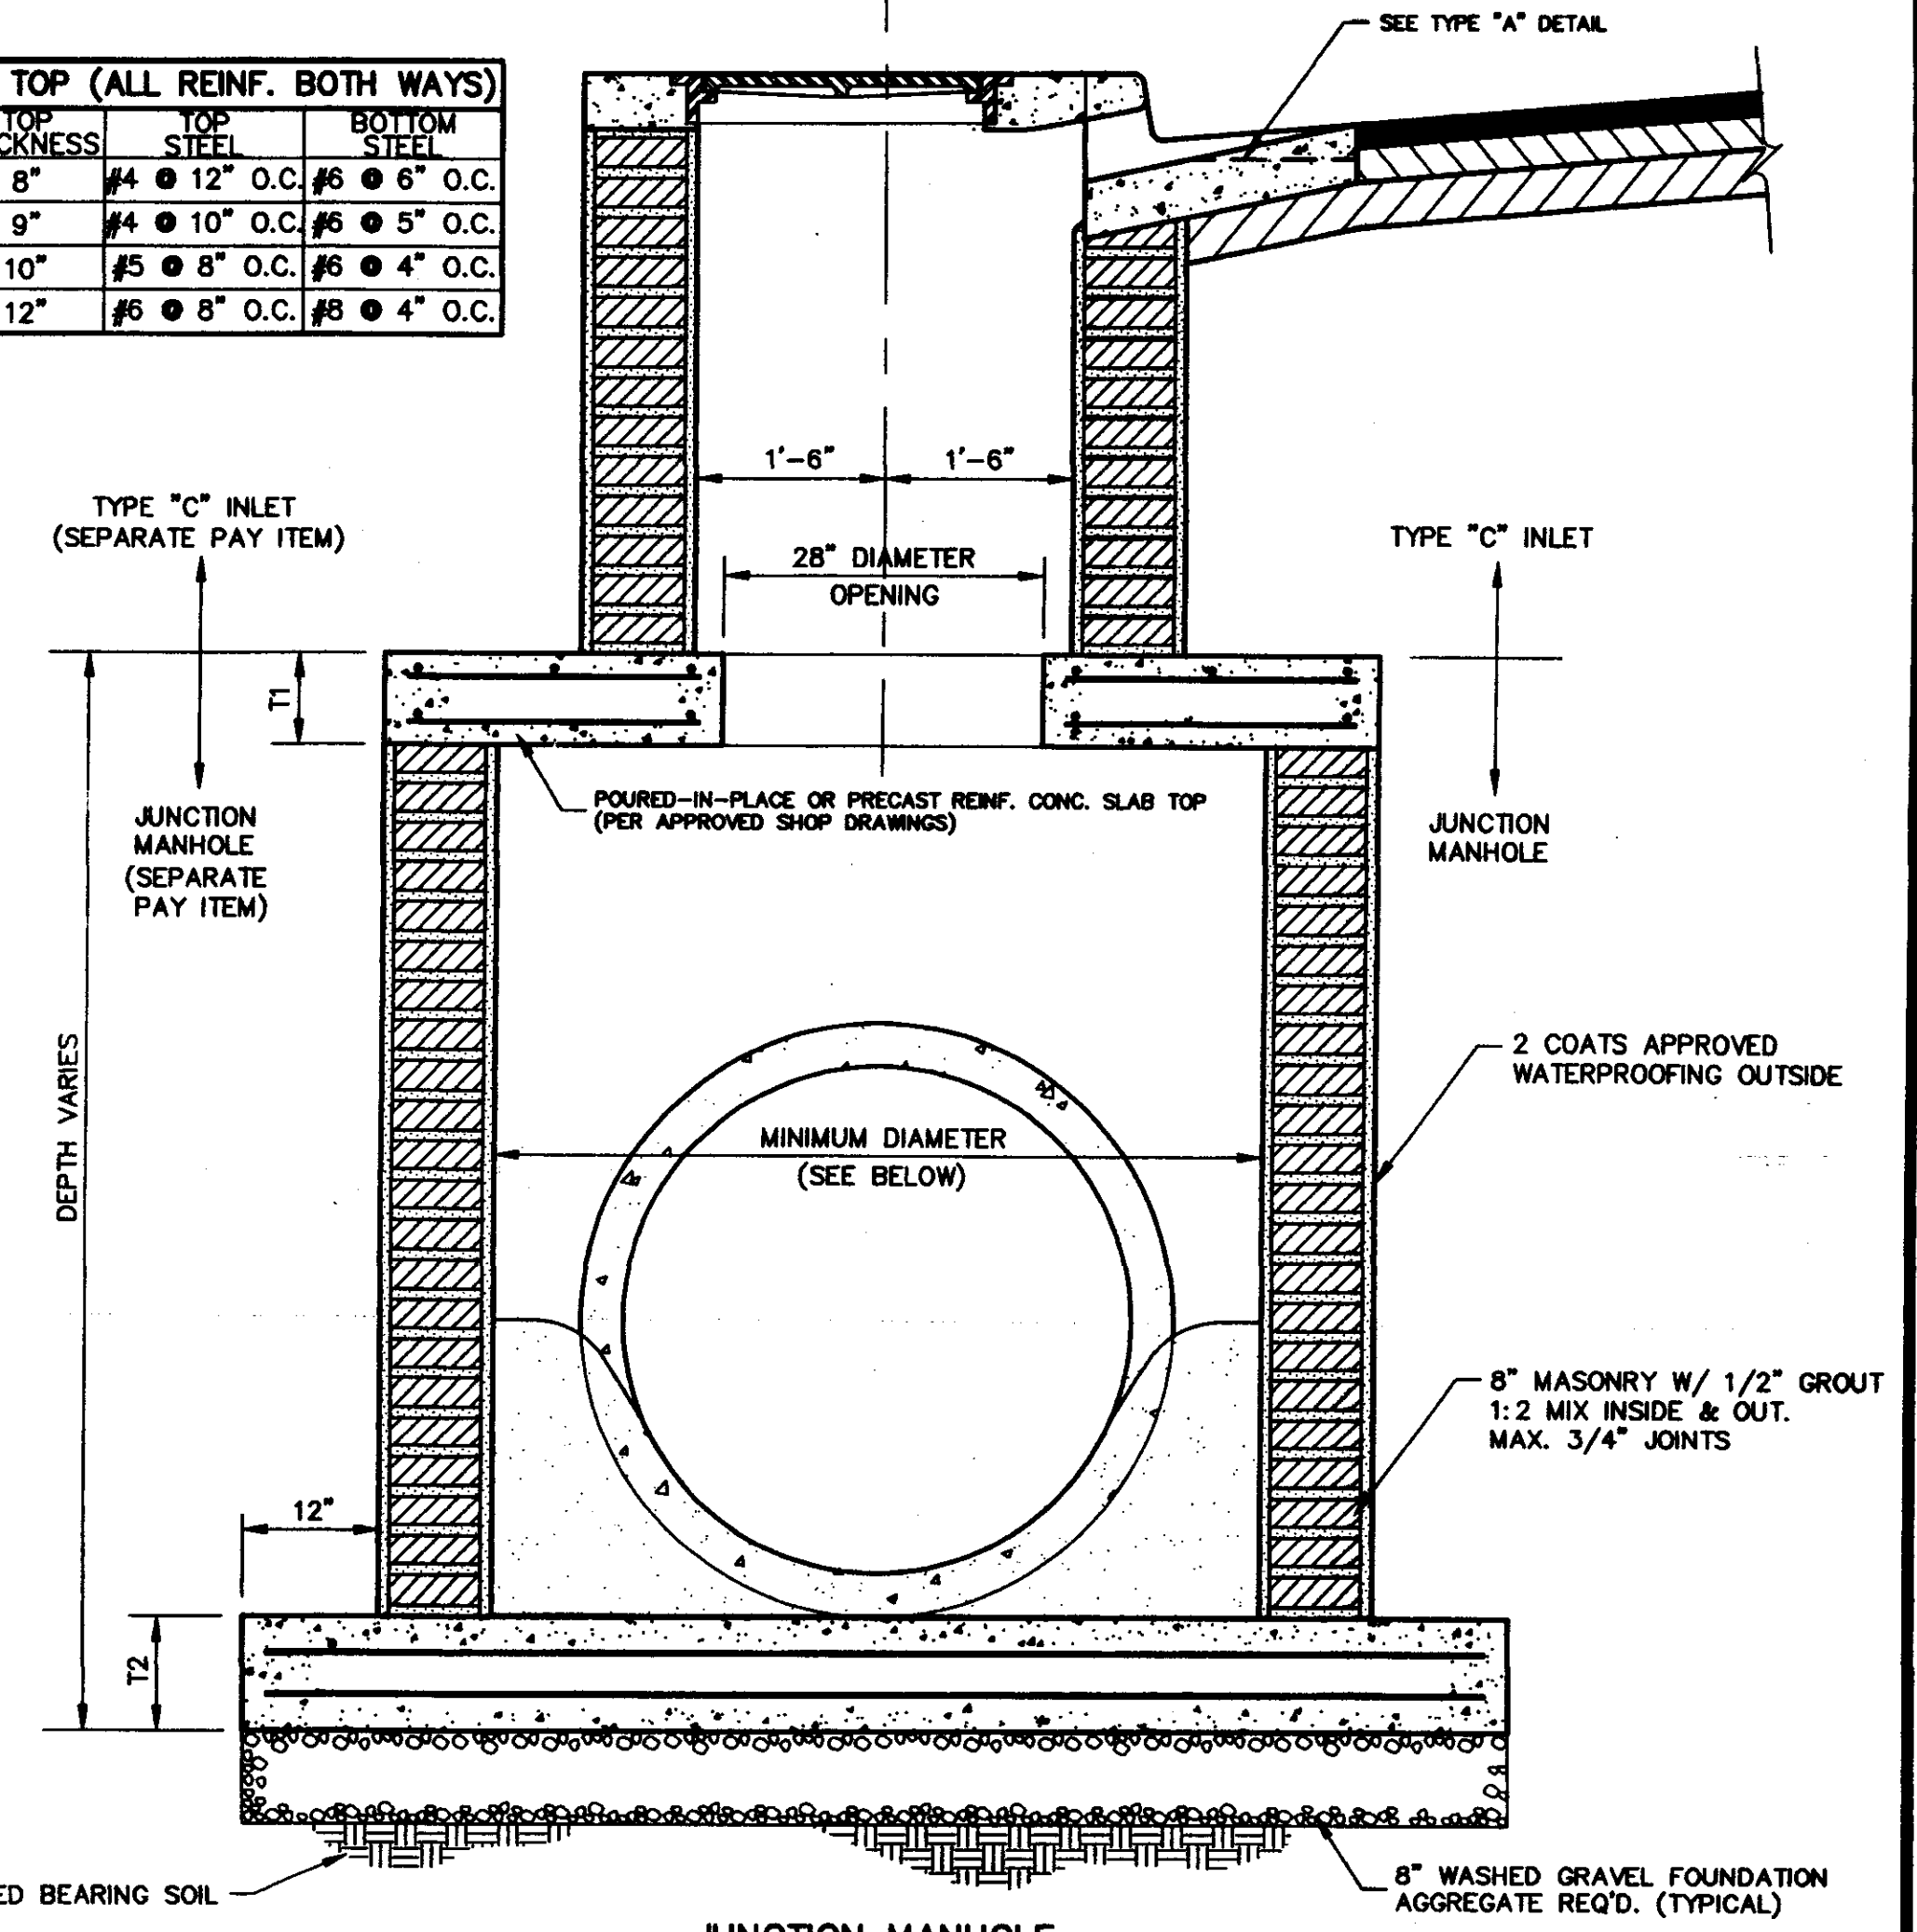


JUNCTION MANHOLE  
(NOTED "B" ON PLAN-PROFILES)

PIPE I.D.	PIPE O.D.	MIN. M.H. DIA. I.D.	MIN. T1	MIN. T2	REIN. FOR FOUNDATION
42"	52 1/2"	72"	8"	10"	#6 @ 10" O.C.
48"	59 1/2"	72"	8"	10"	#6 @ 10" O.C.
54"	66 1/2"	84"	9"	12"	#6 @ 8" O.C.
60"	76"	84"	9"	12"	#6 @ 8" O.C.
65"x40"	76"	84"	9"	12"	#6 @ 8" O.C.
73"x45"	85"	96"	10"	12"	#6 @ 6" O.C.
88"x54"	102"	120"	12"	16"	#8 @ 6" O.C.


NOTE: ALL REINFORCING BOTH WAYS EACH FACE

RECORD DRAWING  
FEBRUARY 1997

CITY OF RIDGELAND, MISSISSIPPI  
INLET DETAILS - STANDARD STORM SEWER  
EAST SCHOOL STREET/  
WHEATLEY STREET RECONSTRUCTION  
WAGGONER ENGINEERING, INC.  
Consulting Engineers - Jackson, Mississippi  
DRAWN BY: C.R.H. DATE: APRIL 95 SHEET NUMBER  
REVIEWED BY: SCALE: 3/4"=1'-0" 11 OF 14

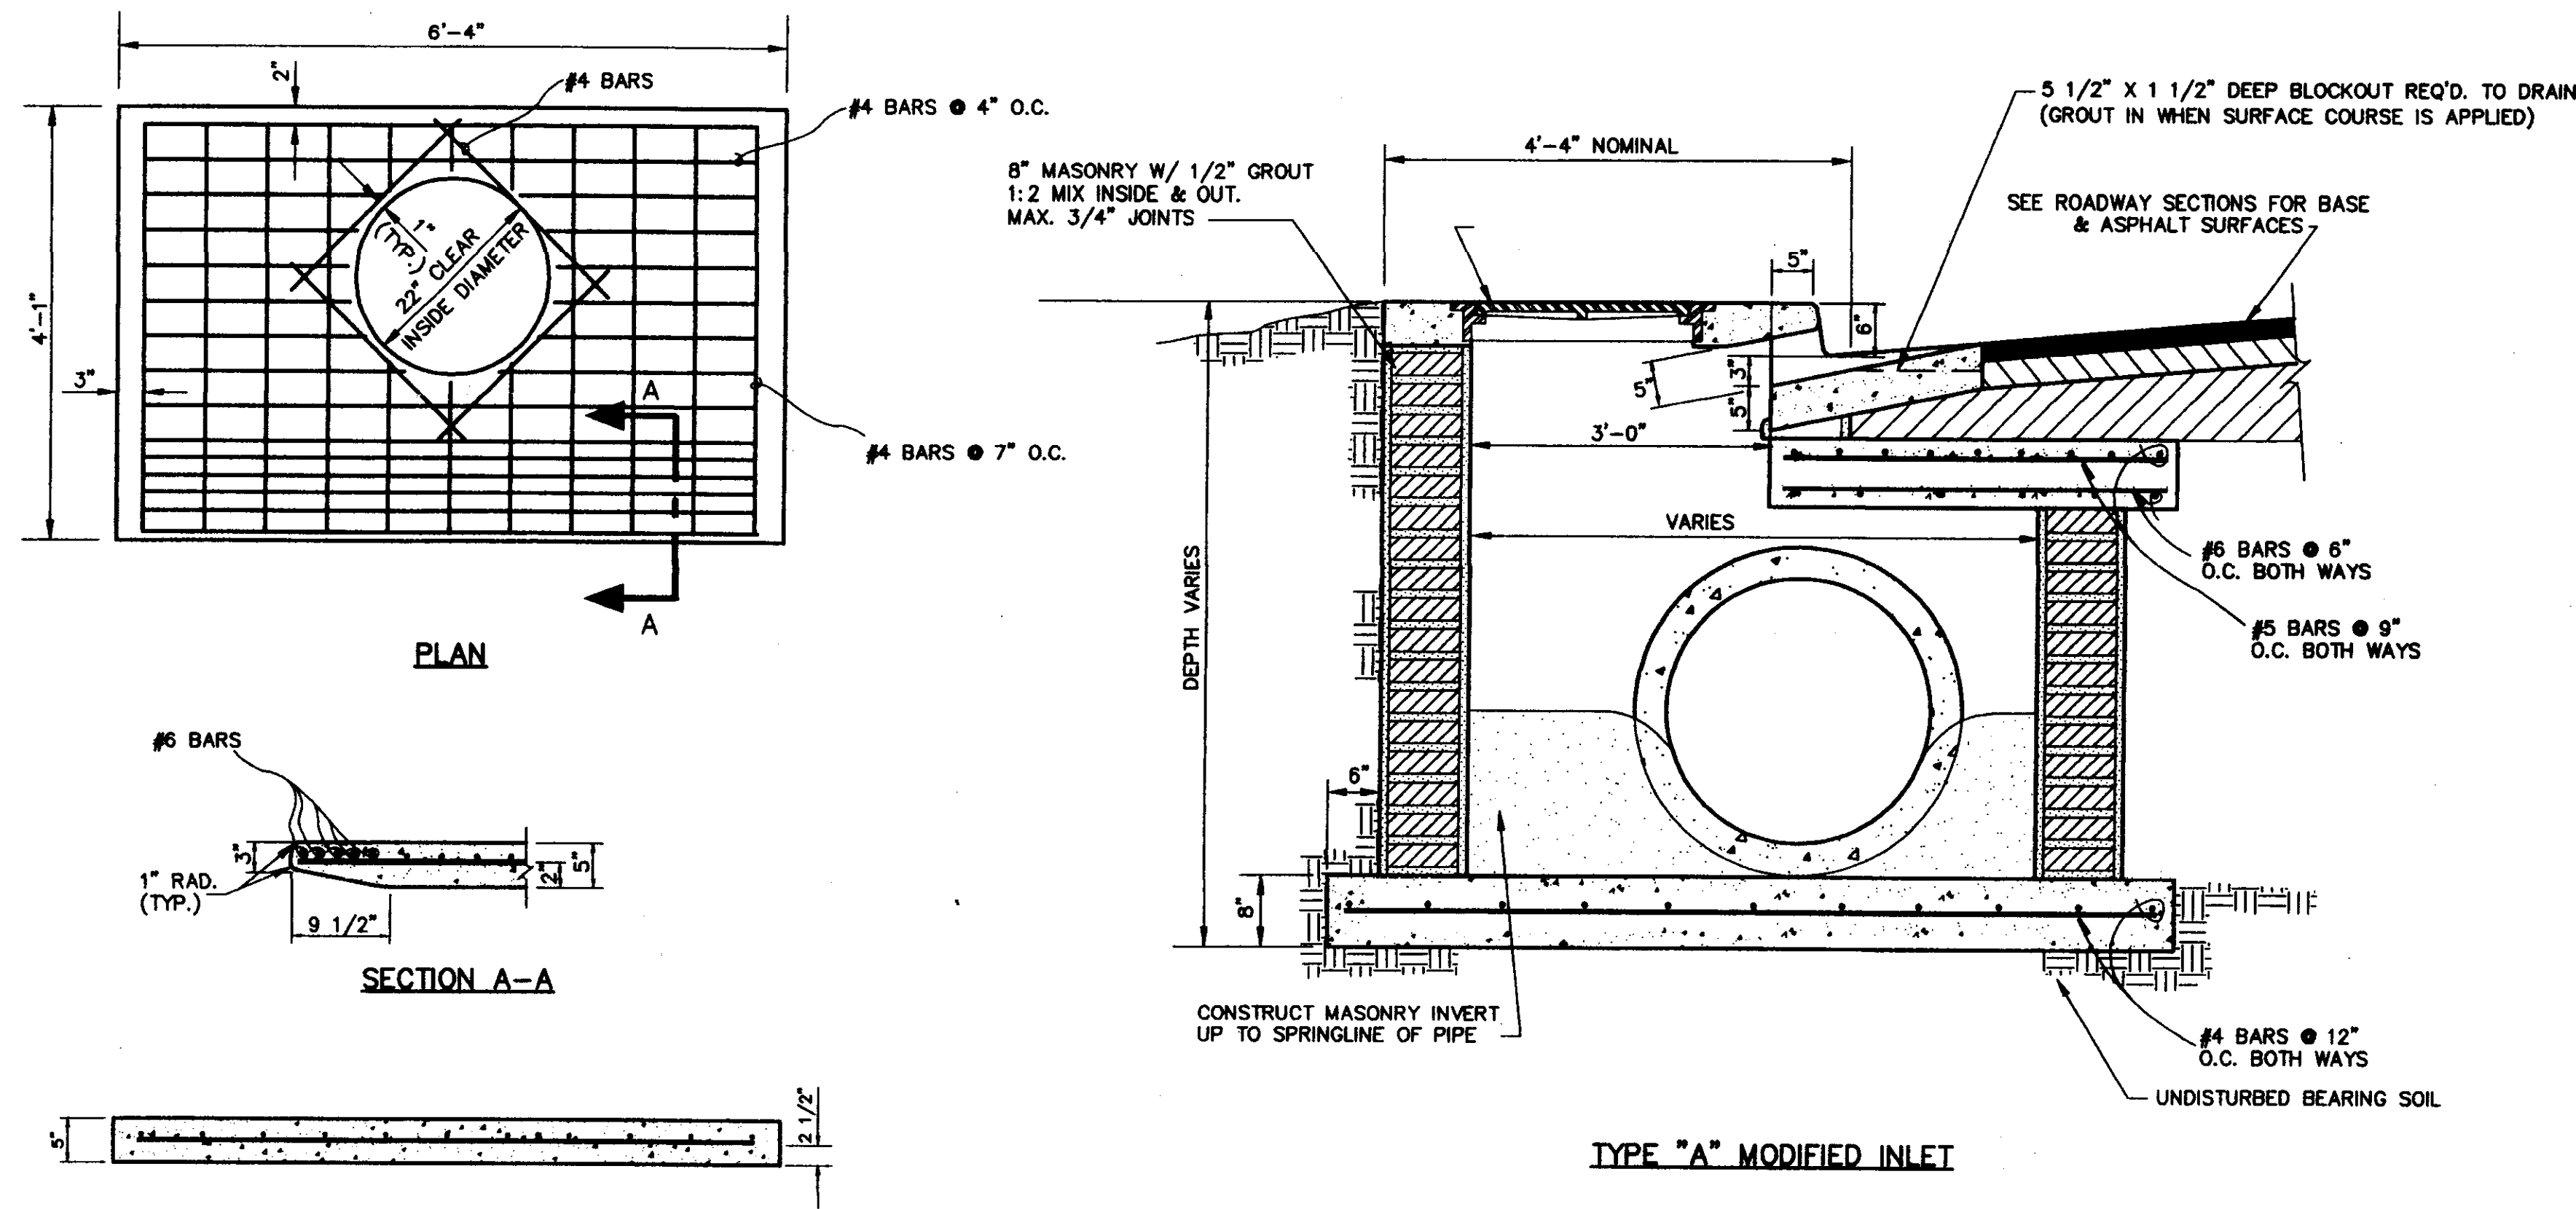


TYPE "A" MODIFIED INLET

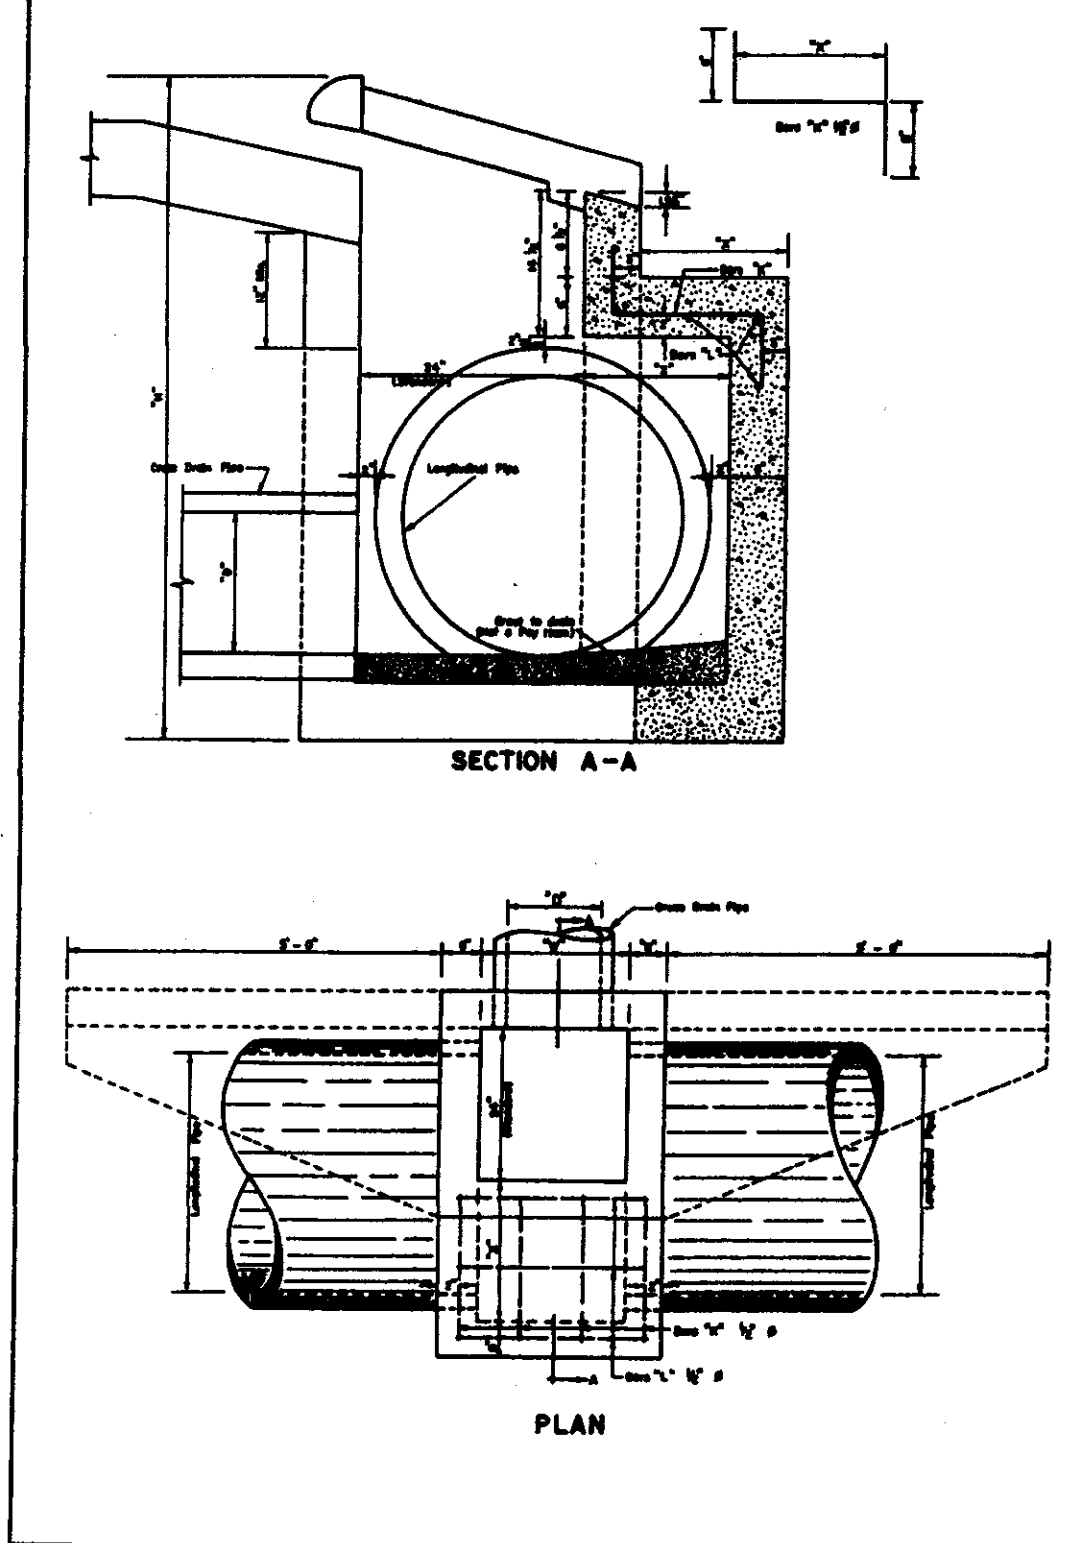


DIMENSIONS		QUANTITIES		MATERIALS	
NO.	DESCRIPTION	AMOUNT	UNIT	ITEM NO.	REMARKS
1	CONCRETE	1.00	CU YD	0101	CONCRETE
2	BRICK	1.00	CU YD	0201	BRICK
3	PLASTER	1.00	CU YD	0301	PLASTER
4	REINFORCING BARS	1.00	TON	0401	REINFORCING BARS
5	GRAVEL	1.00	CU YD	0501	GRAVEL
6	PIPE	1.00	LINEAL FT.	0601	PIPE
7	GRATE	1.00	EA	0701	GRATE
8	FOOTING	1.00	CU YD	0801	FOOTING
9	CONCRETE	1.00	CU YD	0901	CONCRETE
10	BRICK	1.00	CU YD	1001	BRICK
11	PLASTER	1.00	CU YD	1101	PLASTER
12	REINFORCING BARS	1.00	TON	1201	REINFORCING BARS
13	GRAVEL	1.00	CU YD	1301	GRAVEL
14	PIPE	1.00	LINEAL FT.	1401	PIPE
15	GRATE	1.00	EA	1501	GRATE
16	FOOTING	1.00	CU YD	1601	FOOTING
17	CONCRETE	1.00	CU YD	1701	CONCRETE
18	BRICK	1.00	CU YD	1801	BRICK
19	PLASTER	1.00	CU YD	1901	PLASTER
20	REINFORCING BARS	1.00	TON	2001	REINFORCING BARS
21	GRAVEL	1.00	CU YD	2101	GRAVEL
22	PIPE	1.00	LINEAL FT.	2201	PIPE
23	GRATE	1.00	EA	2301	GRATE
24	FOOTING	1.00	CU YD	2401	FOOTING
25	CONCRETE	1.00	CU YD	2501	CONCRETE
26	BRICK	1.00	CU YD	2601	BRICK
27	PLASTER	1.00	CU YD	2701	PLASTER
28	REINFORCING BARS	1.00	TON	2801	REINFORCING BARS
29	GRAVEL	1.00	CU YD	2901	GRAVEL
30	PIPE	1.00	LINEAL FT.	3001	PIPE
31	GRATE	1.00	EA	3101	GRATE
32	FOOTING	1.00	CU YD	3201	FOOTING
33	CONCRETE	1.00	CU YD	3301	CONCRETE
34	BRICK	1.00	CU YD	3401	BRICK
35	PLASTER	1.00	CU YD	3501	PLASTER
36	REINFORCING BARS	1.00	TON	3601	REINFORCING BARS
37	GRAVEL	1.00	CU YD	3701	GRAVEL
38	PIPE	1.00	LINEAL FT.	3801	PIPE
39	GRATE	1.00	EA	3901	GRATE
40	FOOTING	1.00	CU YD	4001	FOOTING
41	CONCRETE	1.00	CU YD	4101	CONCRETE
42	BRICK	1.00	CU YD	4201	BRICK
43	PLASTER	1.00	CU YD	4301	PLASTER
44	REINFORCING BARS	1.00	TON	4401	REINFORCING BARS
45	GRAVEL	1.00	CU YD	4501	GRAVEL
46	PIPE	1.00	LINEAL FT.	4601	PIPE
47	GRATE	1.00	EA	4701	GRATE
48	FOOTING	1.00	CU YD	4801	FOOTING
49	CONCRETE	1.00	CU YD	4901	CONCRETE
50	BRICK	1.00	CU YD	5001	BRICK
51	PLASTER	1.00	CU YD	5101	PLASTER
52	REINFORCING BARS	1.00	TON	5201	REINFORCING BARS
53	GRAVEL	1.00	CU YD	5301	GRAVEL
54	PIPE	1.00	LINEAL FT.	5401	PIPE
55	GRATE	1.00	EA	5501	GRATE
56	FOOTING	1.00	CU YD	5601	FOOTING
57	CONCRETE	1.00	CU YD	5701	CONCRETE
58	BRICK	1.00	CU YD	5801	BRICK
59	PLASTER	1.00	CU YD	5901	PLASTER
60	REINFORCING BARS	1.00	TON	6001	REINFORCING BARS

- GENERAL NOTES**
1. PLAN SHALL BE USED AS A GUIDE ONLY. REFER TO SPECIFICATIONS FOR ALL DETAILS.
  2. FOR ALL DETAILS NOT SHOWN REFER TO SPECIFICATIONS.
  3. MATERIALS SHALL BE AS SPECIFIED OR OF EQUAL QUALITY. ALL MATERIALS SHALL BE APPROVED BY THE ENGINEER BEFORE USE.
  4. FINISH GRADE SHALL BE MAINTAINED AS SHOWN UNLESS OTHERWISE NOTED.
  5. THE ENGINEER SHALL BE RESPONSIBLE FOR THE PROPER INSTALLATION OF ALL DETAILS.


MISSISSIPPI STATE HIGHWAY DEPARTMENT  
**STORM SEWER INLET**  
 TYPE SS-1B  
 (LONGITUDINAL DRAINAGE)  
 SHEET NUMBER 28A.1

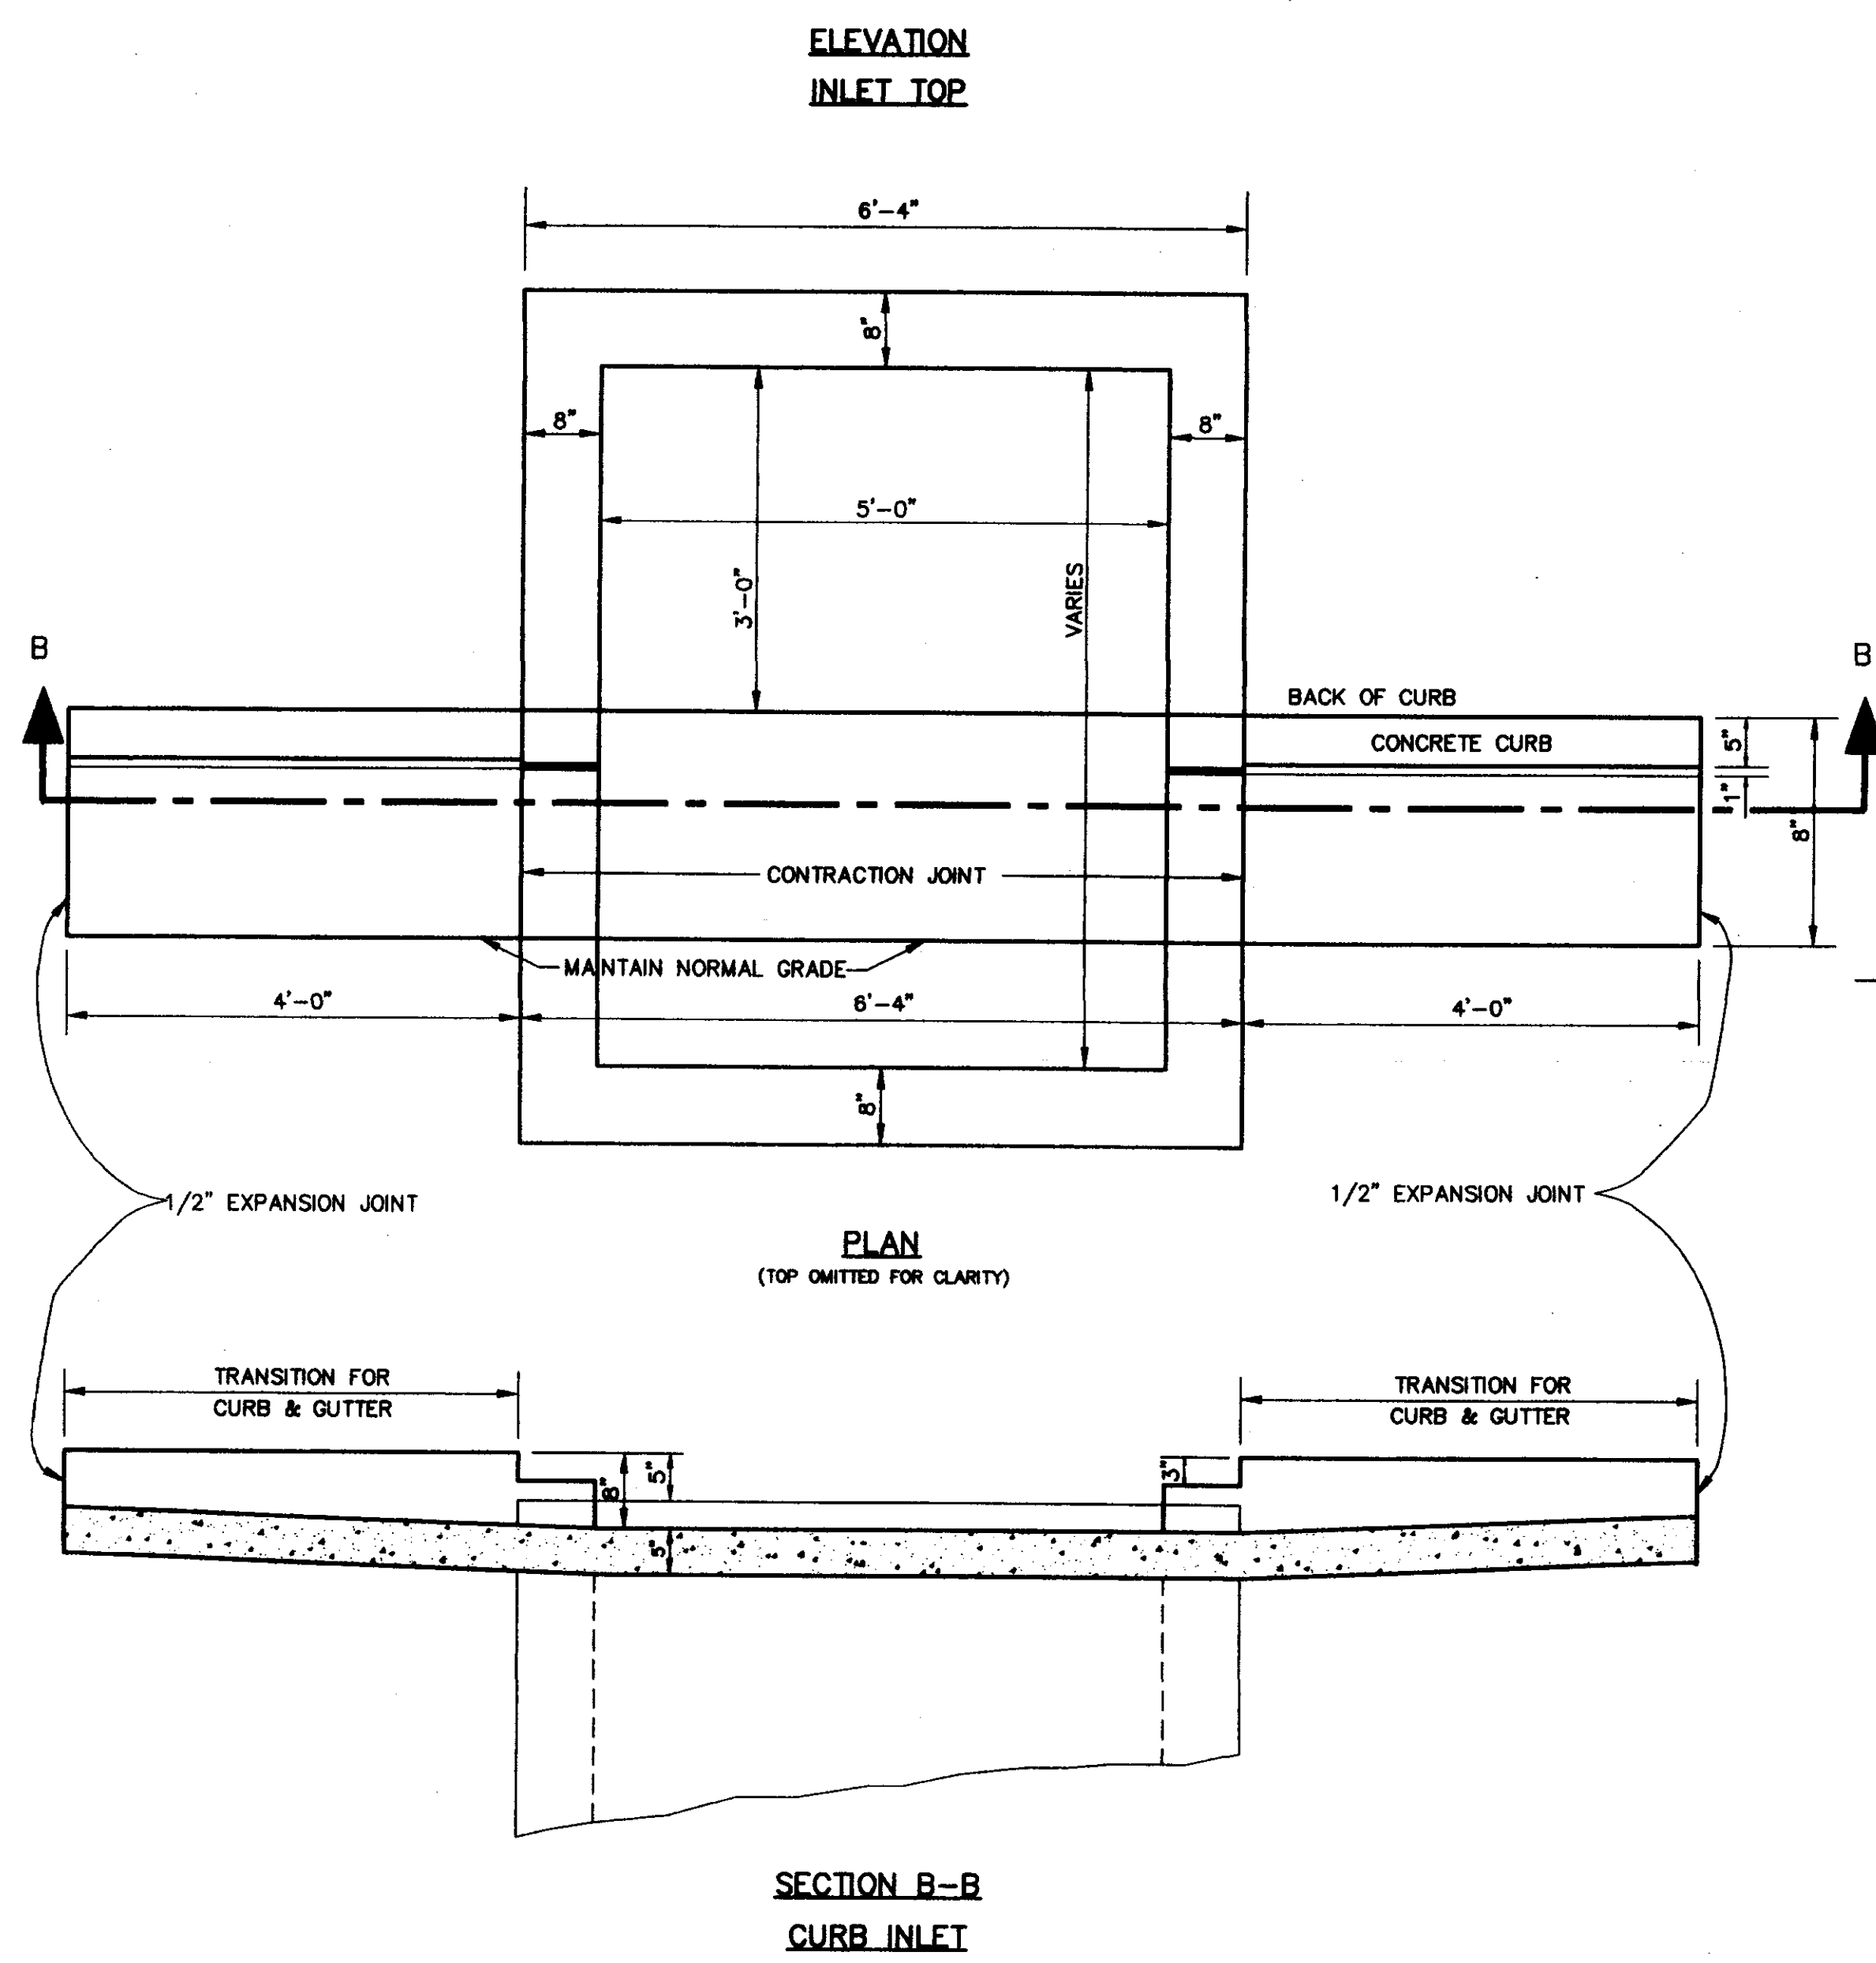

SECTION B-B  
CURB INLET

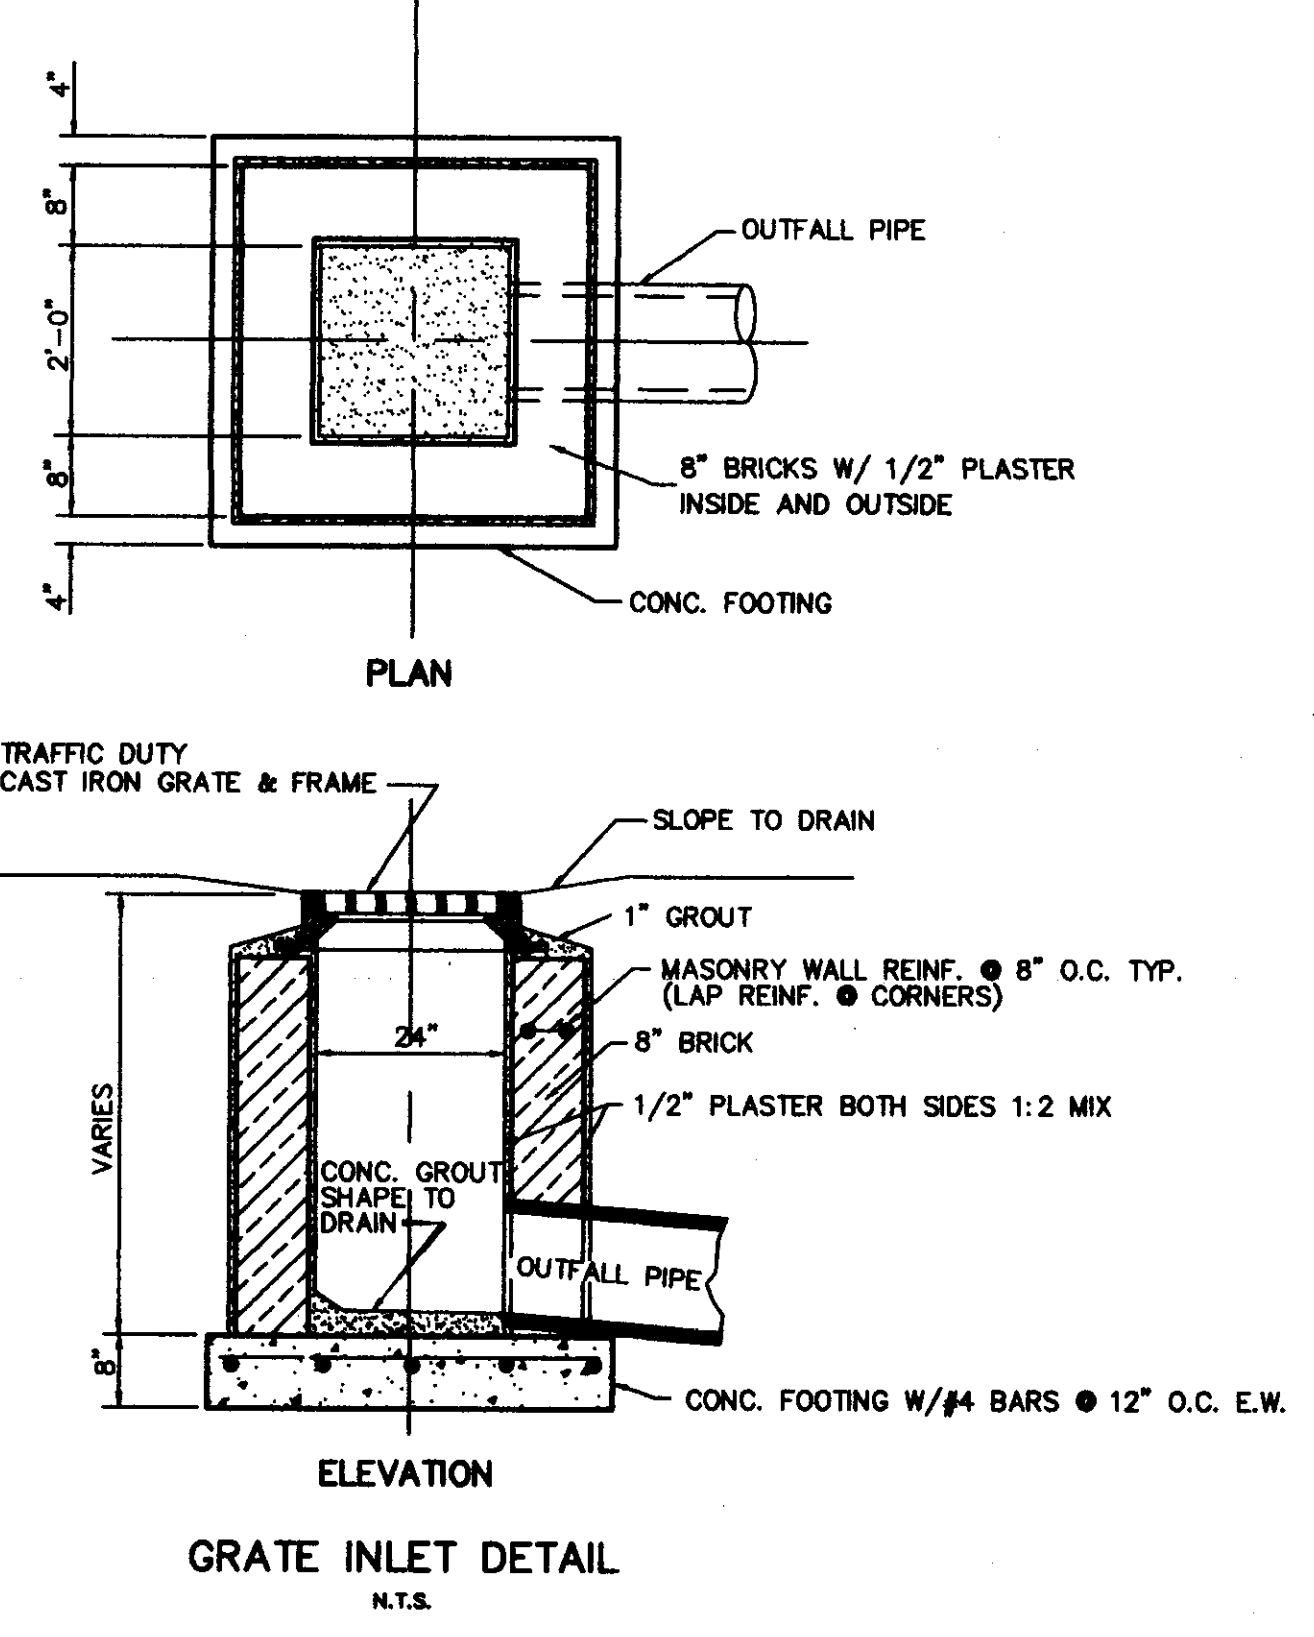

GRATE INLET DETAIL  
N.T.S.

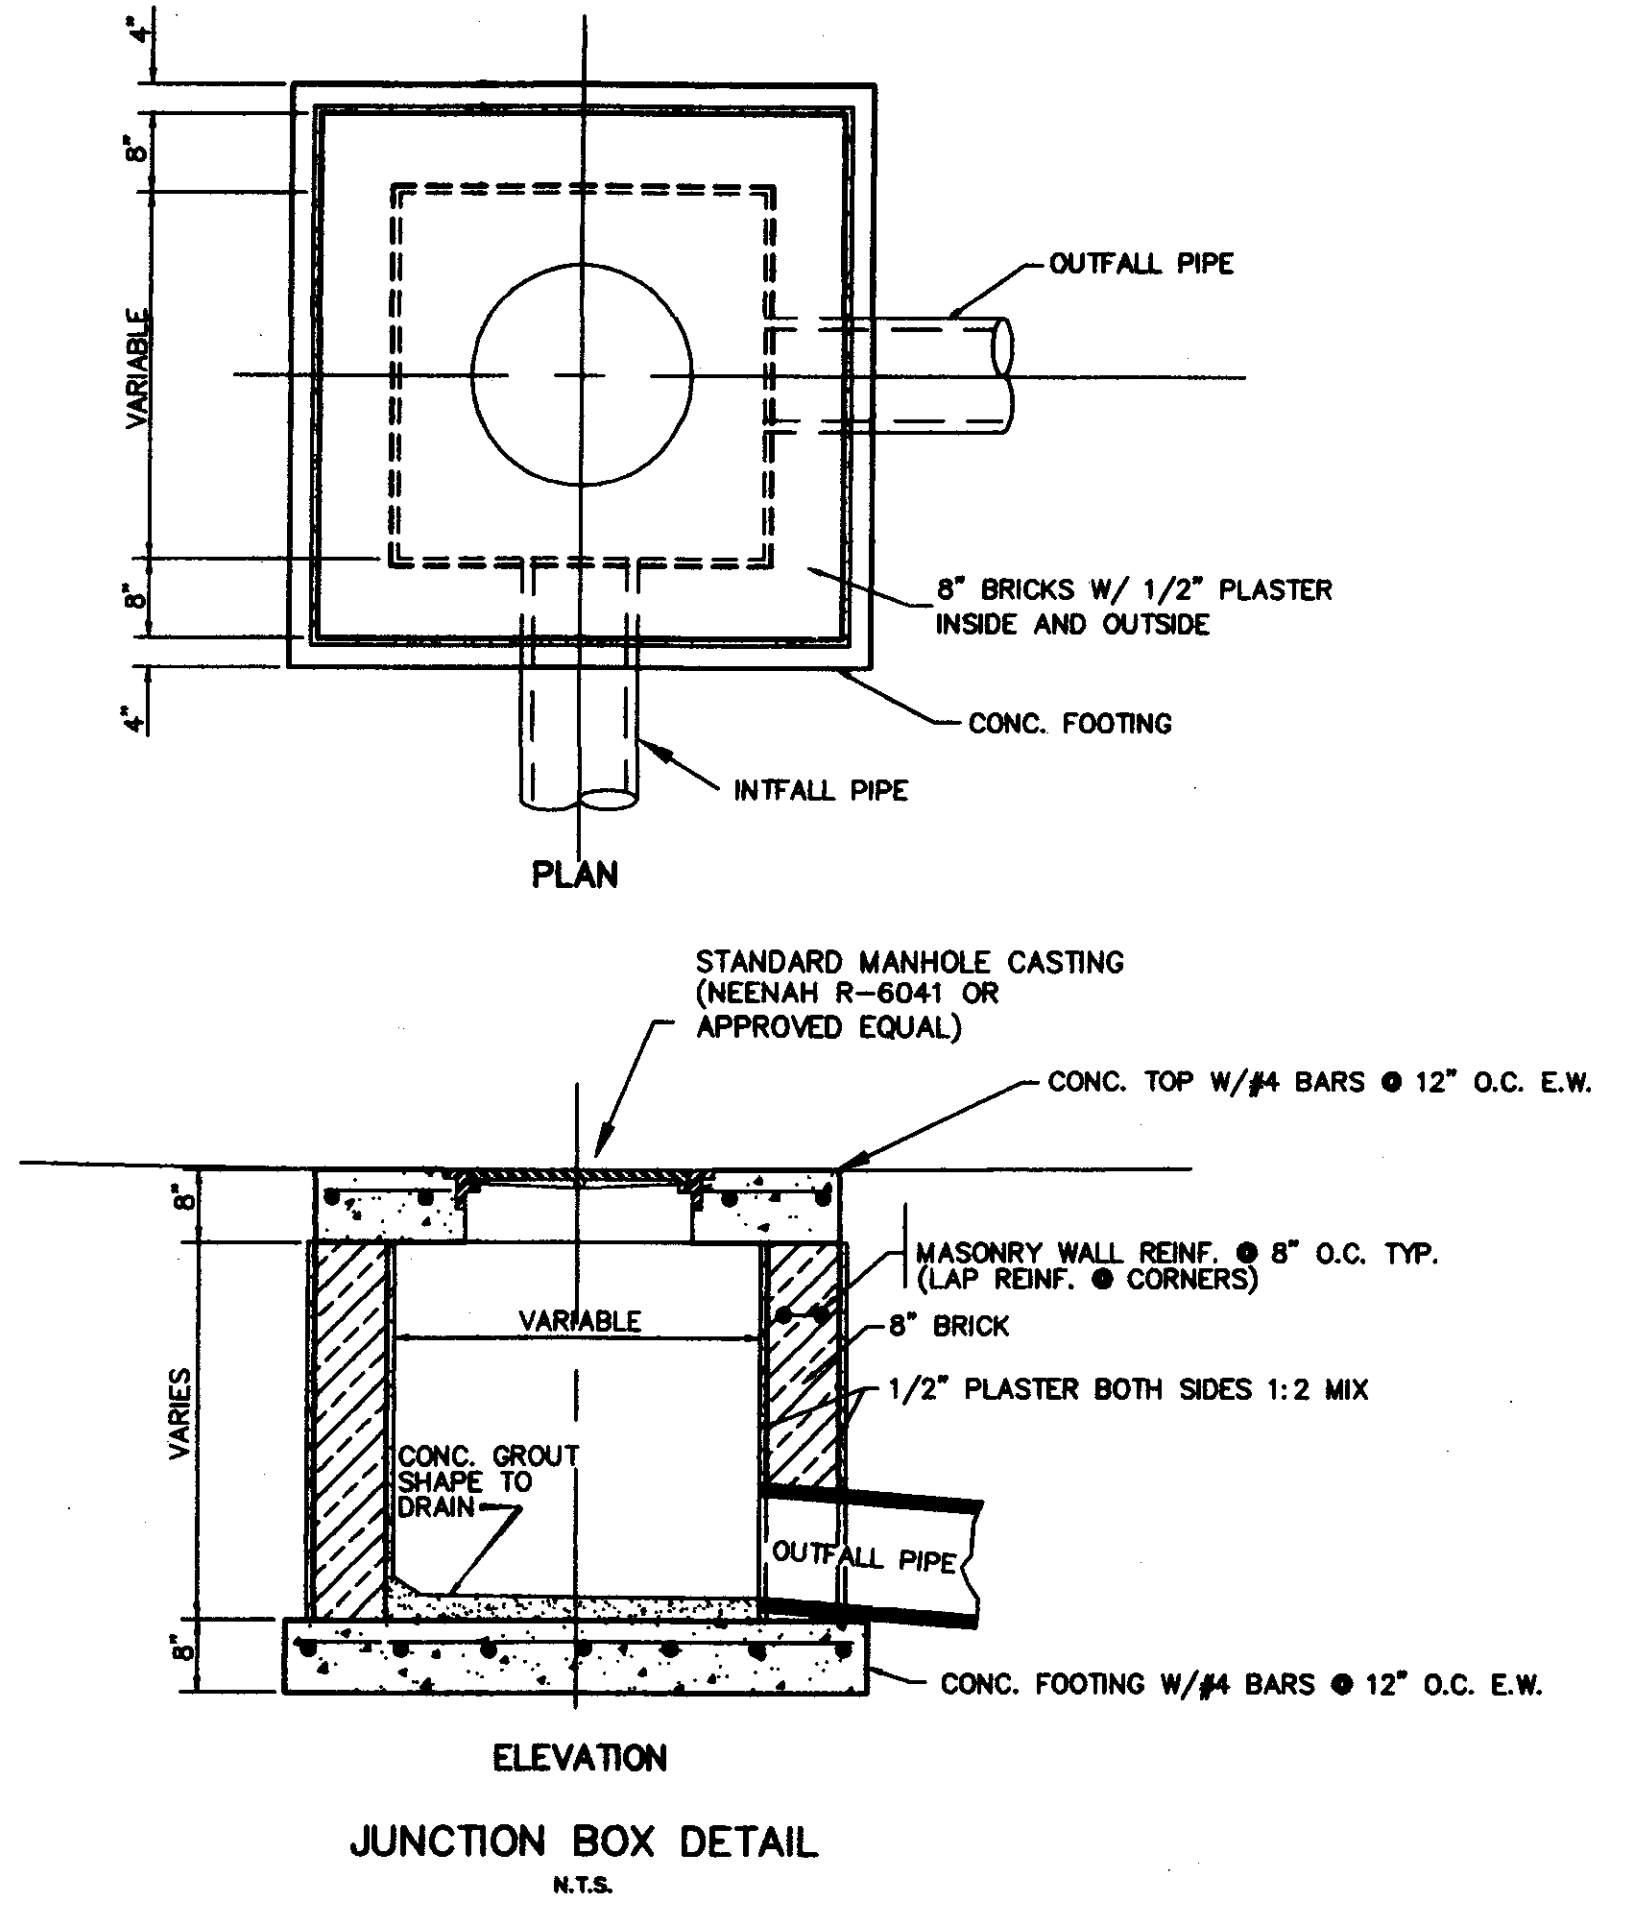


JUNCTION BOX DETAIL  
N.T.S.












RECORD DRAWING  
FEBRUARY 1997

CITY OF RIDGELAND, MISSISSIPPI  
 INLET AND HEADWALL DETAILS  
 EAST SCHOOL STREET/  
 WHEATLEY STREET RECONSTRUCTION  
 WAGGONER ENGINEERING, INC.  
 Consulting Engineers - Jackson, Mississippi  
 DRAWN BY C.R.H. DATE 4-1-93 SHEET NUMBER  
 REVISION BY B.W. SCALE N.T.S. 12 OF 14







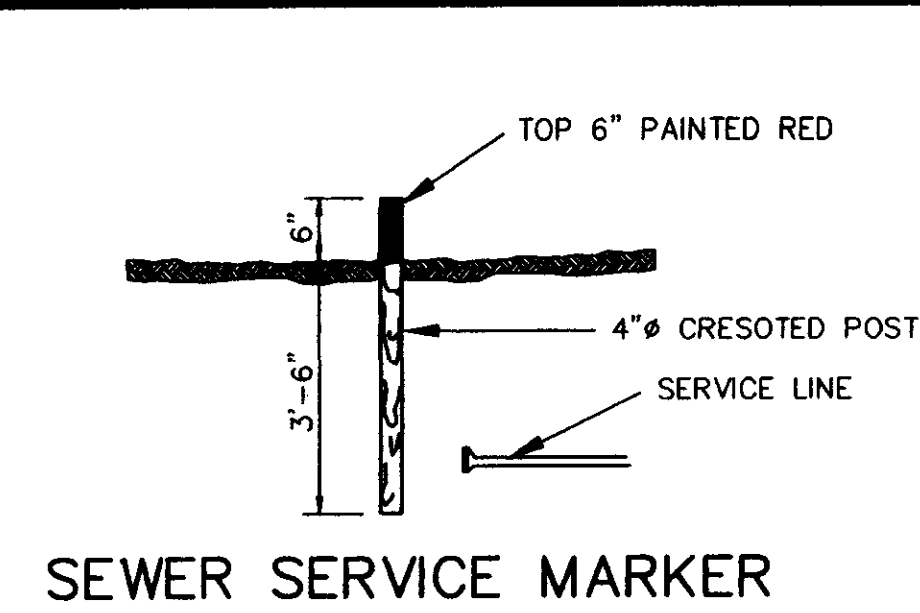

NOTES: DIMENSION "A" TO BE 3' MIN. FOR ALL CASINGS. DIMENSIONS "B" TO BE 2" MIN. FOR LINES 3" DIA. AND UNDER, AND 4" MIN. FOR LINES OVER 3". ENCASUREMENTS TO BE INSTALLED UNDER THE ROAD BY MEANS OF JACKING THROUGH, OR BY DRY BORING A HOLE THAT WILL RECIEVE THE CASING WITH A SNUG FIT.

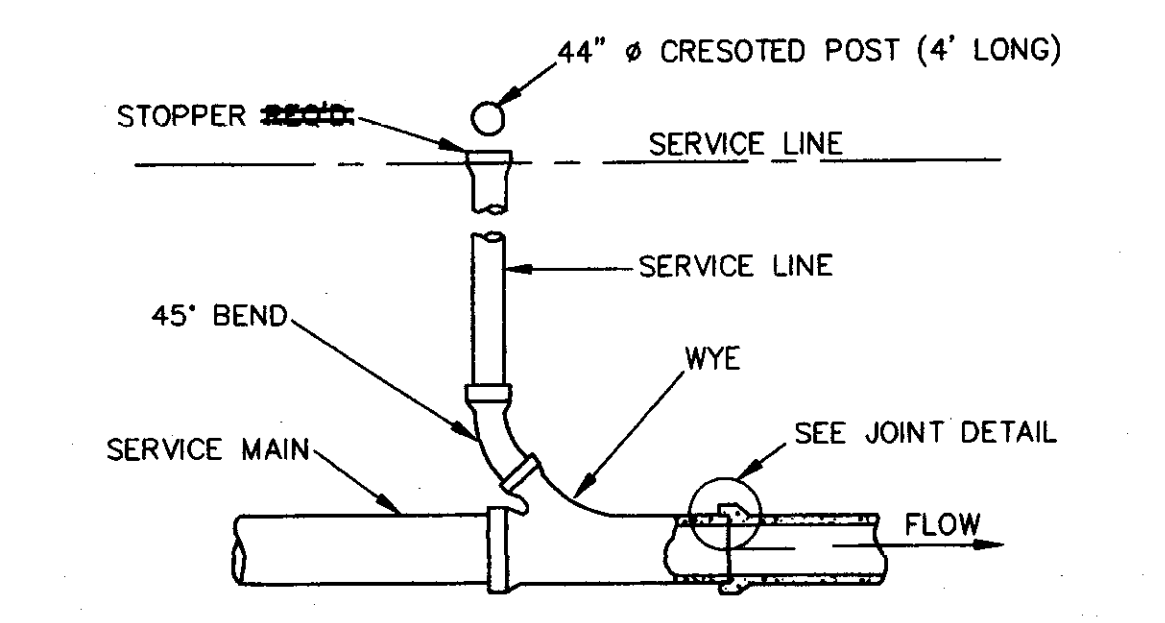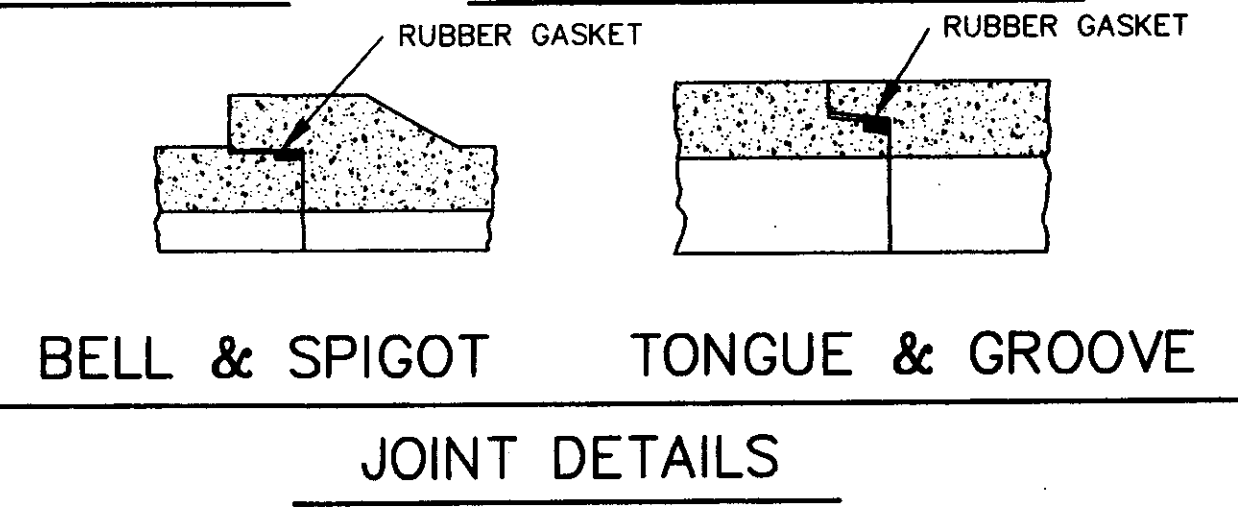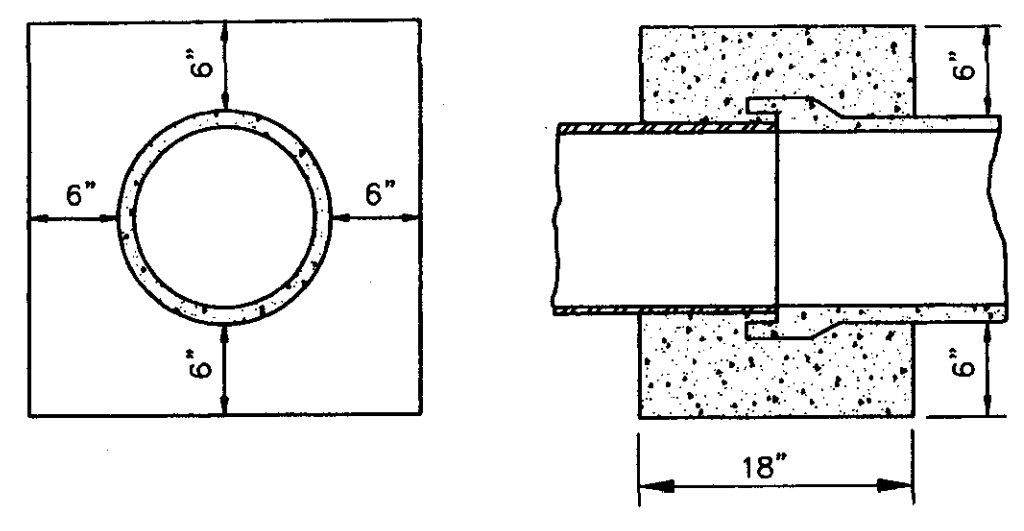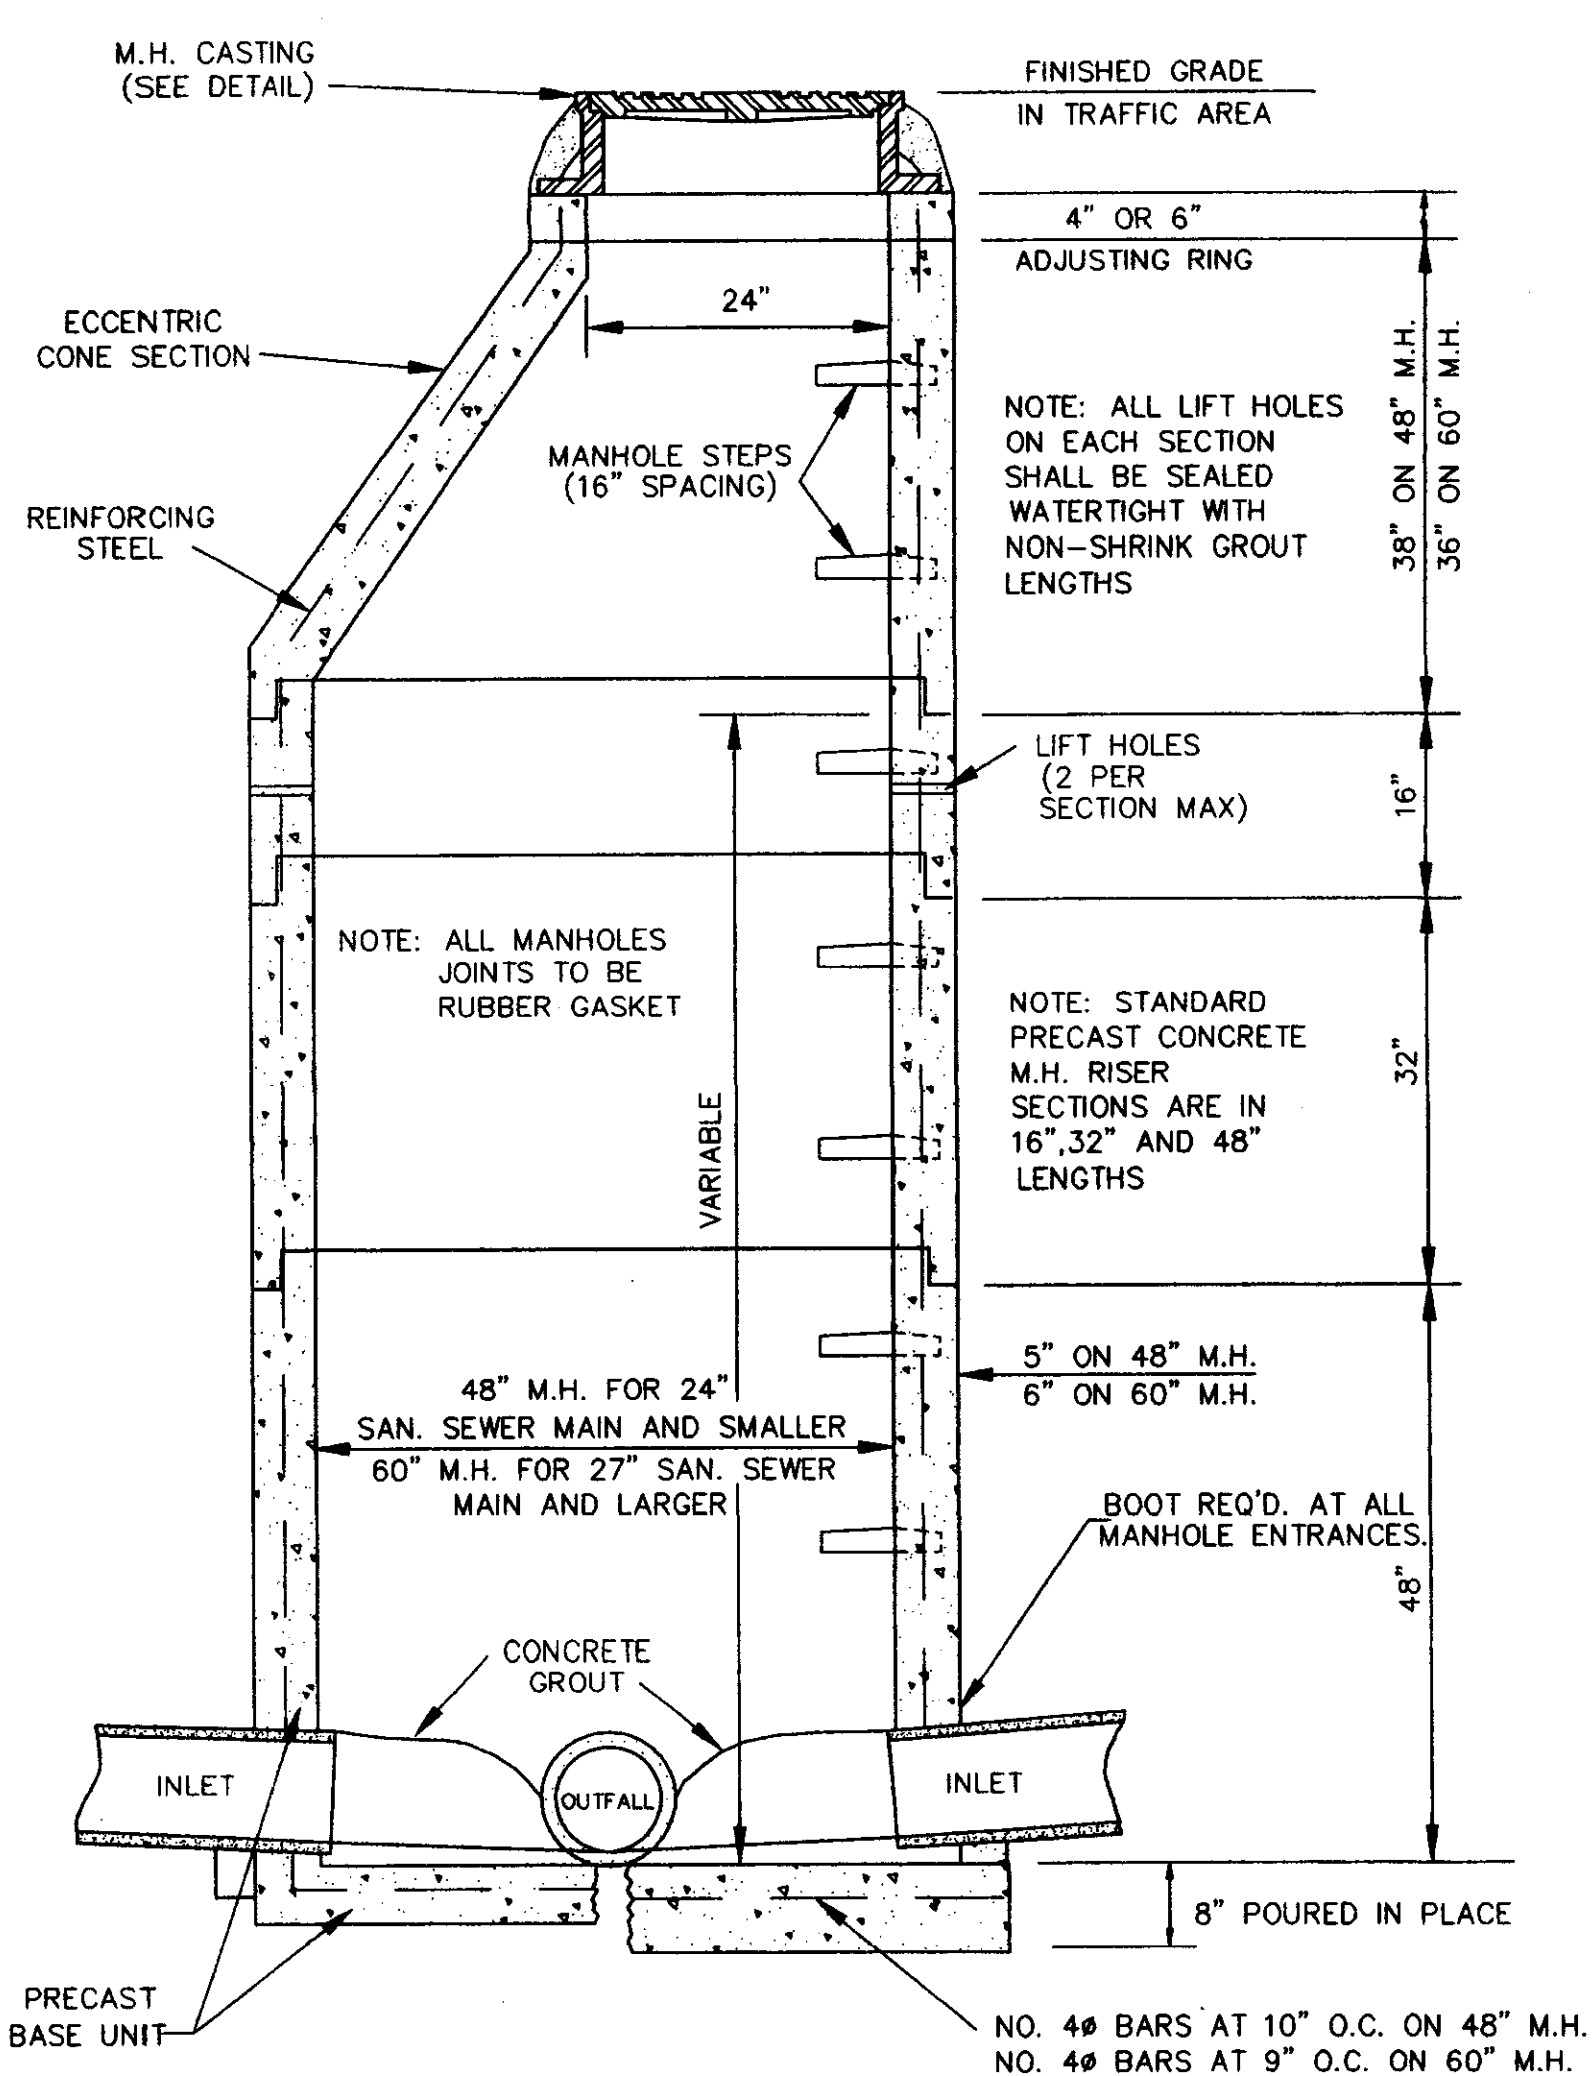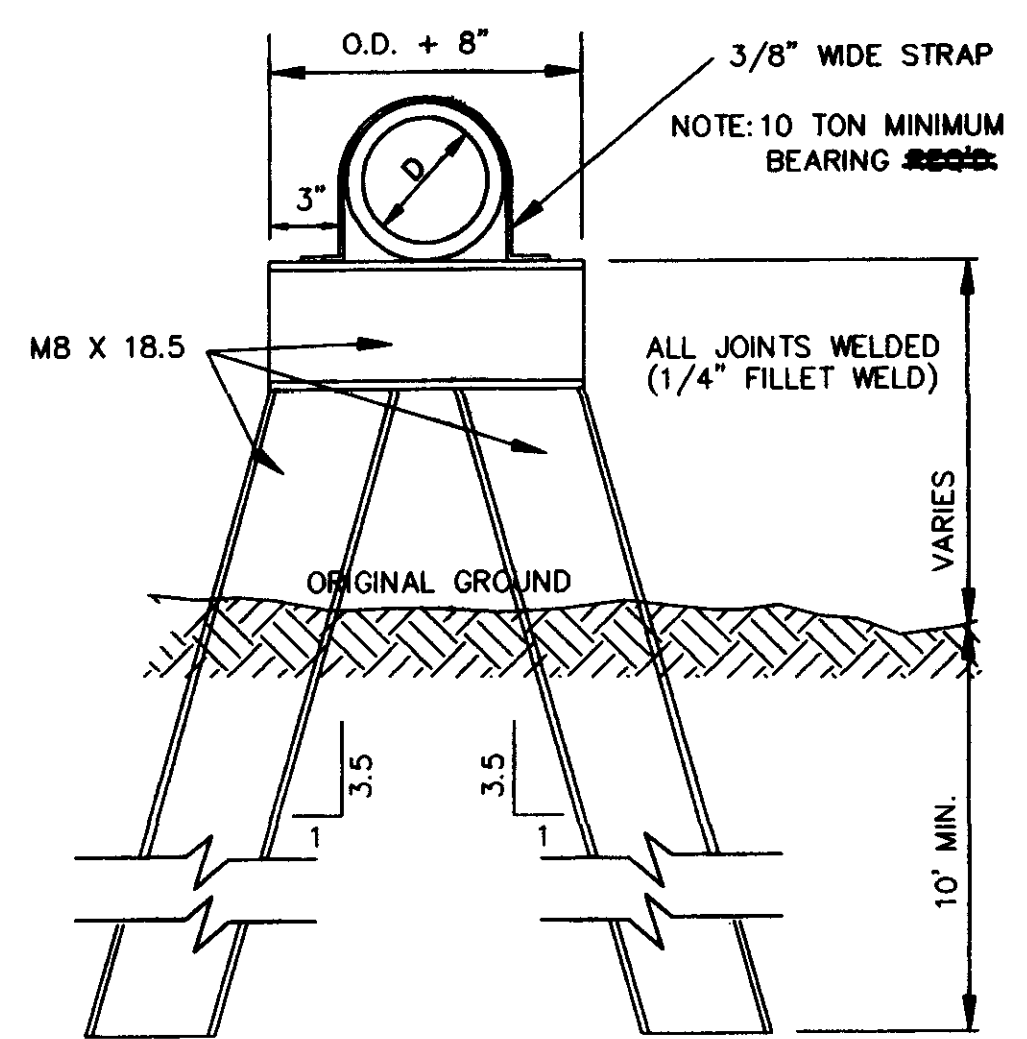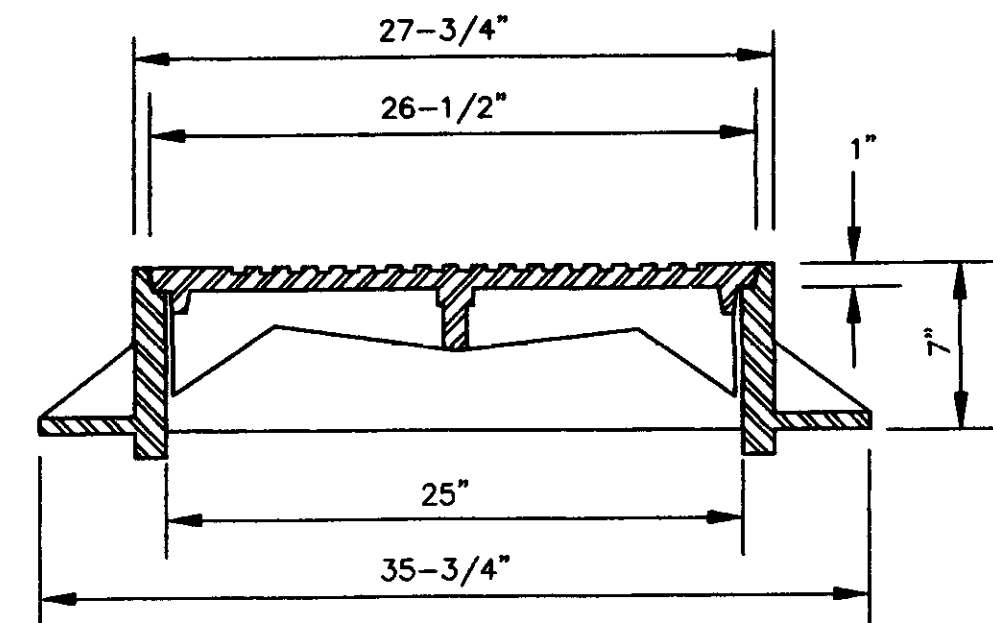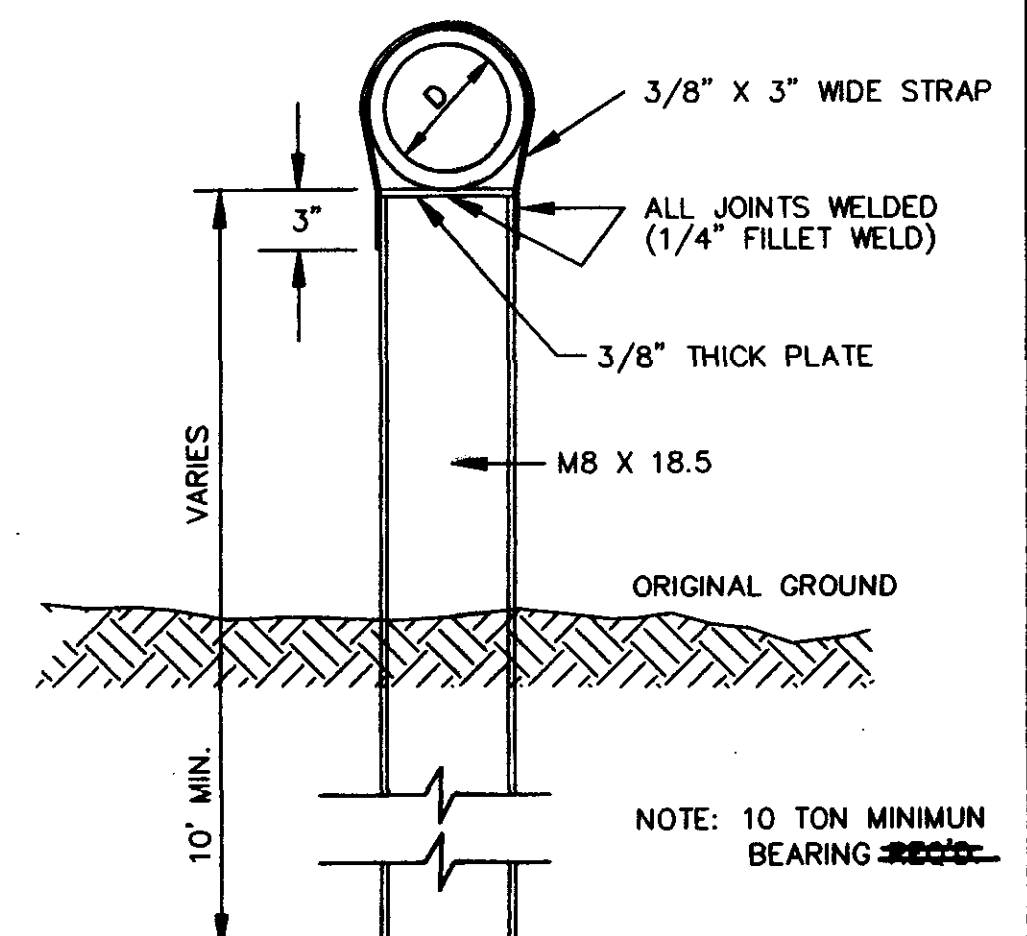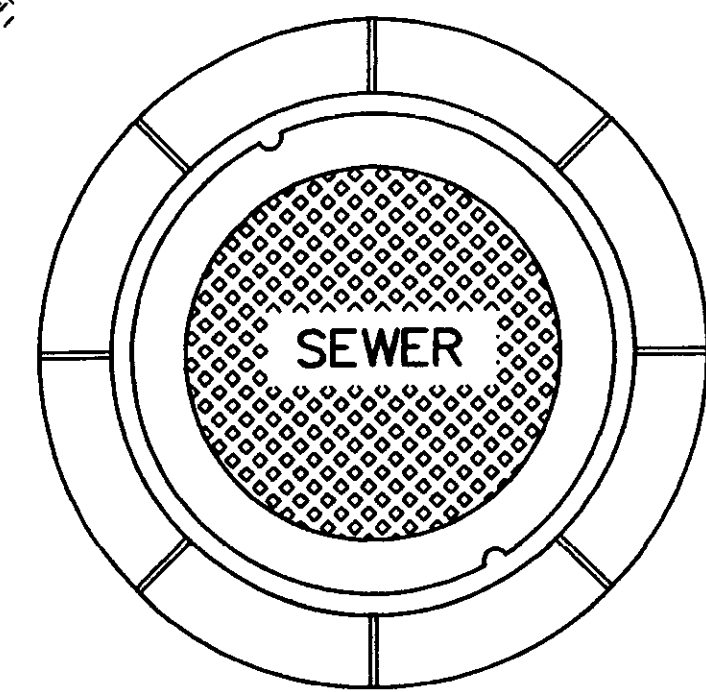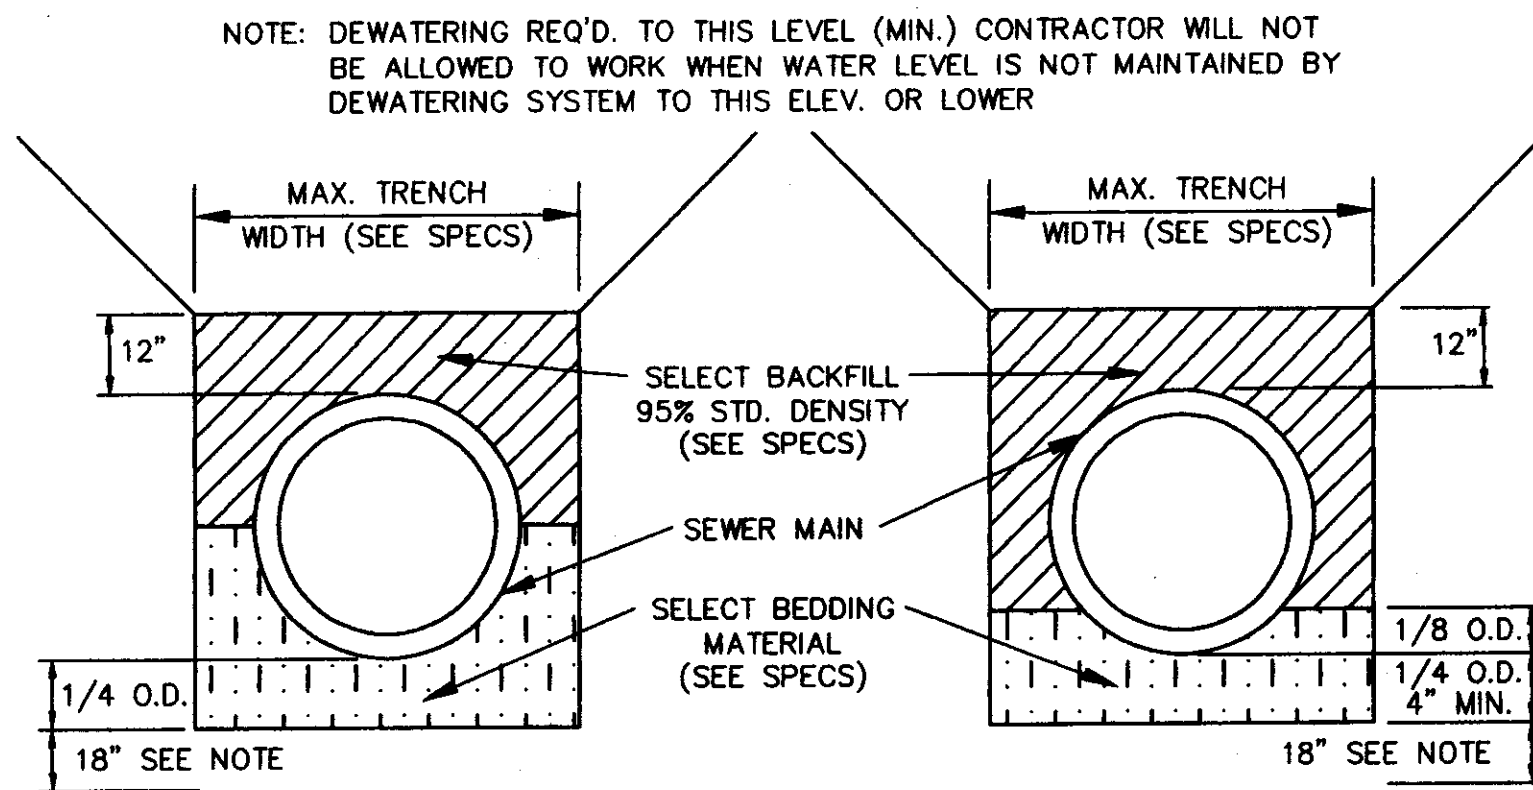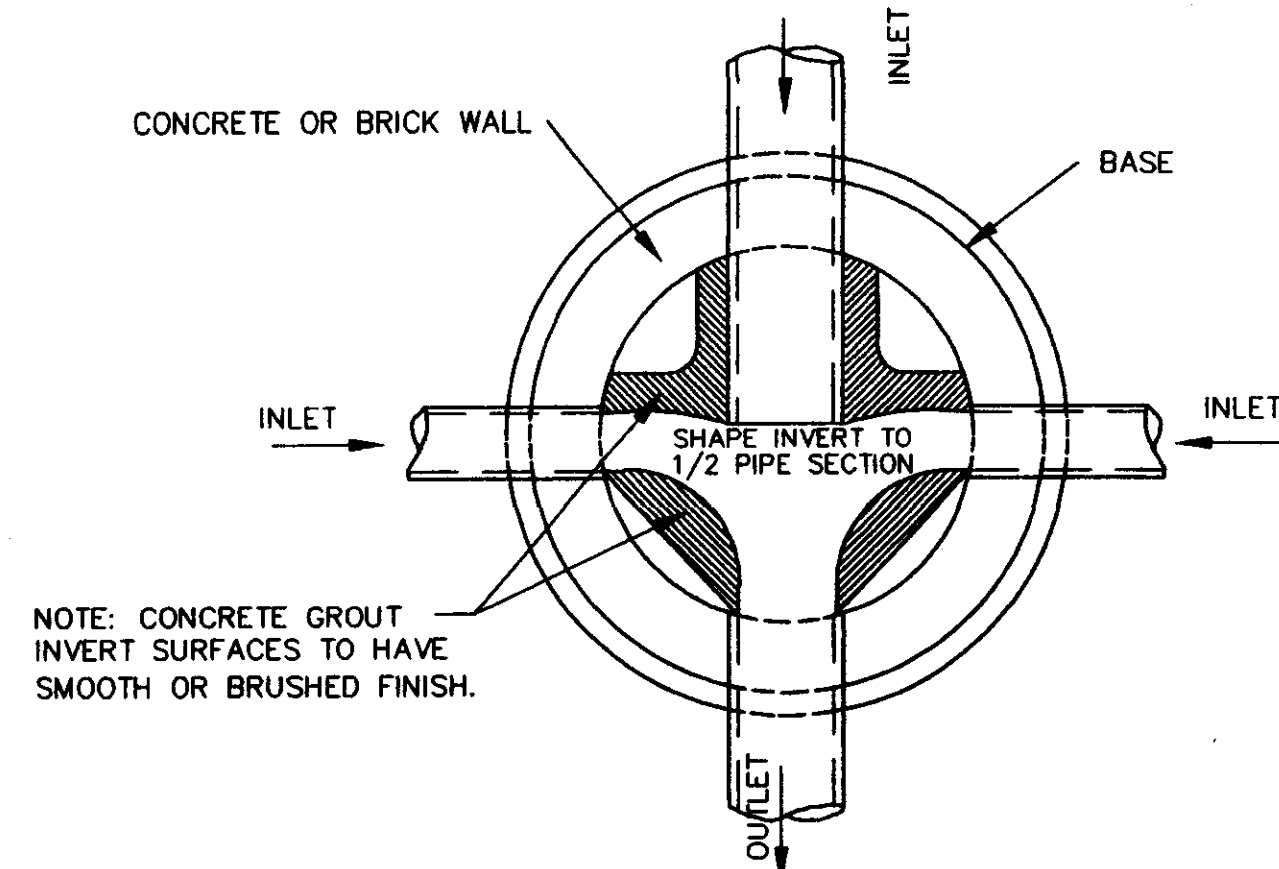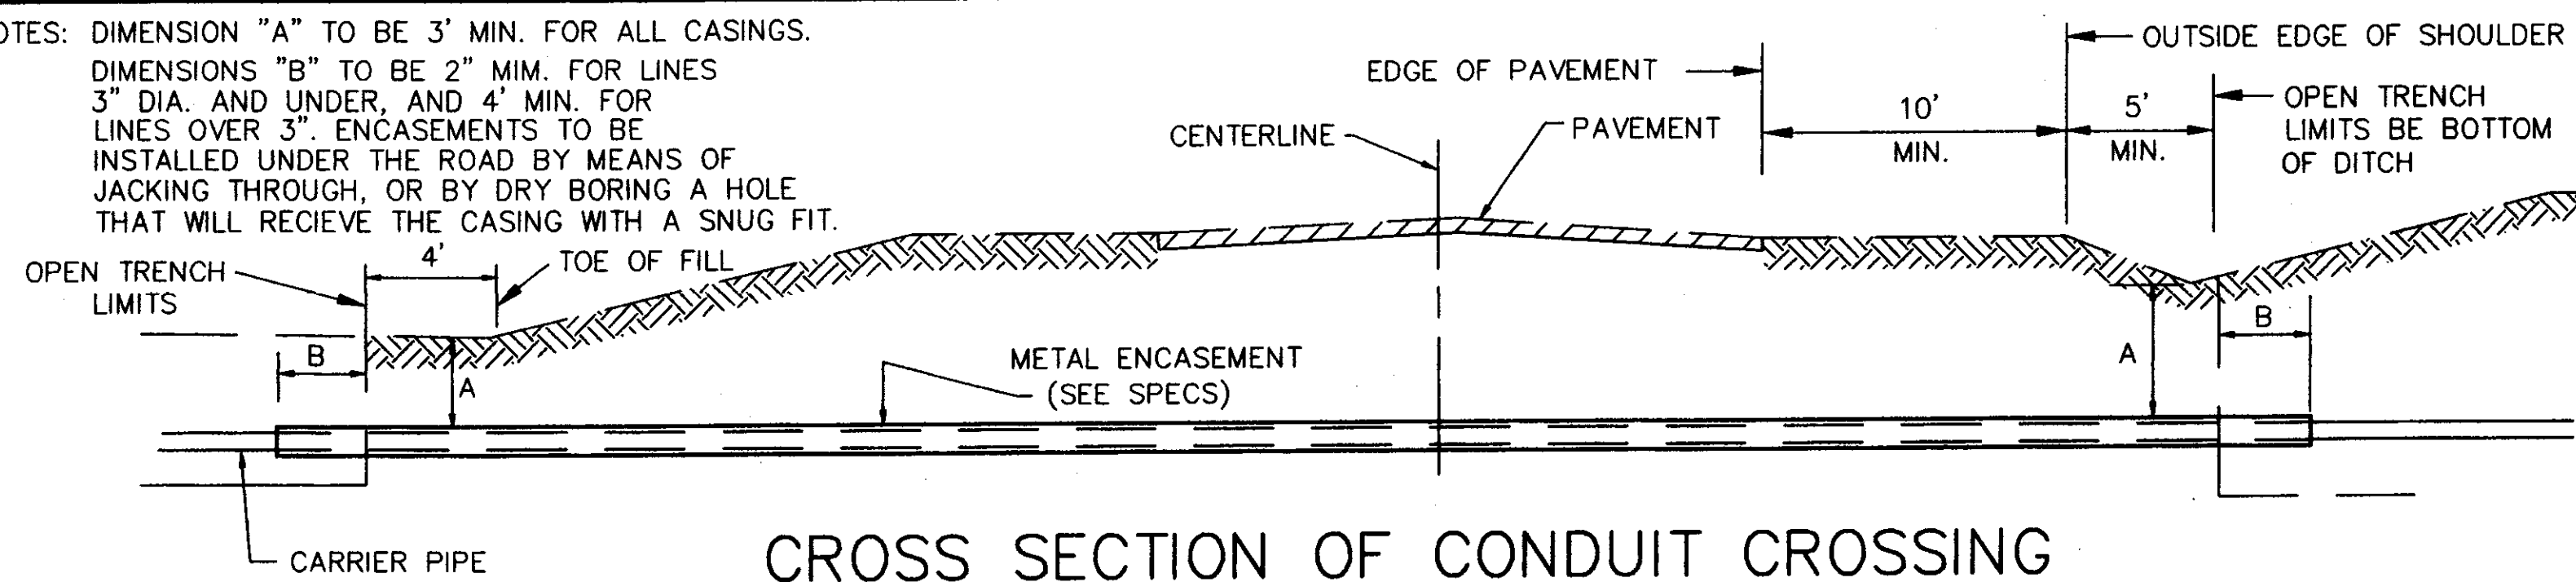

NOTE: 1. USE TYPE "A" MANHOLE CASTING IN STREET R.O.W. 2. USE VULCAN NO. VM-8, (440 lbs.)

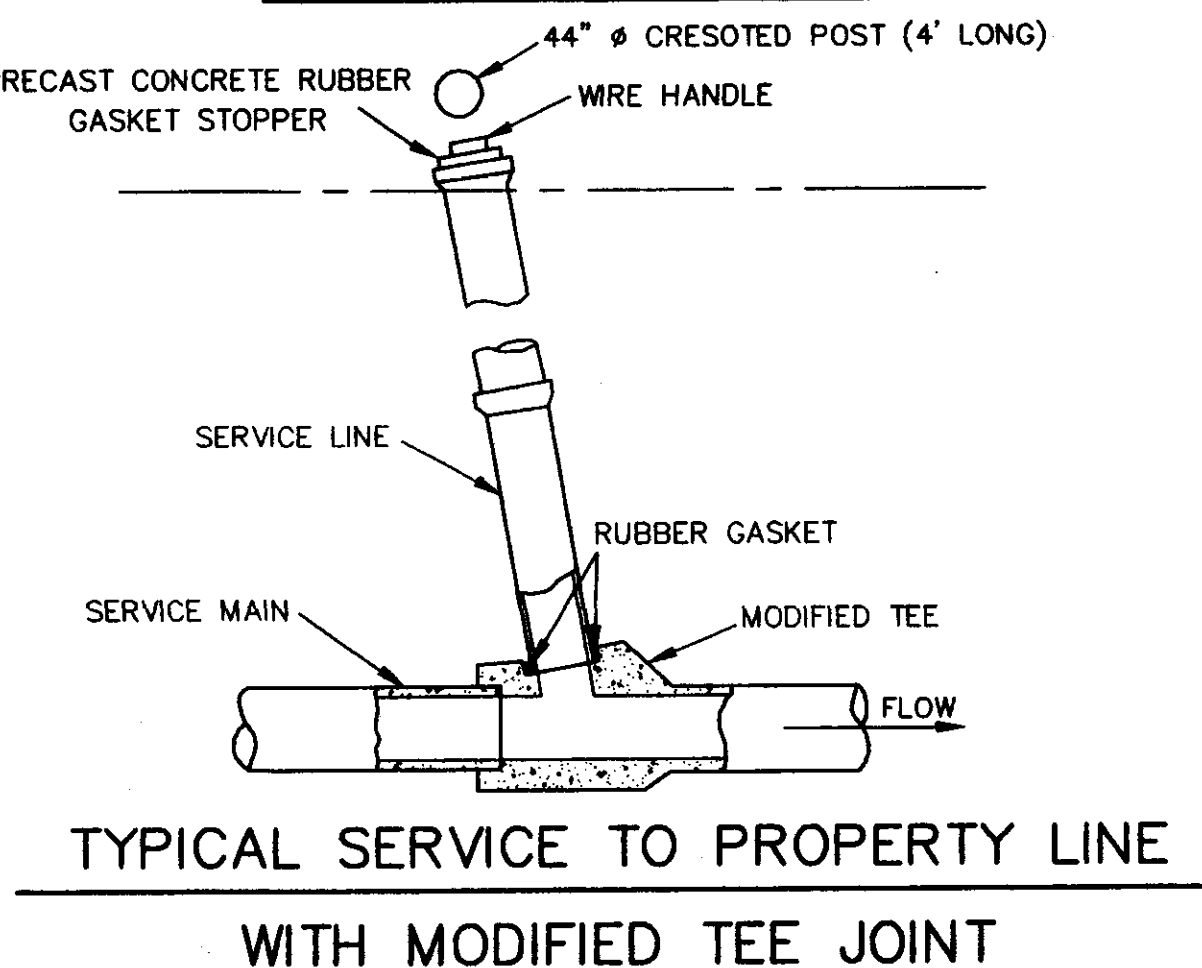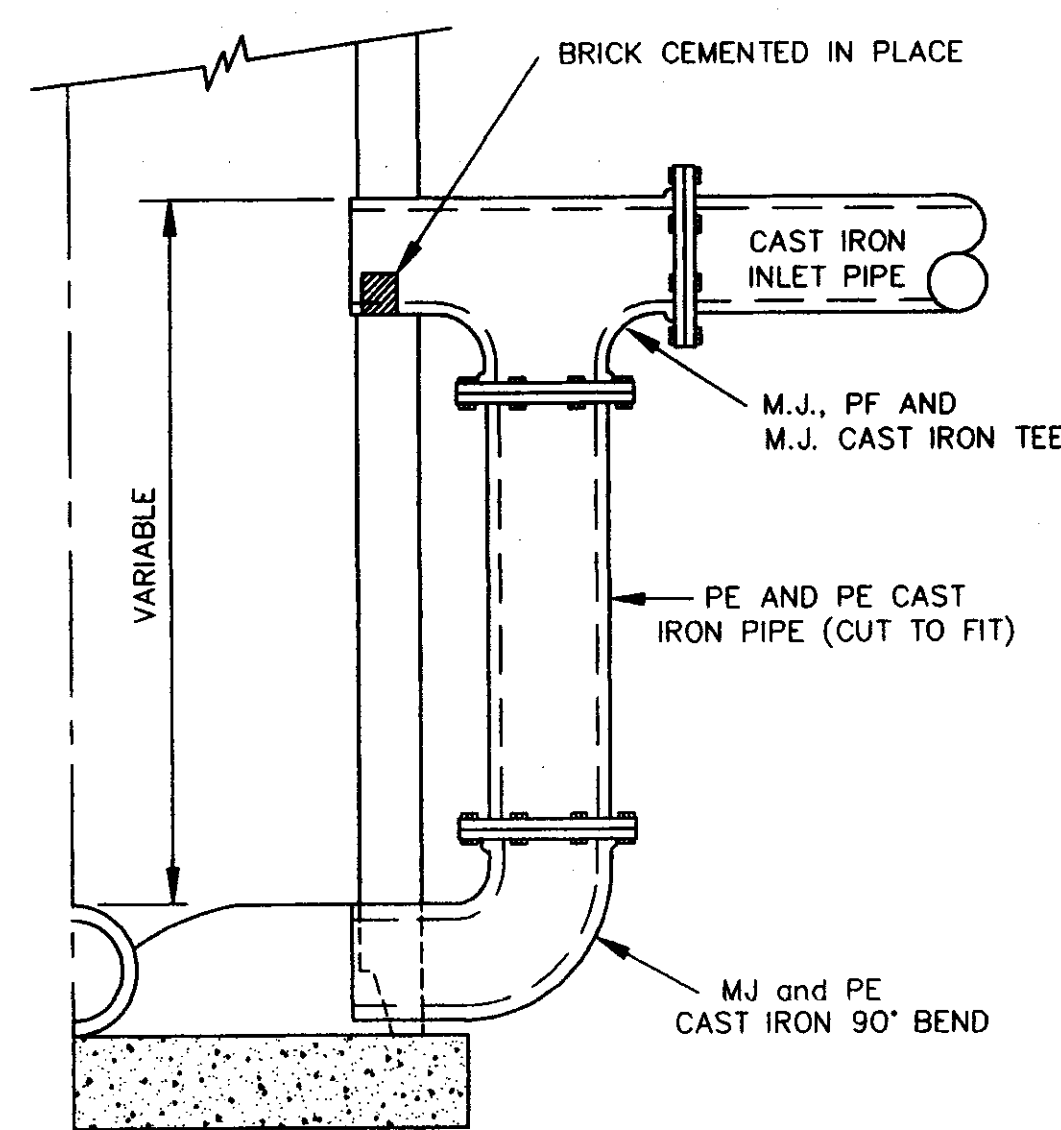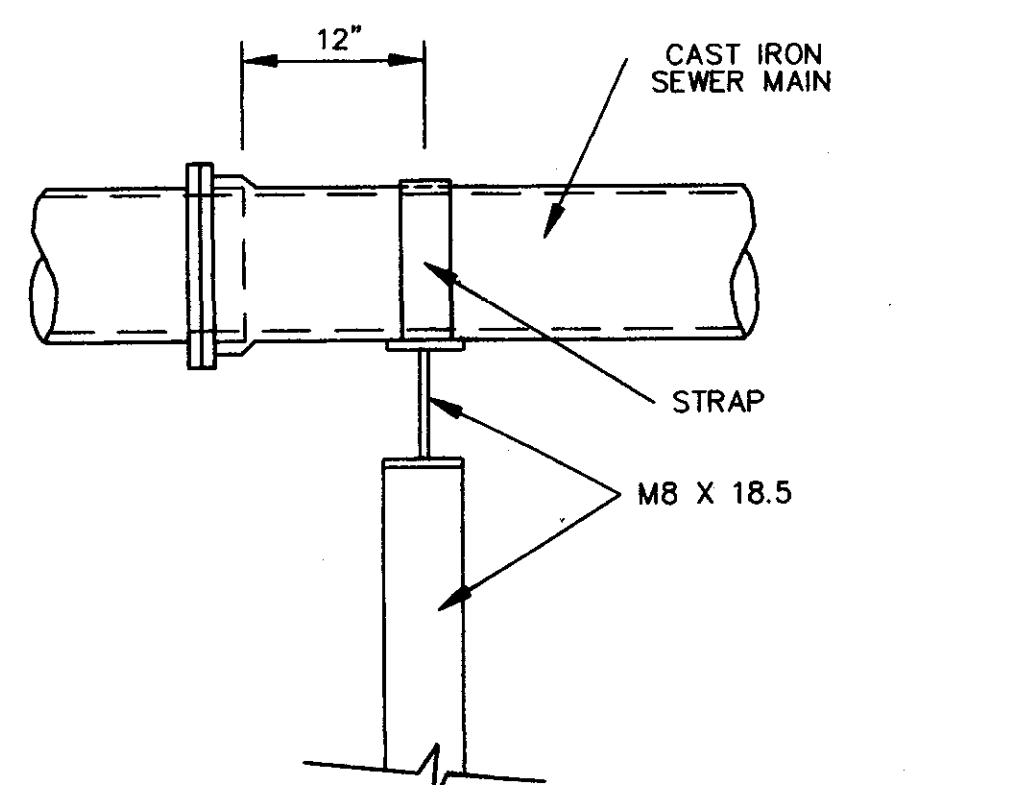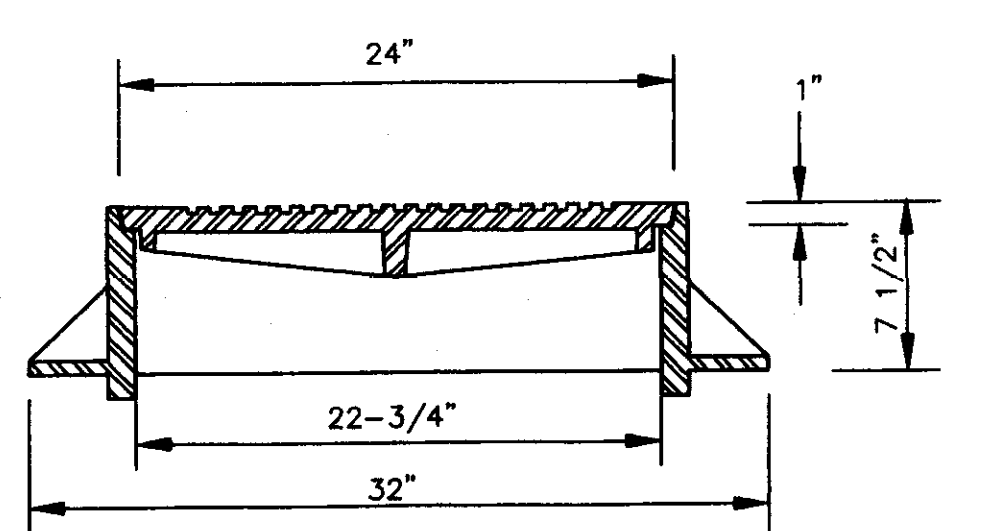


NOTE: 1. USE TYPE "B" MANHOLE CASTING FOR ANY MANHOLE NOT IN A STREET R.O.W. 2. VULCAN NO. VM-7 (300 LBS.) OR NEENAH NO. R-1779 (300 LBS.)

RECORD DRAWING  
FEBRUARY 1997

**CITY OF RIDGELAND, MISSISSIPPI**  
**SANITARY SEWER - STANDARD DETAILS**  
 EAST SCHOOL STREET/  
 WHEATLEY SREET RECONSTRUCTION


WAGGONER ENGINEERING, INC.  
 Consulting Engineers - Jackson, Mississippi

DRAWN BY: C.R.H. DATE: JULY-1995 SHEET NUMBER  
 REVIEWED BY: B.W. SCALE: N.T.S. 13 OF 14

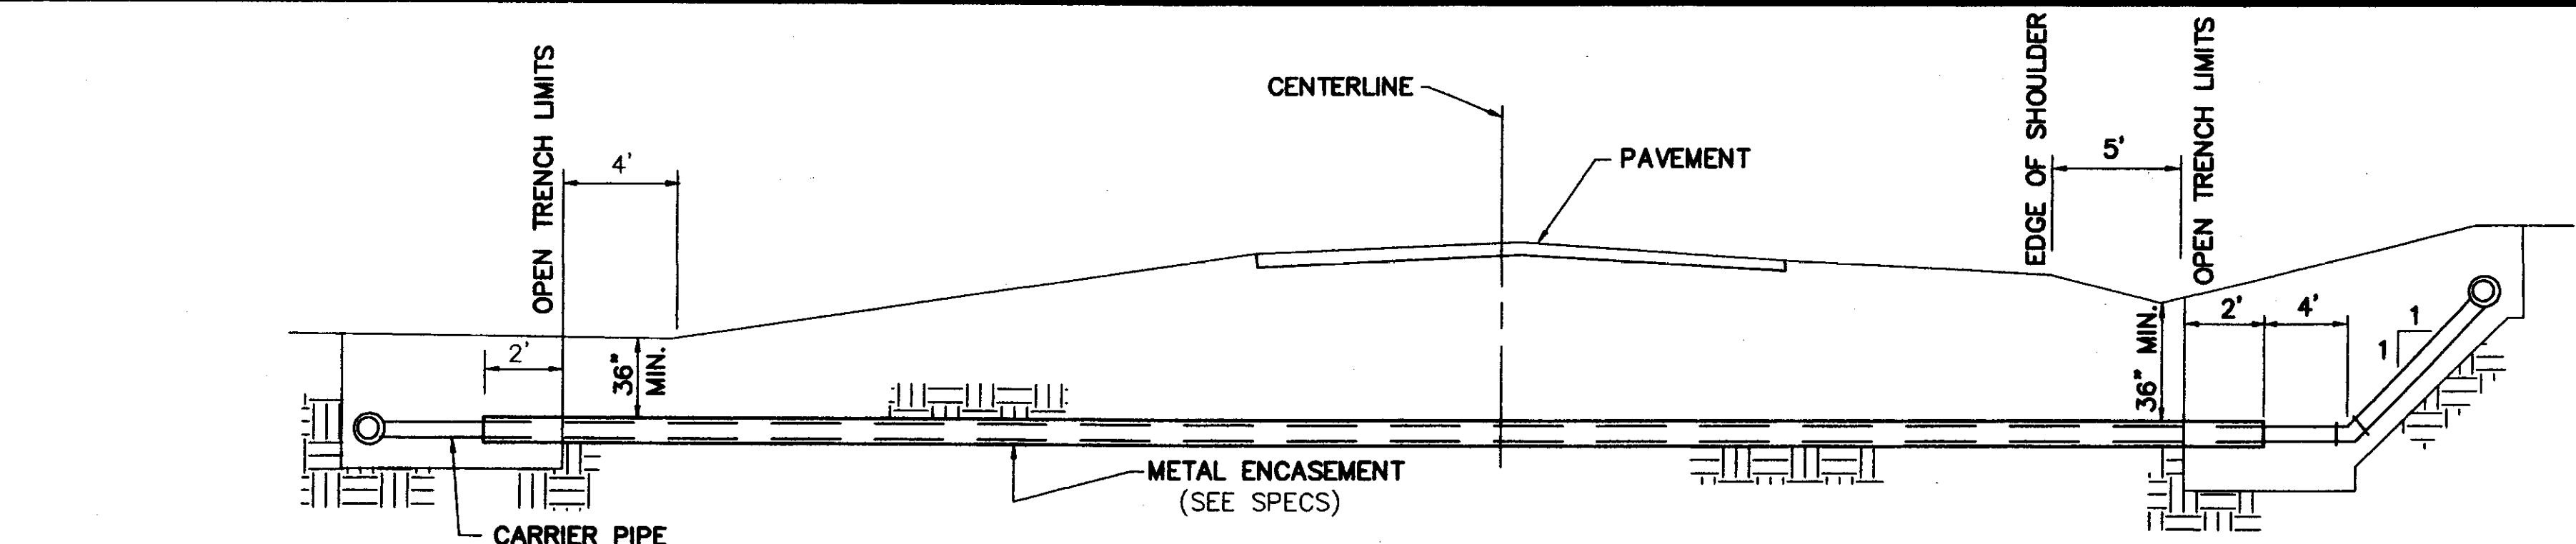


TYPICAL CASSED CROSSING

NOTE: COMPENSATION FOR CONCRETE THRUST BLOCKS SHALL BE INCLUDED IN THE UNIT PRICE BID FOR VALVES, FIRE HYDRANTS AND FITTINGS.

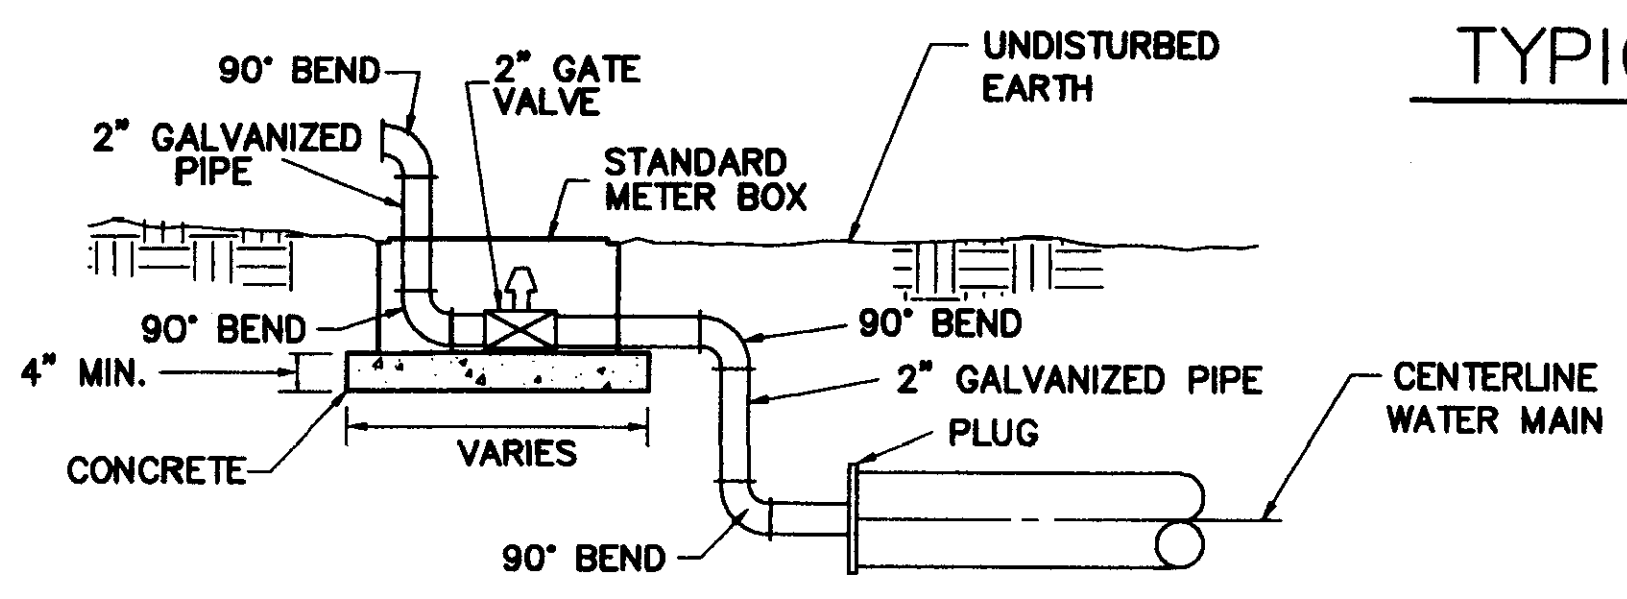


TYPICAL 2" BLOW-OFF DETAIL

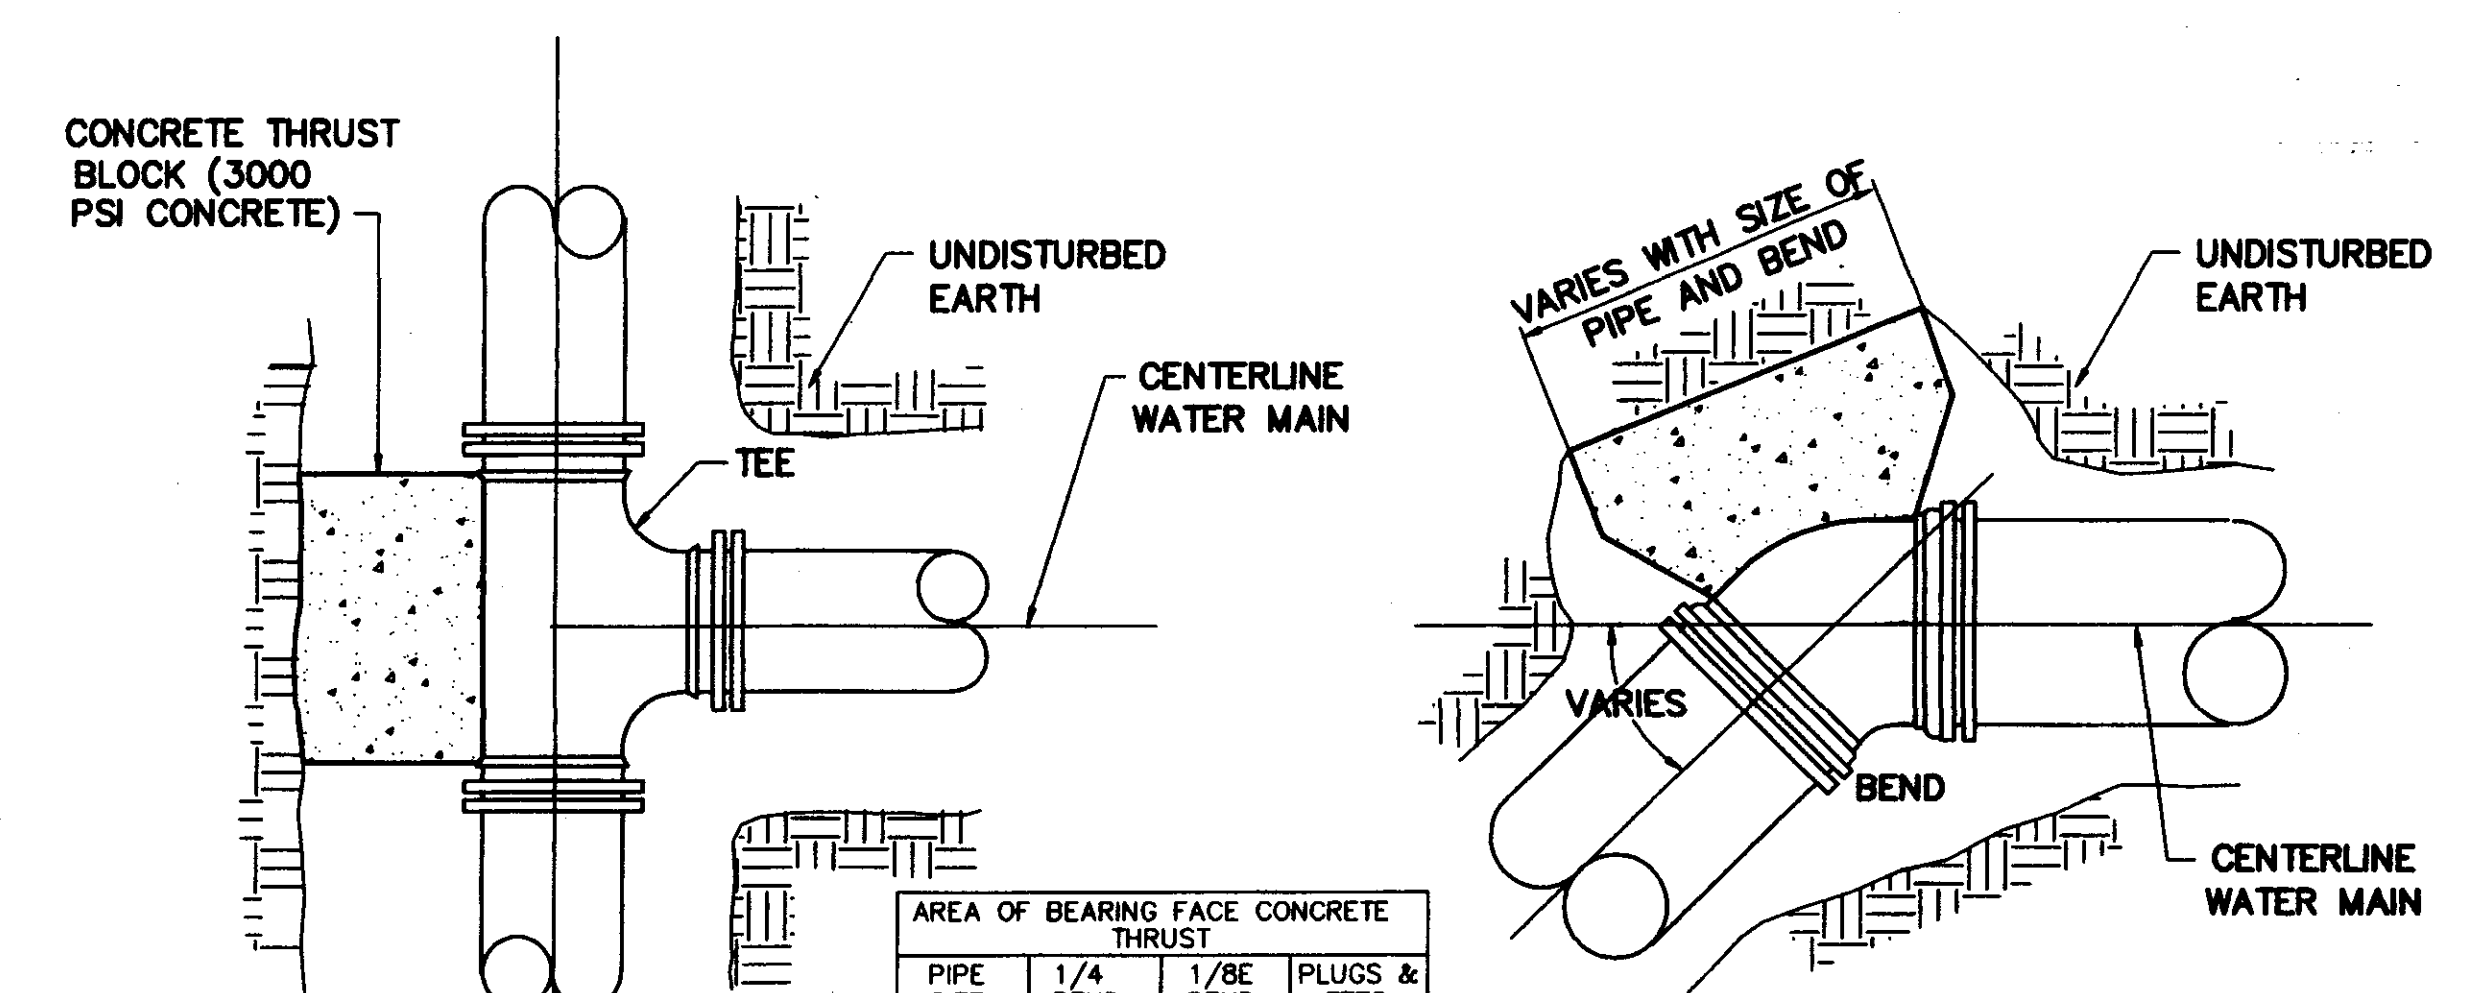

PLAN

PLAN


PIPE SIZE	1/4 BEND	1/8 BEND	PLUGS & TEES
4-6	3	3	3
8	3	3	3
10	4	3	3
12	6	3	4
16	11	4	7

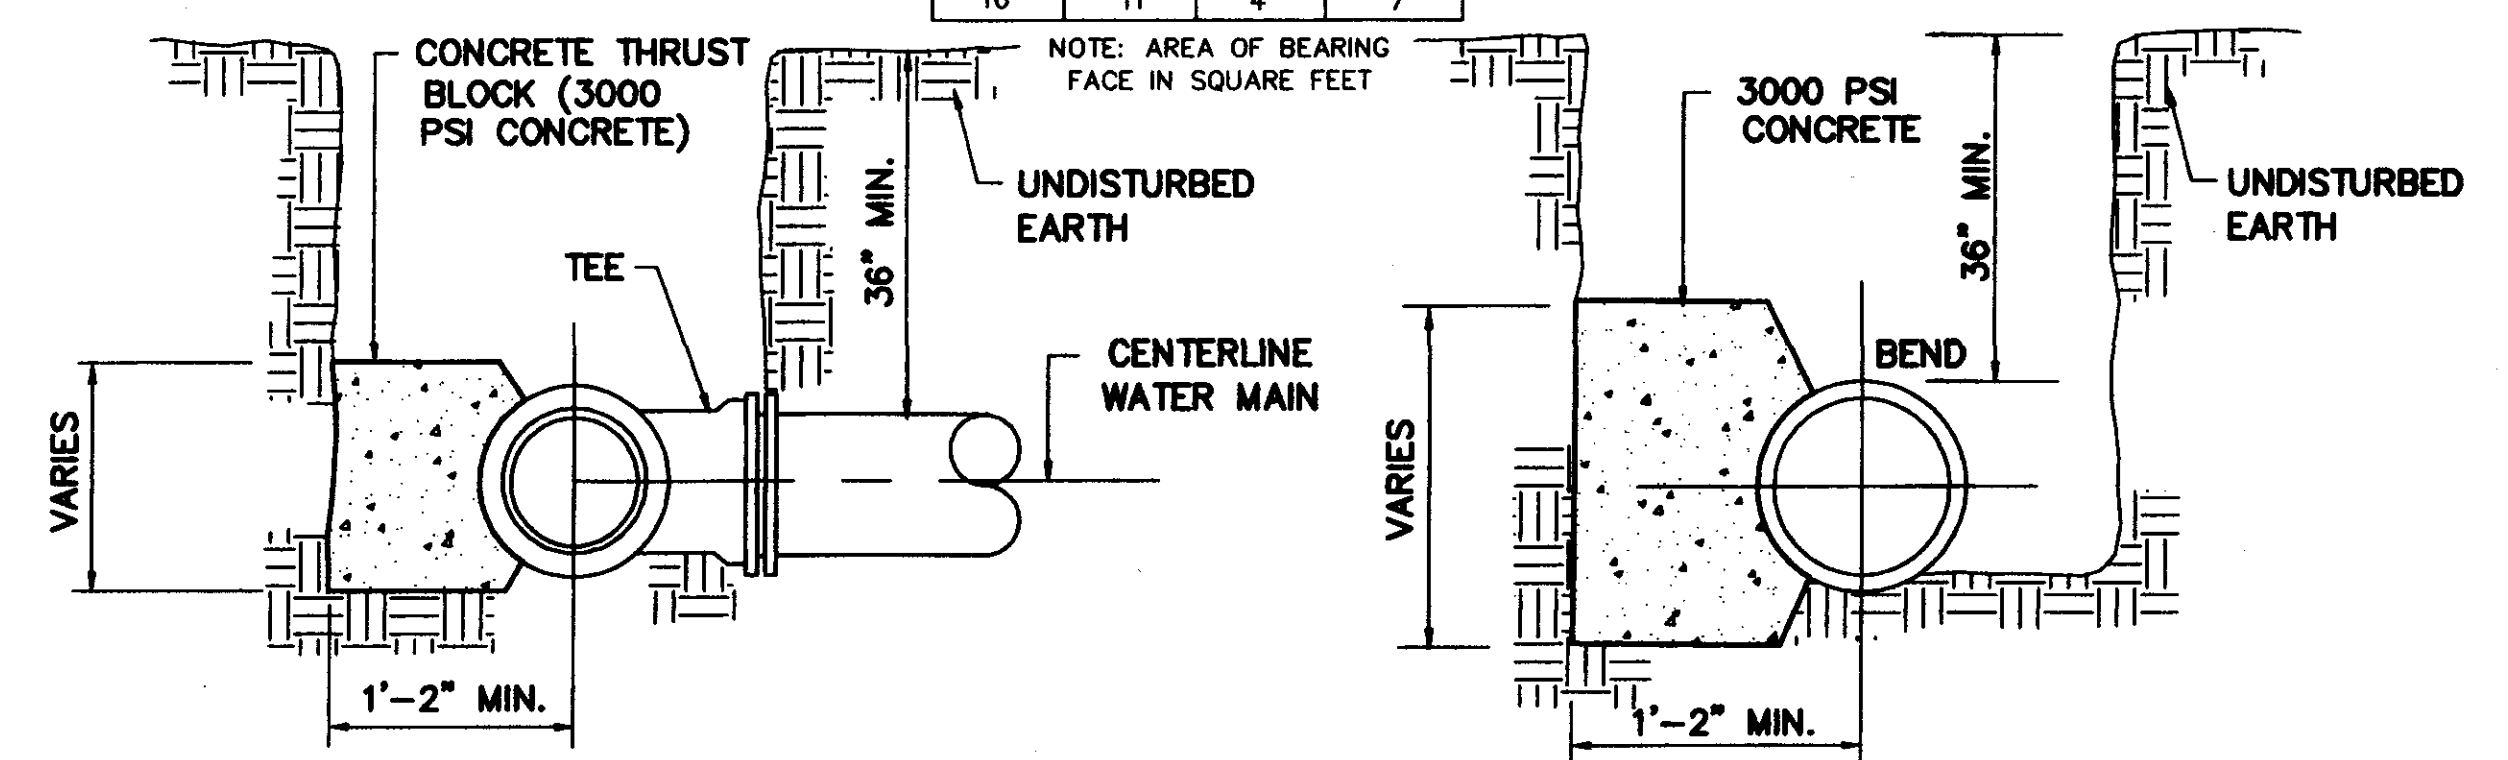


SECTION

SECTION

BLOCKING DETAILS FOR TEES & BENDS

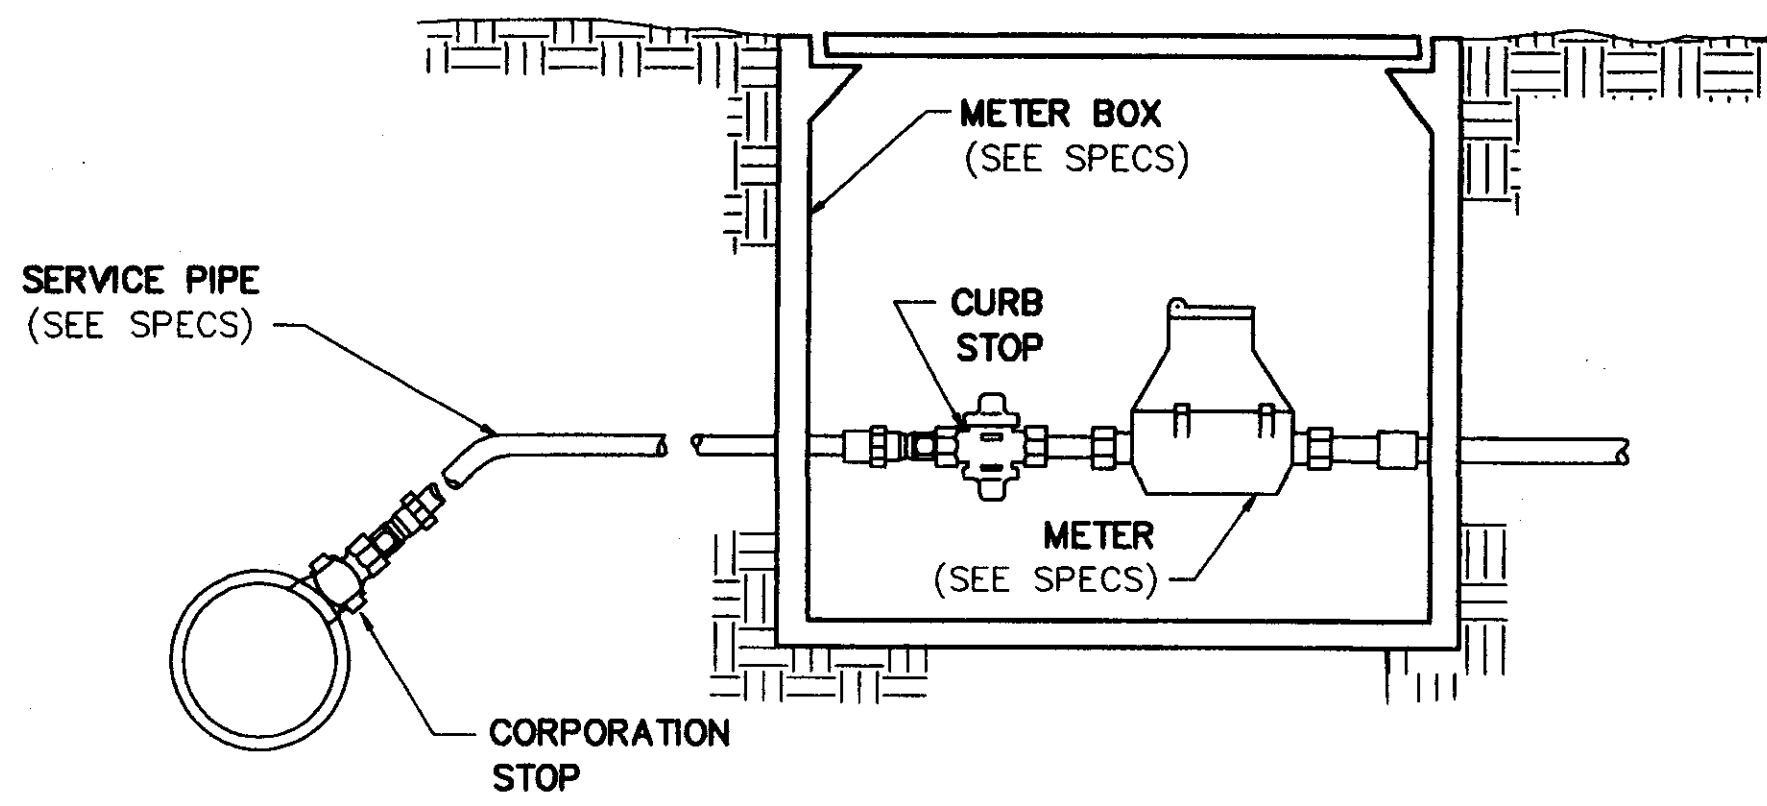


TYPICAL SERVICE ASSEMBLY

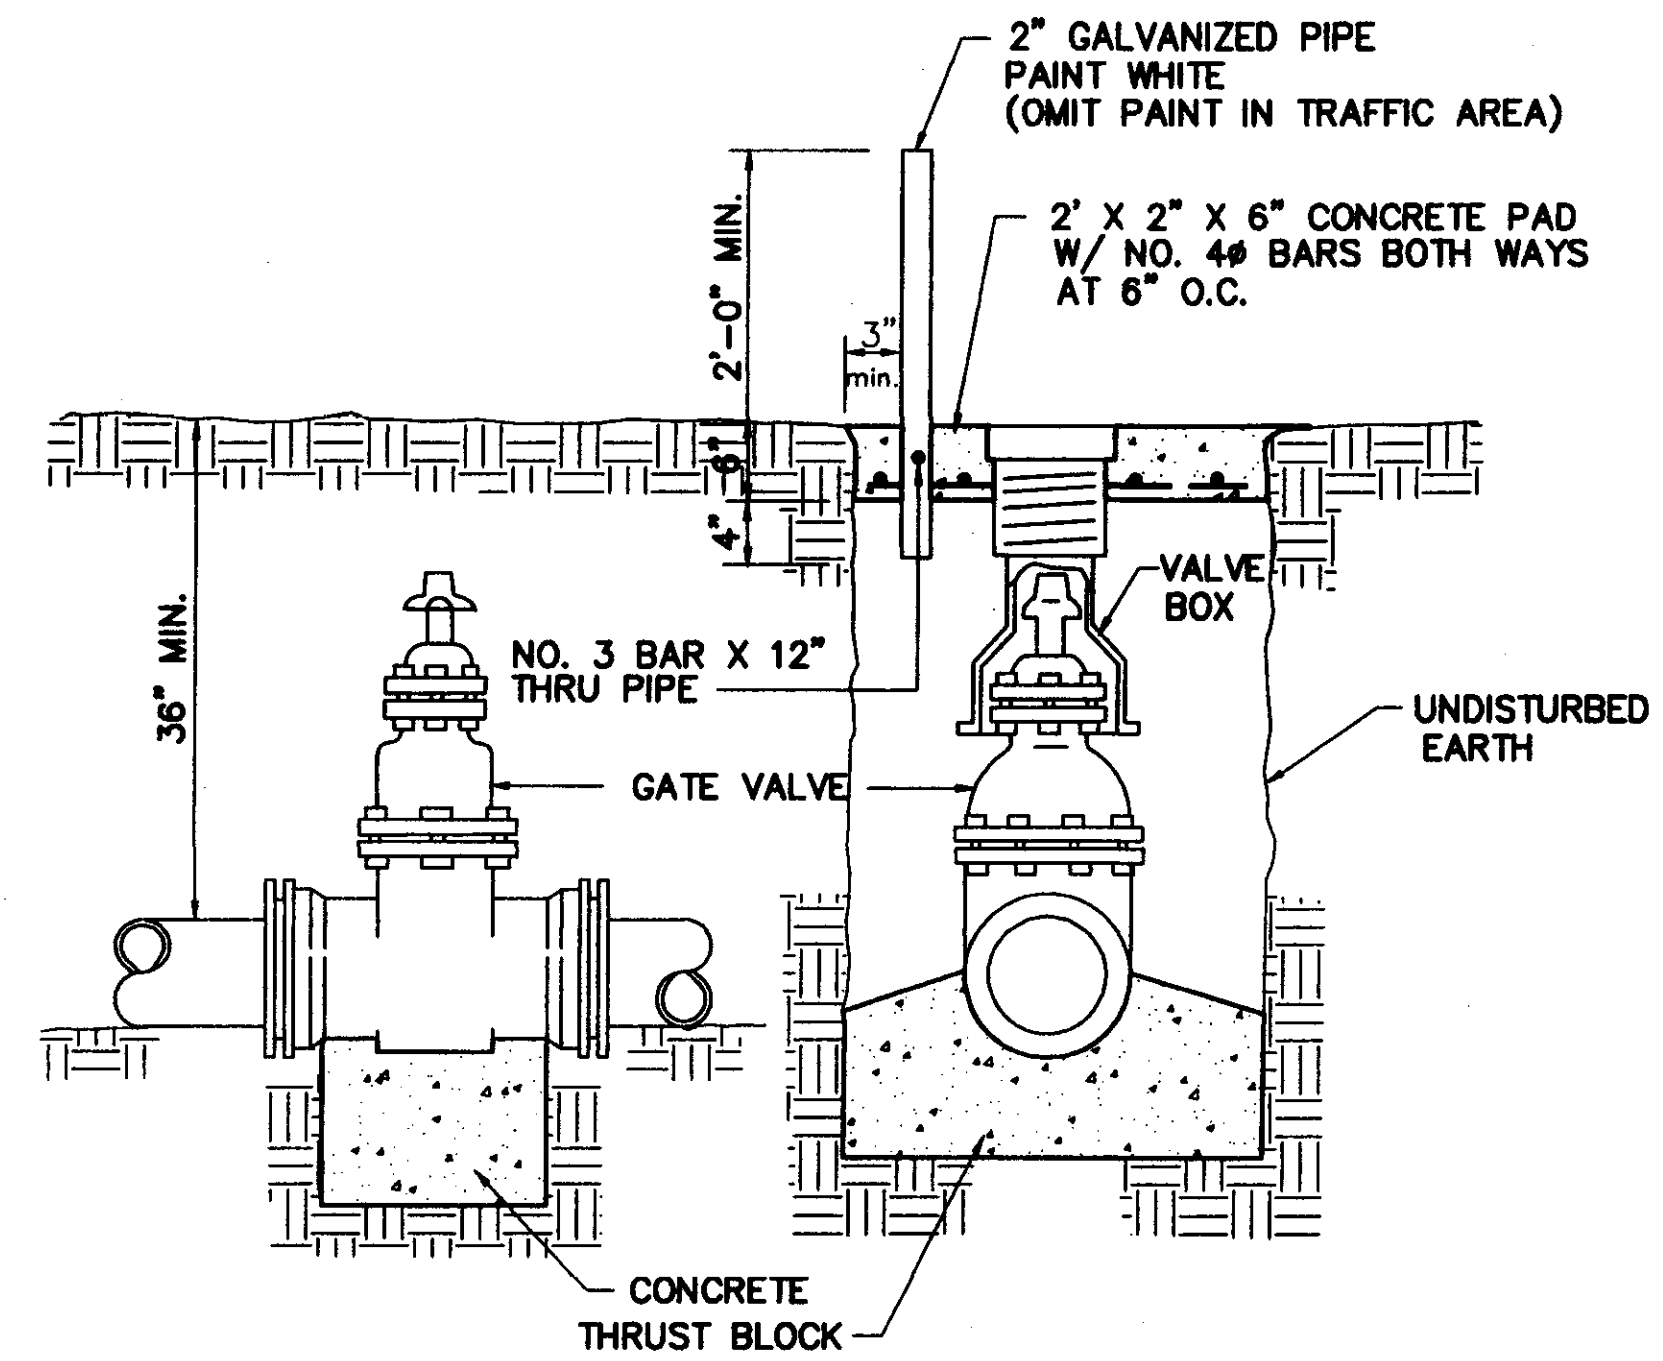


ELEVATION SECTION

TYPICAL VALVE & BOX

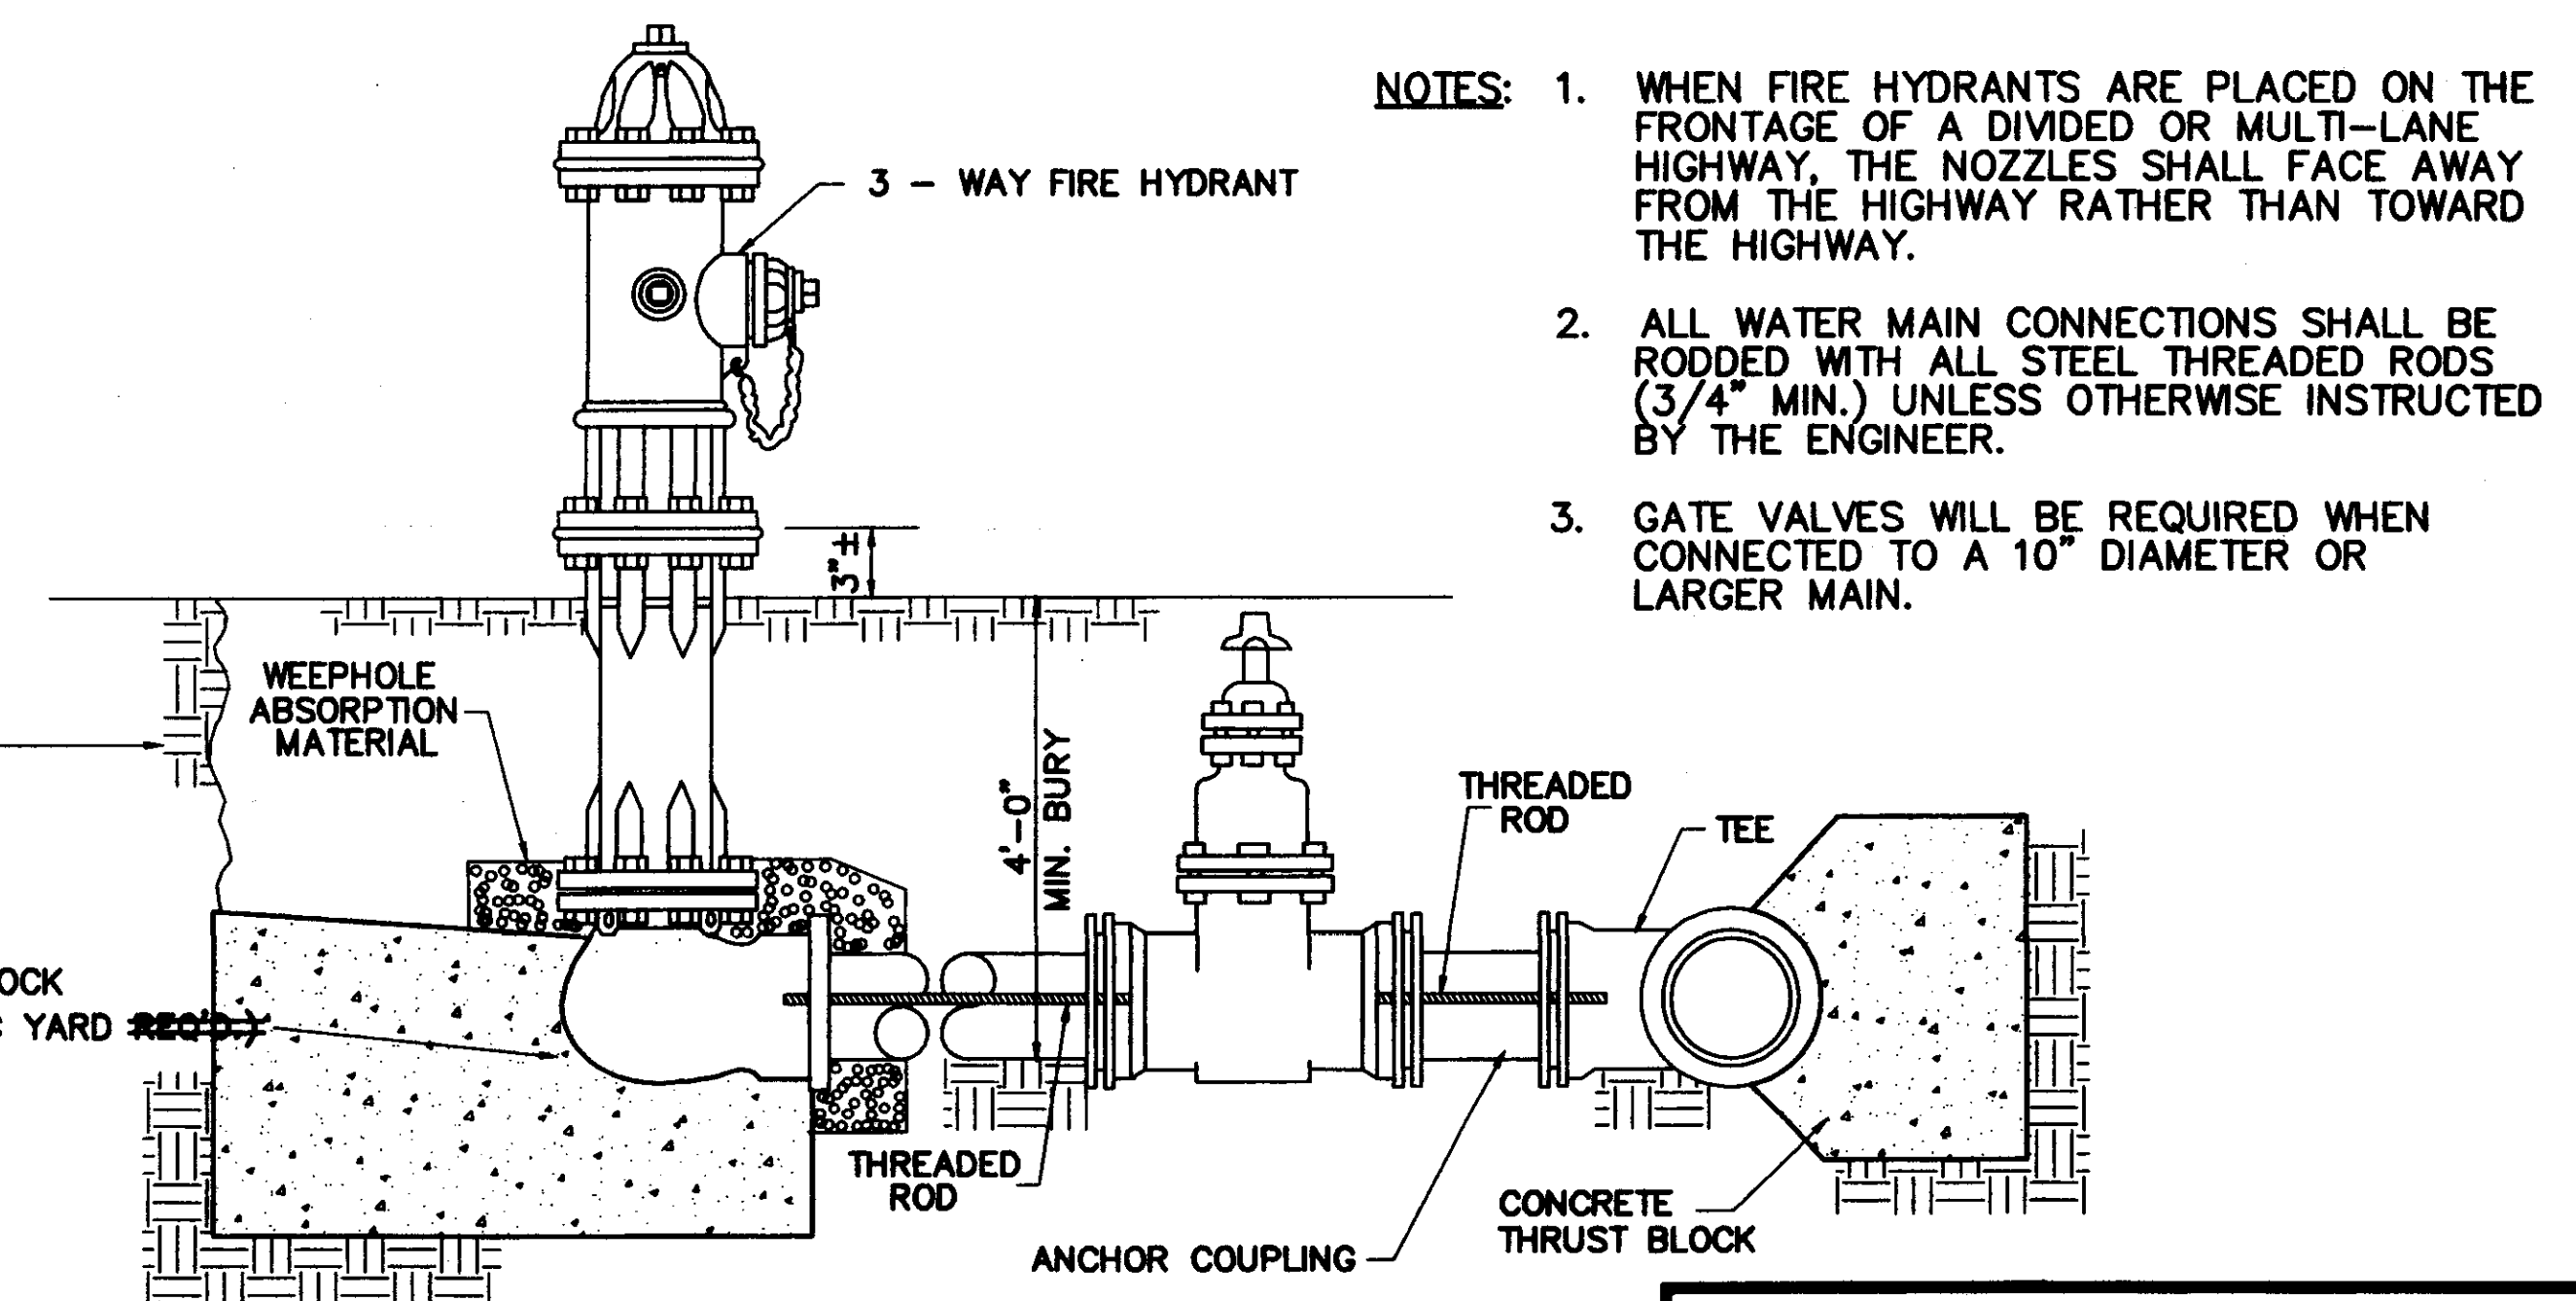


TYPICAL FIRE HYDRANT

- NOTES:
1. WHEN FIRE HYDRANTS ARE PLACED ON THE FRONTAGE OF A DIVIDED OR MULTI-LANE HIGHWAY, THE NOZZLES SHALL FACE AWAY FROM THE HIGHWAY RATHER THAN TOWARD THE HIGHWAY.
  2. ALL WATER MAIN CONNECTIONS SHALL BE RODDED WITH ALL STEEL THREADED RODS (3/4" MIN.) UNLESS OTHERWISE INSTRUCTED BY THE ENGINEER.
  3. GATE VALVES WILL BE REQUIRED WHEN CONNECTED TO A 10" DIAMETER OR LARGER MAIN.

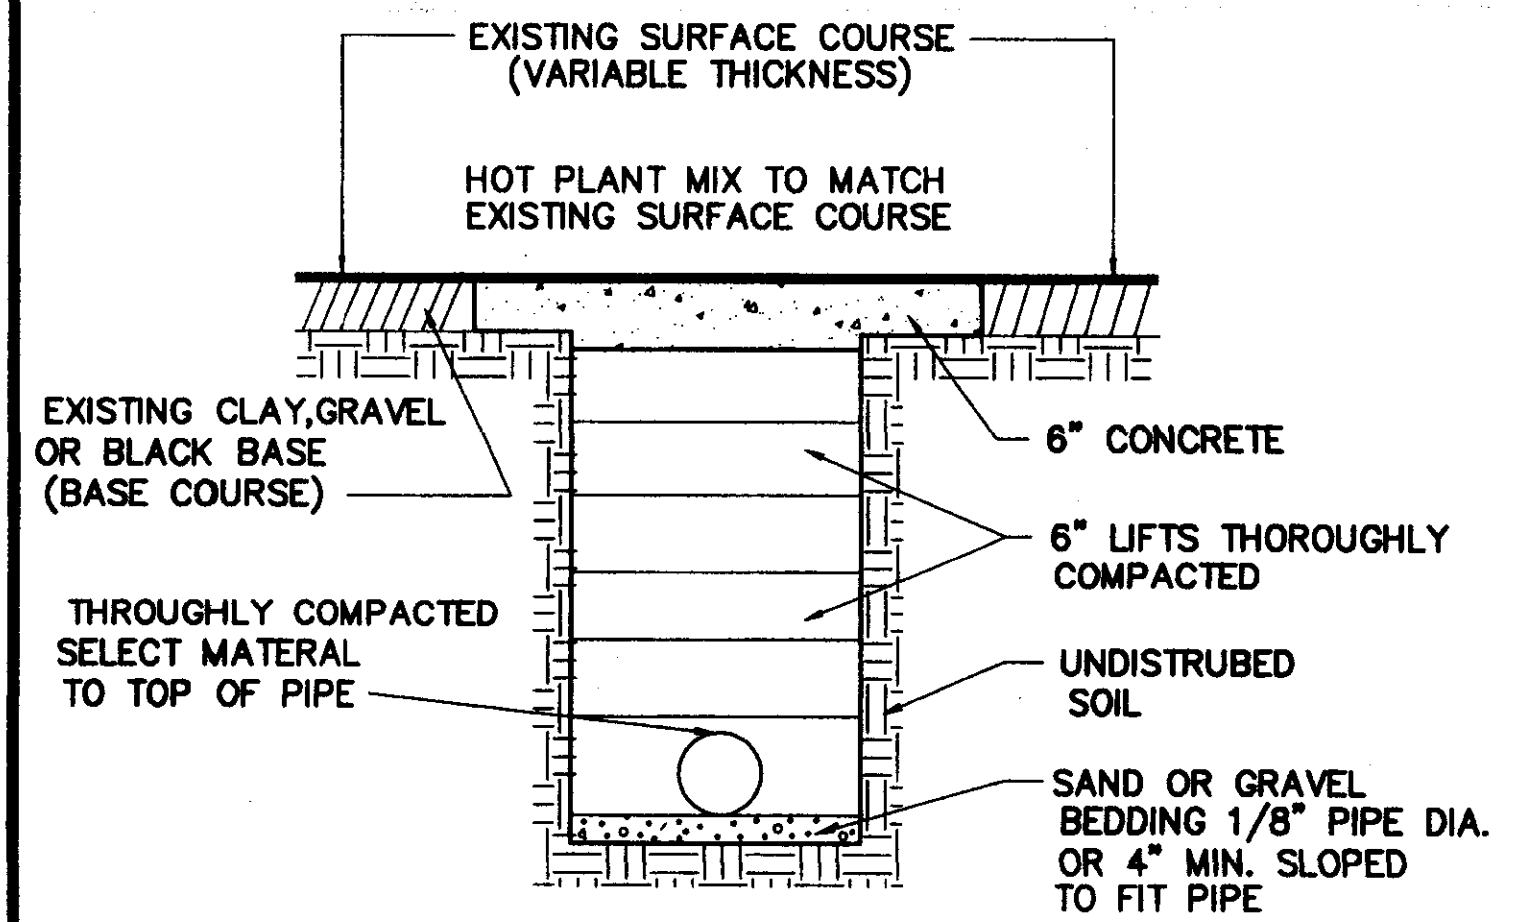

STREET REPAIR OF OPEN CUT

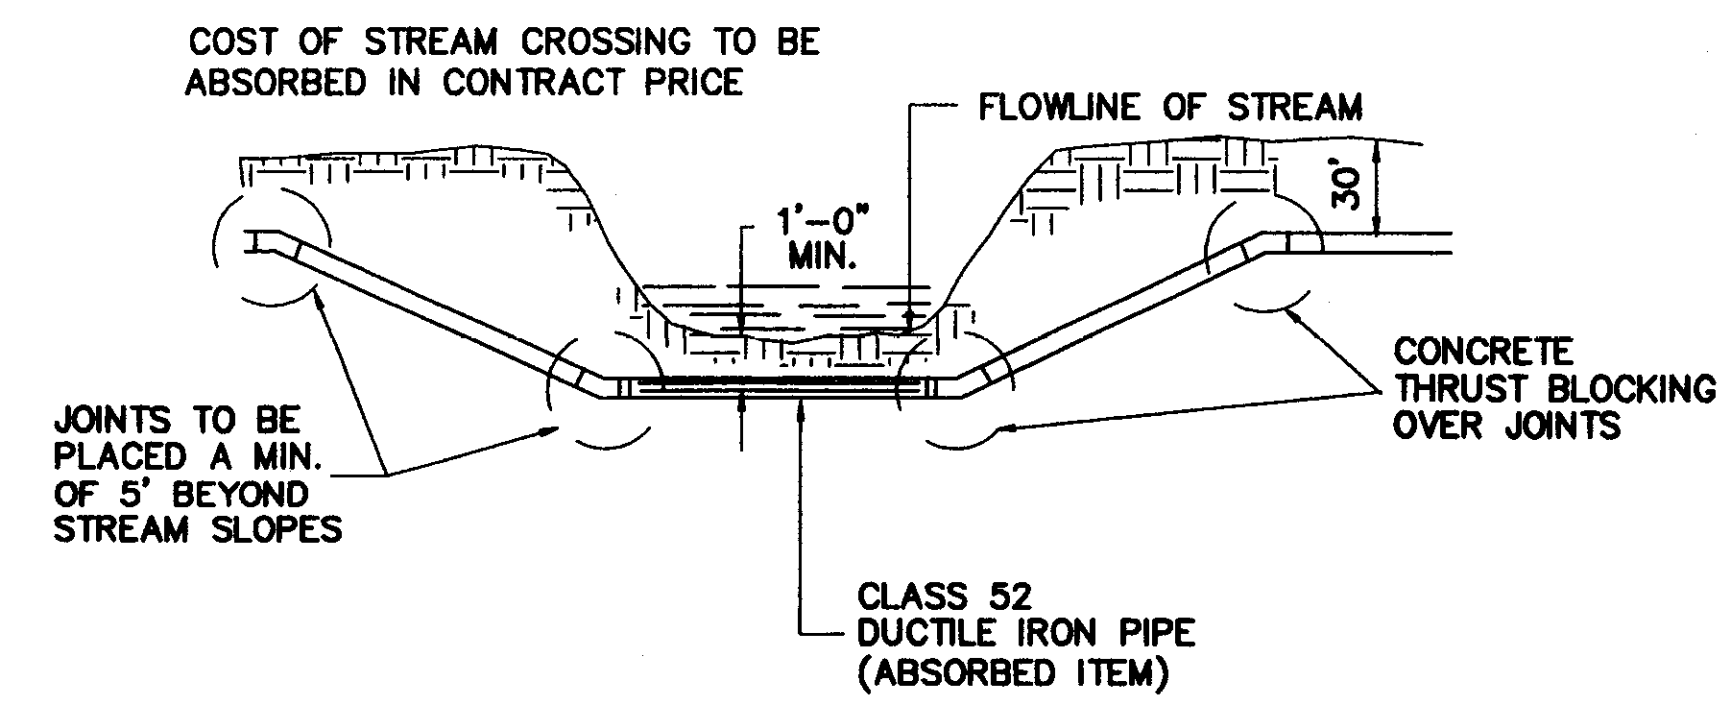

TYPICAL STREAM CROSSING

RECORD DRAWING  
FEBRUARY 1997

CITY OF RIDGELAND, MISSISSIPPI

WATER SYSTEM STANDARDS

WAGGONER ENGINEERING, INC.  
Consulting Engineers - Jackson, Brandon, Pascagoula, Mississippi

DRAWN BY: C.R.H.	DATE: 7-31-92	SHEET NUMBER
REVIEWED BY: T.C.	SCALE: NTS	14 OF 14