
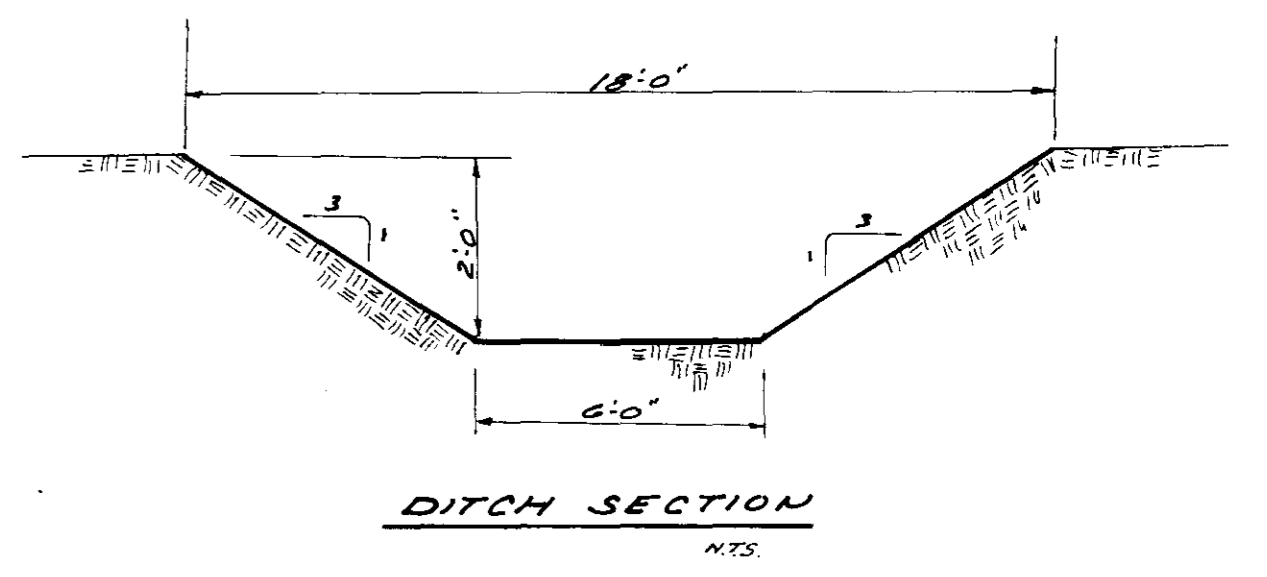


COMMENCE AT THE NE CORNER OF LOT 3,
 BLOCK II, HIGHLAND COLONY SUBDIVISION,
 ALSO BEING THE NE CORNER OF THE SW 1/4
 OF THE NW 1/4 OF SECT 19, T7N, R2E.

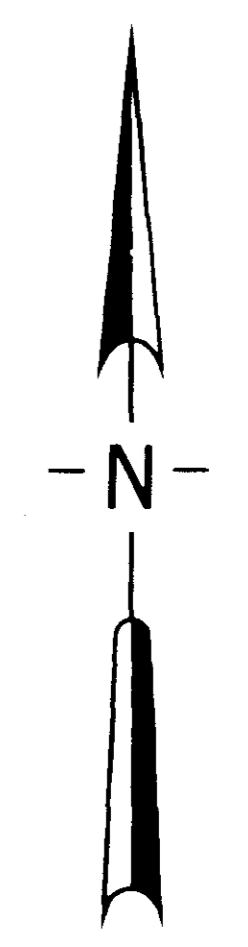

⊙ T.O.M. PLATE BOLT OVER LARGE
 OPENING ON F.H.
 ELEV. 354.35

REVISED 2-18-87 - PARKING LOT DIMENSIONS & GAS LINE
 REVISED 1-10-87 - EXISTING SEWER
 REVISED 1-9-87 - PROPOSED TOPO & DRAINAGE
 REVISED 12-23-86 - DITCH TOPO

CITY OF RIDGELAND FIRE STATION SITE HOLMES JR. COLLEGE		
SITUATED IN THE SW 1/4 OF THE NW 1/4 OF SECT 19, T7N, R2E MADISON COUNTY, MISSISSIPPI		
JOE A. WAGGONER Civil Engineer - Brandon / Jackson, Miss.		
DRAWN BY: J.W.P.	DATE: DEC. 17, 1985	SHEET NO.
CHECKED BY: M.K.	SCALE:	G-1 - 7
APPROVED BY:		

PWP-00601