


RECORD DRAWINGS 8/27/07



NOTE: MAINTAIN 10' HORIZONTAL SEPARATION BETWEEN WATER LINES AND SEWER LINES AND 18" VERTICAL CLEARANCE BETWEEN SEWER LINES AND WATER LINES, WITH WATER OVER SEWER.

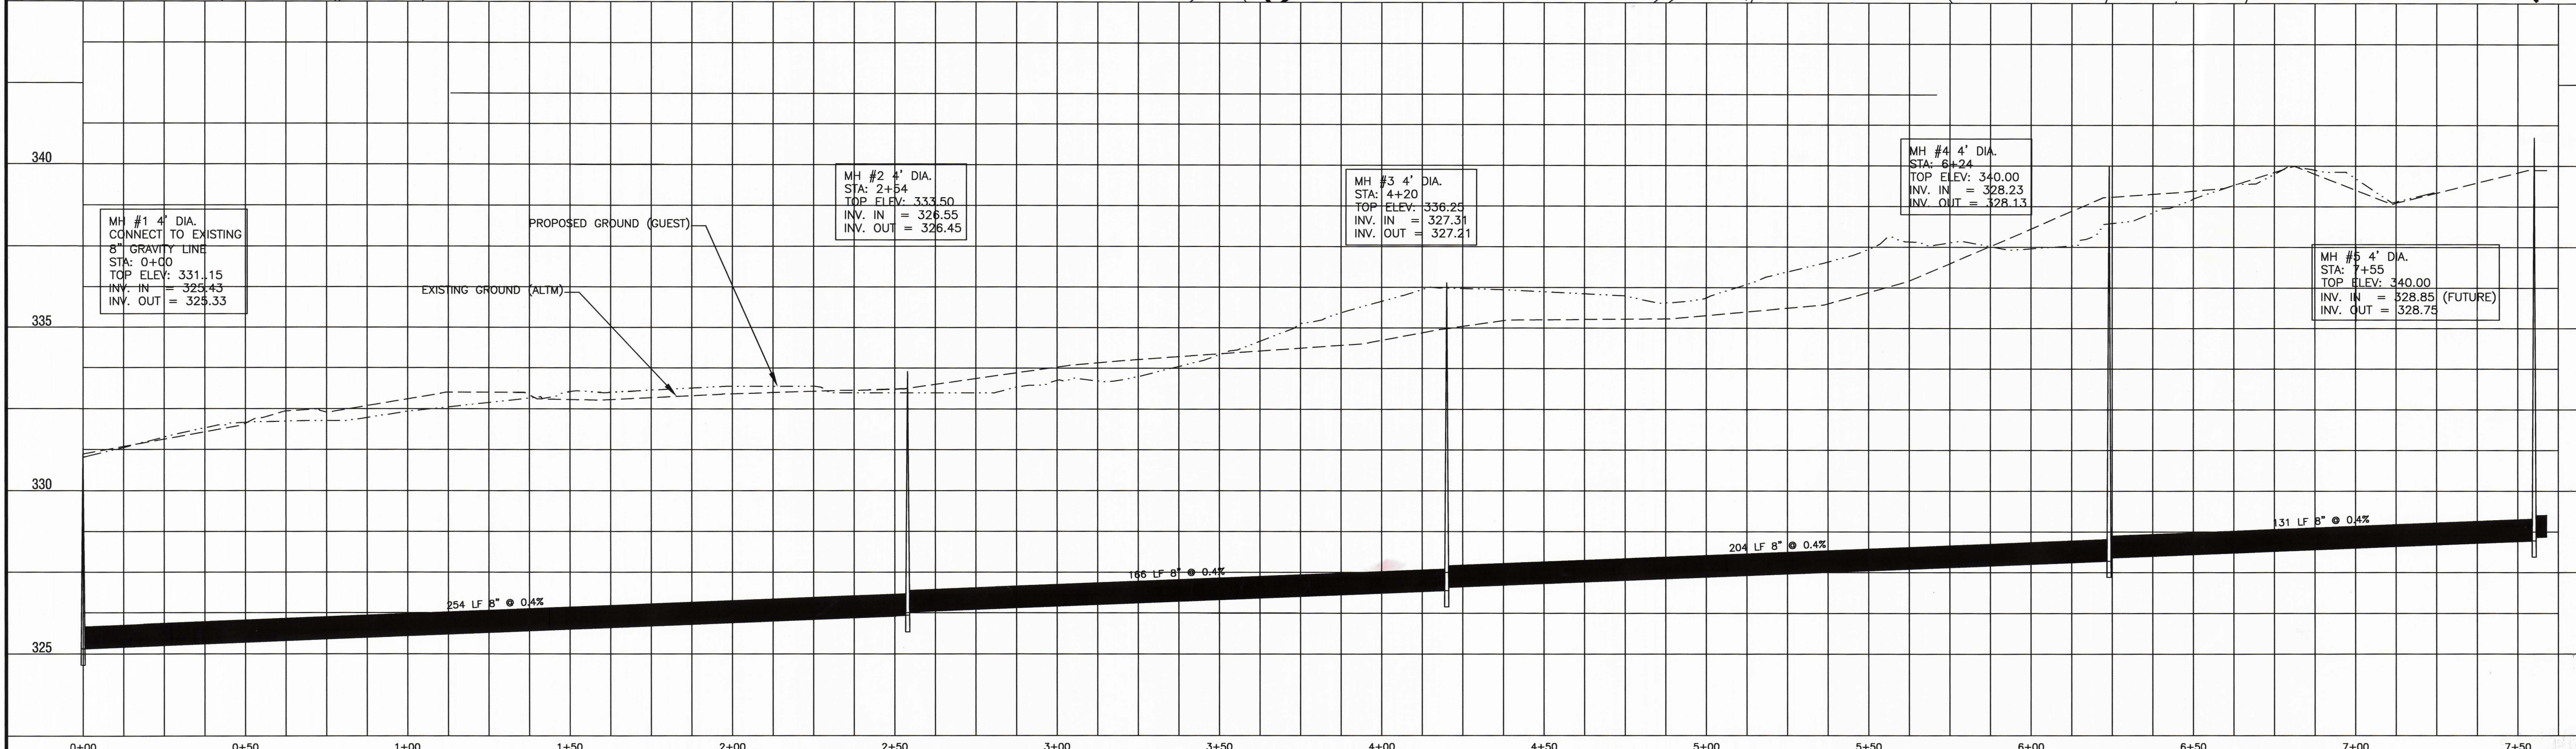

NO.	DATE	REVISIONS	BY	DATE	HORIZ. SCALE	 143-A LeFleurs Square JACKSON, MS 39211 601-355-9526 FAX 601-352-3945	<b>FORD STREET SEWER IMPROVEMENTS</b> CITY OF RIDGELAND, MISSISSIPPI	<b>GRAVITY LINE PLAN &amp; PROFILE VIEW</b> (STA. 0+00 TO STA. 7+55)	SHEET NUMBER: <b>PP1.1</b>
			DESIGNED BY: BGG	04/20/07	1":50'				
			CHECKED BY: WJS	PROJECT: CO3-099	VERT. SCALE: 1":5'				

PWP-00



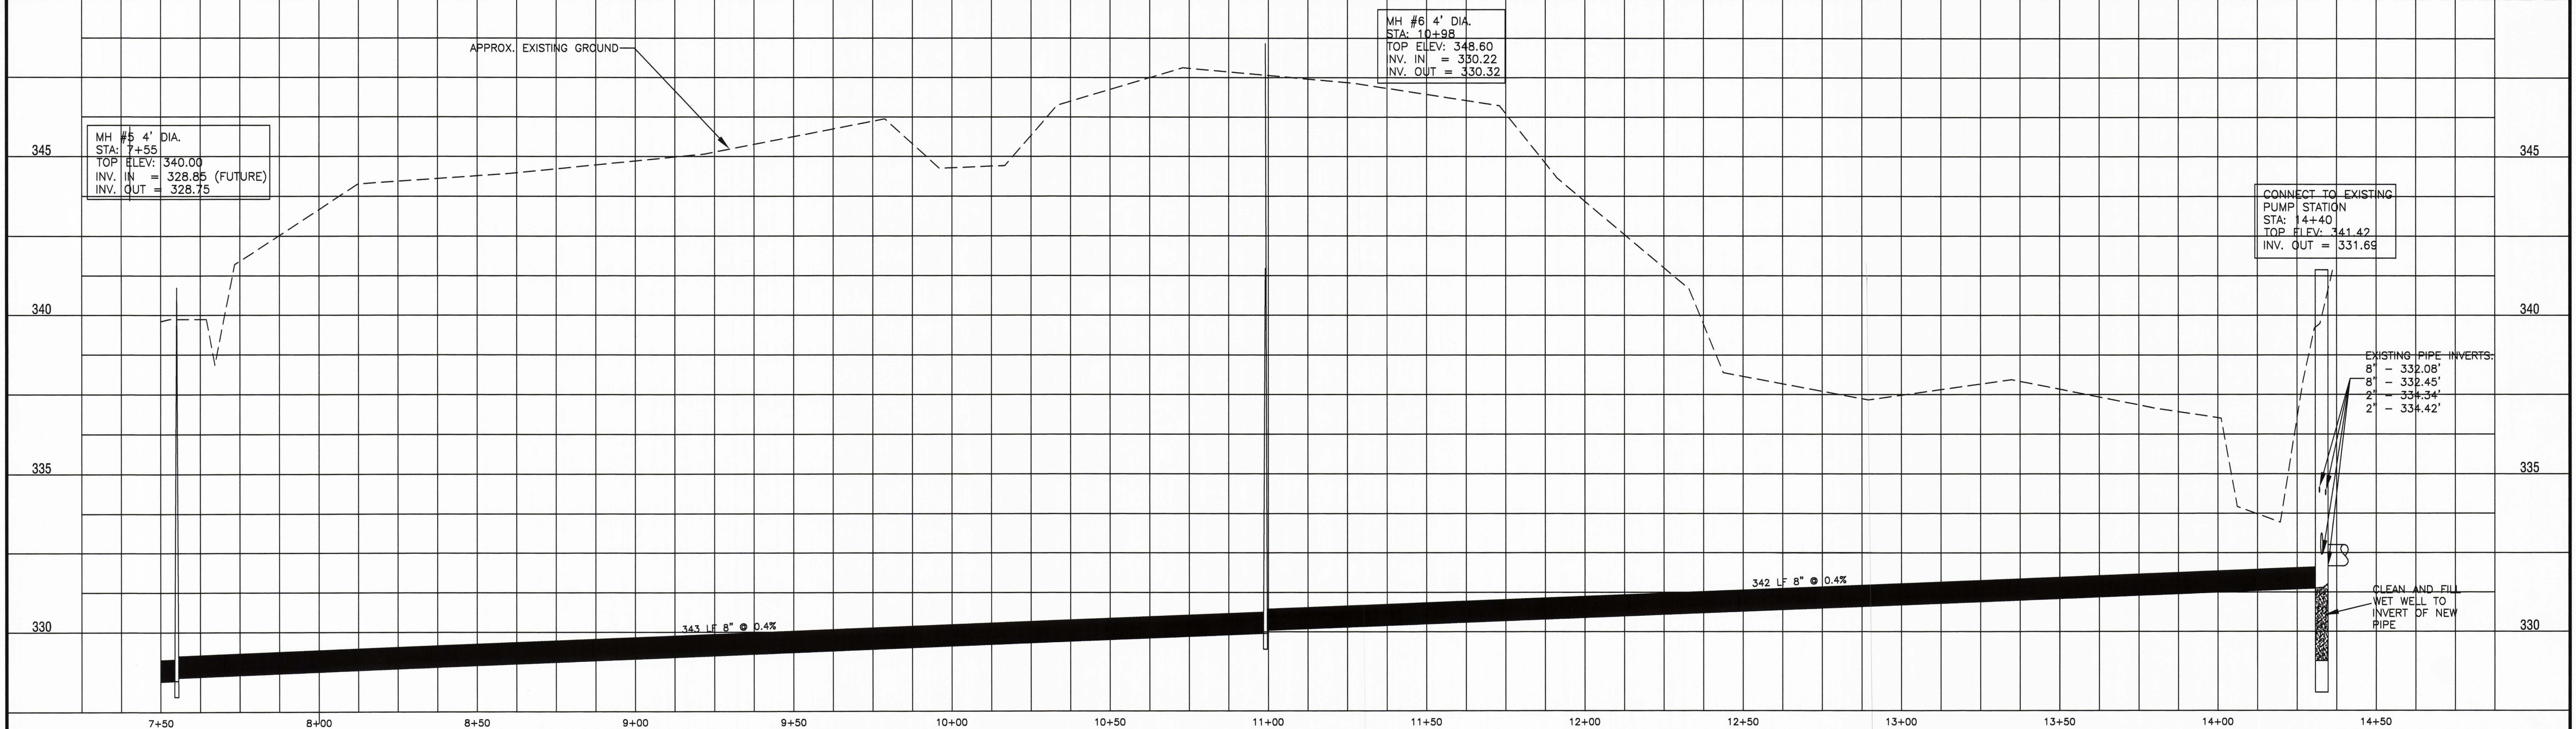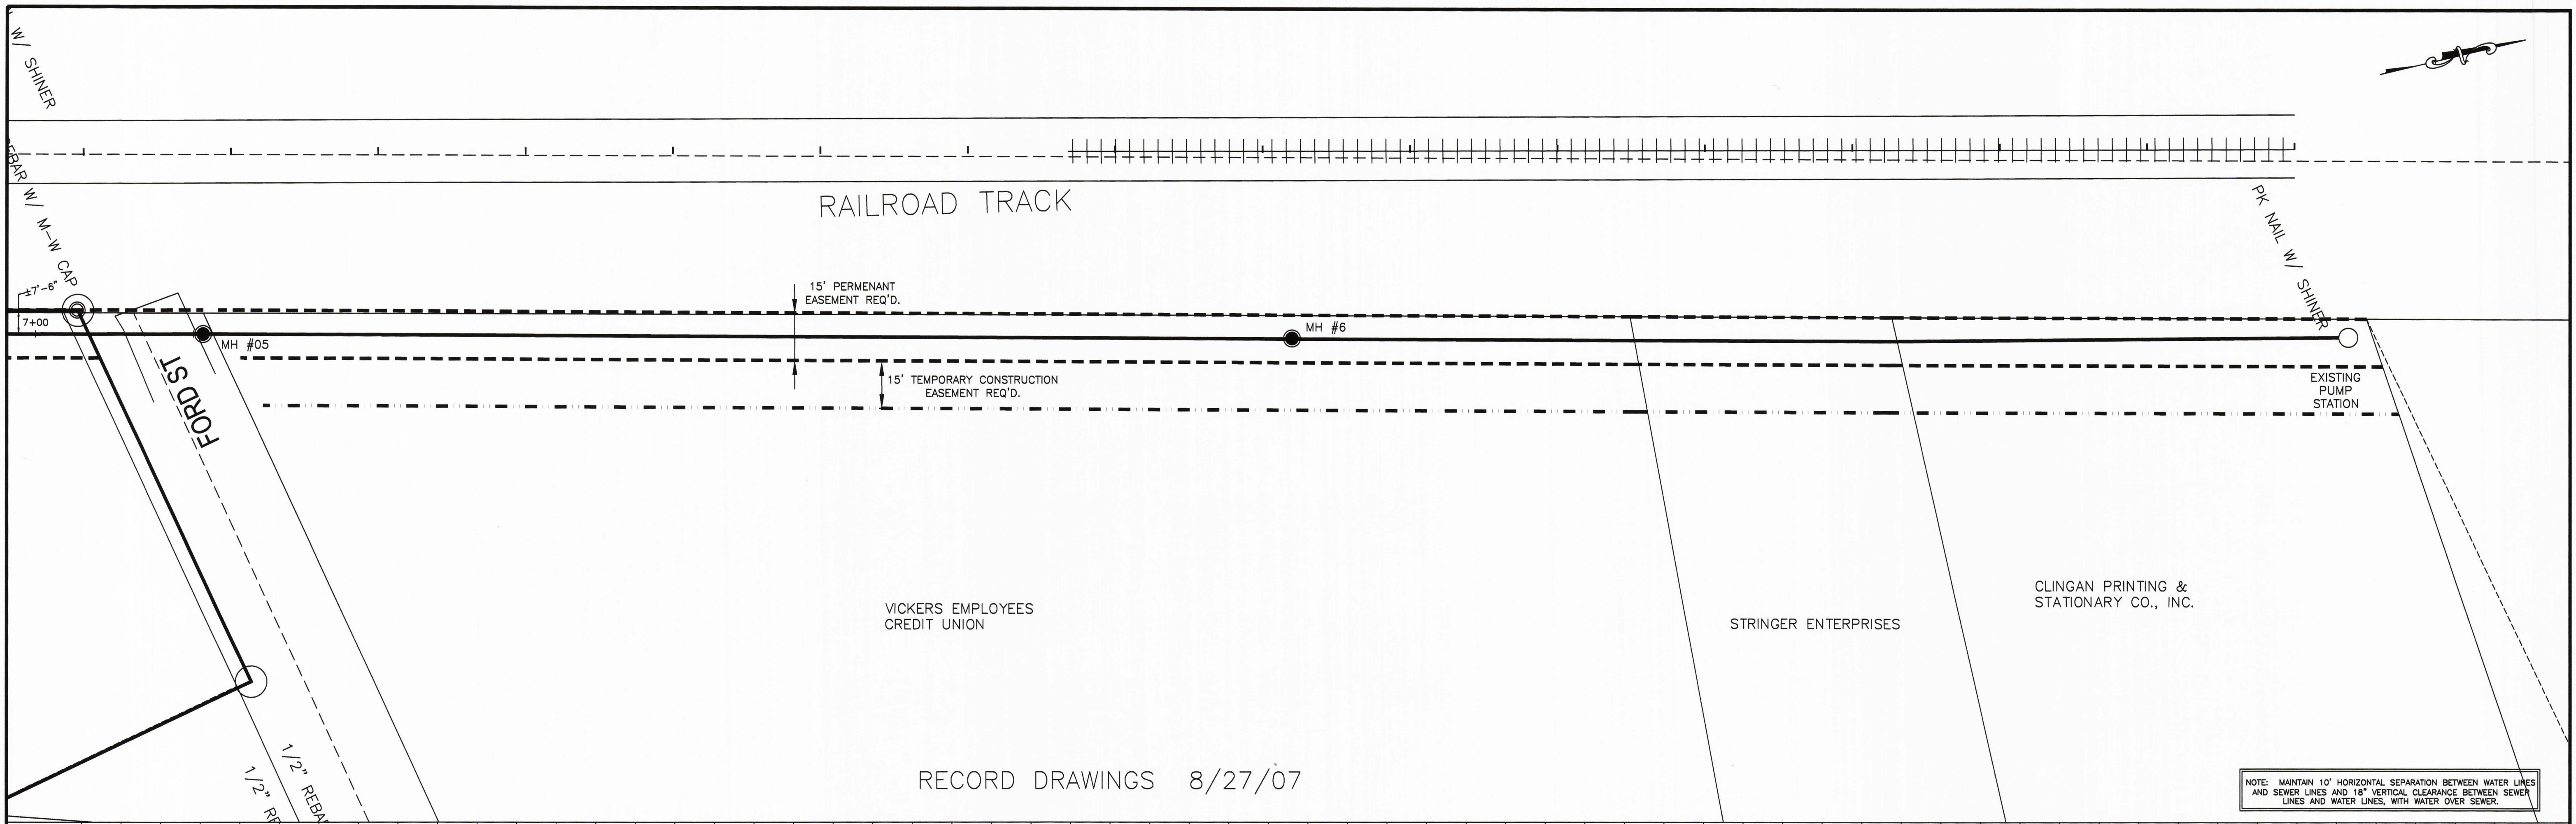

NO. DATE		REVISIONS		DRAWN BY: BGG DESIGNED BY: BGG CHECKED BY: WJS	DATE: 04/20/07 PROJECT: CO3-099	HORIZ. SCALE: 1"=50' VERT. SCALE: 1"=5'	143-A LeFleurs Square JACKSON, MS 39211 601-355-9526 FAX 601-352-3945	<b>FORD STREET SEWER IMPROVEMENTS</b> CITY OF RIDGELAND, MISSISSIPPI	<b>GRAVITY LINE PLAN &amp; PROFILE VIEW</b> (STA. 7+55 TO STA. 14+40)	SHEET NUMBER: <b>PP1.2</b>
----------	--	-----------	--	--	------------------------------------	--	--	---	--	-------------------------------