



CONSTRUCTION PLANS FOR FRIDAY HARBOUR

DEVELOPED BY:
GOOD EARTH DEVELOPEMENT, INC.
POST OFFICE BOX 328
MADISON, MISSISSIPPI

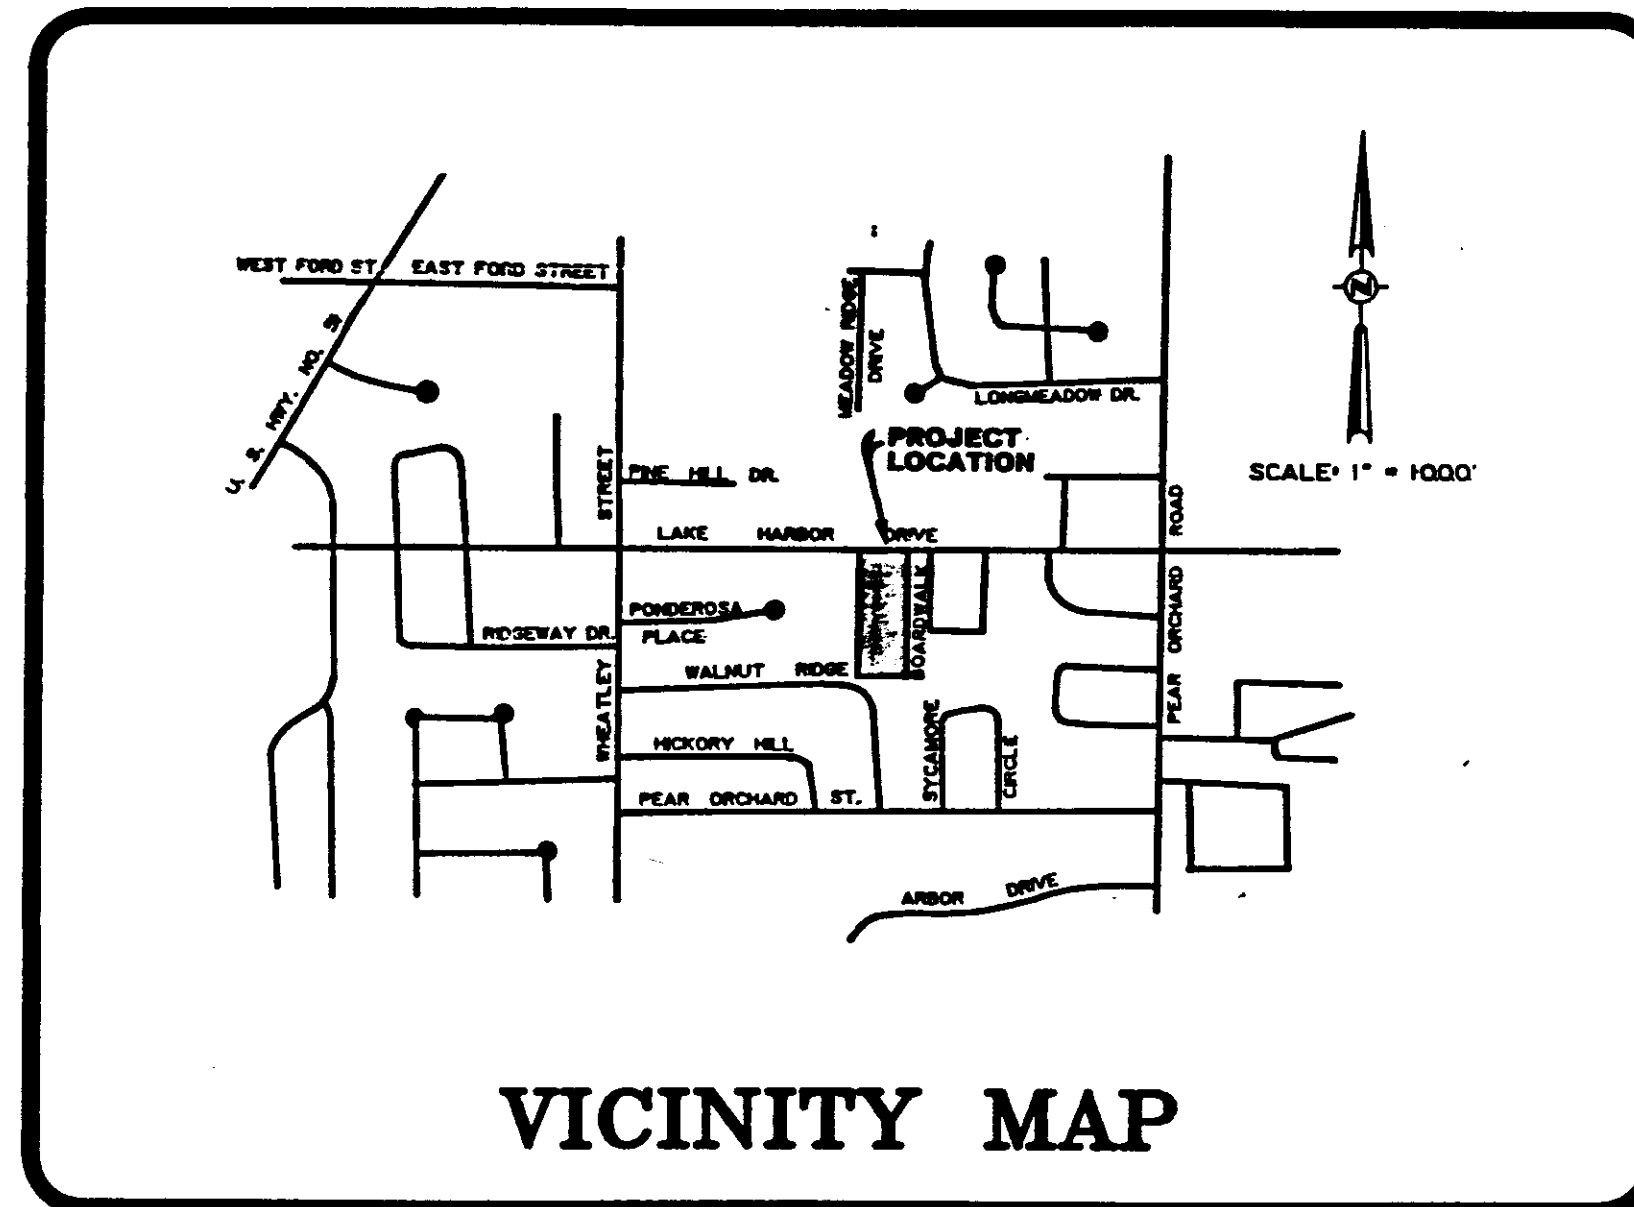

INDEX TO DRAWINGS	
SHEET NO.	DESCRIPTION
1	COVER SHEET
2	GRADING & DRAINAGE PLAN
3	UTILITY PLAN
4	PLAN-PROFILE FRIDAY HARBOUR
5	STANDARD SANITARY SEWER DETAILS
6	STANDARD WATER DETAILS


PREPARED BY:
REYNOLDS ENGINEERING, INC.
POST OFFICE BOX 526
JACKSON, MISSISSIPPI 39205
(601) 362-4885

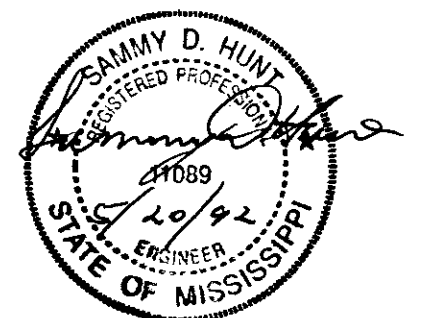

AS BUILT
PJP-00602


PEAR ORCHARD, PART III
 WALNUT RIDGE
 33
 34
 62
 44
 45
 46
UNDEVELOPED

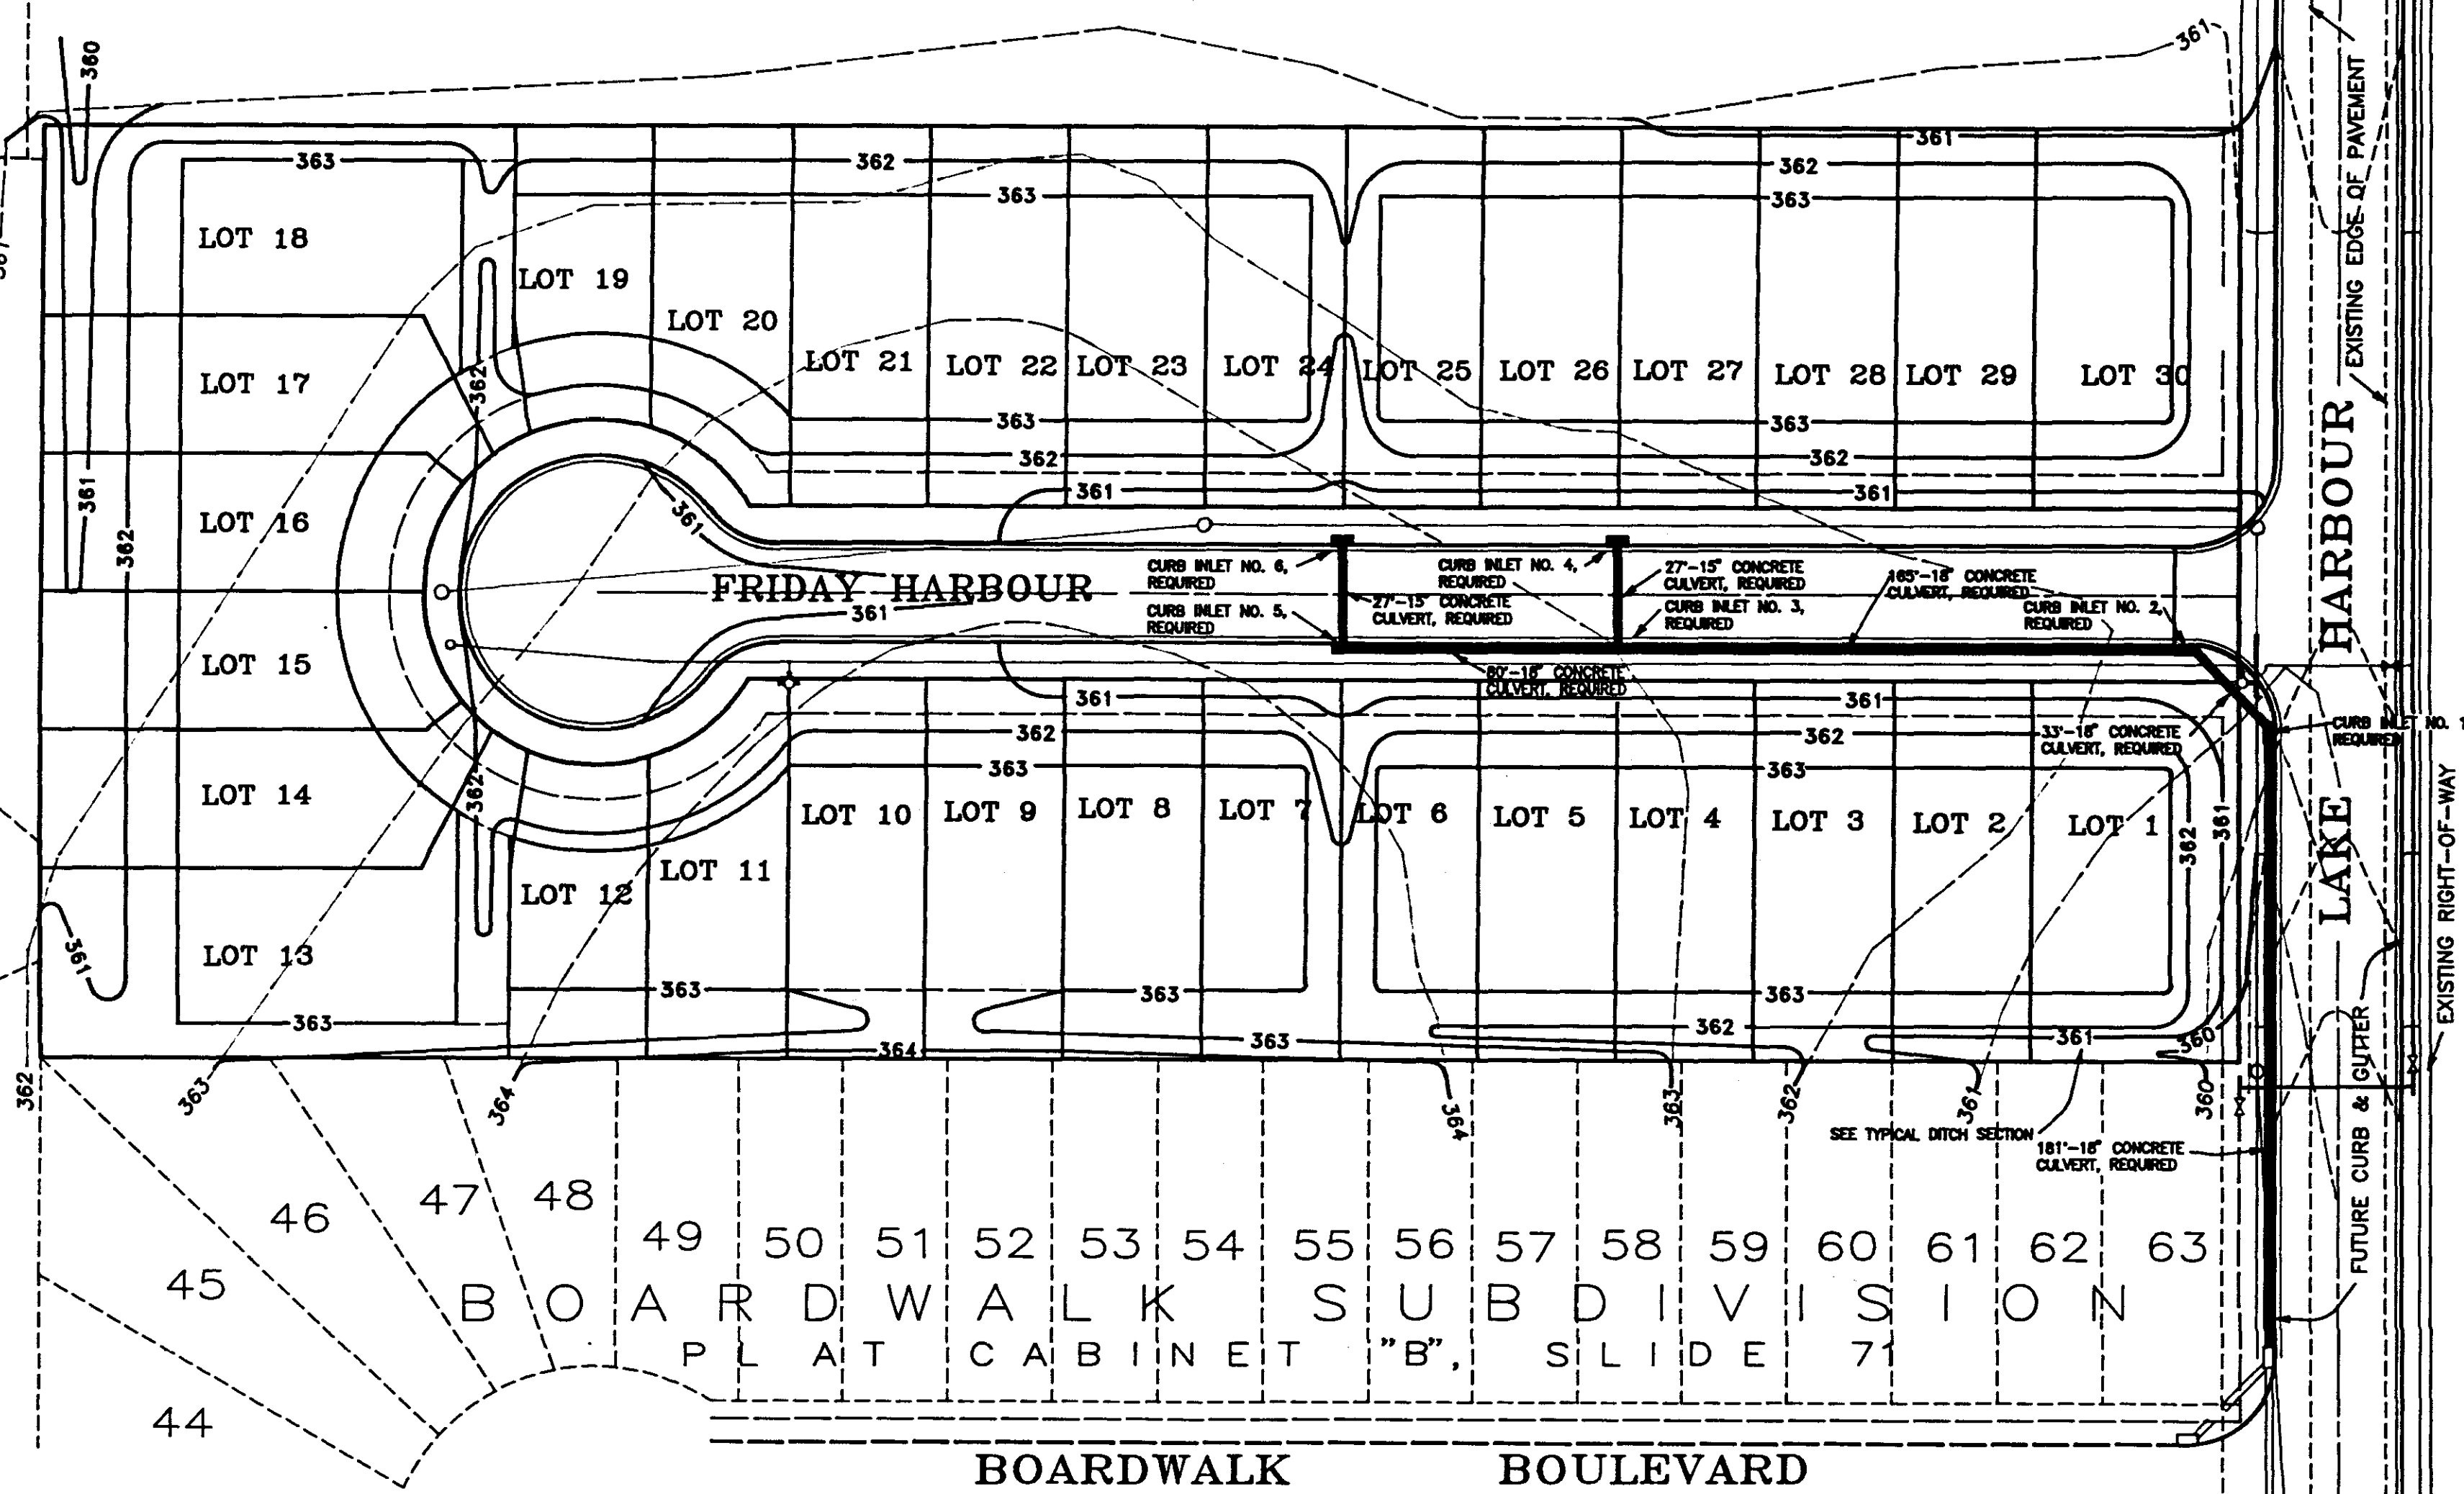


NOTES:

- 1/2" Expansion Joint Req'd @ 30' c.c.
 2-3/4" Dowel Bars, 15" Long Req'd At All Expansion Joints. They Shall Be Held In Place By Approved Chairs Or Supports, & 1/2" Expansion Materials. 1/4" Contraction Joint Req'd @ 10' c.c.
- All Curb And Outlet And Driveway To Be Constructed Of 1:2:4 Mix Concrete.

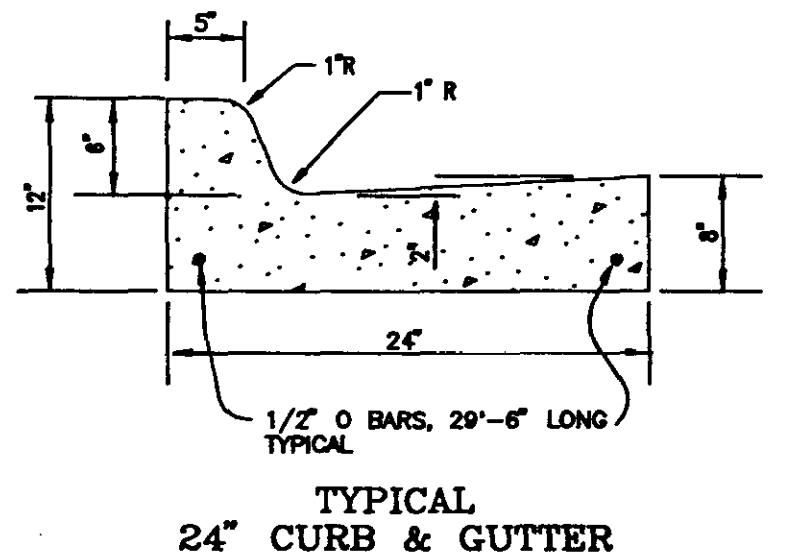


TYPICAL 24" CURB & GUTTER


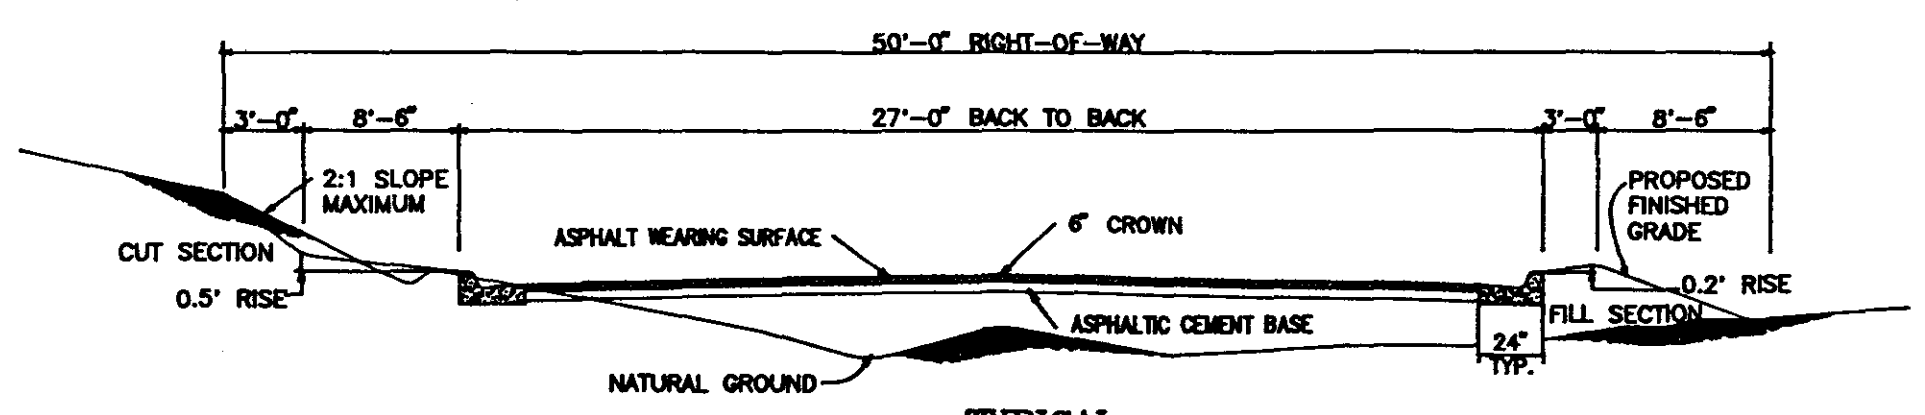


TYPICAL STREET SECTION


- ALTERNATE NO. 1
 1 1/2" WEARING SURFACE
 5" ASPHALTIC CEMENT BASE
- ALTERNATE NO. 2
 1 1/2" WEARING SURFACE
 3" ASPHALTIC CEMENT BASE
 6" SOIL TREATMENT (LIME)

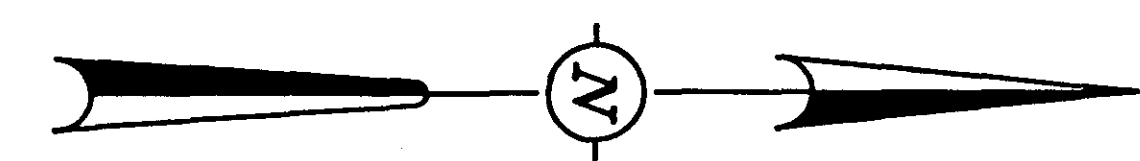

GRAPHIC SCALE

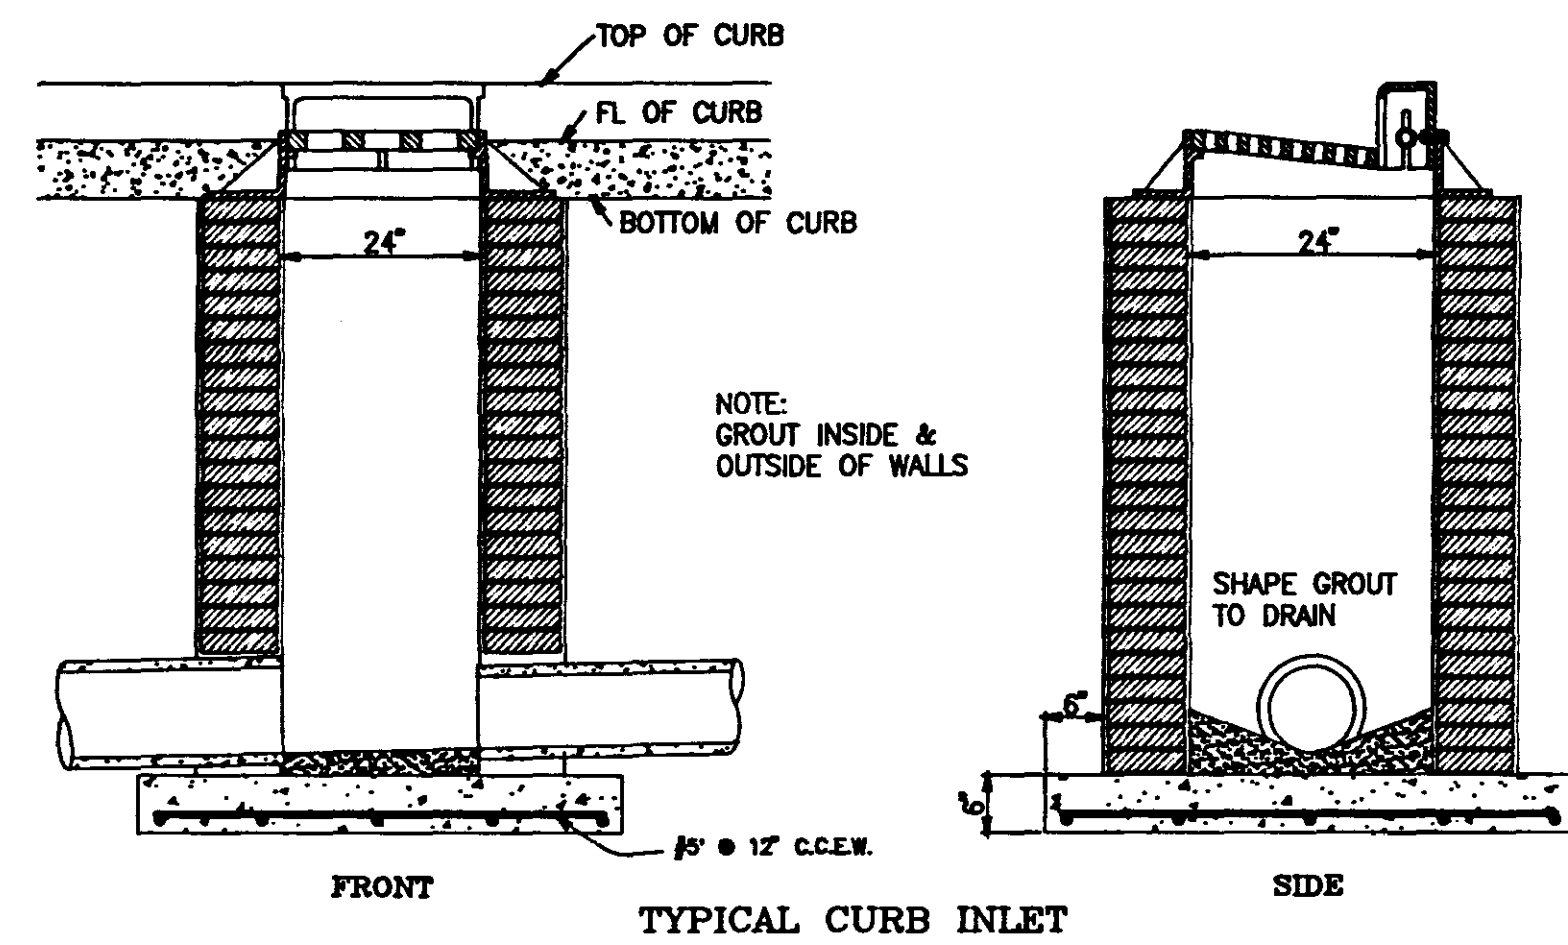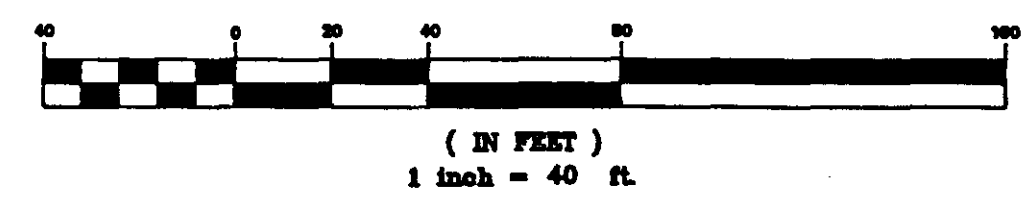

TYPICAL CURB INLET

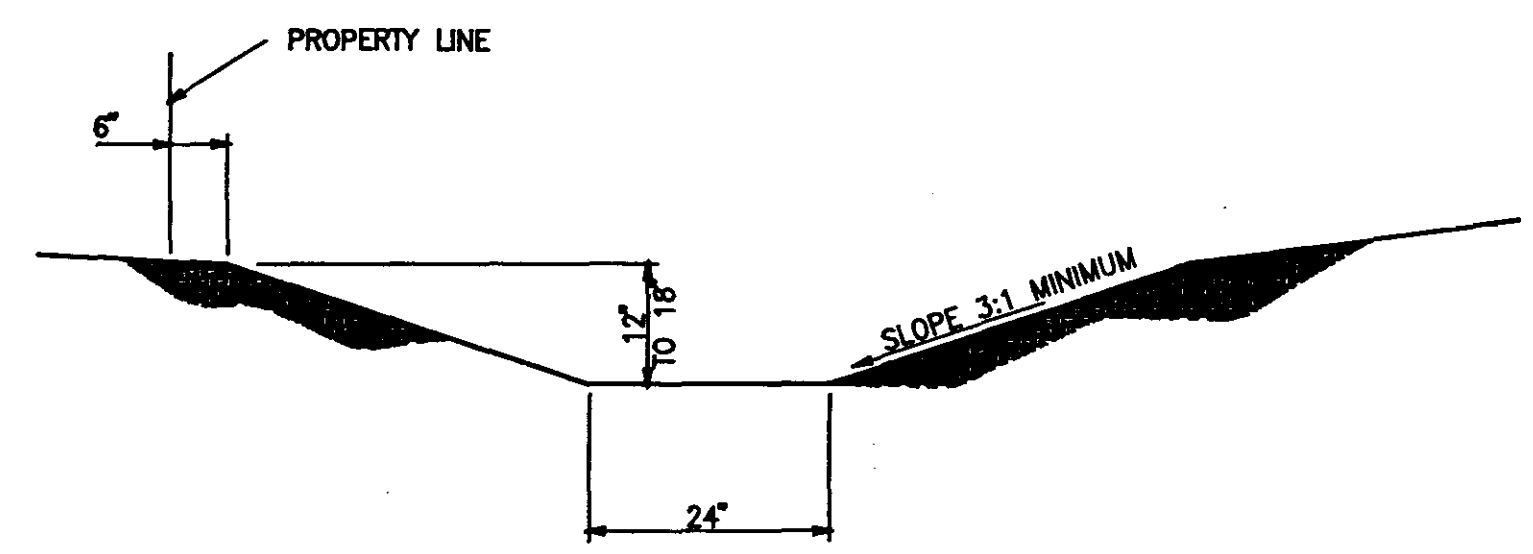


TYPICAL DITCH SECTION

GRADING & DRAINAGE PLAN
 FOR
FRIDAY HARBOR


REYNOLDS ENGINEERING, INC.
 POST OFFICE BOX 526
 JACKSON, MISSISSIPPI 39205

DATE: 9-18-1991 SCALE: 1" = 40' DRAWN BY: B.C.B. TITLE NO. 91049-GF JOB NO. 91-049

DATE: _____ BY: _____
 SURVEYED _____ PLOTTED _____
 CHECKED _____ CHECKED _____
 NOTE BOOK NO. _____
 PLAN

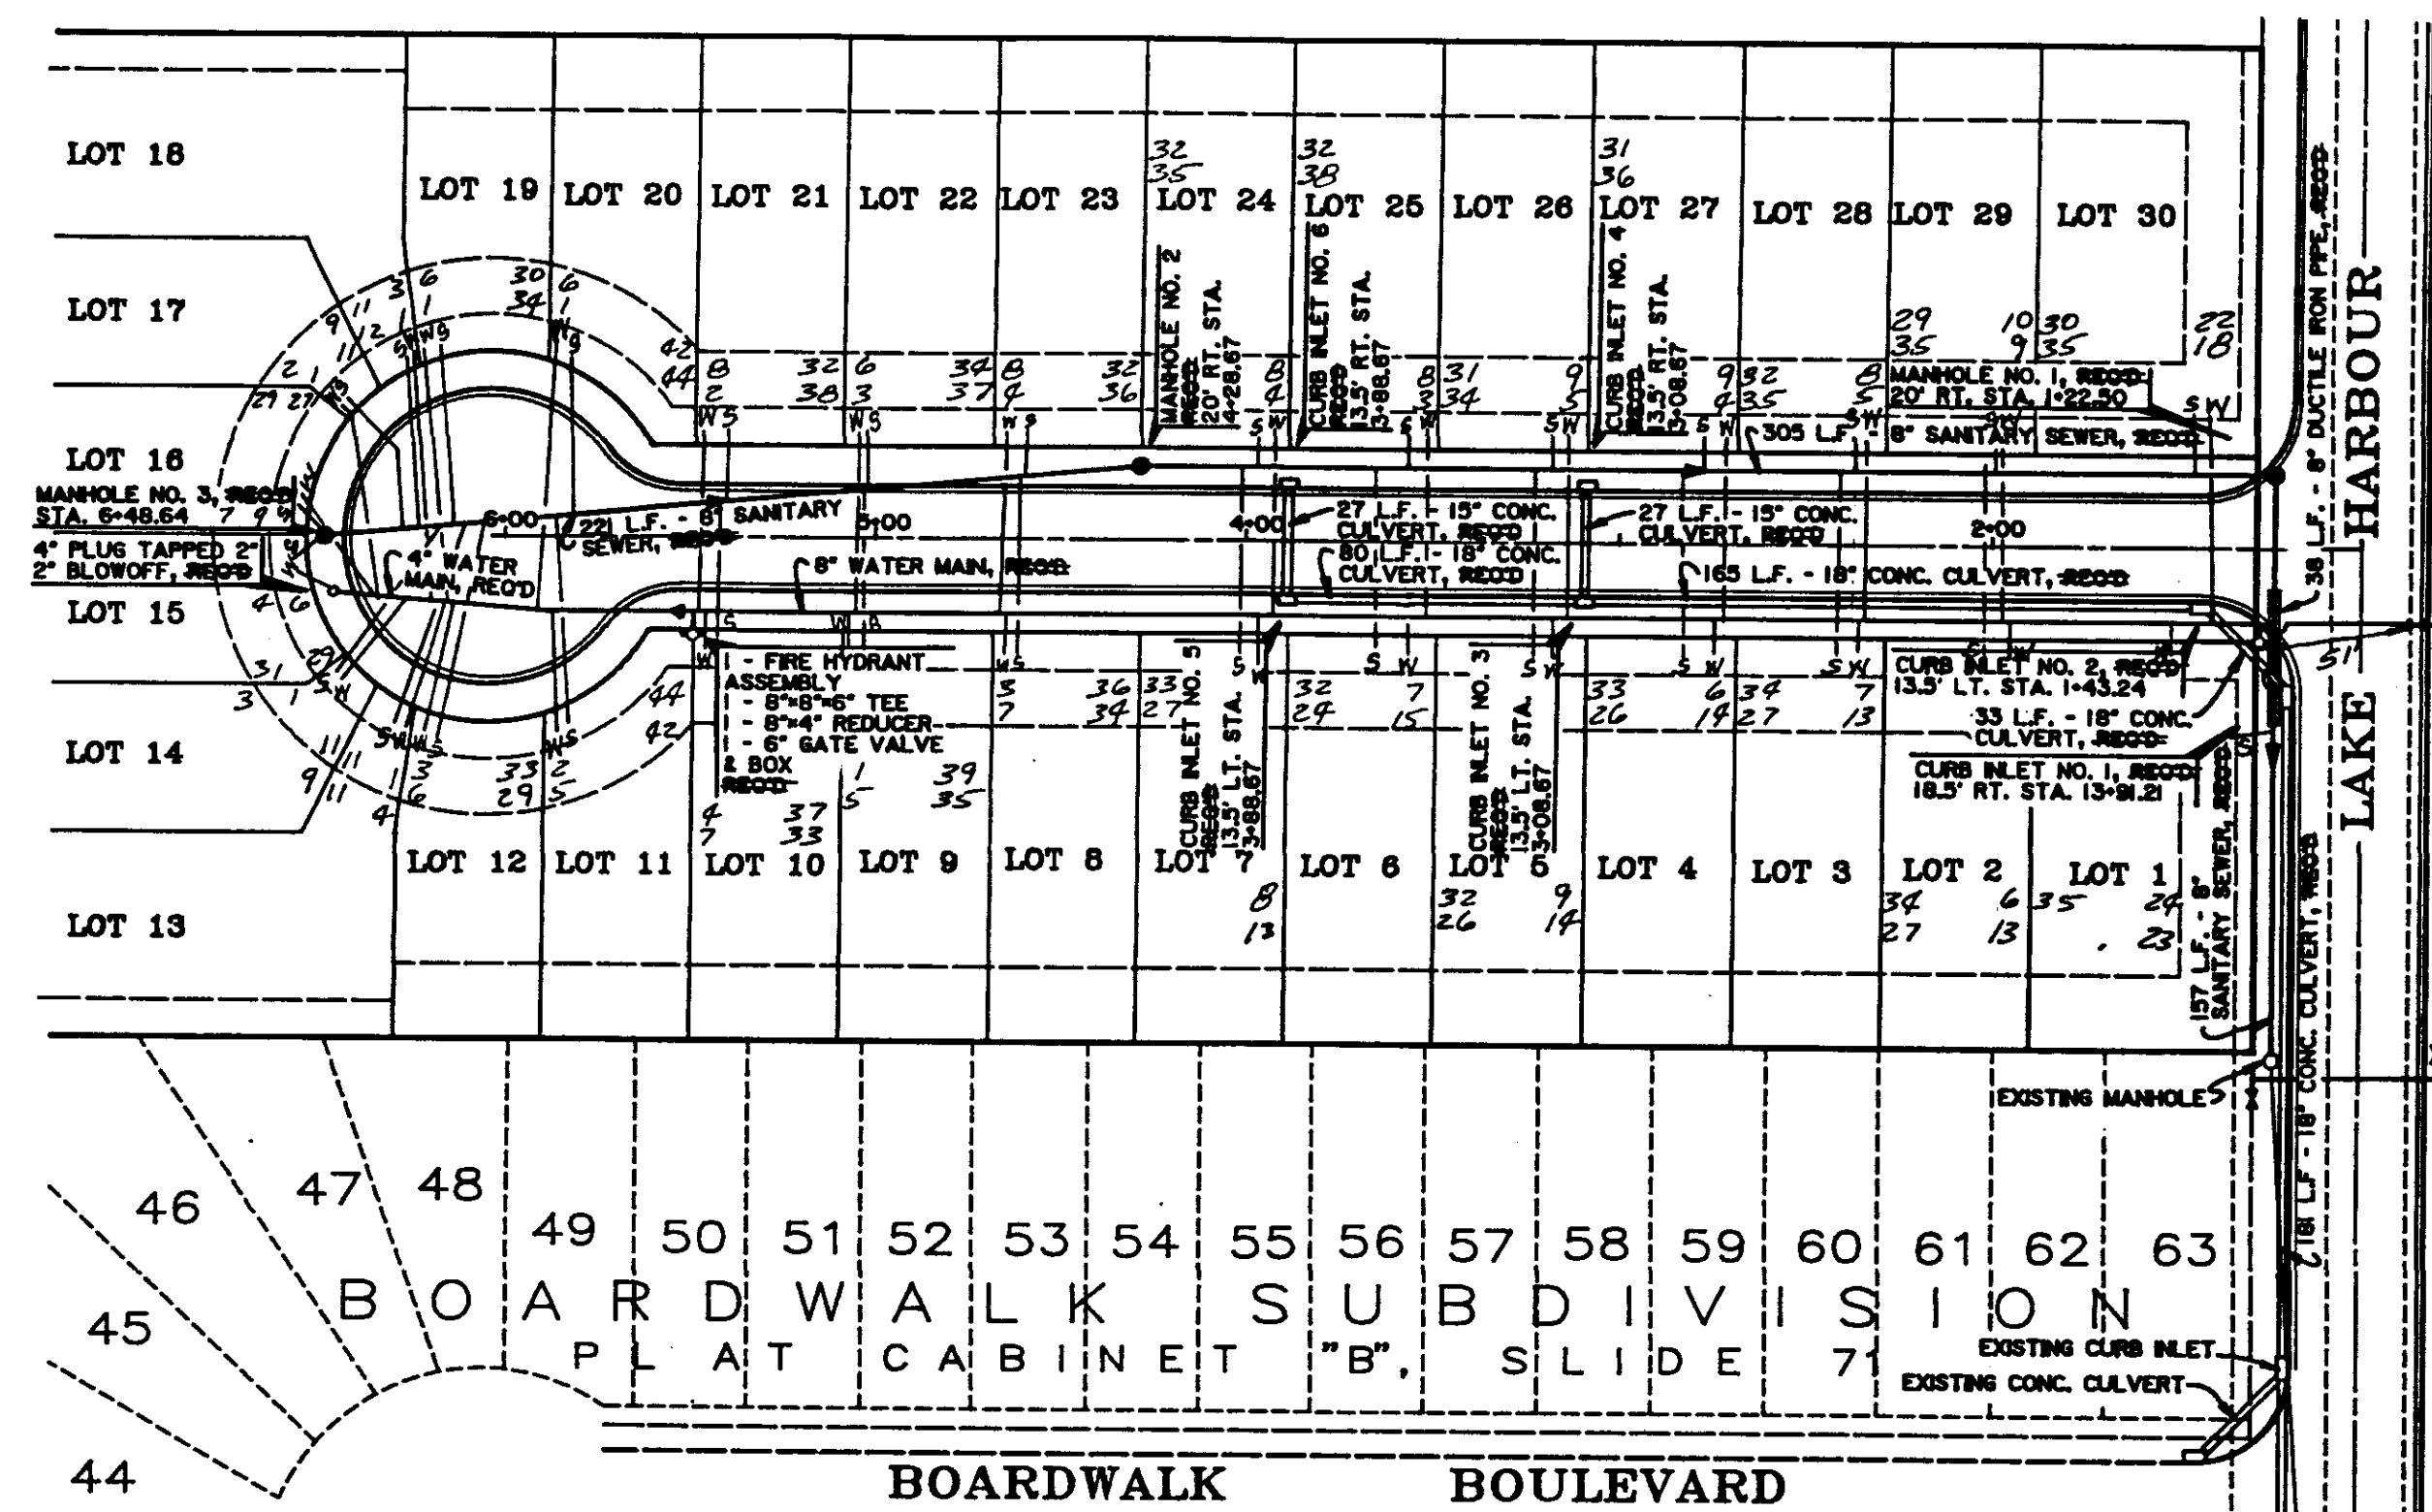

DATE: _____ BY: _____
 SURVEYED _____ PLOTTED _____
 CHECKED _____ CHECKED _____
 NOTE BOOK NO. _____
 PROFILE

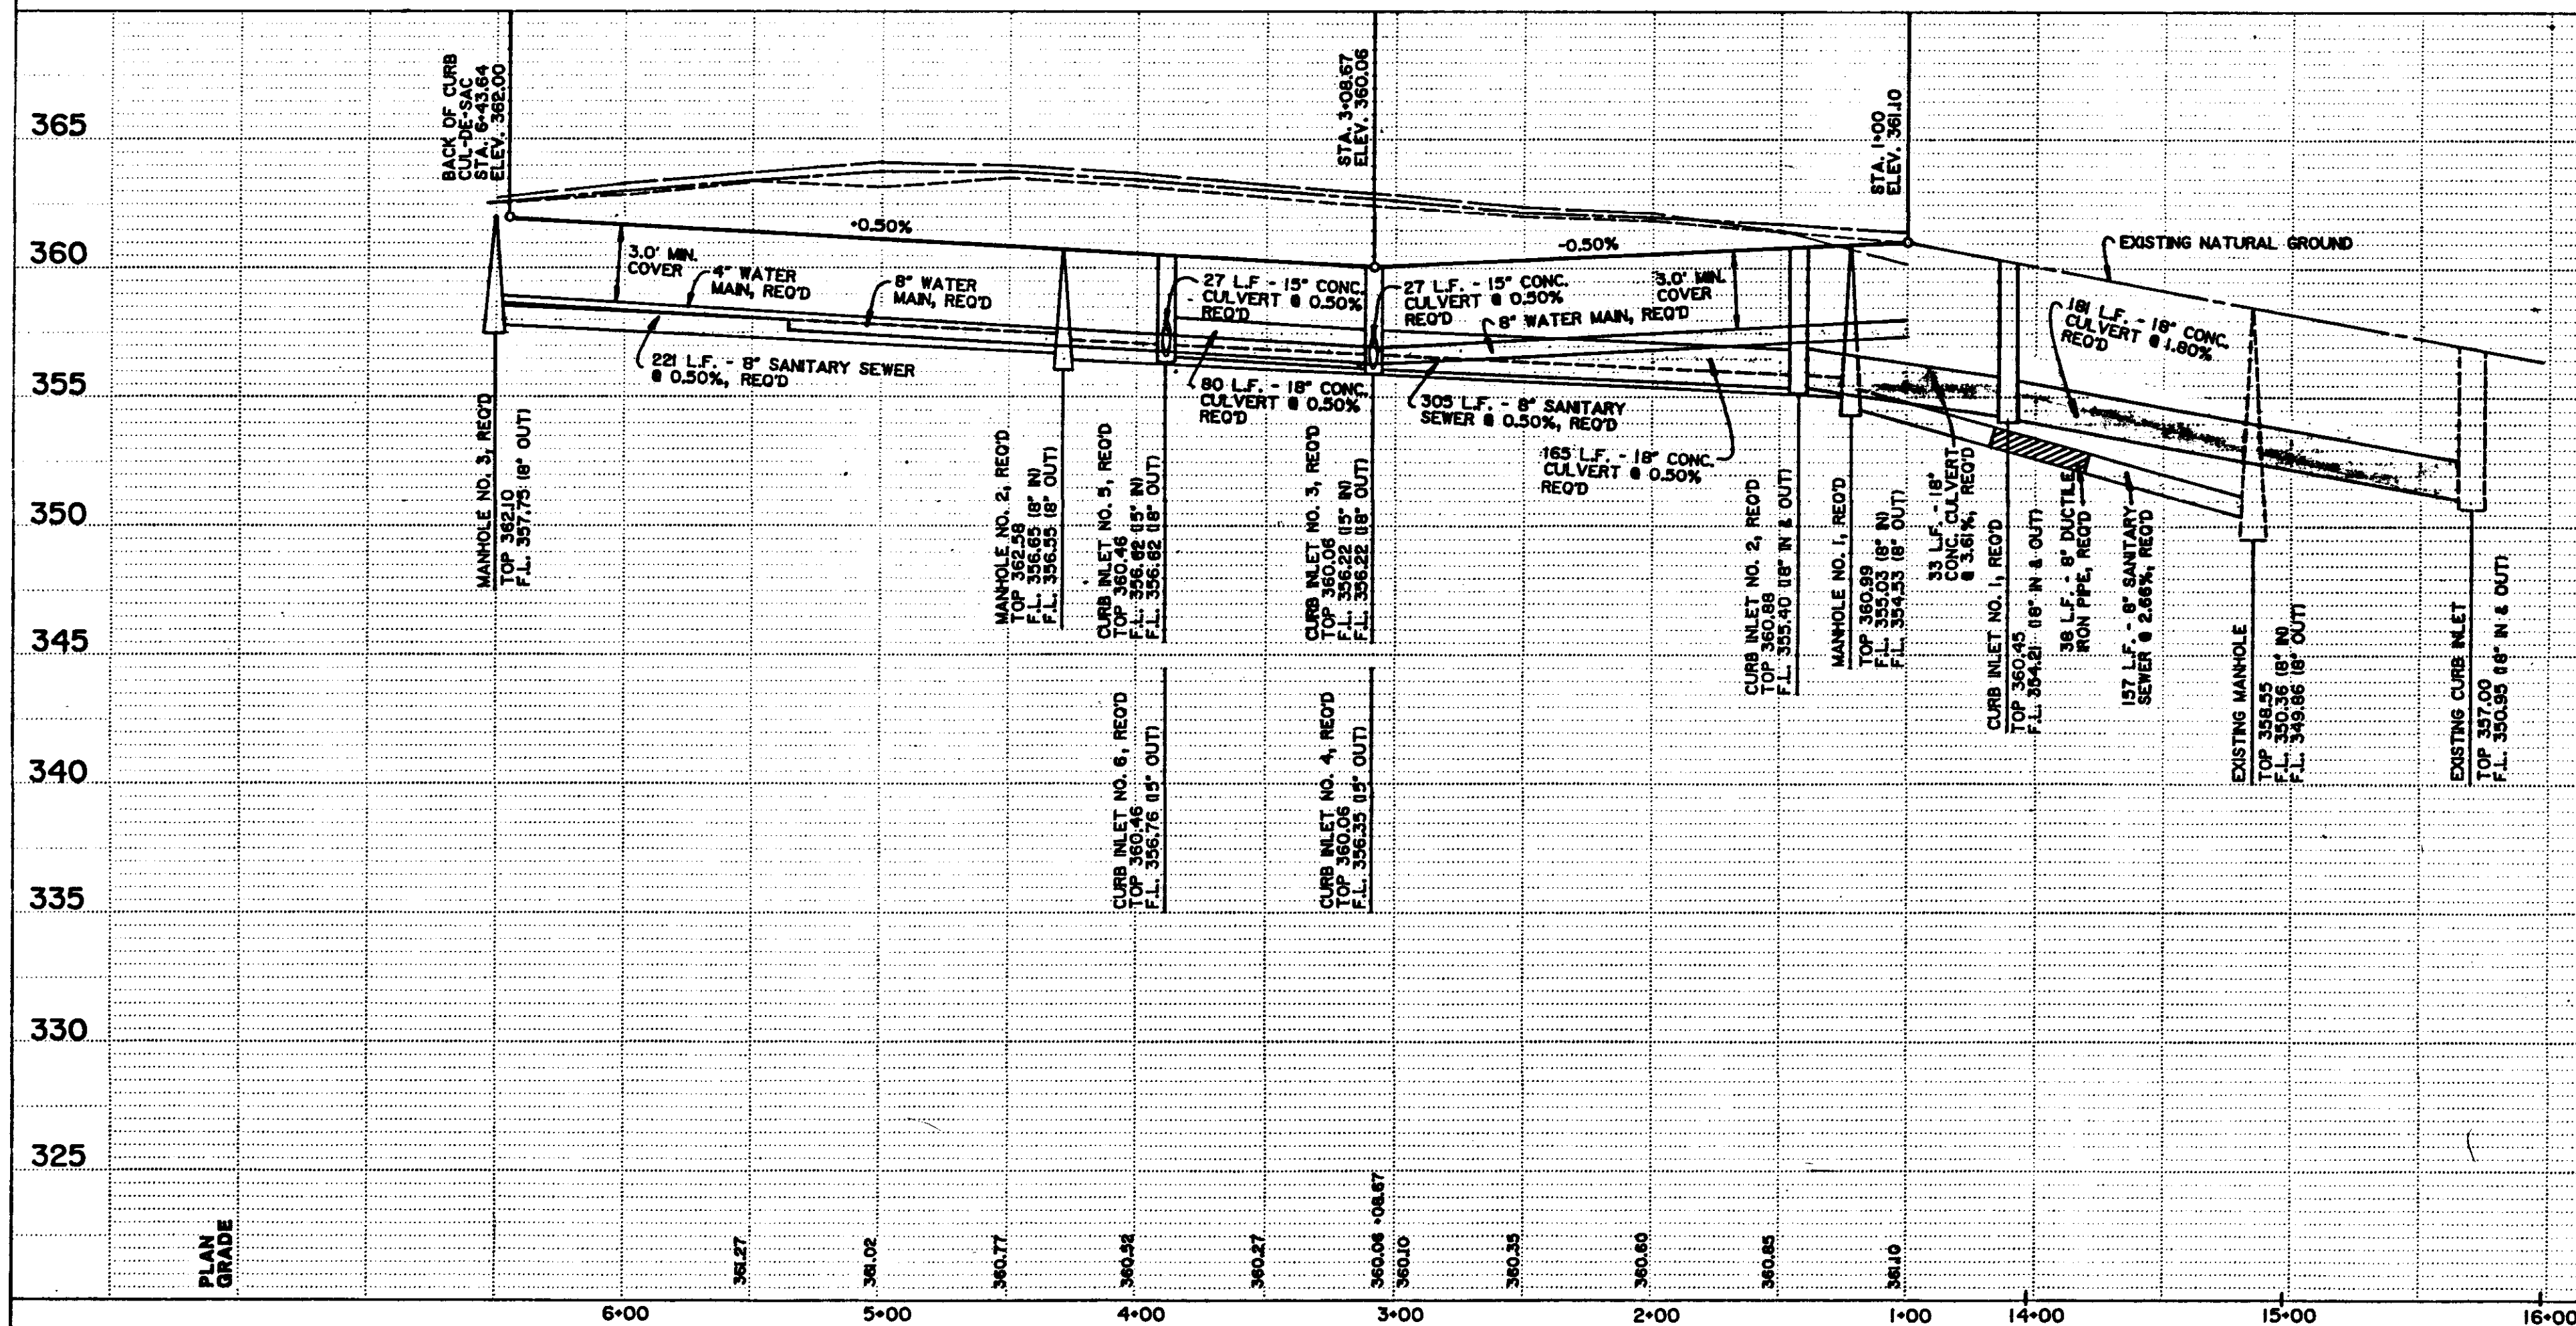

SCALE: 1" = 20' HORIZ.
 1" = 5' VERT.

LEFT
 RIGHT

1323 HIGHWAY FEDERAL AID SHEET
 PLATE 1-SINGLE PLAN AND PROFILE-FULL DOT
 MELEUNE
 PRINTED IN U.S.A.