

PS&E
PROJECT NO. DECD-0045(24)B
MADISON COUNTY

LENGTH DATA

EXCEPTIONS

NONE

EQUATIONS

NONE

STATE OF MISSISSIPPI
OFFICE OF STATE AID ROAD CONSTRUCTION
MISSISSIPPI DEPARTMENT OF TRANSPORTATION



PLAN AND PROFILE OF PROPOSED
CITY STREET
PROJECT NO. DECD-0045(24)B
HARBOR DRIVE AND RICE RD
CITY OF RIDGELAND
MADISON COUNTY

LENGTH OF ROADWAY (HARBOR DRIVE)	3504.59 FT.	0.663 MI
LENGTH OF ROADWAY (RICE RD)	537.70 FT.	0.101 MI
LENGTH OF BRIDGES	0.00 FT.	0.000 MI
LENGTH OF PROJECT (NET)	4042.29 FT.	0.764 MI
LENGTH OF EXCEPTIONS (NET)	0.00 FT.	0.000 MI
LENGTH OF PROJECT (GROSS)	4042.29 FT.	0.764 MI

SCALES


PLAN	1 IN. = 20 FT.
PROFILE-- HORIZ.	1 IN. = 20 FT.
VERT.	1 IN. = 5 FT.
LAYOUT	1 IN. = 400 FT.

INDEX
FOR INDEX SEE SHEET NO. 2

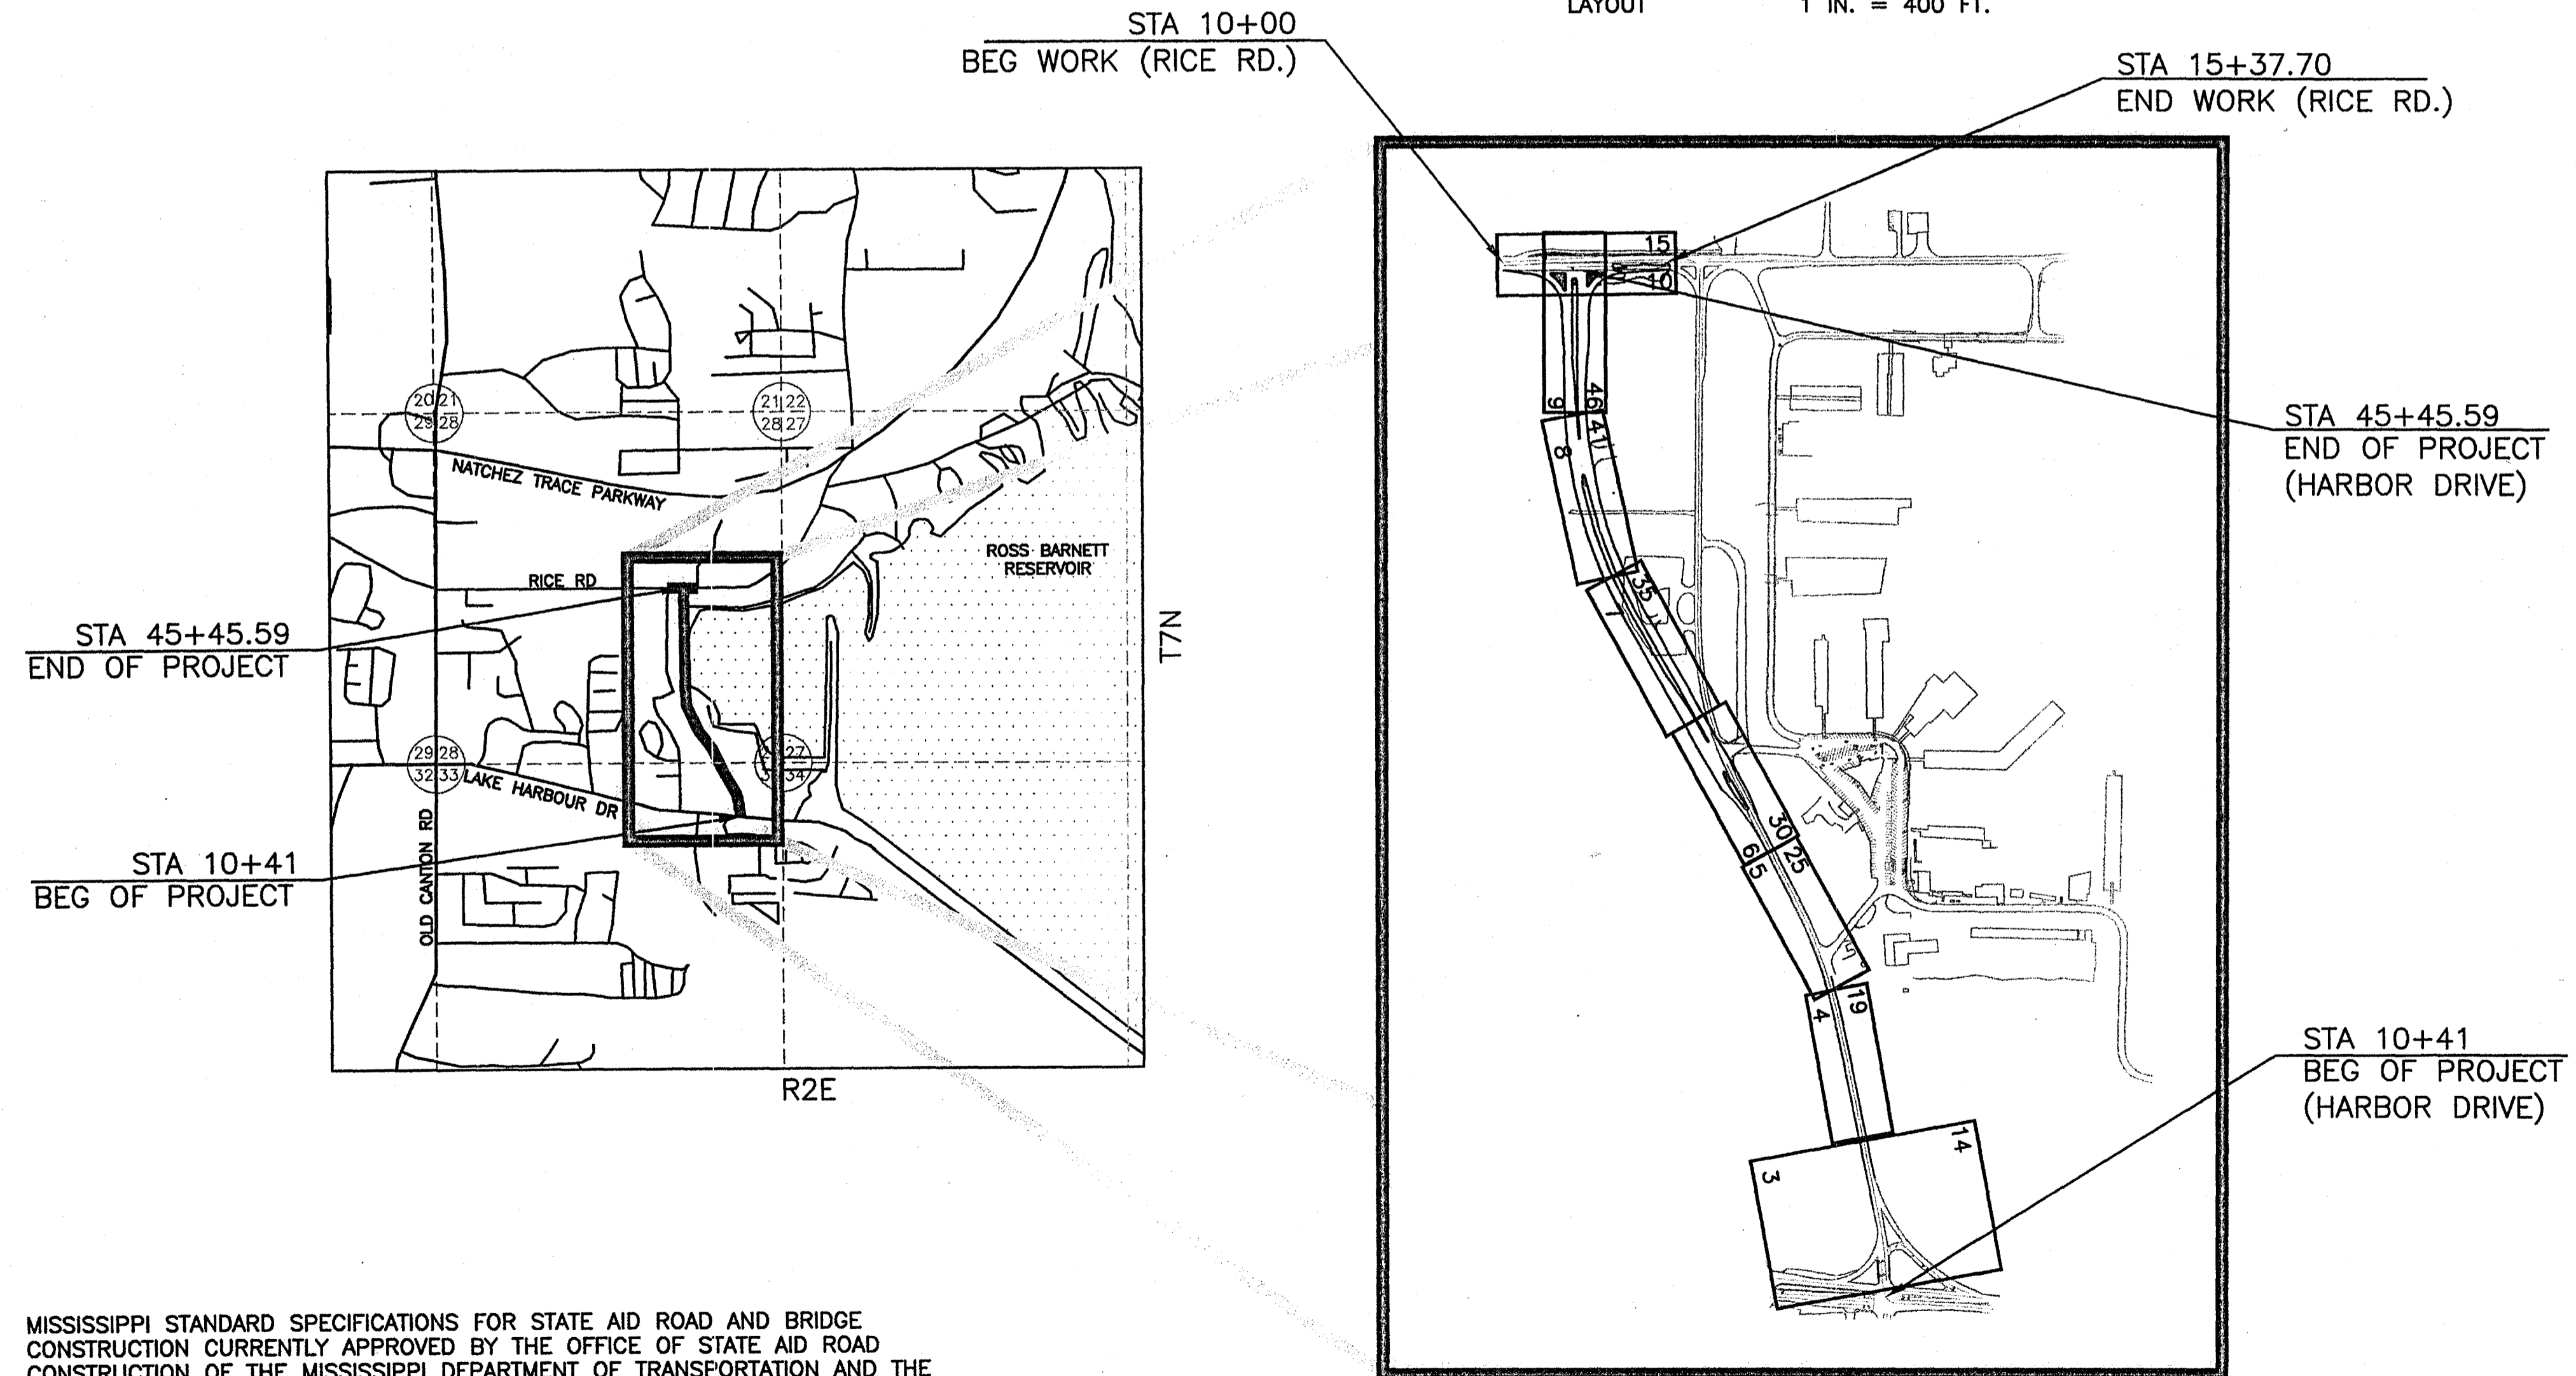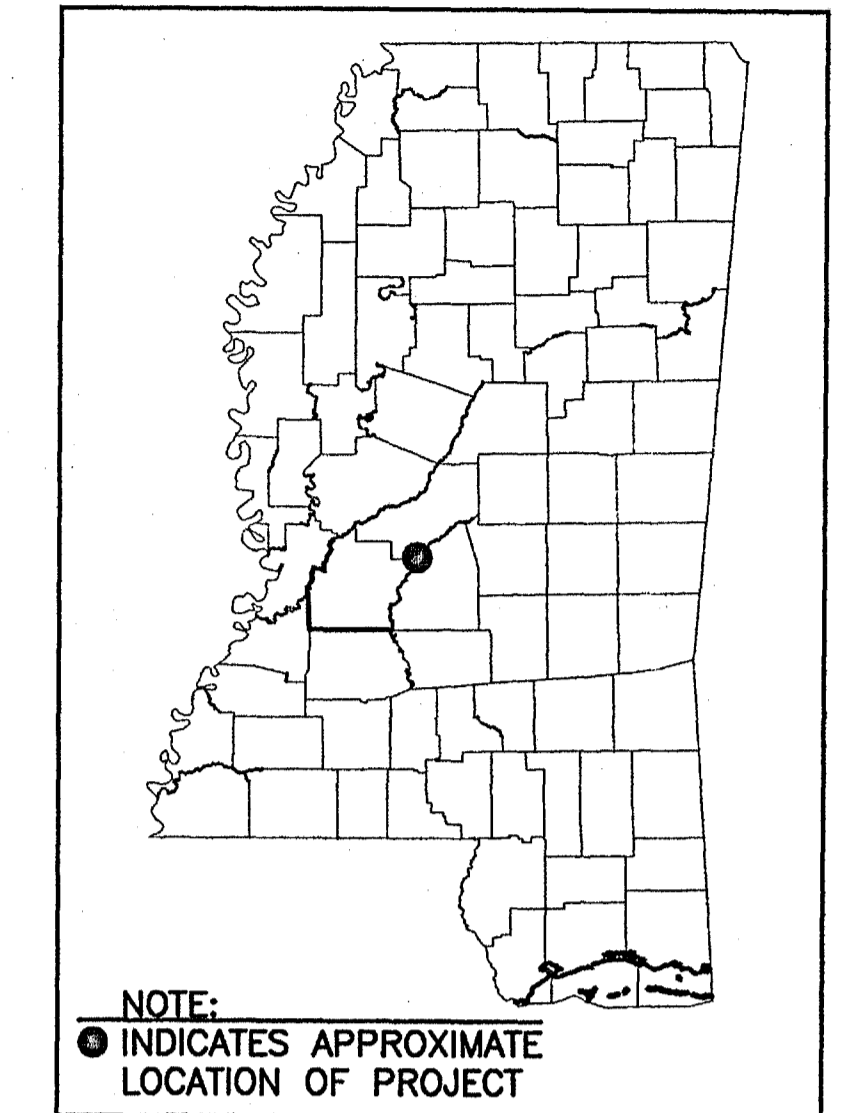

MISSISSIPPI STANDARD SPECIFICATIONS FOR STATE AID ROAD AND BRIDGE CONSTRUCTION CURRENTLY APPROVED BY THE OFFICE OF STATE AID ROAD CONSTRUCTION OF THE MISSISSIPPI DEPARTMENT OF TRANSPORTATION AND THE FEDERAL HIGHWAY ADMINISTRATION ARE MADE A PART HEREOF FULLY AND COMPLETELY AS IF ATTACHED HERETO, EXCEPT WHERE SUPERSEDED BY THE SPECIAL PROVISIONS, OR AMENDED BY REVISIONS.

Record Drawings
1-8-08

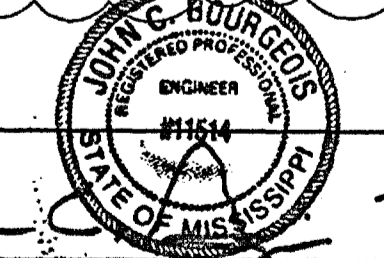

PREPARED BY: John C. Bourgeois 31 MAR 08
PROJECT ENGINEER DATE

OFFICE OF STATE AID ROAD CONSTRUCTION
MISSISSIPPI DEPARTMENT OF TRANSPORTATION
APPROVED
STATE AID ENGINEER _____ DATE _____

PWP-00846

PAY ITEM NO.	PAY ITEM	TOTAL QUANTITY		UNIT
		PLAN	FINAL	
ROADWAY ITEMS				
S-200-A	MOBILIZATION		L.S.	L.S.
S-201-A	CLEARING & GRUBBING		L.S.	L.S.
S-202-D	REMOVAL OF ASPHALT (ALL DEPTHS)	2,928.0		S.Y.
S-203-A	UNCLASSIFIED EXCAVATION, F.M.	624.0		C.Y.
S-203-A	UNCLASSIFIED EXCAVATION, F.M.	30.0		C.Y.
S-203-E1	BORROW EXCAVATION F.M.E., (CONTRACTOR FURNISHED) (CLASS 9-7)	67,325.0		C.Y.
S-203-H	EXCESS EXCAVATION (FM)	2,180.0		C.Y.
S-206-A	STRUCTURE EXCAVATION	825.0		C.Y.
S-304-A	GRANULAR MATERIAL (FM), (CLASS 5, GROUP C)	2,361.0		C.Y.
S-307-C	6" SOIL-LIME-WATER MIXING (CLASS C)	15,920.0		S.Y.
S-307-D	LIME	248.0		TN
S-403-A	HOT MIX ASPHALT, ST, 9.5 MM	2,100.0		TN
S-403-A	HOT MIX ASPHALT, ST, 12.5 MM	1,777.0		TN
S-403-A	HOT MIX ASPHALT, ST, 19 MM	4,644.0		TN
S-403-A	HOT MIX ASPHALT, ST, 19 MM, BASE REPAIR	30.0		TN
S-403-C	HOT MIX ASPHALT, ST, 19 MM, TRENCH WIDENING	204.0		TN
S-406-A	COLD MILLING OF BITUMINOUS PAVEMENTS, ALL DEPTHS	1,137.0		S.Y.
S-601-B	CLASS "B" STRUCTURAL CONCRETE, MINOR STRUCTURES	128.00		C.U.YD.
S-602-A	REINFORCING STEEL	11,290.0		LB
S-603-C-A	18" REINFORCED CONCRETE PIPE, CLASS III	1,896.0		L.F.
S-603-C-A	36" REINFORCED CONCRETE PIPE, CLASS III	101.0		L.F.
S-603-C-B	18" REINFORCED CONCRETE PIPE END SECTION	3.0		EA.
S-603-C-B	36" REINFORCED CONCRETE PIPE END SECTION	2.0		EA.
S-604-A	CASTINGS	2,954.0		LB
S-608-B	CONCRETE DRIVEWAY	63.0		S.Y.
S-609-D	COMBINATION CONCRETE CURB AND GUTTER, TYPE 1	6,771.0		L.F.
S-609-D	COMBINATION CONCRETE CURB AND GUTTER, TYPE 2	294.0		L.F.
S-613-A	ADJUSTMENT OF CASTINGS, GRATINGS AND UTILITY APPURTENANCES	L.S.		L.S.
S-616-A	CONCRETE ISLAND PAVEMENT	32.0		S.Y.
S-617-A	RIGHT-OF-WAY MARKERS, TYPE 1	22.0		EA.
S-618-A	MAINTENANCE OF TRAFFIC	L.S.		L.S.
S-618-B	ADDITIONAL CONSTRUCTION SIGNS	0.0		S.F.
S-621-A	4" WIDE, THERMOPLASTIC TRAFFIC STRIPE (SKIP WHITE)(90 MILS)	0.48		MILE
S-621-C	4" WIDE, THERMOPLASTIC EDGE STRIPE (CONTINUOUS WHITE)(60 MILS)	0.76		MILE
S-621-E2	4" WIDE, THERMOPLASTIC TRAFFIC STRIPE (CONTINUOUS YELLOW)(90 MILS)	0.71		MILE
S-621-G-1	THERMOPLASTIC DETAIL STRIPE (4" EQUIVALENT LENGTH)(WHITE)(90 MILS)	5,345.0		L.F.
S-621-G-2	THERMOPLASTIC DETAIL STRIPE (4" EQUIVALENT LENGTH)(YELLOW)(90 MILS)	923.0		L.F.
S-621-H-1	THERMOPLASTIC LEGEND (WHITE)(120 MILS)	1,352.0		L.F.
S-621-H-2	THERMOPLASTIC LEGEND (WHITE)(120 MILS)	626.8		S.F.
S-627-K	RED-CLEAR REFLECTIVE HIGH PERFORMANCE RAISED MARKERS	235.0		EA.
S-627-L	TWO-WAY YELLOW REFLECTIVE HIGH PERFORMANCE RAISED MARKERS	72.0		EA.
S-630-A	REFLECTORIZED TRAFFIC WARNING SIGN (ENCAPSULATED LENS)	6.00		EA.
S-630-B	REFLECTORIZED TRAFFIC REGULATORY SIGN (ENCAPSULATED LENS)	2.00		EA.
S-630-D	REFLECTORIZED TRAFFIC DELINEATOR SIGN (ENCAPSULATED LENS)	4.00		EA.
635-A	VEHICLE LOOP ASSEMBLY	500.0		L.F.
636-A	SHIELDED CABLE, AWG #14, 4 CONDUCTOR	425.0		L.F.
637-A	EQUIPMENT CABINET	1.0		EA.
639-A	TRAFFIC EQUIPMENT SIGNAL POLE, TYPE II	3.0		EA.
640-A	TRAFFIC SIGNAL HEAD, TYPE 1	4.0		EA.
640-A	TRAFFIC SIGNAL HEAD, TYPE 6	2.0		EA.
640-A	TRAFFIC SIGNAL HEAD, TYPE 7	1.0		EA.
642-A	SOLID STATE TRAFFIC ACTUATED CONTROLLER, TYPE 3, WITH TCB	1.0		EA.
644-A	OPTICAL DETECTOR	1.0		EA.
644-B	OPTICAL DETECTOR CABLE	570.0		L.F.
644-C	PHASE SELECTOR, 4 CHANNELS	1.0		EA.
647-A	PULL BOXES, TYPE 2	4.0		EA.
653-A	TRAFFIC SIGN, ENCAPSULATED LENS	6.0		S.F.
666-B	ELECTRIC CABLE, UNDERGROUND IN CONDUIT, ISWAM20-1, AWG# 6, 1 CONDUCTOR	50.0		L.F.
666-B	ELECTRIC CABLE, UNDERGROUND IN CONDUIT, ISWAM20-1, AWG# 14, 4 CONDUCTOR	490.0		L.F.
666-B	ELECTRIC CABLE, UNDERGROUND IN CONDUIT, ISWAM20-1, AWG# 14, 7 CONDUCTOR	570.0		L.F.
668-A	TRAFFIC SIGNAL CONDUIT, UNDERGROUND, TYPE 1, 3"	120.0		L.F.
668-A	TRAFFIC SIGNAL CONDUIT, UNDERGROUND, TYPE 4, 1"	50.0		L.F.
668-A	TRAFFIC SIGNAL CONDUIT, UNDERGROUND, TYPE 4, 2"	160.0		L.F.

PAY ITEM NO.	PAY ITEM	TOTAL QUANTITY		UNIT
		PLAN	FINAL	
668-B	TRAFFIC SIGNAL CONDUIT, UNDERGROUND DRILLED OR JACKED, TYPE 1, 3"	160.0		L.F.
683-A	LIGHTING ASSEMBLY, HIGH MAST, LUMINAIRE	3.0		EA.
901-S-1000-A	6" DUCTILE IRON WATER MAIN	18.0		L.F.
901-S-1000-A	12" DUCTILE IRON WATER MAIN	1,986.0		L.F.
901-S-1001-A	6" TAPPING SLEEVE AND VALVE W/BOX	1.0		EA.
901-S-1002-A	DUCTILE IRON FITTINGS	438.0		LB
901-S-1005-A	CONNECT EXISTING MAIN, 12"(LABOR ONLY)	2.0		EA.
901-S-2000-A	8" SANITARY SEWER 0/6	184.0		L.F.
901-S-2000-A	8" SANITARY SEWER 6/8	367.0		L.F.
901-S-2000-A	8" SANITARY SEWER 8/10	70.0		L.F.
901-S-2001-A	48" MANHOLE 0/6	1.0		EA.
901-S-2001-A	48" MANHOLE 6/8	1.0		EA.
901-S-2001-A	48" MANHOLE 8/10	1.0		EA.
901-2002-A	ADJUST MANHOLE TO GRADE(ALL DEPTHS)	2.0		EA.
901-S-3000-A	STAMPED, PIGMENTED CONCRETE	364.0		S.Y.
901-S-4000-A	HANDICAP RAMP PAVERS	24.0		S.F.
EROSION CONTROL ITEMS				
S-211-A	TOPSOIL FOR SLOPE TREATMENT	19,360.0		S.Y.
S-212-A	AGRICULTURAL LIMESTONE	1.2		TON
S-212-B	COMMERCIAL FERTILIZER (13-13-13)	1.2		TON
S-214 -A	SEEDING	4.0		ACRE
S-215-A	VEGETATIVE MATERIAL FOR MULCH	12.00		TN
S-231-A	EROSION CONTROL FABRIC	15,000.0		S.Y.
S-233-A	TEMPORARY SILT FENCE (TYPE II)(AOS 0.15-0.84)	9,000.0		L.F.
S-235-A	TEMPORARY EROSION CHECKS	40.0		BALE
S-815-B	GRouted RIPRAP	80.0		S.Y.
S-815-E	GEOTEXTILE UNDER RIPRAP, TYPE V, AOS .21-.43	90.0		S.Y.

(1) All signalization items to be in accord with Mississippi Standard Specifications for Road and Bridge Construction, 2004 Edition.
(2) For base repair.
(3) Material for erosion control fabric shall be as defined in Specification S-715.09.3.

PREPARED BY: _____ PROJECT ENGINEER DATE _____


INDEX OF DRAWINGS			
1	TITLE SHEET	6A	FORM GRADE SHEET
2	QUANTITY & INDEX SHEET	7	PLAN/PROFILE SHEET
2-A	TYPICAL SECTION SHEET	8	PLAN/PROFILE SHEET
2-B	TYPICAL SECTION SHEET	8A	FORM GRADE SHEET
2-C	TYPICAL SECTION SHEET	9	PLAN/PROFILE SHEET
2-D	TYPICAL SECTION SHEET	9A	FORM GRADE SHEET
2-E	TYPICAL SECTION SHEET	10	PLAN/PROFILE SHEET
2-F	TYPICAL SECTION SHEET	10A	TRAFFIC SIGNAL PLAN
2-G	SCHEDULE SHEET		
2-H	SCHEDULE SHEET		
2-I	INTERSECTION DETAIL SHEET		
2-J	TYPICAL DETAIL SHEET		
2-K	SANITARY SEWER SYSTEM DETAIL SHEET		
2-L	WATER DISTRIBUTION SYSTEM DETAIL SHEET		
2-M	SIGNAL POLE DETAIL SHEET		
2-N	LOOP ASSEMBLY DETAIL SHEET		
2-O	SIGNAL JUNCTION BOXES/CONDUIT DETAIL SHEET		
2-P	EROSION CONTROL DETAIL SHEET		
2-Q	STRIPING DETAIL & TRAFFIC SIGN SHEET		
2-R	STRIPING DETAIL SHEET		
2-S	STRIPING DETAIL SHEET		
2-T	STRIPING DETAIL SHEET		
2-U	TRAFFIC CONTROL PLAN		
SA-PSM-1	PAVEMENT STRIPING AND MARKING DETAILS		
SA-TSP-1	TRAFFIC SIGN PLACEMENT		
125	PAVEMENT MARKING LEGEND DETAILS		
140	EROSION CONTROL		
252	TRAFFIC CONTROL PLAN		
259	HIGHWAY SIGN AND BARRICADE DETAILS		
270	RIGHT-OF-WAY MARKER		
287	DRIVEWAYS, CURB & GUTTER & SIDEWALK		
300	PIPE CULVERT INSTALLATION		
302	JUNCTION BOX FOR PIPE CULVERTS		
322	STORM SEWER STRUCTURE TYPE SS-2		
328	FLARED END SECTION FOR CONCRETE PIPE		
3	OVERLAY PLAN SHEET		
4	OVERLAY PLAN SHEET		
5	OVERLAY PLAN SHEET		
6	PLAN/PROFILE SHEET		

Record Drawings
1-8-08

24P-00846

RATES OF APPLICATION USED FOR ESTIMATING QUANTITIES

ITEM	RATE
HOT MIX ASPHALT	112 LB / SY-IN
HYDRATED LIME (6%)	.016 TN / SY
AGRICULTURAL LIMESTONE	600 LB / AC
VEGETATIVE MATERIALS FOR MULCH	3 TN / AC
COMMERCIAL FERTILIZER	600 LB / AC
SEEDING	15 LB / AC

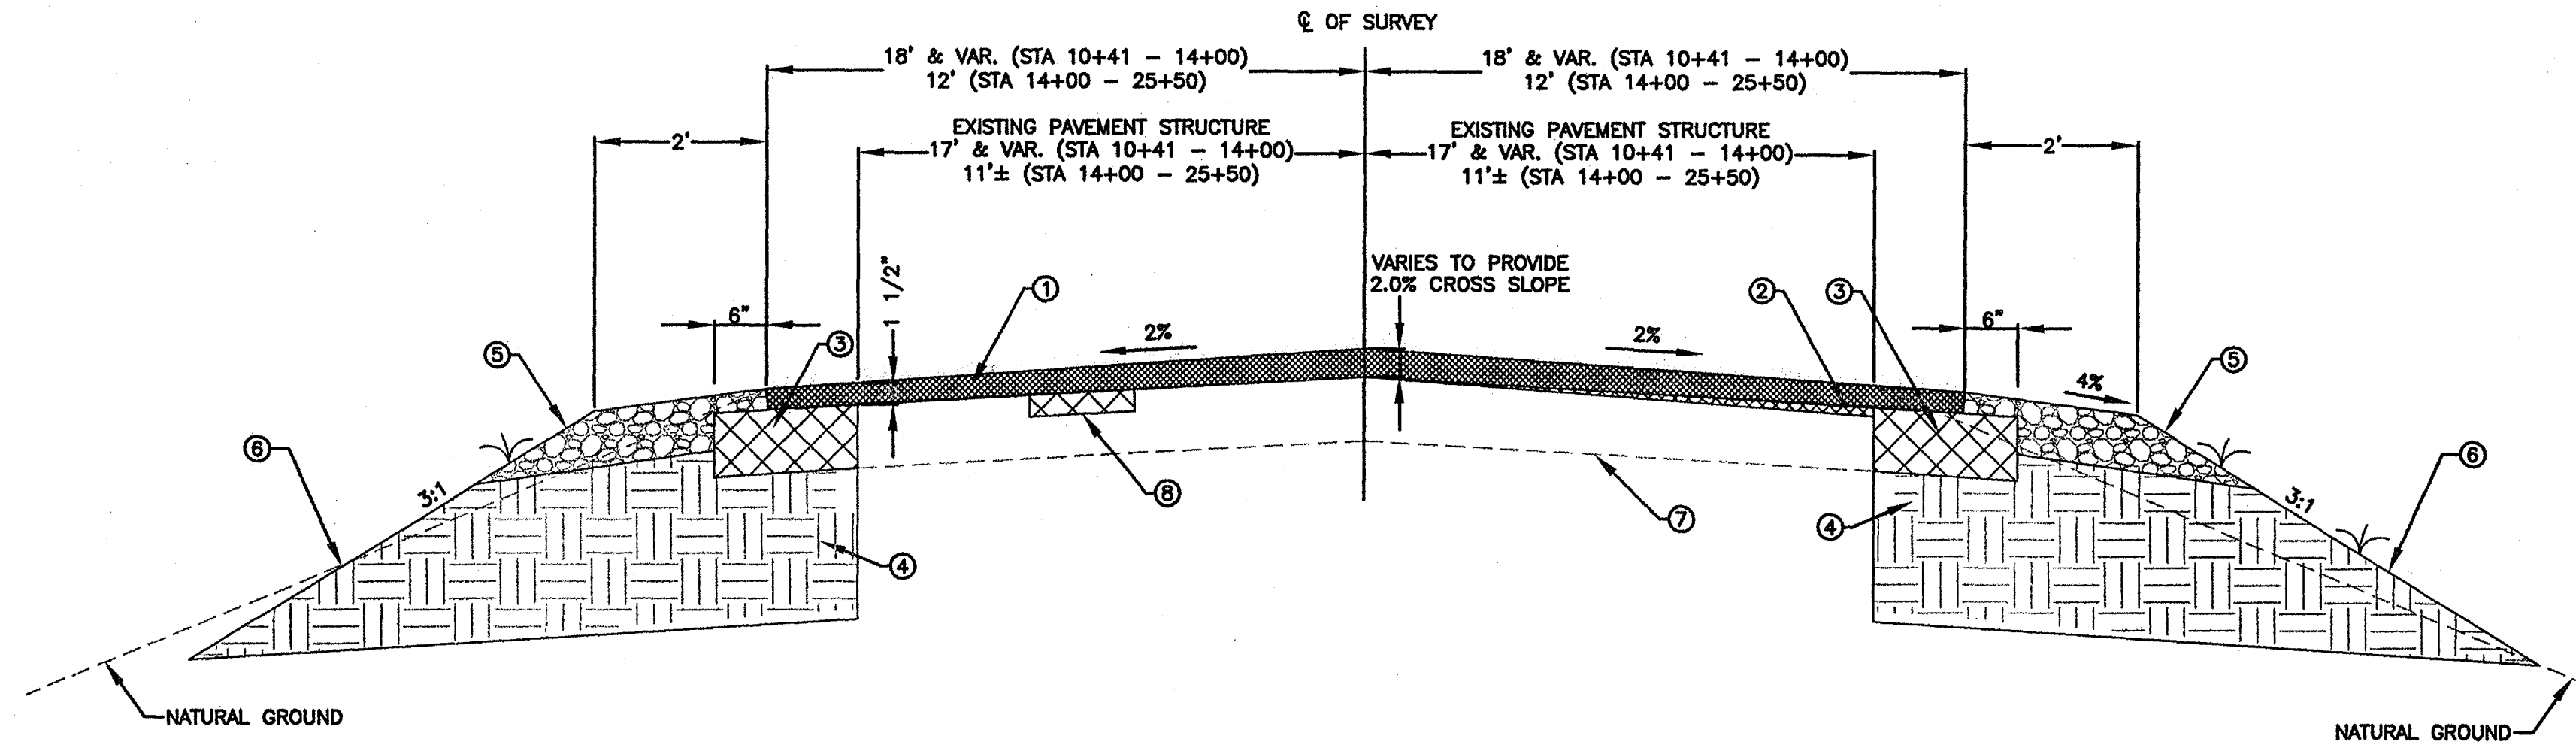

TYPICAL TWO-LANE WIDENING & OVERLAY SECTION
STA 10+41 TO STA 25+55

- ① 2" MIN. HMA, ST, 9.5mm
- ② COLD MILLING PER PLAN OR HMA, ST, 12.5mm, BINDER (0" TO 3" CL OF SURVEY)
- ③ 6" DEEP X 1.5' WIDE HMA ST, 19mm, TRENCH WIDENING
- ④ UNDERCUT AND BORROW EXCAVATION. UNDERCUT MAY BE ELIMINATED UPON VERIFICATION OF EX. SUBGRADE MATERIAL. (STA 10+41 - STA 25+50)
- ⑤ 6" GRANULAR MATERIAL CLASS 5, GROUP C
- ⑥ ESTABLISH VEGETATIVE COVER ON ALL PROPOSED SLOPES. EROSION CONTROL (S-715.09.3) REQ'D ON ALL SLOPES OF 3:1 OR GREATER.
- ⑦ EXISTING PAVEMENT STRUCTURE (6" GRANULAR SUBBASE, 2" BIT. BASE, 3" BIT. SURFACE)
- ⑧ FAILED AREAS DESIGNATED BY THE ENGINEER SHALL BE UNDERCUT TO A 12" MINIMUM DEPTH AND REPAIRED WITH HOT MIX ASPHALT; 19mm. (SEE SHEET 3 FOR LOCATIONS)

GENERAL CONSTRUCTION NOTES

1. The existing utility locations shown on the Drawings are approximate only. The Contractor shall coordinate the location (horizontal and vertical) of existing utilities (power, telephone, gas, water, sewer, etc.) with the appropriate utility company before construction begins.
2. All utility main lines or service lines encountered during construction, whether shown on the Drawings or not, shall be protected by the Contractor and repairs necessary due to damage to same by the Contractor shall be at no additional cost to the Owner.
3. The Contractor shall establish a vegetative cover on all areas where the existing vegetation was removed or disturbed during construction, unless solid sod is required.
4. Unsuitable bedding, backfill or site subgrade material which may be encountered shall be excavated to the limits required and backfilled with acceptable material to the lines and grades shown on the Drawings.
5. Contractor shall install all required signal and advance loops prior to placement of final bituminous surface course.
6. Contractor is responsible to perform all reasonable means necessary for maintaining proper operation of traffic signals throughout construction.
7. Existing sanitary sewer manhole tops, water valves, valve boxes, meters, storm sewer or other related appurtenances shall, when required, be adjusted to finished grade by Contractor and paid for under S-613-A. Castings required to be removed shall be salvaged to the Owner by the Contractor.
8. All salvageable material including traffic signs, water valves, fire hydrants, and drainage pipes that are removed during construction, shall be stored on site and recovered by the City, unless otherwise refused by the City.
9. Clearing and grubbing of construction easements shall be considered as normal right-of-way and paid for by lump sum.

FLEXIBLE PAVEMENT DESIGN

DATA FOR PAVEMENT DETERMINATION

(2005) ADT = 8845 Current
(2015) ADT = 11726 n Year
(2025) ADT = 15546 Design
D = 50 % of DHV
T = 3 % of DHV
T (Total) = 10% of ADT
18k (Flex) = 675/1000
18k (Rigid) = 1000

DATA FOR OVERLAY DETERMINATION

2025		2015	
ADL	412	ADL	347
CBR	15	CBR	15
SSV	5.29	SSV	5.29
PT	2.5	PT	2.5
SN	3.84	SN	3.34

SCHEDULE OF STRUCTURE THICKNESS

STATION TO STATION	ESTIMATED SUBGRADE CBR	SOIL SUPPORT VALUE	AVERAGE DAILY LANE LOADING	STRUCTURE NUMBER REQUIRED	SUBBASE THICKNESS		BASE COURSE THICKNESS		BINDER COURSE THICKNESS		SURFACE COURSE THICKNESS		TOTAL PROVIDED	
					In	SN	In	SN	In	SN	In	SN	In	SN
OVERLAY														
STA 10+41 - 25+55	15	5.29	347	3.34	6	0.6	2	.68			*6	2.2	13	3.48


* INCLUDES 2" OF REQ'D OVERLAY

NOTE: SUBGRADE CBR FOR NEW PAVEMENT STRUCTURE IS ESTIMATED ONLY. A SUBGRADE SOIL PROFILE WILL BE PREPARED AND THE CBR AND THE REQUIRED BASE STRUCTURE THICKNESS ARE TO BE DETERMINED AFTER GRADING BEFORE PLACING BASE MATERIAL. SUBGRADE CBR FOR THE EXISTING PAVEMENT STRUCTURE WAS VERIFIED BY FIELD INVESTIGATION.

Record Drawings
1-8-08

RATES OF APPLICATION USED FOR ESTIMATING QUANTITIES

ITEM	RATE
HOT MIX ASPHALT	112 LB / SY-IN
HYDRATED LIME (6%)	.016 TN / SY
AGRICULTURAL LIMESTONE	600 LB / AC
VEGETATIVE MATERIALS FOR MULCH	3 TN / AC
COMMERCIAL FERTILIZER	600 LB / AC
SEEDING	15 LB / AC

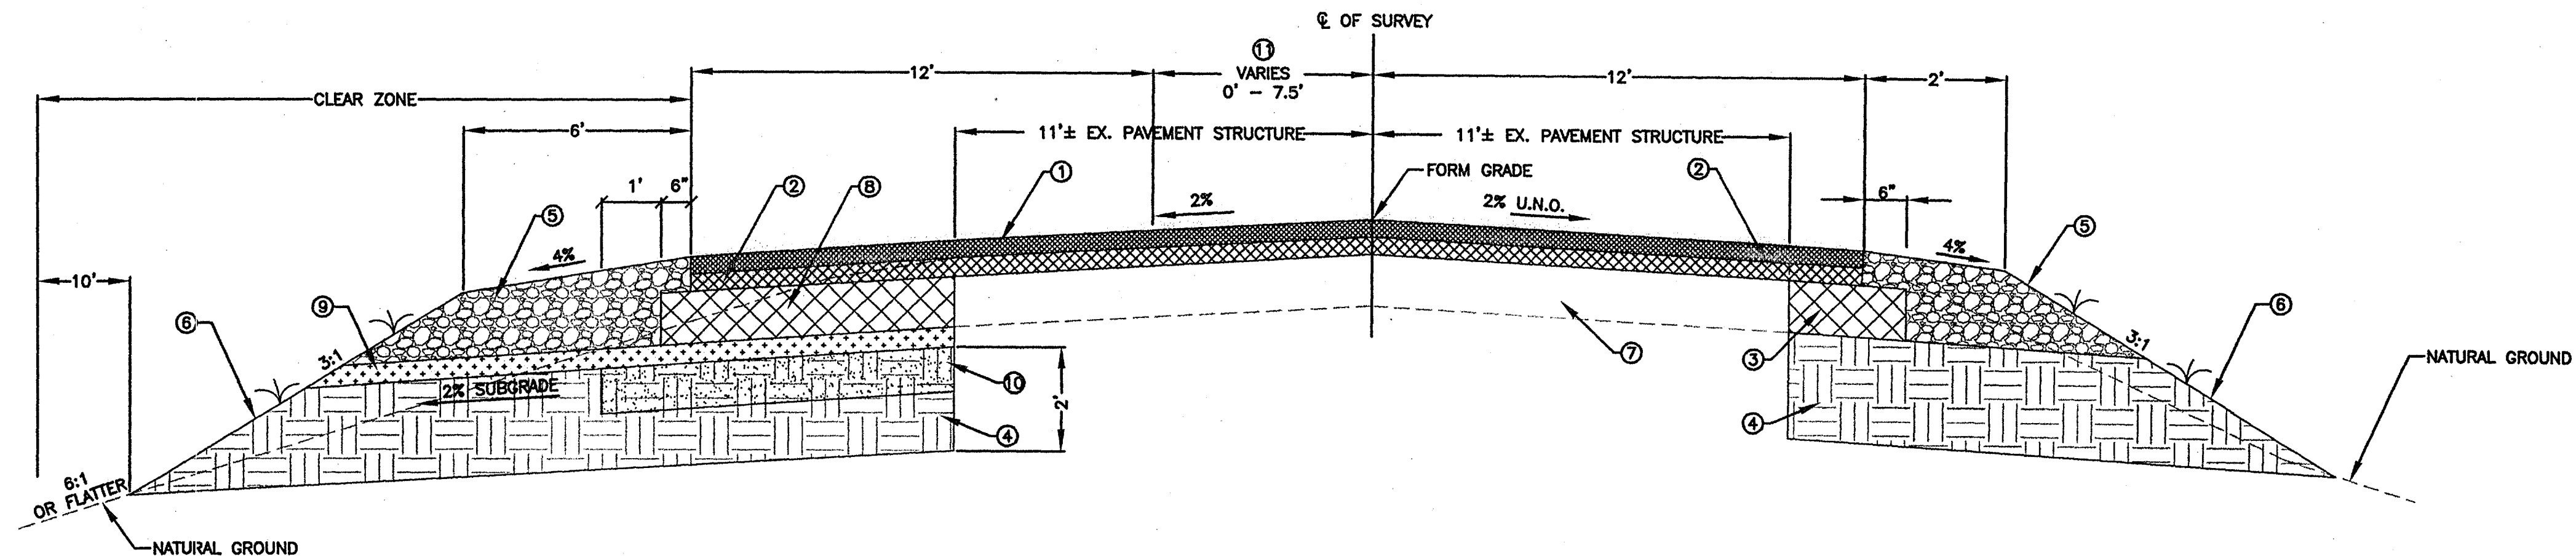

TYPICAL TWO-LANE WIDENING AND OVERLAY SECTION
STA 25+55 TO STA 26+44

- ① 1 1/2" HMA, ST, 9.5mm
- ② VARIABLE THICKNESS HMA, ST, 12.5mm, BINDER (3" TO 4" @ CL OF SURVEY)
- ③ 6" DEEP X 1.5' WIDE HMA ST, 19mm, TRENCH WIDENING
- ④ UNDERCUT AND BORROW EXCAVATION. UNDERCUT MAY BE ELIMINATED UPON VERIFICATION OF EX. SUBGRADE MATERIAL. (STA 25+50 - STA 27+70)
- ⑤ 10" GRANULAR MATERIAL CLASS 5, GROUP C
- ⑥ ESTABLISH VEGETATIVE COVER ON ALL PROPOSED SLOPES. EROSION CONTROL BLANKET (S-715.09.3) REQ'D ON ALL SLOPES OF 3:1 OR GREATER.
- ⑦ EXISTING PAVEMENT STRUCTURE (6" GRANULAR SUBBASE, 2" BIT. BASE, 3" BIT. SURFACE)
- ⑧ 6" HMA, ST, 19mm
- ⑨ 4" GRANULAR SUBBASE (CLASS 5, GROUP C)
- ⑩ 6" LIME TREATED SUBGRADE
- ⑪ WIDENING FOR LANE TAPER LT

FLEXIBLE PAVEMENT DESIGN

DATA FOR PAVEMENT DETERMINATION
(2005) ADT = 8845 Current (2015) ADT = 11726 n Year (2025) ADT = 15546 Design DHV = 1555 D = 50 % of DHV T = 3 % of DHV T (Total) = 10% of ADT 18k (Flex) = 675/1000 18k (Rigid) = 1000

DATA FOR OVERLAY DETERMINATION	
2025	2015
ADL 412	ADL 347
CBR 15	CBR 15
SSV 5.29	SSV 5.29
PT 2.5	PT 2.5
SN 3.84	SN 3.34

DATA FOR NEW PAVEMENT DETERMINATION	
2025	2015
ADL 412	ADL 347
CBR 5	CBR 5
SSV 3.72	SSV 3.72
PT 2.5	PT 2.5
SN 4.72	SN 4.15

SCHEDULE OF STRUCTURE THICKNESS																
STATION TO STATION	ESTIMATED SUBGRADE CBR	SOIL SUPPORT VALUE	AVERAGE DAILY LANE LOADING	STRUCTURE NUMBER REQUIRED	LIME TREATED SUBGRADE		SUBBASE THICKNESS		BASE COURSE THICKNESS		BINDER COURSE THICKNESS		SURFACE COURSE THICKNESS		TOTAL PROVIDED	
					in	SN	in	SN	in	SN	in	SN	in	SN	in	SN
OVERLAY																
STA 25+55 - 26+44	15	5.29	347	3.34			6	0.6	2	.68	3	1.32	4.5	1.98	15.5	4.58
NEW STRUCTURE																
STA 25+55 - 26+44	5	3.72	347	4.15	6	.36	4	0.4	6	2.04	3	1.32	1.5	.66	20.5	4.78

* INCLUDES 1.5" OF REQ'D OVERLAY

NOTE: SUBGRADE CBR FOR NEW PAVEMENT STRUCTURE IS ESTIMATED ONLY. A SUBGRADE SOIL PROFILE WILL BE PREPARED AND THE CBR AND THE REQUIRED BASE STRUCTURE THICKNESS ARE TO BE DETERMINED AFTER GRADING BEFORE PLACING BASE MATERIAL. SUBGRADE CBR FOR THE EXISTING PAVEMENT STRUCTURE WAS VERIFIED BY FIELD INVESTIGATION.


GENERAL CONSTRUCTION NOTES

- The existing utility locations shown on the Drawings are approximate only. The Contractor shall coordinate the location (horizontal and vertical) of existing utilities (power, telephone, gas, water, sewer, etc.) with the appropriate utility company before construction begins.
- All utility main lines or service lines encountered during construction, whether shown on the Drawings or not, shall be protected by the Contractor and repairs necessary due to damage to same by the Contractor shall be at no additional cost to the Owner.
- The Contractor shall establish a vegetative cover on all areas where the existing vegetation was removed or disturbed during construction, unless solid sod is required.
- Unsuitable bedding, backfill or site subgrade material which may be encountered shall be excavated to the limits required and backfilled with acceptable material to the lines and grades shown on the Drawings.
- Contractor shall install all required signal and advance loops prior to placement of final bituminous surface course.
- Contractor is responsible to perform all reasonable means necessary for maintaining proper operation of traffic signals throughout construction.
- Existing sanitary sewer manhole tops, water valves, valve boxes, meters, storm sewer or other related appurtenances shall, when required, be adjusted to finished grade by Contractor and paid for under S-613-A. Castings required to be removed shall be salvaged to the Owner by the Contractor.
- All salvageable material including traffic signs, water valves, fire hydrants, and drainage pipes that are removed during construction, shall be stored on site and recovered by the City, unless otherwise refused by the City.
- Clearing and grubbing of construction easements shall be considered as normal right-of-way and paid for by lump sum.

Record Drawings
1-8-08

RATES OF APPLICATION USED FOR ESTIMATING QUANTITIES

ITEM	RATE
HOT MIX ASPHALT	112 LB / SY-IN
HYDRATED LIME (6%)	.016 TN / SY
AGRICULTURAL LIMESTONE	600 LB / AC
VEGETATIVE MATERIALS FOR MULCH	3 TN / AC
COMMERCIAL FERTILIZER	600 LB / AC
SEEDING	15 LB / AC

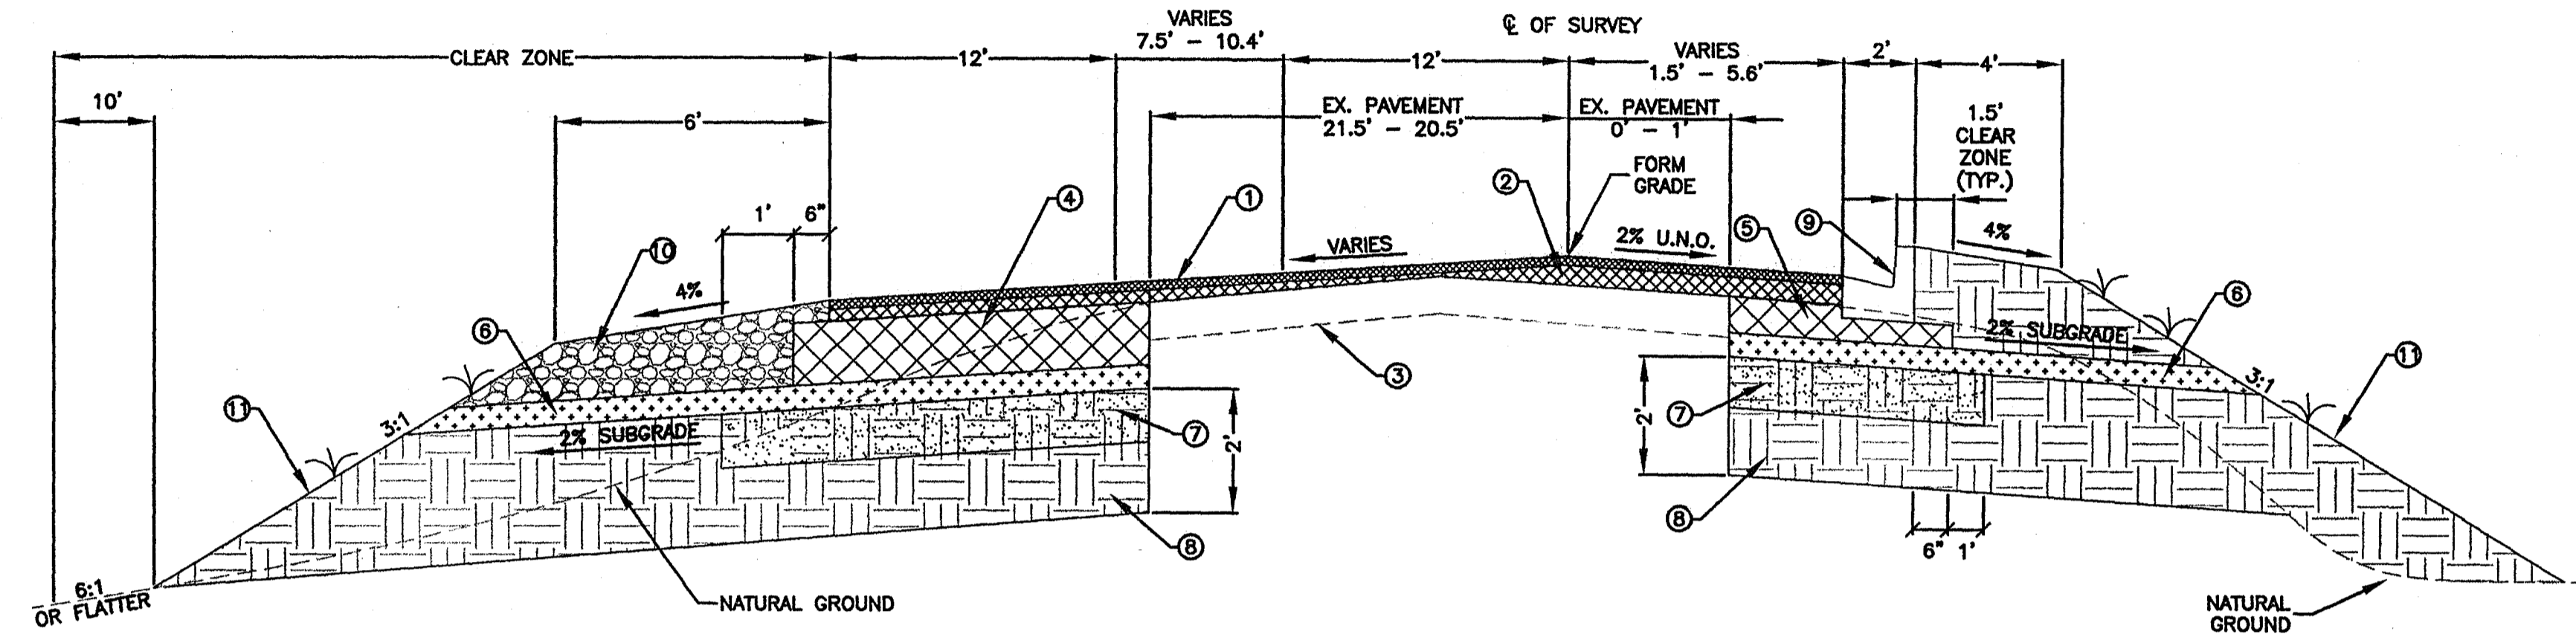

**TYPICAL VARIABLE WIDTH WIDENING GRADE, DRAIN, BASE & SURFACING SECTION
STA 26+44 TO STA 26+72**

- ① 1 1/2" HMA, ST, 9.5mm
- ② VAR. THICKNESS HMA, ST, 12.5mm (7" TO 5" @ CL OF SURVEY)
- ③ EXISTING PAVEMENT STRUCTURE (6" GRANULAR SUBBASE, 2" BIT. BASE, 3" BIT. SURFACE)
- ④ 6" HMA, ST, 19mm
- ⑤ VAR. THICKNESS HMA, ST, 19mm (3" MIN. BELOW CURB)
- ⑥ 4" GRANULAR SUBBASE (CLASS 5, GROUP C)
- ⑦ 6" LIME TREATED SUBGRADE
- ⑧ UNDERCUT AND BORROW EXCAVATION. UNDERCUT MAY BE ELIMINATED UPON VERIFICATION OF EX. SUBGRADE MATERIAL.
- ⑨ TYPE 1 CURB AND GUTTER
- ⑩ 10" GRANULAR MATERIAL CLASS 5, GROUP C
- ⑪ ESTABLISH VEGETATIVE COVER ON ALL PROPOSED SLOPES. EROSION CONTROL BLANKET (S-715.09.3) REQ'D ON ALL SLOPES OF 3:1 OR GREATER.

GENERAL CONSTRUCTION NOTES

1. The existing utility locations shown on the Drawings are approximate only. The Contractor shall coordinate the location (horizontal and vertical) of existing utilities (power, telephone, gas, water, sewer, etc.) with the appropriate utility company before construction begins.
2. All utility main lines or service lines encountered during construction, whether shown on the Drawings or not, shall be protected by the Contractor and repairs necessary due to damage to same by the Contractor shall be at no additional cost to the Owner.
3. The Contractor shall establish a vegetative cover on all areas where the existing vegetation was removed or disturbed during construction, unless solid sod is required.
4. Unsuitable bedding, backfill or site subgrade material which may be encountered shall be excavated to the limits required and backfilled with acceptable material to the lines and grades shown on the Drawings.
5. Contractor shall install all required signal and advance loops prior to placement of final bituminous surface course.
6. Contractor is responsible to perform all reasonable means necessary for maintaining proper operation of traffic signals throughout construction.
7. Existing sanitary sewer manhole tops, water valves, valve boxes, meters, storm sewer or other related appurtenances shall, when required, be adjusted to finished grade by Contractor and paid for under S-613-A. Castings required to be removed shall be salvaged to the Owner by the Contractor.
8. All salvageable material including traffic signs, water valves, fire hydrants, and drainage pipes that are removed during construction, shall be stored on site and recovered by the City, unless otherwise refused by the City.
9. Clearing and grubbing of construction easements shall be considered as normal right-of-way and paid for by lump sum.

FLEXIBLE PAVEMENT DESIGN

DATA FOR PAVEMENT DETERMINATION	
(2005) ADT = 8845 Current	
(2015) ADT = 11726 n Year	
(2025) ADT = 15546 Design	
DHV = 1555	
D = 50 % of DHV	
T = 3 % of DHV	
T (Total) = 10% of ADT	
18k (Flex) = 675/1000	
18k (Rigid) = 1800	

DATA FOR OVERLAY DETERMINATION	
2025	2015
ADL 412	ADL 347
CBR 15	CBR 15
SSV 5.29	SSV 5.29
PT 2.5	PT 2.5
SN 3.84	SN 3.34

DATA FOR NEW PAVEMENT DETERMINATION	
2025	2015
ADL 412	ADL 347
CBR 5	CBR 5
SSV 3.72	SSV 3.72
PT 2.5	PT 2.5
SN 4.72	SN 4.15

SCHEDULE OF STRUCTURE THICKNESS

STATION TO STATION	ESTIMATED SUBGRADE CBR	SOIL SUPPORT VALUE	AVERAGE DAILY LANE LOADING	STRUCTURE NUMBER REQUIRED	LIME TREATED SUBGRADE		SUBBASE THICKNESS		BASE COURSE THICKNESS		BINDER COURSE THICKNESS		SURFACE COURSE THICKNESS		TOTAL PROVIDED	
					In	SN	In	SN	In	SN	In	SN	In	SN	In	SN
OVERLAY																
STA 26+44 - 26+72	15	5.29	347	3.34			6	0.8	2	.68	3	1.32	*4.5	1.98	15.5	4.58
NEW STRUCTURE																
STA 26+44 - 26+72	5	3.72	347	4.15	6	.36	4	0.4	6	2.04	3	1.32	1.5	.66	20.5	4.78


* INCLUDES 1.5" OF REQ'D OVERLAY

NOTE: SUBGRADE CBR FOR NEW PAVEMENT STRUCTURE IS ESTIMATED ONLY. A SUBGRADE SOIL PROFILE WILL BE PREPARED AND THE CBR AND THE REQUIRED BASE STRUCTURE THICKNESS ARE TO BE DETERMINED AFTER GRADING BEFORE PLACING BASE MATERIAL. SUBGRADE CBR FOR THE EXISTING PAVEMENT STRUCTURE WAS VERIFIED BY FIELD INVESTIGATION.

Record Drawings
1-8-08

RATES OF APPLICATION USED FOR ESTIMATING QUANTITIES

ITEM	RATE
HOT MIX ASPHALT	112 LB / SY-IN
HYDRATED LIME (8%)	.016 TN / SY
AGRICULTURAL LIMESTONE	600 LB / AC
VEGETATIVE MATERIALS FOR MULCH	3 TN / AC
COMMERCIAL FERTILIZER	600 LB / AC
SEEDING	15 LB / AC

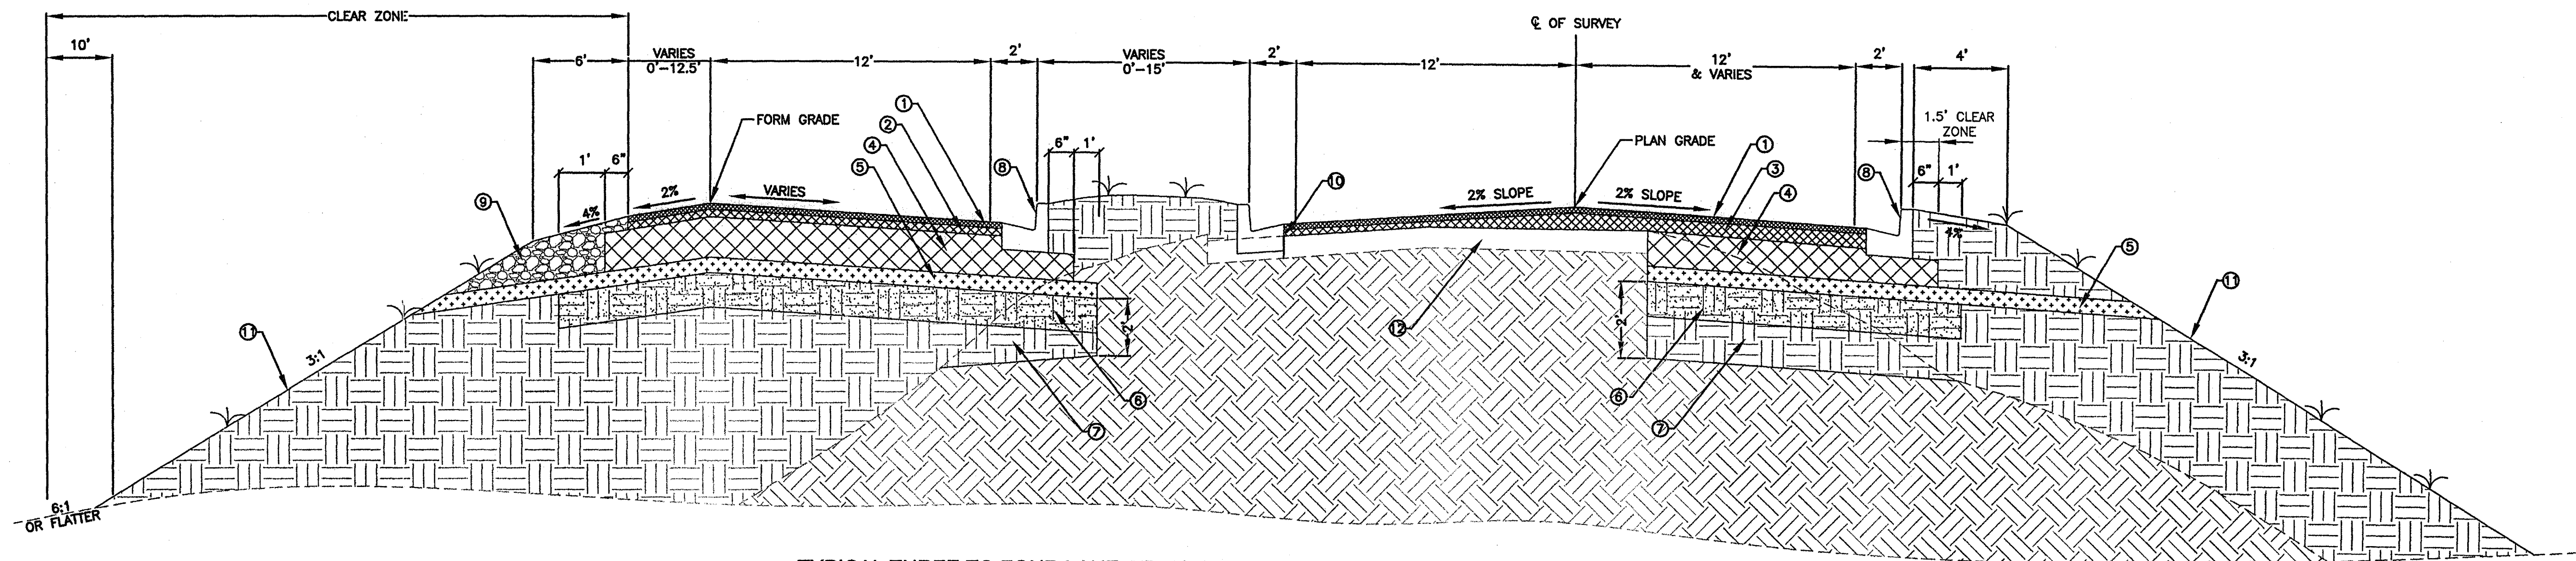

TYPICAL THREE TO FOUR LANE TRANSITION, OVERLAY, GRADE, DRAIN, BASE & SURFACING SECTION
STA 26+72 TO STA 27+69.5

- ① 1 1/2" HMA, ST, 9.5MM
- ② 1 1/2" HMA, ST, 12.5MM
- ③ VARIABLE THICKNESS HMA, ST, 12.5MM (5" TO 3.5" @ CL OF SURVEY)
- ④ 6" & VARIABLE HMA, ST, 19MM (3" MIN. BELOW CURB)
- ⑤ 4" GRANULAR SUBBASE (CLASS 5, GROUP C)
- ⑥ 6" LIME TREATED SUBGRADE
- ⑦ UNDERCUT AND BORROW EXCAVATION. UNDERCUT MAY BE ELIMINATED UPON VERIFICATION OF EX. SUBGRADE MATERIAL.
- ⑧ TYPE 1 CURB AND GUTTER
- ⑨ 10" GRANULAR MATERIAL CLASS 5, GROUP C
- ⑩ SAW CUT EXISTING PAVEMENT AT LIMITS OF PROPOSED PAVEMENT AND REMOVE EXISTING PAVEMENT WITHIN LIMITS OF MEDIAN
- ⑪ ESTABLISH VEGETATIVE COVER ON ALL PROPOSED SLOPES. EROSION CONTROL BLANKET (S-715.09.3) REQ'D ON ALL SLOPES OF 3:1 OR GREATER.
- ⑫ EXISTING PAVEMENT STRUCTURE (6" GRANULAR SUBBASE, 2" BIT. BASE, 3" BIT. SURFACE)

GENERAL CONSTRUCTION NOTES

1. The existing utility locations shown on the Drawings are approximate only. The Contractor shall coordinate the location (horizontal and vertical) of existing utilities (power, telephone, gas, water, sewer, etc.) with the appropriate utility company before construction begins.
2. All utility main lines or service lines encountered during construction, whether shown on the Drawings or not, shall be protected by the Contractor and repairs necessary due to damage to same by the Contractor shall be at no additional cost to the Owner.
3. The Contractor shall establish a vegetative cover on all areas where the existing vegetation was removed or disturbed during construction, unless solid sod is required.
4. Unsuitable bedding, backfill or site subgrade material which may be encountered shall be excavated to the limits required and backfilled with acceptable material to the lines and grades shown on the Drawings.
5. Contractor shall install all required signal and advance loops prior to placement of final bituminous surface course.
6. Contractor is responsible to perform all reasonable means necessary for maintaining proper operation of traffic signals throughout construction.
7. Existing sanitary sewer manhole tops, water valves, valve boxes, meters, storm sewer or other related appurtenances shall, when required, be adjusted to finished grade by Contractor and paid for under S-813-A. Castings required to be removed shall be salvaged to the Owner by the Contractor.
8. All salvageable material including traffic signs, water valves, fire hydrants, and drainage pipes that are removed during construction, shall be stored on site and recovered by the City, unless otherwise refused by the City.
9. Clearing and grubbing of construction easements shall be considered as normal right-of-way and paid for by lump sum.

FLEXIBLE PAVEMENT DESIGN

DATA FOR PAVEMENT DETERMINATION
(2005) ADT = 8845 Current
(2015) ADT = 11728 n Year
(2025) ADT = 15548 Design
DHV = 1555
D = 50 % of DHV
T = 3 % of DHV
T (Total) = 10% of ADT
18k (Flex) = 675/1000
18k (Rigid) = 1000

DATA FOR OVERLAY DETERMINATION	
2025	2015
ADL 412	ADL 347
CBR 15	CBR 15
SSV 5.29	SSV 5.29
PT 2.5	PT 2.5
SN 3.84	SN 3.34

DATA FOR NEW PAVEMENT DETERMINATION	
2025	2015
ADL 412	ADL 347
CBR 5	CBR 5
SSV 3.72	SSV 3.72
PT 2.5	PT 2.5
SN 4.72	SN 4.15

SCHEDULE OF STRUCTURE THICKNESS

STATION TO STATION	ESTIMATED SUBGRADE CBR	SOIL SUPPORT VALUE	AVERAGE DAILY LANE LOADING	STRUCTURE NUMBER REQUIRED	LIME TREATED SUBGRADE		SUBBASE THICKNESS		BASE COURSE THICKNESS		BINDER COURSE THICKNESS		SURFACE COURSE THICKNESS		TOTAL PROVIDED	
					In	SN	In	SN	In	SN	In	SN	In	SN	In	SN
OVERLAY																
STA 26+72 - 27+69.5	15	5.29	347	3.34			6	0.6	2	.68	3	1.32	*4.5	1.98	15.5	4.58
NEW STRUCTURE																
STA 26+72 - 27+69.5	5	3.72	347	4.15	6	.36	4	0.4	6	2.04	1.5	.66	1.5	.66	19	4.12


* INCLUDES 1.5" OF REQ'D OVERLAY

NOTE: SUBGRADE CBR FOR NEW PAVEMENT STRUCTURE IS ESTIMATED ONLY. A SUBGRADE SOIL PROFILE WILL BE PREPARED AND THE CBR AND THE REQUIRED BASE STRUCTURE THICKNESS ARE TO BE DETERMINED AFTER GRADING BEFORE PLACING BASE MATERIAL. SUBGRADE CBR FOR THE EXISTING PAVEMENT STRUCTURE WAS VERIFIED BY FIELD INVESTIGATION.

Record Drawings
1-8-08

RATES OF APPLICATION USED FOR ESTIMATING QUANTITIES

ITEM	RATE
HOT MIX ASPHALT	112 LB / SY-IN
HYDRATED LIME (6%)	.016 TN / SY
AGRICULTURAL LIMESTONE	600 LB / AC
VEGETATIVE MATERIALS FOR MULCH	3 TN / AC
COMMERCIAL FERTILIZER	600 LB / AC
SEEDING	15 LB / AC

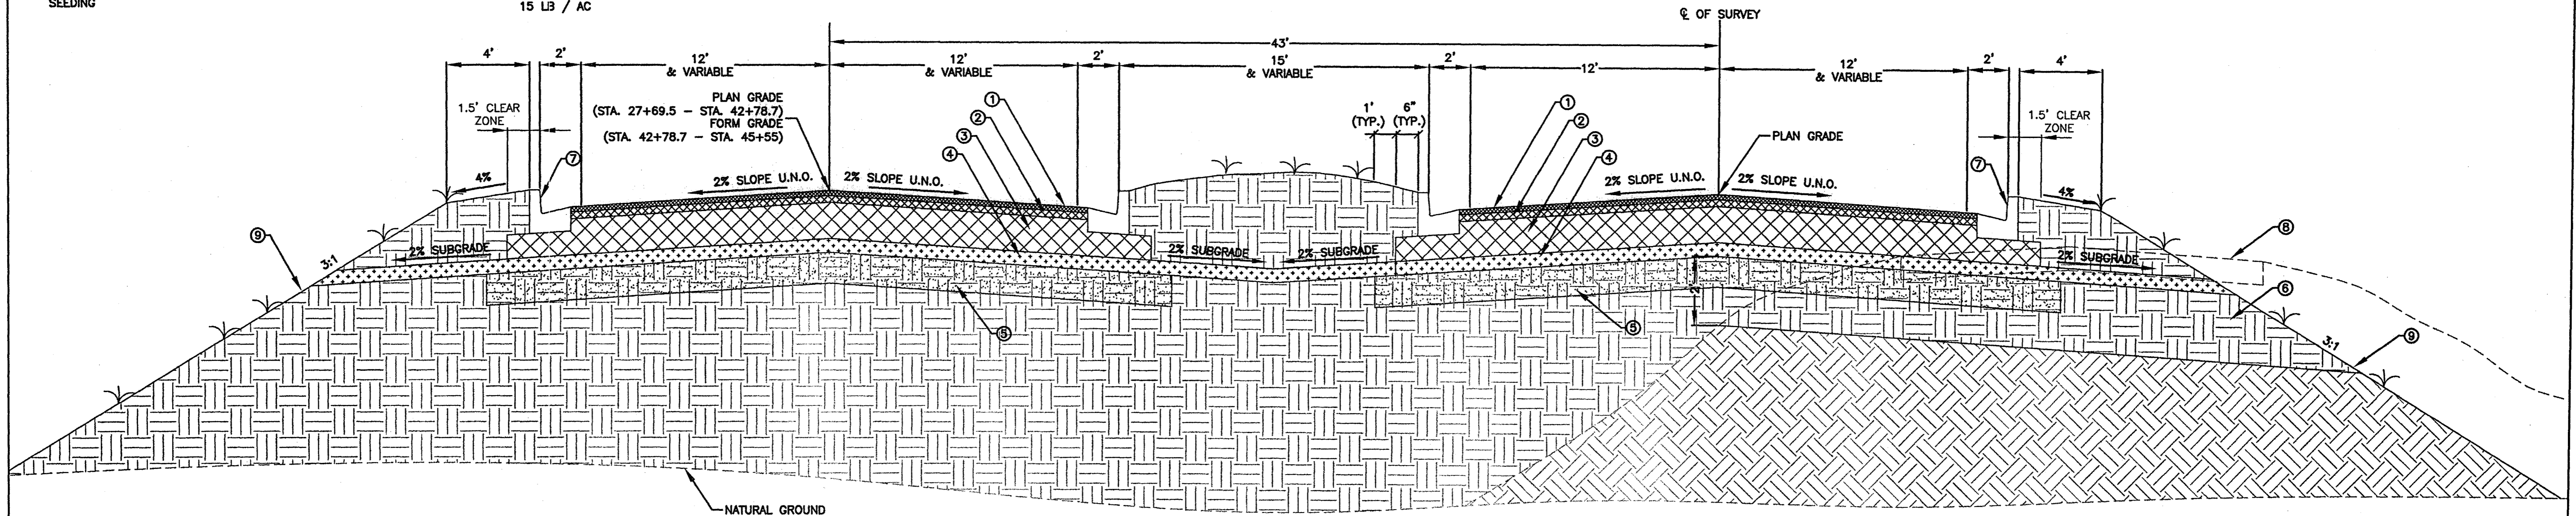

TYPICAL FOUR LANE GRADE, DRAIN, BASE & SURFACING SECTION
STA 27+69.5 TO STA 45+55

- ① 1 1/2" HMA, ST, 9.5MM
- ② 1 1/2" HMA, ST, 12.5MM
- ③ 6" & VARIABLE HMA, ST, 19MM (3" BELOW CURB)
- ④ 4" GRANULAR SUBBASE (CLASS 5, GROUP C)
- ⑤ 6" LIME TREATED SUBGRADE
- ⑥ UNDERCUT AND BORROW EXCAVATION. UNDERCUT MAY BE ELIMINATED UPON VERIFICATION OF EX. SUBGRADE MATERIAL.
- ⑦ TYPE 1 CURB AND GUTTER
- ⑧ REMOVE EX. PAVEMENT STRUCTURE WITHIN PROPOSED CONSTRUCTION LIMITS. EXISTING SUBGRADE MATERIAL SHALL BE FIELD VERIFIED FOR USE IN PROPOSED SUBGRADE / EMBANKMENT.
- ⑨ ESTABLISH VEGETATIVE COVER ON ALL PROPOSED SLOPES. EROSION CONTROL BLANKET (S-715.09.3) REQ'D ON ALL SLOPES OF 3:1 OR GREATER.

GENERAL CONSTRUCTION NOTES

1. The existing utility locations shown on the Drawings are approximate only. The Contractor shall coordinate the location (horizontal and vertical) of existing utilities (power, telephone, gas, water, sewer, etc.) with the appropriate utility company before construction begins.
2. All utility main lines or service lines encountered during construction, whether shown on the Drawings or not, shall be protected by the Contractor and repairs necessary due to damage to same by the Contractor shall be at no additional cost to the Owner.
3. The Contractor shall establish a vegetative cover on all areas where the existing vegetation was removed or disturbed during construction, unless solid sod is required.
4. Unsuitable bedding, backfill or site subgrade material which may be encountered shall be excavated to the limits required and backfilled with acceptable material to the lines and grades shown on the Drawings.
5. Contractor shall install all required signal and advance loops prior to placement of final bituminous surface course.
6. Contractor is responsible to perform all reasonable means necessary for maintaining proper operation of traffic signals throughout construction.
7. Existing sanitary sewer manhole tops, water valves, valve boxes, meters, storm sewer or other related appurtenances shall, when required, be adjusted to finished grade by Contractor and paid for under S-613-A. Castings required to be removed shall be salvaged to the Owner by the Contractor.
8. All salvageable material including traffic signs, water valves, fire hydrants, and drainage pipes that are removed during construction, shall be stored on site and recovered by the City, unless otherwise refused by the City.
9. Clearing and grubbing of construction easements shall be considered as normal right-of-way and paid for by lump sum.

FLEXIBLE PAVEMENT DESIGN

DATA FOR PAVEMENT DETERMINATION
(2005) ADT = 8845 Current
(2015) ADT = 11726 n Year
(2025) ADT = 15546 Design
DHV = 1555
D = 50 % of DHV
T = 3 % of DHV
T (Total) = 10% of ADT
18k (Flex) = 675/1000
18k (Rigid) = 1000

DATA FOR PAVEMENT DETERMINATION	
2025	2015
ADL 412	ADL 347
CBR 5	CBR 5
SSV 3.72	SSV 3.72
PT 2.5	PT 2.5
SN 4.72	SN 4.15


SCHEDULE OF STRUCTURE THICKNESS																
STATION TO STATION	ESTIMATED SUBGRADE CBR	SOIL SUPPORT VALUE	AVERAGE DAILY LANE LOADING	STRUCTURE NUMBER REQUIRED	LIME TREATED SUBGRADE		SUBBASE THICKNESS		BASE COURSE THICKNESS		BINDER COURSE THICKNESS		SURFACE COURSE THICKNESS		TOTAL PROVIDED	
					in	SN	in	SN	in	SN	in	SN	in	SN	in	SN
NEW STRUCTURE																
STA 27+69.5 - 45+55	5	3.72	347	4.15	6	.38	4	0.4	6	2.04	1.5	.66	1.5	.66	19	4.12

NOTE: SUBGRADE CBR FOR NEW PAVEMENT STRUCTURE IS ESTIMATED ONLY. A SUBGRADE SOIL PROFILE WILL BE PREPARED AND THE CBR AND THE REQUIRED BASE STRUCTURE THICKNESS ARE TO BE DETERMINED AFTER GRADING BEFORE PLACING BASE MATERIAL. SUBGRADE CBR FOR THE EXISTING PAVEMENT STRUCTURE WAS VERIFIED BY FIELD INVESTIGATION.

Record Drawings
1-8-08

RATES OF APPLICATION USED FOR ESTIMATING QUANTITIES

ITEM	RATE
HOT MIX ASPHALT	112 LB / SY-IN
HYDRATED LIME (6%)	.016 TN / SY
AGRICULTURAL LIMESTONE	600 LB / AC
VEGETATIVE MATERIALS FOR MULCH	3 TN / AC
COMMERCIAL FERTILIZER	600 LB / AC
SEEDING	15 LB / AC

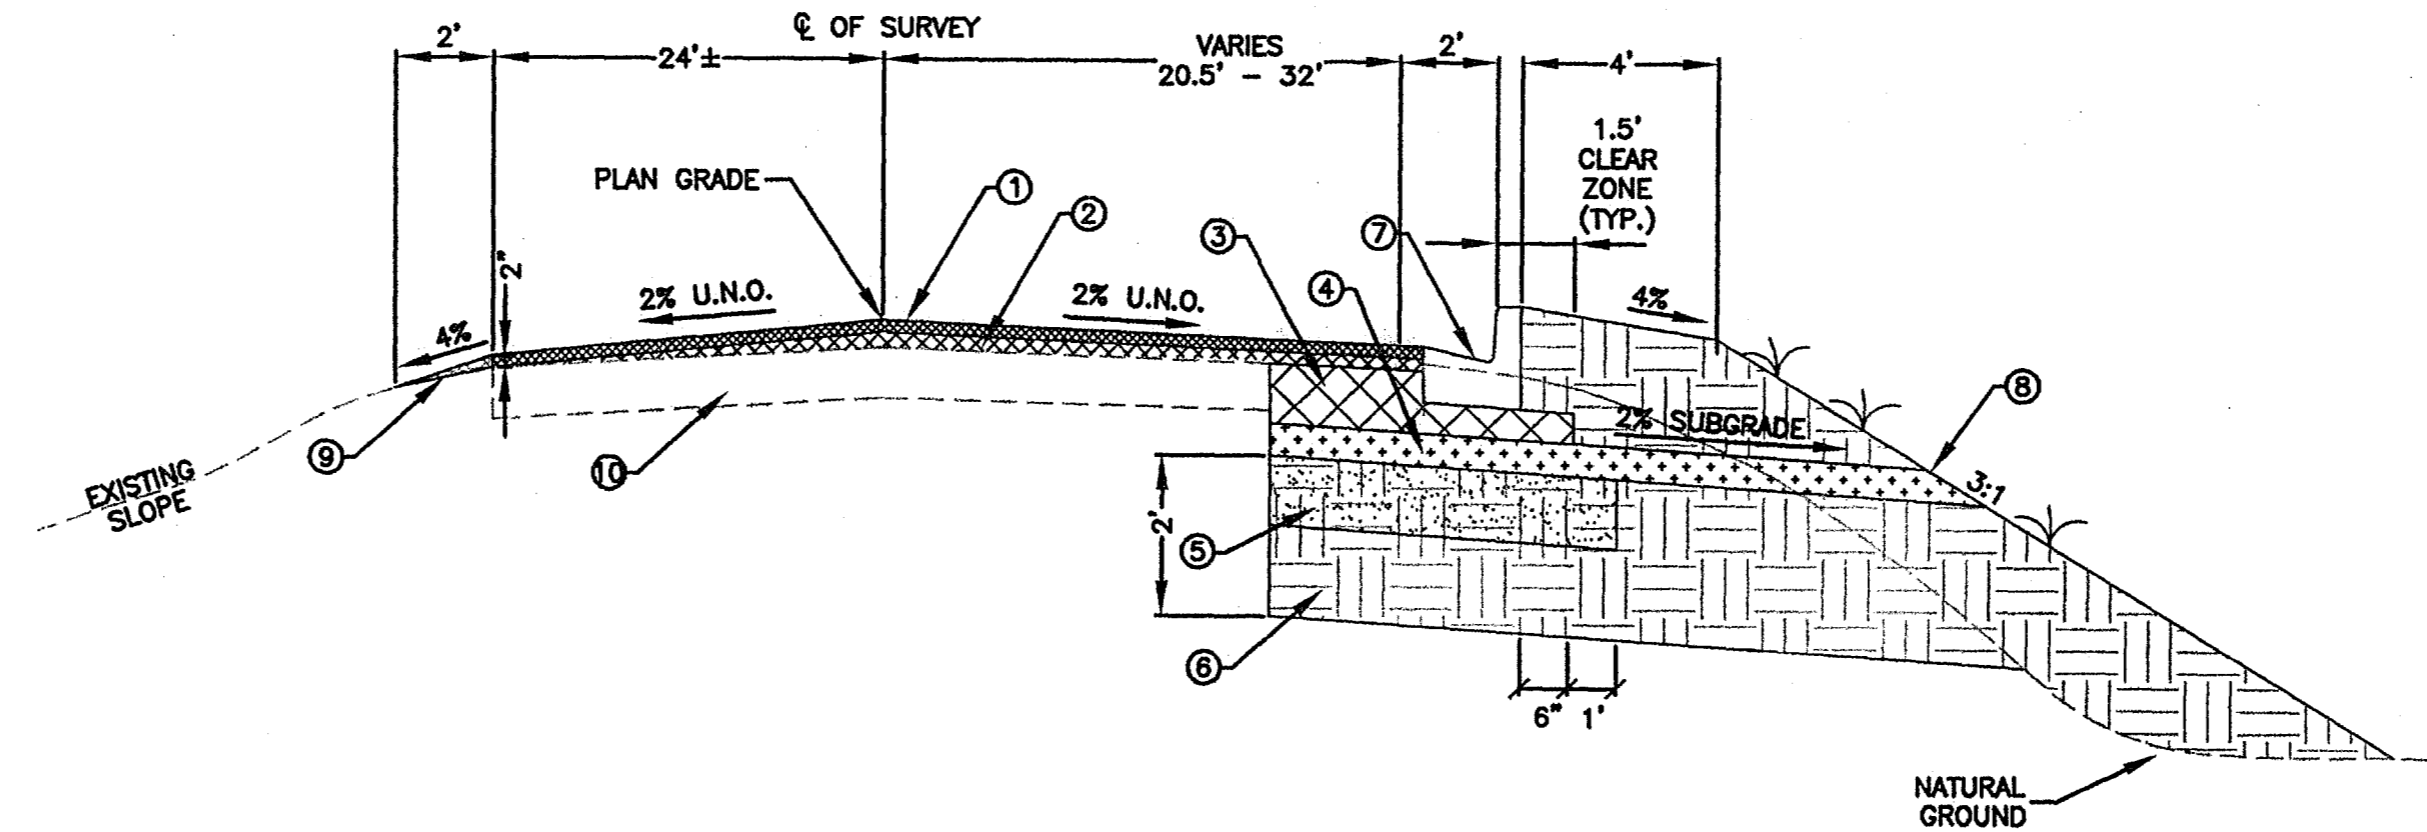

TYPICAL OVERLAY AND WIDENING SECTION @ RICE ROAD
STA 10+00 TO STA 15+40

- ① 2" HMA, ST, 9.5MM
- ② COLD MILLING AND HMA, ST, 12.5mm, BINDER REQ'D AS INDICATED OR DIRECTED BY ENGINEER
- ③ 7" & VARIABLE HMA, ST, 19MM (4" MIN. BELOW CURB)
- ④ 4" GRANULAR SUBBASE (CLASS 5, GROUP C)
- ⑤ 6" LIME TREATED SUBGRADE
- ⑥ UNDERCUT AND BORROW EXCAVATION. UNDERCUT MAY BE ELIMINATED UPON VERIFICATION OF EX. SUBGRADE MATERIAL.
- ⑦ TYPE 1 CURB AND GUTTER
- ⑧ ESTABLISH VEGETATIVE COVER ON ALL PROPOSED SLOPES. EROSION CONTROL BLANKET (S-715.09.3) REQ'D ON ALL SLOPES OF 3:1 OR GREATER.
- ⑨ 2.0" & VARIABLE GRANULAR MATERIAL CLASS 5, GROUP C
- ⑩ EXISTING PAVEMENT STRUCTURE (6" GRANULAR SUBBASE, 2" BIT. BASE, 3" BIT. SURFACE)

GENERAL CONSTRUCTION NOTES

1. The existing utility locations shown on the Drawings are approximate only. The Contractor shall coordinate the location (horizontal and vertical) of existing utilities (power, telephone, gas, water, sewer, etc.) with the appropriate utility company before construction begins.
2. All utility main lines or service lines encountered during construction, whether shown on the Drawings or not, shall be protected by the Contractor and repairs necessary due to damage to same by the Contractor shall be at no additional cost to the Owner.
3. The Contractor shall establish a vegetative cover on all areas where the existing vegetation was removed or disturbed during construction, unless solid sod is required.
4. Unsuitable bedding, backfill or site subgrade material which may be encountered shall be excavated to the limits required and backfilled with acceptable material to the lines and grades shown on the Drawings.
5. Contractor shall install all required signal and advance loops prior to placement of final bituminous surface course.
6. Contractor is responsible to perform all reasonable means necessary for maintaining proper operation of traffic signals throughout construction.
7. Existing sanitary sewer manhole tops, water valves, valve boxes, meters, storm sewer or other related appurtenances shall, when required, be adjusted to finished grade by Contractor and paid for under S-613-A. Castings required to be removed shall be salvaged to the Owner by the Contractor.
8. All salvageable material including traffic signs, water valves, fire hydrants, and drainage pipes that are removed during construction, shall be stored on site and recovered by the City, unless otherwise refused by the City.
9. Clearing and grubbing of construction easements shall be considered as normal right-of-way and paid for by lump sum.

FLEXIBLE PAVEMENT DESIGN

DATA FOR PAVEMENT DETERMINATION		DATA FOR OVERLAY DETERMINATION				DATA FOR NEW PAVEMENT DETERMINATION			
		2025		2015		2025		2015	
(2005) ADT = 12672 Current (2015) ADT = 15743 n Year (2025) ADT = 19558 Design DHV = 1958 D = 50 % of DHV T = 3 % of DHV T (Total) = 10% of ADT 18k (Flex) = 675/1000 18k (Rigid) = 1000		ADL	544	ADL	479	ADL	412	ADL	347
		CBR	15	CBR	15	CBR	5	CBR	5
		SSV	5.29	SSV	5.29	SSV	3.72	SSV	3.72
		PT	2.5	PT	2.5	PT	2.5	PT	2.5
		SN	4.02	SN	3.52	SN	4.72	SN	4.15

* BASED ON HARBOR DRIVE TRAFFIC DATA

SCHEDULE OF STRUCTURE THICKNESS																
STATION TO STATION	ESTIMATED SUBGRADE CBR	SOIL SUPPORT VALUE	AVERAGE DAILY LANE LOADING	STRUCTURE NUMBER REQUIRED	LIME TREATED SUBGRADE		SUBBASE THICKNESS		BASE COURSE THICKNESS		BINDER COURSE THICKNESS		SURFACE COURSE THICKNESS		TOTAL PROVIDED	
					in	SN	in	SN	in	SN	in	SN	in	SN	in	SN
OVERLAY																
STA 10+00 - 15+40	15	5.29	479	3.52			6	0.6	2	.68			5	2.2	13	3.48
NEW STRUCTURE																
HARBOR DRIVE																
STA 10+00 - 15+40	5	3.72	347	4.15	6	0.38	4	0.4	6	2.04	1.5	.66	1.5	.66	19	4.12

* INCLUDES 2" OF REQ'D OVERLAY

Record Drawings
1-8-08

NOTE: SUBGRADE CBR FOR NEW PAVEMENT STRUCTURE IS ESTIMATED ONLY. A SUBGRADE SOIL PROFILE WILL BE PREPARED AND THE CBR AND THE REQUIRED BASE STRUCTURE THICKNESS ARE TO BE DETERMINED AFTER GRADING BEFORE PLACING BASE MATERIAL. SUBGRADE CBR FOR THE EXISTING PAVEMENT STRUCTURE WAS VERIFIED BY FIELD INVESTIGATION.

CURB & GUTTER SCHEDULE							
AREA	SIDE	TYPE 1 STANDARD	TYPE 1 PITCH AWAY	TYPE 2 STANDARD	TYPE 2 PITCH AWAY	CONCRETE DRIVEWAY	REMARKS
STA 28+44 - STA 27+94	R	150					
STA 28+09 - STA 28+20	R	11					
STA 28+20 - STA 29+28	R					24.22	Omit Curb for Future Drive
STA 29+28 - STA 32+59	R	331					
STA 32+74 - STA 33+32	R	56					
STA 33+32 - STA 33+95	R					14.00	Omit Curb for Future Drive
STA 33+95 - STA 37+17	R	320					
STA 37+32 - STA 38+92	R	158					
STA 38+92 - STA 40+06	R					25.11	Omit Curb for Future Drive
STA 40+06 - STA 41+30	R	123					
STA 41+45 - STA 45+02	R	362					
MEDIAN							
STA 26+72 - STA 27+30	MEDIAN R	56					
STA 27+35 - STA 27+99	MEDIAN R	64					
STA 28+08 - STA 28+20	MEDIAN R	11					
STA 29+29 - STA 28+32	MEDIAN R		3				
STA 29+32 - STA 29+46	MEDIAN R	14					
STA 29+51 - STA 31+96	MEDIAN R	247					
STA 32+03 - STA 32+64	MEDIAN R	61					
STA 32+69 - STA 33+32	MEDIAN R	63					
STA 33+37 - STA 36+56	MEDIAN R	322					
STA 36+61 - STA 37+22	MEDIAN R	62					
STA 37+27 - STA 37+90	MEDIAN R	63					
STA 37+95 - STA 38+92	MEDIAN R	100					
STA 40+07 - STA 40+69	MEDIAN R	65					
STA 40+74 - STA 41+35	MEDIAN R	62					
STA 41+45 - STA 42+03	MEDIAN R	58					
STA 42+08 - STA 45+31	MEDIAN R	326					
MEDIAN L							
STA 26+72 - STA 27+99	MEDIAN L	122					
STA 28+08 - STA 28+20	MEDIAN L	11					
STA 29+29 - STA 28+32	MEDIAN L		3				
STA 29+32 - STA 29+46	MEDIAN L	14					
STA 29+51 - STA 31+96	MEDIAN L	248					
STA 32+03 - STA 32+64	MEDIAN L	61					
STA 32+69 - STA 33+32	MEDIAN L	63					
STA 33+37 - STA 36+56	MEDIAN L	324					
STA 36+61 - STA 37+22	MEDIAN L	63					
STA 37+27 - STA 37+90	MEDIAN L	64					
STA 37+95 - STA 38+92	MEDIAN L	99					
STA 40+07 - STA 40+69	MEDIAN L	64					
STA 40+74 - STA 41+35	MEDIAN L	63					
STA 41+45 - STA 42+03	MEDIAN L	58					
STA 42+08 - STA 45+02	MEDIAN L	295					
STA 45+07 - STA 45+31	MEDIAN L	26					
L							
STA 27+70 - STA 27+94	L	24					
STA 28+09 - STA 32+59	L	451					
STA 32+74 - STA 37+16	L	456					
STA 37+32 - STA 41+31	L	414					
STA 41+45 - STA 44+83	L	341					
RICE ROAD							
STA 10+00 - STA 10+70	R	71					
STA 10+75 - STA 11+70	R	116					
STA 13+05 - STA 13+93	R	99					
STA 13+98 - STA 15+33	R	135					
CHANNELIZATION ISLANDS							
STA 45+00	R			65	51		
STA 45+00	L			109	89		
PROJECT TOTAL							
UNITS		6771	8	174	120	83	
		LF	LF	LF	LF	SY	


REMOVAL OF ASPHALT PAVEMENT AND COLD MILLING SCHEDULE		
AREA	COLD MILLING	ASPHALT PAVEMENT REMOVAL
HARBOR DRIVE		
STA 10+41 - STA 10+56 (LT)	69.44	
STA 10+41 - STA 10+56 (ENTER)	75.00	
STA 10+41 - STA 10+56 (RT)	166.11	
STA 19+93 - STA 22+05	279.67	
STA 27+69 - STA 30+50		891.67
STA 32+26 - STA 35+94		2036.67
RICE RD		
STA 10+00 - STA 10+65	346.67	
STA 14+73 - STA 15+33	200.00	
PROJECT TOTAL		
UNITS	1136.89	2928.33
	SY	SY

CULVERT HYDRAULIC DESIGN SUMMARY															
SHEET NO.	STATION	D. A. (AC)	CULVERT SIZE	UPSTREAM FLOWLINE ELEVATION (FT)	DESIGN STORM (Q25) (25-YEAR STORM)				BASE STORM (Q100) (100-YEAR STORM)				STORM OF RECORD		REMARKS
					DISCHARGE (CFS)	HW/D	HW (DEPTH)	HW (ELEV)	DISCHARGE (CFS)	HW/D	HW (DEPTH)	HW (ELEV)	DATE OCCURRED	DISCHARGE (CFS)	
6	28+00	2.94	36	290.56	23.79	0.54	1.62	292.18	27.76	0.59	1.77	292	Not Available		C=0.9, I = 9.0 in/hr

PIPE SCHEDULE									
SHEET NO.	STATION	CONC. PIPE, CLASS III		CONC. F.E.S. REQ'D		CLASS "B" CONC. MINOR STRUCTURES	8" SANITARY SEWER	12" O.I. WATER MAIN	REMARKS
		18"	36"	18"	36"				
Harbor Drive									
6	27+50	64							A1 TO A4
6	28+01		8		1	0.123			FES TO A5
6	28+01		37						A5 TO A4
6	28+01		8						A4 TO A3
6	28+01		32						A3 TO A2
6	28+01		16		1	0.123			A2 TO FES
6	29+25	56						403	A6 TO EX. JB
6							191		
7	32+00	13							A8 TO A7
7	32+25	64							A7 TO B1
7	32+67	32							B3 TO B2
7	32+67	13							B2 TO B1
7	32+67	32							B1 TO A9
7	32+67	24		1		0.063			A9 TO FES
7	33+00	64							B4 TO B1
7	33+34	13							B5 TO B4
7							430	549	
8	36+58	13							B7 TO B6
8	37+00	64							B6 TO B9
8	37+25	32							C2 TO C1
8	37+25	13							C1 TO B9
8	37+25	32							B9 TO B8
8	37+25	16		1		0.063			B8 TO FES
8	37+50	64							C3 TO B9
8	37+92	13							C4 TO C3
8	41+00	64							C5 TO C7
8								541	
9	41+38	32							C8 TO C7
9	41+38	42							C7 TO C6
9	41+50	64							D1 TO C7
9	42+05	8							C9 TO D1
9	43+00	344							C6 TO D2
9	44+95	56							D3 TO D2
9	45+15	56							D5 TO D3
9	45+25	42							D4 TO D8
9	45+30	14							D6 TO D5
9								334	
Rice Rd									
10	10+50	136		1		0.063			E2 TO FES
10	11+00	56							D7 TO E2
10	11+50	56							D2 TO E2
10	12+80	24							D8 TO D6
10	14+25	136							D9 TO E1
10	15+50	144							E1 TO EX. INLET
10								159	
PROJECT TOTAL		1896	101	3	2	0.435	621	1986	
UNITS		LF	LF	EA	EA	CY	LF	LF	

NOTE: PIPE LENGTHS IN THIS SCHEDULE REFLECT ESTIMATED PIPE LENGTHS AND PIPE LENGTHS SHOWN ON PLAN SHEETS REPRESENT ACTUAL LENGTHS OF PIPE REQUIRED.

Record Drawings
1-8-08

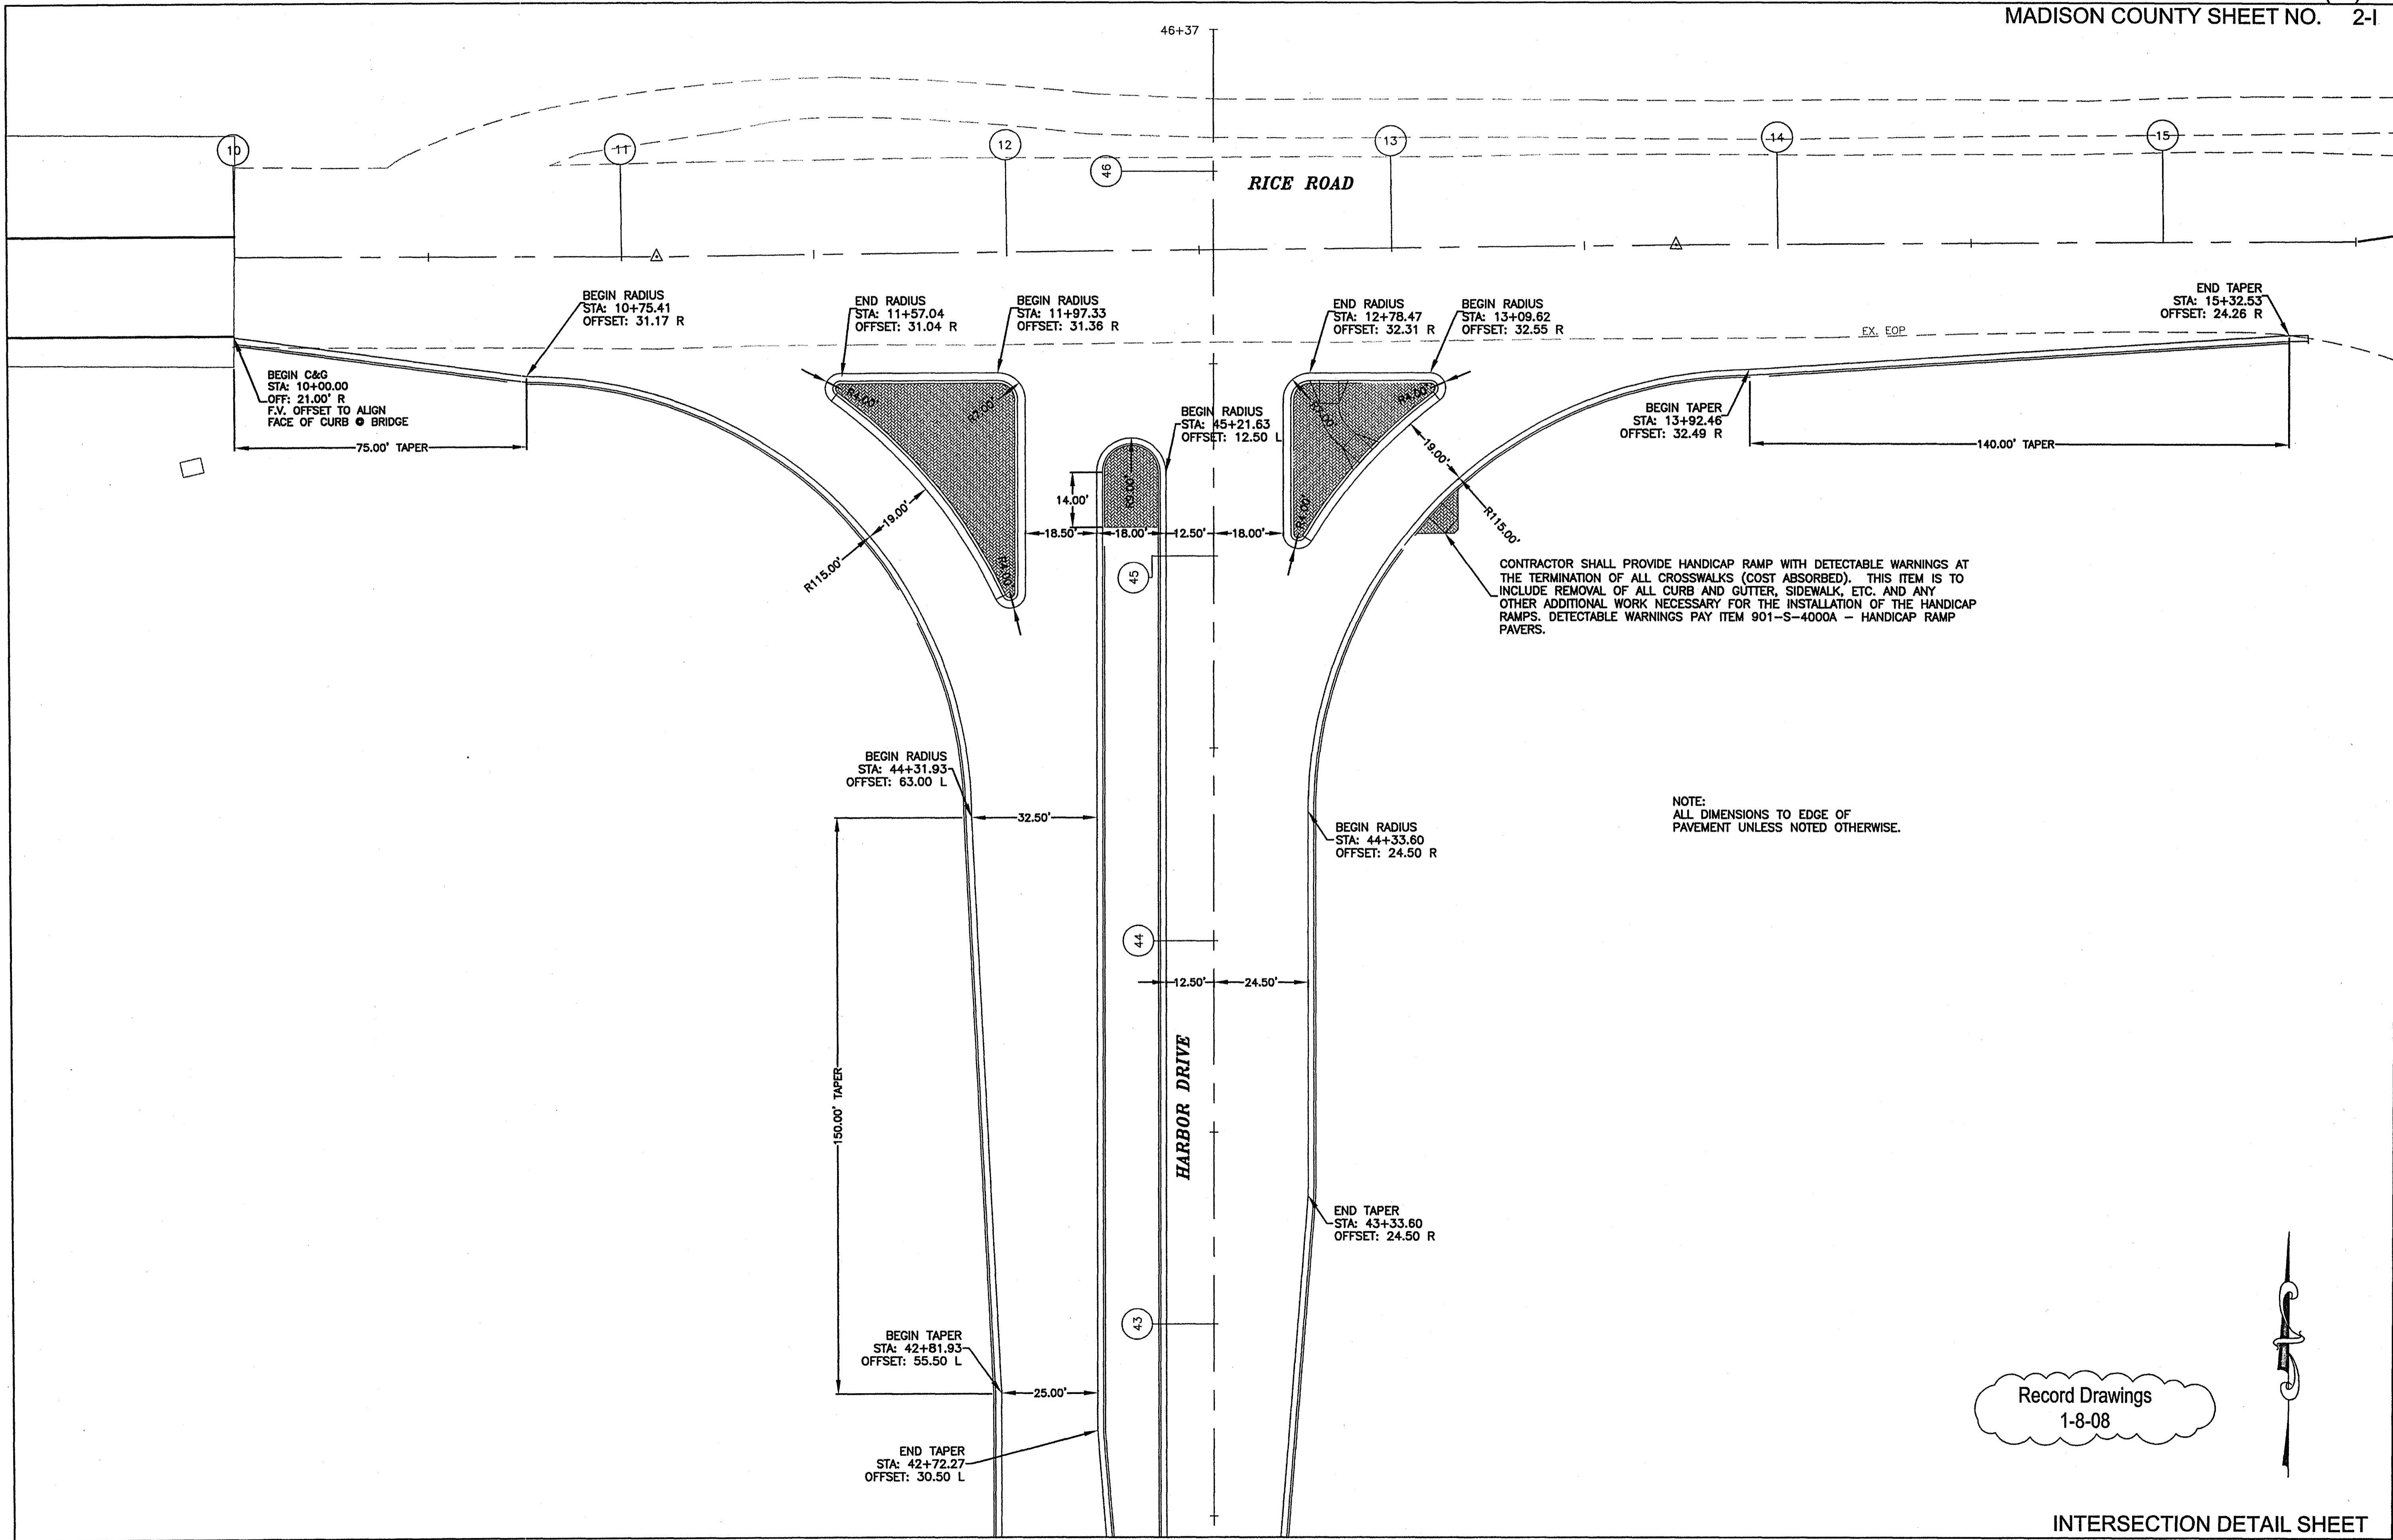

BEGIN C&G
STA: 10+00.00
OFF: 21.00' R
F.V. OFFSET TO ALIGN
FACE OF CURB @ BRIDGE

75.00' TAPER

BEGIN RADIUS
STA: 10+75.41
OFFSET: 31.17 R

END RADIUS
STA: 11+57.04
OFFSET: 31.04 R

BEGIN RADIUS
STA: 11+97.33
OFFSET: 31.36 R

END RADIUS
STA: 12+78.47
OFFSET: 32.31 R

BEGIN RADIUS
STA: 13+09.62
OFFSET: 32.55 R

END TAPER
STA: 15+32.53
OFFSET: 24.26 R

BEGIN TAPER
STA: 13+92.46
OFFSET: 32.49 R

140.00' TAPER

BEGIN RADIUS
STA: 44+31.93
OFFSET: 63.00 L

BEGIN RADIUS
STA: 45+21.63
OFFSET: 12.50 L

BEGIN RADIUS
STA: 44+33.60
OFFSET: 24.50 R

END TAPER
STA: 43+33.60
OFFSET: 24.50 R

BEGIN TAPER
STA: 42+81.93
OFFSET: 55.50 L



END TAPER
STA: 42+72.27
OFFSET: 30.50 L

CONTRACTOR SHALL PROVIDE HANDICAP RAMP WITH DETECTABLE WARNINGS AT THE TERMINATION OF ALL CROSSWALKS (COST ABSORBED). THIS ITEM IS TO INCLUDE REMOVAL OF ALL CURB AND GUTTER, SIDEWALK, ETC. AND ANY OTHER ADDITIONAL WORK NECESSARY FOR THE INSTALLATION OF THE HANDICAP RAMPS. DETECTABLE WARNINGS PAY ITEM 901-S-4000A - HANDICAP RAMP PAVERS.


NOTE:
ALL DIMENSIONS TO EDGE OF PAVEMENT UNLESS NOTED OTHERWISE.

Record Drawings
1-8-08



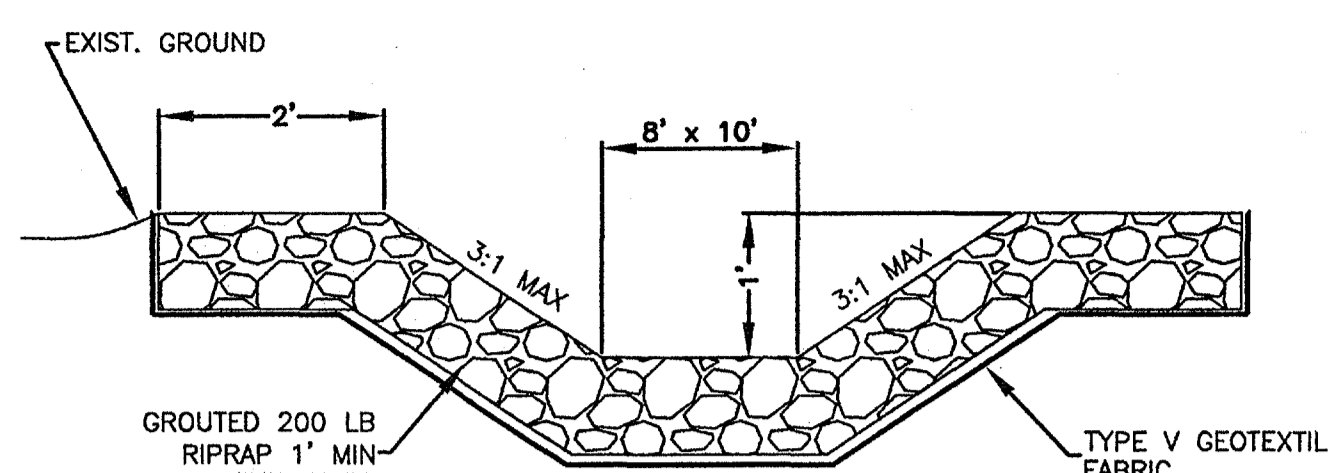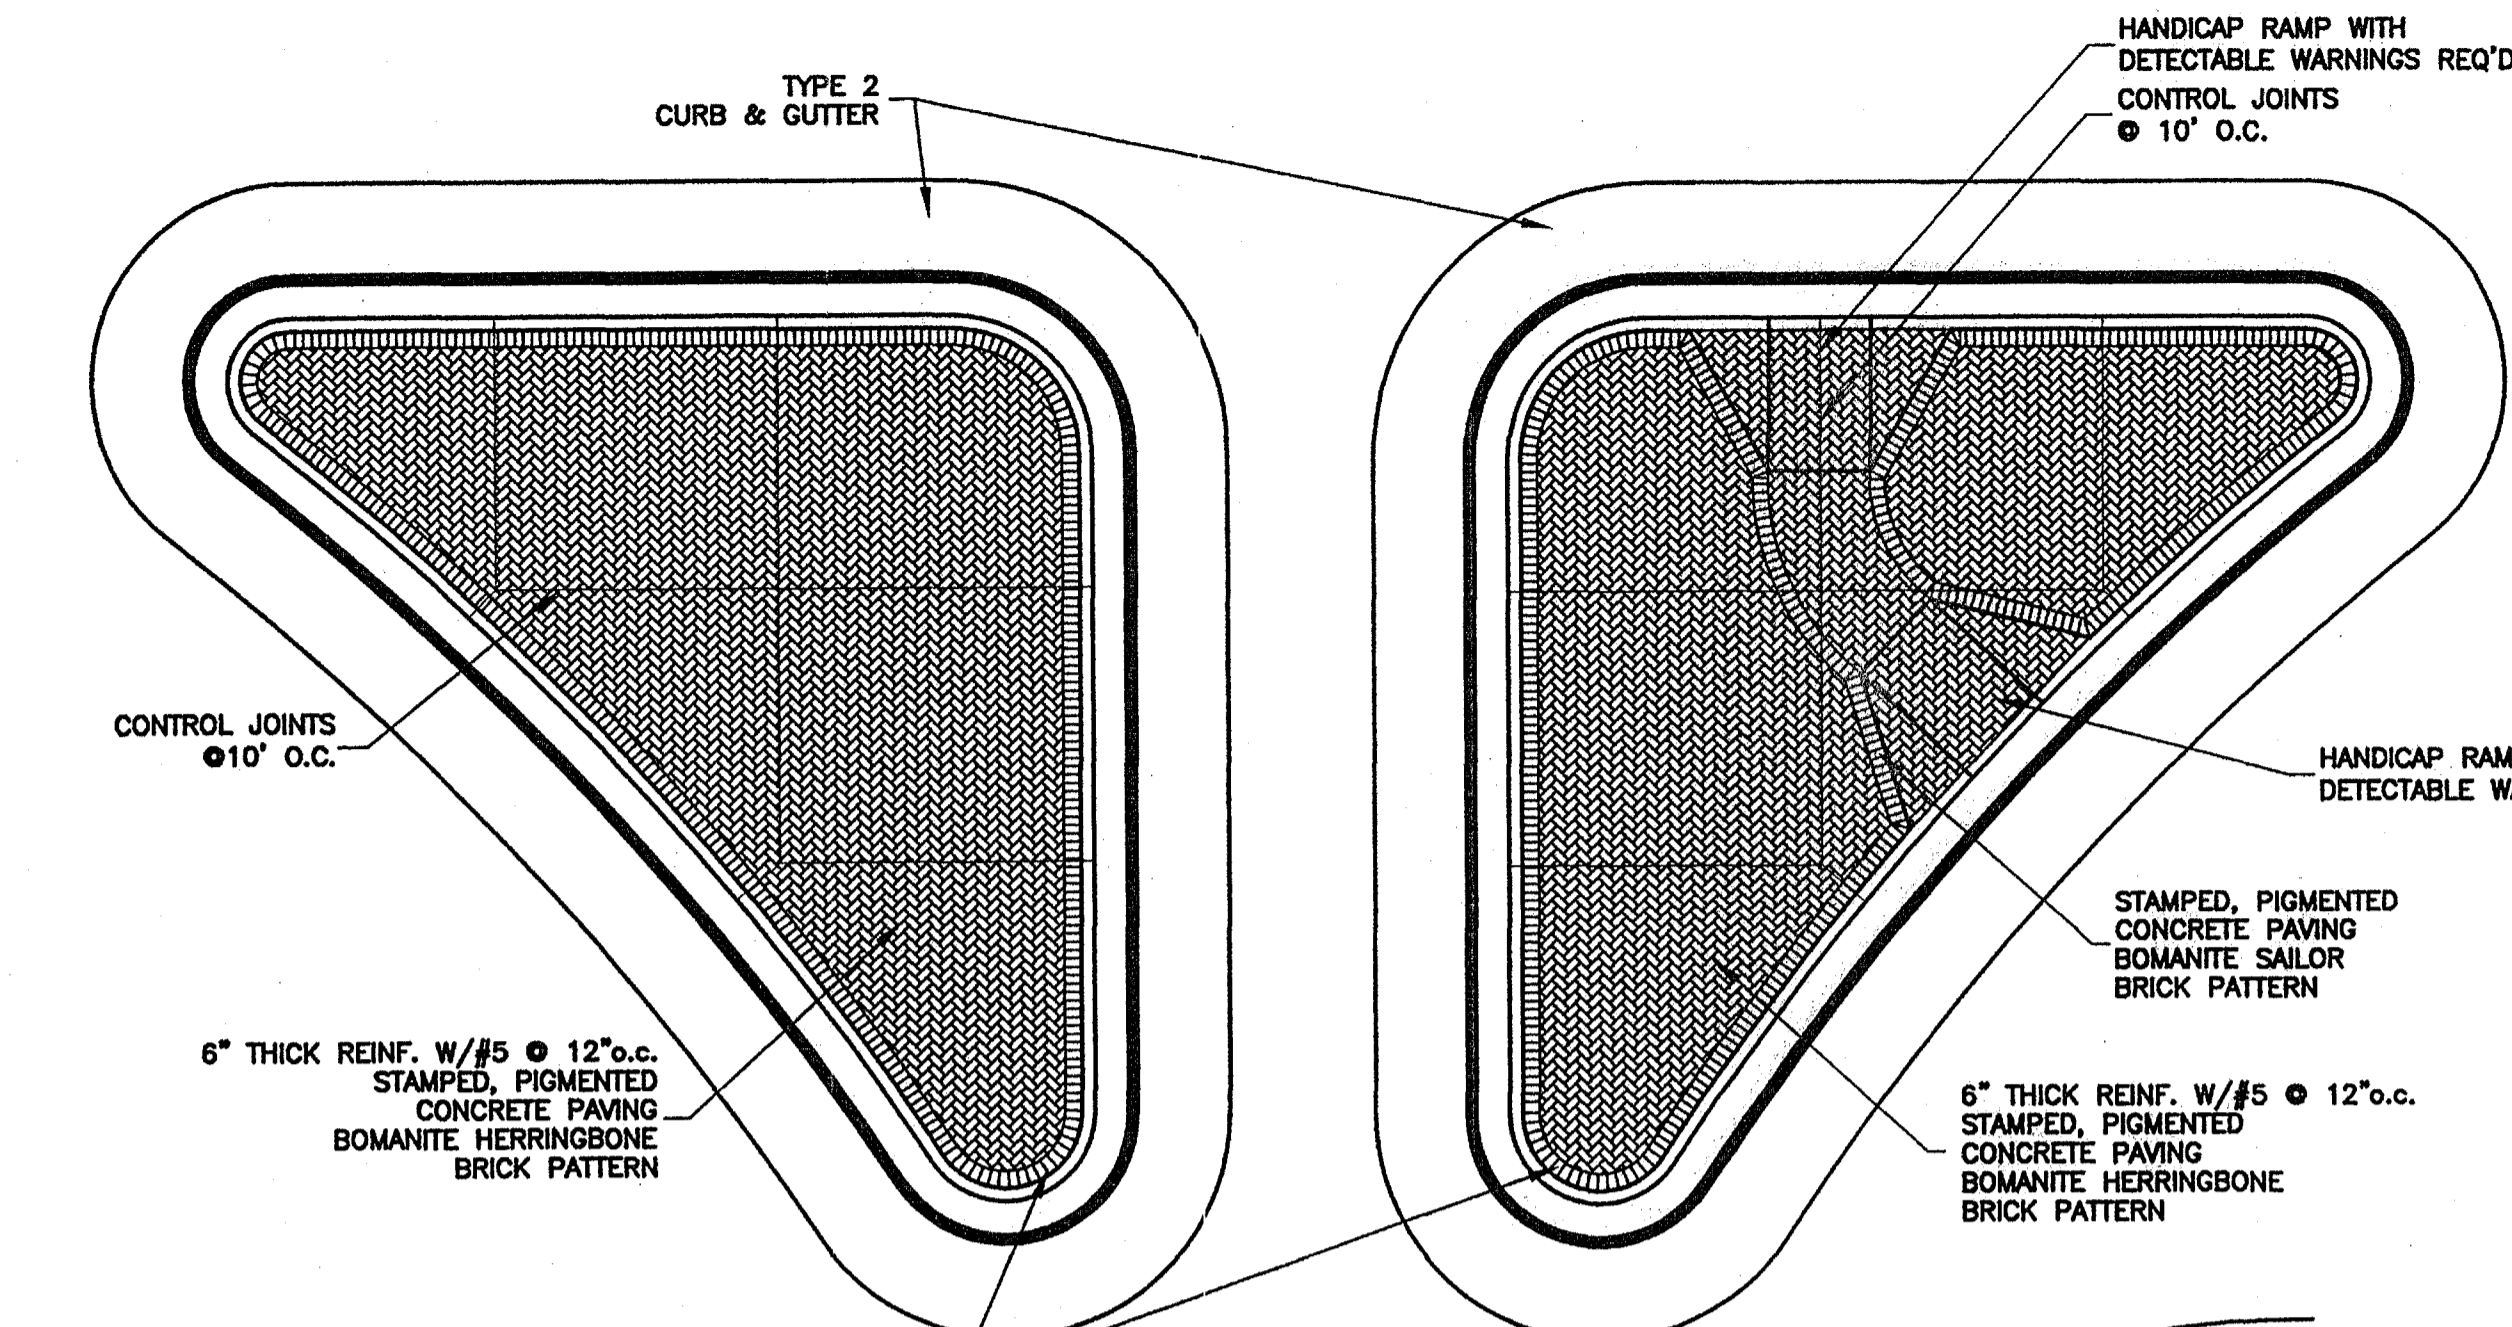


TYPICAL SCOUR HOLE SECTION
N.T.S.

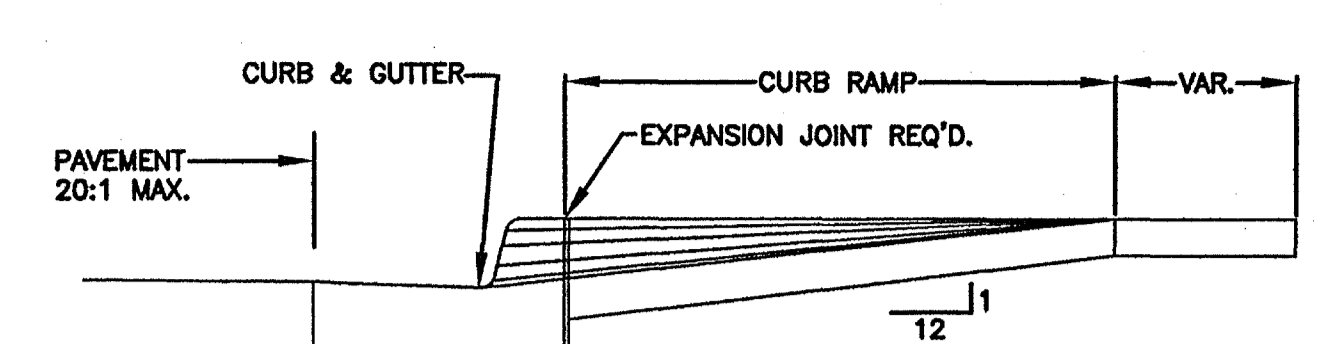


SECTION A-A

GENERAL NOTES FOR DETECTABLE WARNINGS

1. FOR DETECTABLE WARNING GUIDELINES SEE THE AMERICAN WITH DISABILITIES ACT ACCESSIBLE GUIDELINE (ADAAG-REGULATORY STANDARD)
2. PLACEMENT OF THE DETECTABLE WARNINGS SHOULD BE A MAXIMUM OF 6 TO 8 INCHES FROM THE CURB LINE
3. LOCATION AND TYPE OF CURB RAMP SHALL BE AS SHOWN ON THE PLANS OR AS DIRECTED.
4. THE CURB RAMP SHALL BE PAID FOR AS SIDEWALK.
5. THE THICKNESS OF THE CURB RAMP SHALL BE A MINIMUM OF 4 INCHES.
6. ALL RAMP SLOPES SHALL NOT BE STEEPER THAN 12:1
7. THE MATERIALS USED FOR DETECTABLE WARNINGS SHALL CONTRAST VISUALLY WITH ADJOINING SURFACES AND BE AN INTEGRAL PART OF THE WALKING SURFACE.

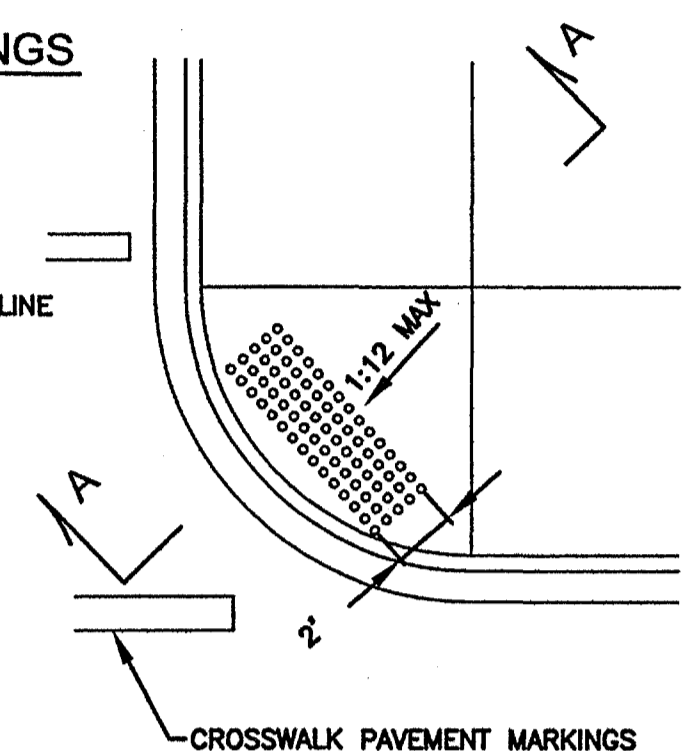


HANDICAP RAMP DETAILS
PROVIDE HANDICAPPED RAMP W/ DETECTABLE WARNINGS @ EACH DRIVEWAY/ROADWAY

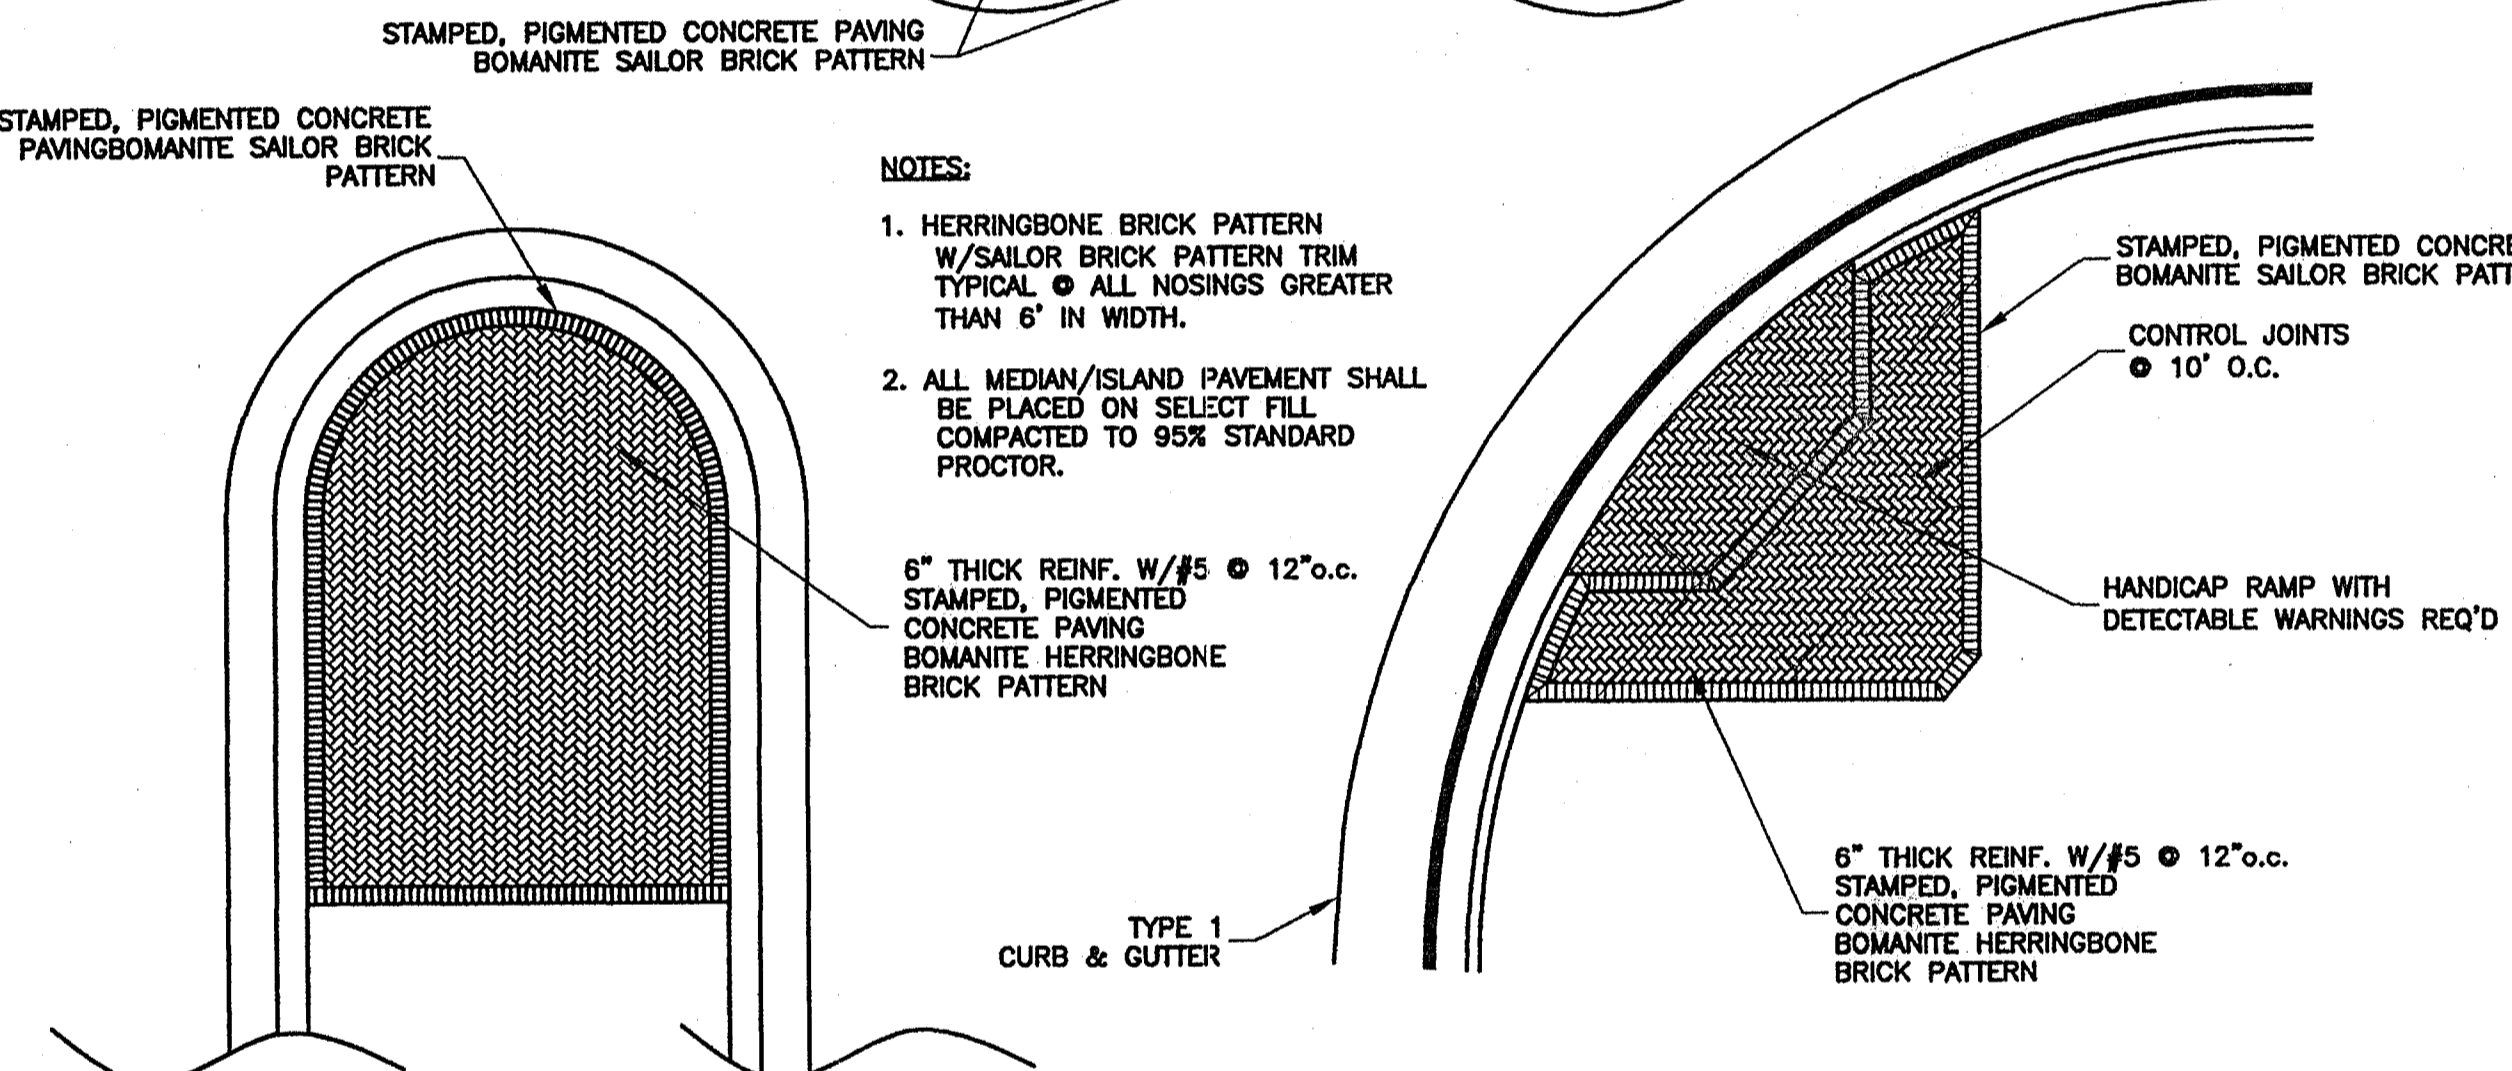


TYPICAL STAMPED CONCRETE DETAIL
N.T.S.


- NOTES:
1. HERRINGBONE BRICK PATTERN W/SAILOR BRICK PATTERN TRIM TYPICAL @ ALL NOSINGS GREATER THAN 6" IN WIDTH.
 2. ALL MEDIAN/ISLAND PAVEMENT SHALL BE PLACED ON SELECT FILL COMPACTED TO 95% STANDARD PROCTOR.

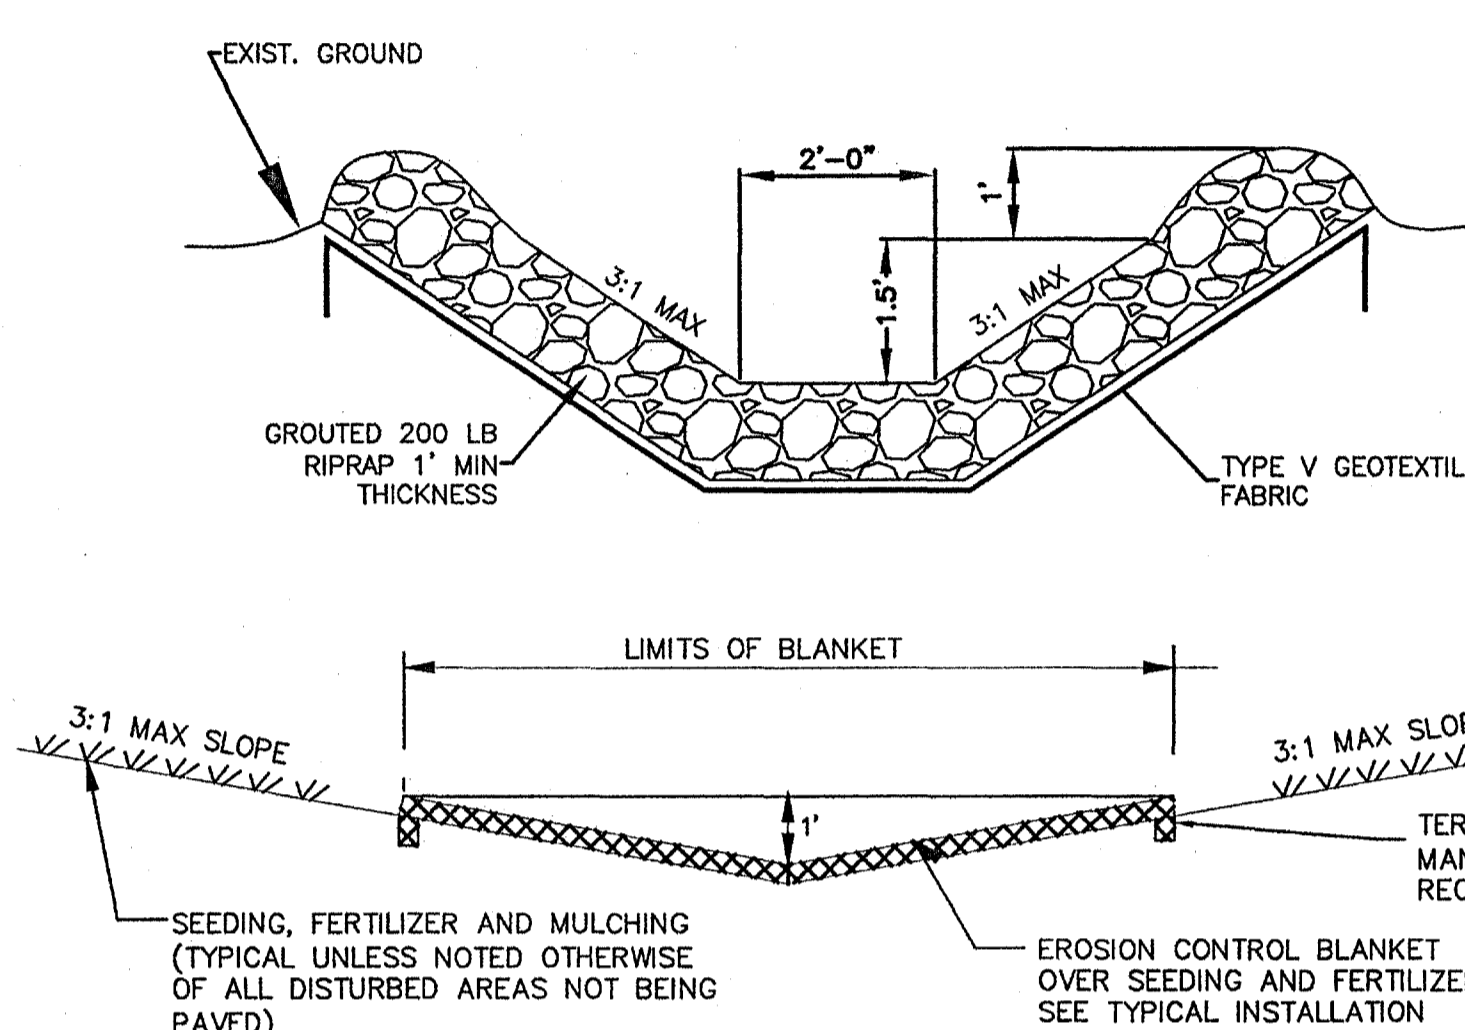


TYPICAL DITCH SECTIONS
SCALE: N.T.S.

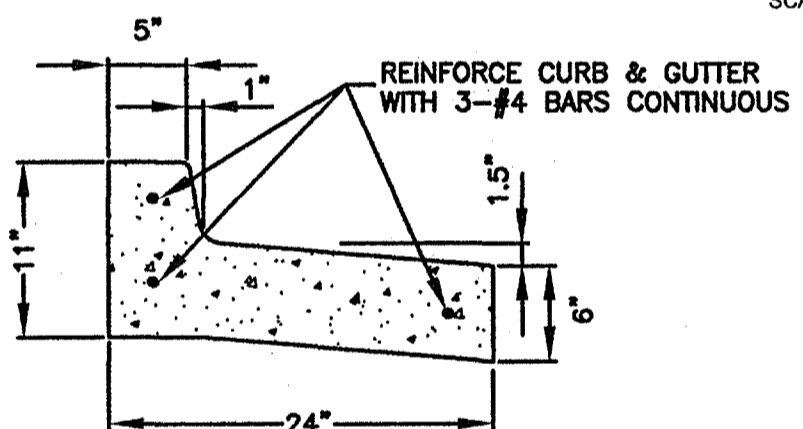

TYPE 1 PITCH-AWAY CURB & GUTTER DETAIL
SCALE: N.T.S.

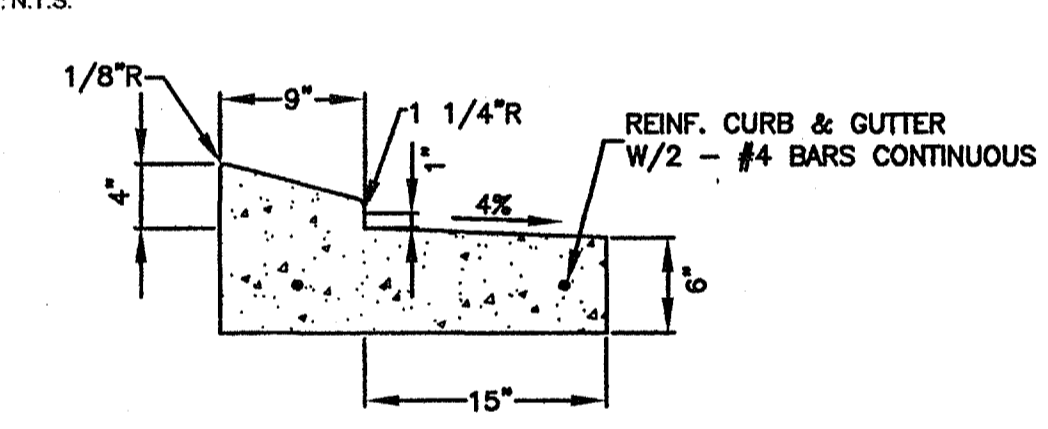


TYPE 2 STANDARD PITCH-AWAY MOUNTABLE CURB & GUTTER DETAIL
SCALE: N.T.S.

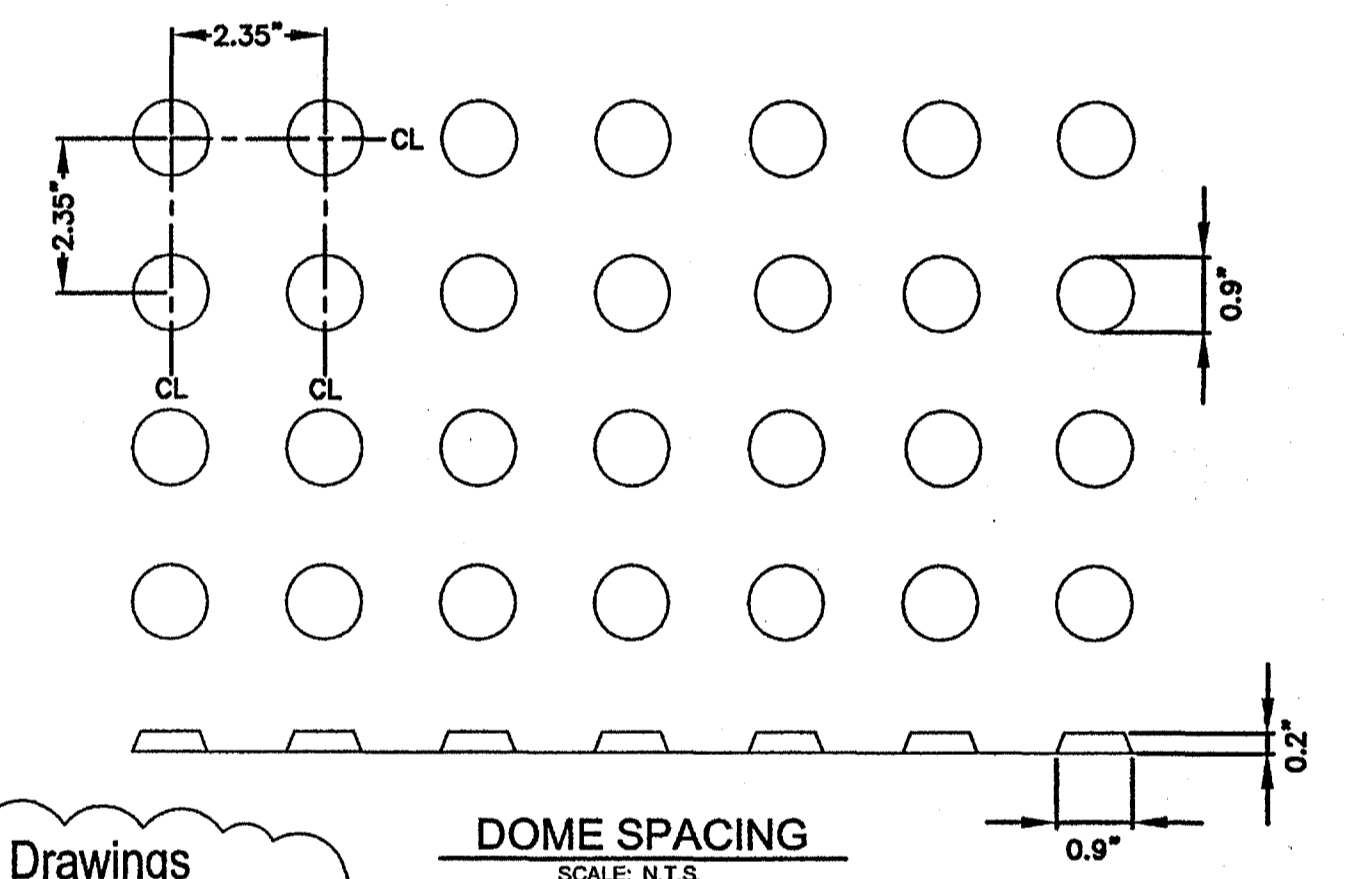


DOMES SPACING
SCALE: N.T.S.


Record Drawings
1-8-08

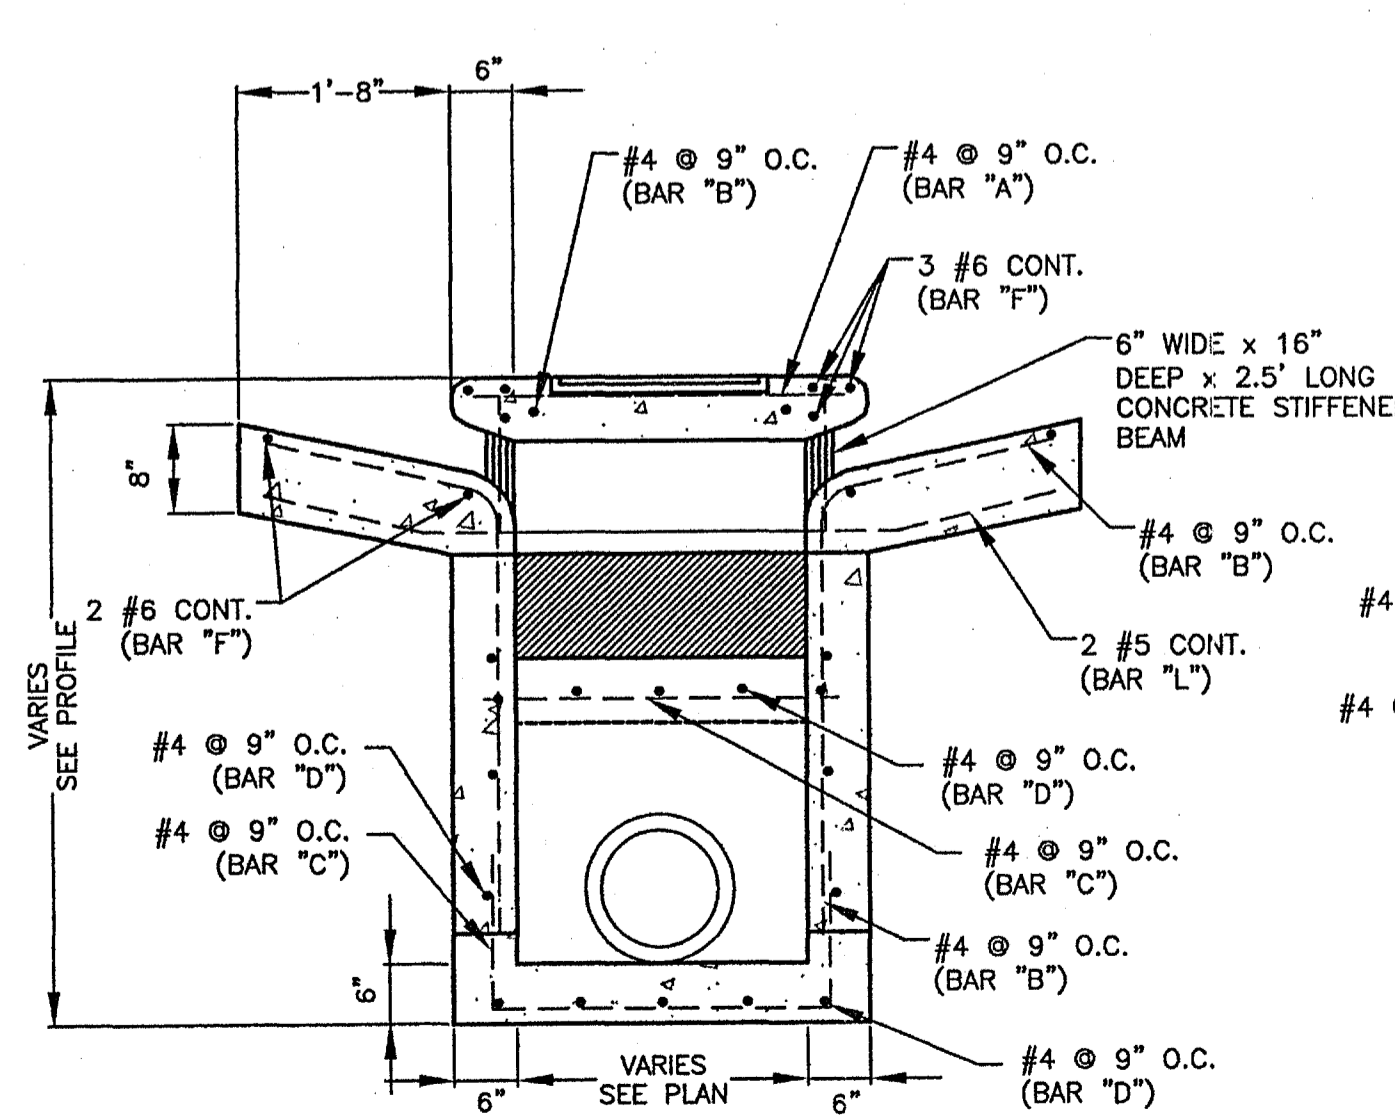

MODIFIED SS-2 INLET SECTION
SCALE: N.T.S.








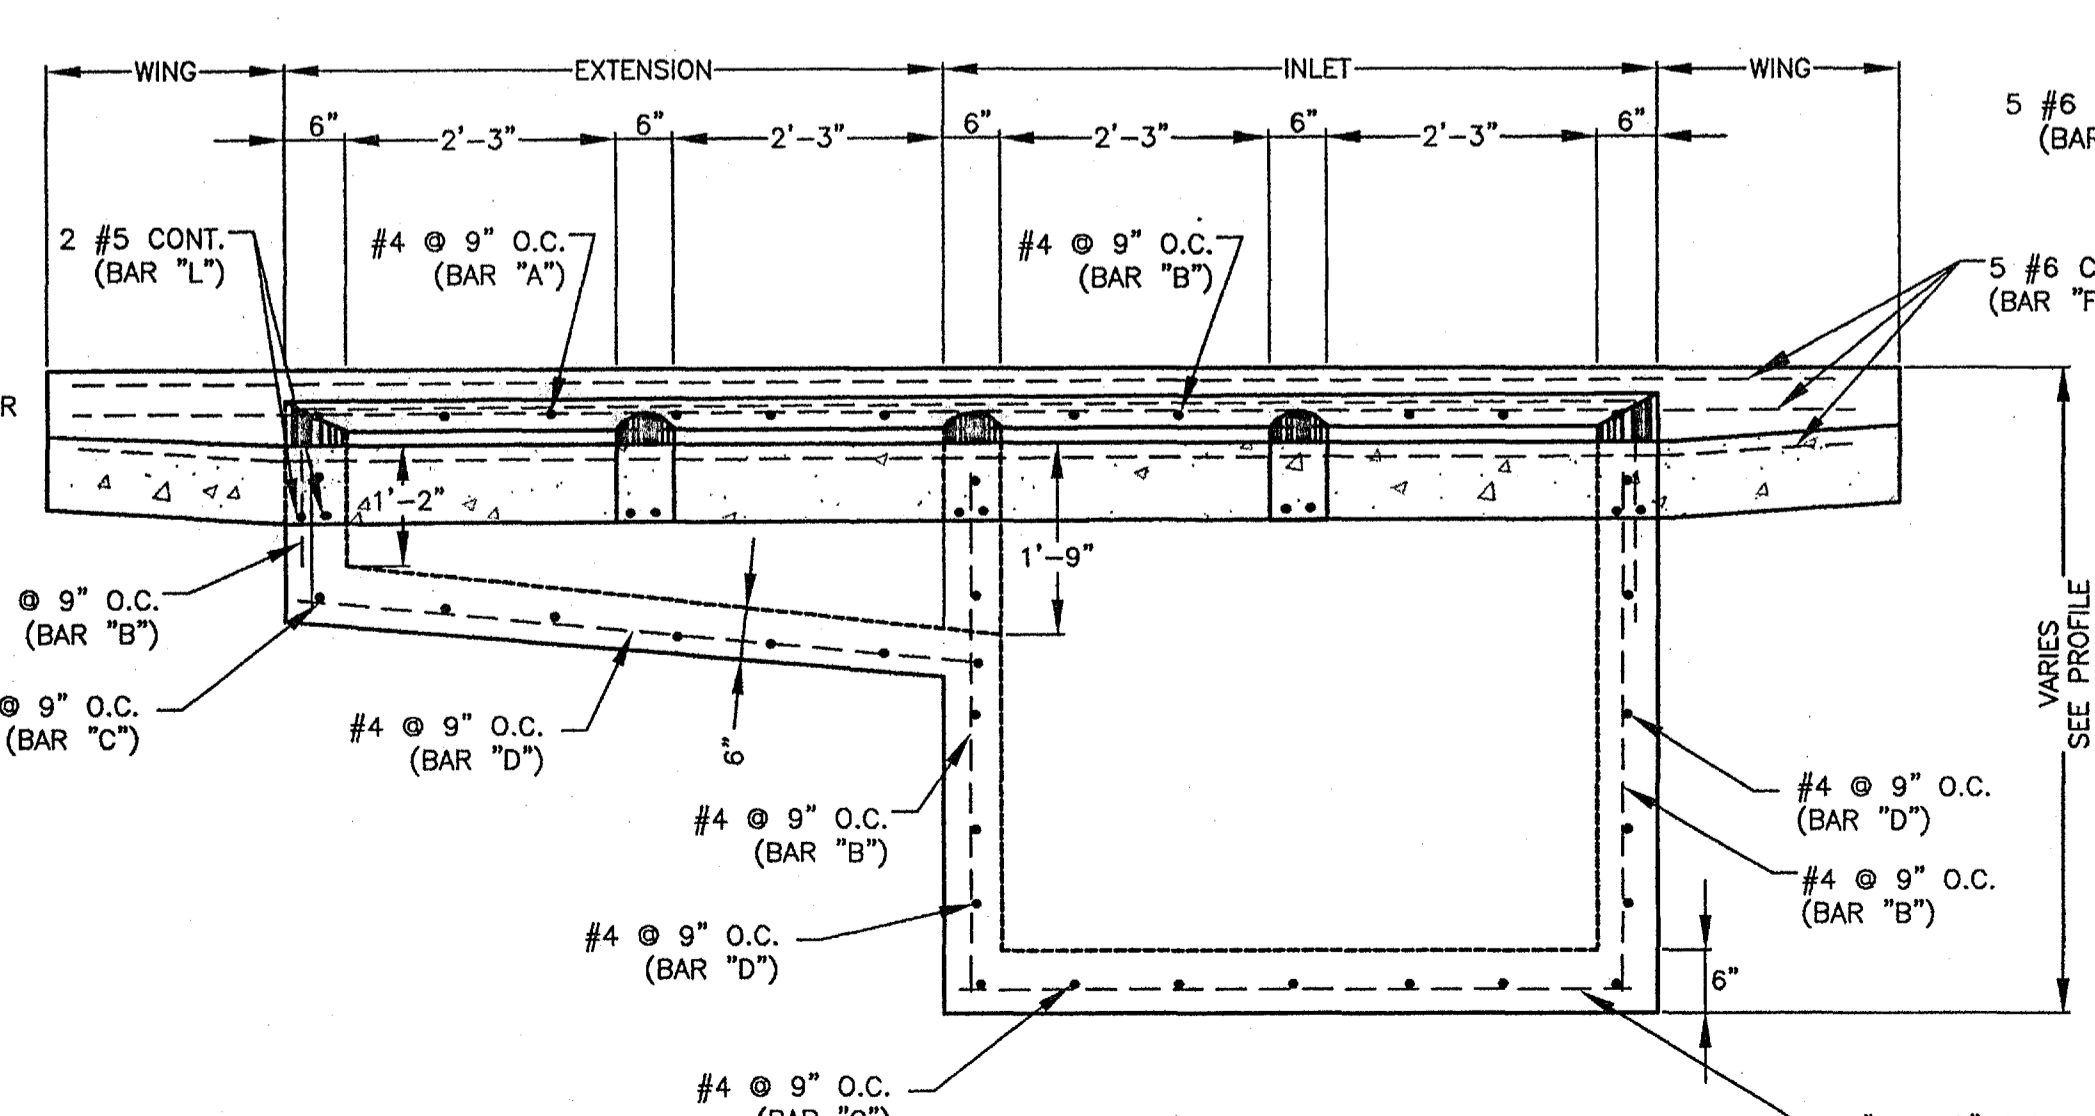


MODIFIED SS-2 INLET SECTION
SCALE: N.T.S.







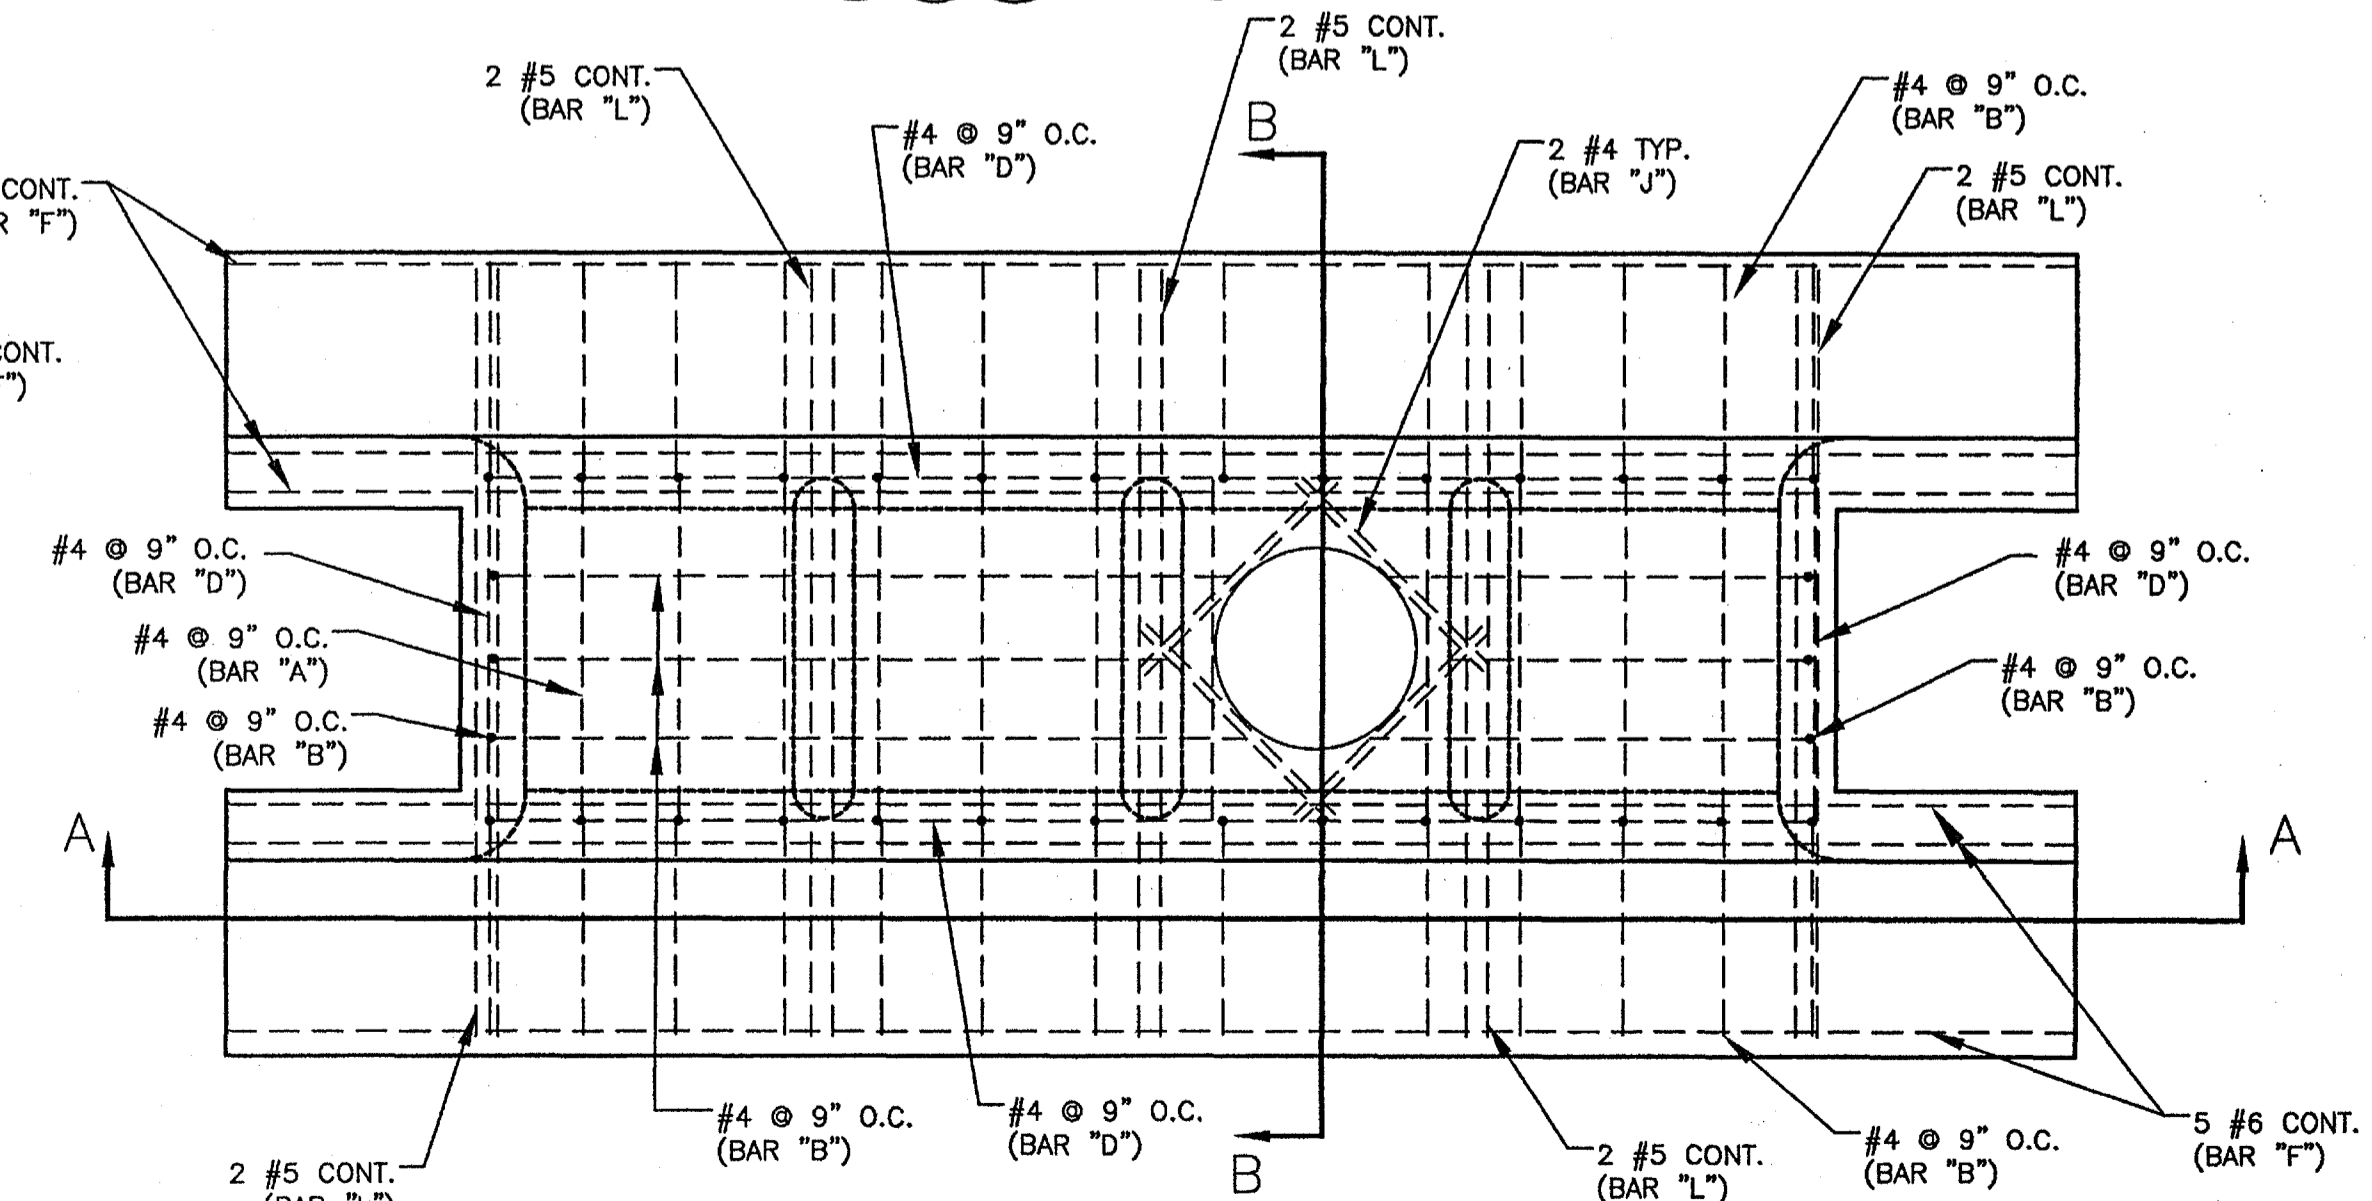


MODIFIED SS-2 INLET PLAN
SCALE: N.T.S.


TYPICAL DETAIL SHEET

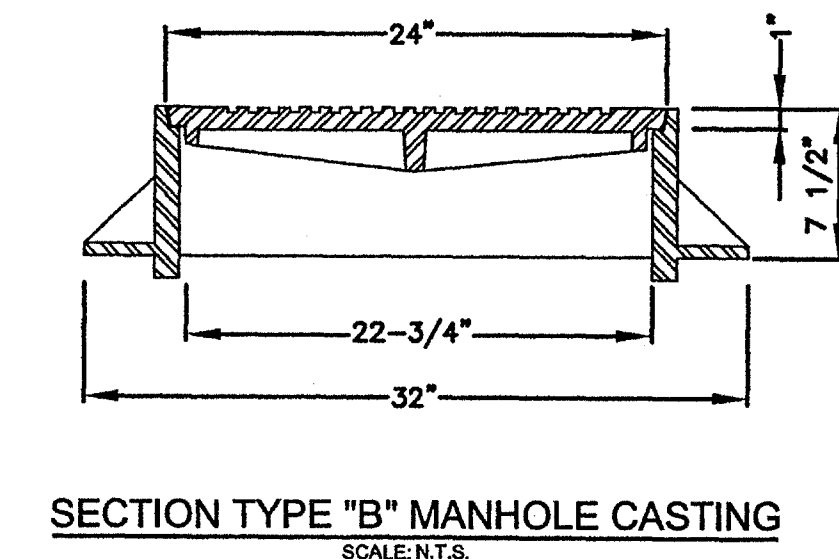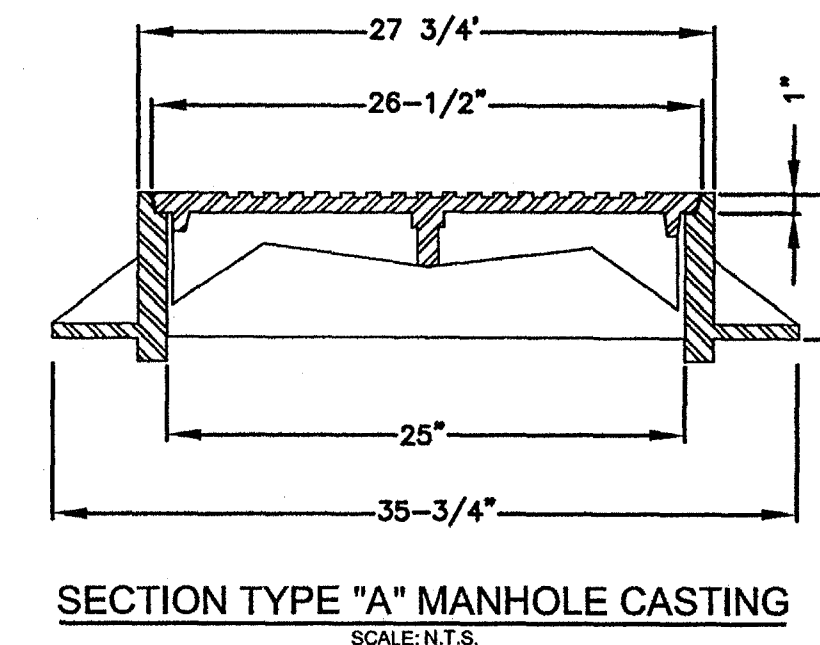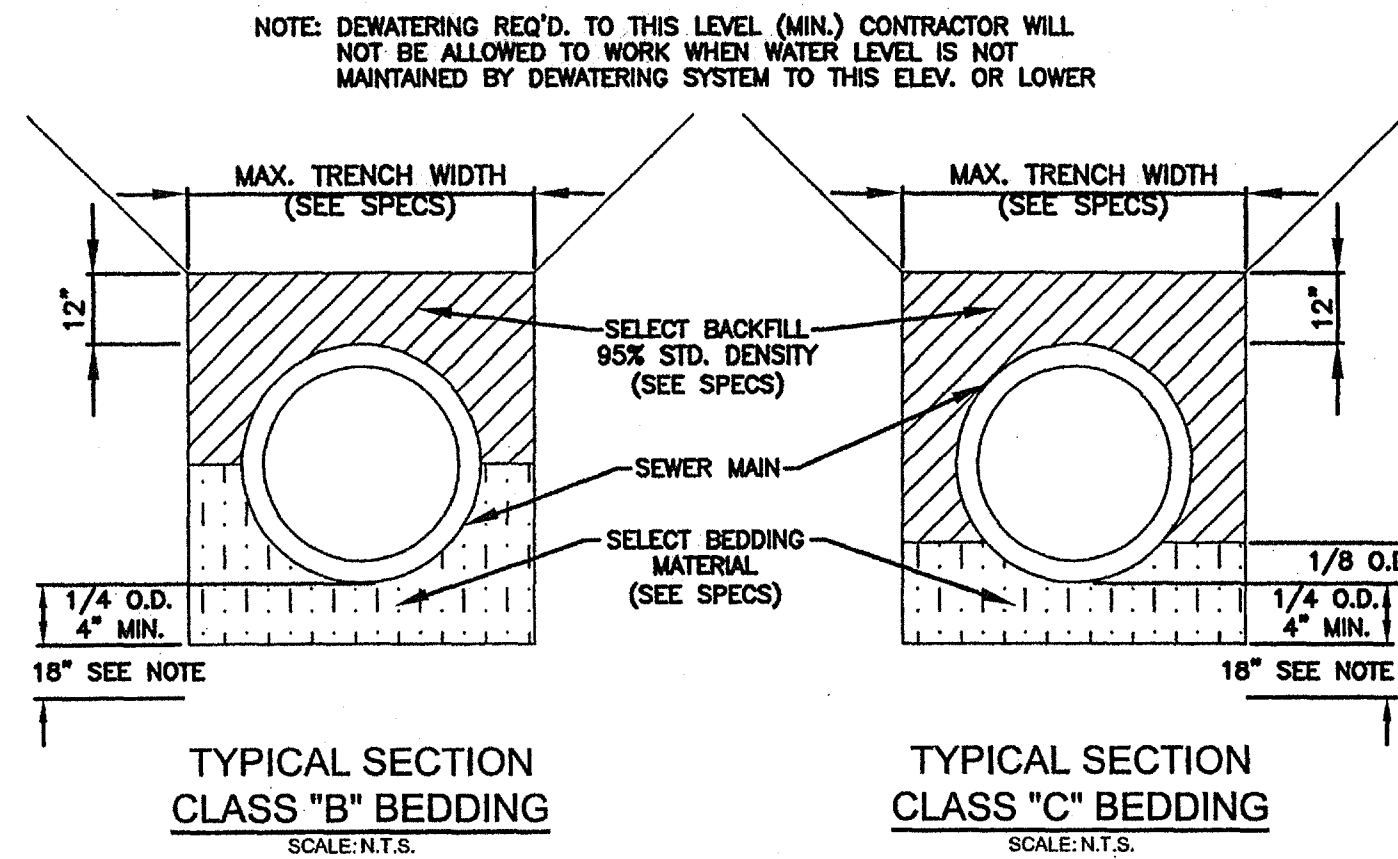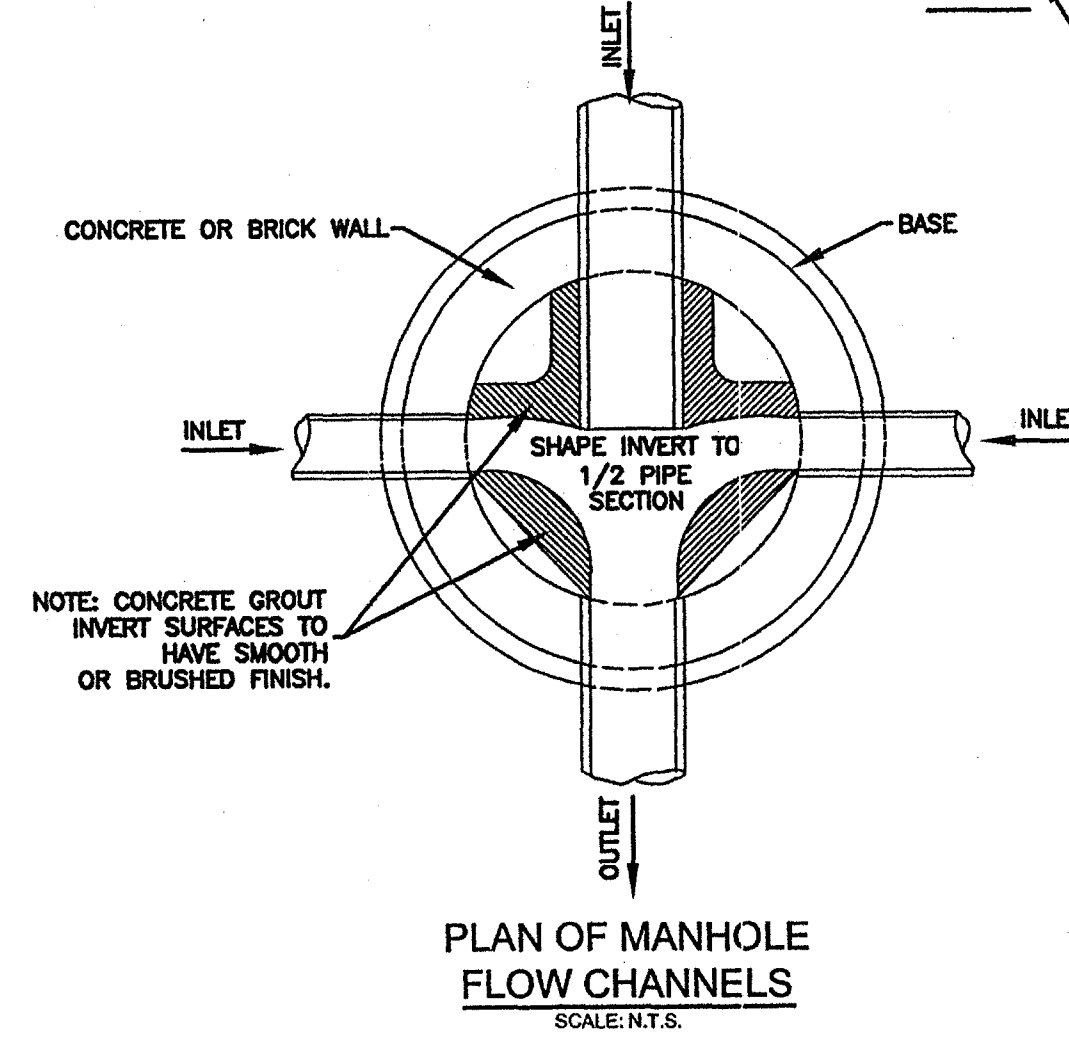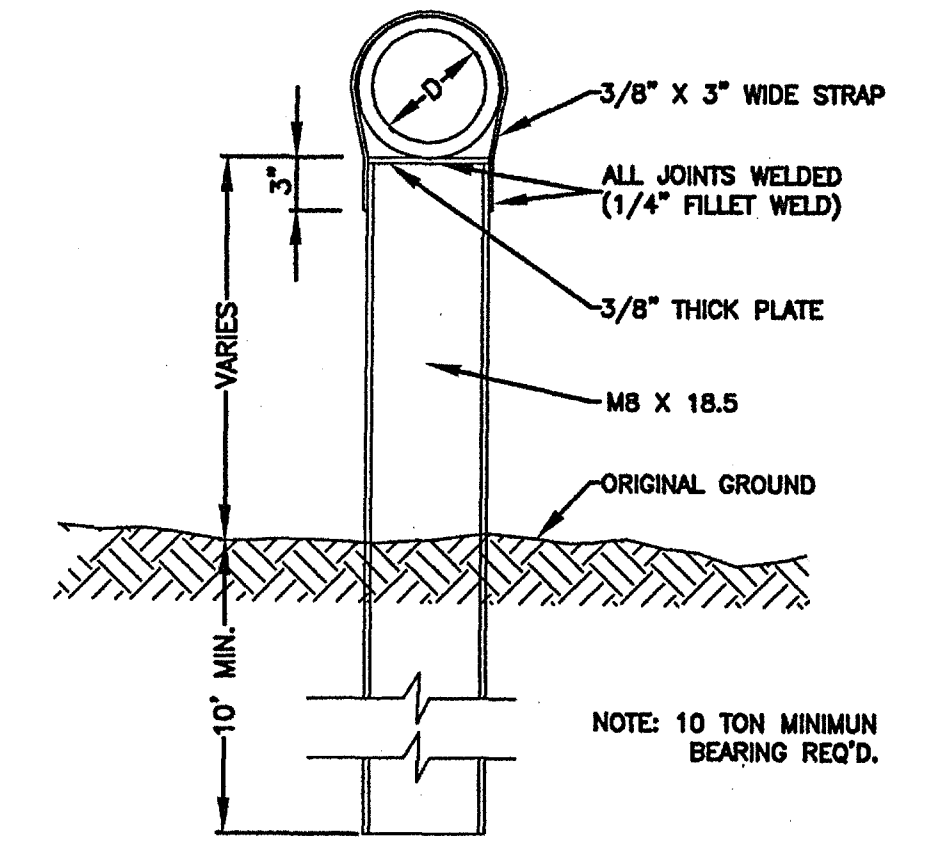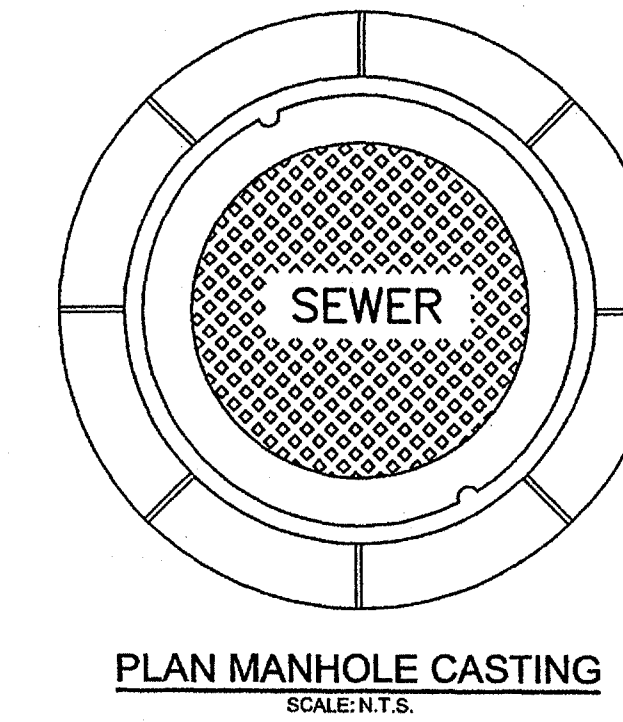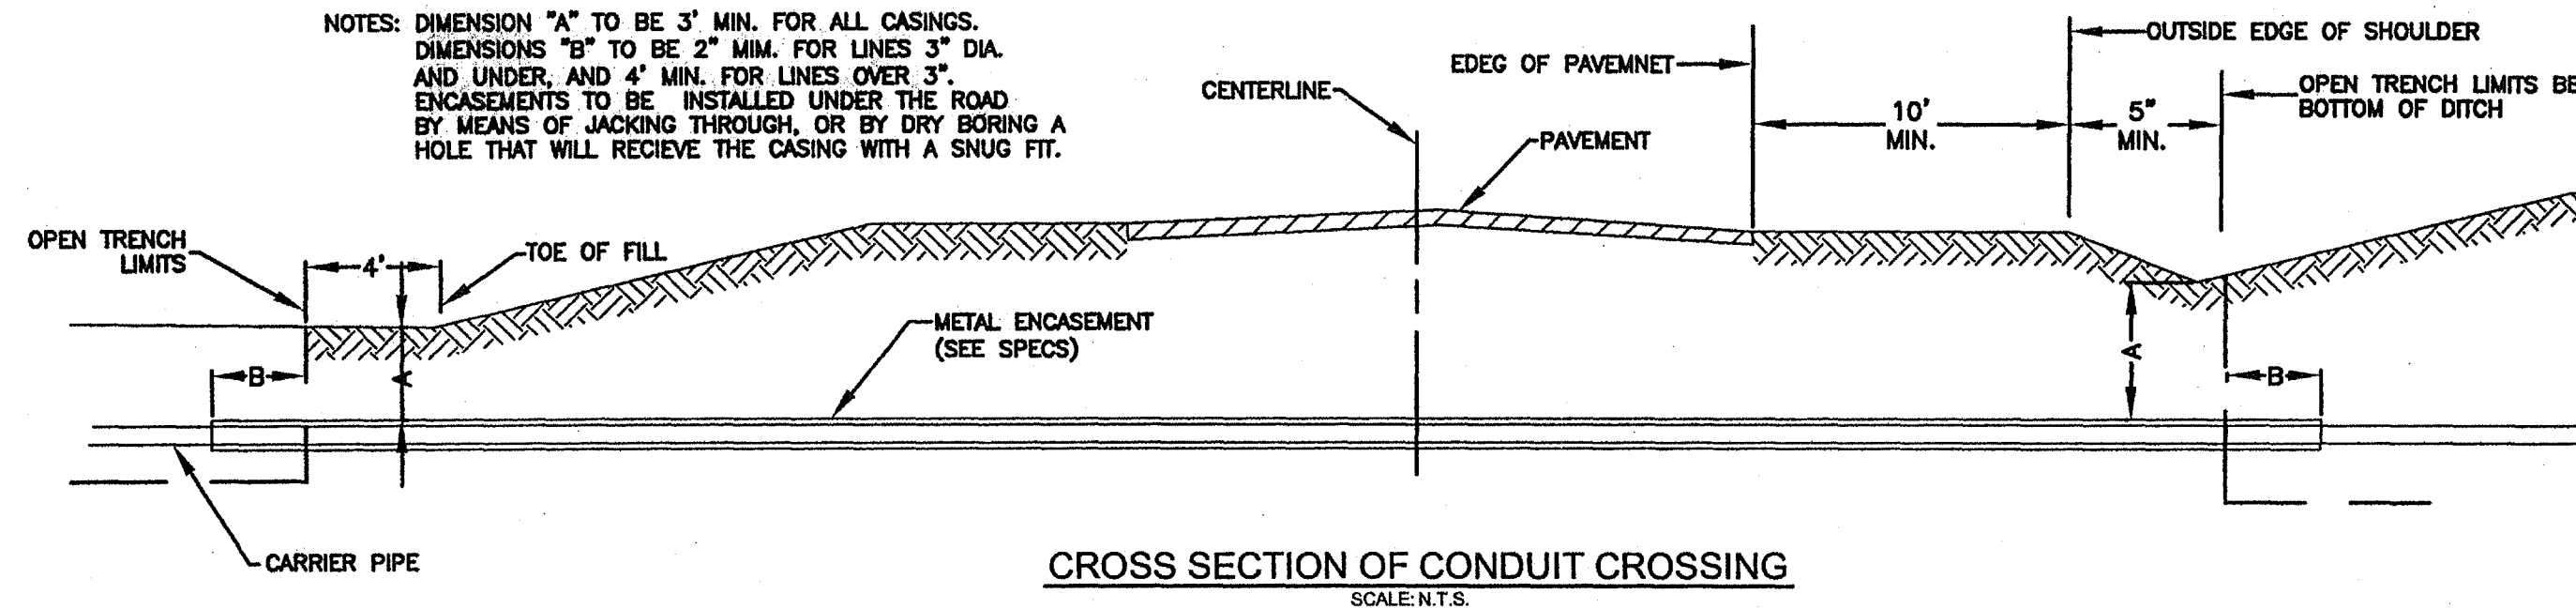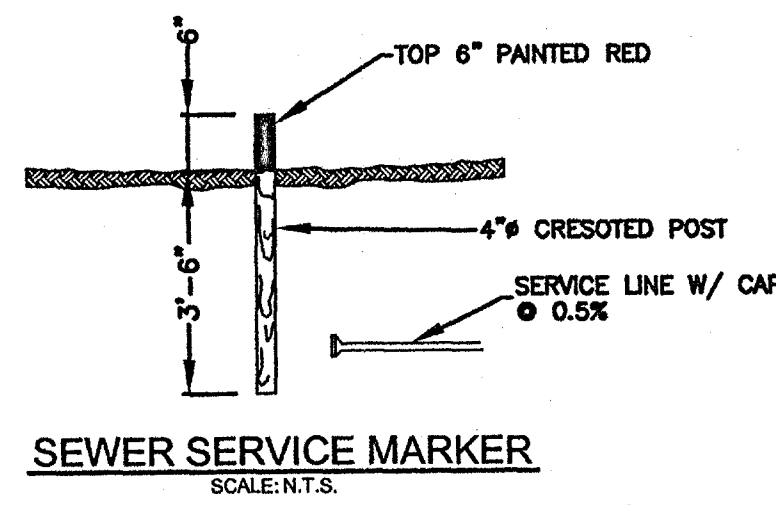

NOTE: 1. USE TYPE "A" MANHOLE CASTING IN STREET R.O.W. 2. USE VULCAN NO. VM-8, (440 lbs.)
NOTE: 1. USE TYPE "B" MANHOLE CASTING FOR ANY MANHOLE NOT IN A STREET R.O.W. 2. VULCAN NO. VM-7 (300 LBS.) OR NEENAH NO. R-1779 (300 LBS.)

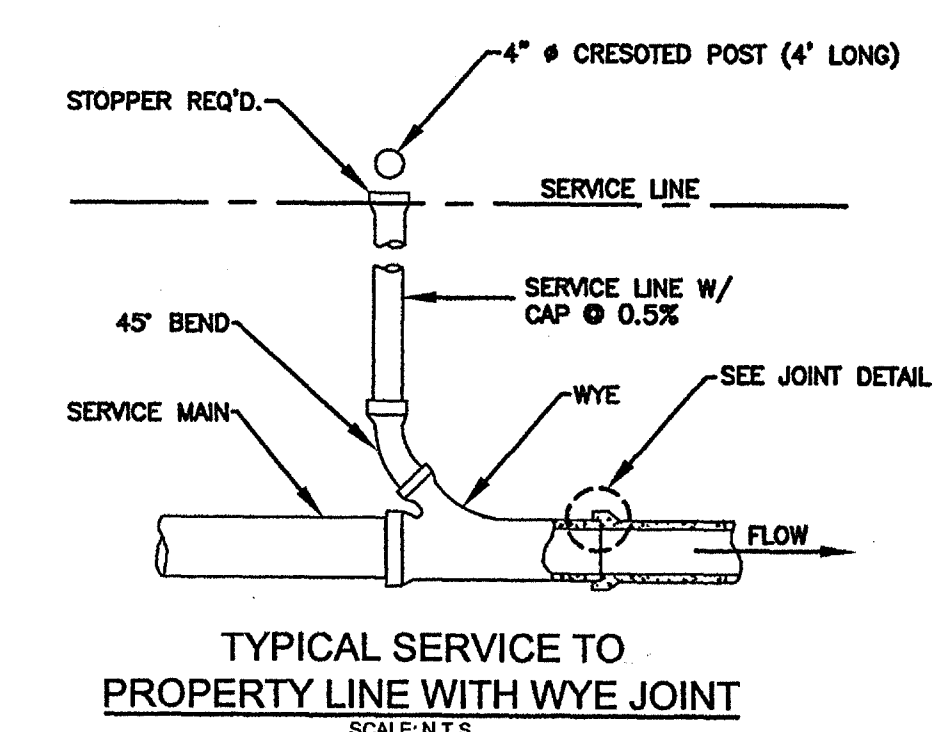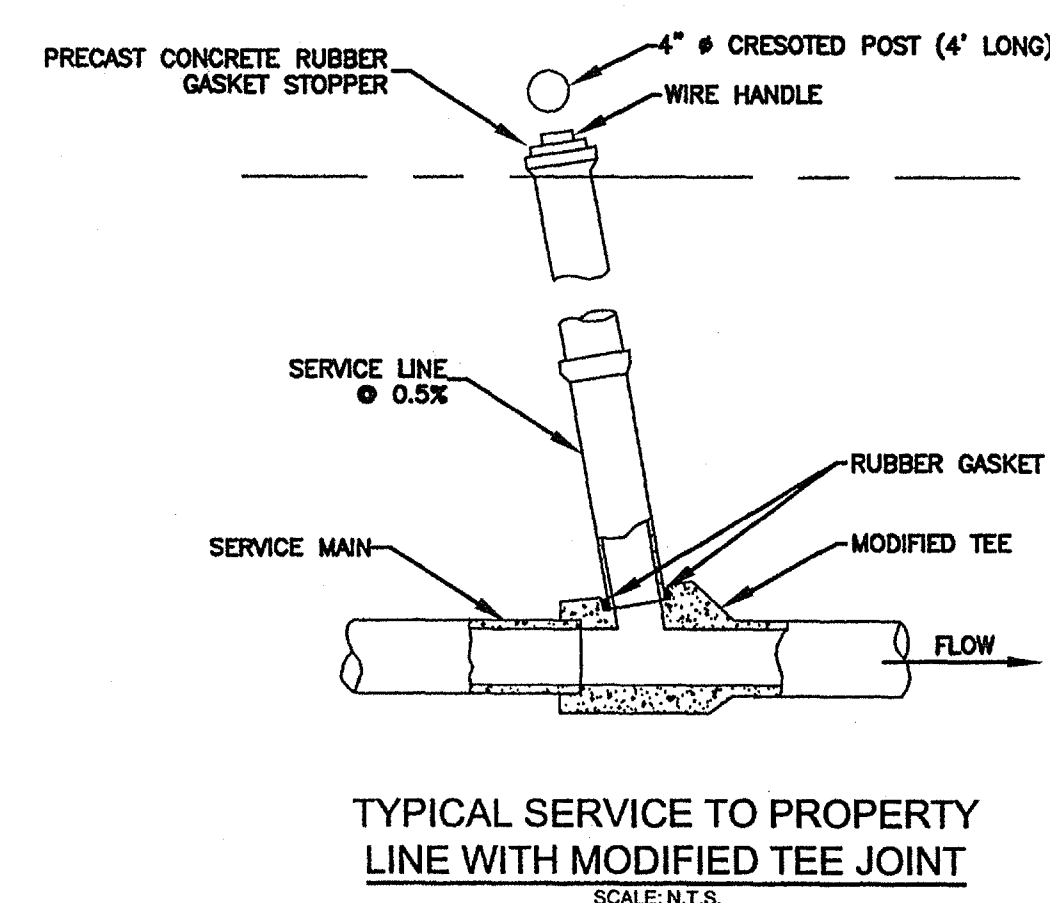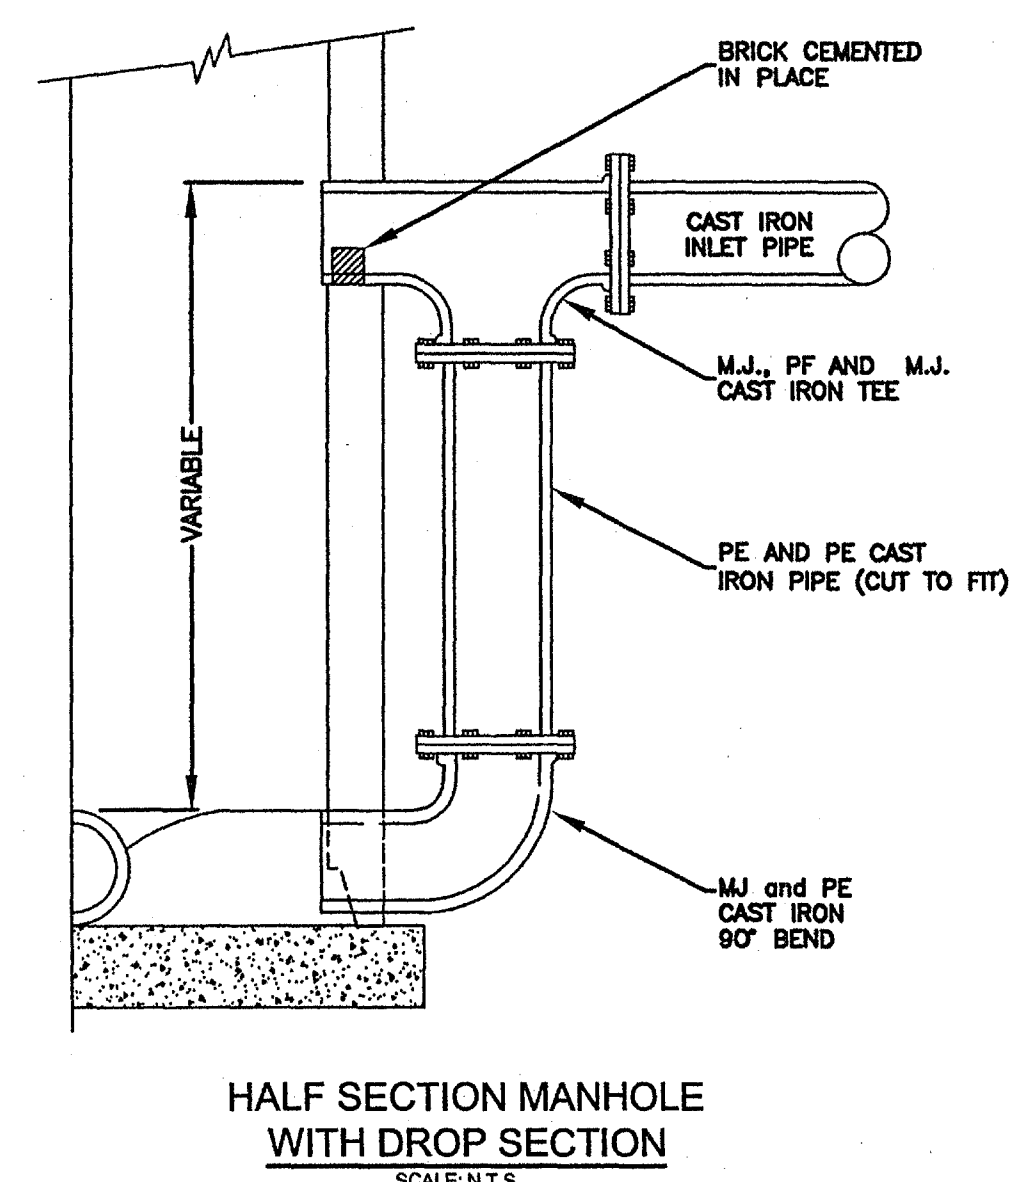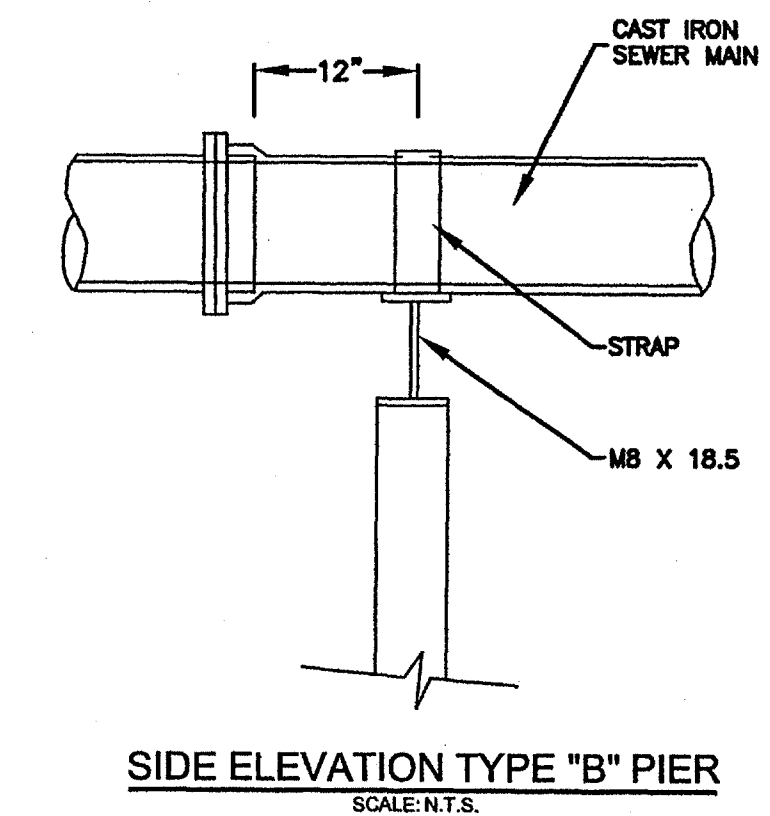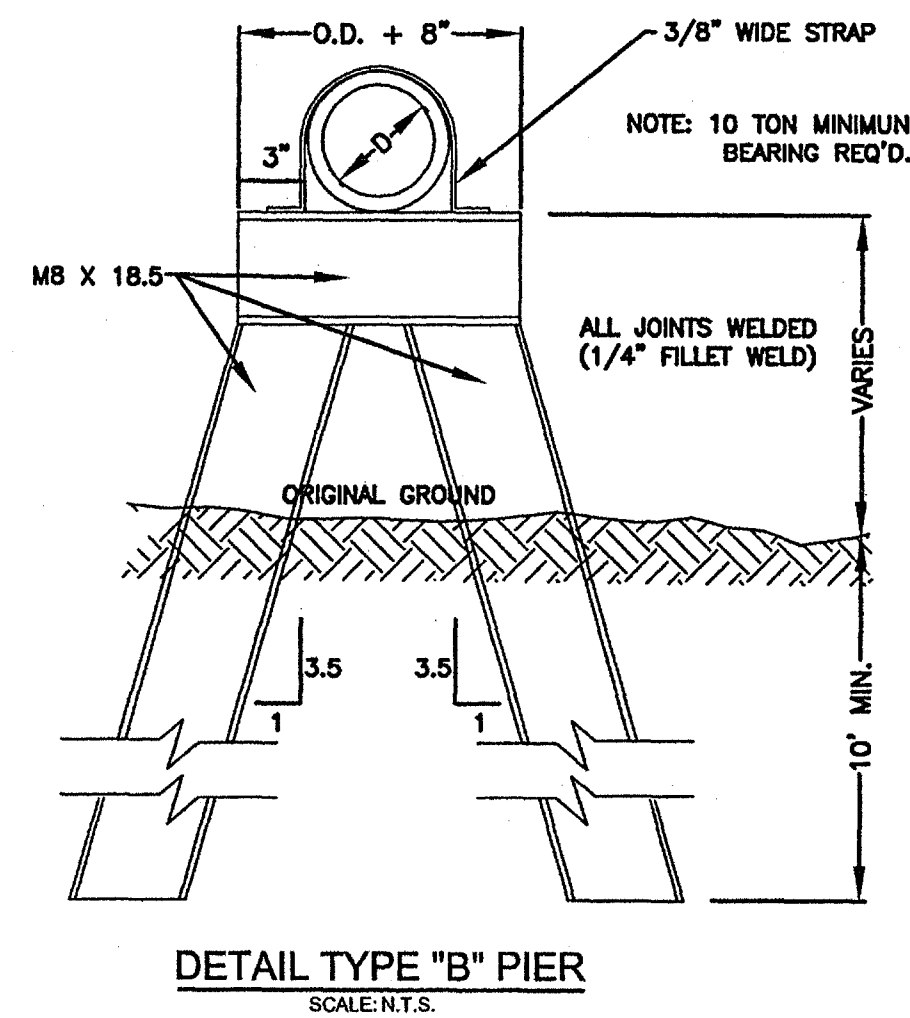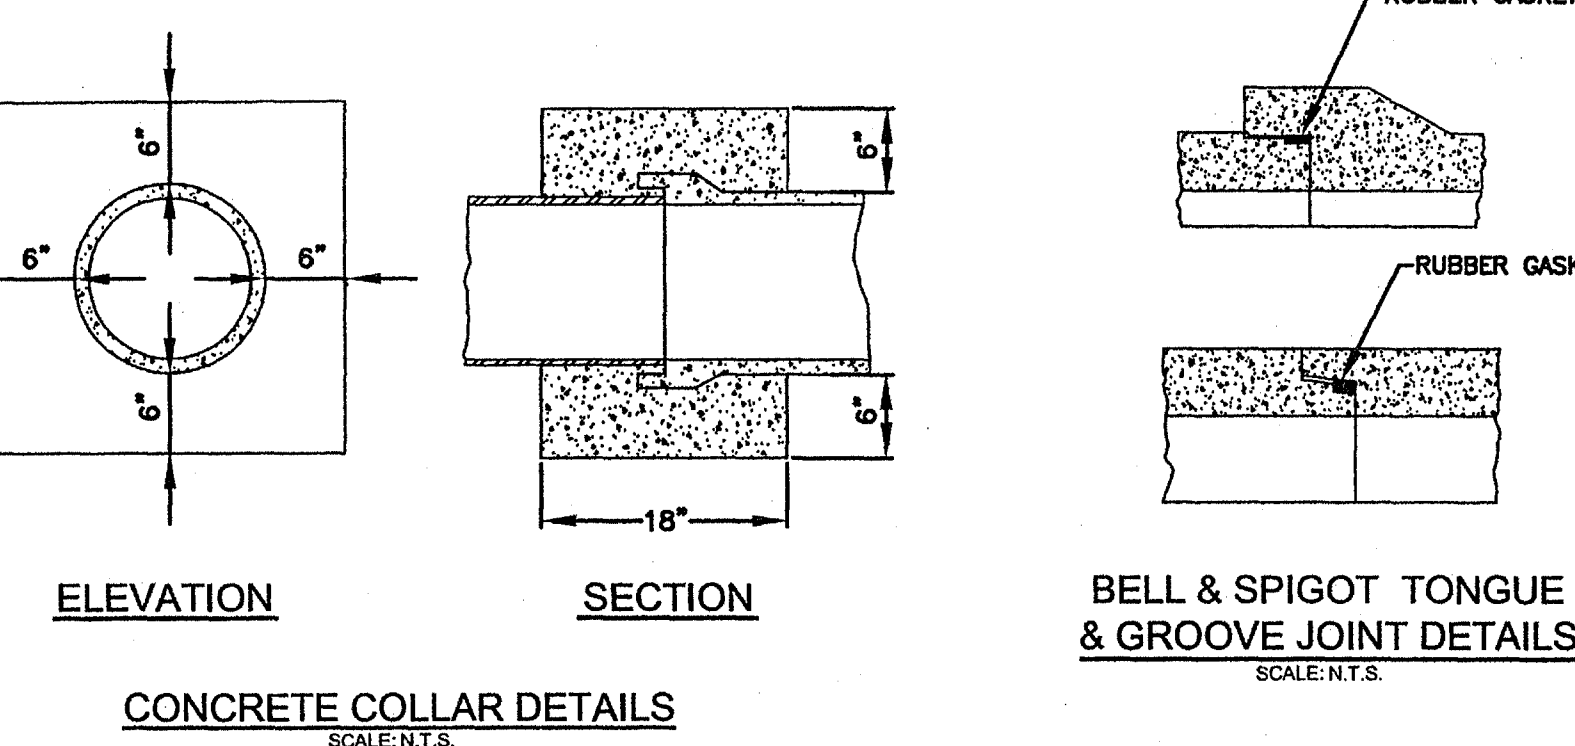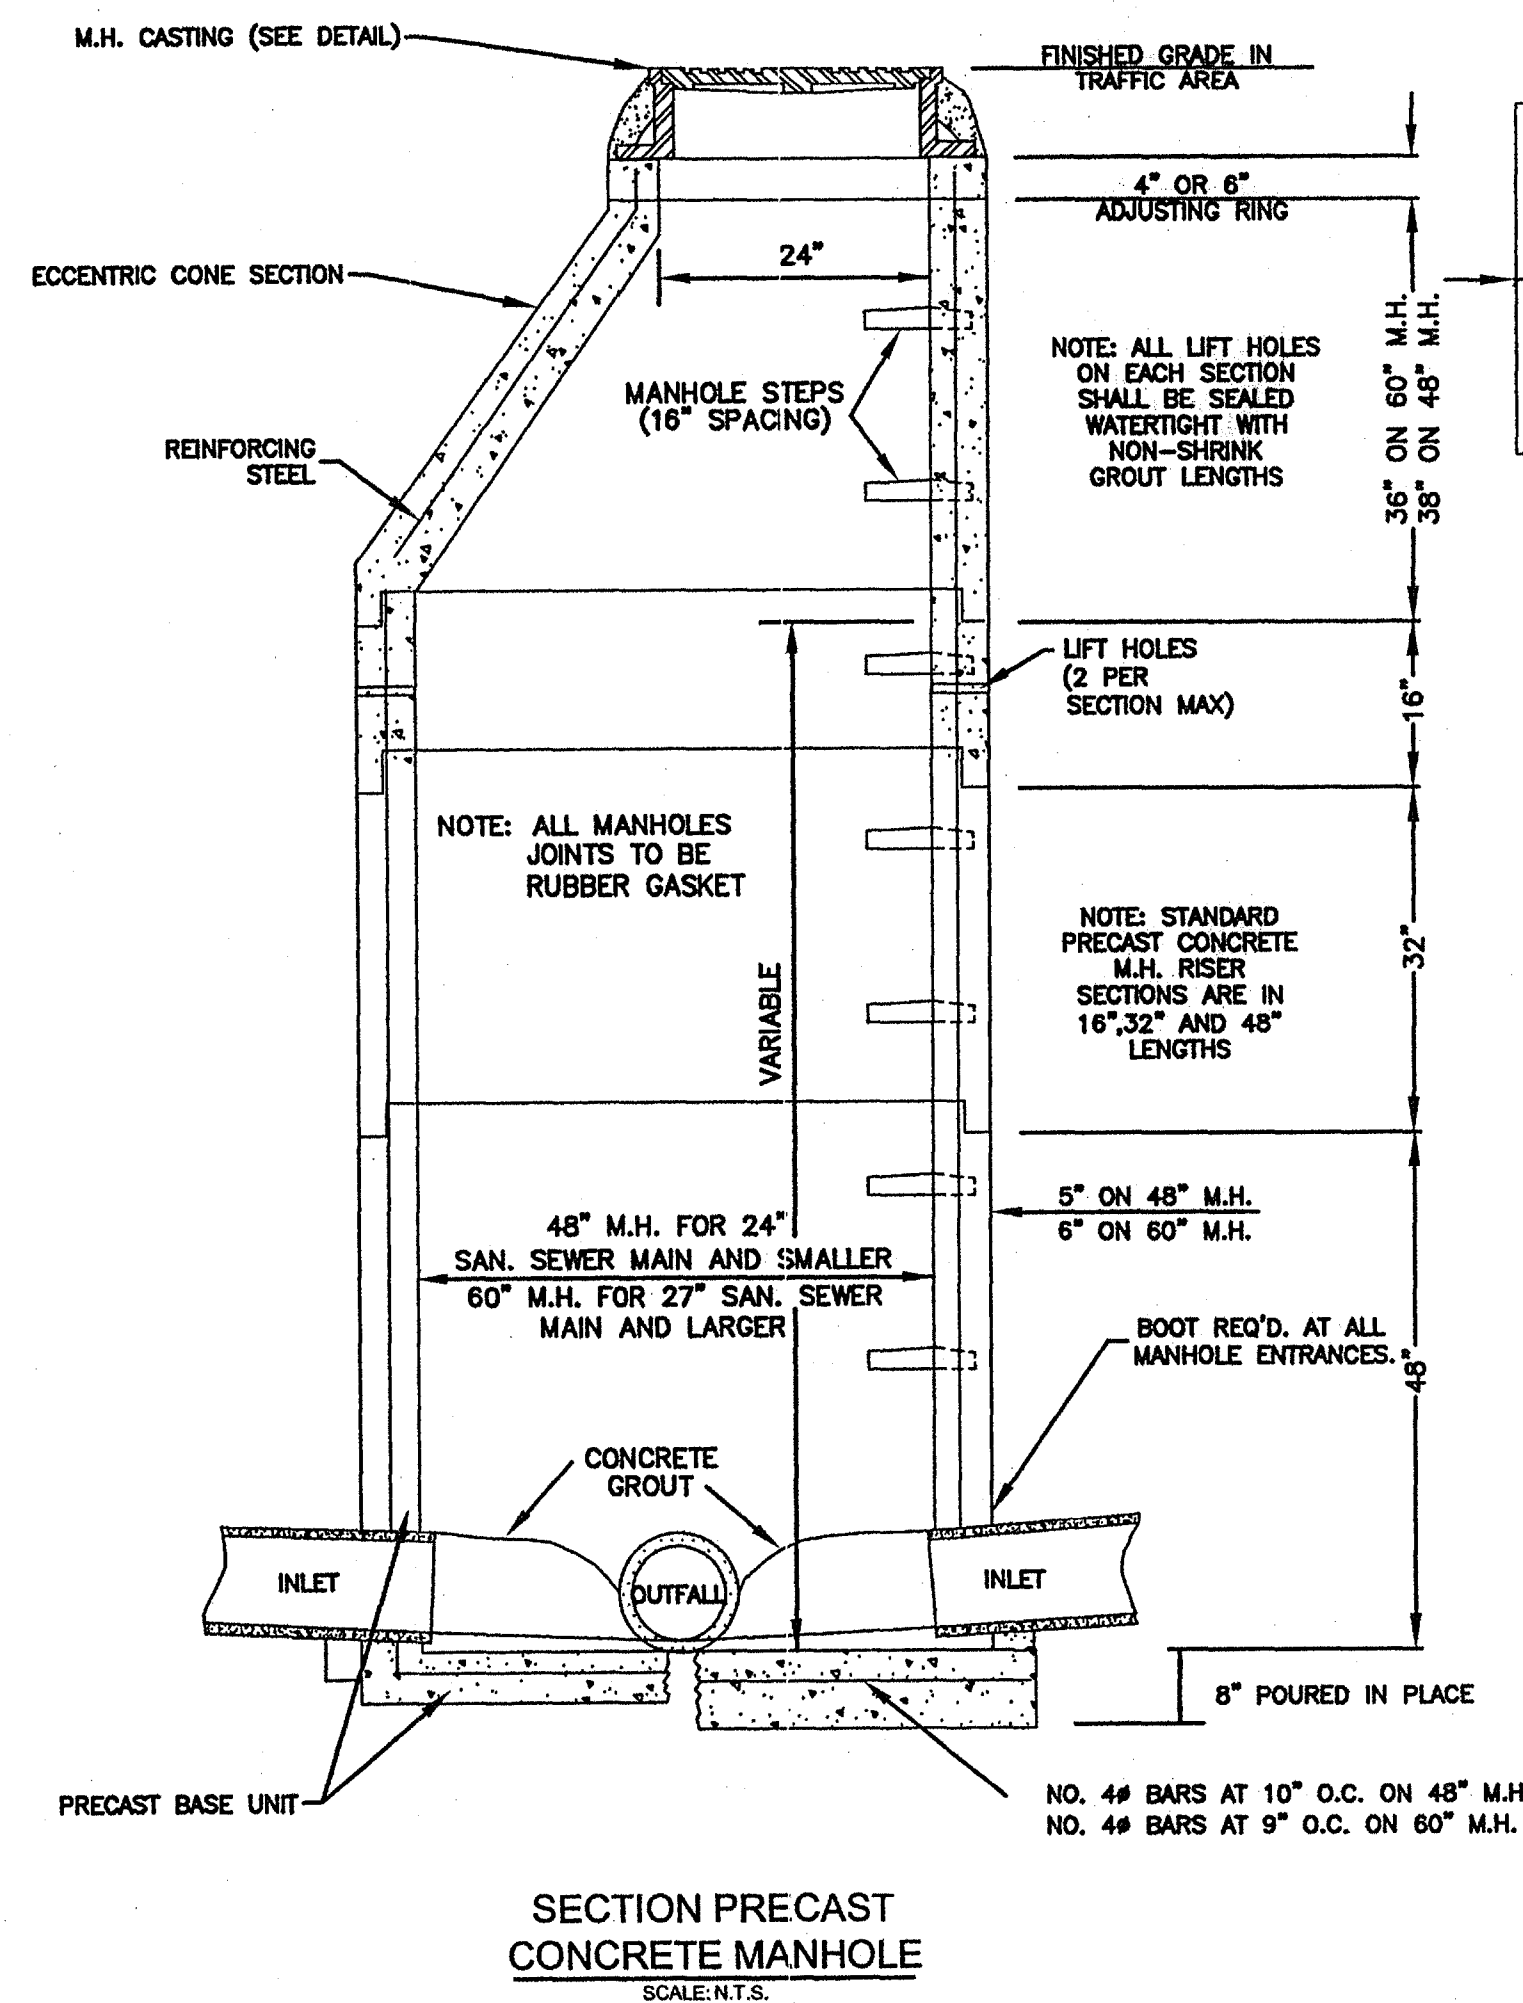


Record Drawings
1-8-08

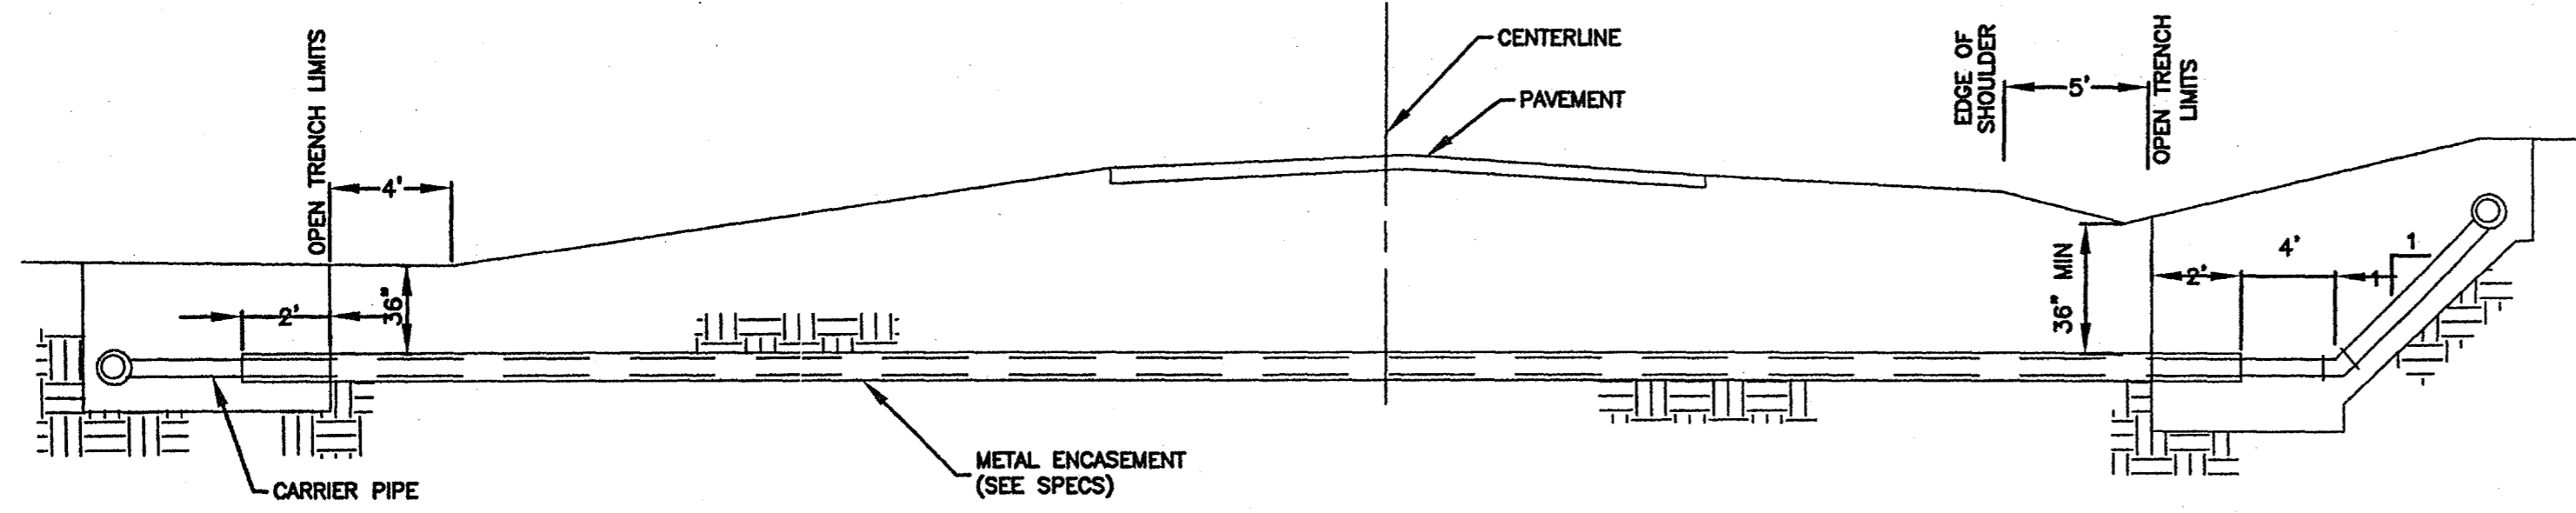


TYPICAL CASED CROSSING
SCALE: N.T.S.



NOTE: COMPENSATION FOR CONCRETE THRUST BLOCKS SHALL BE INCLUDED IN THE UNIT PRICE BID FOR VALVES, FIRE HYDRANTS AND FITTINGS.

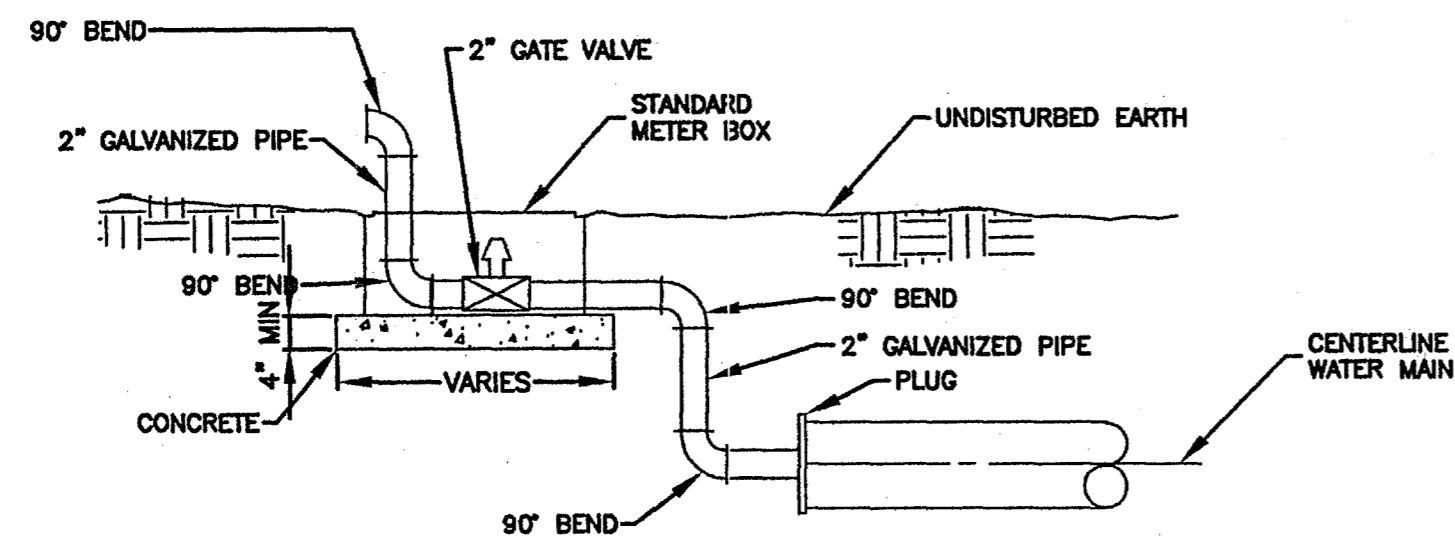


TYPICAL 2" BLOW-OFF DETAIL
SCALE: N.T.S.

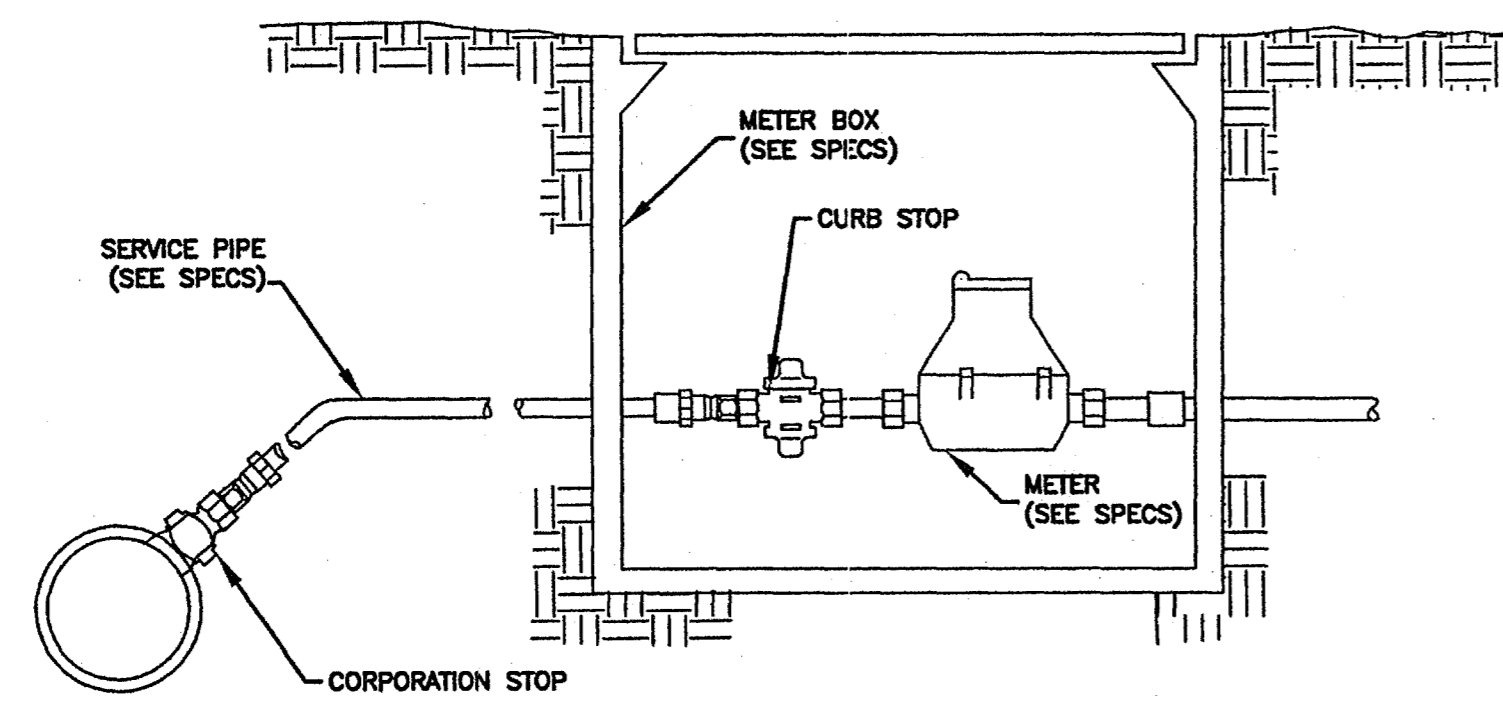

TYPICAL SERVICE ASSEMBLY
SCALE: N.T.S.

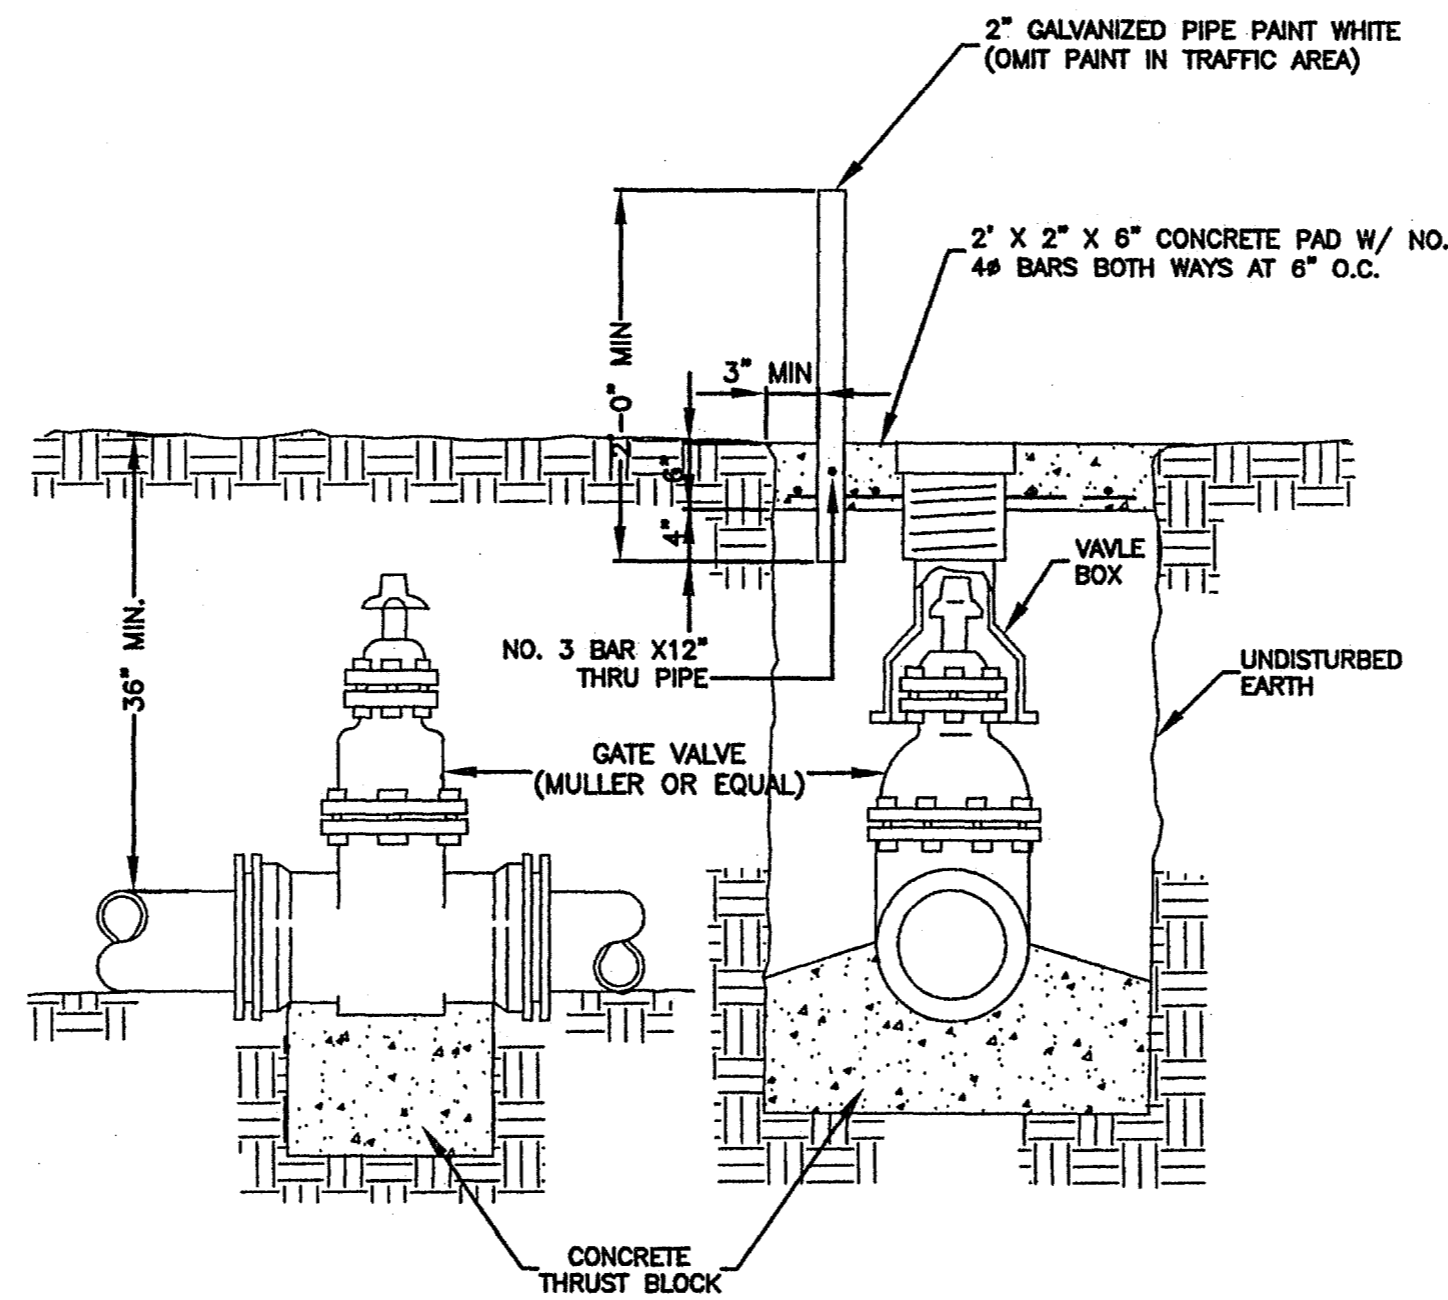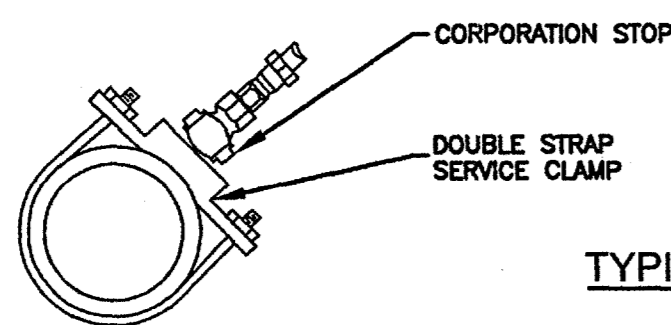


TYPICAL VALVE & BOX
SCALE: N.T.S.

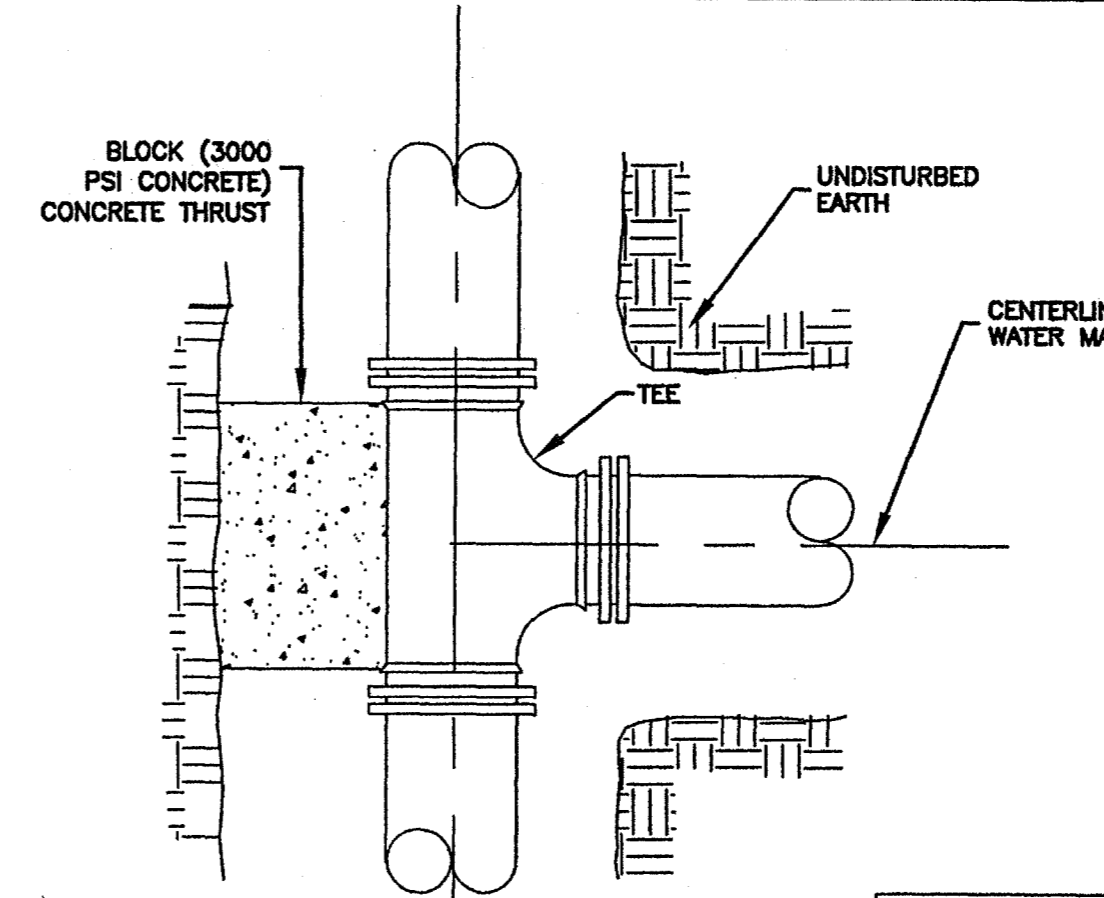


PLAN

PIPE SIZE	1/4 BEND	1/8E BEND	PLUGS & TEES
4-6	3	3	3
8	3	3	3
10	4	3	3
12	6	3	4
16	11	4	7


NOTE: AREA OF BEARING FACE IN SQUARE FEET

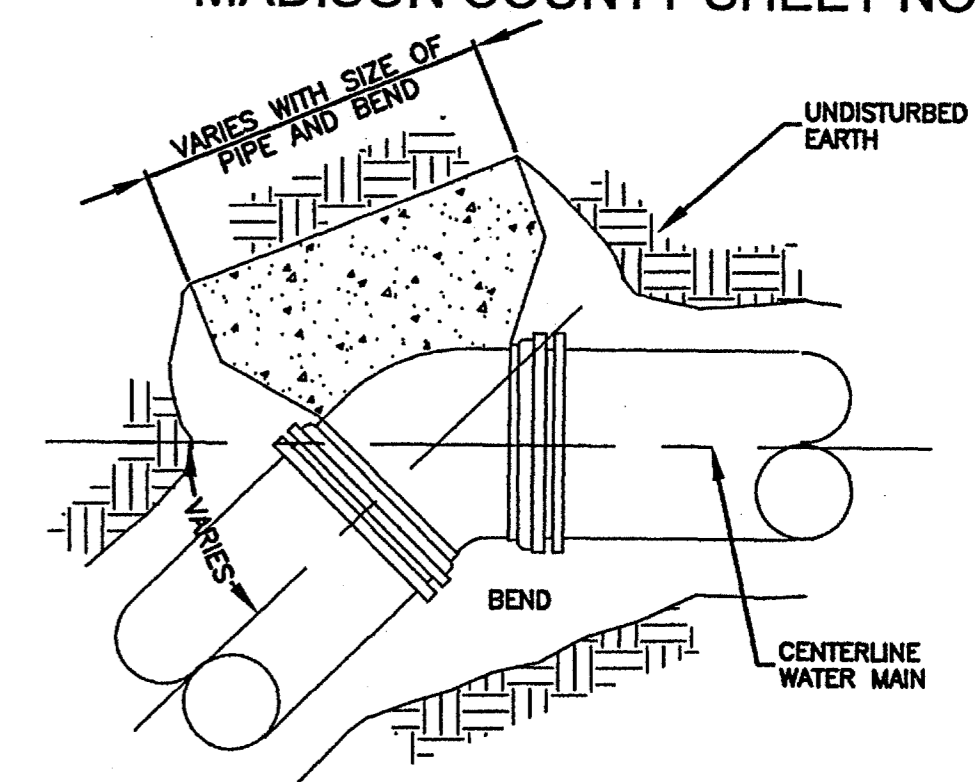

PLAN

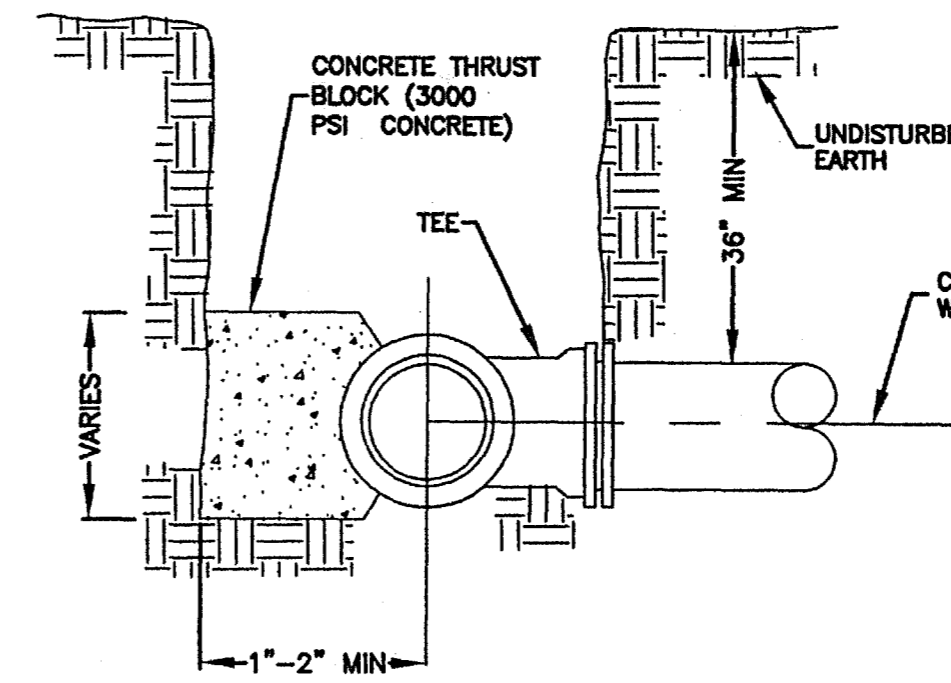


SECTION

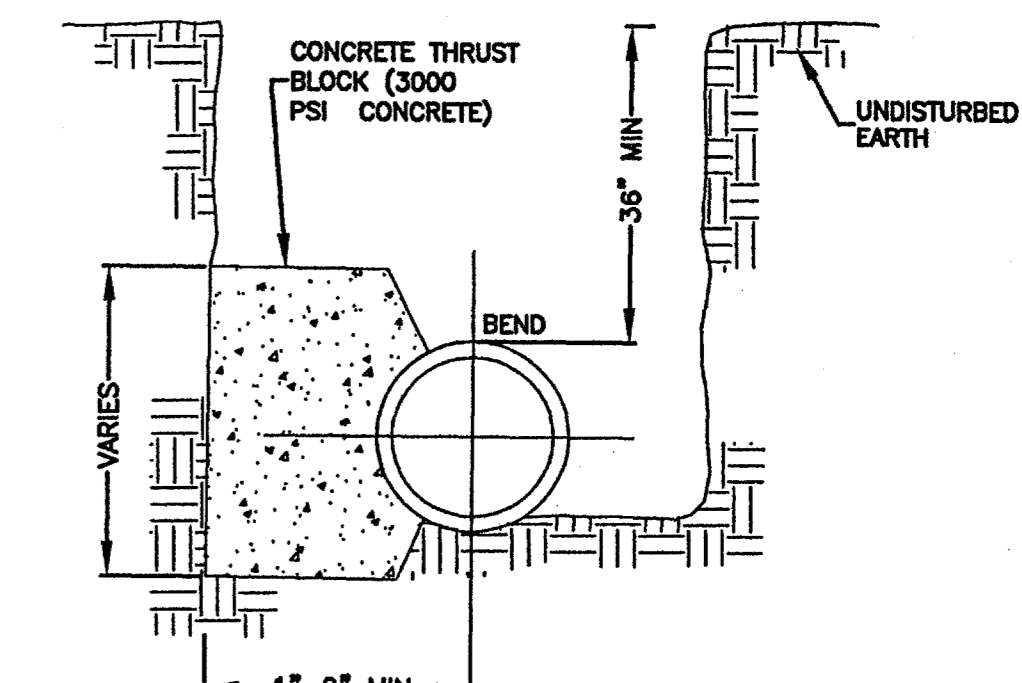


SECTION


BLOCKING DETAILS FOR TEES & BENDS
SCALE: N.T.S.

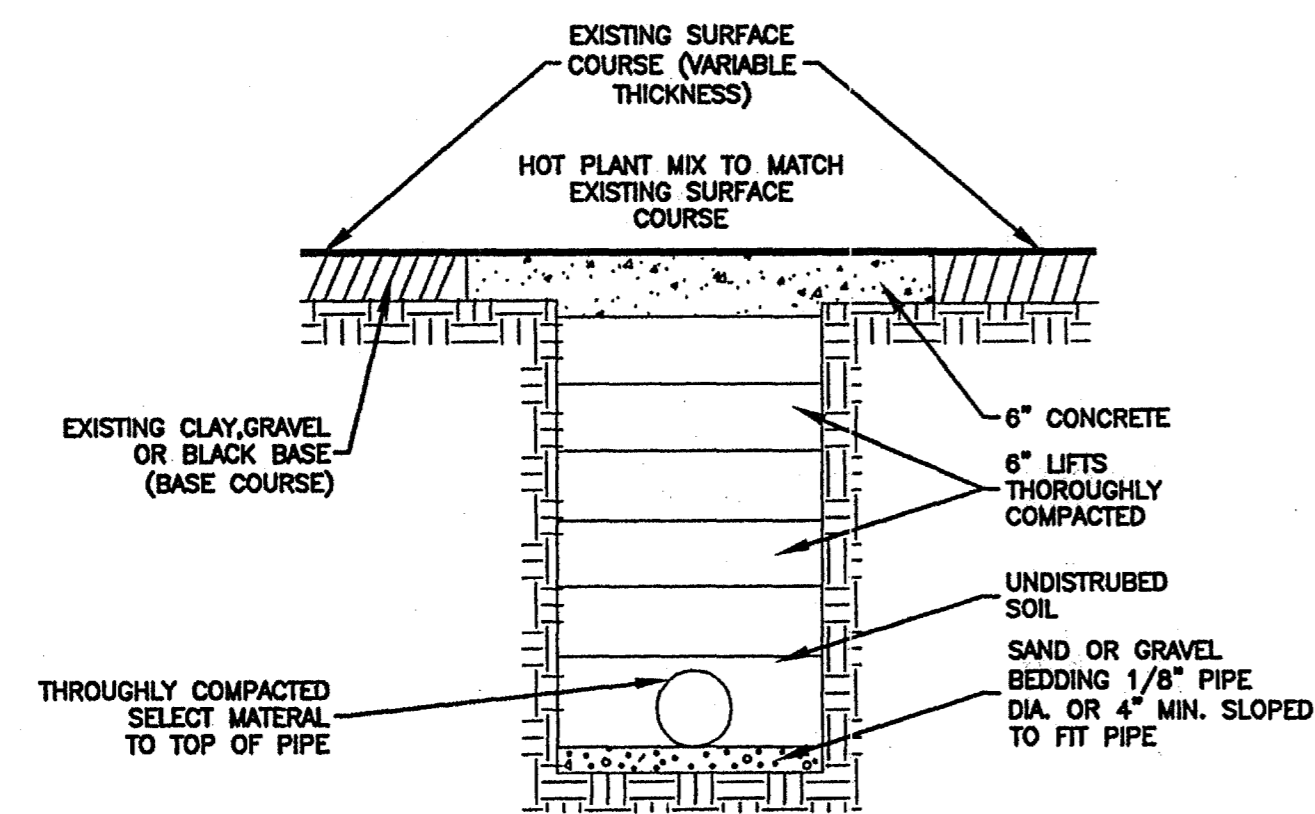

STREET REPAIR OF OPEN CUT
SCALE: N.T.S.

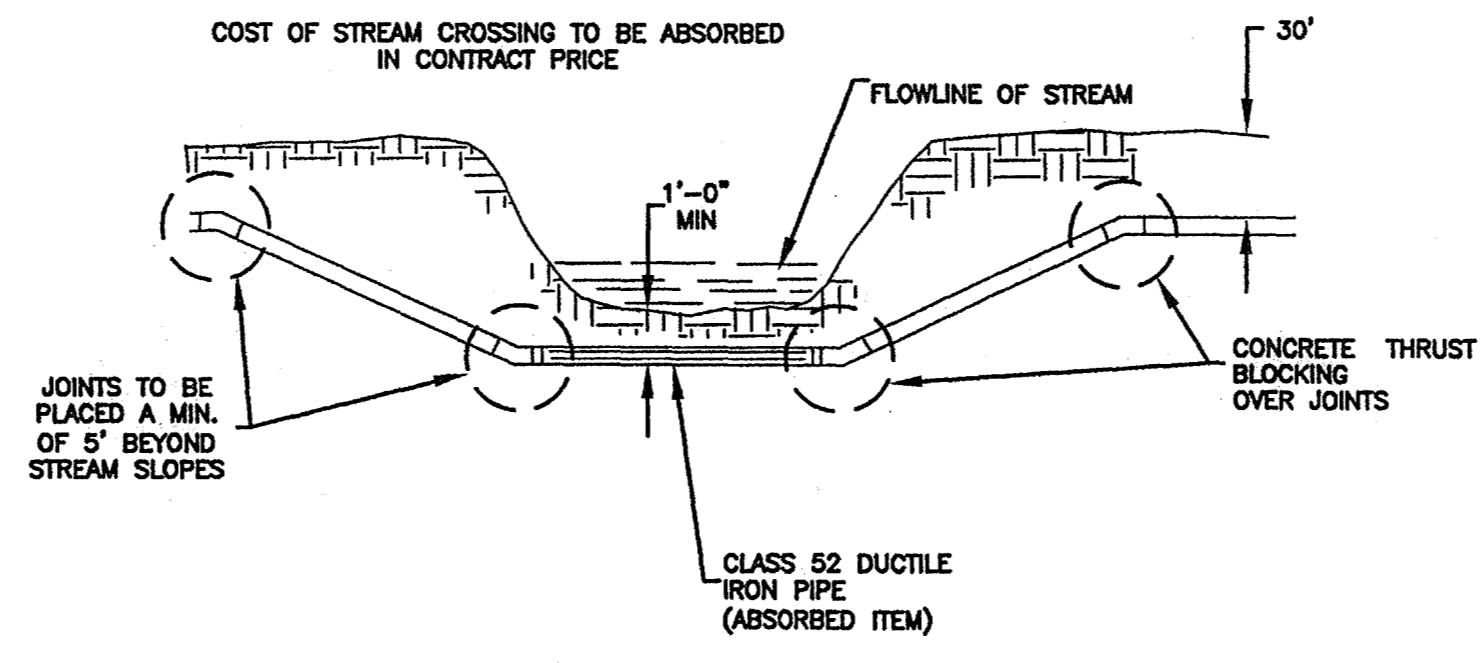


TYPICAL STREAM CROSSING
SCALE: N.T.S.

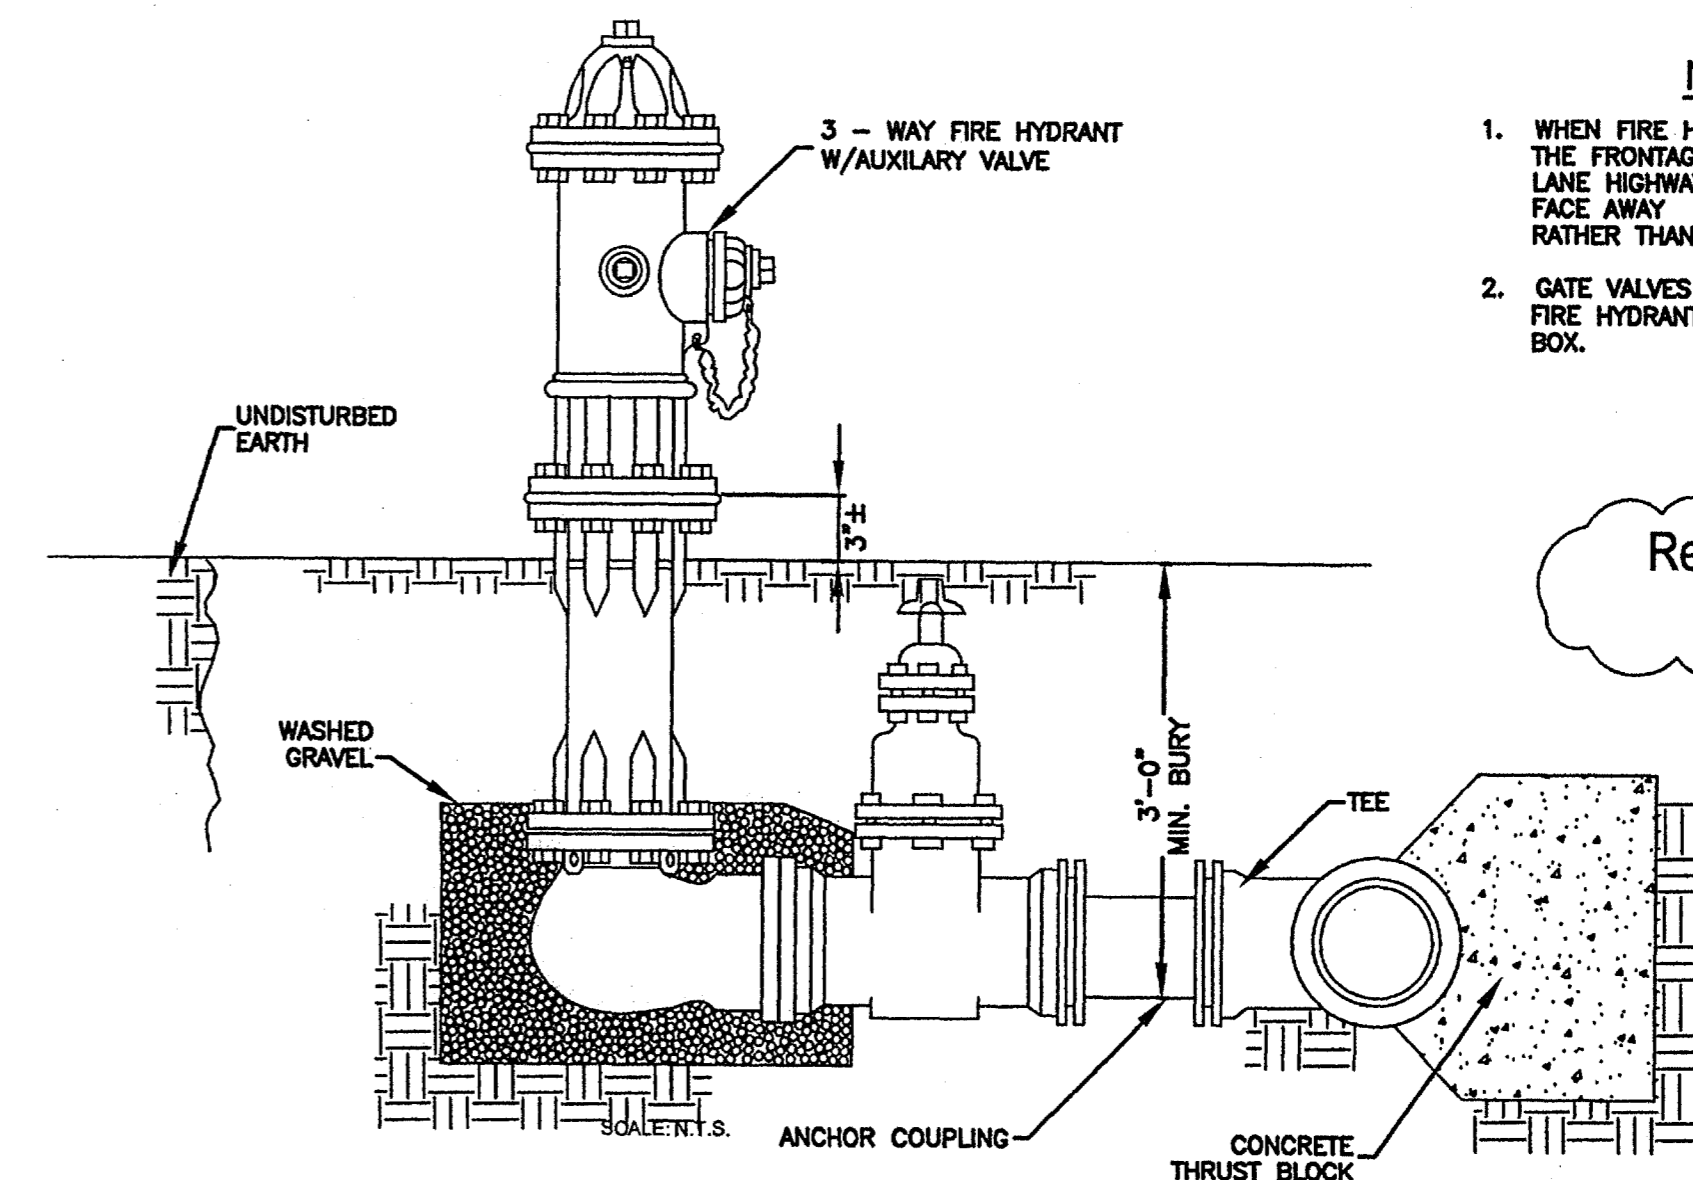

TYPICAL FIRE HYDRANT
SCALE: N.T.S.

- NOTES:
1. WHEN FIRE HYDRANTS ARE PLACED ON THE FRONTAGE OF A DIVIDED OR MULTI-LANE HIGHWAY, THE NOZZLES SHALL FACE AWAY FROM THE HIGHWAY RATHER THAN TOWARD THE HIGHWAY.
 2. GATE VALVES ARE REQUIRED ON ALL FIRE HYDRANT LATERALS, WITH VALVE BOX.

Record Drawings
1-8-08

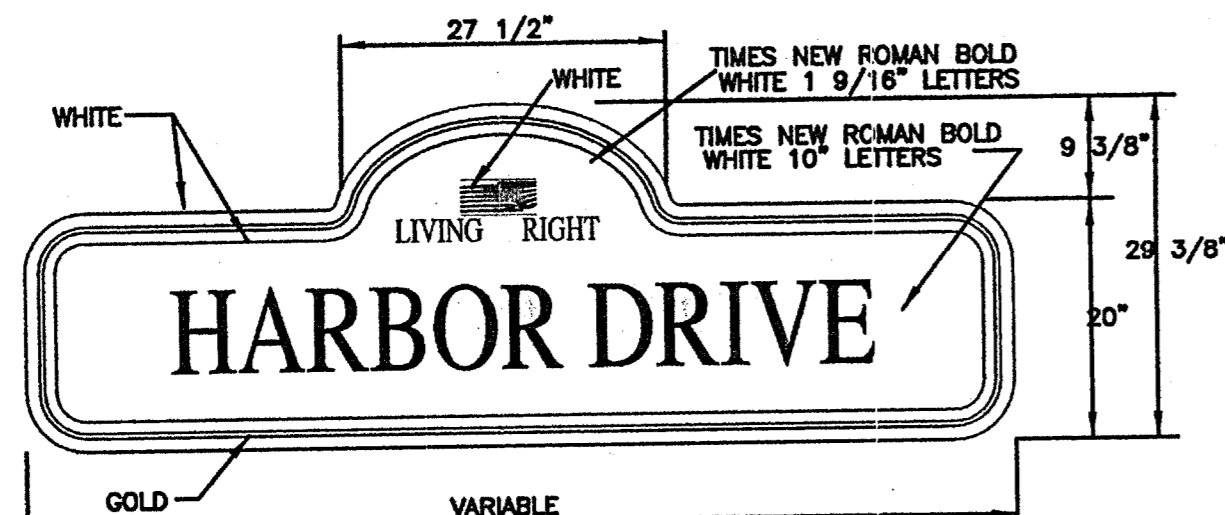


STREET NAME SIGNS (TYPICAL)
SCALE: N.T.S.


THE SIGN BLANK SHALL BE A SINGLE PIECE OF SMOOTH CUT ALUMINUM FROM ASTM B-209 ALLOY 5052-H38, 5154-H38 OR 6061-T6 SHEETS IN 0.125 INCH THICKNESS. THE ALUMINUM SHALL BE DEGRADED AND LIGHTLY ACID ETCHED BEFORE THE SIGN SHEETING IS APPLIED. THE SIGN SHEETING SHALL BE APPLIED TO THE PANELS IN ACCORDANCE WITH THE RECOMMENDATIONS OF THE RETROFLECTIVE SHEETING MANUFACTURER.

THE DECORATIVE STREET NAME SIGNS SHALL BE FINISHED ON BOTH SIDES. THE SIGN SHEETING MATERIAL SHALL BE REFLECTIVE ENCLOSED LINES (ENGINEER GRADE) CONFORMING TO FEDERAL SPECIFICATIONS FP92. THE COLORS OF THE DECORATIVE STREET NAME SIGNS SHALL MATCH THE EXISTING DECORATIVE STREET NAME SIGNS.
NOTE: COST OF STREET NAME SIGNS TO BE ABSORBED


- NOTES:
1. WIRE ENTRANCE TO MAST ARM WILL BE FIELD DRILLED TO CORRESPOND TO THE LOCATION OF THE SIGNAL HEADS WHEN ALIGNED IN THE FIELD.
 2. ALL SIGNAL HEADS TO BE YELLOW IN COLOR.
 3. RED SECTION INDICATIONS TO BE APPROXIMATELY SAME HEIGHT.
 4. EXACT DIMENSIONS AND LOCATIONS OF ANCHOR BOLTS TO BE SUPPLIED BY THE POLE MANUFACTURER.
 5. DESIGN WIND LOAD FOR POLES AND MAST ARMS IS 70 MPH.
 6. #8 COPPER GROUND WIRE INSIDE POLE AND MAST ARM TO BE COST ABSORBED.

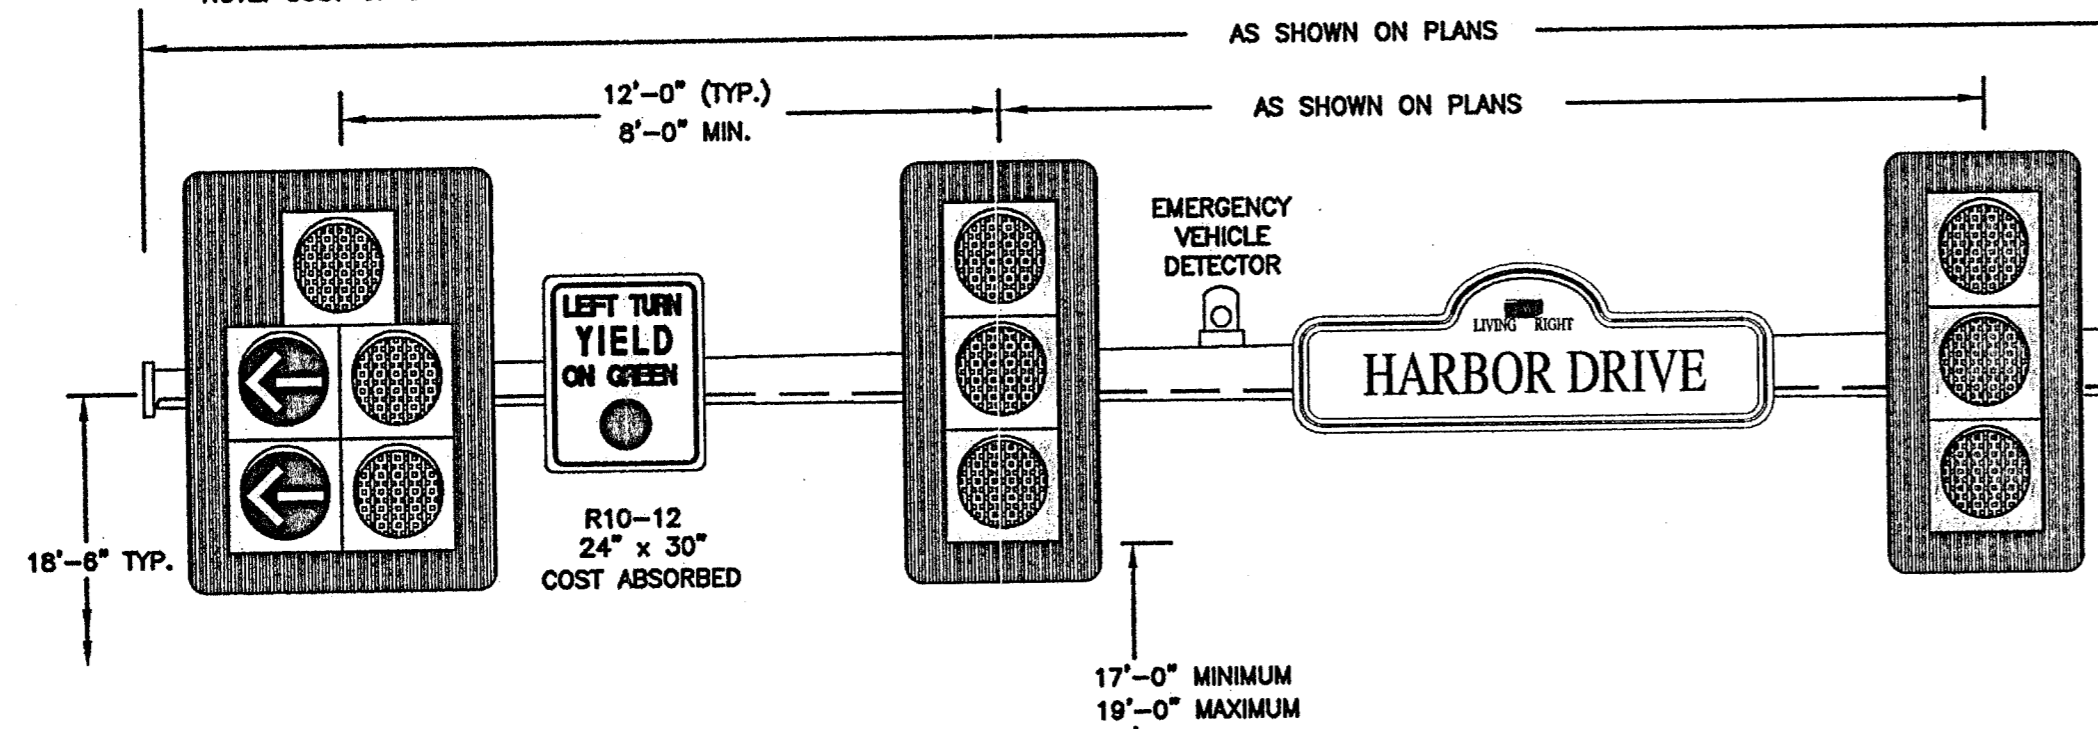


- NOTES:
- LUMINAIRE AND PHOTOELECTRIC CONTROL
250 WATT H.P.S.
LIGHT FIXTURE WITH 250 WATT LAMPS AND PHOTO CELL TO BE PROVIDED BY THE CONTRACTOR. (COST ABSORBED)

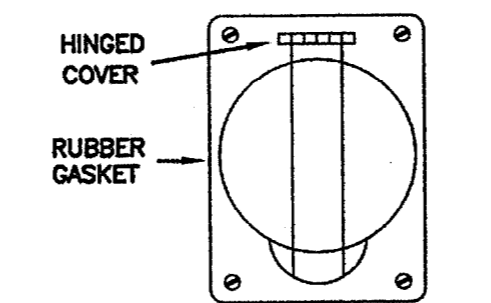


OUTLET BOX WITH SINGLE 15 AMP - 125 VOLT POLARIZED RECEPTACLE (GROUNDING TYPE)
SCALE: N.T.S.

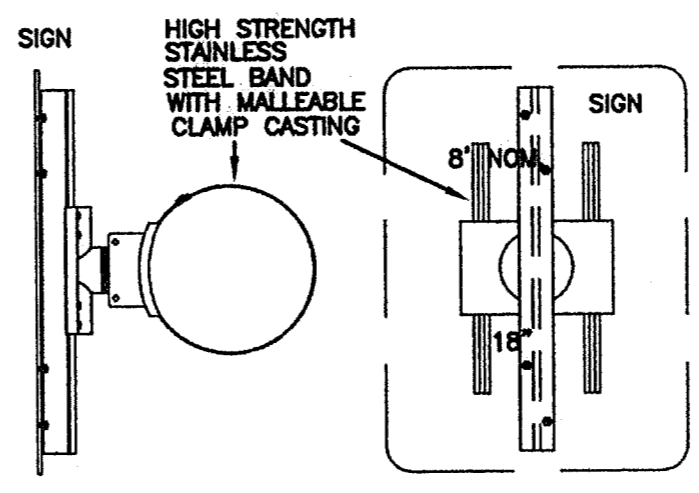


MAST ARM SIGN BRACKET (TYPICAL)
SCALE: N.T.S.

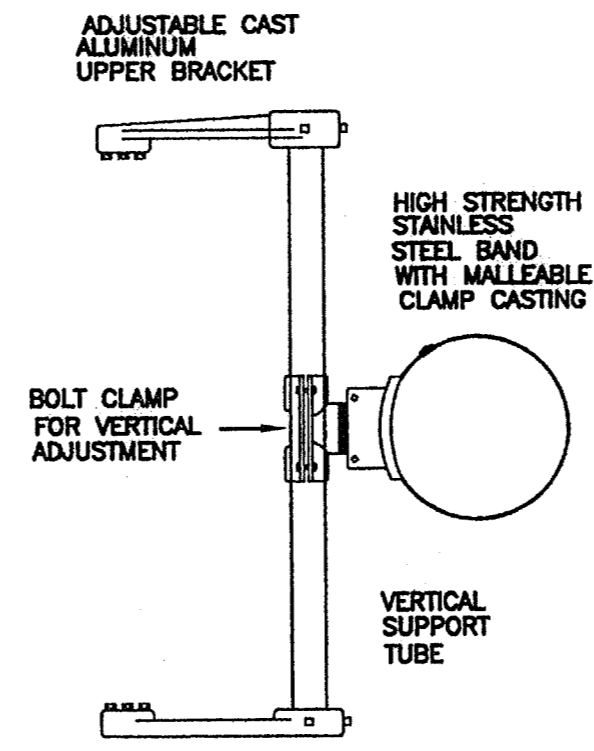


SIGNAL MOUNTING BRACKET (TYPICAL)
SCALE: N.T.S.

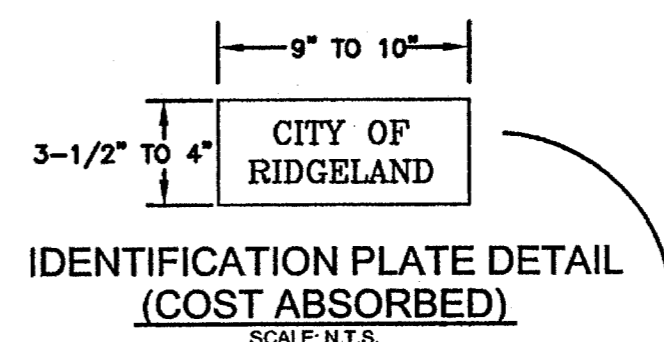


IDENTIFICATION PLATE DETAIL (COST ABSORBED)
SCALE: N.T.S.

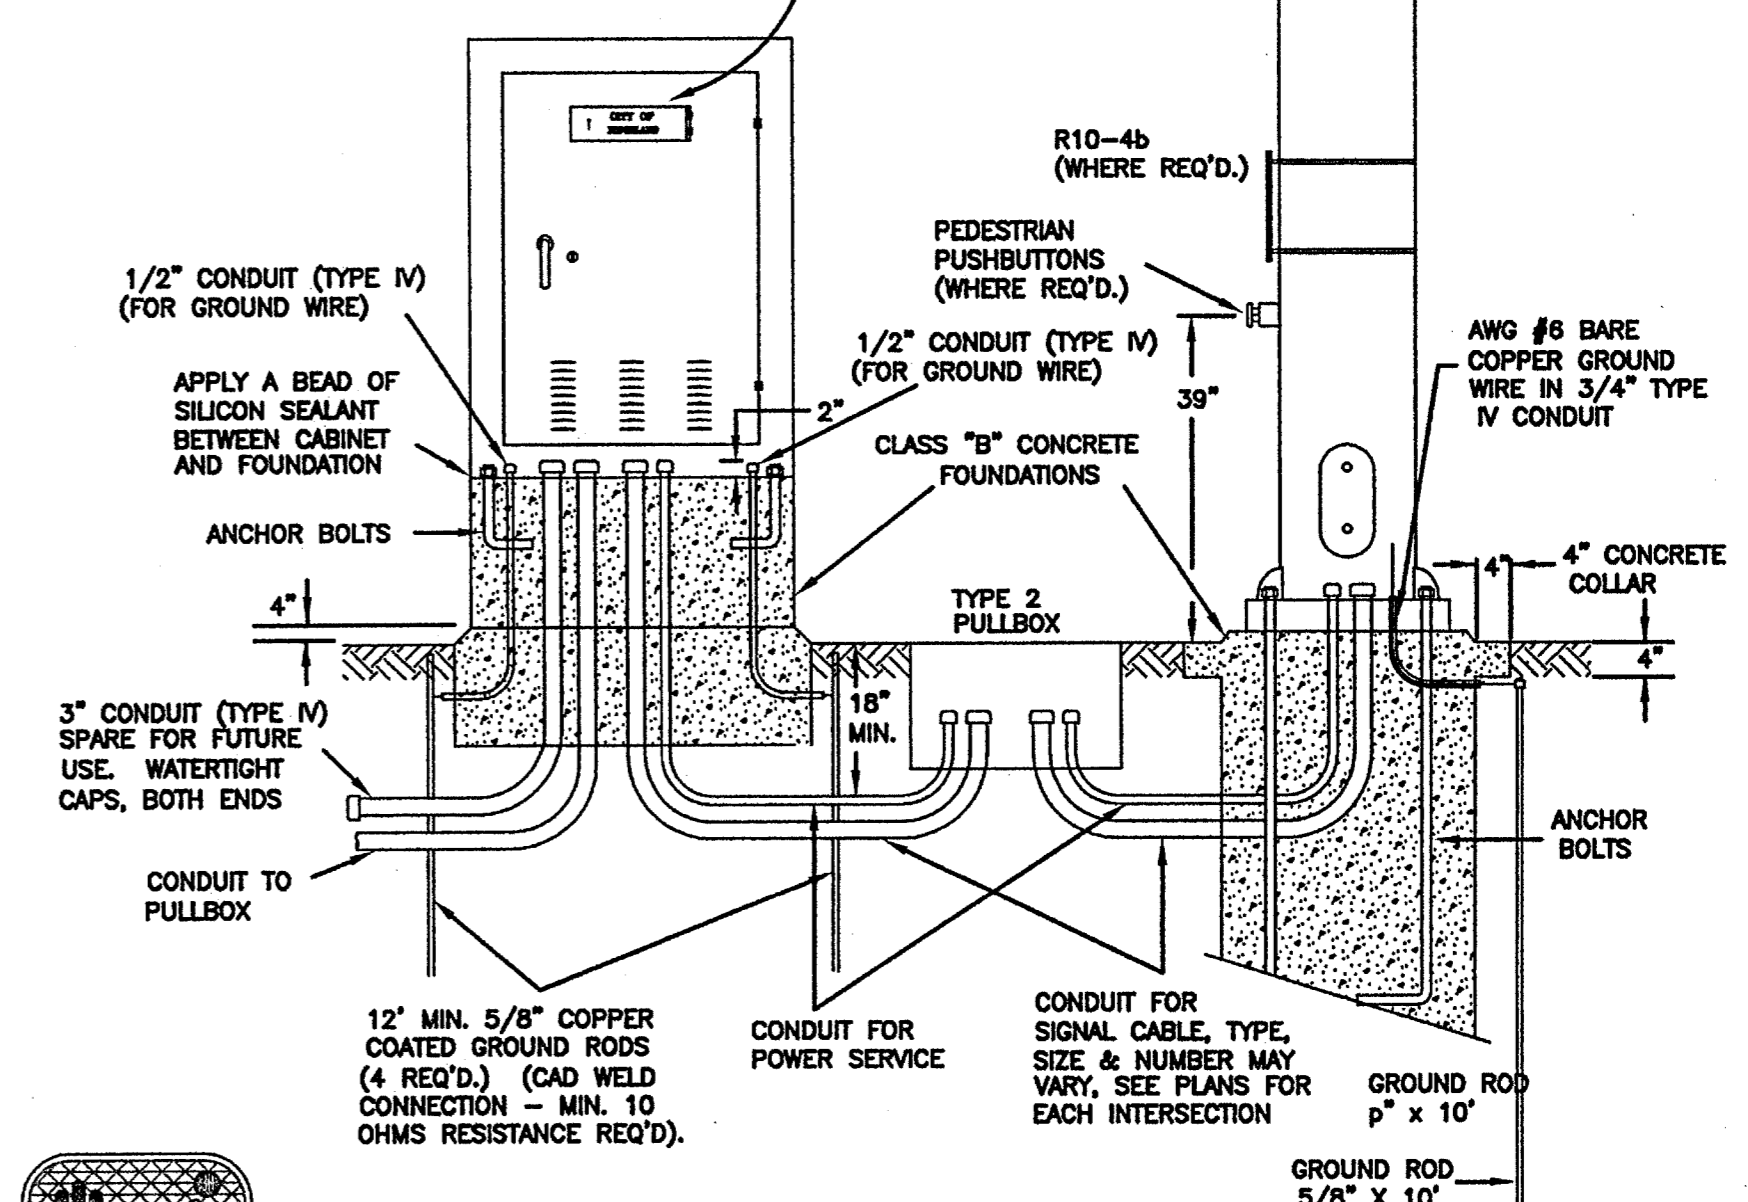


FRONT VIEW
SCALE: N.T.S.

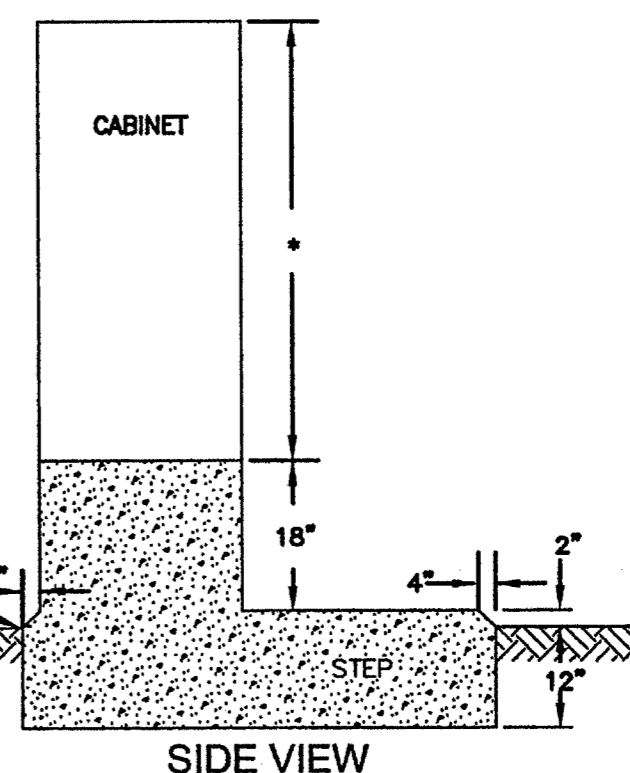


SIDE VIEW
SCALE: N.T.S.

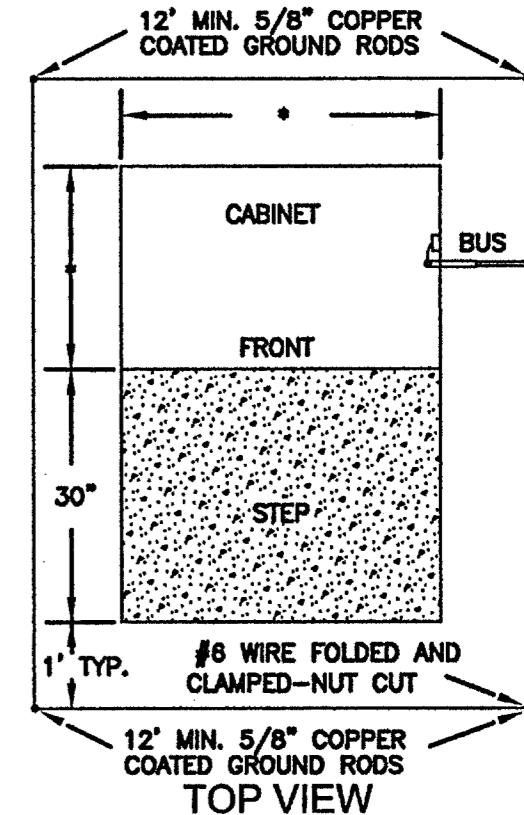


TOP VIEW
SCALE: N.T.S.

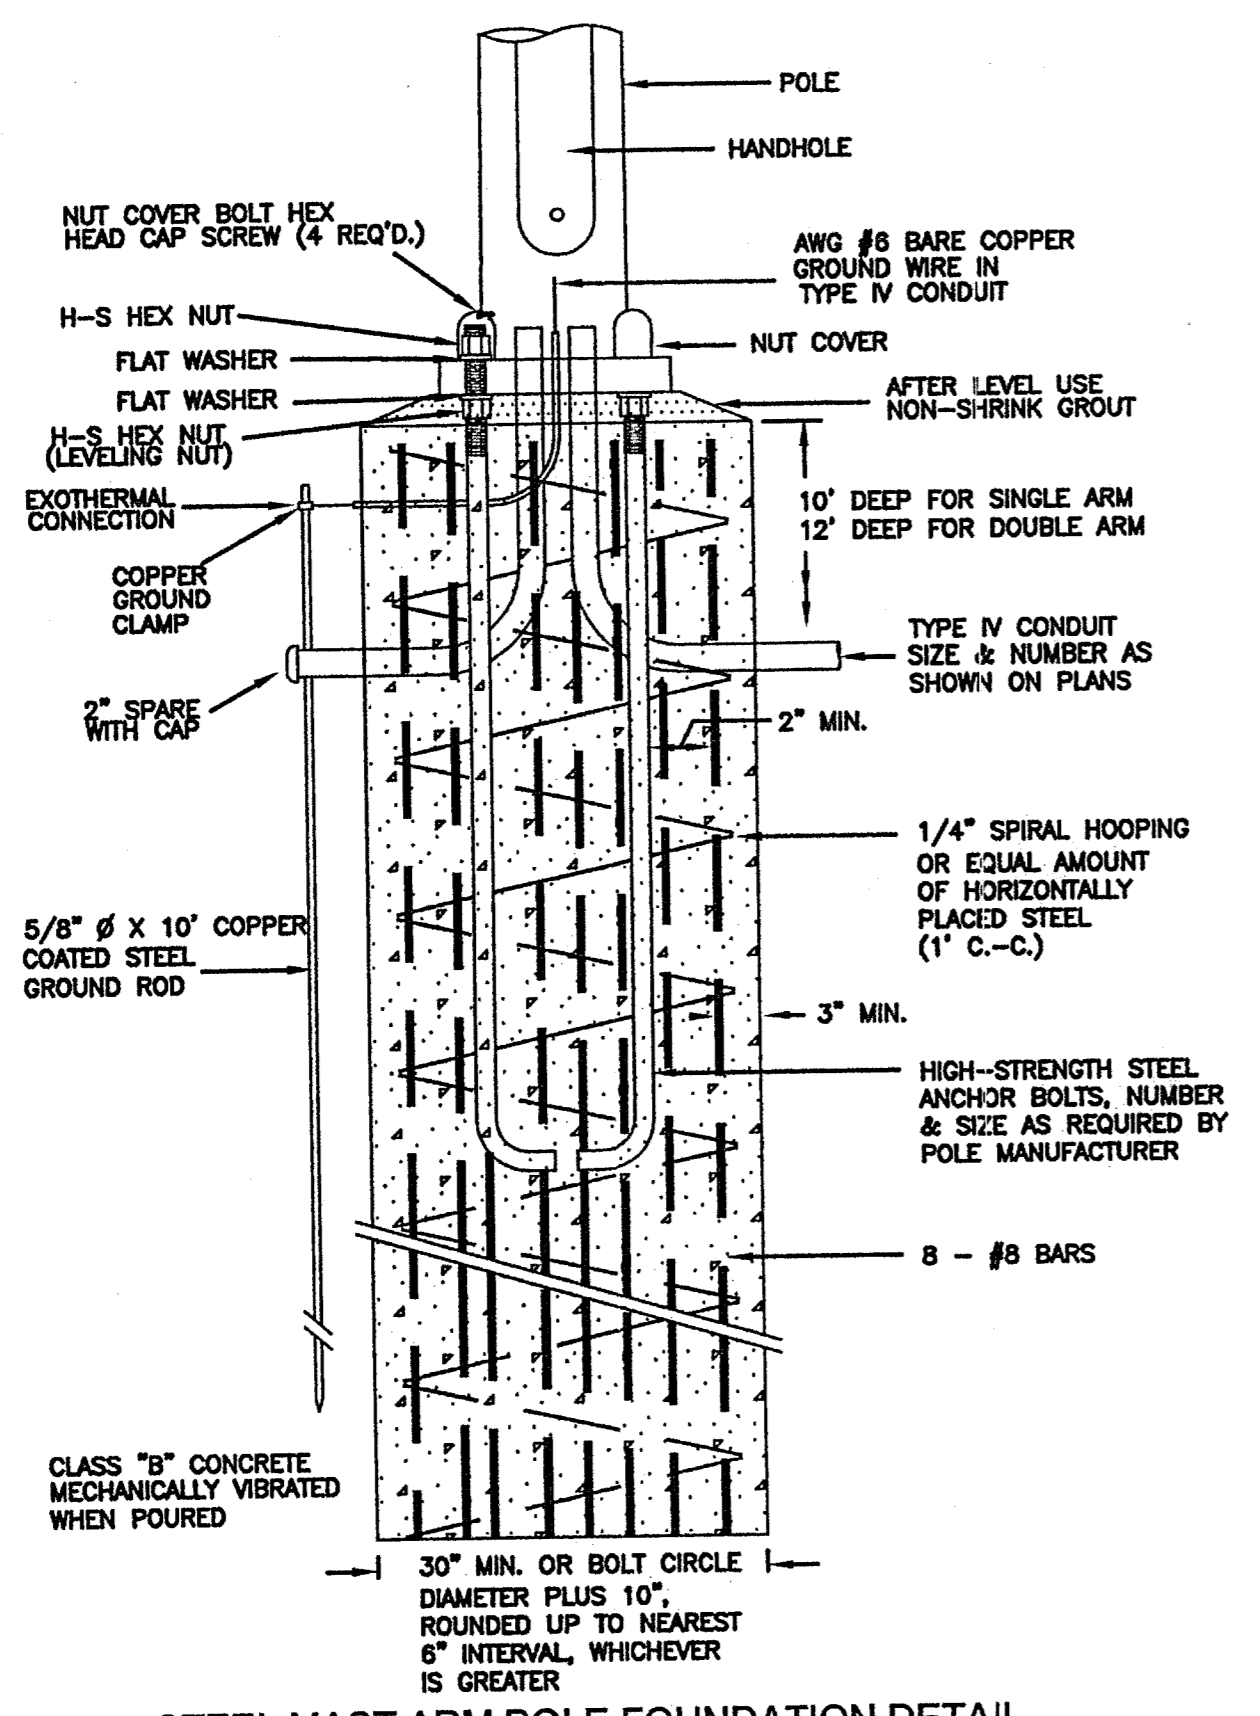


STEEL MAST ARM POLE FOUNDATION DETAIL
SCALE: N.T.S.

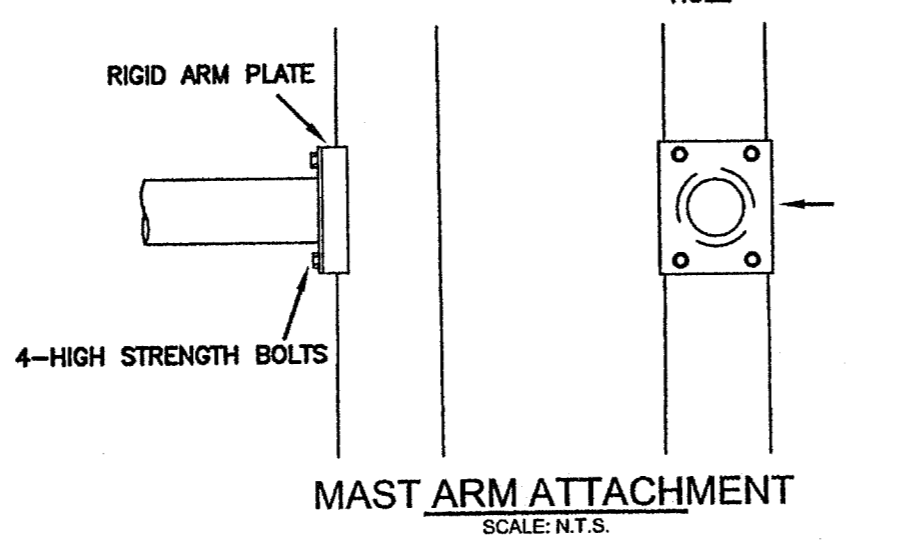


MAST ARM ATTACHMENT
SCALE: N.T.S.

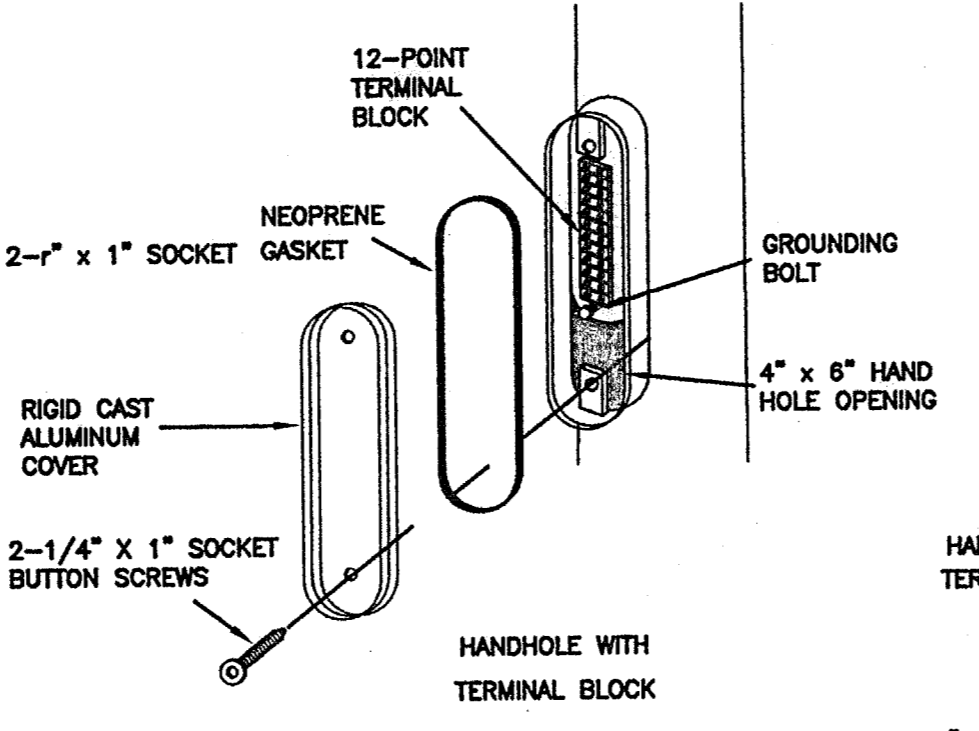

HANDHOLE WITH TERMINAL BLOCK

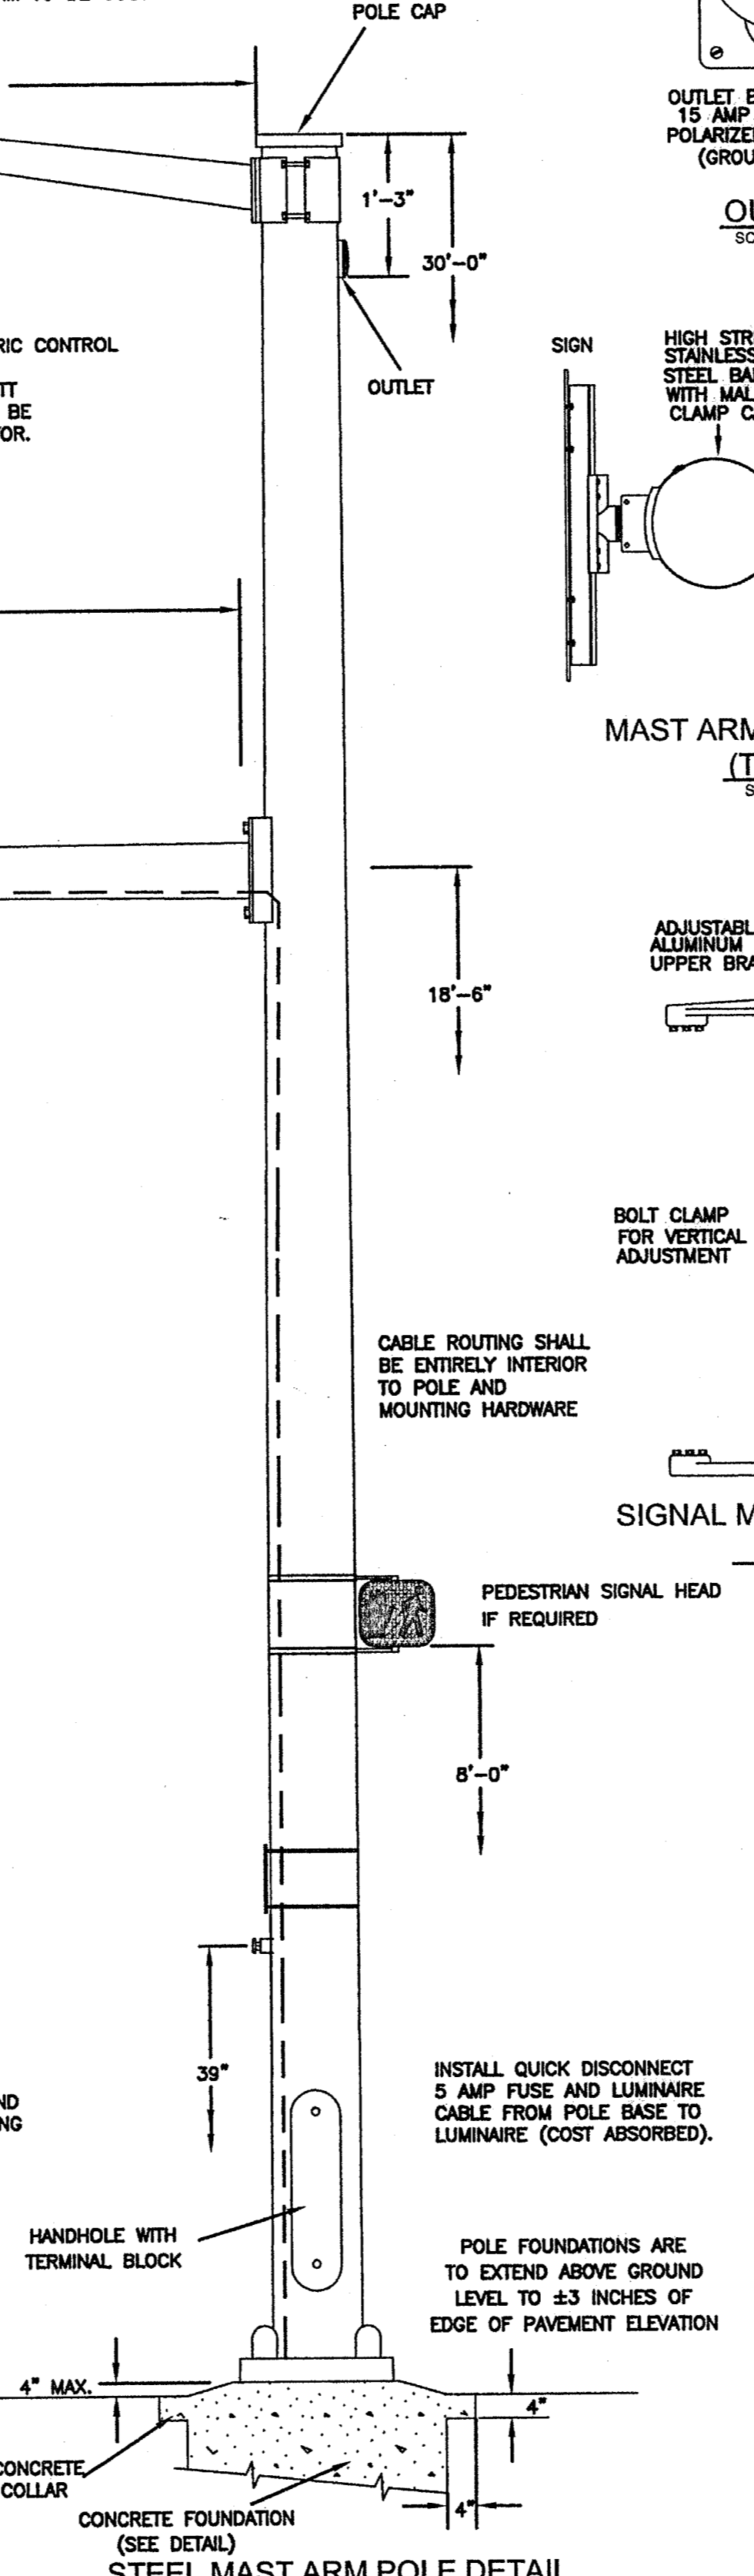

STEEL MAST ARM POLE DETAIL
SCALE: N.T.S.

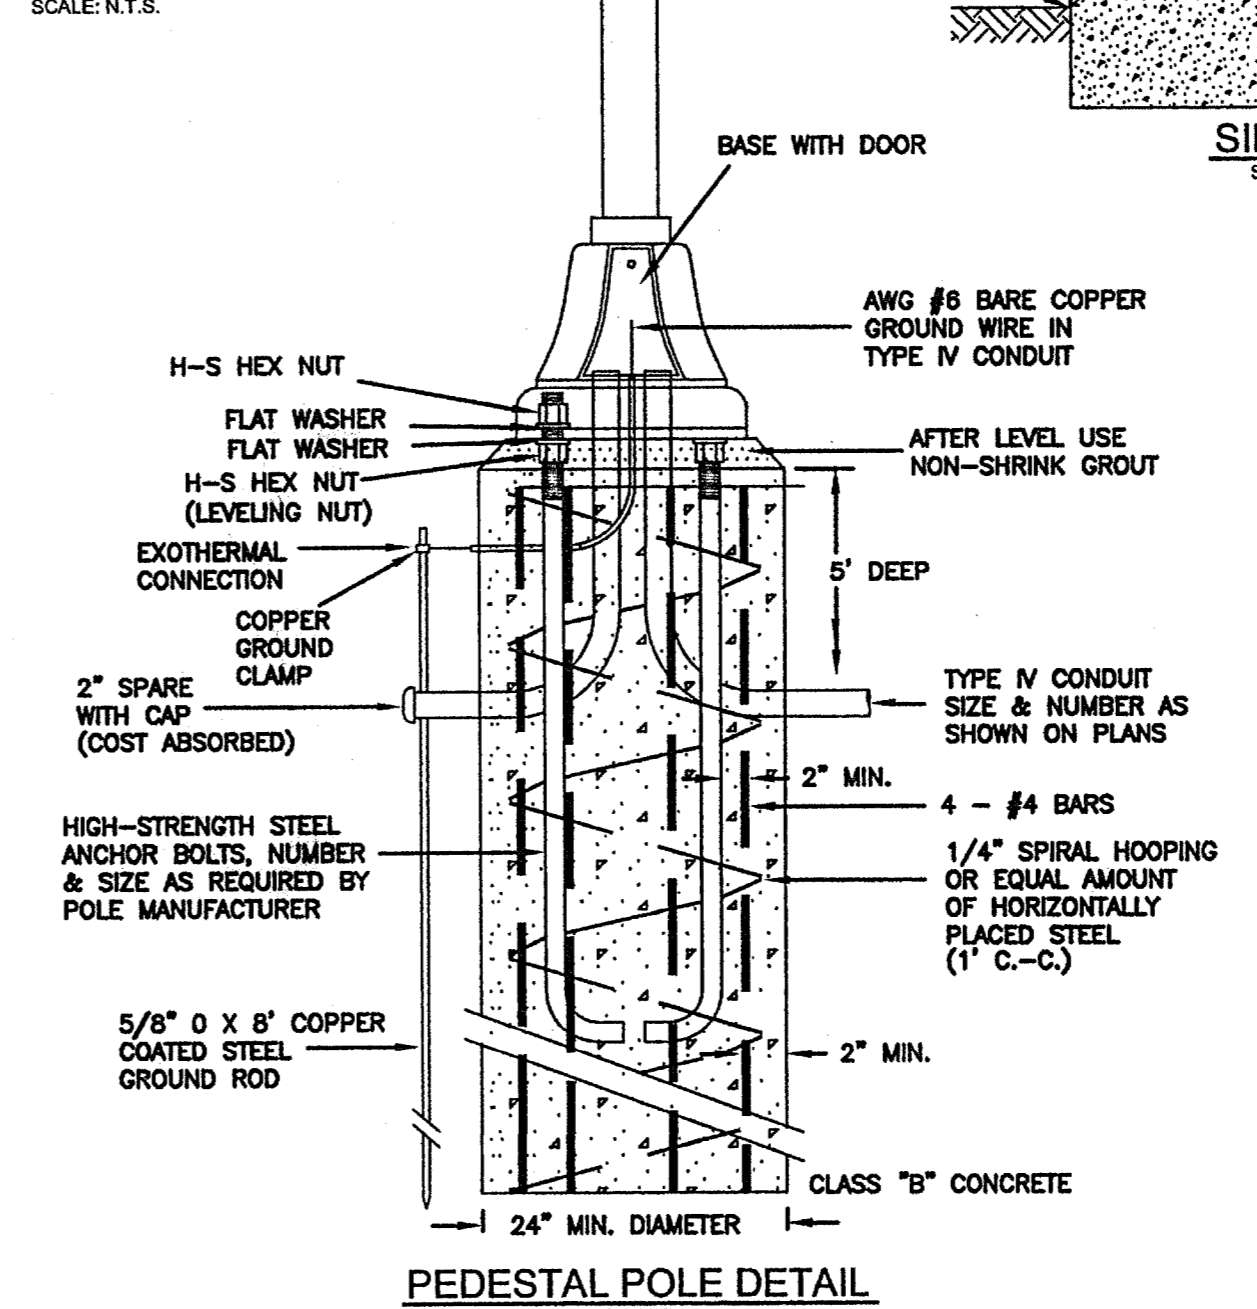

PEDESTAL POLE DETAIL
SCALE: N.T.S.

CONTROLLER BASE DETAIL


- CABINET DIMENSIONS TO MEET SIGNAL CABINET MANUFACTURER'S SPECIFICATIONS.
NOMINAL DIMENSIONS: 8-PHASE - D=26", W=44", H=55"
4-PHASE - D=17", W=30", H=52"

GENERAL FOUNDATION NOTES


1. EXACT DIMENSIONS AND LOCATIONS OF ANCHOR BOLTS TO BE SUPPLIED BY THE MANUFACTURER. ANY FOUNDATION FAILING TO MEET THESE DIMENSIONS WILL BE REJECTED.
2. TYPE IV CONDUIT TO BE RUN INTERNALLY FOR CONCRETE AND STEEL POLES; TYPE I CONDUIT RISERS REQUIRED FOR WOOD POLES.
3. DESIGN WIND LOAD FOR POLES SHALL BE 70 MPH.
4. FOUNDATIONS TO BE CLASS "B" CONCRETE, MECHANICALLY VIBRATED WHEN POURING.
5. MINIMUM STEEL POLE FOUNDATION SHALL BE 30" DIA. X 10' DEEP.
6. #8 COPPER GROUND WIRE AND 5/8" DIA. COPPER GROUND ROD REQ'D. FOR ALL POLE FOUNDATIONS. (COST ABSORBED).

Record Drawings
1-8-08

SIGNAL POLE DETAIL SHEET


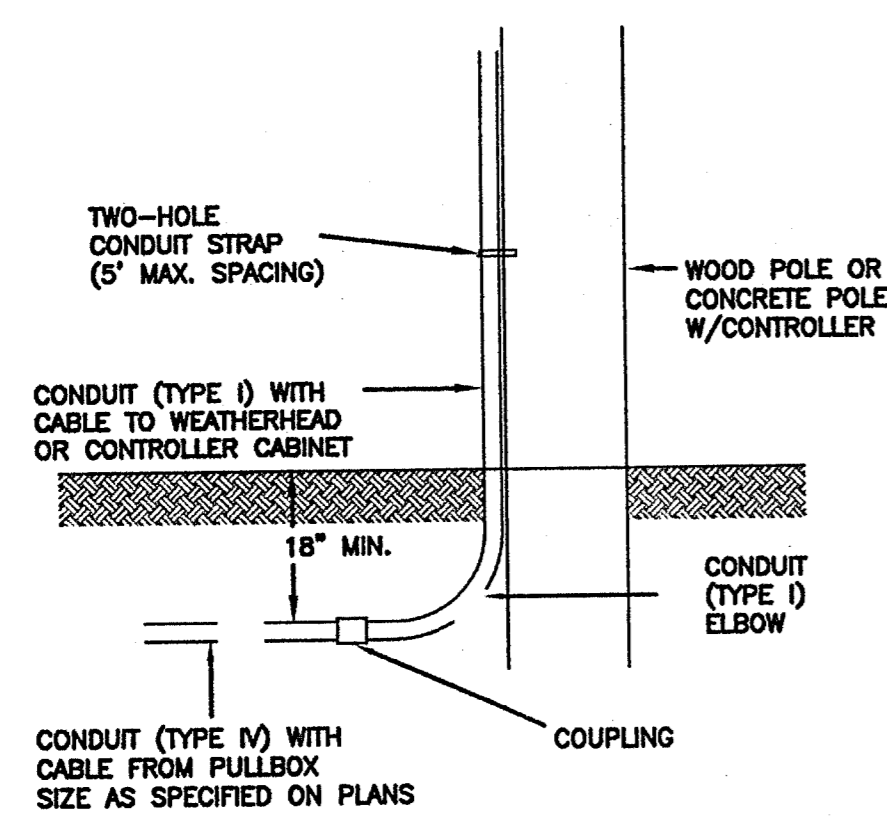


CONDUIT DETAIL AT POLES
SCALE: N.T.S.

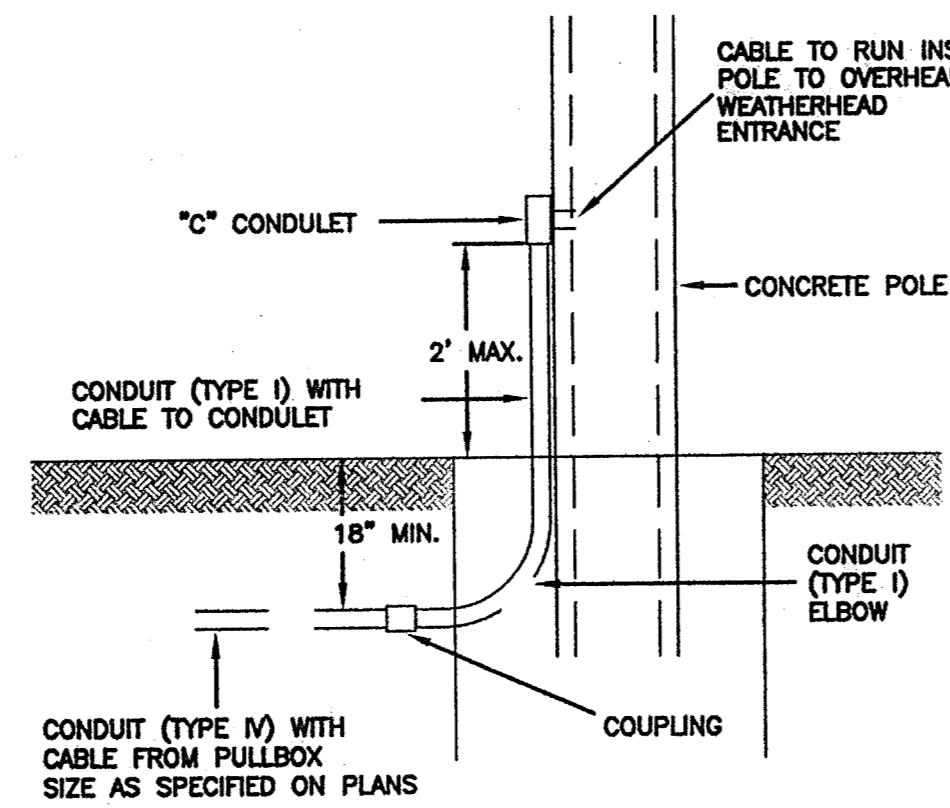


3/4" CONDUIT (TYPE I) REQUIRED ON WOOD POLES.
CABLE TO BE ROUTED INSIDE POLES EXCEPT ON WOOD POLES.

PEDESTRIAN PUSH BUTTON AND SIGN INSTALLATION DETAIL
SCALE: N.T.S.

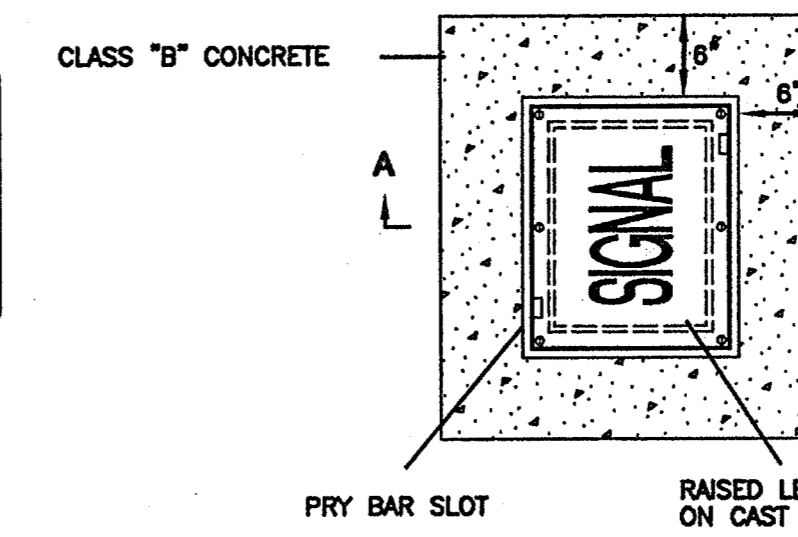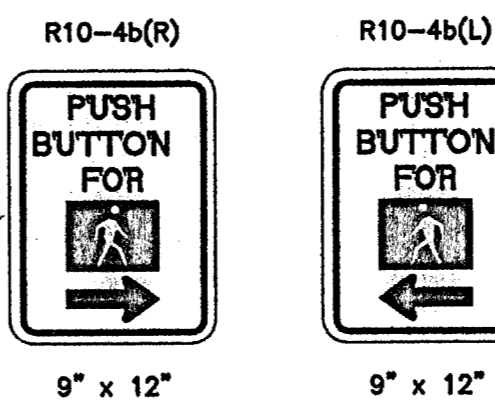


PLAN TWO-PIECE PULLBOX (TYPE 1)
SCALE: N.T.S.

CAST IRON, CAST ALUMINUM, WELDED ALUMINUM, OR APPROVED EQUAL.

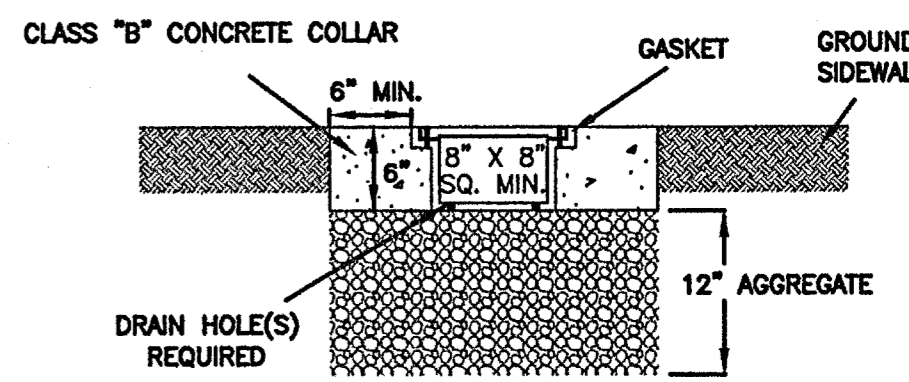


SECTION A-A

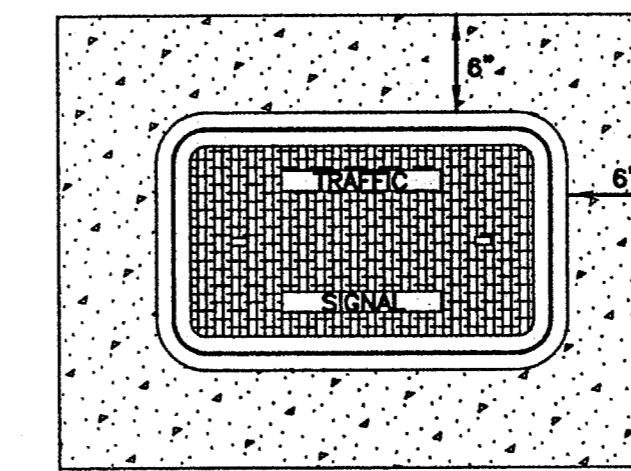


PLAN TWO-PIECE PULLBOX (TYPE 2)
SCALE: N.T.S.


PRECAST CLASS "B" CONCRETE, HIGH DENSITY POLYETHYLENE, COMPOSOLITE, OR APPROVED EQUAL.

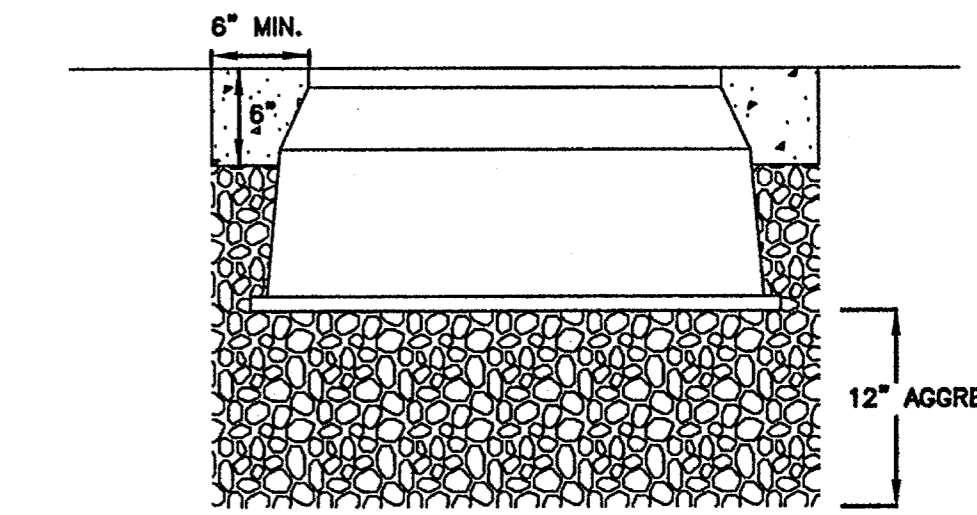


SECTION B-B

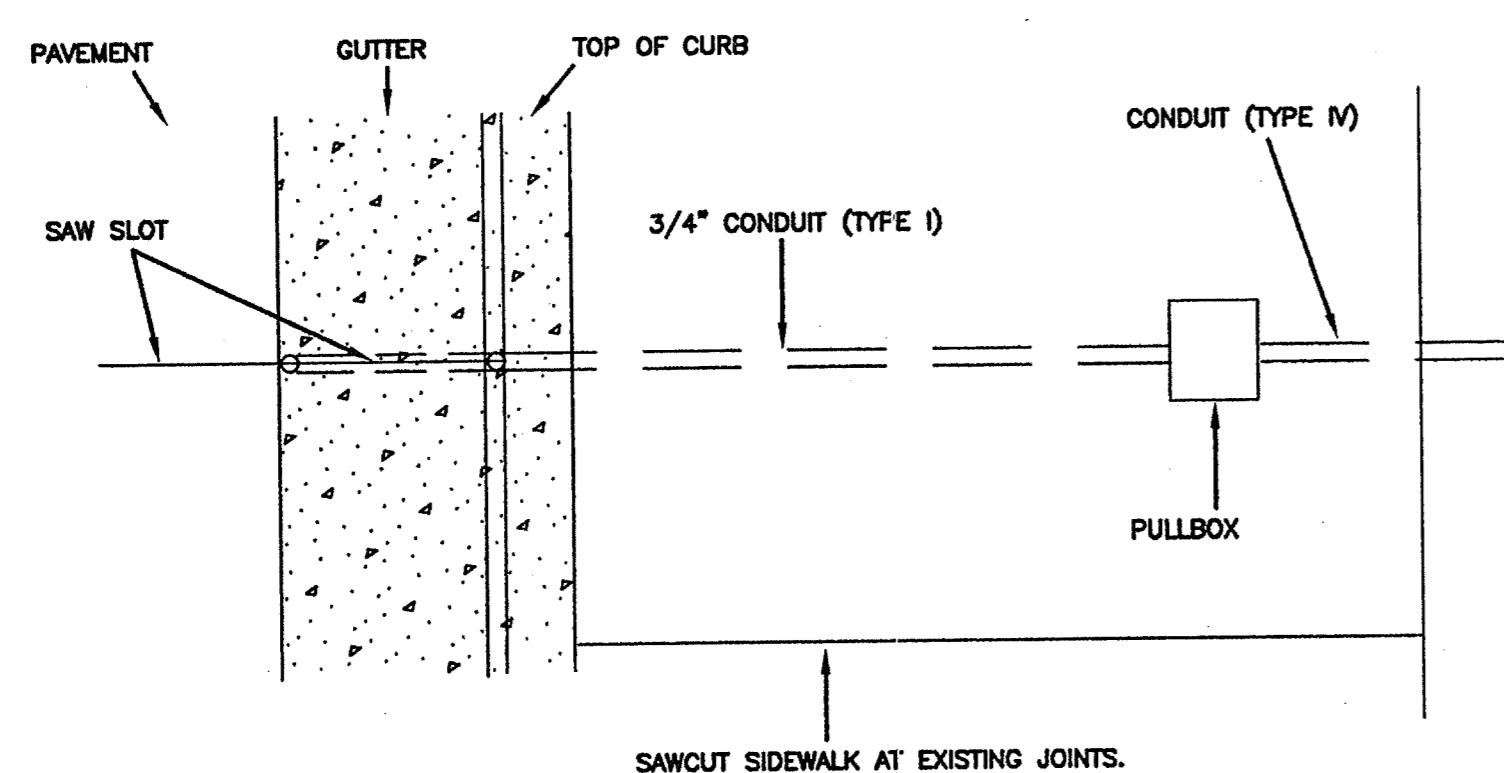


PLAN VIEW - LOOP LEAD-IN CONDUIT
SCALE: N.T.S.

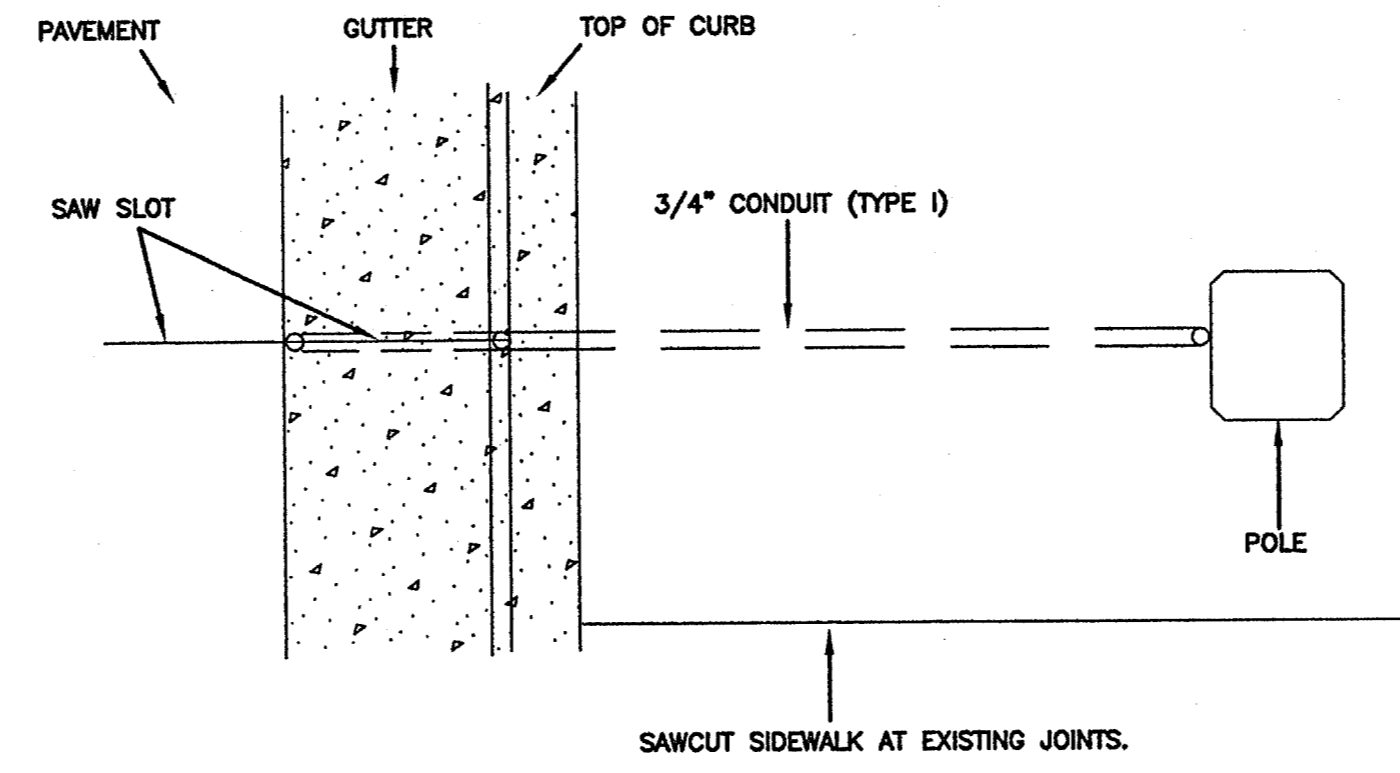


PLAN VIEW - LOOP LEAD-IN CONDUIT
SCALE: N.T.S.

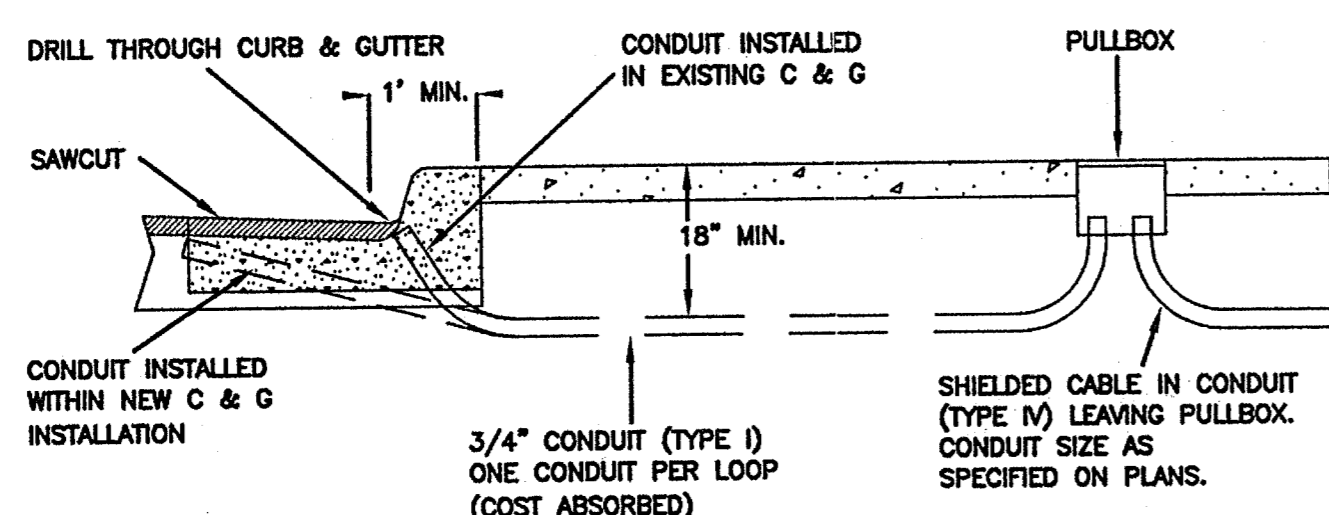


TYPICAL SECTION IN GUTTER AND SIDEWALK
SCALE: N.T.S.

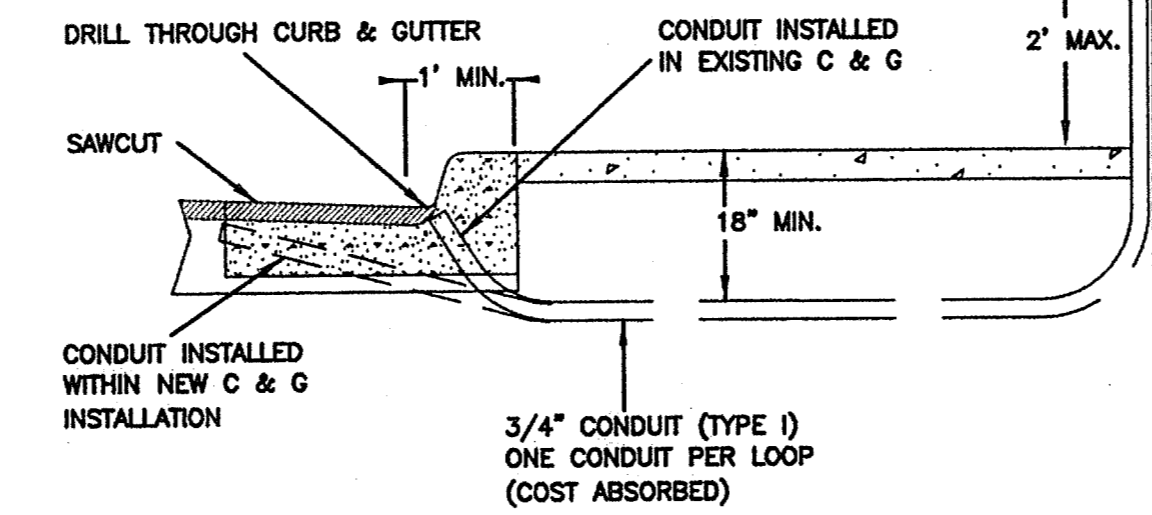


TYPICAL SECTION IN GUTTER AND SIDEWALK
SCALE: N.T.S.

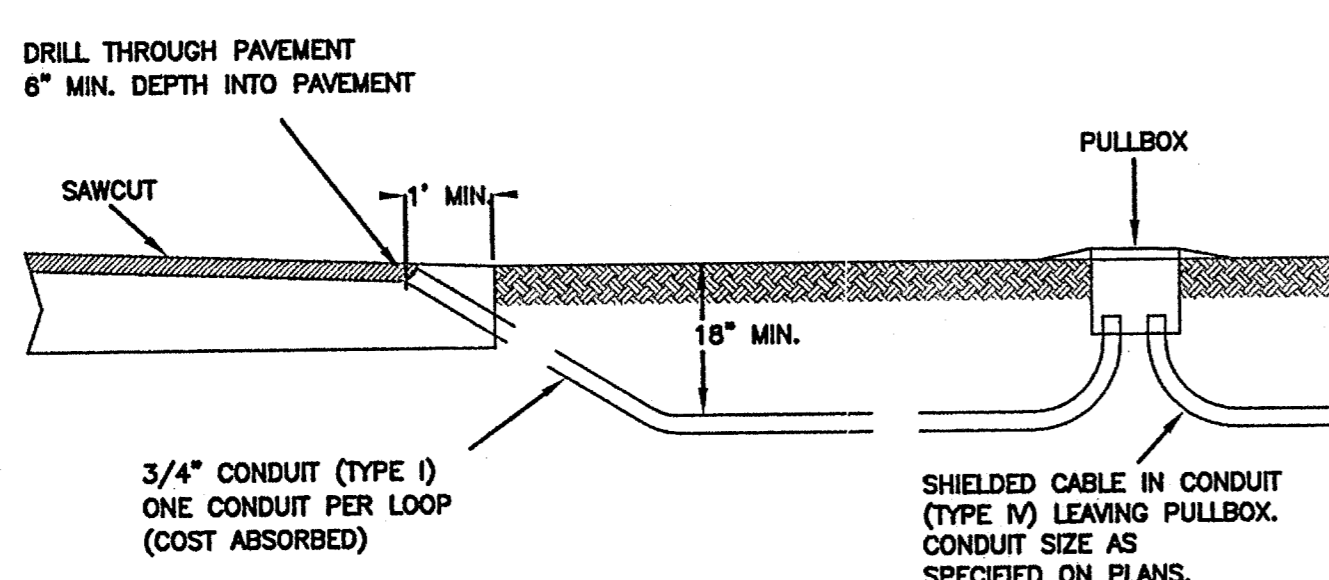

TYPICAL SECTION IN EARTH
SCALE: N.T.S.

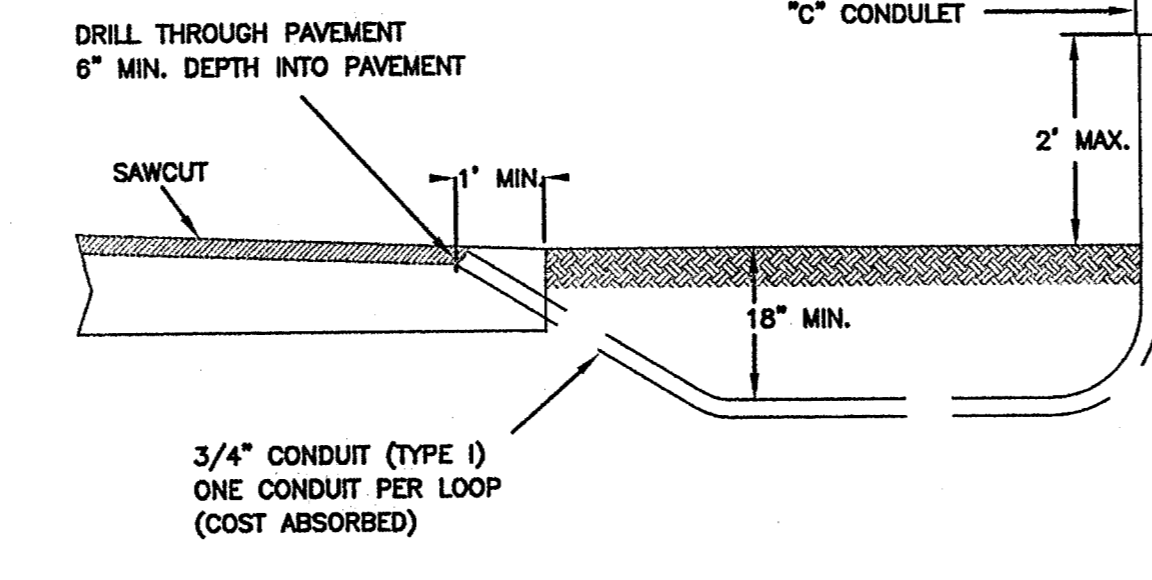


TYPICAL SECTION IN EARTH
SCALE: N.T.S.

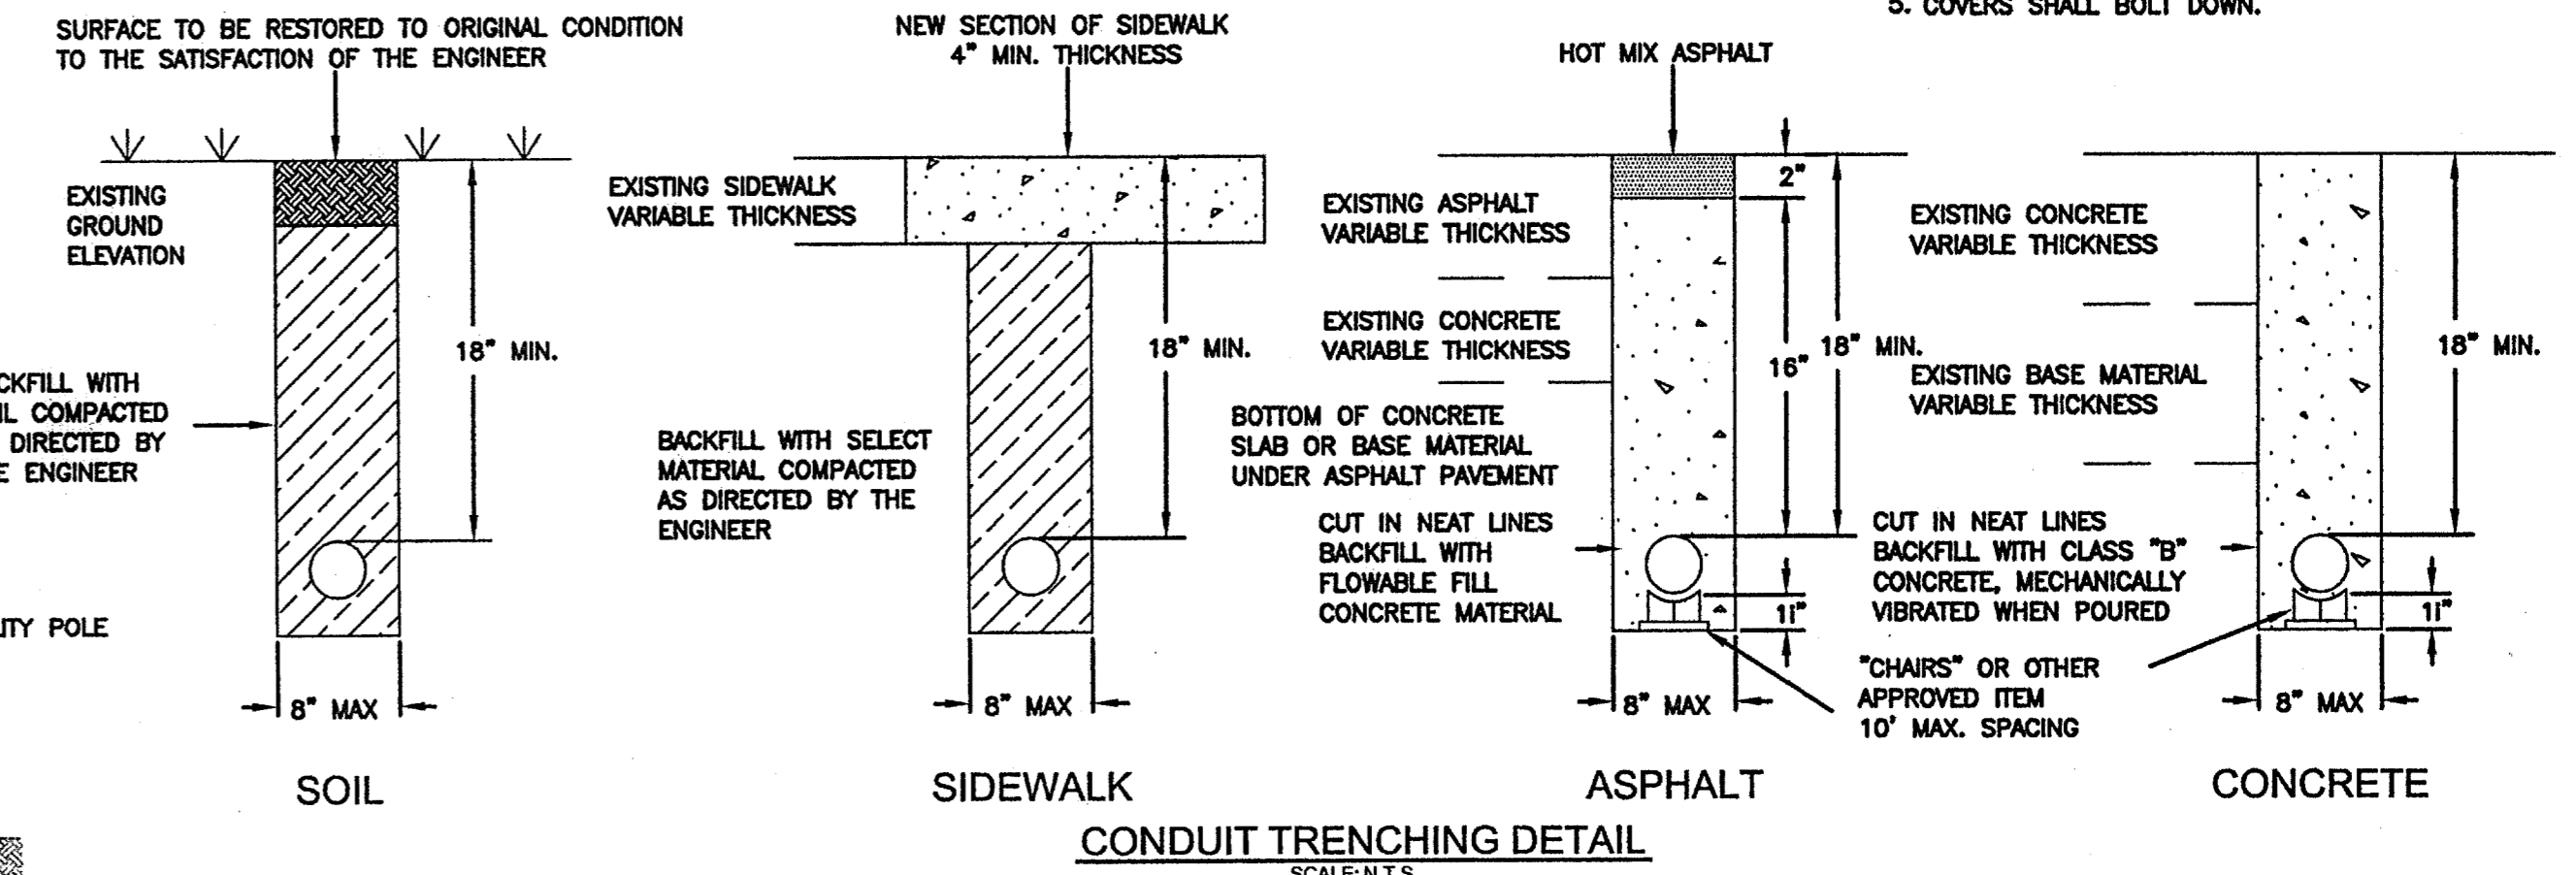

NOTES:

- CONDUIT TO BE SEALED WITH DUCT SEALER ONCE CABLE IS INSTALLED.
- SAWCUT SIDEWALK AT EXISTING JOINTS AND REPLACE ENTIRE SECTION TO MATCH EXISTING MATERIAL. WHEN NEW SIDEWALK IS BEING CONSTRUCTED, CONDUIT, PULLBOX, AND POLE ARE TO BE INSTALLED BEFORE SIDEWALK IS POURED.
- TYPE I CONDUIT IS RIGID STEEL; TYPE IV CONDUIT IS PVC.
- CONDUIT MAY BE TRENCHED OR JACKED. ELECTRICAL SUBCONTRACTOR SHALL COORDINATE CONDUIT INSTALLATION WORK UNDER ROADWAY WITH ROADWAY CONSTRUCTION PHASING IN ORDER TO MINIMIZE JACKING.


Record Drawings
1-8-08

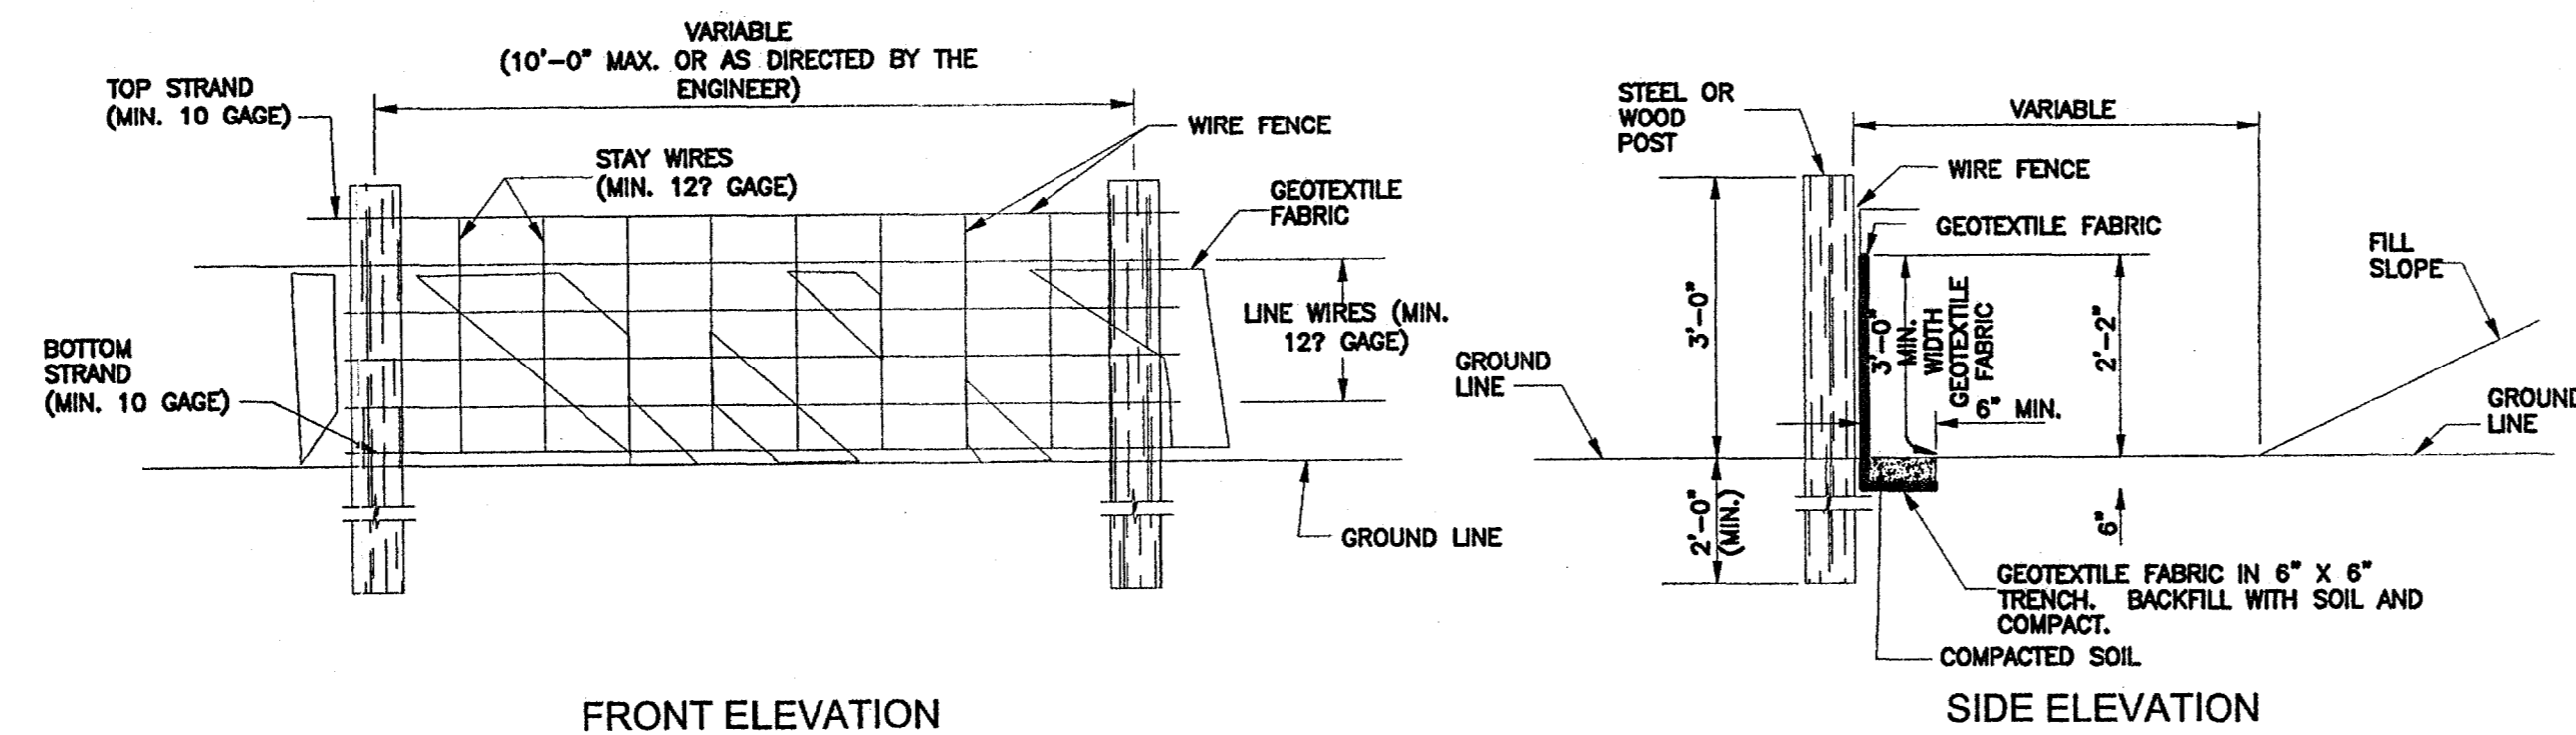

- NOTES:**
1. WIRE SHALL BE MINIMUM OF 32" IN WIDTH AND SHALL HAVE A MINIMUM OF 6 LINE WIRES WITH 12" STAY SPACING.
 2. GEOTEXTILE FABRIC SHALL BE A MINIMUM OF 36" IN WIDTH AND SHALL BE FASTENED ADEQUATELY TO THE WIRE AS DIRECTED BY THE ENGINEER.
 3. STEEL POST SHALL BE 5'-0" IN HEIGHT AND OF THE SELF-FASTENER ANGLE STEEL TYPE. WOOD POST SHALL BE A MINIMUM OF 5'-0" IN HEIGHT AND 3" OR MORE IN DIAMETER. WIRE FENCE SHALL BE FASTENED TO WOODEN POST WITH NOT LESS THAN 9 GAGE WIRE STAPLES 1" LONG.
 4. GEOTEXTILE FABRIC MEETING THE TYPE II MATERIAL REQUIREMENTS AND INSTALLED ACCORDING TO SPECIFICATIONS MAY BE USED WITHOUT WIRE FENCE.

1 SILT FENCE DETAILS


SCALE: N.T.S.

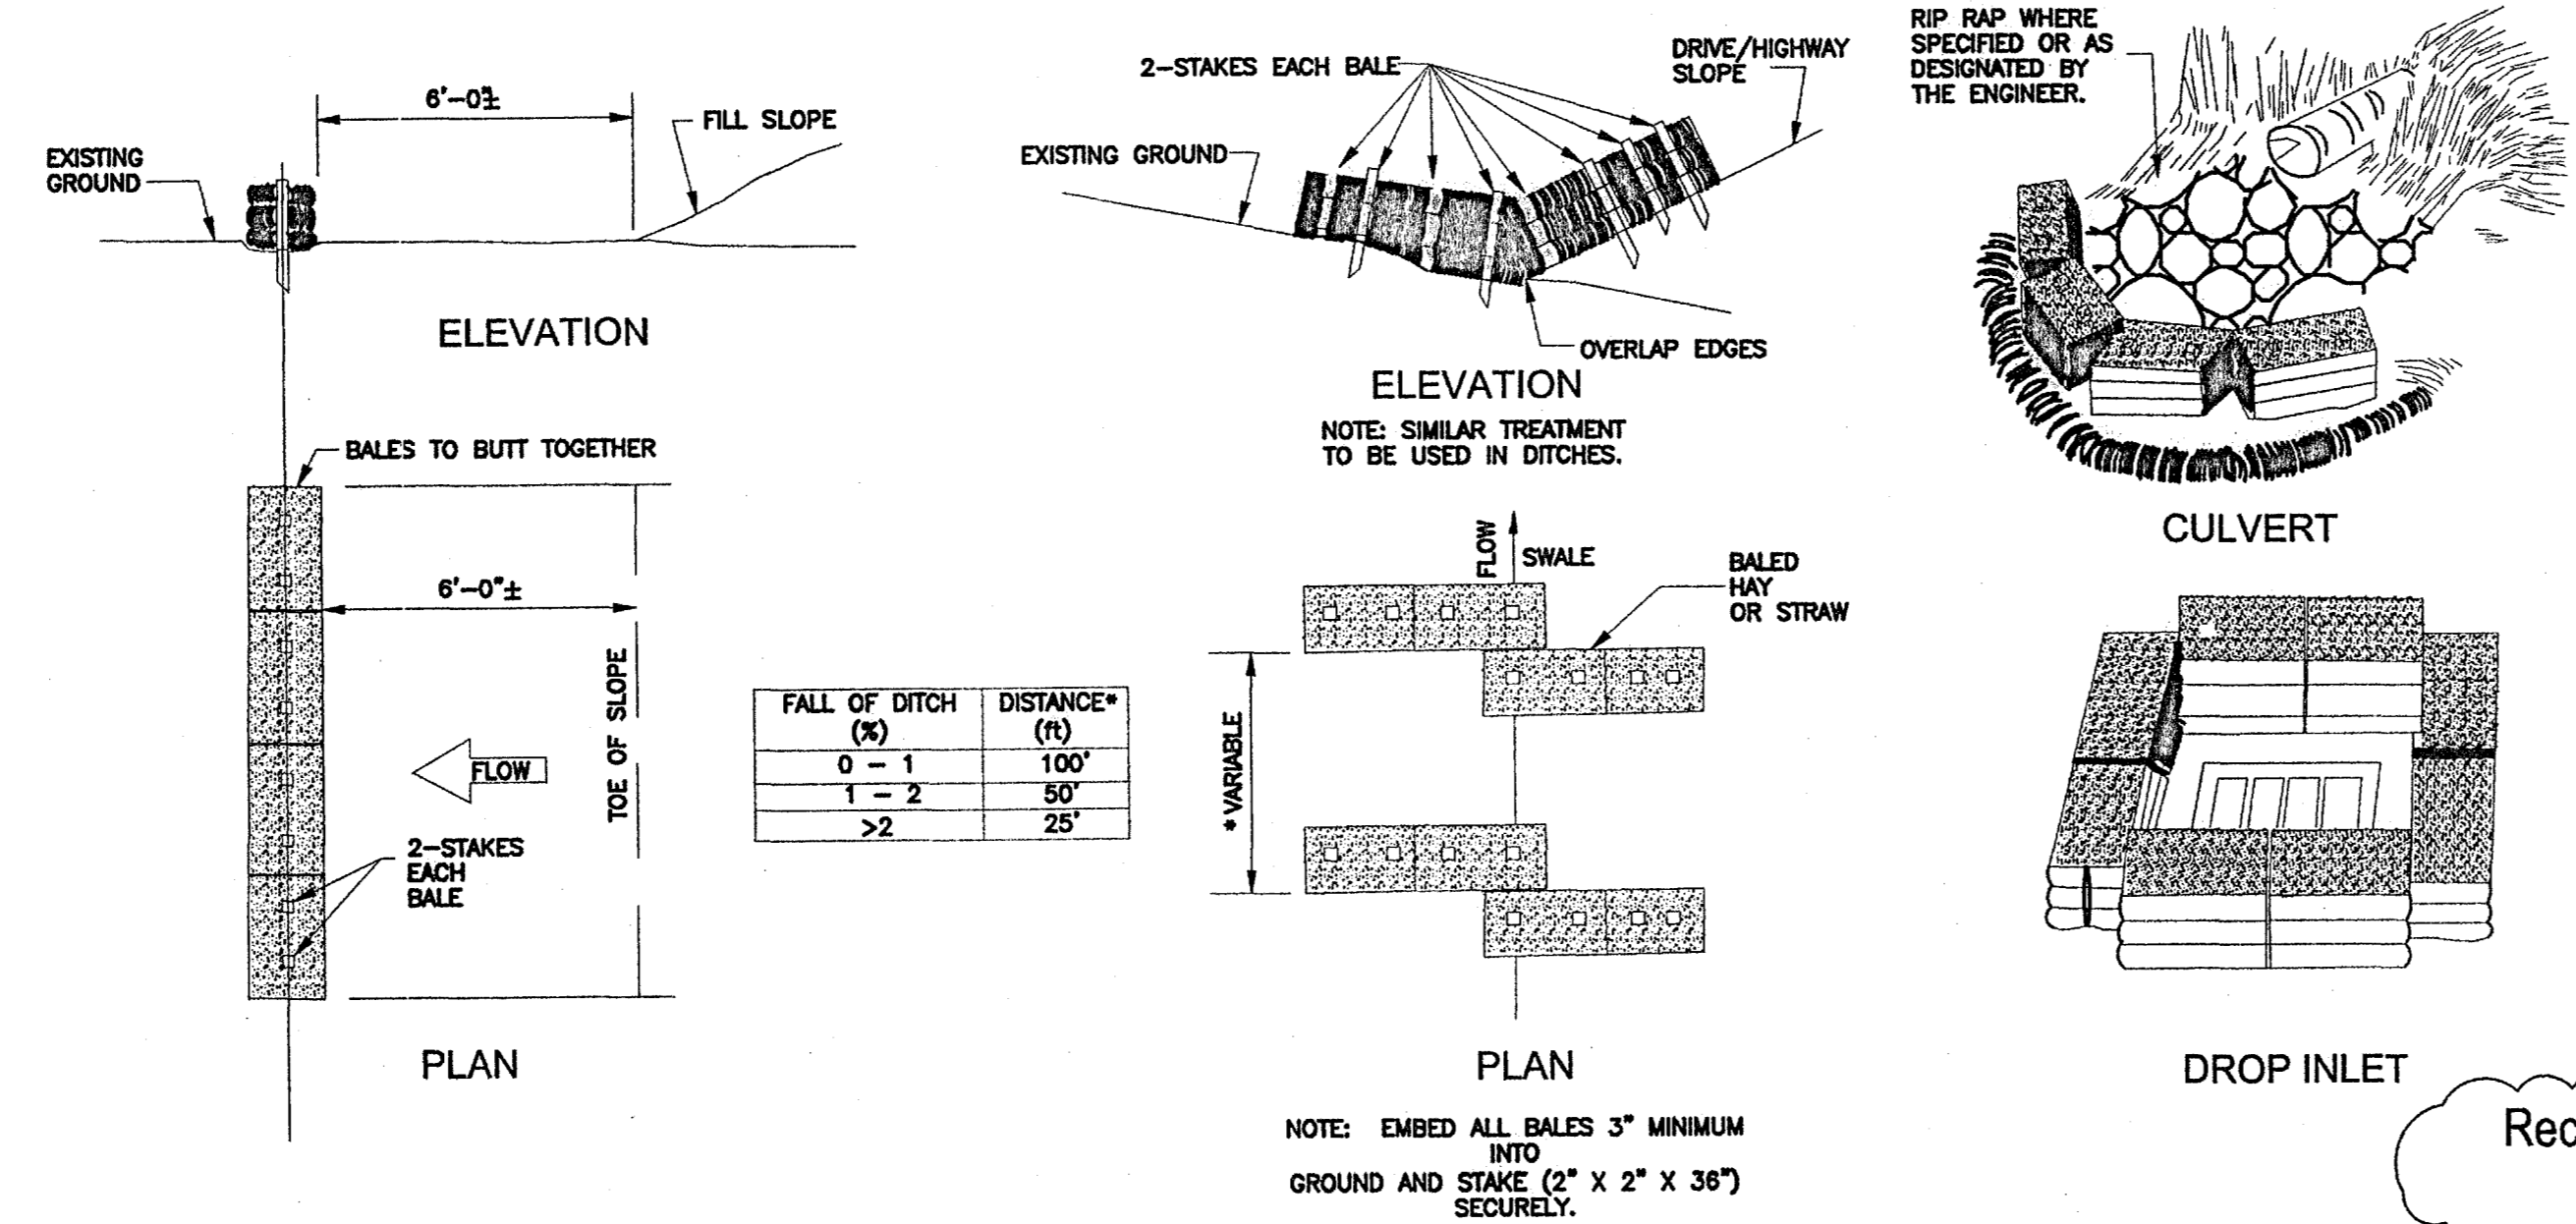

Record Drawings
1-8-08


2 EROSION/SEDIMENTATION CONTROL DETAILS

SCALE: N.T.S.

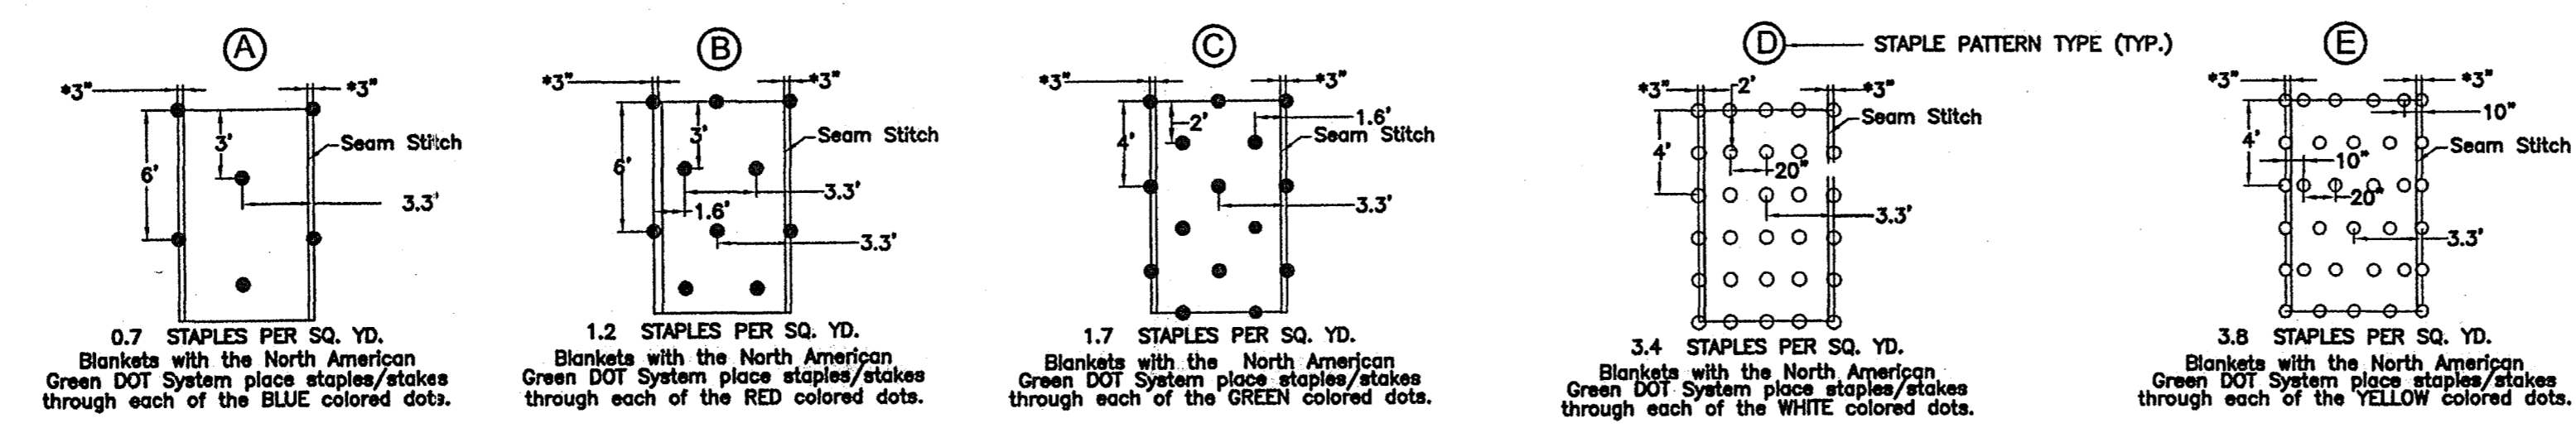


3 DRAINAGE BLANKET STAPLE PATTERNS

SCALE: N.T.S.

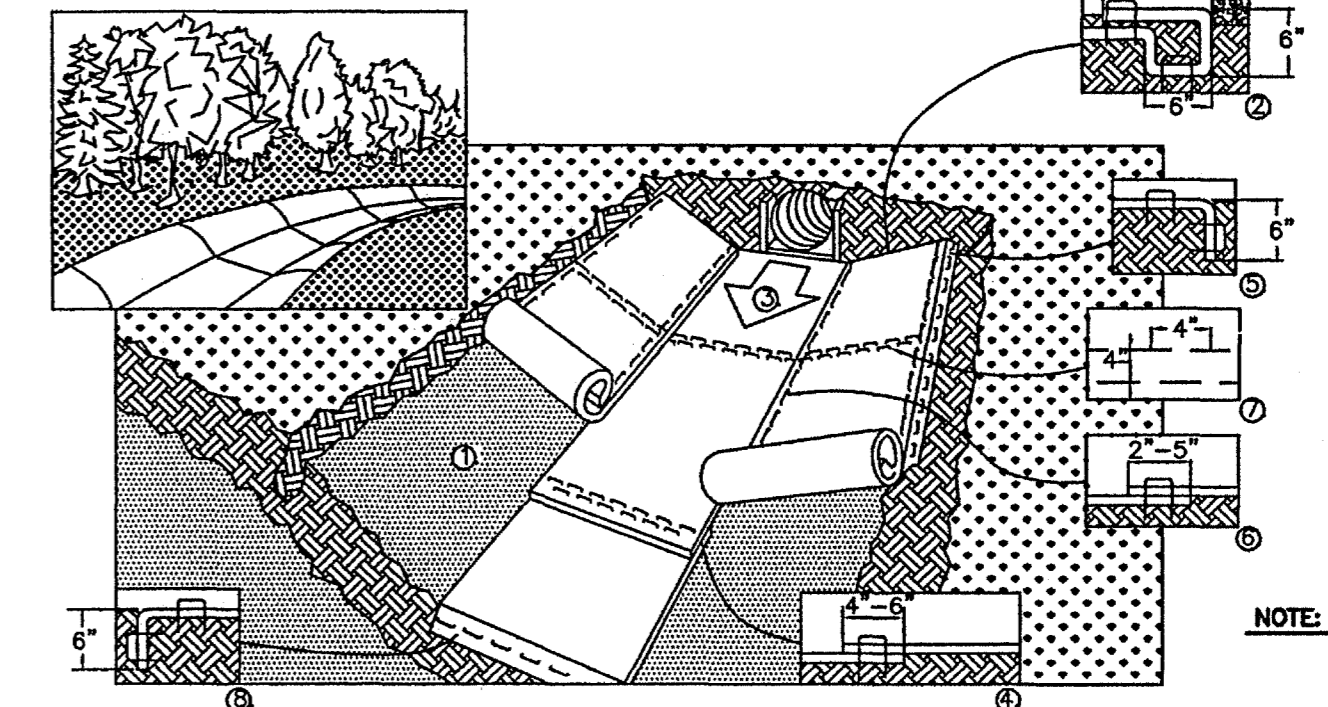


- NOTE: SEE EROSION CONTROL PLAN**
1. PREPARE SOIL BEFORE INSTALLING BLANKETS, INCLUDING ANY NECESSARY APPLICATION OF LIME, FERTILIZER, AND SEED. NOTE: WHEN USING CELL-O-SEED DO NOT SEED PREPARED AREA. CELL-O-SEED MUST BE INSTALLED WITH PAPER SIDE DOWN.
 2. BEGIN AT THE TOP OF THE CHANNEL BY ANCHORING THE BLANKET IN A 6" (15cm) DEEP X 6" (15cm) WIDE TRENCH WITH APPROXIMATELY 12" (30cm) OF BLANKET EXTENDED BEYOND THE UP-SLOPE PORTION OF THE TRENCH. ANCHOR THE BLANKET WITH A ROW OF STAPLES/STAKES APPROXIMATELY 12" (30cm) APART IN THE BOTTOM OF THE TRENCH. BACKFILL AND COMPACT THE TRENCH AFTER STAPLING. APPLY SEED TO COMPACTED SOIL AND FOLD REMAINING 12" (30cm) PORTION OF BLANKET BACK OVER SEED AND COMPACTED SOIL. SECURE BLANKET OVER COMPACTED SOIL WITH A ROW OF STAPLES/STAKES SPACED APPROXIMATELY 12" (30cm) APART ACROSS THE WIDTH OF THE BLANKET.
 3. ROLL CENTER BLANKET IN DIRECTION OF WATER FLOW IN BOTTOM OF CHANNEL. BLANKETS WILL UNROLL WITH APPROPRIATE SIDE AGAINST THE SOIL SURFACE. ALL BLANKETS MUST BE SECURELY FASTENED TO SOIL SURFACE BY PLACING STAPLES/STAKES IN APPROPRIATE LOCATIONS AS SHOWN IN THE STAPLE PATTERN GUIDE. WHEN USING OPTIONAL DOT SYSTEM, STAPLES/STAKES SHOULD BE PLACED THROUGH EACH OF THE COLORED DOTS CORRESPONDING TO THE APPROPRIATE STAPLE PATTERN.
 4. PLACE CONSECUTIVE BLANKETS END OVER END (SHINGLE STYLE) WITH A 4"-8" (10cm-15cm) OVERLAP. USE A DOUBLE ROW OF STAPLES STAGGERED 4" (10cm) APART AND 4" (10cm) ON CENTER TO SECURE BLANKETS.
 5. FULL LENGTH EDGE OF BLANKETS AT TOP OF SIDE SLOPES MUST BE ANCHORED WITH A ROW OF STAPLES/STAKES APPROXIMATELY 12" (30cm) APART IN A 6" (15cm) DEEP X 6" (15cm) WIDE TRENCH. BACKFILL AND COMPACT THE TRENCH AFTER STAPLING.
 6. ADJACENT BLANKETS MUST BE OVERLAPPED APPROXIMATELY 2"-5" (5cm-12.5cm) (DEPENDING ON BLANKET TYPE) AND STAPLED. TO ENSURE PROPER SEAM ALIGNMENT, PLACE THE EDGE OF THE OVERLAPPING BLANKET (BLANKET BEING INSTALLED ON TOP) EVEN WITH THE COLORED SEAM STITCH ON THE BLANKET BEING OVERLAPPED.
 7. IN CHANNEL APPLICATIONS, A STAPLE CHECK SLOT IS RECOMMENDED AT 30 TO 40 FOOT (9m-12m) INTERVALS. USE A DOUBLE ROW OF STAPLES STAGGERED 4" (10cm) APART AND 4" (10cm) ON CENTER OVER ENTIRE WIDTH OF THE CHANNEL.
 8. THE TERMINAL END OF THE BLANKETS MUST BE ANCHORED WITH A ROW OF STAPLES/STAKES APPROXIMATELY 12" (30cm) APART IN A 6" (15cm) DEEP X 6" (15cm) WIDE TRENCH. BACKFILL AND COMPACT THE TRENCH AFTER STAPLING.

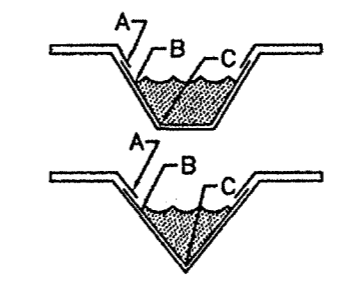

- CRITICAL POINTS**
- A. OVERLAPS AND SEAMS
 - B. PROJECTED WATER LINE
 - C. CHANNEL BOTTOM/SIDE SLOPE VERTICES
- NOTE:**
- * HORIZONTAL STAPLE SPACING SHOULD BE ALTERED IF NECESSARY TO ALLOW STAPLES TO SECURE THE CRITICAL POINTS ALONG THE CHANNEL SURFACE.
 - ** IN LOOSE SOIL CONDITIONS, THE USE OF STAPLE OR STAKE LENGTHS GREATER THAN 6" (15 cm) MAY BE NECESSARY TO PROPERLY ANCHOR THE BLANKETS.

4 DRAINAGE BLANKET "CHANNEL" INSTALLATION

SCALE: N.T.S.

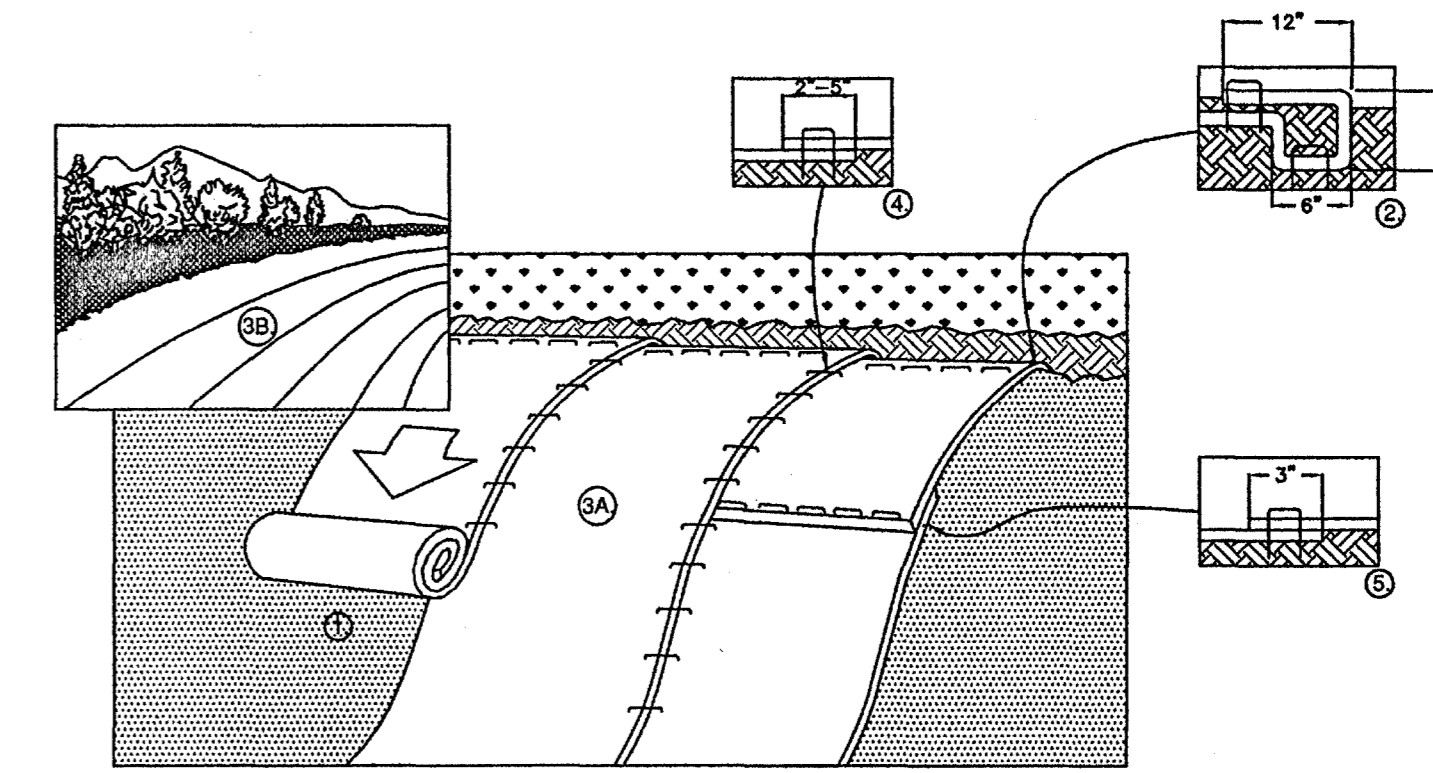

NOTE: SEE EROSION CONTROL PLAN


1. PREPARE SOIL BEFORE INSTALLING BLANKETS, INCLUDING ANY NECESSARY APPLICATION OF LIME, FERTILIZER, AND SEED. NOTE: WHEN USING CELL-O-SEED DO NOT SEED PREPARED AREA. CELL-O-SEED MUST BE INSTALLED WITH PAPER SIDE DOWN.
 2. BEGIN AT THE TOP OF THE SLOPE BY ANCHORING THE BLANKET IN A 6" (15cm) DEEP X 6" (15cm) WIDE TRENCH WITH APPROXIMATELY 12" (30cm) OF BLANKET EXTENDED BEYOND THE UP-SLOPE PORTION OF THE TRENCH. ANCHOR THE BLANKET WITH A ROW OF STAPLES/STAKES APPROXIMATELY 12" (30cm) APART IN THE BOTTOM OF THE TRENCH. BACKFILL AND COMPACT THE TRENCH AFTER STAPLING. APPLY SEED TO COMPACTED SOIL AND FOLD REMAINING 12" (30cm) PORTION OF BLANKET BACK OVER SEED AND COMPACTED SOIL. SECURE BLANKET OVER COMPACTED SOIL WITH A ROW OF STAPLES/STAKES SPACED APPROXIMATELY 12" (30cm) APART ACROSS THE WIDTH OF THE BLANKET.
 3. ROLL THE BLANKETS (A) DOWN OR (B) HORIZONTALLY ACROSS THE SLOPE. BLANKETS WILL UNROLL WITH APPROPRIATE SIDE AGAINST THE SOIL SURFACE. ALL BLANKETS MUST BE SECURELY FASTENED TO SOIL SURFACE BY PLACING STAPLES/STAKES IN APPROPRIATE LOCATIONS AS SHOWN IN THE STAPLE PATTERN GUIDE. WHEN USING OPTIONAL DOT SYSTEM, STAPLES/STAKES SHOULD BE PLACED THROUGH EACH OF THE COLORED DOTS CORRESPONDING TO THE APPROPRIATE STAPLE PATTERN.
 4. THE EDGES OF PARALLEL BLANKETS MUST BE STAPLED WITH APPROXIMATELY 2"-5" (5cm-12.5cm) OVERLAP DEPENDING ON BLANKET TYPE. TO ENSURE PROPER SEAM ALIGNMENT, PLACE THE EDGE OF THE OVERLAPPING BLANKET (BLANKET BEING INSTALLED ON TOP) EVEN WITH THE COLORED SEAM STITCH ON THE PREVIOUSLY INSTALLED BLANKET.
 5. CONSECUTIVE BLANKETS SPICED DOWN THE SLOPE MUST BE PLACED END OVER END (SHINGLE STYLE) WITH AN APPROXIMATE 3" (7.5cm) OVERLAP. STAPLE THROUGH OVERLAPPED AREA, APPROXIMATELY 12" (30cm) APART ACROSS ENTIRE BLANKET WIDTH.
- NOTE:**
- ** IN LOOSE SOIL CONDITIONS, THE USE OF STAPLE OR STAKE LENGTHS GREATER THAN 6" (15cm) MAY BE NECESSARY TO PROPERLY SECURE THE BLANKETS.

5 DRAINAGE BLANKET "SLOPE" INSTALLATION



SCALE: N.T.S.

STRIPING SHEET TOTALS	
4" CONTINUOUS WHITE (MI)	= 0.116 MI
4" SKIP WHITE (MI)	= 0 MI
4" EQ. DETAIL WHITE (LF)	= 2141 LF
4" EQ. WHITE LEGEND (LF)	= 276 LF
4" CONTINUOUS YELLOW (MI)	= .093 MI
4" EQ. DETAIL YELLOW (LF)	= 0 LF
WHITE LEGEND (SF)	= 164.6 SF

ALL RAISED REFLECTIVE PAVEMENT MARKERS SHALL BE PLACED IN ACCORDANCE WITH STATE AID STANDARD DRAWING SA-PSM-1

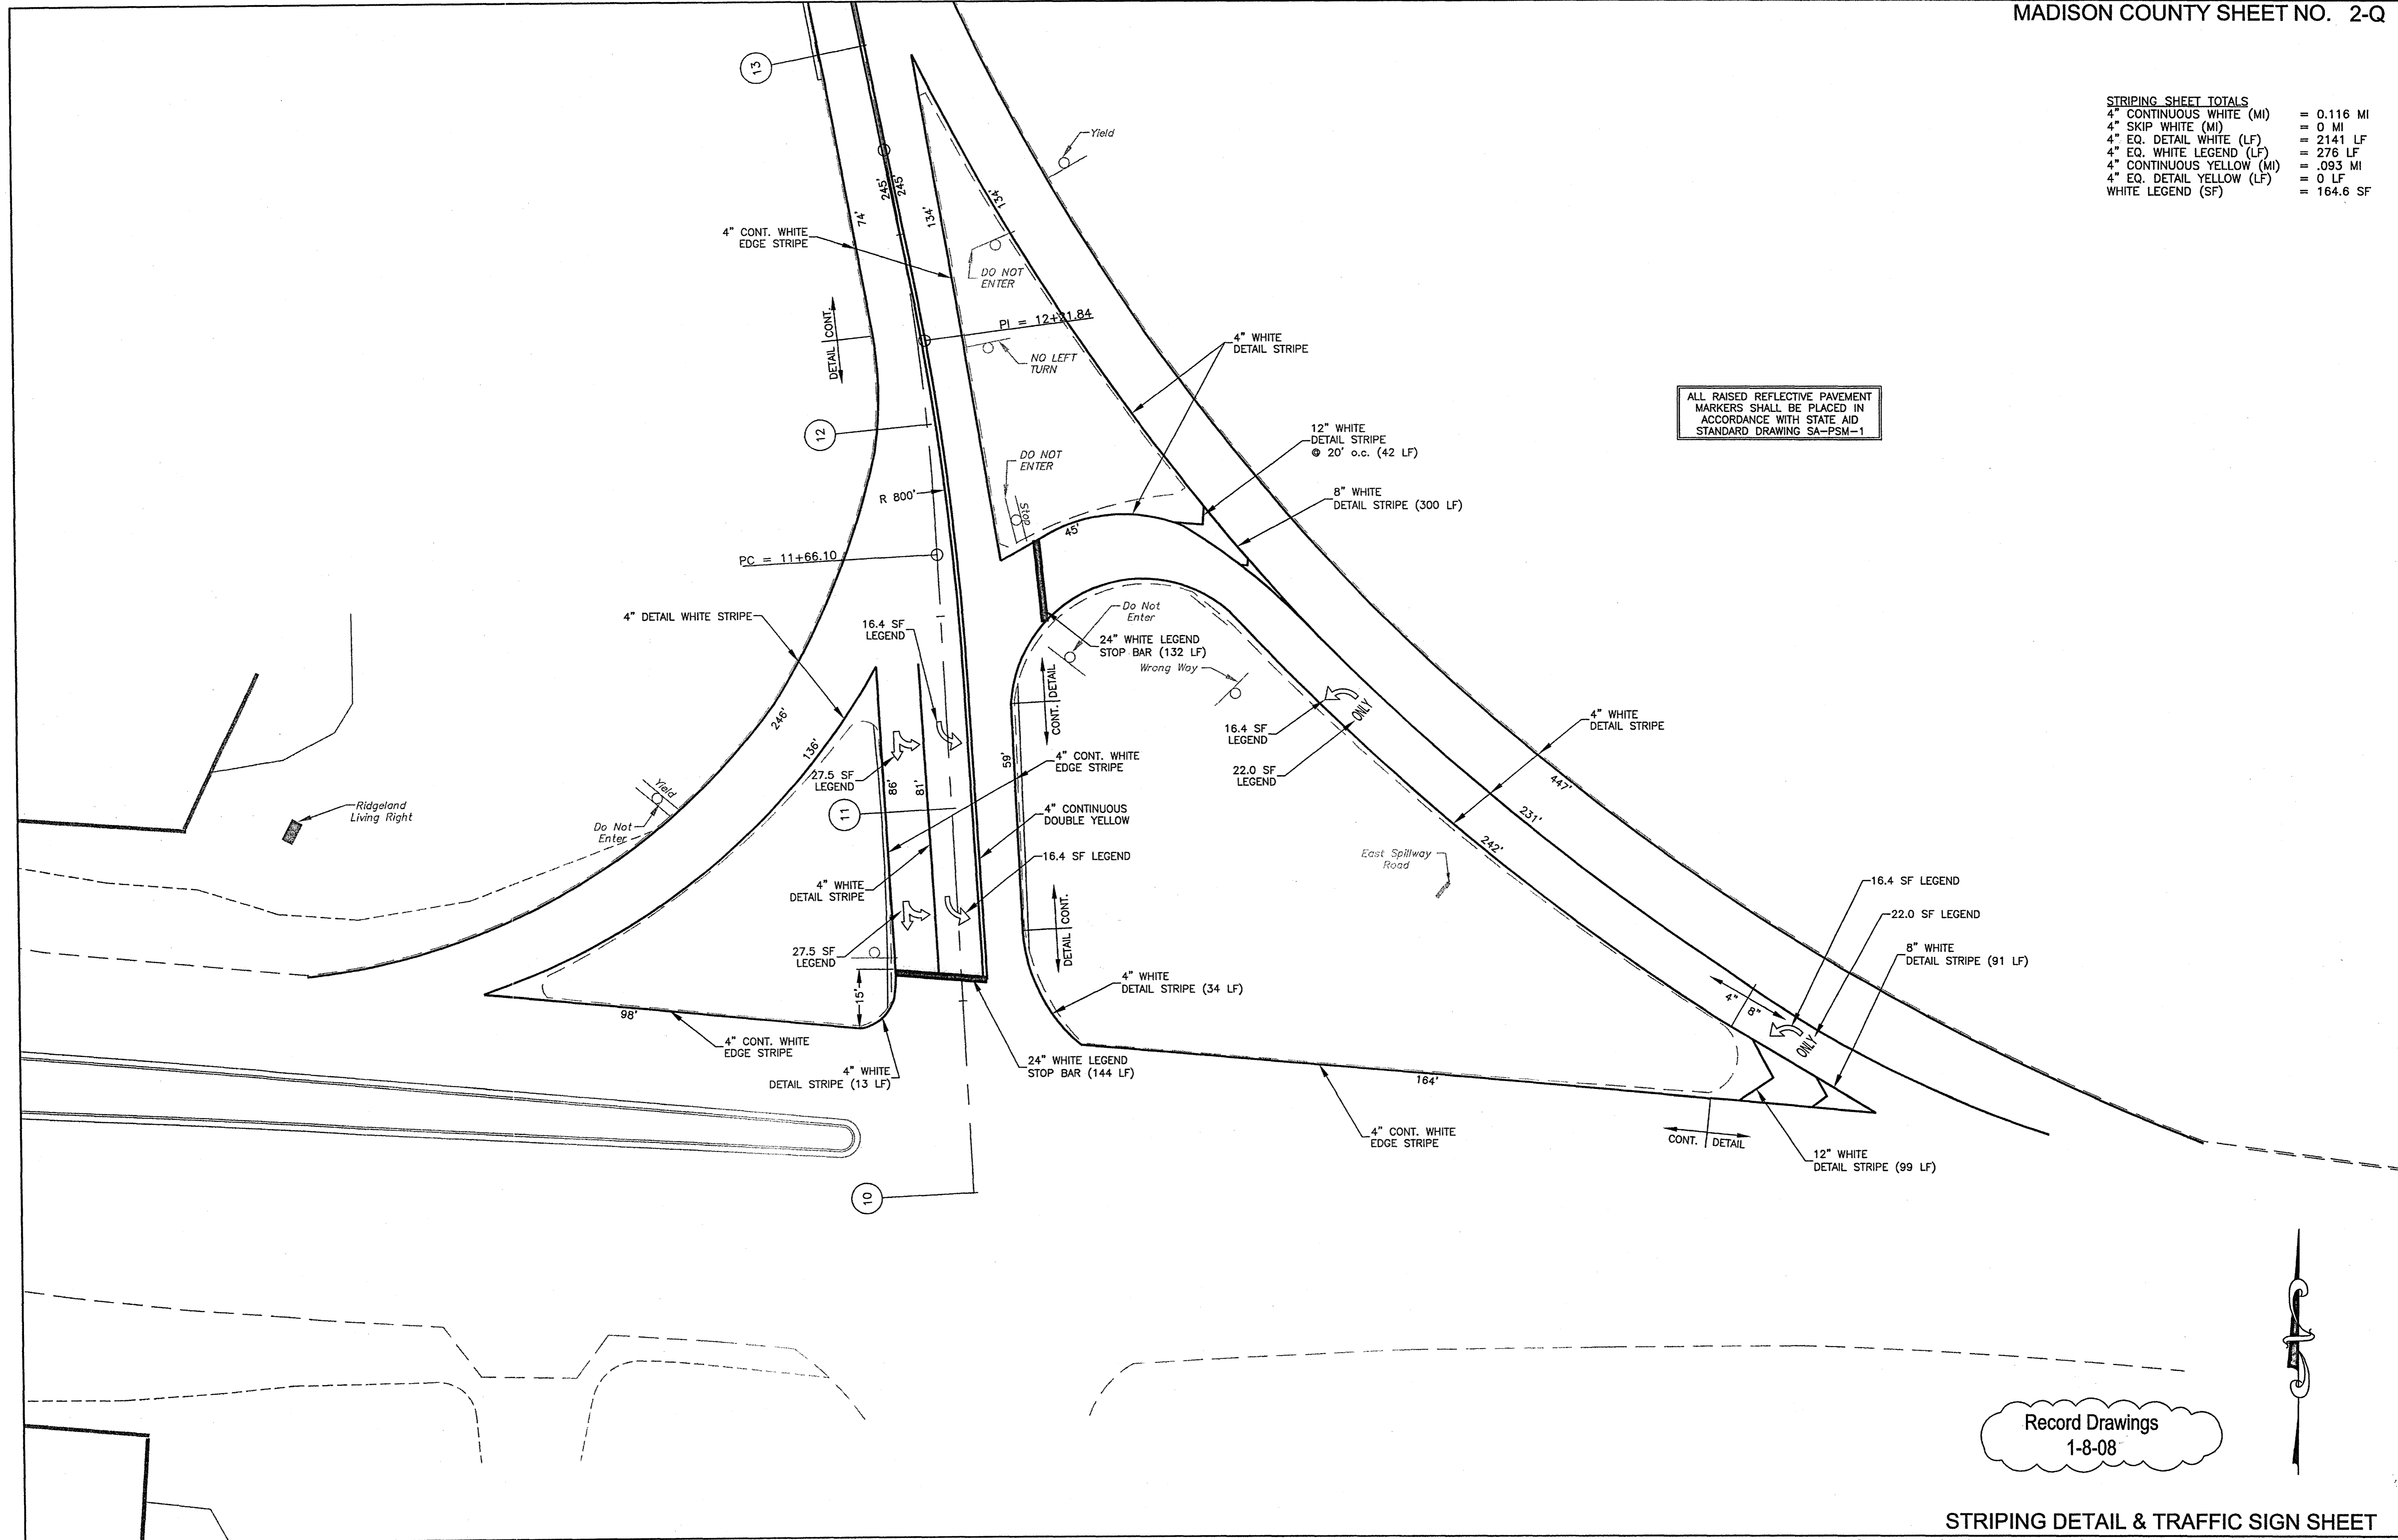

Record Drawings
1-8-08

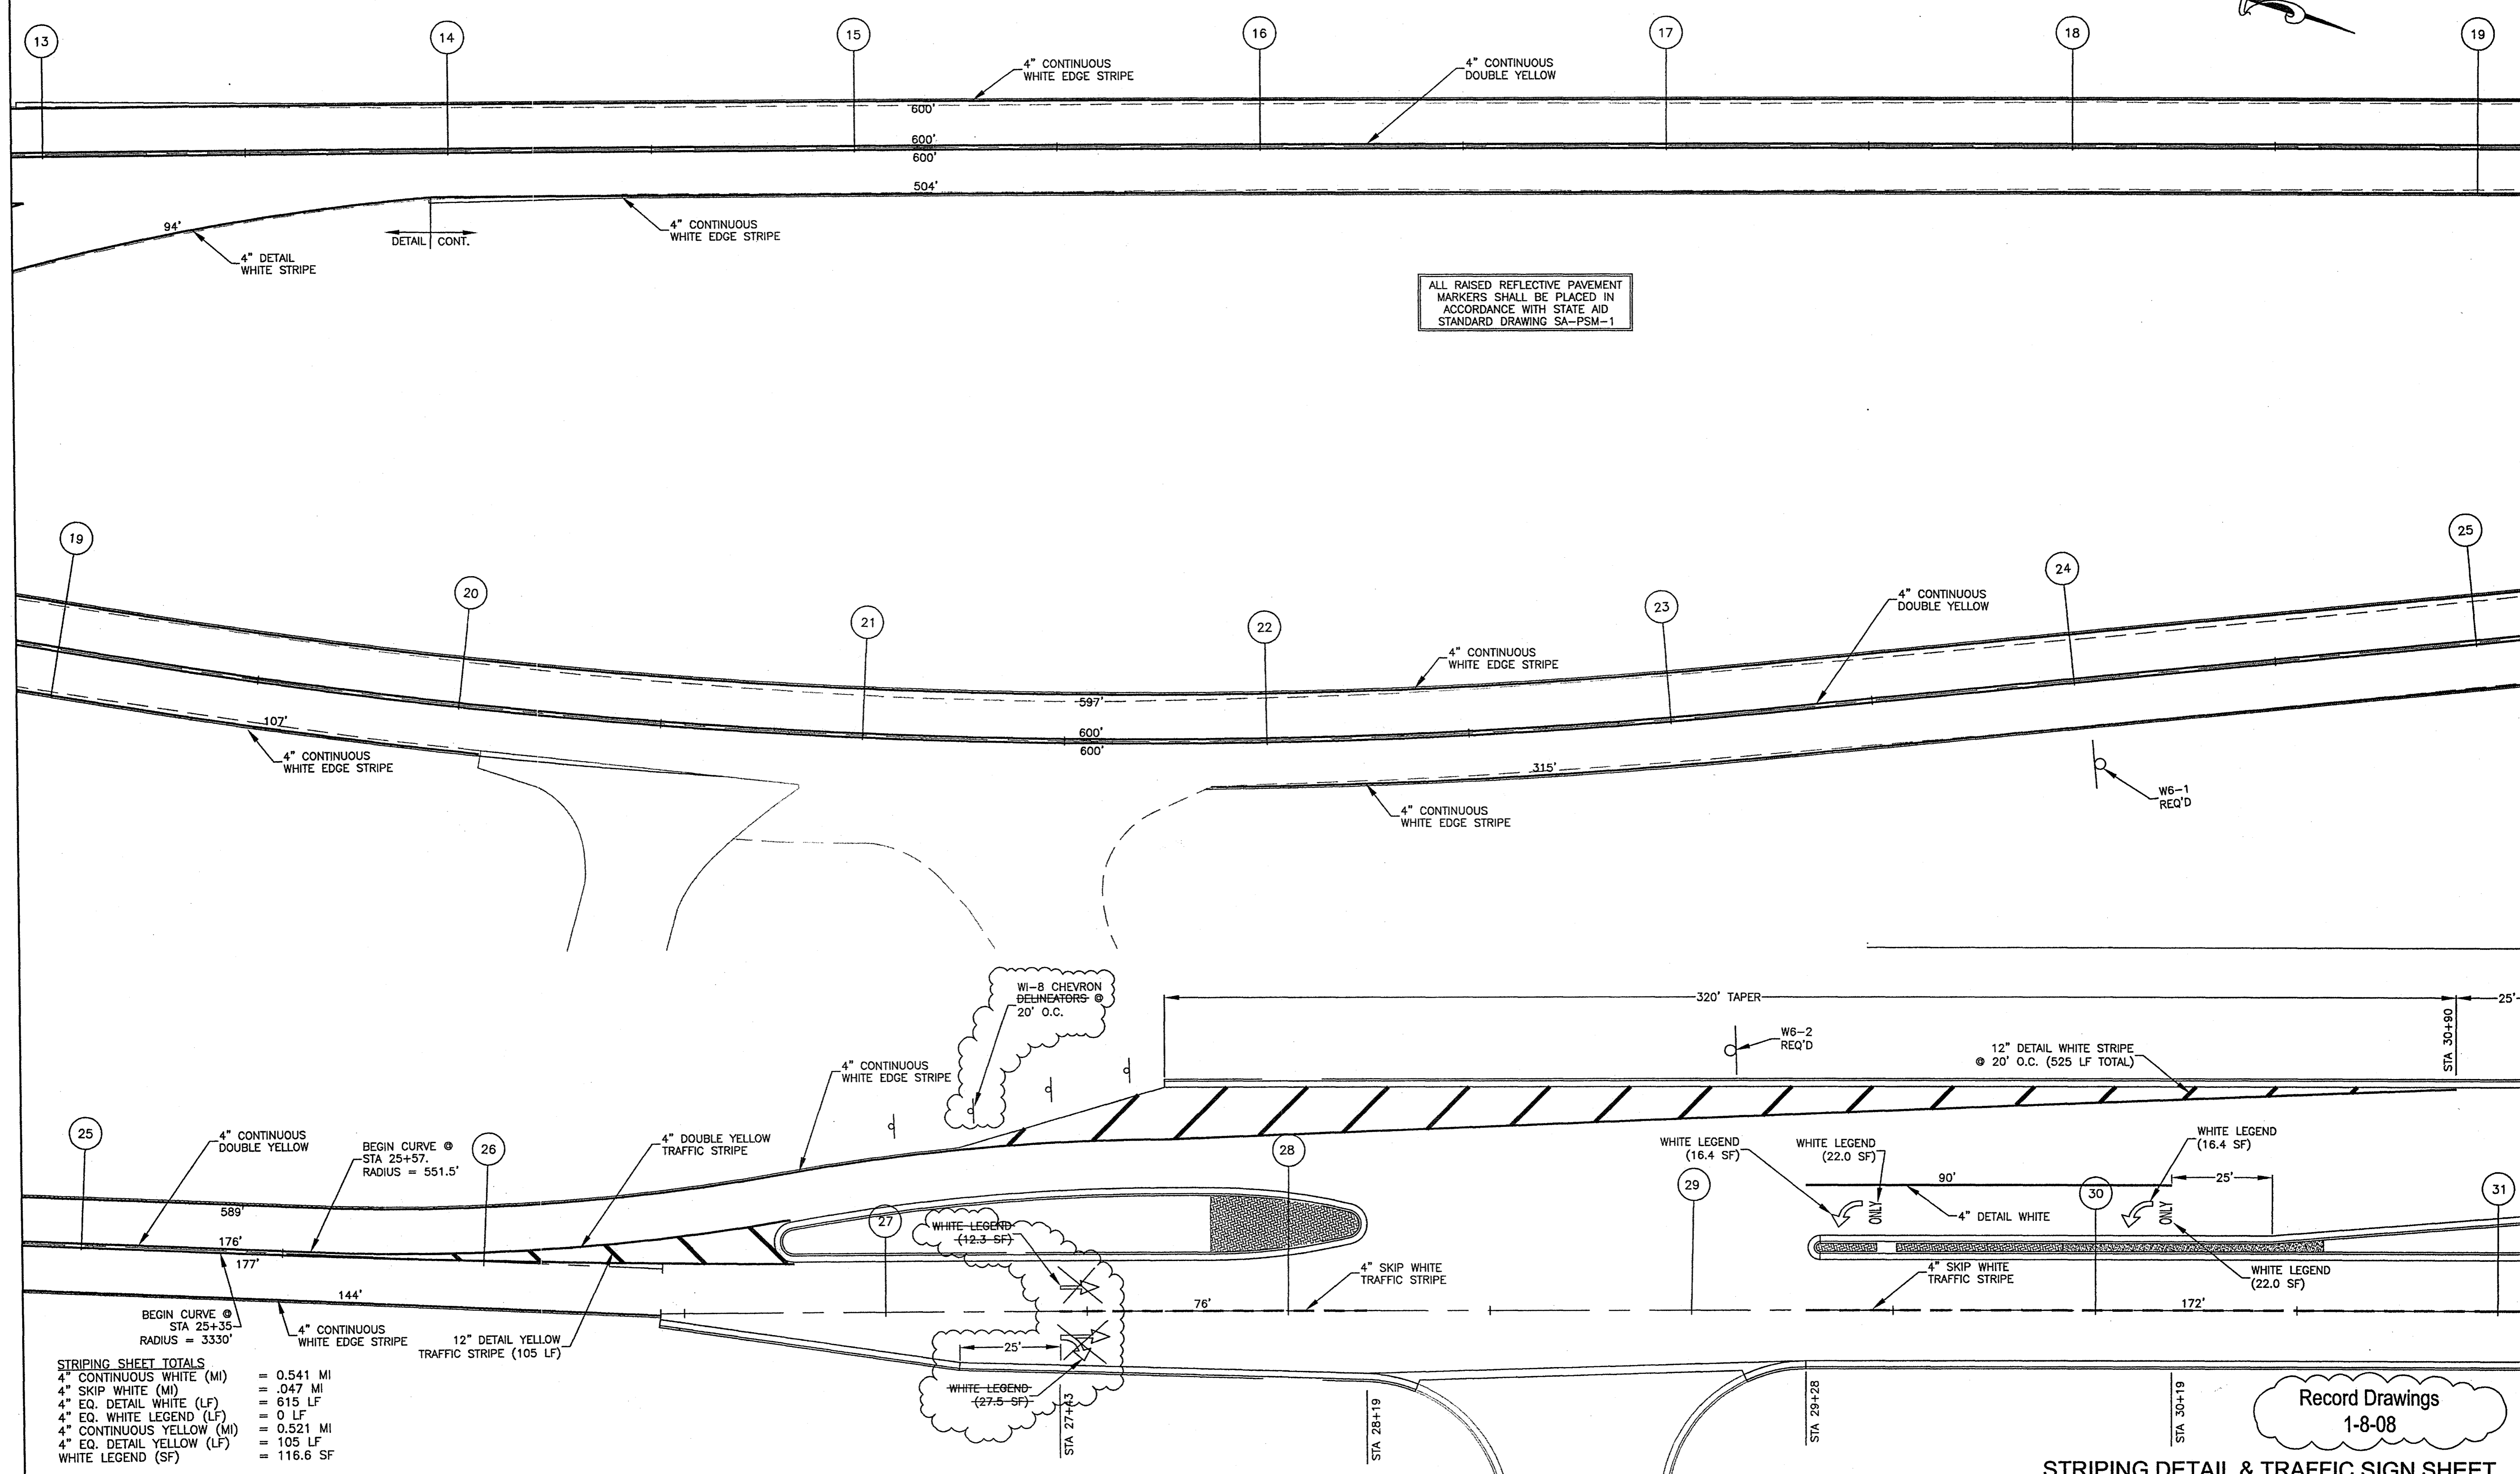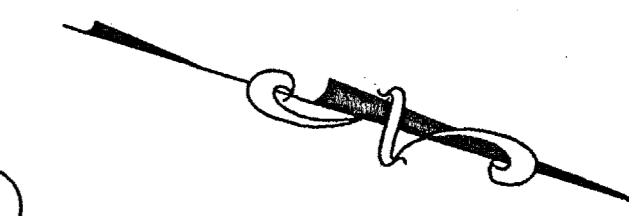


ALL RAISED REFLECTIVE PAVEMENT MARKERS SHALL BE PLACED IN ACCORDANCE WITH STATE AID STANDARD DRAWING SA-PSM-1

STRIPING SHEET TOTALS

4" CONTINUOUS WHITE (MI)	= 0.541 MI
4" SKIP WHITE (MI)	= 0.047 MI
4" EQ. DETAIL WHITE (LF)	= 615 LF
4" EQ. WHITE LEGEND (LF)	= 0 LF
4" CONTINUOUS YELLOW (MI)	= 0.521 MI
4" EQ. DETAIL YELLOW (LF)	= 105 LF
WHITE LEGEND (SF)	= 116.6 SF





Record Drawings
1-8-08

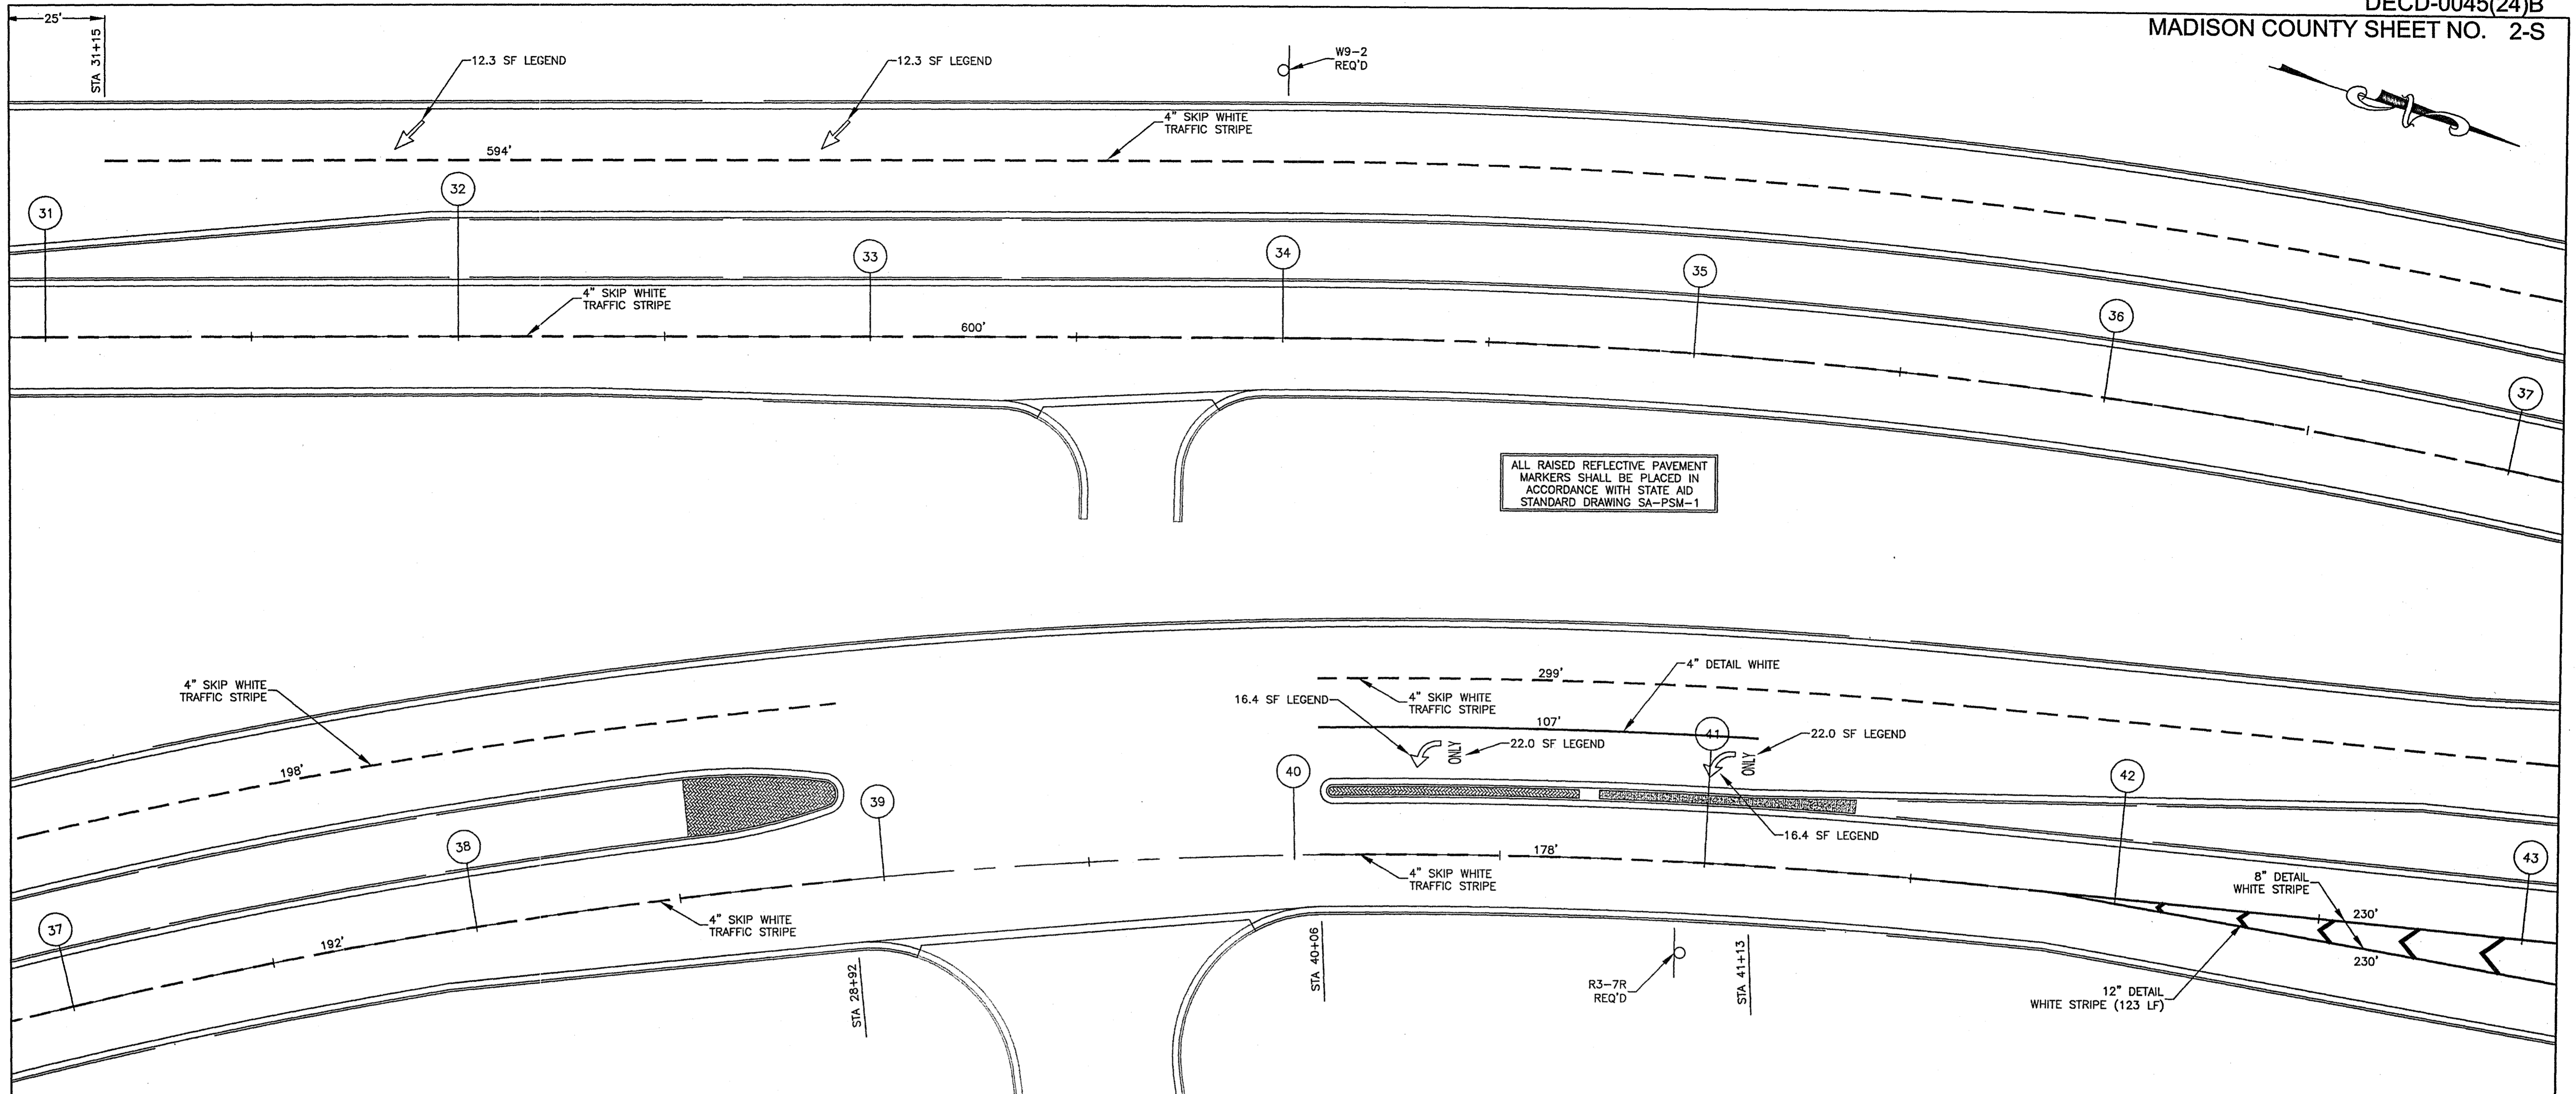

STRIPING SHEET TOTALS

4" CONTINUOUS WHITE (MI)	= 0 MI
4" SKIP WHITE (MI)	= 0.390 MI
4" EQ. DETAIL WHITE (LF)	= 690 LF
4" EQ. WHITE LEGEND (LF)	= 0 LF
4" CONTINUOUS YELLOW (MI)	= 0 MI
4" EQ. DETAIL YELLOW (LF)	= 0 LF
WHITE LEGEND (SF)	= 76.8 SF

Record Drawings
1-8-08

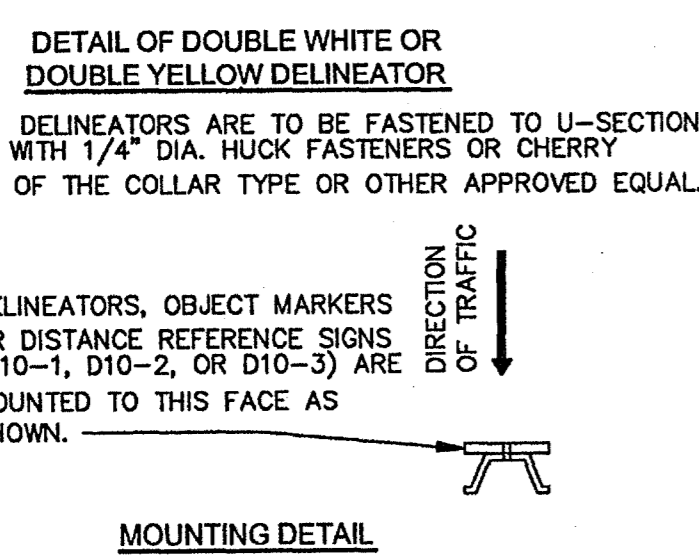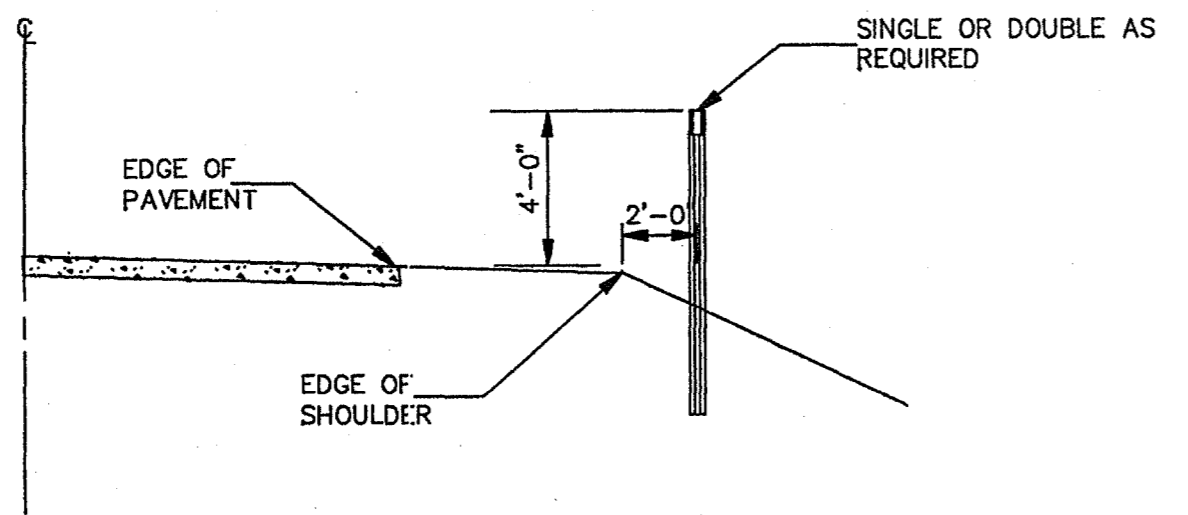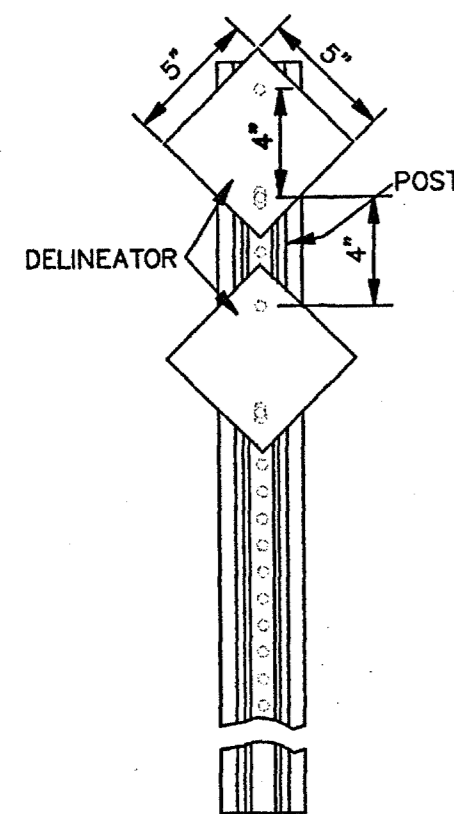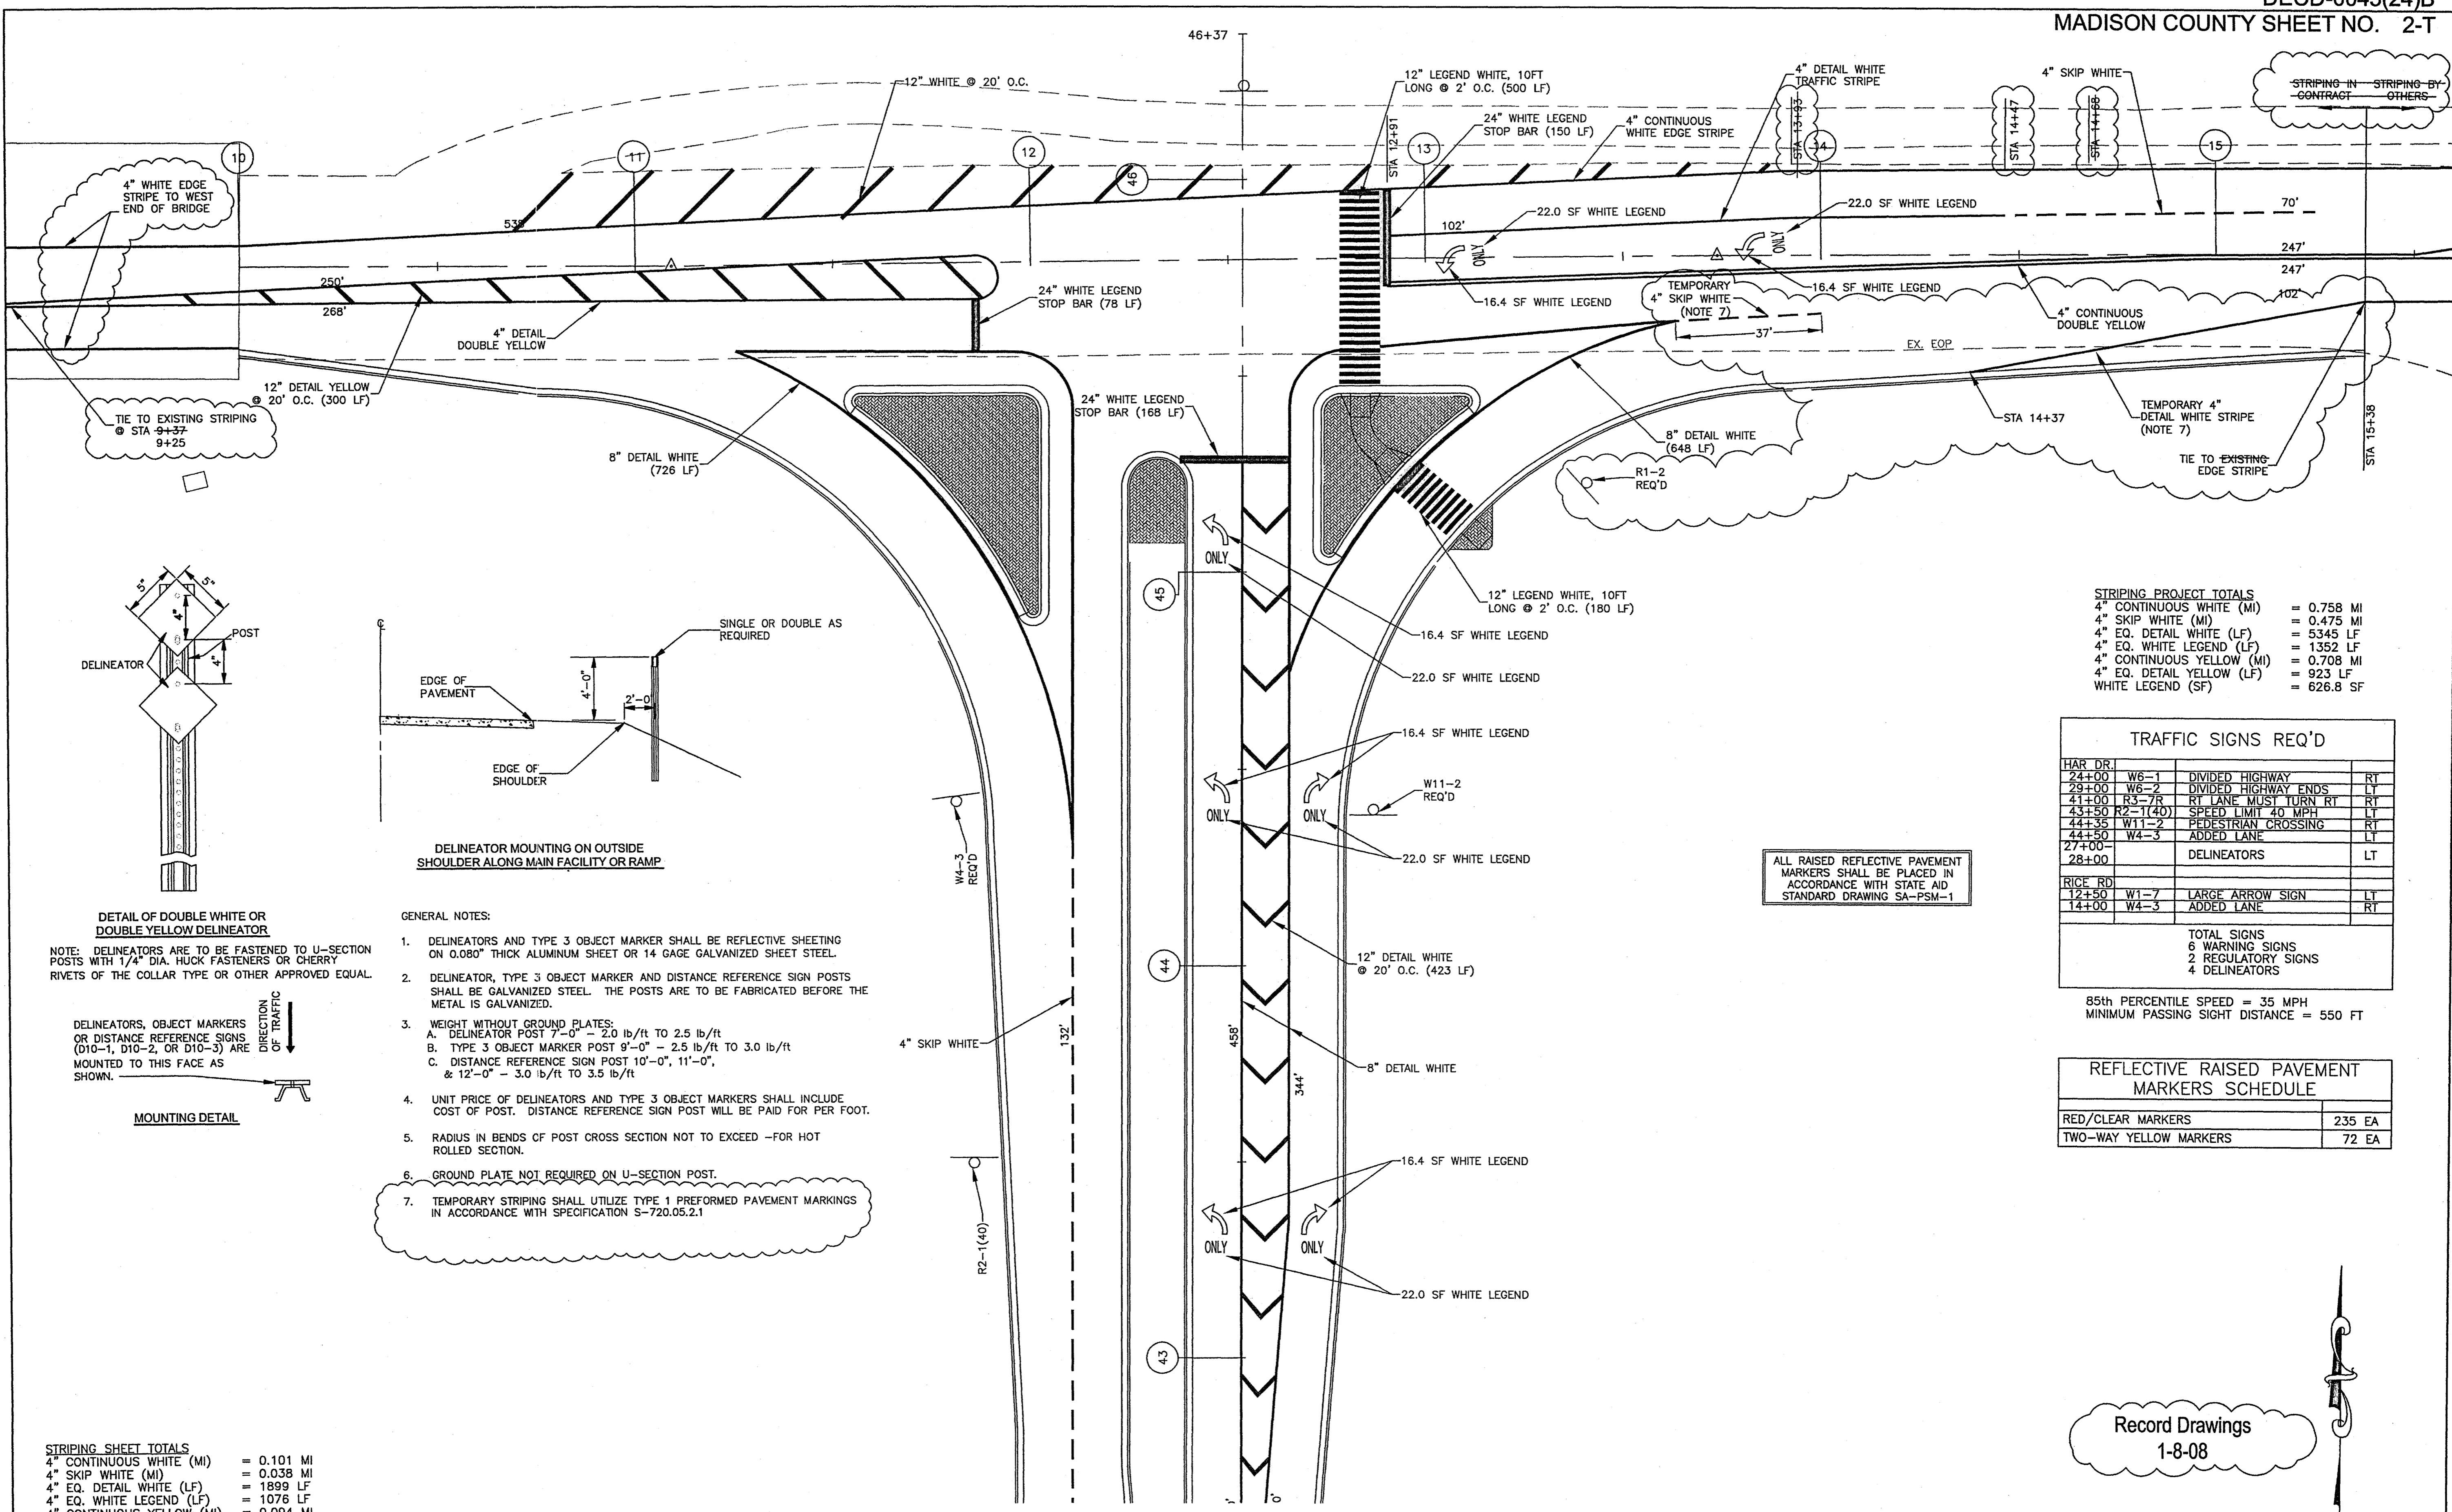

- GENERAL NOTES:
- DELINERATORS AND TYPE 3 OBJECT MARKER SHALL BE REFLECTIVE SHEETING ON 0.080" THICK ALUMINUM SHEET OR 14 GAGE GALVANIZED SHEET STEEL.
 - DELINERATOR, TYPE 3 OBJECT MARKER AND DISTANCE REFERENCE SIGN POSTS SHALL BE GALVANIZED STEEL. THE POSTS ARE TO BE FABRICATED BEFORE THE METAL IS GALVANIZED.
 - WEIGHT WITHOUT GROUND PLATES:
 - A. DELINERATOR POST 7'-0" - 2.0 lb/ft TO 2.5 lb/ft
 - B. TYPE 3 OBJECT MARKER POST 9'-0" - 2.5 lb/ft TO 3.0 lb/ft
 - C. DISTANCE REFERENCE SIGN POST 10'-0", 11'-0", & 12'-0" - 3.0 lb/ft TO 3.5 lb/ft
 - UNIT PRICE OF DELINERATORS AND TYPE 3 OBJECT MARKERS SHALL INCLUDE COST OF POST. DISTANCE REFERENCE SIGN POST WILL BE PAID FOR PER FOOT.
 - RADIUS IN BENDS OF POST CROSS SECTION NOT TO EXCEED -FOR HOT ROLLED SECTION.
 - GROUND PLATE NOT REQUIRED ON U-SECTION POST.
 - TEMPORARY STRIPING SHALL UTILIZE TYPE 1 PREFORMED PAVEMENT MARKINGS IN ACCORDANCE WITH SPECIFICATION S-720.05.2.1

STRIPING PROJECT TOTALS

4" CONTINUOUS WHITE (MI)	= 0.758 MI
4" SKIP WHITE (MI)	= 0.475 MI
4" EQ. DETAIL WHITE (LF)	= 5345 LF
4" EQ. WHITE LEGEND (LF)	= 1352 LF
4" CONTINUOUS YELLOW (MI)	= 0.708 MI
4" EQ. DETAIL YELLOW (LF)	= 923 LF
WHITE LEGEND (SF)	= 626.8 SF

TRAFFIC SIGNS REQ'D

HAR. DR.	W	DESCRIPTION	RT
24+00	W6-1	DIVIDED HIGHWAY ENDS	RT
29+00	W6-2	DIVIDED HIGHWAY ENDS	LT
41+00	R3-7R	RT LANE MUST TURN RT	RT
43+50	R2-1(40)	SPEED LIMIT 40 MPH	LT
44+35	W11-2	PEDESTRIAN CROSSING	RT
44+50	W4-3	ADDED LANE	LT
27+00		DELINERATORS	LT
28+00		DELINERATORS	LT
RICE RD			
12+50	W1-7	LARGE ARROW SIGN	LT
14+00	W4-3	ADDED LANE	RT

TOTAL SIGNS
6 WARNING SIGNS
2 REGULATORY SIGNS
4 DELINERATORS

85th PERCENTILE SPEED = 35 MPH
MINIMUM PASSING SIGHT DISTANCE = 550 FT


REFLECTIVE RAISED PAVEMENT MARKERS SCHEDULE

RED/CLEAR MARKERS	235 EA
TWO-WAY YELLOW MARKERS	72 EA

Record Drawings
1-8-08

STRIPING SHEET TOTALS


4" CONTINUOUS WHITE (MI)	= 0.101 MI
4" SKIP WHITE (MI)	= 0.038 MI
4" EQ. DETAIL WHITE (LF)	= 1899 LF
4" EQ. WHITE LEGEND (LF)	= 1076 LF
4" CONTINUOUS YELLOW (MI)	= 0.094 MI
4" EQ. DETAIL YELLOW (LF)	= 818 LF
WHITE LEGEND (SF)	= 268.8 SF

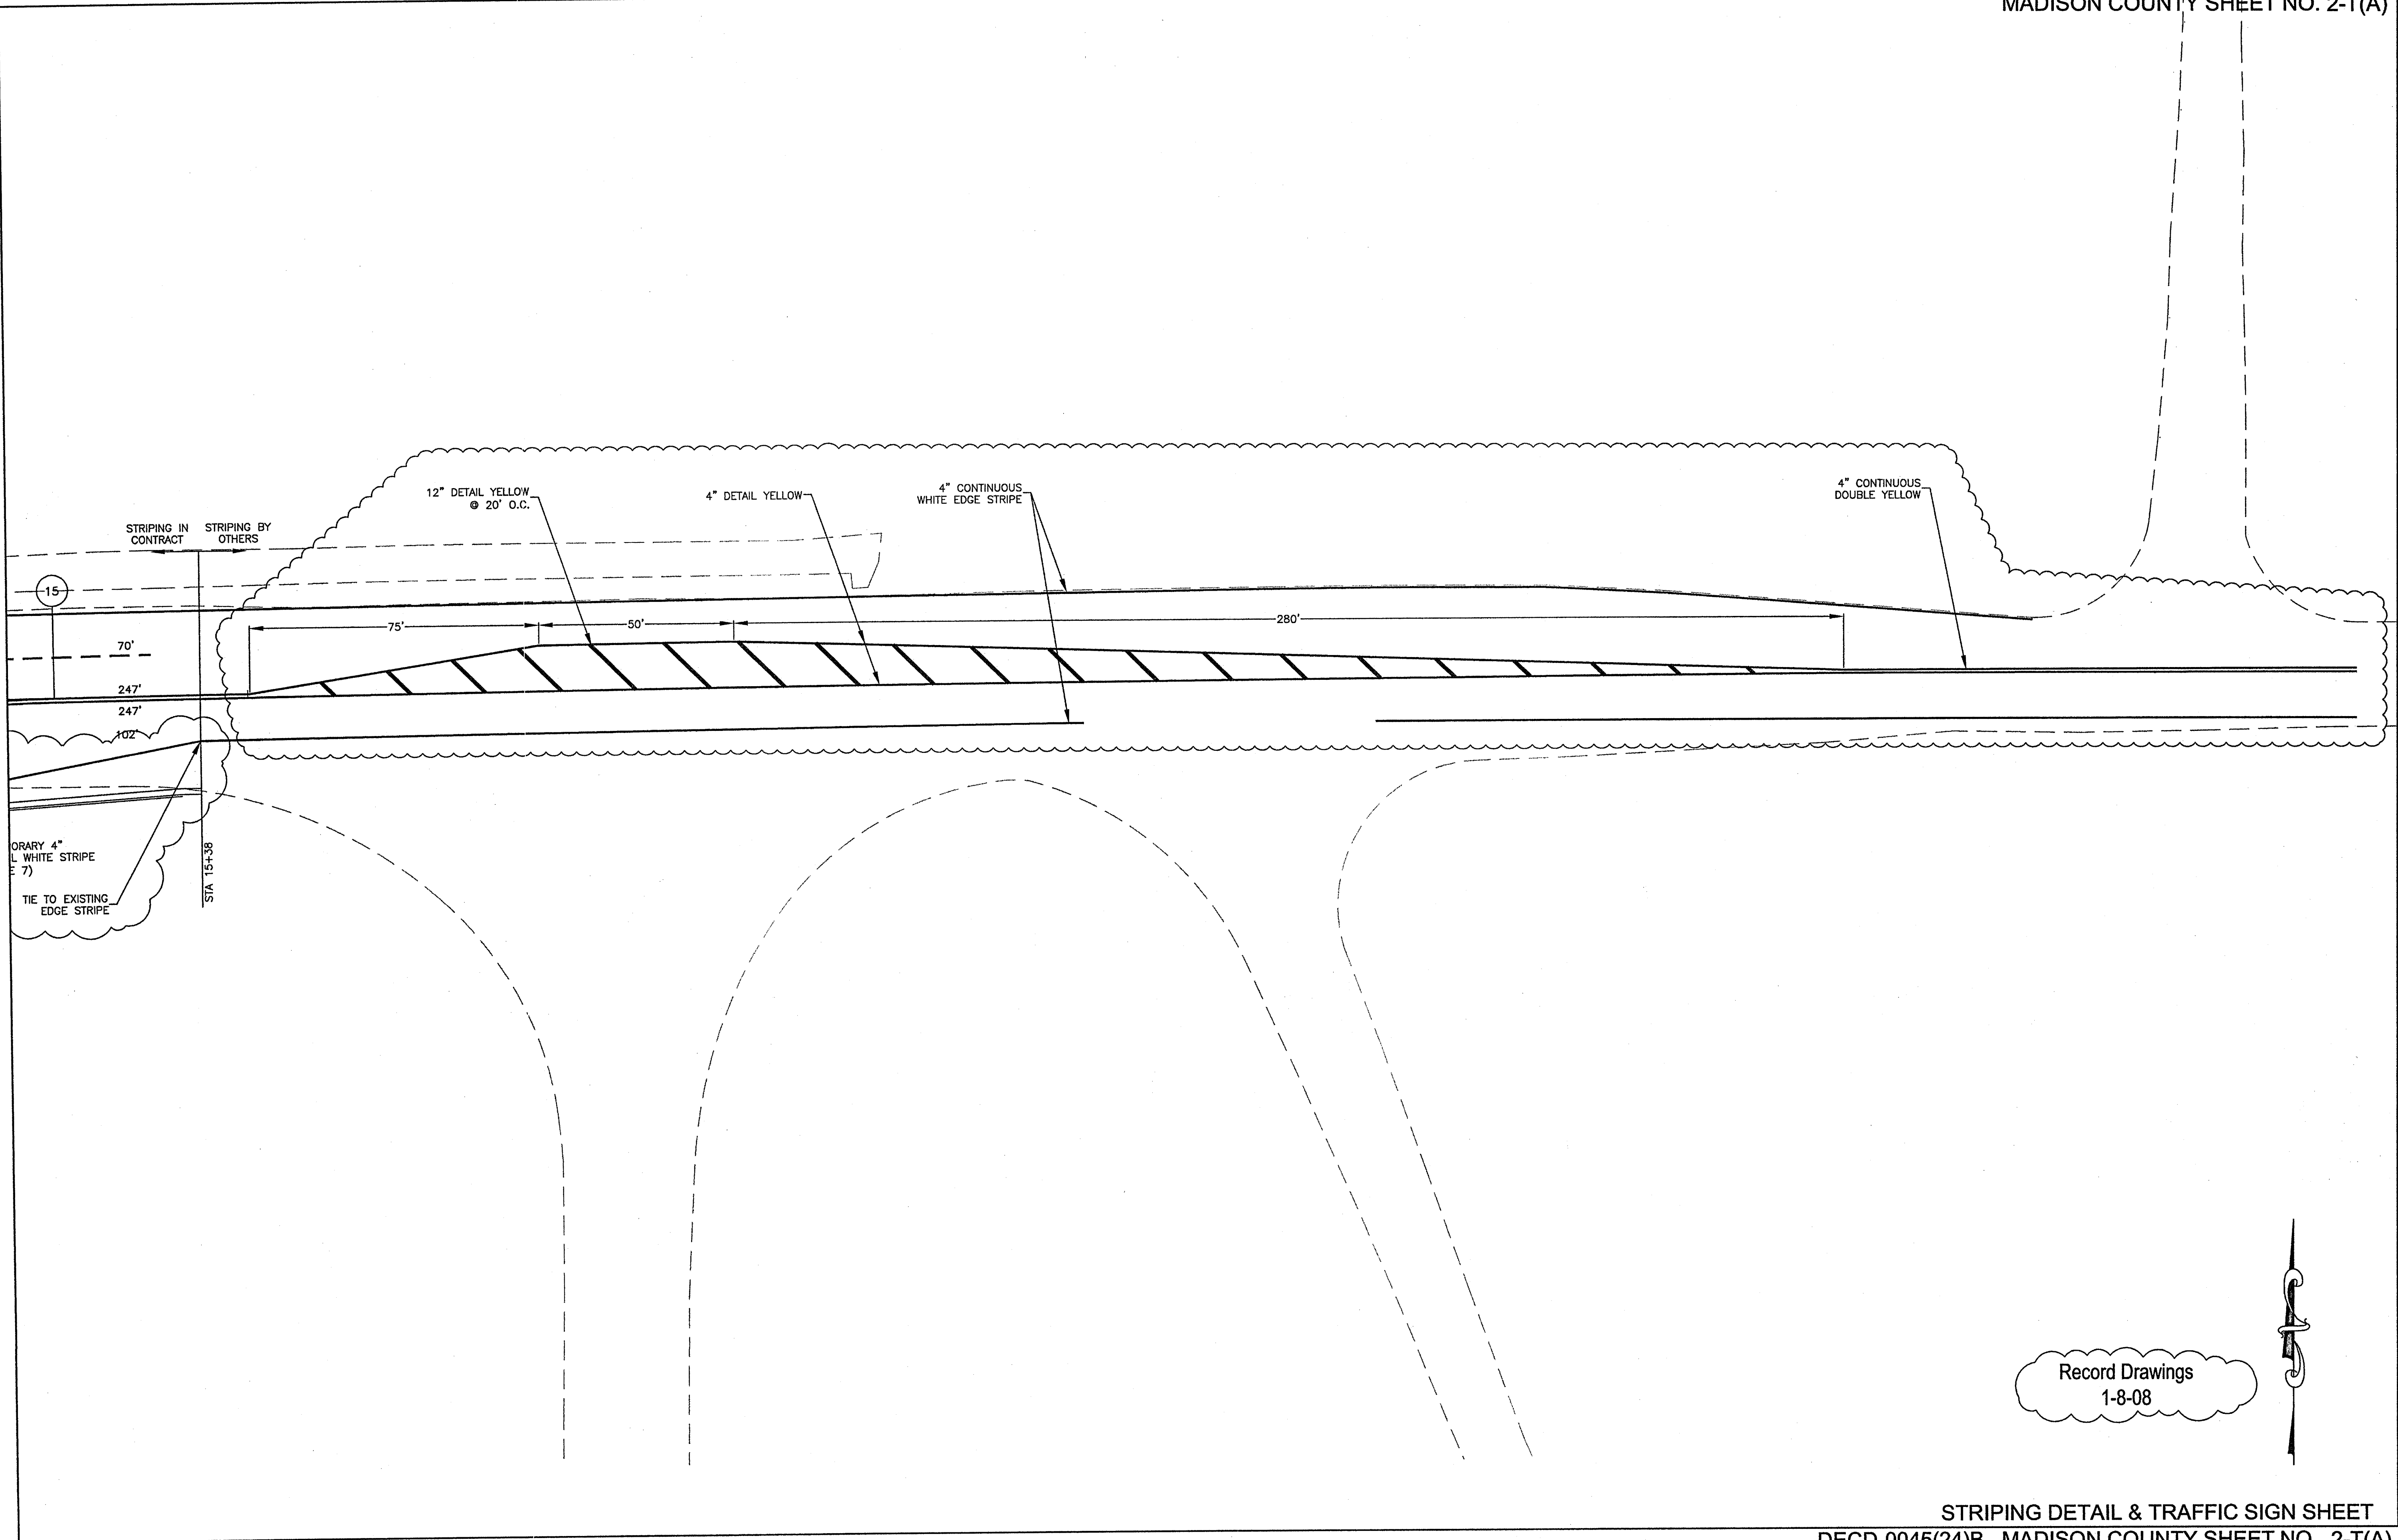


Record Drawings
1-8-08




Copyrighted material

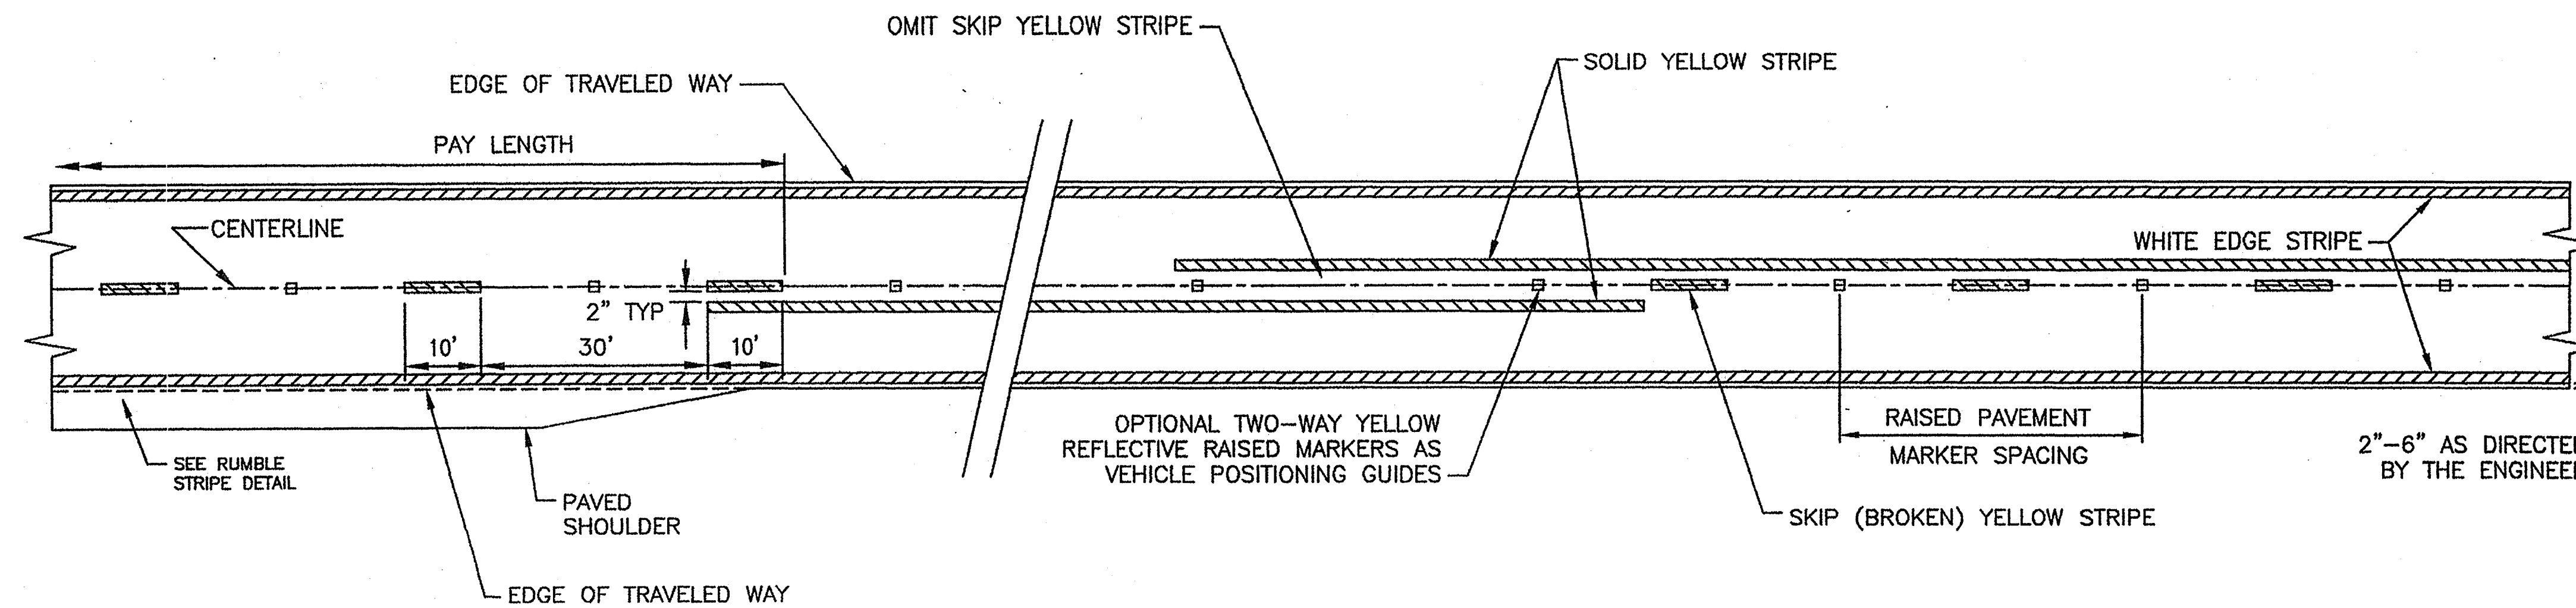

STRIPING DETAIL (TWO-WAY TRAFFIC)
ASPHALT OR CONCRETE PAVEMENT
(not to scale)

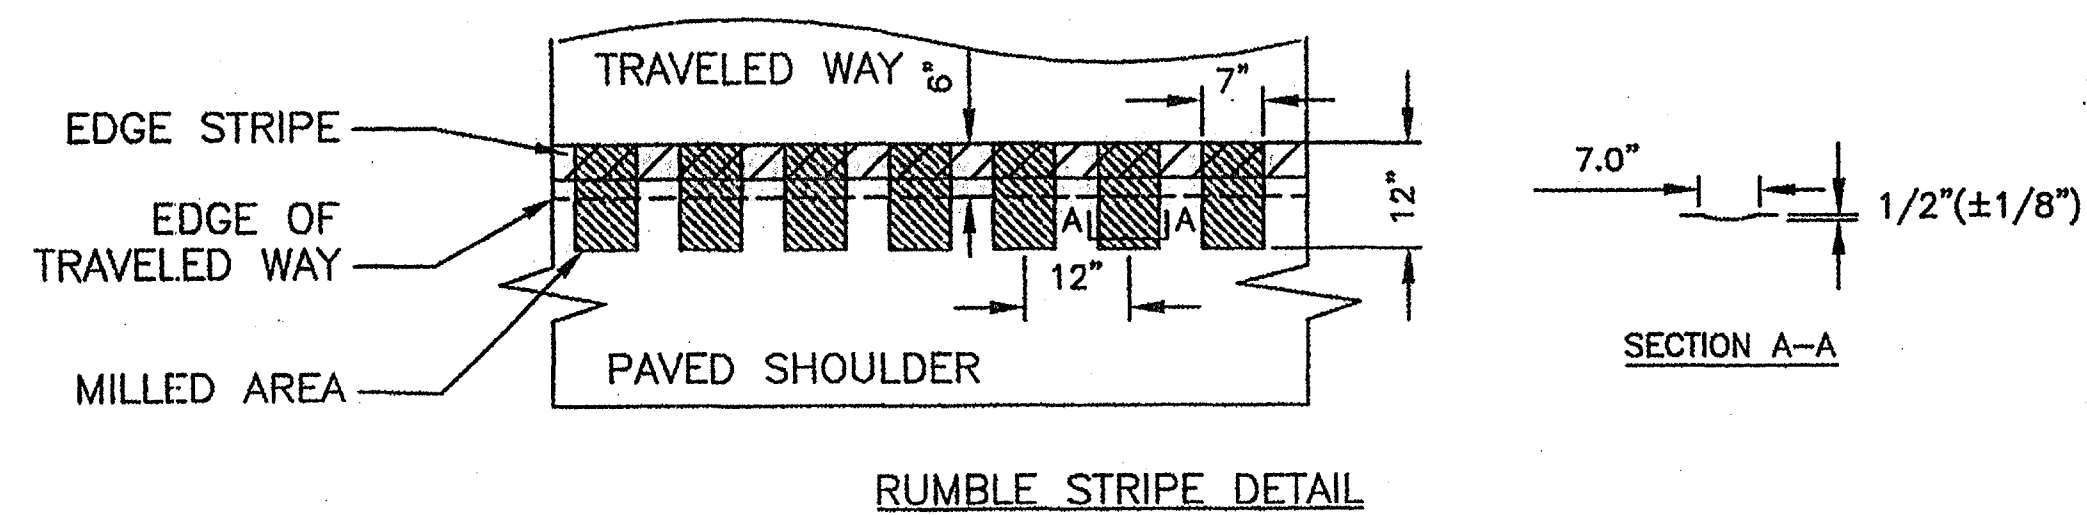

RUMBLE STRIPE DETAIL

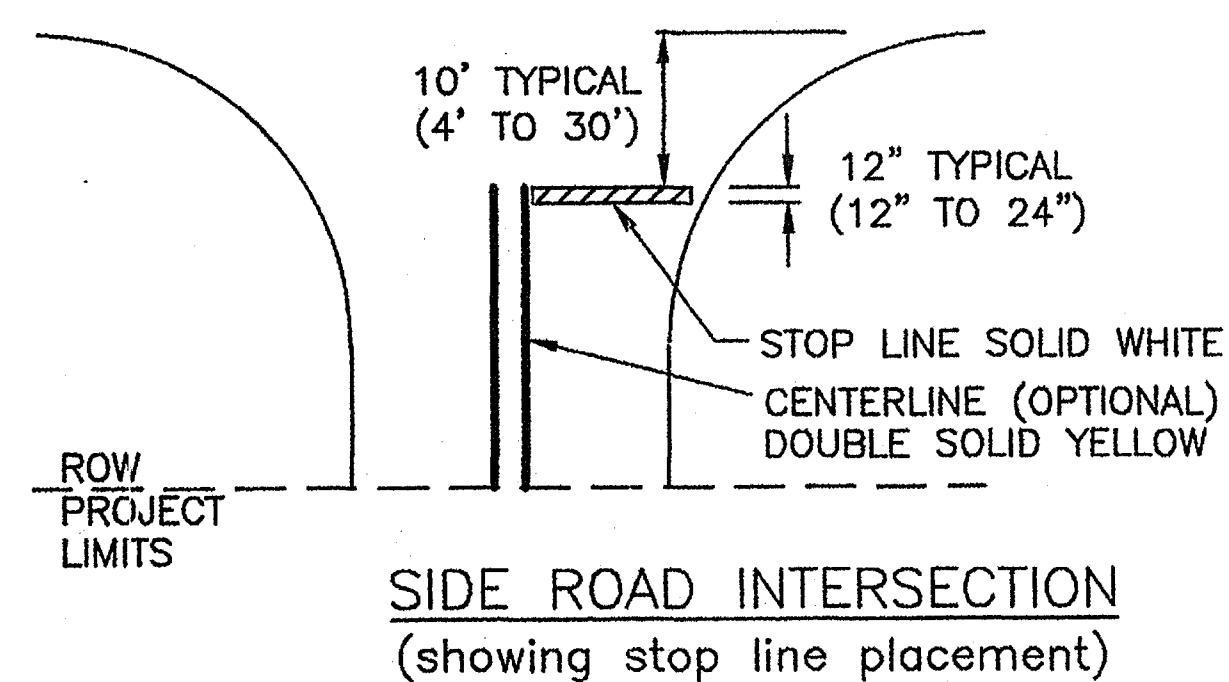

SIDE ROAD INTERSECTION
(showing stop line placement)

NOTES:

REFER TO STRIPING AND SIGNING SHEETS IN THE PLANS FOR STRIPE WIDTH AND REQUIRED STRIPING LOCATIONS IN ACCORDANCE WITH THE MANUAL ON UNIFORM TRAFFIC CONTROL DEVICES.

EDGE STRIPE SHALL BE OMITTED AT ALL TURNOUTS AND INTERSECTIONS, AND CONTINUED THROUGH ALL RAMPS AND DRIVEWAYS UNLESS SHOWN OTHERWISE ON THE PLANS. EDGE STRIPE SHALL BE THE SAME MATERIAL AS CENTERLINE STRIPE. CENTERLINE STRIPE ON CONCRETE PAVEMENT SHALL BE OFFSET 1" FROM PAVEMENT JOINT.


TYPICAL SPACING OF RAISED PAVEMENT MARKERS IS:

AREA	URBAN	RURAL
TANGENT SECTIONS	40'	80'
HORIZONTAL CURVES	40'	40'

Record Drawings
1-8-08


PASSING SIGHT DISTANCE SCHEDULE	
85TH-PERCENTILE OR POSTED OR STATUTORY SPEED LIMIT (MPH)	MINIMUM PASSING SIGHT DISTANCE (FEET)
25	450
30	500
35	550
40	600
50	800
60	1000

BY		OFFICE OF STATE AID ROAD CONSTRUCTION MISSISSIPPI DEPARTMENT OF TRANSPORTATION	
REVISION		PAVEMENT STRIPING AND MARKING	
DATE			
BY:	DATE:	DRAWING NUMBER:	
JBM	MAY 20, 2005	SA-PSM-1	

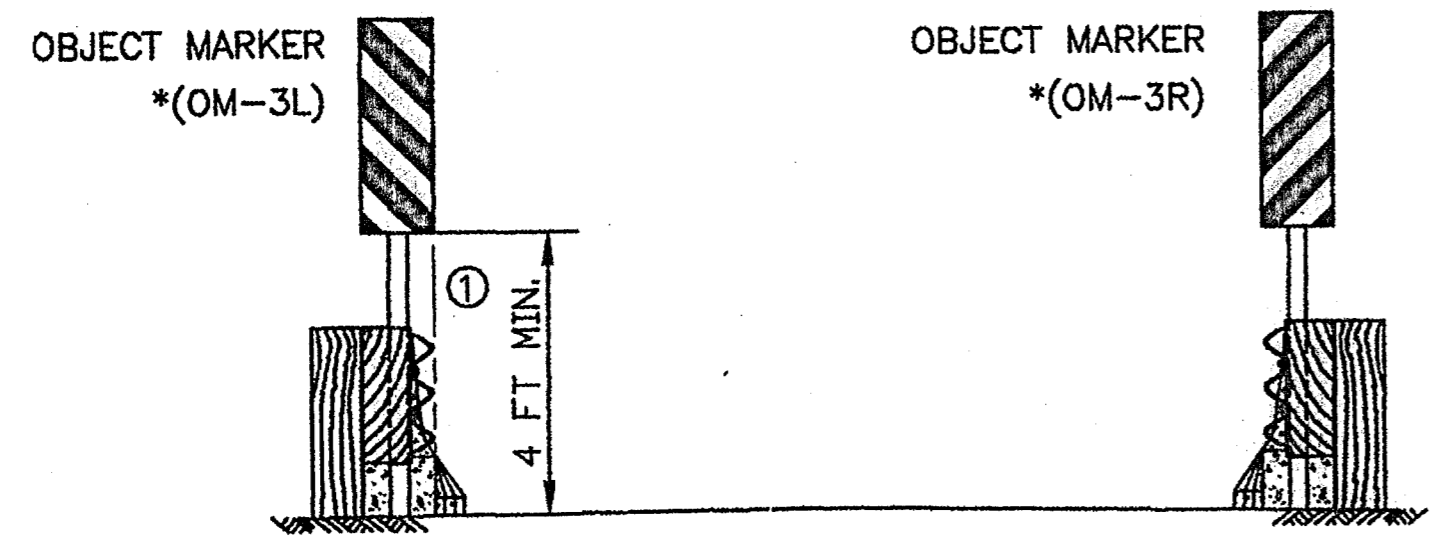


**TYPE 3 OBJECT MARKER INSTALLATION
AT BRIDGE ENDS**


① INSIDE EDGE OF MARKER SHALL BE IN LINE WITH INNER EDGE OF THE OBSTRUCTION AND SHOULD BE AS NEAR THE OBSTRUCTION AS PRACTICAL.

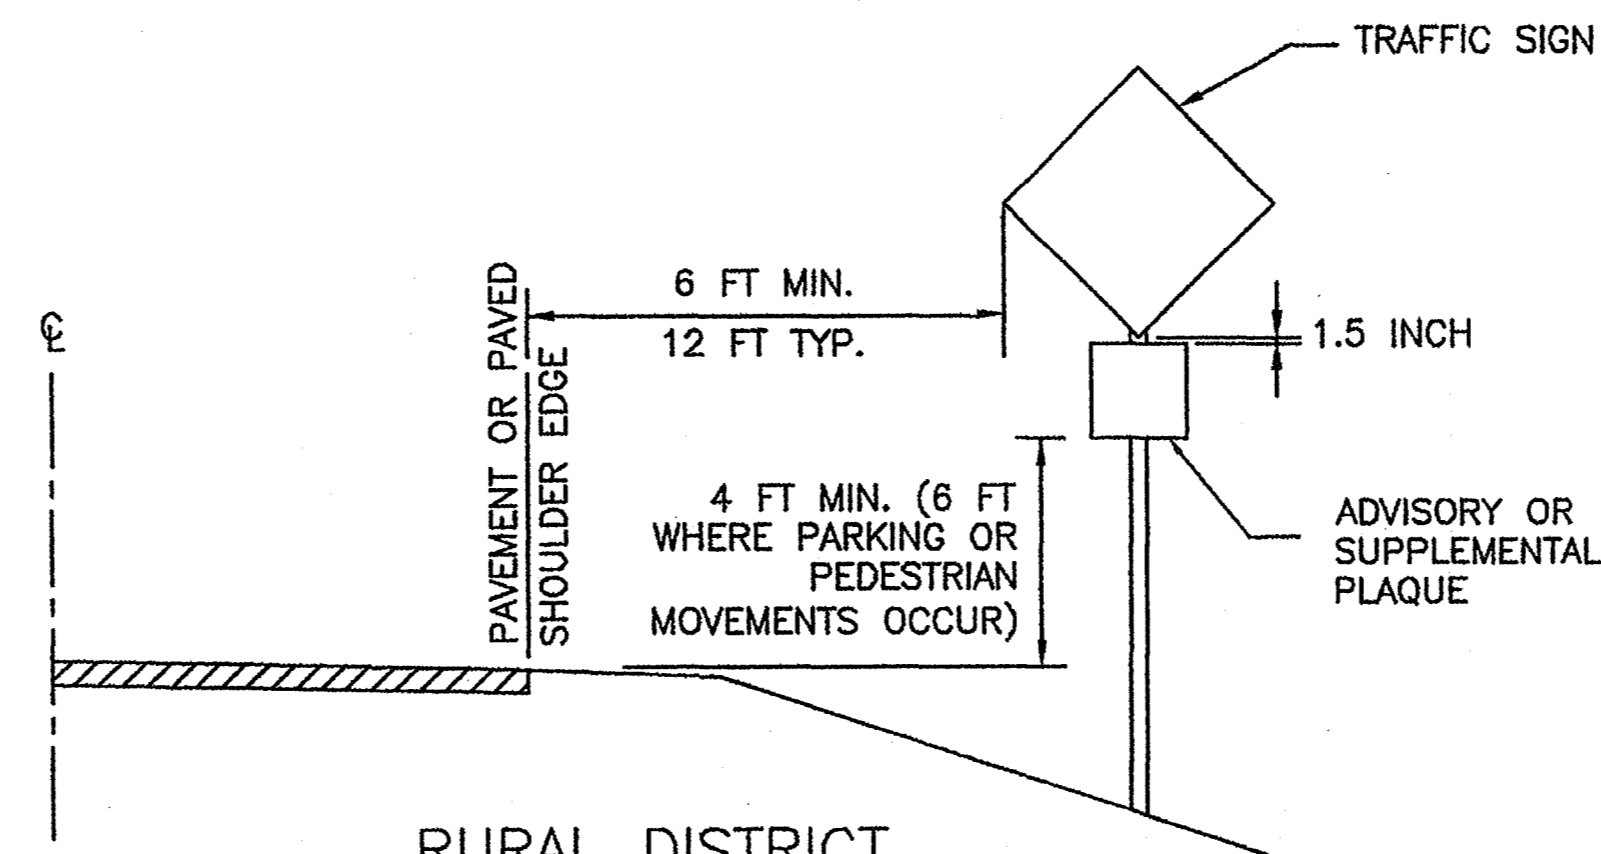


**RURAL DISTRICT
(SHOULDER AND SIDE SLOPE SECTION)**

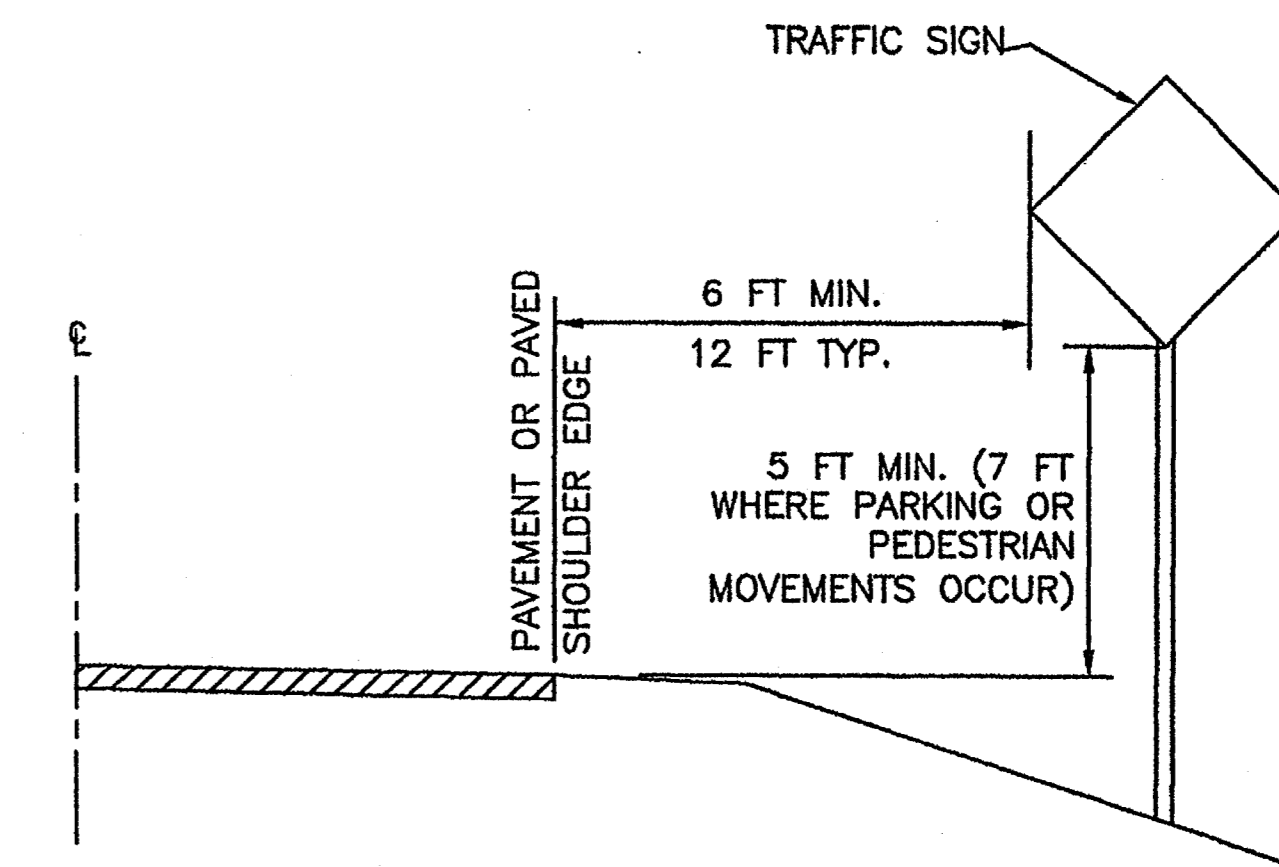

**RURAL DISTRICT
(SHOULDER AND SIDE SLOPE SECTION)**

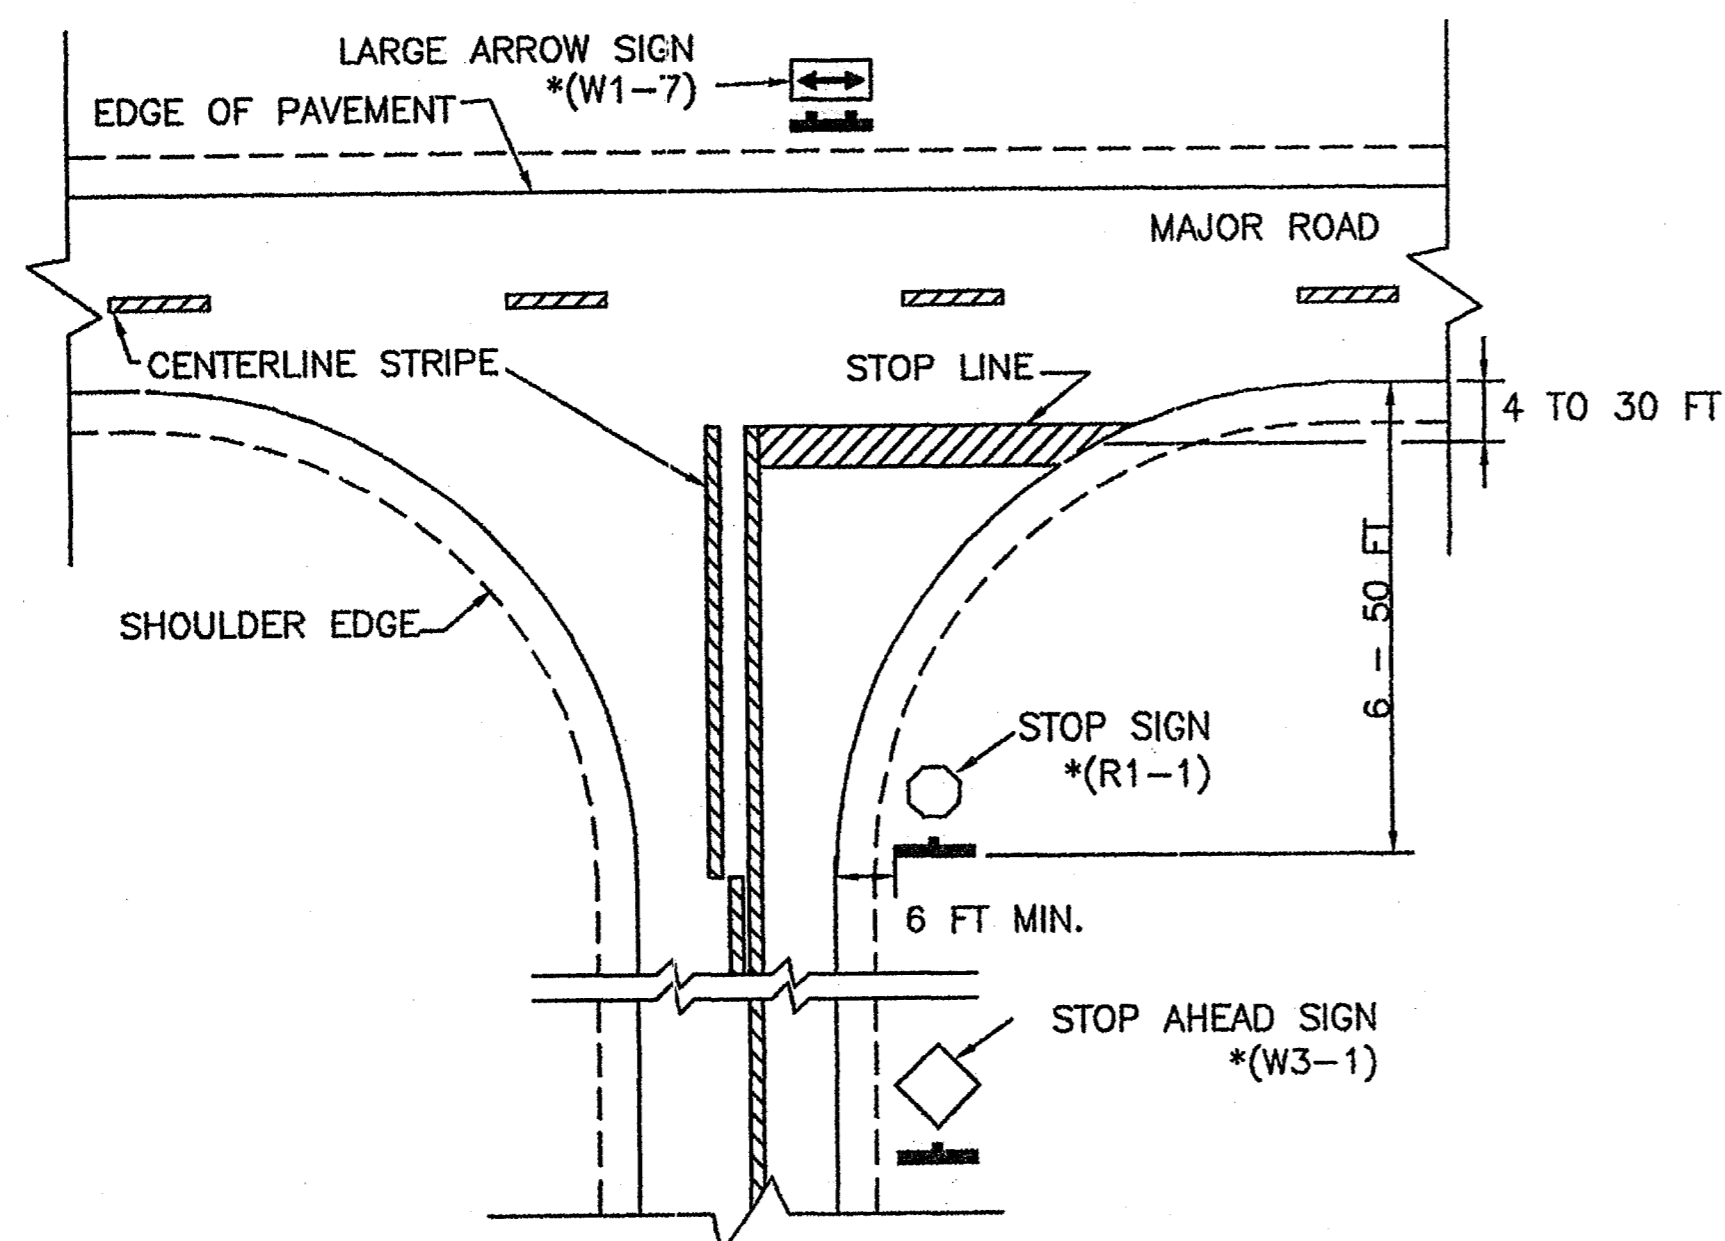

**TYPICAL TEE INTERSECTION
(PLAN VIEW)**

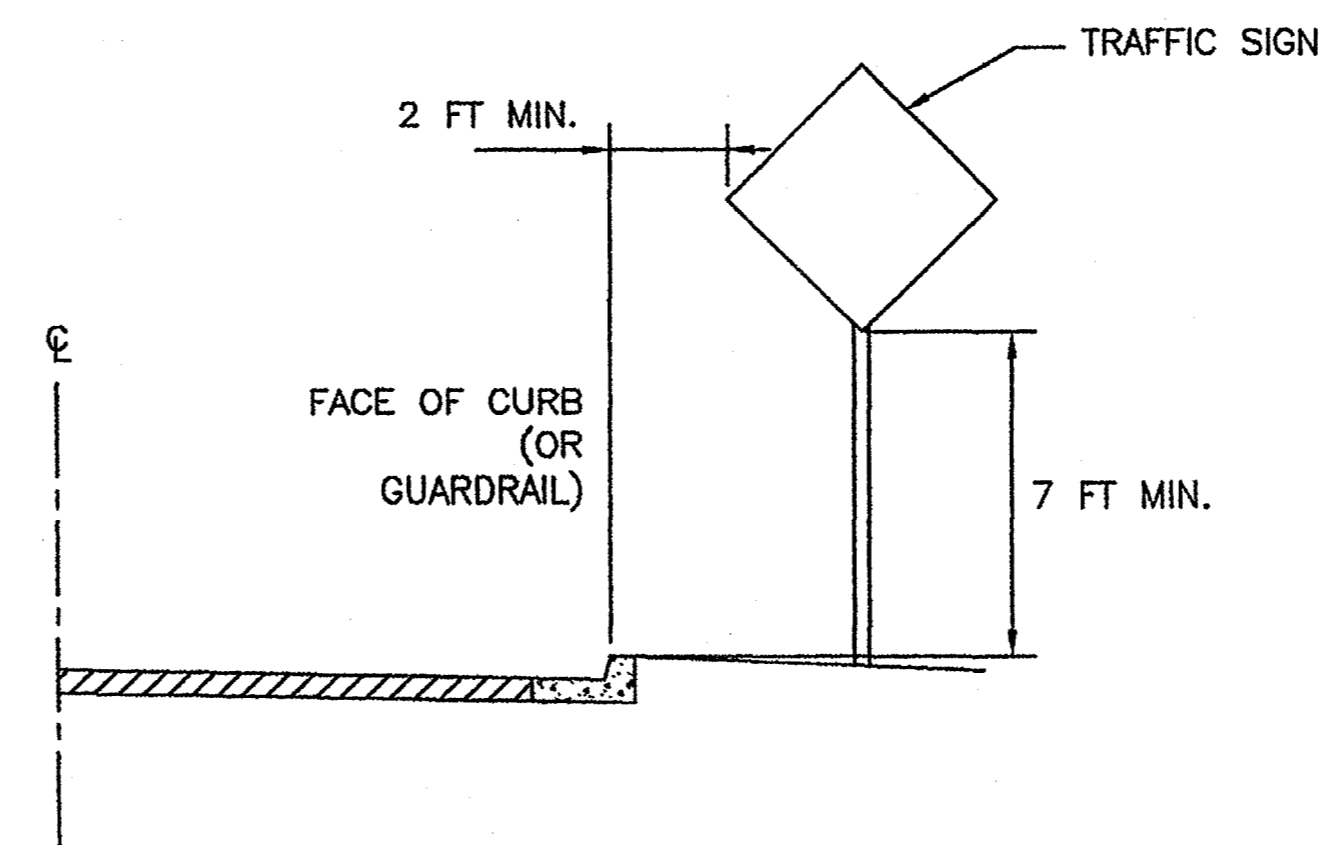

**BUSINESS OR RESIDENTIAL DISTRICT
(CURB & GUTTER SECTION)**

NOTES:
SIGN SIZE SHALL BE THAT DESIGNATED IN THE "MANUAL ON UNIFORM TRAFFIC CONTROL DEVICES" (MUTCD) FOR CONVENTIONAL ROADS.

THE 6-FT LATERAL OFFSET SHOWN FOR RURAL ROADS MAY BE REDUCED TO NO LESS THAN 2 FT ON LOW-VOLUME ROADS (ADT <400) IF ROADSIDE FEATURES SUCH AS TERRAIN, SHRUBBERY, AND/OR TREES PREVENT NORMAL INSTALLATION.

STOP SIGNS *(R1-1) SHOULD BE LOCATED 6 FT TO 50 FT FROM THE INTERSECTING PAVEMENT EDGE AND AS CLOSE AS PRACTICAL TO THE INTERSECTION WHILE PROVIDING MAXIMUM VISIBILITY. IF STOP SIGN VISIBILITY IS RESTRICTED, A STOP AHEAD SIGN SHALL BE INSTALLED IN ADVANCE OF THE STOP SIGN. SEE MUTCD.



POSTS FOR TRAFFIC SIGNS SHALL BE EITHER 4"x4" S4S TREATED TIMBER, OR STEEL.

*SIGN TYPE DESIGNATION REFERS TO THE MUTCD.


Record Drawings
1-8-08

BY:	OFFICE OF STATE AID ROAD CONSTRUCTION MISSISSIPPI DEPARTMENT OF TRANSPORTATION		
REVISION:	TRAFFIC SIGN PLACEMENT		
DATE:	BY:	DATE:	DRAWING NUMBER:
	JBM	NOVEMBER 16, 2004	SA-TSP-1


STATE	PROJECT NO.
MISS.	

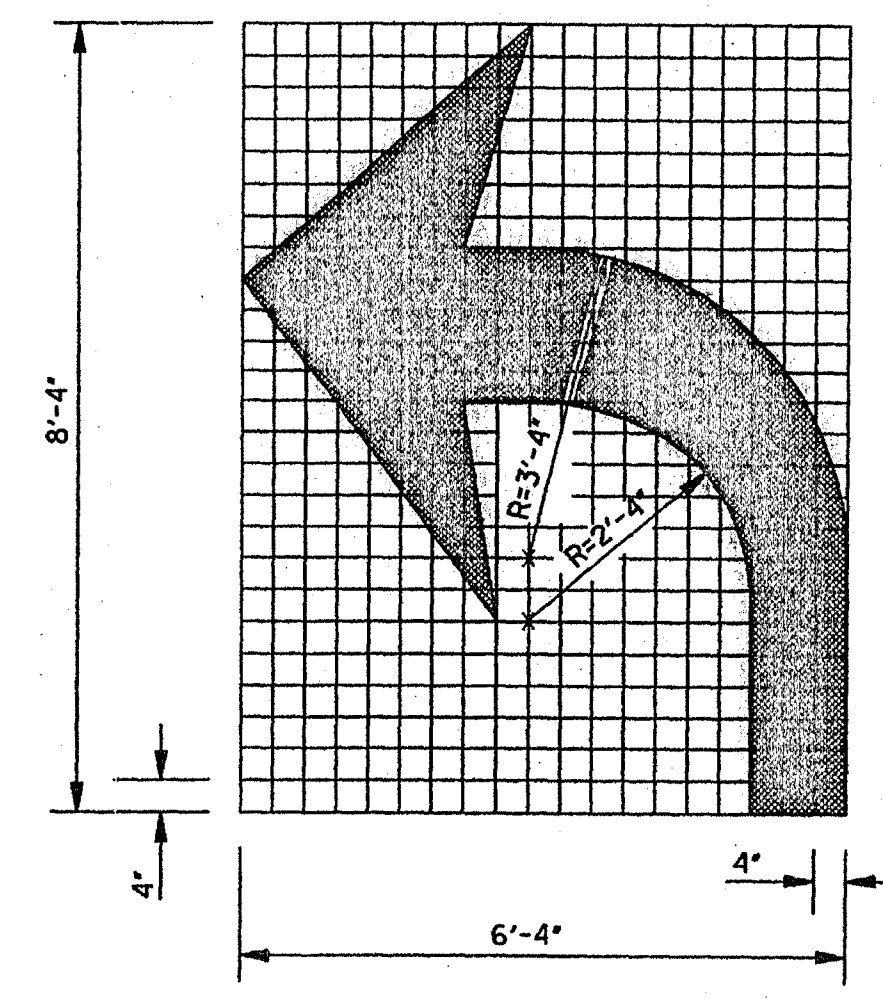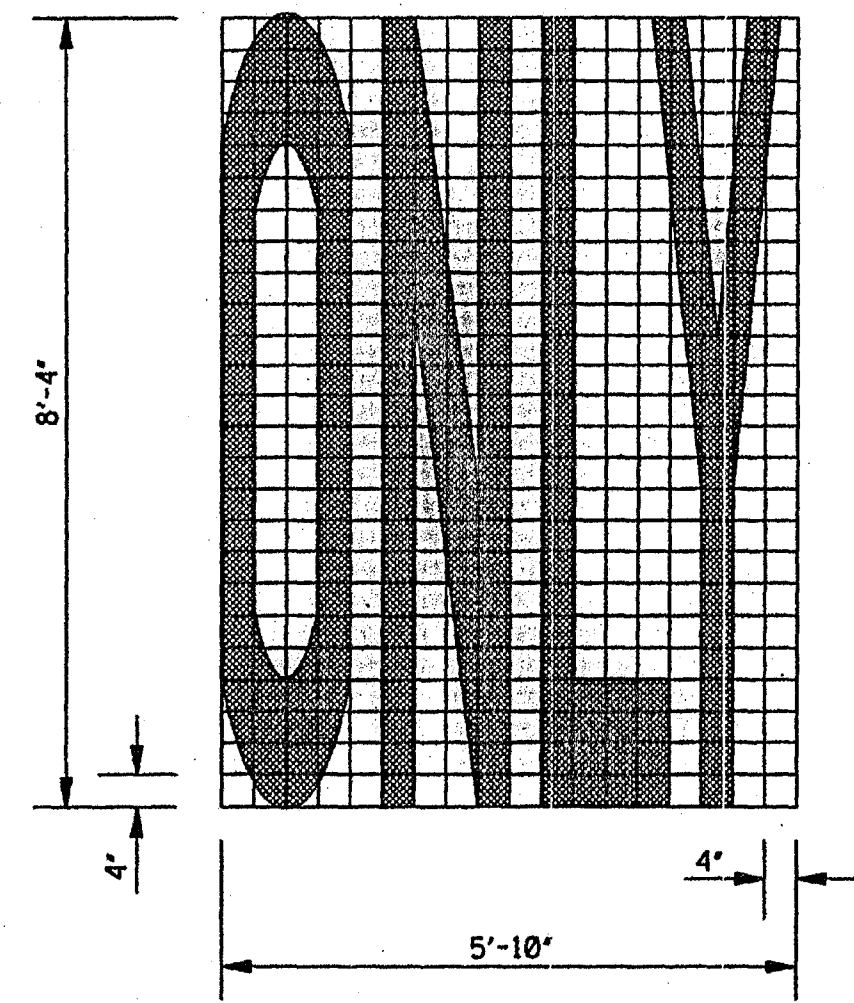

TURN ARROW

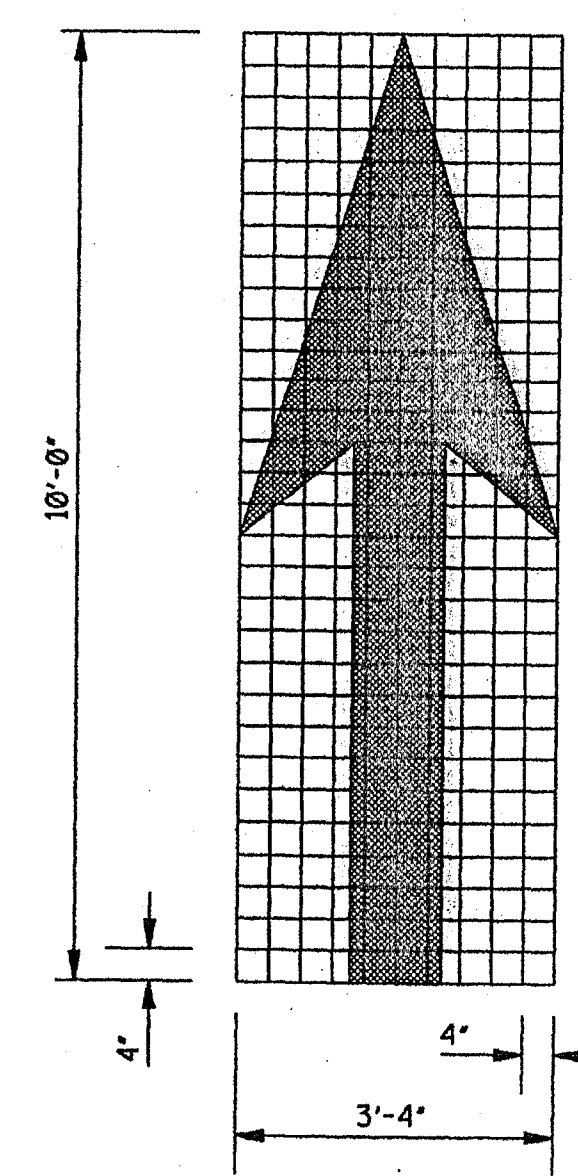

THRU ARROW

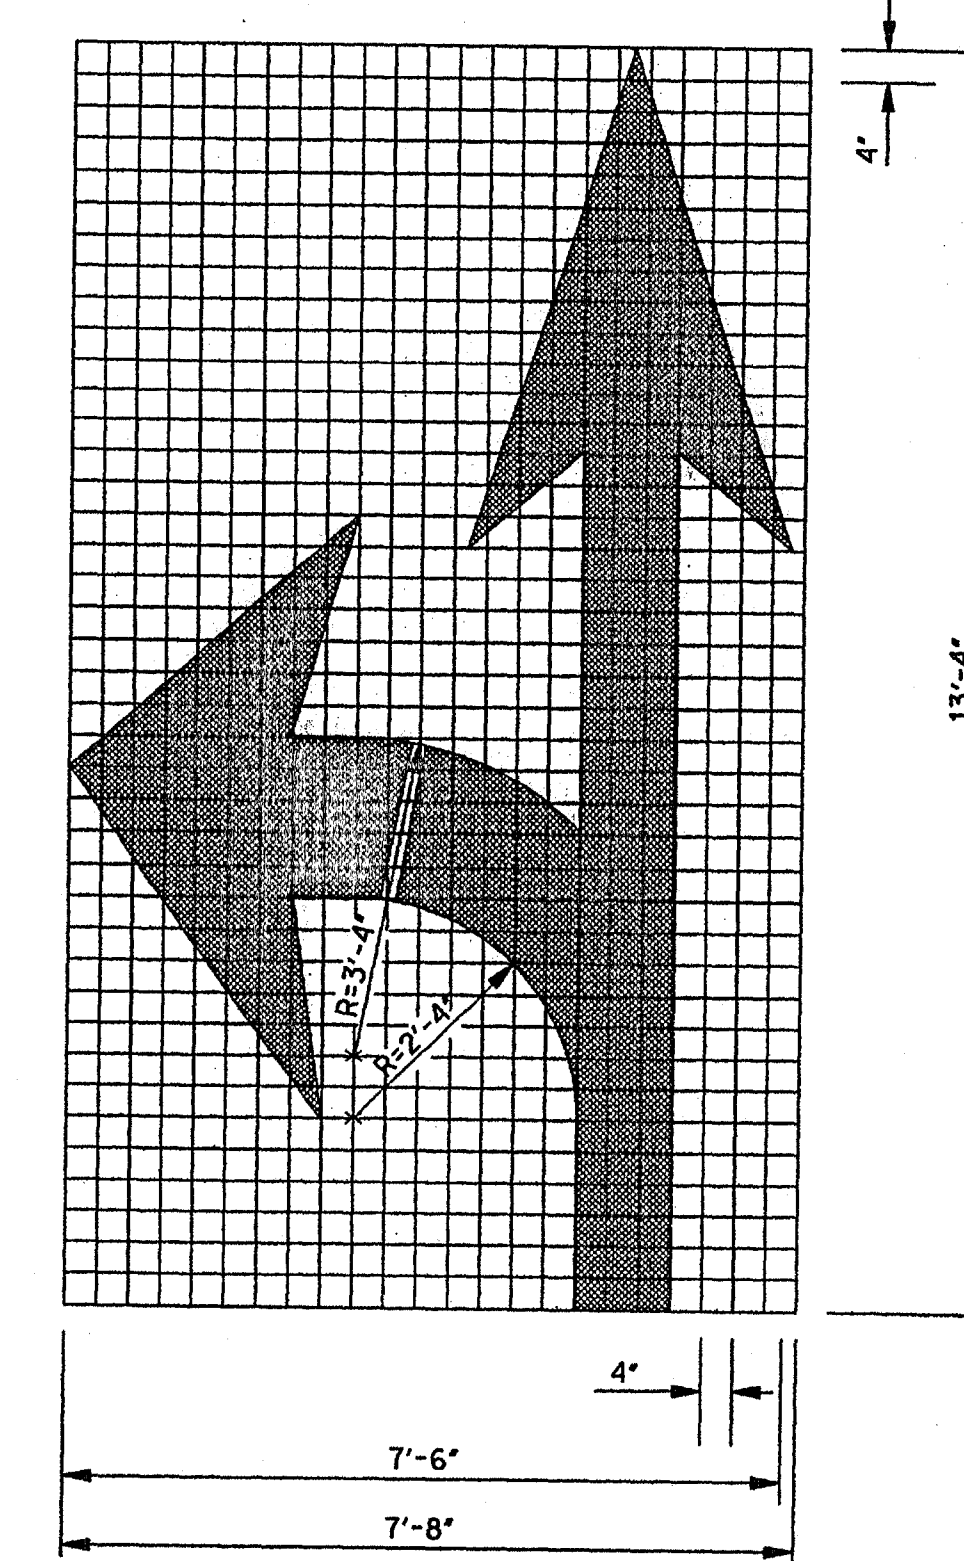


COMBINATION ARROW

GENERAL NOTES:

1. UNLESS OTHERWISE SHOWN ON THE PLANS, ALL PAVEMENT MARKING LEGENDS, INCLUDING TURN ARROWS, SHALL BE APPLIED USING HIGH PERFORMANCE MATERIALS.
2. TWO HORIZONTAL GAPS (CAUSED BY TEMPLATE CONNECTORS) OF 1/2" OR LESS AND EXTENDING THE FULL WIDTH ARE PERMITTED IN EACH LETTER.
3. FOR OTHER DETAILS, SEE THE MANUAL ON UNIFORM TRAFFIC CONTROL DEVICES.
4. PAY QUANTITIES FOR PAVEMENT MARKING LEGENDS ARE AS FOLLOWS:


PAY QUANTITIES	
LEGEND/SYMBOL	AREA (ft ²)
ONLY	22.0
TURN ARROW	16.4
THRU ARROW	12.3
COMB. ARROW	27.5
1-WAY ARROW	24.3






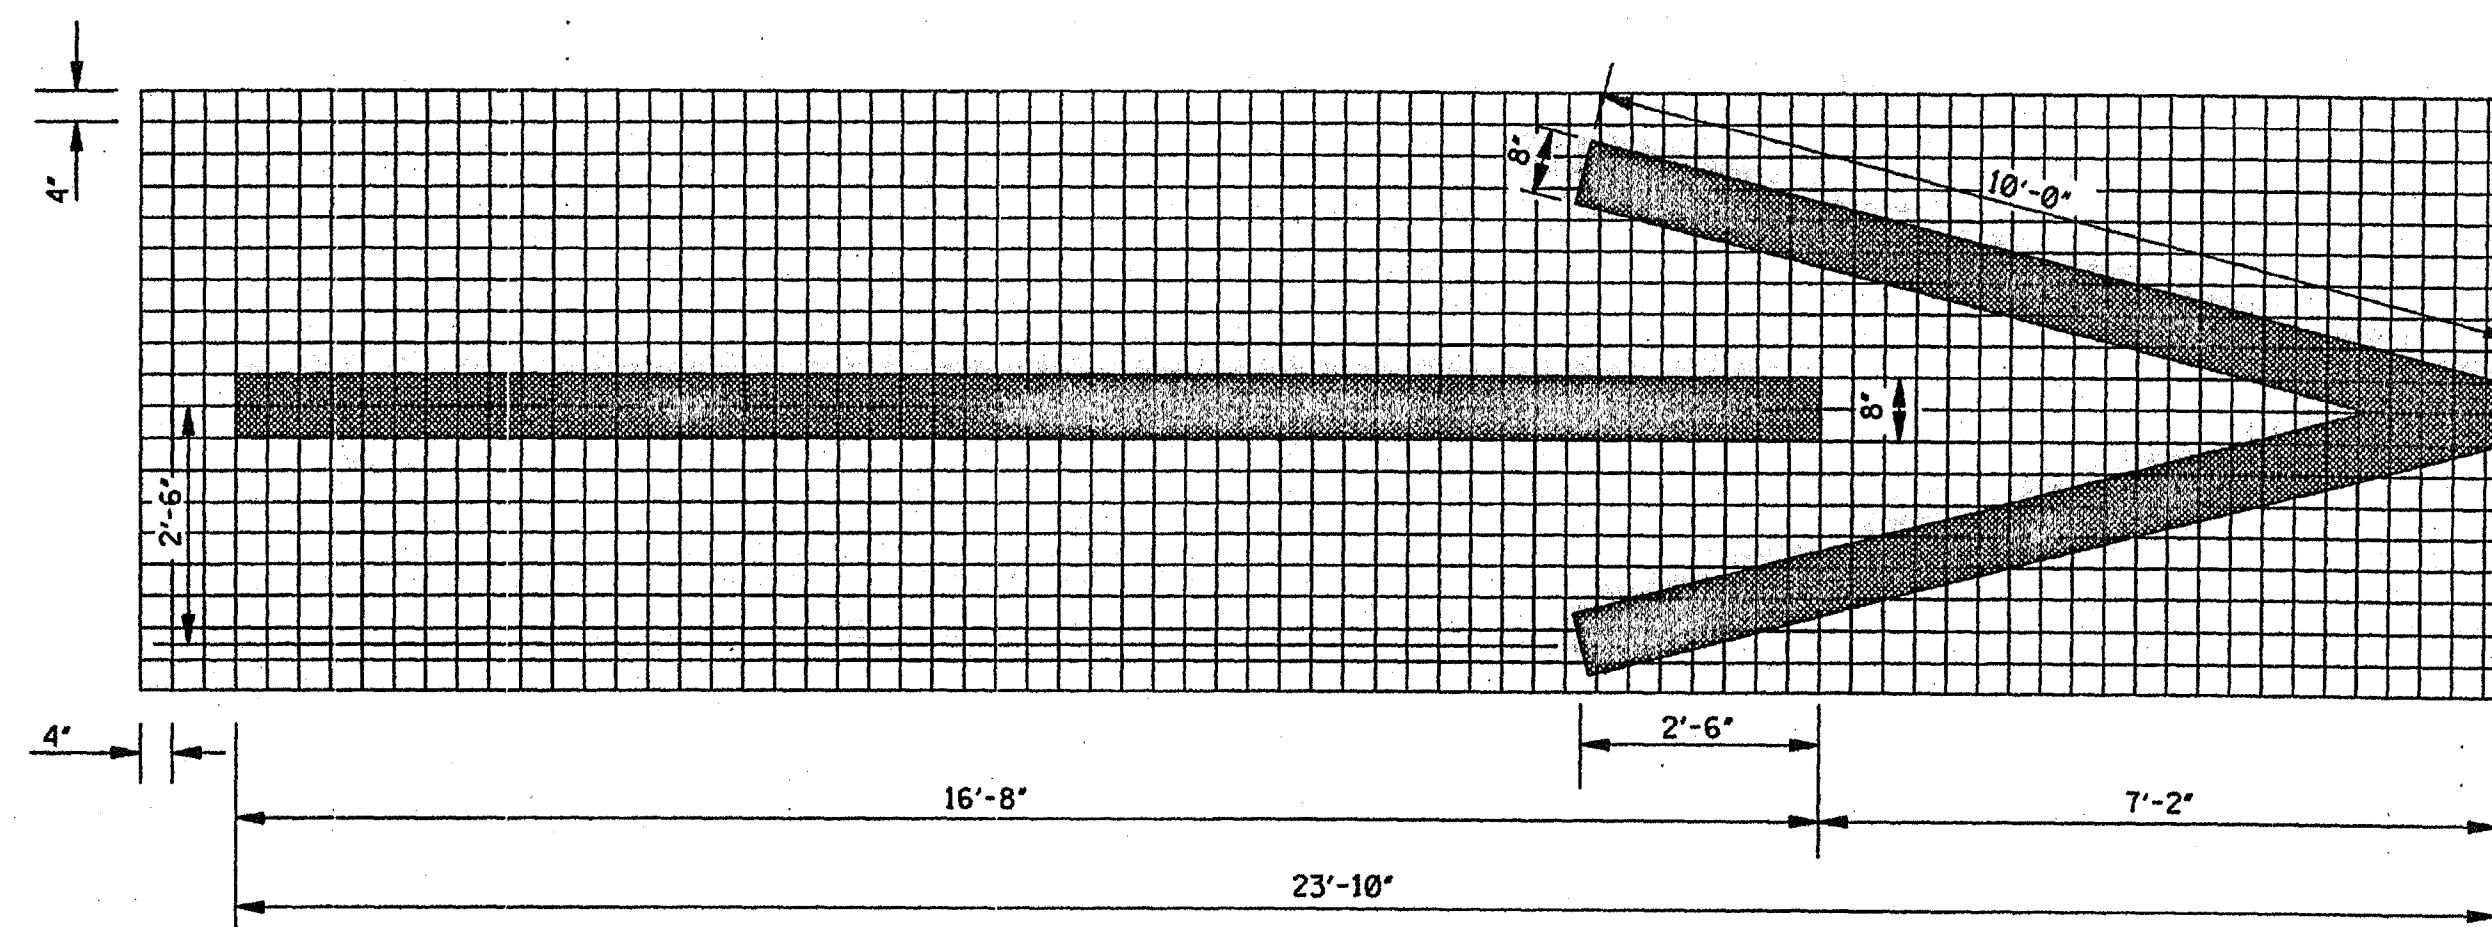


1-WAY ARROW

Record Drawings
1-8-08

DATE	ISSUE DATE: OCTOBER 1, 1998
REVISION	BY MISSISSIPPI DEPARTMENT OF TRANSPORTATION ROADWAY DESIGN DIVISION STANDARD PLAN
	PAVEMENT MARKING LEGEND DETAILS
	WORKING NUMBER PM-6
	SHEET NUMBER 125

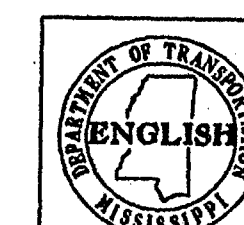

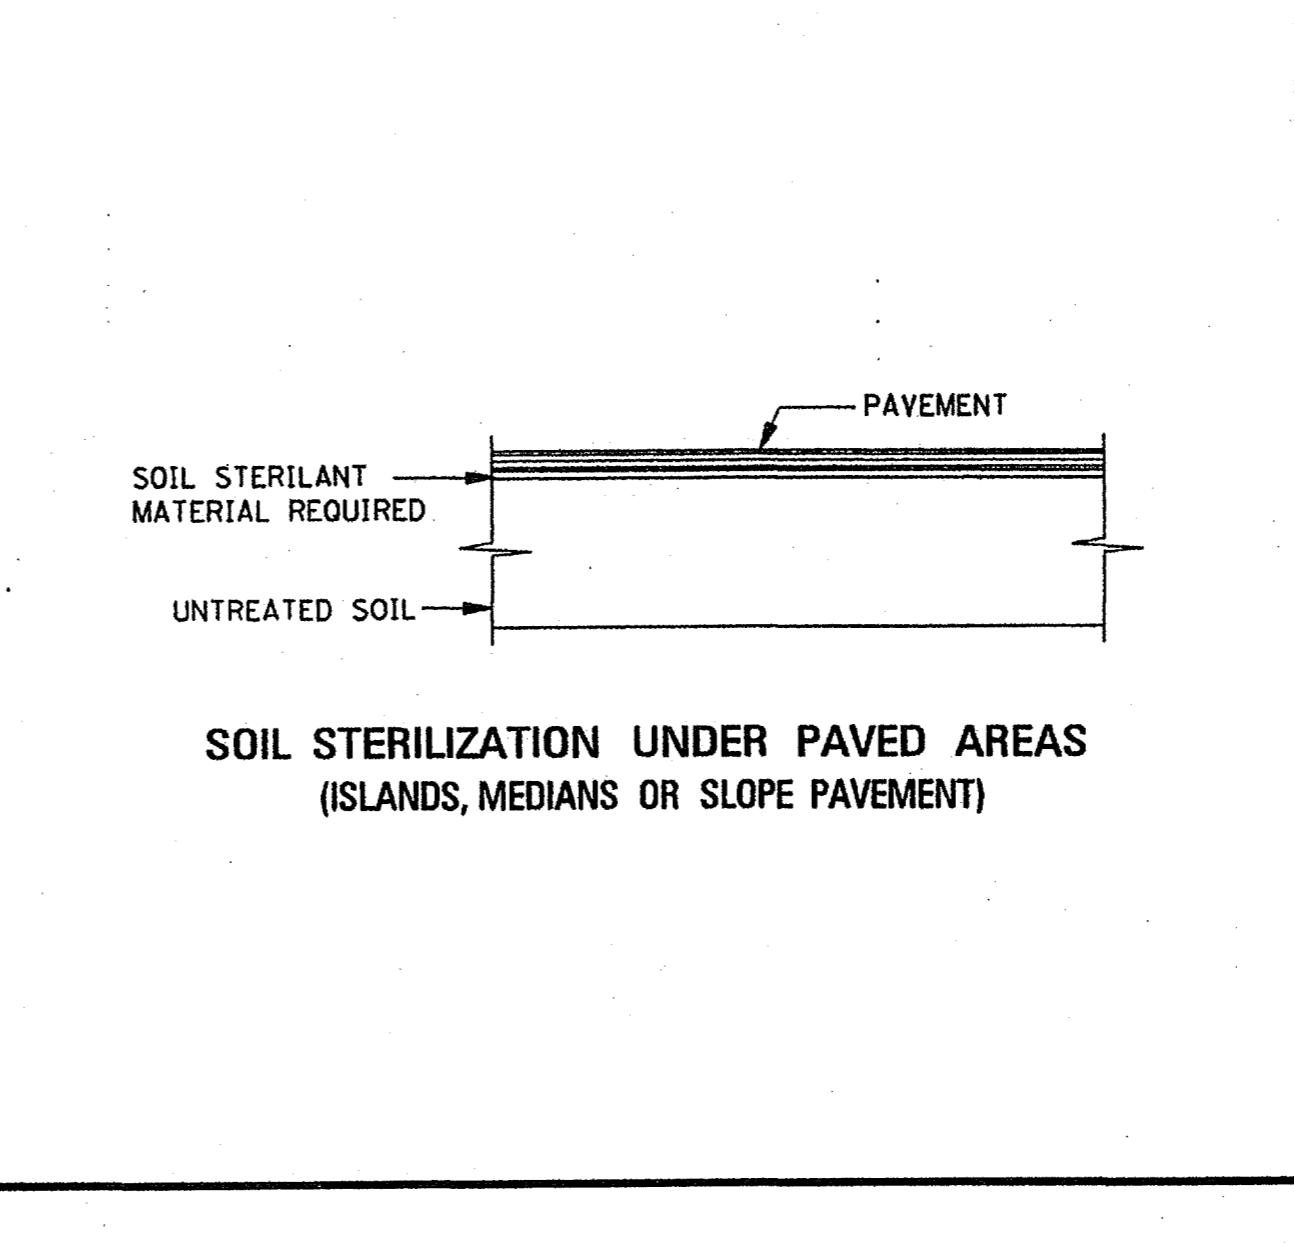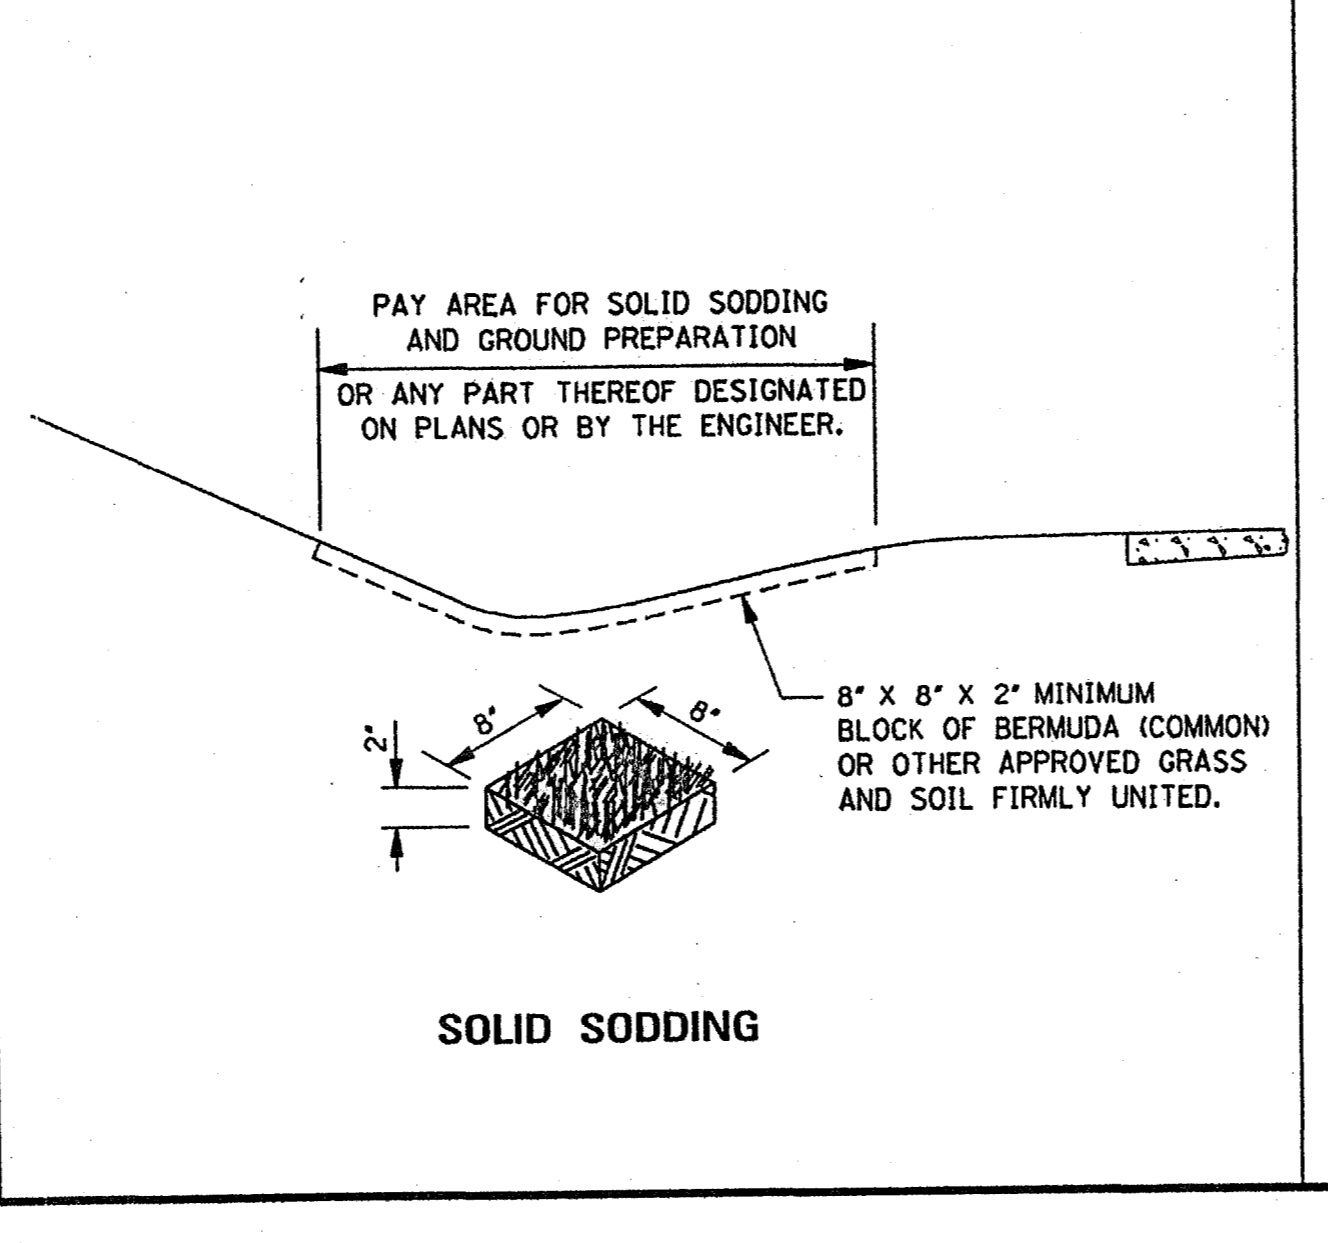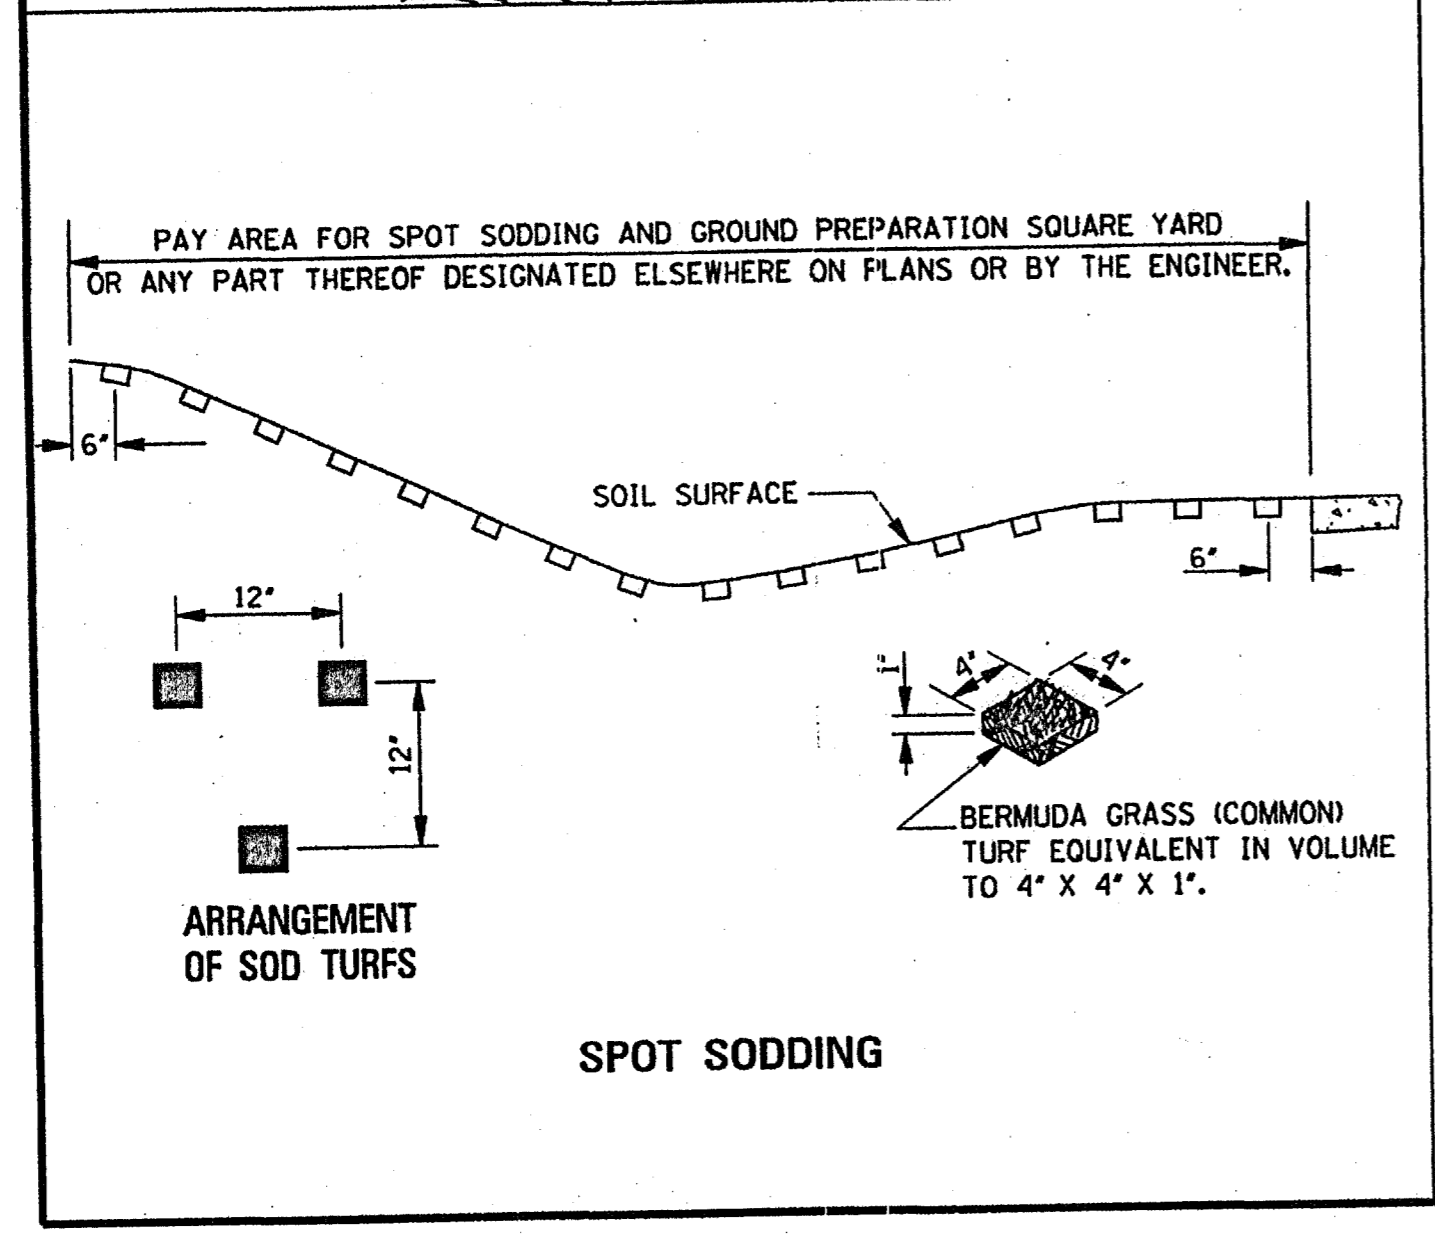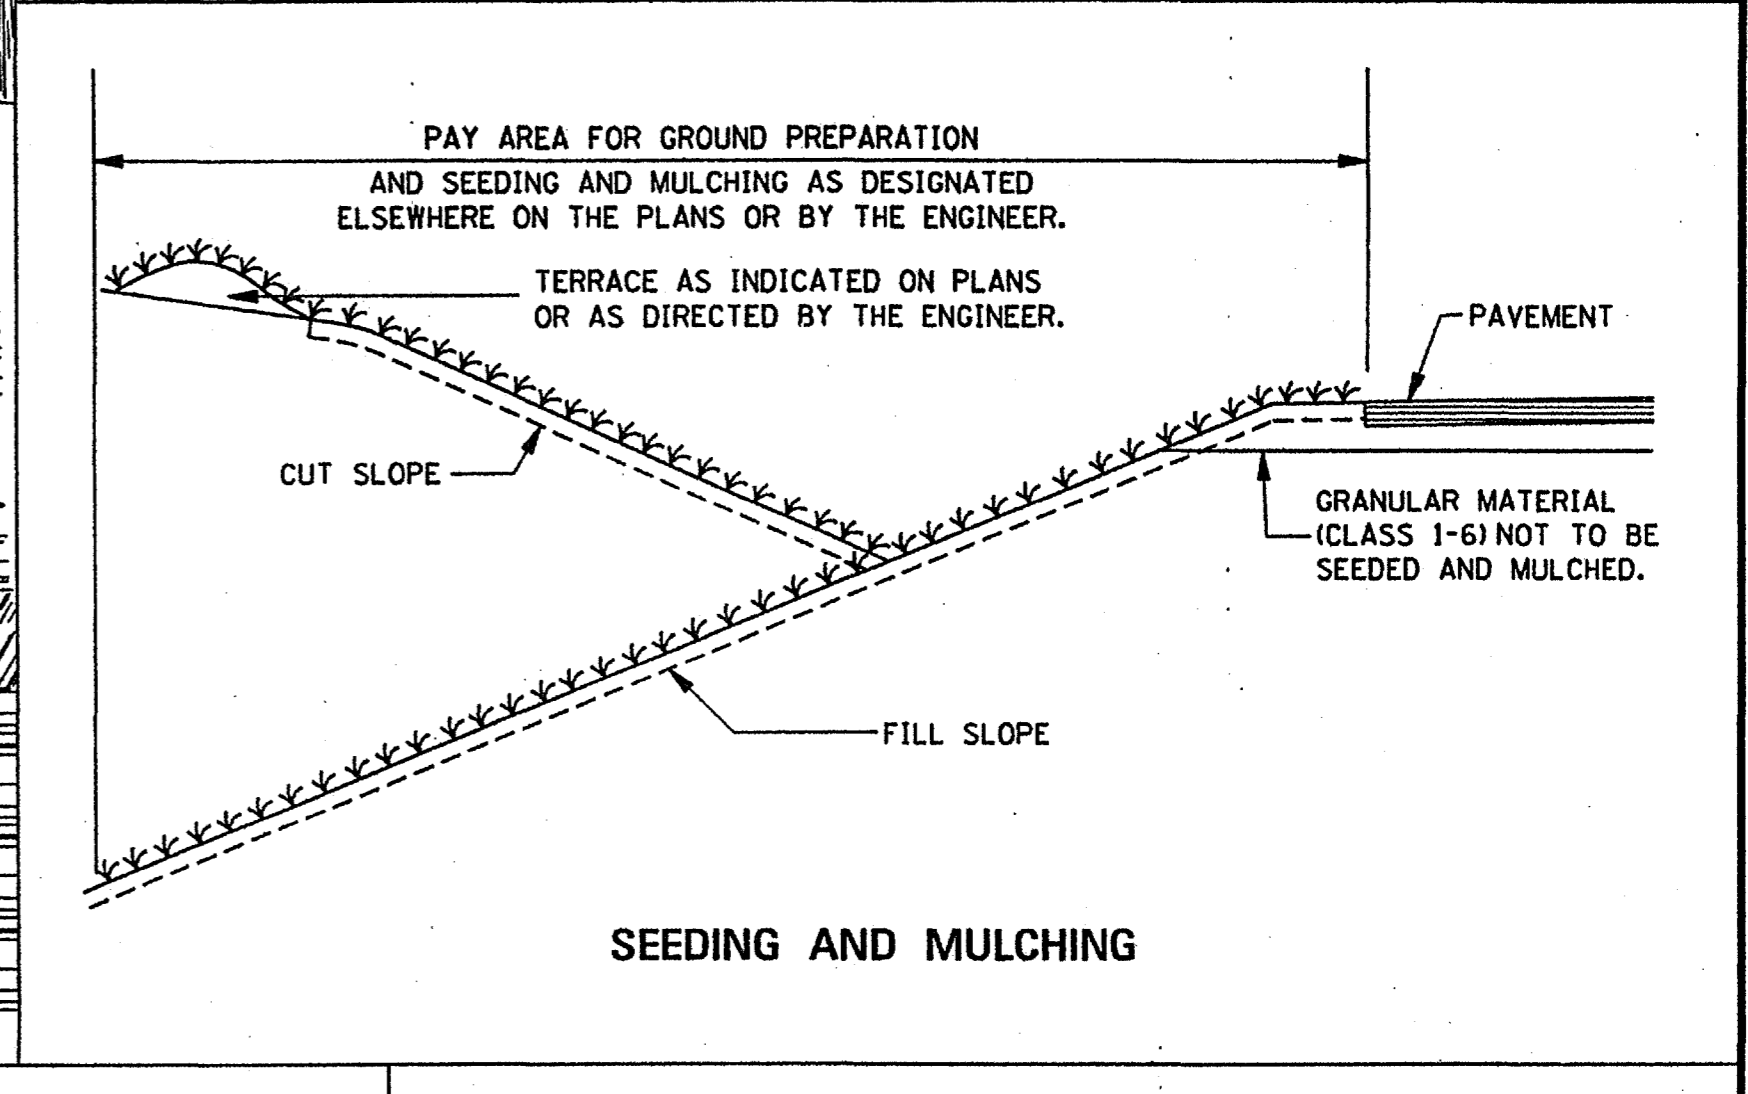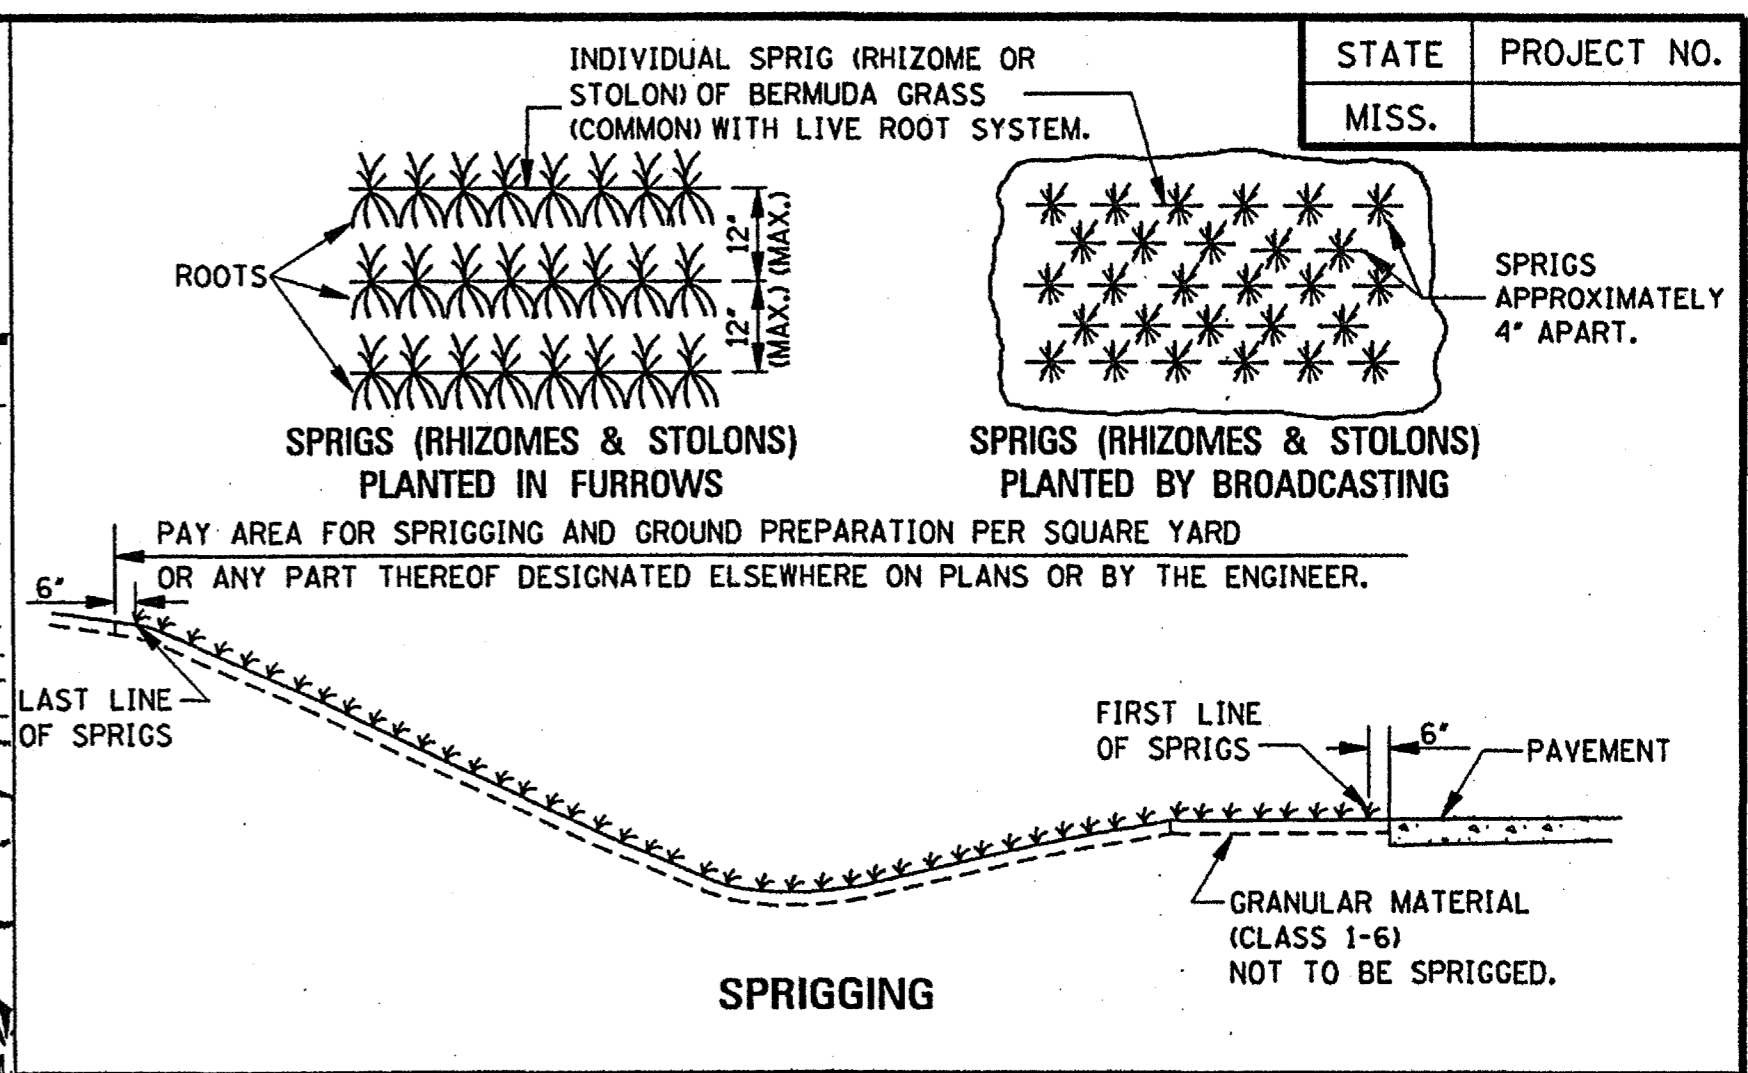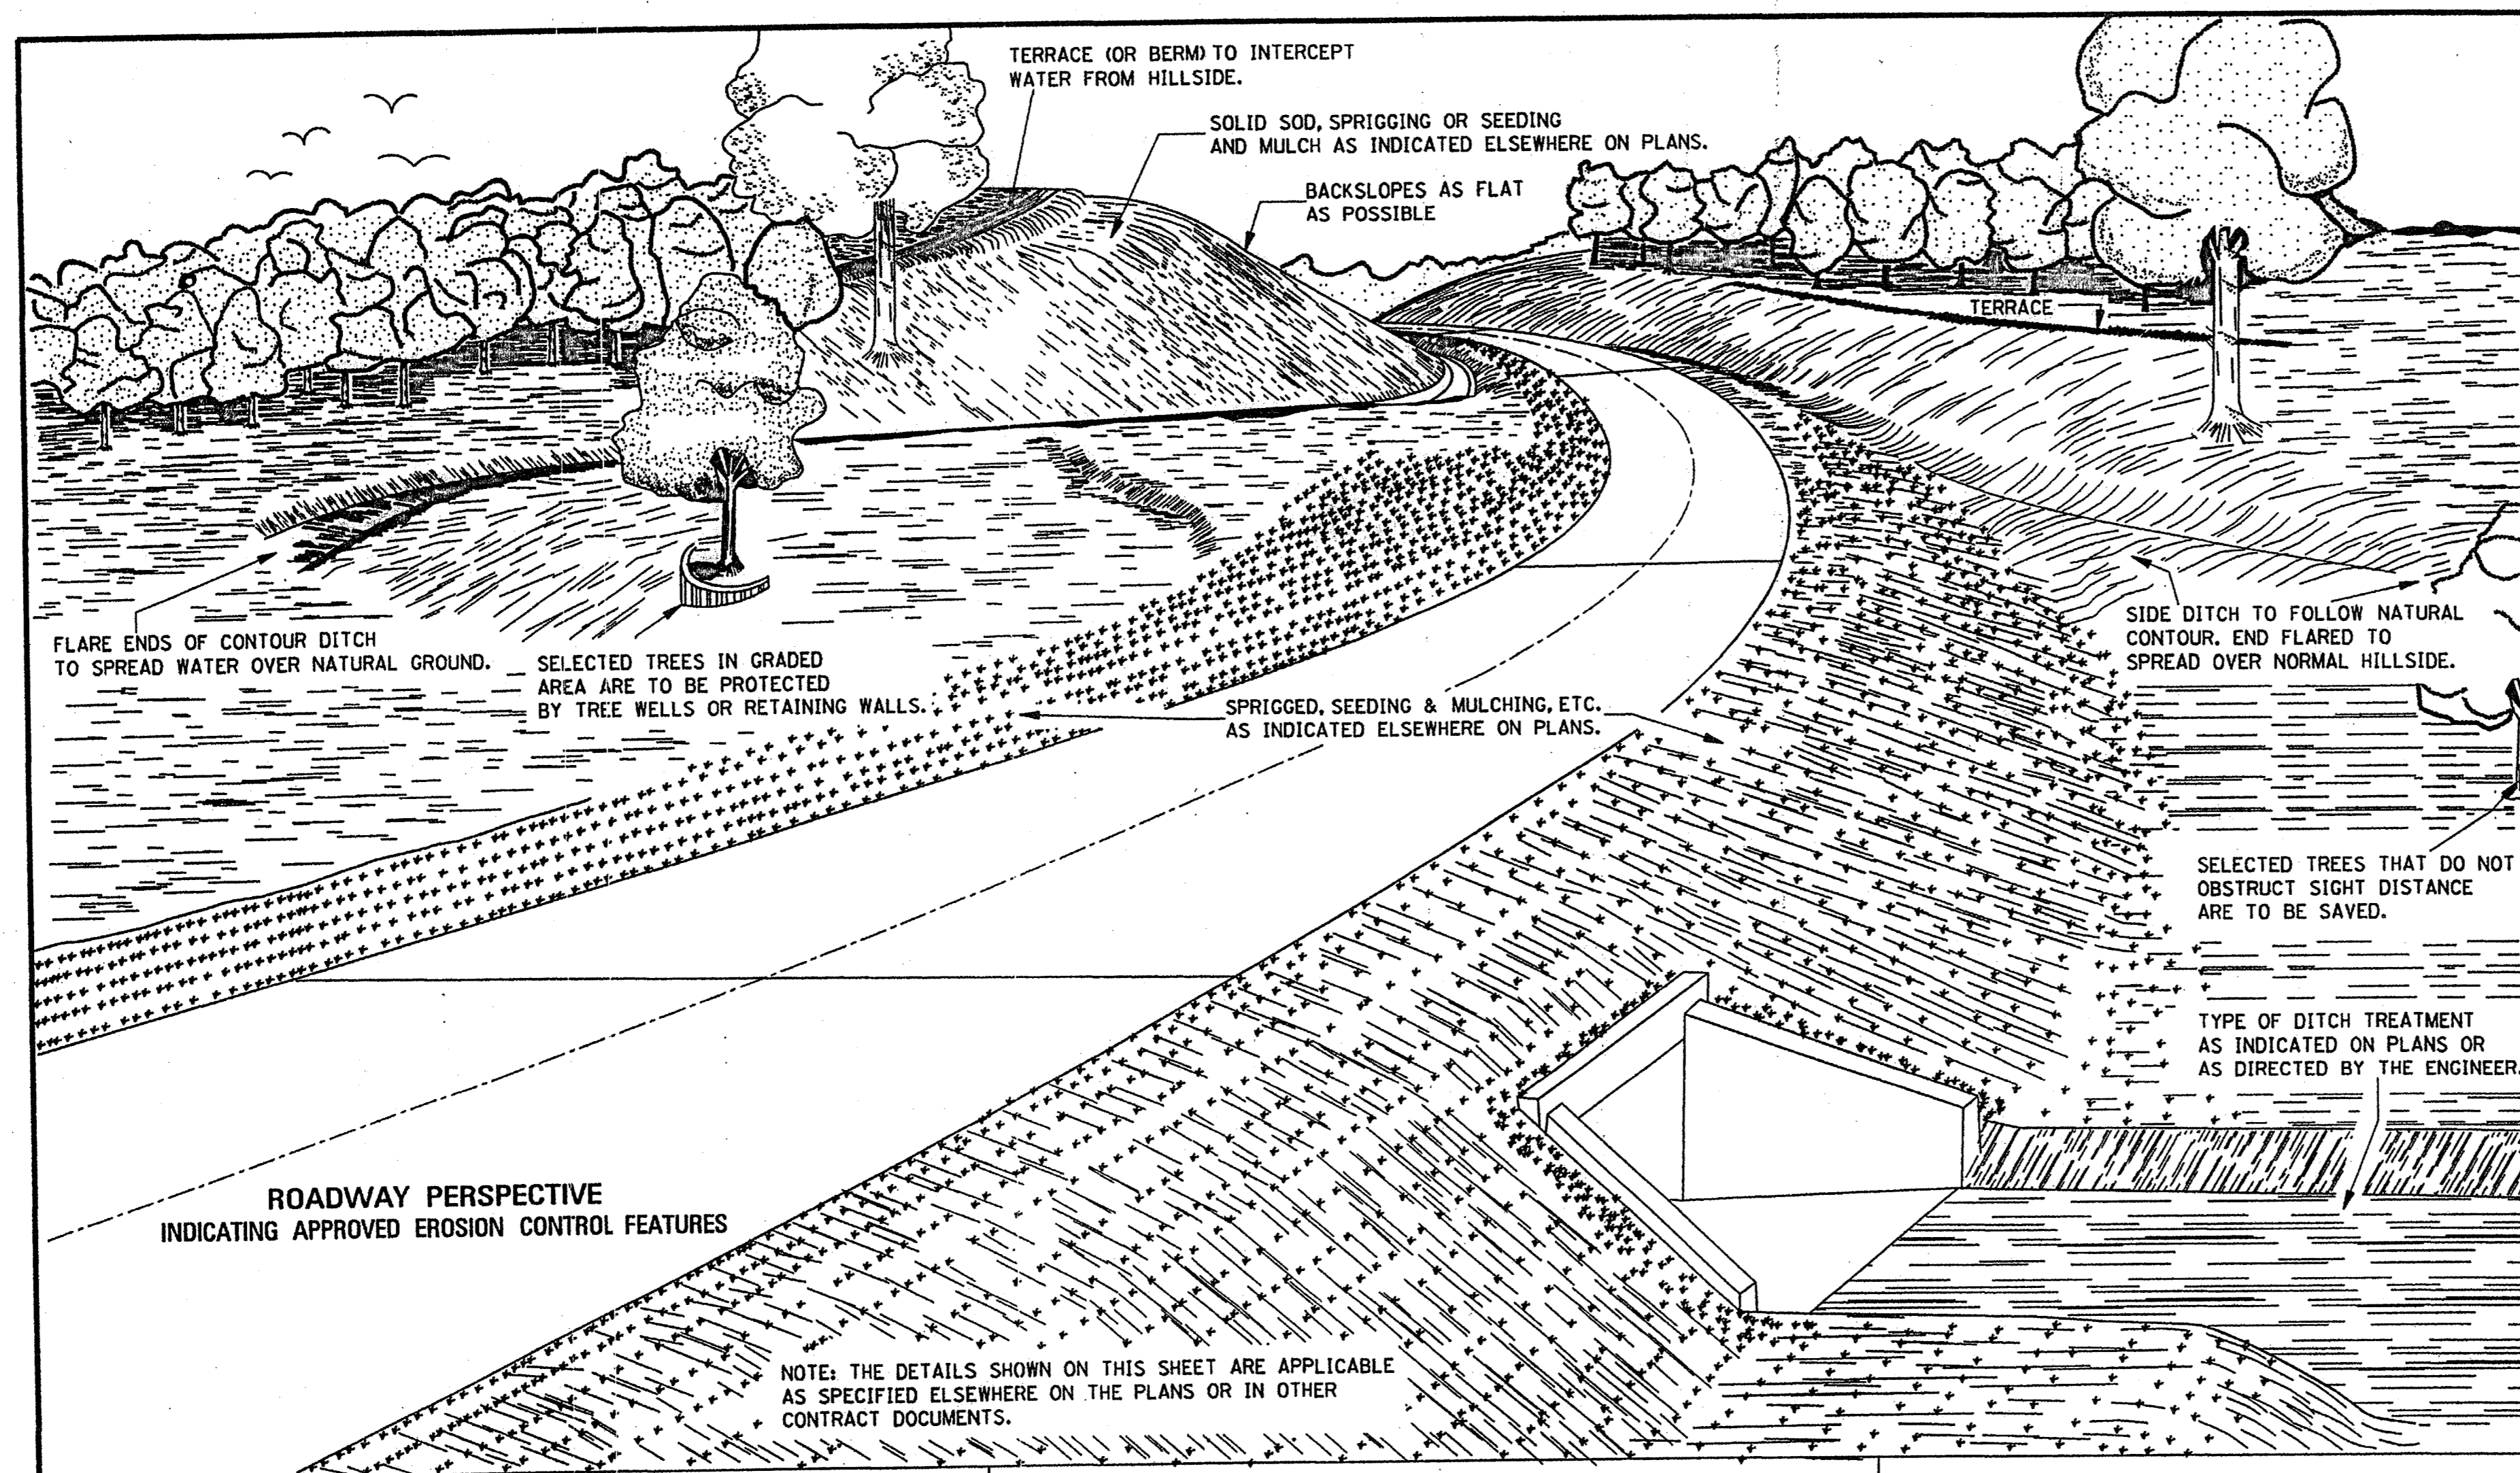


GENERAL NOTE:
1. LONGITUDINAL AND TRANSVERSE MEASUREMENTS FOR THE PAY AREA SHALL BE TAKEN ALONG THE SLOPES.

Record Drawings
1-8-08

MISSISSIPPI DEPARTMENT OF TRANSPORTATION ROADWAY DESIGN DIVISION STANDARD PLAN	
EROSION CONTROL	
DATE: _____ ISSUE DATE: OCTOBER 1, 1998	WORKING NUMBER EC-1 SHEET NUMBER 140

STATE	PROJECT NO.
MISS.	

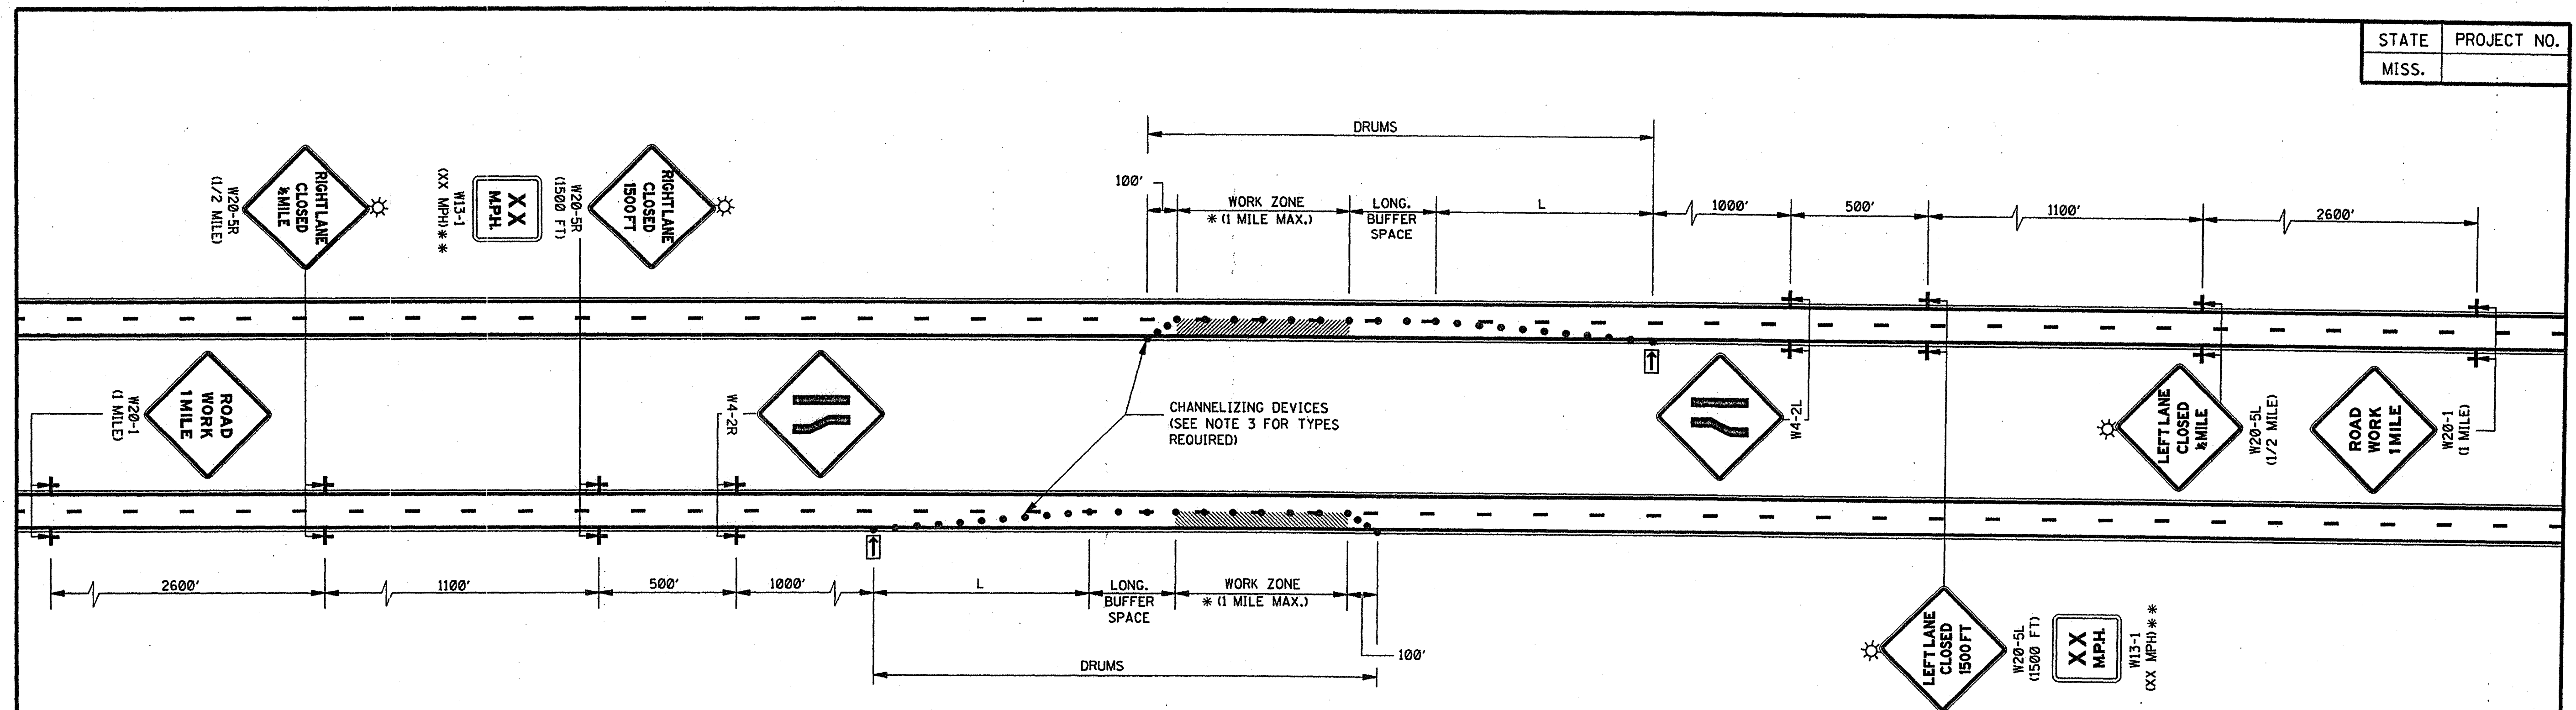

GENERAL NOTES:

1. THE LOCATION OF CHANNELIZING DEVICES AND THE WORK AREA LAYOUT SHALL BE BASED ON THE CRITERIA IN THE FOLLOWING TABLE:

POSTED SPEED AND/OR DESIGN SPEED	MAXIMUM CHANNELIZING DEVICE SPACING (ft)		MINIMUM LONGITUDINAL BUFFER SPACE (ft)	TAPER † RATES
	TAPER	ALONG LANE LINE & WORK ZONE		
<40	40	80	170	27:1
45	45	90	220	45:1
50	50	100	280	50:1
55	55	110	335	55:1
60	60	120	415	60:1
65	65	130	485	65:1
70	70	140	575	70:1


† NOTE: TAPER RATES ARE DETERMINED USING THE FOLLOWING EQUATIONS:
 $L = WS$ FOR SPEEDS OF 45 mph OR GREATER
 $L = WS^2/60$ FOR SPEEDS OF 40 mph OR LESS
 WHERE: L = MINIMUM LENGTH OF TAPER IN FEET
 W = WIDTH OF OFFSET (USUALLY LANE WIDTH) IN FEET
 S = DESIGN SPEED OR 85TH PERCENTILE SPEED IN MILES PER HOUR

2. FLASHING ARROW PANEL SHALL BE AS LEVEL AS POSSIBLE AS APPROVED BY THE ENGINEER. FLASHING ARROW PANEL SHOULD BE LOCATED AT THE BEGINNING OF THE TAPER OR, IF THE SHOULDER IS TOO NARROW, BEHIND THE CHANNELIZING DEVICES IN THE CLOSED LANE.
3. ALL CHANNELIZING DEVICES SHALL BE REFLECTORIZED FREE STANDING PLASTIC DRUMS.
4. FOR MOVING OPERATIONS (PAVING) THE CONTRACTOR SHALL HAVE TWO (2) SETS OF ADVANCE WARNING SIGNS, PLASTIC DRUMS, AND ARROW BOARD. WHEN THE CONSTRUCTION ZONE IS MOVED AHEAD, ALL SIGNS, PLASTIC DRUMS AND ARROW BOARD SHALL BE IN PLACE ON THE SECOND ZONE BEFORE REMOVING ANY SIGNS, PLASTIC DRUMS OR ARROW BOARD ON THE FIRST ZONE.
5. ALL TRAFFIC CONTROL ITEMS SHOWN ON THIS SHEET WILL NOT BE MEASURED FOR SEPARATE PAYMENT. THIS WORK IS TO BE INCLUDED IN THE PRICE BID FOR MAINTENANCE OF TRAFFIC.
6. DIAMOND SHAPED TRAFFIC CONTROL SIGNS SHALL BE A MINIMUM OF 48" X 48".


LEGEND

- * OR AS SHOWN ELSEWHERE OF THE PLANS.
- ** THE LEGEND ON W13-1 (XX MPH) SUPPLEMENTAL PLATE SHALL BE 10 MPH LESS THAN THE POSTED SPEED LIMIT.
- FLASHING ARROW PANEL (TYPE 'C')
- REFLECTORIZED FREE-STANDING PLASTIC DRUMS
- TYPE 'B' WARNING LIGHTS

Record Drawings
1-8-08

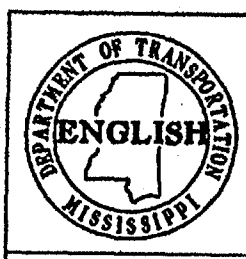MISSISSIPPI DEPARTMENT OF TRANSPORTATION ROADWAY DESIGN DIVISION STANDARD PLAN	
TRAFFIC CONTROL PLAN FOR POSTED SPEED LIMIT LESS THAN 65 MPH (4-LANE: MEDIAN OR OUTSIDE LANE CLOSURE) (EXTENDED PERIOD)	
WORKING NUMBER TCP-3	
SHEET NUMBER 252	
DATE ISSUE DATE: OCTOBER 1, 1998	BY

STATE	PROJECT NO.
MISS.	

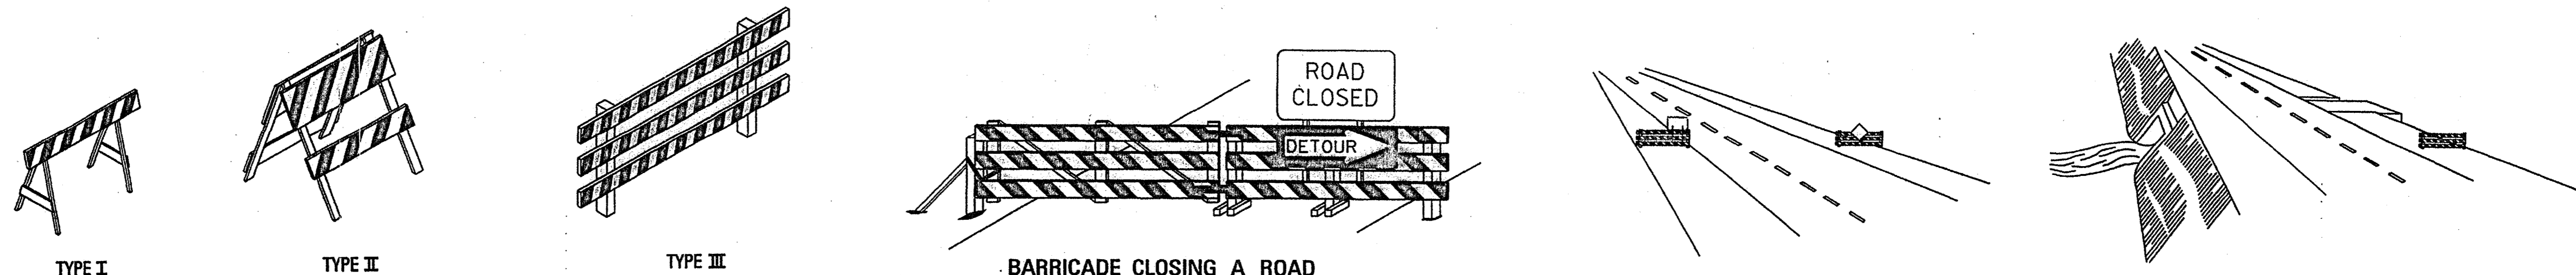


STANDARD BARRICADES

1. A TYPE I BARRICADE CONSISTS OF ONE (1) HORIZONTAL RAIL SUPPORTED BY A DEMOUNTABLE FRAME OR A LIGHT "A" FRAME. A TYPE I BARRICADE NORMALLY WOULD BE USED ON CONVENTIONAL ROADS OR URBAN STREETS AND ARTERIALS.
2. A TYPE II BARRICADE CONSISTS OF TWO (2) HORIZONTAL RAILS ON A LIGHT "A" FRAME. TYPE II BARRICADES ARE INTENDED FOR USE ON EXPRESSWAYS AND FREEWAYS AND OTHER HIGH-SPEED ROADWAYS.
3. TYPE I AND TYPE II BARRICADES ARE INTENDED FOR USE WHERE THE HAZARD IS RELATIVELY SMALL AS, FOR EXAMPLE, ON CITY STREETS, OR FOR THE MORE OR LESS CONTINUOUS DELIMITING OF A RESTRICTED ROADWAY, OR FOR TEMPORARY DAYTIME USE.
4. A TYPE III BARRICADE CONSISTS OF THREE (3) HORIZONTAL RAILS SUPPORTED BY FIXED POSTS, A RIGID SKID, A HEAVY DEMOUNTABLE FRAME OR A HEAVY, HINGED "A" FRAME.
5. TYPE III BARRICADES ARE INTENDED FOR USE ON CONSTRUCTION AND MAINTENANCE PROJECTS AS WING BARRICADES AND AT ROAD CLOSURES, WHERE THEY MUST REMAIN IN PLACE FOR EXTENDED PERIODS.
6. THE MARKING FOR BARRICADE RAILS SHALL BE ORANGE AND WHITE (SLOPING DOWNWARD AT AN ANGLE OF 45° IN THE DIRECTION TRAFFIC IS TO PASS).
7. DO NOT PLACE SANDBAGS OR OTHER DEVICES TO PROVIDE MASS ON THE BOTTOM RAIL THAT WILL BLOCK VIEW OR RAIL FACE.
8. FOR ADDITIONAL INFORMATION OR DETAILS, SEE MUTCD, LATEST EDITION.


BARRICADE CHARACTERISTICS

	I	II	III
WIDTH OF RAIL **	8" MIN. - 12" MAX.	8" MIN. - 12" MAX.	8" MIN. - 12" MAX.
LENGTH OF RAIL **	24" MIN.	24" MIN.	48" MIN.
WIDTH OF STRIPE *	6"	6"	6"
HEIGHT	36" MIN.	36" MIN.	60" MIN.
NUMBER OF REFLECTORIZED RAIL FACES	2 (ONE EACH DIRECTION)	4 (TWO EACH DIRECTION)	3 IF FACING TRAFFIC IN ONE DIRECTION 6 IF FACING TRAFFIC IN TWO DIRECTIONS
TYPE OF FRAME	LIGHT	LIGHT "A" FRAME	POST OR SKID


- * 1. FOR RAILS LESS THAN 36" LONG, 4" WIDE STRIPES MAY BE USED.
- ** 2. BARRICADES INTENDED FOR USE ON EXPRESSWAYS, FREEWAYS AND OTHER HIGH SPEED ROADWAYS, SHALL HAVE A MINIMUM OF 270 in² OF REFLECTIVE AREA FACING TRAFFIC.

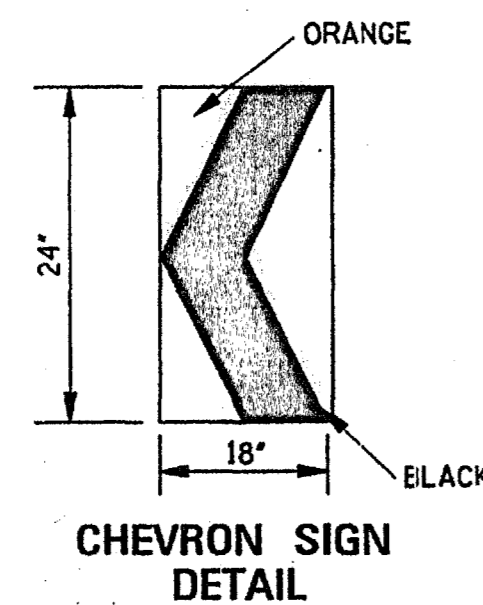

1. A CHEVRON SIGN CONSISTS OF A BLACK CHEVRON TYPE MARKING ON AN ORANGE BACKGROUND AND SHALL POINT IN THE DIRECTION OF TRAFFIC FLOW.
2. THE CHEVRON SIGN SHALL BE MOUNTED ON FIXED POST OR RIGID SKID.
3. CHEVRON SIGNS MAY BE USED TO SUPPLEMENT OTHER STANDARD DEVICES WHERE ONE OR MORE LANES ARE CLOSED FOR CONSTRUCTION OR MAINTENANCE. THEY SHALL BE PLACED APPROXIMATELY 2'-0" BEHIND THE LANE TRANSITION STRIPE.

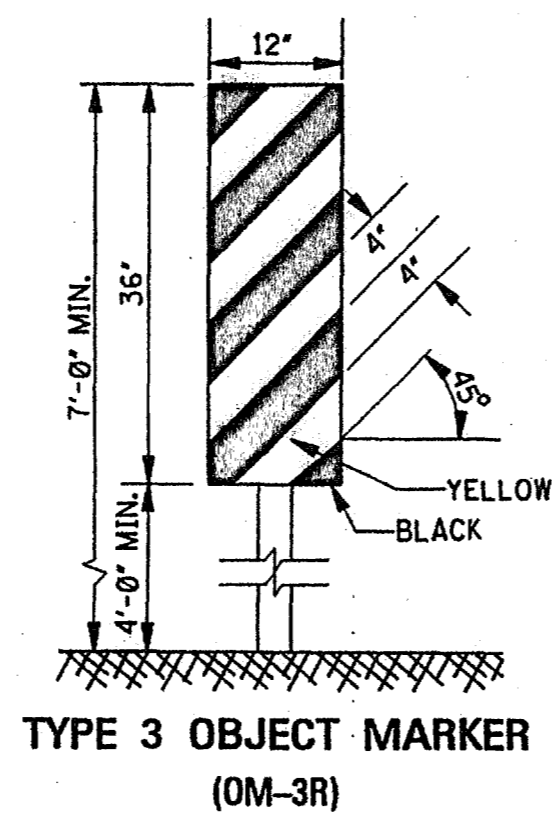

1. TYPE 3 OBJECT MARKERS SHALL BE USED AT ALL EXPOSED BRIDGE ABUTMENTS AND AT OTHER LOCATIONS AS DEEMED NECESSARY BY THE ENGINEER.
2. THE OM-3R IS SHOWN. THE OM-3L IS SIMILAR EXCEPT THE STRIPES SLOPE DOWNWARD FROM THE UPPER LEFT SIDE TO THE LOWER RIGHT SIDE AND SHALL BE PLACED ON THE LEFT SIDE OF THE OBJECT.
3. THE INSIDE EDGE OF THE MARKER SHALL BE IN LINE WITH THE INNER EDGE OF THE OBSTRUCTION.

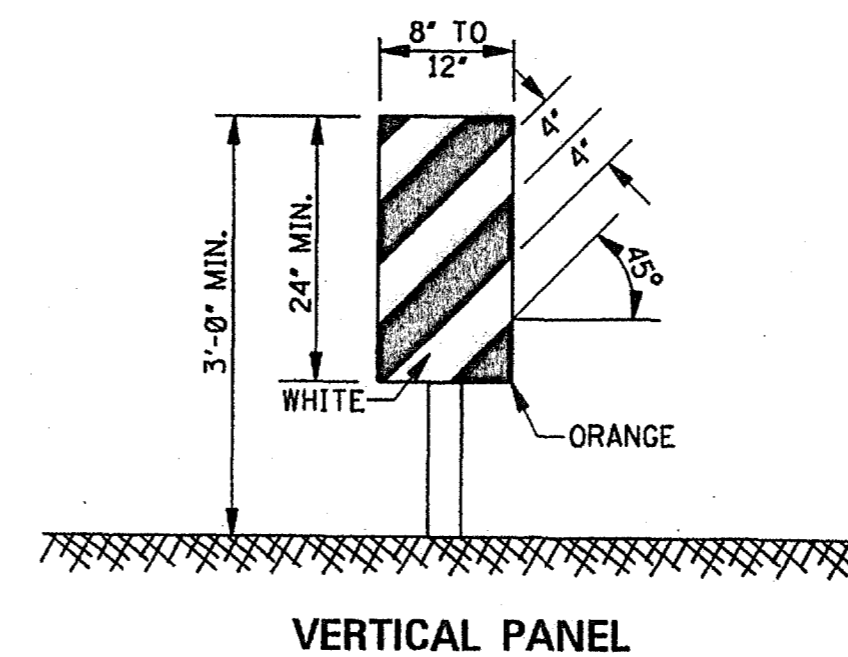


1. VERTICAL PANELS CONSIST OF AT LEAST ONE PANEL 8" TO 12" IN WIDTH AND A MINIMUM OF 24" IN HEIGHT.
2. THE DIAGONAL STRIPES SHALL SLOPE DOWNWARD IN THE DIRECTION THAT TRAFFIC IS TO PASS THE PANEL. THE PANELS SHALL BE MOUNTED WITH THE TOP A MINIMUM OF 36" ABOVE THE ROADWAY ON A SINGLE LIGHTMASS POST.
3. VERTICAL PANELS USED ON EXPRESSWAYS, FREEWAYS AND OTHER HIGH-SPEED ROADWAYS SHALL HAVE A MINIMUM OF 270 in² OF RETROREFLECTIVE AREA FACING TRAFFIC.
4. FOR TWO-WAY TRAFFIC OPERATIONS, BACK-TO-BACK PANELS SHALL BE USED.

- GENERAL NOTES:
1. MARKINGS ON ALL DEVICES SHOWN ON THIS SHEET SHALL BE HIGH INTENSITY REFLECTIVE SHEETING.
 2. THE TRAFFIC CONTROL PLAN WILL LIST THE VARIOUS TRAFFIC CONTROL DEVICES REQUIRED FOR EACH PROJECT.

WING BARRICADES

1. WING BARRICADES ARE TYPE III BARRICADES ERECTED ON THE SHOULDER ON ONE OR BOTH SIDES OF THE PAVEMENT TO GIVE THE SENSATION OF A NARROWING OR RESTRICTED ROADWAY. WING BARRICADES MAY BE USED AS A MOUNTING FOR THE ADVANCE WARNING SIGNS OR FLASHERS.
2. WING BARRICADES SHOULD BE USED:
 - A. IN ADVANCE OF A CONSTRUCTION PROJECT EVEN WHEN NO PART OF THE ROADWAY IS ACTUALLY CLOSED.
 - B. IN ADVANCE OF ALL BRIDGE OR CULVERT WIDENING OPERATIONS.










Record Drawings
1-8-08

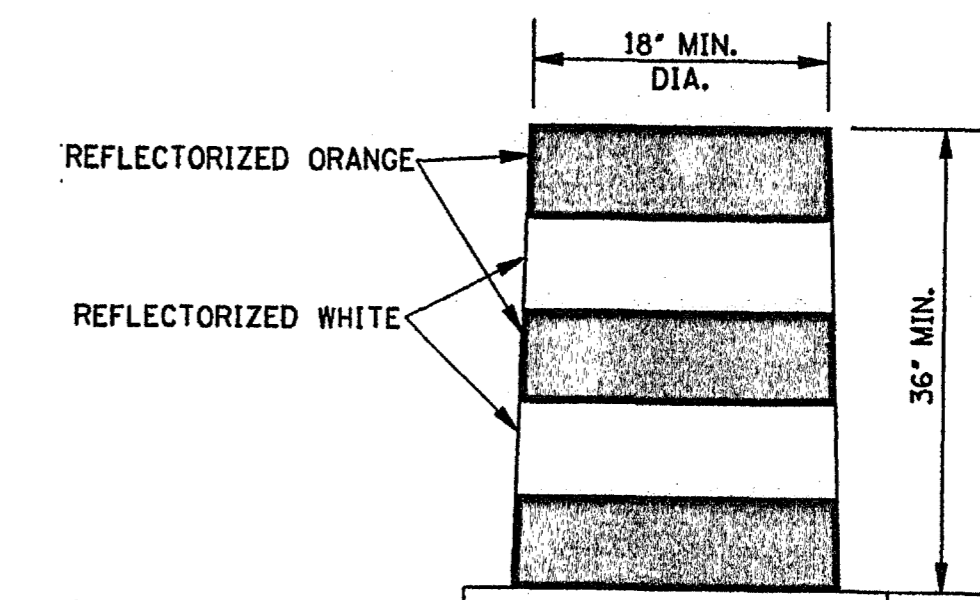

PLASTIC DRUM STRIPING DETAIL

1. PLASTIC DRUMS SHALL BE ON END AND USED AS AN EXPEDIENT METHOD FOR TRAFFIC CHANNELIZATION. THE COLOR AND MARKING OF DRUMS SHALL BE CONSISTENT WITH MARKING STANDARDS FOR BARRICADE. THE PREDOMINANT COLOR ON DRUMS SHALL BE ORANGE WITH FOUR (4) REFLECTORIZED, HORIZONTAL, CIRCUMFERENTIAL STRIPES (2 ORANGE & 2 WHITE) 6" WIDE.
2. DRUMS SHOULD NEVER BE PLACED IN THE ROADWAY WITHOUT WARNING SIGNS.
3. WHERE PRACTICAL PLASTIC DRUMS SHALL BE PLACED NO CLOSER THAN 3'-0" FROM THE EDGE OF TRAVELED LANE.

MISSISSIPPI DEPARTMENT OF TRANSPORTATION ROADWAY DESIGN DIVISION STANDARD PLAN		
<p>HIGHWAY SIGN AND BARRICADE DETAILS FOR CONSTRUCTION PROJECTS</p>		
WORKING NUMBER TCP-10	SHEET NUMBER 259	
ISSUE DATE: OCTOBER 1, 1998		

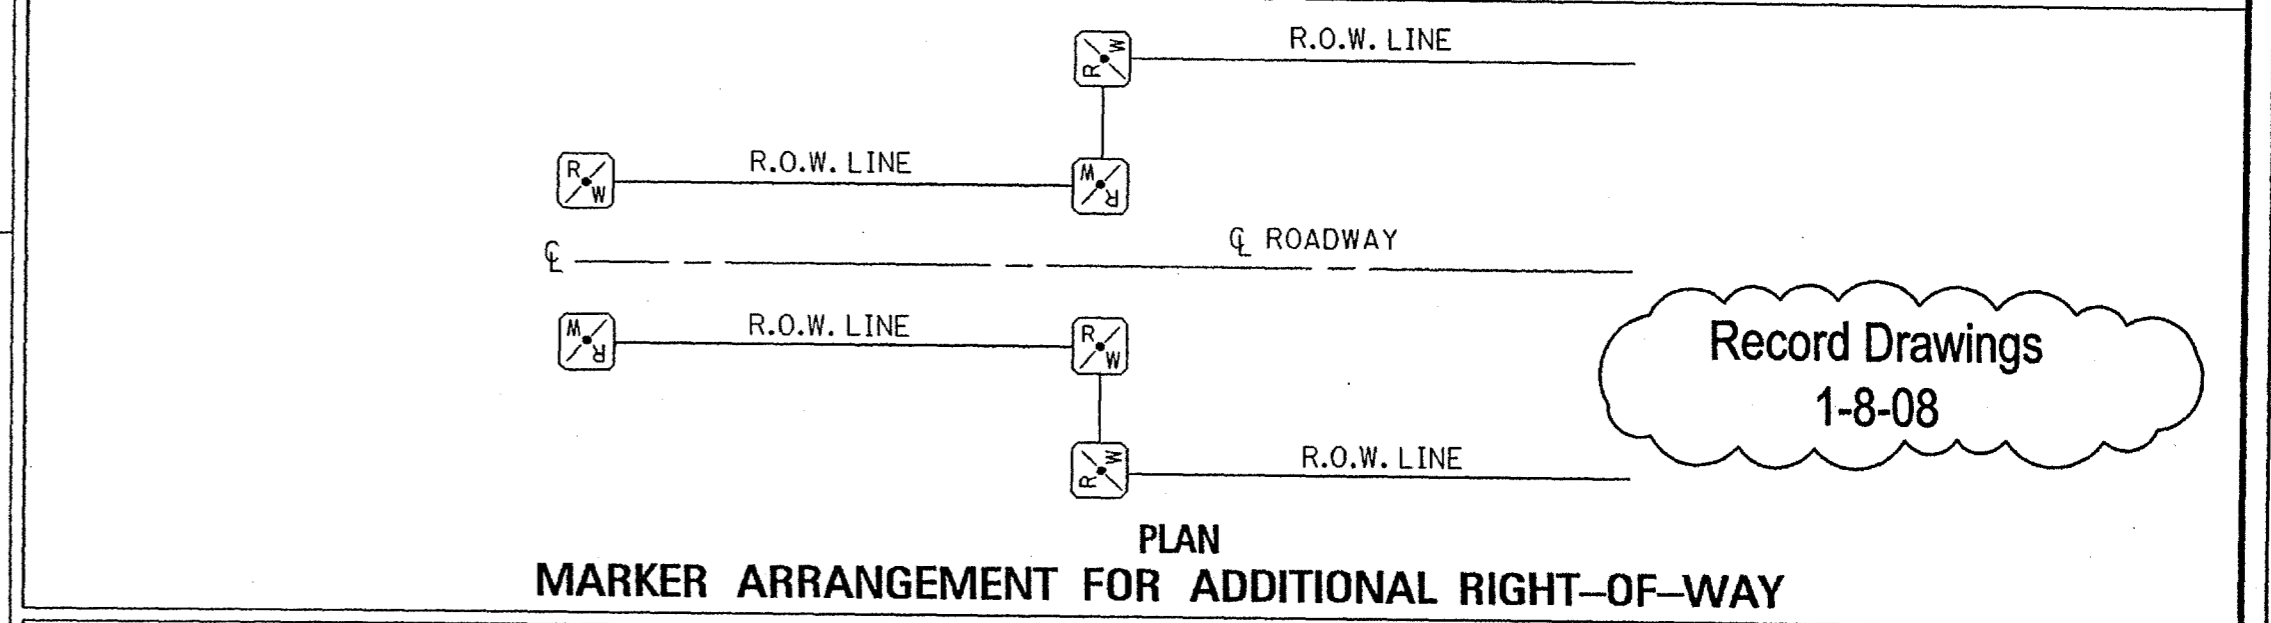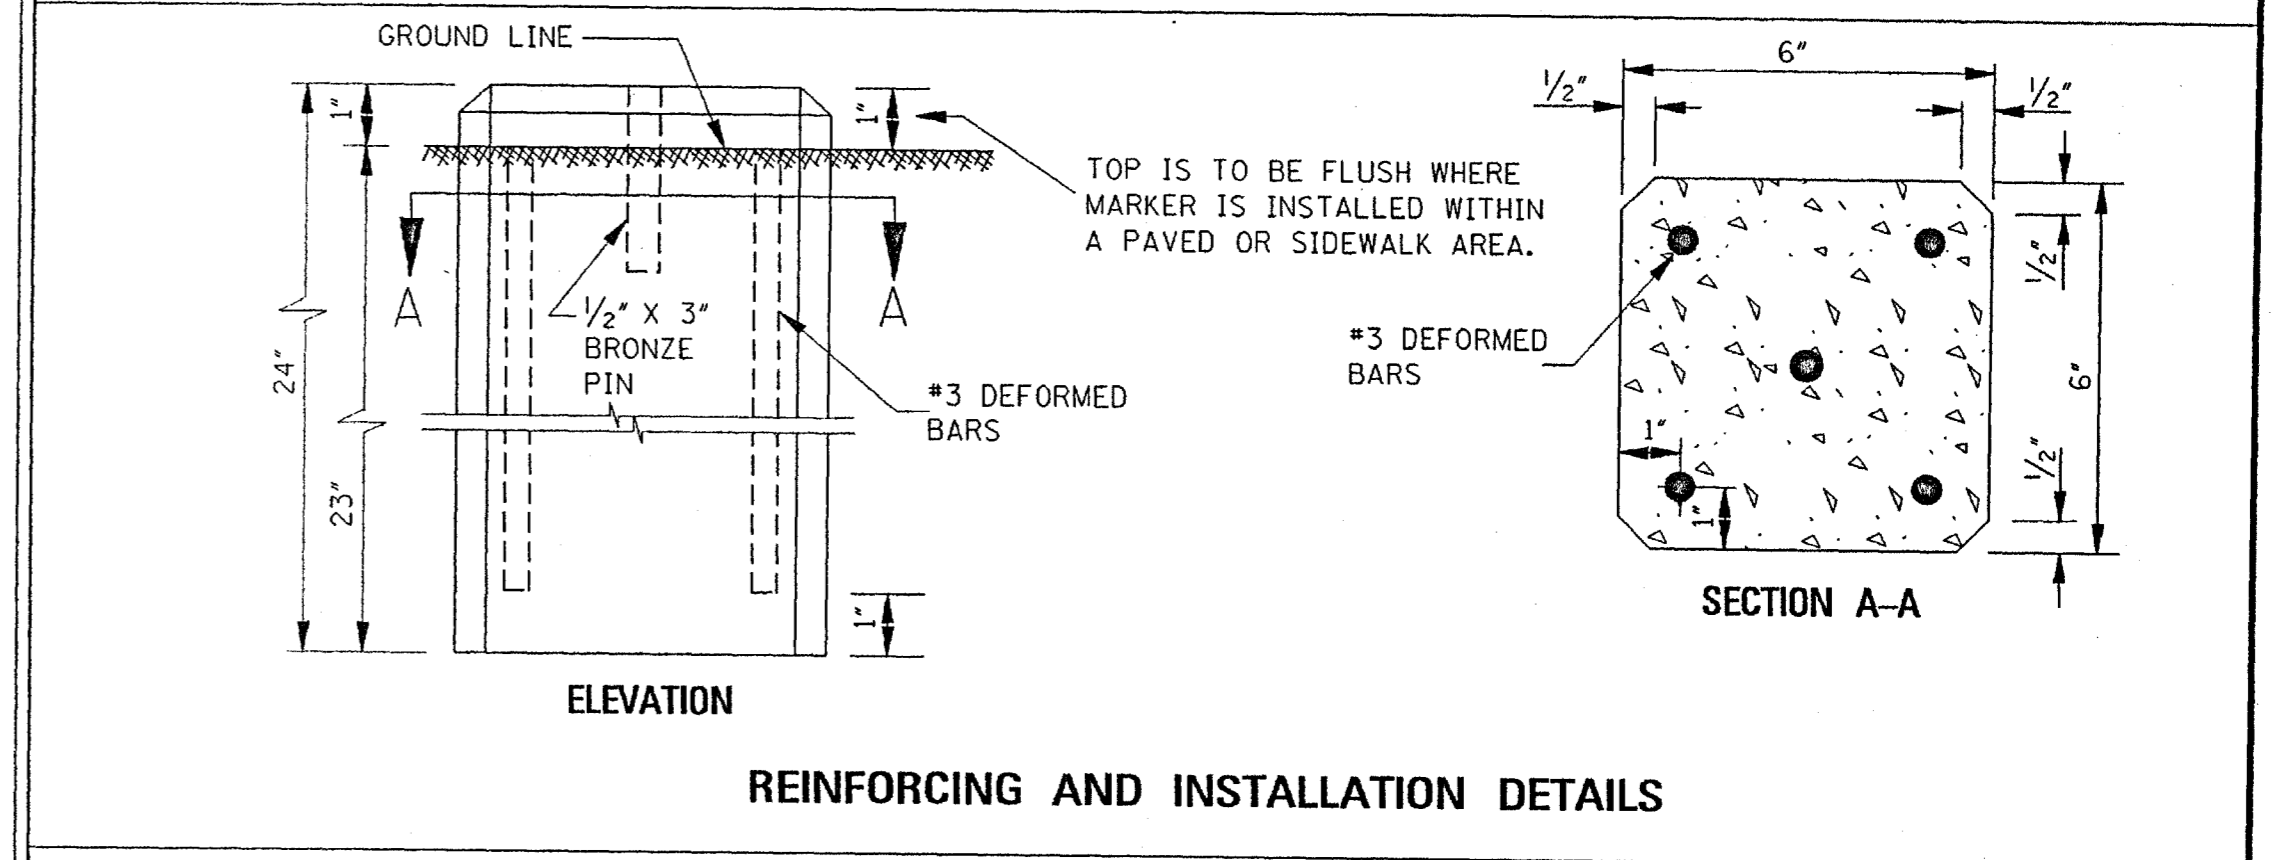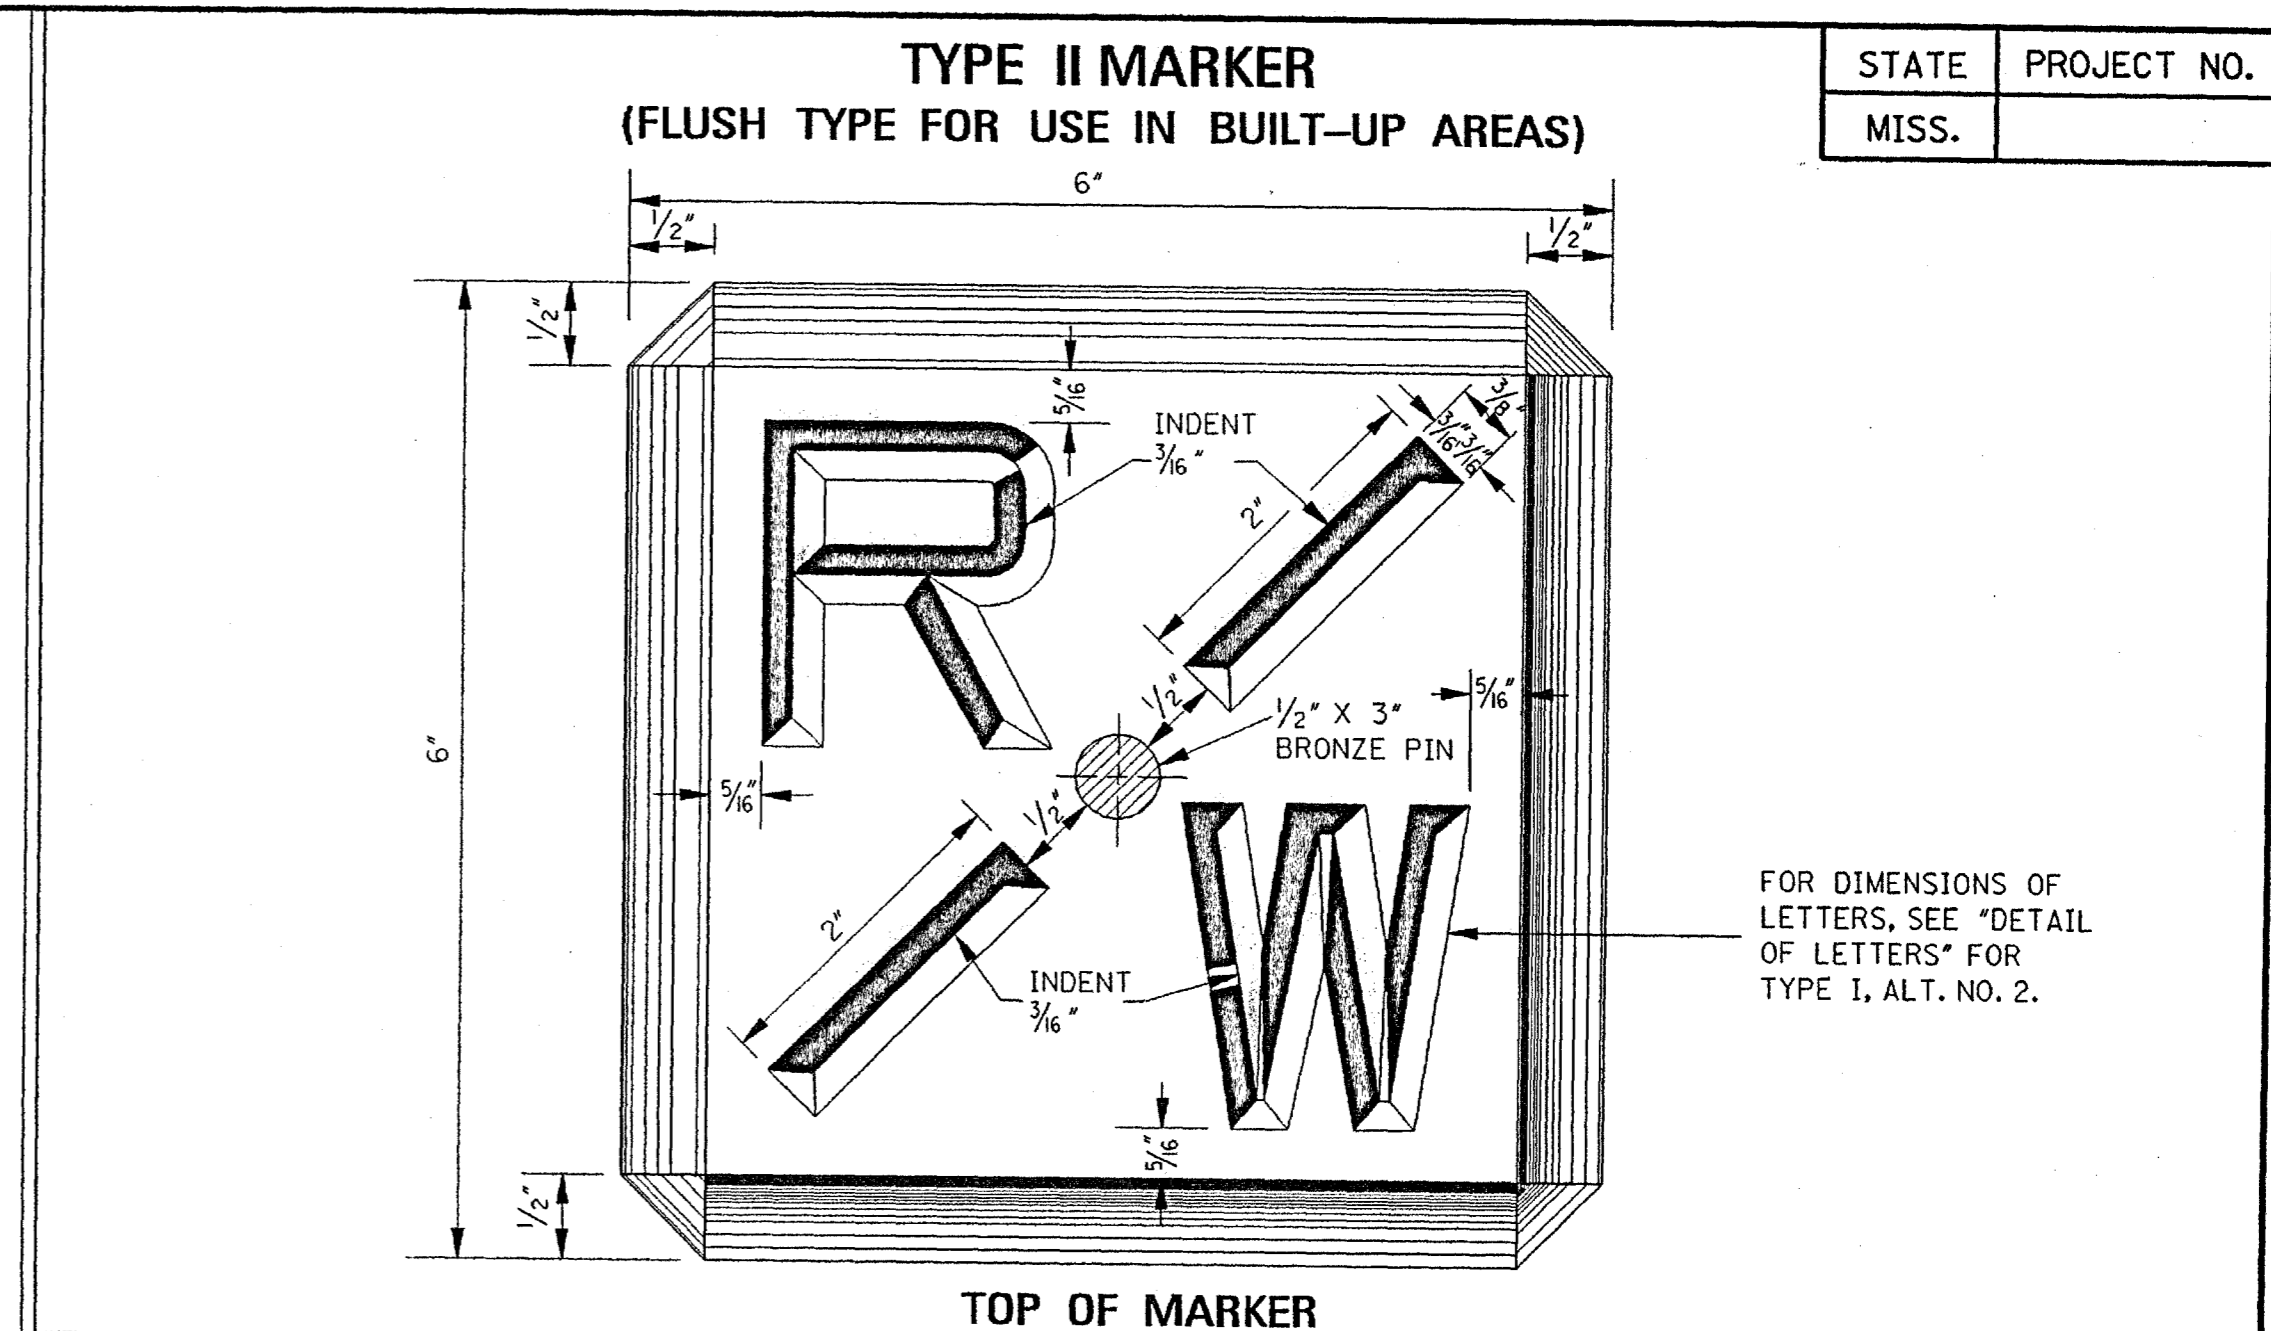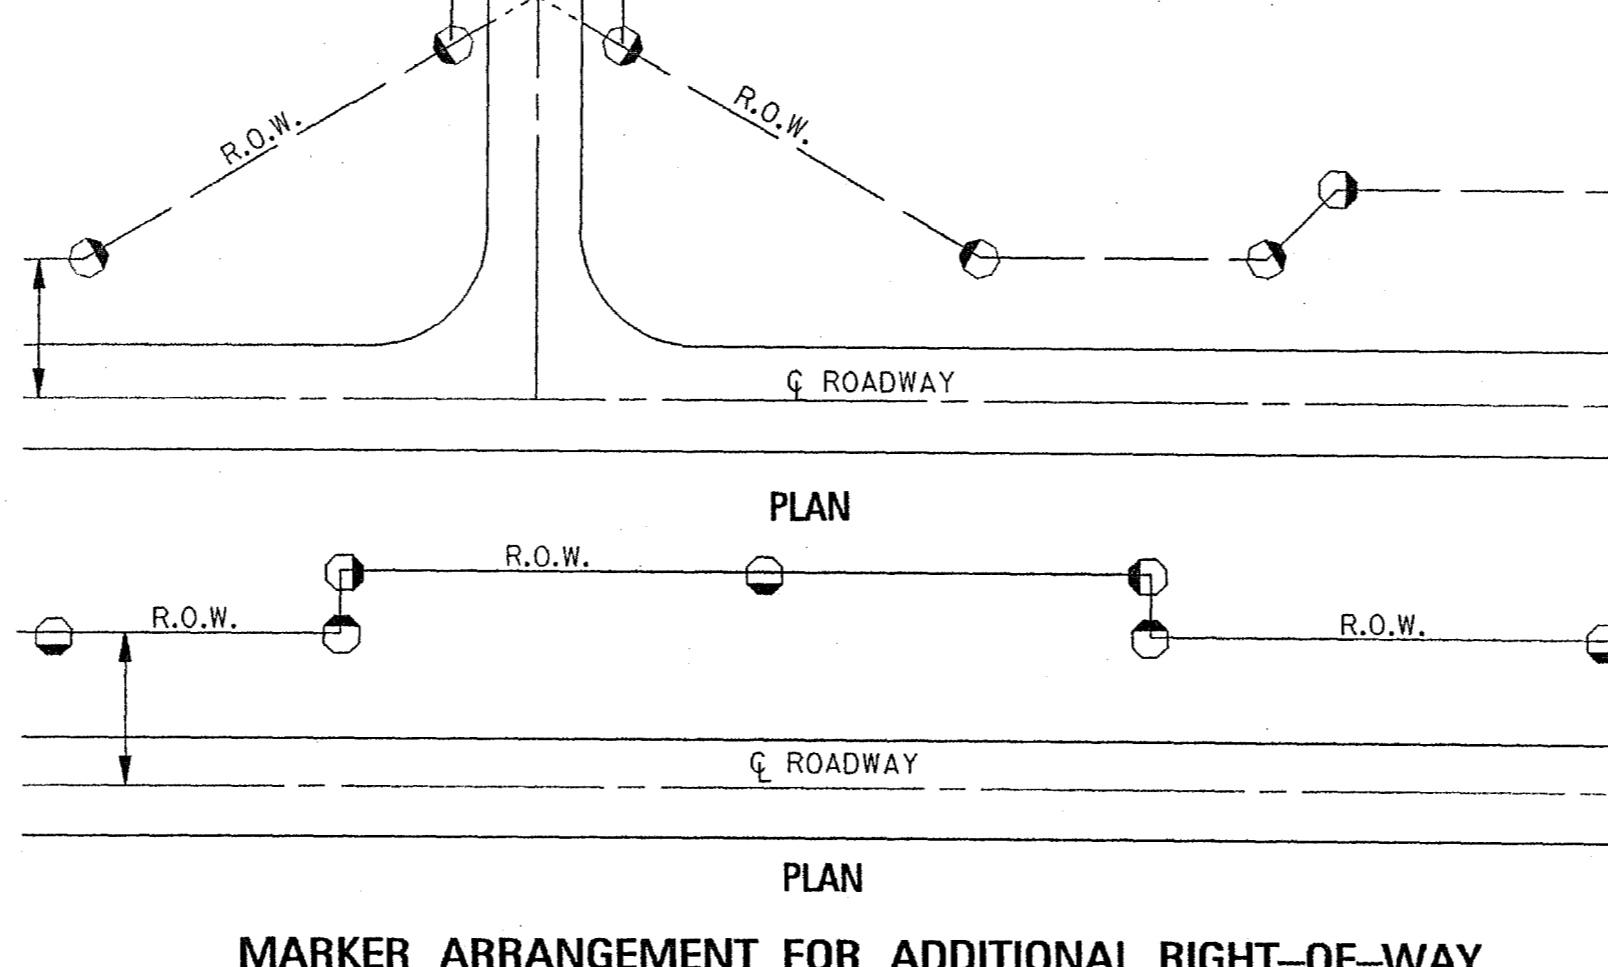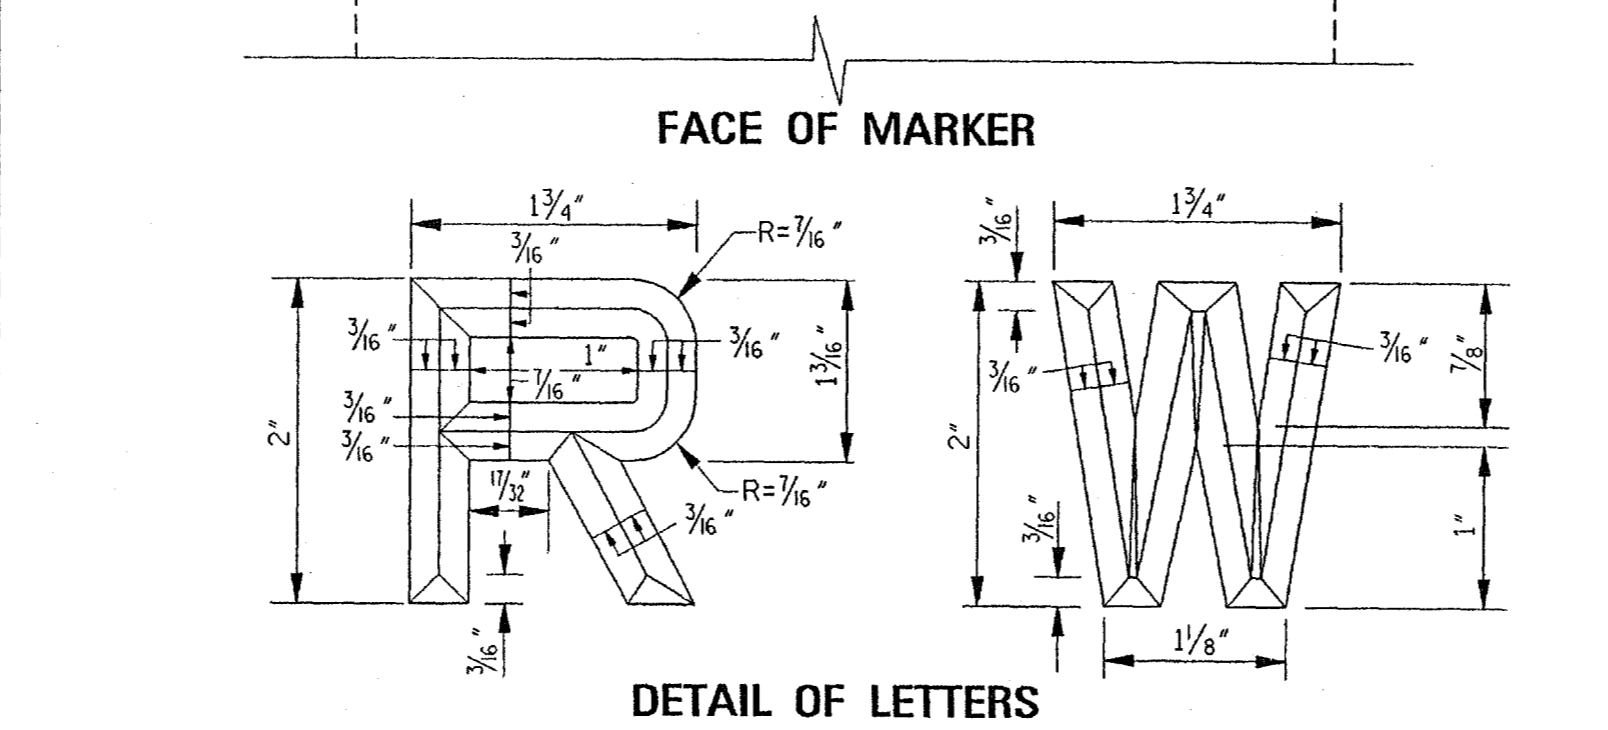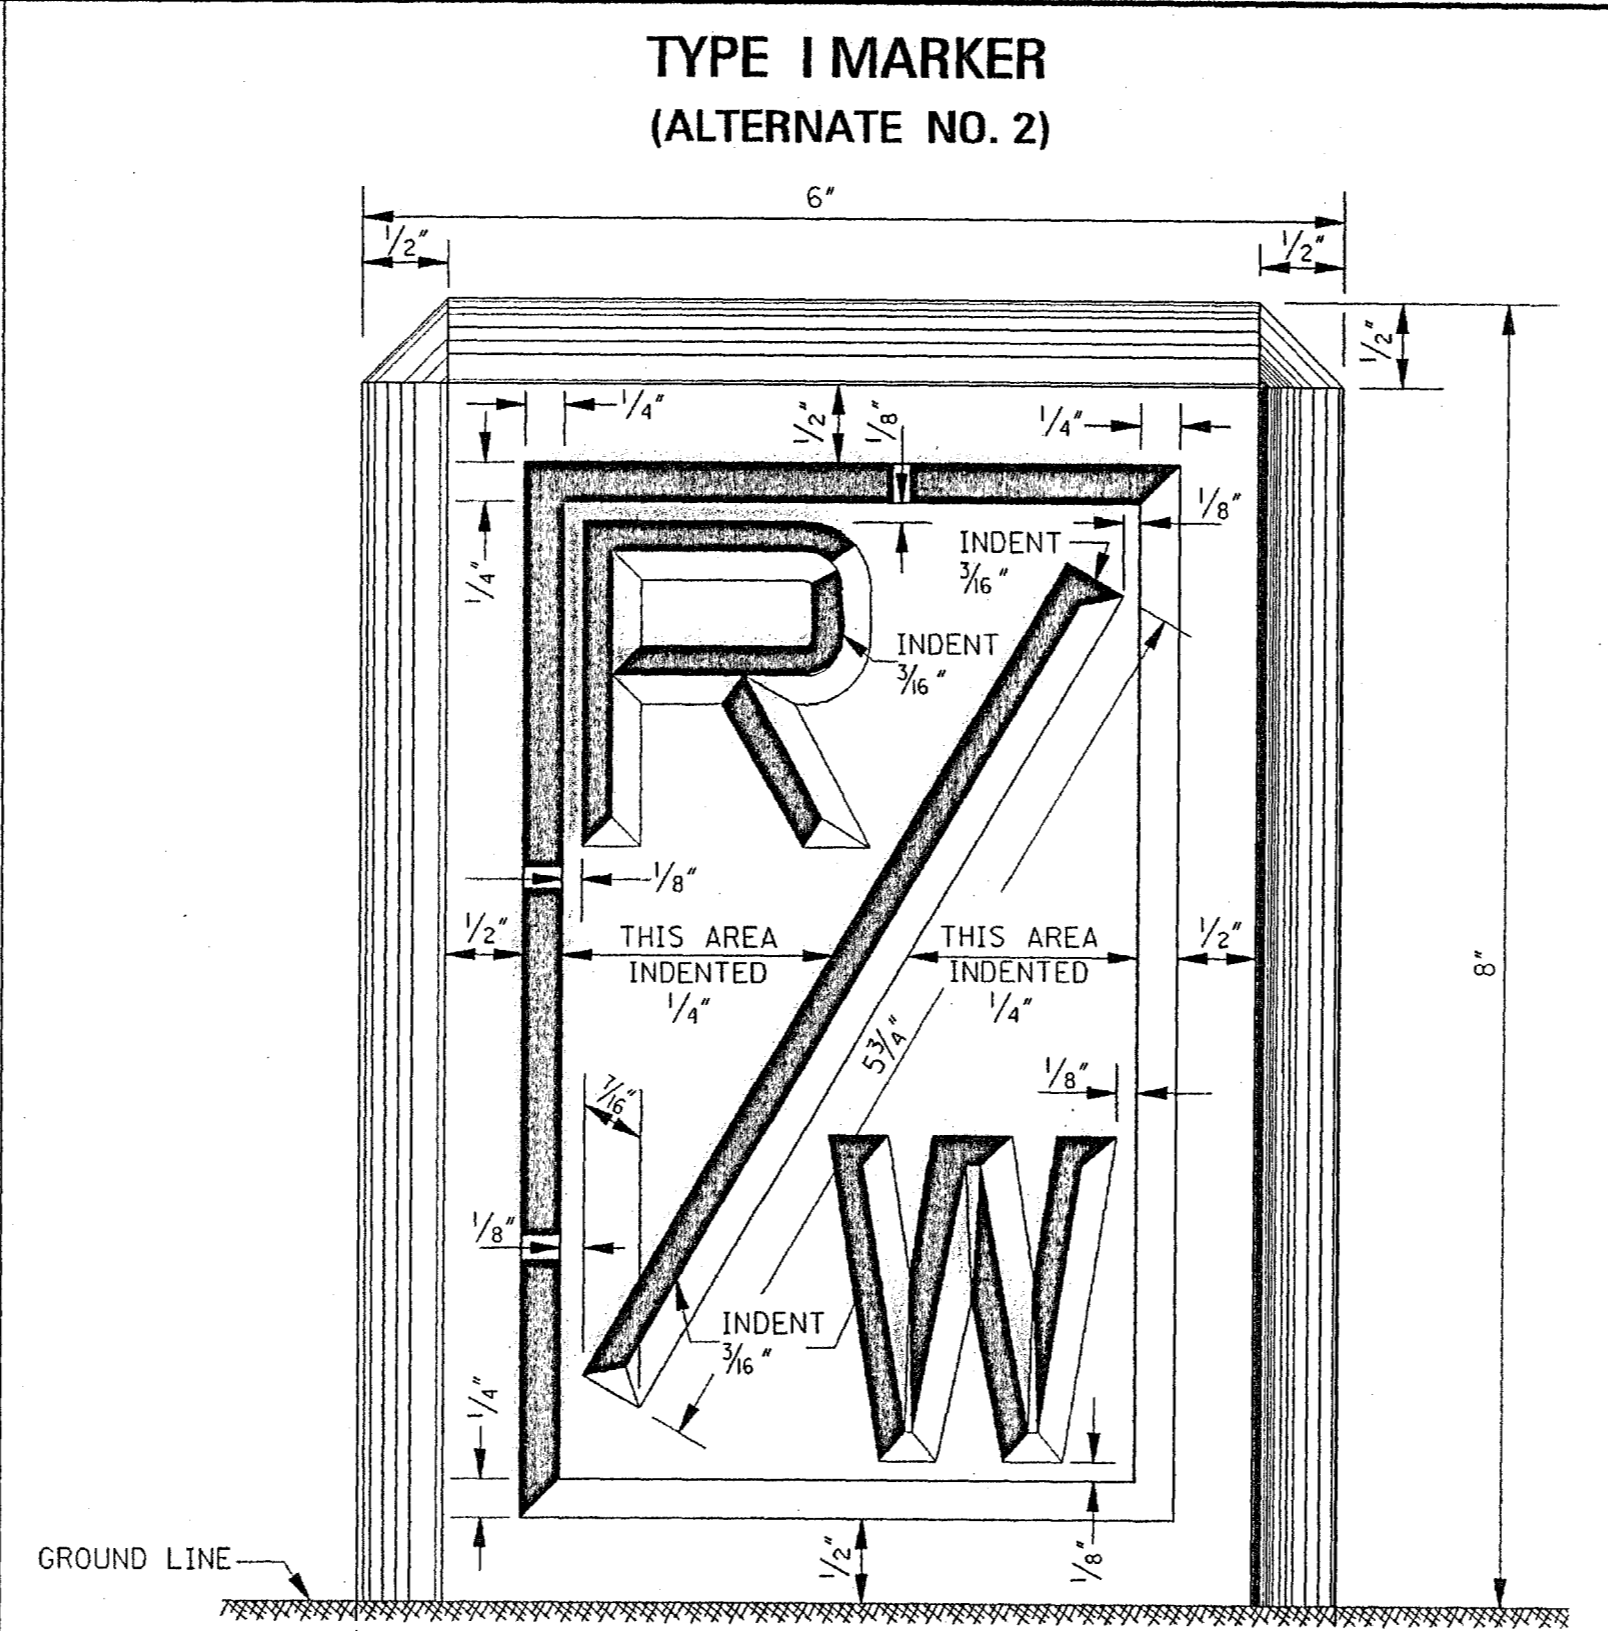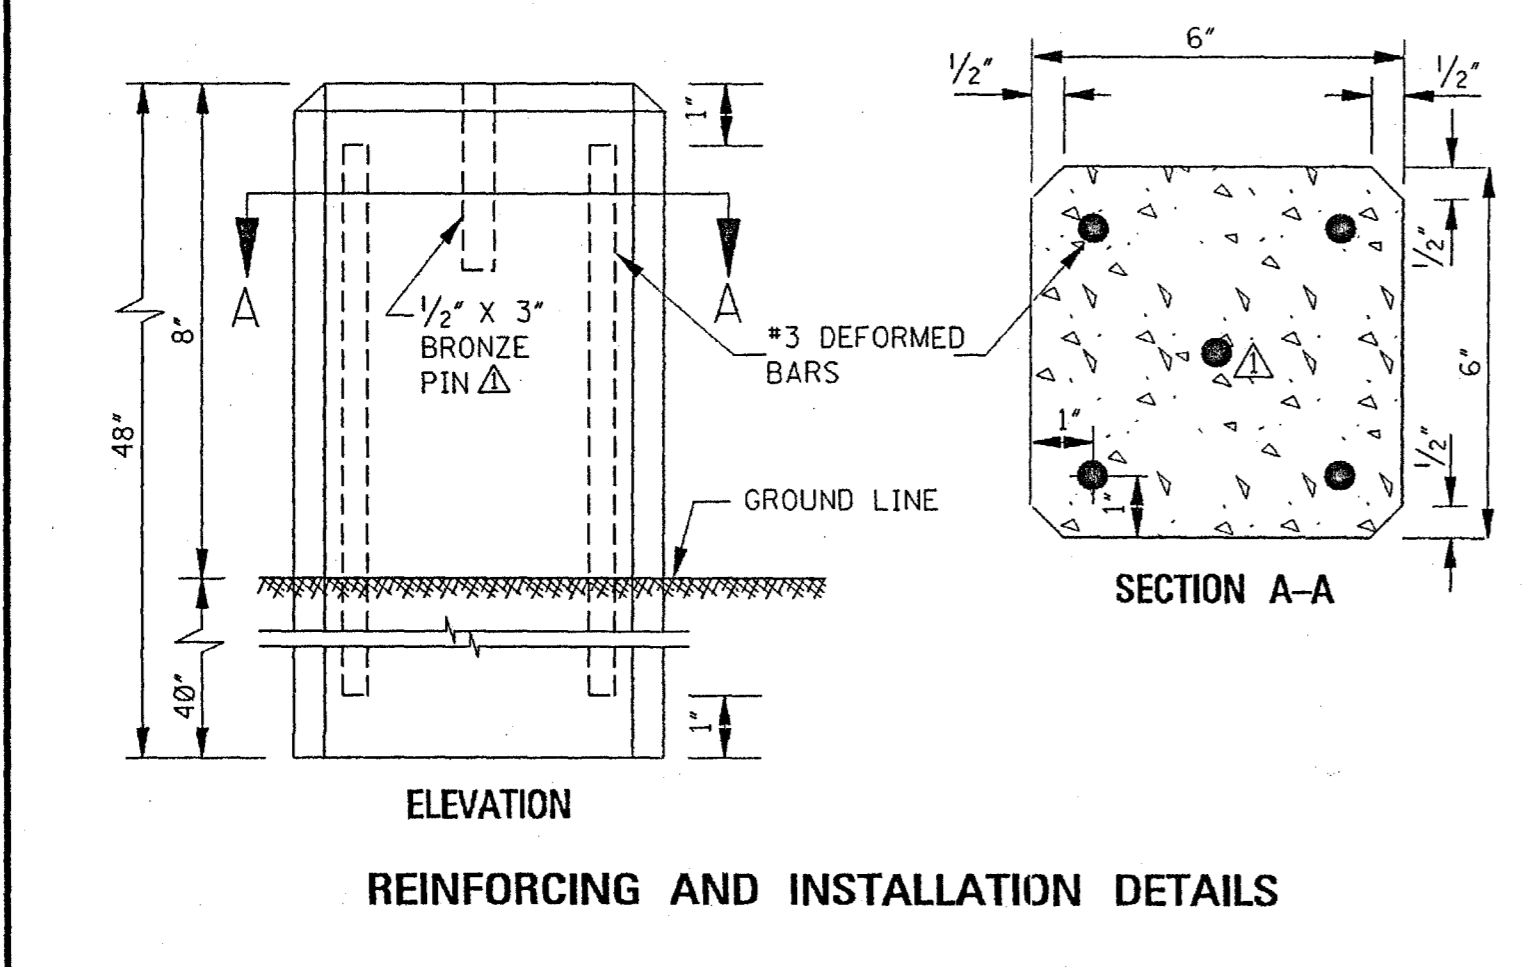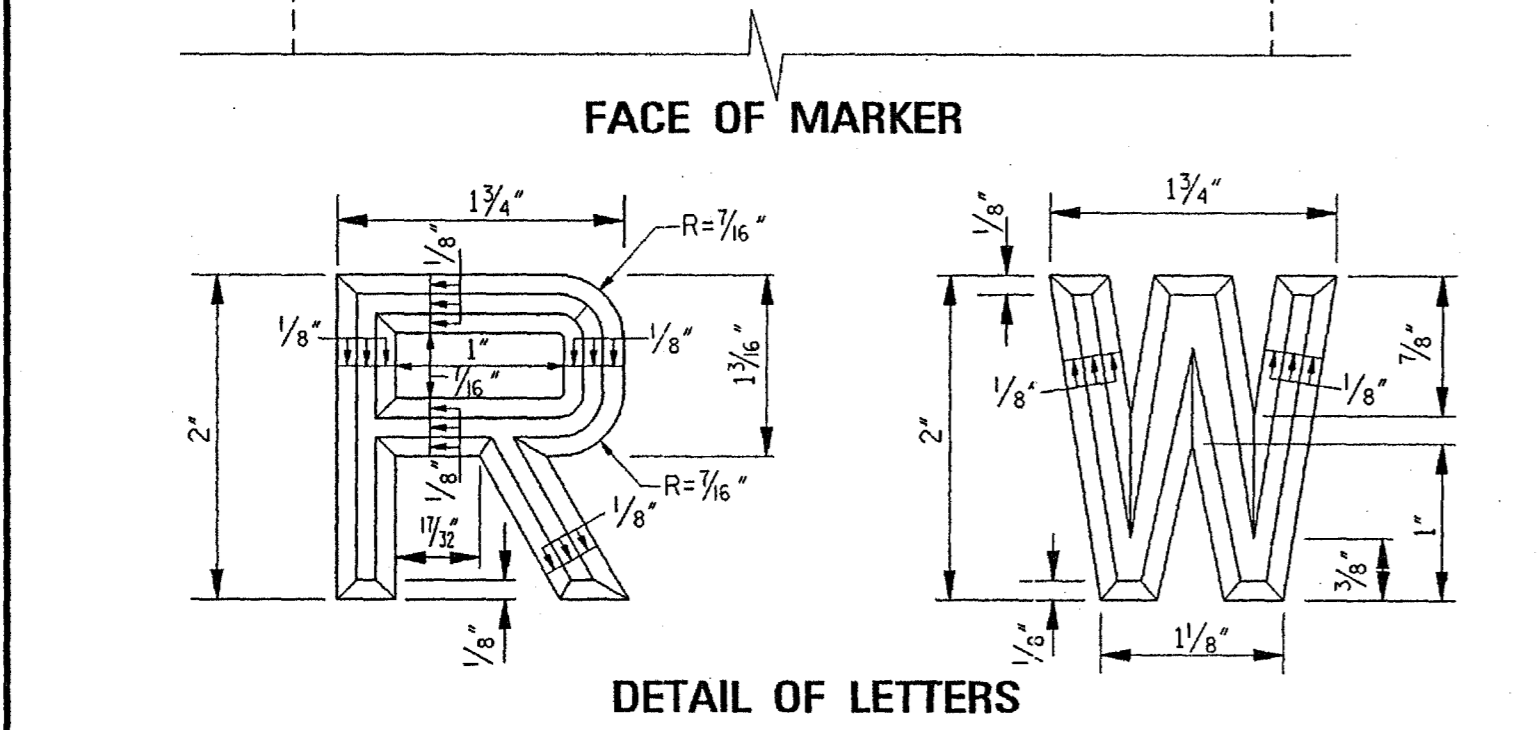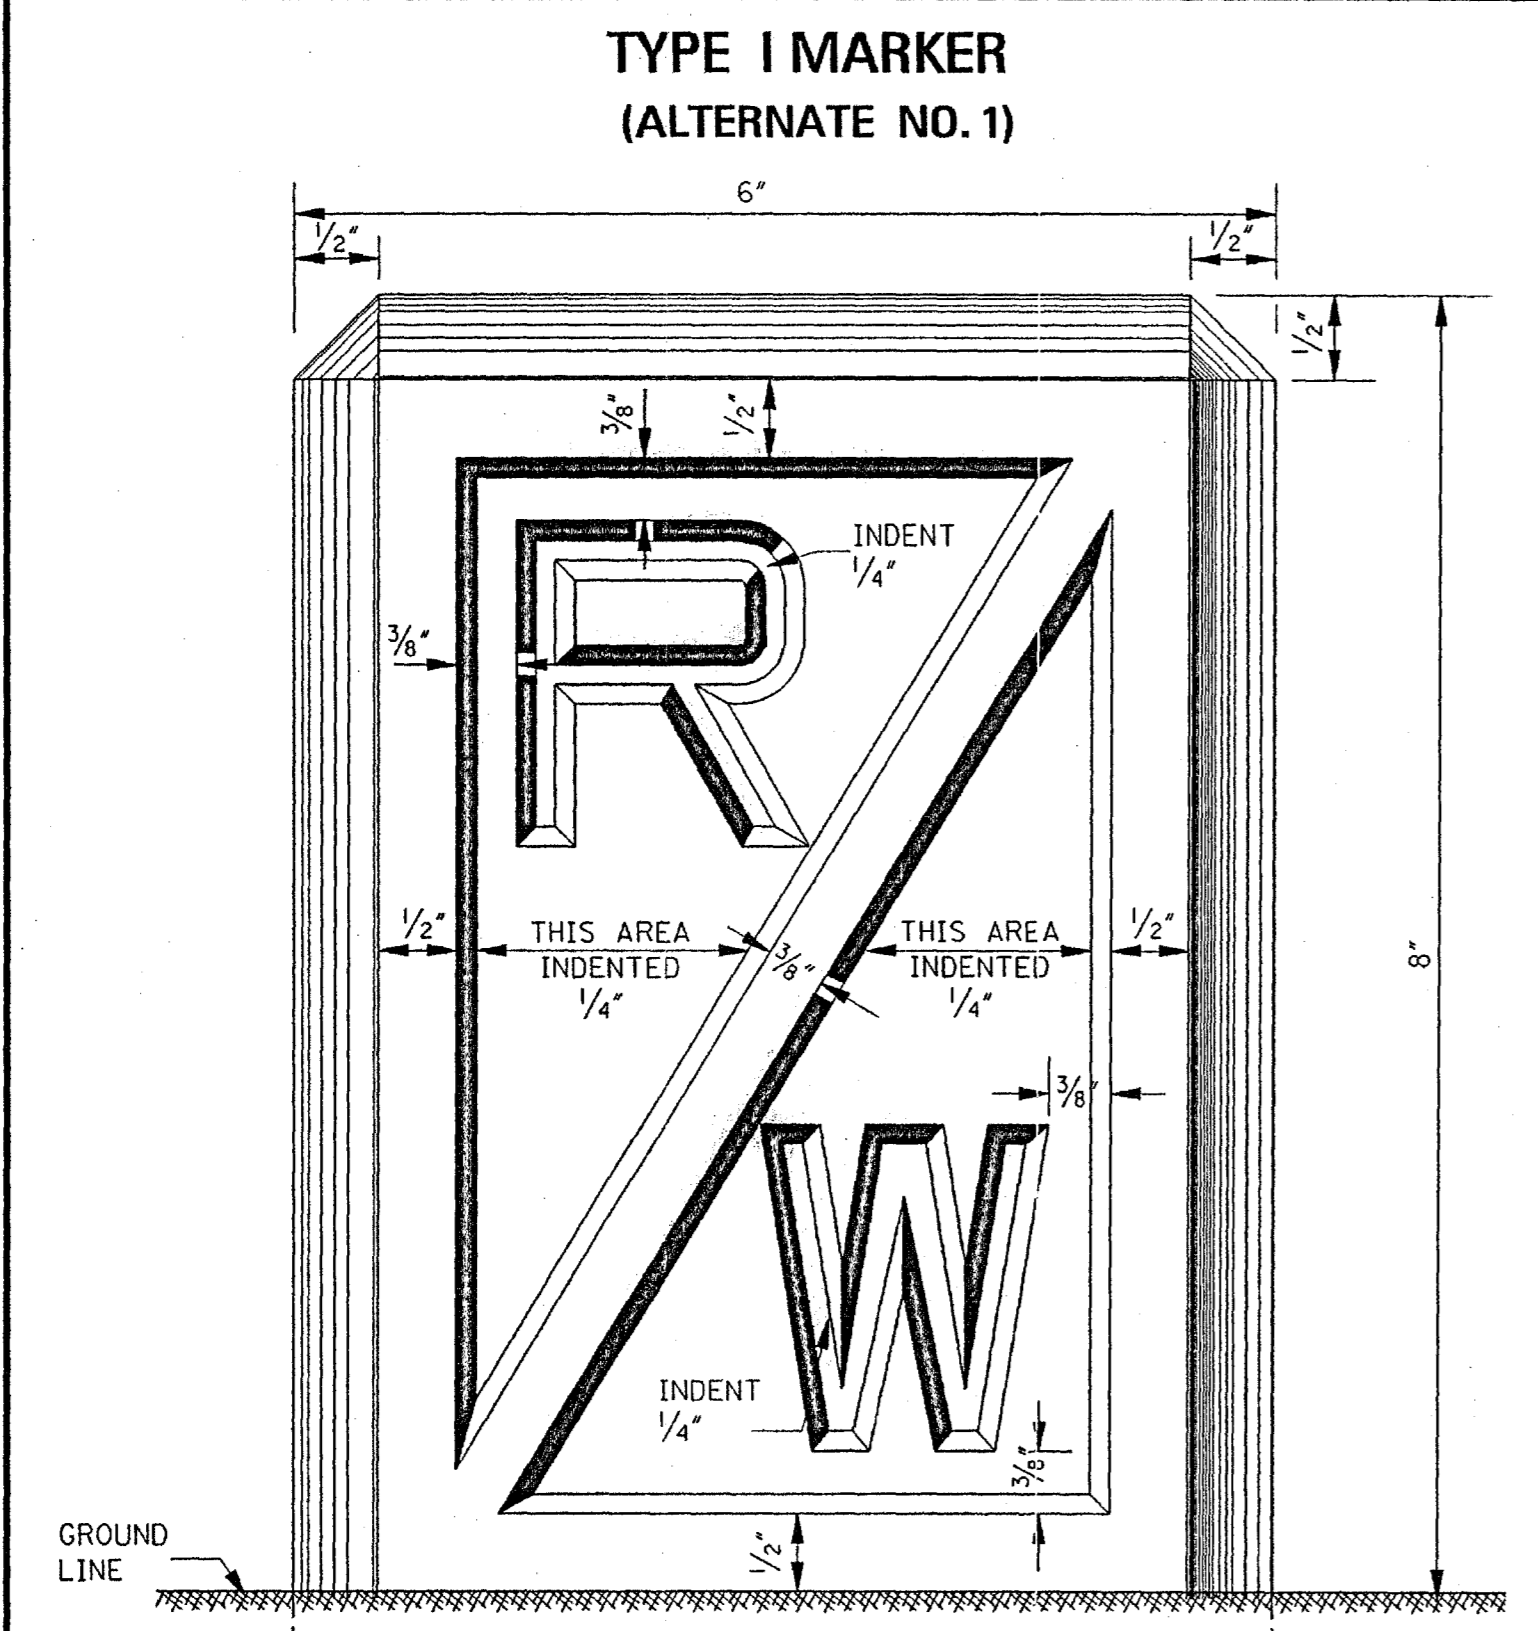

GENERAL NOTES:

- THE CONCRETE SHALL HAVE A MINIMUM CEMENT CONTENT OF 470 LBS OF CEMENT PER CUBIC YARD OF CONCRETE.
- THE MARKERS SHALL BE PLACED AS INDICATED ELSEWHERE ON PLANS.

DATE	ISSUE DATE: OCTOBER 1, 1998
REVISION	
BY	
S.W.R.	

MISSISSIPPI DEPARTMENT OF TRANSPORTATION
ROADWAY DESIGN DIVISION
STANDARD PLAN

RIGHT-OF-WAY MARKER




WORKING NUMBER: RW-1
SHEET NUMBER: 270

STATE	PROJECT NO.
MISS.	

FOR DIMENSIONS OF LETTERS, SEE "DETAIL OF LETTERS" FOR TYPE I, ALT. NO. 2.


Record Drawings
1-8-08

STATE	PROJECT NO.
MISS.	

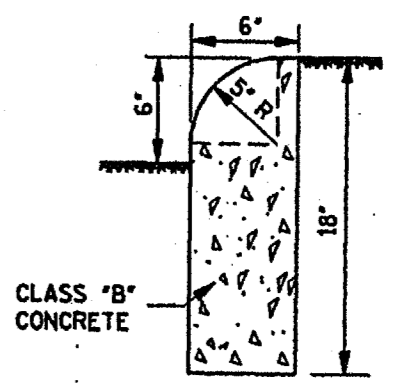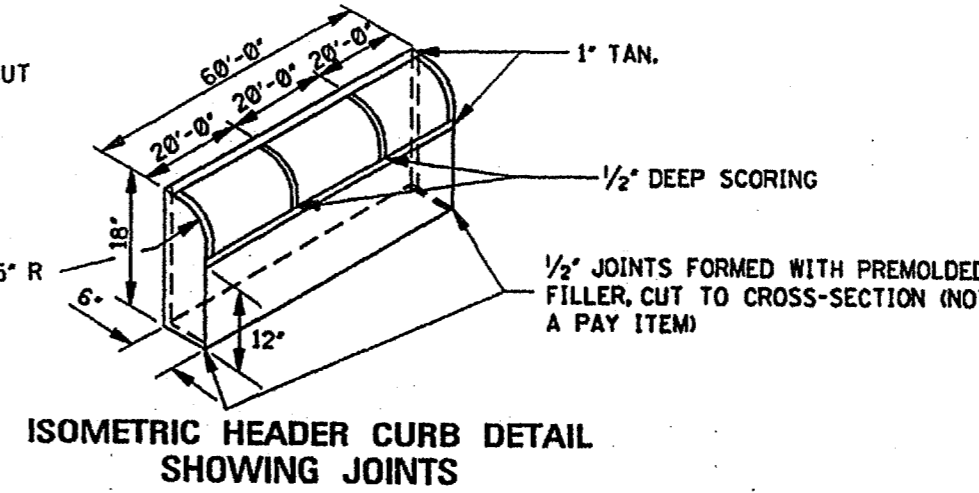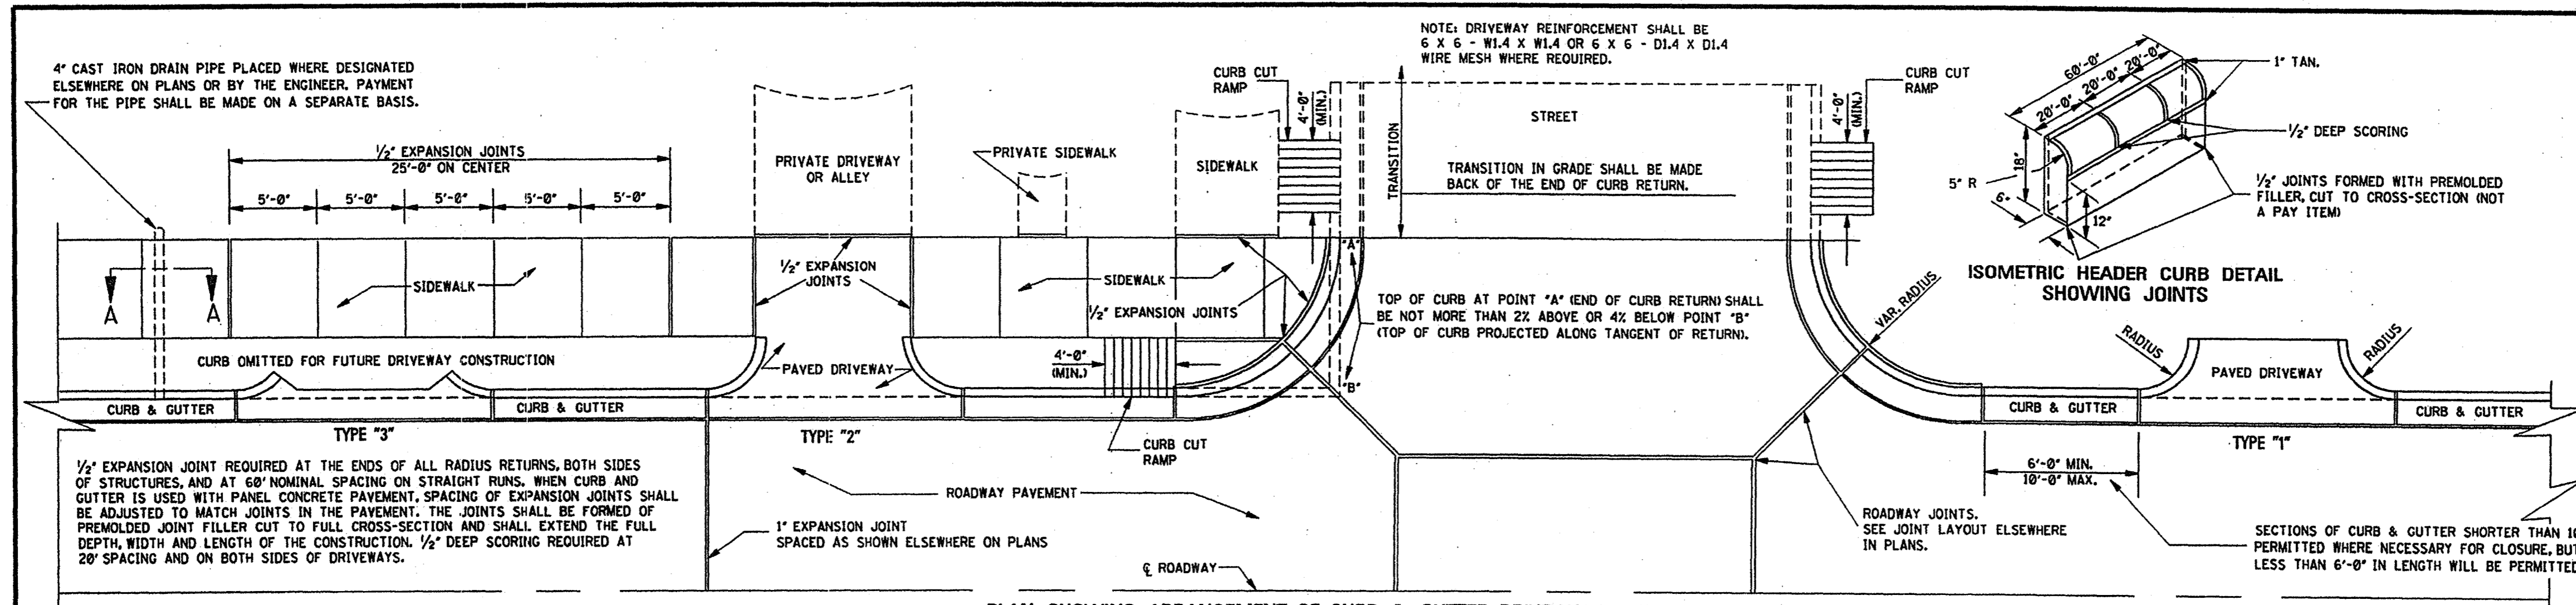














DETAIL OF HEADER CURB
CONTRACTION JOINTS REQUIRED AT 20' O.C.
EXPANSION JOINTS REQUIRED AT 60' O.C.
UNLESS OTHERWISE DIRECTED BY ENGINEER.

Record Drawings
1-8-08

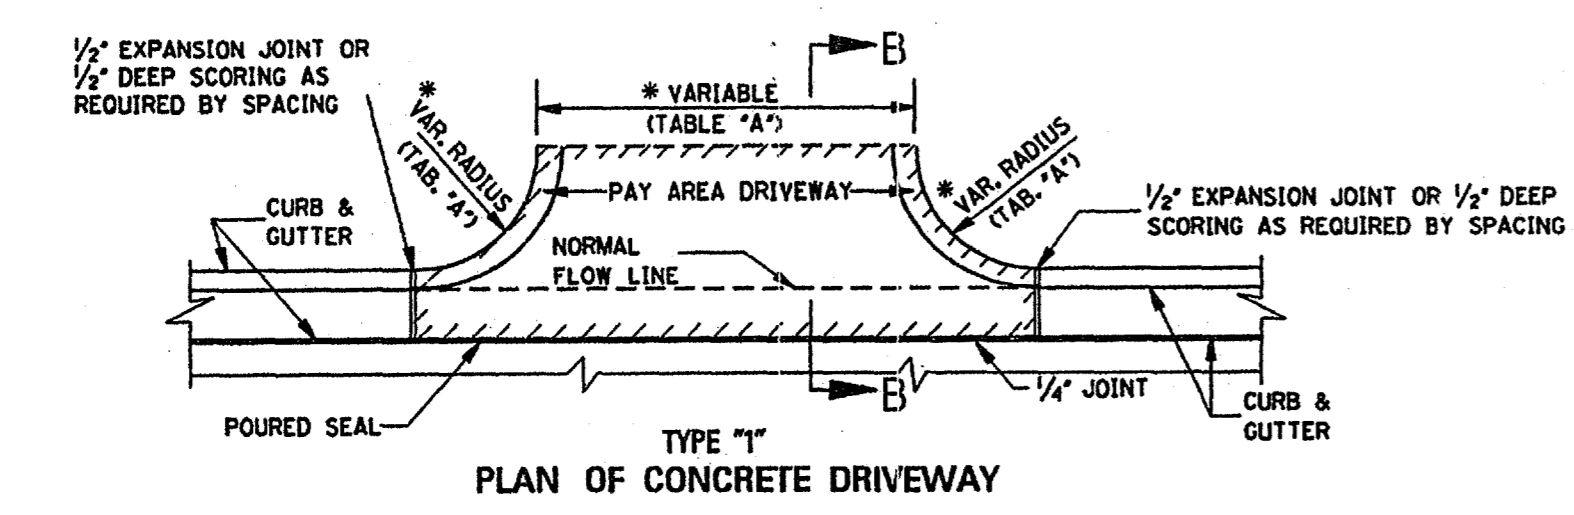

11.056 yd² FOR DRIVEWAY 16'-0" IN WIDTH.
0.574 yd² FOR EACH ADDED OR SUBTRACTED
FOOT OF WIDTH.
NOTE: THIS DRIVEWAY AREA EXAMPLE IS
COMPUTED ON THE BASIS OF 3'-0" RADIUS.
PAYMENT FOR CURB RADIUS SHALL BE
INCLUDED IN COMPENSATION FOR DRIVEWAY.

*TABLE 'A'		
DRIVEWAY TYPE	DRIVEWAY WIDTH (ft)	CURB RETURN RADIUS (ft)
RESIDENTIAL	16'	3' - 10"
COMMERCIAL/ INDUSTRIAL	30' - 50'	5' - 30"

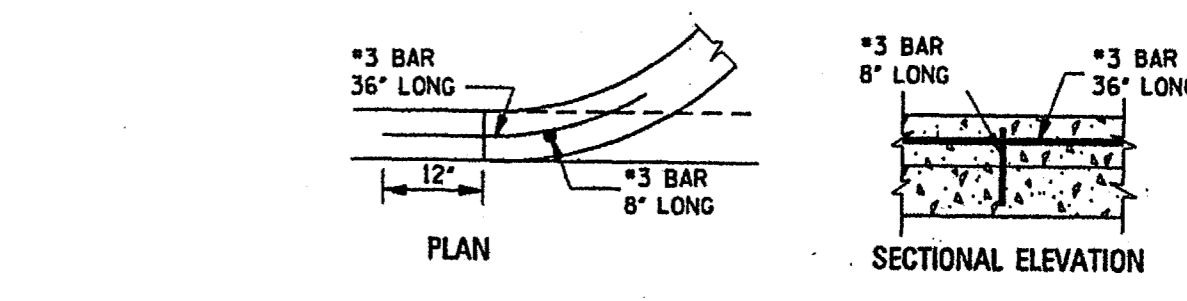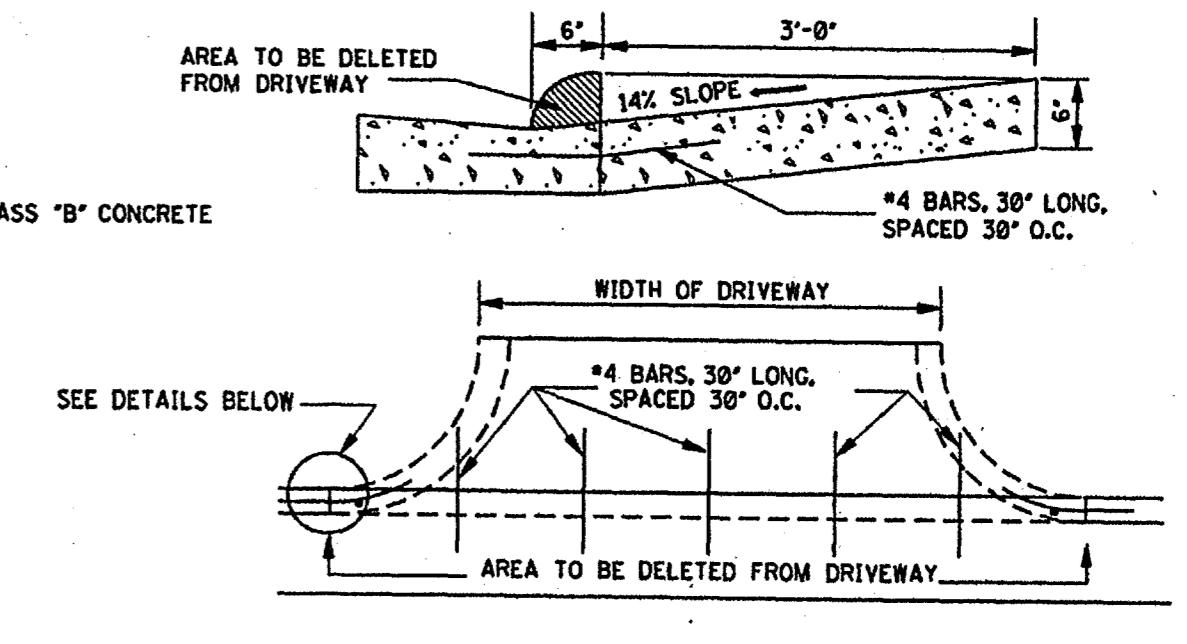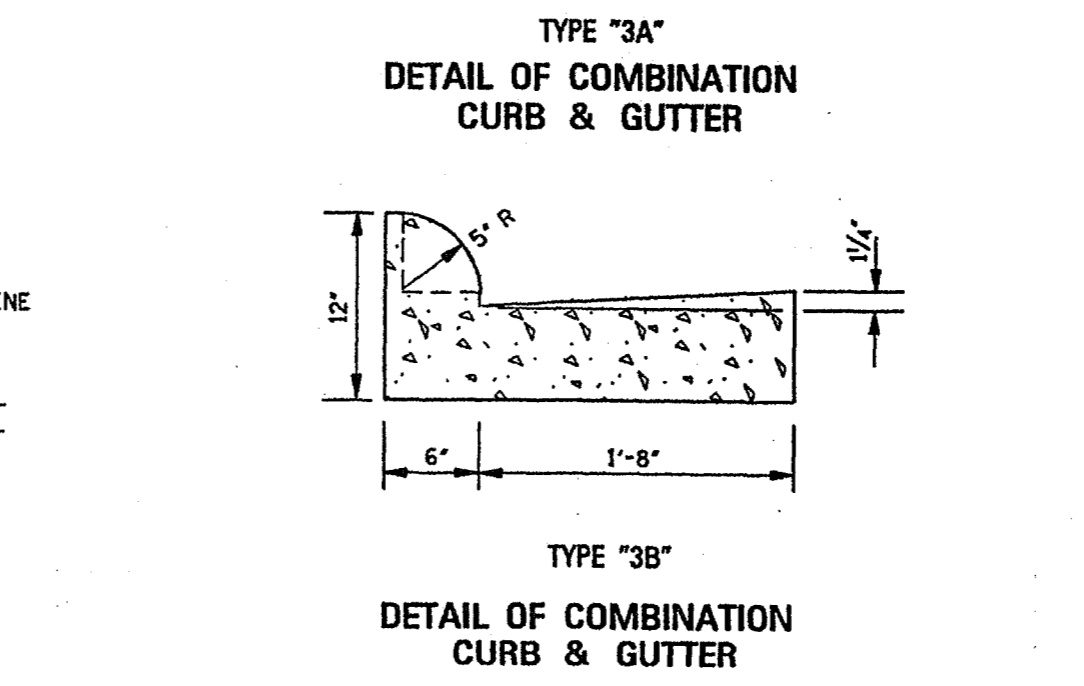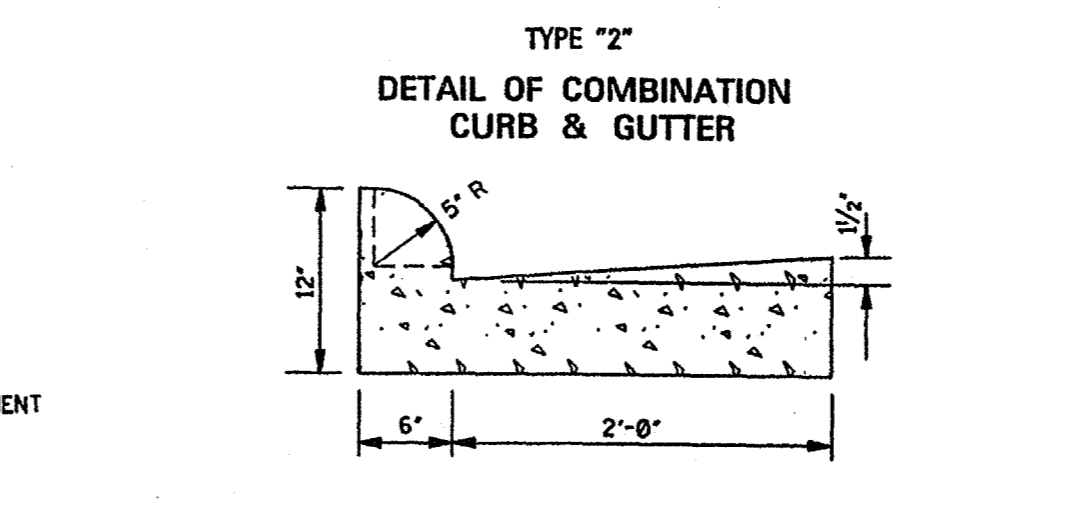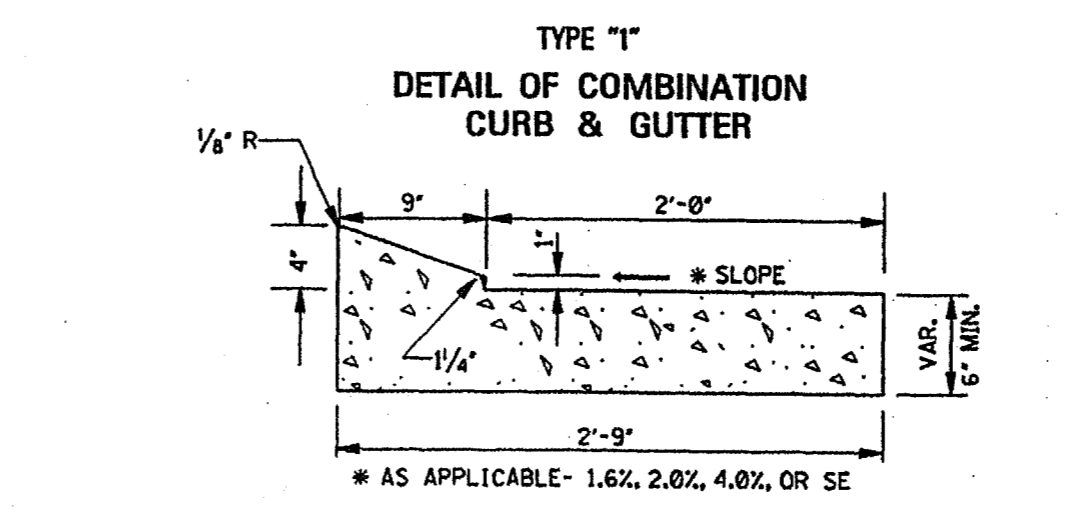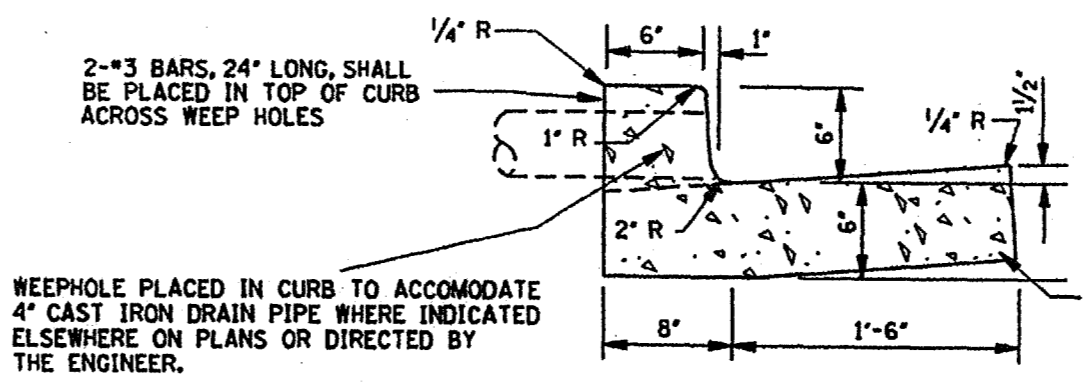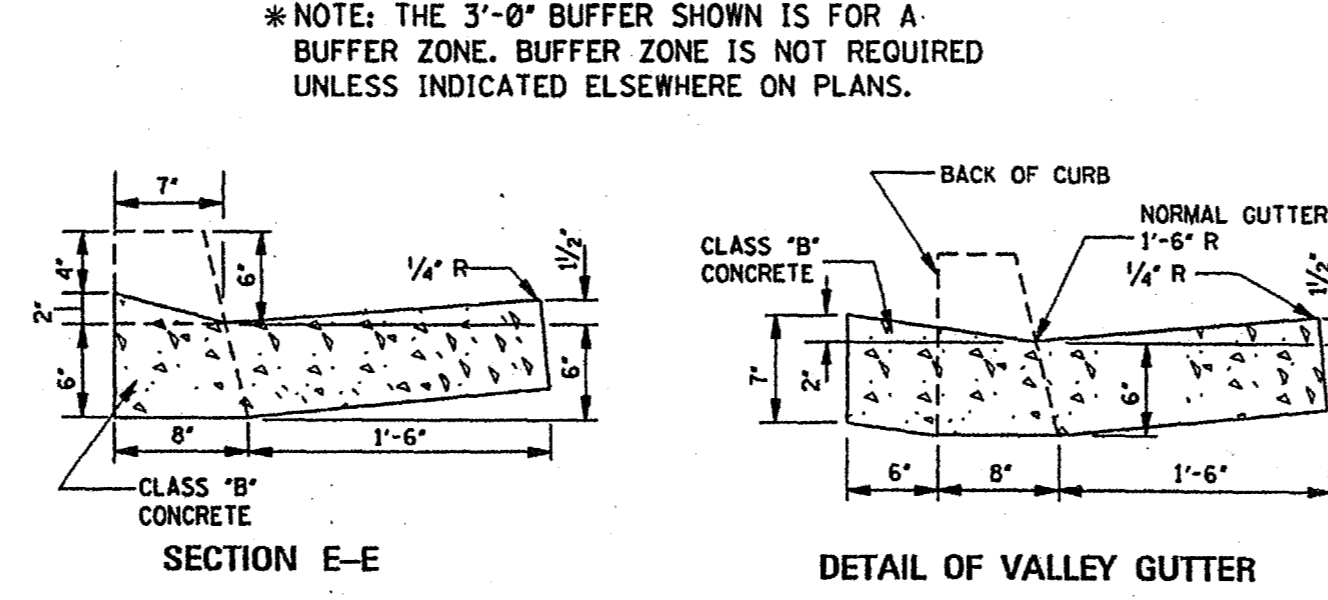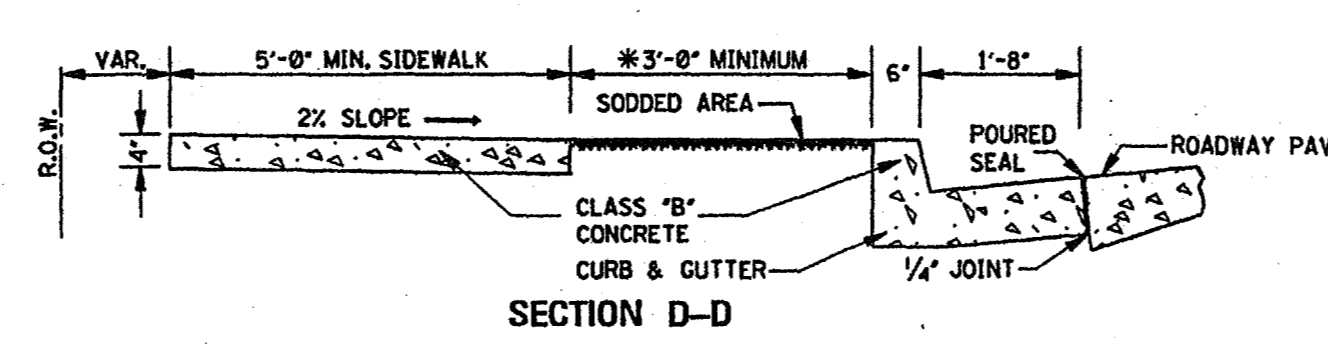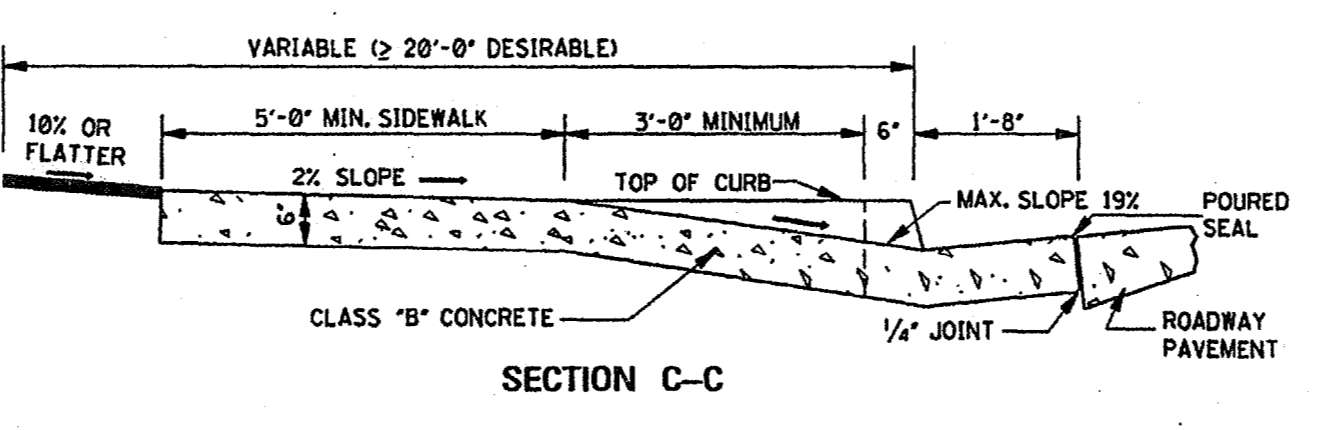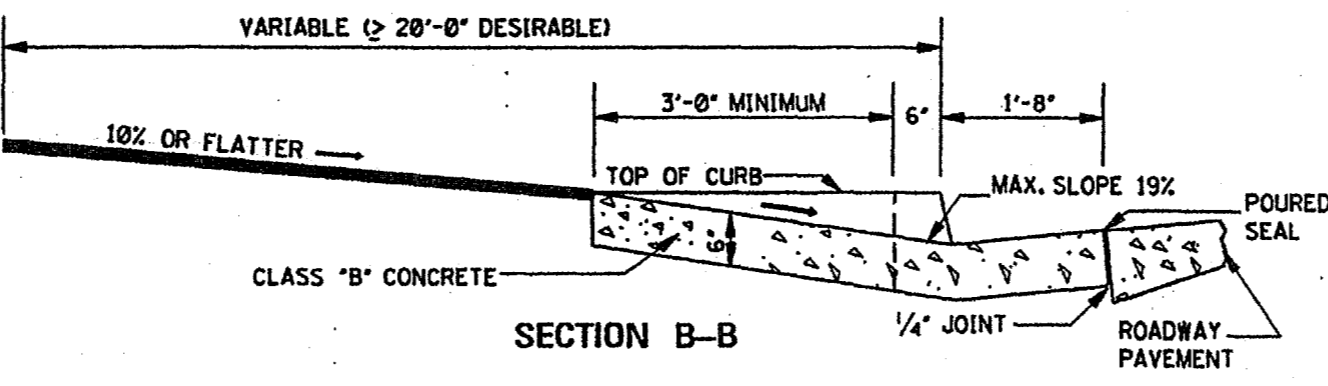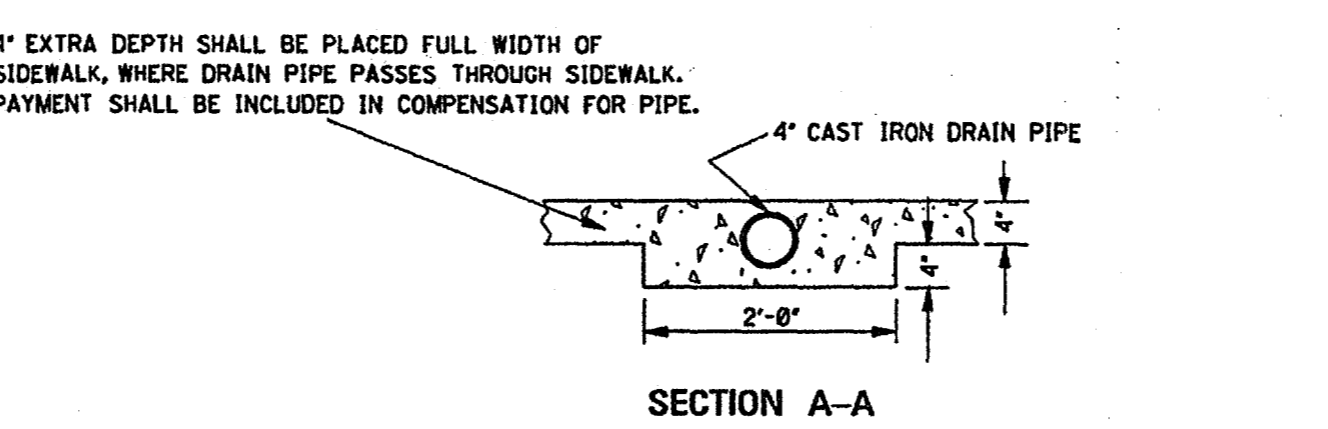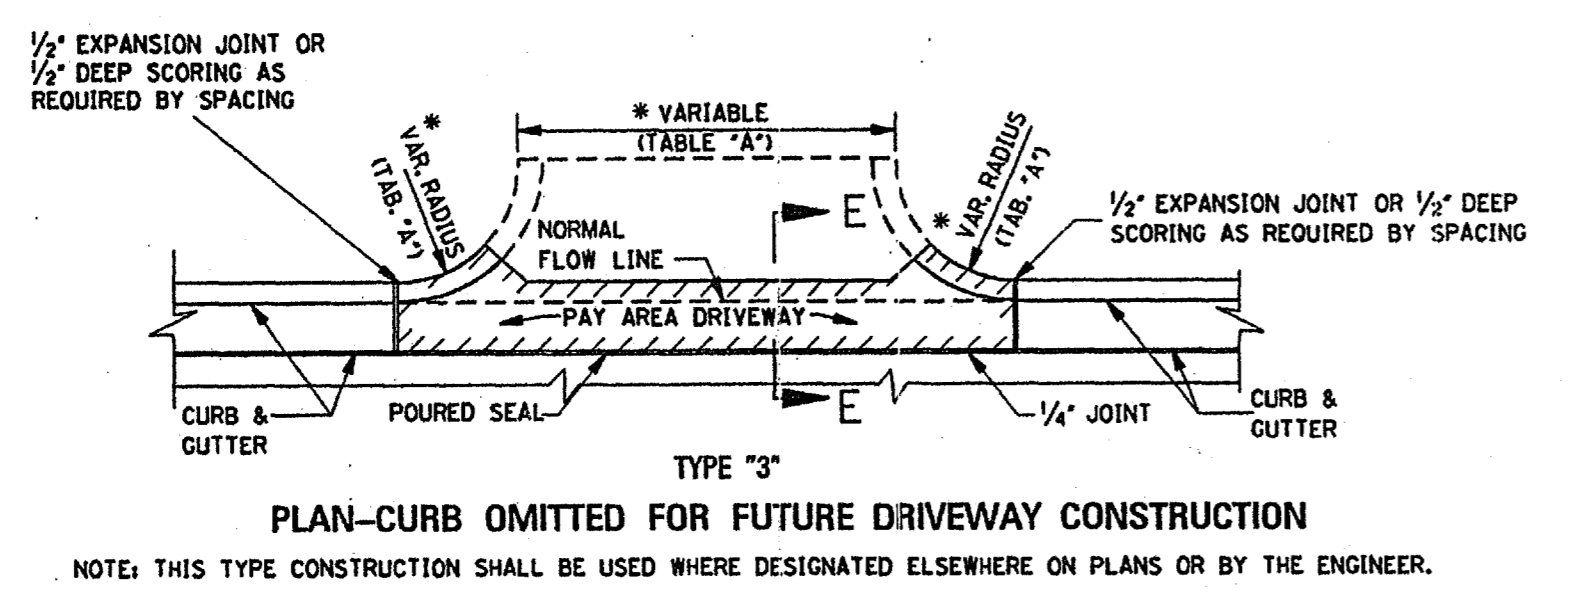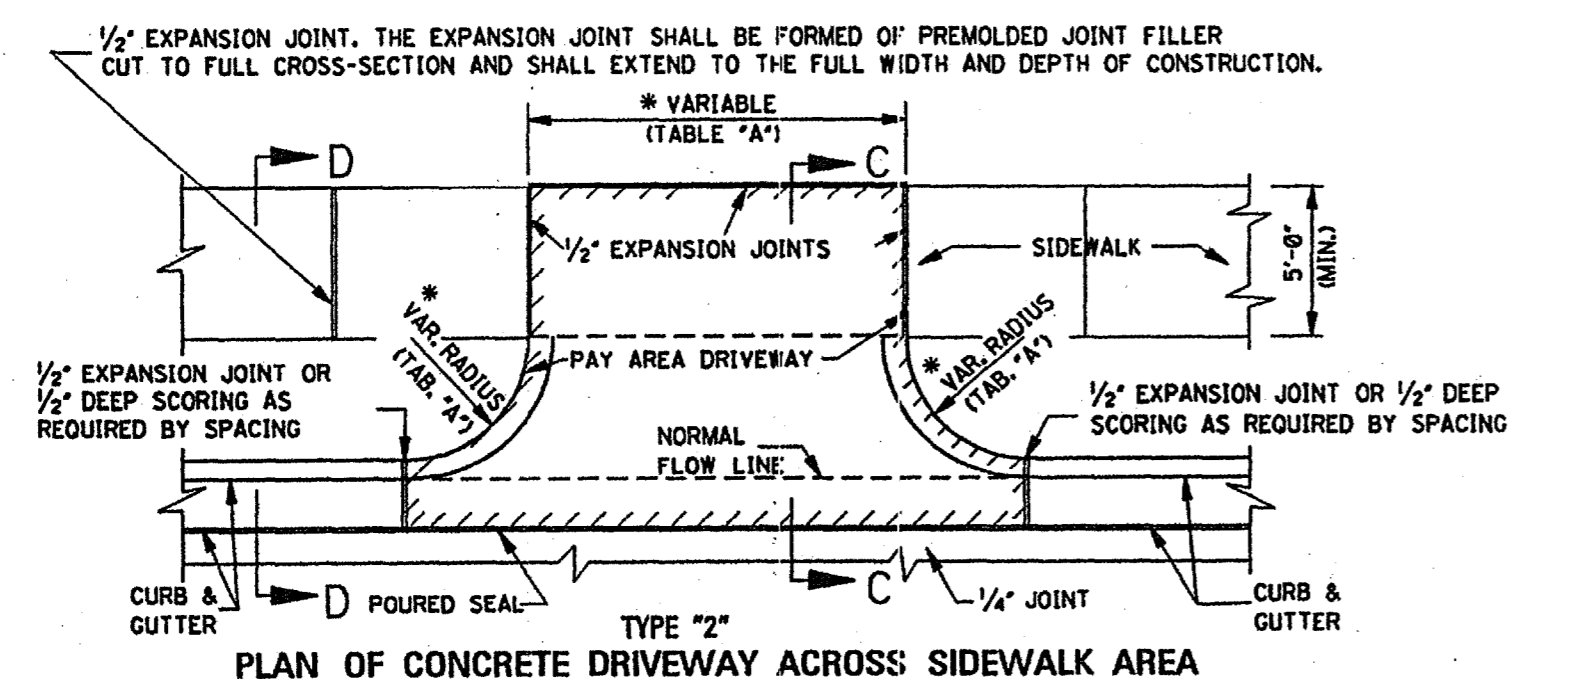

- GENERAL NOTES:
1. THE STANDARD SPECIFICATIONS ADOPTED BY THE MISSISSIPPI DEPARTMENT OF TRANSPORTATION SHALL UNLESS OTHERWISE SPECIFIED HEREIN, APPLY TO ALL ITEMS INCLUDED ON THIS DRAWING.
 2. TRAVERSE CONTRACTION JOINTS ARE REQUIRED AT 20' ON CENTER FOR ALL CONCRETE DRIVEWAYS THAT EXTEND PAST THE END OF THE CURB RETURN. A 1/2" WIDE EXPANSION JOINT IS REQUIRED AT THE END OF THE CURB RETURN AND AT 60' ON CENTER THROUGHOUT THE LENGTH OF THE DRIVEWAY. A LONGITUDINAL CONTRACTION JOINT IS REQUIRED FOR ALL DRIVEWAYS EXCEEDING 20' IN WIDTH.
 3. SEE SHEET CCR-1 FOR DETAILS OF CURB-CUT RAMPS.


MISSISSIPPI DEPARTMENT OF TRANSPORTATION ROADWAY DESIGN DIVISION STANDARD PLAN	
DRIVEWAYS, CURB & GUTTER & SIDEWALK	
WORKING NUMBER SD-1	SHEET NUMBER 287
ISSUE DATE: OCTOBER 1, 1998	

STATE	PROJECT NO.
MISS.	

**CORRUGATED STEEL AND ALUMINUM PIPE (ROUND)
H-20 LOADING**

PIPE DIAMETER (in)	MINIMUM COVER FROM TOP OF PIPE TO TOP OF SUBGRADE (in)	MAXIMUM FILL HEIGHT ABOVE TOP OF PIPE (ft)					
		SHEET THICKNESS (in)					
		0.064 STEEL 0.060 ALUM. 16 GAGE	0.079 STEEL 0.075 ALUM. 14 GAGE	0.109 STEEL 0.105 ALUM. 12 GAGE	0.138 STEEL 0.135 ALUM. 10 GAGE	0.168 STEEL 0.164 ALUM. 8 GAGE	
		2 3/4" x 1/2" CORRUGATED STEEL / RIVETED, WELDED OR HELICAL		3" x 1" OR 5" x 1" CORRUGATED STEEL / RIVETED, WELDED, HELICAL OR BOLTED		2 3/4" x 1/2" CORRUGATED ALUMINUM / RIVETED OR HELICAL	
12"	12"	84' / - / 45'	91' / - / 45'	- / - / 78'	- / - / 81'	- / - / 84'	- / - / 84'
15"	12"	67' / - / -	73' / - / -	- / - / -	- / - / -	- / - / -	- / - / -
18"	12"	56' / - / 30'	61' / - / 30'	- / - / 52'	- / - / 54'	- / - / 56'	- / - / 56'
24"	12"	42' / - / 22'	46' / - / 22'	59' / - / 39'	- / - / 41'	- / - / 42'	- / - / 42'
30"	12"	34' / - / 18'	36' / - / 18'	47' / - / 31'	- / - / 32'	- / - / 34'	- / - / 34'
36"	12"	28' / 48' / 15'	30' / 60' / 15'	39' / 78' / 26'	41' / 89' / 27'	- / 101' / 28'	- / 101' / 28'
42"	12"	31' / 41' / -	43' / 51' / 26'	46' / 64' / 43'	48' / 71' / 43'	50' / 79' / 44'	50' / 79' / 44'
48"	12"	27' / 36' / -	37' / 45' / -	45' / 57' / 40'	46' / 61' / 41'	47' / 66' / 43'	47' / 66' / 43'
54"	12"	- / 32' / -	33' / 40' / -	43' / 52' / 35'	44' / 55' / 37'	45' / 59' / 38'	45' / 59' / 38'
60"	12"	- / 29' / -	- / 36' / -	43' / 49' / -	43' / 51' / 33'	44' / 54' / 34'	44' / 54' / 34'
66"	12"	- / 26' / -	- / 33' / -	42' / 47' / -	43' / 49' / 30'	43' / 51' / 31'	43' / 51' / 31'
72"	12"	- / 24' / -	- / 30' / -	- / 44' / -	41' / 47' / -	43' / 49' / 29'	43' / 49' / 29'
78"	12"	- / 22' / -	- / 28' / -	- / 41' / -	- / 46' / -	39' / 47' / -	39' / 47' / -
84"	12"	- / 21' / -	- / 26' / -	- / 38' / -	- / 45' / -	35' / 46' / -	35' / 46' / -
90"	12"	- / 19' / -	- / 24' / -	- / 35' / -	- / 43' / -	- / 45' / -	- / 45' / -
96"	12"	- / 18' / -	- / 22' / -	- / 33' / -	- / 40' / -	- / 44' / -	- / 44' / -
102"	24"	- / 17' / -	- / 21' / -	- / 31' / -	- / 38' / -	- / 42' / -	- / 42' / -
108"	24"	- / - / -	- / 20' / -	- / 30' / -	- / 35' / -	- / 39' / -	- / 39' / -
114"	24"	- / - / -	- / 19' / -	- / 28' / -	- / 34' / -	- / 37' / -	- / 37' / -
120"	24"	- / - / -	- / - / -	- / 27' / -	- / 32' / -	- / 35' / -	- / 35' / -

NOTE: THE AVERAGE INSIDE DIAMETER SHALL NOT VARY MORE THAN ONE (1) PERCENT OR 1/2", WHICHEVER IS GREATER, FROM THE NOMINAL DIAMETER WHEN MEASURED ON THE INSIDE CREST OF THE CORRUGATIONS (AASHTO M 36/M 36 & AASHTO M 196/M 196).

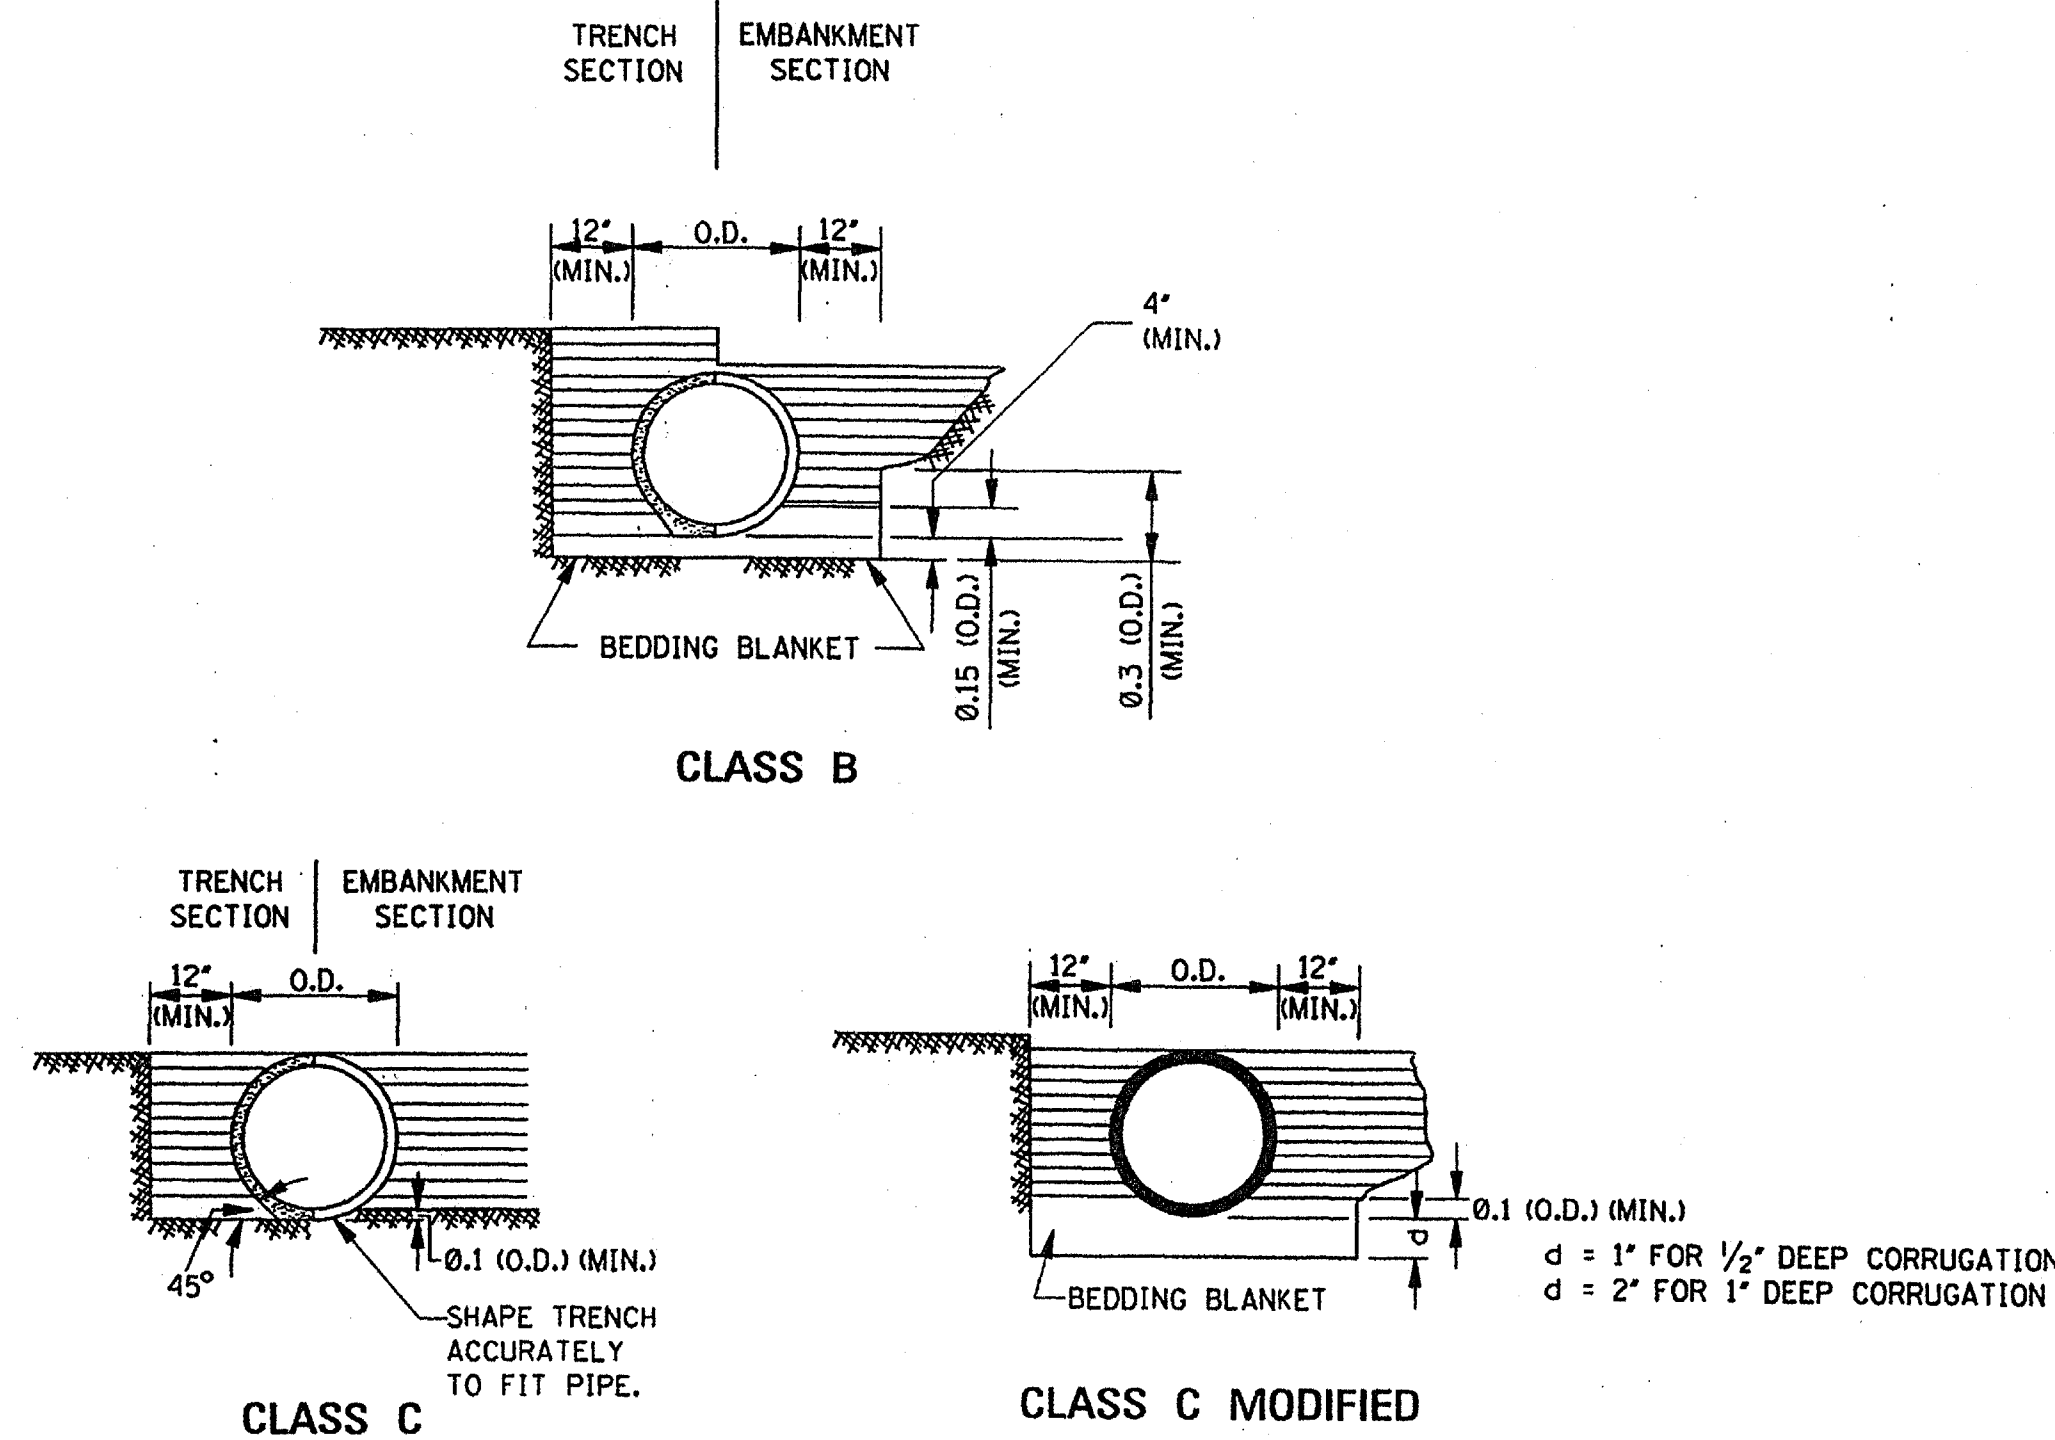

MAXIMUM HEIGHT OF FILL OVER REINFORCED CONCRETE PIPE

CLASS OF PIPE	TYPE OF BACKFILL	MAXIMUM COVER (ft)	
		CLASS "C" BEDDING	CLASS "B" BEDDING
III	NORMAL	16'	-
IV	NORMAL	23'	28'
V	NORMAL	30'	36'
IV	IMPERFECT	-	90'
V	IMPERFECT	-	115'

NOTE: CLASS OF PIPE AND BEDDING TO BE CONSISTENT THROUGHOUT THE PIPE LENGTH.

MAXIMUM HEIGHT OF FILL OVER CLASS 2 NONREINFORCED CONCRETE PIPE, PERFORATED AND/OR PLAIN, FOR UNDERDRAINS


PIPE SIZE (in)	MAXIMUM COVER (ft)			
	BEDDING CLASS "C" / CLASS "B"		PROJECTING	
	TRENCH	SAND & GRAVEL	DAMP CLAY	POSITIVE
4"	2.00'	*	*	34'/42'
6"	2.00'	*	*	25'/30'
8"	2.25'	*	16'/*	19'/24'
10"	2.50'	*	12'/20'	16'/19'
12"	2.75'	*	12'/18'	14'/17'

- NOTES:
- *1. INDICATES NO LIMIT OF FILL HEIGHT (130 lbs/ft³).
 2. TRENCH WIDTH (B_d) NO GREATER THAN 16" PLUS O.D.
 3. FACTOR OF SAFETY IS 1.25 ON MINIMUM ULTIMATE STRENGTH.
 4. MINIMUM COVER FOR HIGHWAY LOADS IS 18".
 5. PERFORATED PIPE SHALL BE TYPE 1.


CORRUGATED METAL PIPE ARCHES H-20 LOADING

EQUIV. DIAMETER (in)	PIPE DIMENSION (SPAN X RISE) (in)	MINIMUM CORNER RADIUS (in)	MINIMUM COVER FROM TOP OF PIPE TO TOP OF SUBGRADE FOR 2 tons/ft ² (in)	STEEL		ALUMINUM		
				MINIMUM THICKNESS REQUIRED (in)	MAXIMUM FILL HEIGHT ABOVE TOP OF PIPE (ft) FOR THE FOLLOWING CORNER BEARING PRESSURE (tons/ft ²)	MINIMUM THICKNESS REQUIRED (in)	MAXIMUM FILL HEIGHT ABOVE TOP OF PIPE (ft) FOR THE FOLLOWING CORNER BEARING PRESSURE (tons/ft ²)	
				2 tons/ft ²	3 tons/ft ²	2 tons/ft ²	3 tons/ft ²	
				2 3/4" x 1/2" CORRUGATION RIVETED, WELDED OR HELICAL		2 3/4" x 1/2" CORRUGATION RIVETED OR HELICAL		
15"	17" x 13"	3"	18"	0.064"	13'	15'	0.060"	15'
18"	21" x 15"	3"	18"	0.064"	12'	15'	0.060"	14'
24"	28" x 20"	3"	18"	0.064"	10'	15'	0.060"	10'
30"	35" x 24"	3"	18"	0.079"	9'	14'	0.060"	9'
36"	42" x 29"	3 1/2"	18"	0.079"	9'	13'	0.075"	9'
42"	49" x 33"	4"	18"	0.079"	8'	12'	0.105"	8'
48"	57" x 38"	5"	18"	0.109"	8'	12'	0.135"	8'
54"	64" x 43"	6"	18"	0.109"	8'	12'	0.135"	8'
60"	71" x 47"	7"	18"	0.138"	8'	12'	0.164"	8'
66"	77" x 52"	8"	18"	0.168"	8'	12'	-	-
72"	83" x 57"	9"	18"	0.168"	9'	13'	-	-
				5" x 1" OR 3" x 1" CORRUGATION RIVETED, WELDED OR HELICAL				
36"	40" x 31"	5"	18"	0.079"	12'	15'	-	-
42"	46" x 36"	6"	18"	0.079"	12'	15'	-	-
48"	53" x 41"	7"	18"	0.079"	12'	15'	-	-
54"	60" x 46"	8"	18"	0.079"	12'	15'	-	-
60"	66" x 51"	9"	18"	0.079"	12'	15'	-	-
66"	73" x 55"	12"	18"	0.079"	15'	-	-	-
72"	81" x 59"	14"	18"	0.079"	15'	-	-	-
78"	87" x 63"	14"	18"	0.079"	14'	15'	-	-
84"	95" x 67"	16"	18"	0.109"	13'	15'	-	-
90"	103" x 71"	16"	24"	0.109"	12'	15'	-	-
96"	112" x 75"	18"	24"	0.109"	11'	15'	-	-

- NOTES:
1. THE AVERAGE INSIDE DIAMETER SHALL NOT VARY MORE THAN ONE (1) PERCENT OR 1/2", WHICHEVER IS GREATER, FROM THE NOMINAL DIAMETER WHEN MEASURED ON THE INSIDE CREST OF THE CORRUGATIONS. (AASHTO M 36/M 36 & AASHTO M 196/M 196).
 2. BEARING PRESSURES EXCEEDING 2 tons/ft² REQUIRED FOR GIVEN FILL HEIGHT SHALL HAVE FOUNDATION MATERIALS INVESTIGATED TO DETERMINE BEARING CAPACITY.

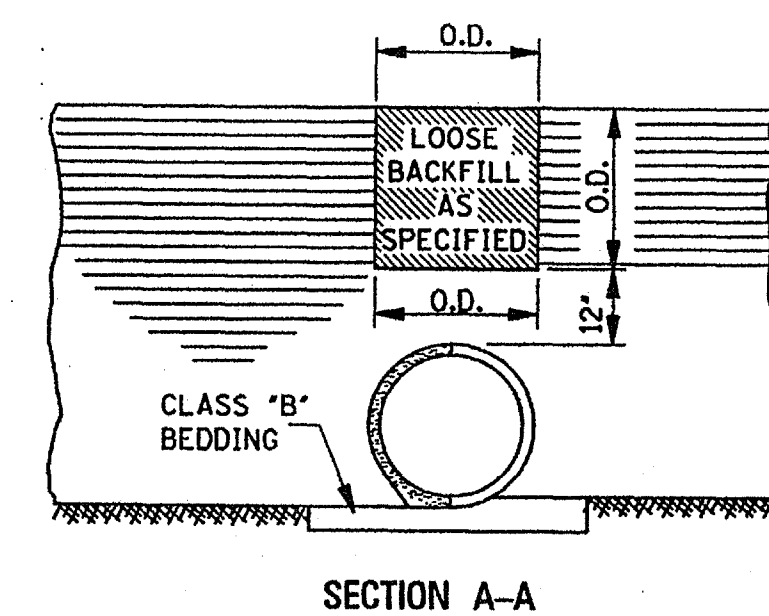

Record Drawings
1-8-08

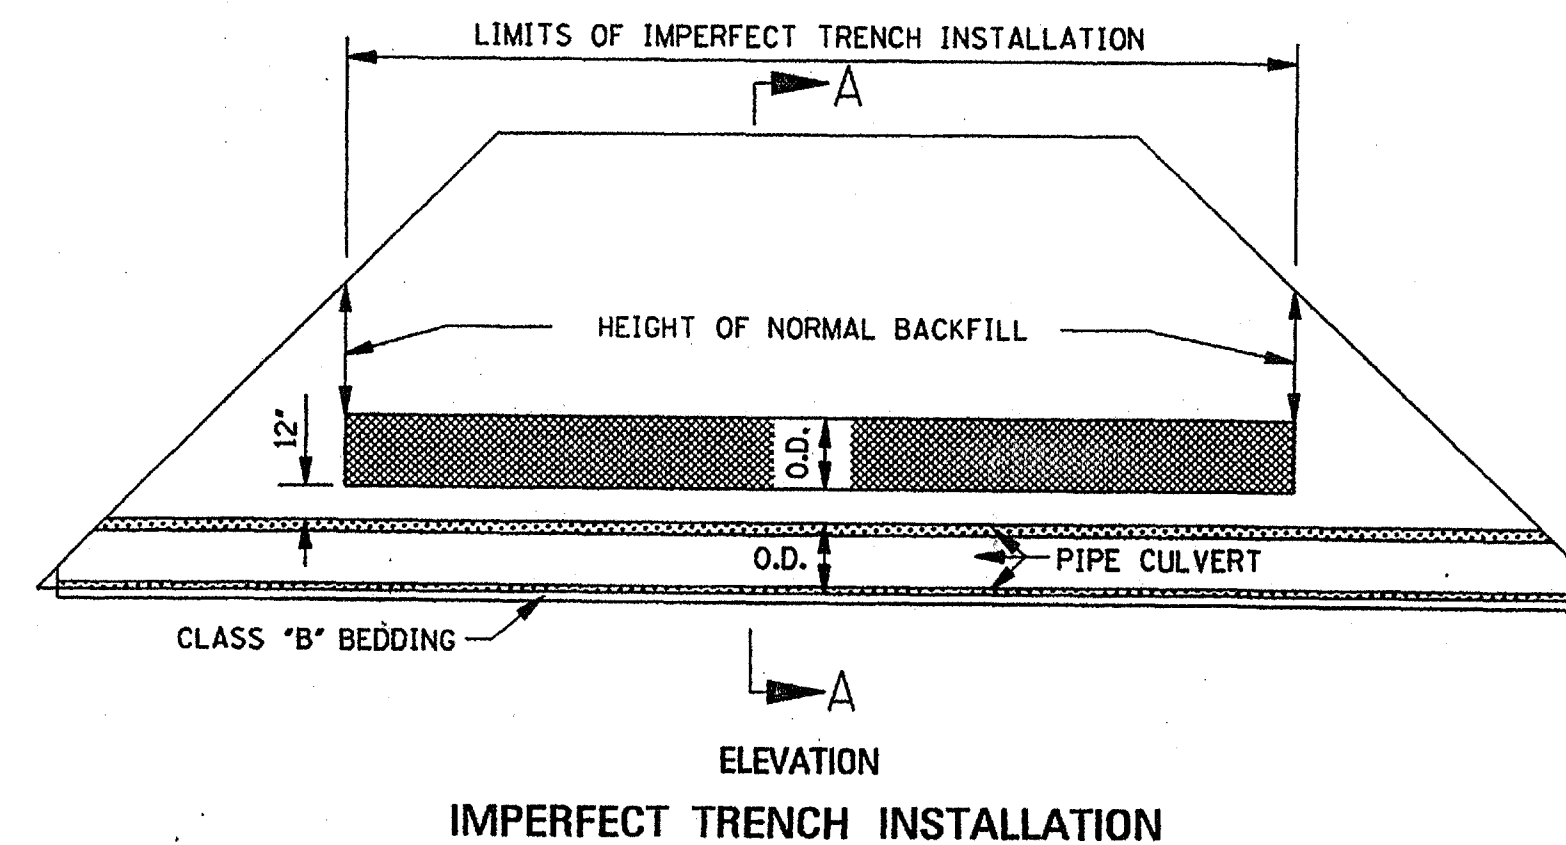


GENERAL NOTES:


1. MINIMUM SPACING BETWEEN MULTIPLE LINES OF PARALLEL PIPE SHALL BE THE DISTANCE REQUIRED FOR INSTALLING THE ADJACENT FLARED END SECTIONS OR AS SHOWN ON THE HEADWALL DRAWINGS FOR CONDUITS REQUIRING HEADWALLS.
2. UNLESS OTHERWISE INDICATED, THE TOP OF THE PIPE SHALL BE BELOW THE TOP OF THE SUBGRADE, AND A MINIMUM OF 12" OF COVER OVER THE TOP OF THE PIPE SHALL BE MAINTAINED BETWEEN THE SHOULDER LINES.
3. WHERE PRE-BED PIPE IS INSTALLED, FLARED END SECTIONS FROM OTHER MANUFACTURERS MAY BE JOINED TO PRE-BED PIPE PROVIDED A CONCRETE COLLAR IS PLACED AT THE CONTRACTOR'S EXPENSE AND A DEFORMATION TO THE PIPE'S FLOWLINE IS NOT EVIDENT ON FINAL PLACEMENT.

MISSISSIPPI DEPARTMENT OF TRANSPORTATION ROADWAY DESIGN DIVISION STANDARD PLAN		
<p align="center">PIPE CULVERT INSTALLATION</p>		
DATE	ISSUE DATE: OCTOBER 1, 1998	WORKING NUMBER PI-1
REVISION		SHEET NUMBER 300


STATE	PROJECT NO.
MISS.	

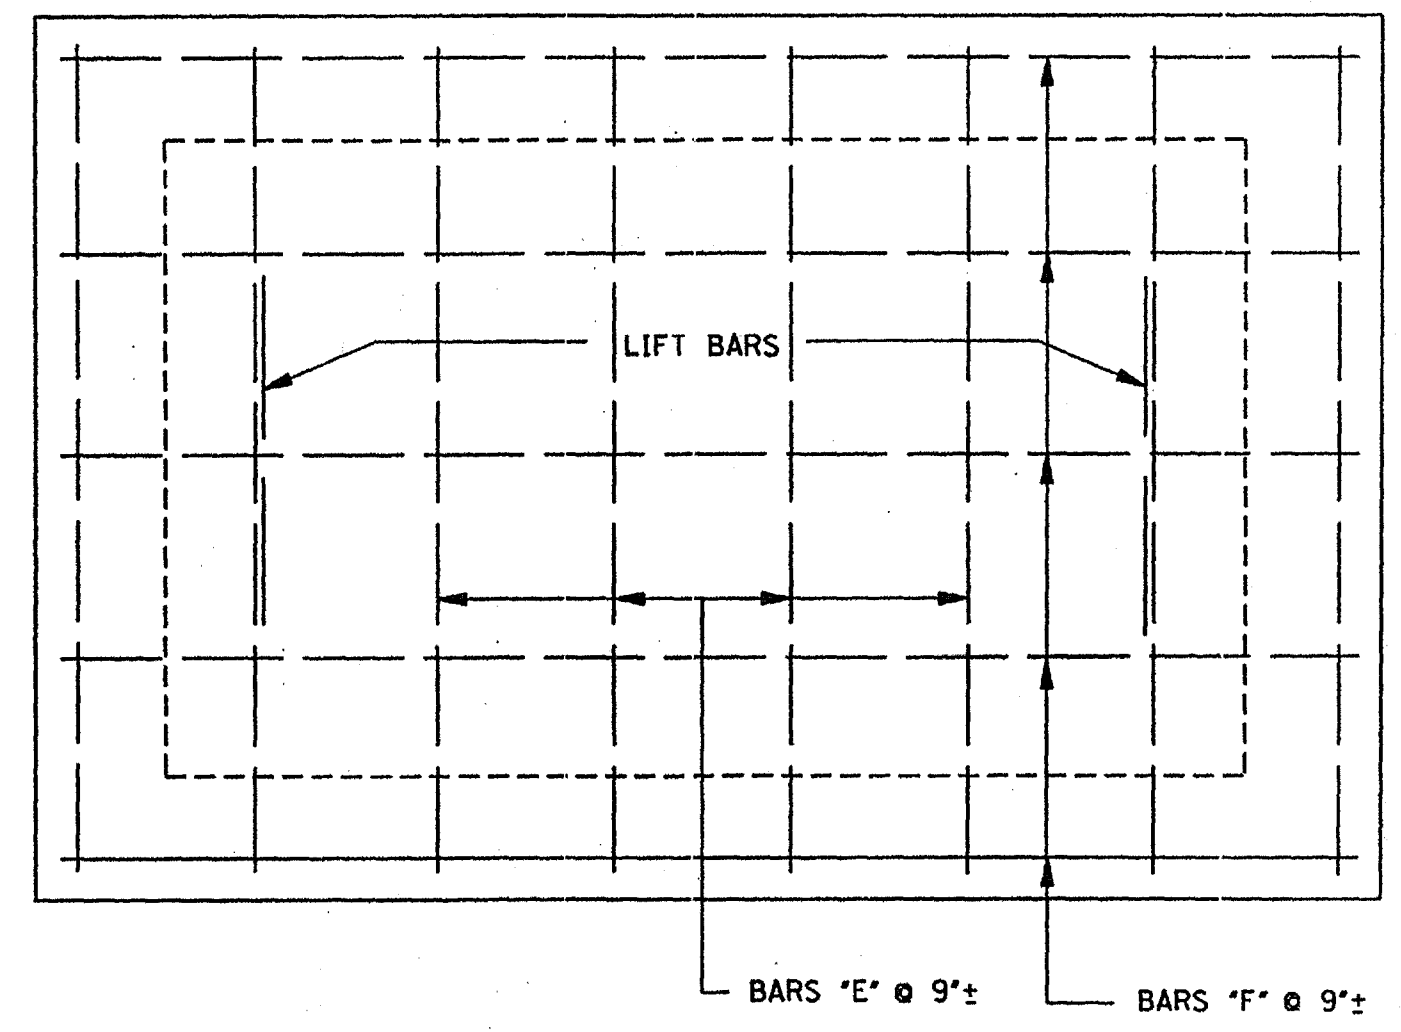


PLAN OF COVER

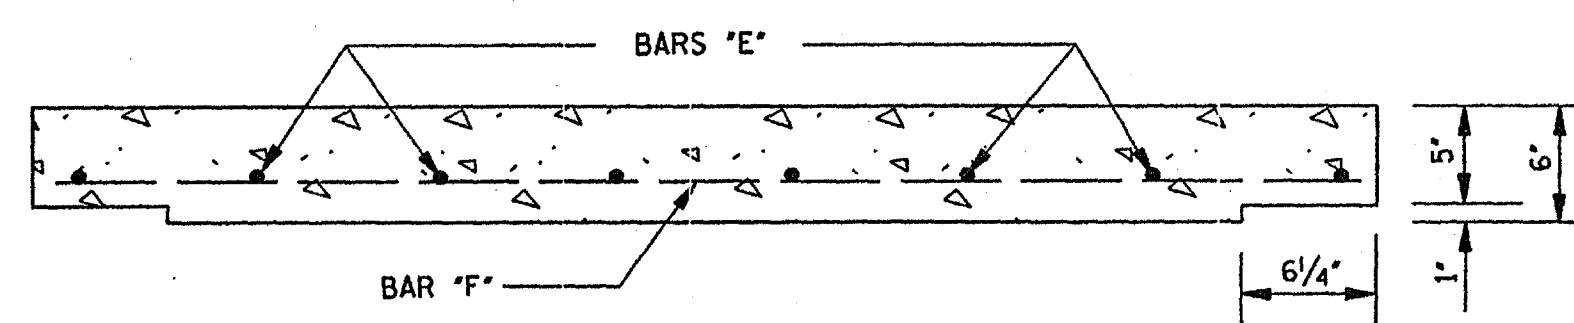


ELEVATION OF COVER

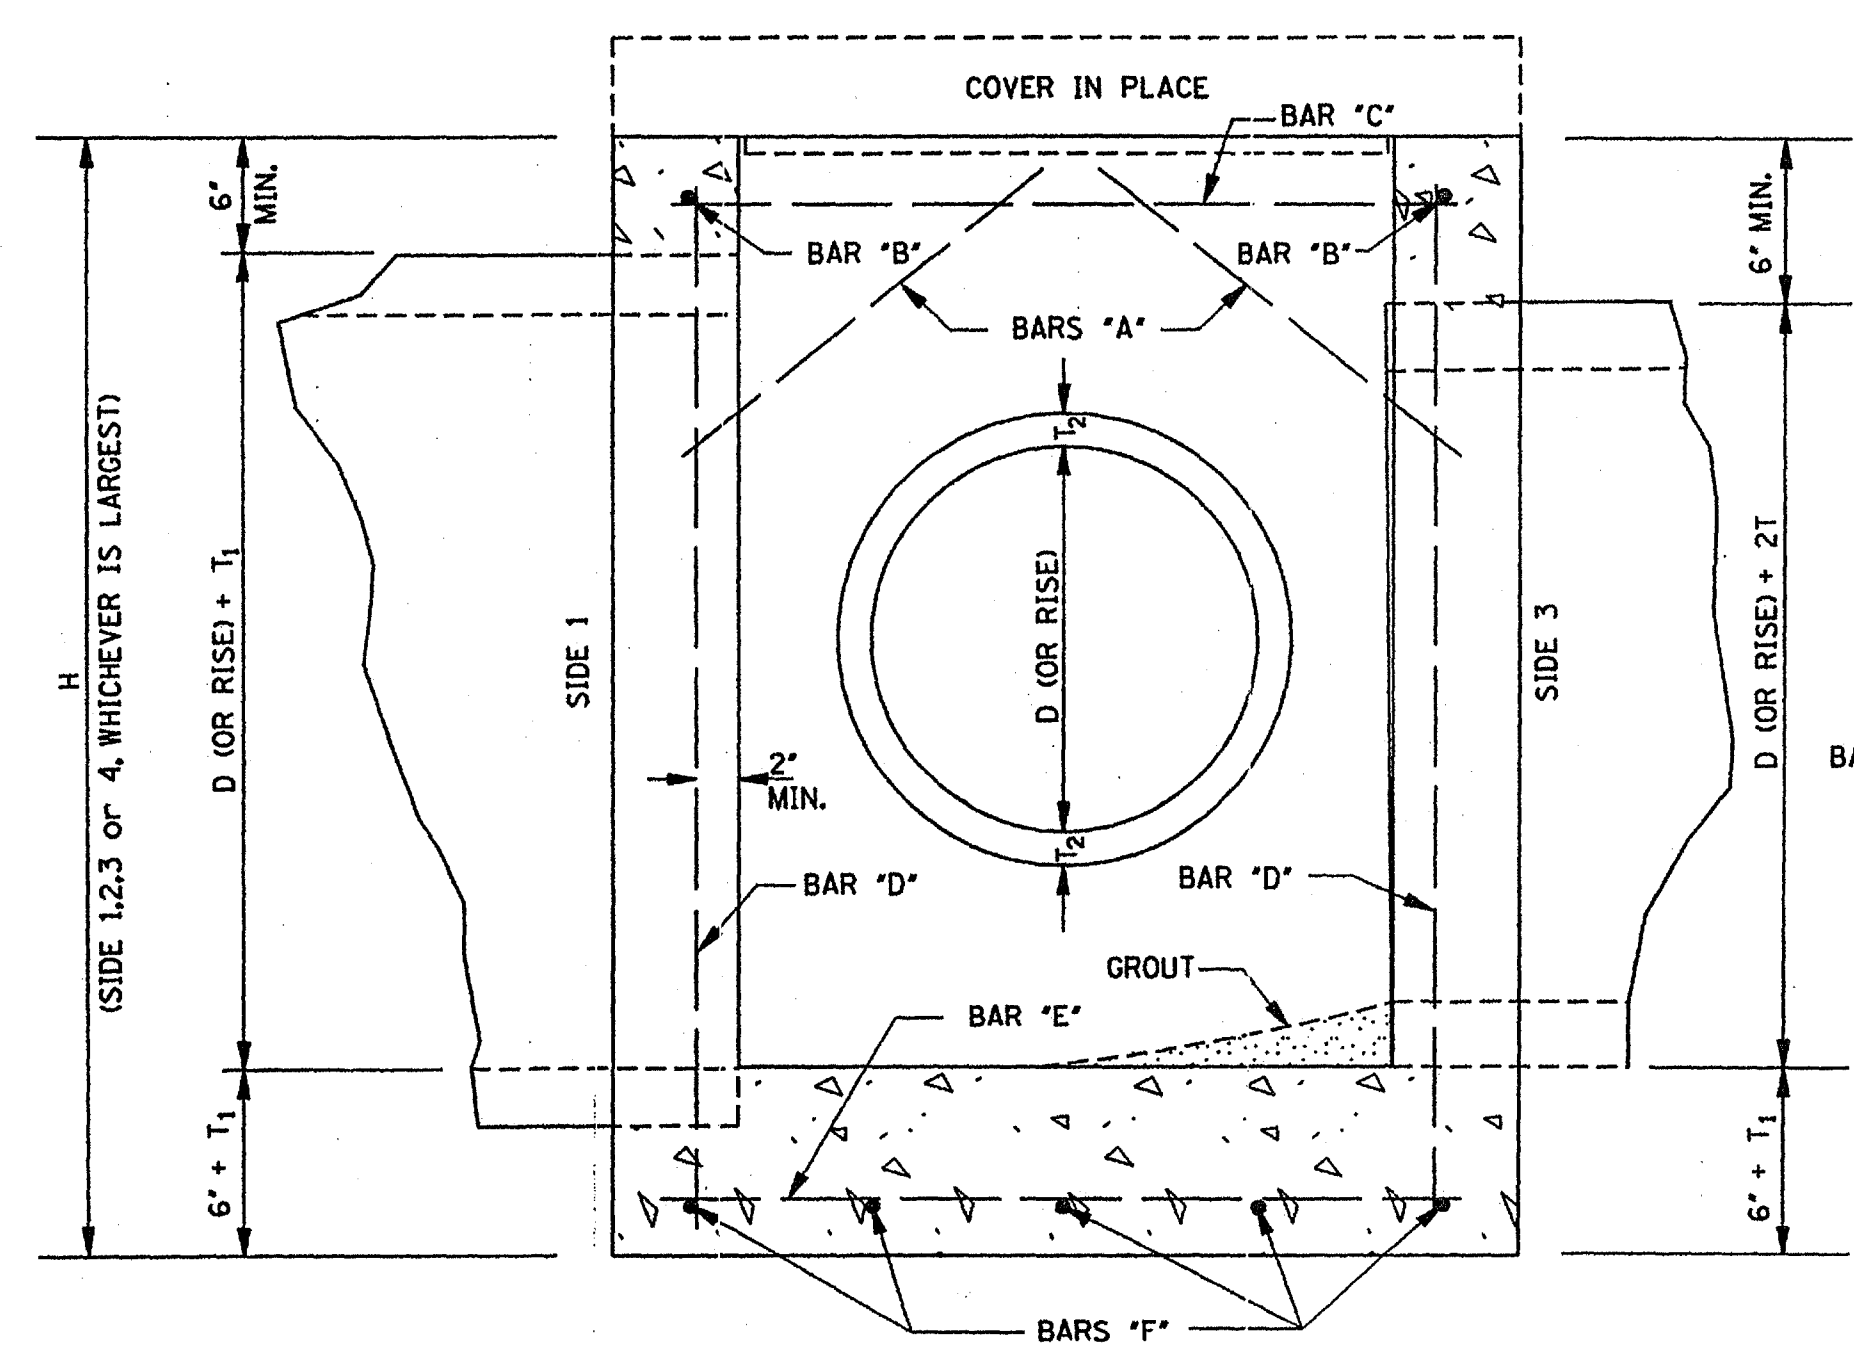

SECTION B-B

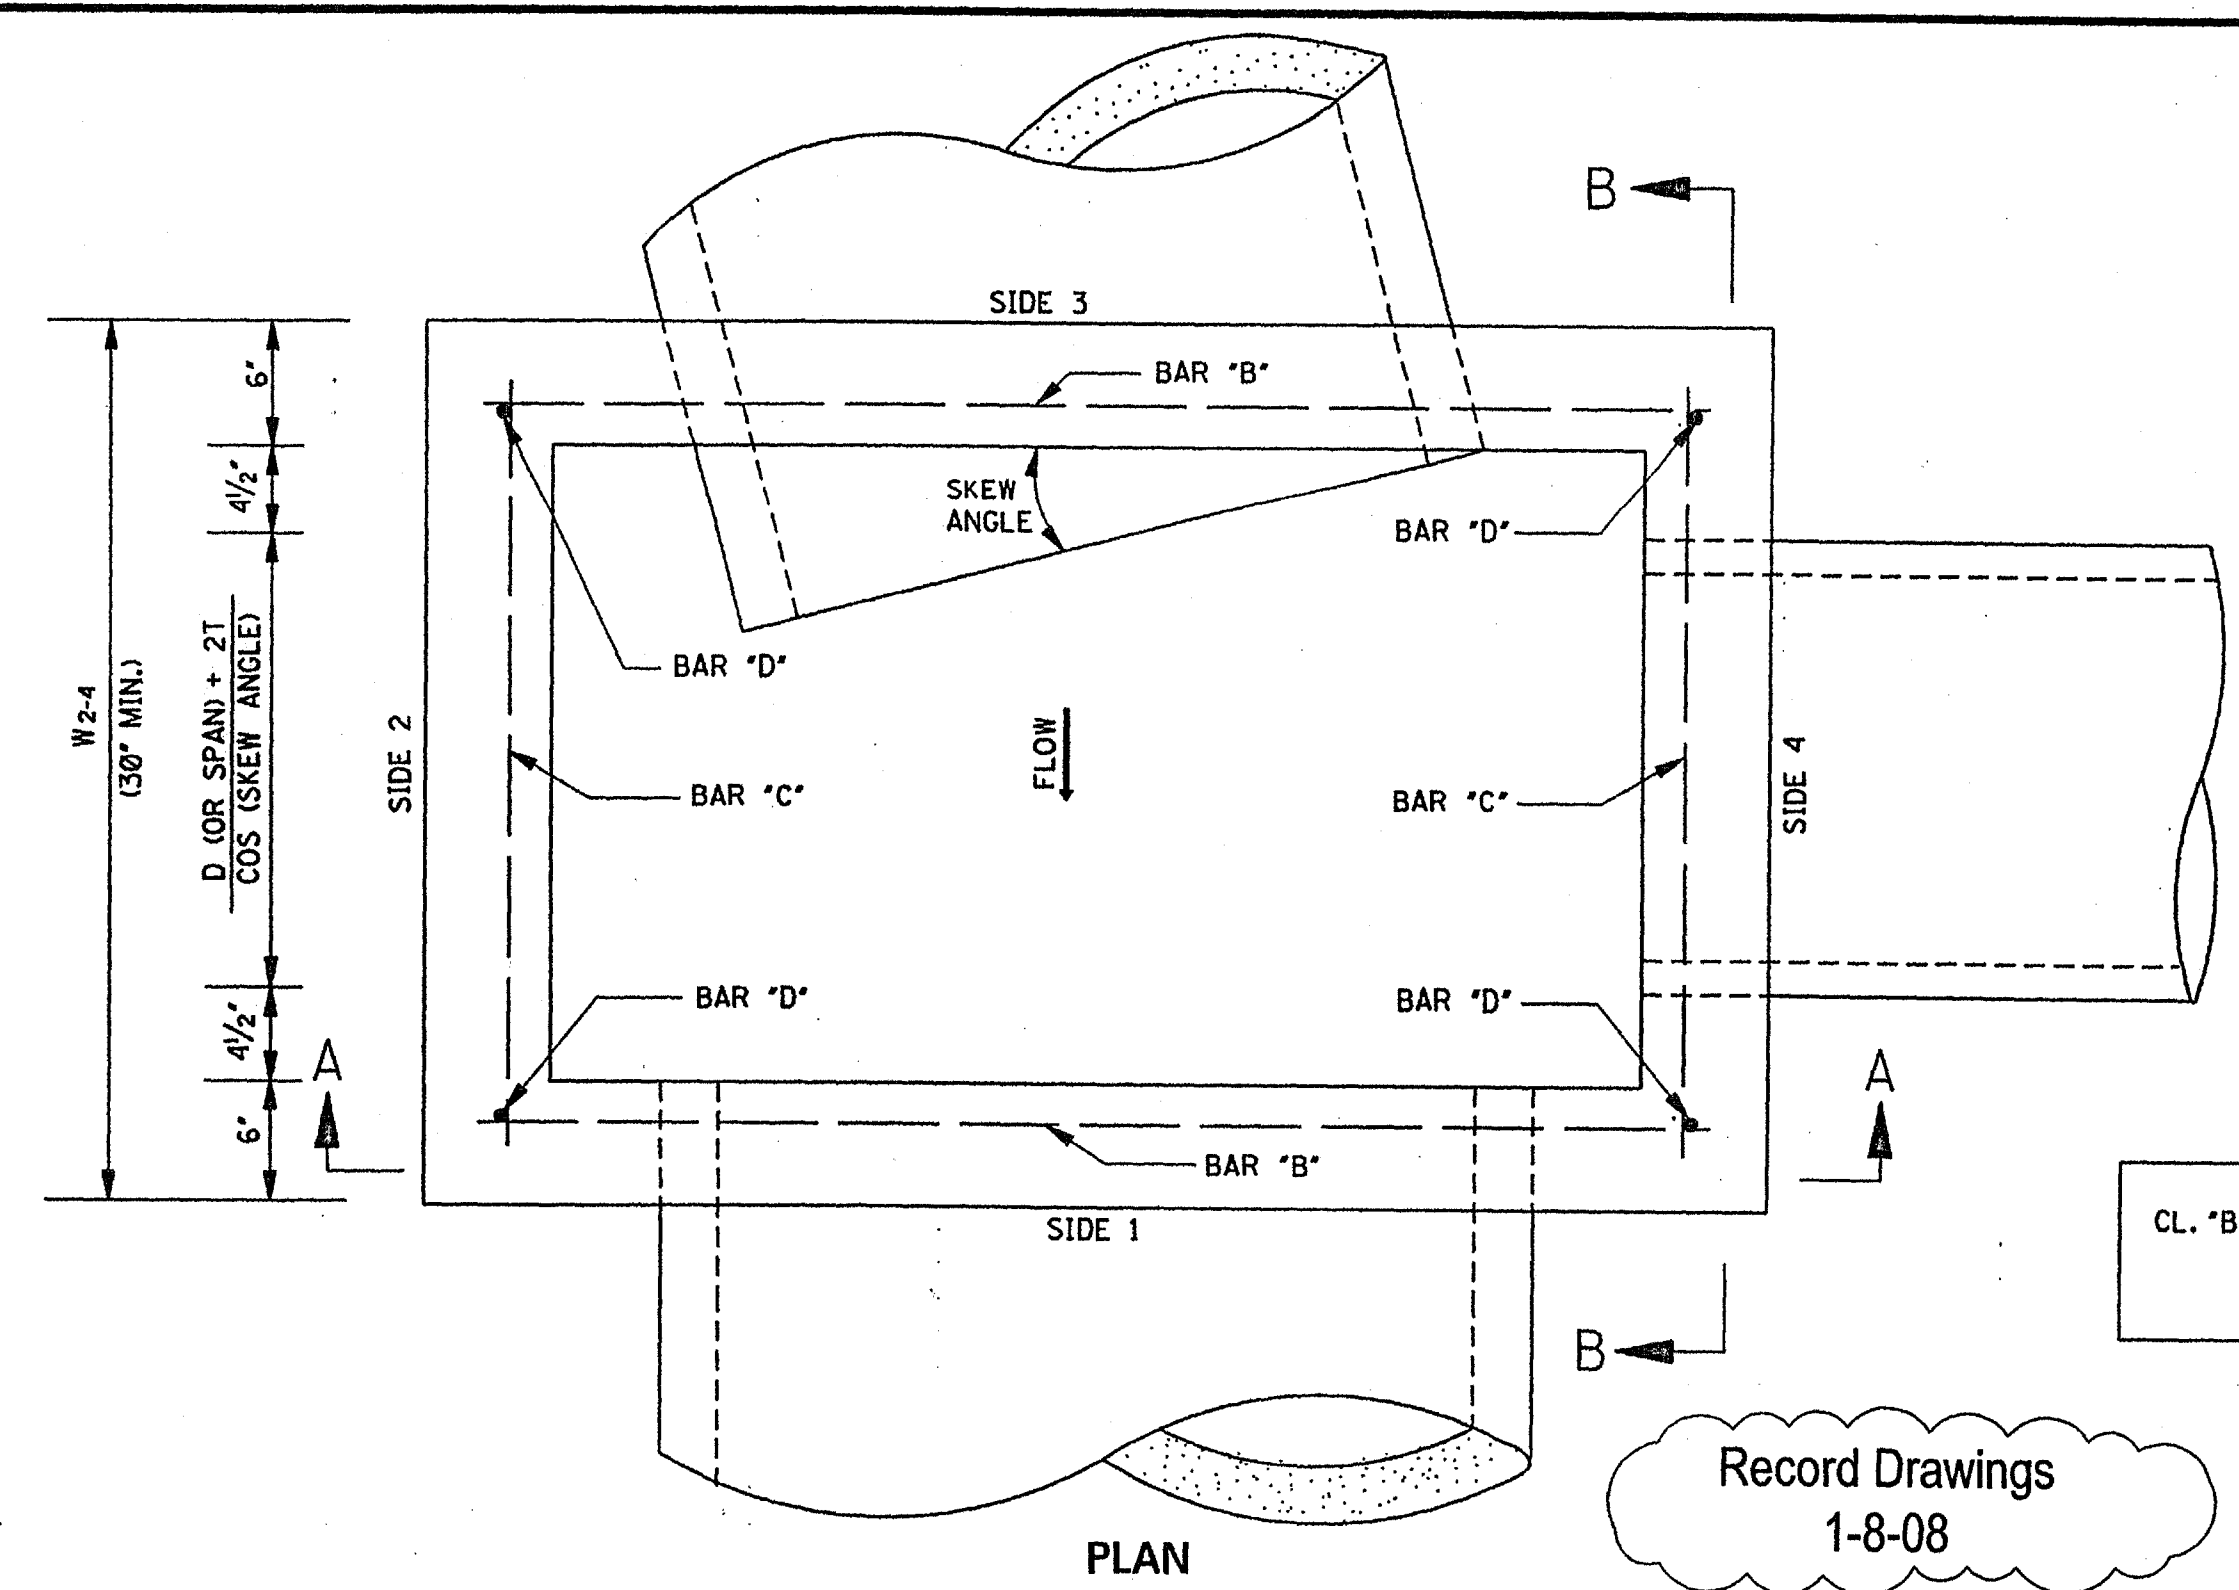

PLAN

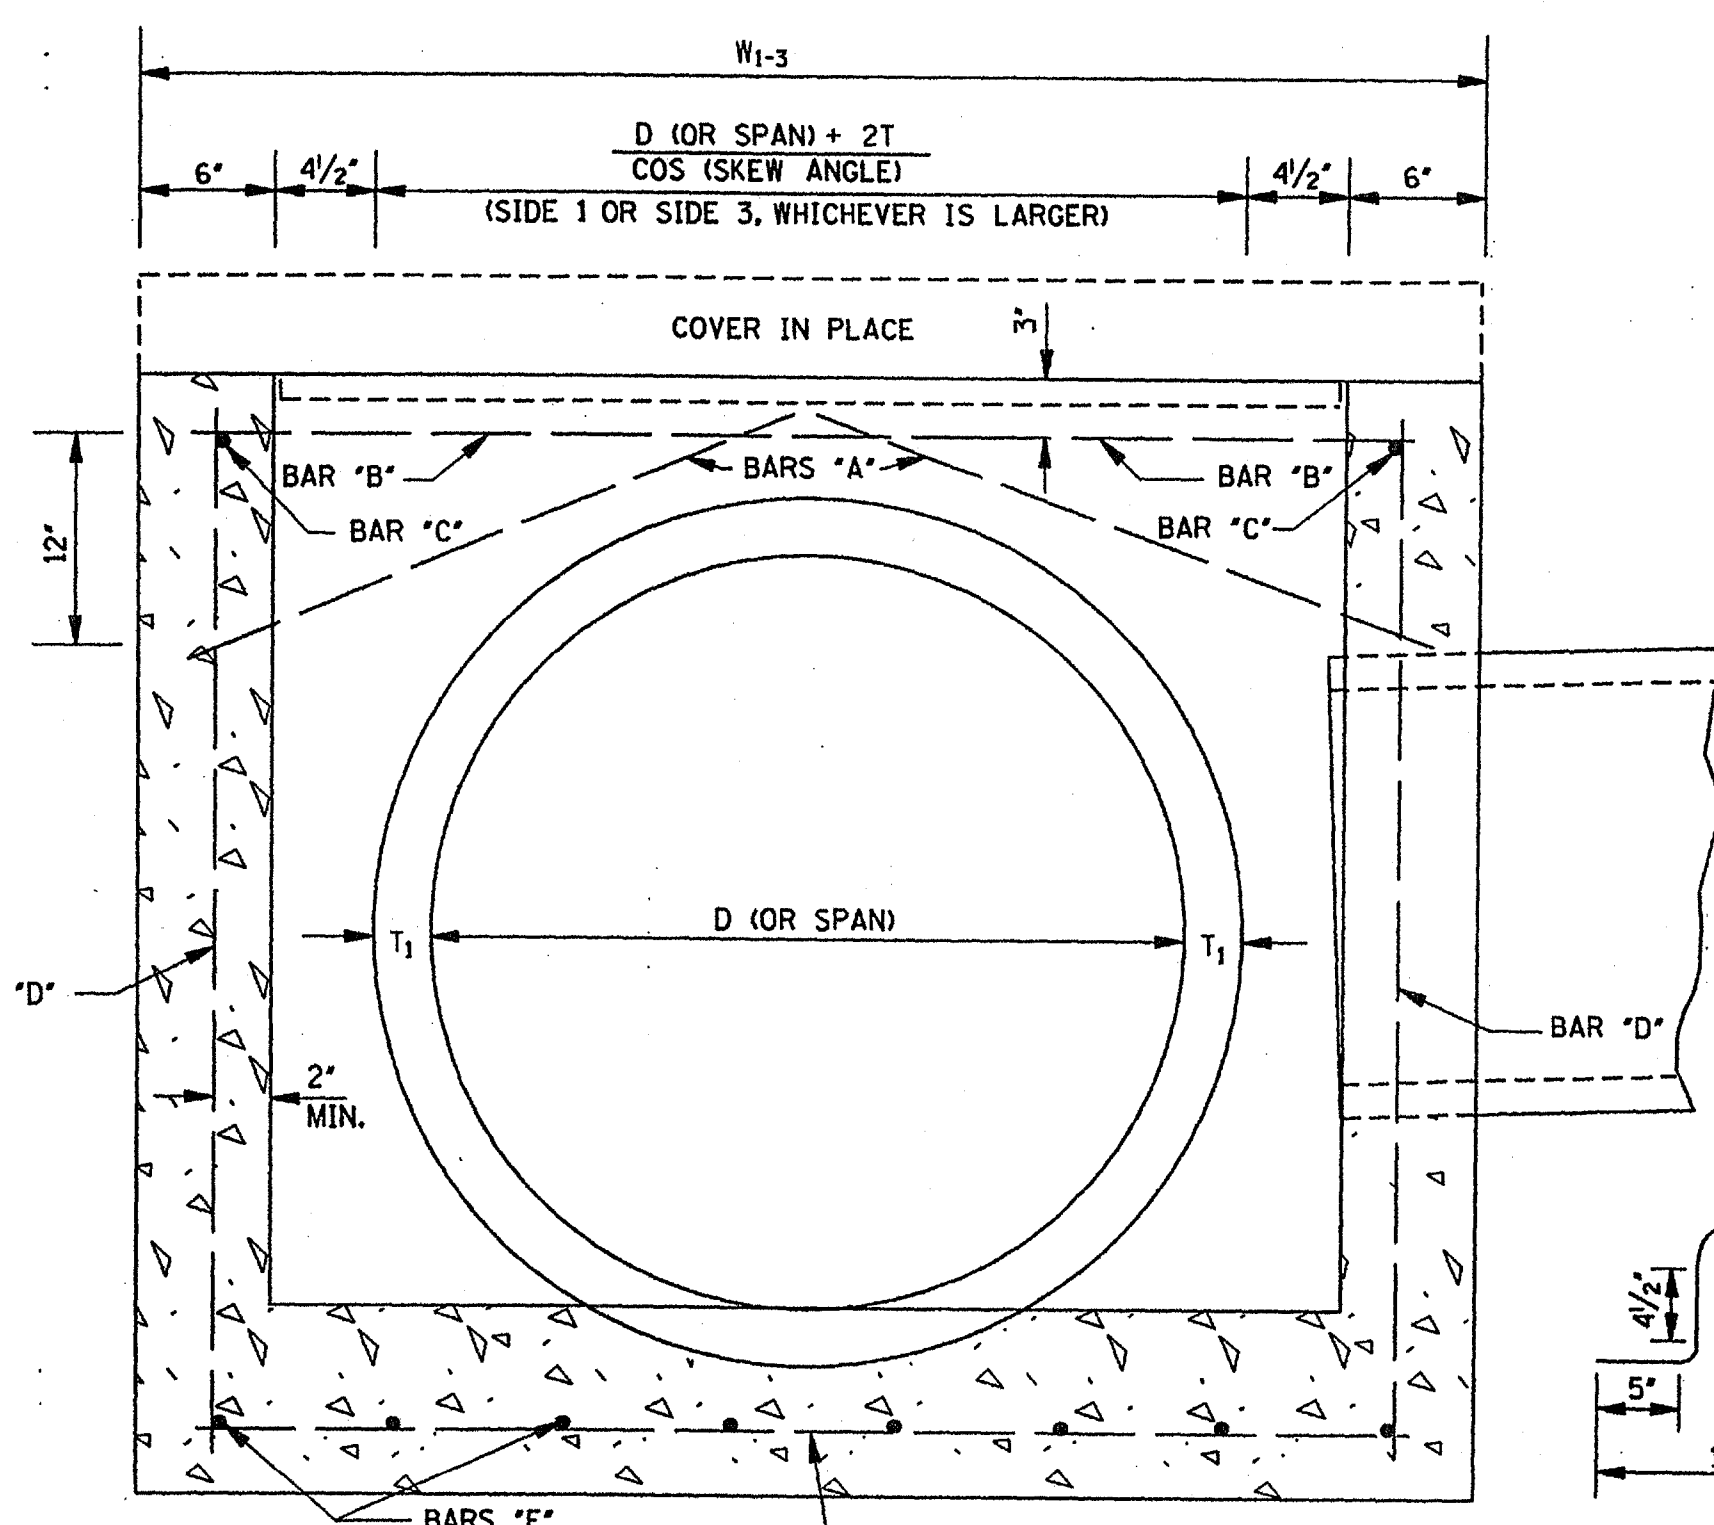

SECTION A-A

BAR	SIZE	NUMBER REQUIRED	LENGTH
A	#4	2 PER PIPE OPENING	$\sqrt{196 + (\frac{W}{2} + 2)^2}$
B	#4	2	$W_{1-3} - 6'$
C	#4	2	$W_{2-4} - 6'$
D	#4	4	$H - 6'$
E	#4	$2 \left[\left(\frac{W_{1-3}}{9} \right) ** + 1 \right]$	$W_{2-4} - 4'$
F	#4	$2 \left[\left(\frac{W_{2-4}}{9} \right) ** + 1 \right]$	$W_{1-3} - 4'$

NOTE: VARIABLES AND DESIGNATIONS ARE AS FOLLOWS:
 D (OR SPAN) = PIPE DIAMETER (OR SPAN)
 W₁₋₃ = WIDTH OF SIDE 1 & SIDE 3
 W₂₋₄ = WIDTH OF SIDE 2 & SIDE 4
 W* = W₁₋₃ OR W₂₋₄ (SIDE OF ENTERING PIPE)
 ** = ROUND TO NEAREST WHOLE NUMBER


CL. "B" CONC. (yd³) = (O1 + O2) / 46,656 - Σ PIPE OPENING DEDUCTIONS
 WHERE: O1 = [5'W₁₋₃W₂₋₄] + [(1'W₁₋₃ - 12.5'W₂₋₄ - 12.5') + [(1' + 6')W₁₋₃W₂₋₄]
 O2 = 12'H - (1' + 6')[(W₁₋₃ - 12') + W₂₋₄]

Record Drawings
1-8-08

CIRCULAR PIPE			ARCH PIPE		
PIPE SIZE	T	PIPE OPENING DEDUCTION (yd ³)	PIPE SIZE	T	PIPE OPENING DEDUCTION (yd ³)
18"	2 1/2"	0.053	22" x 13"	2 1/2"	0.053
24"	3"	0.091	29" x 18"	3"	0.087
30"	3 1/2"	0.138	36" x 23"	3 1/2"	0.129
36"	4"	0.196	44" x 27"	4"	0.185
42"	4 1/2"	0.263	51" x 31"	4 1/2"	0.245
48"	5"	0.340	58" x 36"	5"	0.318
54"	5 1/2"	0.427	65" x 40"	5 1/2"	0.394
60"	6"	0.524	73" x 45"	6"	0.489
66"	6 1/2"	0.630			
72"	7"	0.747			


GENERAL NOTES:

1. REINFORCING STEEL QUANTITIES TO BE COMPUTED FROM BAR LIST AND SHOWN ELSEWHERE ON THE PLANS.
2. QUANTITIES FOR JUNCTION BOXES SHOWN ON THE PLANS WILL BE THE BASIS FOR PAYMENT UNLESS AUTHORIZED MODIFICATIONS ARE MADE.
3. CONCRETE SHALL BE CLASS "B" AND REINFORCING STEEL SHALL BE DEFORMED BARS.
4. SIDE 1 OF THE JUNCTION BOX WILL ALWAYS BE THE OUTFLOW SIDE.
5. IF PIPES ARE SKEWED MORE THAN 15° OR IF SKEWED PIPES PRODUCE CONFLICTS WITH ANOTHER OPENING, THE PIPE SHALL BE BROKEN BACK TO THE WALL OF THE JUNCTION BOX.

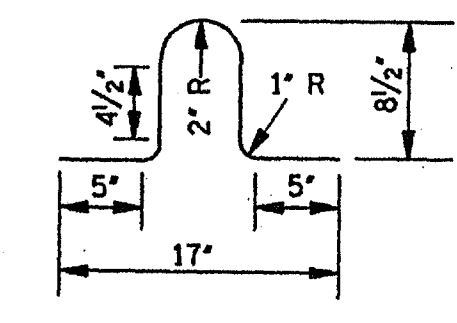

LIFT BAR


NOTE: LIFT BAR TO BE FABRICATED FROM A #4 BAR 30" LONG. TWO LIFT BARS ARE REQUIRED. REINFORCING STEEL FOR 2 LIFT BARS = 3.3 lbs.

MISSISSIPPI DEPARTMENT OF TRANSPORTATION ROADWAY DESIGN DIVISION STANDARD PLAN		 WORKING NUMBER JB-1 SHEET NUMBER 302
DATE	ISSUE DATE: OCTOBER 1, 1998	

STATE	PROJECT NO.
MISS.	

BELL AND SPIGOT END OPTION

NOTE: BELL-END ON DOWNSTREAM SECTION
SPIGOT-END ON UPSTREAM SECTION.

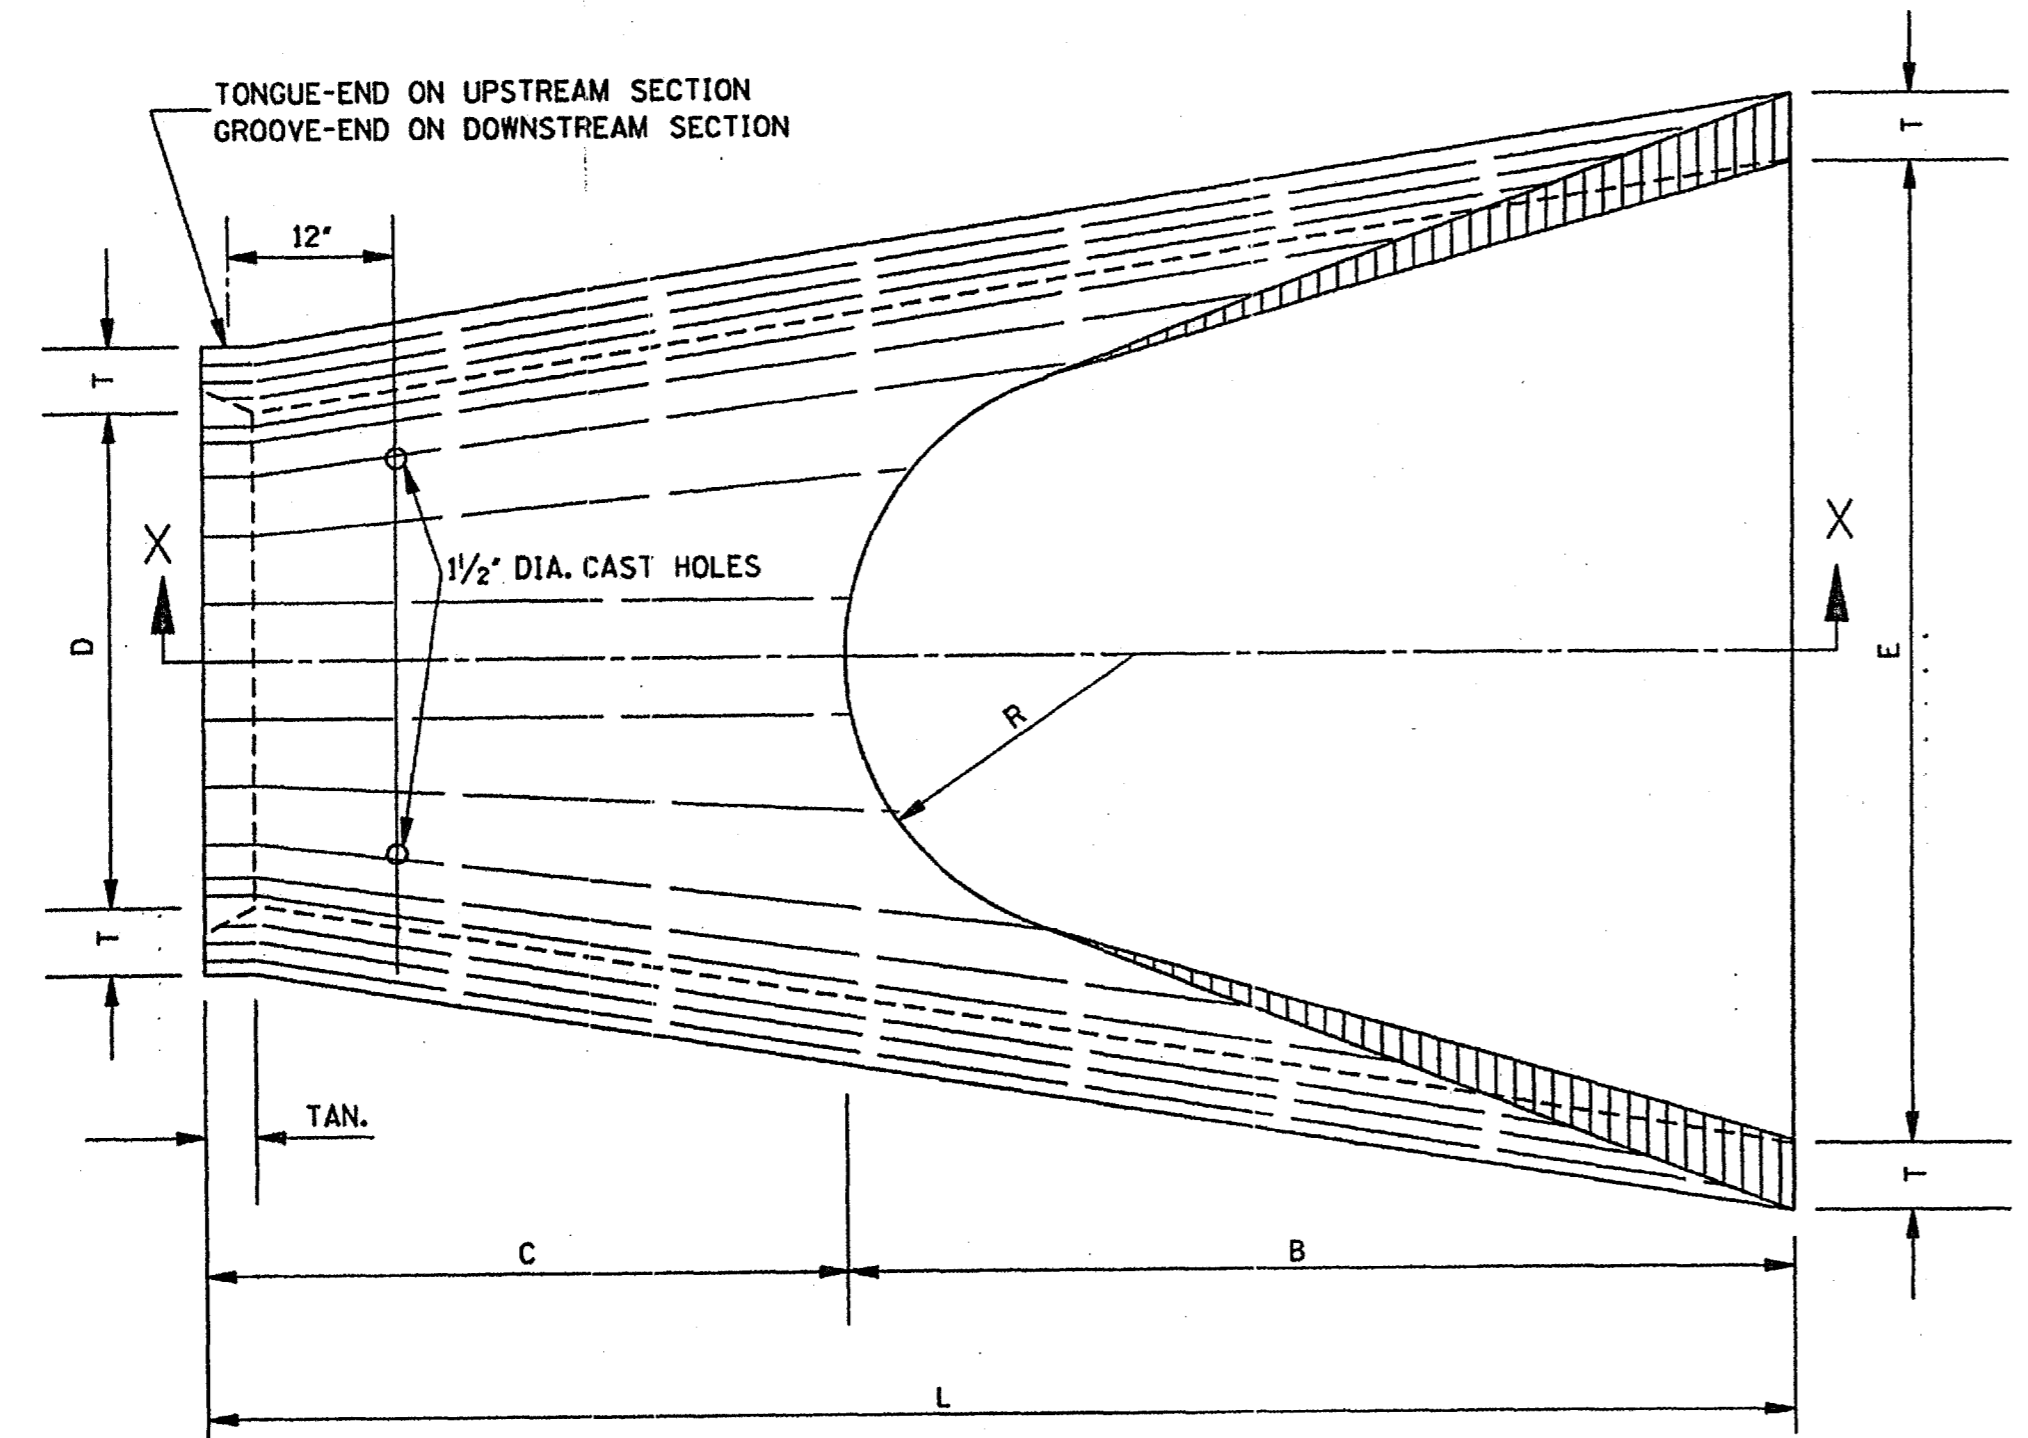


PLAN OF DOWNSTREAM END


TABLE OF DIMENSIONS							
D	T	H:V	A	B	C	E	L
15'	2 1/4"	3:1	6'	2'-3"	4'-1"	2'-8"	6'-1"
18'	2 1/2"	3:1	9'	2'-3"	3'-10"	3'-0"	6'-1"
24'	3"	3:1	10'	3'-8"	2'-6"	4'-0"	6'-2"
30'	3 1/2"	3:1	1'-0"	4'-6"	1'-8"	5'-0"	6'-2"
36'	4"	3:1	1'-3"	5'-3"	2'-11"	6'-0"	8'-2"
42'	4 1/2"	3:1	1'-9"	5'-3"	2'-11"	6'-6"	8'-2"
48'	5"	3:1	2'-0"	6'-0"	2'-2"	7'-0"	8'-2"
54'	5 1/2"	3:1	2'-4"	6'-6"	1'-10"	7'-6"	8'-4"
* 60'	6"	3:1	2'-10"	6'-6"	1'-10"	8'-0"	8'-4"
* 66'	6 1/2"	3:1	3'-4"	6'-6"	1'-10"	8'-6"	8'-4"
* 72'	7"	3:1	3'-10"	6'-6"	1'-10"	9'-0"	8'-4"

TOE WALL CONC. QUANTITY (yd ³)
0.056
0.063
0.083
0.102
0.123
0.134
0.145
0.156
0.167
0.177
0.188

* NOTE: SEE GENERAL NOTE 2.

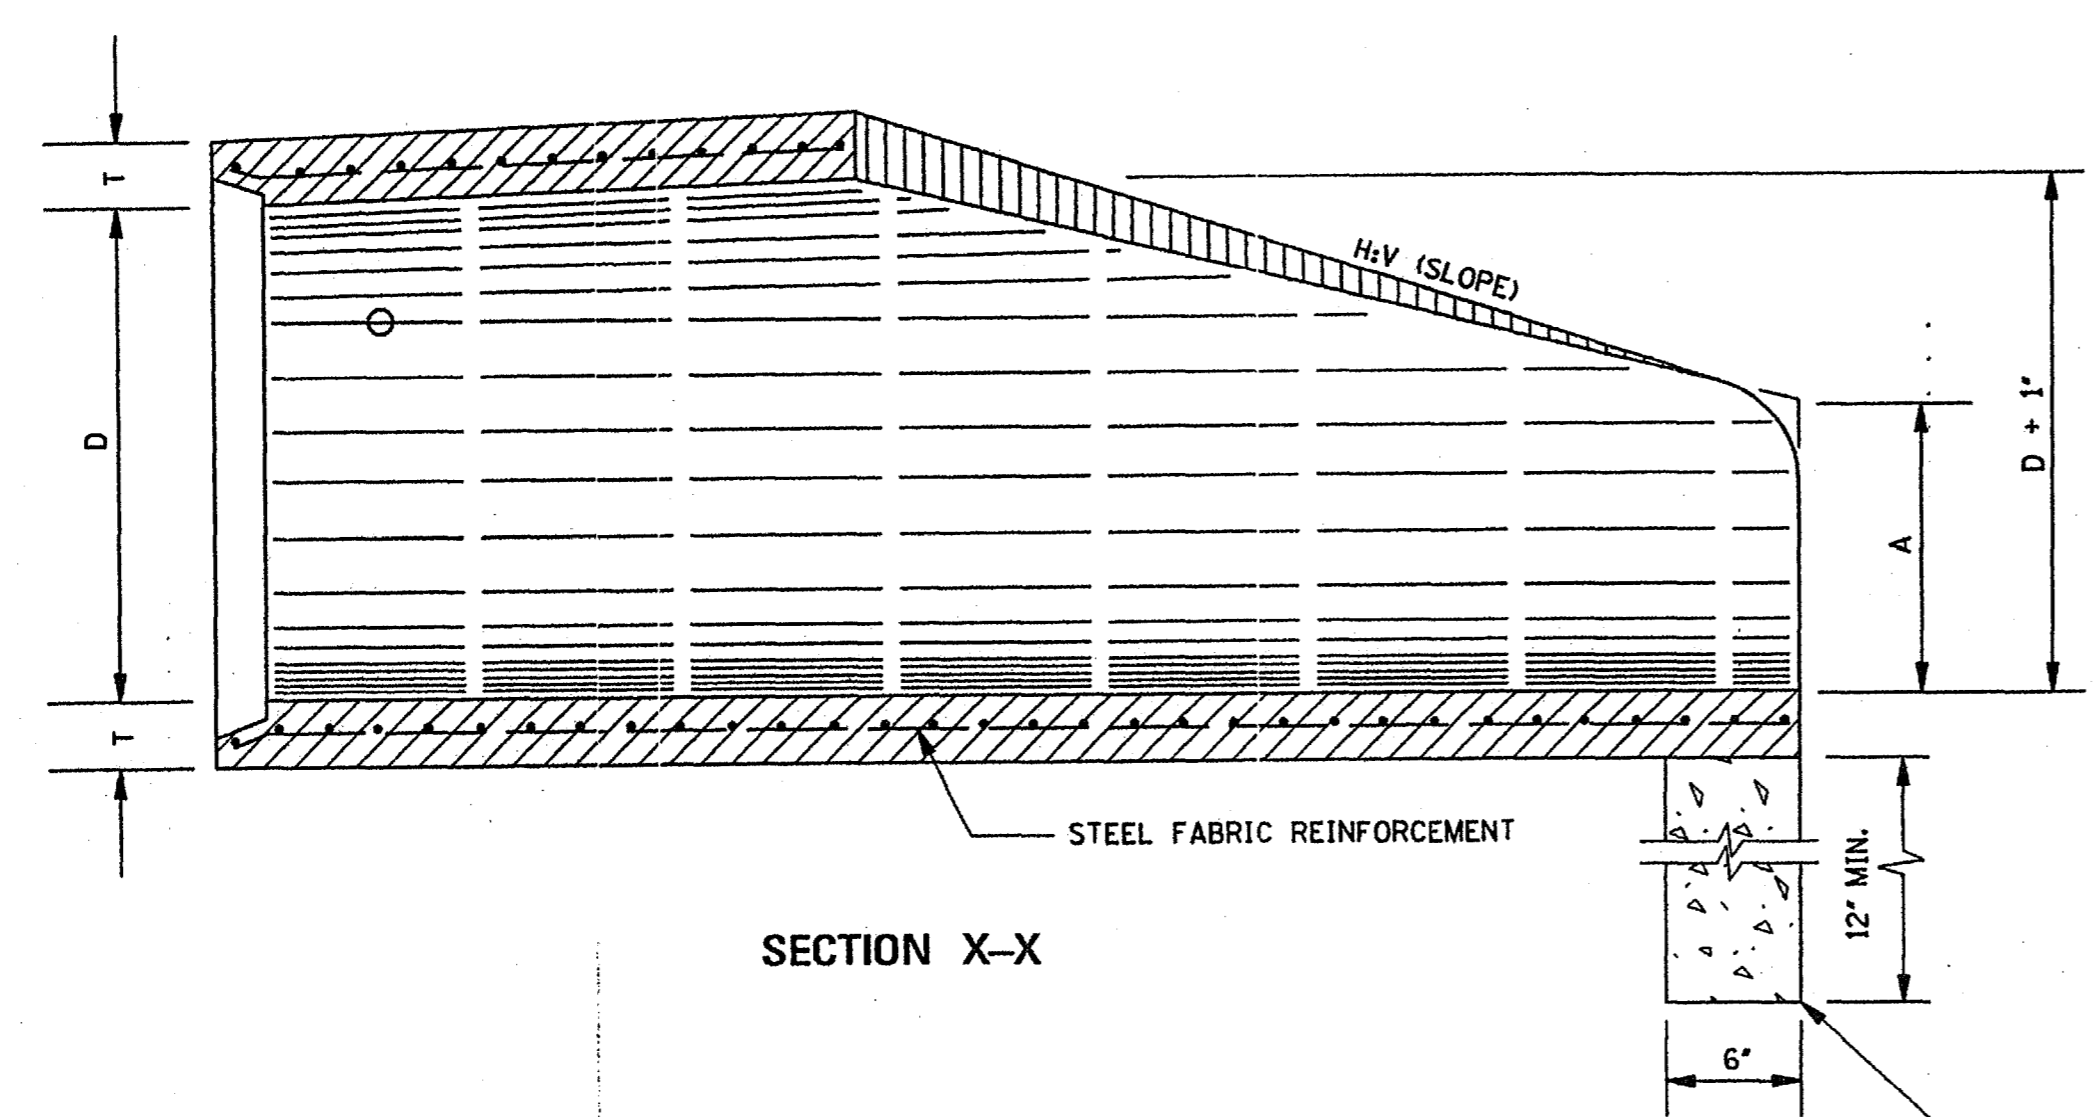

SECTION X-X

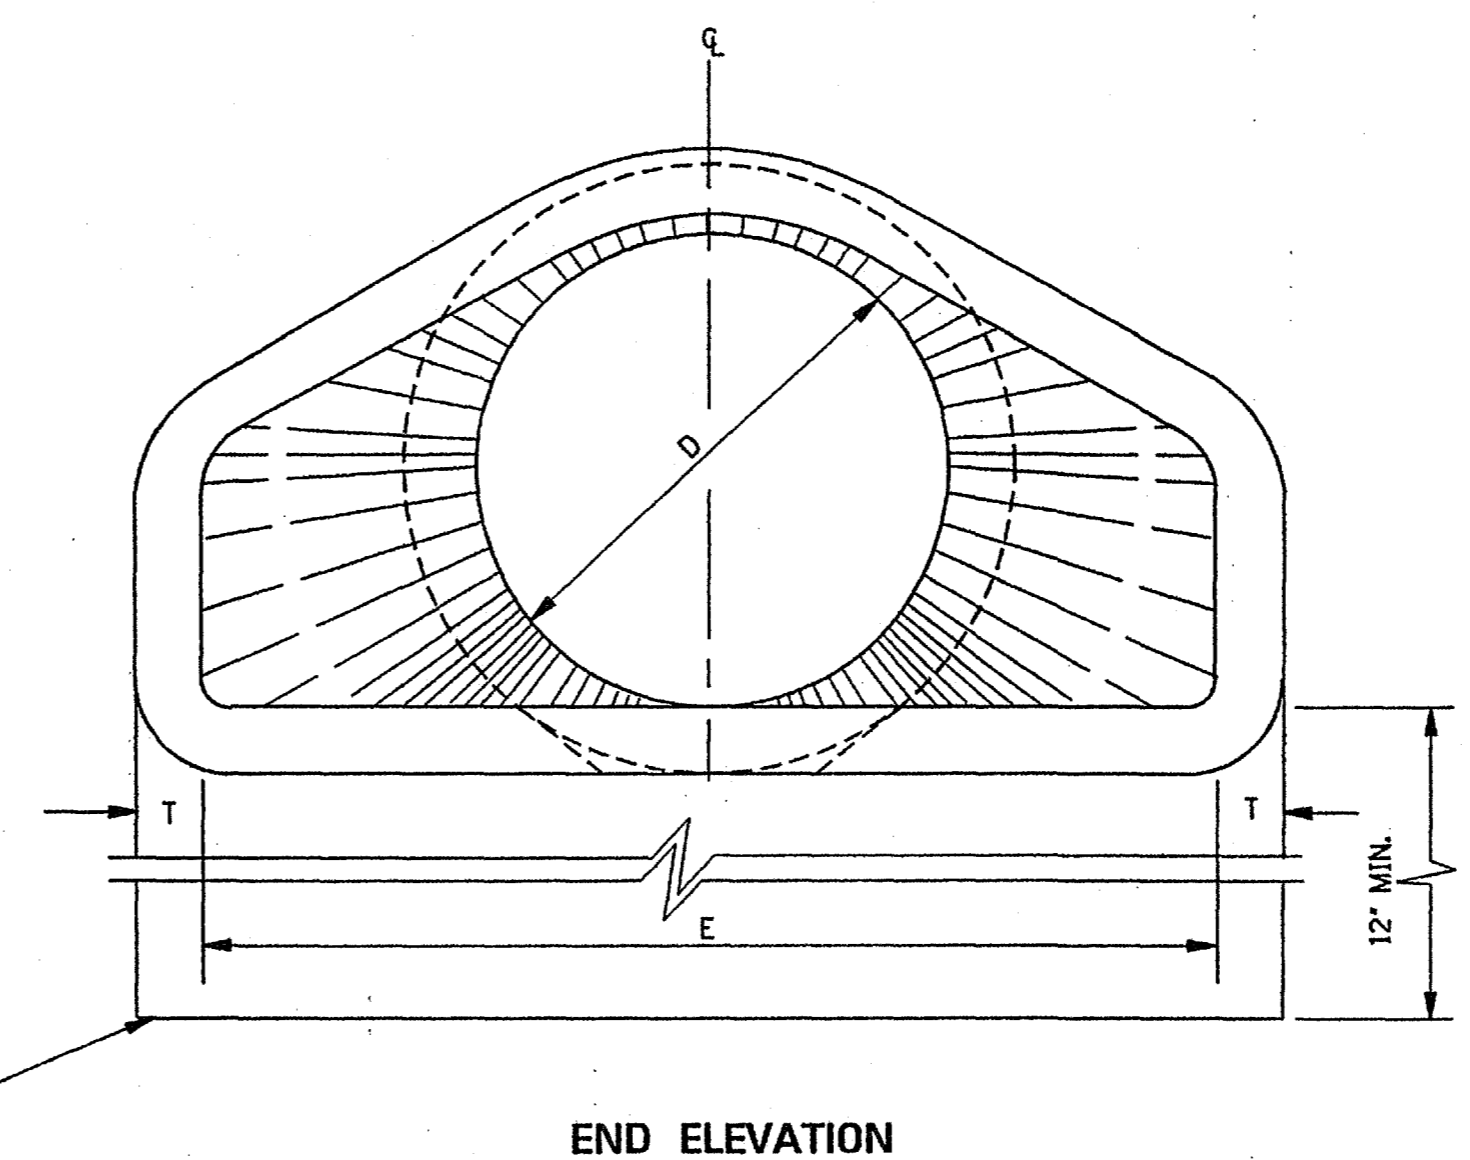


END ELEVATION

GENERAL NOTES:

1. REINFORCEMENT SHALL CONFORM TO THE REQUIREMENTS OF REINFORCED CONCRETE PIPE OF LIKE DIAMETER PER AASHTO M 170, TABLE 2, WALL B.
2. 2 - 1/2" DIA. CAST HOLES REQUIRED AS SHOWN TO ACCOMMODATE 2 - 1" DIA. TIE BOLTS, USED IN TIEING SECTION TO PIPE CULVERT.
3. LENGTH (L) OF A BELL-END OPTION MAY VARY BY A NOMINAL EXTENSION ON THE BELL END.
4. FLARED END SECTIONS ARE NOT TO BE USED INSIDE THE CLEAR ZONE.
5. ALL SIZES OF FLARED END SECTIONS FOR CIRCULAR CONCRETE PIPE MAY BE FURNISHED WITH EITHER BELL AND SPIGOT OR TONGUE AND GROOVE ENDS.

Record Drawings
1-8-08

TOE WALL REQUIRED ON ALL DOWNSTREAM FLARED END SECTIONS. TOE WALL AT UPSTREAM END WILL BE CONSTRUCTED WHERE DIRECTED BY THE ENGINEER. TO BE PAID FOR AS CLASS 'B' STRUCTURAL CONCRETE - MINOR STRUCTURES.

BY		MISSISSIPPI DEPARTMENT OF TRANSPORTATION	
REVISION		ROADWAY DESIGN DIVISION	
DATE		STANDARD PLAN	
FLARED END SECTION FOR CONCRETE PIPE			
WORKING NUMBER			
FE-1			
SHEET NUMBER		328	
ISSUE DATE:		OCTOBER 1, 1998	

B.M. ELEV. 285.32
CHISELED SQUARE
ON TOP OF 24" RCP
89.48 L. STA. 11+27.76

UTILITY OWNERS
GAS = ATMOS ENERGY
WATER = CITY OF RIDGELAND/MDA
SEWER = CITY OF RIDGELAND/PRWSD
ELEC. = ENTERGY

GENERAL NOTES
HORIZONTAL DATUM IS REFERENCED TO THE MS STATE PLANE COORDINATE SYSTEM WEST ZONE (NAD 83/93).

VERTICAL DATUM IS REFERENCED TO BARNETT RESERVOIR DATUM (NGVD 29) FROM WATER SURFACE ELEVATION PROVIDED BY TOWER, ROSS BARNETT RESERVOIR POOL ELEVATION = 296.25 AT 10:50 A.M. ON JAN. 6, 2004 PER RESERVOIR GAUGING STATION.

EXISTING UTILITIES CONFLICTING WITH PROPOSED CONSTRUCTION TO BE ADJUSTED BY OTHERS IN ACCORDANCE WITH SECTION SA II-2-8

DRAINAGE AREAS TAKEN FROM PROJECT SURVEY

DISTRUBED AREA = 8.25 AC

HYDRAULIC DESIGN
0-25 AC - RATIONAL METHOD
>25 AC - "FLOOD CHARACTERISTICS OF MISSISSIPPI STREAMS" 1991


SHRINKAGE FACTOR
UNCLASSIFIED EXCAVATION (F.M.) = 1.3
BORROW EXCAVATION (F.M.E.) = N/A

DESIGN DATA
DESIGN SPEED = 40 M.P.H.
CURRENT ADT (2005) = 8845

SHEET TOTALS

EXCESS EXCAVATION	= 445 CY
TOPSOIL (SLOPE TRMT)	= 1980 SY
STRUCTURAL EXCAVATION	= 0 CY
BORROW EXCAVATION	= 445 CY
R.O.W. MARKERS	= 0

NOTE: TOPSOIL IS TO BE SALVAGED FROM WITHIN CONSTRUCTION LIMITS. THE ENTIRE AREA ENCOMPASSED BY THE PROPOSED EMBANKMENT IS TO BE STRIPPED 6" DEEP PRIOR TO PLACEMENT OF FILL. APPROXIMATELY 2400 CY OF STRIPPING WILL BE REMOVED FROM THE PROJECT LIMITS AT NO ADDITIONAL COST TO THE OWNER.

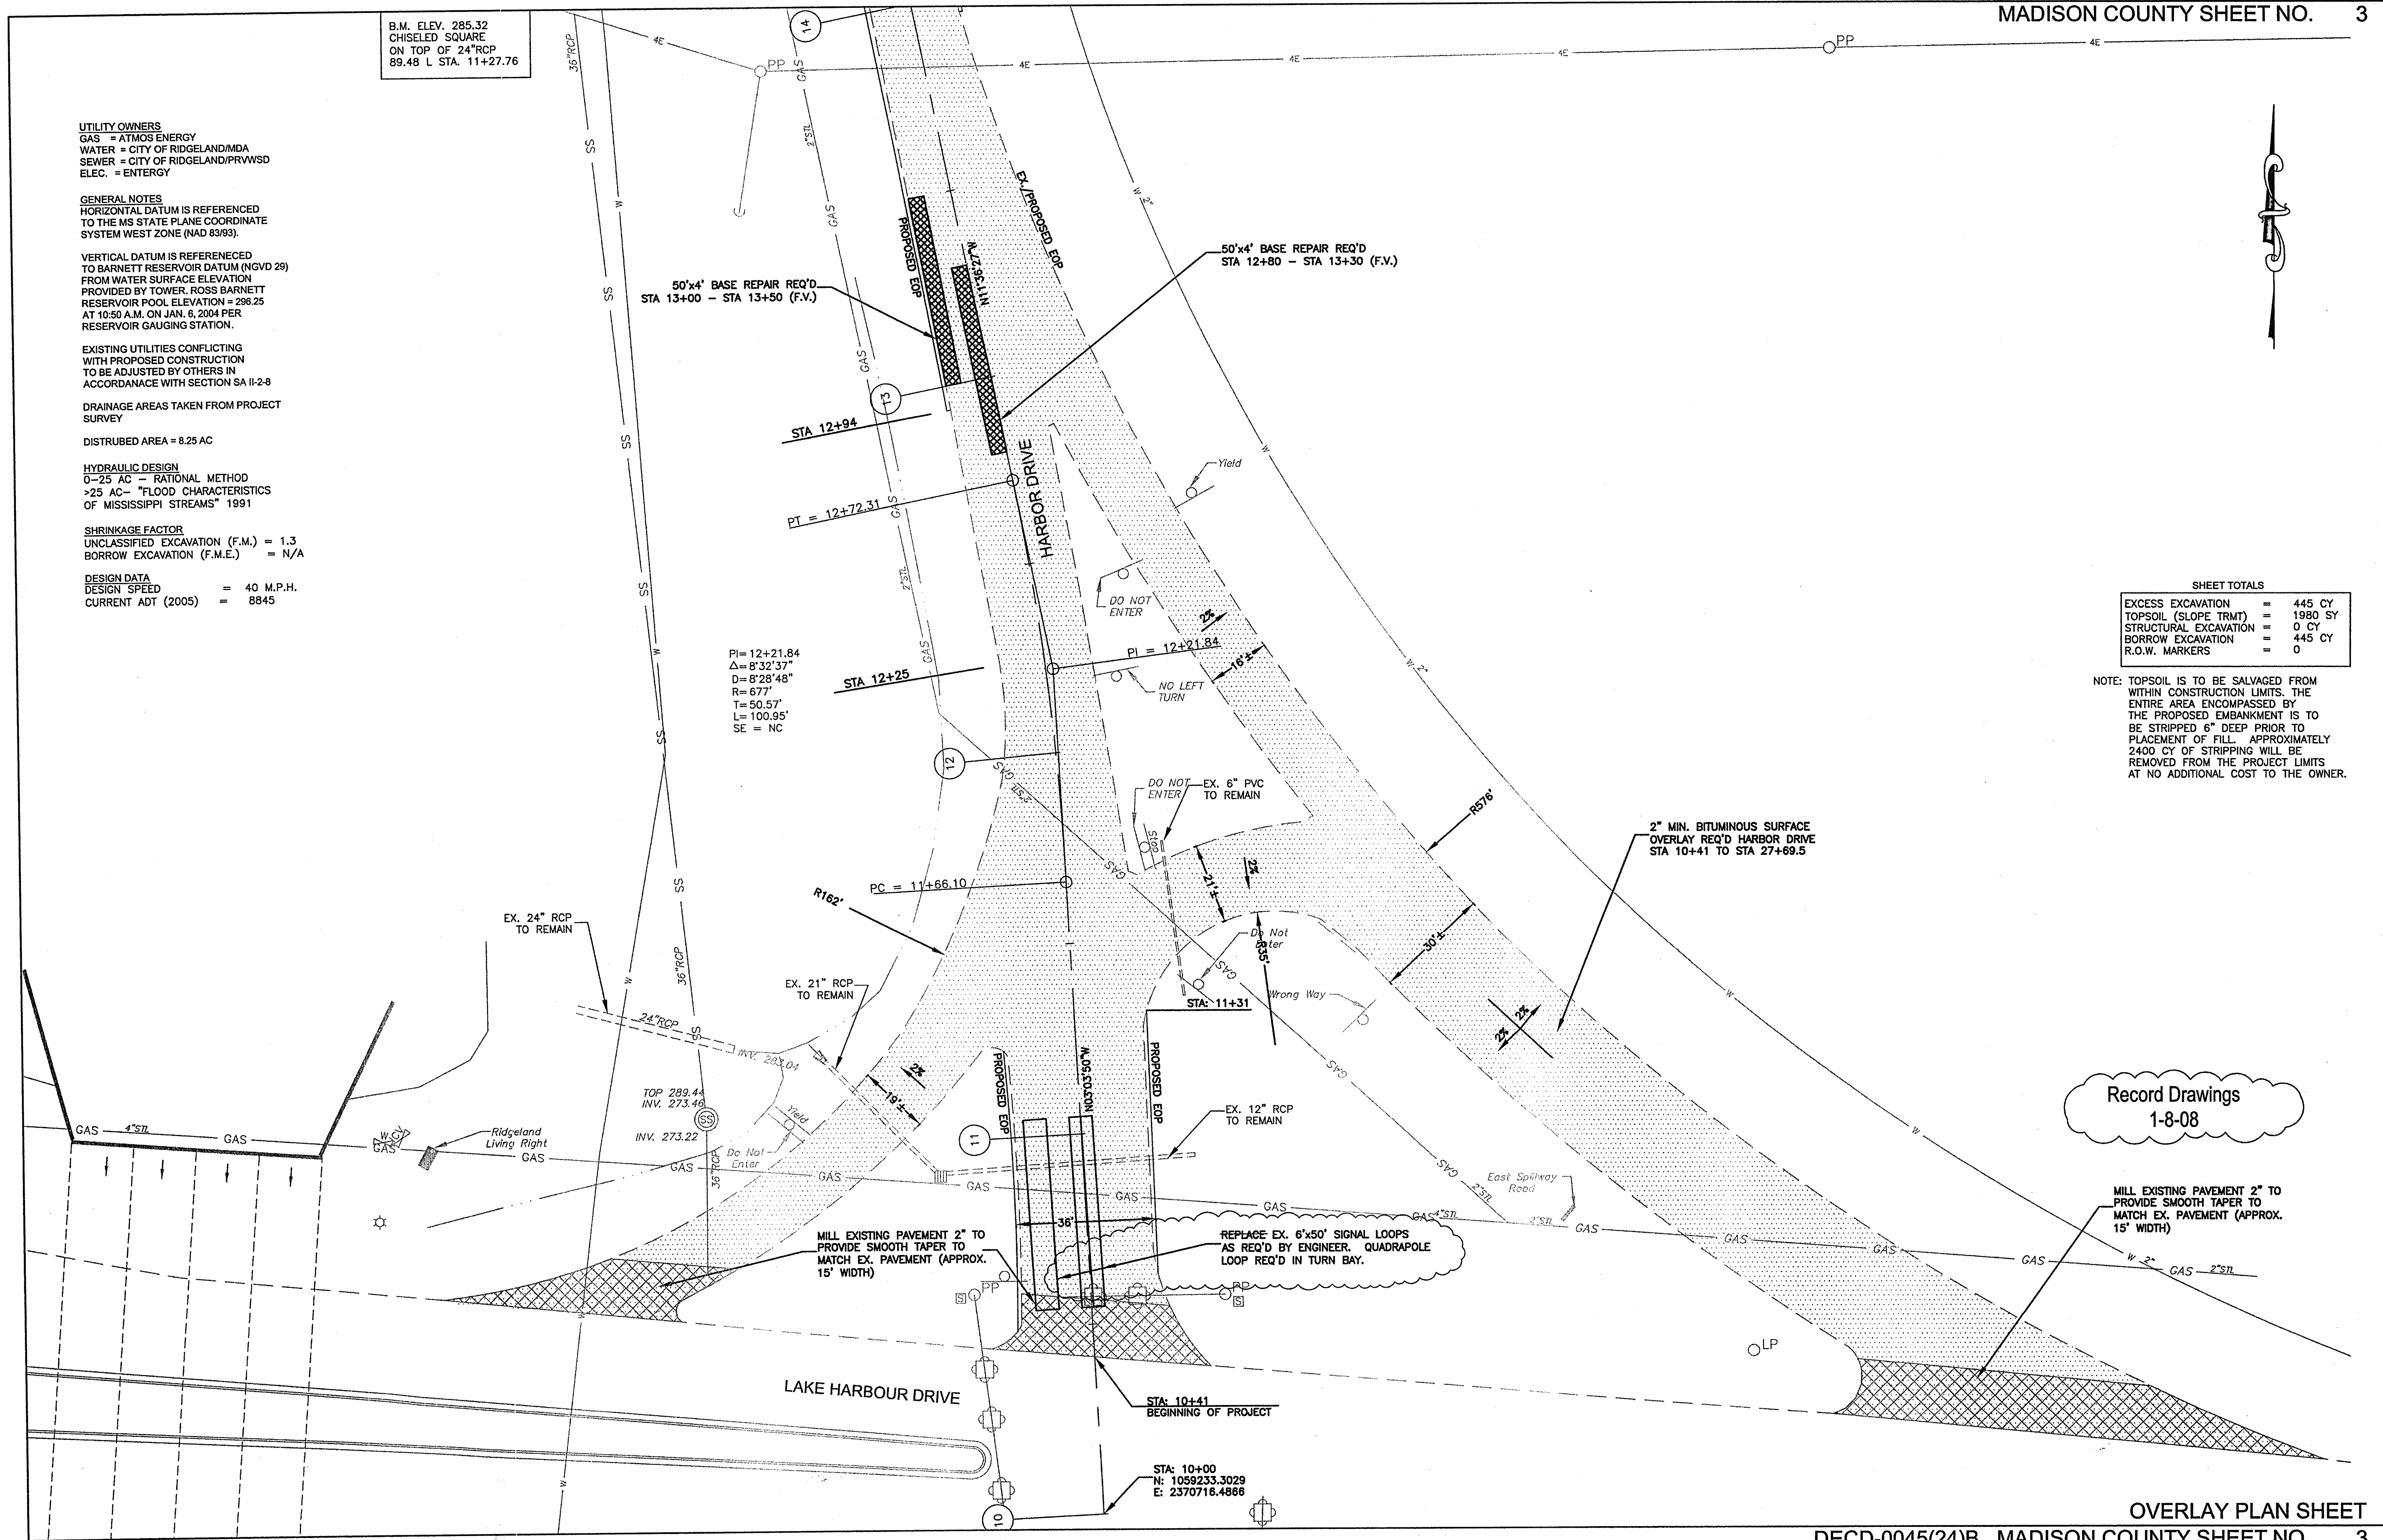


Record Drawings
1-8-08

MILL EXISTING PAVEMENT 2" TO PROVIDE SMOOTH TAPER TO MATCH EX. PAVEMENT (APPROX. 15' WIDTH)

B.M. ELEV 295.54
CHISELED SQUARE ON
TOP OF 12"RCP
31.65' R STA. 20+27.17

PI=21+18.42
Δ=15°25'52"
D=3'46'28"
R=1518'
T=205.66'
L=408.83'
SE = NC

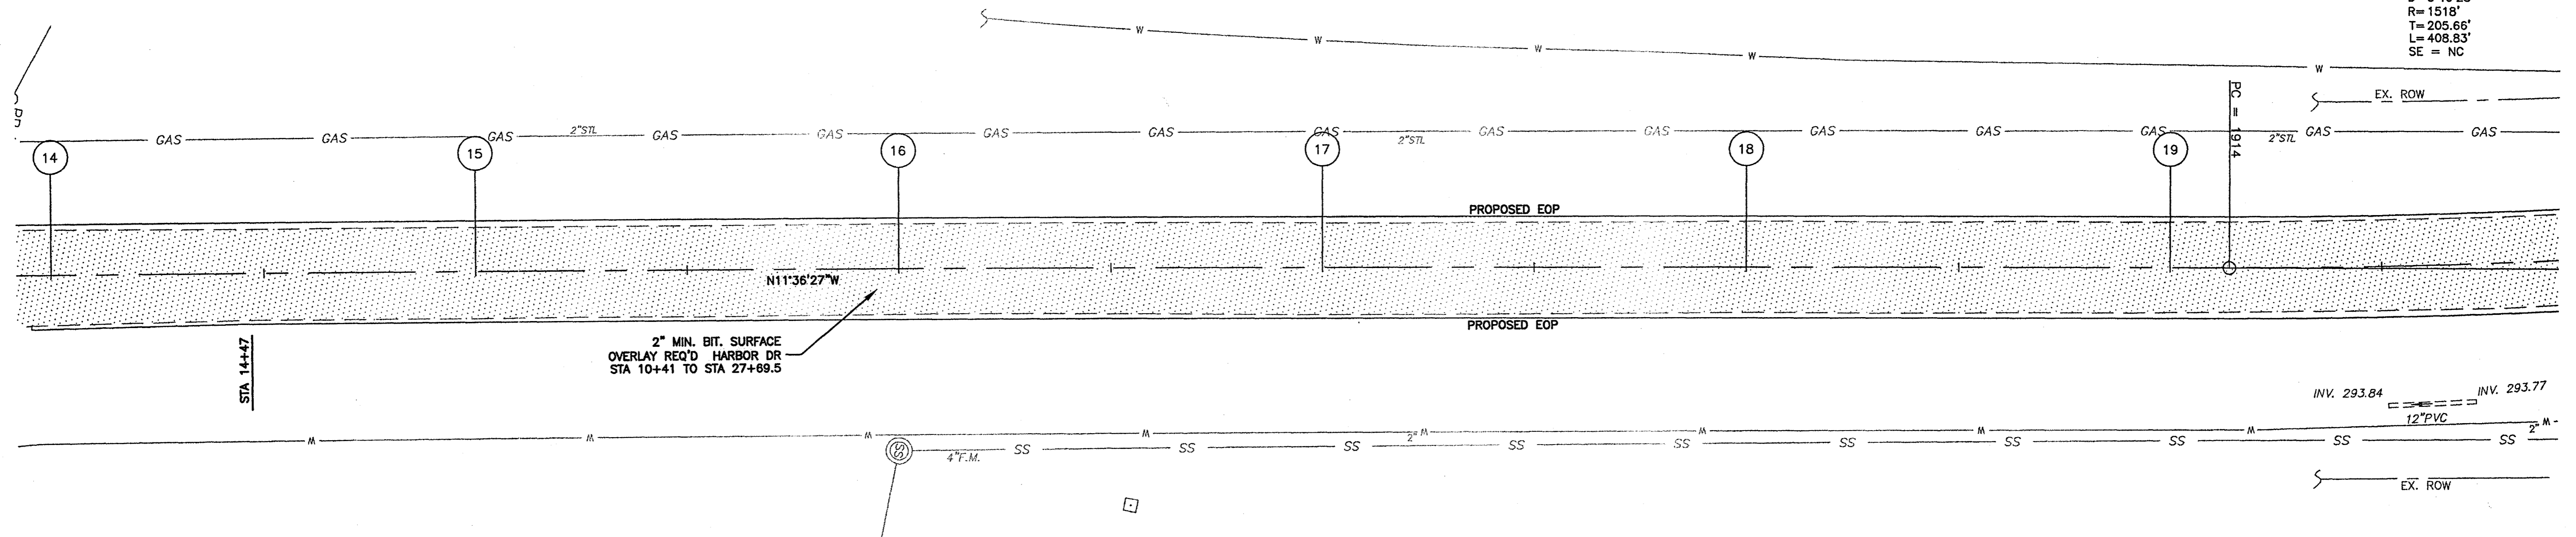

STA 14+47

2" MIN. BIT. SURFACE
OVERLAY REQ'D HARBOR DR
STA 10+41 TO STA 27+69.5

N11°36'27"W

INV. 293.84
12" PVC
INV. 293.77
EX. ROW

SHEET TOTALS



EXCESS EXCAVATION	= 750 CY
TOPSOIL (SLOPE TRMT)	= 2805 CY
STRUCTURAL EXCAVATION	= 0 CY
BORROW EXCAVATION	= 750 CY
R.O.W. MARKERS	= 0

Record Drawings
1-8-08

OVERLAY PLAN SHEET

B.M. ELEV 295.54
CHISELED SQUARE ON
TOP OF 12" RCP
31.65' R STA. 20+27.17

PI=21+18.42
Δ=15°25'52"
D=3'46'28"
R=1518'
T=205.66'
L=408.83'
SE = NC

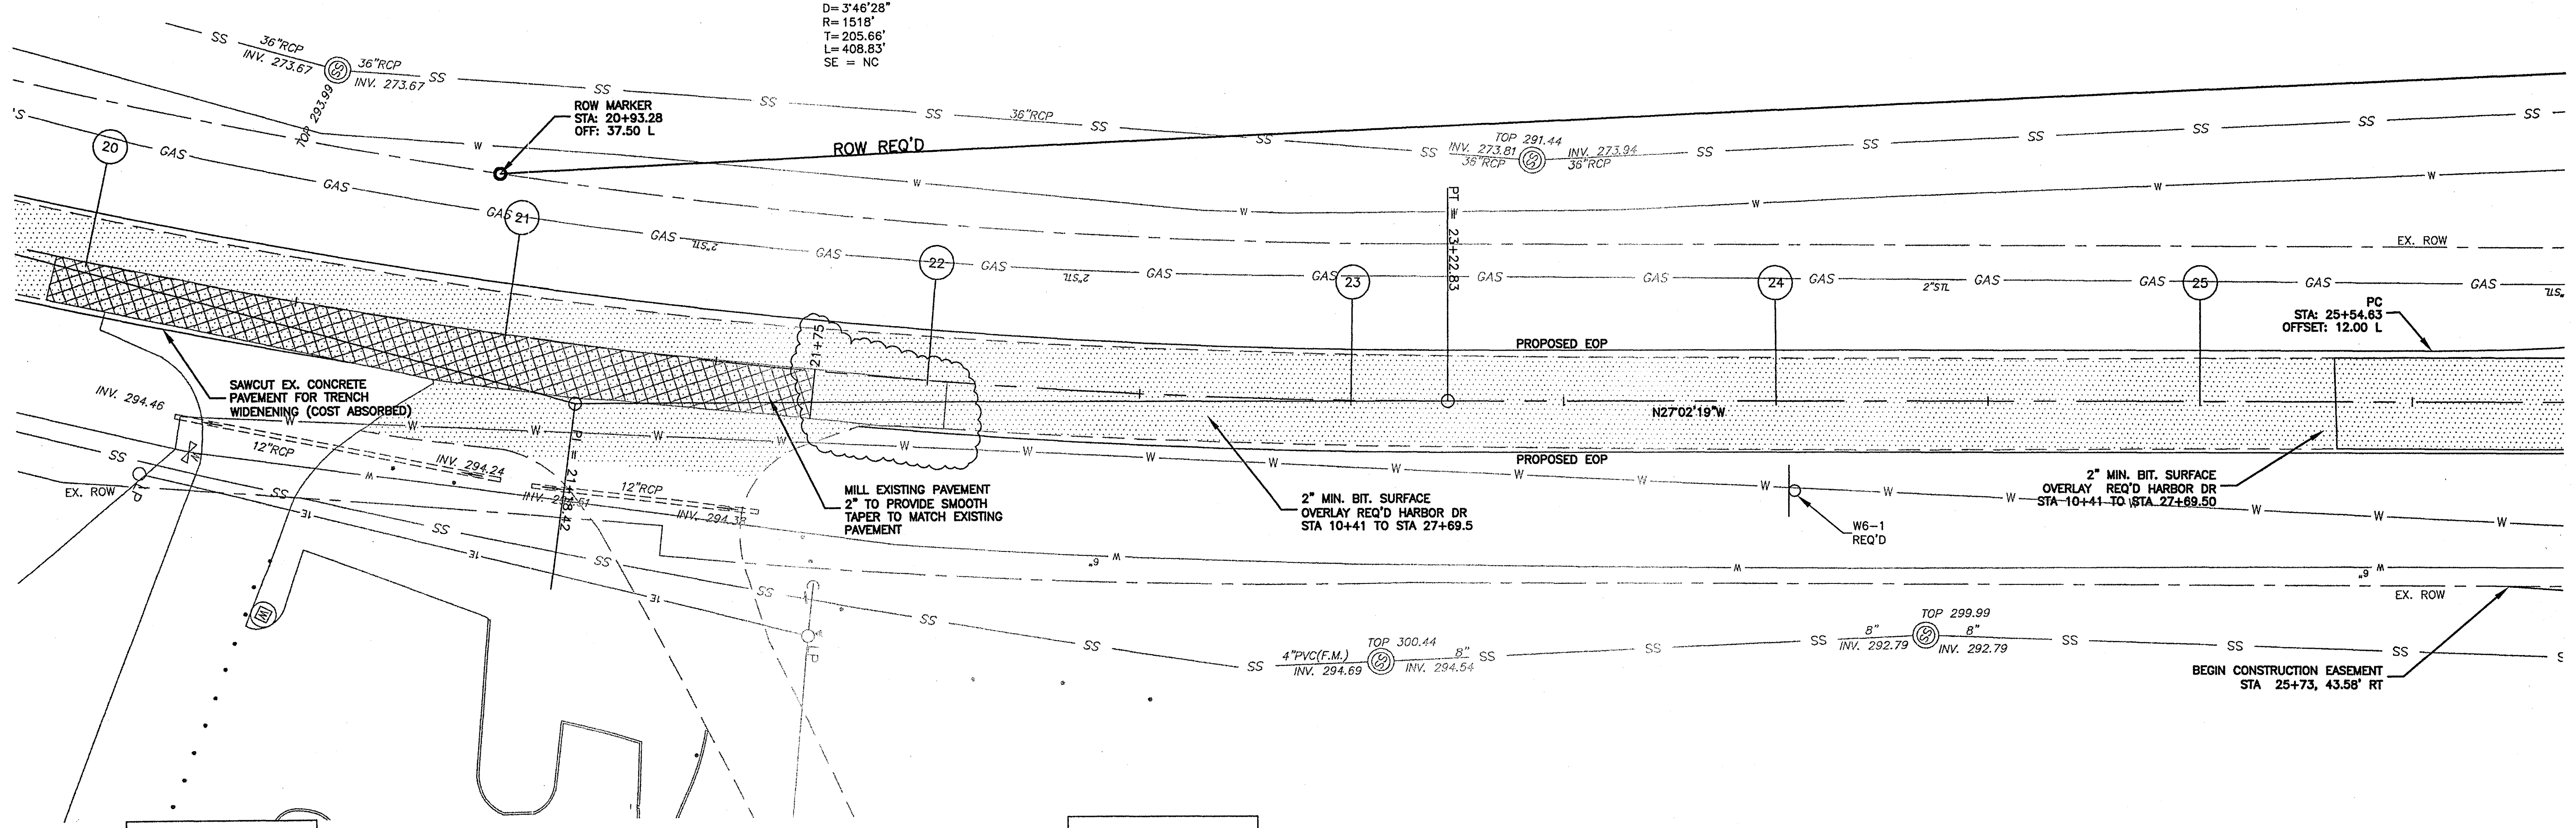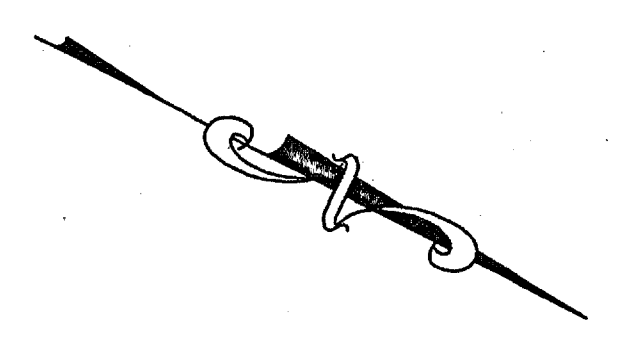

STA. 20+06.6 RT
EXISTING CONCRETE TURNOUT
12" RCP TO REMAIN

STA. 21+89.67 RT
EXISTING TURNOUT
12" RCP TO REMAIN



SHEET TOTALS

EXCESS EXCAVATION	=	575 CY
TOPSOIL (SLOPE TRMT)	=	2805 SY
STRUCTURAL EXCAVATION	=	0 CY
BORROW EXCAVATION	=	575 CY
R.O.W. MARKERS	=	1

Record Drawings
1-8-08

OVERLAY PLAN SHEET

Record Drawings
1-8-08

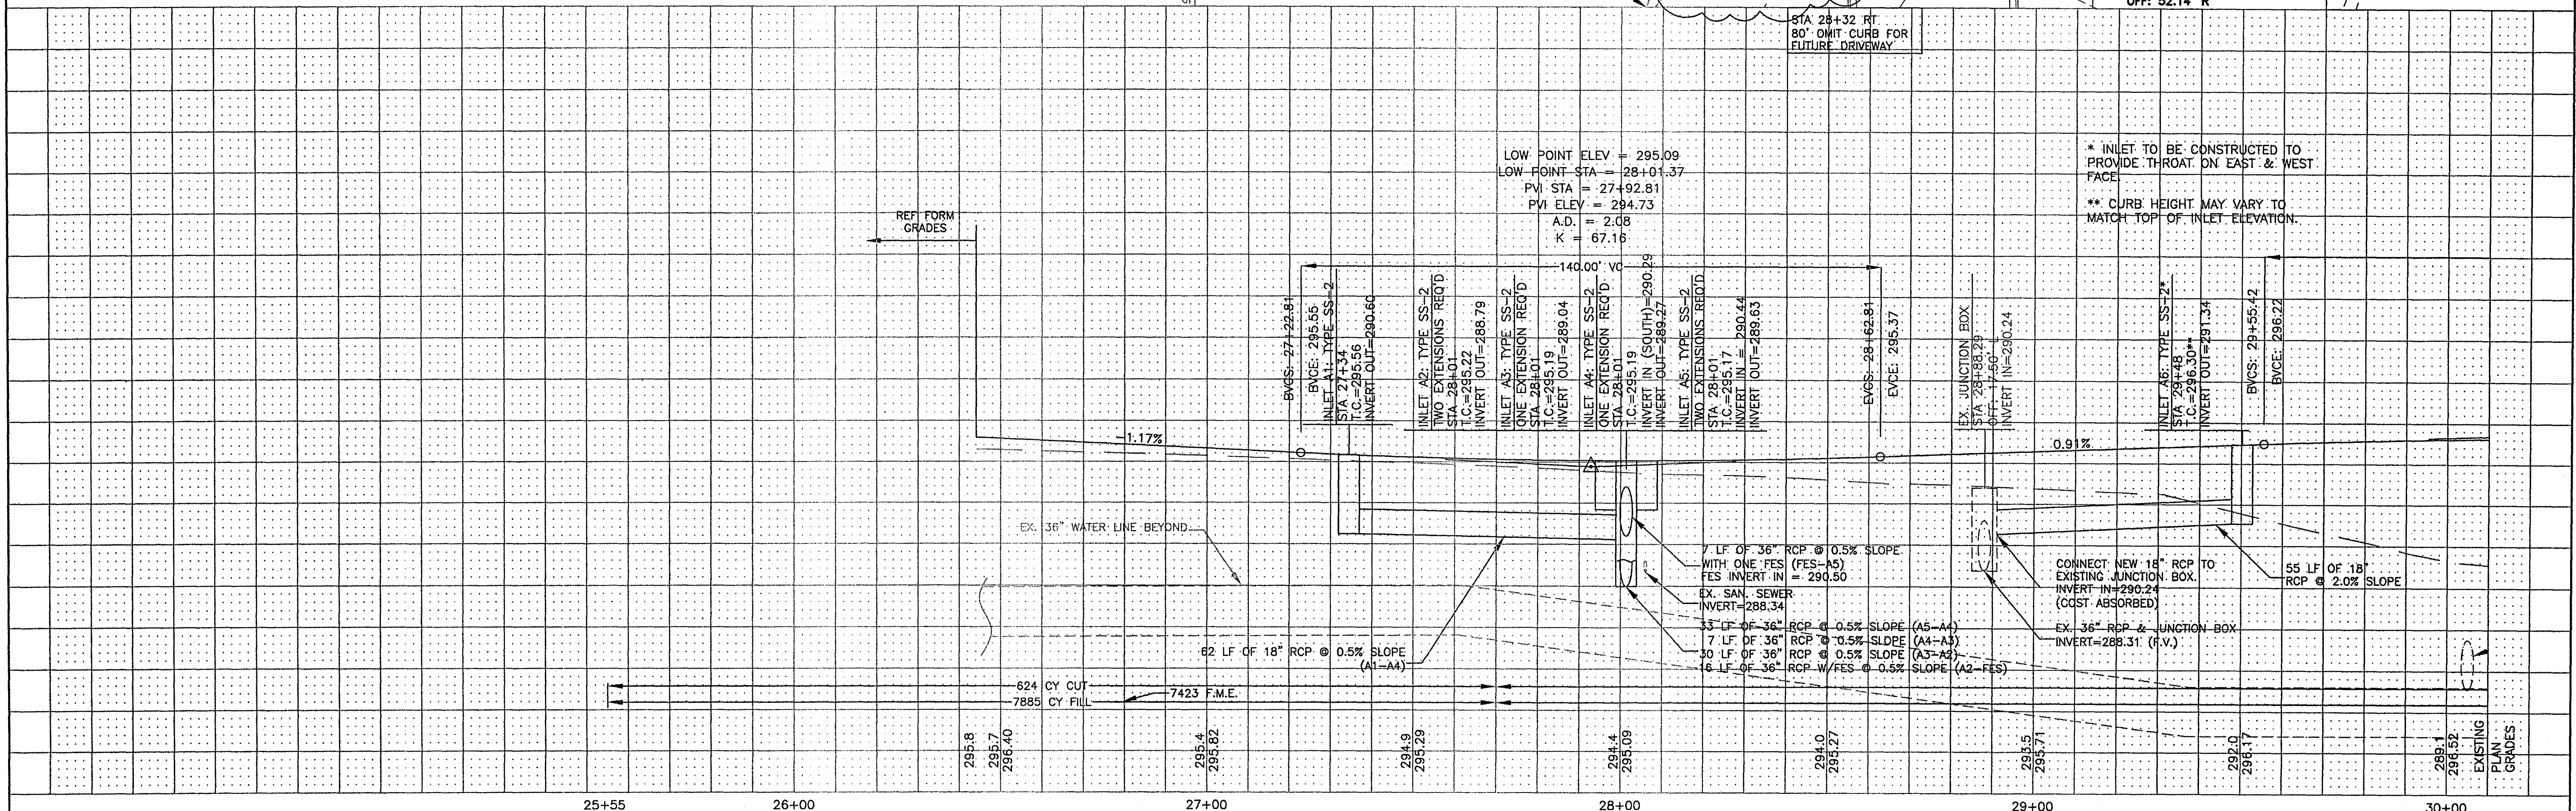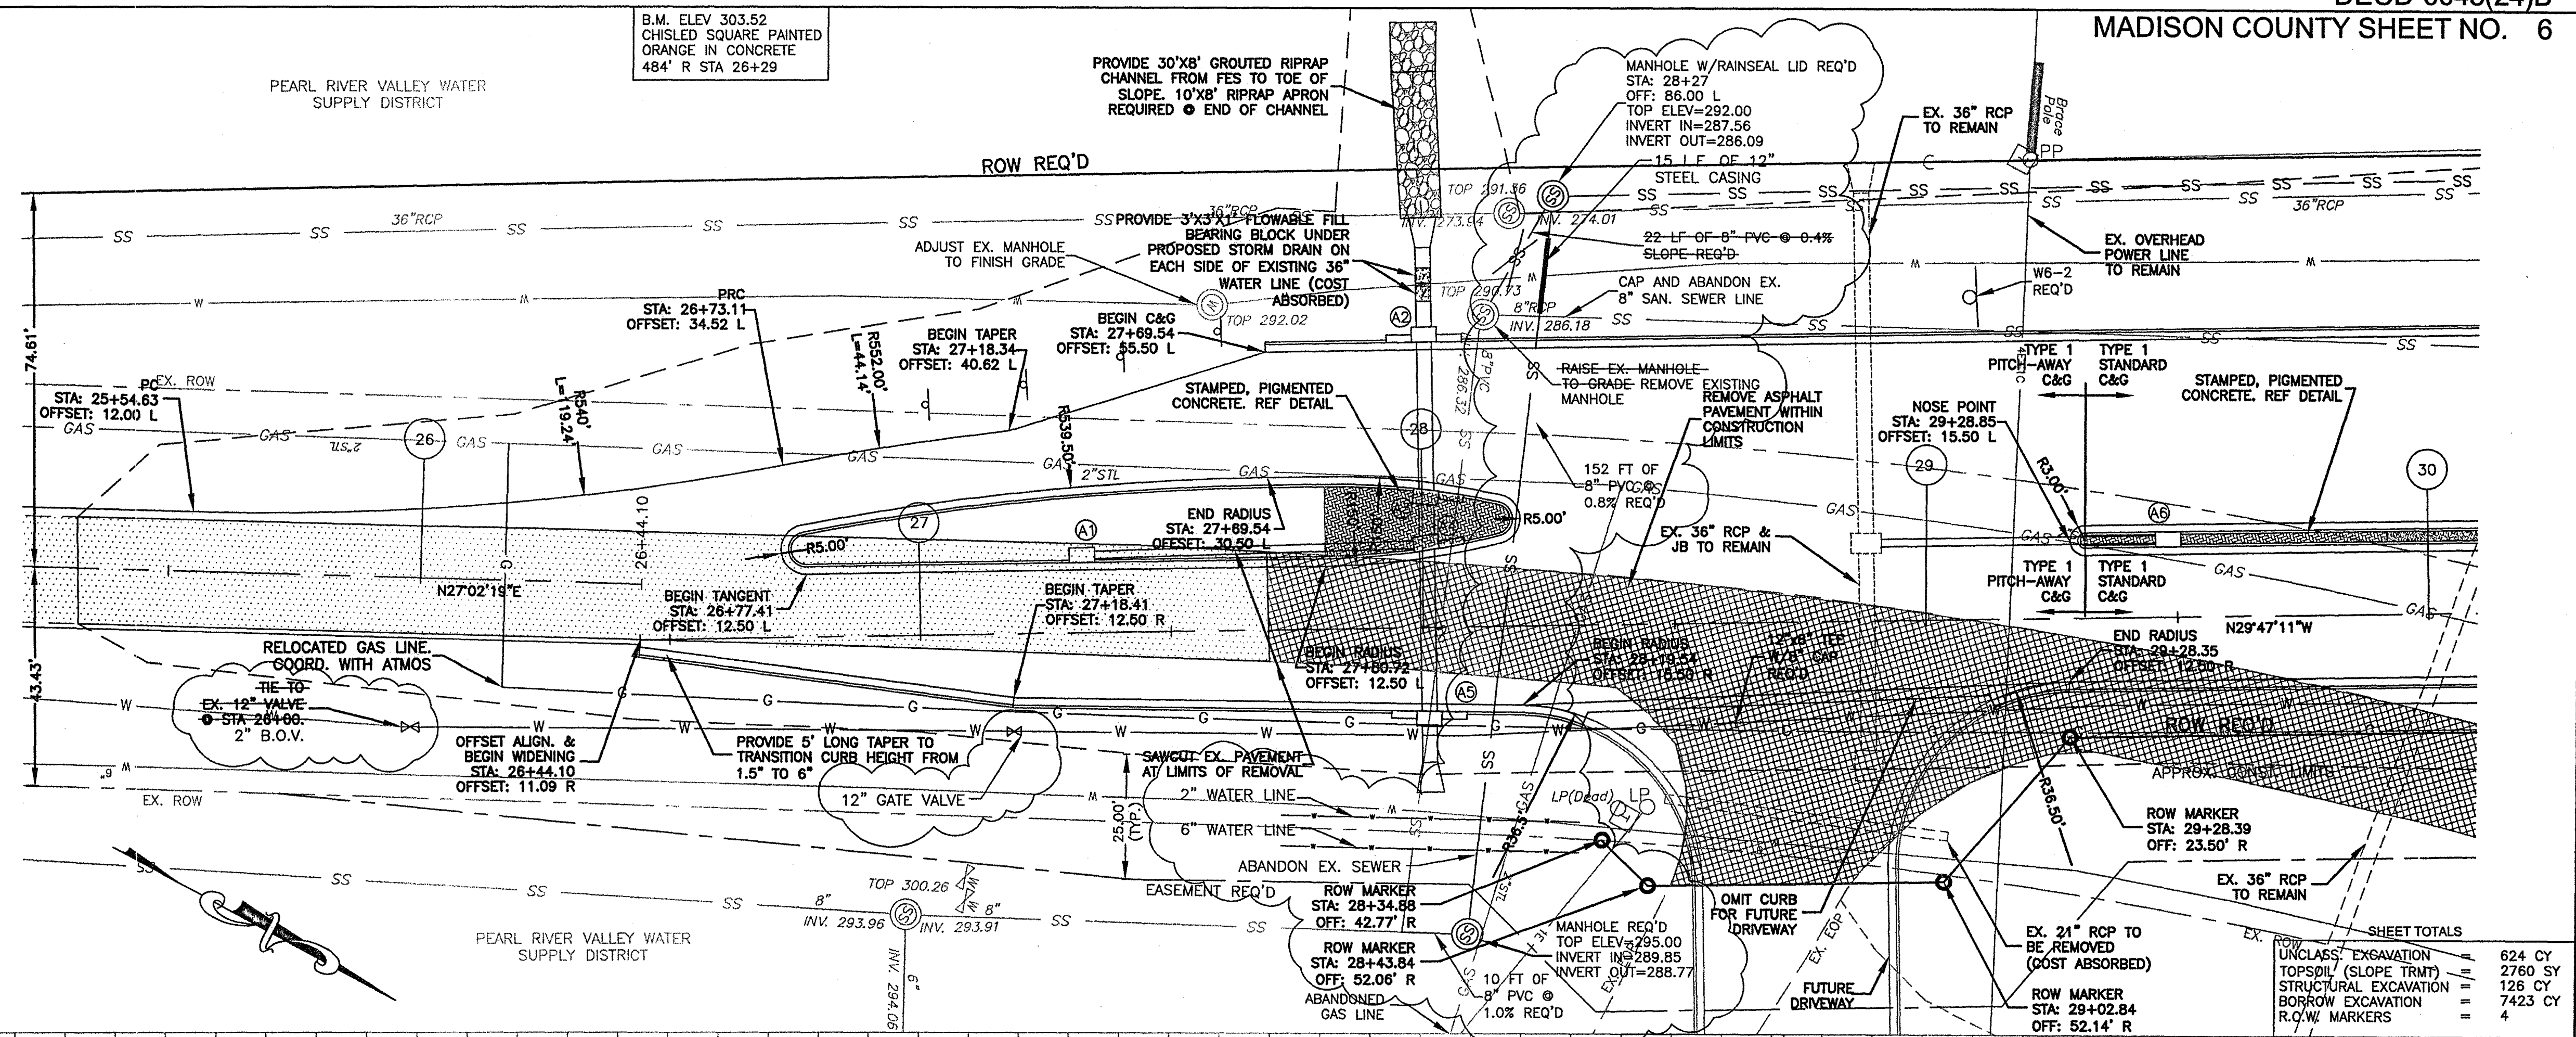


LOW POINT ELEV = 295.09
LOW POINT STA = 28+01.37
PVI STA = 27+92.81
PVI ELEV = 294.73
A.D. = 2.08
K = 67.16

* INLET TO BE CONSTRUCTED TO PROVIDE THROAT ON EAST & WEST FACE
** CURB HEIGHT MAY VARY TO MATCH TOP OF INLET ELEVATION.



SHEET TOTALS




UNCLASS. EXCAVATION TOPSOIL (SLOPE TRMT)	624 CY
STRUCTURAL EXCAVATION	126 CY
BORROW EXCAVATION	7423 CY
R.O.W. MARKERS	4

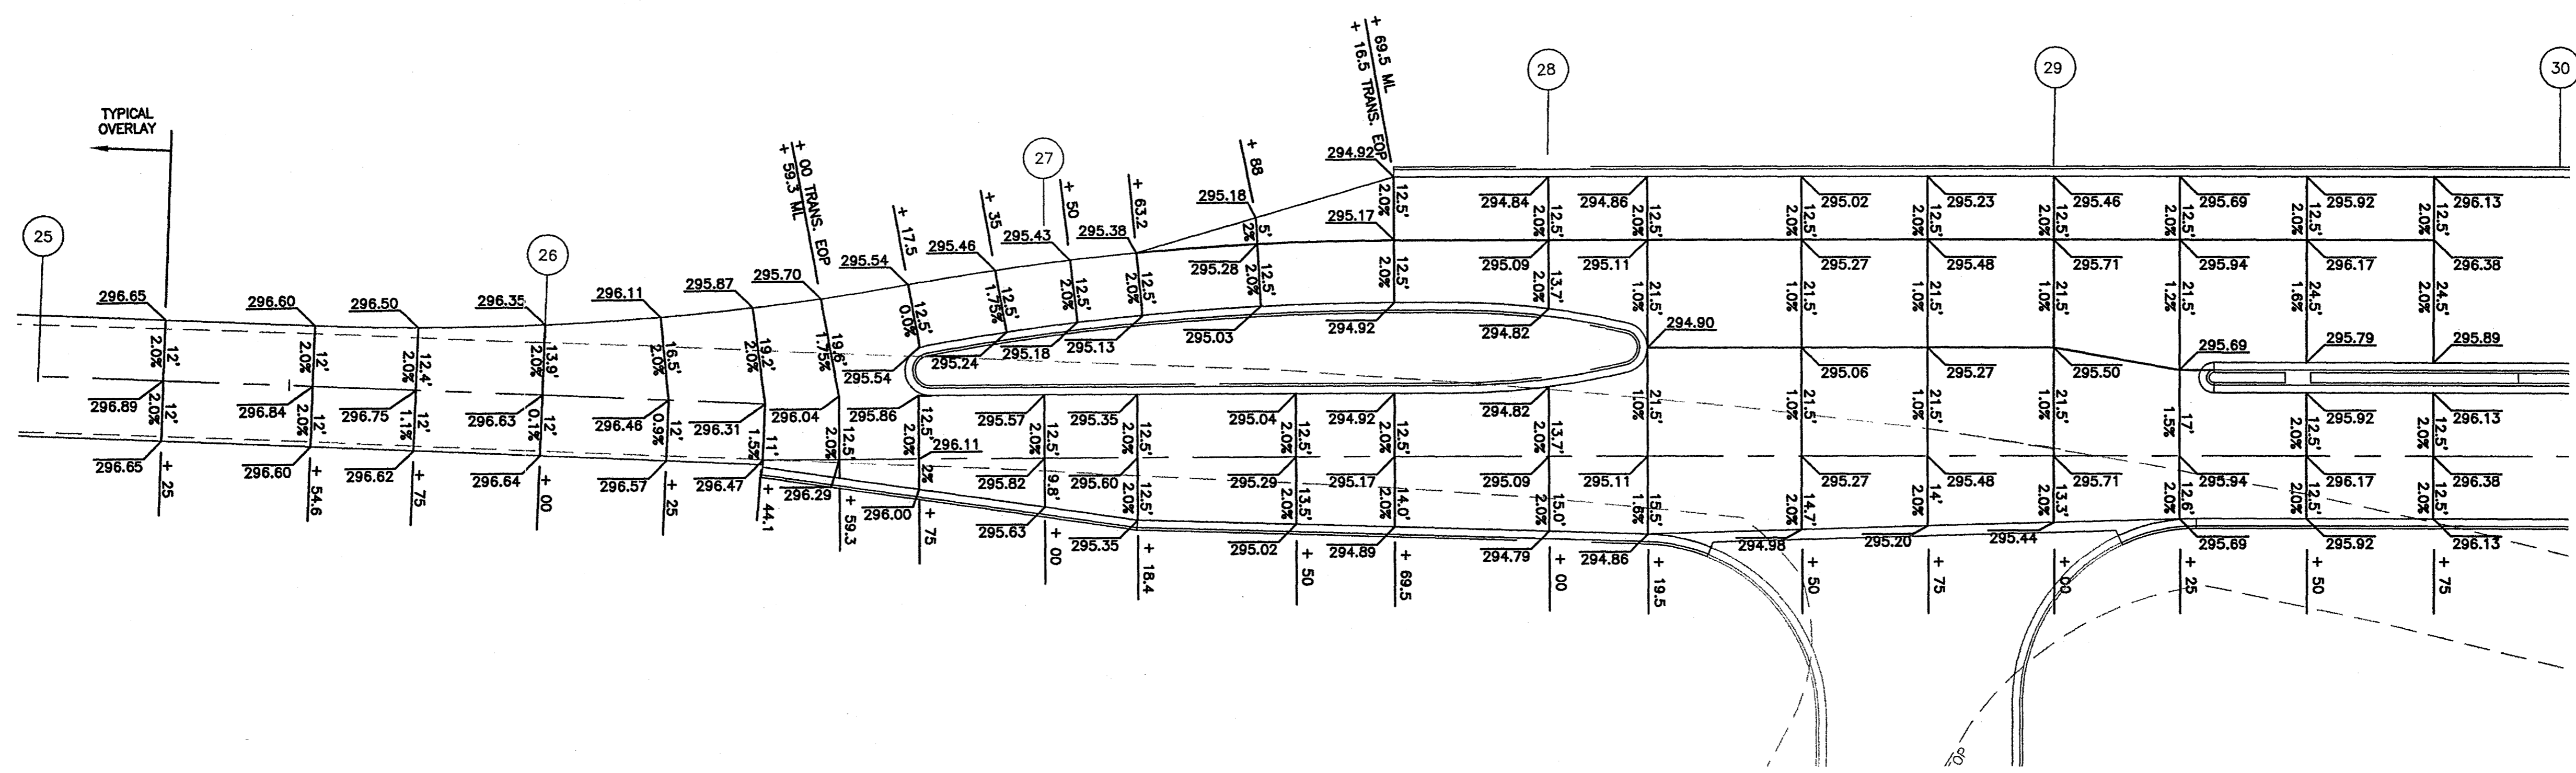

Record Drawings
1-8-08

Small vertical text on the left margin, likely a reference or scale indicator.

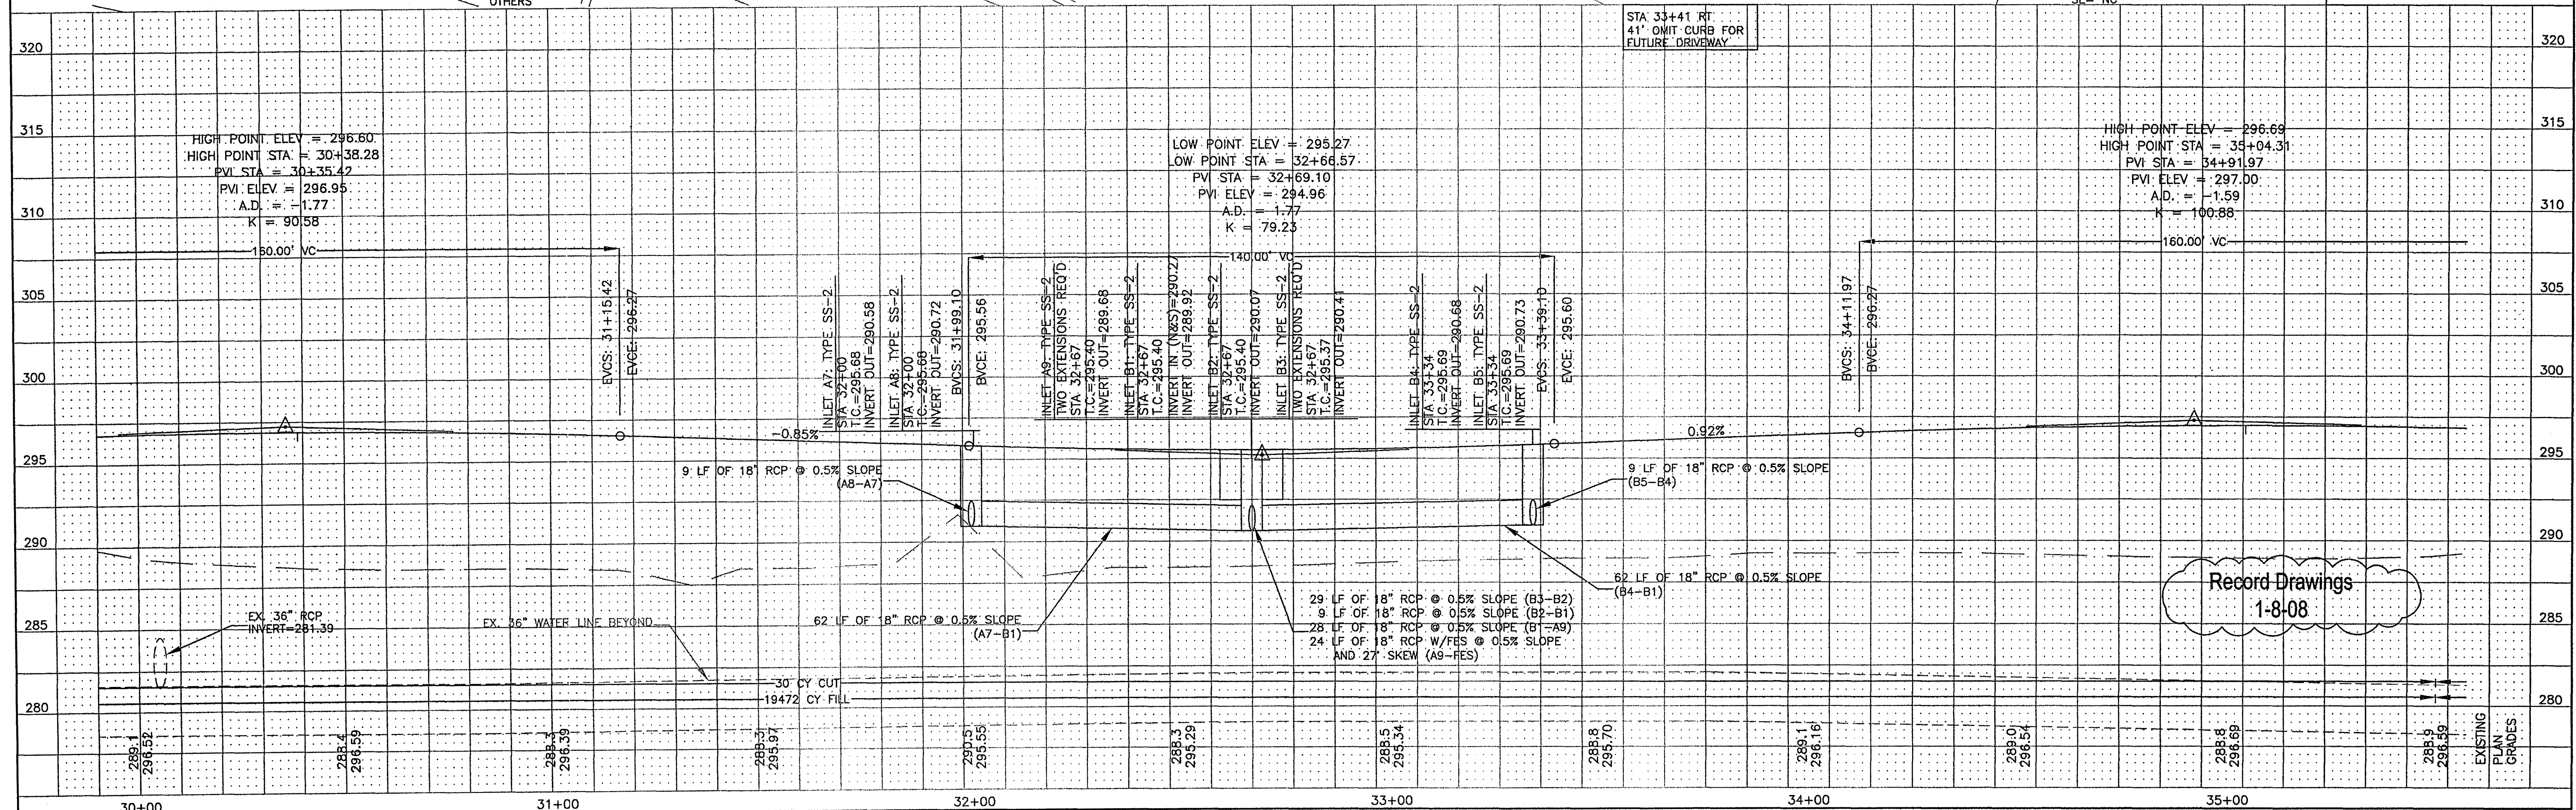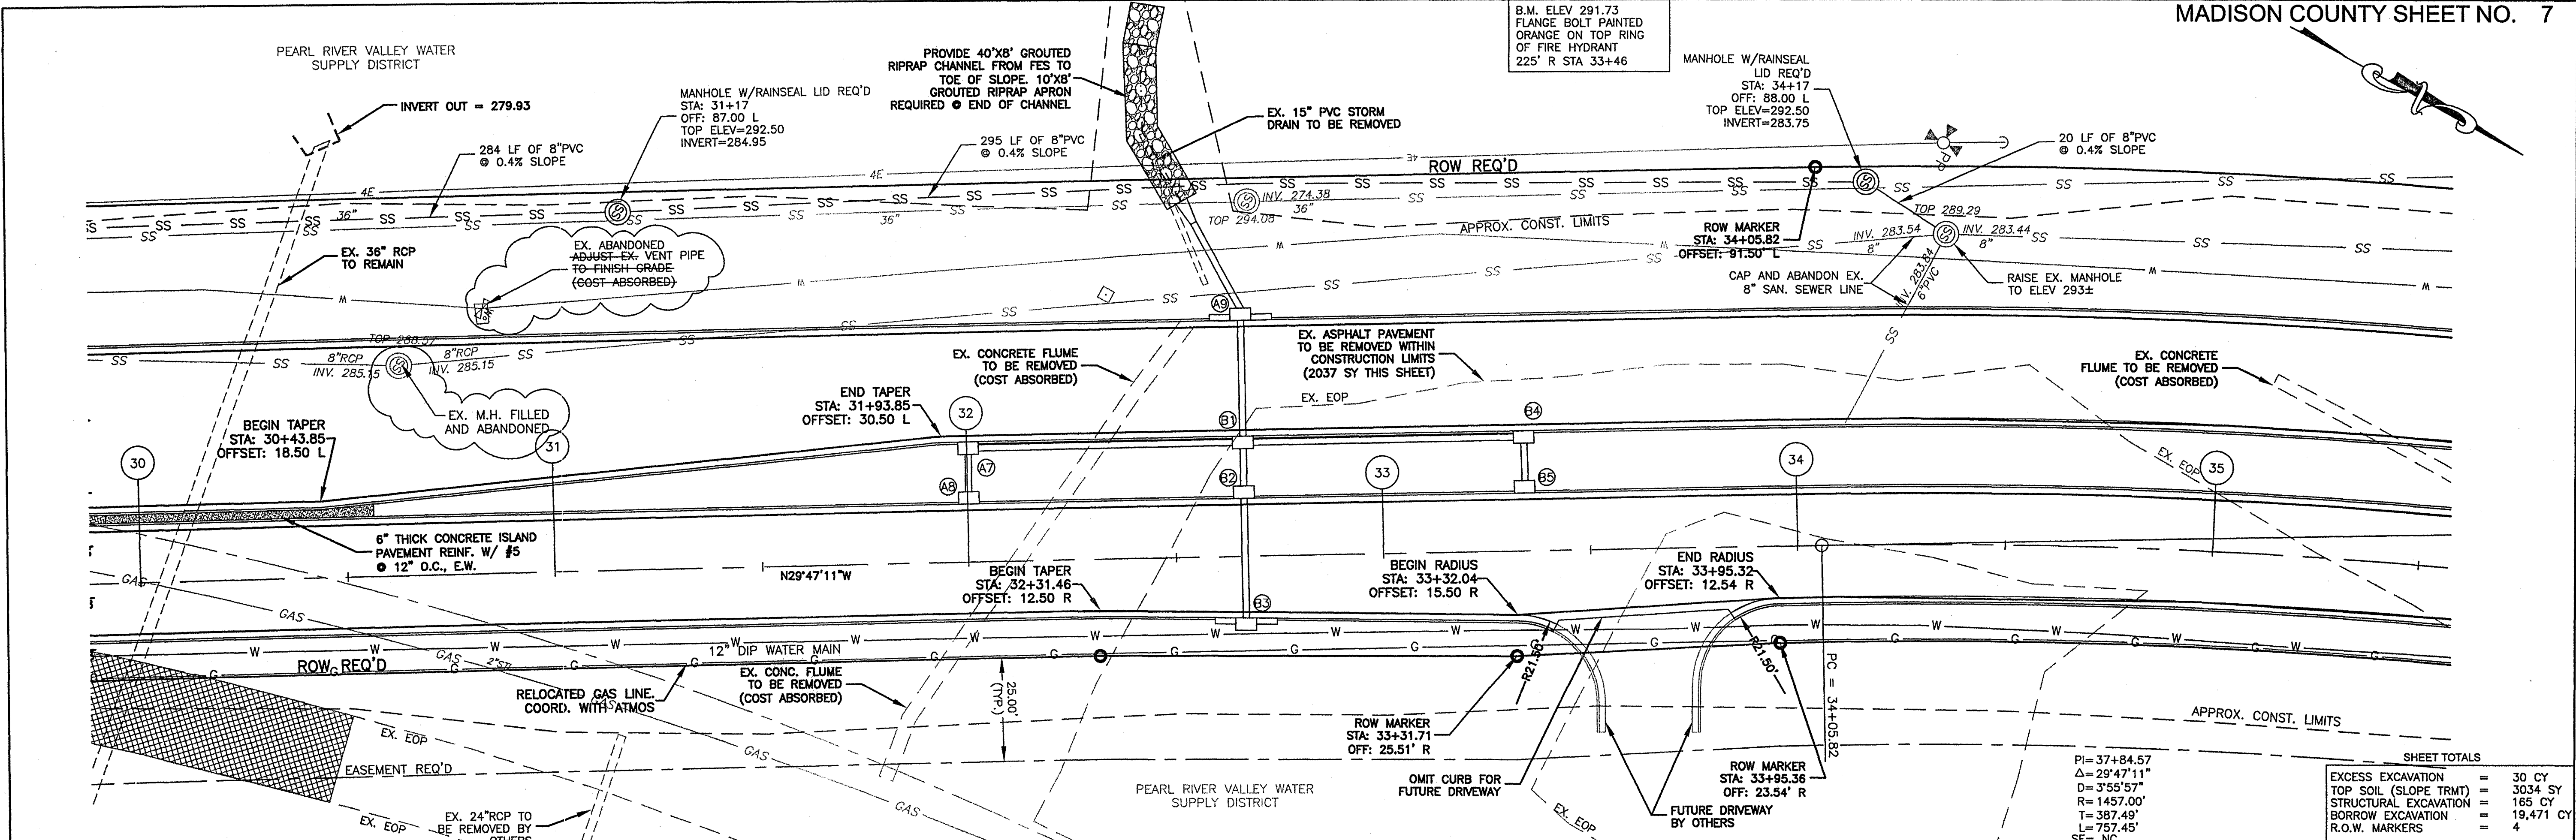

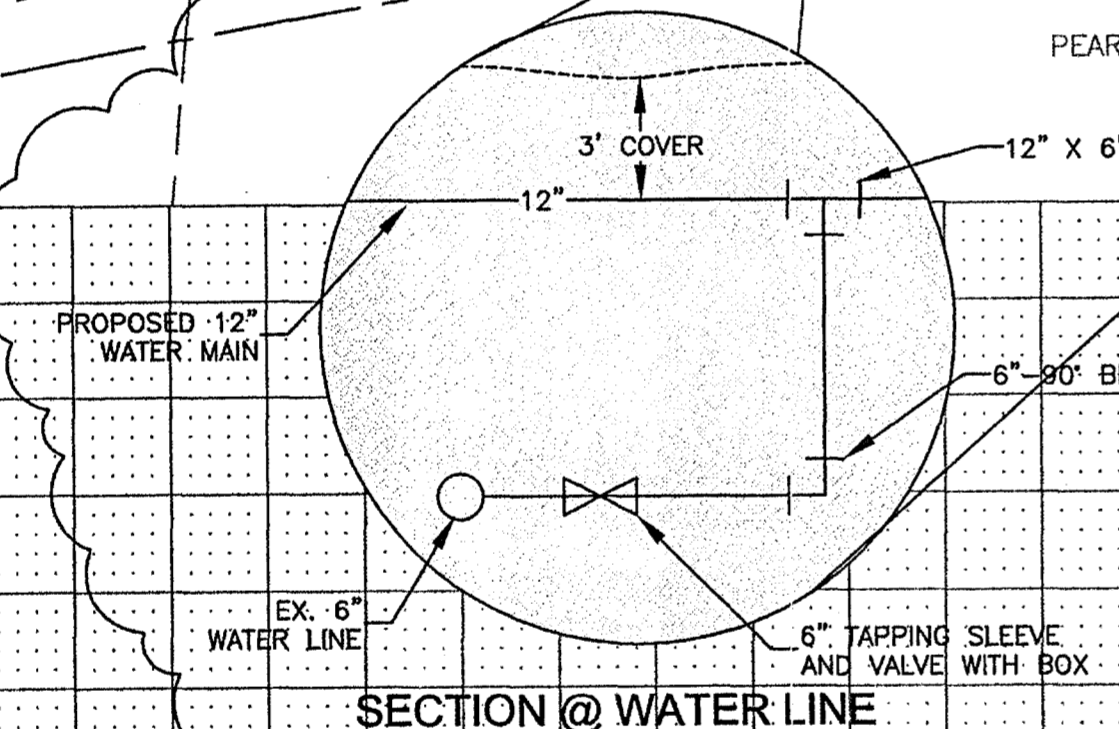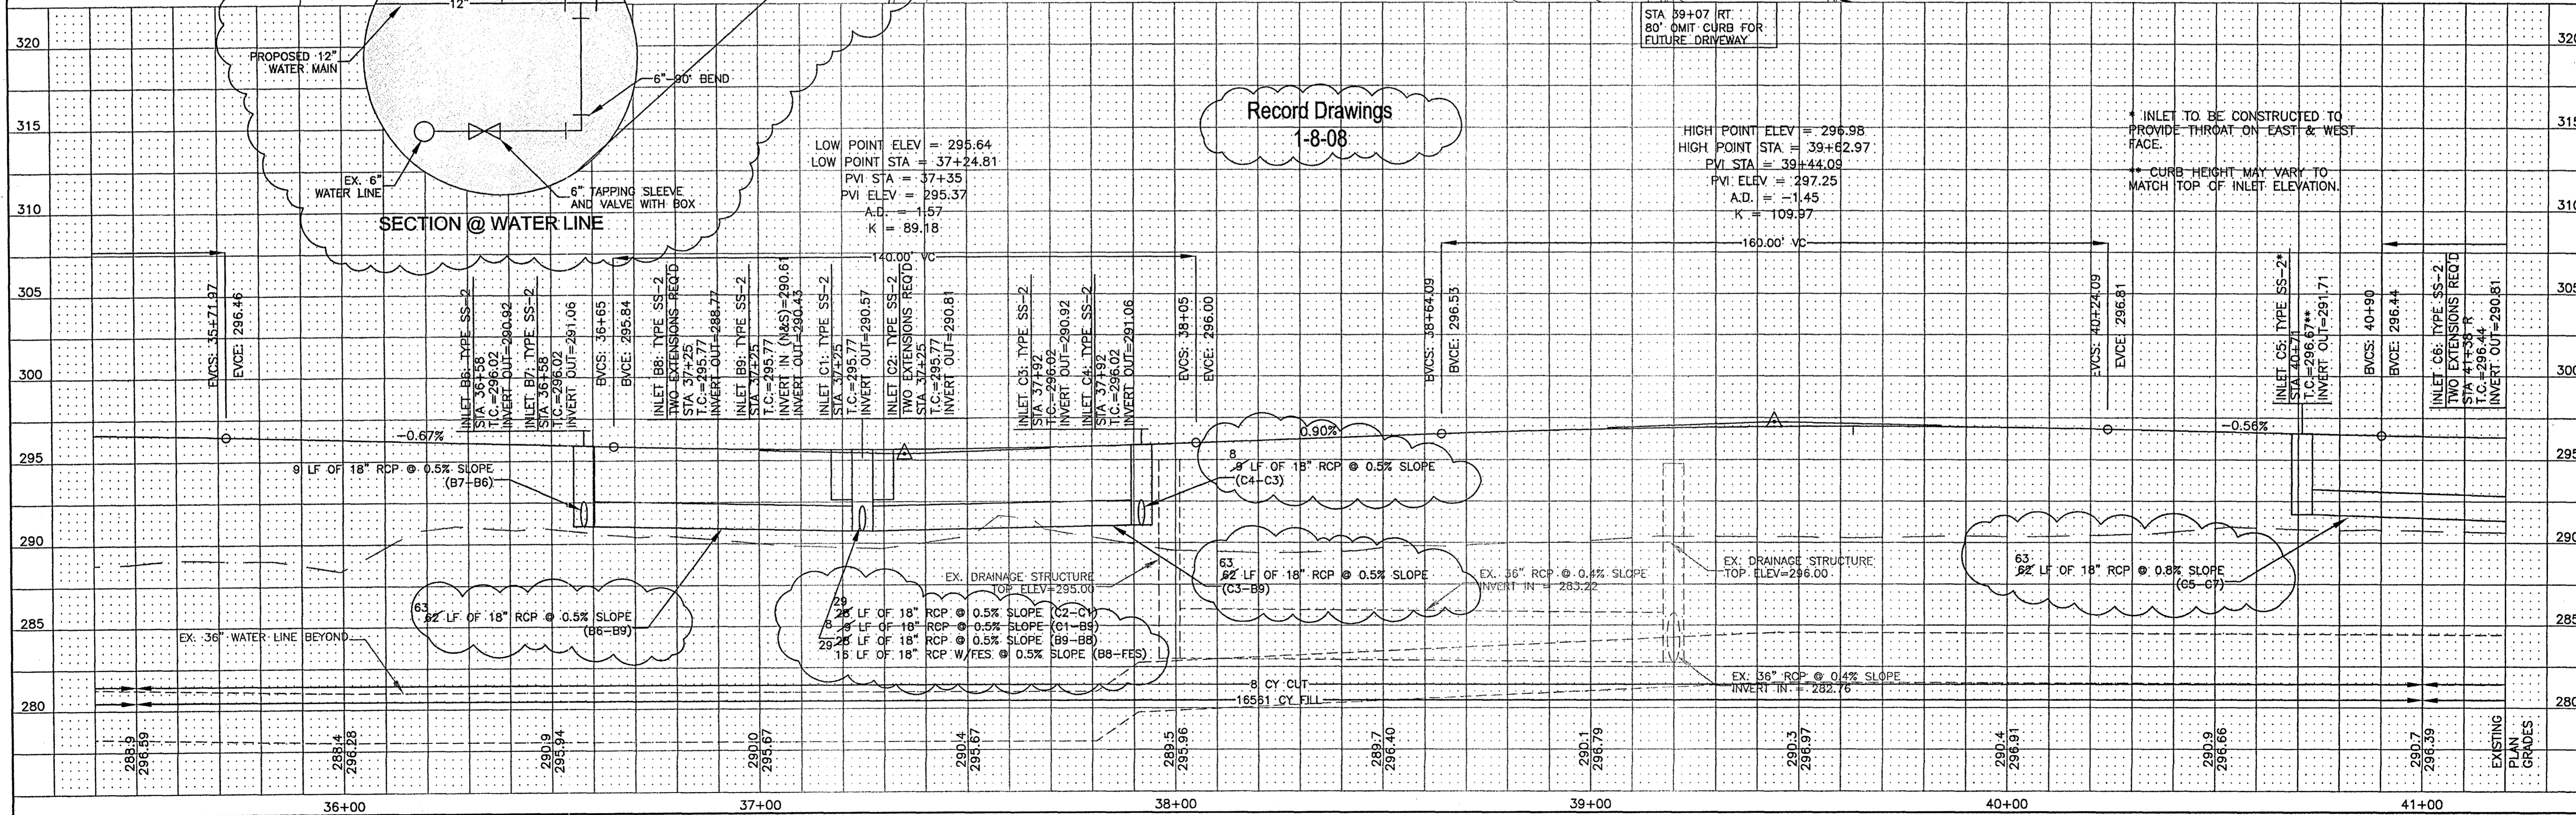
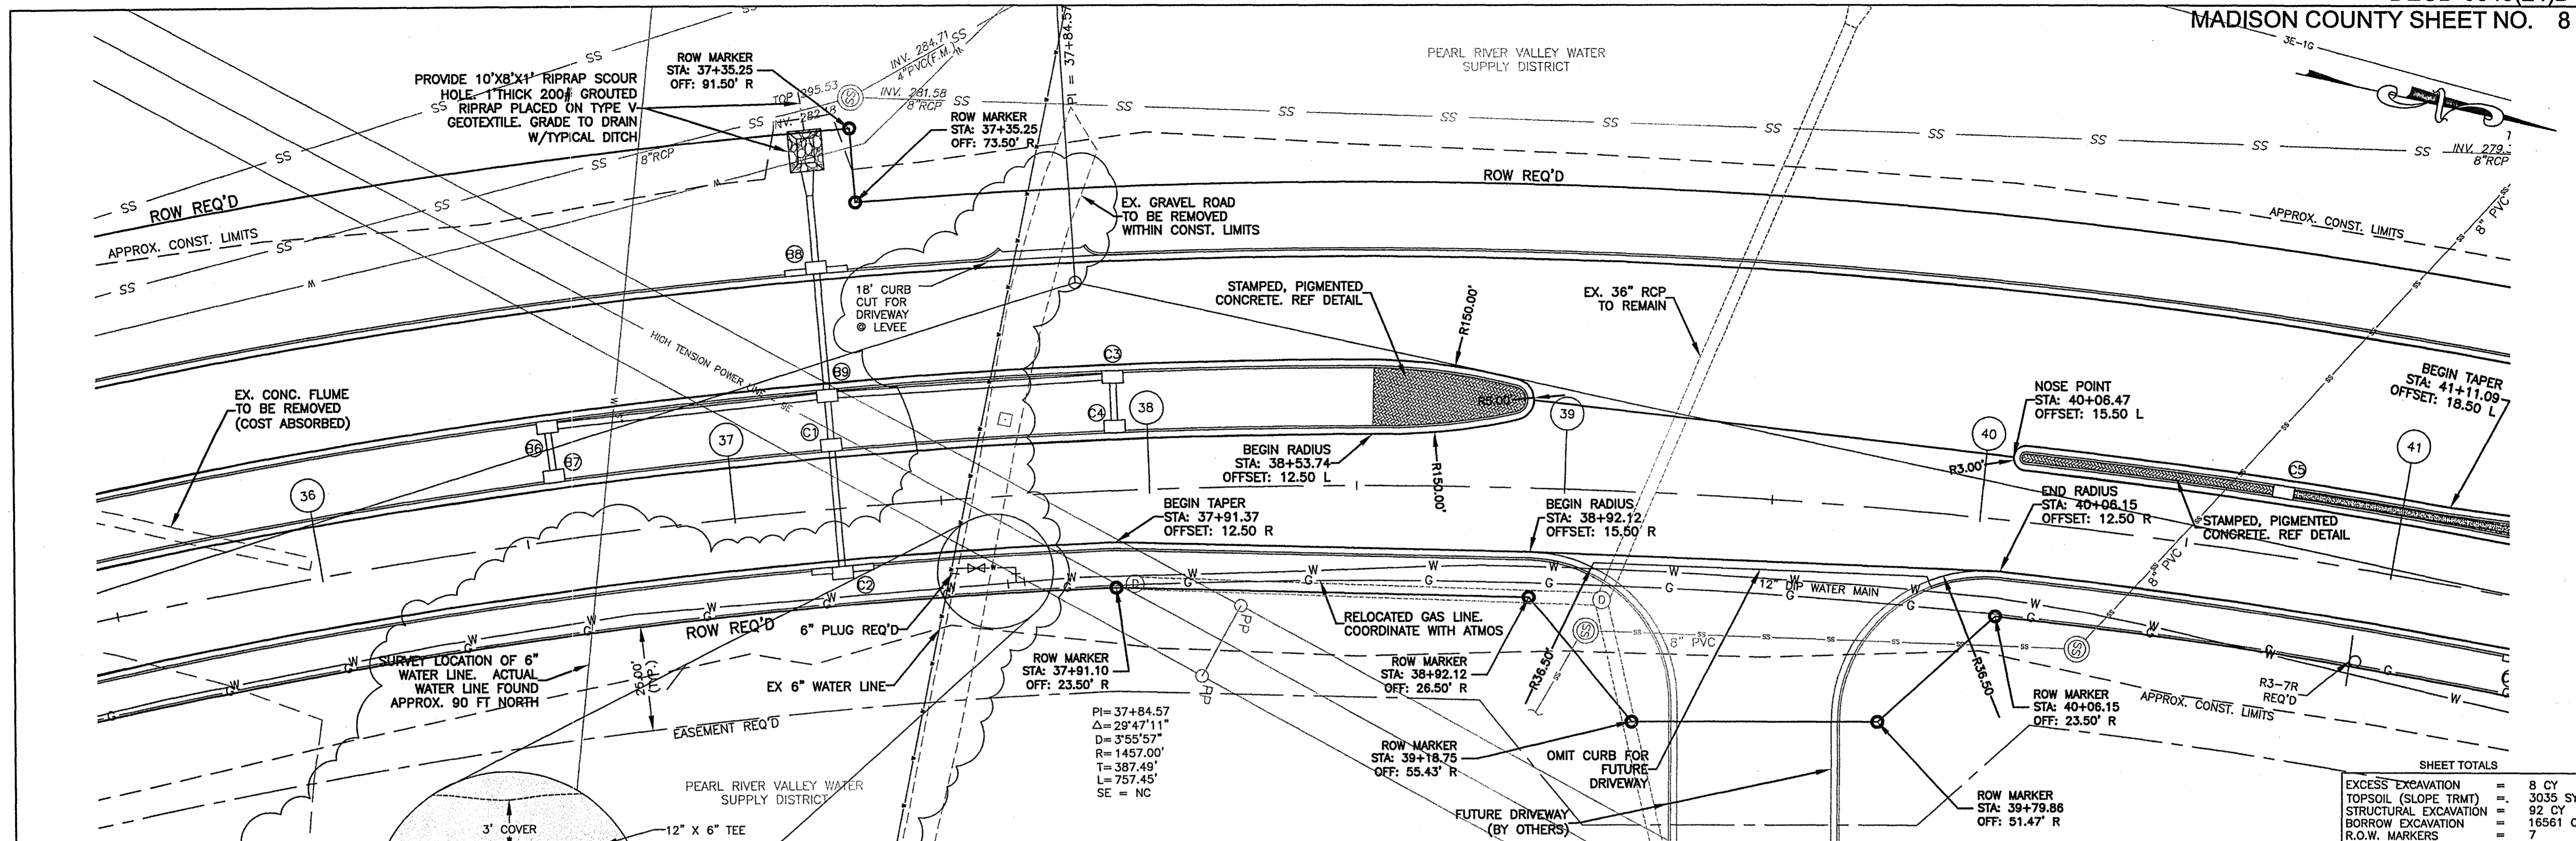


Record Drawings
1-8-08

SHEET TOTALS

EXCESS EXCAVATION	=	8 CY
TOPSOIL (SLOPE TRMT)	=	3035 SY
STRUCTURAL EXCAVATION	=	92 CY
BORROW EXCAVATION	=	16561 CY
R.O.W. MARKERS	=	7

Record Drawings
1-8-08

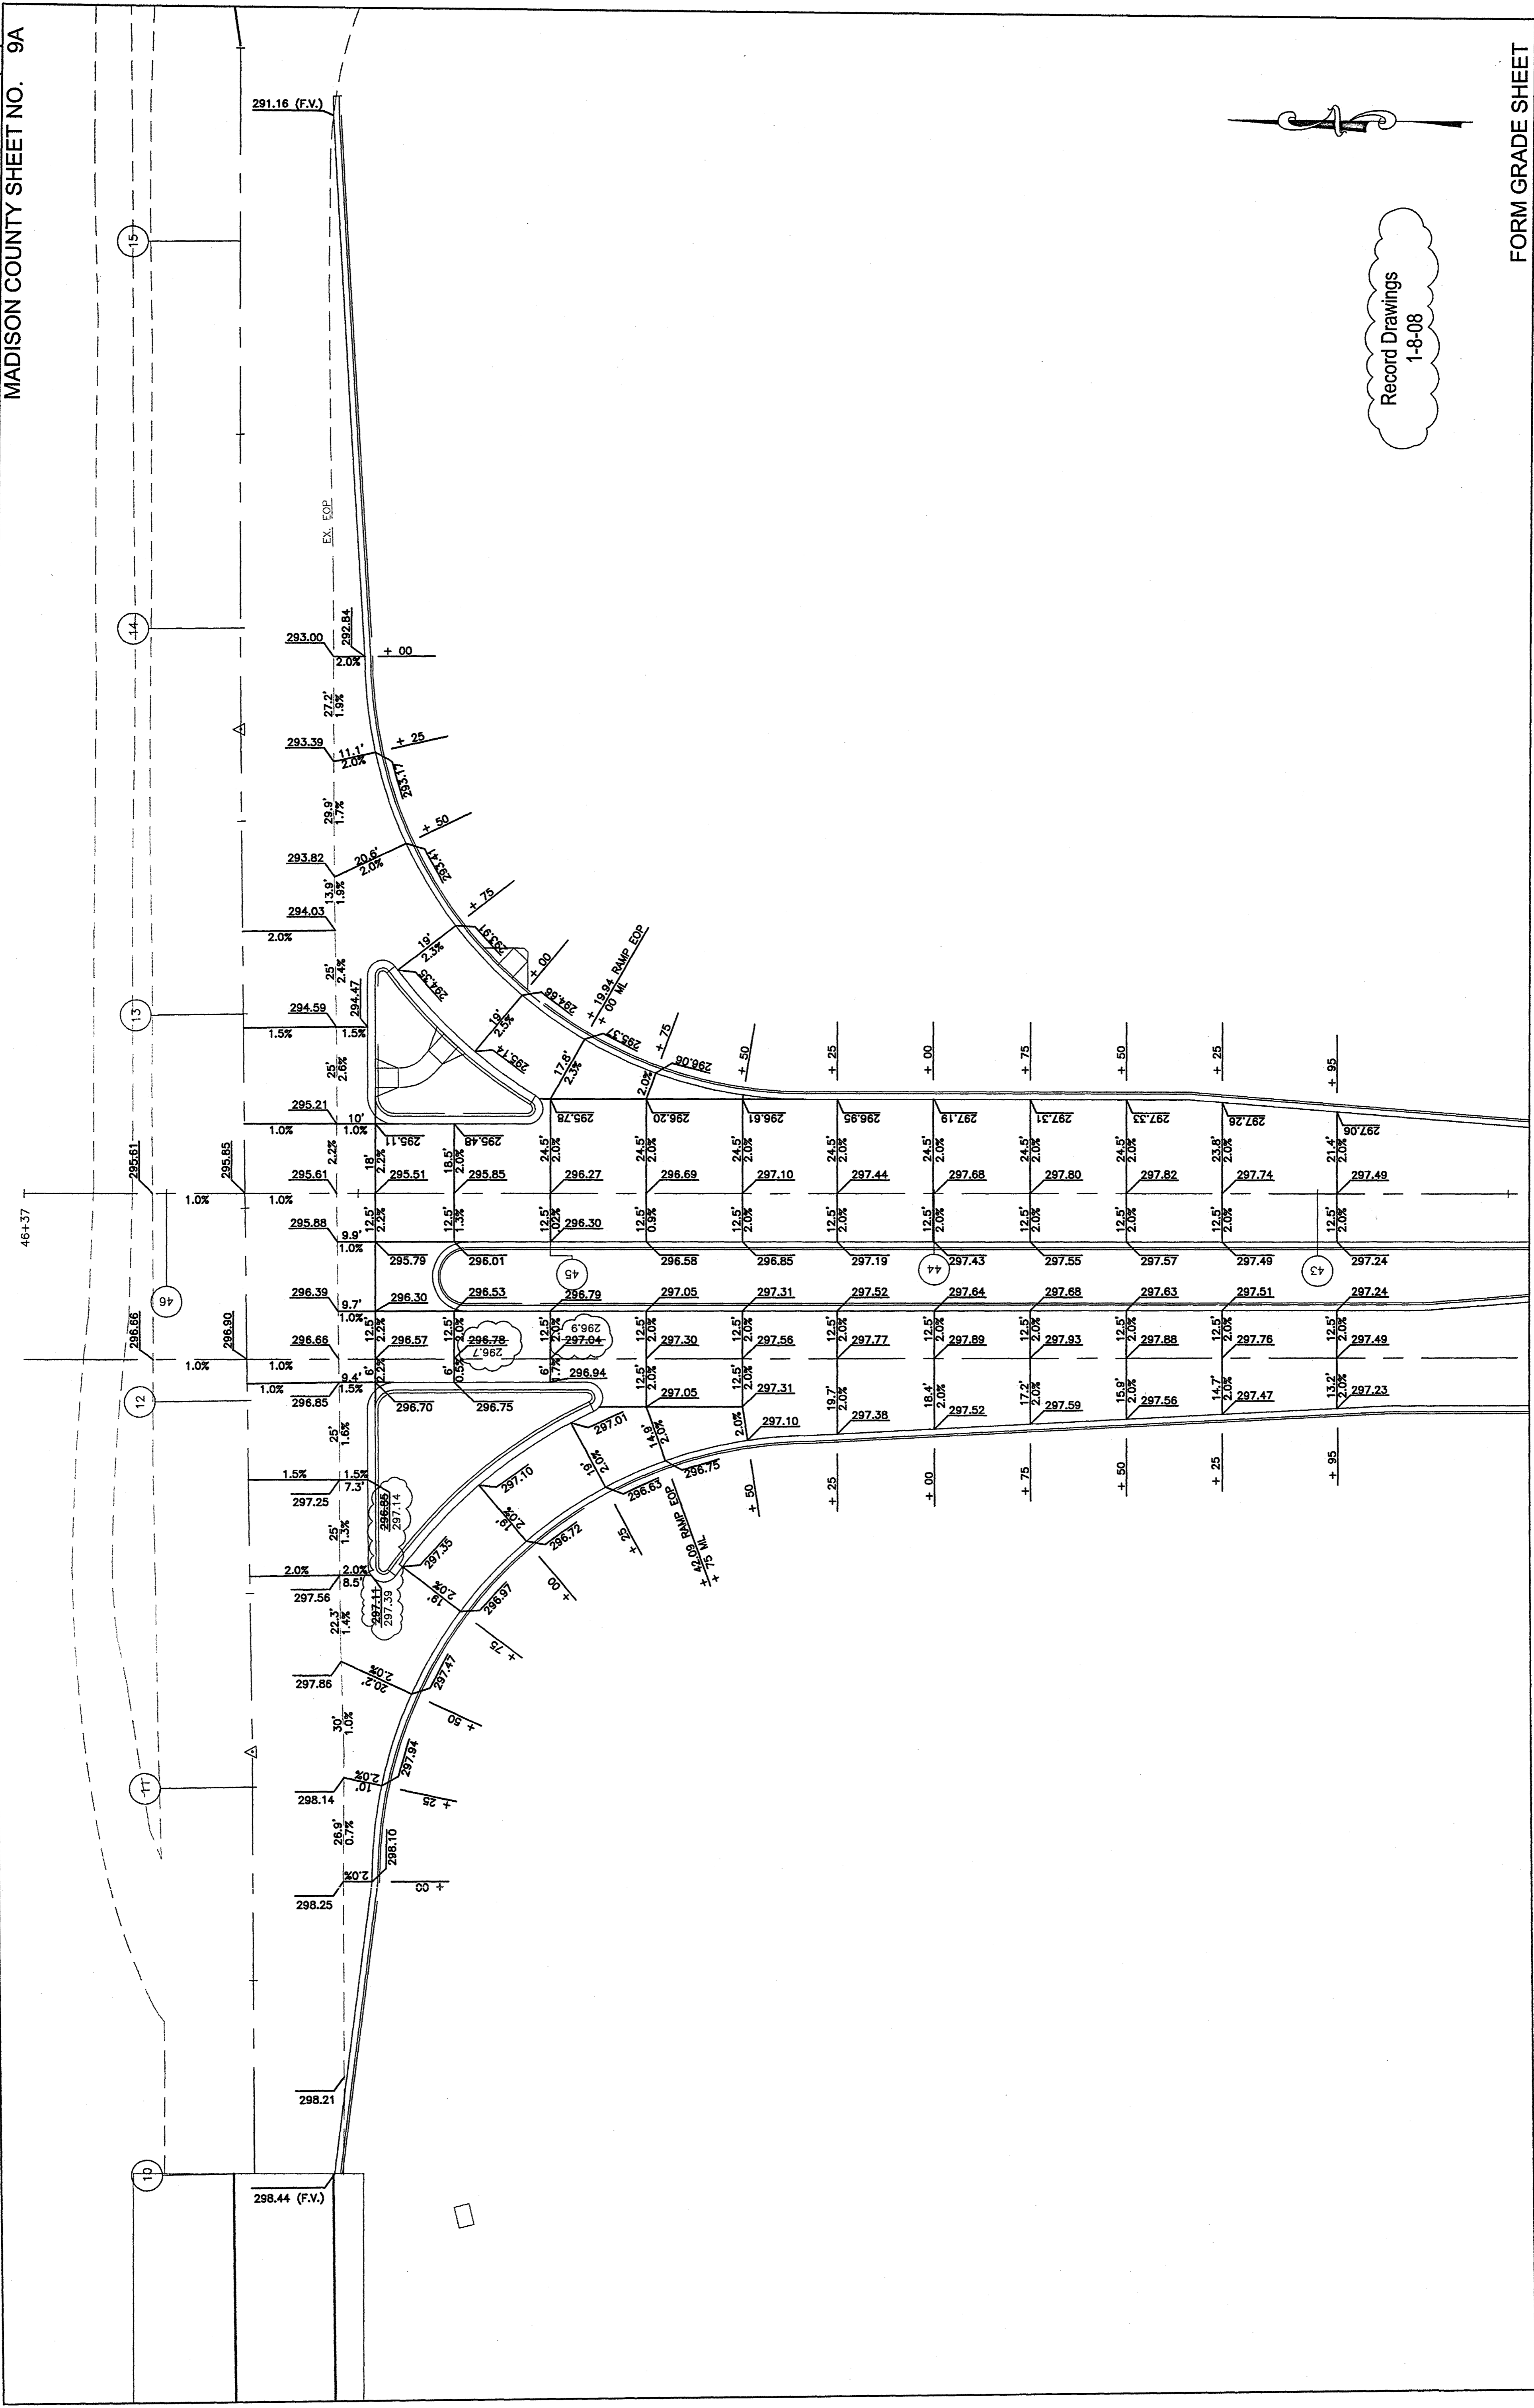
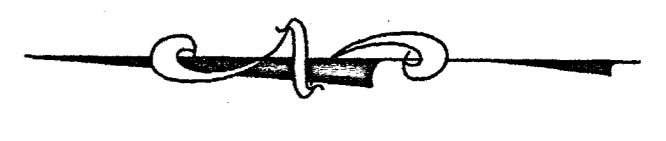


SHEET TOTALS		PROJECT TOTALS	
EXCESS EXCAVATION	= 372 CY	EXCESS EXCAVATION	= 2180 CY
TOPSOIL (SLOPE TRMT)	= W/SHT 9	UNCLASS. EXCAVATION	= 654 CY
STRUCTURAL EXCAVATION	= 274 CY	TOPSOIL (SLOPE TRMT)	= 19360 SY
BORROW EXCAVATION	= W/SHT 9	STRUCTURAL EXCAVATION	= 825 CY
R.O.W. MARKERS	= 4 EA	BORROW EXCAVATION	= 67325 CY
		R.O.W. MARKERS	= 22 EA

B.M. ELEV 288.96
 CHISLED SQ. ON SW
 CORNER OF CONCRETE
 PRESSURE RELIEF VALVE
 267' L HD STA 45+21



WIDEN EX. BIKE PATH FROM STA
 11+06 TO STA 12+36 WITHIN
 LIMITS SHOWN (APPROX. 56 SY).
 STRUCTURE: 10" CLASS 5, GROUP
 C GRANULAR MATERIAL, 2" BIT.
 SURFACE. MATCH EX. PAVEMENT
 ELEVATION

PEARL RIVER VALLEY
 WATER SUPPLY DISTRICT

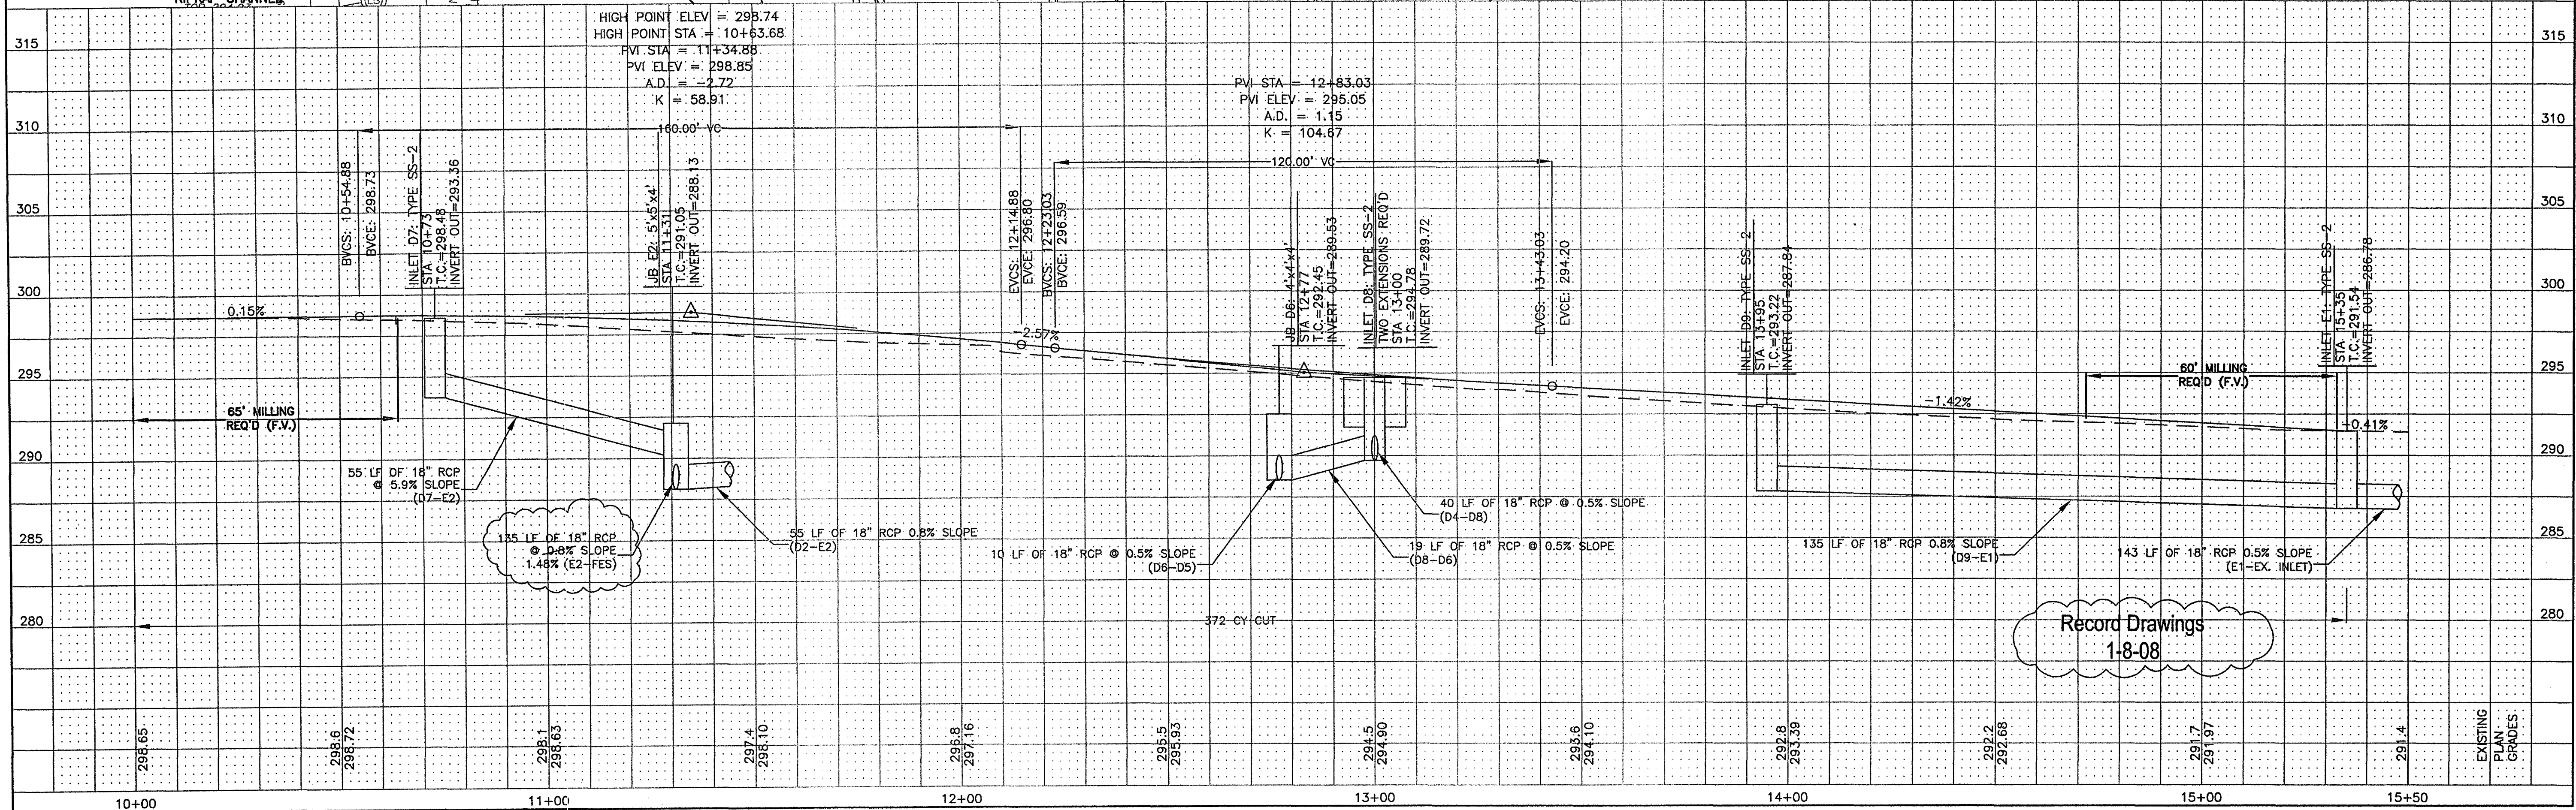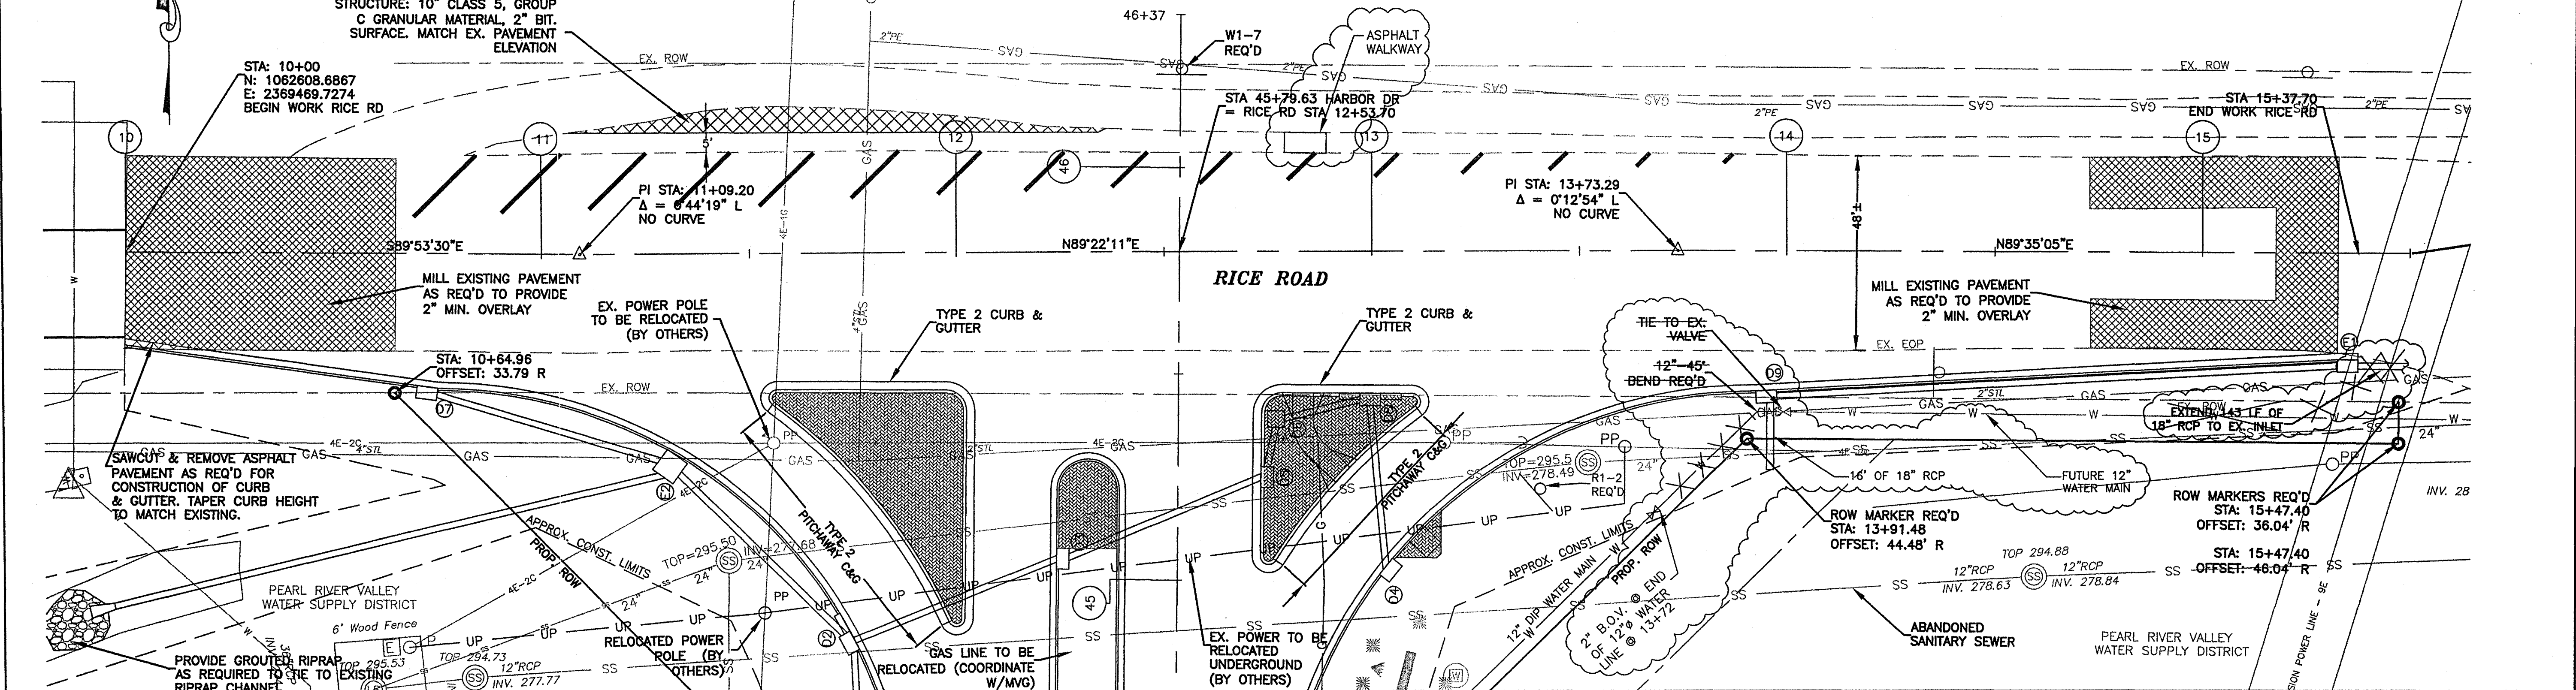


LOCATION	EST. SHAFT LENGTH	MAST ARM LENGTH	SIGNAL HEADS/SIGNS	EMERGENCY VEHICLE DETECTOR	SIGNS
SE QUADRANT	30'	35'	0', 15', 22', 34'	28'	ⓐ
SE QUADRANT (PED)	8'	0'	0'	N/A	N/A
NW QUADRANT	30'	42'	0, 21', 29', 37', 41'	33'	ⓐ, ⓑ
NE QUADRANT	30'	36'	0', 25', 32', 44'	36'	ⓐ

SIGNAL HEADS & SIGNS

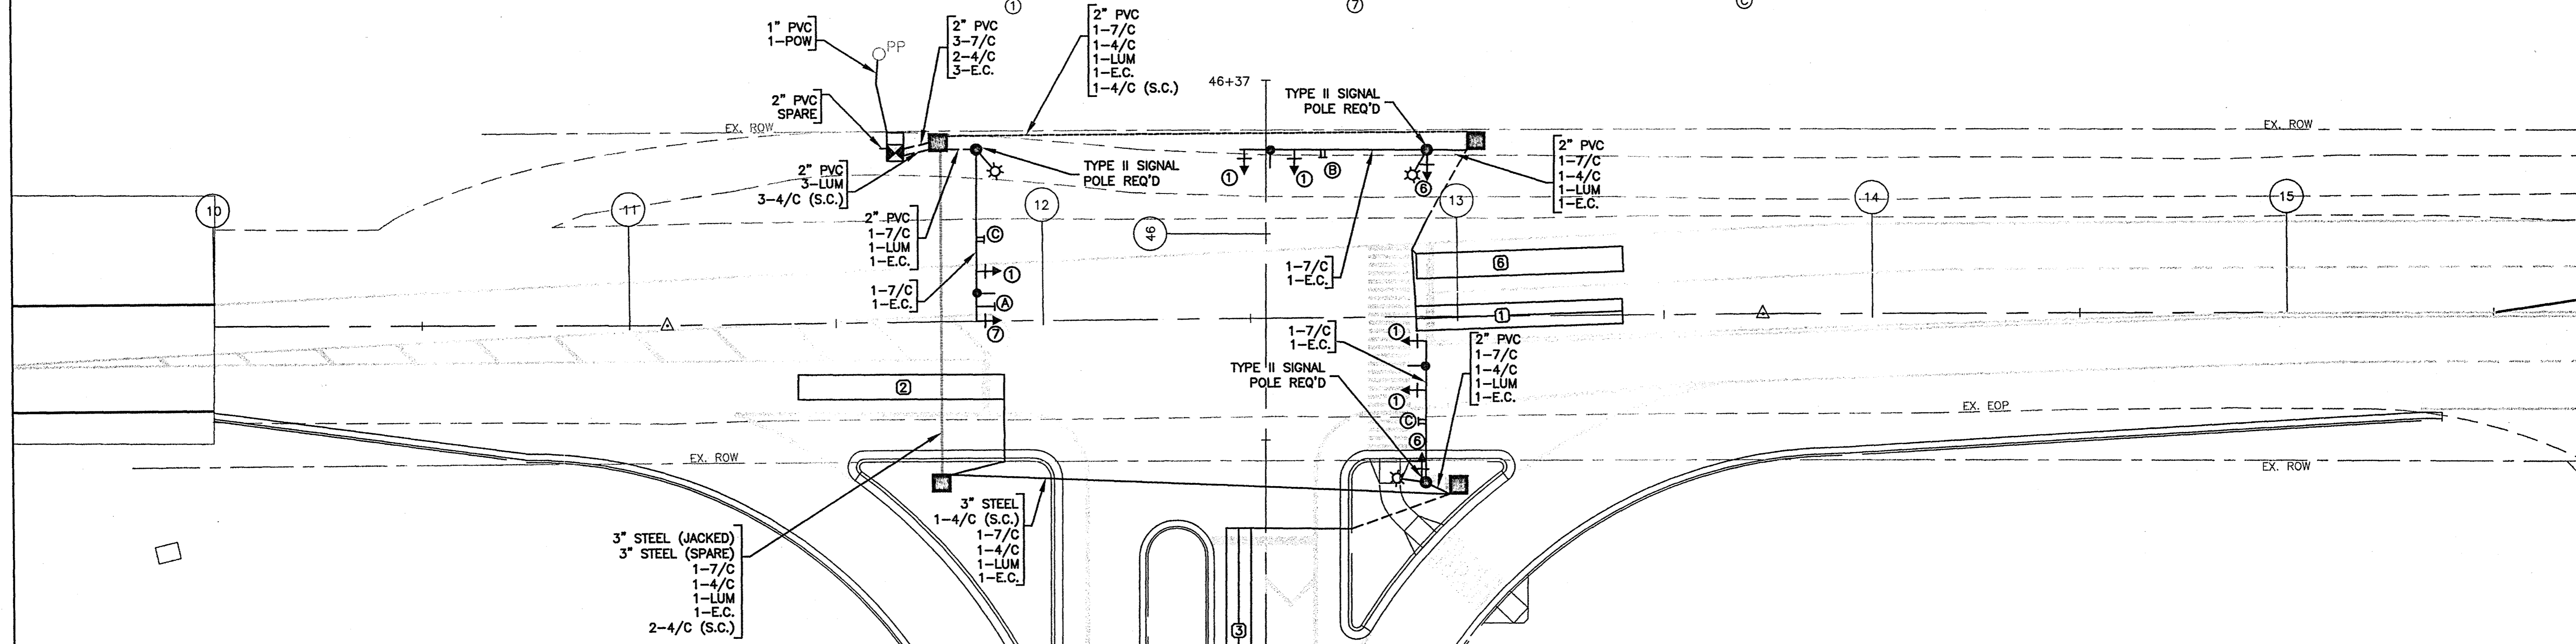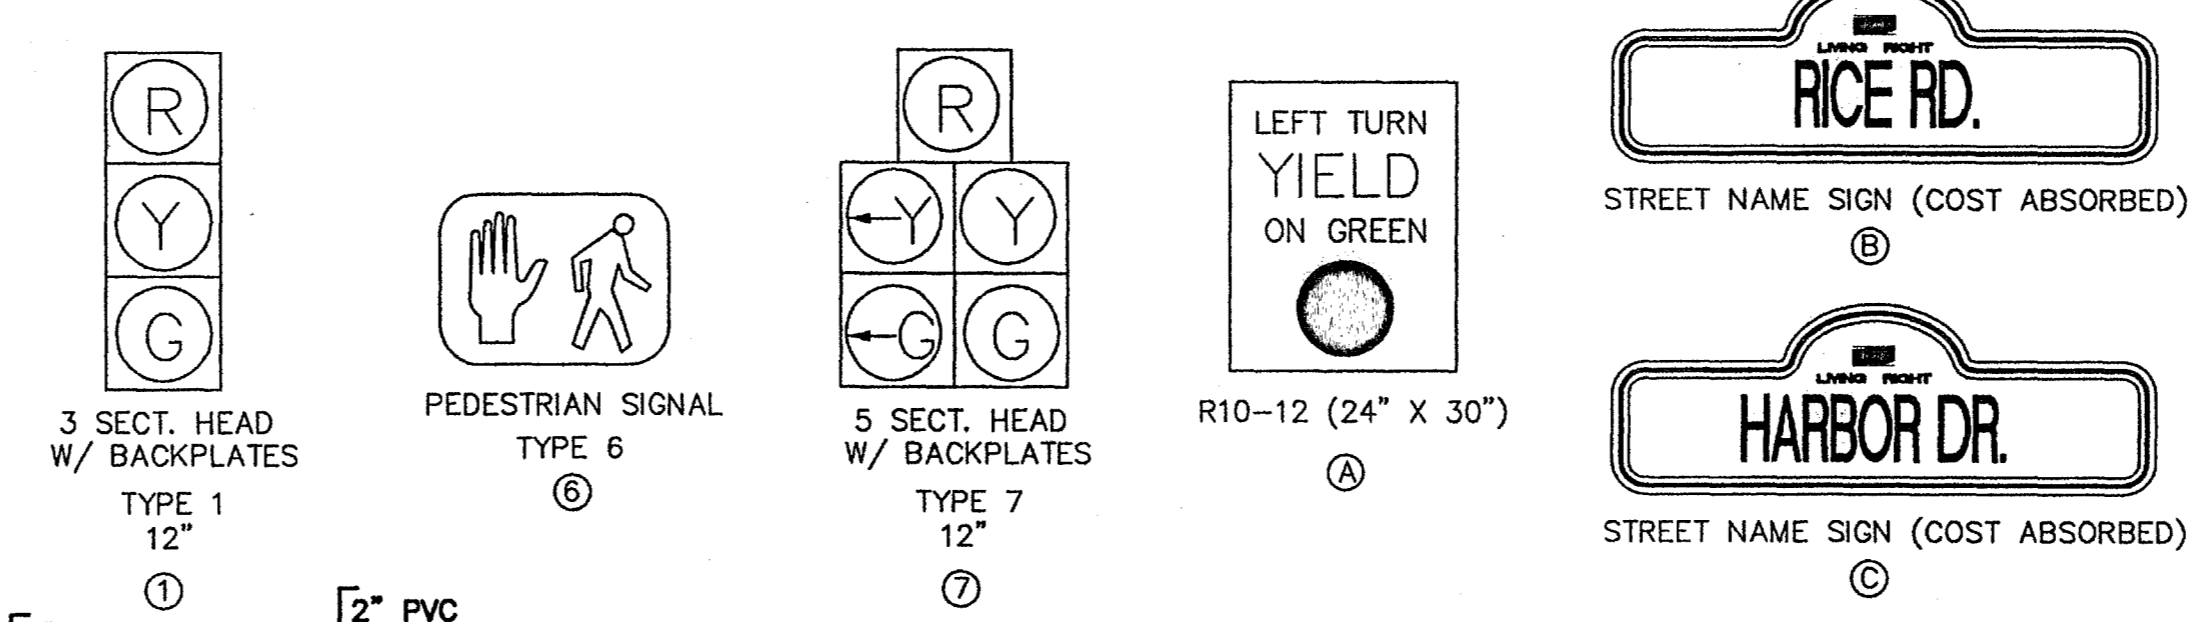


SIGNAL PHASING DIAGRAM

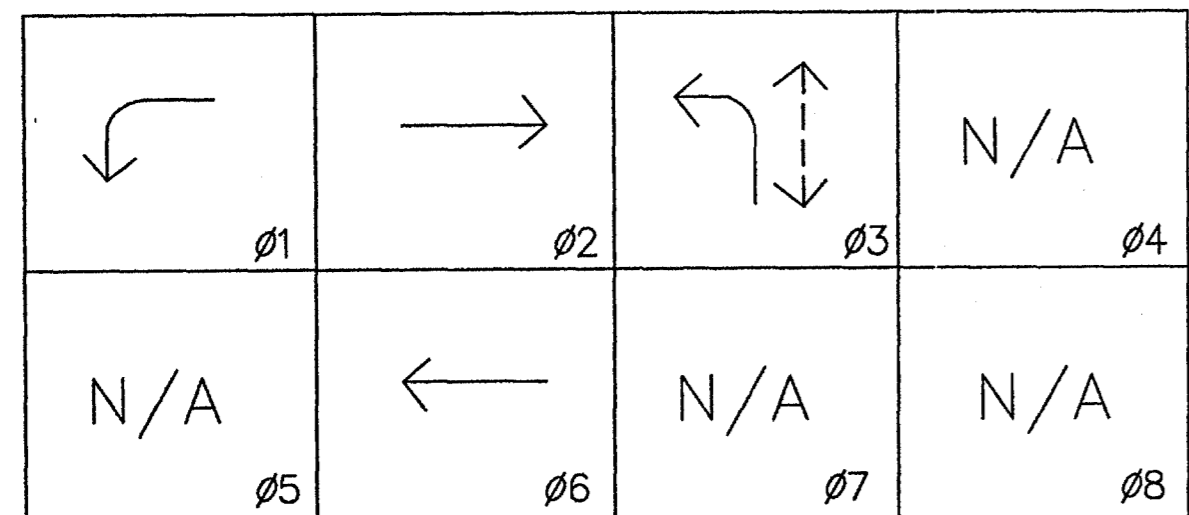

NOTE: PEDESTRIAN INDICATOR SHALL BE HARD WIRED TO VEHICLE PHASE 3.

DETECTOR NUMBER	LOOP SIZE	TURNS	AMP-CHANNEL	COMMENTS
2	6'x 50'	2	2-1	
1	6'x 50'	2-4-2	1-1	
6	6'x 50'	2	2-2	
3	6'x 50'	2-4-2	3-1	

LEGEND

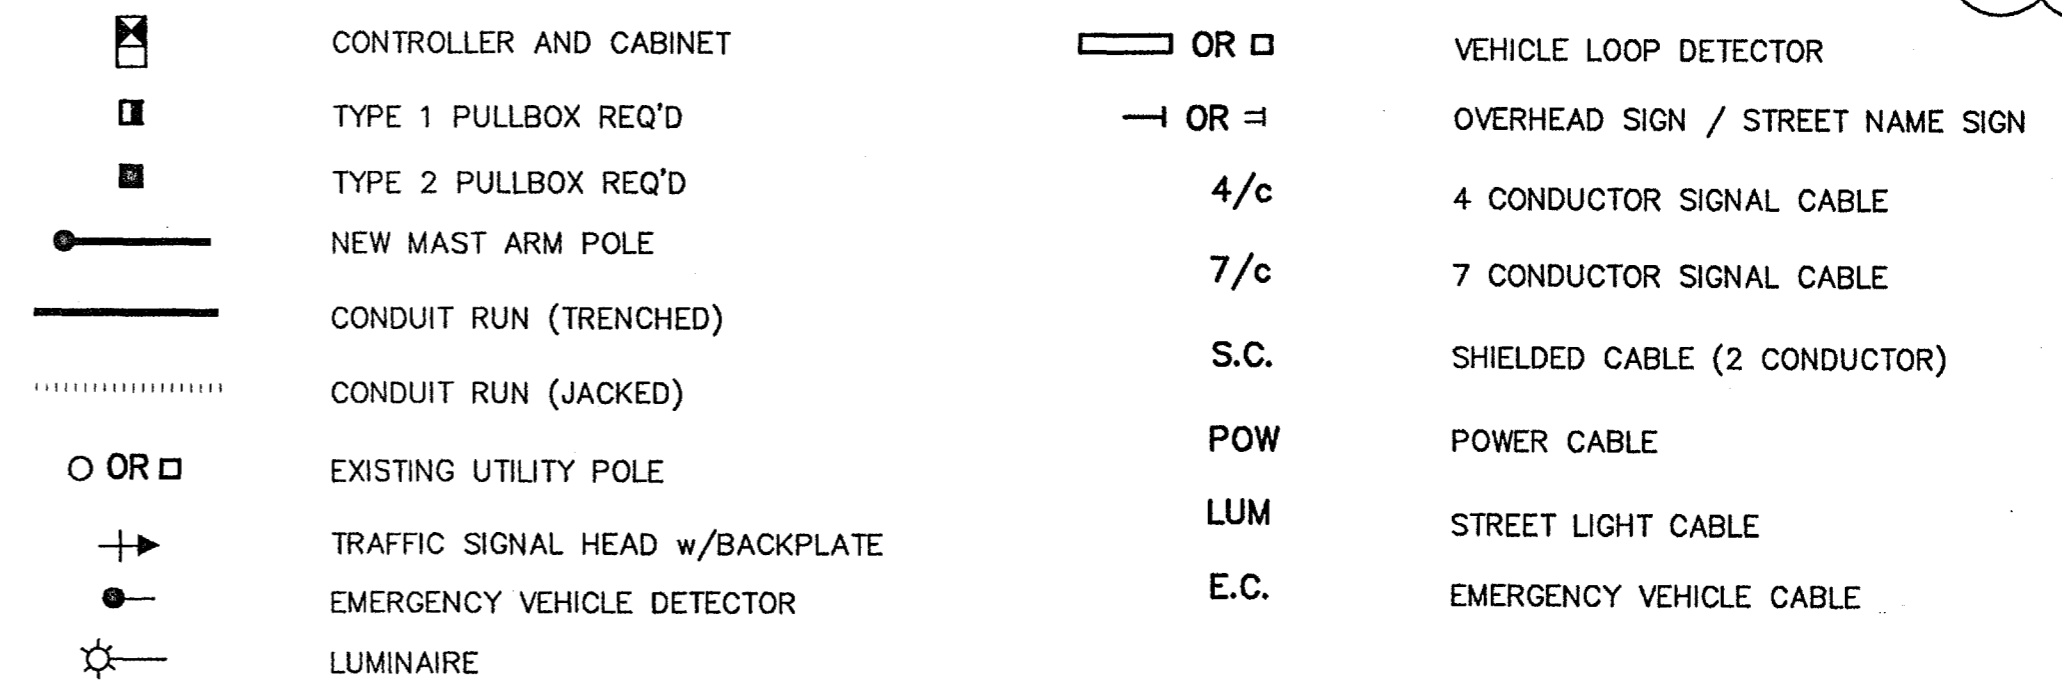

Record Drawings
1-8-08