


UTILITIES LAYOUT  
 BY  
 BARTER F. WADDE ENGINEERS  
 CONSULTANTS  
 JACKSON, MISS.  
 7-67

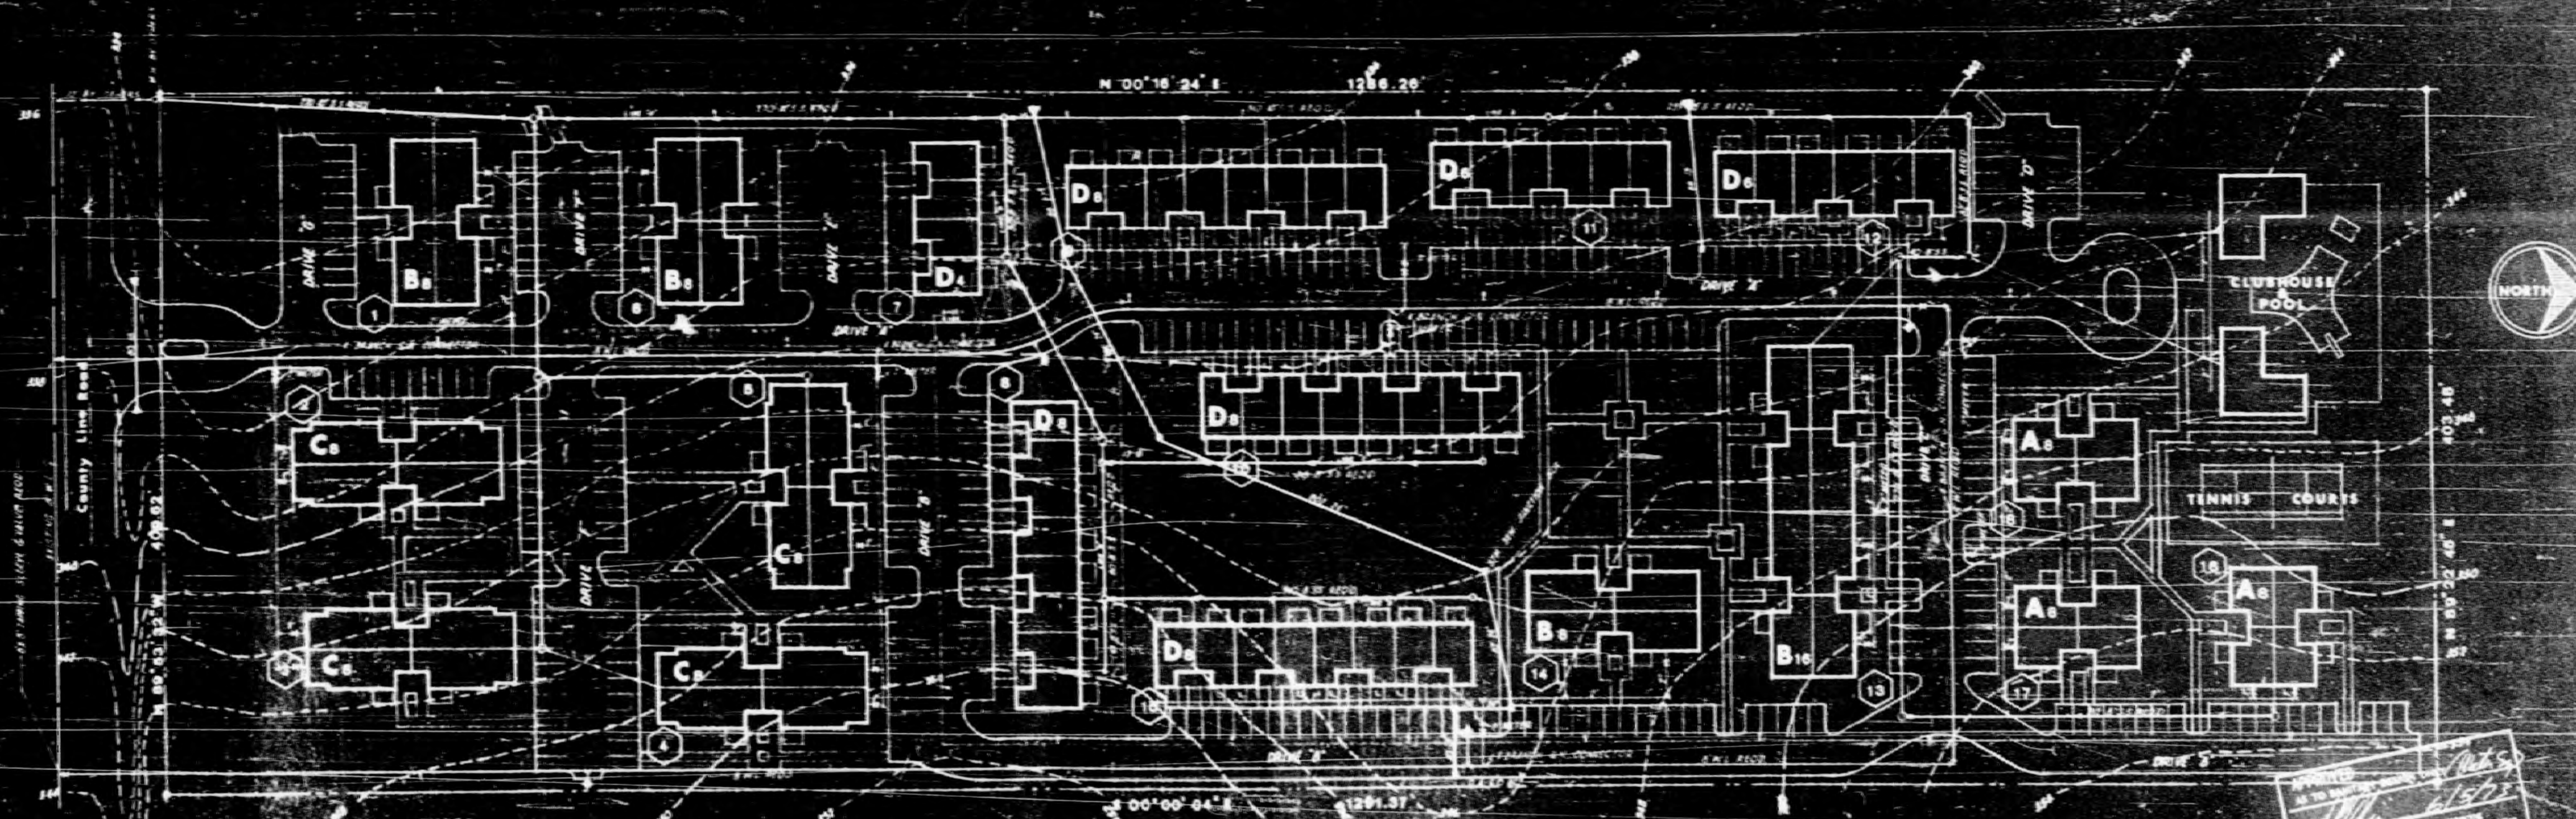

# SITE PLAN

SCALE 1" = 30'

LEGEND  
 UNIT type  
 A no of units  
 in the bldg.

UNIT TYPES	
A	ONE BR FLAT 24
B	TWO BR FLAT 40
C	THREE BR FLAT 32
D	THREE BR TOWNHOUSE 48
TOTAL NO. OF UNITS 144	

TOTAL LAND AREA	12.03
NO. OF UNITS PER ACRE	12
NO. OF PARKING SPACES	2 per unit

2110

F 11

NO.	REVISIONS	DATE	BY
1			
2			
3			
4			
5			
6			
7			



CHRISTIE DEVELOPERS  
 SUITE 400  
 1 PERIMETER WAY  
 ATLANTA, GEORGIA 30309

PROJECT  
**HICKORY KNOLL APARTMENTS**  
 COUNTY LINE ROAD  
 MADISON COUNTY, MISS.  
 ARCHITECT  
**LEROY W. VANDER**  
 1111 BOWWELL ROAD, S.E.  
 ATLANTA, GEORGIA 30316

SITE PLAN	
DRAWN BY HEWELL	SHEET NO.
DATE 1-26-73	
CHECKED BY	
JOB NO. 7220	<b>SITE-1</b>