


CONTRACT DRAWINGS
FOR
**HIGHLAND COLONY
BUSINESS PARK**
PHASE ONE
STREETS, DRAINAGE, SANITARY SEWER & WATER SYSTEM

9-17-98 These Plans provided by MR. Phillip Browning.
Final plat not yet filed.

INDEX TO DRAWINGS

Cover Sheet	1
General Layout	2
Drainage Layout & Stormwater Pollution Plan	3
Plan Profile Sheets	4 - 9
Water Details	10
Sewer Details	11
Drainage Details	12
Box Culvert Details	13 - 14

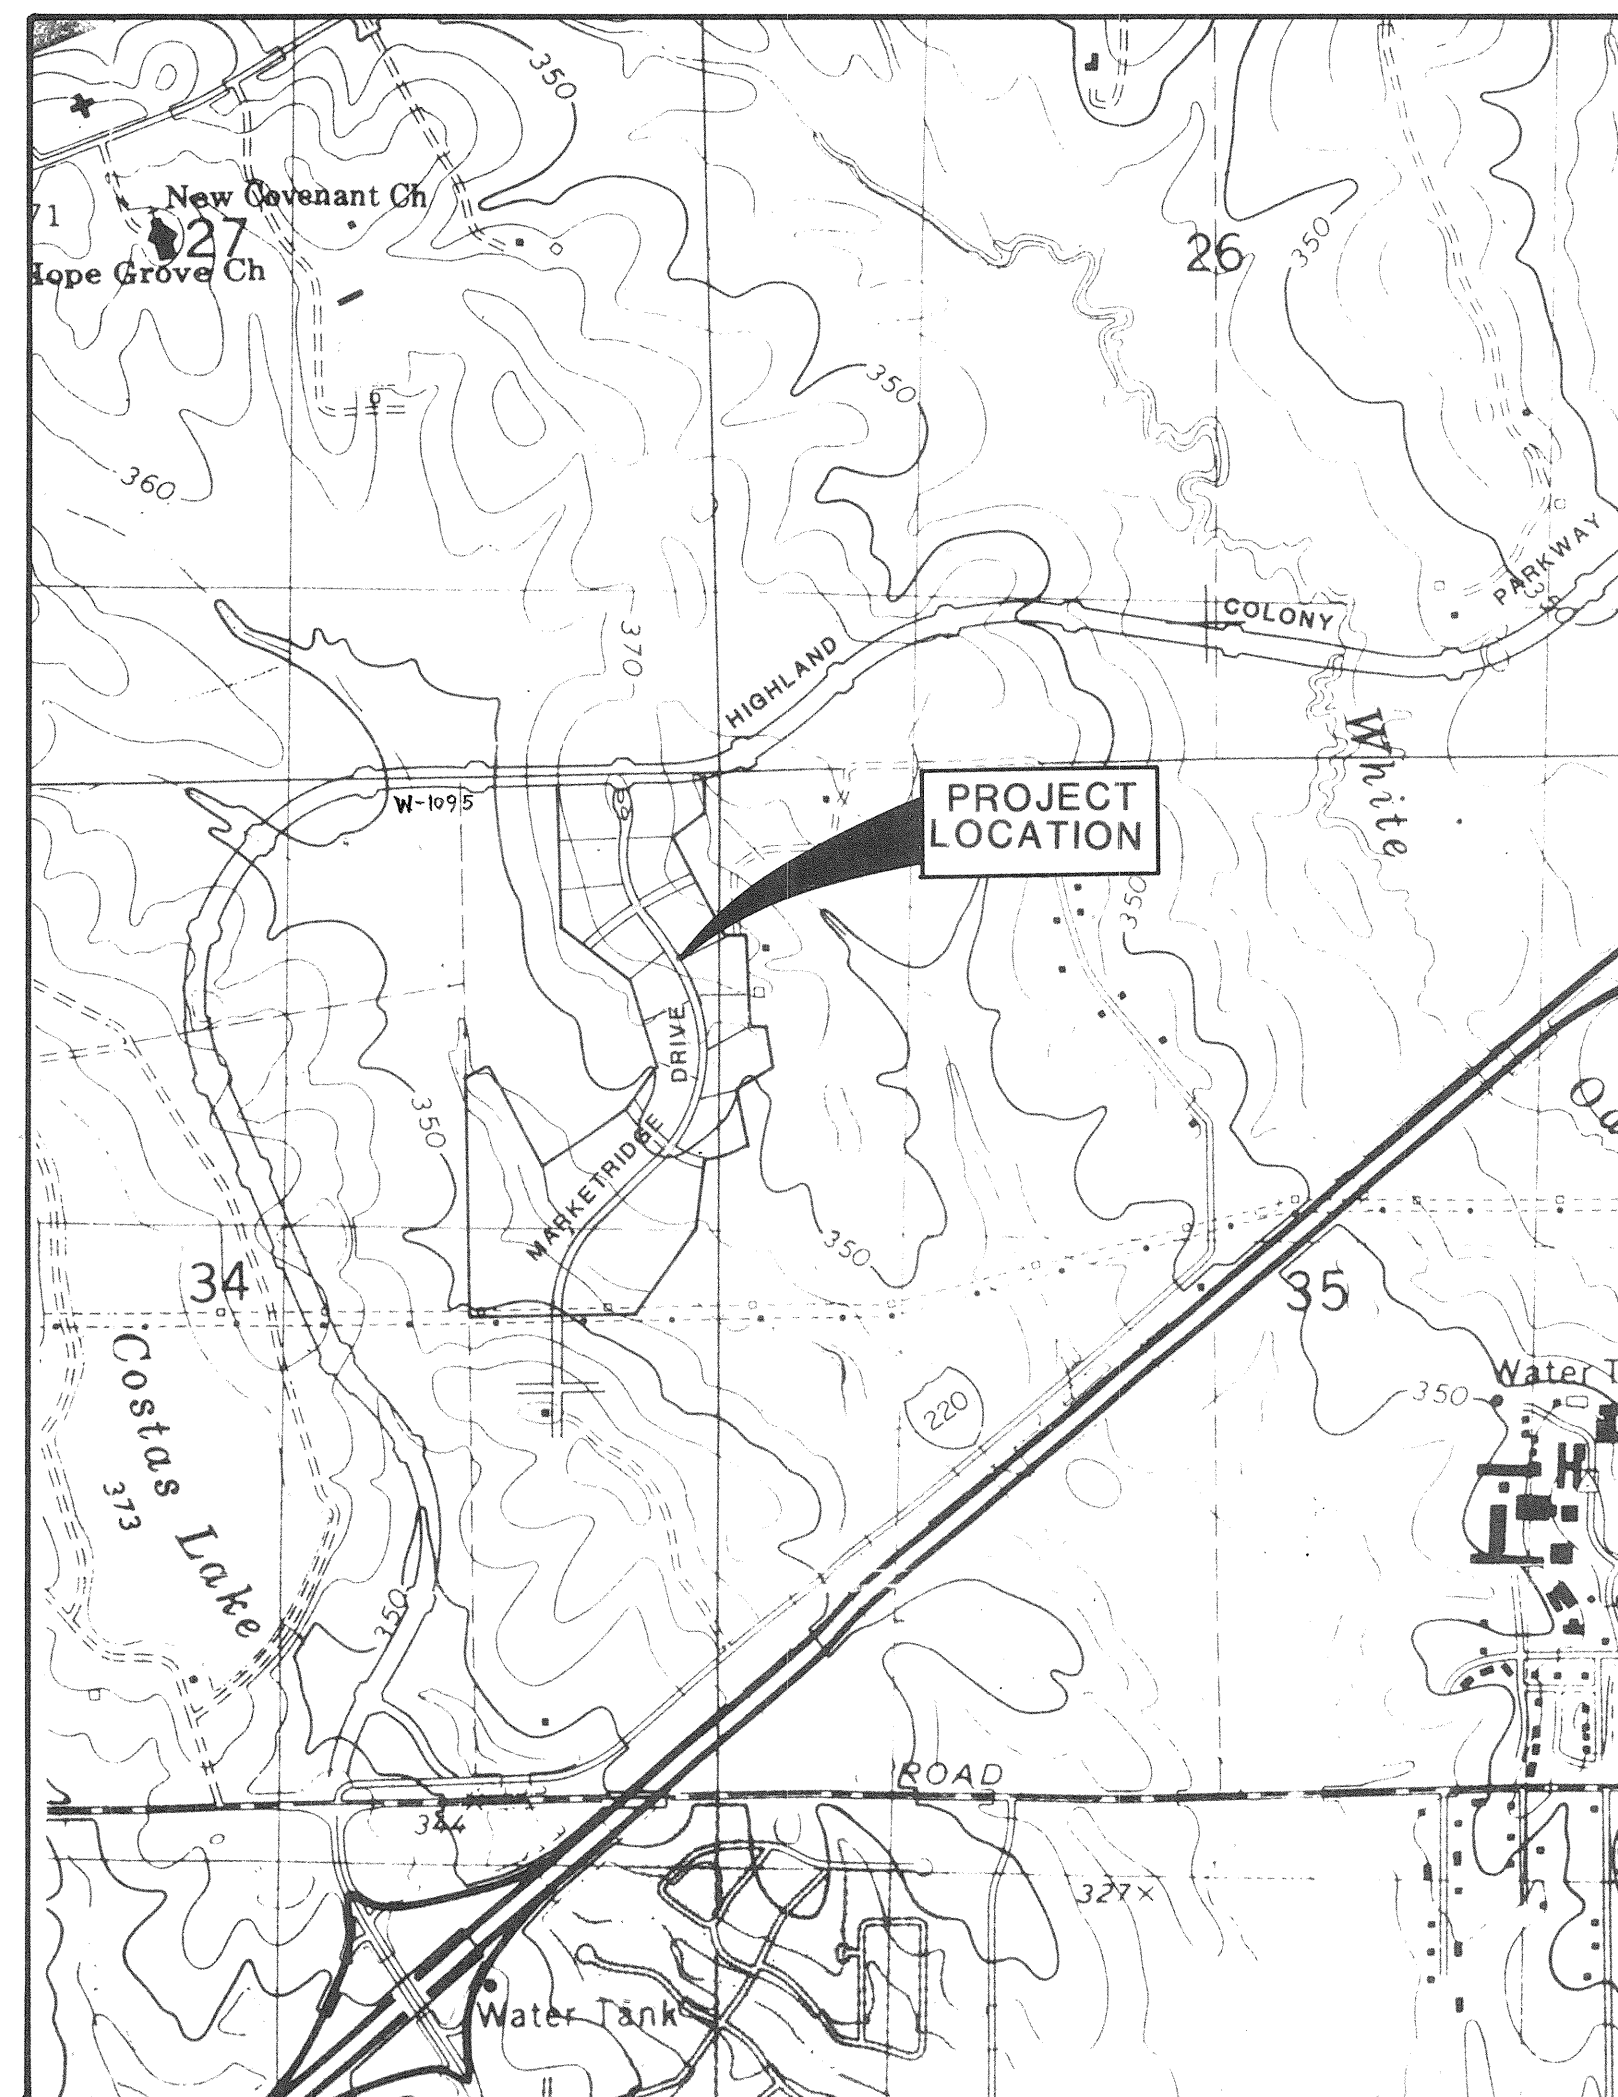




VICINITY MAP

Item	Estimated Quantity	Unit
<u>STREETS AND DRAINAGE</u>		
Clearing and Grubbing	3.3	AC
Excavation - Common	16,000	CY
Street Undercut/On-Site Backfill	500	CY
Embankment	15,900	CY
Sub-Base Preparation	14,000	SY
3" Black Base	14,000	SY
1 1/2" Surface Course	14,000	SY
Concrete Curb and Gutter	9,502	LF
Curb Inlets	10	EA
15" RCP	633	LF
18" RCP	368	LF
24" RCP	280	LF
<u>WATER DISTRIBUTION SYSTEM</u>		
Connection to Existing Water Main	2	EA
12" PVC Water Main, C-900, Class 150	4,875	LF
12" Gate Valve W/Box	8	EA
6" Gate Valve W/Box	1	EA
6" Fire Hydrant W/Valve and Tee	6	EA
8" Plug	1	EA
Service Assembly	17	EA
1" Service Line	850	LF
Service Markers	17	EA
12" X 12" X 12" Cross	2	EA
<u>SANITARY SEWER</u>		
Connection to Existing Manhole	1	EA
48" Manhole (10'-12')	1	EA
8" Gravity Sewer (10'-12')	310	LF
8" Gravity Sewer (6'-8')	1,858	LF
8" Gravity Sewer (8'-10')	853	LF
48" Manhole (8'-10')	4	EA
48" Manhole (6'-8')	3	EA
Undercut and Select Backfill	500	CY
Service Tee	17	EA
Service Line	1,190	LF
Service Markers	17	EA
8" Gravity Sewer (12'-14')	699	LF
8" Gravity Sewer (14'-16')	342	LF
48" Drop Manhole (14'-16')	1	EA
<u>GRASS PLANTING</u>		
Seeding	6.5	AC
<u>STORMWATER POLLUTION PREVENTION</u>		
Stormwater Pollution Prevention	1	LS

See Also Q-1648 (s)




ASBUILTS
DECEMBER, 1996

W-1077

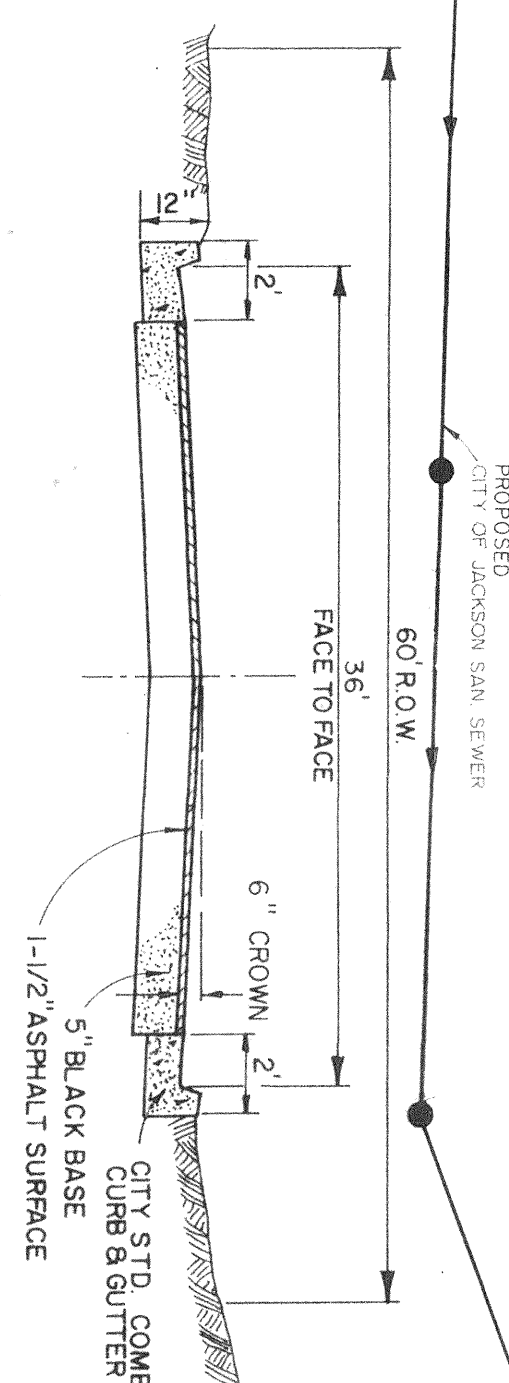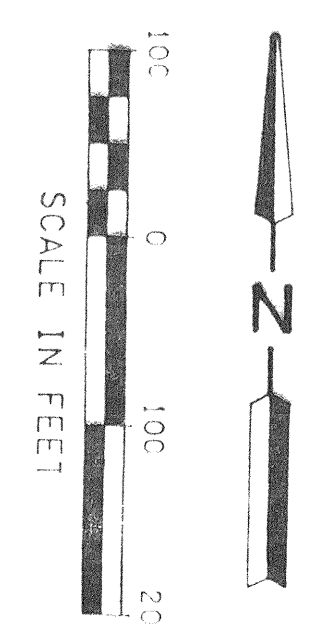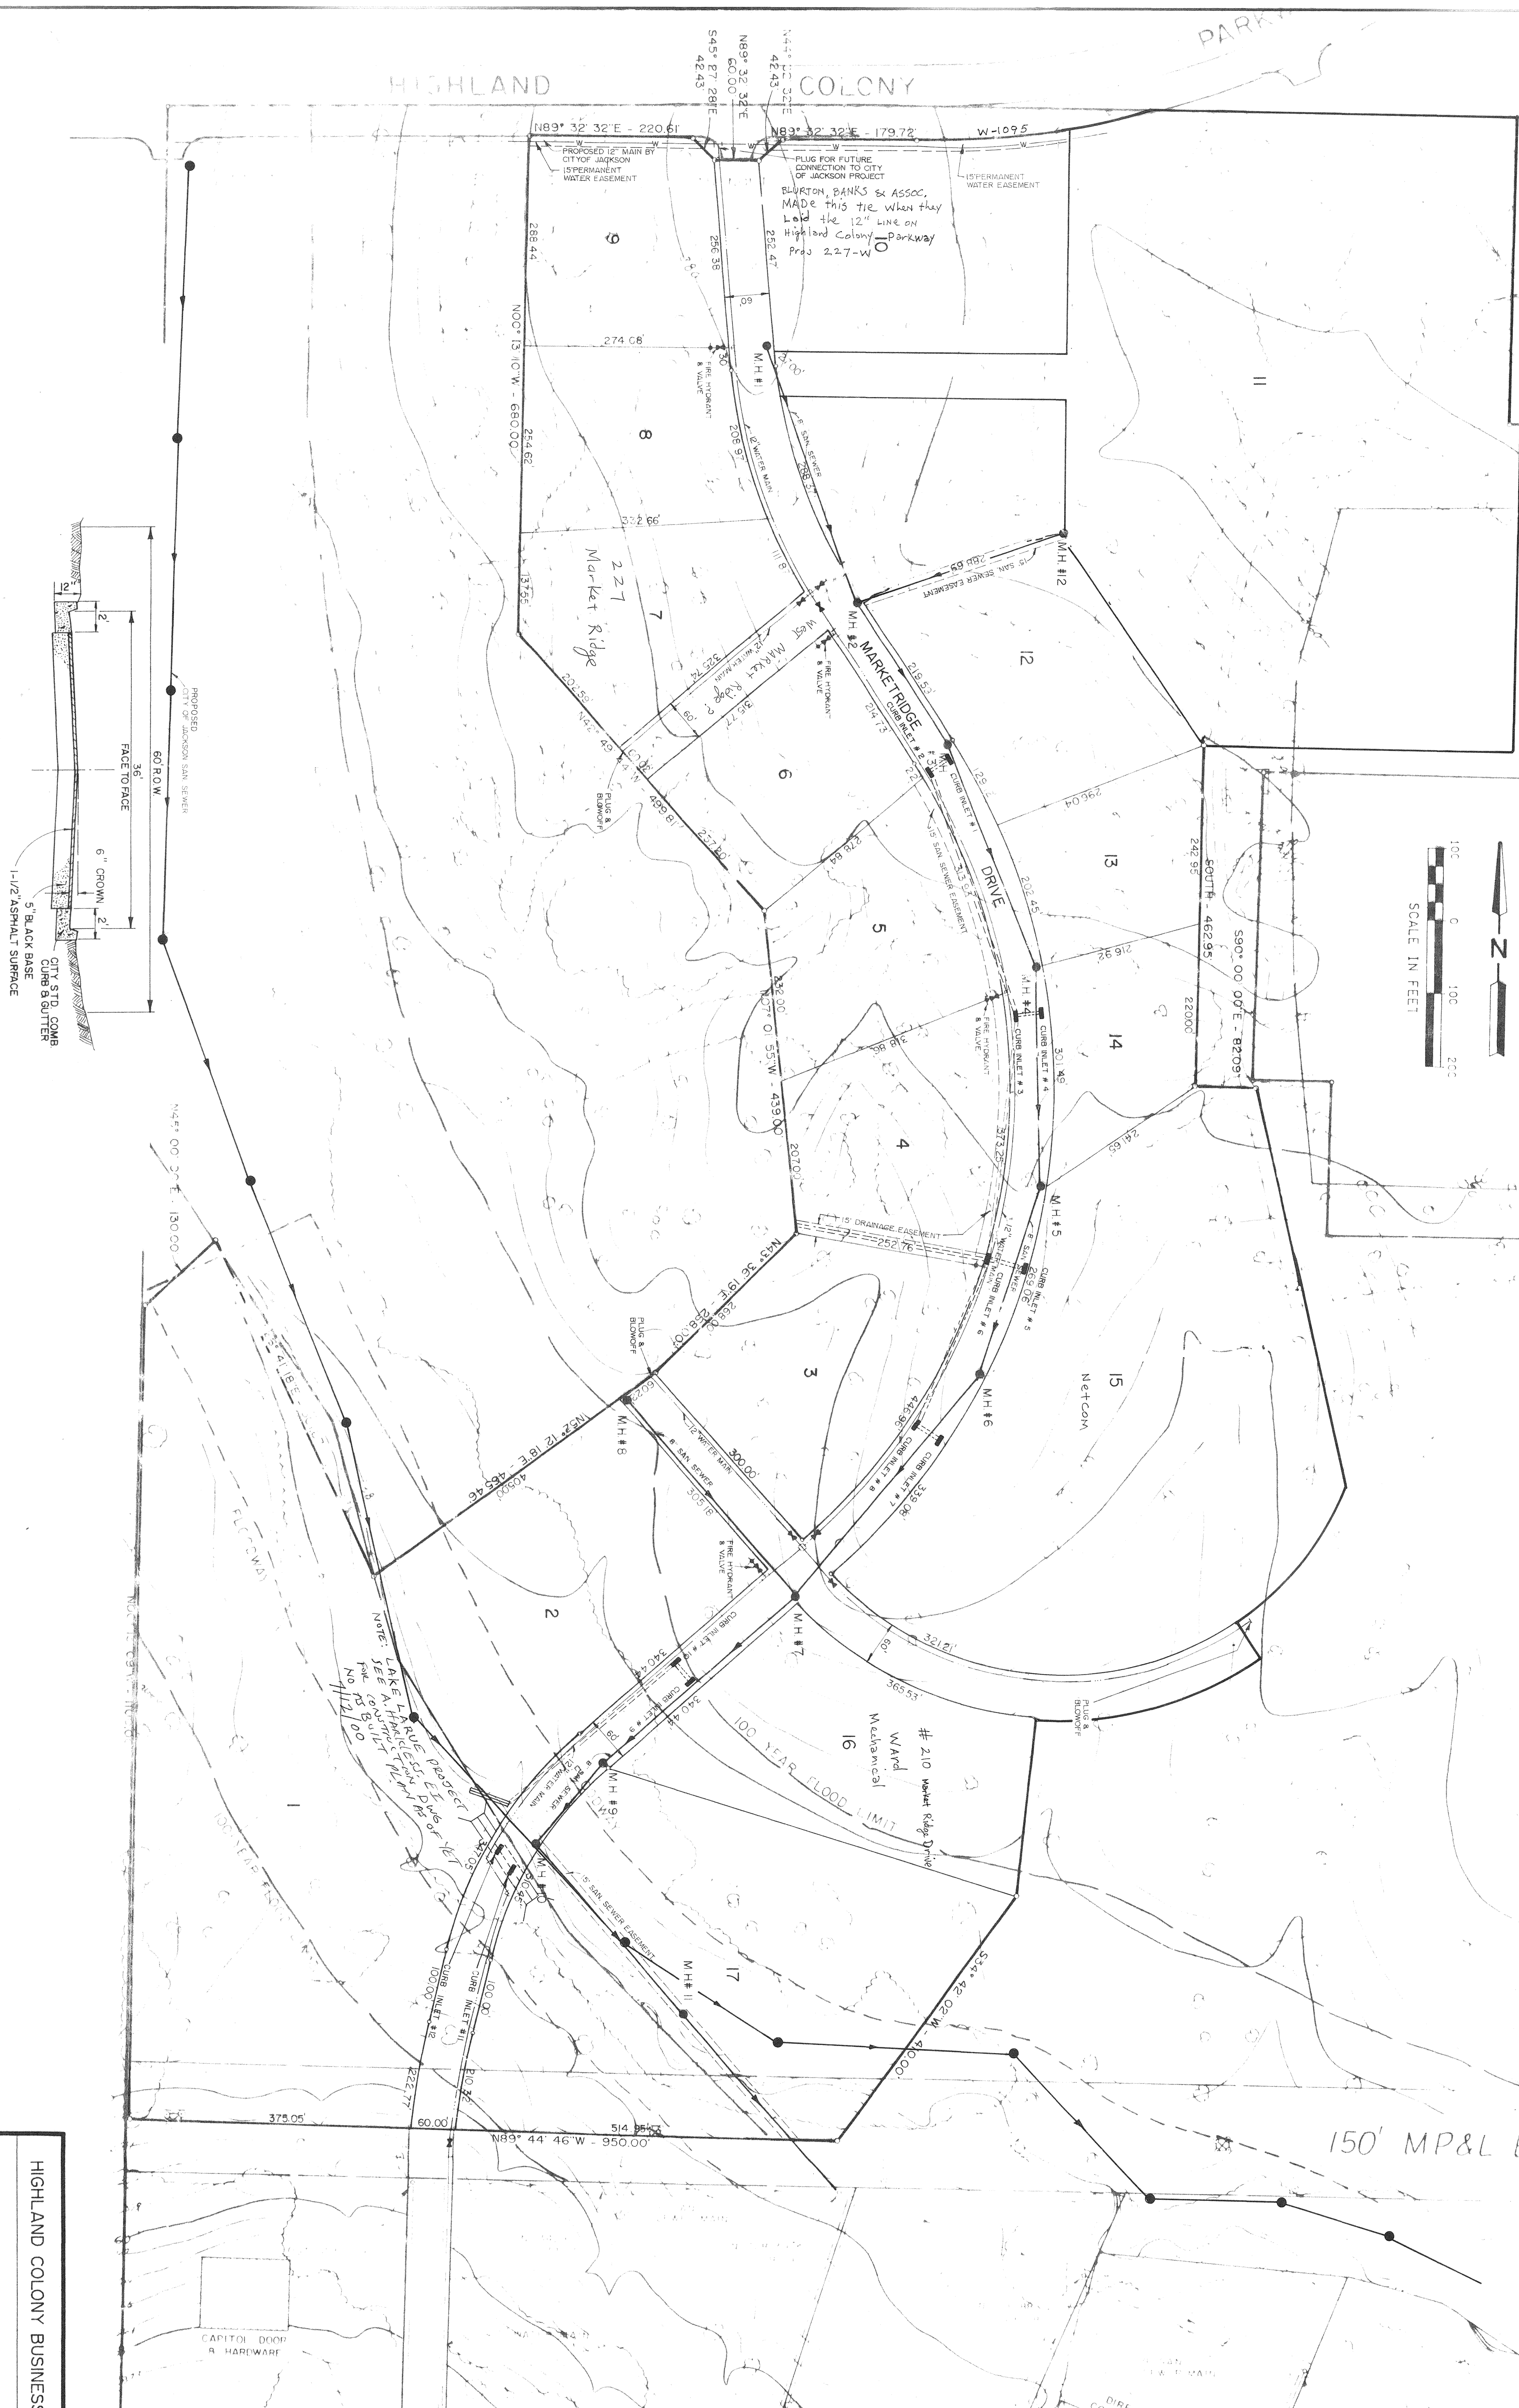


HIGHLAND COLONY BUSINESS PARK GENERAL LAYOUT	
DESIGNED BY P.L.B. CONSULTING ENGINEERS JACKSON, MISSISSIPPI	BROWNING INC. SCALE 1" = 100' DATE AUG. 1995
SHEET 2 OF 14	

W-1077

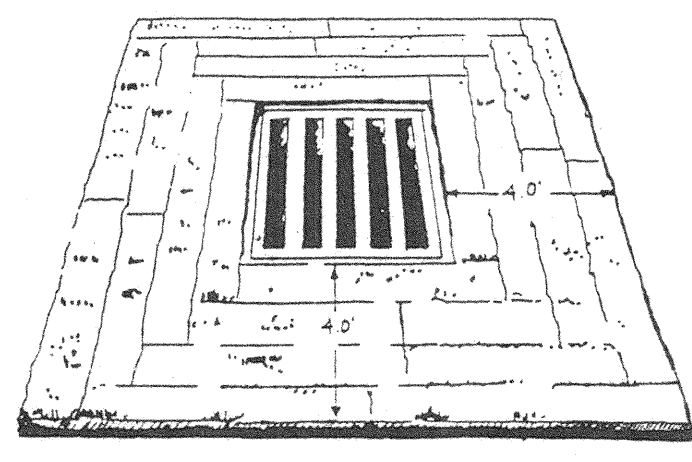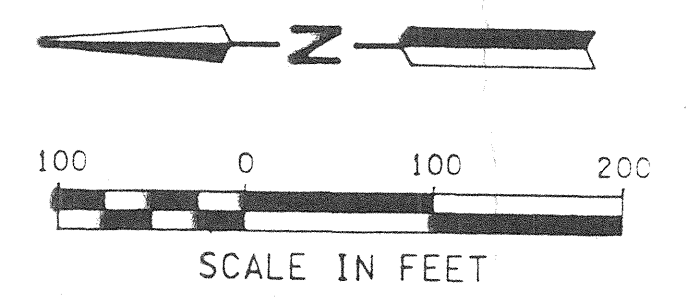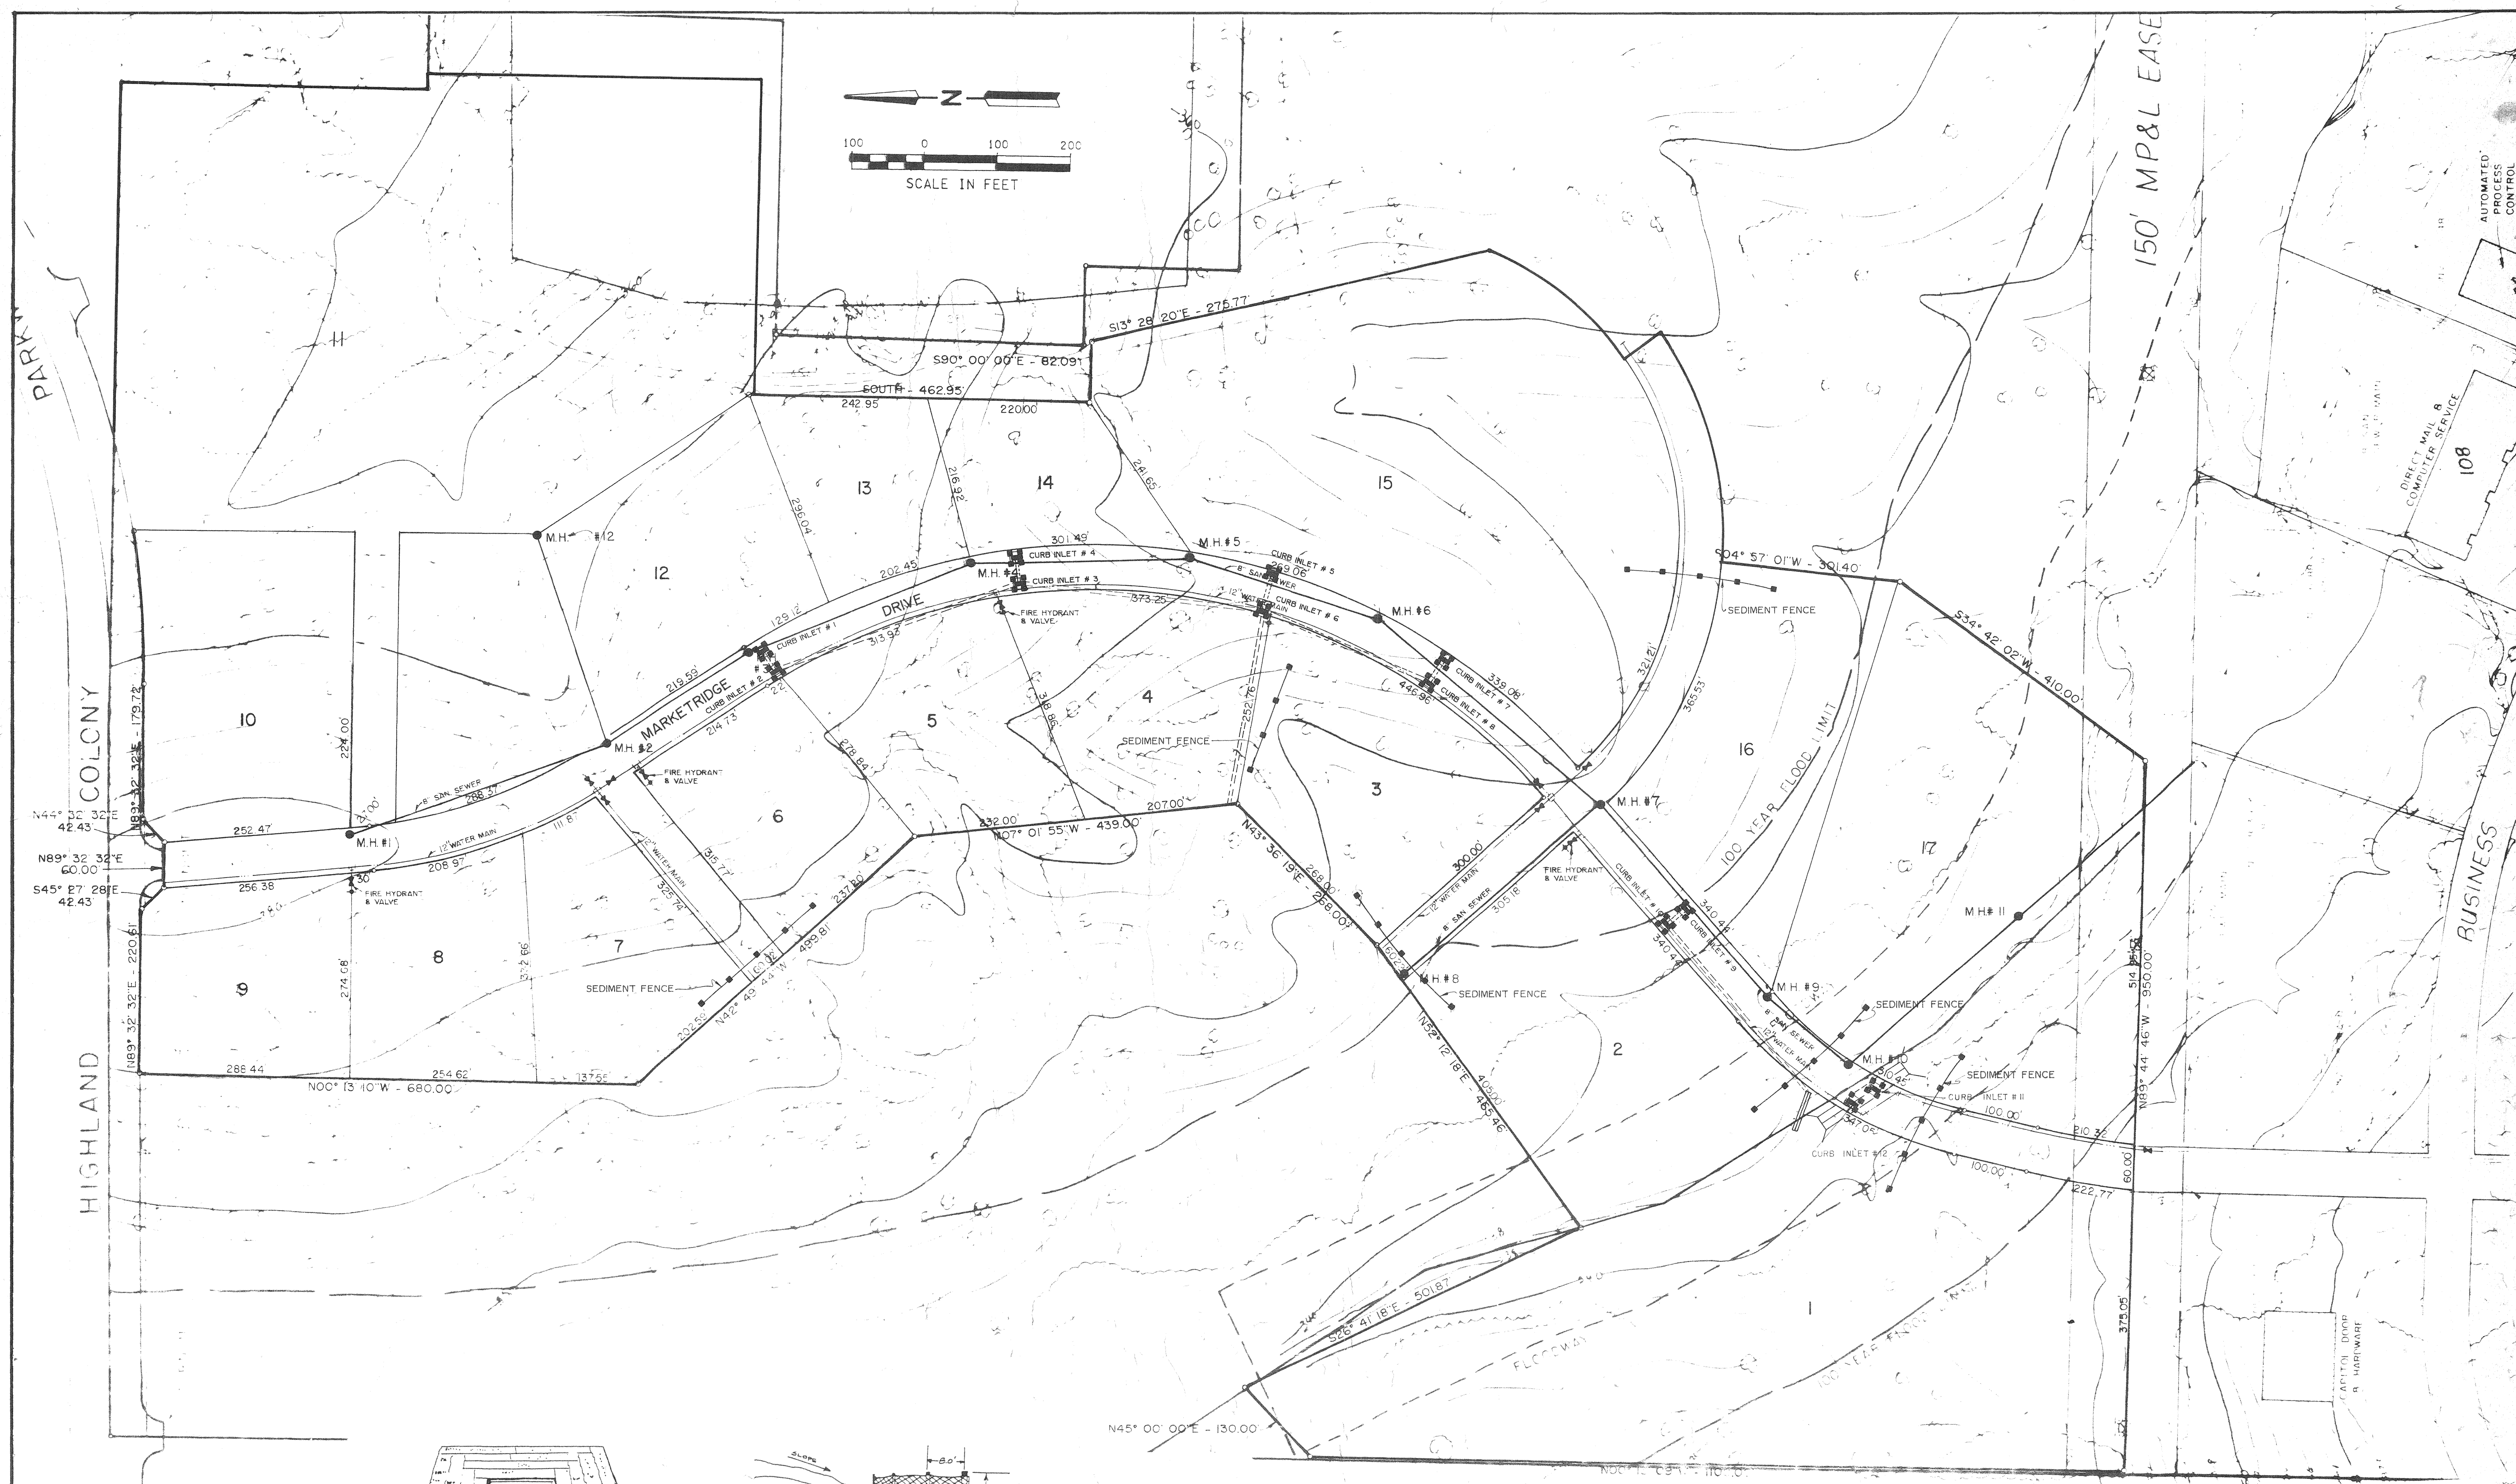

TYPICAL STORM DRAIN INLET PROTECTION

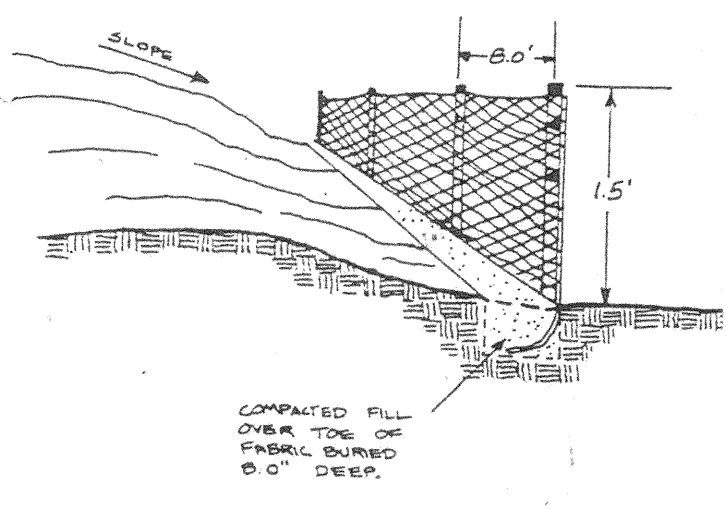

TYPICAL SEDIMENT FENCE INSTALLATION

- LEGEND**
- Sediment Fence
 - Storm Drain Inlet Protection
 - Rip-Rap As Req'd

W-1077

HIGHLAND COLONY BUSINESS PARK		
DRAINAGE LAYOUT AND STORMWATER POLLUTION PREVENTION PLAN		
BROWNING INC. CONSULTING ENGINEERS JACKSON, MISSISSIPPI		
DESIGNED BY P.L.B.	SCALE 1" = 100'	SHEET 3 OF 14
DRAWN BY J.F.	DATE AUG, 1995	

PLAN	SURVEYED	DATE
	PLOTTED	BY
	NOTE BOOK	ALIGNED CHECKED
		NO. OF WAY CHECKED
		No.

PROFILE	SURVEYED	DATE
	PLOTTED	BY
	NOTE BOOK	ALIGNED CHECKED
		NO. OF WAY CHECKED
		No.

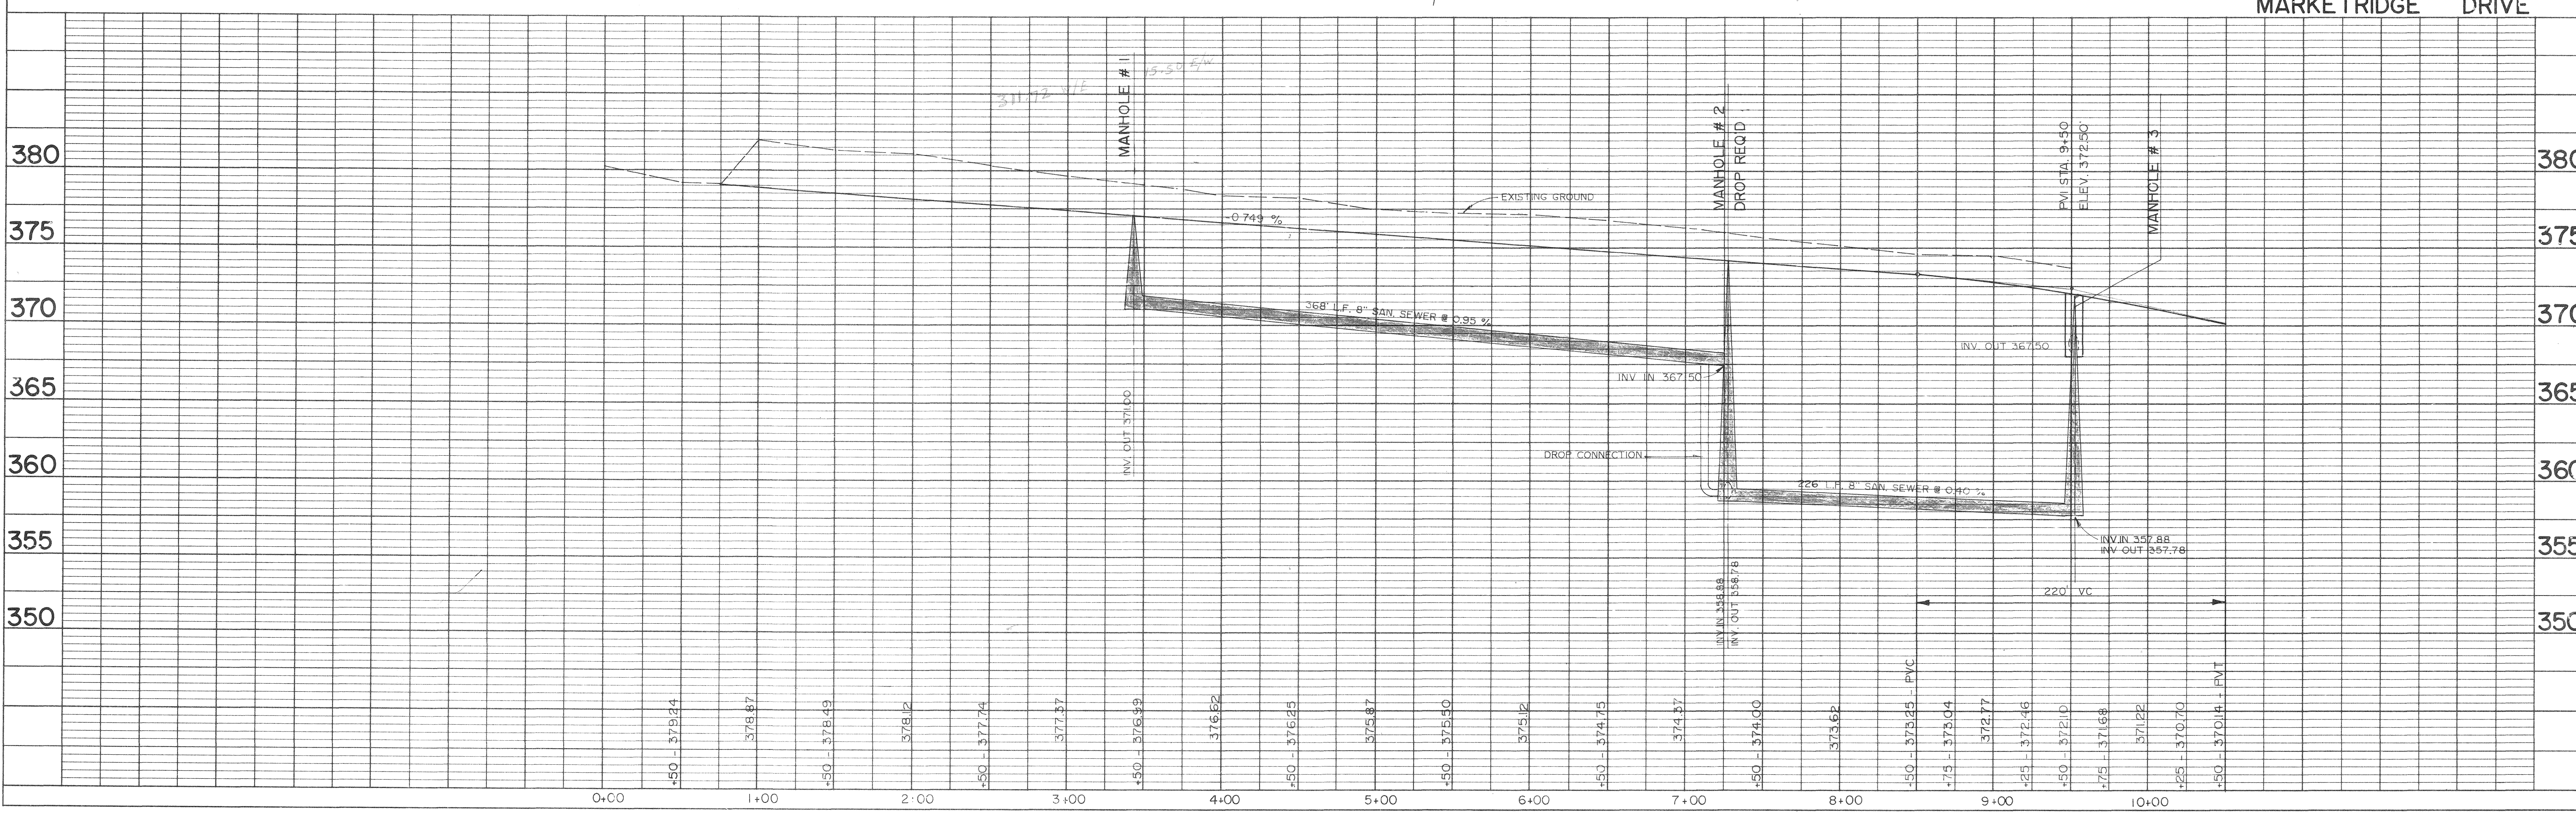
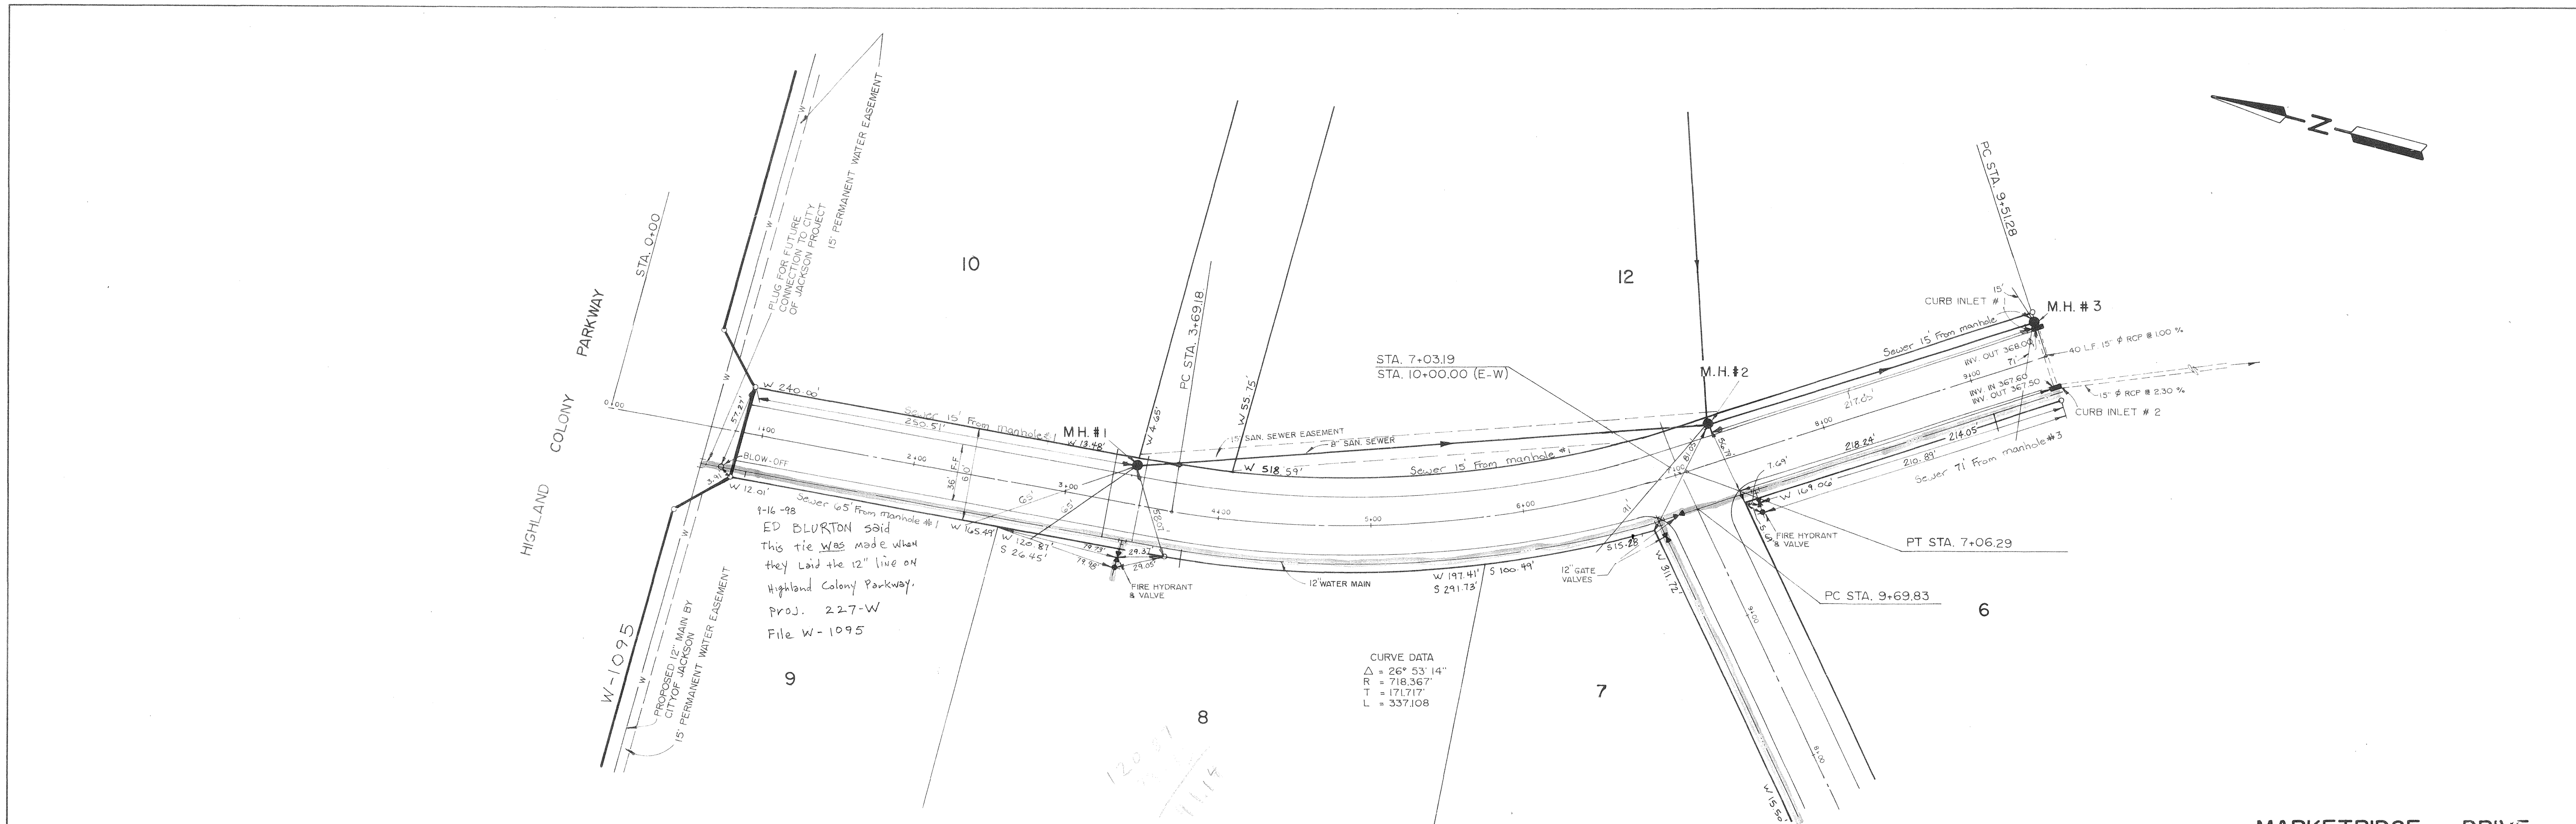


PLATE 1-SINGLE PLAN AND PROFILE-FULL LINE
NATIONAL PRINTFAST
PRINTED IN U.S.A.

W-1077

DATE	
BY	
SURVYD	
PLANN	
NOTE BOOK	
ALIGNMENT CHECKED	
BY	
No.	

DATE	
BY	
SURVYD	
PROFILE	
NOTE BOOK	
STRUCTURE NOTATIONS CHECKED	
BY	
No.	




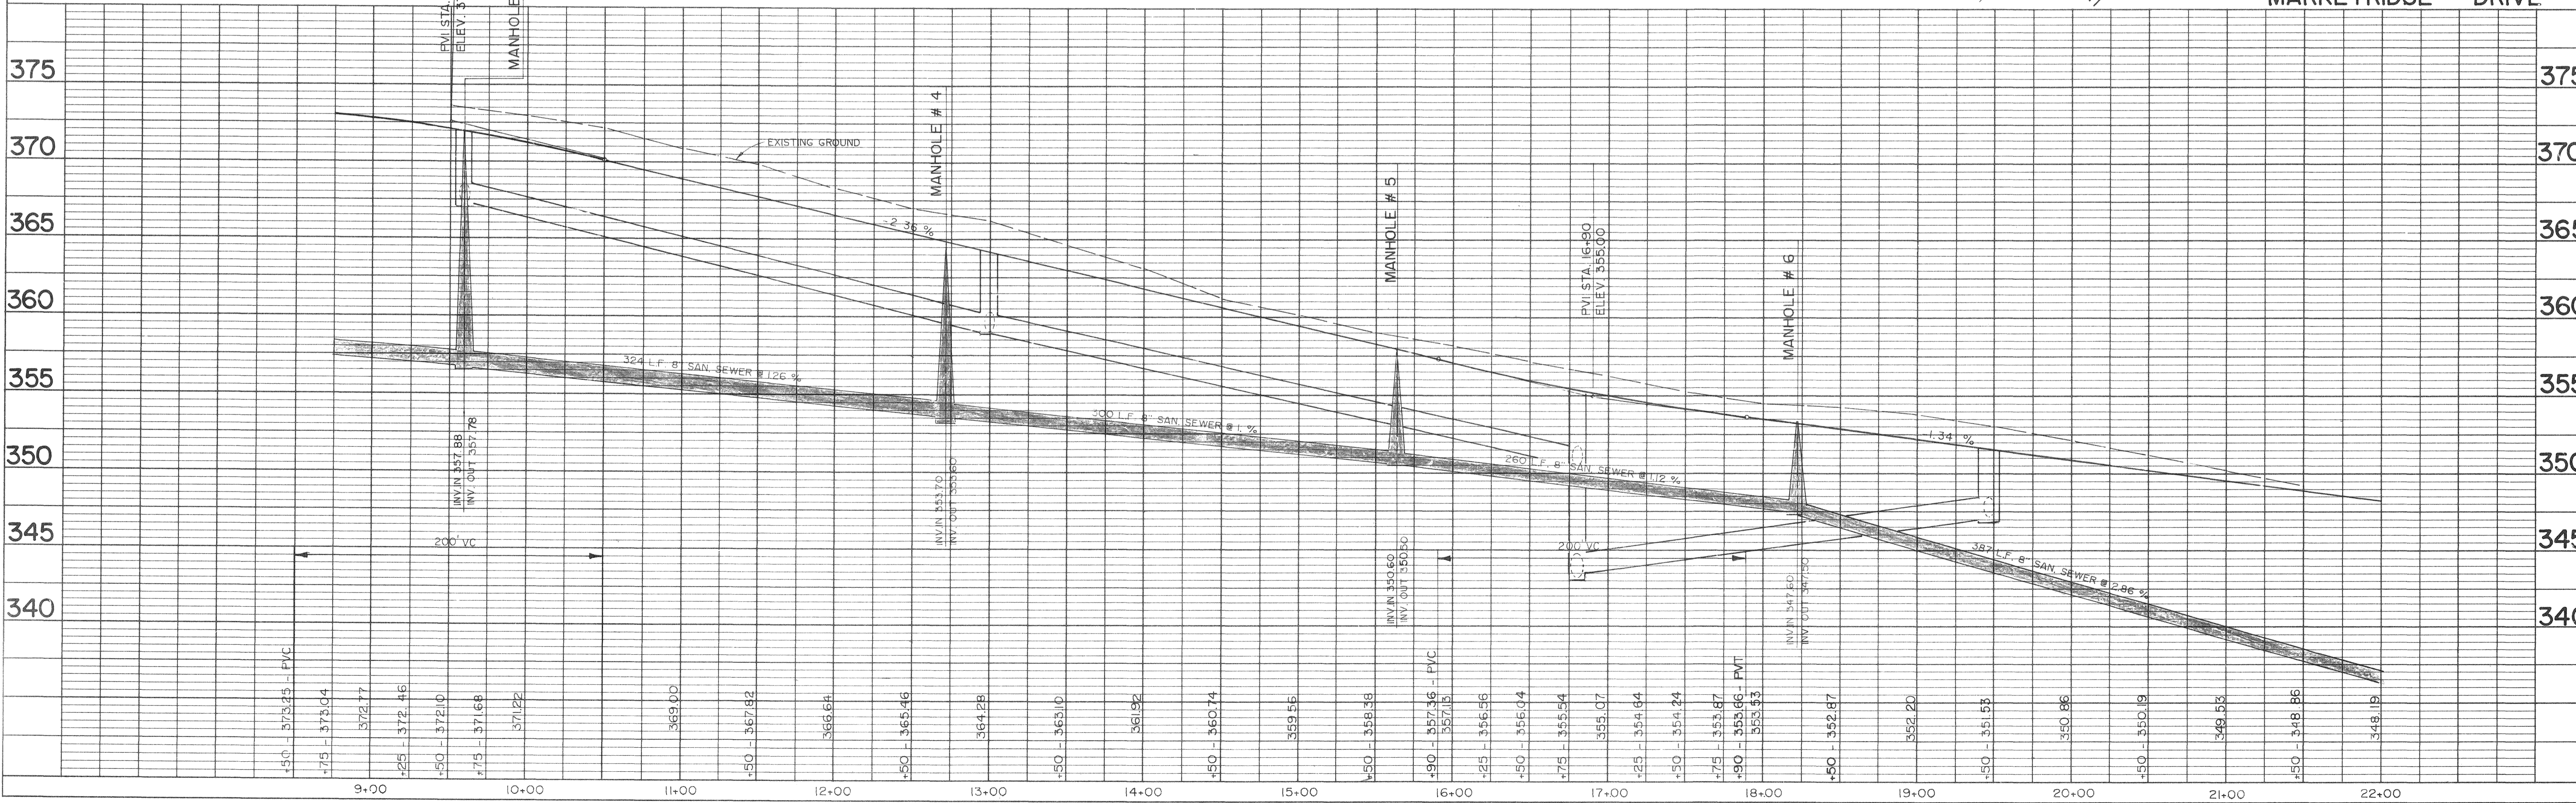


PLATE 1-SINGLE PLAN AND PROFILE-FULL LINE
NATIONAL PRINTING

W-1077

DATE: _____
 BY: _____
 SUBMITTED: _____
 PLAN NOTE BOOK: _____
 ALIGNMENT CHECKED: _____
 RT. OF WAY CHECKED: _____
 No. _____

DATE: _____
 BY: _____
 SURVEYED: _____
 PROFILE PLOTTED: _____
 NOTE BOOK: _____
 GRADES CHECKED: _____
 E. M. V. NOTED: _____
 STRUCTURE DIMENSIONS CHECKED: _____
 No. _____

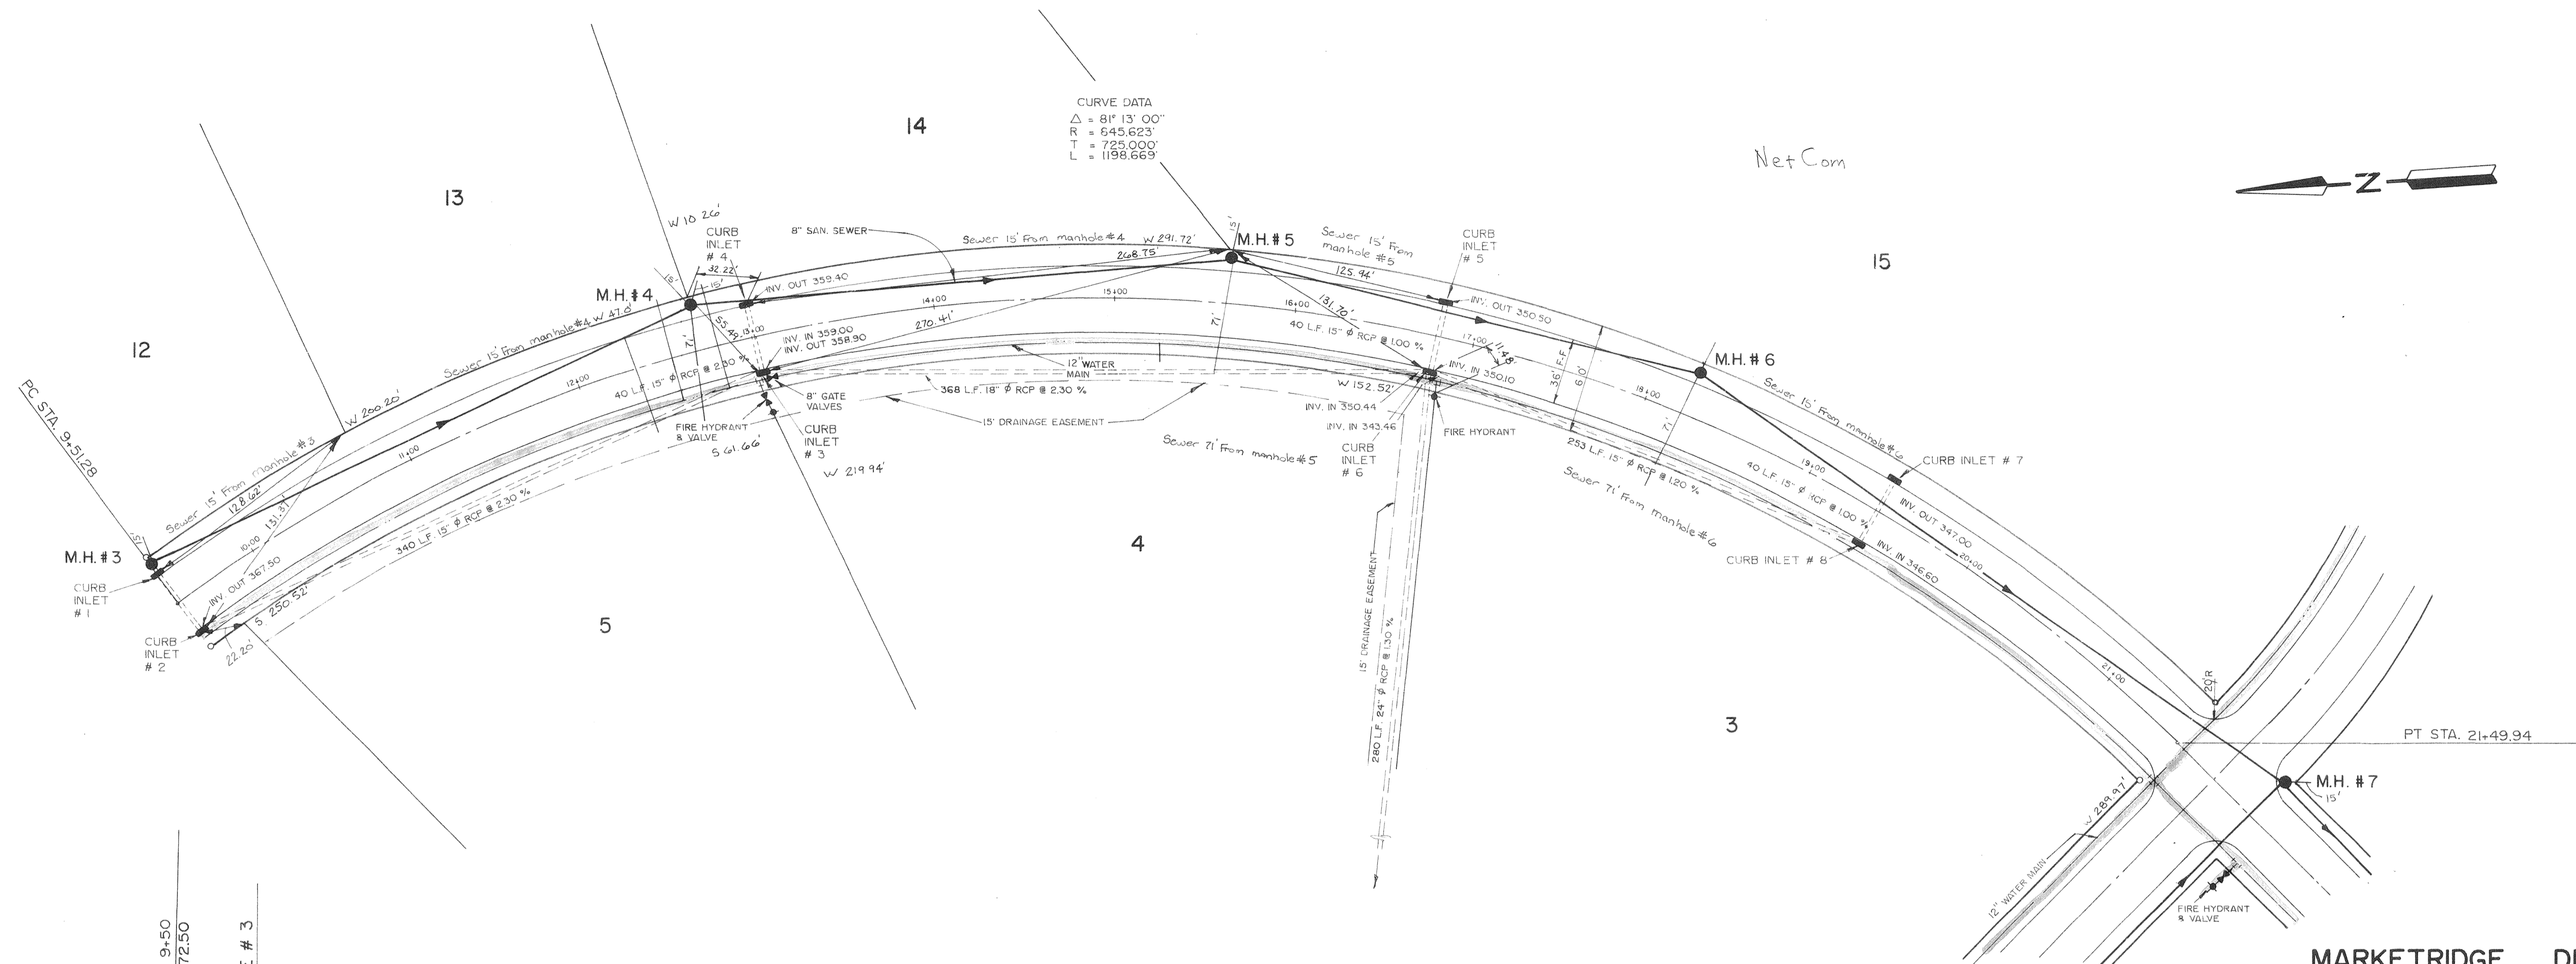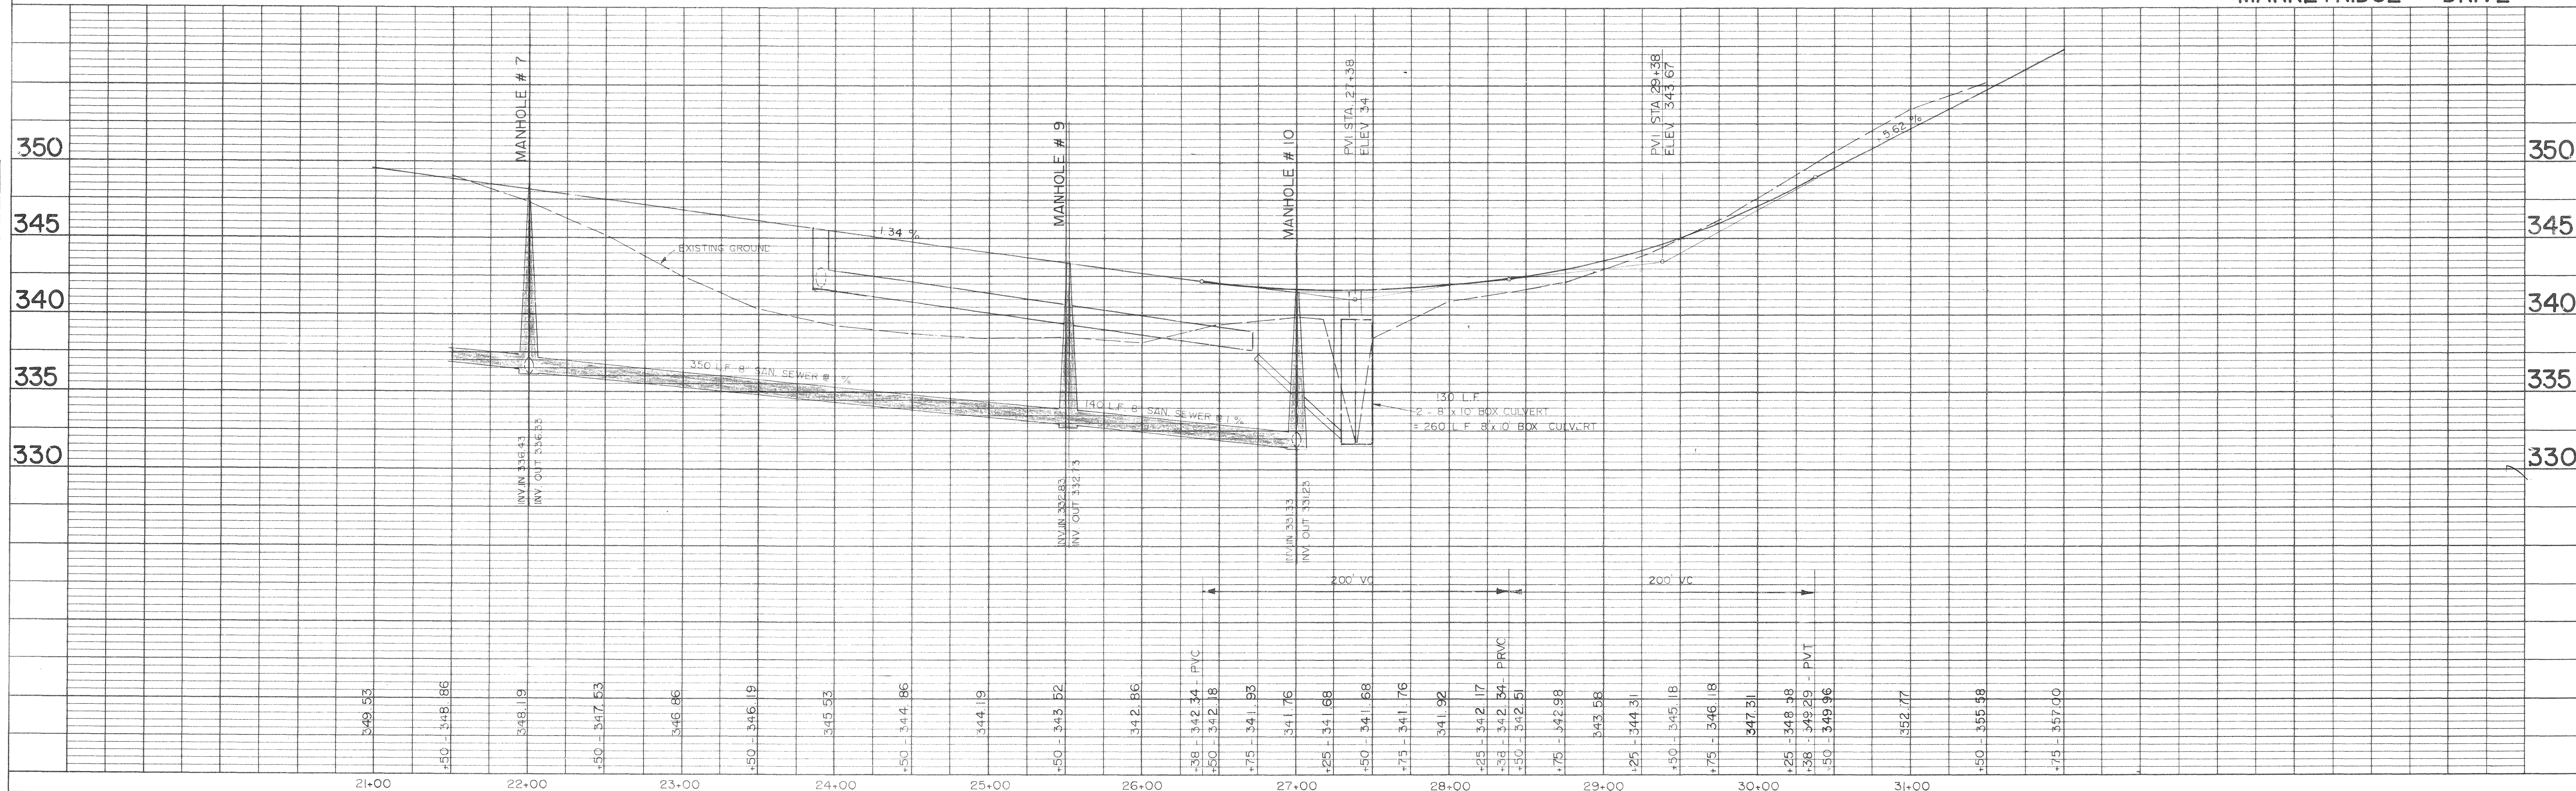
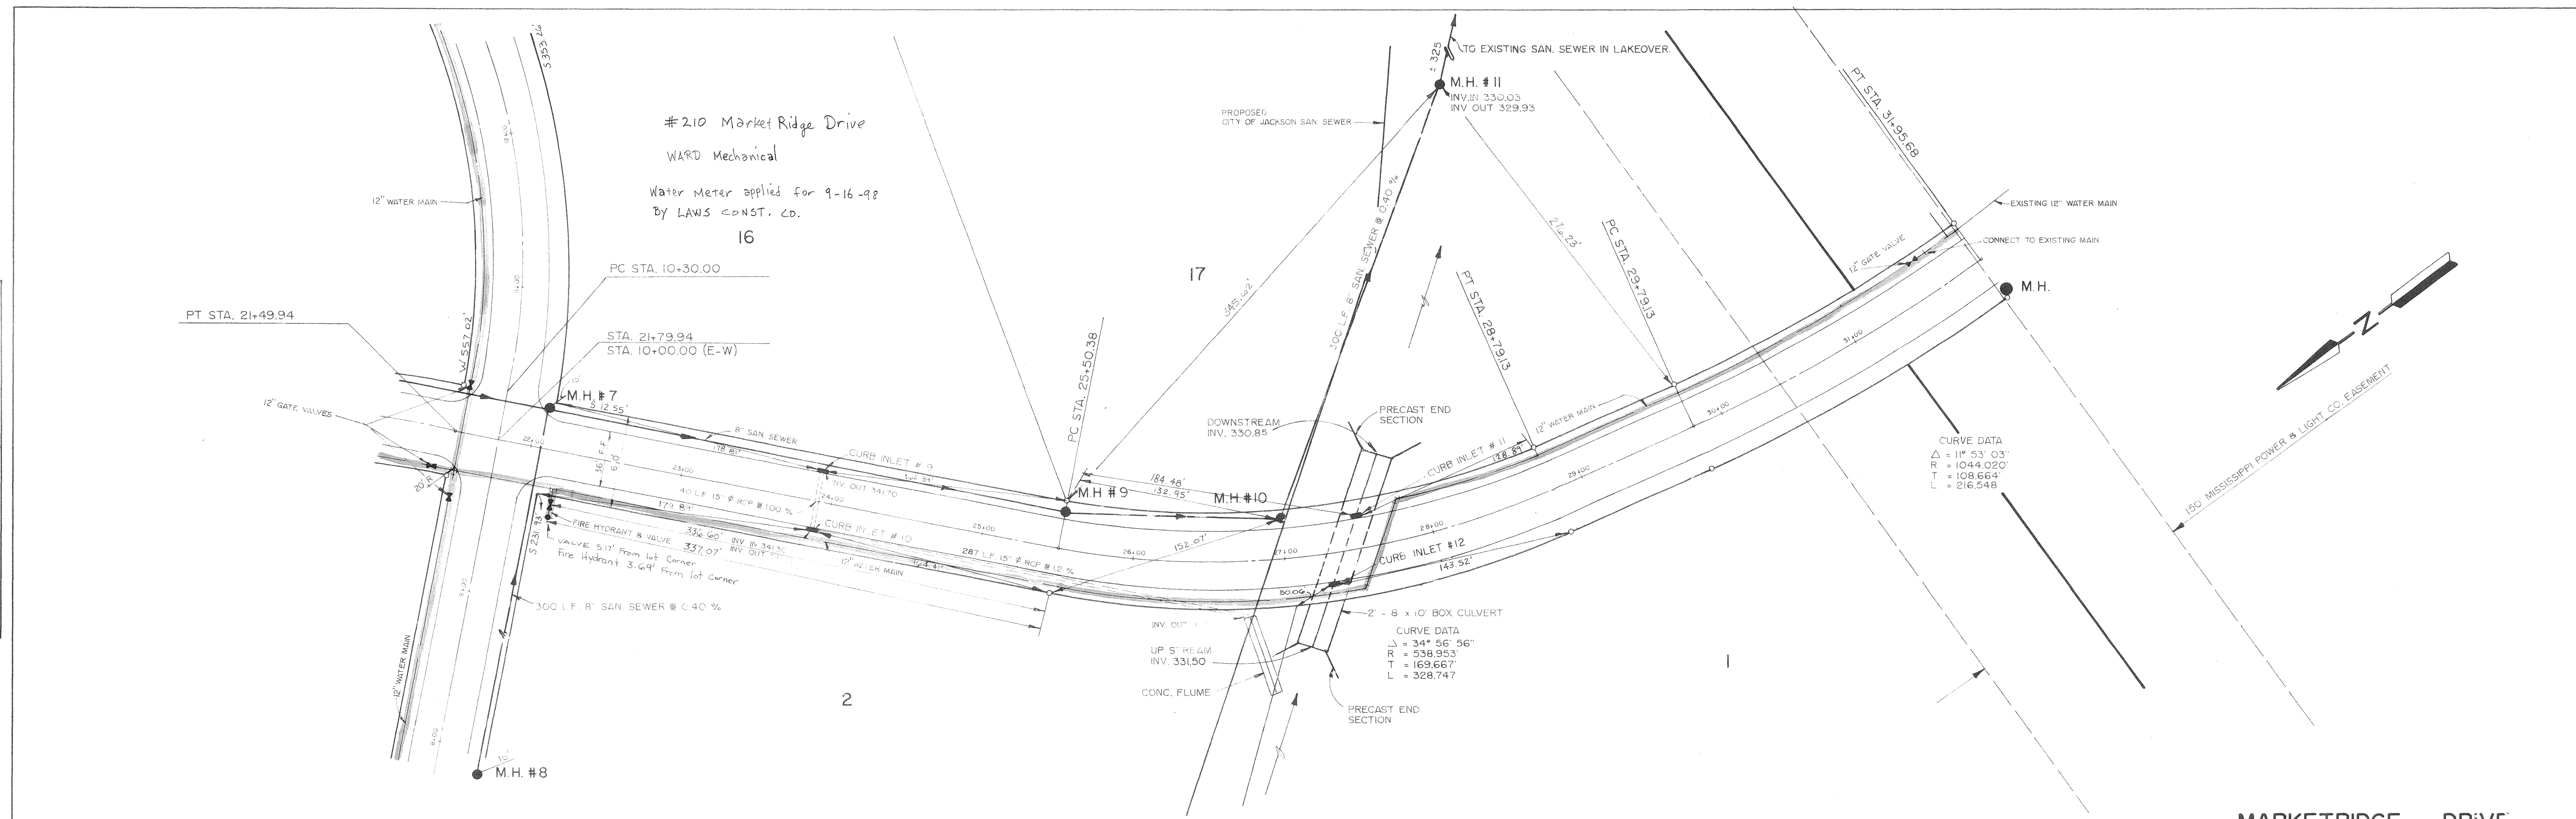


HIGHWAY FEDERAL AID SHEET
 PLATE 1-SINGLE PLAN AND PROFILE-FULL LINE
 NATIONAL PRIVATE
 PRINTED IN U.S.A.


See Q-1648 (3)
 SHEET 6 OF 14

W-1077

PLAN
 SURVEYED _____ DATE _____
 PLOTTED _____ BY _____
 NOTE BOOK _____
 NO. _____
 RT. OF WAY CHECKED _____
 NO. _____

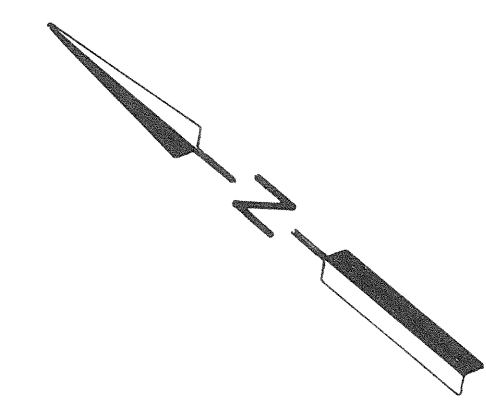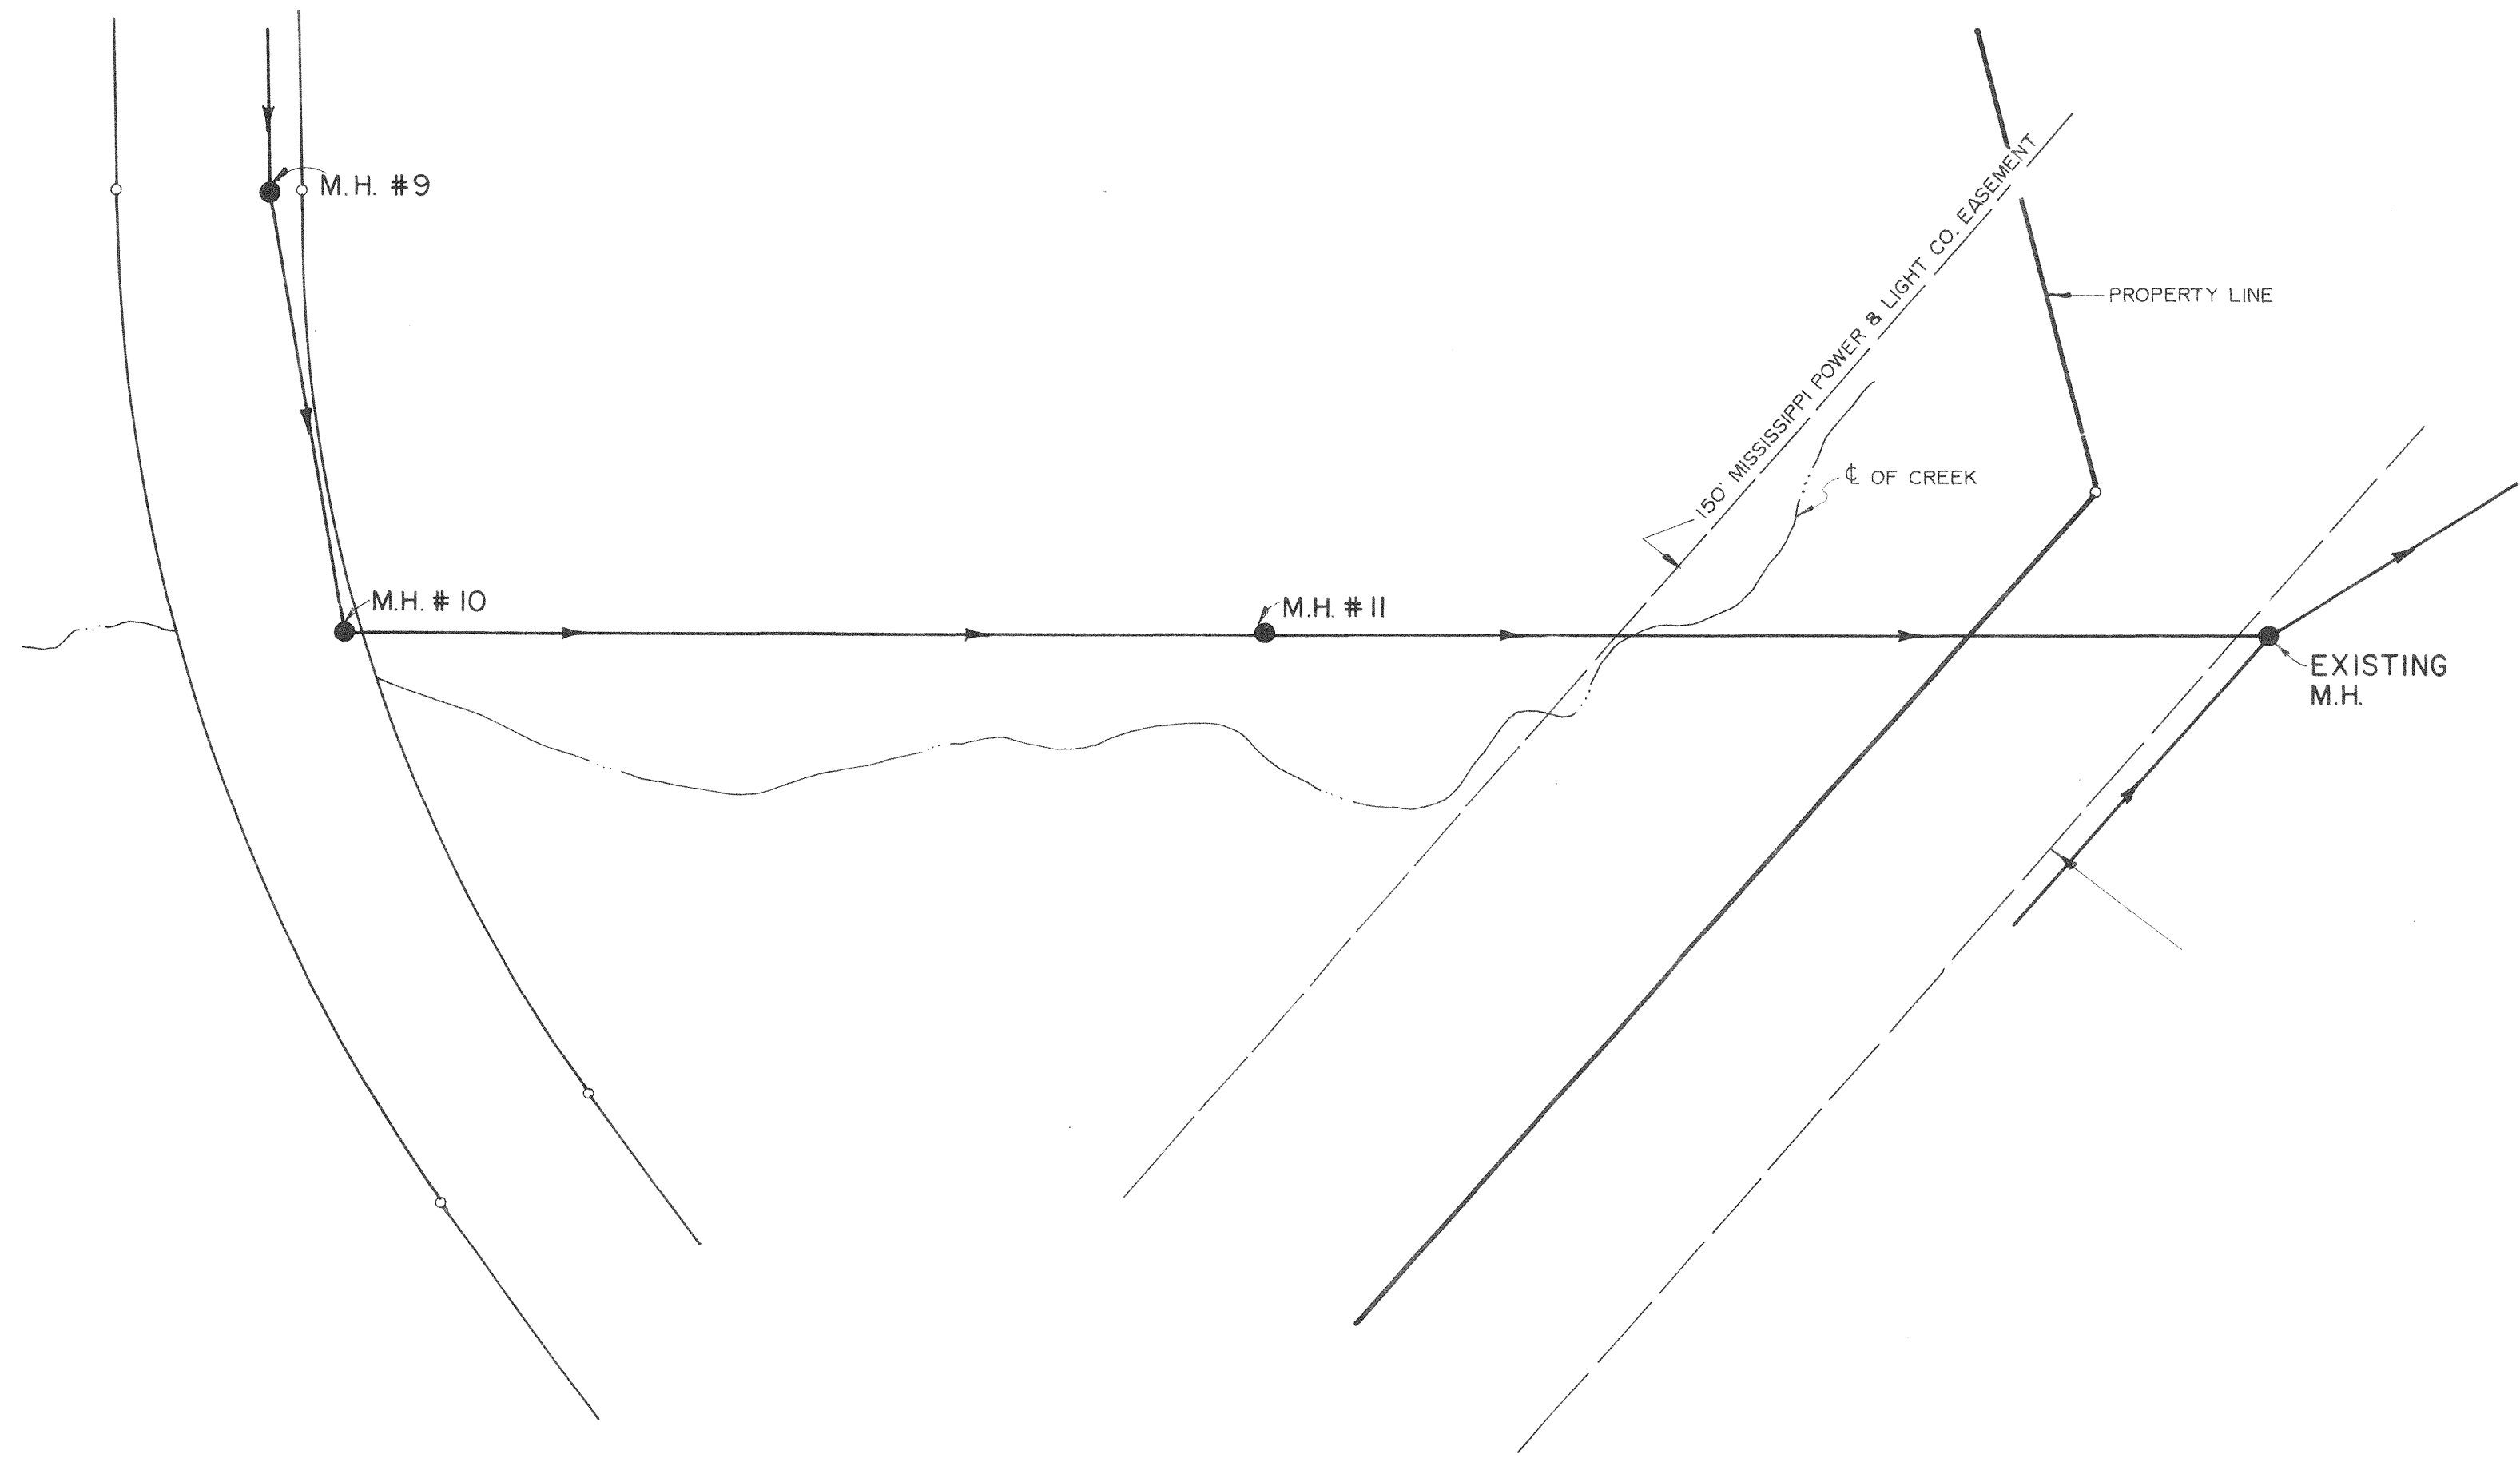



PROFILE
 SURVEYED _____ DATE _____
 NOTE BOOK _____
 NO. _____
 GRADES CHECKED _____
 B. M.'S. NOTED _____
 STRUCTURE NOTATIONS CHECKED _____

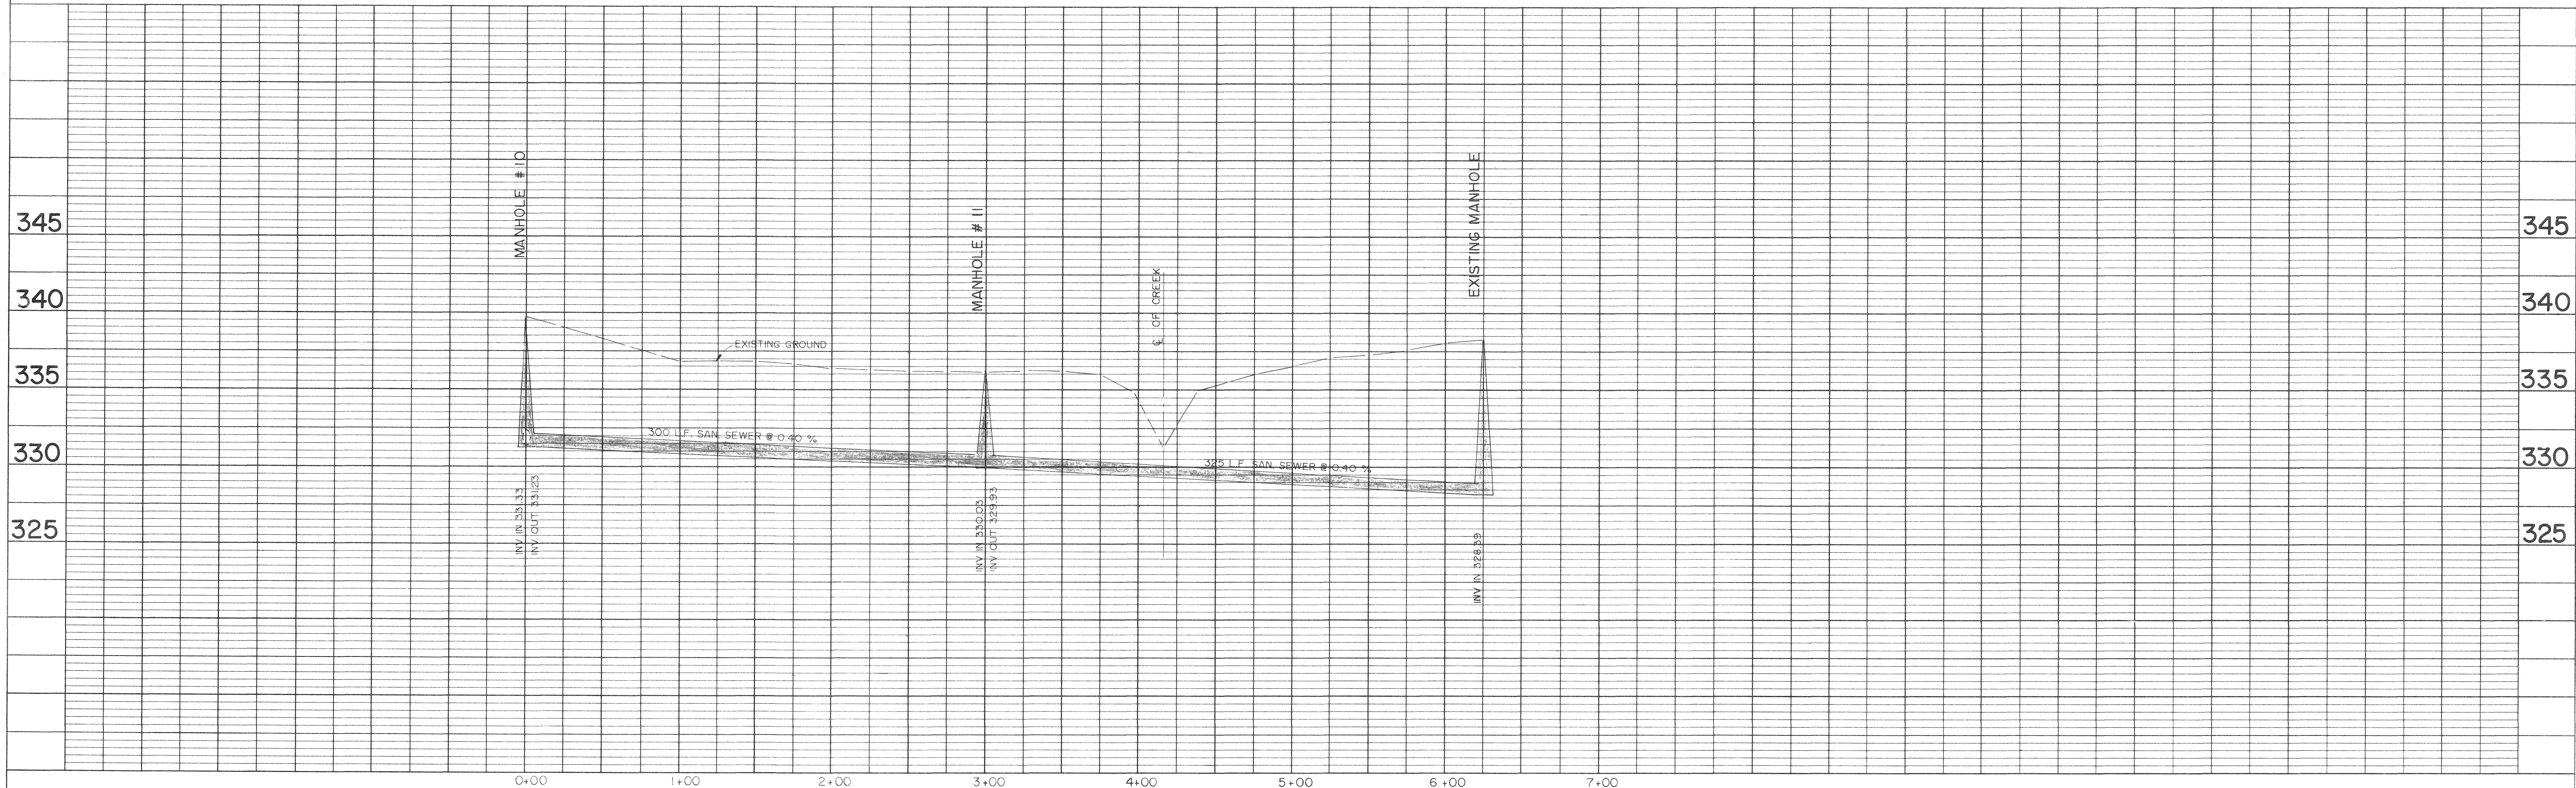

HIGHWAY FEDERAL AID SHEET
 PLATE 1-SINGLE PLAN AND PROFILE-FULL LINE
 NATIONAL PRINTFAST
 PRINTED IN U.S.A.

DATE: _____
 BY: _____
 SURVTD. _____
 PLOTTED _____
 NOTE BOOK _____
 ALIGNMENT CHECKED _____
 RE. OF WAY CHECKED _____
 No. _____



DATE: _____
 BY: _____
 SURVTD. _____
 PLOTTED _____
 NOTE BOOK _____
 RE. OF WAY CHECKED _____
 No. _____

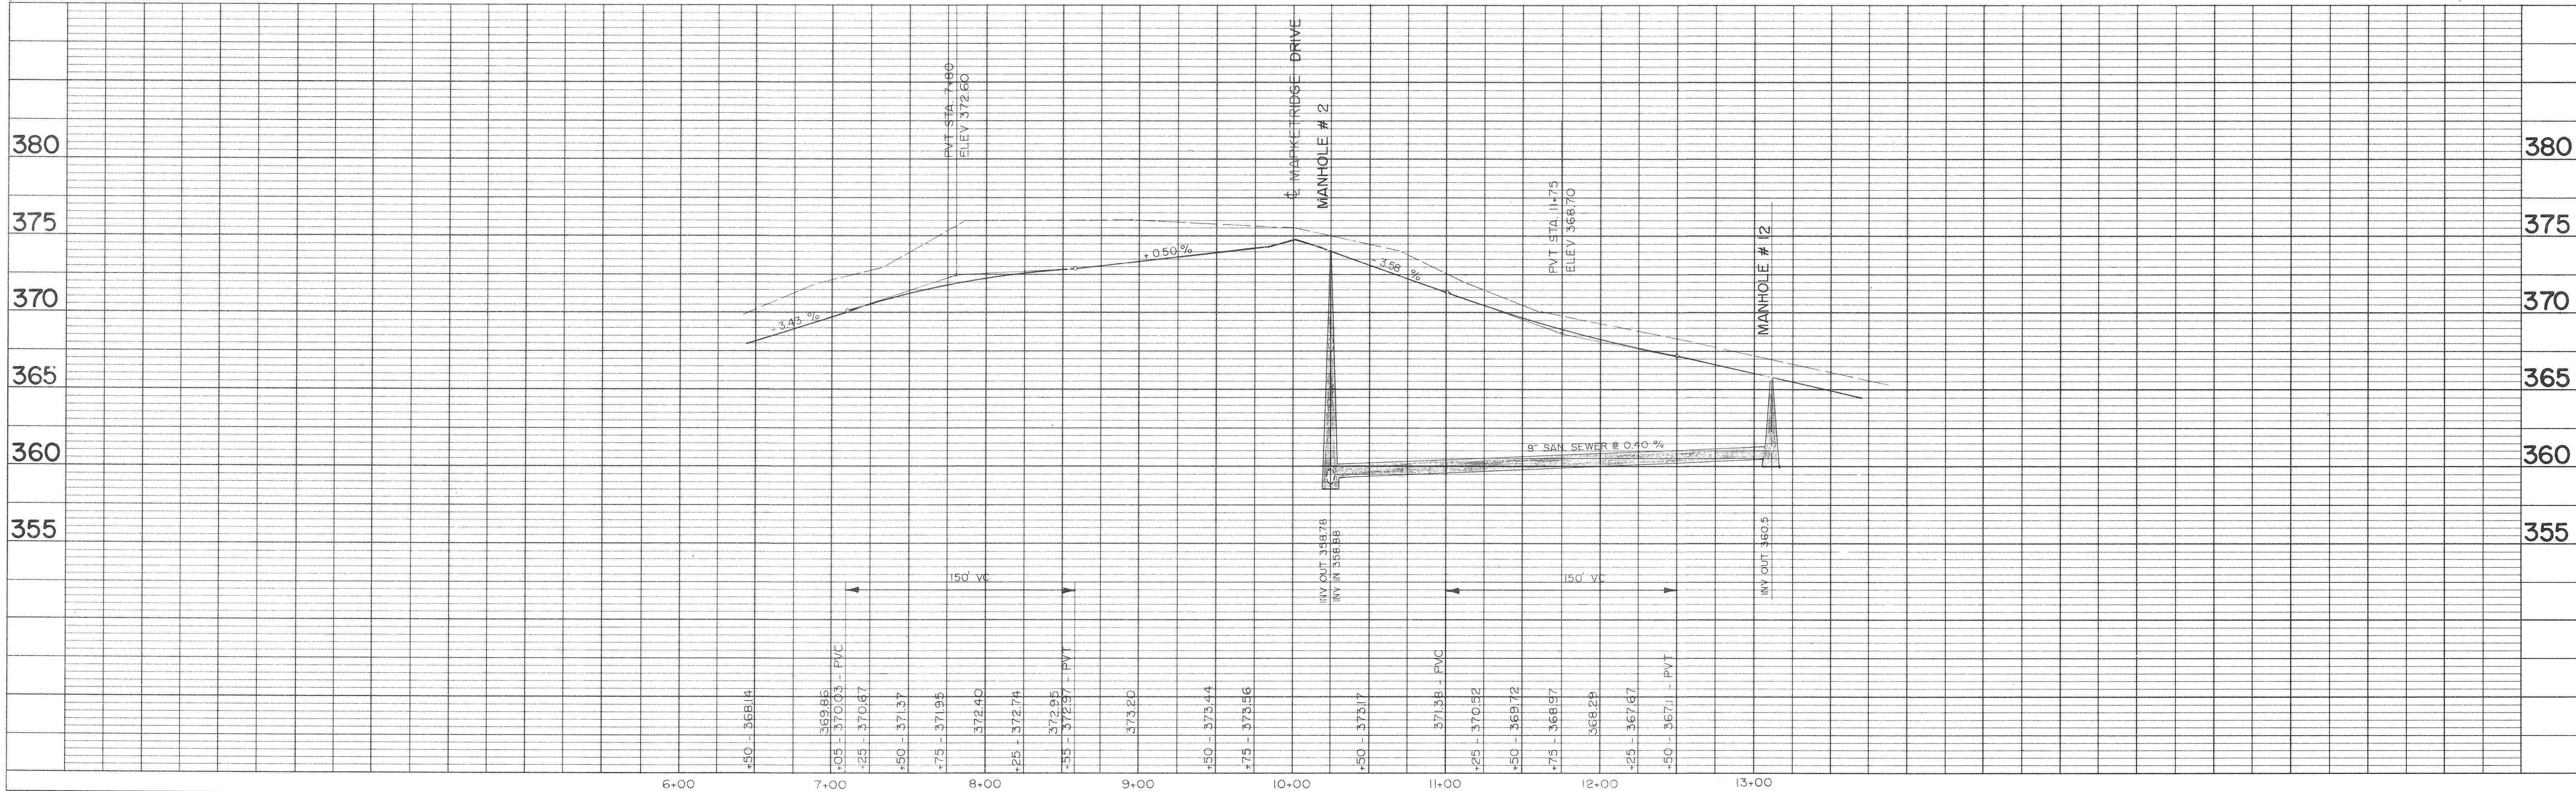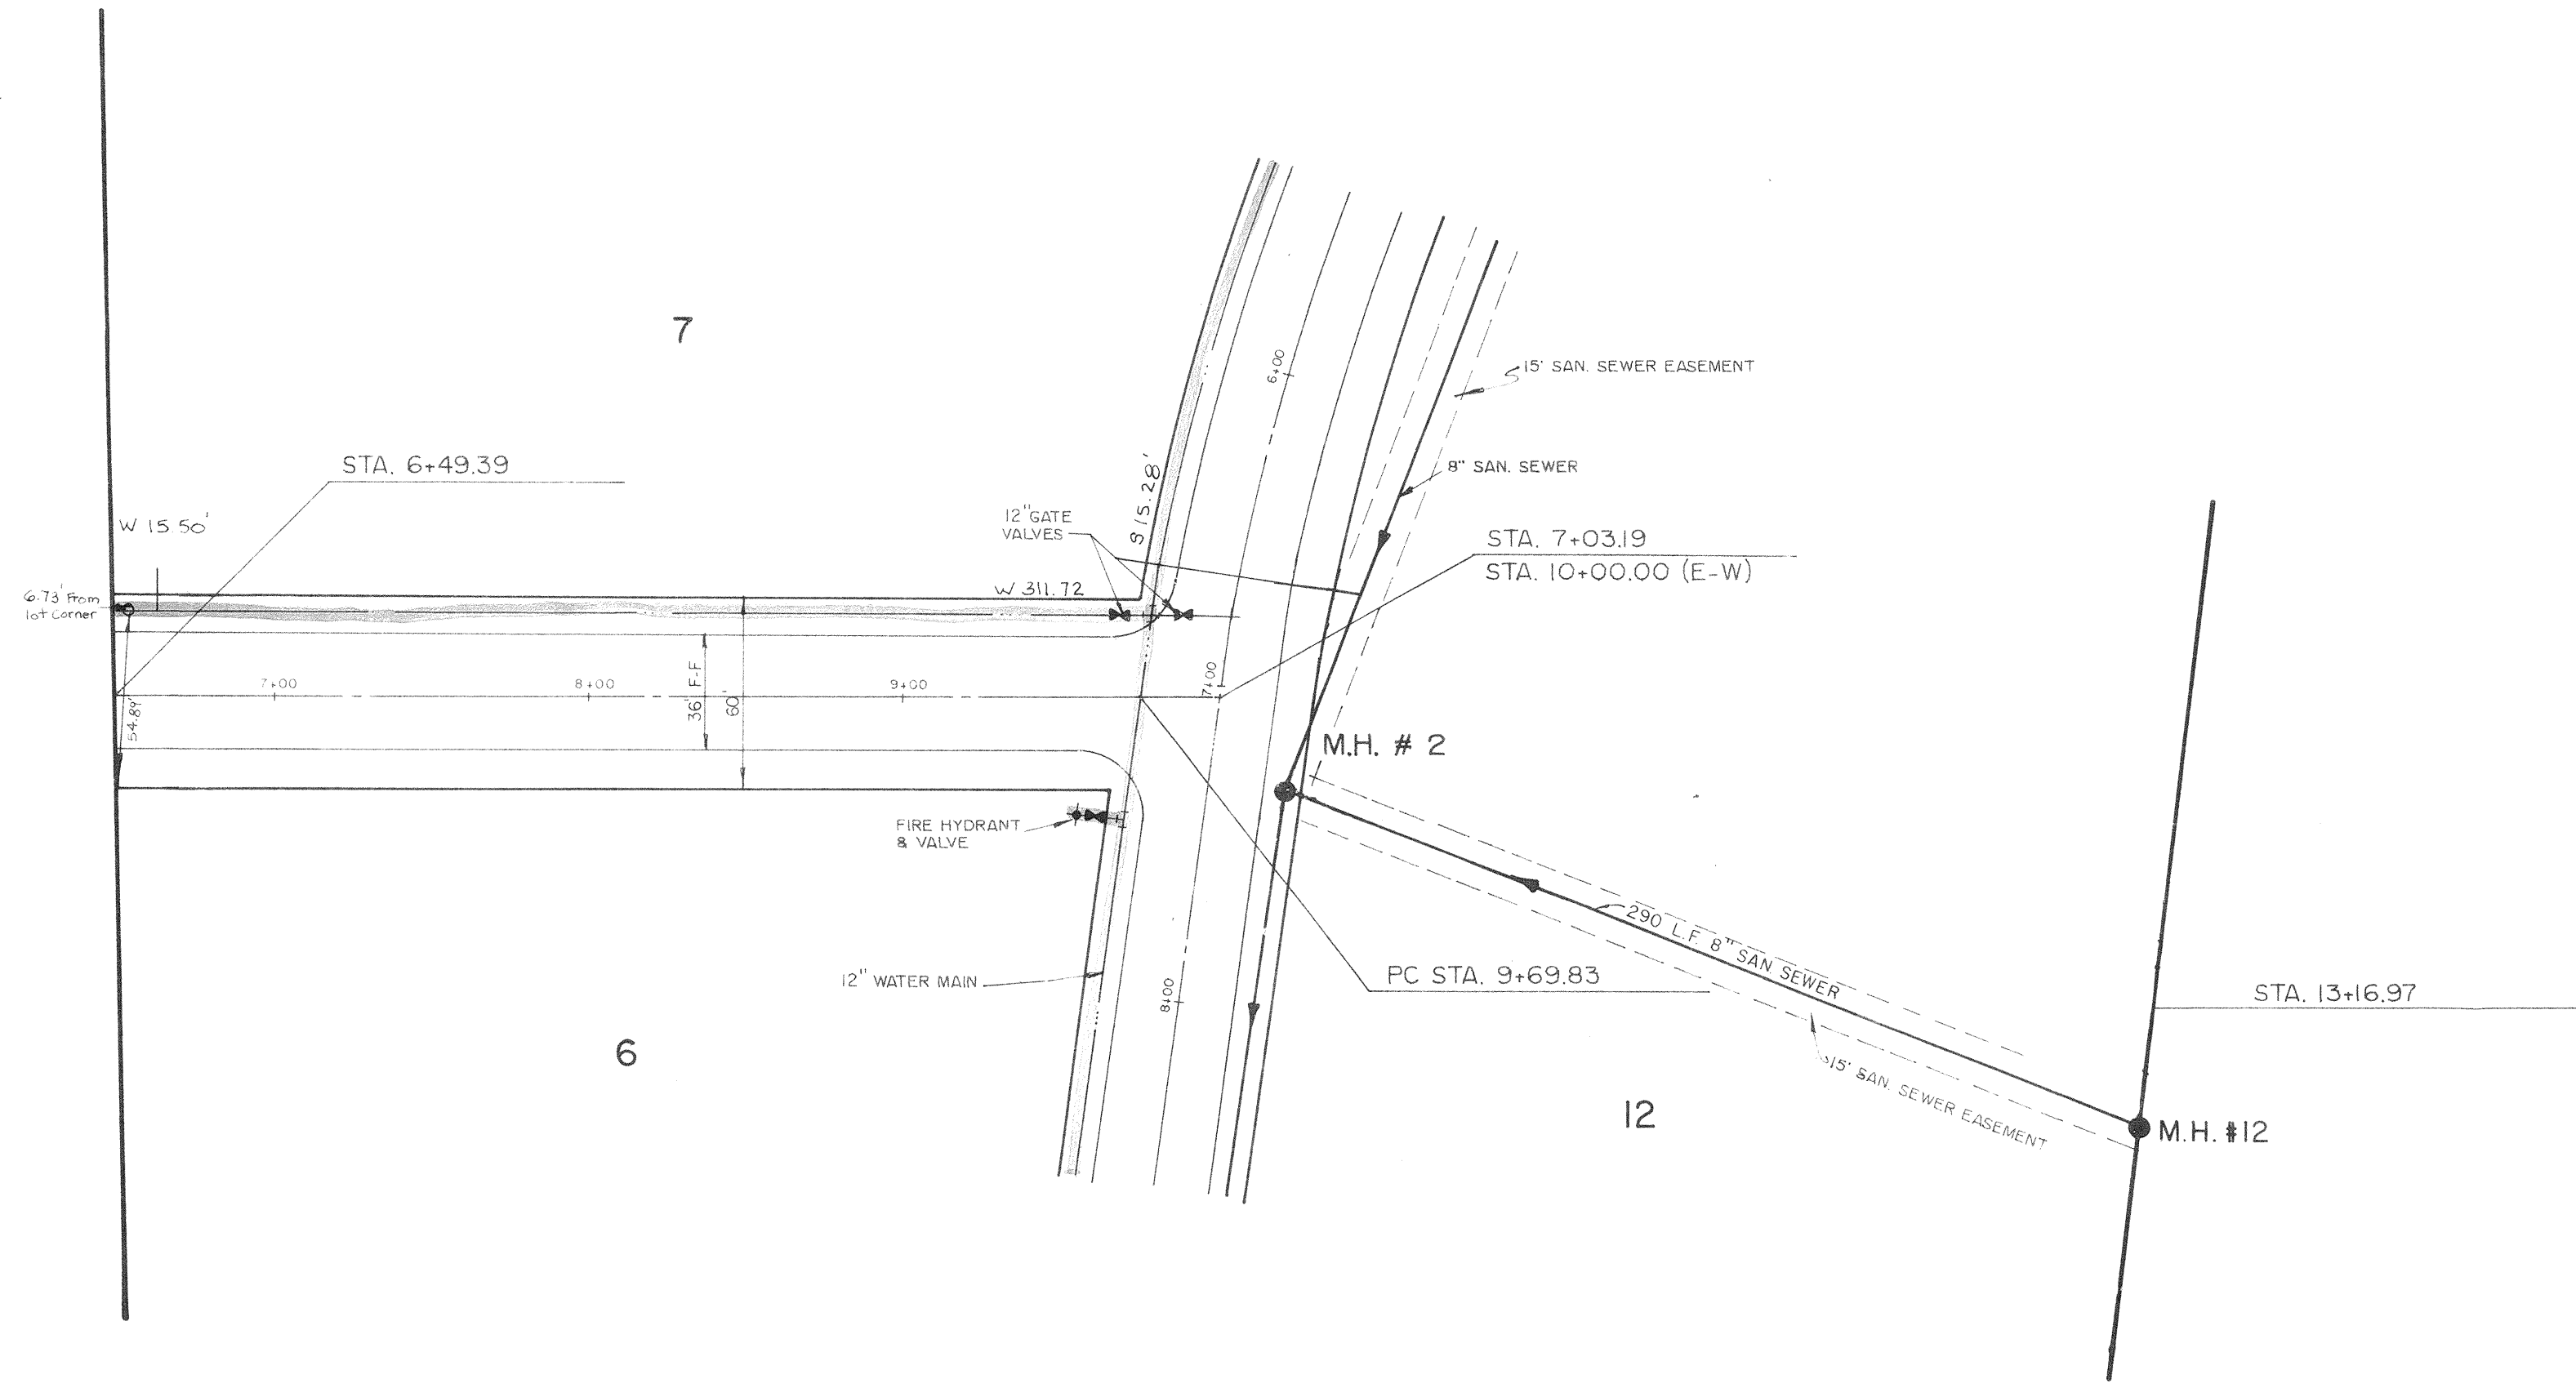

HIGHWAY FEDERAL AID SHEET
 PLATE 1-SINGLE PLAN AND PROFILE-FULL LINE
 NATIONAL PRINTING
 PRINTED IN U.S.A.


PLAN	SURVEYED	DATE
	PLOTTED	
	NOTED	
	BY	
	DATE	

PROFILE	SURVEYED	DATE
	PLOTTED	
	NOTED	
	BY	
	DATE	

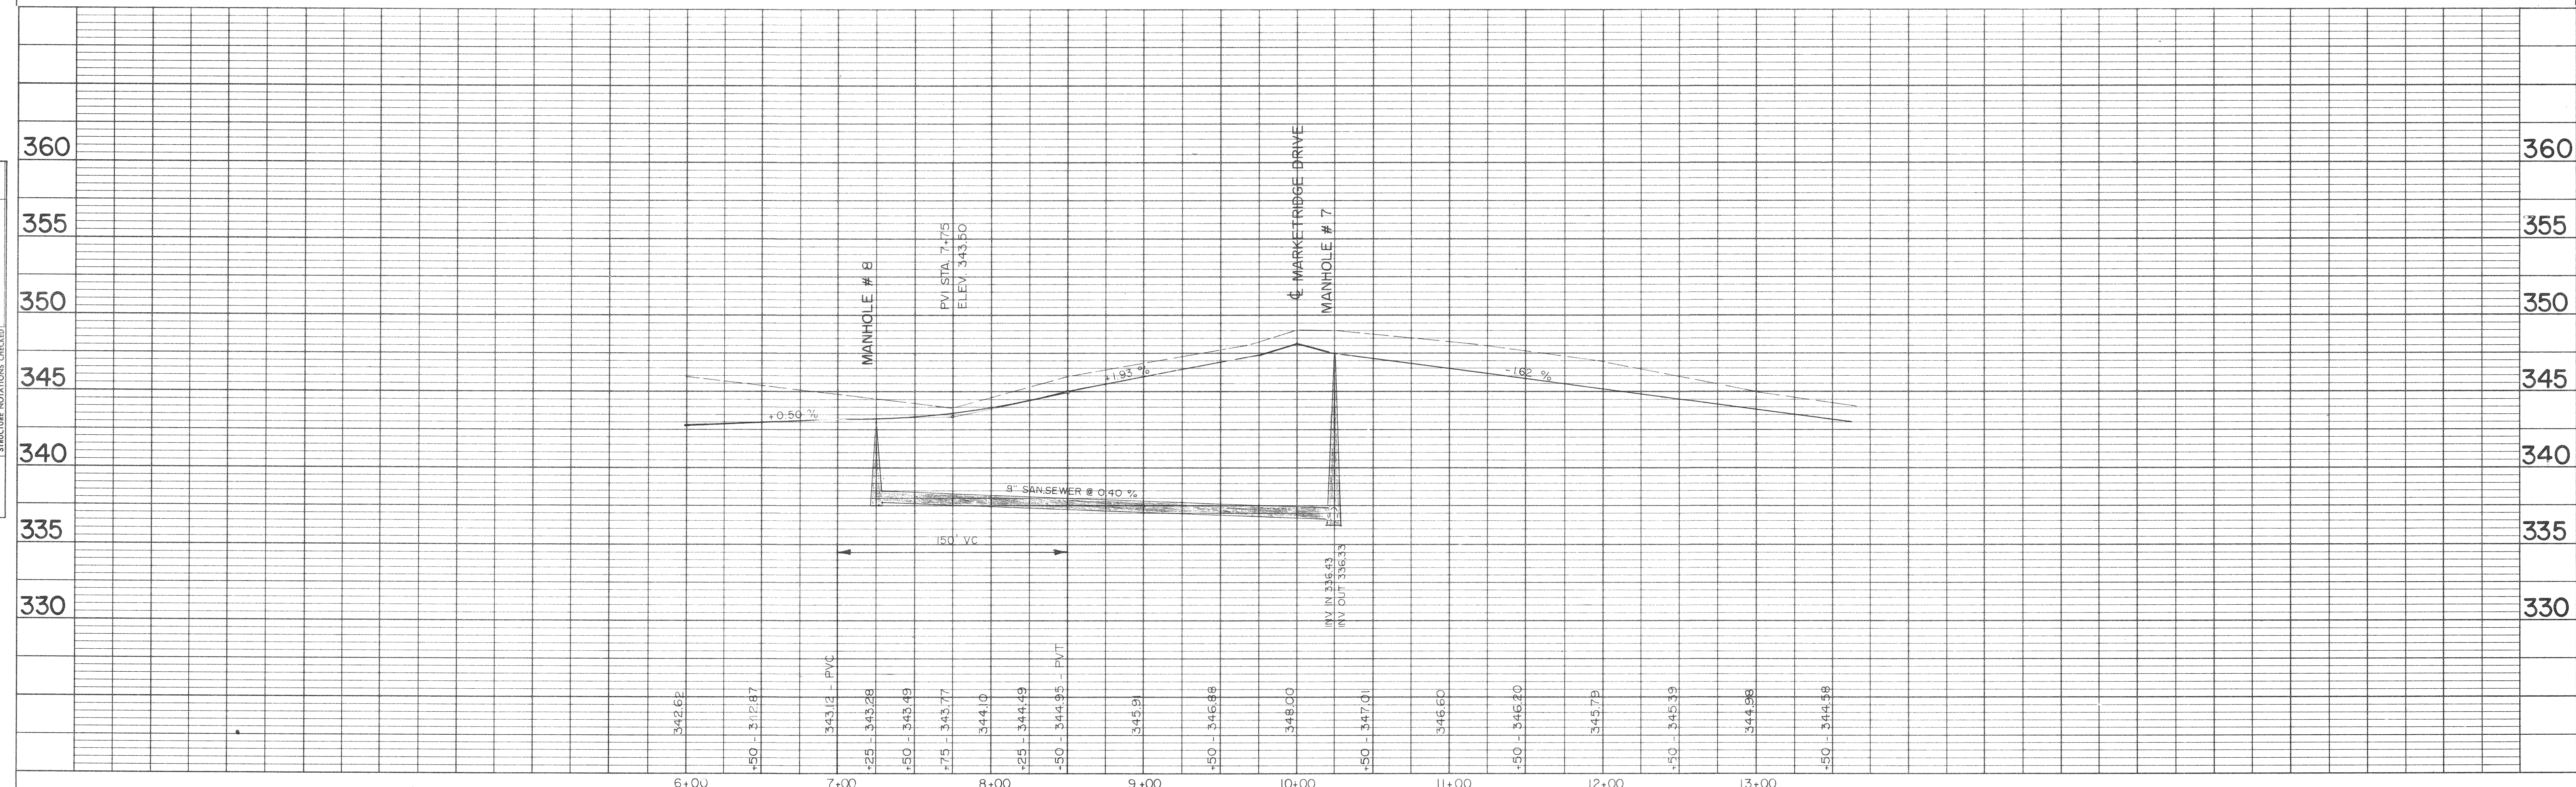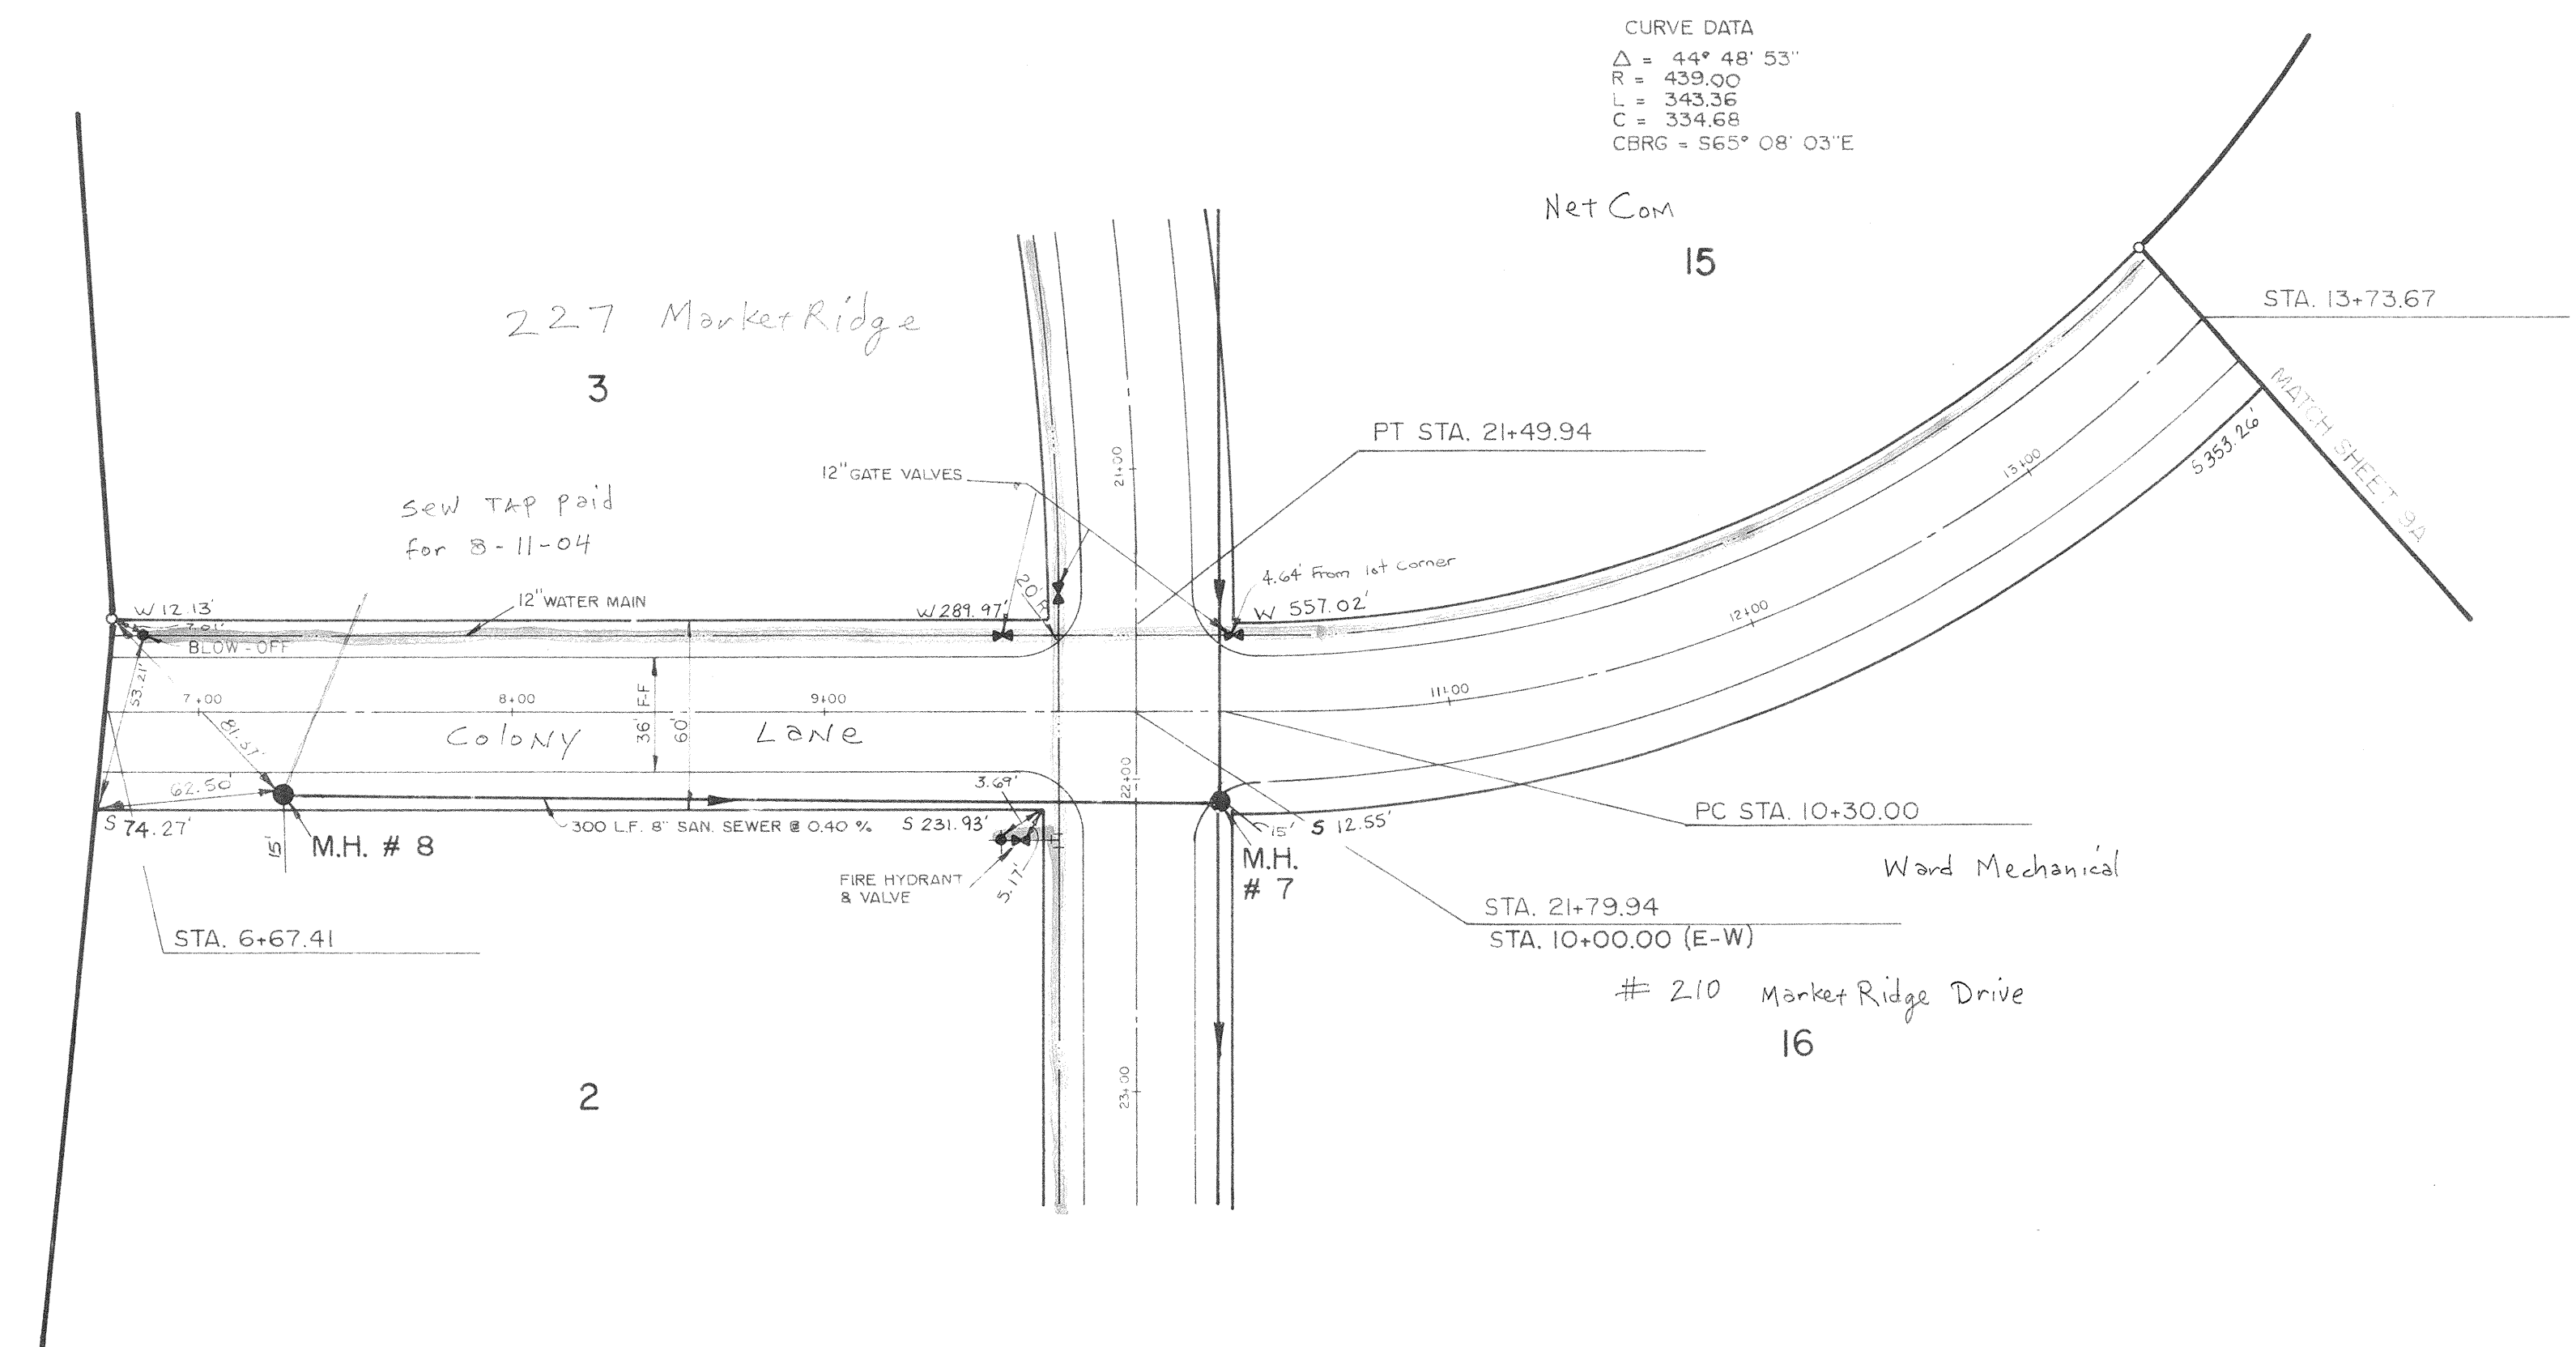

HIGHWAY FEDERAL AID SHEET
 PLATE 1-SINGLE PLAN AND PROFILE-FULL LINE
 NATIONAL PRINTING
 PRINTED IN U.S.A.


W-1077

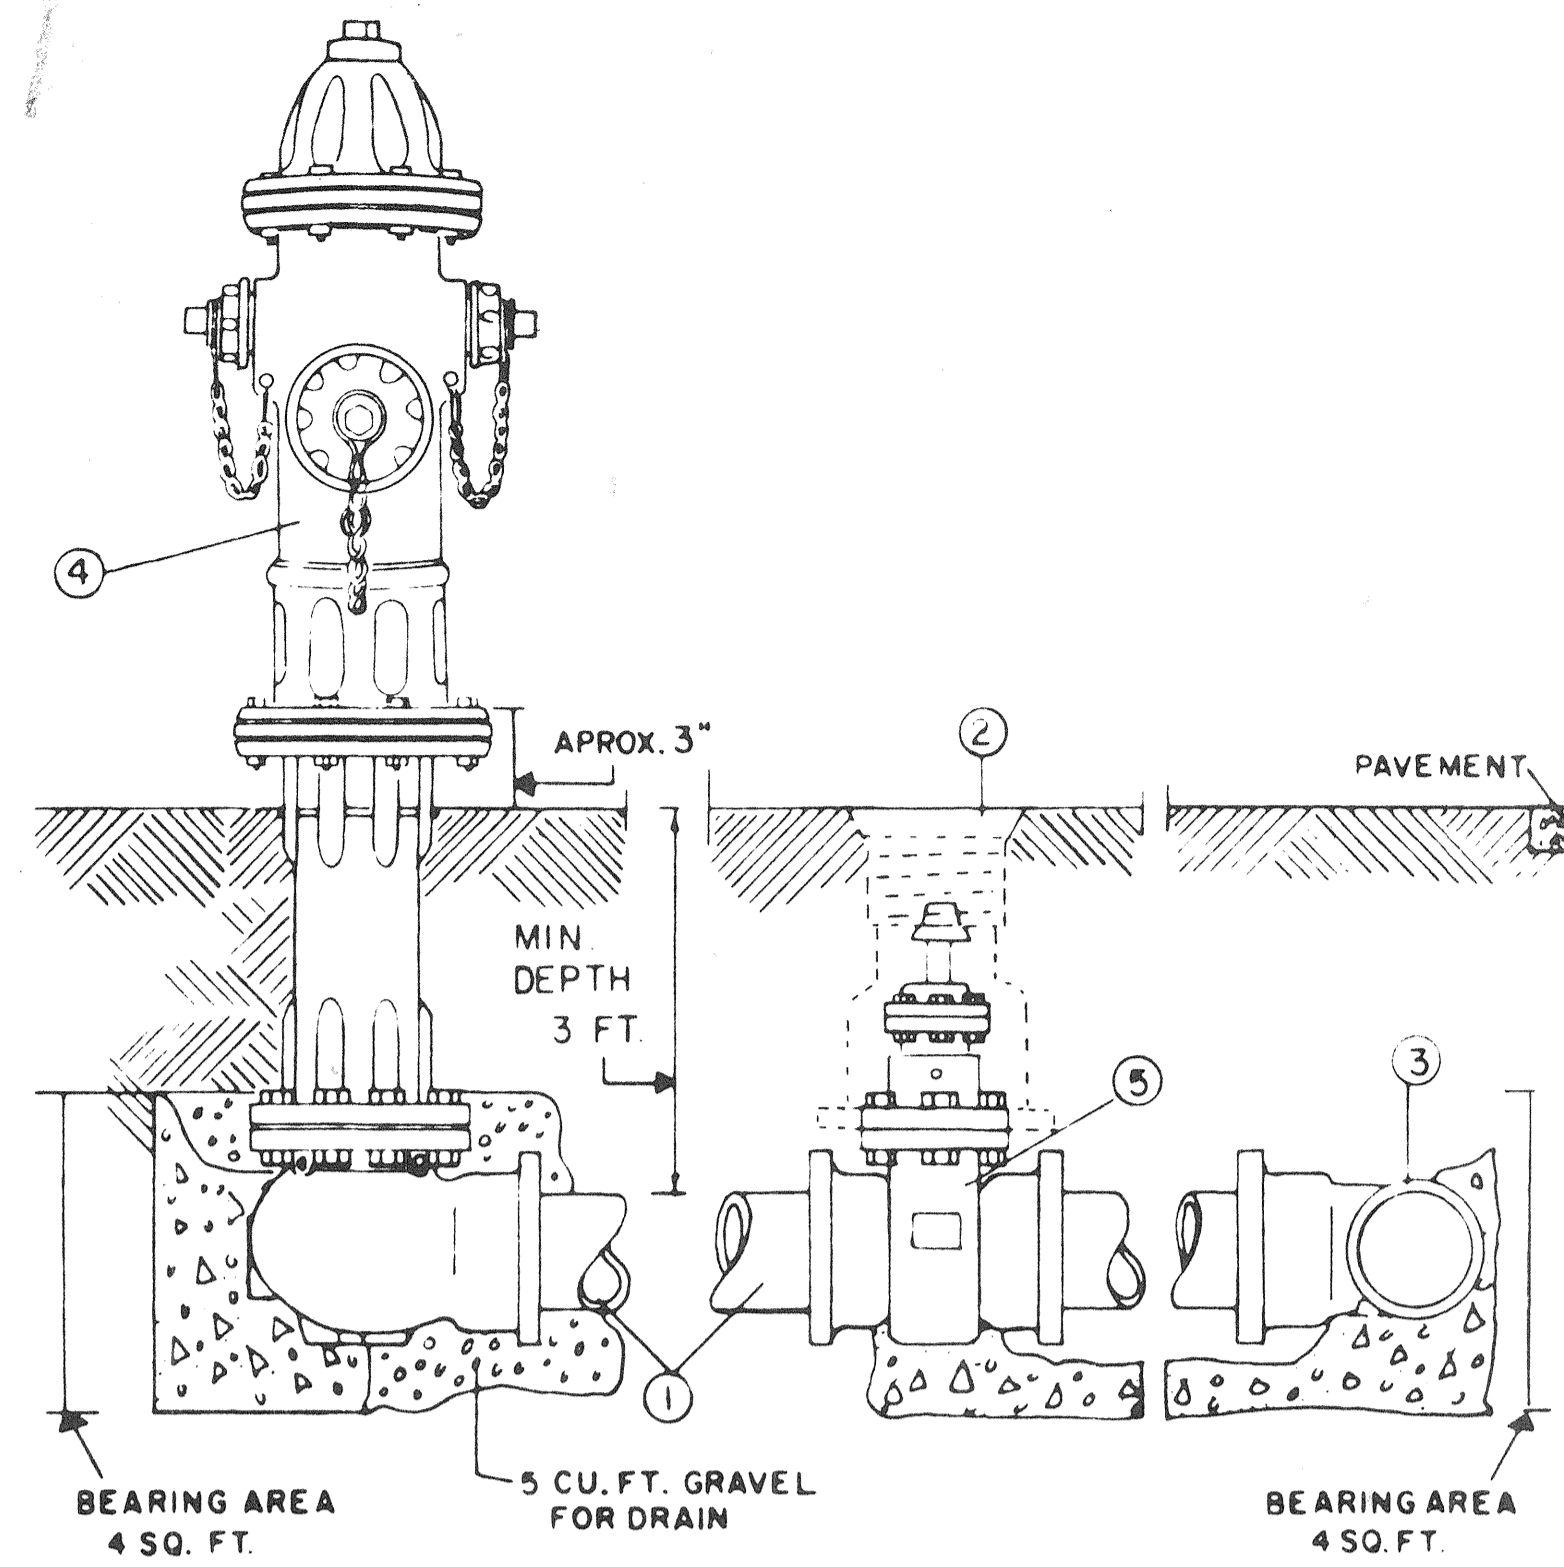


ITEM NO.	NO. REQ'D	DESCRIPTION AND MATERIAL
1	1	PIPE 3'-0" LONG
2	1	VALVE BOX - MUELLER H-10360
3	1	CAST IRON TEE
4	1	FIRE HYDRANT (THREE WAY)
5	1	GATE VALVE - MUELLER A-2380-20 (WHERE REQ'D ON PLAN)

Note: Valves Shall Be Installed On Each Fire Hydrant. Both Valve And Hydrant Shall Be Installed With Ductile Iron Anchor Couplings To The Main.


TYPICAL FIRE HYDRANT AND VALVE ASSEMBLY

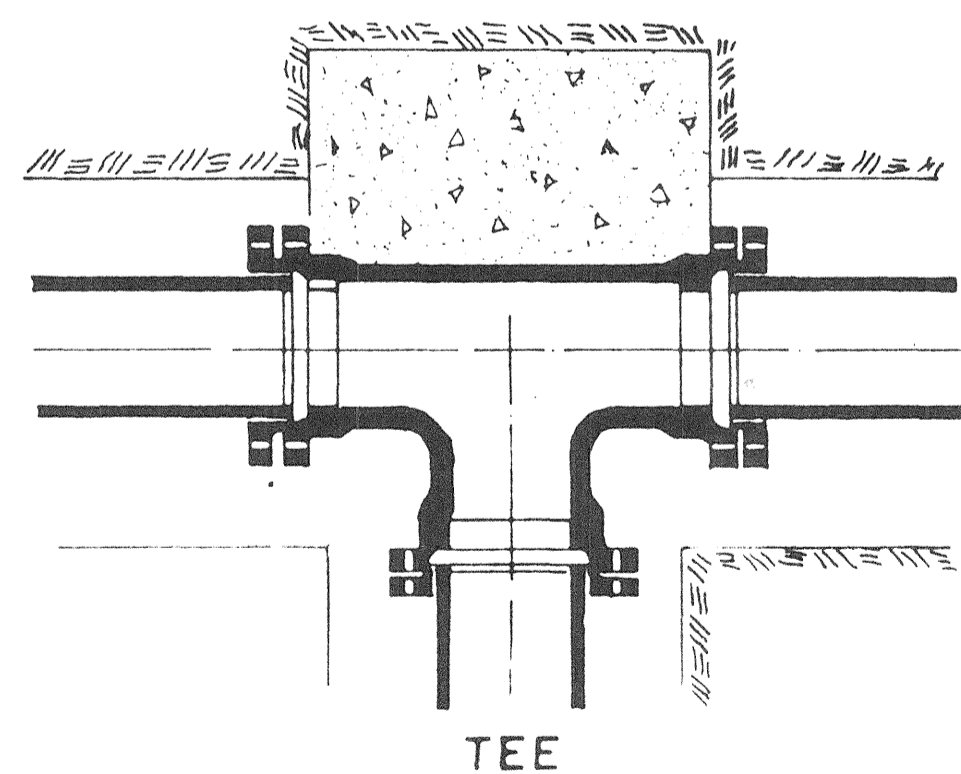

PLUGGED TEE

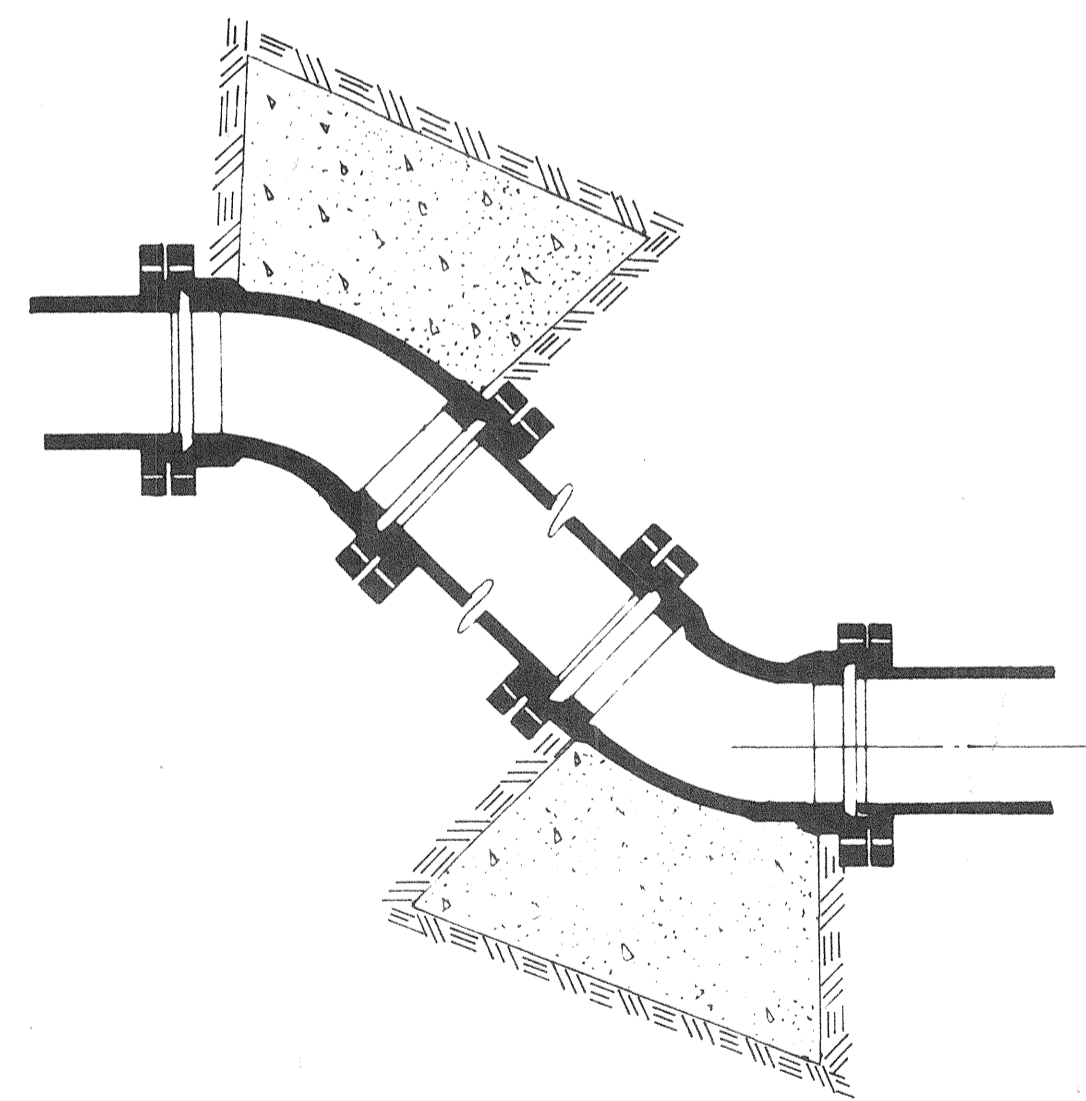


VERTICAL BENDS

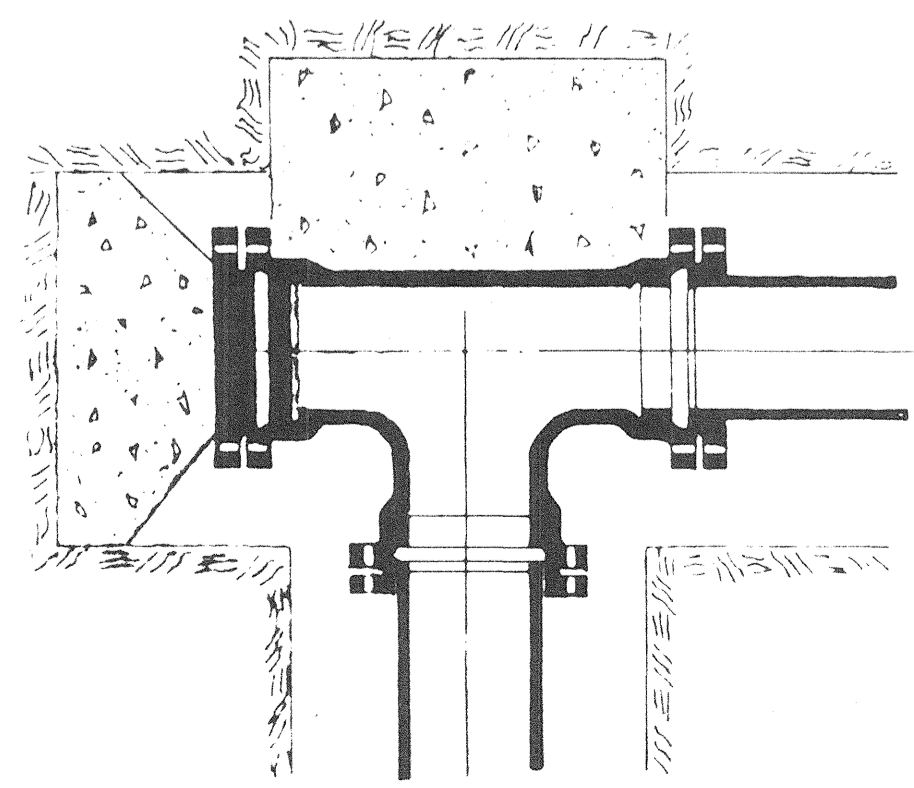


90° BEND


TYPICAL BLOCKING ON WATER MAINS

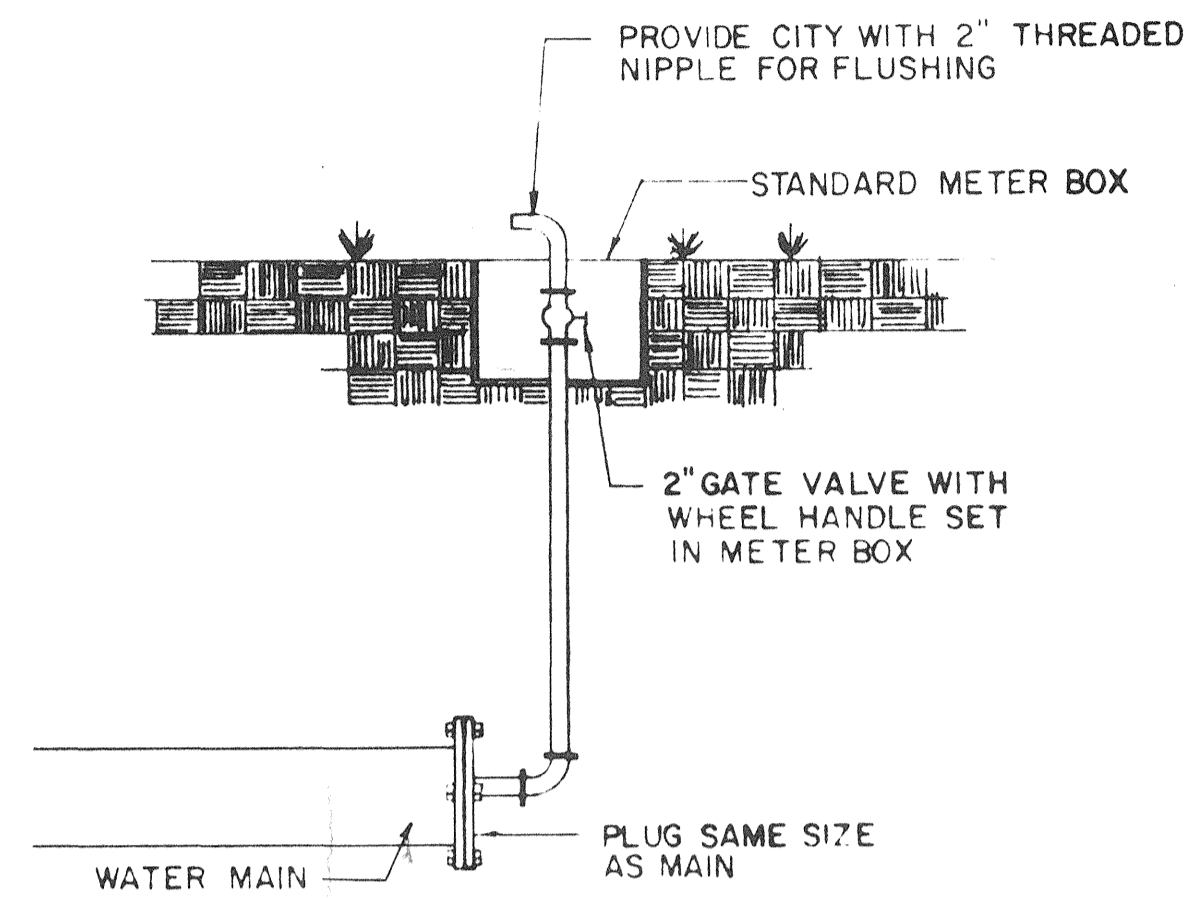

TYPICAL BLOW-OFF VALVE

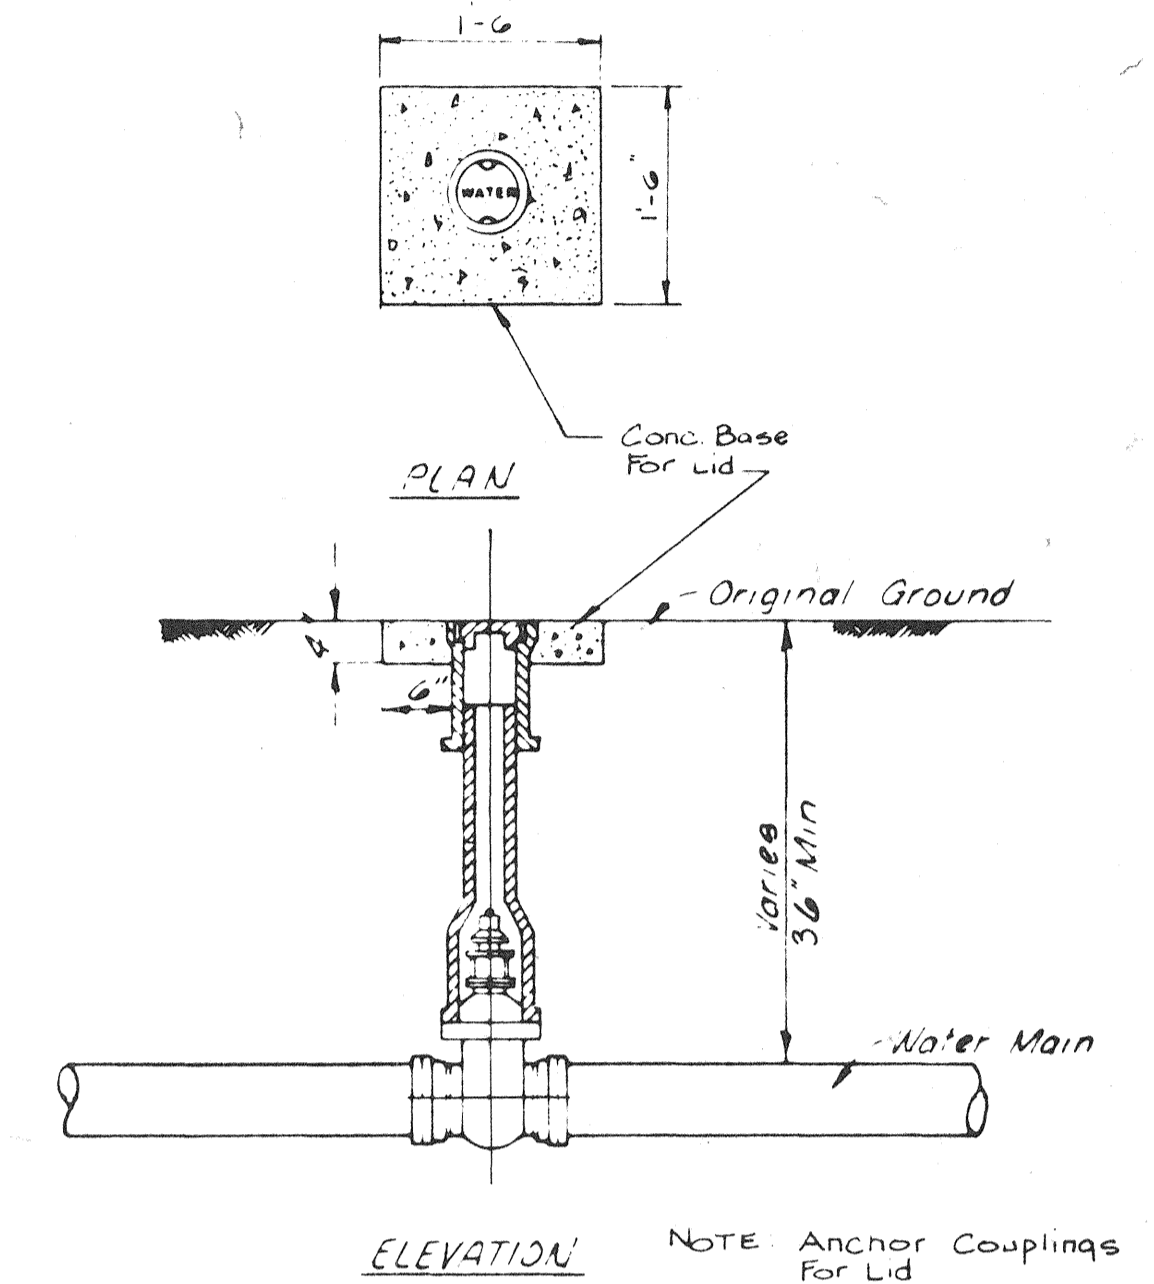

VALVE BOX INSTALLATION

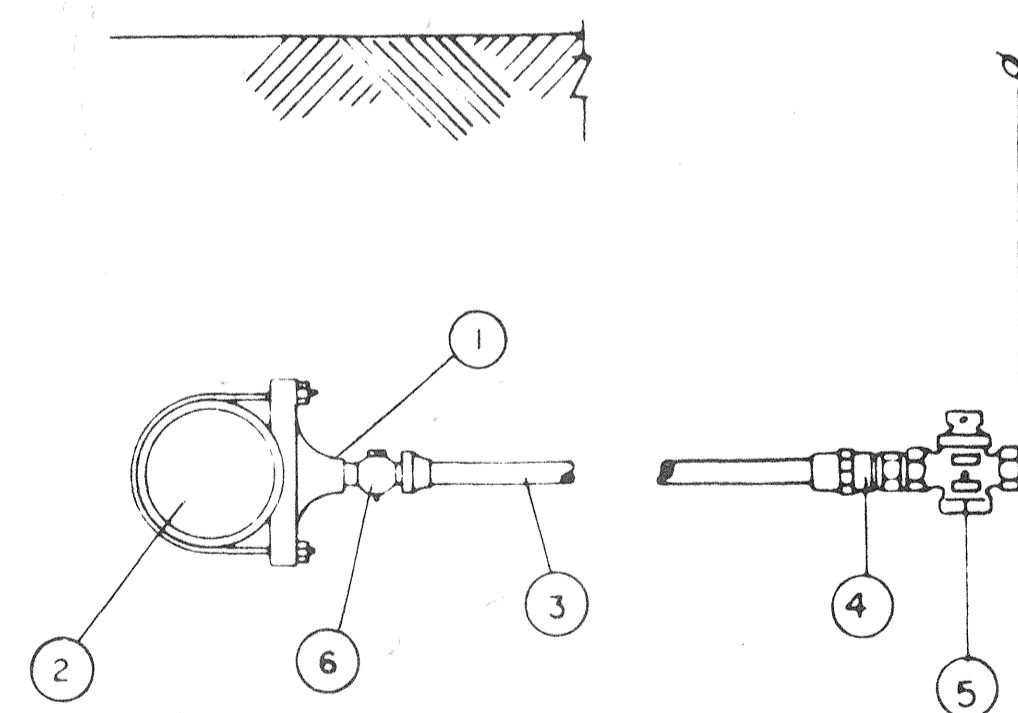

TYPICAL SERVICE CONNECTION

ITEM NO.	NO. REQ'D	SIZE AND DESCRIPTION	MATERIAL SPECIFICATIONS
1	1	SERVICE CLAMP	MUELLER-DOUBLE STRAP
2	1	PVC MAIN, C-900, CLASS 150	AS REQ'D ON PLANS
3	1	3/4" IP SIZE SERVICE LINE	AS REQ'D ON PANS
4	1	3/4" TRANSITION FITTING PVC	MUELLER H-12211
5	1	CURB STOP	MUELLER H-15171
6	1	CORPORATION STOP	MUELLER H-15013


TYPICAL WATER SERVICE ASSEMBLY CONNECTING TO P.V.C. MAIN

HIGHLAND COLONY BUSINESS PARK


WATER DETAILS

BROWNING INC.
Consulting Engineers Jackson, Mississippi
Designed By: P.L.B. Scale: None
Drawn By: J.F. Date: AUG., 1995 Sheet 10 of 14

W-1077

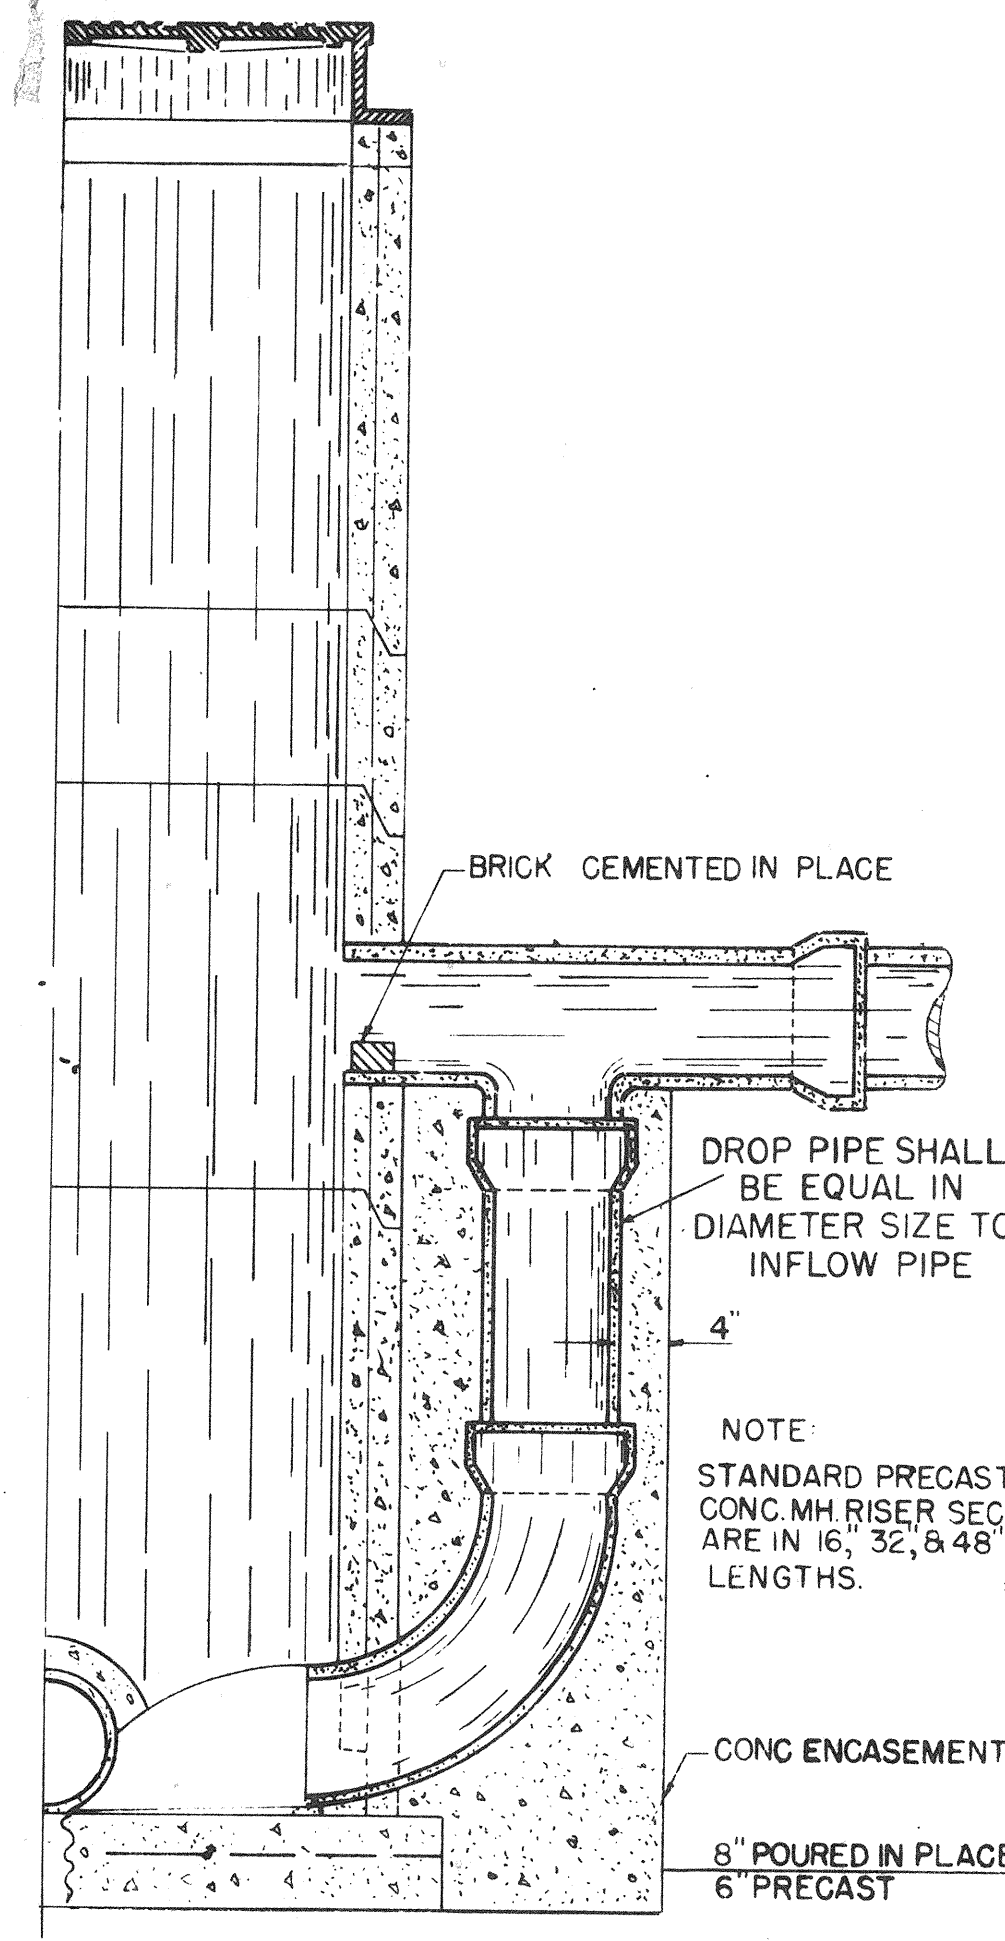





SECTION OF PRECAST CONCRETE MANHOLE WITH DROP CONNECTION

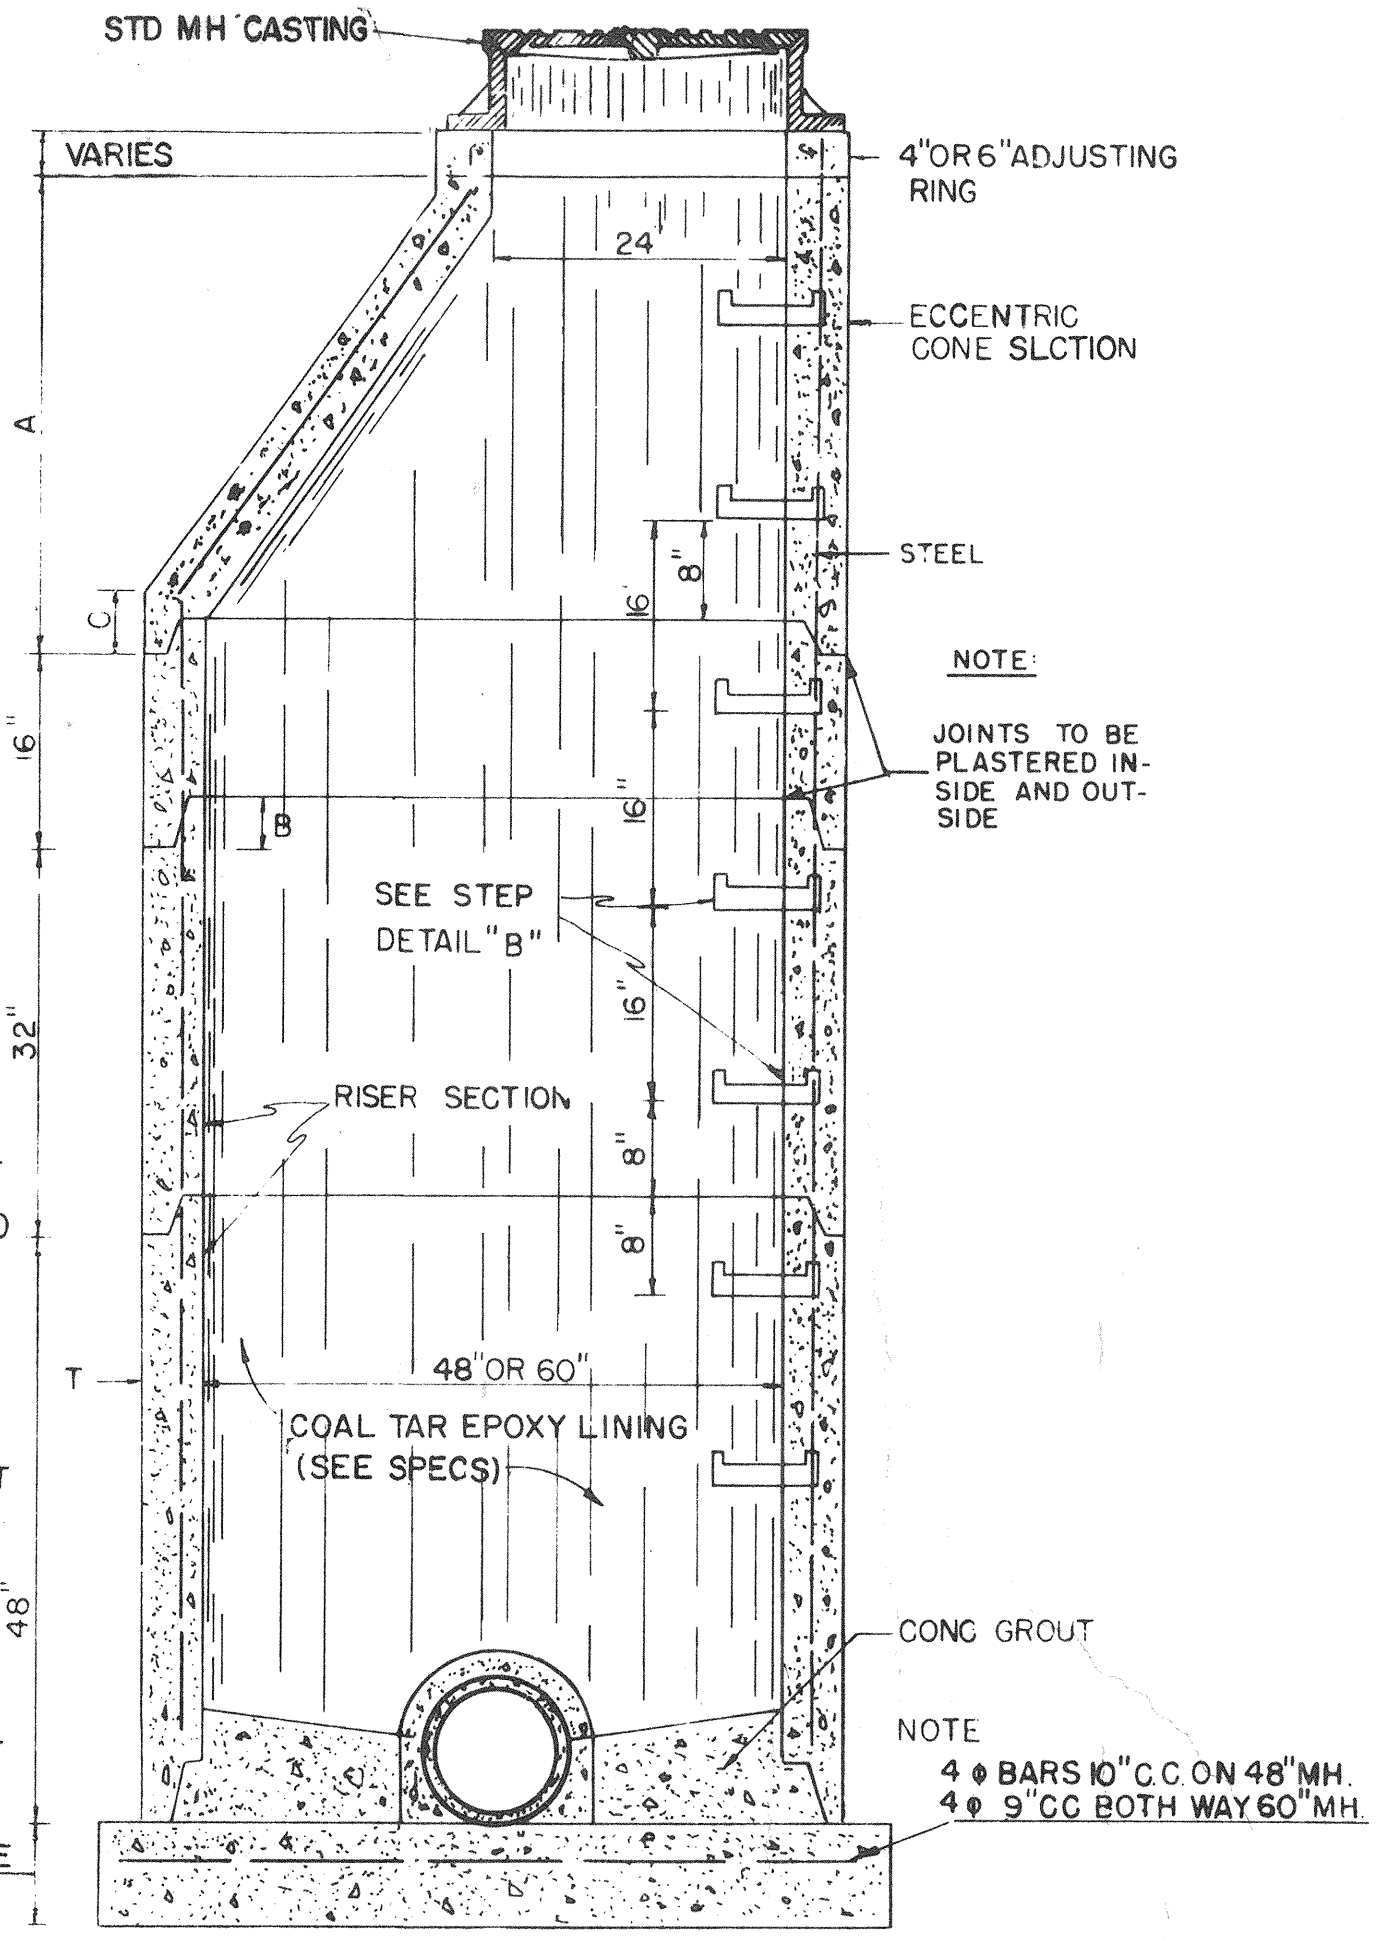




SECTION OF PRECAST CONCRETE MANHOLE

SECTION OF PRECAST CONCRETE MANHOLE

DIA.	A	B	C	T	APPROX. CONC. WEIGHT LBS.	APPROX. RISE WITH RIBS P.F.T.
48"	38"	3 1/2"	5"	5"	2075	870
60"	36"	5"	9"	6"	3455	1250

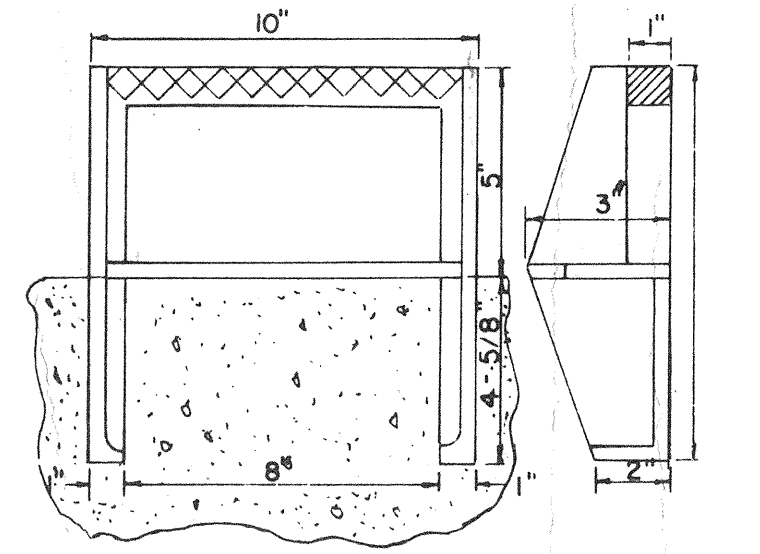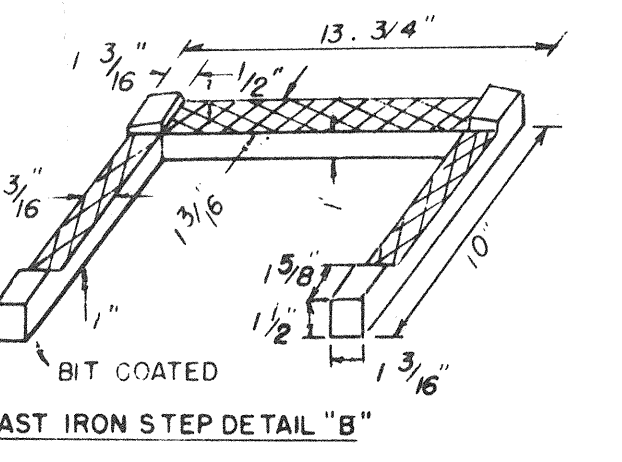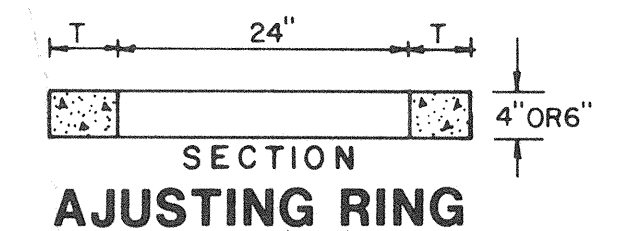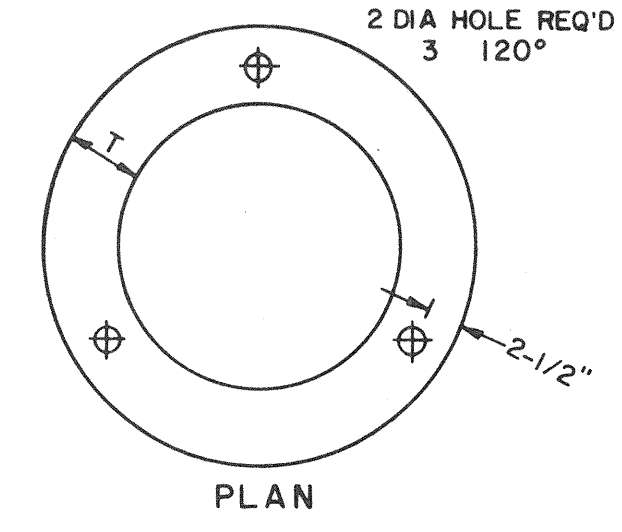


STEP A

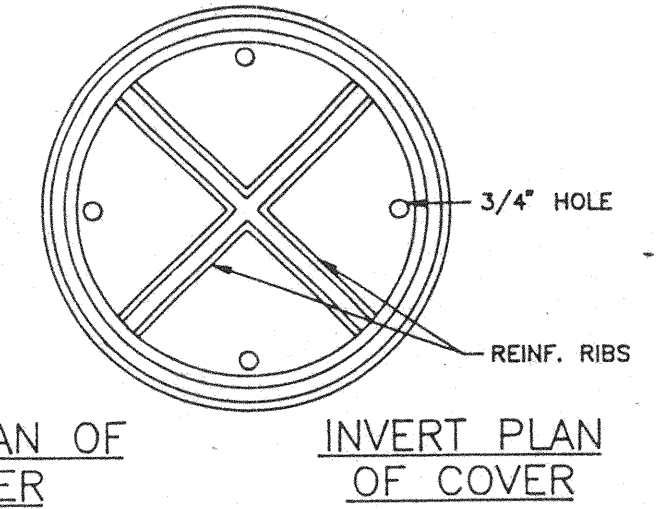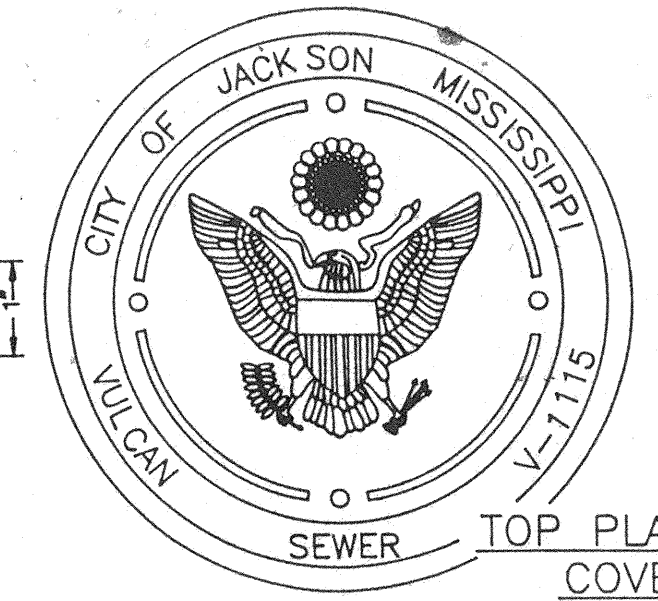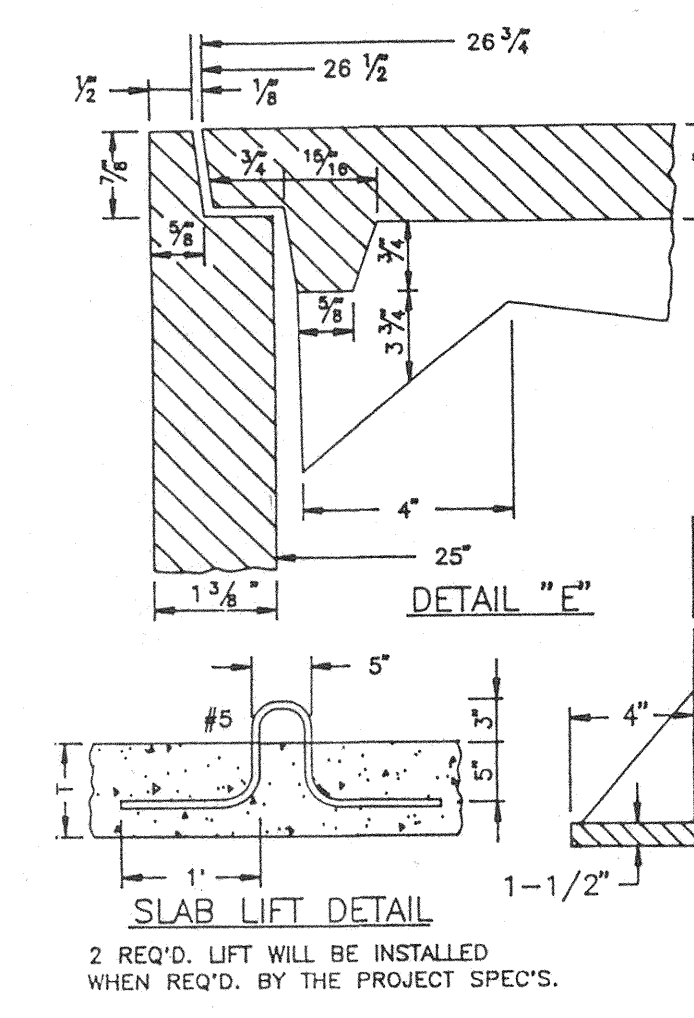

STD. MH CASTING


PIPE DIA.	W	D	T	EST. WT.
48"	5"	58"	6"	1,145 LBS
54"	5 1/2"	65"	8"	1,990 LBS
60"	6"	72"	8"	2,515 "
65"	6 1/2"	79"	8"	3,090 "
72"	7"	86"	8"	3,270 "
84"	8"	100"	8"	5,140 "
96"	9"	114"	8"	6,775 "
108"	9"	126"	8"	8,345 "

FLAT SLAB MANHOLE TOP

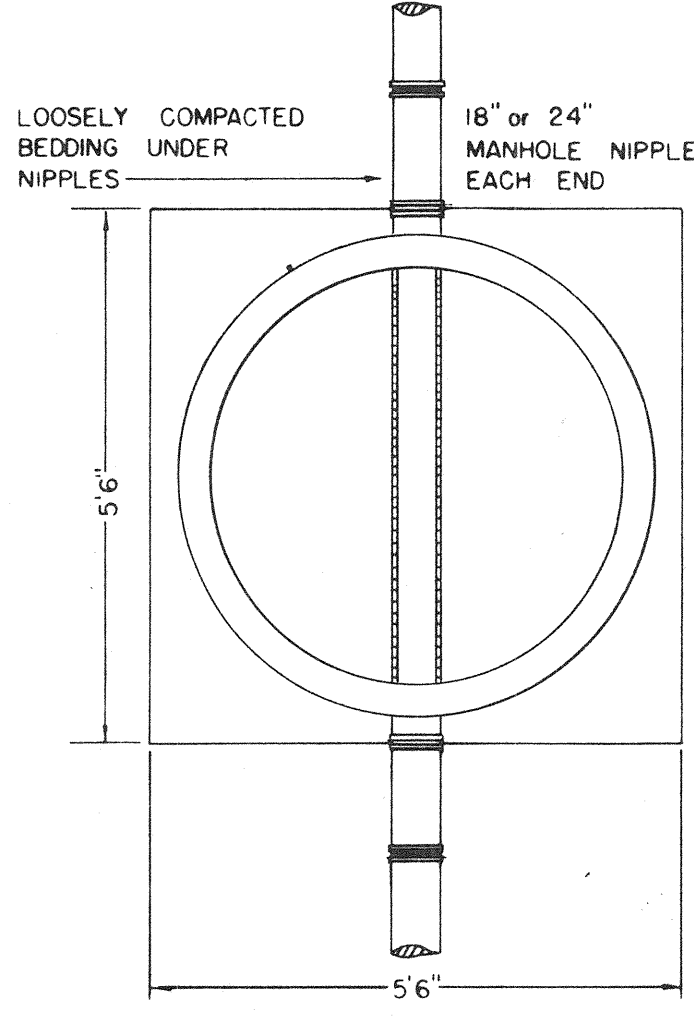


TYPICAL PIPE CONNECTION TO MANHOLE


- NOTE:**
- DO NOT POUR ADDITIONAL CONCRETE ON OR BEYOND MH NIPPLE.
 - USE A MINIMUM OF 1 NIPPLE AT EACH ENTRANCE TO M.H.
 - PIPE OPENING IN PRE-CAST CONCRETE UNITS SHALL BE EQUAL TO O.D. OF PIPE PLUS 6" MAXIMUM.
 - DO NOT USE BRICK, BLOCK OR TIMBER TO SUPPORT PIPE OR NIPPLES OUTSIDE OF MANHOLE.

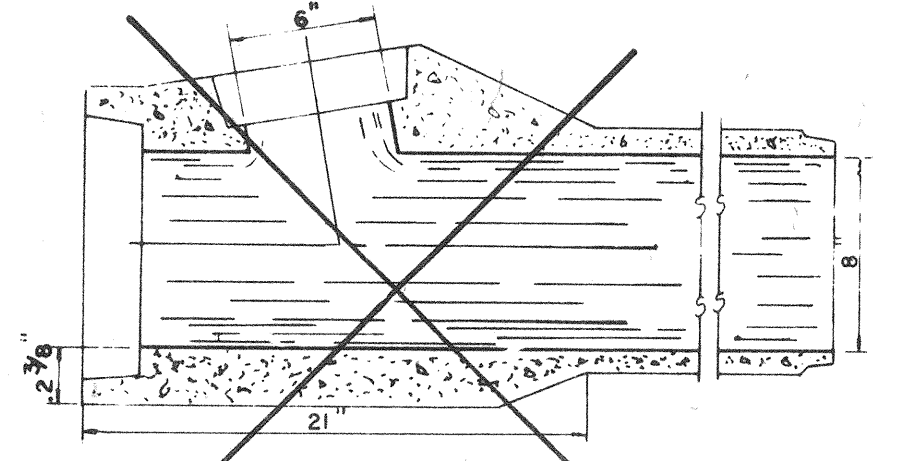

TYPICAL SEC MODIFIED TEE JOINT

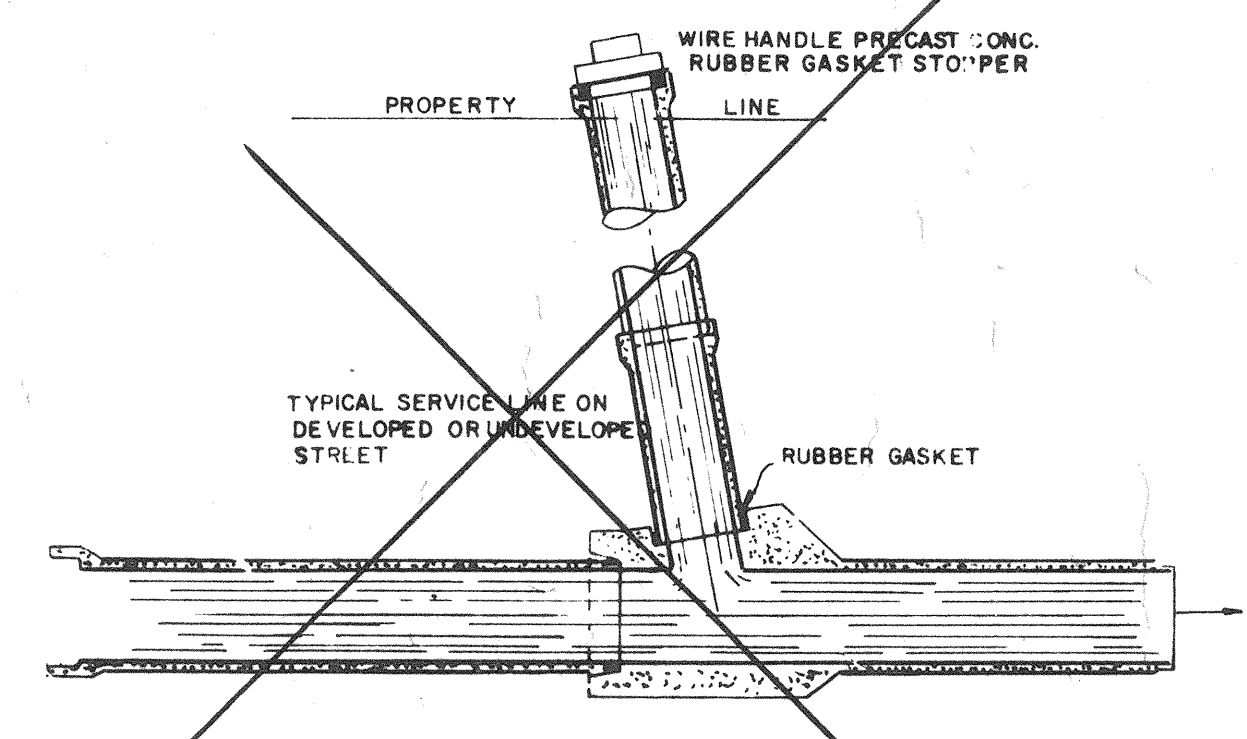

TYPICAL SERVICE TO PROPERTY LINE WITH MODIFIED TEE JOINT

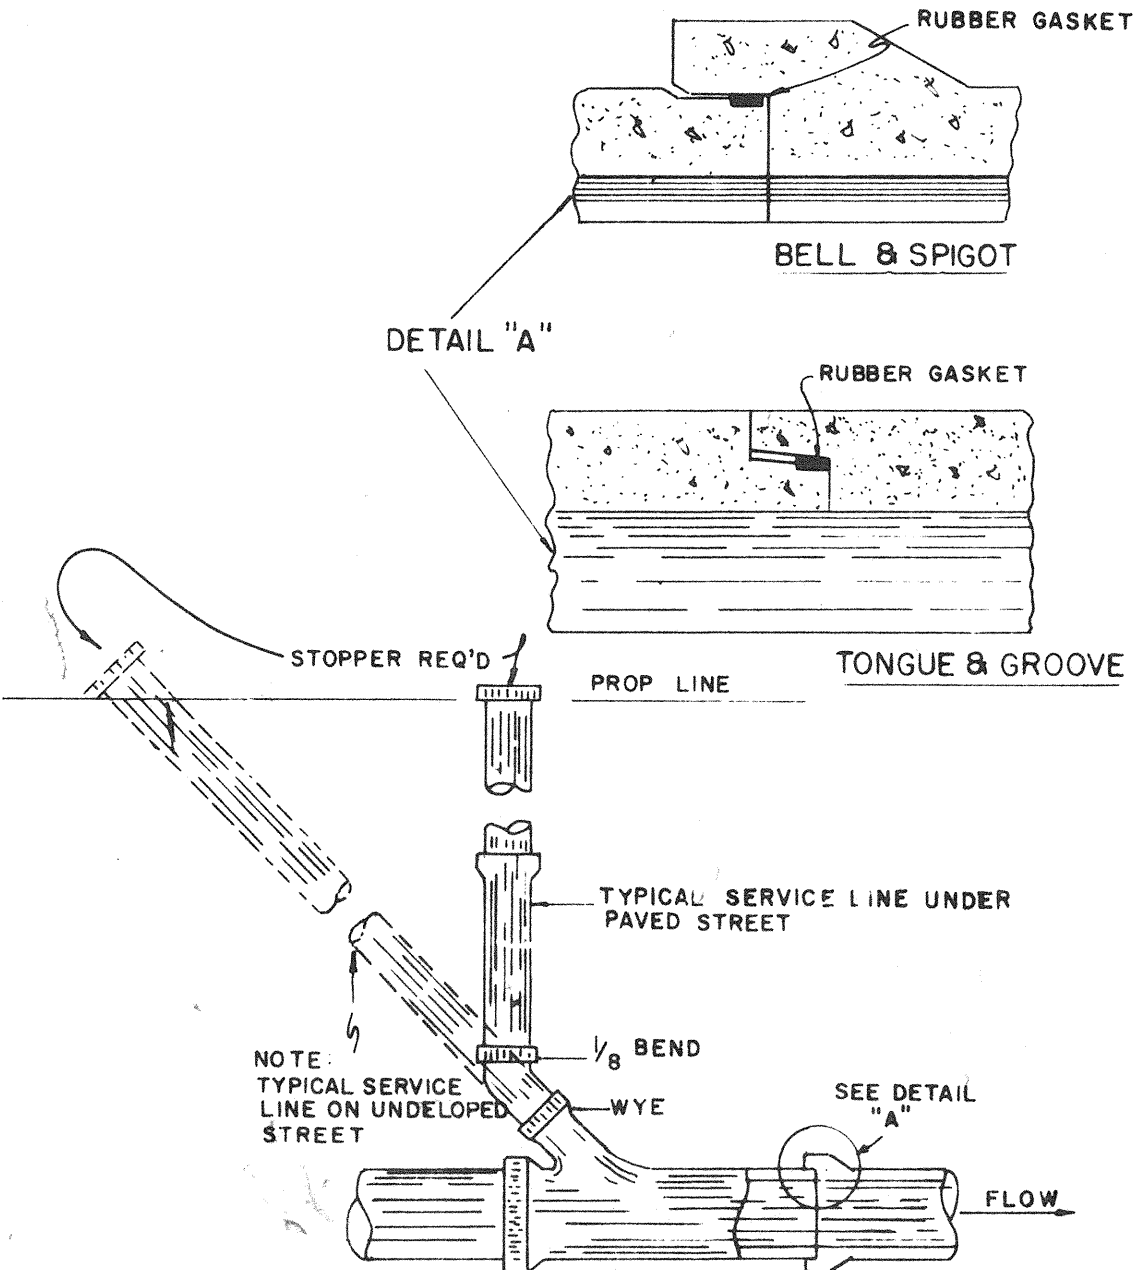

TYPICAL SERVICE TO PROPERTY LINE OR TEE CONNECTION AS REQUIRED BY CITY OF JACKSON


W-1077

HIGHLAND COLONY BUSINESS PARK

SEWER DETAILS

BROWNING, INC.
 Consulting Engineers Jackson, Mississippi
 Designed By: P.L.B. Scale: NONE Sheet 11 of 14
 Drawn By: J.F. Date: AUG, 1995

GROUP III DIAGRAMS
6-12 FT TRAFFIC LANES ~ 4 FT THRU 36 FT MEDIANS
OR 4-12 FT (PRESENT) & 2-12 FT (FUTURE) TRAFFIC LANES
WITH 28 FT THRU 60 FT MEDIANS

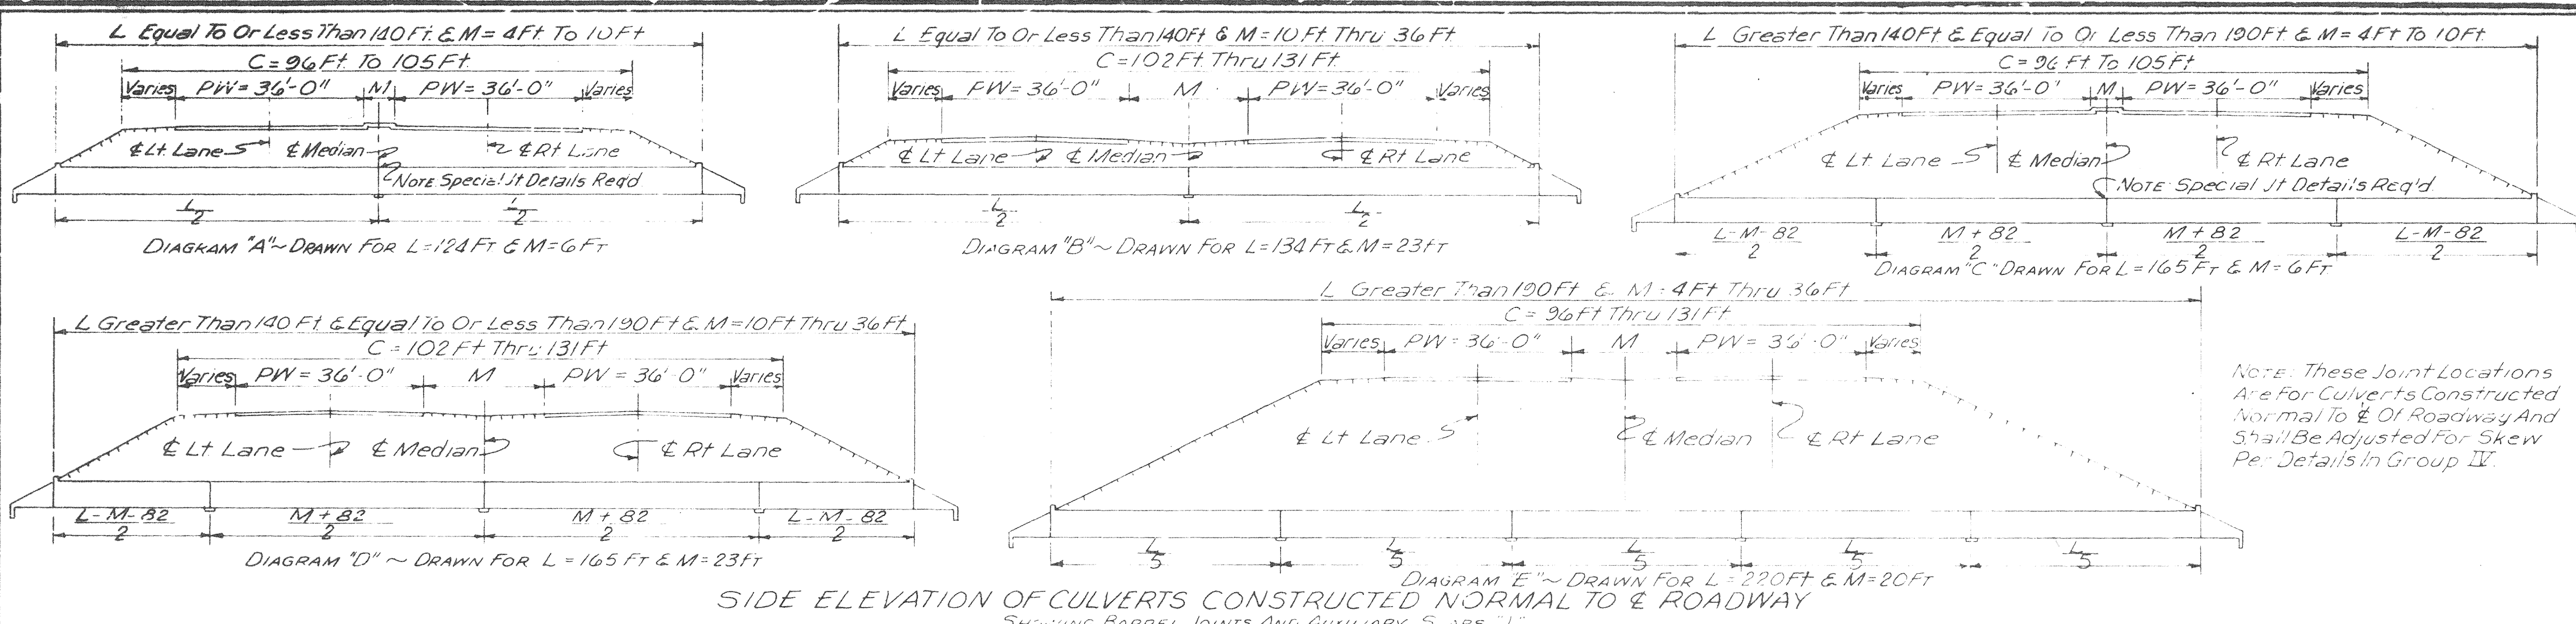

GROUP IV DIAGRAMS
TYPICAL DIAGRAMS FOR SKEWED CULVERTS

APPLICATION OF DIAGRAMS:
The Following Diagrams Show The General Application Of Joint Location Diagrams In Groups I, II & III To Skewed Culverts. LOCATION OF BARREL JOINTS FOR SKEWED CULVERTS IS DETERMINED AS FOLLOWS:
1. With LSK (Length Of Skewed Culvert Along & Barrel) Given And Number Of Joints And Length Of Barrel Sections Required, MULTIPLY LSK By The COSINE OF THE SKEW ANGLE (θ) To Obtain L (Length Of Culvert Normal To & Roadway).
2. Enter Group I, II Or III (Determined By Roadway Cross Section) With L To Determine The Number Of Joints And Length Of Each Barrel Section For A Culvert Constructed Normal To & Roadway.
3. DIVIDE Each Length Of Section By The COSINE OF THE SKEW ANGLE (θ) To Determine The Length Of Each Barrel Section Along & Barrel.
4. Place The Barrel Joints (Type Per Basic Dwg.) At These Locations. If The Length Of Any Section Exceeds 70 FT And A Construction Joint Is Desired (To Reduce Yardage Of Pour) Place A Construction Joint In Center Of Section.

Note: These Joint Locations Are For Culverts Constructed Normal To & Of Roadway And Shall Be Adjusted For Skew Per Details In Group IV.

GROUP II DIAGRAMS
4-12 FT TRAFFIC LANES
4 FT THRU 60 FT MEDIANS

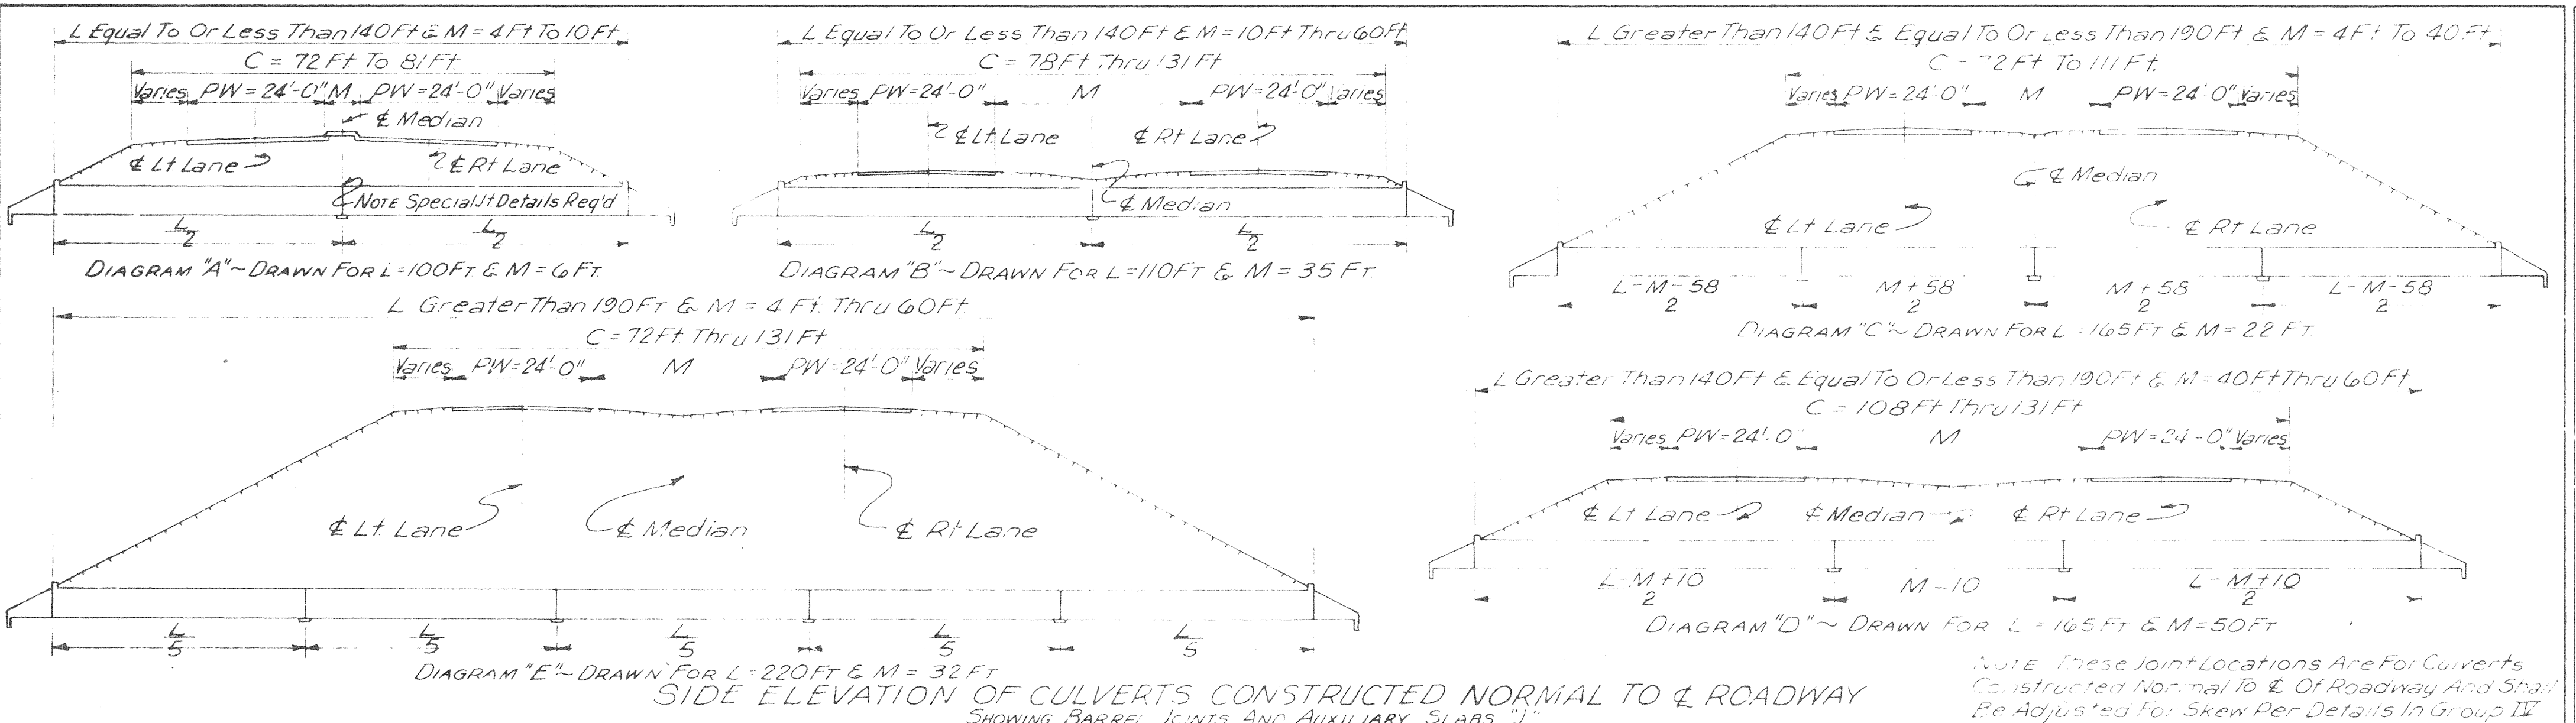


DIAGRAM "A"
PLAN OF SKEWED CULVERT
TYPICAL FOR DIAGRAM "A" GROUP I AND SKEWED 15° RIGHT FORWARD
(NO BARREL JOINTS REQUIRED)
NOTE: LSK = 103528L FOR 15° SKEW.

DIAGRAM "B"
PLAN OF SKEWED CULVERT
TYPICAL FOR DIAGRAM "B" GROUP III AND SKEWED 30° RIGHT FORWARD
(ONE BARREL JOINT REQUIRED)
NOTE: LSK = 115470L FOR 30° SKEW.

DIAGRAM "C"
PLAN OF SKEWED CULVERT
TYPICAL FOR DIAGRAM "D" GROUP II AND SKEWED 45° RIGHT FORWARD
(TWO BARREL JOINTS REQUIRED)
NOTE: LSK = 141421L FOR 45° SKEW.

*NOTE: L = LENGTH OF CULVERT NORMAL TO & ROADWAY PER DIAGRAMS A, B, C, D, E, GROUPS I, II & III.

GROUP I DIAGRAMS
2 OR 3-10 FT THRU 12 FT TRAFFIC LANES
OR
2-12 FT (PRESENT) & 1-12 FT (FUTURE) TRAFFIC LANES

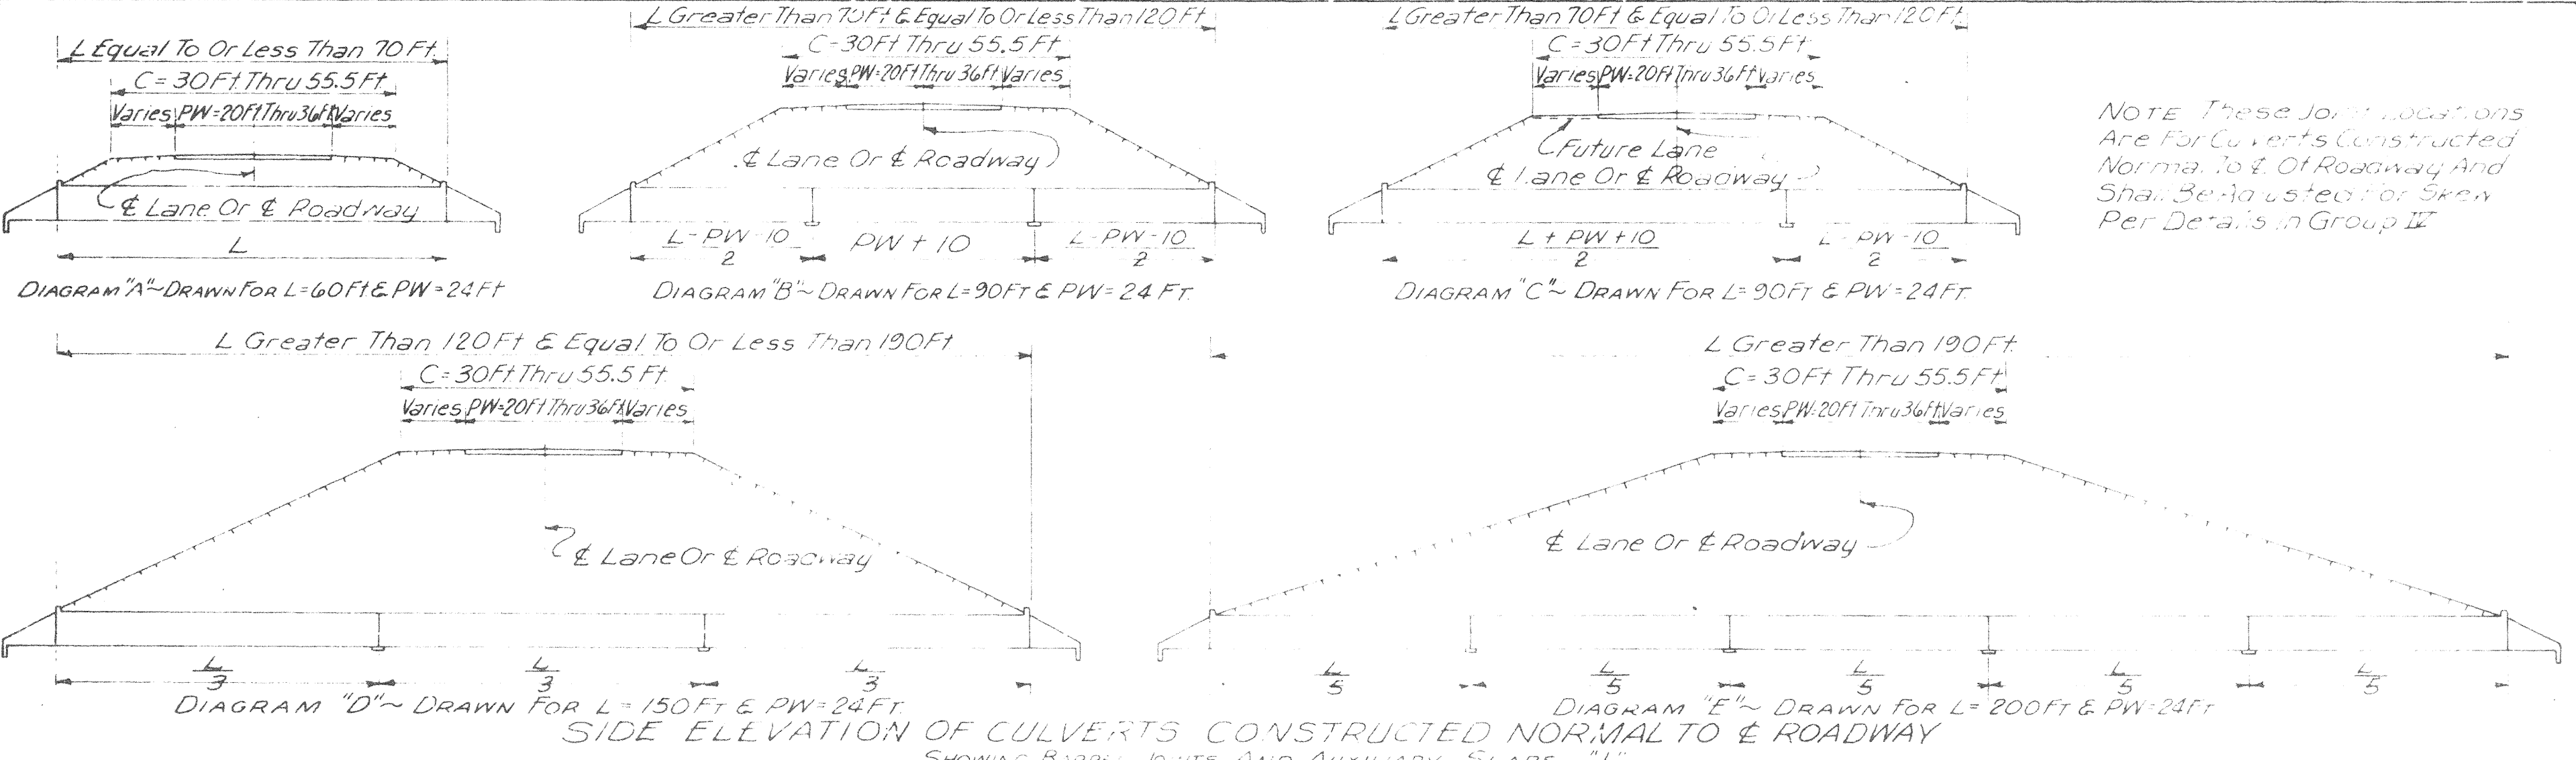



DIAGRAM "A"
PLAN OF SKEWED CULVERT
TYPICAL FOR DIAGRAM "A" GROUP I AND SKEWED 15° RIGHT FORWARD
(NO BARREL JOINTS REQUIRED)

DIAGRAM "B"
PLAN OF SKEWED CULVERT
TYPICAL FOR DIAGRAM "B" GROUP III AND SKEWED 30° RIGHT FORWARD
(ONE BARREL JOINT REQUIRED)

DIAGRAM "C"
PLAN OF SKEWED CULVERT
TYPICAL FOR DIAGRAM "D" GROUP II AND SKEWED 45° RIGHT FORWARD
(TWO BARREL JOINTS REQUIRED)

*NOTE: L = LENGTH OF CULVERT NORMAL TO & ROADWAY PER DIAGRAMS A, B, C, D, E, GROUPS I, II & III.

GENERAL NOTES:
This Drawing Shows The Barrel Joint Locations For Box Culverts Constructed Normal To & Of Roadway And General Details Necessary To Locate Joints For Culverts On 15, 30 And 45° Skews. The Diagrams On This Sheet Show Joint Locations For Culverts Under Variable Amounts Of Cover, Crown Width And Side Slopes. Barrel Joints Shall Be Of Type Per Basic Drawing And Shall Be Placed Only At Locations Shown Unless Otherwise Stated. Joints Shall Not Be Located Closer Than 5 Ft. Outside Pavement For Cover Of 8 Ft. Or Less, Except In Cases Where Median Is Less Than 10 Ft. Where Cover Is 8 Ft. Or Less And A Joint Occurs Within The Limits Of 5 Ft. Beyond Each Edge Of Pavement, Use Complete Collar At Joints Per Drawing ICJ-1 Or ICJ-3-1. Where Cover Exceeds 8 Ft., Joints May Be Located Without Regard To Pavement Edge. Construction Joints Per Group II, If Required, Shall Have Reinforcement Continuous Thru Joint And Shall Be Placed Only At Locations Indicated. General Requirements Of Basic Culvert Drawings Shall Apply Except As Specifically Modified Hereon.

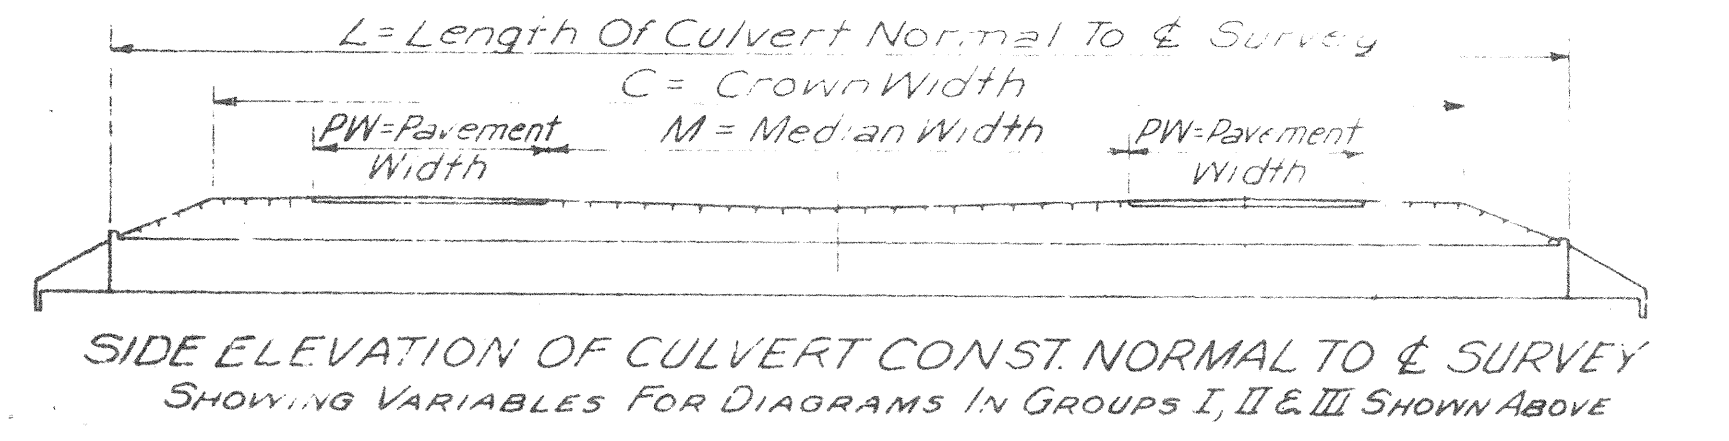






MISSISSIPPI STATE HIGHWAY DEPARTMENT
BOX CULVERT DRAWING
BARREL JOINT LOCATIONS
NORMAL AND SKEWED CULVERTS

DATE	REVISIONS	WORKING NUMBER
1-10-77	Title Block & General Notes	IBJL
DATE	DATE	DATE
TRACED	CHECKED	ISSUED
FILE	DATE	DATE
SHEET NUMBER		272

W-1077

CULVERT DIMENSIONS				ESTIMATED QUANTITIES				BAR LIST FOR BARREL (L=150') & PARAPETS & 4 AUXILIARY SLABS (2 J's & 2 W's)																																														
CLEAR MAX SPAN COVER	T	V	W	Y	CULVERT (L=150')		1 AUX. SLAB 'J'		BARS 'A'		BARS 'B'		BARS 'C'		BARS 'D'		DOWELS Q-#4		SPACERS QS-#4		SETS OF BARS AS-#4		SETS OF BARS BS-#4		SETS OF BARS DS-#4		SETS OF BARS ES-#4		BARS H-#4		BARS I-#4		BARS J-#4		BARS K-#4		BARS L-#4		BARS M-#4		BARS N-#4													
					CONC. CU. YD.	REINF. STEEL LB.	CONC. CU. YD.	REINF. STEEL LB.	NO.	SIZE	SPAC.	LGTH.	NO.	SIZE	SPAC.	LGTH.	NO.	SIZE	SPAC.	LGTH.	NO.	SIZE	SPAC.	LGTH.	NO.	SIZE	SPAC.	LGTH.	NO.	SIZE	SPAC.	LGTH.	NO.	SIZE	SPAC.	LGTH.	NO.	SIZE	SPAC.	LGTH.	NO.	SIZE	SPAC.	LGTH.	NO.	SIZE	SPAC.	LGTH.						
8' 10"	10'	8'	1/40	33'-2 1/2"	296.44	34,101	1.7284	207.79	0.89	51	300	#4	10'	17'-3"	200	#4	6"	8'-2"	300	#5	1'-0"	17'-3"	300	#7	1'-0"	6'-10"	32	#6	4	7'-7"	16	152'-9"	16	155'-7"	28	152'-9"	12	152'-9"	204	9'-4"	12	152'-6"	204	7'-7"	8	152'-9"	32	4'-6"	4	17'-9"	8	17'-8"	76	2'-2"
10'	9'	11'	8 1/2"	37'-3"	366.31	42,375	2.1628	260.95	1.09	62	360	#4	10'	21'-0"	1200	#4	6"	8'-9"	360	#5	1'-0"	21'-0"	1200	#7	1'-0"	7'-10"	32	#6	4	7'-7"	20	152'-9"	20	155'-7"	32	152'-9"	16	152'-9"	204	9'-6"	12	152'-6"	204	7'-7"	8	152'-9"	40	4'-8"	4	21'-9"	8	21'-9"	92	2'-2"
12'	7'	14'	9"	41'-3 1/2"	456.14	48,403	2.7291	299.63	1.30	74	276	#4	1'-1"	26'-0"	1440	#4	5"	9'-5"	276	#6	1'-1"	26'-0"	1440	#8	1'-1"	8'-10"	32	#6	4	7'-7"	24	152'-9"	24	155'-7"	32	152'-9"	16	152'-9"	204	9'-9"	12	152'-6"	204	7'-7"	8	152'-9"	48	4'-11"	4	25'-10"	8	25'-11"	108	2'-2"
14'	6'	14'	9"	45'-3 1/2"	536.03	56,008	3.2307	348.39	1.49	85	276	#4	1'-1"	30'-0"	1440	#4	5"	10'-0"	276	#6	1'-1"	29'-6"	1440	#8	1'-1"	9'-10"	32	#6	4	7'-7"	28	152'-9"	28	155'-7"	36	152'-9"	20	152'-9"	204	9'-11"	12	152'-6"	204	7'-7"	8	152'-9"	56	5'-1"	4	29'-10"	8	29'-11"	124	2'-2"
16'	6'	14'	9"	49'-4"	630.75	70,208	3.8299	440.50	1.70	96	240	#5	1'-3"	34'-1"	200	#5	6"	10'-9"	240	#7	1'-3"	33'-8"	240	#10	1'-3"	10'-10"	32	#6	4	7'-7"	32	152'-9"	32	155'-7"	36	152'-9"	20	152'-9"	204	10'-1"	12	152'-6"	204	7'-7"	8	152'-9"	64	5'-3"	4	33'-10"	8	34'-0"	140	2'-2"

BAR LIST FOR WINGS & APRONS											
BAR SIZE	NO. REQUIRED				DIM. X	DIM. XI	LENGTH				
	8"	10"	12"	16"							
T1	#4	2	2	2	2		25+11.8'				
T2	#4	2	2	2	2		25+21.0'				
T3	#4	2	2	2	2		25+41.0'				
T4	#4	2	2	2	2		25+51.2'				
T5	#4	2	2	2	2		25+61.3'				
T6	#4	2	2	2	2		25+71.5'				
T7	#4	2	2	2	2		25+81.7'				
T8	#4	2	2	2	2		25+91.9'				
T9	#4	2	2	2	2		25+101.1'				
T10	#4	2	2	2	2		25+111.3'				
T11	#4	2	2	2	2		25+121.5'				
T12	#4	2	2	2	2		25+131.7'				
T13	#4	2	2	2	2		25+141.9'				
T14	#4	2	2	2	2		25+152.1'				
T15	#4	2	2	2	2		25+162.3'				
U	#4	12	12	12	12		16'-1"				
V1	#4	38	46	54	62	14'-2"	1'-8"				
V2	#4	4	4	4	4	12'-3"	1'-8"				
V3	#4	4	4	4	4	10'-6"	1'-8"				
V4	#4	4	4	4	4	8'-10"	1'-8"				
V5	#4	4	4	4	4	7'-1"	1'-8"				
V6	#4	4	4	4	4	5'-9"	1'-8"				
V7	#4	4	4	4	4	3'-8"	1'-8"				
W1	#5	16	16	16	16	6'-6"	W+6'-7"				
W2	#5	12	12	12	12	4'-1"	W+5'-8"				
W3	#5	8	8	8	8	3'-8"	W+4'-9"				
W4	#4	8	8	8	8	3'-4"	W+3'-11"				
W5	#4	8	8	8	8	3'-0"	W+3'-0"				
W6	#4	8	8	8	8	2'-8"	W+2'-2"				
W7	#4	8	8	8	8	2'-4"	W+1'-3"				
W8	#4	8	8	8	8	2'-0"	W+6'-0"				
Y1	#4	4	4	4	4		2'-11"				
Y2	#4	4	4	4	4		5'-3"				
Y3	#4	4	4	4	4		7'-7"				
Y4	#4	4	4	4	4		9'-10"				
Y5	#4	4	4	4	4		12'-2"				
Y6	#4	4	4	4	4		14'-5"				
Y7	#4	8	8	8	8		16'-1"				

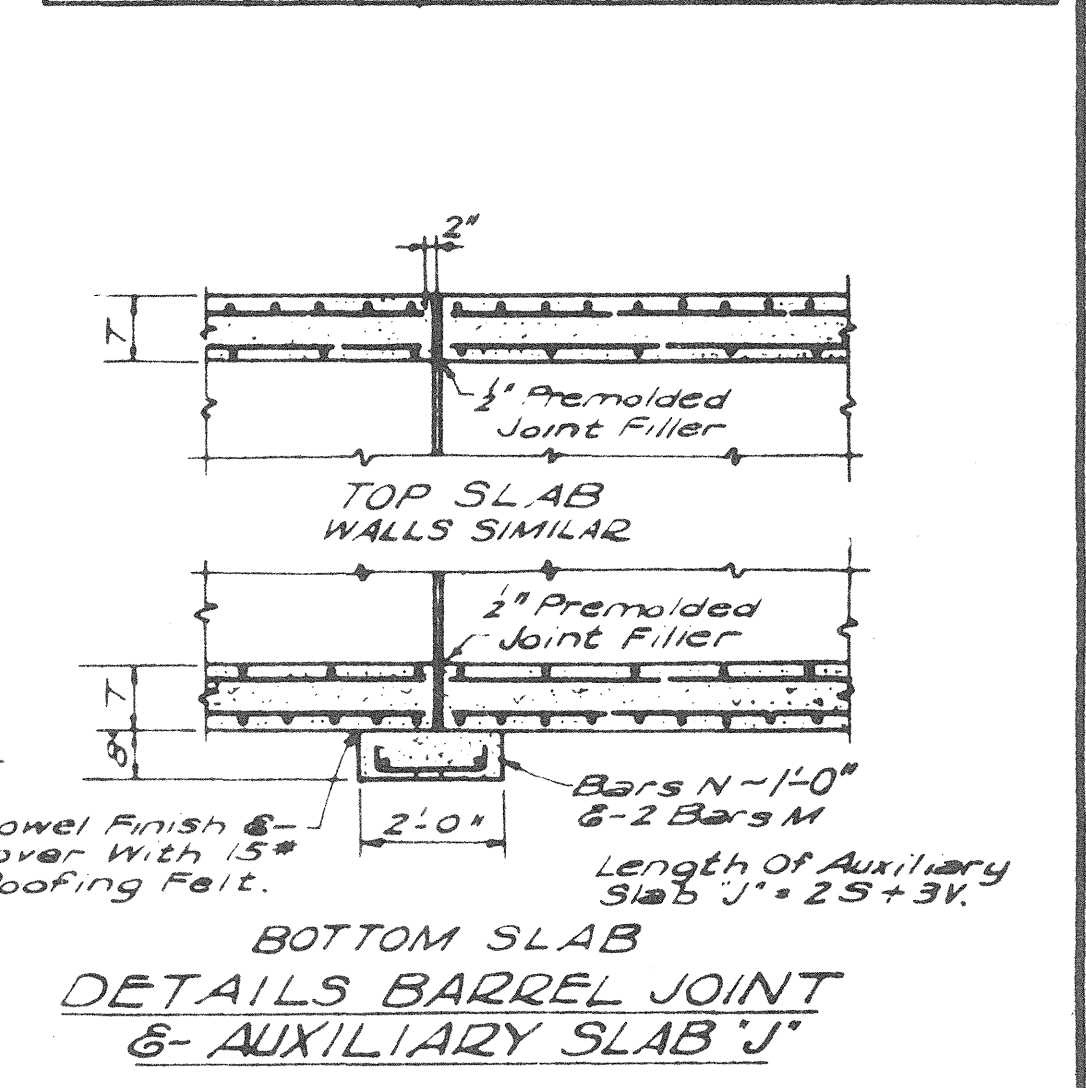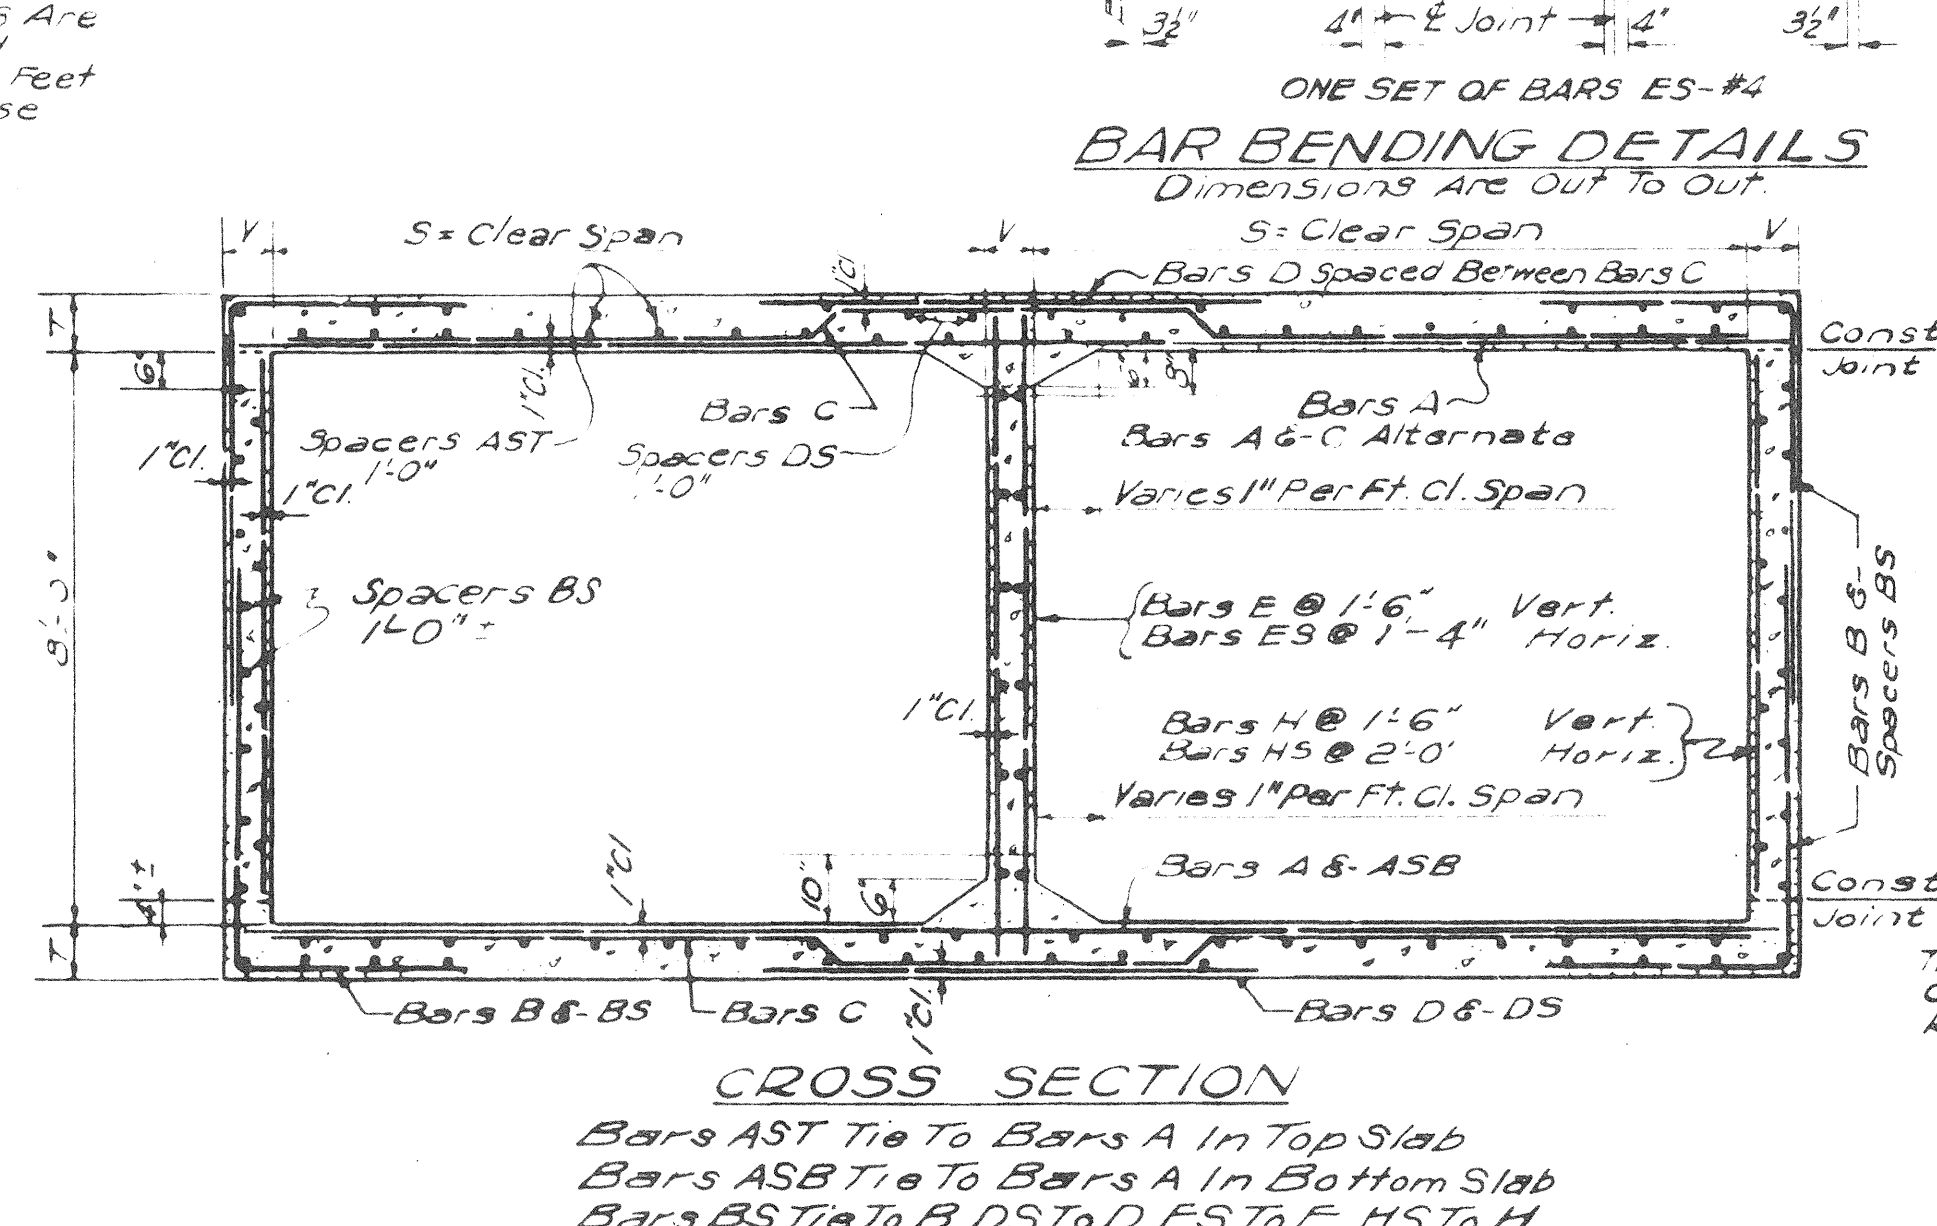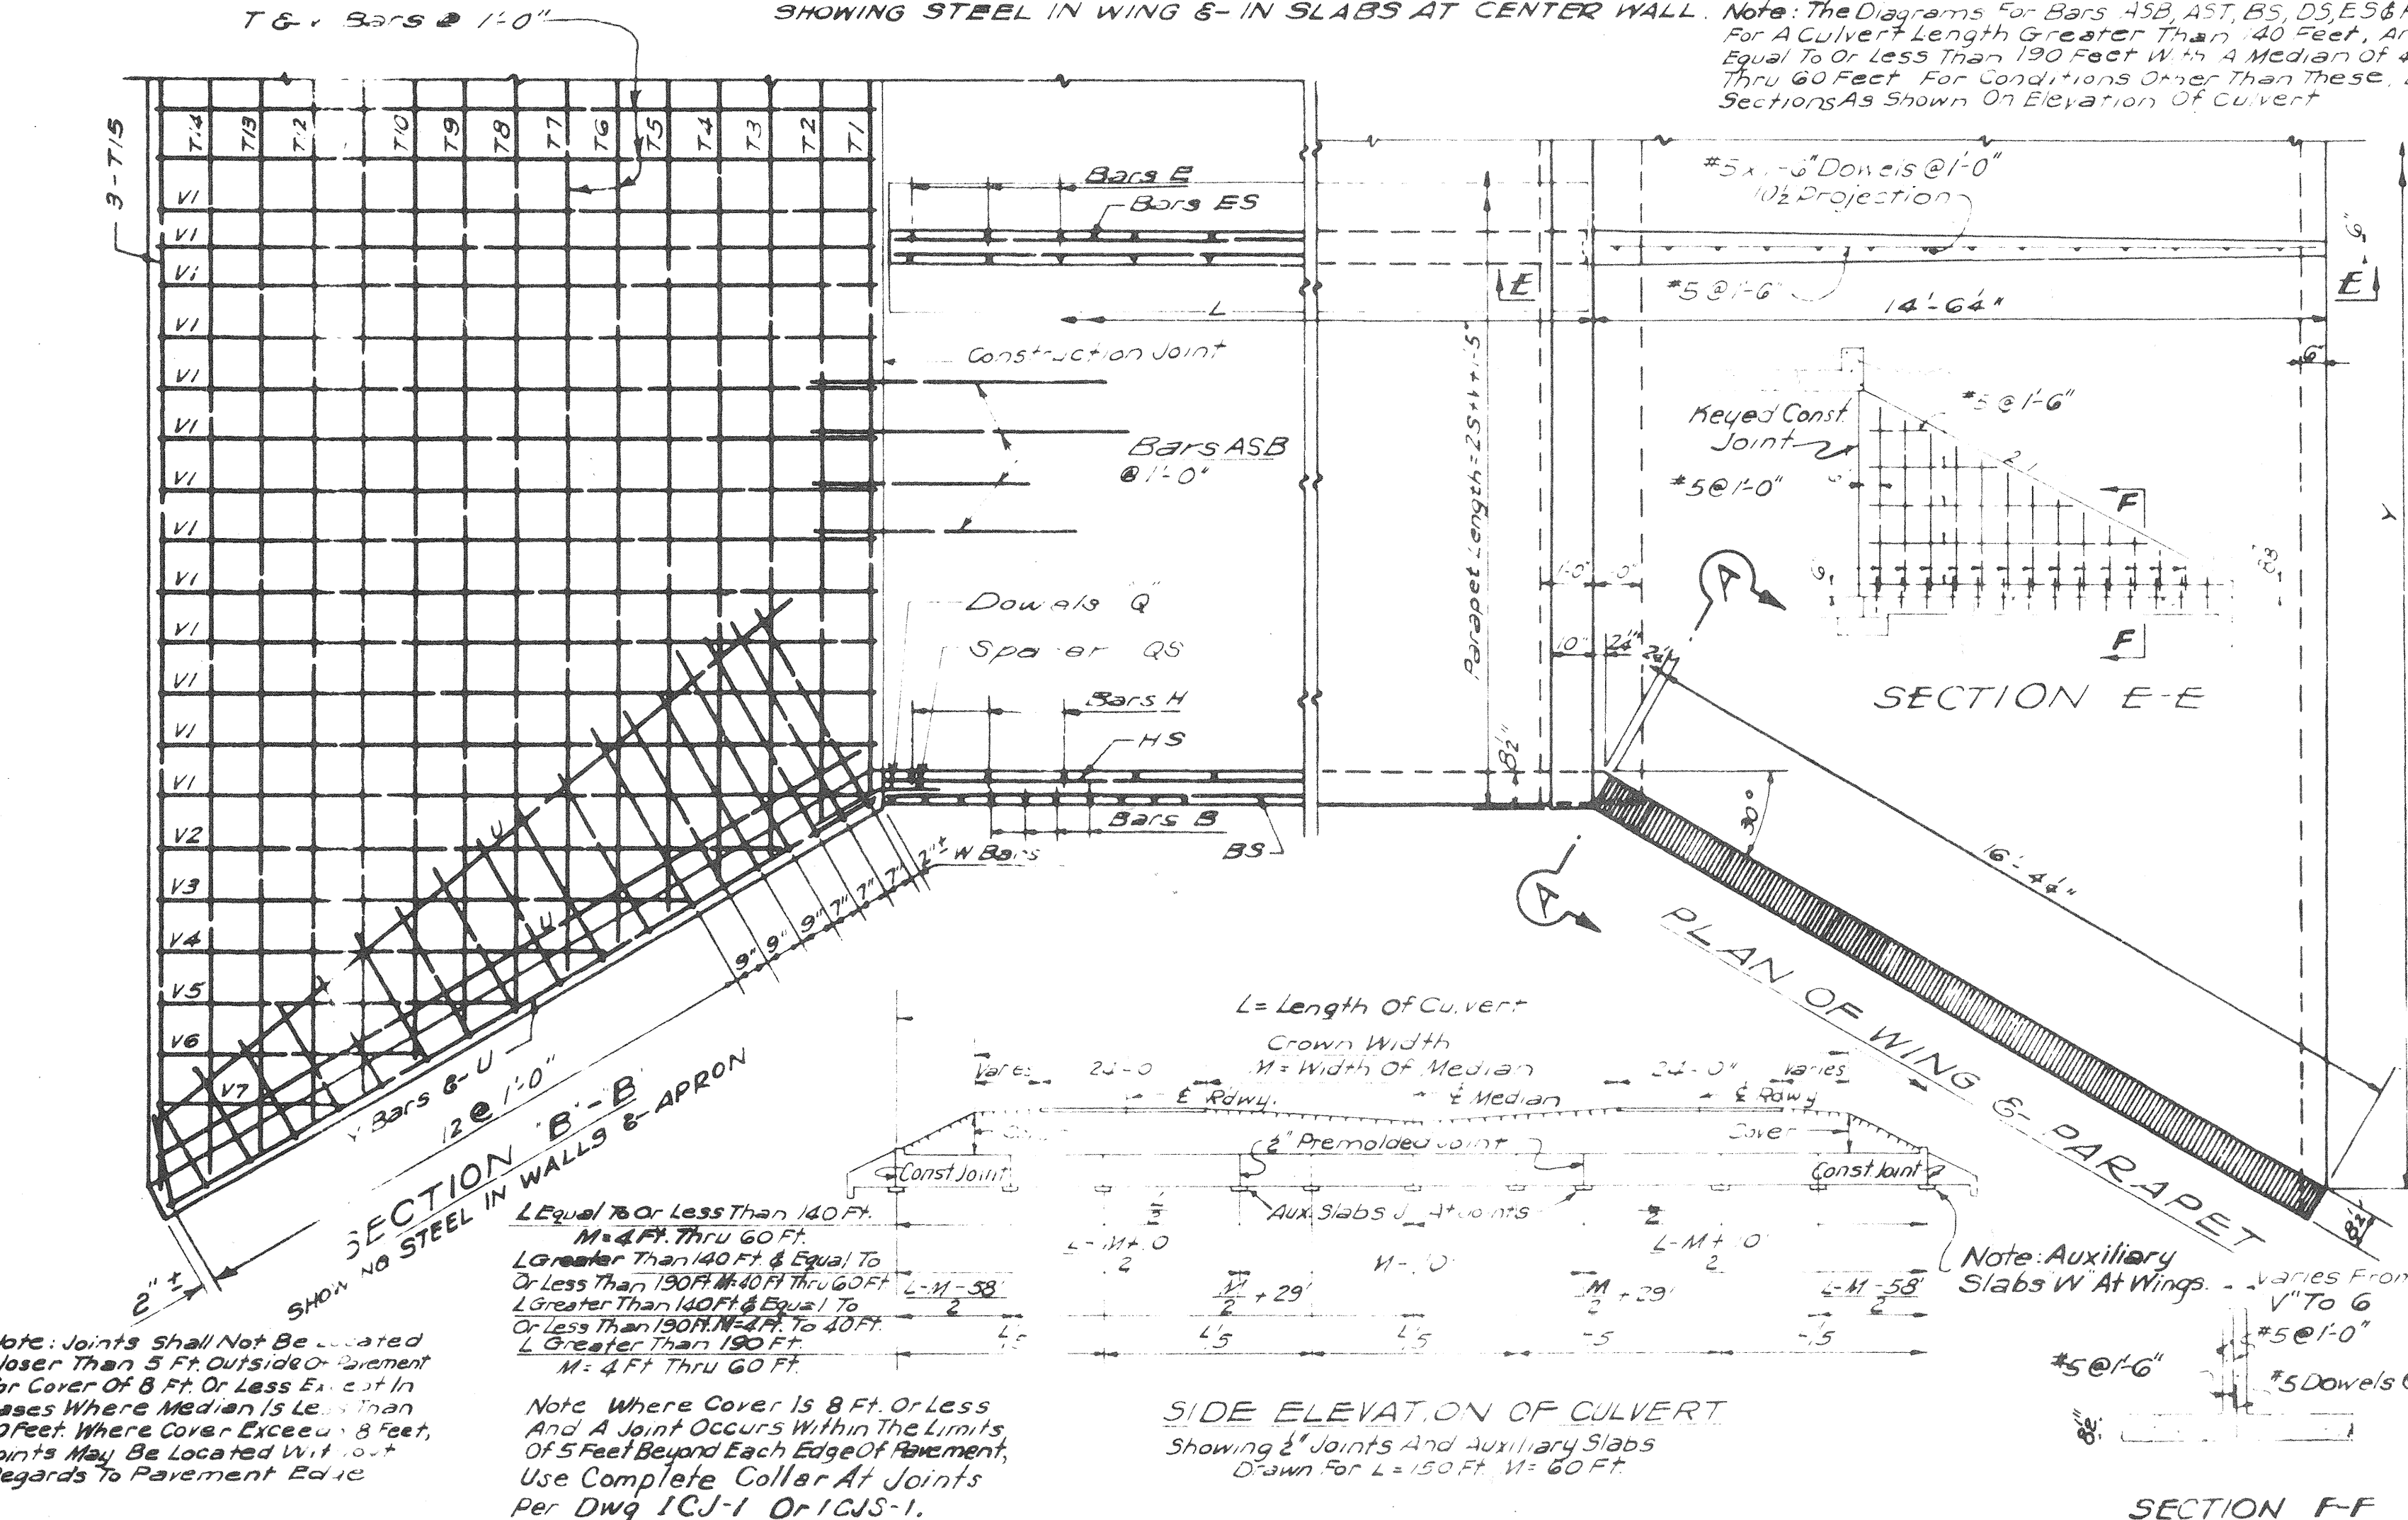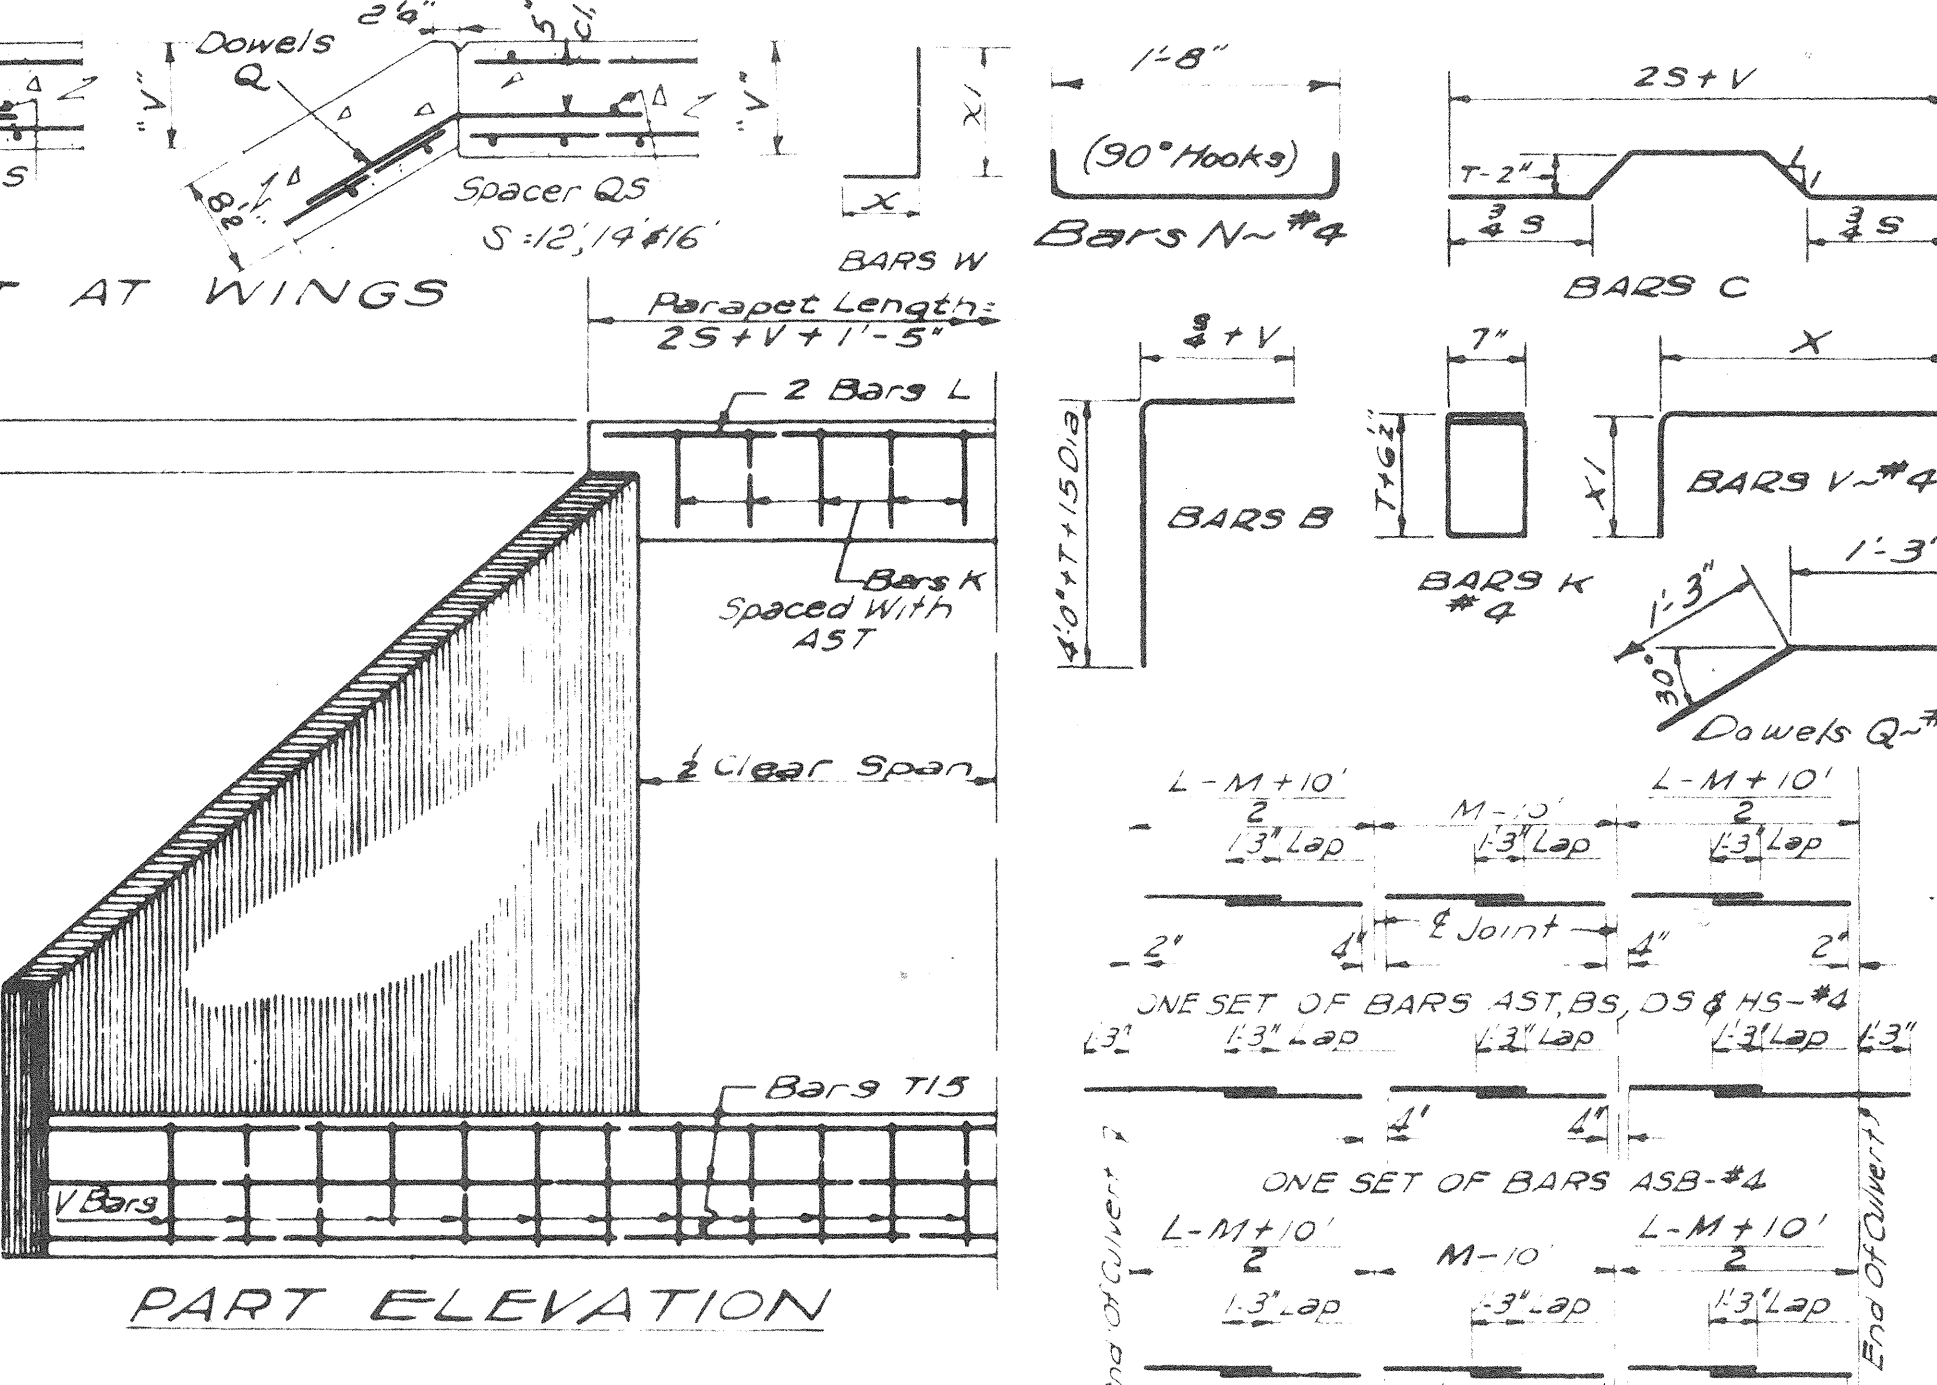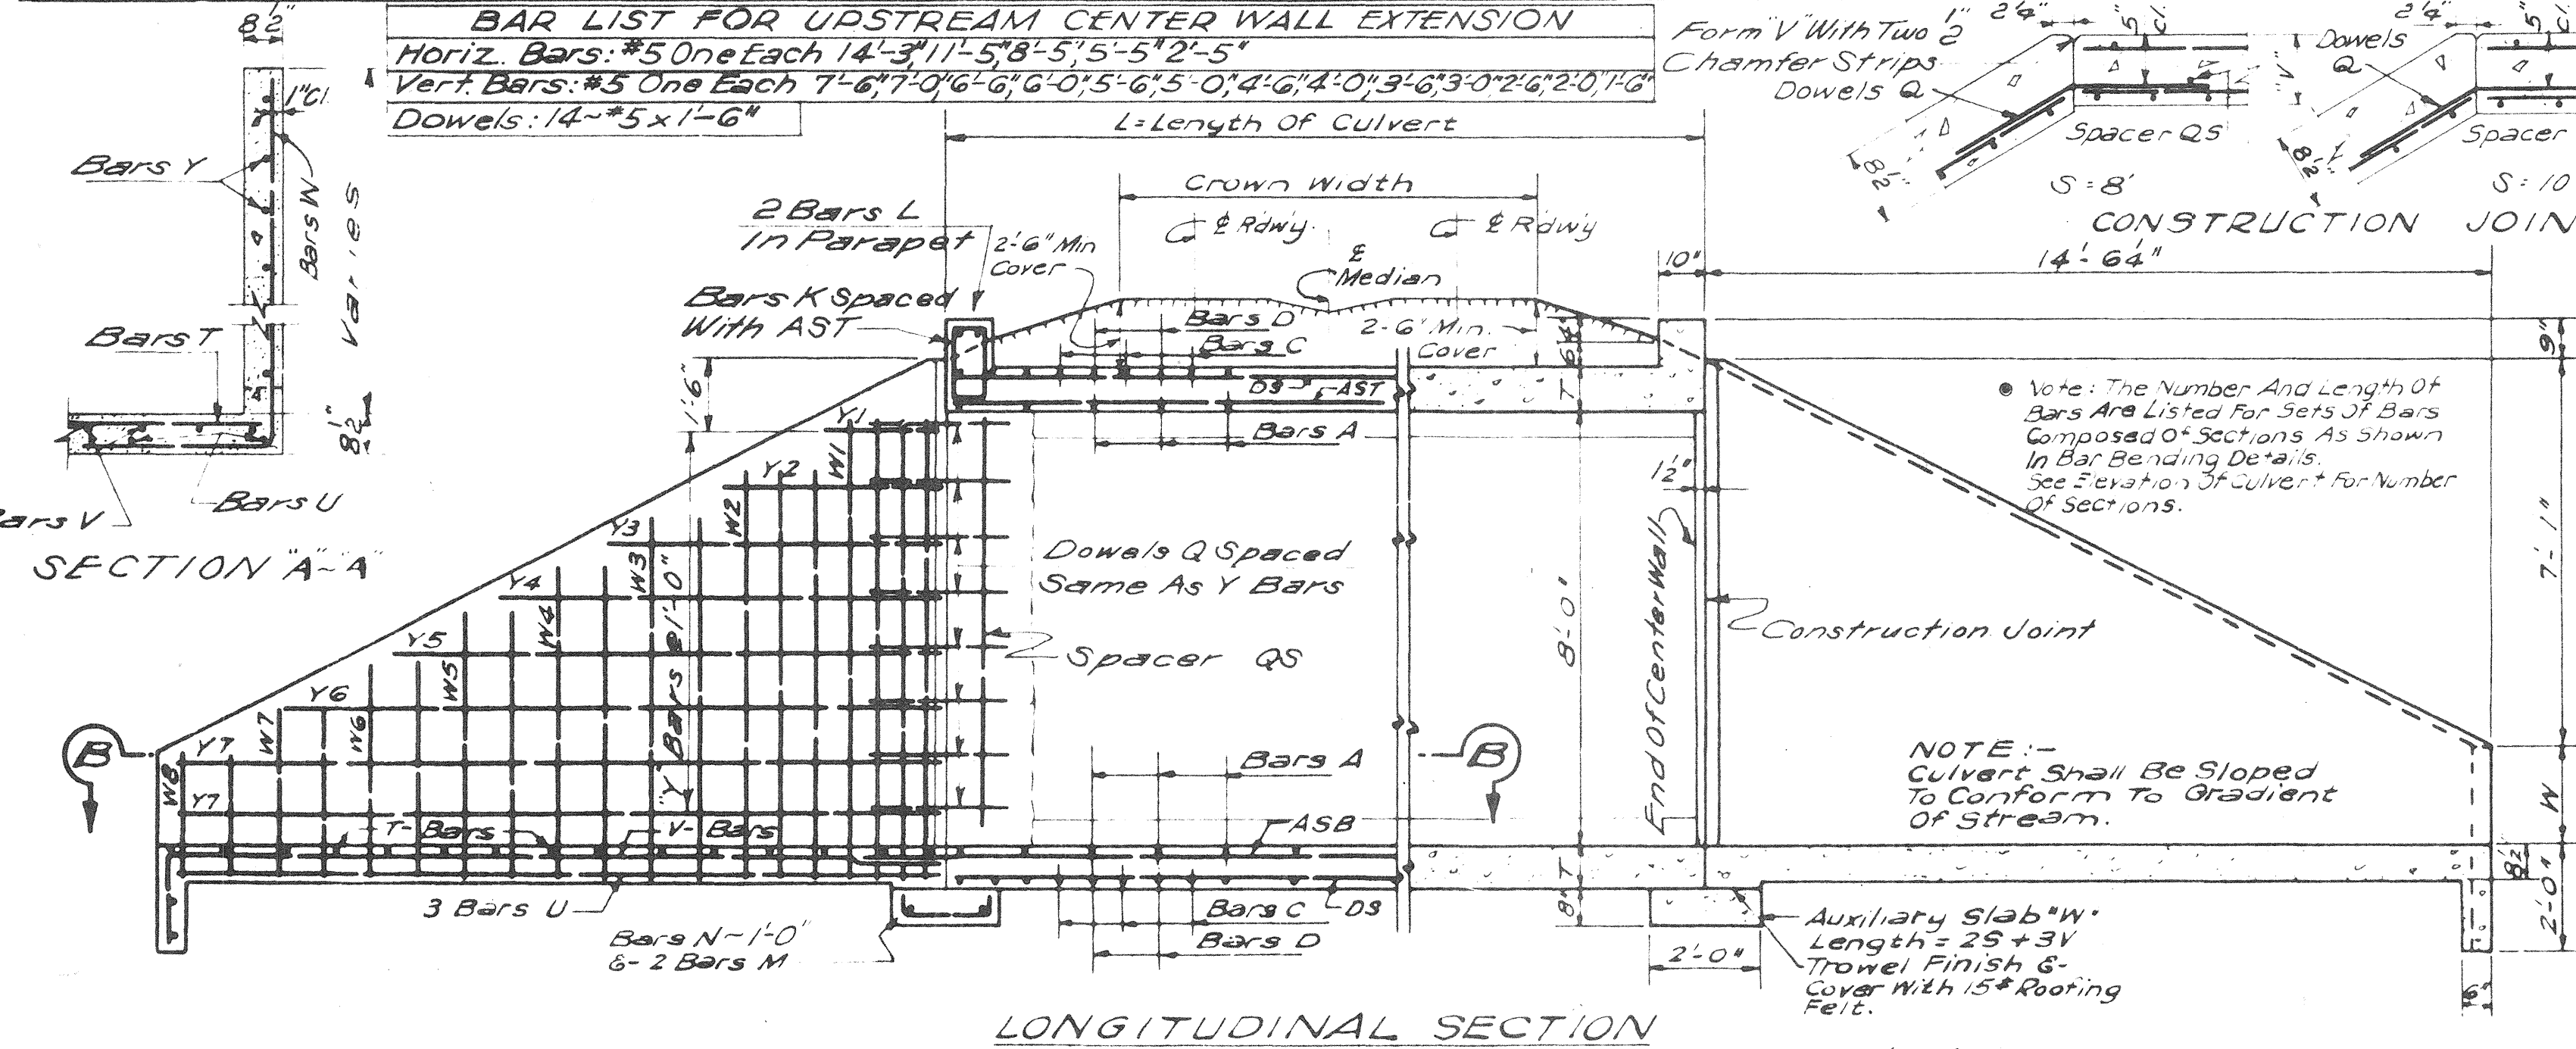

GENERAL NOTES:

- Specifications: Mississippi State Highway Department.
- All Concrete Shall Be Class 'B' For Box Culverts And Class 'BB' For Box Bridges.
- Concrete Surfaces Shall Be Finished In Accordance With Sub Section 804.24.
- All Exposed Corners Shall Be Chamfered 3/8 Inch.
- Reinforcing Steel Shall Be Placed 1" Clear Minimum From The Surface of The Concrete, And Shall Be Adequately Supported From The Forms.
- All Bars Shall Be Accurately Spaced And Securely Wired At Each Intersection Before Placing Concrete.
- Horizontal Construction Joints Shall Be Placed Only At The Locations Shown, And The Concrete Shall Be Allowed To Set A Minimum Period Of Two Hours Before Continuing The Pour.
- Auxiliary Slabs W And Vertical Construction Joints At The Wings Shall Be Placed In All Culverts Regardless Of Length.
- The Quantities Shown Will Be Used As The Basis For Final Payment Unless This Drawing Is Modified.



DESIGN DATA

Specifications: A.A. 5 H.O. 1969
Live Load: H520-44 Mod For 24,000 Miles
Unit Stresses: fs = 20,000 psi, fc = 1,200 psi, n = 10.

MISSISSIPPI STATE HIGHWAY DEPARTMENT
BASIC CULVERT DRAWING
DOUBLE CELL
HEIGHT 8 FT.
TOTAL SPAN 16-32 FT.

WORKING NUMBER: **1BD-8-2W**
SHEET NUMBER: **294**

DATE: _____
DRAWN BY: _____
CHECKED BY: _____
ISSUED BY: _____
DATE: _____

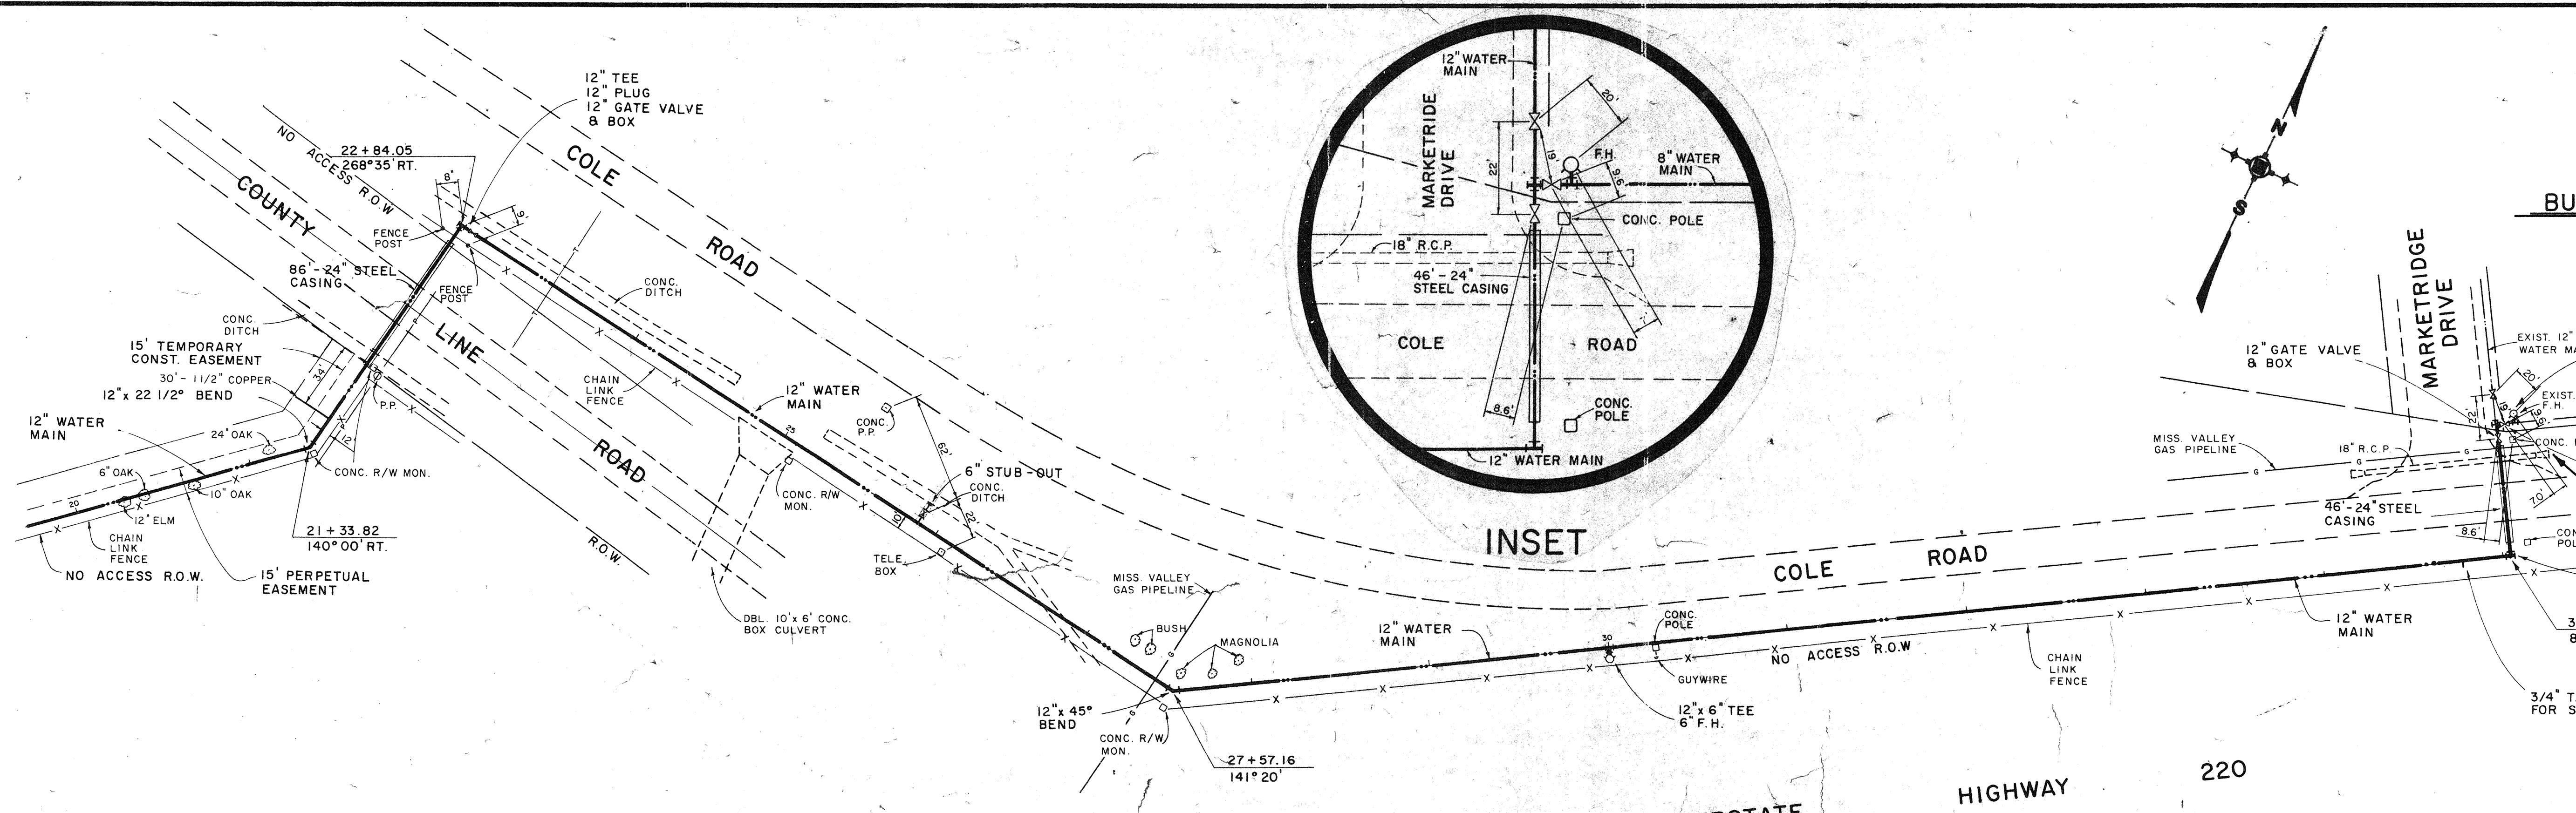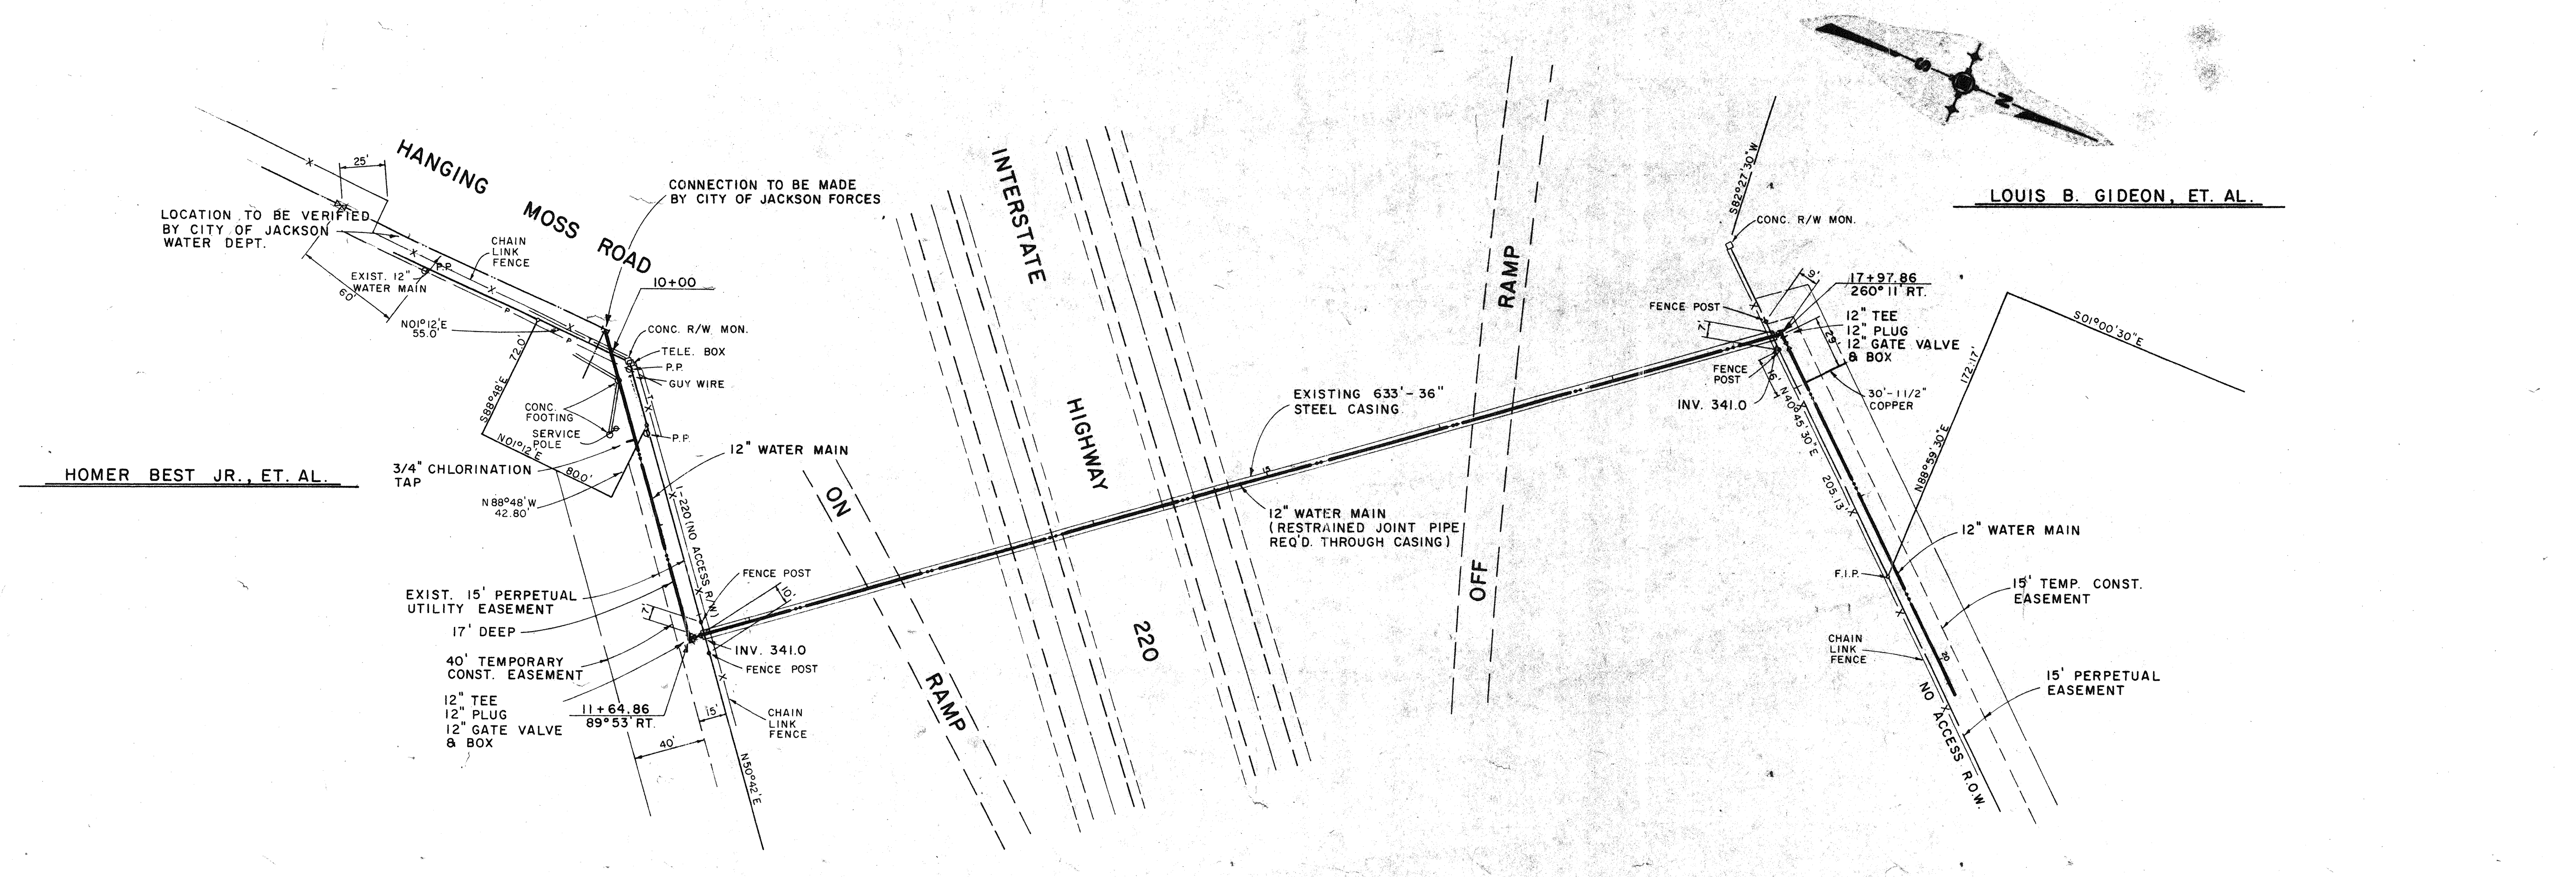

AS-BUILT
Date 7-11-88
W-904

NO.	DATE	NATURE	BY	APP'D.	CHECKED	JOB NO.
		REVISIONS			J.L.J.	7200.9


DESIGNED J.L.J.	DATE 4-6-88
DRAWN M.C.	SCALE 1" = 50'
CHECKED J.L.J.	JOB NO. 7200.9

UNDERWOOD DEVELOPMENT COMPANY
ENGINEERING ASSOCIATES, INC. - CONSULTING ENGINEERS
JACKSON / PEARL, MISSISSIPPI


Professional Engineer seals for Robert Montgomery and John L. Johnson, State of Mississippi.

PLAN		PROJECT NO.
COLE ROAD WATER MAIN		CONTRACT SHEET

LAKEOVER BOOK 15, PAGE 33-43


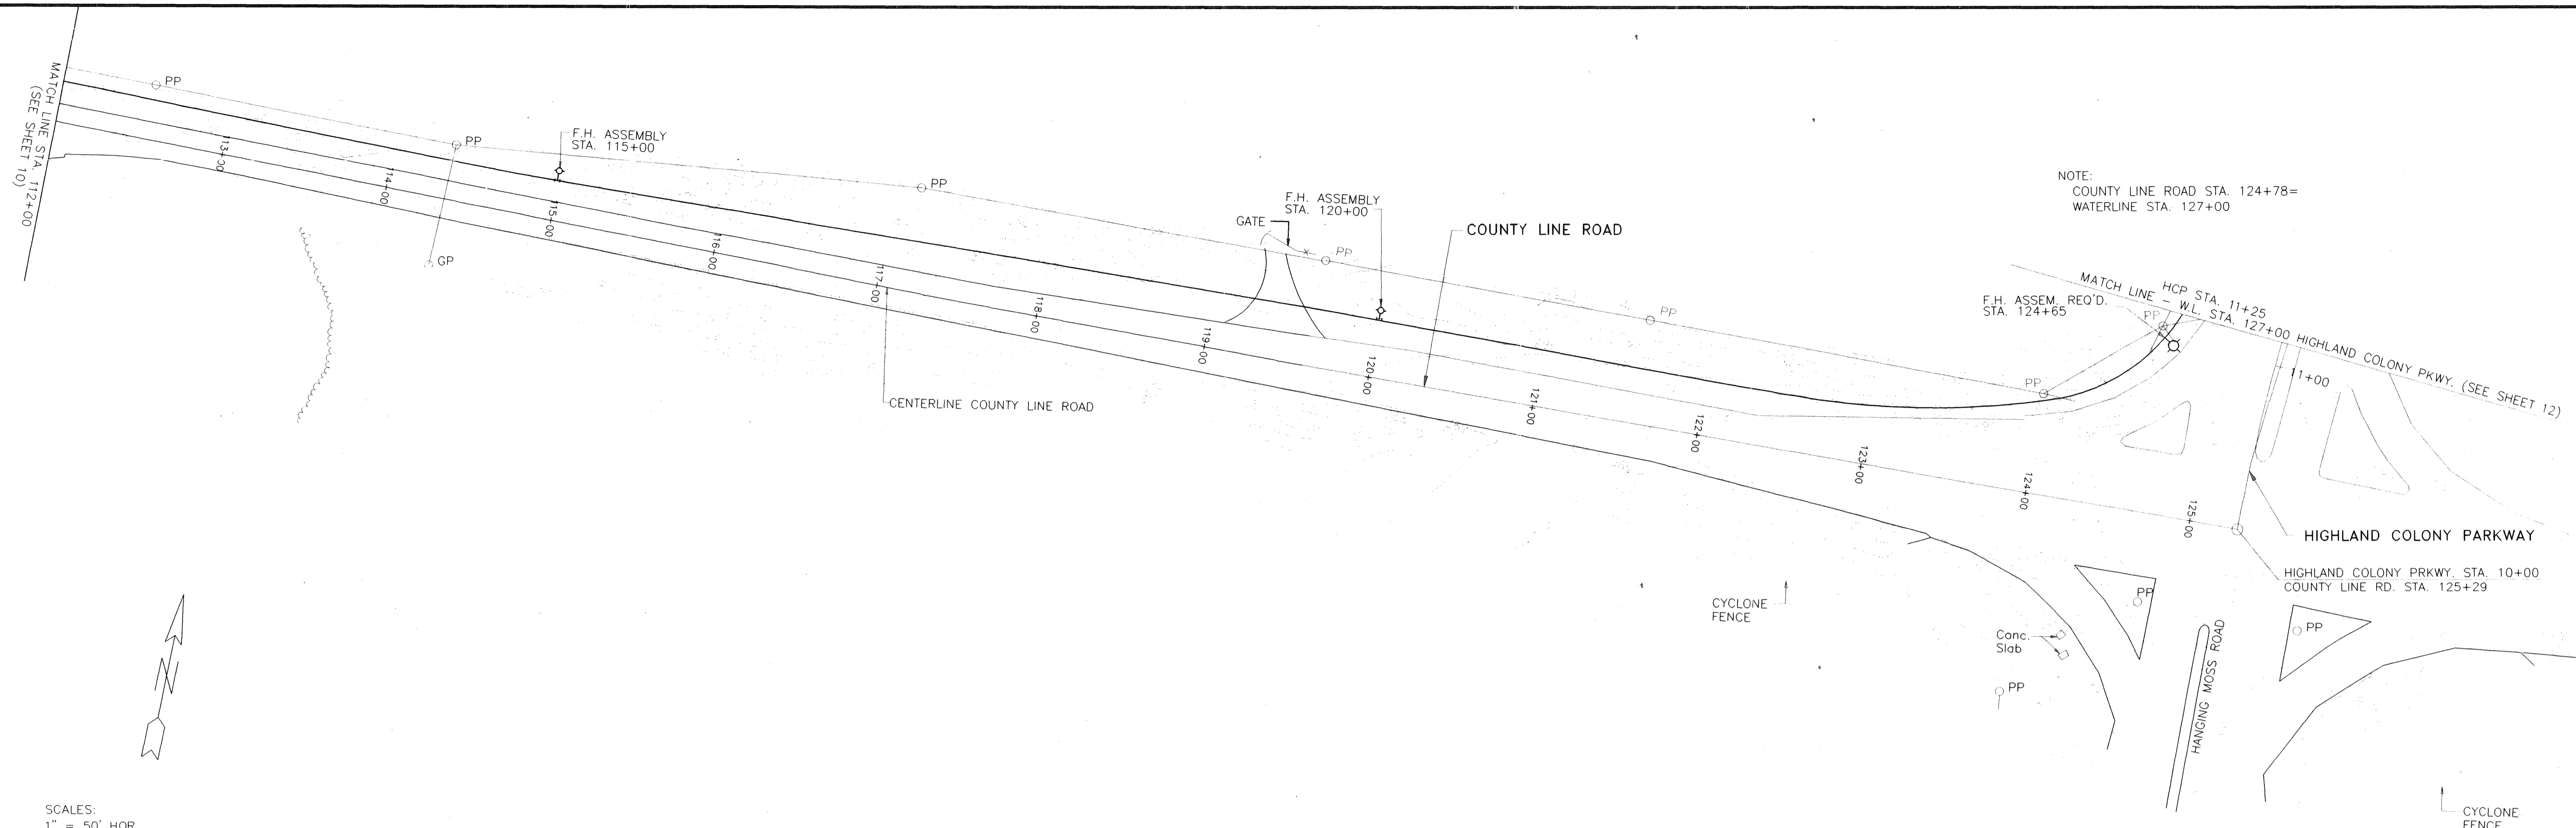


SCALES:
 1" = 50' HOR
 1" = 5' VER

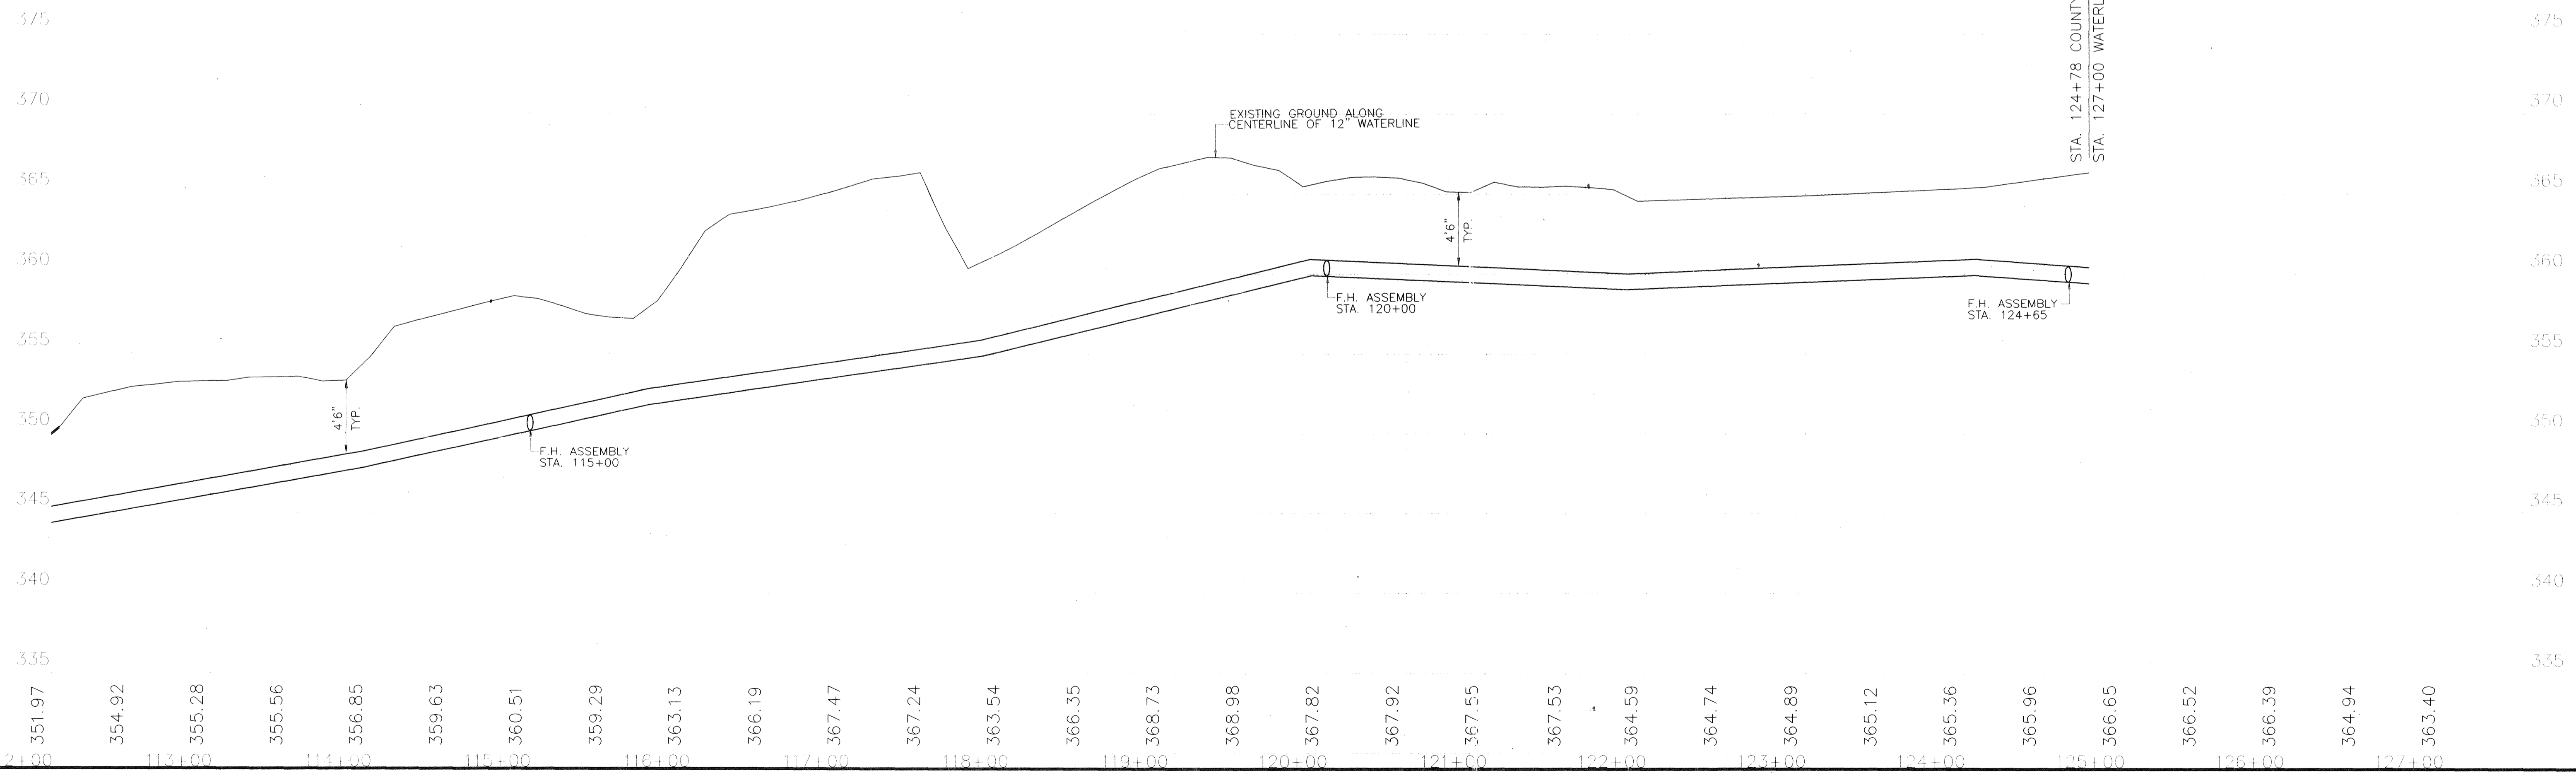

	MICHAEL BAKER, JR., INC. CONSULTING ENGINEERS Jackson, Mississippi	CITY OF JACKSON MISSISSIPPI	WATER LINE PROJECT NO. 227-W	DRAWING NO. CLWL-PP9
PLAN & PROFILE STA. 112+00 TO 125+29		SHEET 11		DATE SEPT. 1996

W-1095

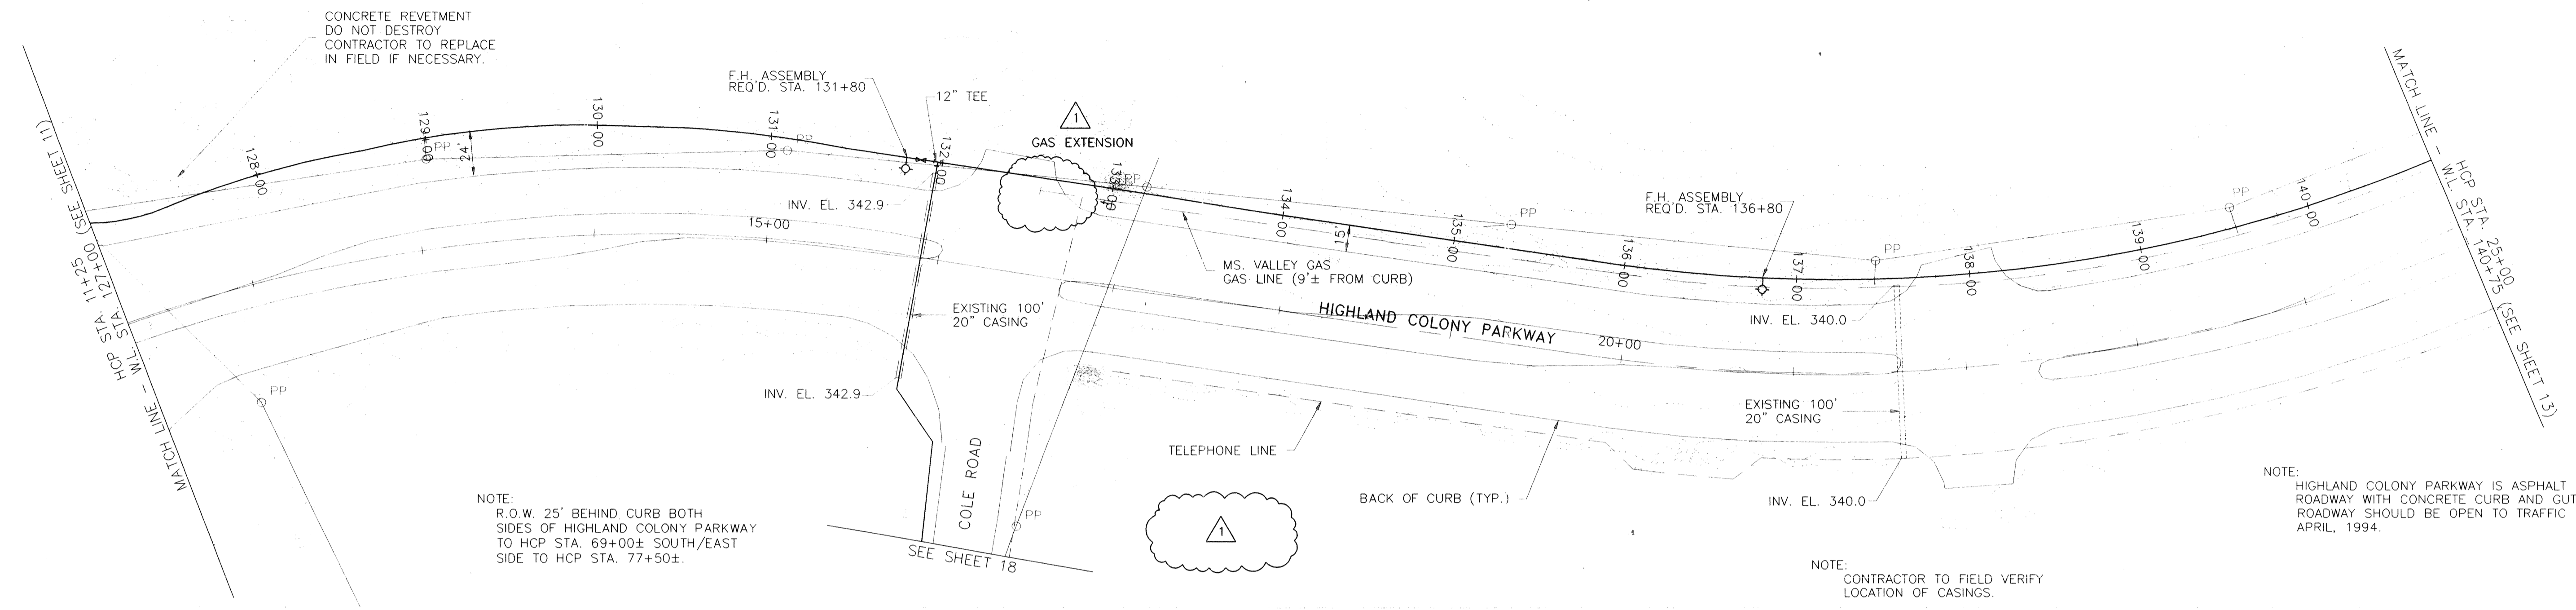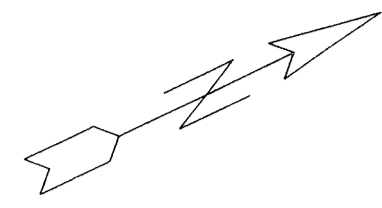


CONCRETE REVETMENT
DO NOT DESTROY
CONTRACTOR TO REPLACE
IN FIELD IF NECESSARY.


NOTE:
R.O.W. 25' BEHIND CURB BOTH
SIDES OF HIGHLAND COLONY PARKWAY
TO HCP STA. 69+00± SOUTH/EAST
SIDE TO HCP STA. 77+50±.

NOTE:
HIGHLAND COLONY PARKWAY IS ASPHALT
ROADWAY WITH CONCRETE CURB AND GUTTER
ROADWAY SHOULD BE OPEN TO TRAFFIC
APRIL, 1994.

NOTE:
CONTRACTOR TO FIELD VERIFY
LOCATION OF CASINGS.

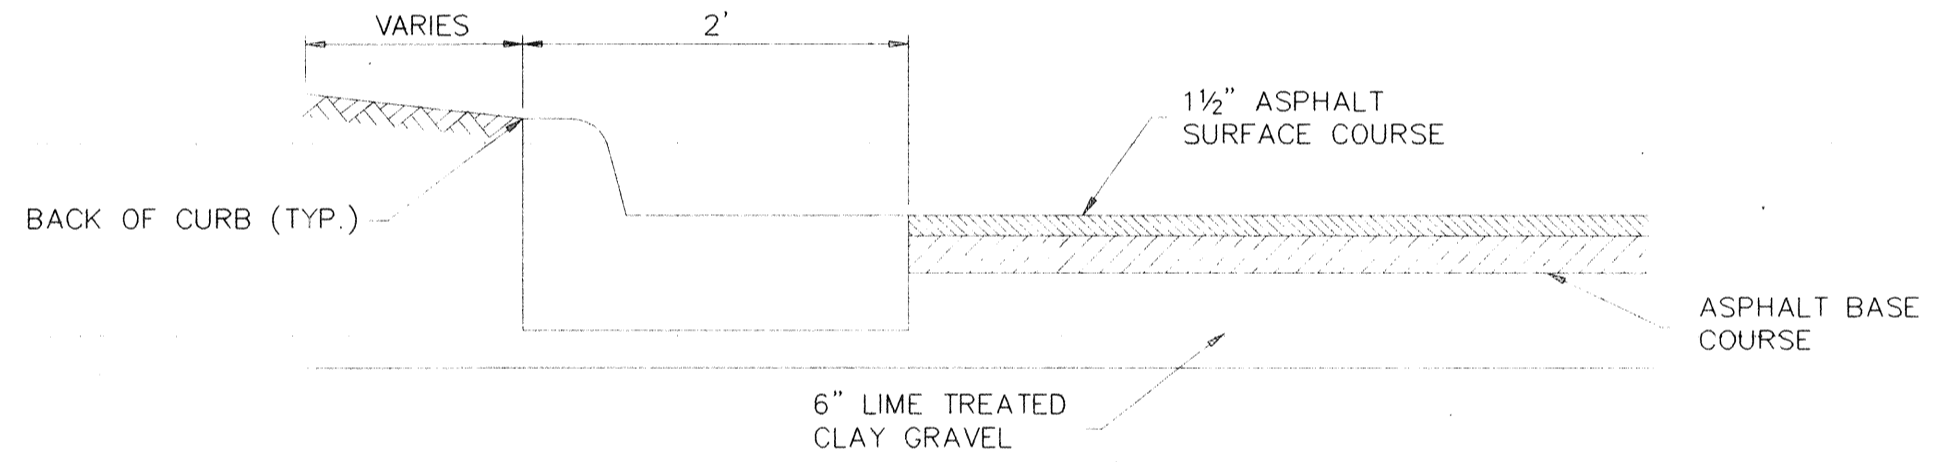

TYPICAL PAVEMENT SECTION

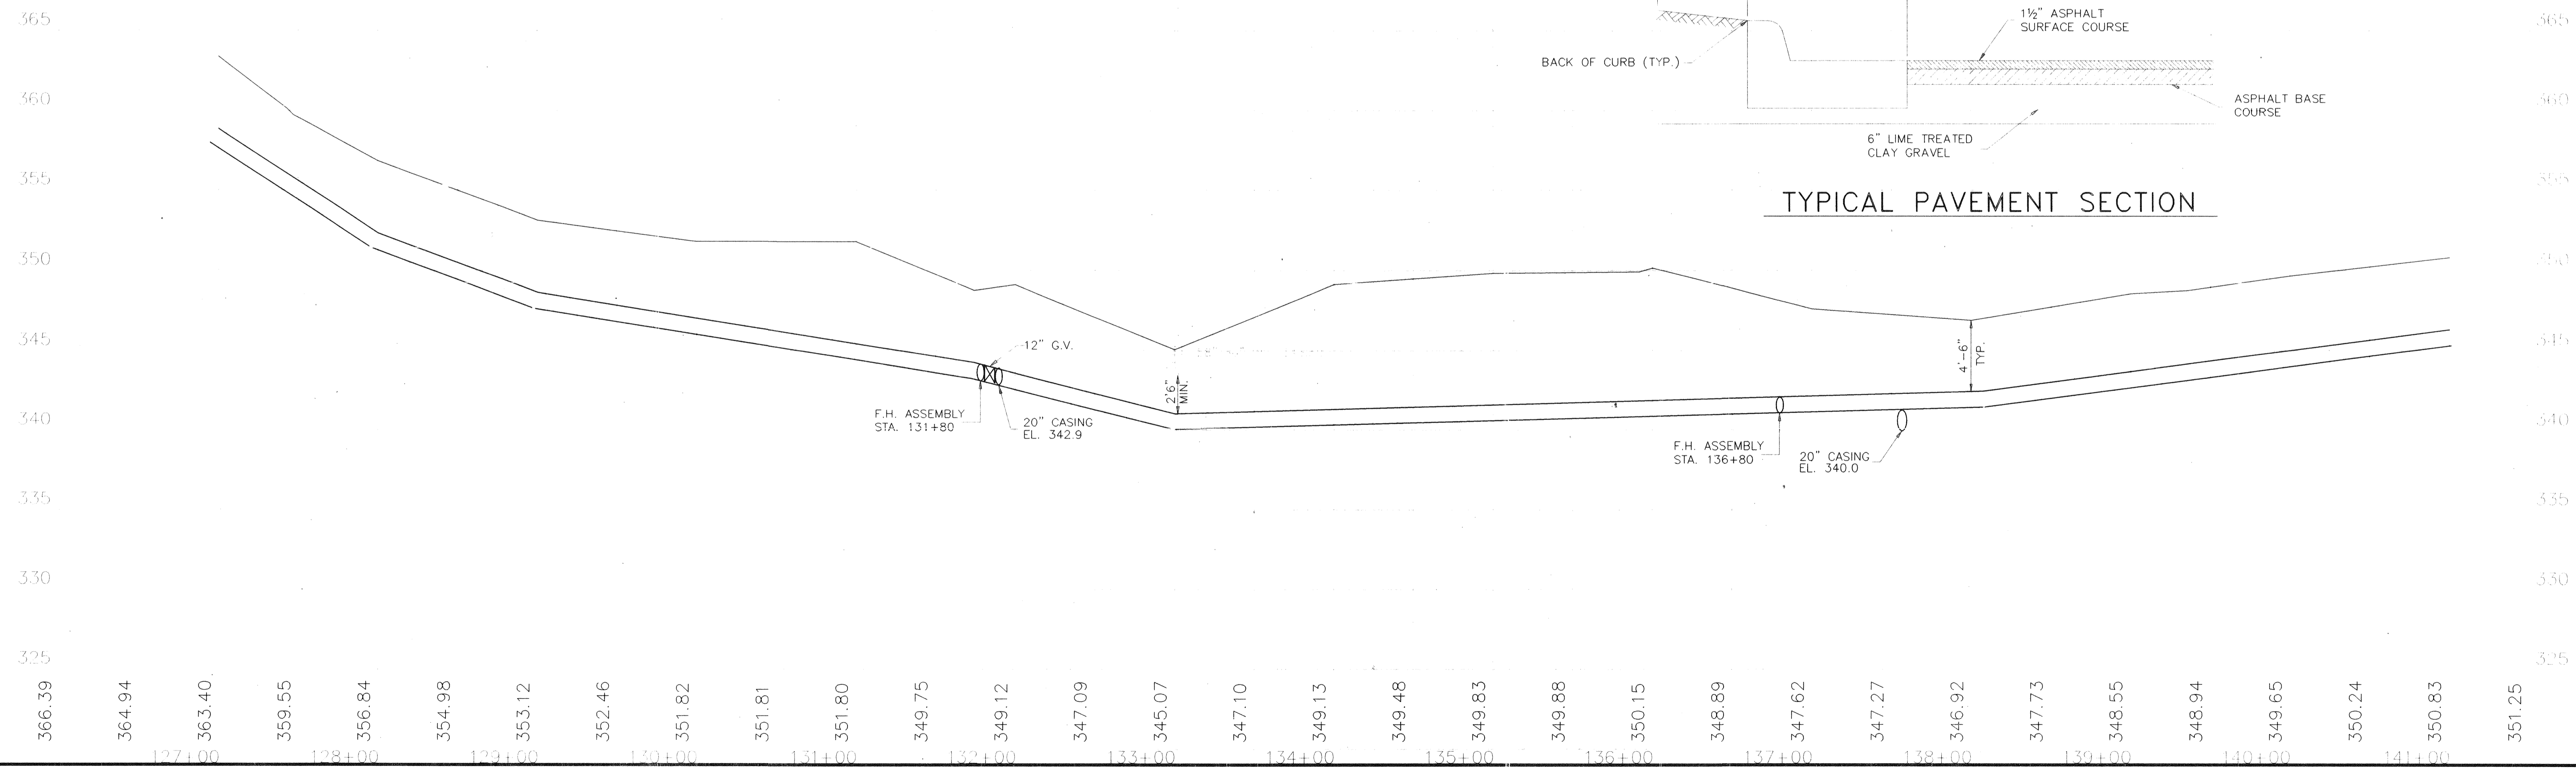

366.39 364.94 363.40 359.55 356.84 354.98 353.12 352.46 351.82 351.81 351.80 349.75 349.12 347.09 345.07 347.10 349.13 349.48 349.83 349.88 350.15 348.89 347.62 347.27 346.92 347.73 348.55 348.94 349.65 350.24 350.83 351.25

127+00 128+00 129+00 130+00 131+00 132+00 133+00 134+00 135+00 136+00 137+00 138+00 139+00 140+00 141+00 140+25



MICHAEL BAKER, JR., INC.
CONSULTING ENGINEERS
Jackson, Mississippi

REVISION	BY	AS-BUILT	DESCRIPTION	DATE
DESIGNED	C.A.W.	DRAWN	W.B.S.	CHECKED C.E.C.

CITY OF JACKSON
MISSISSIPPI

WATER LINE
PROJECT NO. 227-W

PLAN & PROFILE
STA. 127+00 TO 140+75

DRAWING NO.
HCPWL-PP10

SHEET 12
DATE SEPT. 1996


W-1095

SECTION 27

SECTION 26

SECTION 25

SECTION 30

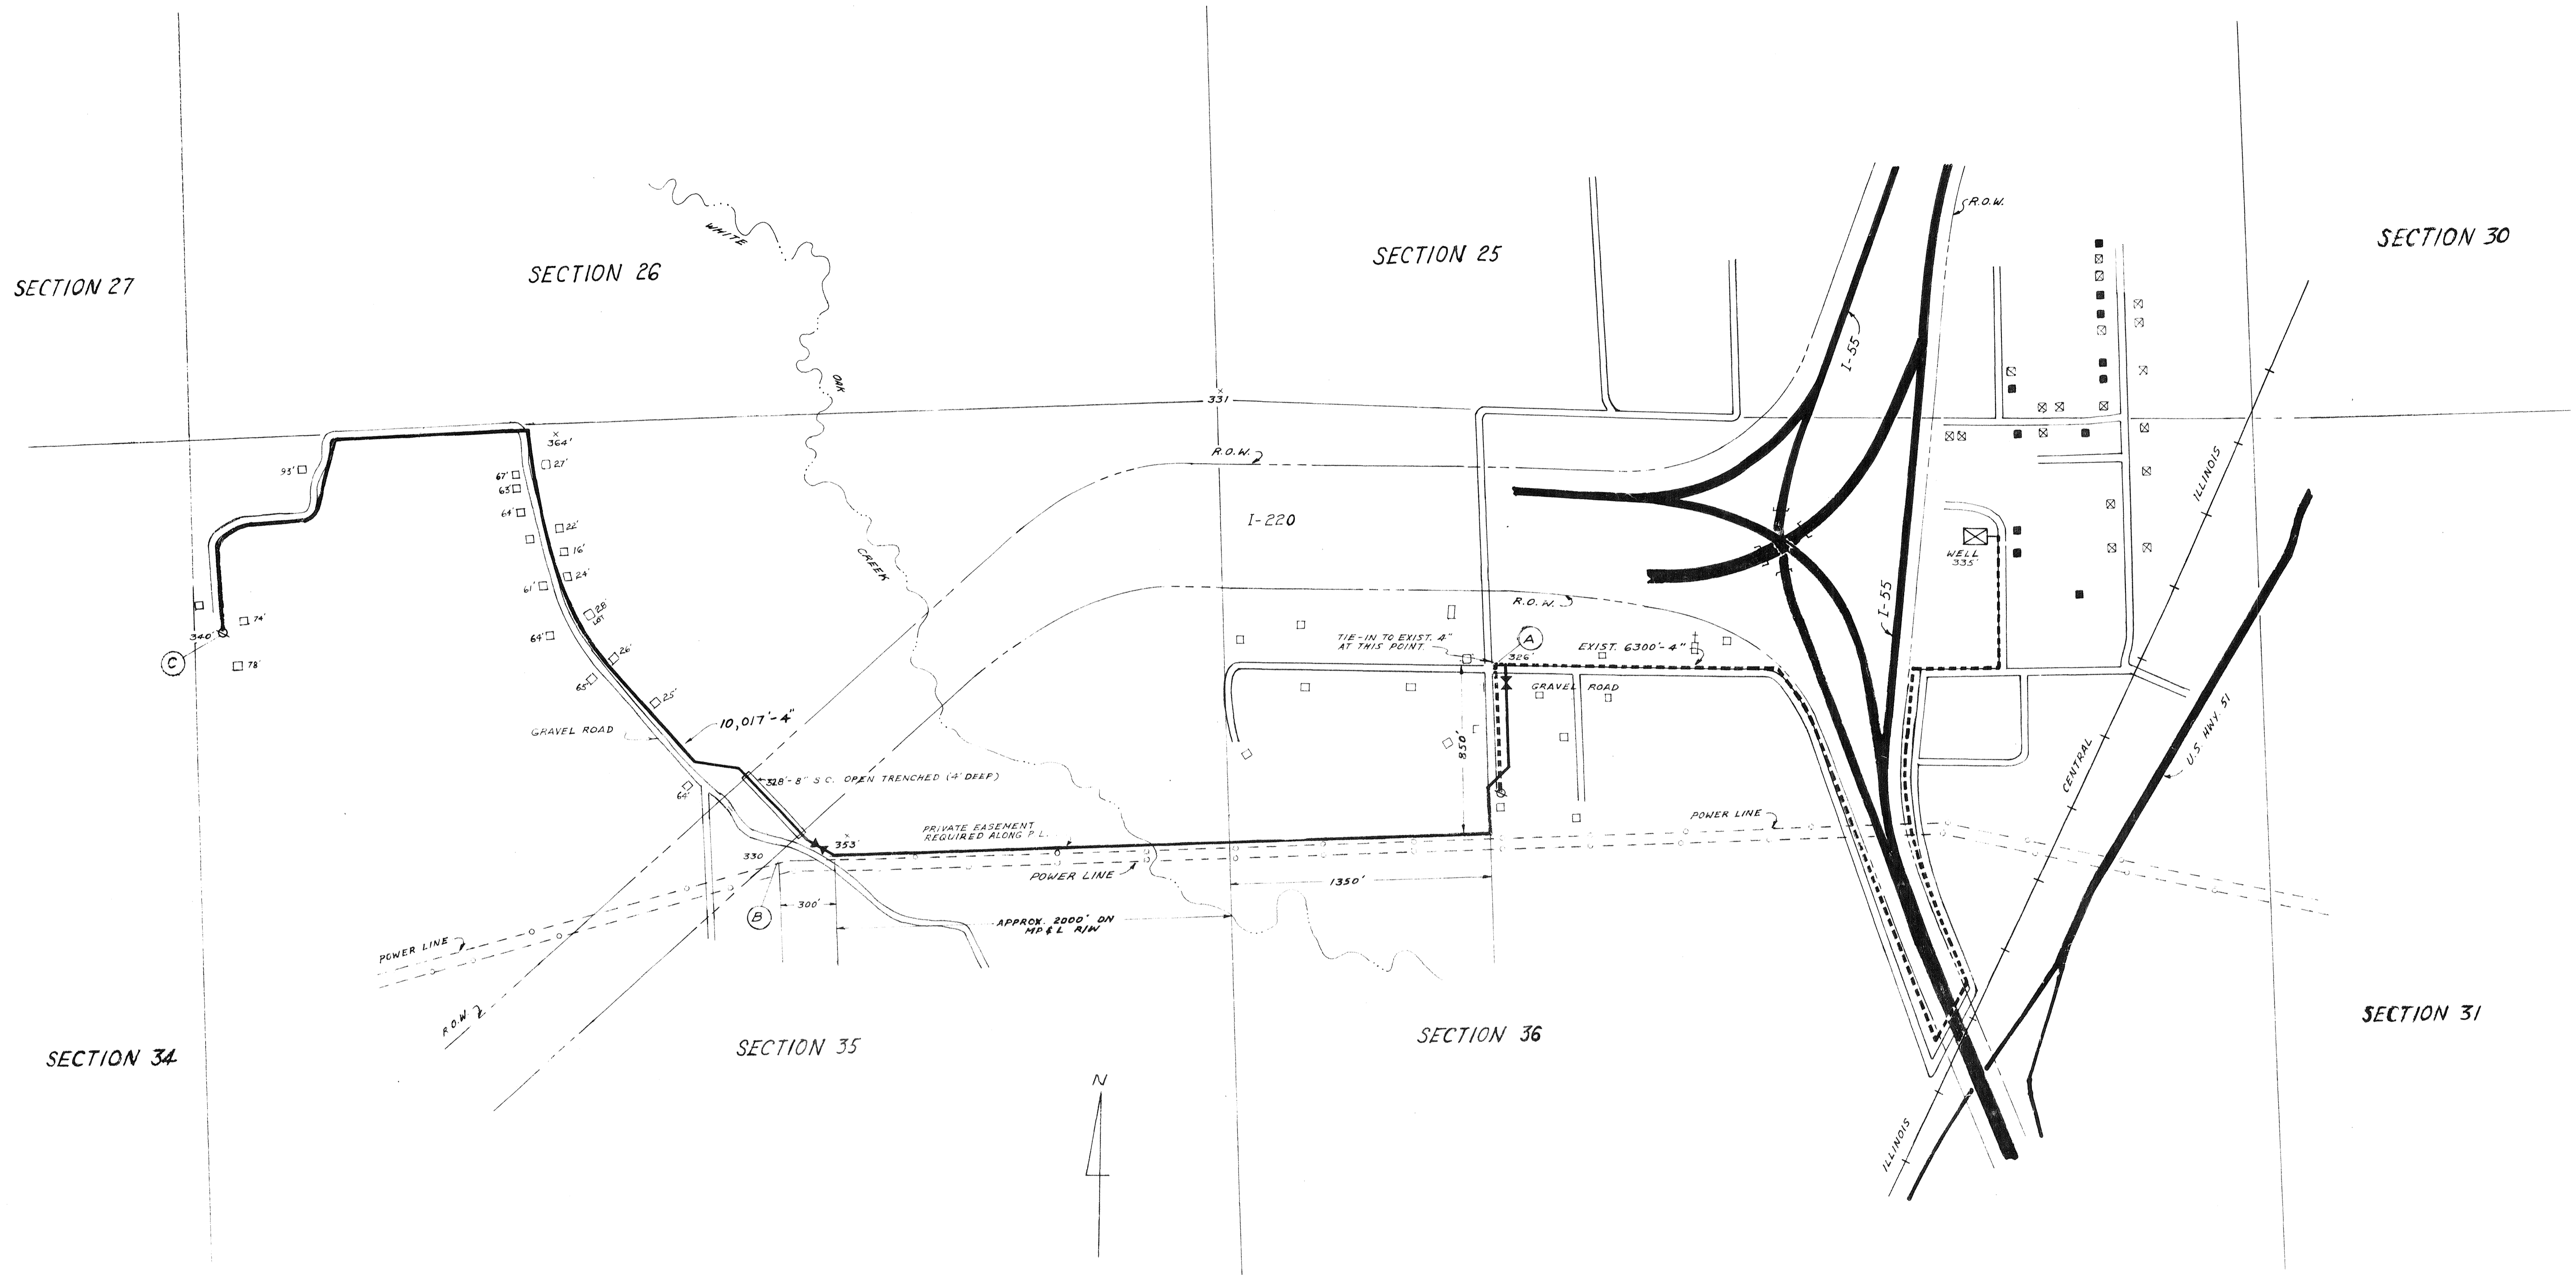

SECTION 34

SECTION 35

SECTION 36

SECTION 31

W-1000


AS BUILT 1-8-75

RICHMOND GROVE EXTENSIONS, 1974

MADISON COUNTY, MS. SCALE 1"=400'

WATER DISTRIBUTION SYSTEM EXT.

DATE	APPROVED BY	DRAWING NUMBER
3-13-74	R. C. L.	73-156-2

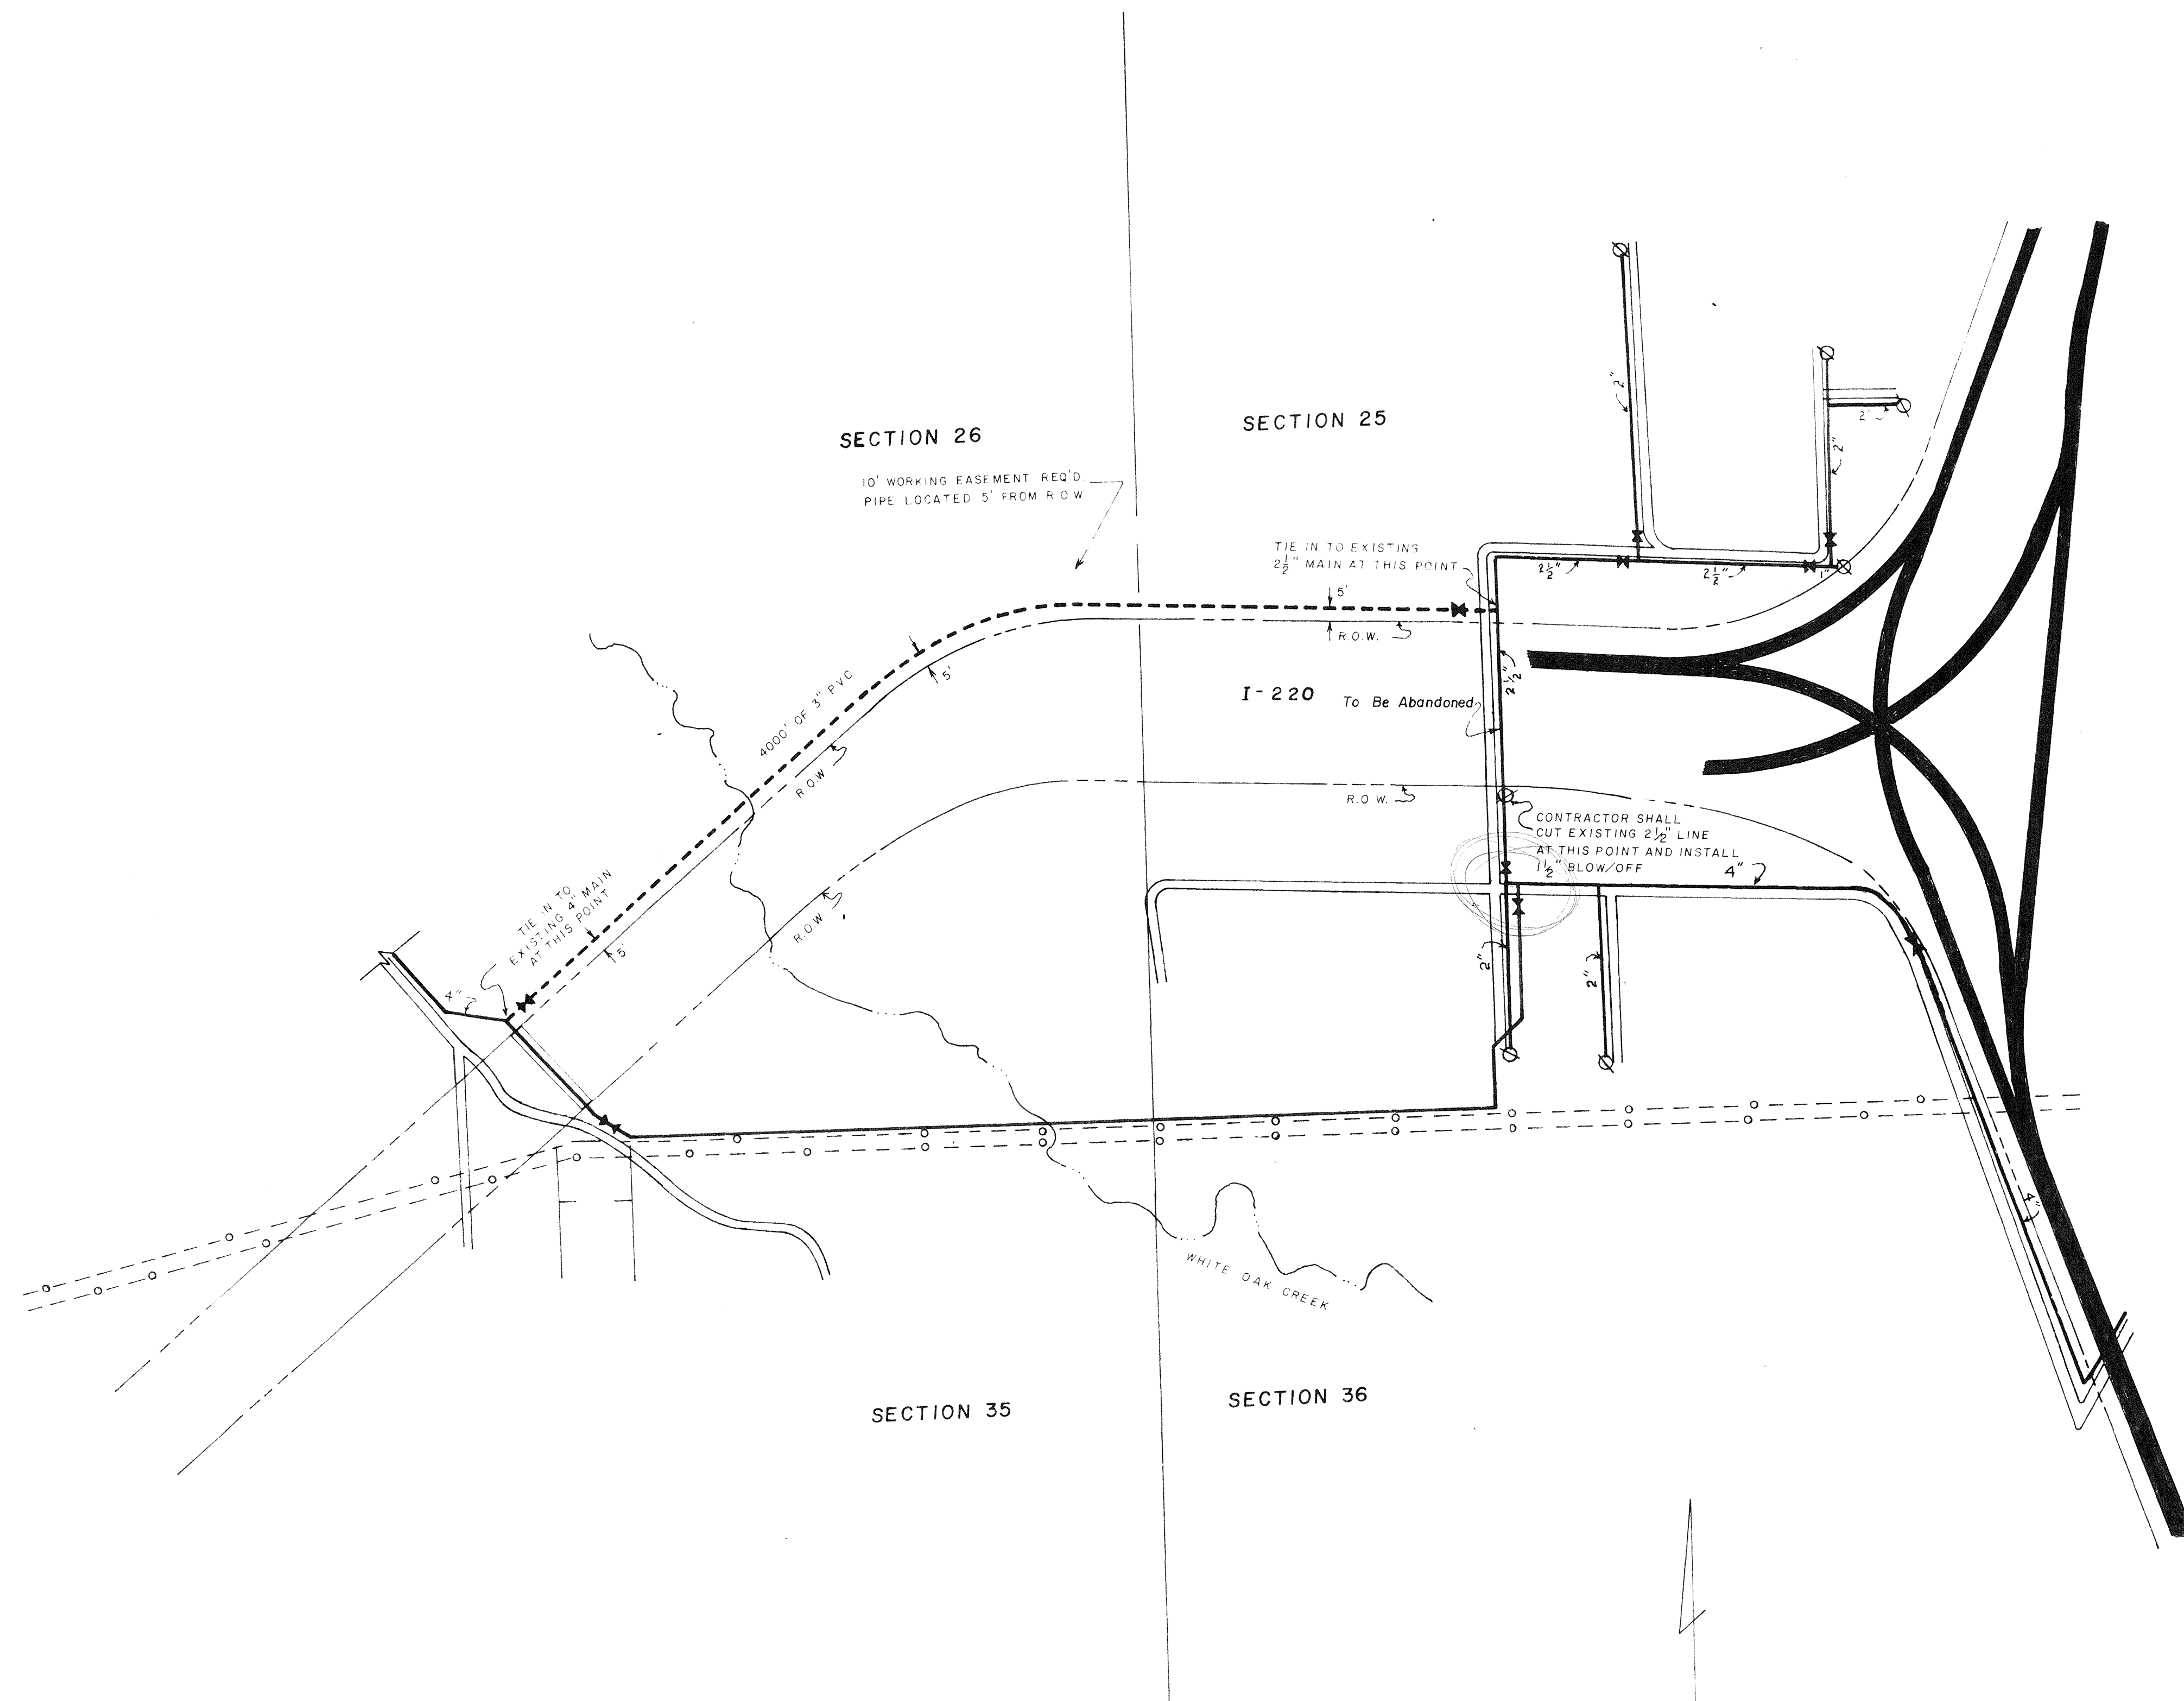

QUANTITY & COST ESTIMATE

4000 LF. 3" PVC. CL. 200 @ 1.50 =	6000.00
2 EA. 3" GATE VALVES @ 125.00 =	250.00
2 EA. TIE IN TO EXISTING LINE @ 200.00 =	400.00
1 EA. 1 1/2" BLOW OFF VALVE @ 100.00 =	100.00
	<u>6750.00</u>



ENGINEERING & INSPECTION FEES	1000.00
TOTAL RE-LOCATION COST	<u>7750.00</u>

LEGEND

---	PROPOSED LINE
—	EXISTING LINE
⊗	GATE VALVE
⊙	BLOW/OFF VALVE

W-1000

RICHMOND GROVE EXTENSIONS		
MADISON COUNTY, MS.	1"=400'	
WATER DISTRIBUTION SYSTEM EXT.		
DATE 2-9-78	APPROVED BY R.C.L.	DRAWING NO. 78-194-1

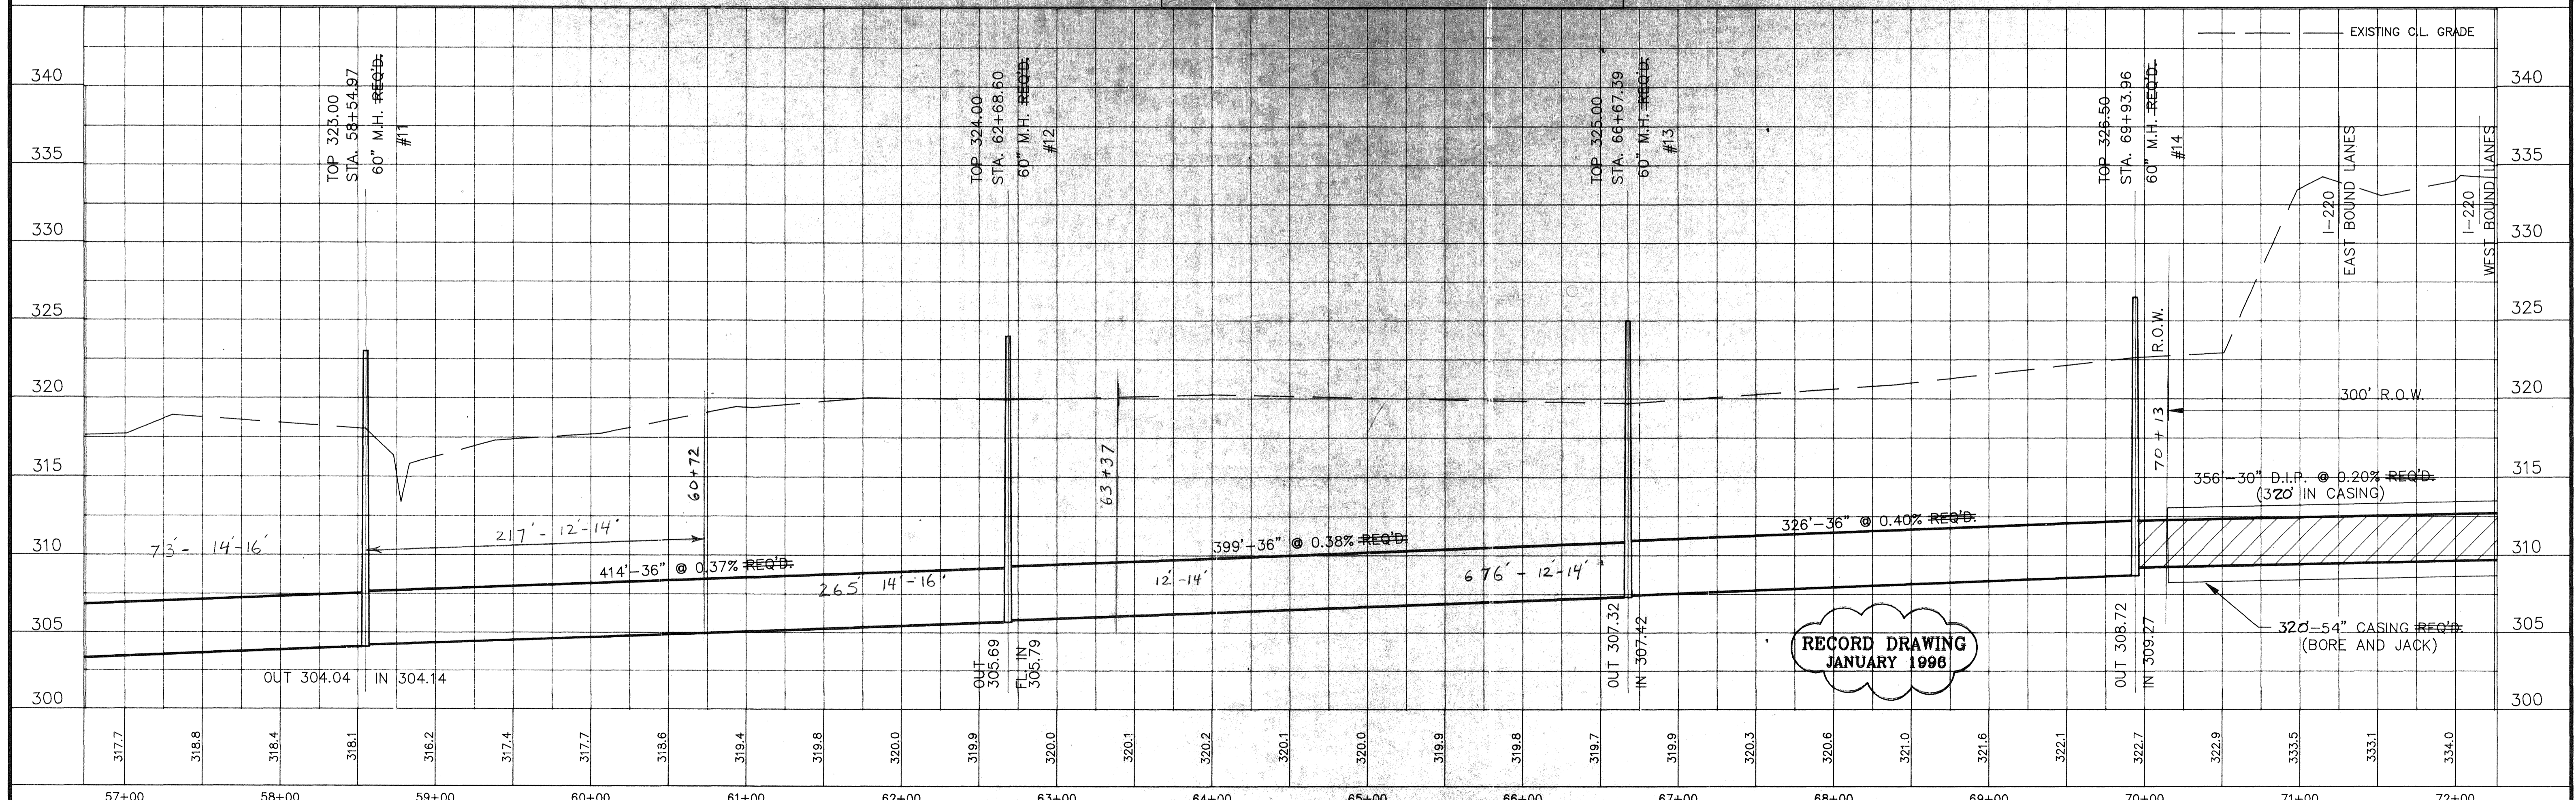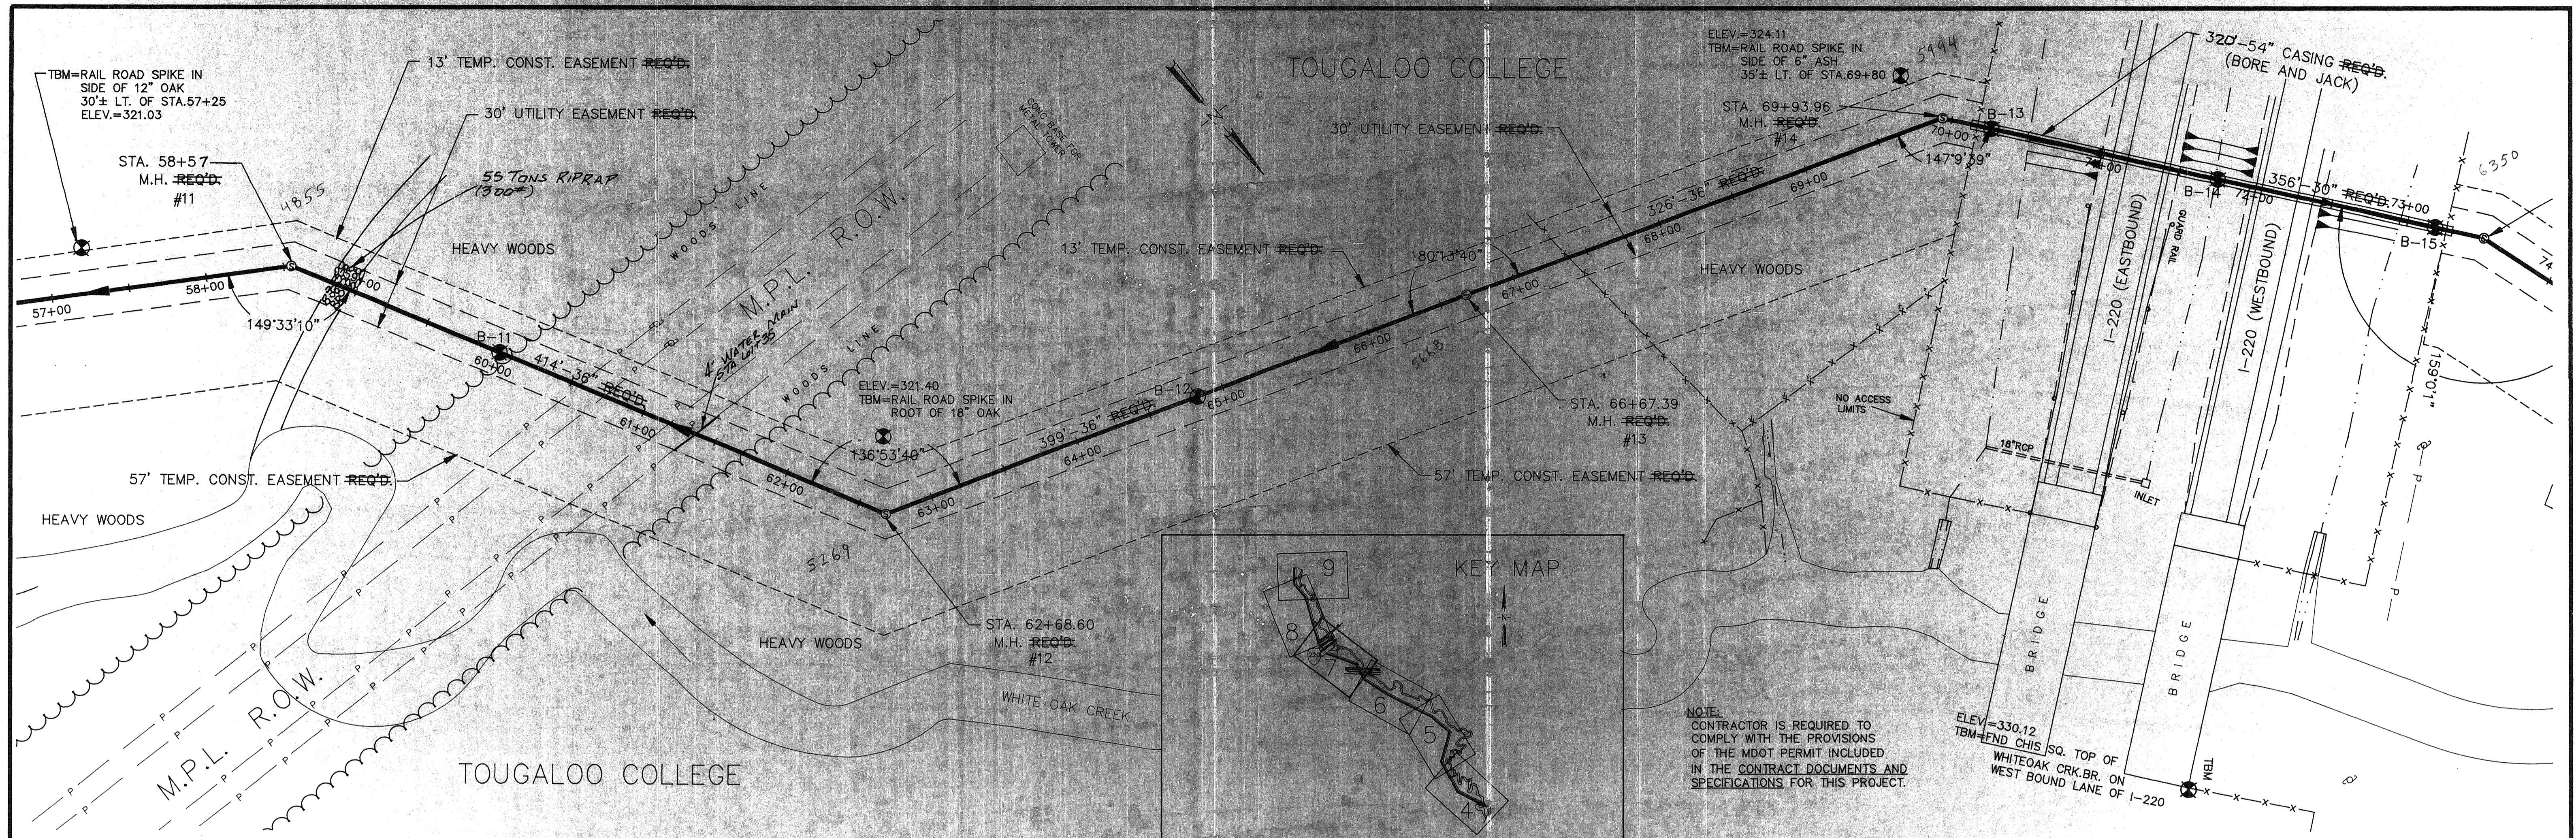

DESIGNED T.C.		DATE 2-14-94		WAGGONER ENGINEERING INC. CONSULTING ENGINEERS JACKSON, MISSISSIPPI		CITY OF JACKSON WHITE OAK CREEK INTERCEPTOR SEWER		ACAD PATH ROUTE 92076\WHOAKSEW(PLOT4)		
DRAWN C.R.H.		SCALE 1"=50' HORT. 1"=5' VERT.						W.E.I. JOB NO. 92076		SHEET NO. 7 OF 10
NO.	DATE	REVISIONS				BY				

RECORD DRAWING
JANUARY 1998

CITY OF JACKSON, MISSISSIPPI

LAKE LARUE SANITARY SEWER INTERCEPTOR EXTENSION

CITY PROJECT NO. 50318201

BCM/SMITH PROJECT 05-3521-05

FEBRUARY 1997



DRAWING INDEX

SHT. NO.	DWG. NO.	DESCRIPTION
1	CS	COVER SHEET
2	G-1	CIVIL LEGEND AND GENERAL NOTES
3	G-2	LAYOUT MAP
4	C-1	PLAN/PROFILE STATION (-) 3+00 TO STATION 12+00
5	C-2	PLAN/PROFILE STATION 12+00 TO STATION 27+00
6	C-3	PLAN/PROFILE STATION 27+00 TO STATION 42+00
7	C-4	PLAN/PROFILE STATION 42+00 TO STATION 57+00
8	C-5	PLAN/PROFILE STATION 57+00 TO STATION 72+00
9	C-6	PLAN/PROFILE STATION 72+00 TO STATION 75+12.50
10	C-7	SANITARY SEWER CONSTRUCTION DETAILS
11	C-8	SANITARY SEWER CONSTRUCTION DETAILS

DESIGN ENGINEER	
	BCM Engineers Inc. Engineers, Planners, Scientists and Laboratory Services
APPROVED BY: _____	DATE: _____

Q-1692 (S) L.R.W. DATE 2/18/98

SYMBOLS LEGEND

	NEW FIRE HYDRANT		MAIL BOX		RIGHT OF WAY OR PROPERTY LINE
	EXIST. FIRE HYDRANT		CONCRETE STREET MARKER		CENTER LINE
	NEW VALVE		GAS LINE WITH ENCASEMENT AND VENT		SURVEY LINE WITH STATION MARK
	EXIST. VALVE		GAS METER		ASPHALT PAVEMENT
	NEW WATER LINE		WATER METER		CONCRETE PAVEMENT
	EXIST. WATER LINE		RAILROAD WITH SWITCH		HOUSE OR BUILDING
	NEW GAS LINE		RAILROAD/HIGHWAY MILE POST		TREE-BROAD LEAF
	EXIST. GAS LINE		RAILROAD BRIDGE		SHRUB
	NEW SANITARY SEWER AND MANHOLE		SOIL BORING LOCATION		TREE-NEEDLE
	EXIST. SANITARY SEWER AND MANHOLE		PENETROMETER LOCATION		HIGHWAY BRIDGE
	NEW FORCE MAIN		PIEZOMETER LOCATION		ELEVATED WATER TANK
	EXIST. FORCE MAIN		GROUND WATER MONITORING WELL		NEW AIR VACUUM VALVE
	EXIST. POWER POLE AND LINE		DATUM POINT		EXIST. AIR VACUUM VALVE
	EXIST. UNDERGROUND POWER LINE		BENCH MARK AND ELEVATION		
	EXIST. TELEPHONE POLE AND LINE		EXIST. GRADE SPOT ELEV.		
	EXIST. UNDERGROUND TELEPHONE LINE		FINISH GRADE SPOT ELEV.		
	GUY ANCHOR		FINISH GRADE HIGH POINT SPOT ELEVATION		
	EXIST. CHAIN LINK FENCE		FINISH GRADE TOP OF CURB SPOT ELEVATION		
	EXIST. WIRE FENCE		EXIST. GRADE CONTOUR		
	EXIST. BOARD FENCE		FINISH GRADE CONTOUR		
	EXIST. STONE, BLOCK OR BRICK FENCE		DRAINAGE SWALE AND DIRECTION OF FLOW		
	EXIST. STORM DRAIN MANHOLE		SHORE LINE		
	EXIST. SANITARY SEWER MANHOLE		UNIMPROVED ROAD (INDICATE TYPE SURFACE)		
	POWER CO. MANHOLE		STREAM OR RIVER (GIVE NAME & SHOW FLOW LINE)		
	TELEPHONE CO. MANHOLE		DITCH (SHOW DIRECTION OF FLOW)		
	TELEPHONE PEDESTAL		SWAMP OR MARSH LAND		
	STORM DRAIN, INLET OR CATCH BASIN		NATIONAL BOUNDARY		
	EXIST. DRAIN & HEADWALLS		STATE BOUNDARY		
	IRON PIN		COUNTY LINE		
	CONCRETE MONUMENT		CIVIL TOWNSHIP, PRECINCT OR TOWN BOUNDARY		
	PROPERTY CORNER		INCORPORATED CITY, VILLAGE OR TOWN BOUNDARY		
	TRIANGULATION OR TRANSIT TRAVERSE STATION		RESERVATION, NATIONAL OR STATE BOUNDARY		
	SECTION CORNER		LAND GRANT BOUNDARY		
	SECTION 34, TOWNSHIP 5 SOUTH, RANGE 1 WEST		SMALL PARK, CEMETERY, AIRPORTS, ETC.		
	STREET SIGN AND POST		TOWNSHIP OR RANGE LINE		
			SECTION LINE		


GENERAL NOTES

- THE EXACT LOCATION OF EXISTING STRUCTURES, UTILITIES AND PIPING SHALL BE VERIFIED IN THE FIELD BY THE CONTRACTOR BEFORE CONSTRUCTION BEGINS. THESE DRAWINGS DO NOT PURPORT TO SHOW IN COMPLETE DETAIL ALL EXISTING STRUCTURES, UTILITIES OR PIPING. THE CONTRACTOR SHALL EXAMINE ALL AVAILABLE RECORDS AND MAKE ALL EXPLORATIONS AND EXCAVATIONS AS REQUIRED TO DETERMINE THE LOCATION OF EXISTING STRUCTURES, UTILITIES AND PIPES WHENEVER NECESSARY. THE OWNER RESERVES THE RIGHT TO CHANGE LOCATIONS OF THE SANITARY SEWER TO AVOID CONFLICT WITH EXISTING STRUCTURES, UTILITIES OR PIPING.
- CONTRACTOR WILL BE RESPONSIBLE FOR ANY DAMAGE DONE BY HIS EQUIPMENT TO EXISTING UTILITIES, CROSS-DRAIN PIPES AND HEADWALLS.
- ALL PROPERTY LINE MARKERS (IRON PINS, CONCRETE MONUMENTS, ETC.) DESTROYED DURING CONSTRUCTION SHALL BE REPLACED IN KIND BY THE CONTRACTOR AT NO ADDITIONAL COST TO THE OWNER. THE CONTRACTOR SHALL EMPLOY A LAND SURVEYOR REGISTERED IN THE STATE OF MISSISSIPPI TO RESET PROPERTY MARKERS.
- ALL ROADWAY SHOULDERS DISTURBED DURING CONSTRUCTION SHALL BE GRASSED AND MULCHED IN ACCORDANCE WITH THE SPECIFICATIONS IMMEDIATELY AFTER PIPE IS IN PLACE.
- THE CONTRACTOR SHALL EXCAVATE FOR NEW SEWER TO ELEVATIONS SHOWN ON PLANS. CONTRACTOR SHALL TAKE EVERY NECESSARY PRECAUTION TO PROTECT EXISTING SEWER DURING CONSTRUCTION OPERATIONS. ALL EXCAVATION, SHORING AND BRACING SHALL BE THE RESPONSIBILITY OF THE CONTRACTOR.
- CONTRACTOR SHALL EXPLORE AHEAD 200 FEET SO ADJUSTMENTS CAN BE MADE IN THE ALIGNMENT OF THE PIPE IN CASE OF CONFLICTS WITH EXISTING STRUCTURES, UTILITIES AND PIPING.
- ALL EXCESS MATERIAL FROM EXCAVATIONS SHALL BE DISPOSED OF BY THE CONTRACTOR AT NO ADDITIONAL COST TO THE OWNER.
- CONTRACTOR SHALL BE RESPONSIBLE FOR PREVENTING PIPE FROM FLOATING. IF PIPE FLOATS DURING CONSTRUCTION, CONTRACTOR SHALL RELAY PIPE TO GRADE AT HIS EXPENSE.
- THE CONTRACTOR SHALL BE RESPONSIBLE FOR MAINTAINING FLOWS THROUGH EXISTING PIPING AND STRUCTURES AND DIVERSION OF FLOWS AS NECESSARY DURING CONSTRUCTION UNDER THIS CONTRACT. THE CONTRACTOR SHALL PROVIDE, AT NO ADDITIONAL COST TO THE OWNER, ALL NECESSARY LABOR, EQUIPMENT, MATERIALS AND INCIDENTALS AS REQUIRED TO ACCOMPLISH THE INTENT OF WORK SHOWN ON THE DRAWINGS AND SPECIFIED.
- ALL EXISTING DRIVEWAYS (PAVED AND UNPAVED) CUT DURING CONSTRUCTION SHALL BE REPAIRED/RESURFACED TO THEIR ORIGINAL CONDITION OR BETTER IN ACCORDANCE WITH "MISSISSIPPI STATE HIGHWAY STANDARD SPECIFICATIONS FOR ROAD AND BRIDGE CONSTRUCTION", LATEST EDITION, AT NO ADDITIONAL COST TO THE OWNER.
- TRAFFIC REGULATION ON THE PROJECT SHALL BE IN ACCORDANCE WITH THE MANUAL ON UNIFORM TRAFFIC CONTROL DEVICES, AND SHALL MEET THE APPROVAL OF THE CITY'S TRAFFIC ENGINEER.
- A PROPERTY RESTORATION CREW, EMPLOYED BY THE CONTRACTOR, SHALL PROCEED IMMEDIATELY BEHIND THE PIPE LAYING CREW TO RESTORE PROPERTY TO A PRECONSTRUCTION CONDITION. NO EXTRA PAY FOR THIS ITEM.
- DURING CONSTRUCTION OPERATIONS, THE CONTRACTOR SHALL TAKE MEASURES TO PREVENT SOIL FROM WASHING INTO ALL CREEKS, BRANCHES OR STREAMS. CONTRACTOR SHALL USE SILT CURTAINS OR OTHER MEANS AND SHALL SUBMIT EROSION AND SEDIMENT CONTROL PLANS FOR ENGINEER'S APPROVAL.
- ALL STEEL ENCASMENT PIPE SHALL CONFORM TO AASHTO WHEN PLACED UNDER STREETS AND HIGHWAYS AND AREA STANDARDS WHEN PLACED UNDER RAILROADS. ENCASMENT SHALL BE PLACED BY DRY BORING METHOD.
- ALL SEWER LINES WHICH ARE BEING TAKEN OUT OF SERVICE SHALL BE ABANDONED IN PLACE AND FILLED WITH SAND. WHERE EXISTING COVER OVER PIPE WILL PERMIT, THE CONTRACTOR MAY BREAK THE PIPE AND FILL THE VOID TO EXISTING GRADE WITH SAND OR SAND CLAY IN LIEU OF FILLING THE PIPE WITH SAND. ALL TRENCH BACKFILL SHALL BE COMPACTED AS SPECIFIED. GROUT MAY BE USED TO FILL ABANDONED SEWER LINES IN LIEU OF SAND OR SAND CLAY AT NO ADDITIONAL COST TO THE OWNER.
- ALL MANHOLES ON THE ABANDONED SEWER LINE SHALL BE BROKEN DOWN THREE FEET BELOW GROUND SURFACE. THE MANHOLE FRAME AND COVER SHALL BE SALVAGED AND TURNED OVER TO THE CITY. THE ABANDONED MANHOLE SHALL BE FILLED TO EXISTING GROUND SURFACE.
- CONTRACTOR SHALL FURNISH AND INSTALL MANUFACTURER APPROVED COUPLINGS WHERE CONNECTING PIPE OF DISSIMILAR MATERIALS AT NO ADDITIONAL COST TO THE OWNER.

RECORD DRAWINGS

Q-1692(s) NAME: L.R. WILLIAMS DATE: 2-10-98

NO.		REVISION		DATE	ENG.	DATE	ISSUED FOR
BCM Engineers Inc. Engineers, Planners, Scientists and Laboratory Services							
VERIFY SCALES BAR IS ONE INCH ON ORIGINAL DRAWING 0 1"				DESIGNER R.B.M. DRAWN BY H.M.S. ENGINEER H.C.B. PROJECT MGR. R.B.M. CHECKED BY H.C.B.		APPROVED APPROVED DATE JANUARY 1995	
CITY OF JACKSON, MISSISSIPPI LAKE LARUE SANITARY SEWER INTERCEPTOR EXTENSION						SCALE N.T.S. PROJECT NO. 05-3521-05 DRAWING NO. G-1REC SHEET 2 OF 11	
CIVIL LEGEND AND GENERAL NOTES							

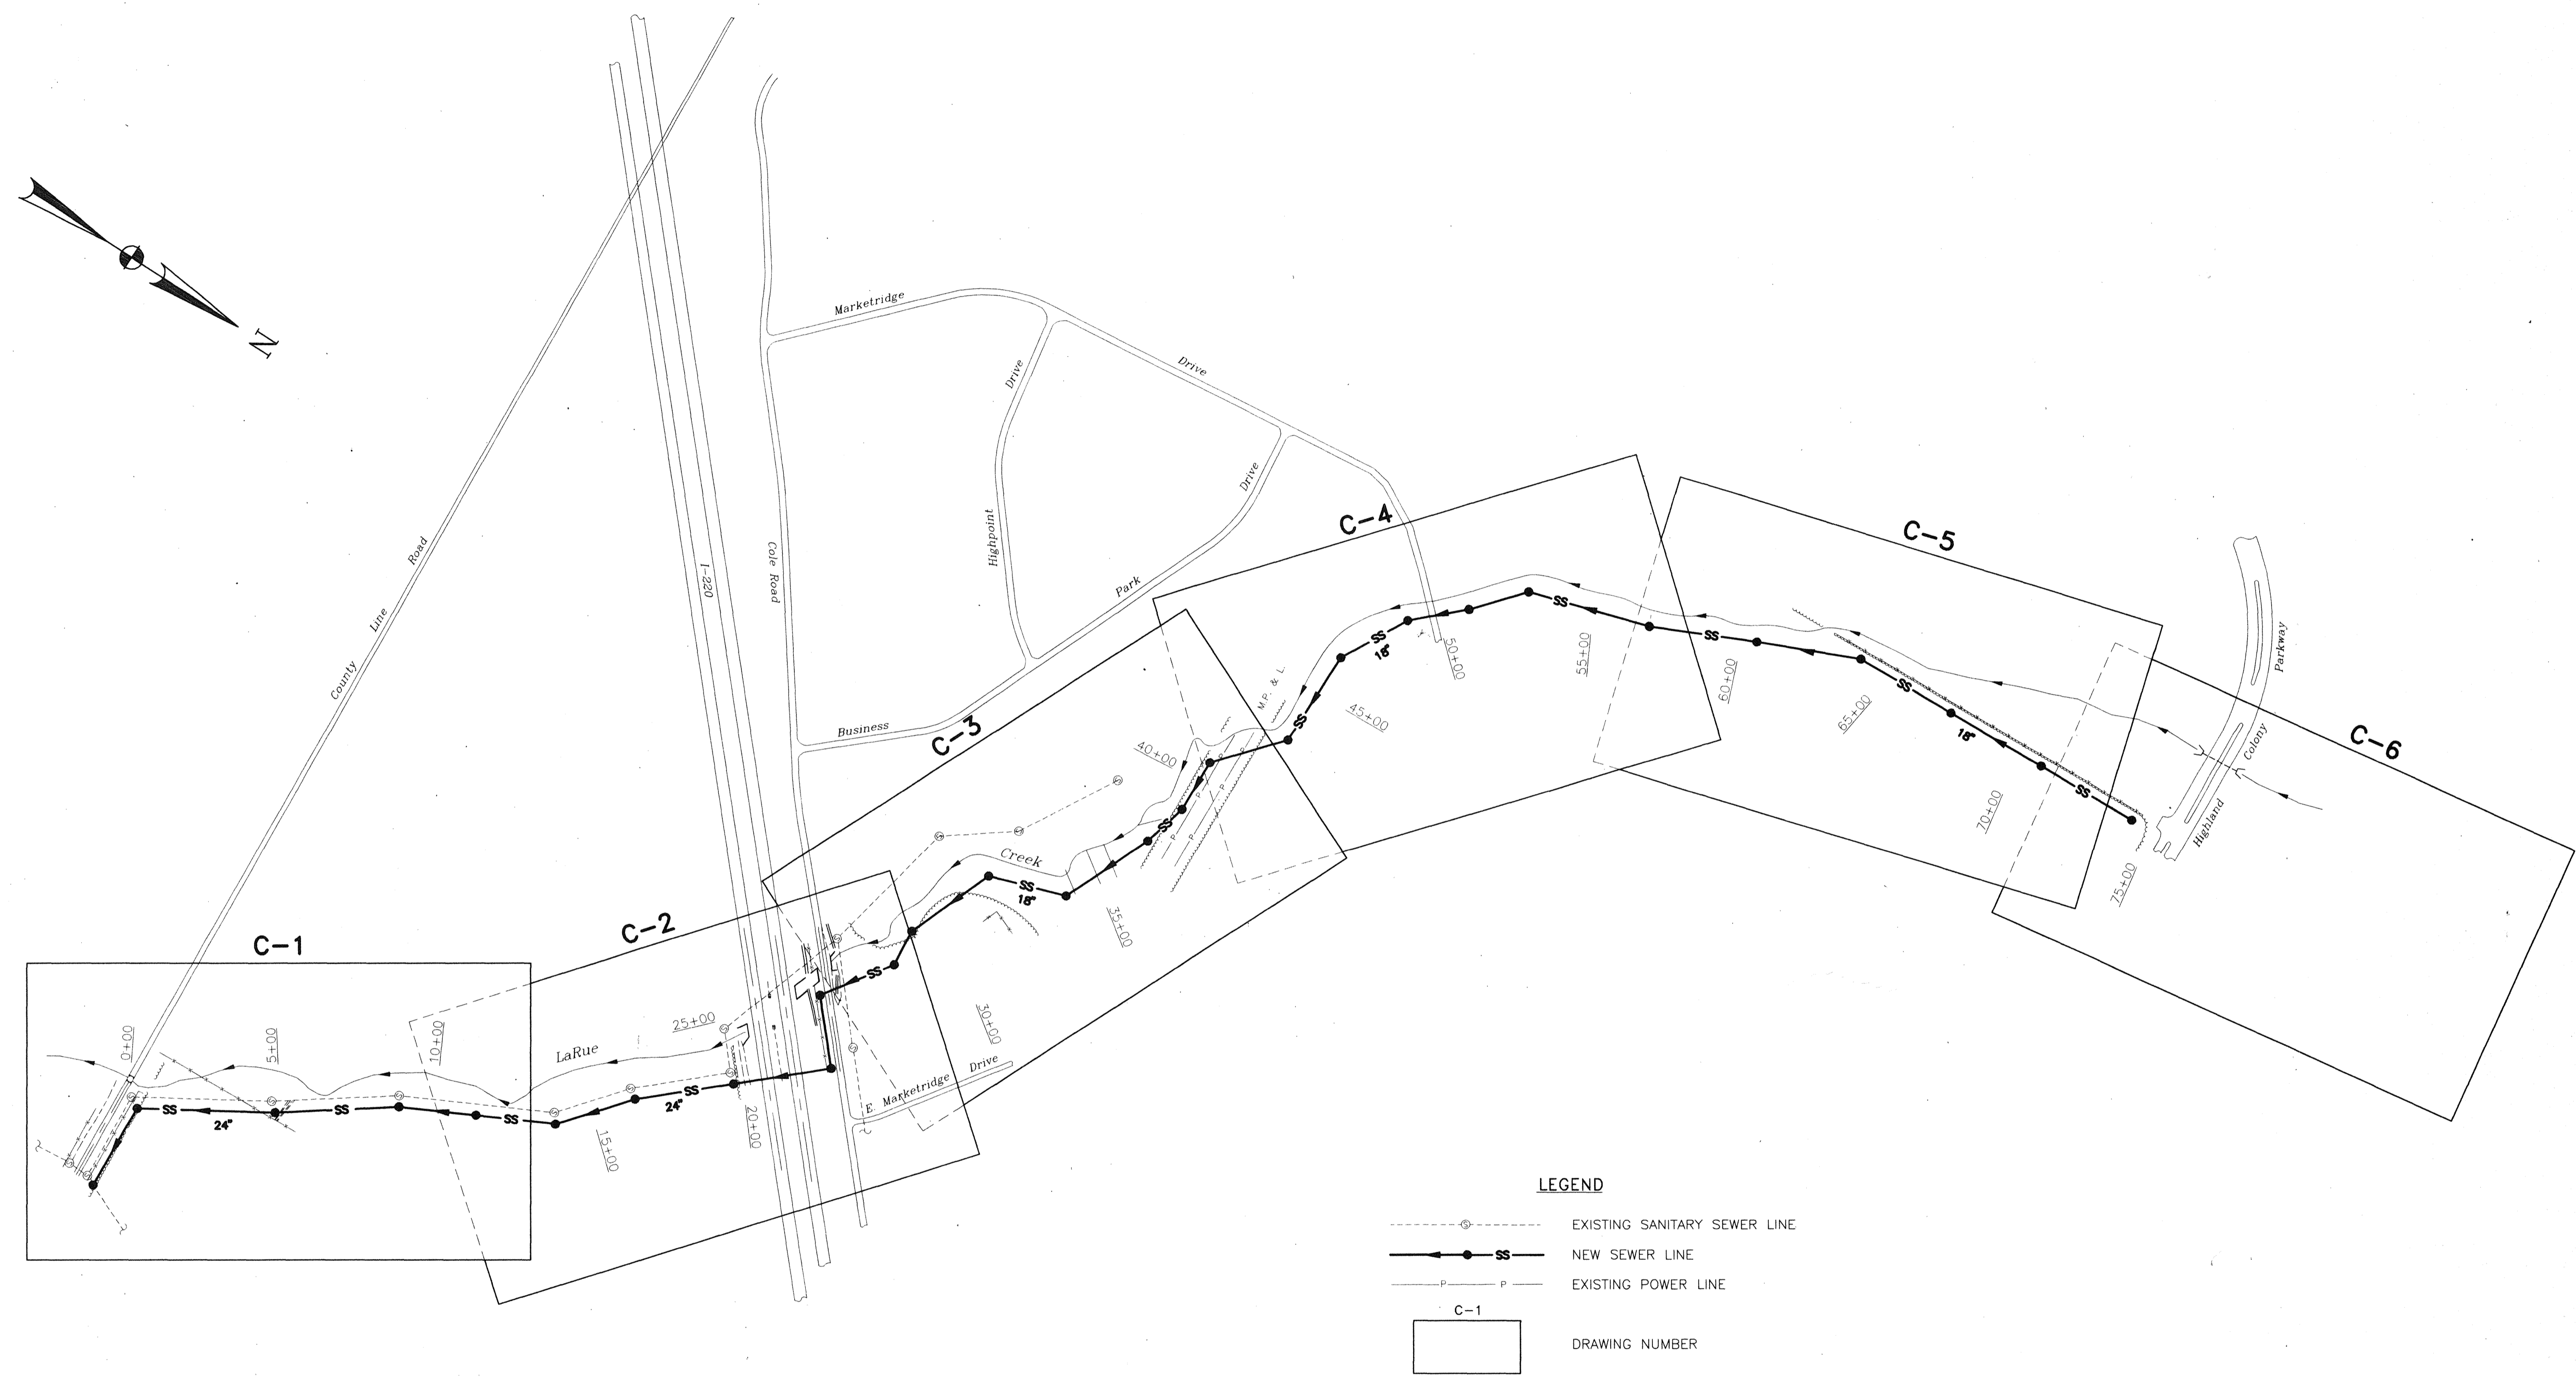

LEGEND

- EXISTING SANITARY SEWER LINE
- NEW SEWER LINE
- EXISTING POWER LINE
- DRAWING NUMBER

RECORD DRAWINGS

NAME: L.R. WILLIAMS DATE: 2-10-98

Q-1692(s)

NO.	REVISION	DATE	ENG.	DATE	ISSUED FOR

BCM BCM Engineers Inc.
Engineers, Planners, Scientists and Laboratory Services


DESIGNER	R.B.M.	APPROVED	SEAL
DRAWN BY	L.R.W.	APPROVED	
ENGINEER	H.C.B.		
PROJECT MGR.	R.B.M.		
CHECKED BY	H.C.B.	DATE	JANUARY 1995

CITY OF JACKSON, MISSISSIPPI
LAKE LARUE SANITARY SEWER
INTERCEPTOR EXTENSION

LAYOUT MAP

SCALE	1" = 300'
PROJECT NO.	05-3521-05
DRAWING NO.	G-2REC
SHEET	3 OF 11


VERIFY SCALES
BAR IS ONE INCH ON ORIGINAL DRAWING
IF NOT ONE INCH ON THIS SHEET, ADJUST SCALES ACCORDINGLY

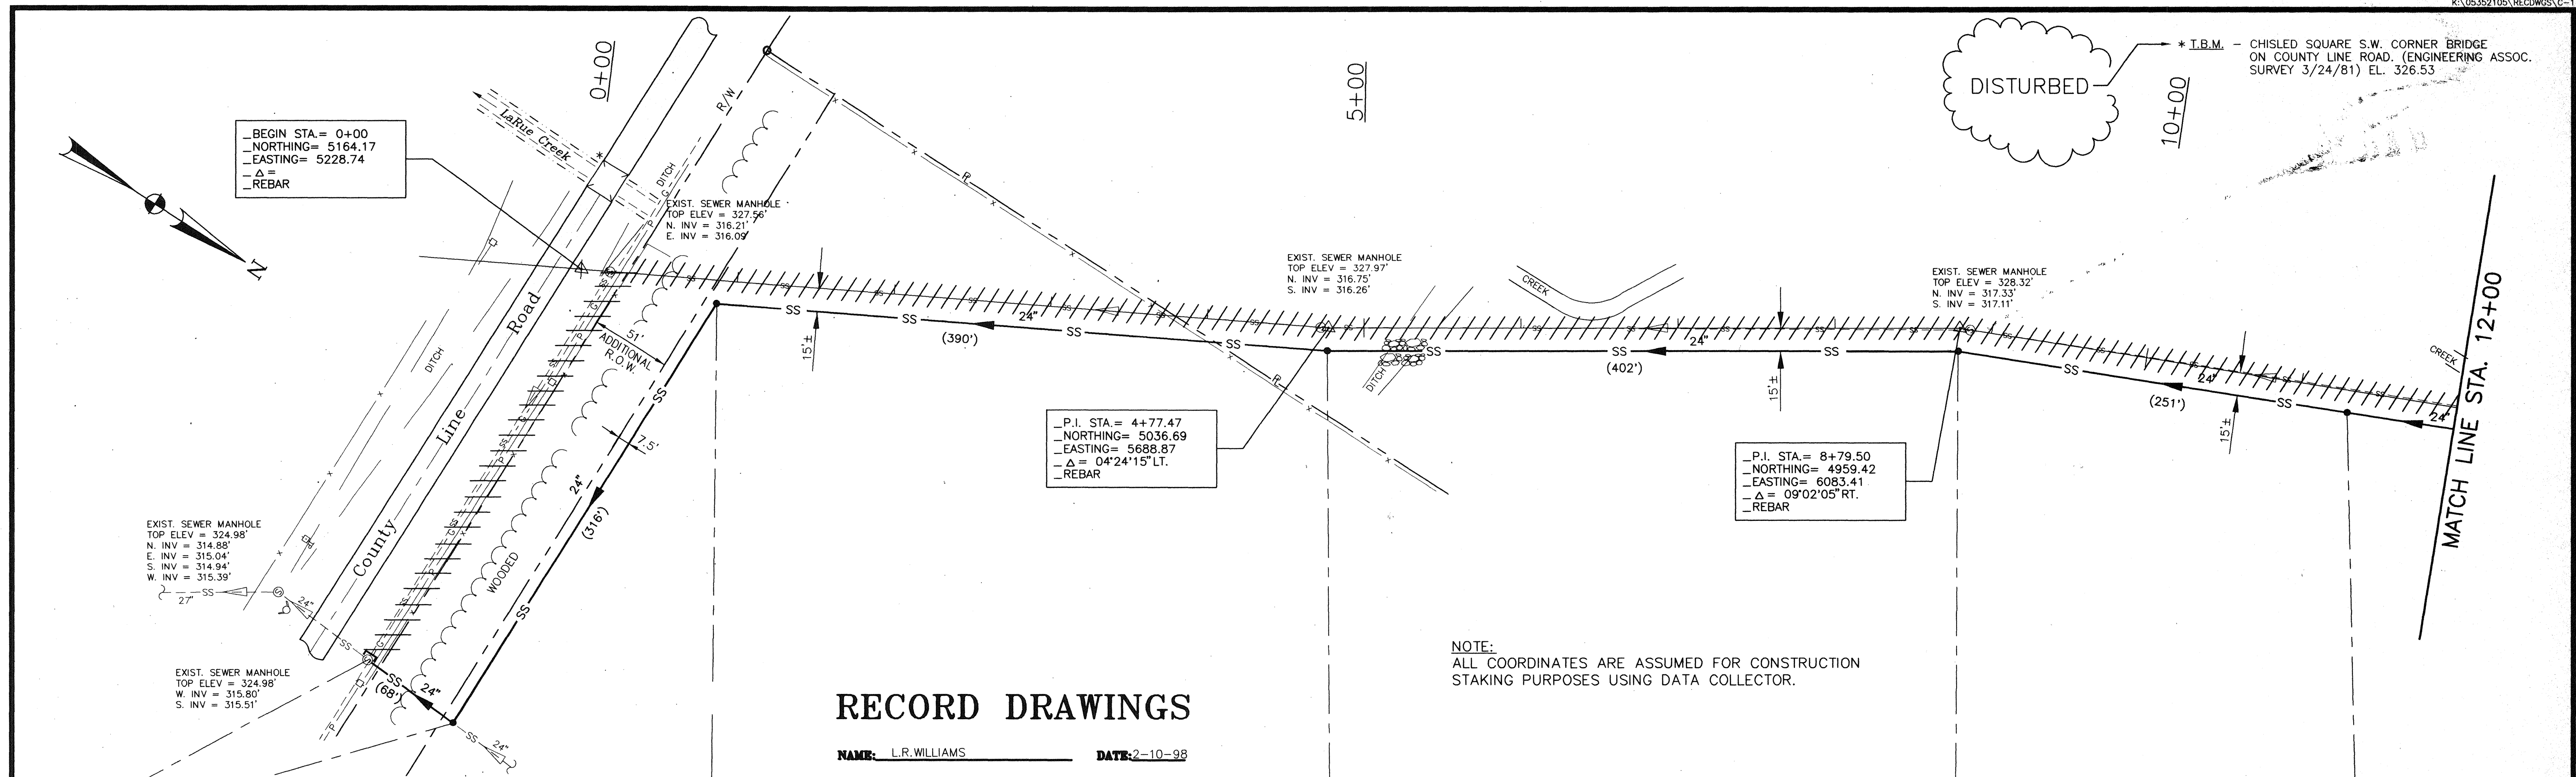

RECORD DRAWINGS


NAME: L.R. WILLIAMS DATE: 2-10-98

NOTE: ALL COORDINATES ARE ASSUMED FOR CONSTRUCTION STAKING PURPOSES USING DATA COLLECTOR.

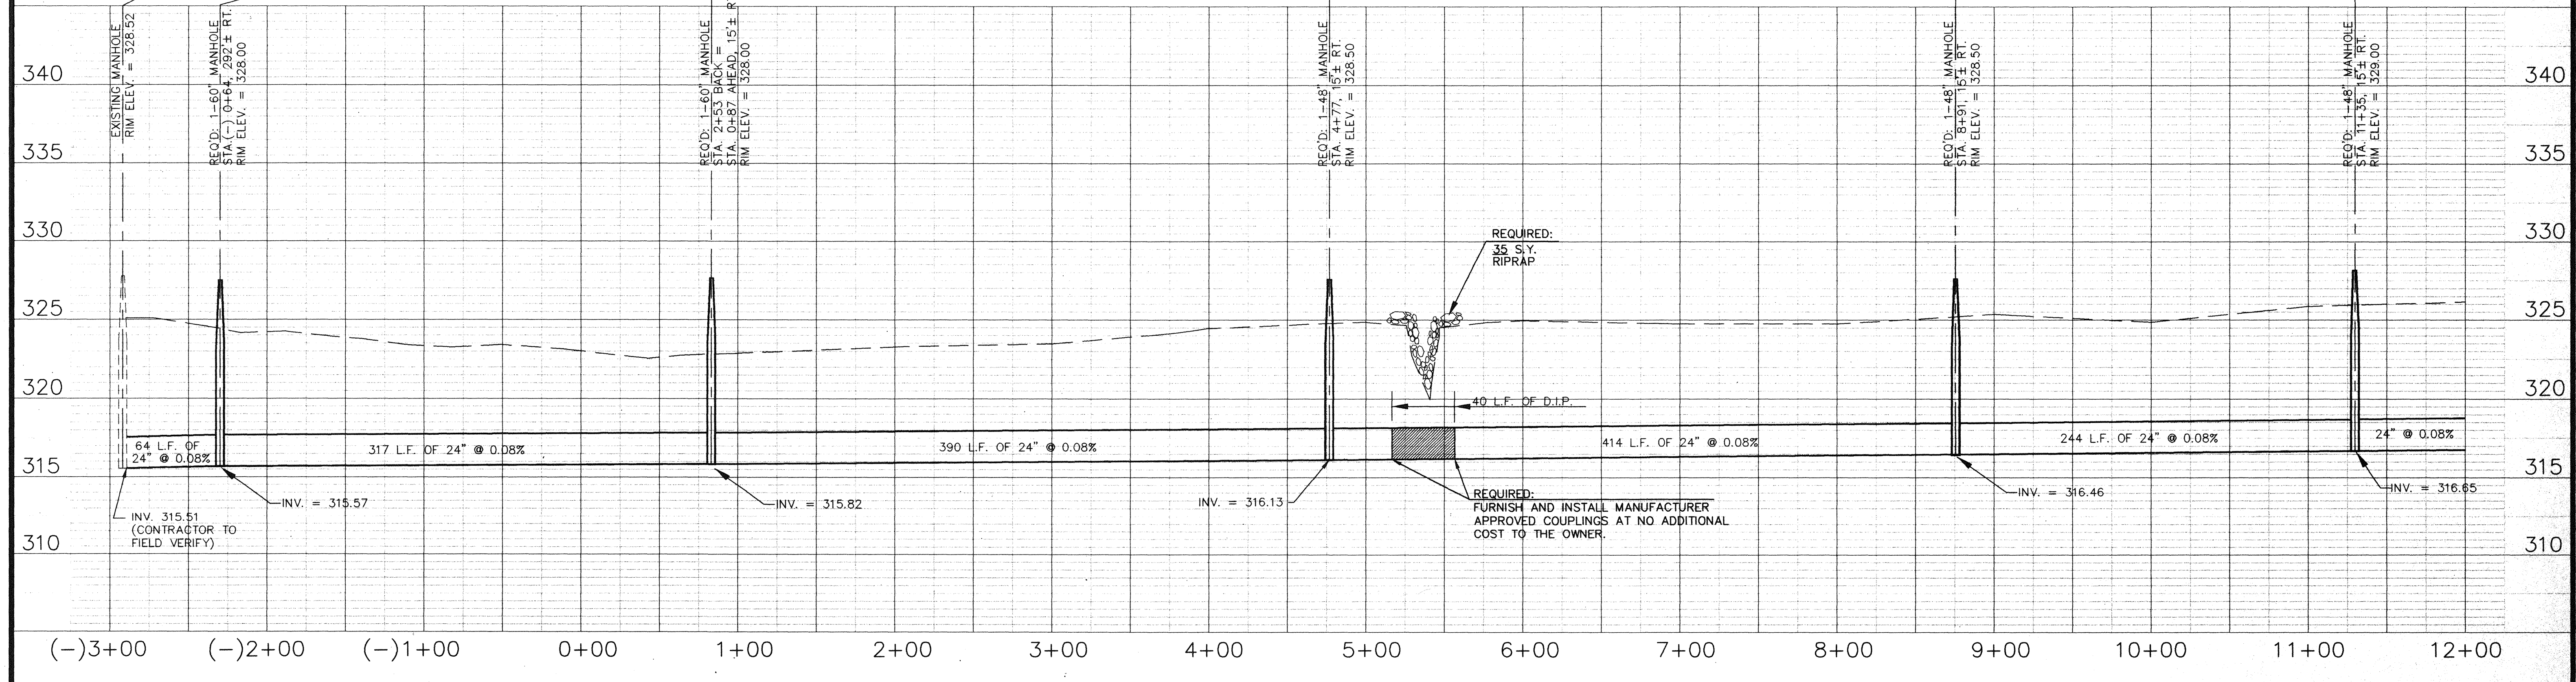

BCM Engineers Inc. Engineers, Planners, Scientists and Laboratory Services					VERIFY SCALES BAR IS ONE INCH ON ORIGINAL DRAWING 0 ————— 1"	DESIGNER: R.B.M. DRAWN BY: L.R.W. ENGINEER: H.C.B. PROJECT MGR.: R.B.M. CHECKED BY: H.C.B.	APPROVED: [Signature] APPROVED: [Signature] DATE: FEBRUARY 1994	SEAL: [Signature]	CITY OF JACKSON, MISSISSIPPI LAKE LARUE SANITARY SEWER INTERCEPTOR EXTENSION PLAN/PROFILE STA. (-) 3+00 TO STA. 12+00	SCALE 1"=50' HORIZ. 1"=5' VERT. PROJECT NO. 05-3521-05 DRAWING NO. C-1REC SHEET 4 OF 11
NO.	REVISION	DATE	ENG.	DATE	ISSUED FOR					


Q-1692 (5)

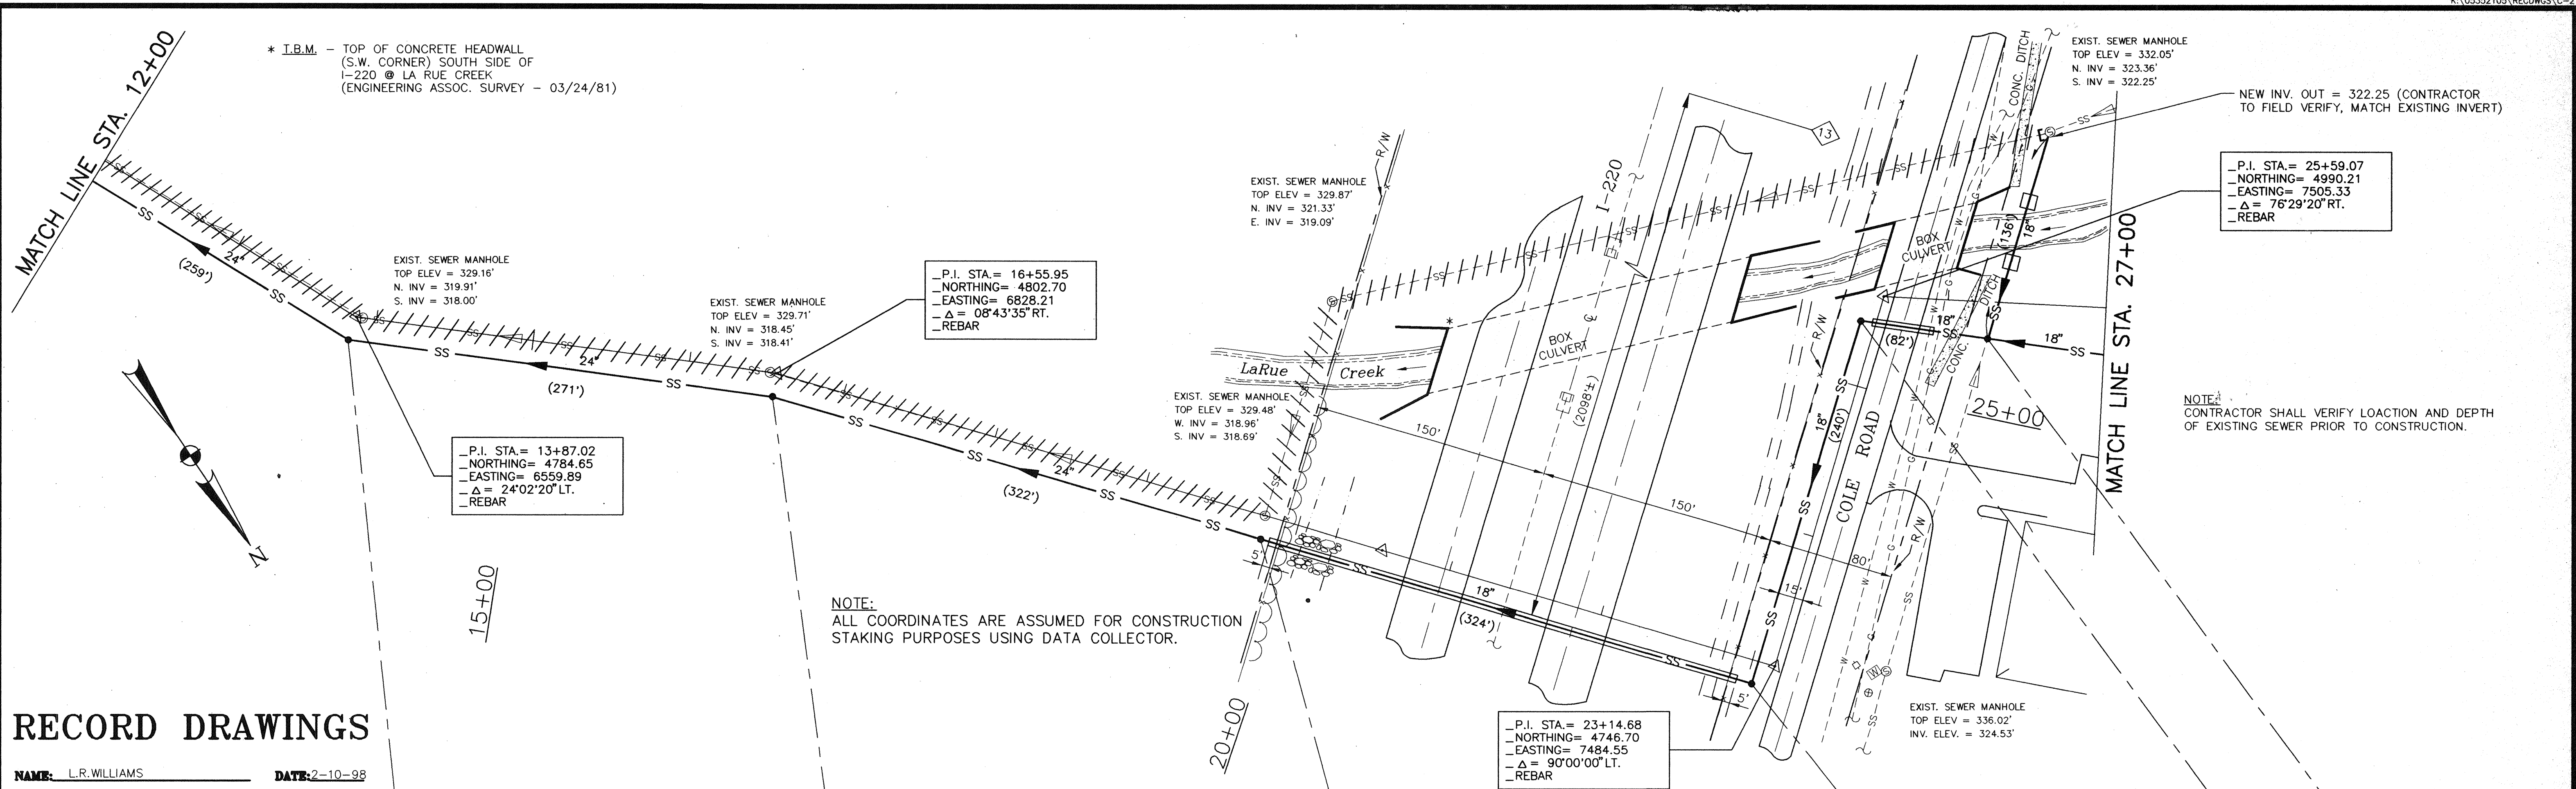

RECORD DRAWINGS

NAME: L.R. WILLIAMS DATE: 2-10-98

NOTE:
ALL COORDINATES ARE ASSUMED FOR CONSTRUCTION STAKING PURPOSES USING DATA COLLECTOR.

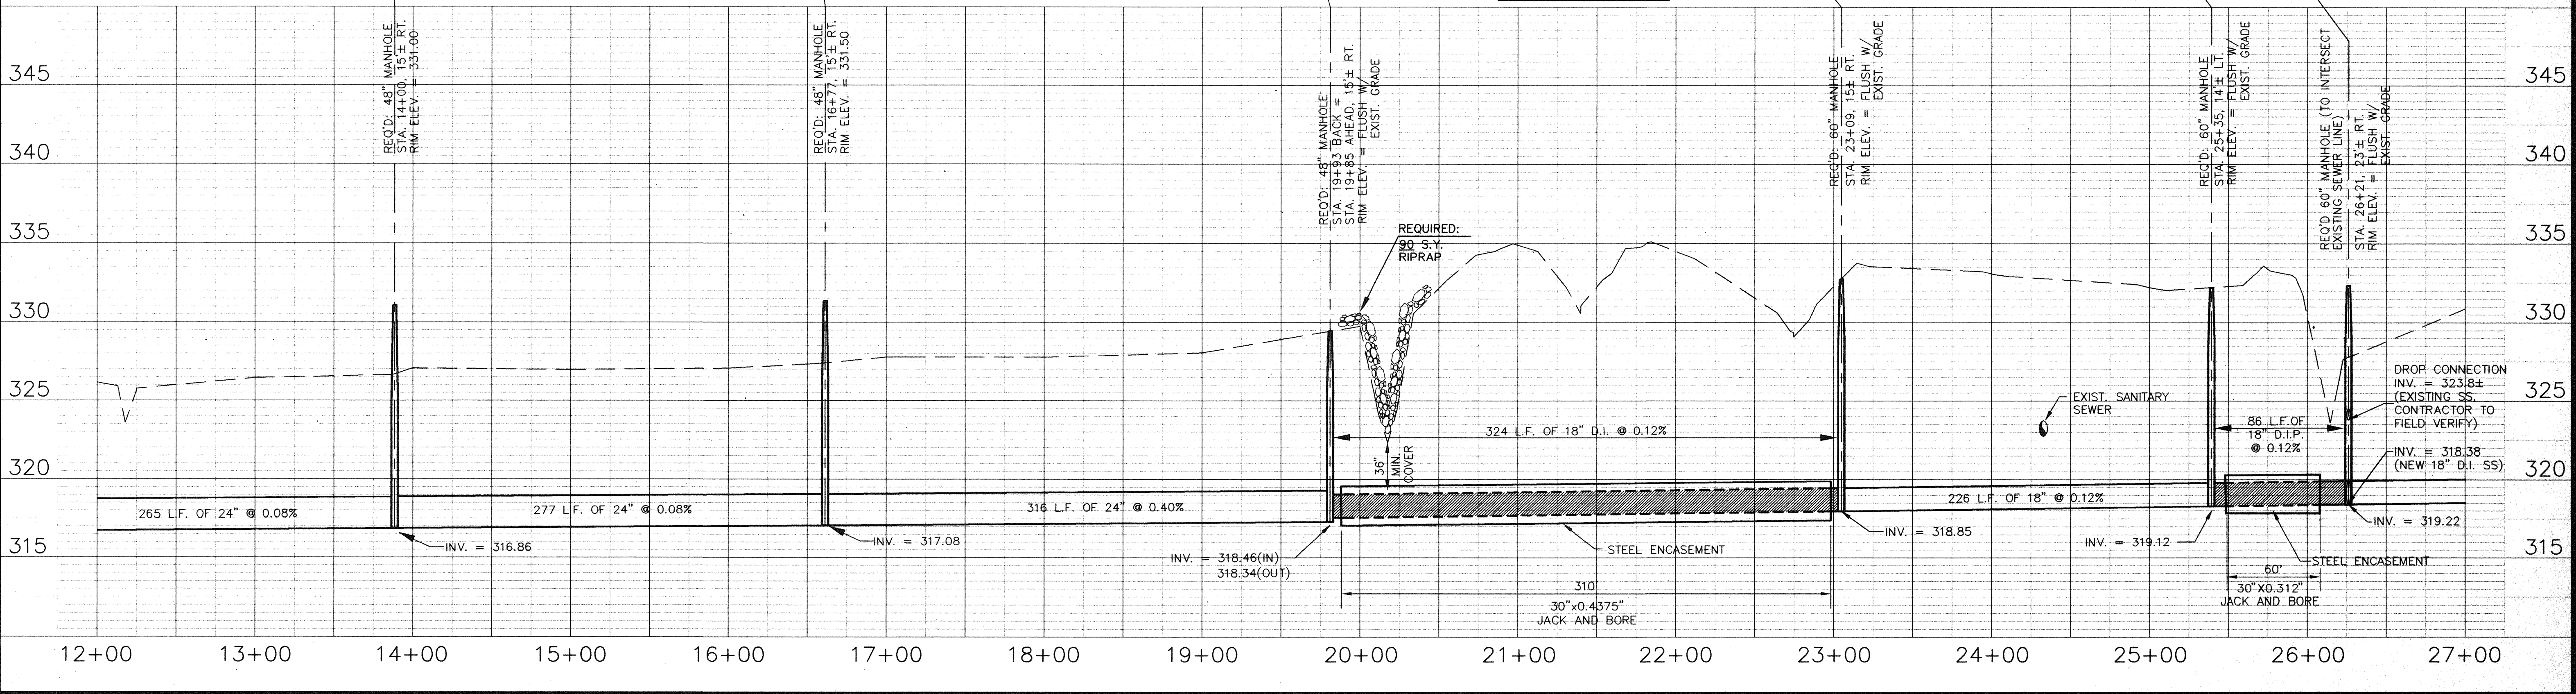

NO.	REVISION	DATE	ENG.	DATE	ISSUED FOR

BCM BCM Engineers Inc.
Engineers, Planners, Scientists and Laboratory Services

DESIGNER	R.B.M.	APPROVED	
DRAWN BY	L.R.W.	APPROVED	
ENGINEER	H.C.B.		
PROJECT MGR.	R.B.M.		
CHECKED BY	H.C.B.	DATE	FEBRUARY 1994

CITY OF JACKSON, MISSISSIPPI
LAKE LARUE SANITARY SEWER
INTERCEPTOR EXTENSION
PLAN/PROFILE
STA. 12+00 TO STA. 27+00


SCALE	1" = 50' HORIZ. 1" = 5' VERT.
PROJECT NO.	05-3521-05
DRAWING NO.	C-2REC
SHEET	5 of 11

Q-1692 (3)


* I.B.M. - TOP OF REBAR @ P.O.T. STA. 31+00, ELEV. 332.92
 ** I.B.M. - TOP OF REBAR @ P.I. STA. 37+53.33, ELEV. 333.58

NOTE:
 ALL COORDINATES ARE ASSUMED FOR CONSTRUCTION STAKING PURPOSES USING DATA COLLECTOR.

-P.I. STA. = 40+81.18
 -NORTHING = 5400.87
 -EASTING = 8916.82
 -Δ = 40°32'40" RT.
 -REBAR

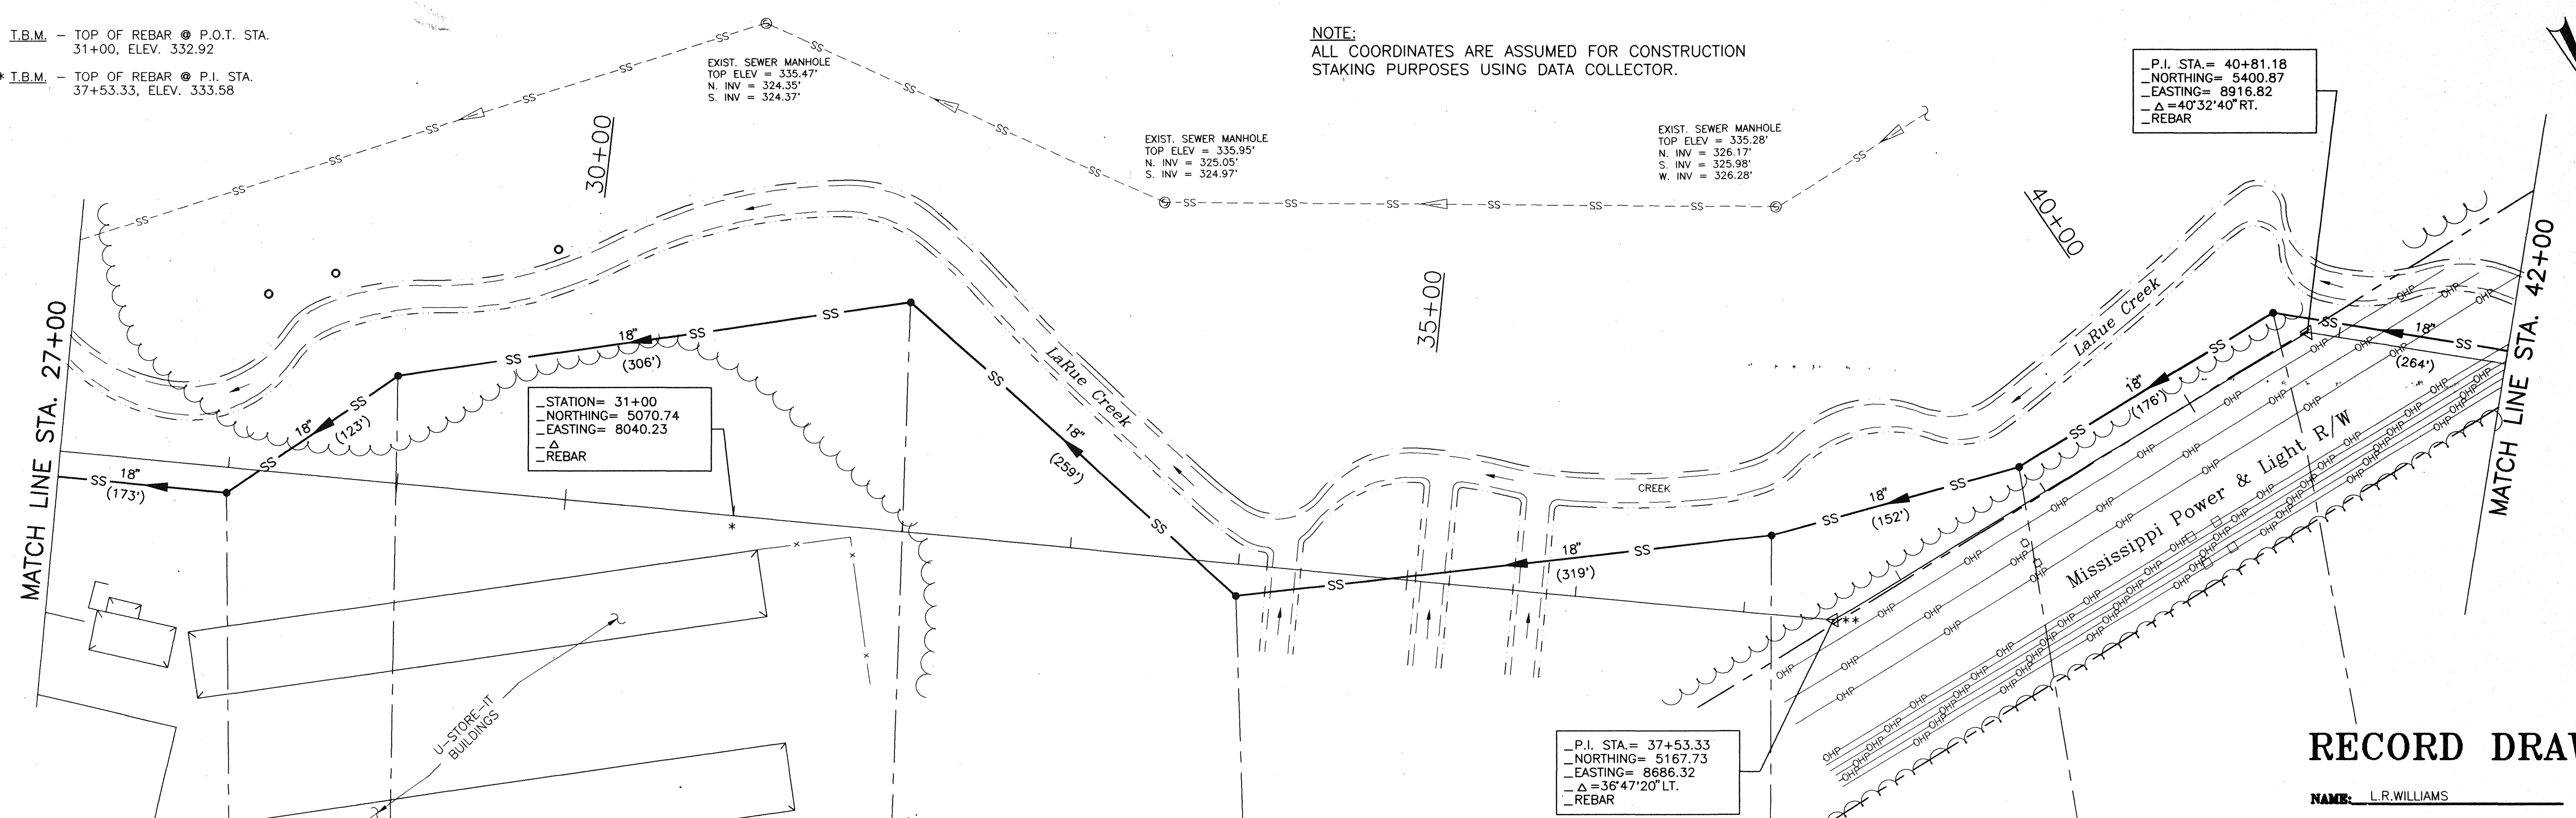

NAME: L.R. WILLIAMS DATE: 2-10-98

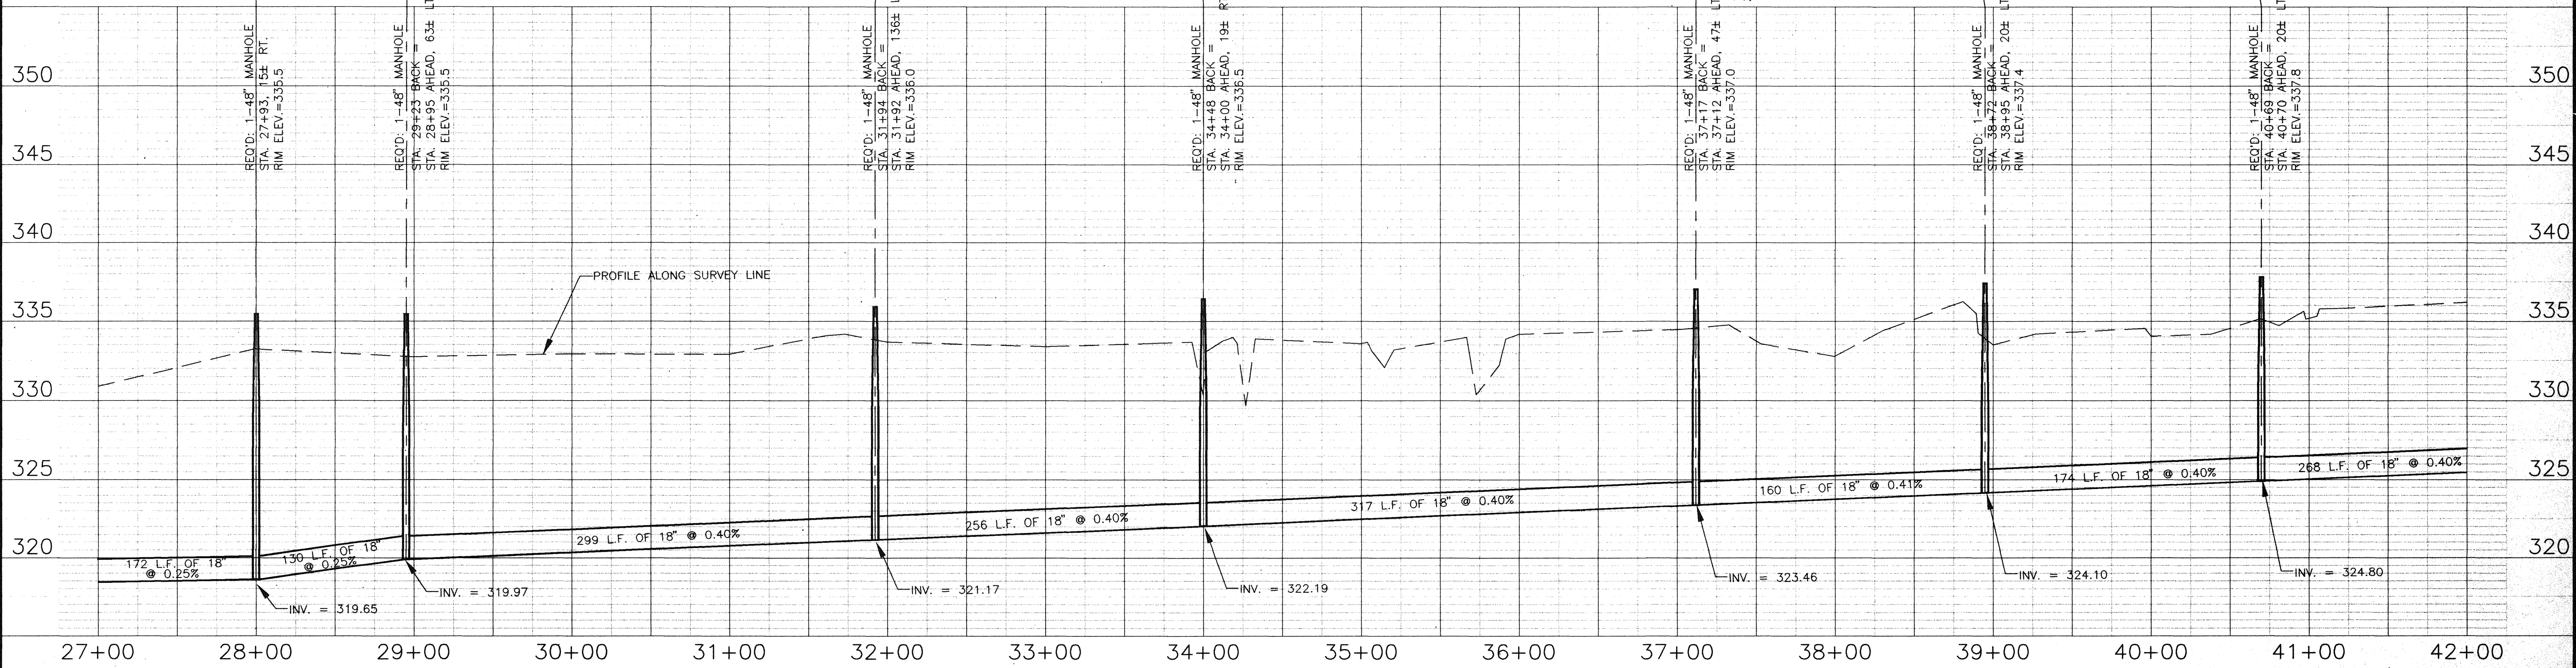

BCM BCM Engineers Inc.
 Engineers, Planners, Scientists and Laboratory Services


DESIGNER	R.B.M.	APPROVED	
DRAWN BY	L.R.W.	APPROVED	
ENGINEER	H.C.B.		
PROJECT MGR.	R.B.M.		
CHECKED BY	H.C.B.	DATE	FEBRUARY 1994

CITY OF JACKSON, MISSISSIPPI
 LAKE LARUE SANITARY SEWER
 INTERCEPTOR EXTENSION
PLAN/PROFILE
 STA. 27+00 TO STA. 42+00

SCALE	1" = 50' HORIZ. 1" = 5' VERT.
PROJECT NO.	05-3521-05
DRAWING NO.	C-3REC
SHEET	6 OF 11

Q-1692 (5)

* I.B.M. - TOP OF REBAR @ P.I. STA.
55+10.41, ELEV. 341.00

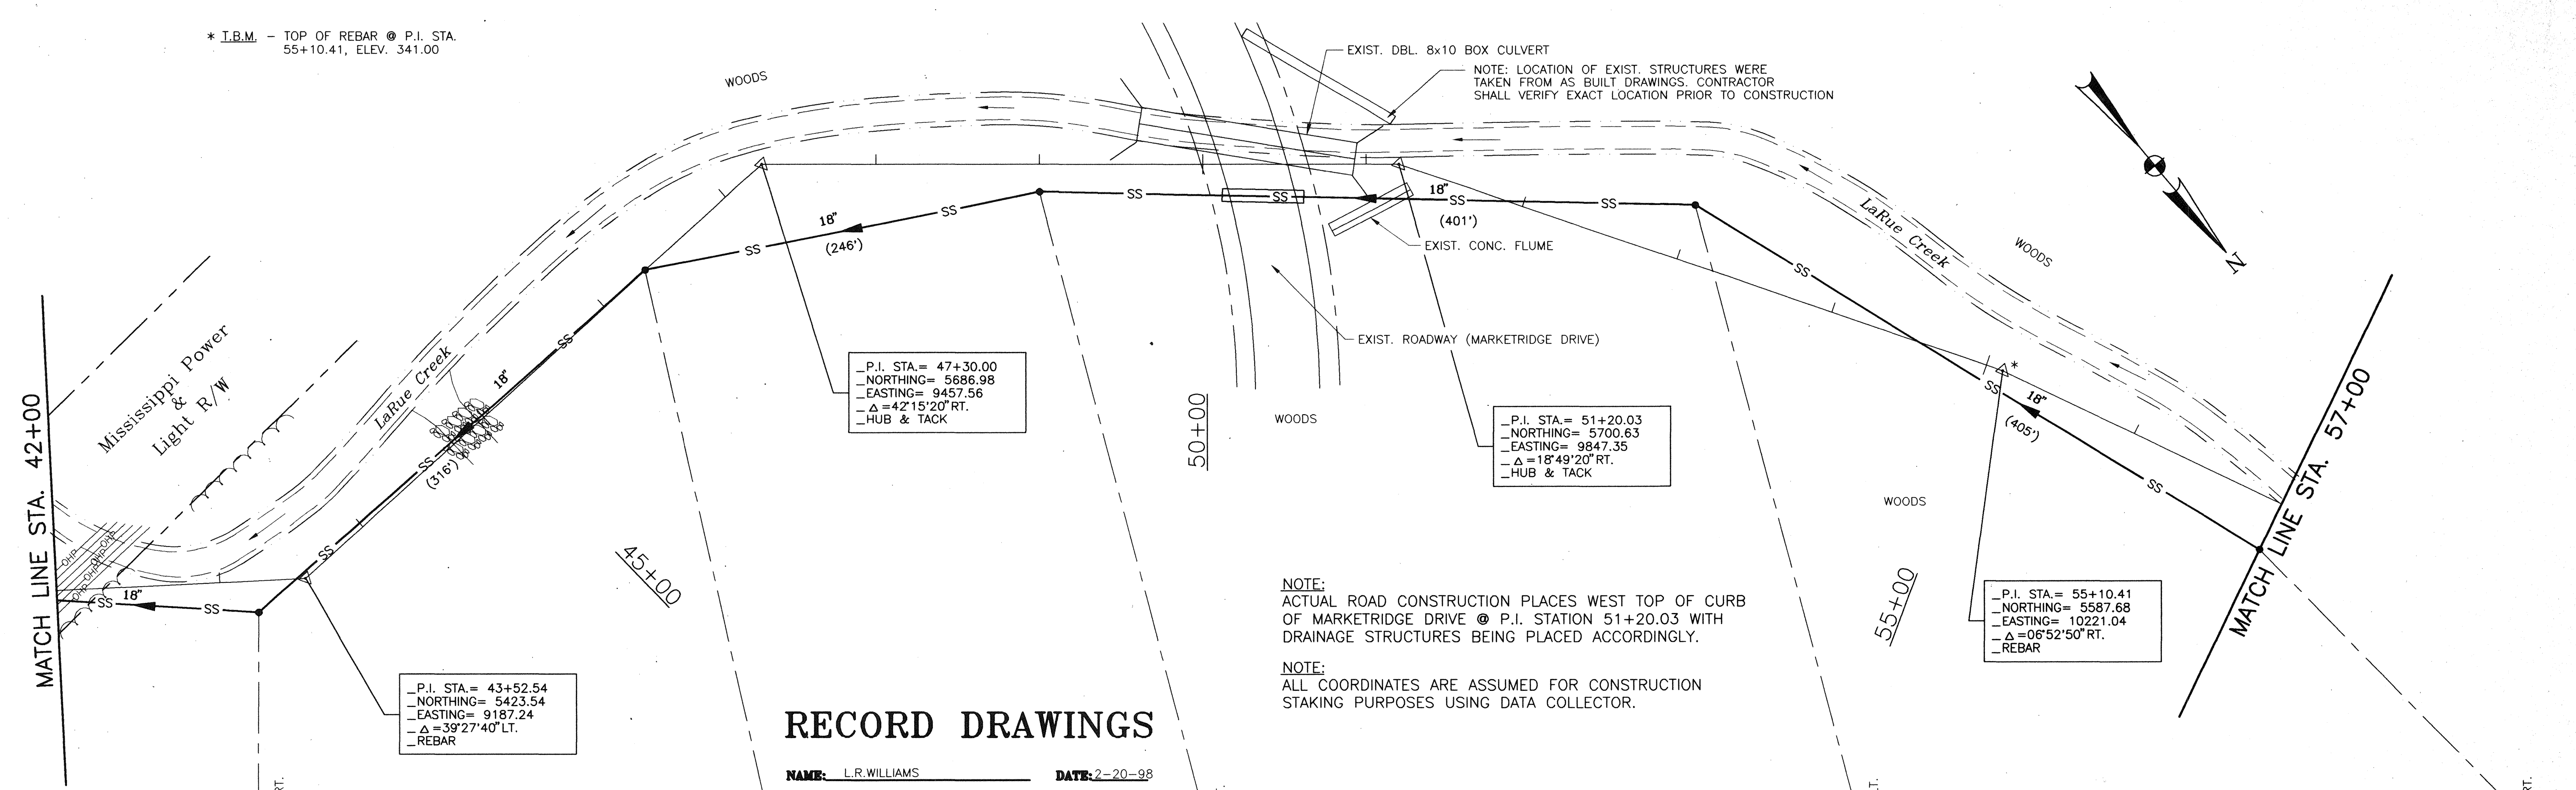

RECORD DRAWINGS

NAME: L.R.WILLIAMS DATE: 2-20-98

P.I. STA. = 43+52.54
NORTHING = 5423.54
EASTING = 9187.24
Δ = 39°27'40" LT.
REBAR


P.I. STA. = 47+30.00
NORTHING = 5686.98
EASTING = 9457.56
Δ = 42°15'20" RT.
HUB & TACK

P.I. STA. = 51+20.03
NORTHING = 5700.63
EASTING = 9847.35
Δ = 18°49'20" RT.
HUB & TACK

P.I. STA. = 55+10.41
NORTHING = 5587.68
EASTING = 10221.04
Δ = 06°52'50" RT.
REBAR

NOTE: ACTUAL ROAD CONSTRUCTION PLACES WEST TOP OF CURB OF MARKETRIDGE DRIVE @ P.I. STATION 51+20.03 WITH DRAINAGE STRUCTURES BEING PLACED ACCORDINGLY.

NOTE: ALL COORDINATES ARE ASSUMED FOR CONSTRUCTION STAKING PURPOSES USING DATA COLLECTOR.

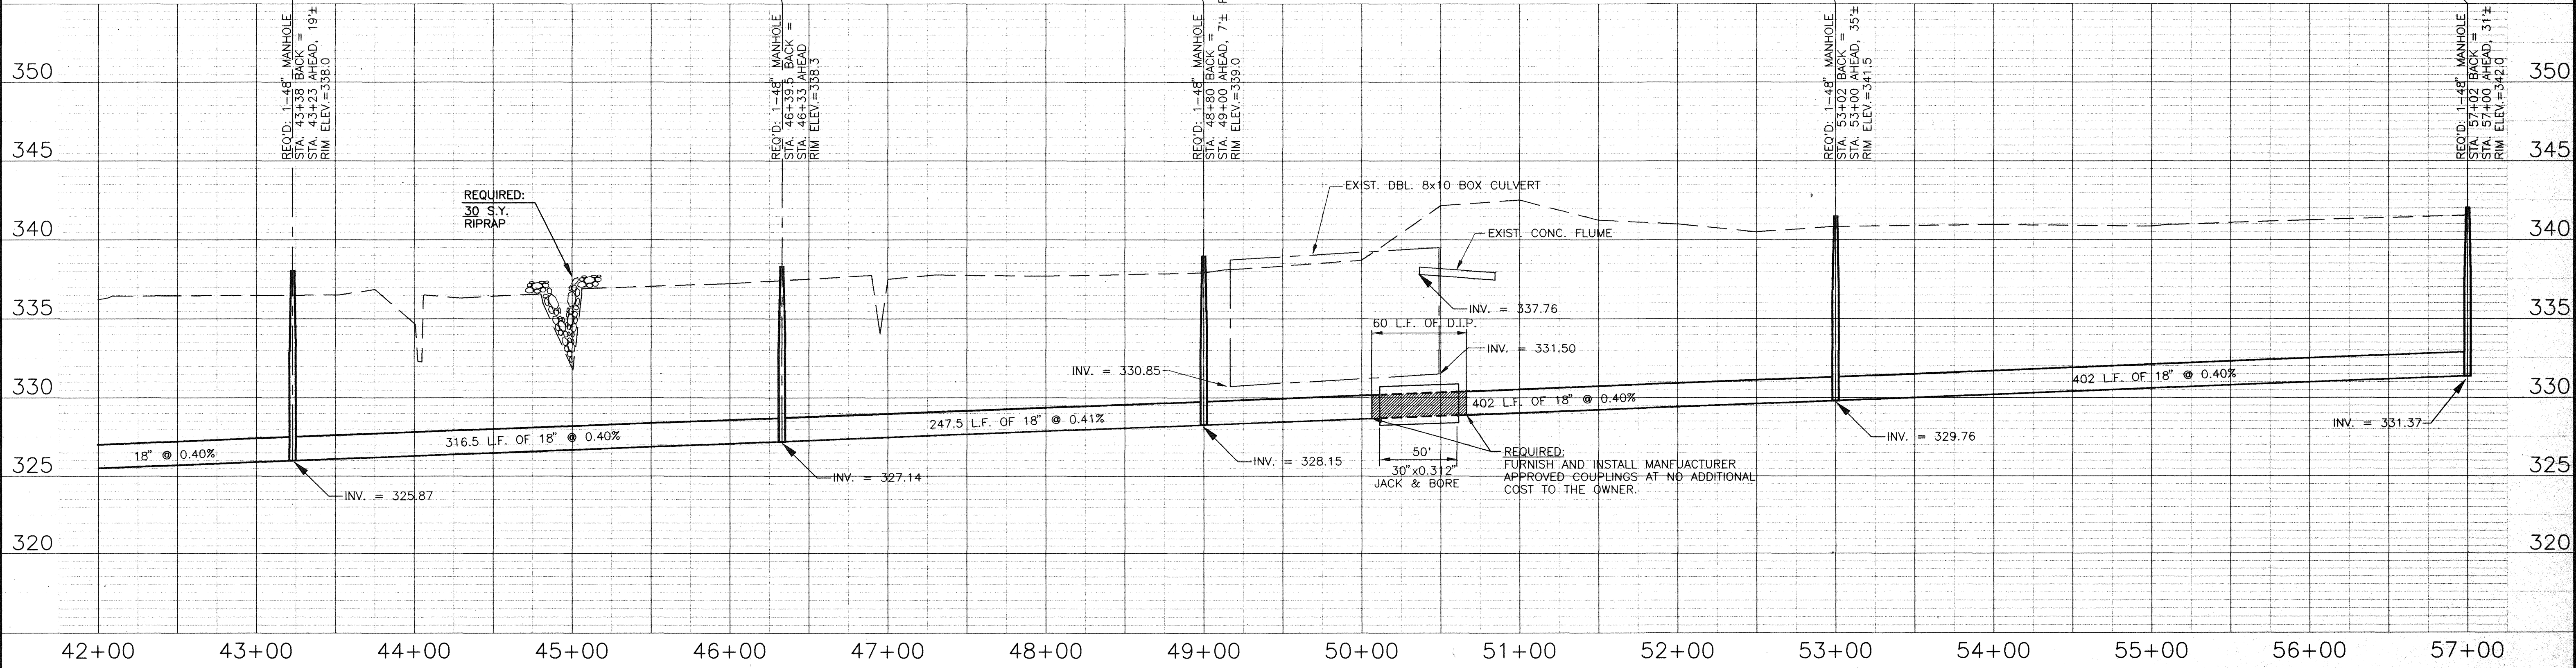

NO.	REVISION	DATE	ENG.	DATE	ISSUED FOR


BCM BCM Engineers Inc.
Engineers, Planners, Scientists and Laboratory Services

VERIFY SCALES
BAR IS ONE INCH ON ORIGINAL DRAWING
0 1"
IF NOT ONE INCH ON THIS SHEET ADJUST SCALES ACCORDINGLY

DESIGNER	R.B.M.	APPROVED	SEAL
DRAWN BY	L.R.W.	APPROVED	
ENGINEER	H.C.B.		
PROJECT MGR.	R.B.M.		
CHECKED BY	H.C.B.	DATE	FEBRUARY 1994

CITY OF JACKSON, MISSISSIPPI
LAKE LARUE SANITARY SEWER INTERCEPTOR EXTENSION
PLAN/PROFILE
STA. 42+00 TO STA. 57+00
SCALE 1"=50' HORIZ.
1"=5' VERT.
PROJECT NO. 05-3521-05
DRAWING NO. C-4REC
SHEET 7 OF 11

Q-16 92 (5)

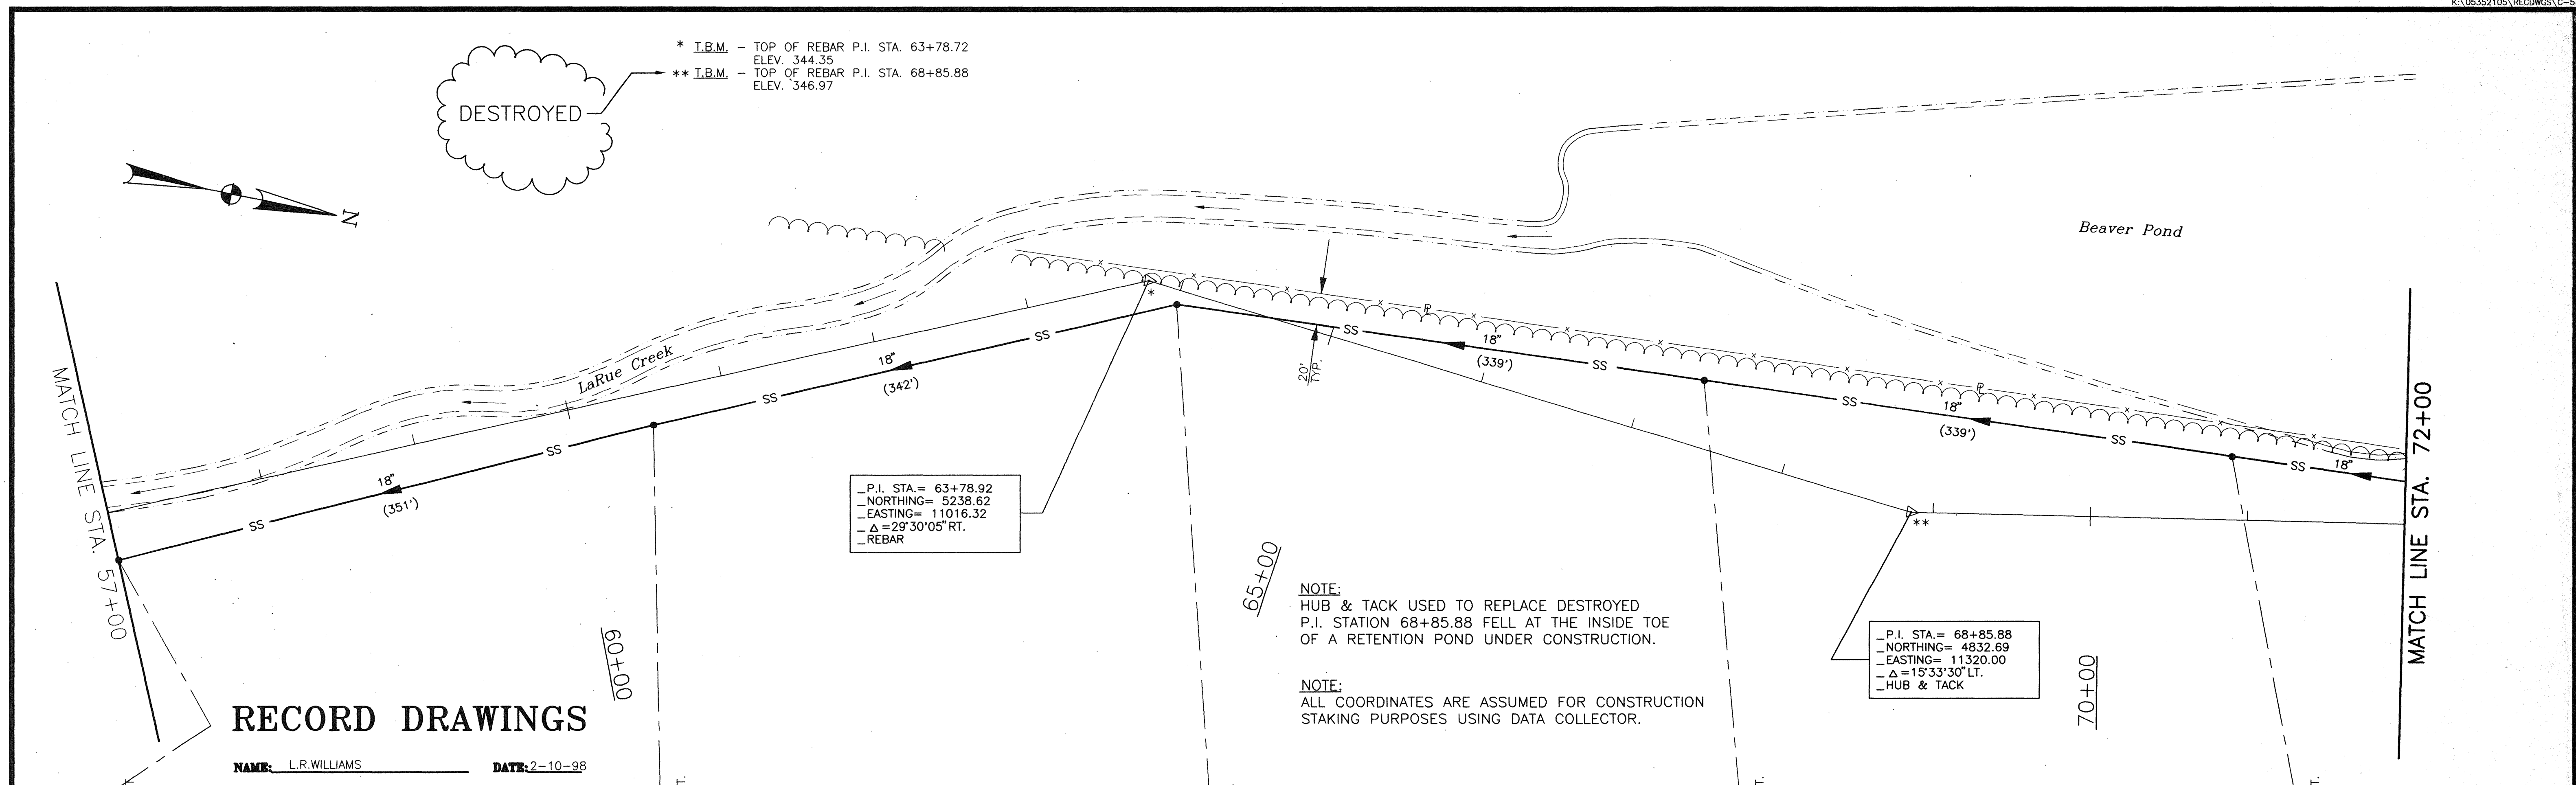

RECORD DRAWINGS


NAME: L.R.WILLIAMS DATE: 2-10-98

P.I. STA. = 63+78.92
NORTHING = 5238.62
EASTING = 11016.32
Δ = 29°30'05" RT.
REBAR

NOTE:
HUB & TACK USED TO REPLACE DESTROYED
P.I. STATION 68+85.88 FELL AT THE INSIDE TOE
OF A RETENTION POND UNDER CONSTRUCTION.

NOTE:
ALL COORDINATES ARE ASSUMED FOR CONSTRUCTION
STAKING PURPOSES USING DATA COLLECTOR.

P.I. STA. = 68+85.88
NORTHING = 4832.69
EASTING = 11320.00
Δ = 15°33'30" LT.
HUB & TACK

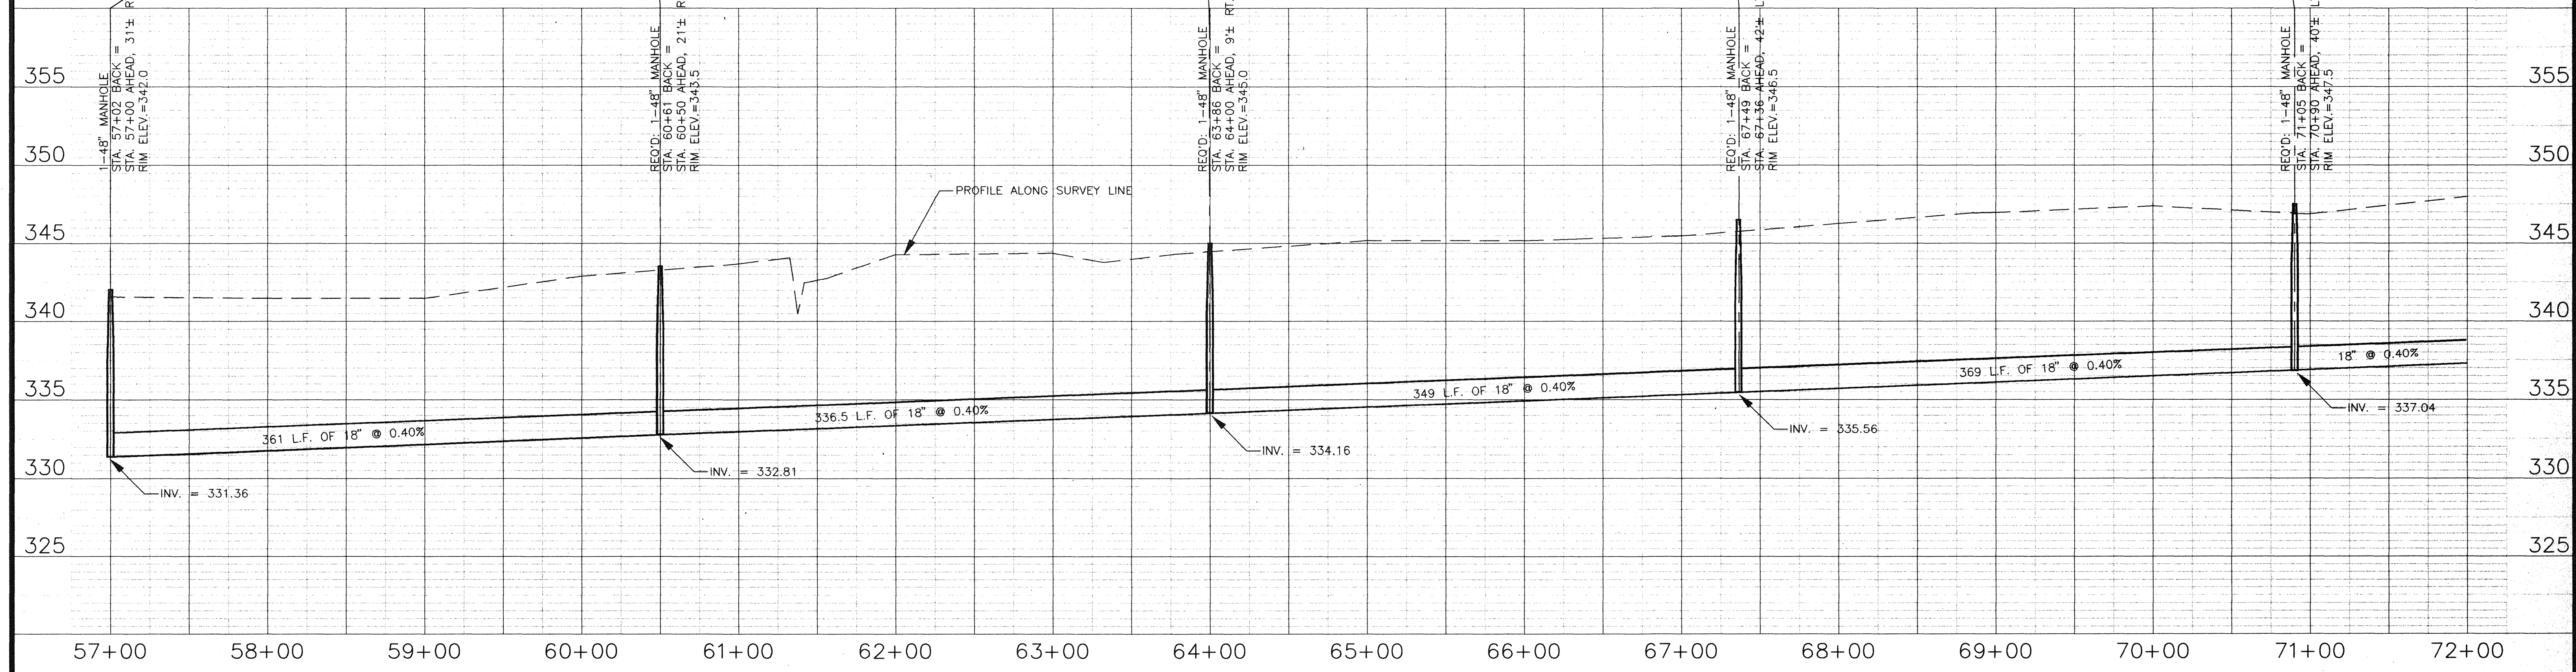

NO.	REVISION	DATE	ENG.	DATE	ISSUED FOR


BCM BCM Engineers Inc.
Engineers, Planners, Scientists and Laboratory Services

DESIGNER	R.B.M.	APPROVED	
DRAWN BY	L.R.W.		
ENGINEER	H.C.B.	APPROVED	
PROJECT MGR.	R.B.M.		
CHECKED BY	H.C.B.	DATE	FEBRUARY 1994

CITY OF JACKSON, MISSISSIPPI
LAKE LARUE SANITARY SEWER
INTERCEPTOR EXTENSION
PLAN/PROFILE
STA. 57+00 TO STA. 72+00


SCALE	1" = 50' HORIZ. 1" = 5' VERT.
PROJECT NO.	05-3521-05
DRAWING NO.	C-5REC
SHEET	8 of 11

Q-1692 (S)

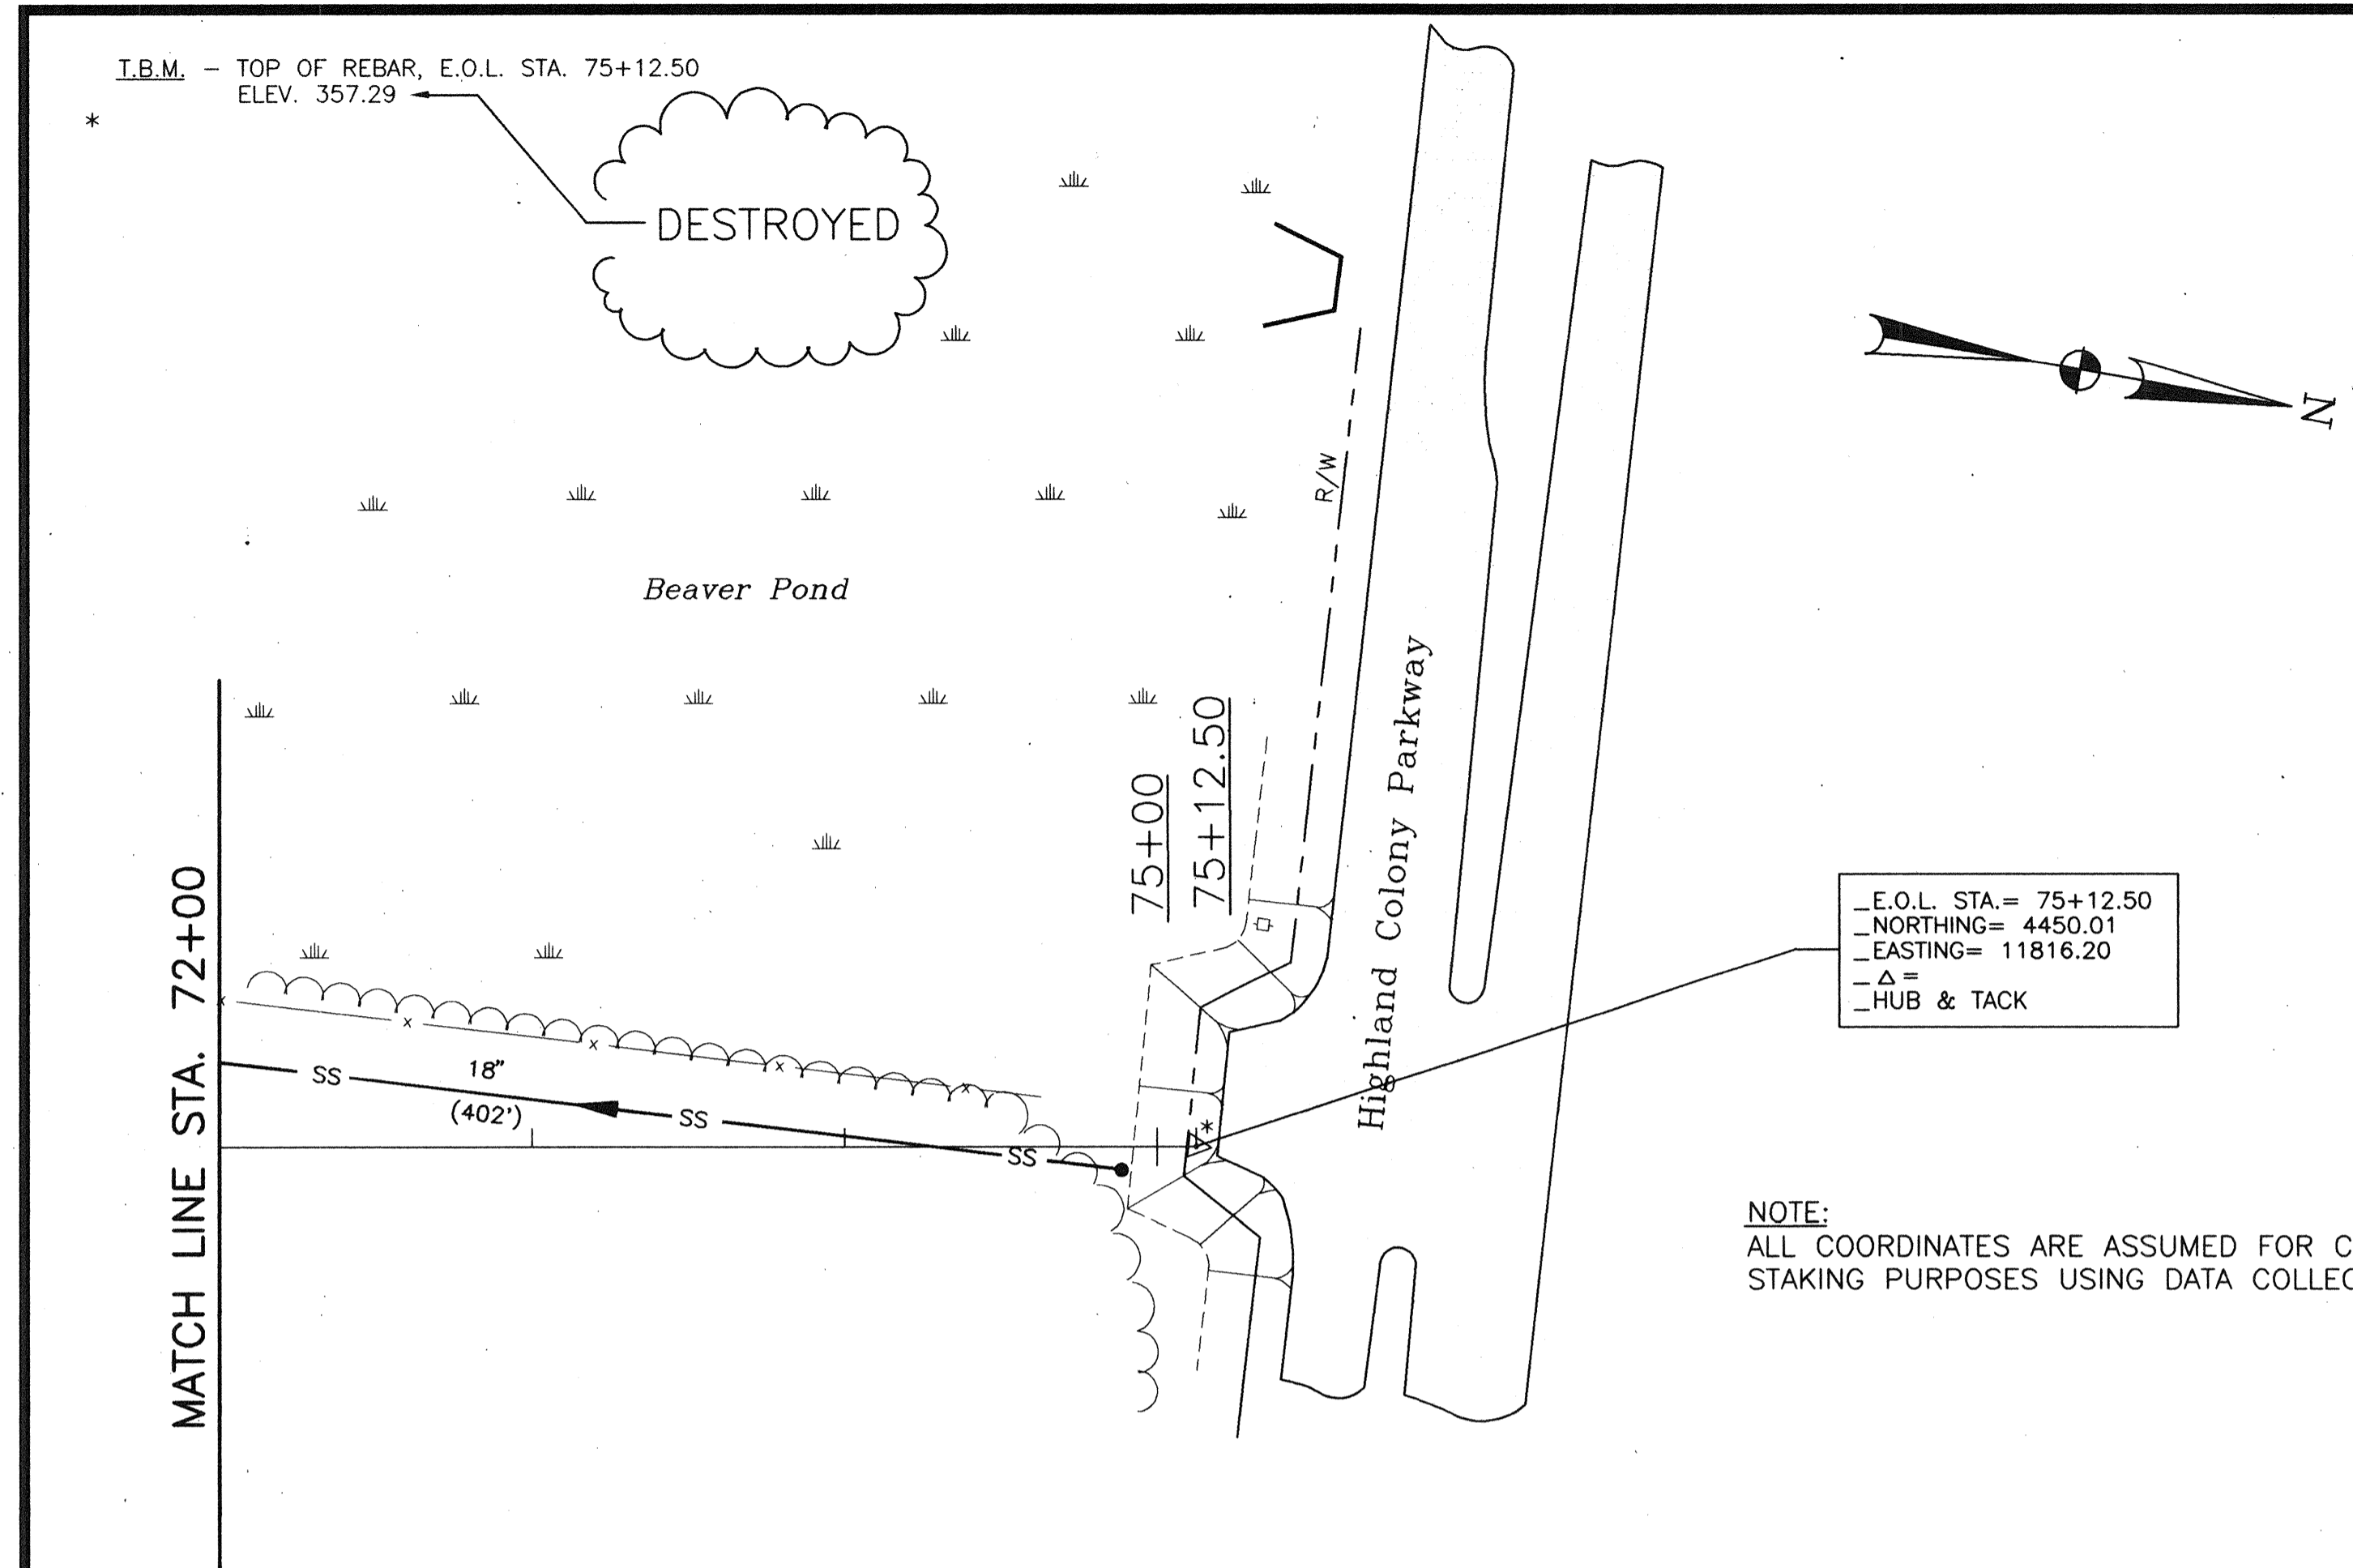

RECORD DRAWINGS

NAME: L.R.WILLIAMS DATE: 2-10-98

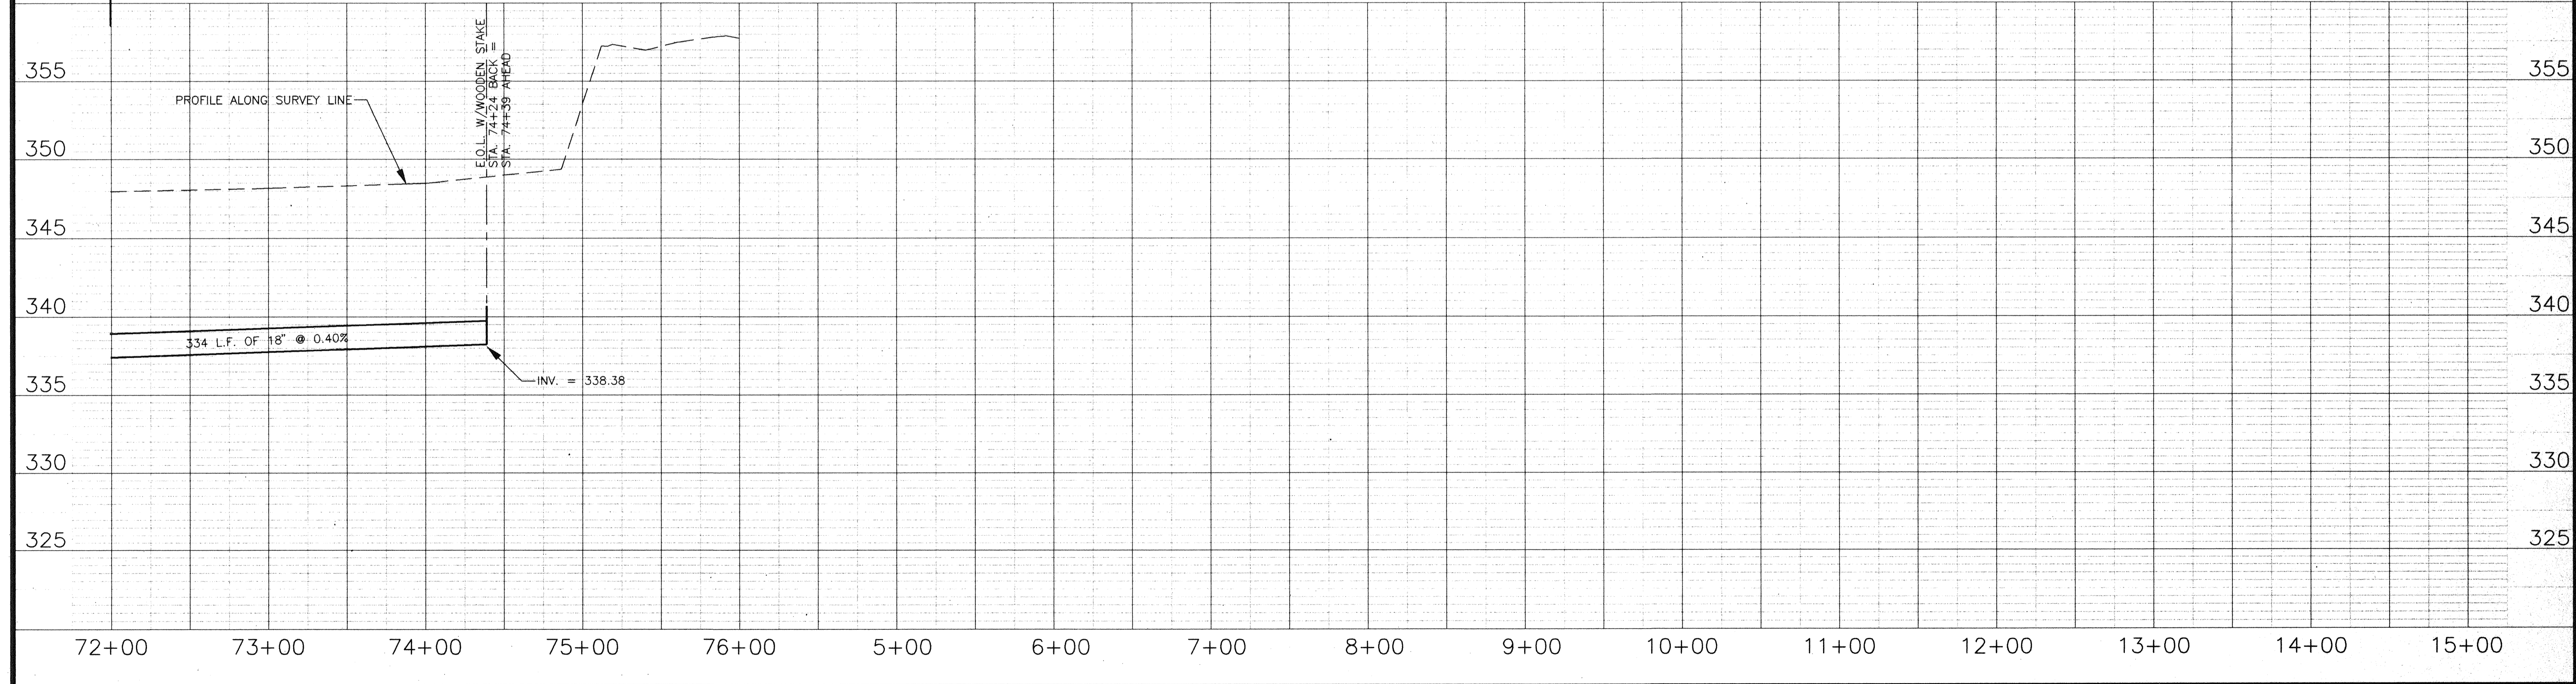

NO.	REVISION	DATE	ENG.	DATE	ISSUED FOR

BCM BCM Engineers Inc.
Engineers, Planners, Scientists and Laboratory Services

DESIGNER	R.B.M.	APPROVED	SEAL
DRAWN BY	L.R.W.	APPROVED	
ENGINEER	H.C.B.		
PROJECT MGR.	R.B.M.		
CHECKED BY	H.C.B.	DATE	FEBRUARY 1994


CITY OF JACKSON, MISSISSIPPI
LAKE LARUE SANITARY SEWER
INTERCEPTOR EXTENSION

SCALE 1" = 50' HORIZ.
1" = 5' VERT.


PROJECT NO. 05-3521-05
DRAWING NO. C-6REC
SHEET 9 OF 11

PLAN/PROFILE
STA. 72+00 TO STA. 75+12.50


Q-1692(5)

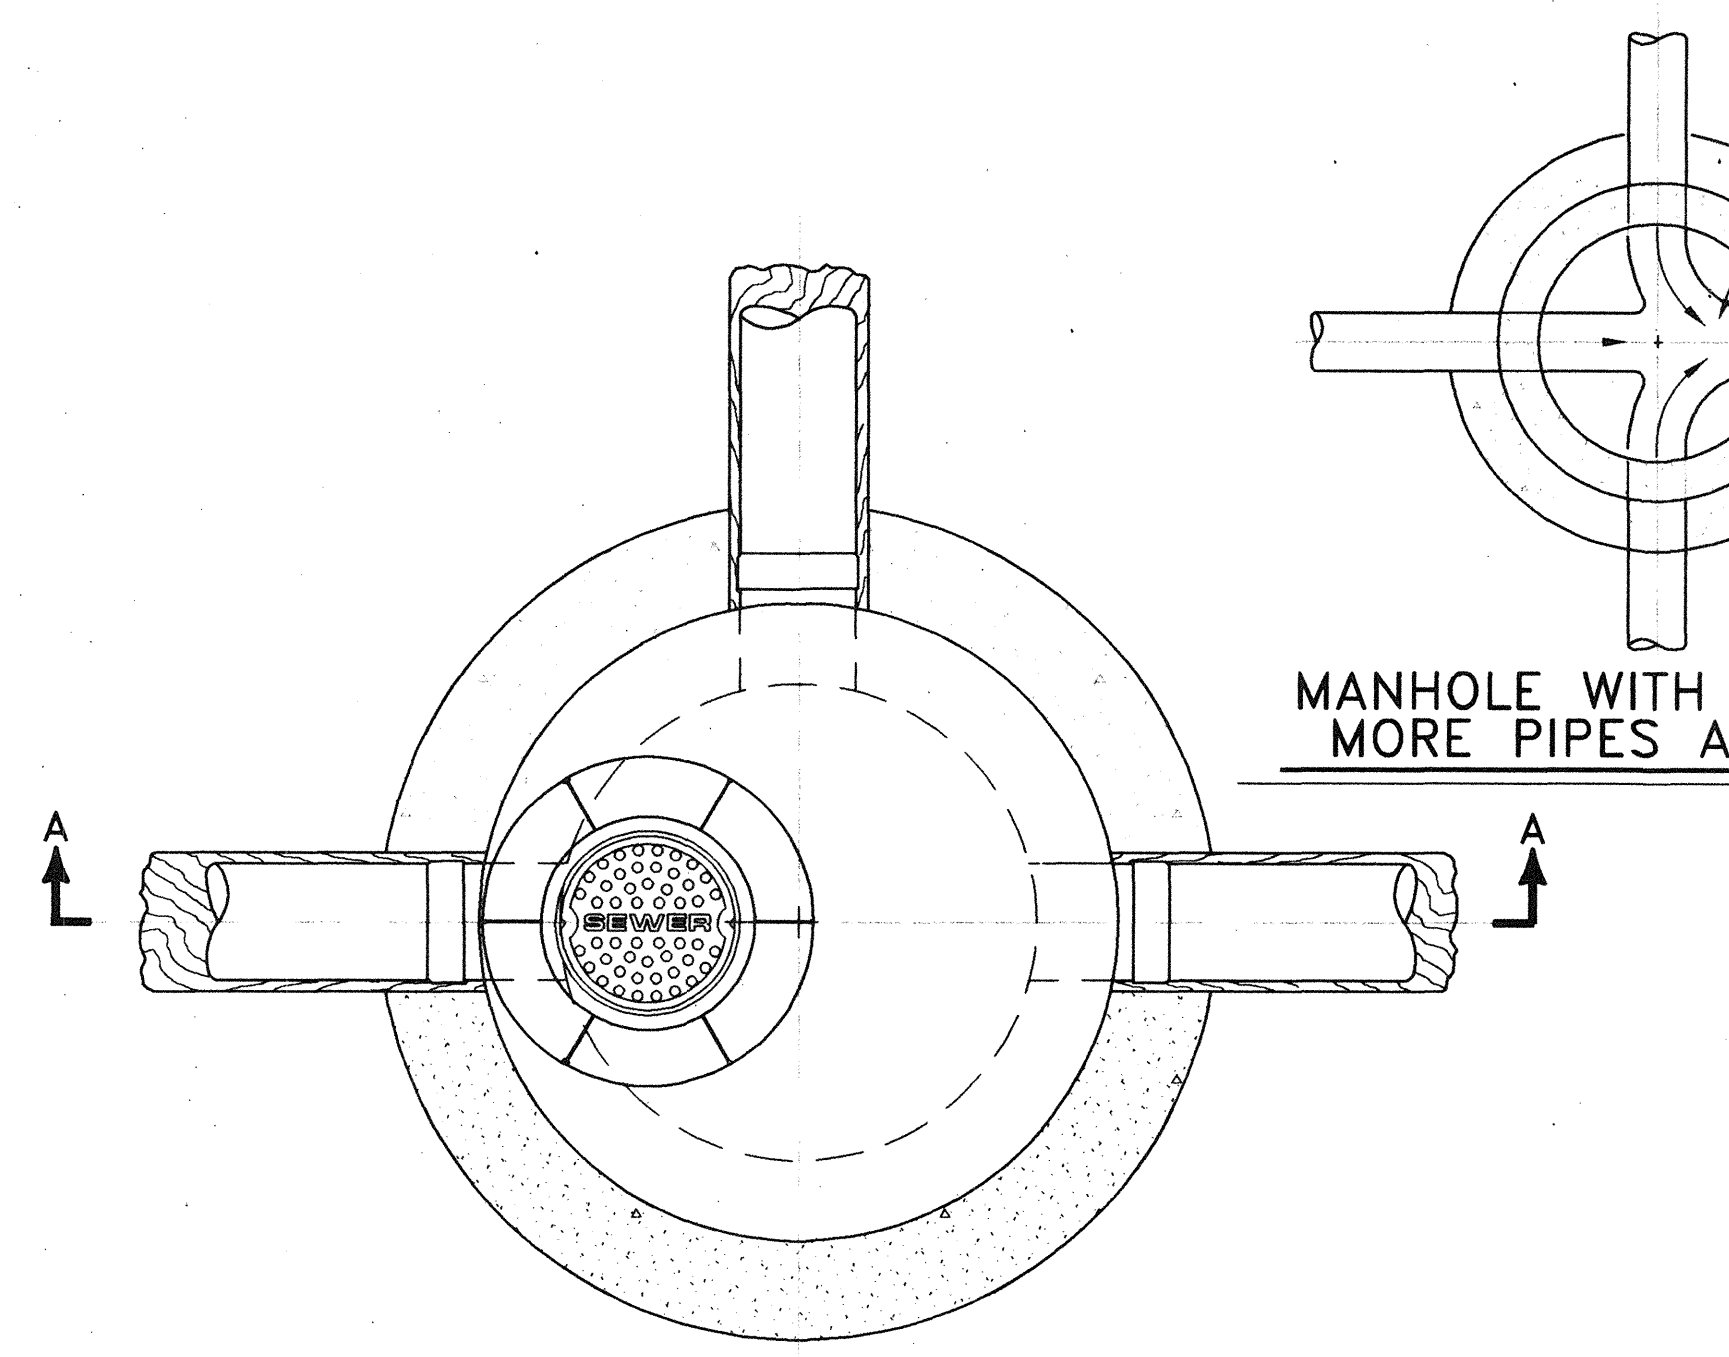


PLAN

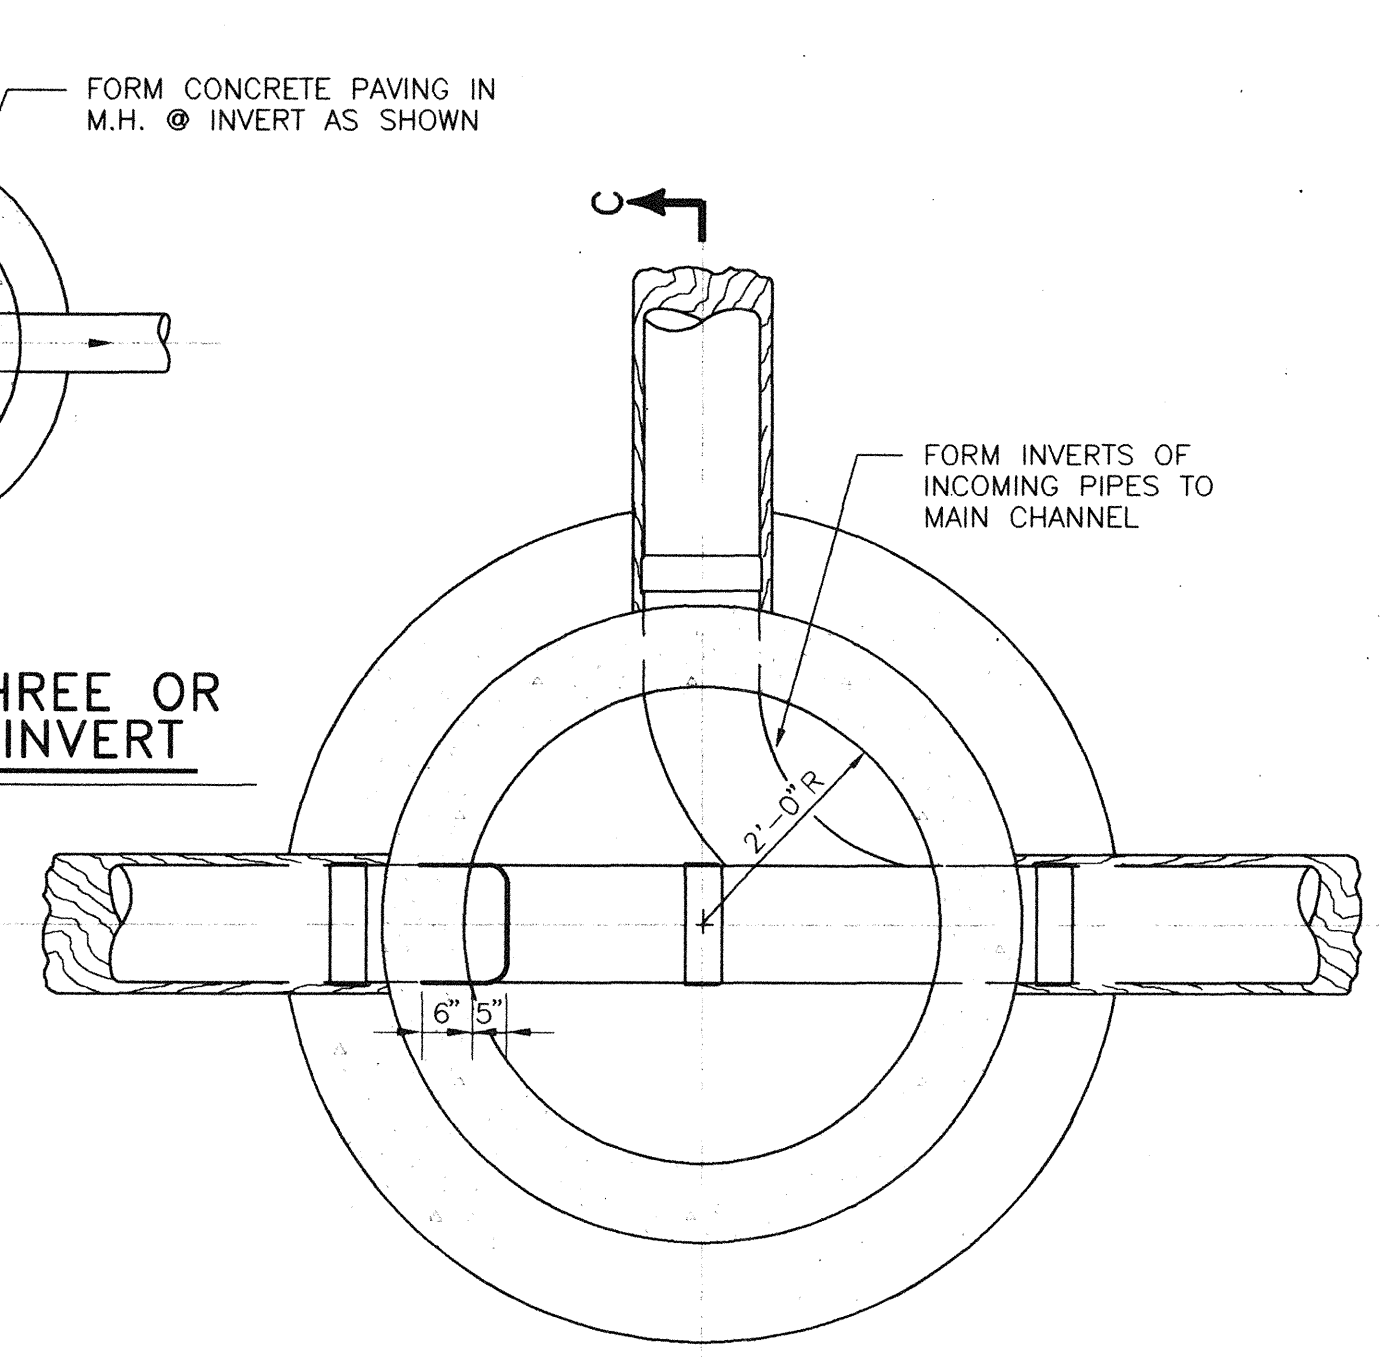


SECTION B-B

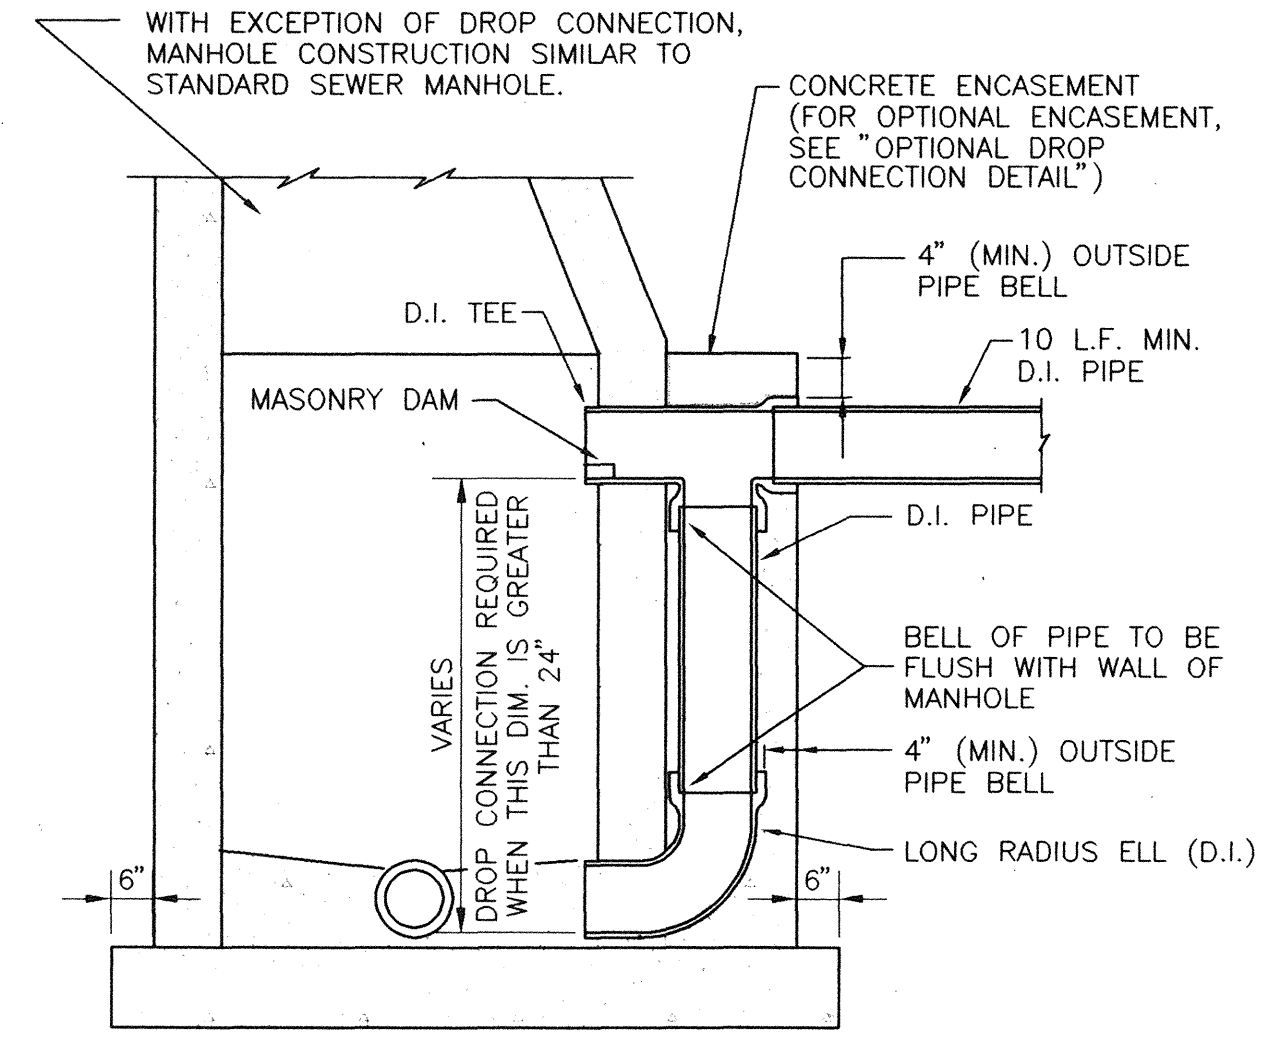


DETAIL OF DROP CONNECTION AT MANHOLE

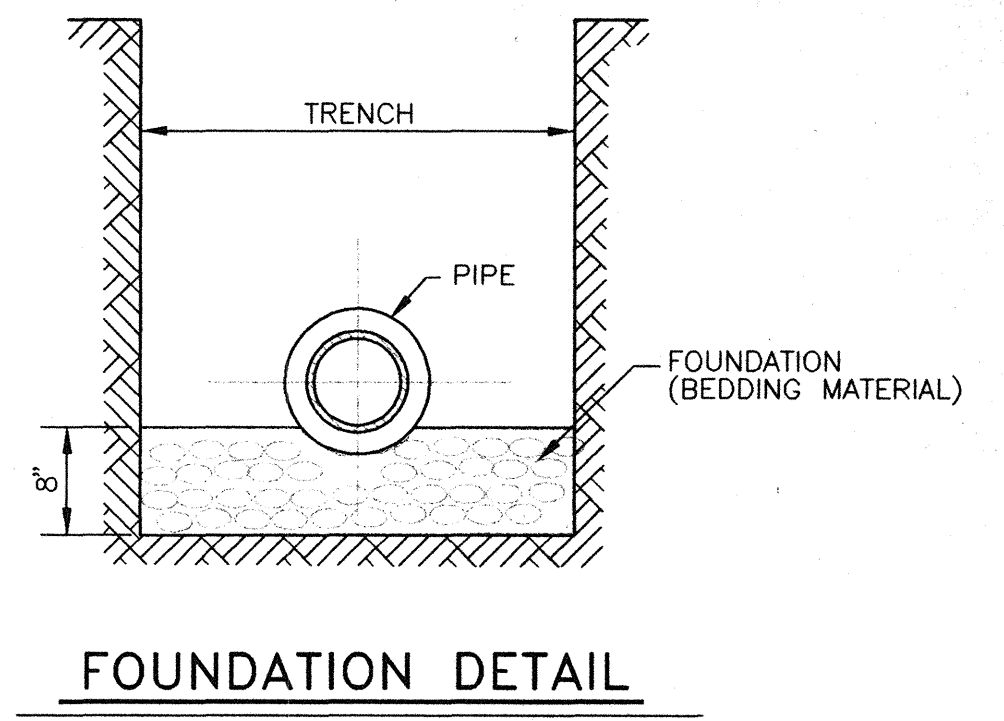

FOUNDATION DETAIL

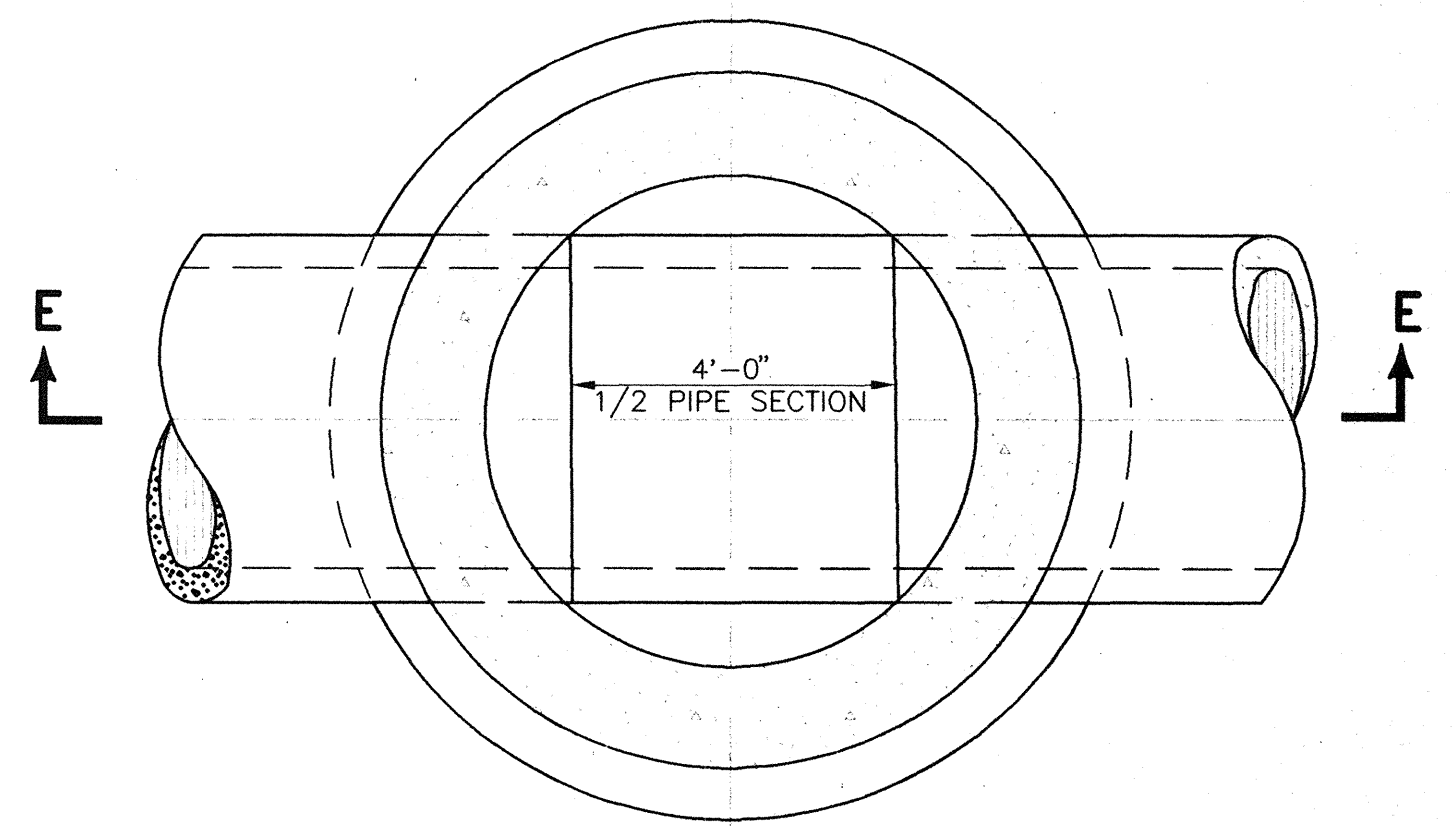


PLAN

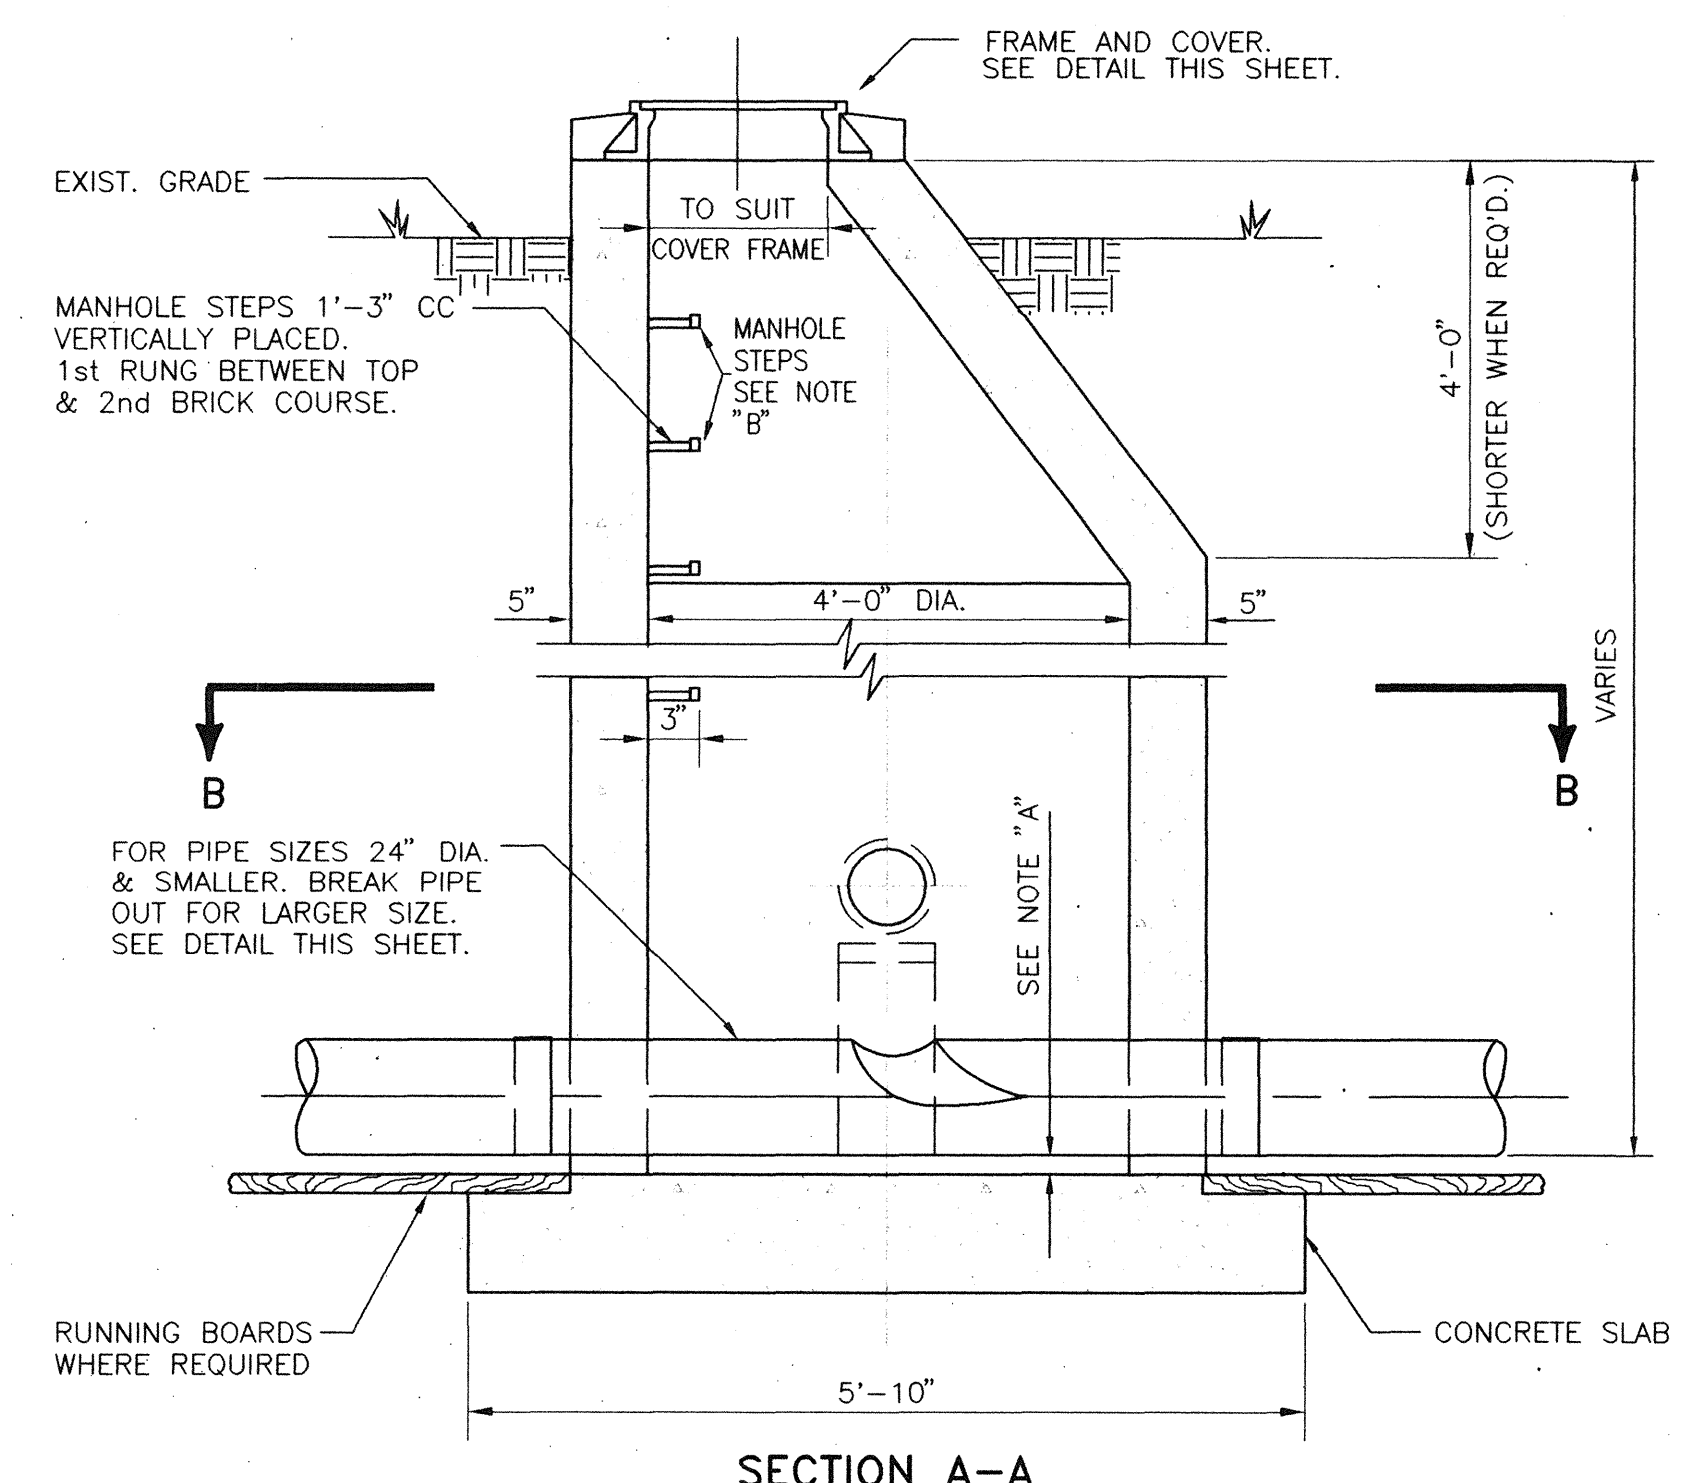


SECTION A-A


DETAIL OF MANHOLE FOR PIPE 24" DIA. & SMALLER

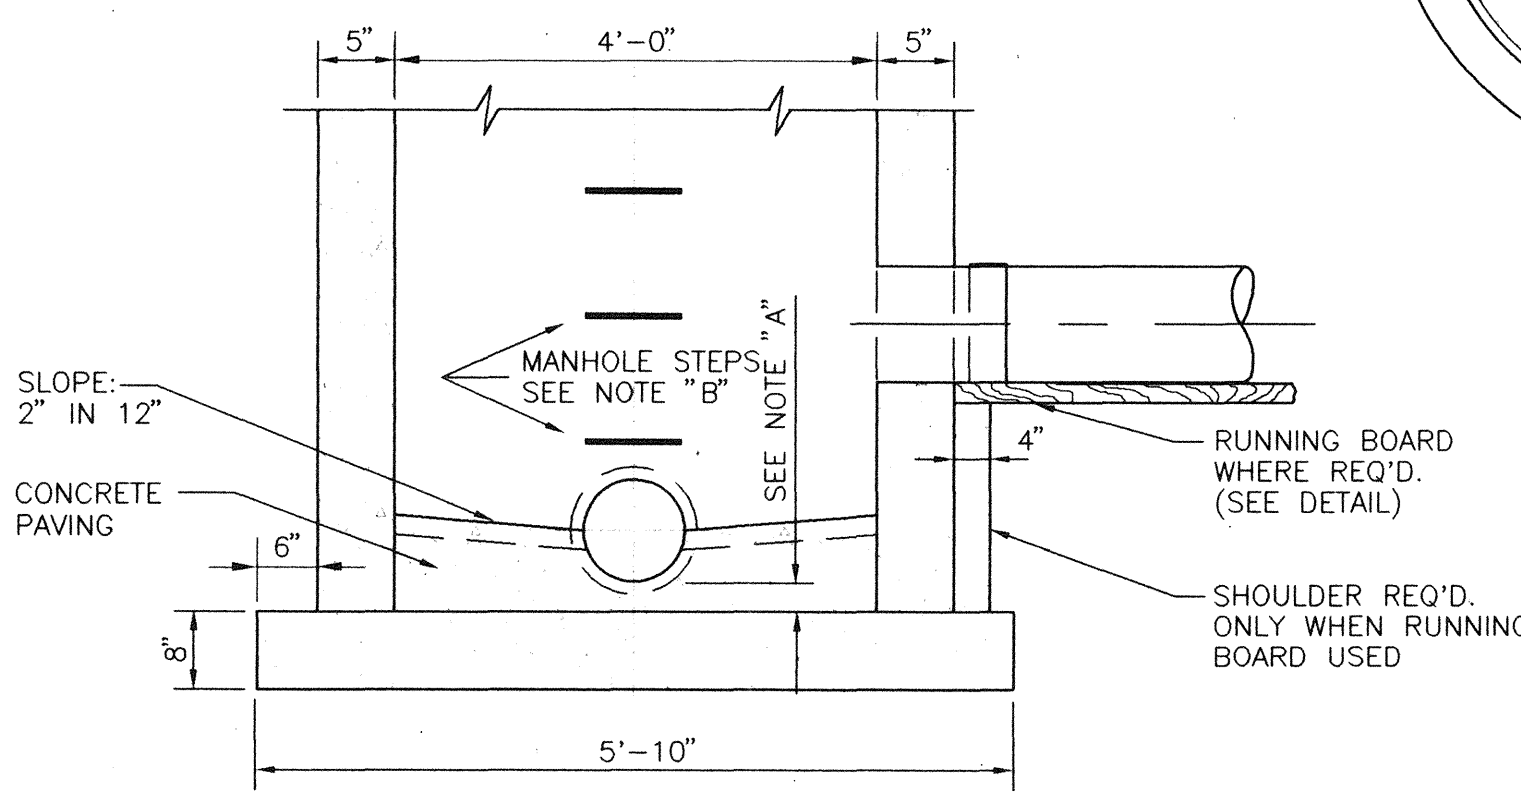

SECTION C-C

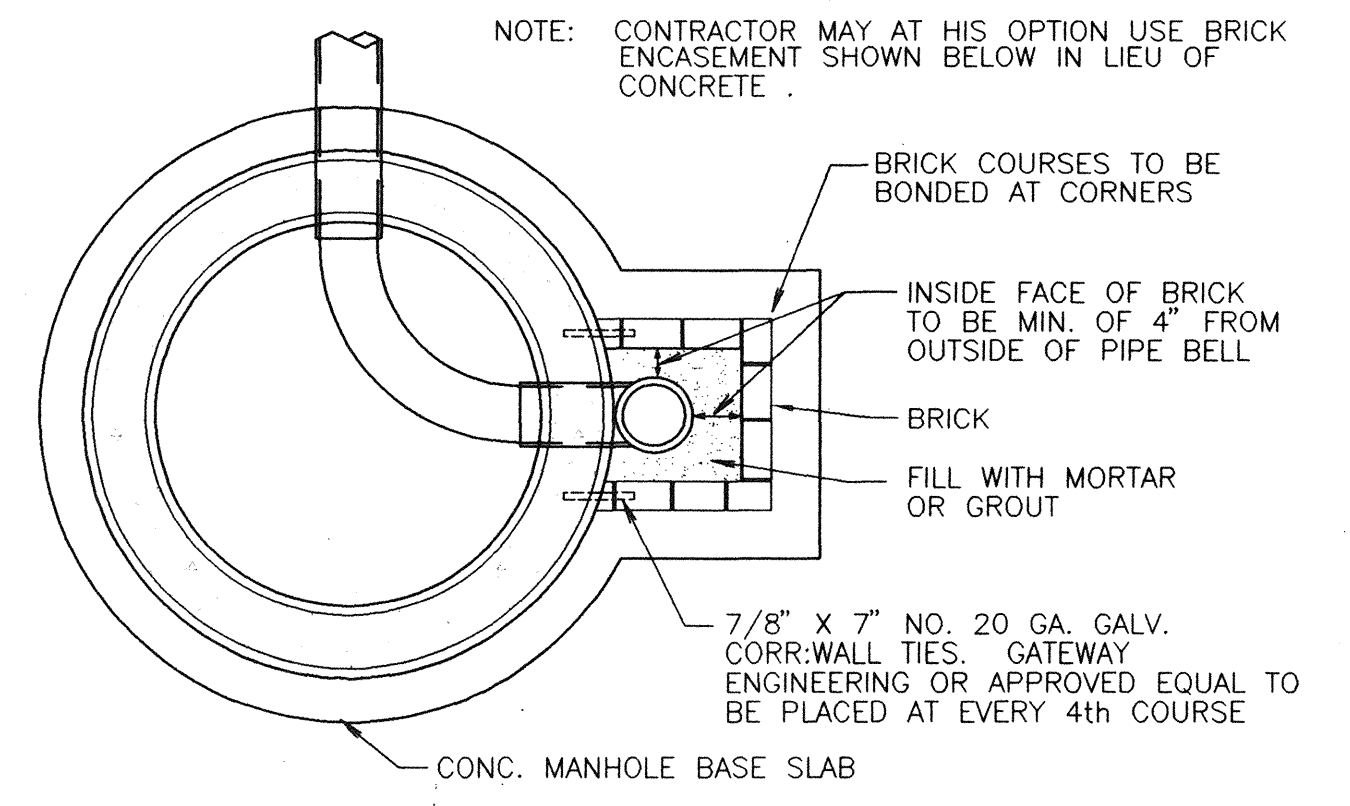


OPTIONAL DROP CONNECTION DETAIL

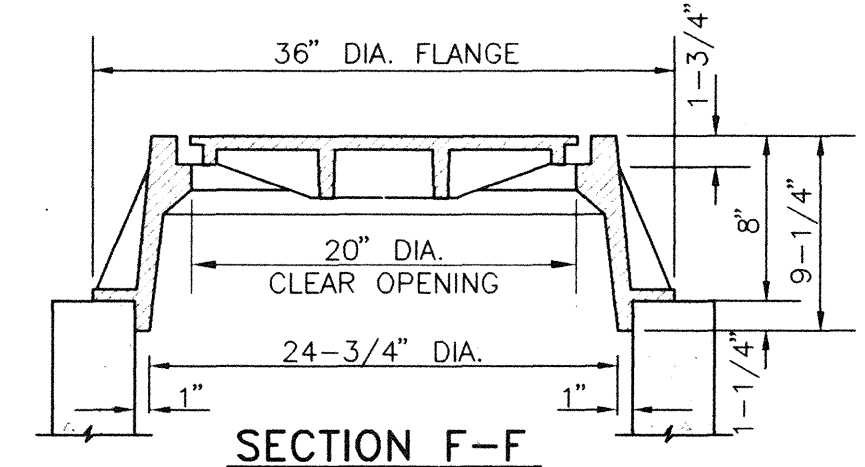


SECTION F-F

NOTE: THE PORTION OF THE FRAME AND COVER WHICH FORMS THE COVER SEAT SHALL BE MACHINED SO THAT NO ROCKING IS POSSIBLE.

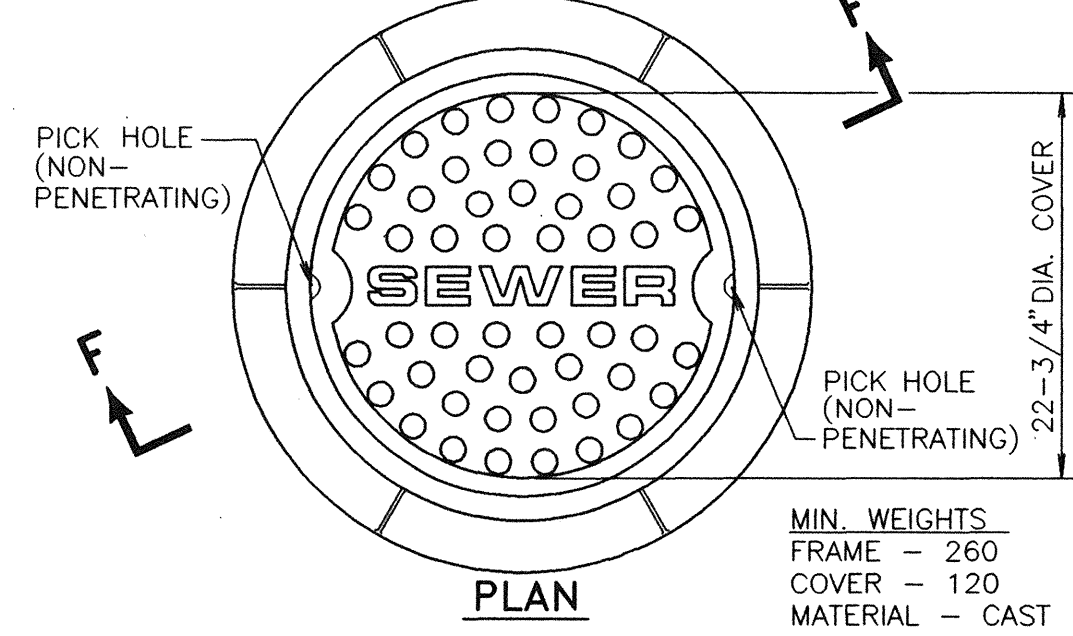


PLAN

MANHOLE FRAME & COVER DETAIL

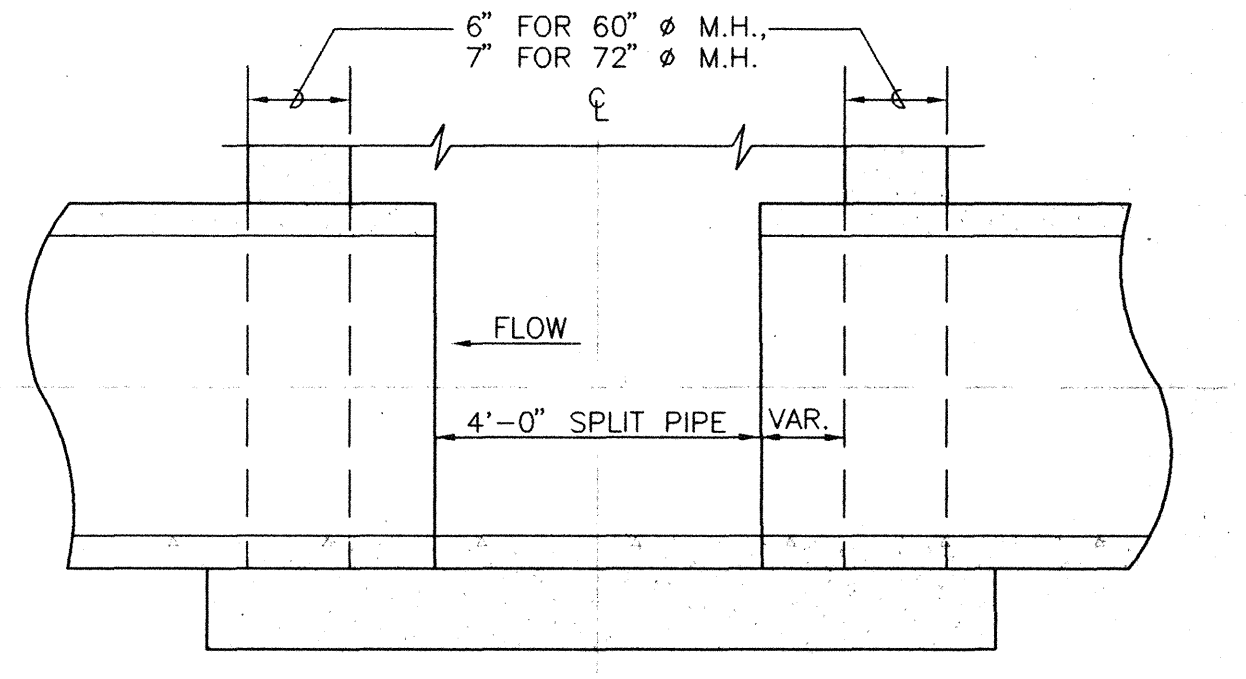

SECTION E-E

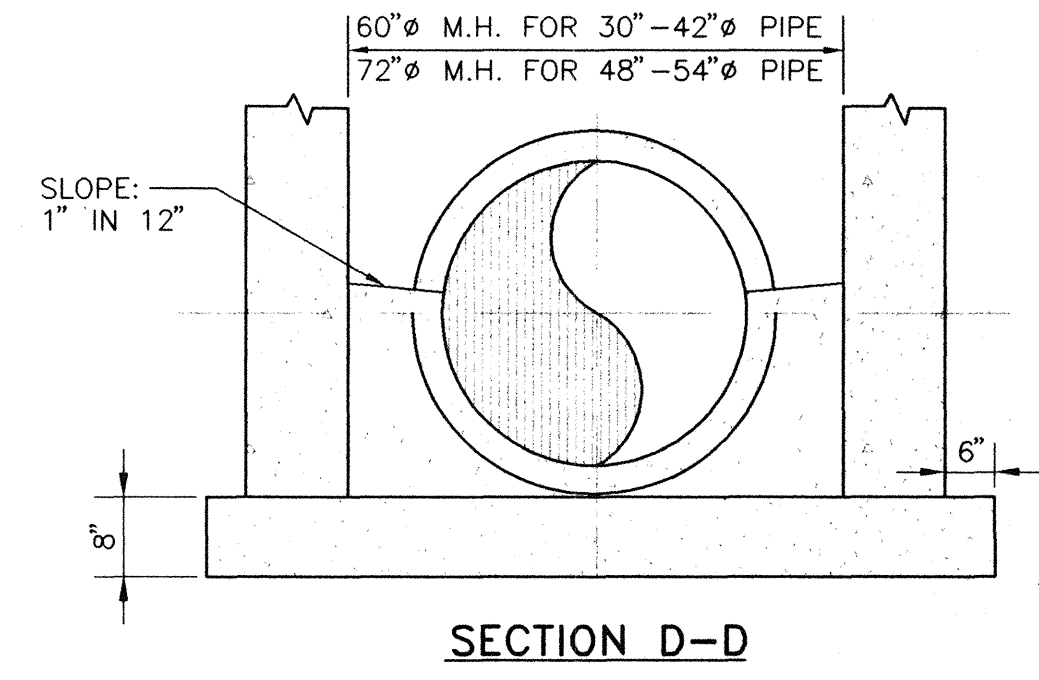

SECTION D-D


DETAIL OF MANHOLE FOR PIPE SIZES LARGER THAN 24" DIA.

NOTE: DETAILS NOT SHOWN SHALL BE SAME AS FOR M.H. SIZE PIPE 24" & SMALLER

NOTE "A"
DISTANCE BETWEEN INVERT OF PIPE AND OUTSIDE OF BELL DETERMINES THE ELEVATION OF TOP OF 8" CONCRETE SLAB.
NOTE "B"
MANHOLE STEPS SHALL BE STEEL RODS ENCASED IN POLYPROPYLENE PLASTIC AND SHALL BE TYPE "PS-1-B" AS MANUFACTURED BY M.A. INDUSTRIES, INC., OR AN APPROVED EQUAL.

RECORD DRAWINGS

NAME: L.R.WILLIAMS DATE: 2-10-98

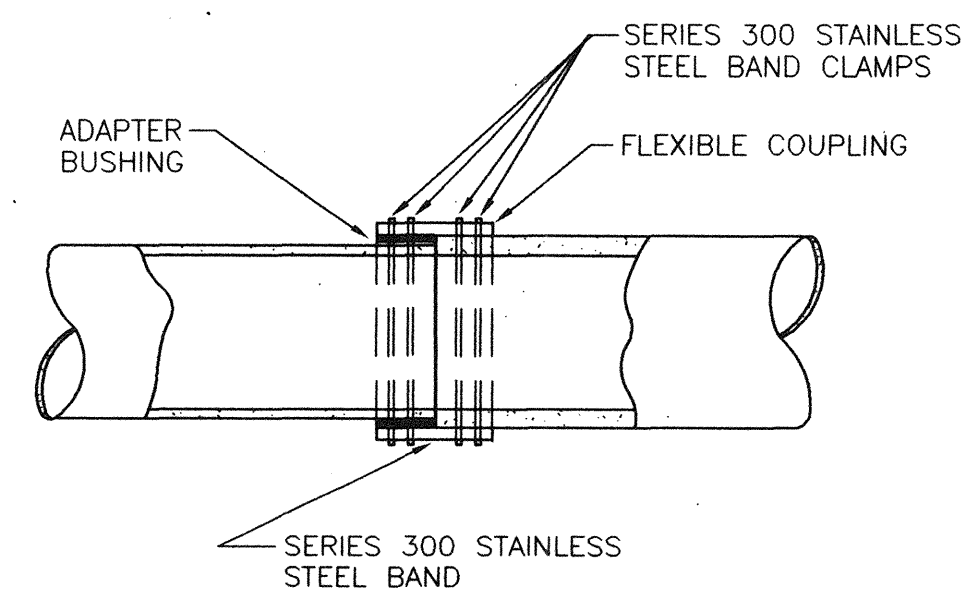

JOINT DETAIL FOR COUPLING OF PIPES OF DISSIMILAR O.D. UP TO 12"


NO.	REVISION	DATE	ENG.	DATE	ISSUED FOR

BCM BCM Engineers Inc.
Engineers, Planners, Scientists and Laboratory Services

DESIGNER	R.B.M.	APPROVED	
DRAWN BY	L.R.W.		
ENGINEER	H.C.B.	APPROVED	
PROJECT MGR.	R.B.M.		
CHECKED BY	H.C.B.	DATE	JANUARY 1993

CITY OF JACKSON, MISSISSIPPI
LAKE LARUE SANITARY SEWER
INTERCEPTOR EXTENSION
**SANITARY SEWER
CONSTRUCTION DETAILS**


SCALE	N.T.S.
PROJECT NO.	05-3521-05
DRAWING NO.	C-7REC
SHEET	10 of 11

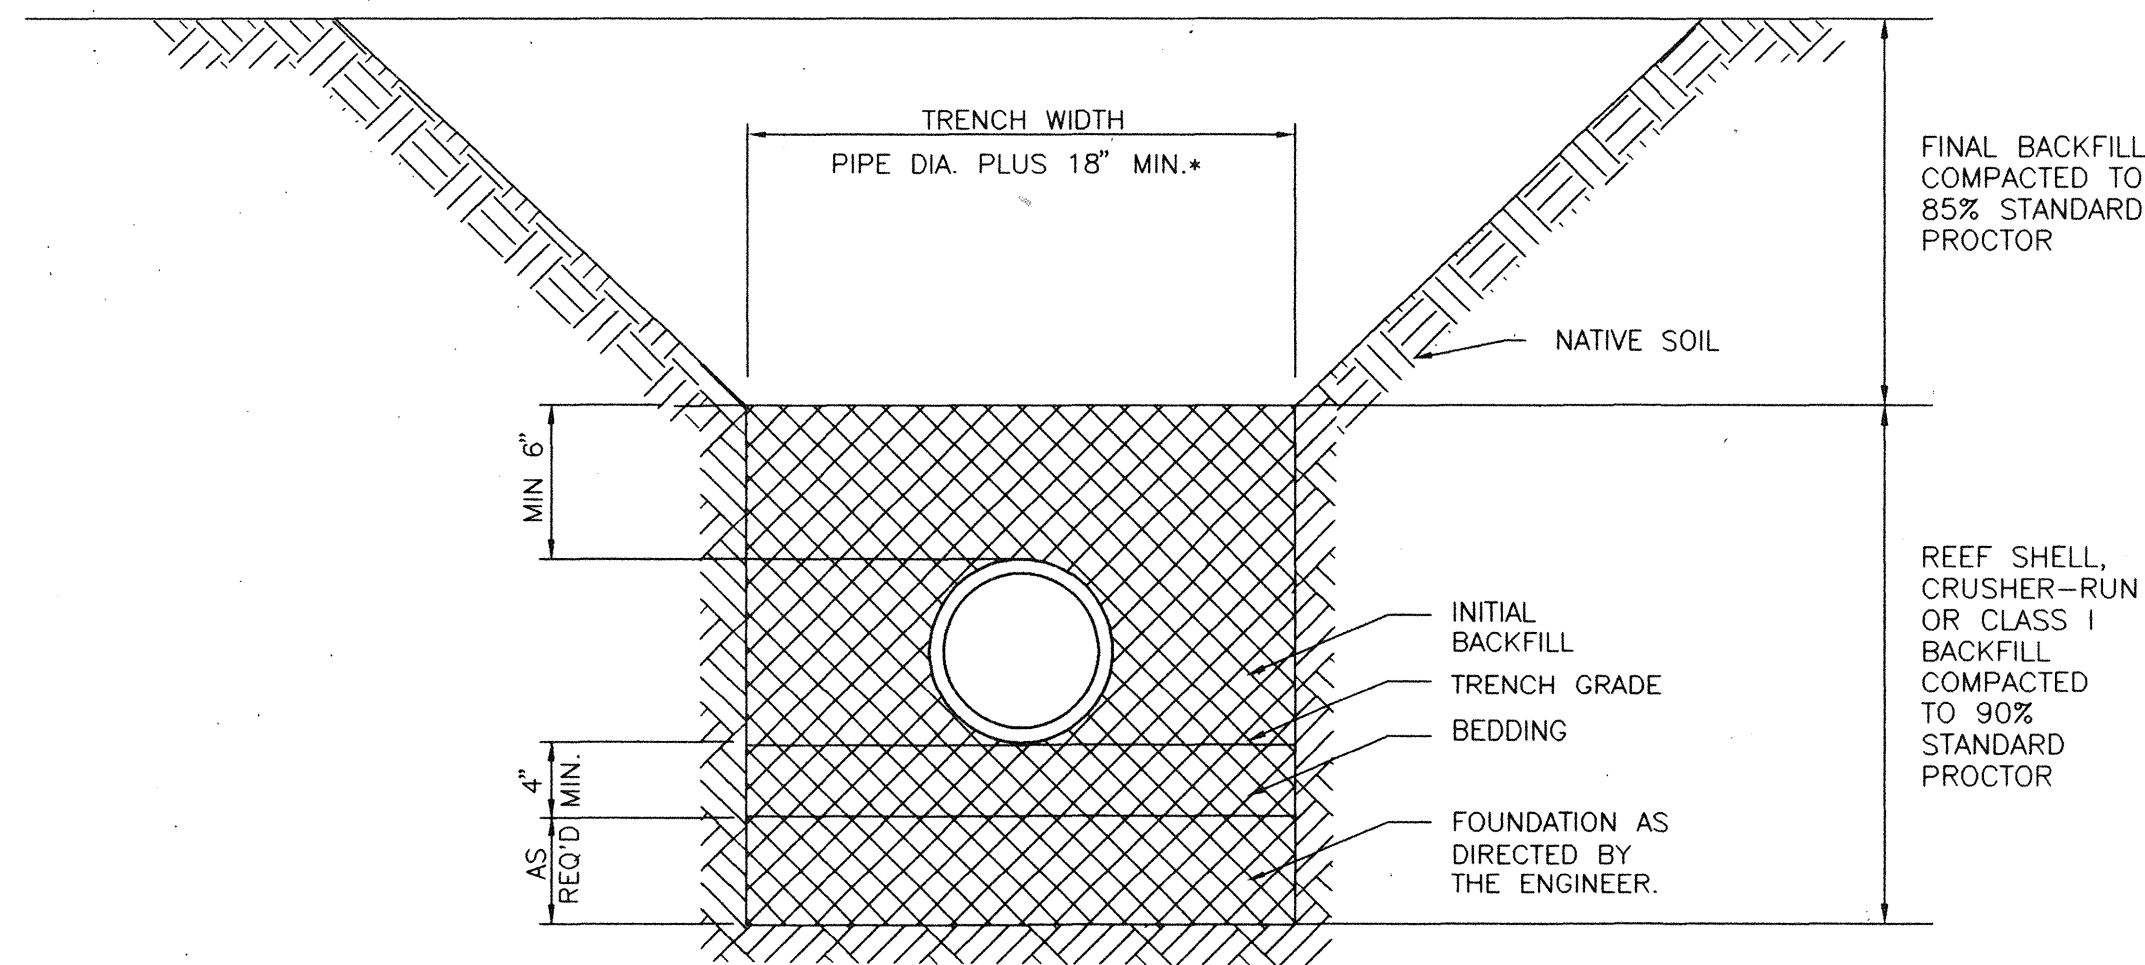

NOTE: WHEN GROUNDWATER LEVELS ARE EXPECTED TO REACH ABOVE PIPE, THE FINAL BACKFILL SHOULD BE A CONTINUATION OF THE INITIAL BACKFILL IN ORDER TO PROVIDE OPTIMUM PIPE SUPPORT.


* MINIMUM WIDTH WILL DEPEND ON SITE CONDITIONS AND EMBEDMENT MATERIAL

EMBEDMENT DETAIL FOR
POLYETHYLENE PROFILE WALL SEWER PIPE
N.T.S.

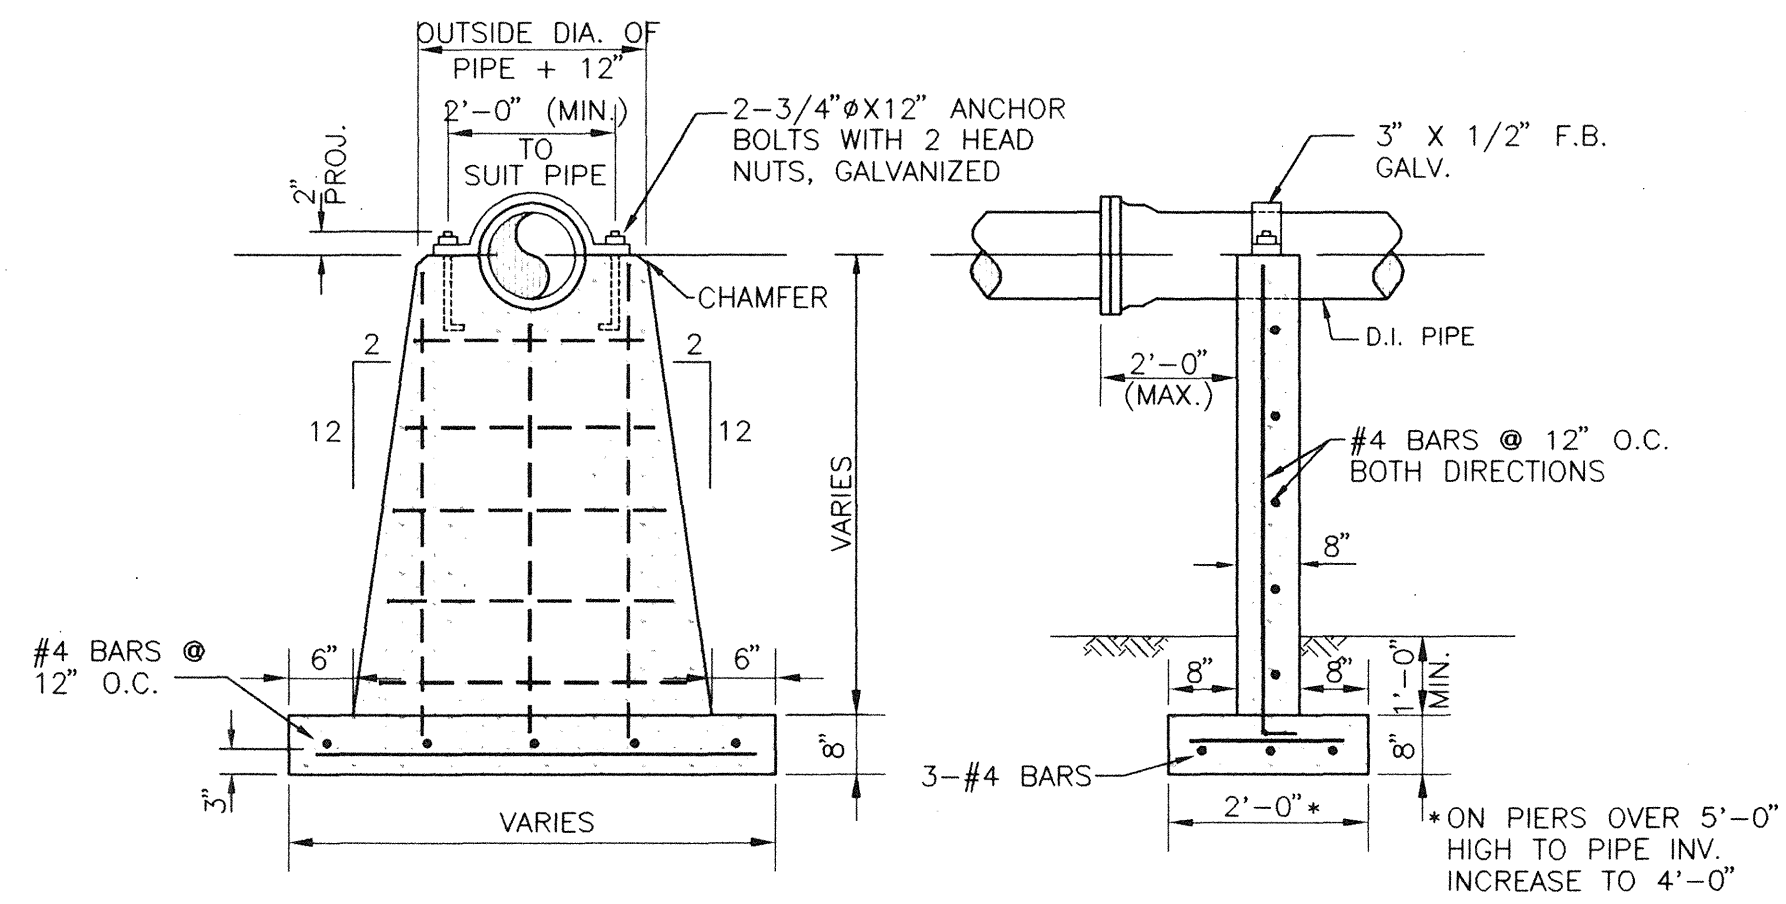


DETAIL OF CONCRETE PIER
FOR D.I. SEWER PIPE

NOTE:
CONC. PIERS SHALL REST
ON UNDISTURBED SOIL.

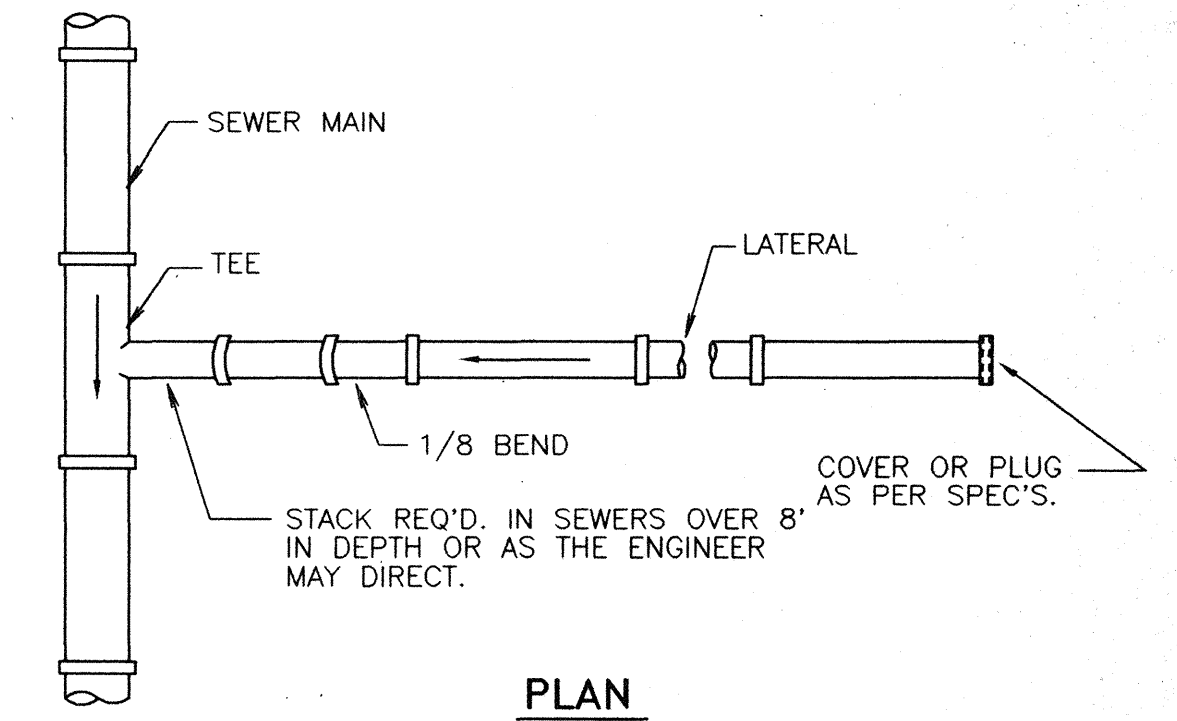

PLAN

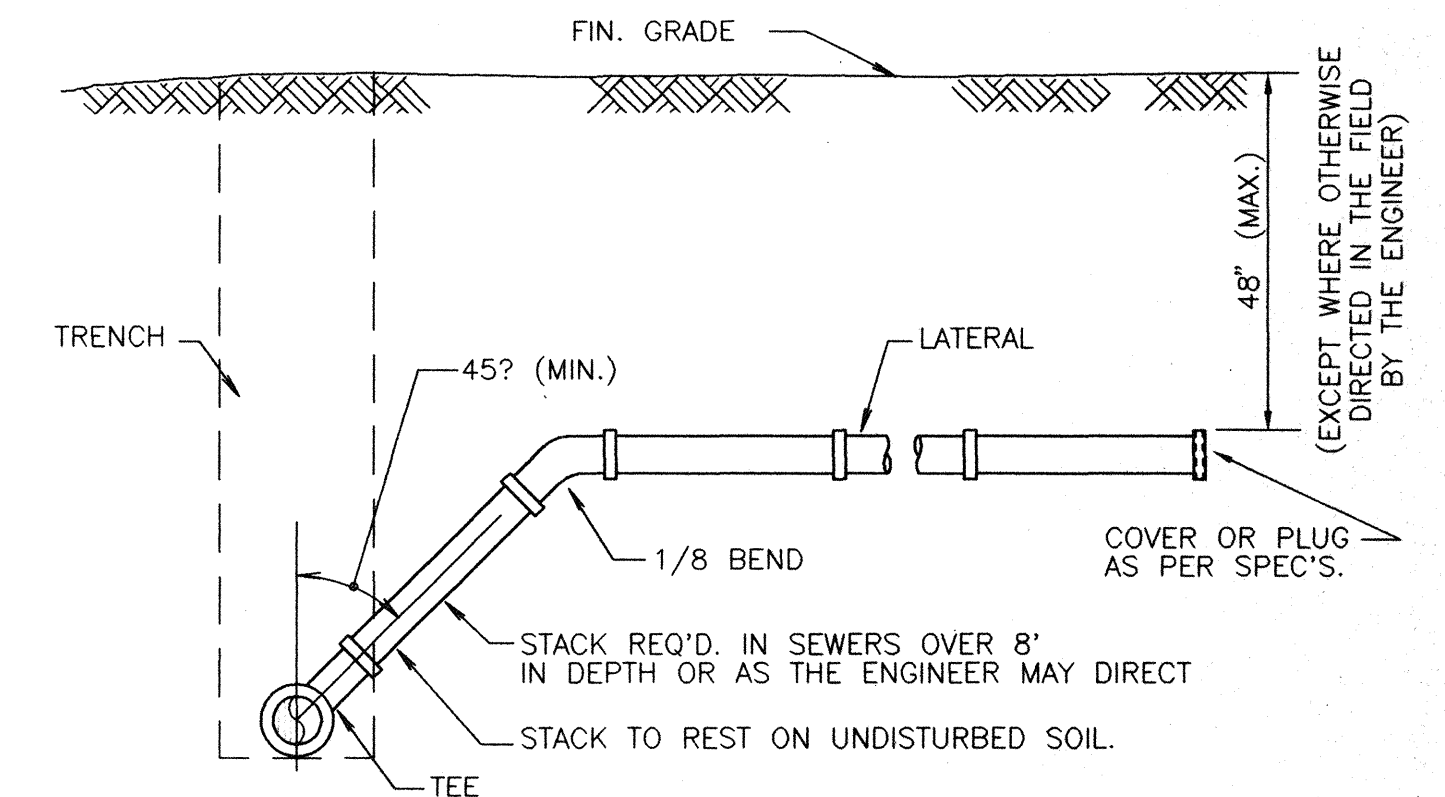

ELEVATION

TYPICAL TEE & LATERAL INSTALLATION

RECORD DRAWINGS

NAME: L.R. WILLIAMS DATE: 2-10-98

NO.	REVISION	DATE	ENG.	DATE	ISSUED FOR

BCM BCM Engineers Inc.
Engineers, Planners, Scientists and Laboratory Services

VERIFY SCALES
BAR IS ONE INCH ON ORIGINAL DRAWING
0 1'
IF NOT ONE INCH ON THIS SHEET, ADJUST SCALES ACCORDINGLY

DESIGNER	R.B.M.	APPROVED	
DRAWN BY	L.R.W.	APPROVED	
ENGINEER	H.C.B.		
PROJECT MGR.	R.B.M.		
CHECKED BY	H.C.B.	DATE	JANUARY 1993

SEAL

CITY OF JACKSON, MISSISSIPPI
LAKE LARUE SANITARY SEWER
INTERCEPTOR EXTENSION
SANITARY SEWER
CONSTRUCTION DETAILS

SCALE	N.T.S.
PROJECT NO.	05-3521-05
DRAWING NO.	C-8REC
SHEET	11 OF 11

Q-1692(s)