


A New Building for  
**CHURCH OF THE HIGHLANDS**  
 Ridgeland, Mississippi

*Church of the Highlands*

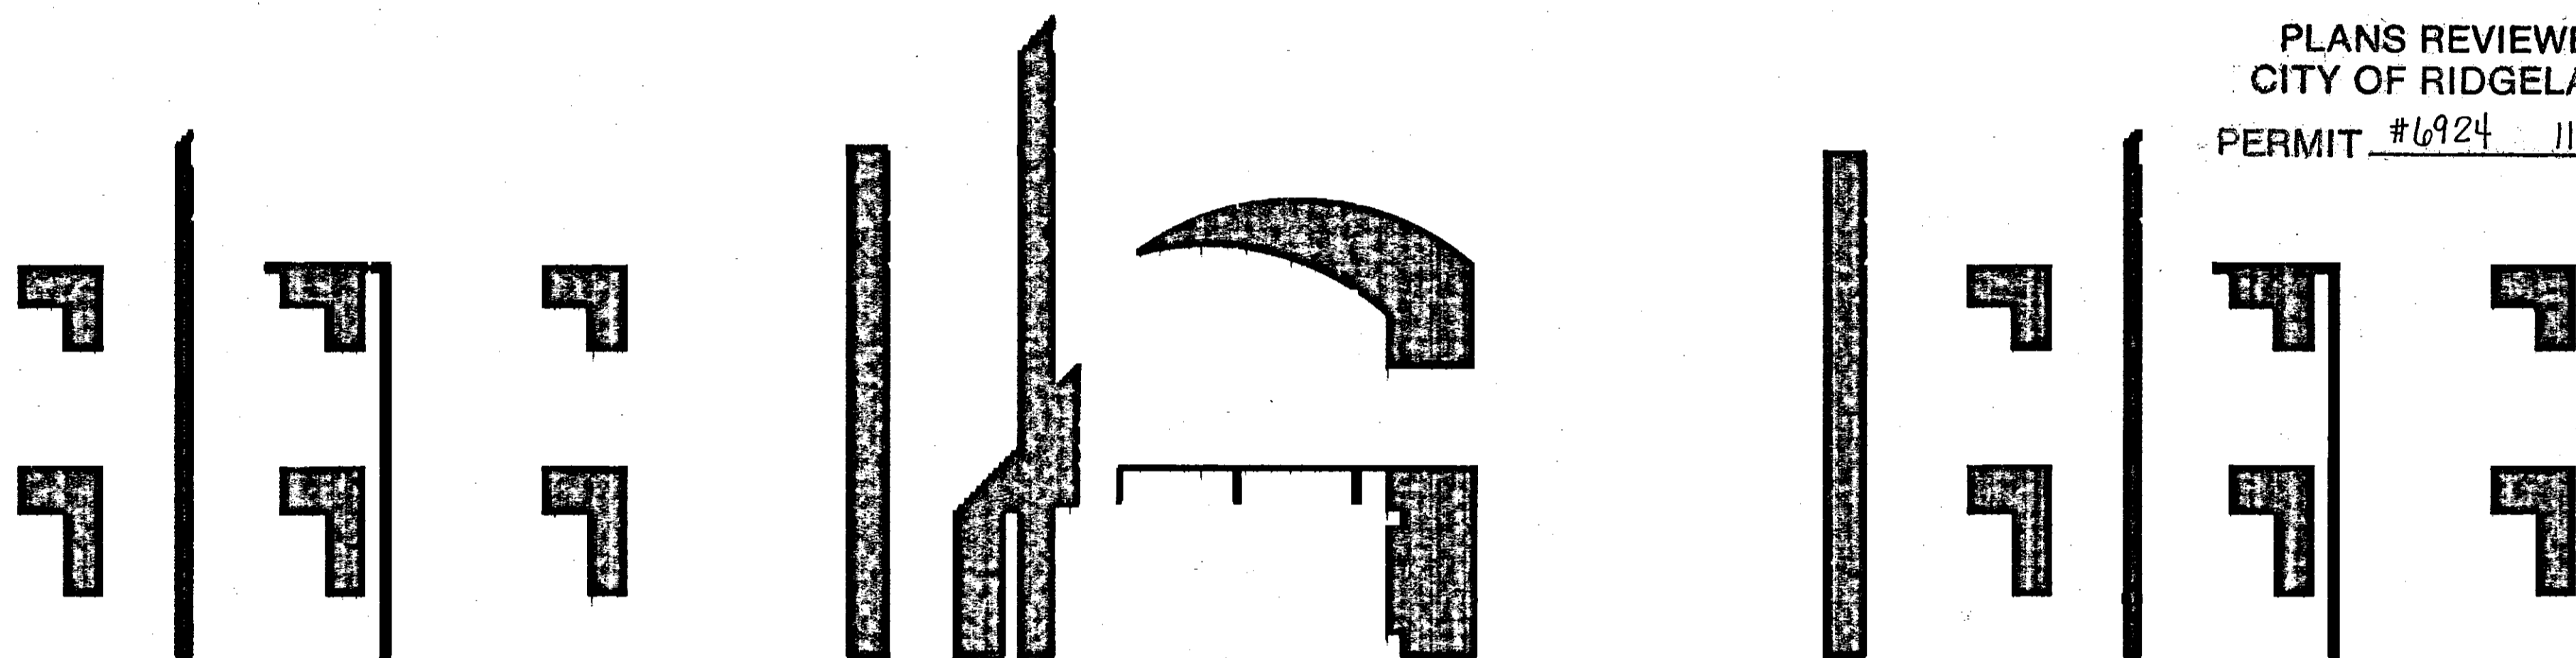

PLANS REVIEWED  
 CITY OF RIDGELAND  
 PERMIT #6924 11-8-2002


OFFICE COPY \_\_\_\_\_  
 PLANS REVIEW \_\_\_\_\_  
 CD Director \_\_\_\_\_  
 PW Director \_\_\_\_\_  
 City Planner \_\_\_\_\_  
 Traffic Engineer \_\_\_\_\_  
 Drainage Engineer \_\_\_\_\_  
 Fire Official \_\_\_\_\_  
 Police Official \_\_\_\_\_

Site plans will not go forward to the  
 Architectural Review Board or the Mayor  
 and Board of Aldermen prior to the above  
 review.

REGISTERED ARCHITECT  
 Daniel B. Wooldridge  
 2265  
 Jackson, MS  
 9-27-02

RECEIVED  
 OCT - 2 2002



PLANS REVIEWED  
 CITY OF RIDGELAND  
 Project Name: Church of the Highlands  
 Date: 10-10-02  
 Reviewer: Chris Gandy

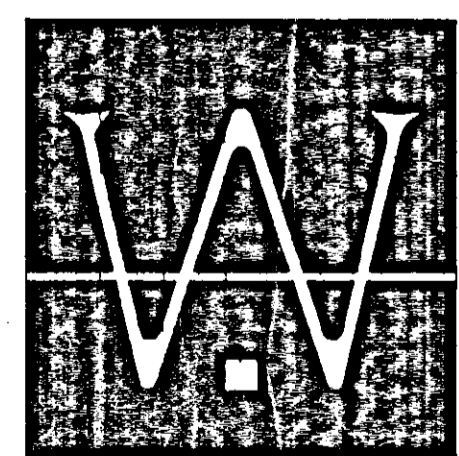

WOOLDRIDGE & ASSOCIATES  
 105 CENTRAL AVENUE  
 RIDGELAND, MS 39157  
 601-856-6161 / 601-856-4266 FAX

September 23, 2002

#02-00083

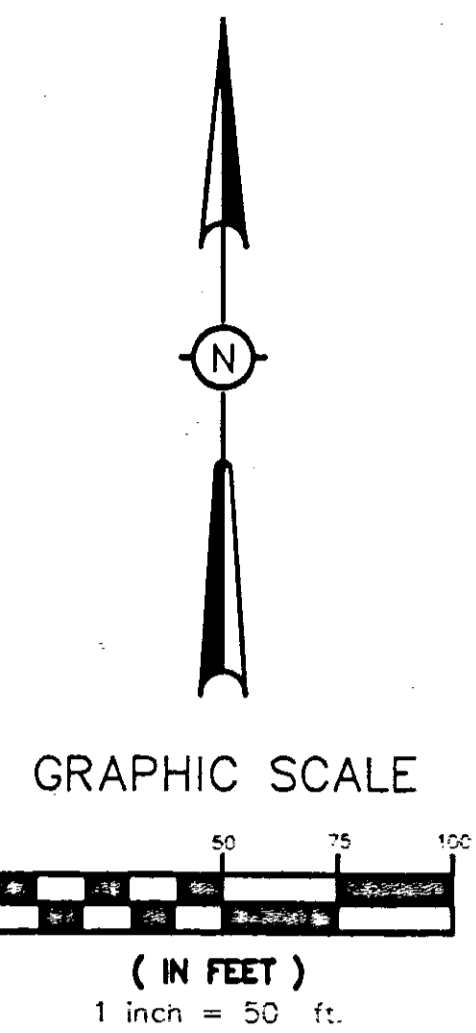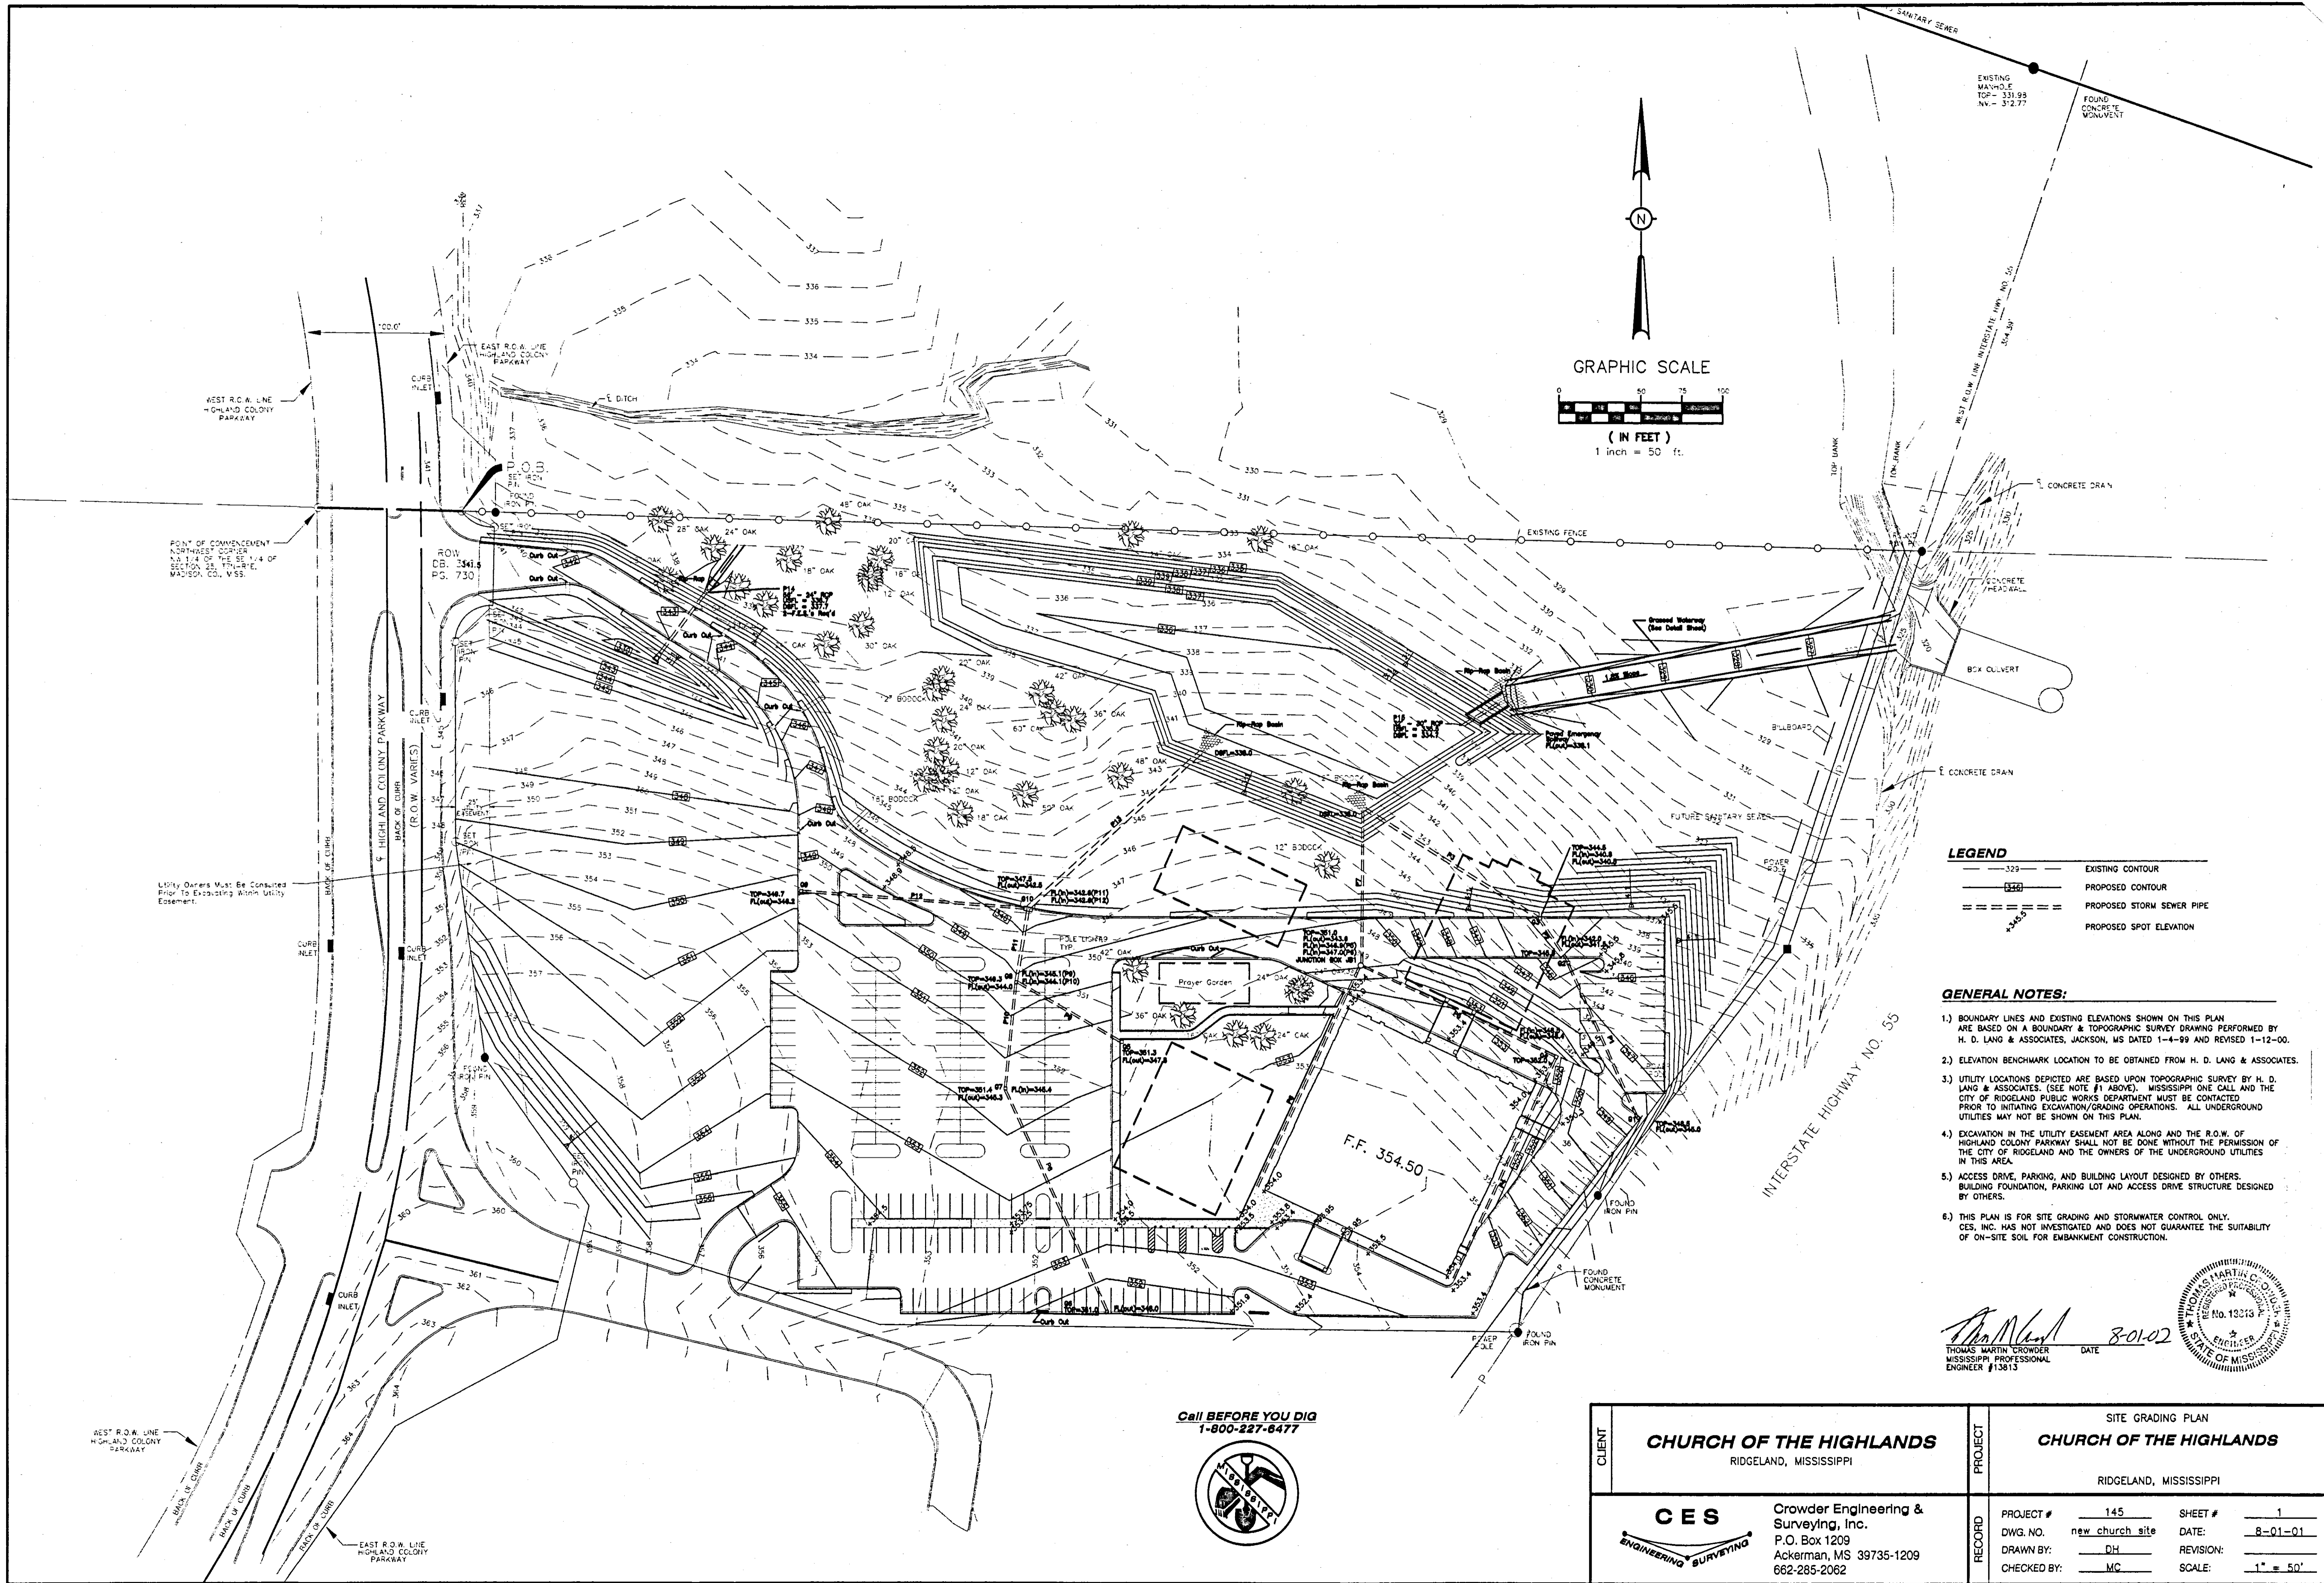


**LEGEND**

	EXISTING CONTOUR
	PROPOSED CONTOUR
	PROPOSED STORM SEWER PIPE
	PROPOSED SPOT ELEVATION

- GENERAL NOTES:**
- BOUNDARY LINES AND EXISTING ELEVATIONS SHOWN ON THIS PLAN ARE BASED ON A BOUNDARY & TOPOGRAPHIC SURVEY DRAWING PERFORMED BY H. D. LANG & ASSOCIATES, JACKSON, MS DATED 1-4-99 AND REVISED 1-12-00.
  - ELEVATION BENCHMARK LOCATION TO BE OBTAINED FROM H. D. LANG & ASSOCIATES.
  - UTILITY LOCATIONS DEPICTED ARE BASED UPON TOPOGRAPHIC SURVEY BY H. D. LANG & ASSOCIATES. (SEE NOTE #1 ABOVE). MISSISSIPPI ONE CALL AND THE CITY OF RIDGELAND PUBLIC WORKS DEPARTMENT MUST BE CONTACTED PRIOR TO INITIATING EXCAVATION/GRADING OPERATIONS. ALL UNDERGROUND UTILITIES MAY NOT BE SHOWN ON THIS PLAN.
  - EXCAVATION IN THE UTILITY EASEMENT AREA ALONG AND THE R.O.W. OF HIGHLAND COLONY PARKWAY SHALL NOT BE DONE WITHOUT THE PERMISSION OF THE CITY OF RIDGELAND AND THE OWNERS OF THE UNDERGROUND UTILITIES IN THIS AREA.
  - ACCESS DRIVE, PARKING, AND BUILDING LAYOUT DESIGNED BY OTHERS. BUILDING FOUNDATION, PARKING LOT AND ACCESS DRIVE STRUCTURE DESIGNED BY OTHERS.
  - THIS PLAN IS FOR SITE GRADING AND STORMWATER CONTROL ONLY. CES, INC. HAS NOT INVESTIGATED AND DOES NOT GUARANTEE THE SUITABILITY OF ON-SITE SOIL FOR EMBANKMENT CONSTRUCTION.


THOMAS MARTIN CROWDER  
 MISSISSIPPI PROFESSIONAL ENGINEER #13813  
 DATE 8-01-02

Call BEFORE YOU DIG  
1-800-227-6477

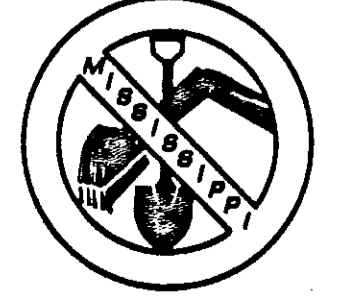


CLIENT	<b>CHURCH OF THE HIGHLANDS</b> RIDGELAND, MISSISSIPPI	
	PROJECT	
RECORD	SITE GRADING PLAN <b>CHURCH OF THE HIGHLANDS</b> RIDGELAND, MISSISSIPPI	
	PROJECT #	145
	DWG. NO.	new church site
	DRAWN BY:	DH
	CHECKED BY:	MC
	SHEET #	1
	DATE:	8-01-01
	REVISION:	
	SCALE:	1" = 50'

**CES**  
 Crowder Engineering & Surveying, Inc.  
 P.O. Box 1209  
 Ackerman, MS 39735-1209  
 662-285-2062

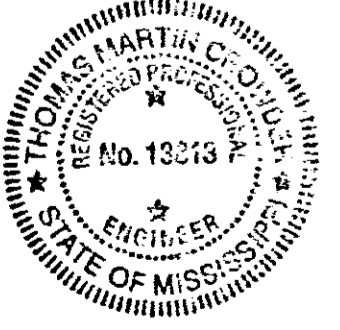


REINFORCING BAR LIST			
BAR	SIZE	NUMBER REQUIRED	LENGTH
"A"	#4	2 PER PIPE OPENING	$196 + \left(\frac{W_{1-3}}{6}\right) + 2$
"B"	#6	2 + [2 PER OPENING SIDE 3] + [1 PER SIDE 1] + [12" O.C. FOR SOLID WALL]	$W_{1-3} - 4"$
"C"		2 + [2 PER OPENING] + [12" O.C. FOR SOLID WALL]	$W_{2-4} - 4"$
"D"		4 + [2 PER OPENING] + [12" O.C. FOR SOLID WALL]	H
"E"		$2 \left[ \left( \frac{W_{1-3}}{6} \right) + 1 \right]$	$W_{2-4} - 4"$
"F"		$2 \left[ \left( \frac{W_{2-4}}{6} \right) + 1 \right]$	$W_{1-3} - 4"$

NOTE: VARIABLES AND DESIGNATIONS ARE AS FOLLOWS:  
D (OR SPAN) = PIPE DIAMETER (OR SPAN)  
W<sub>1-3</sub> = WIDTH OF SIDE 1 & SIDE 3  
W<sub>2-4</sub> = WIDTH OF SIDE 2 & SIDE 4  
W<sub>1-3</sub> OR W<sub>2-4</sub> (SIDE OF ENTERING PIPE)  
\*\* = ROUND TO NEAREST WHOLE NUMBER

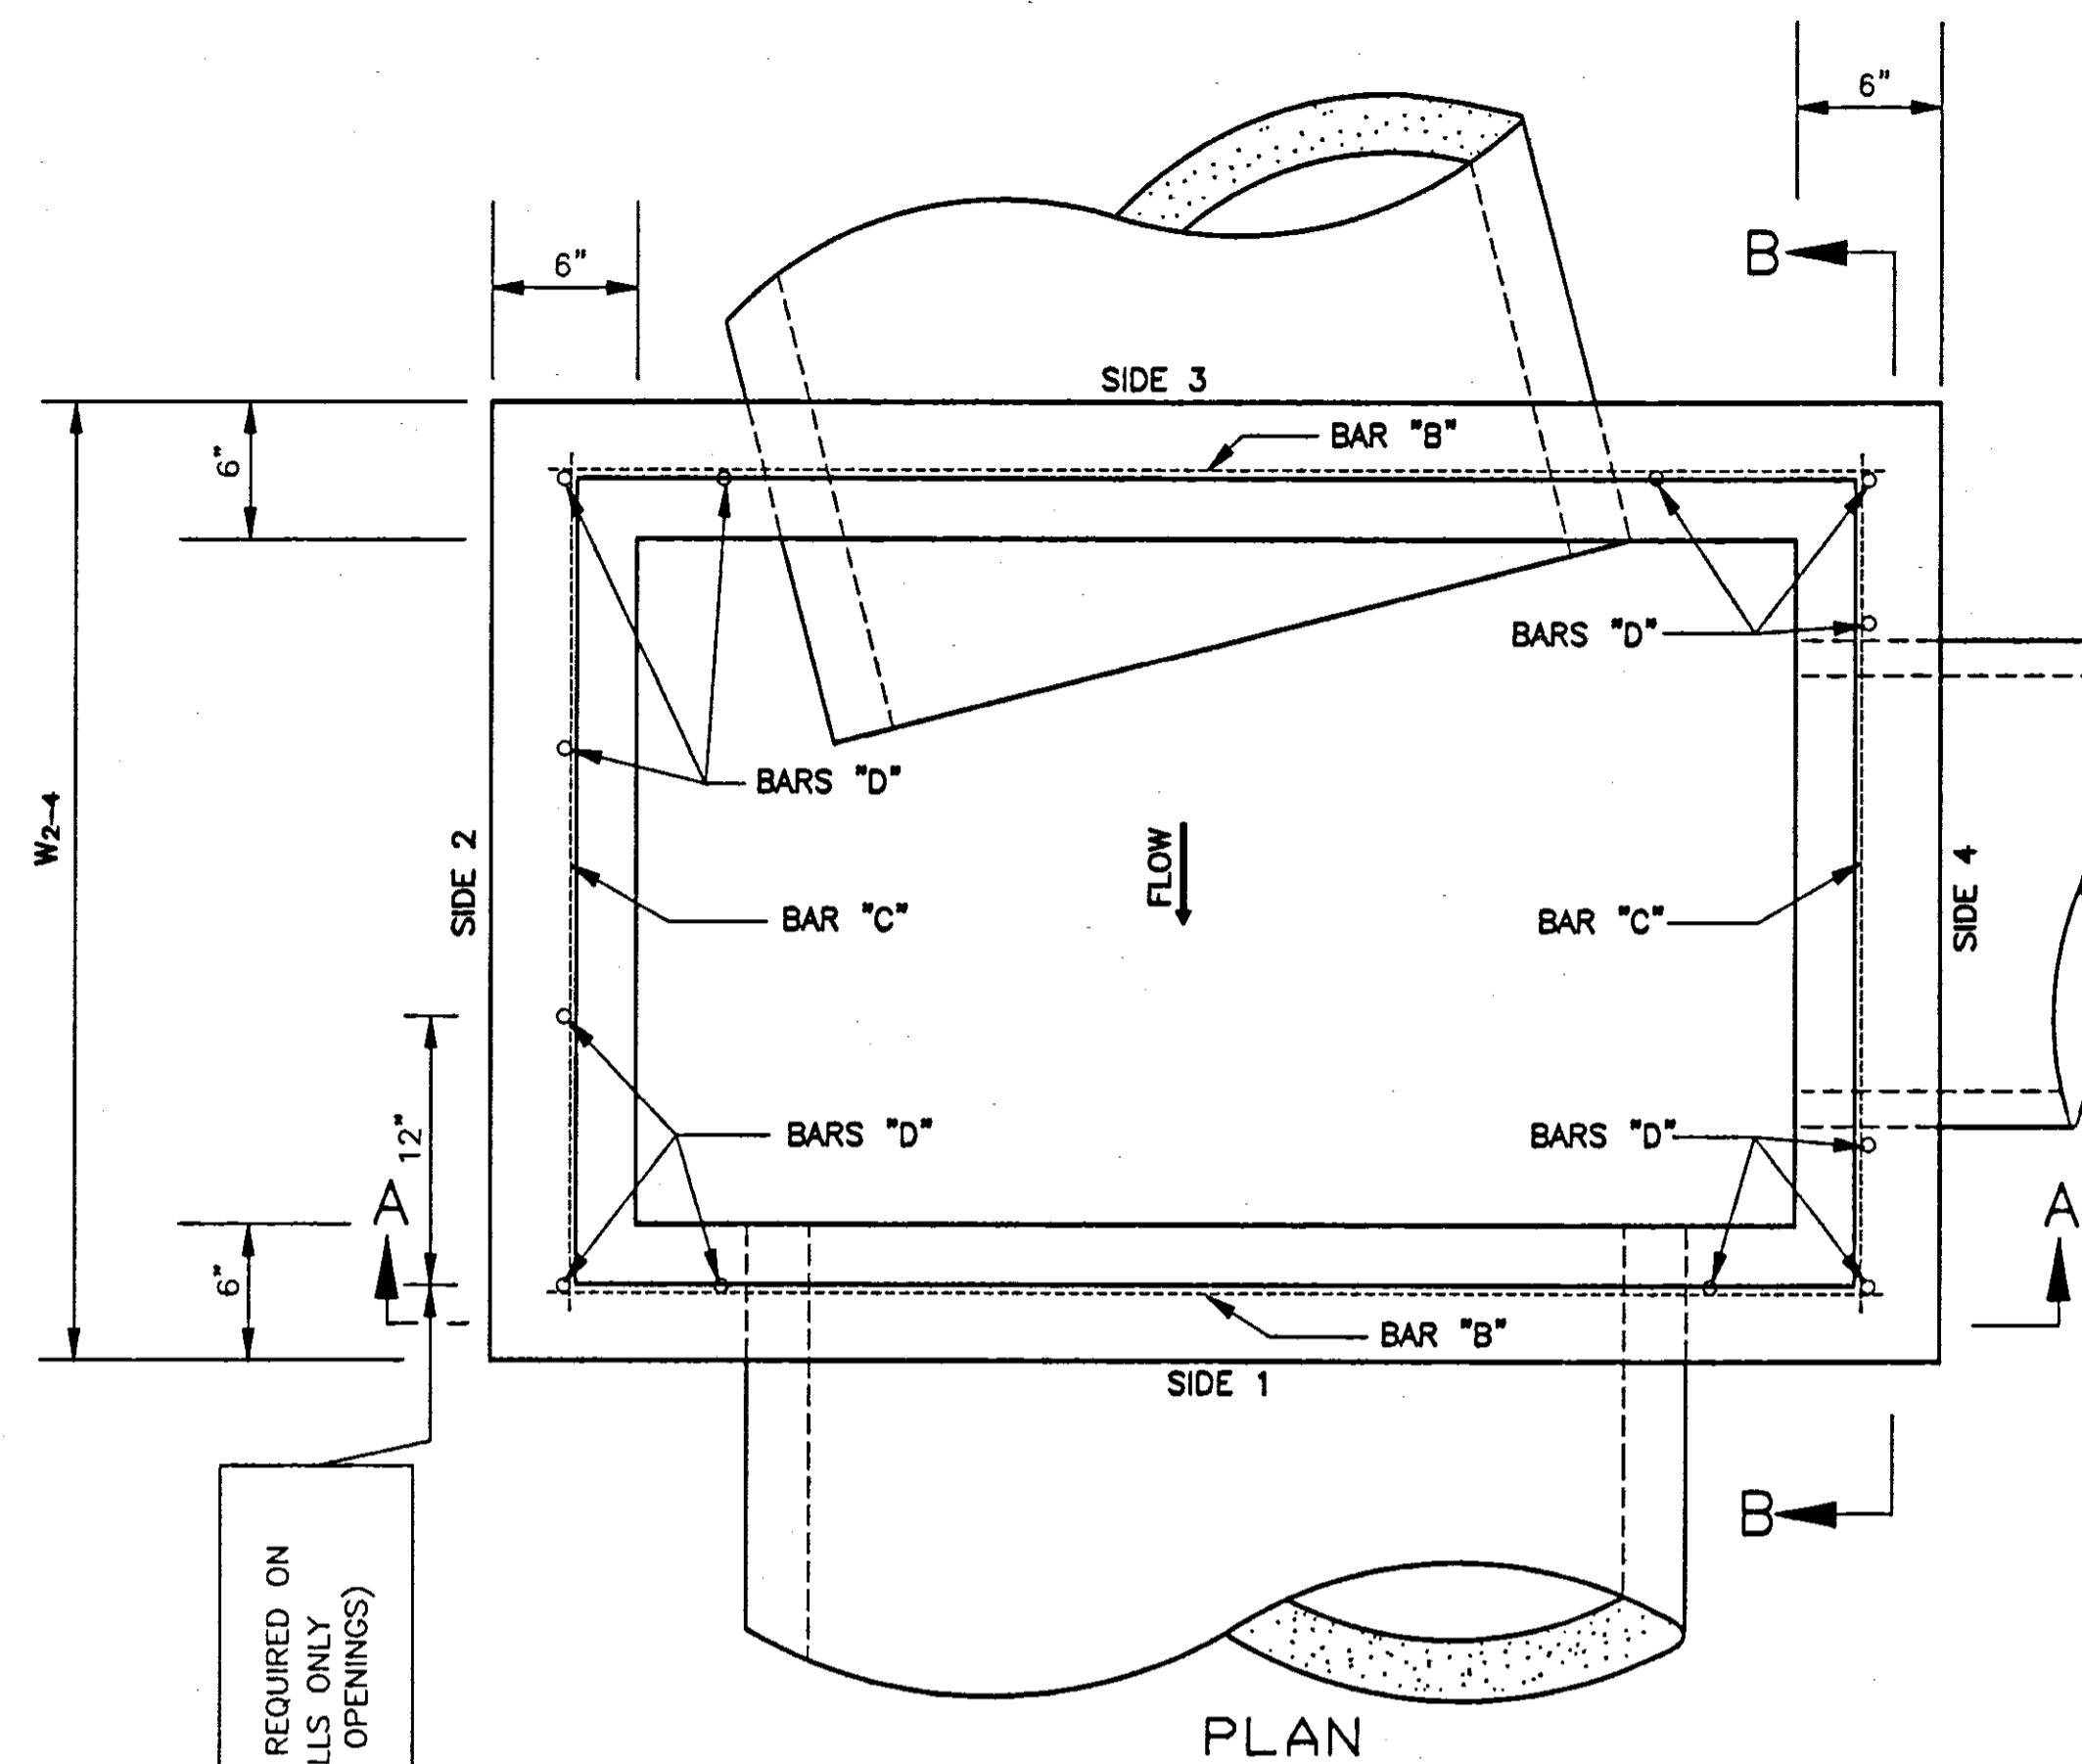


GRATE INLET SCHEDULE		
GRATE	MODEL NUMBER	SIZE (FRAME)
G1	5115 type M2	28 1/4" x 28 1/4"
G2	5115 type M2	28 1/4" x 28 1/4"
G3	5115 type M2	28 1/4" x 28 1/4"
G4	5115 type M2	28 1/4" x 28 1/4"
G5	5115 type M2	28 1/4" x 28 1/4"
G6	5115 type M1	28 1/4" x 28 1/4"
G7	5115 type M1	28 1/4" x 28 1/4"
G8	5115 type M1	28 1/4" x 28 1/4"
G9	5115 type M1	28 1/4" x 28 1/4"
G10	5350 type M1	64 1/2" x 32 1/4"

NOTE: ALL GRATES LISTED ARE EAST JORDAN IRON WORKS OR APPROVED EQUAL.

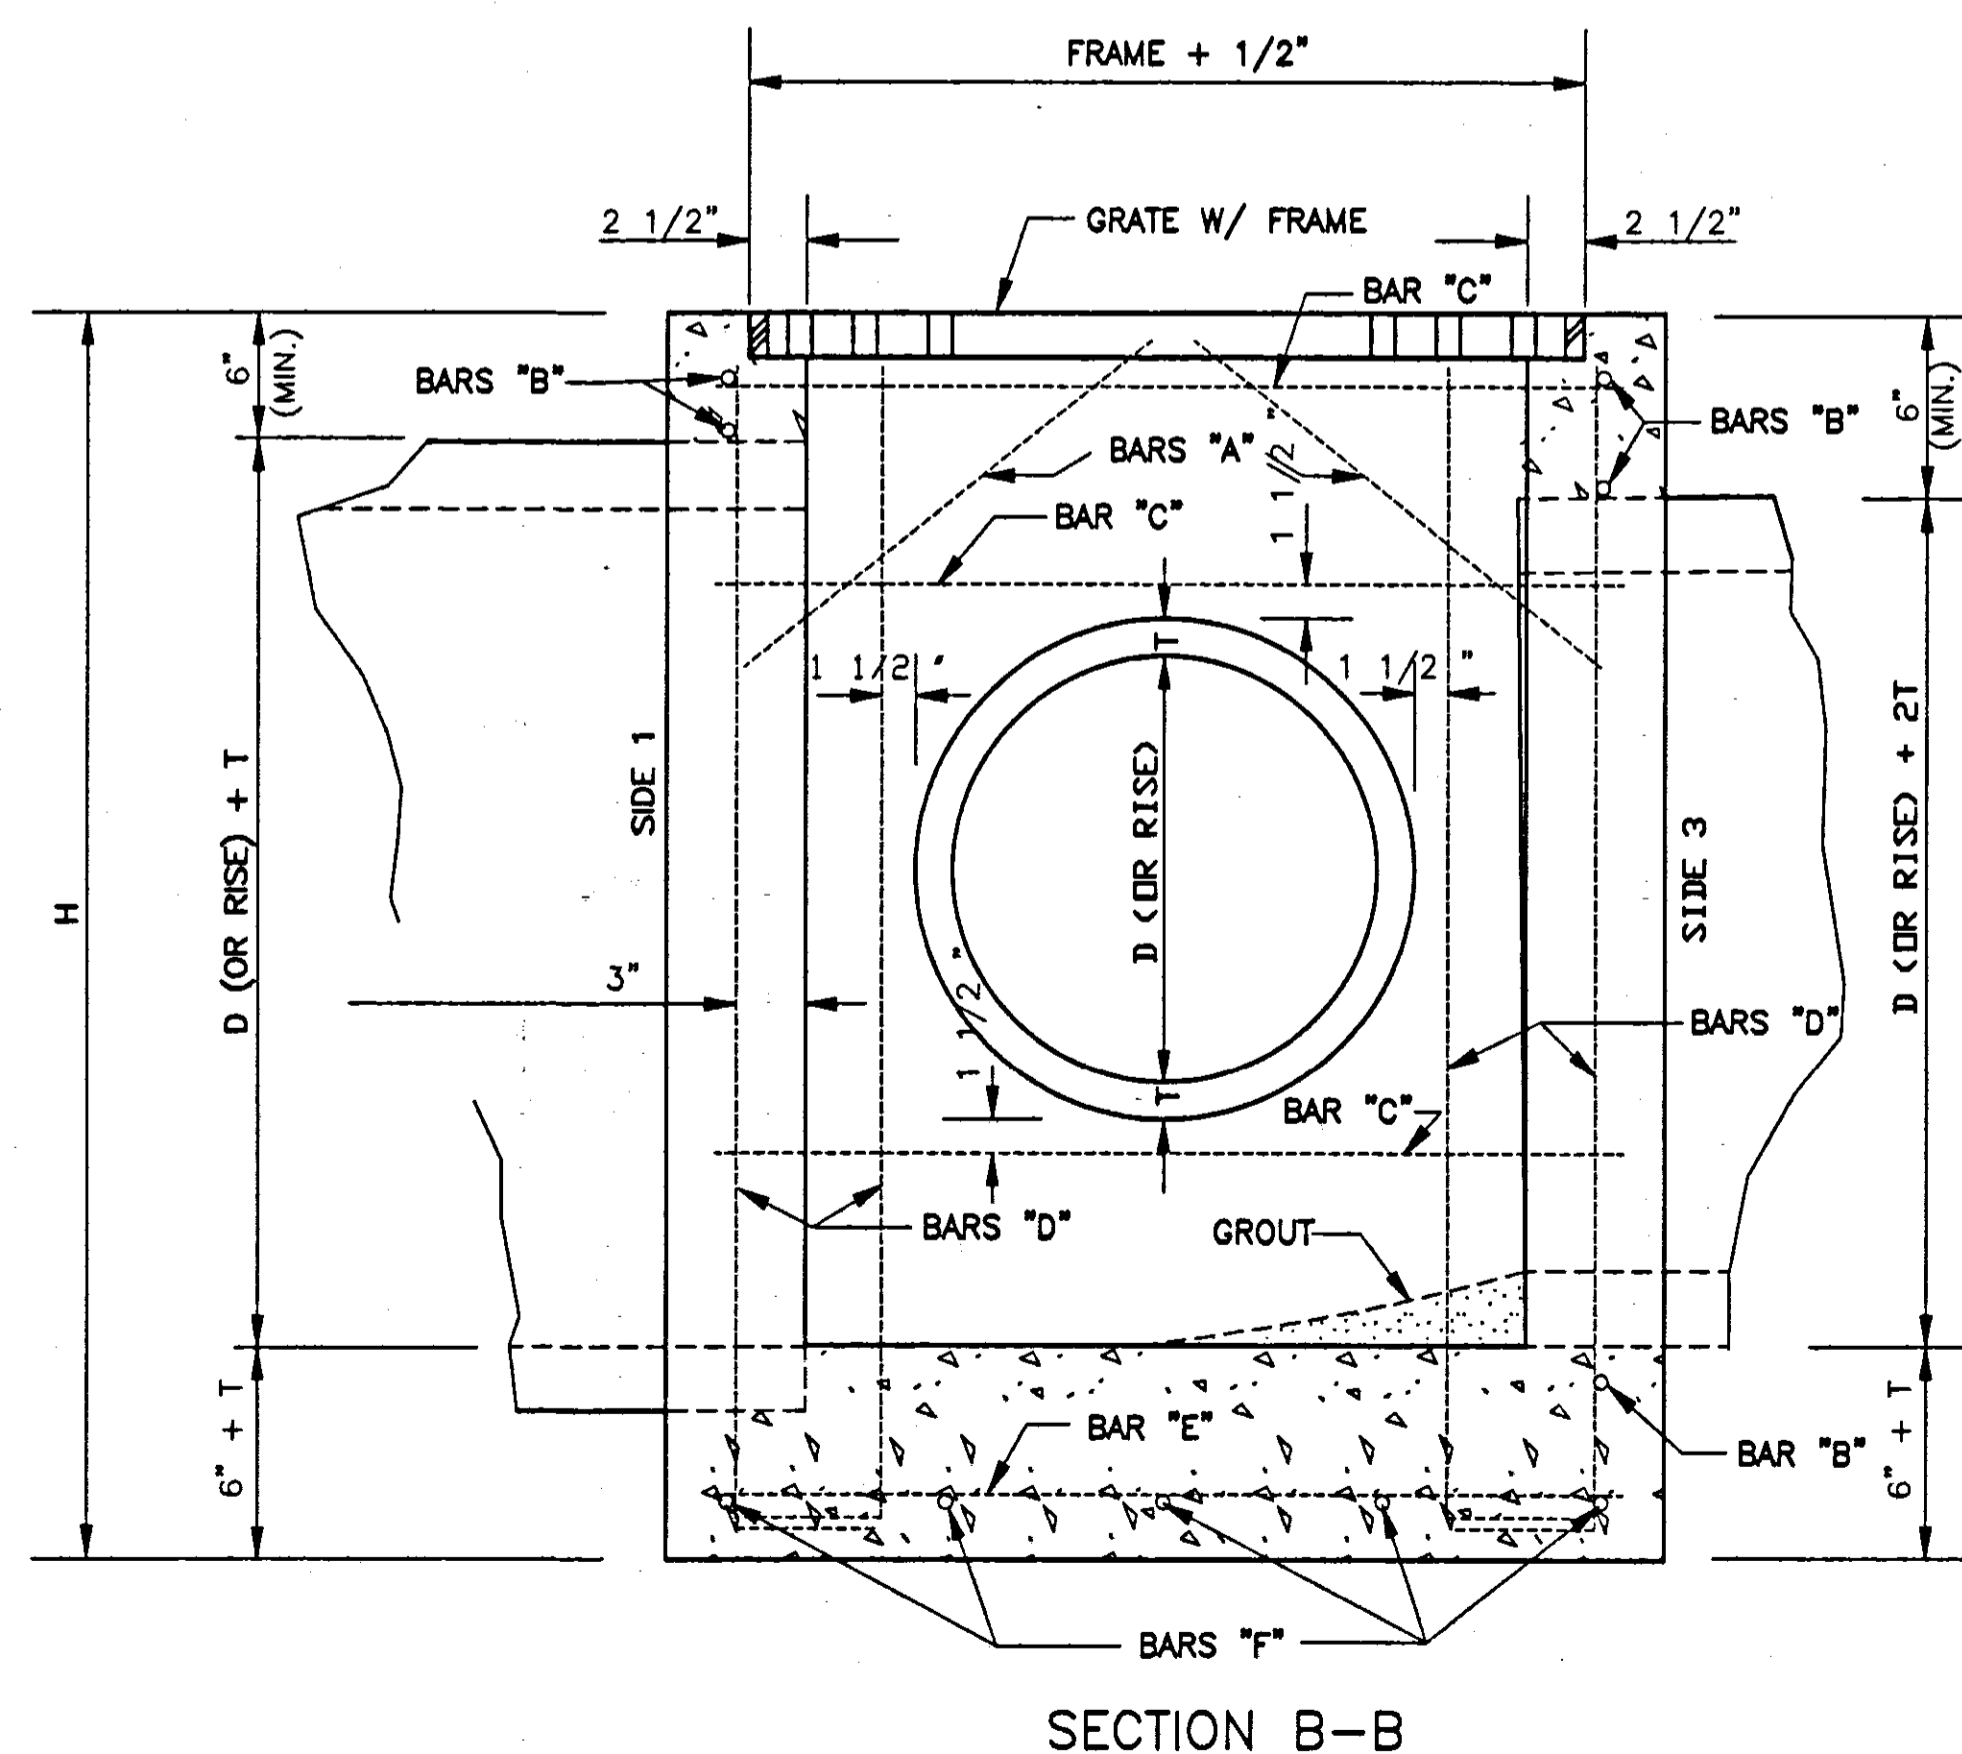


SECTION B-B

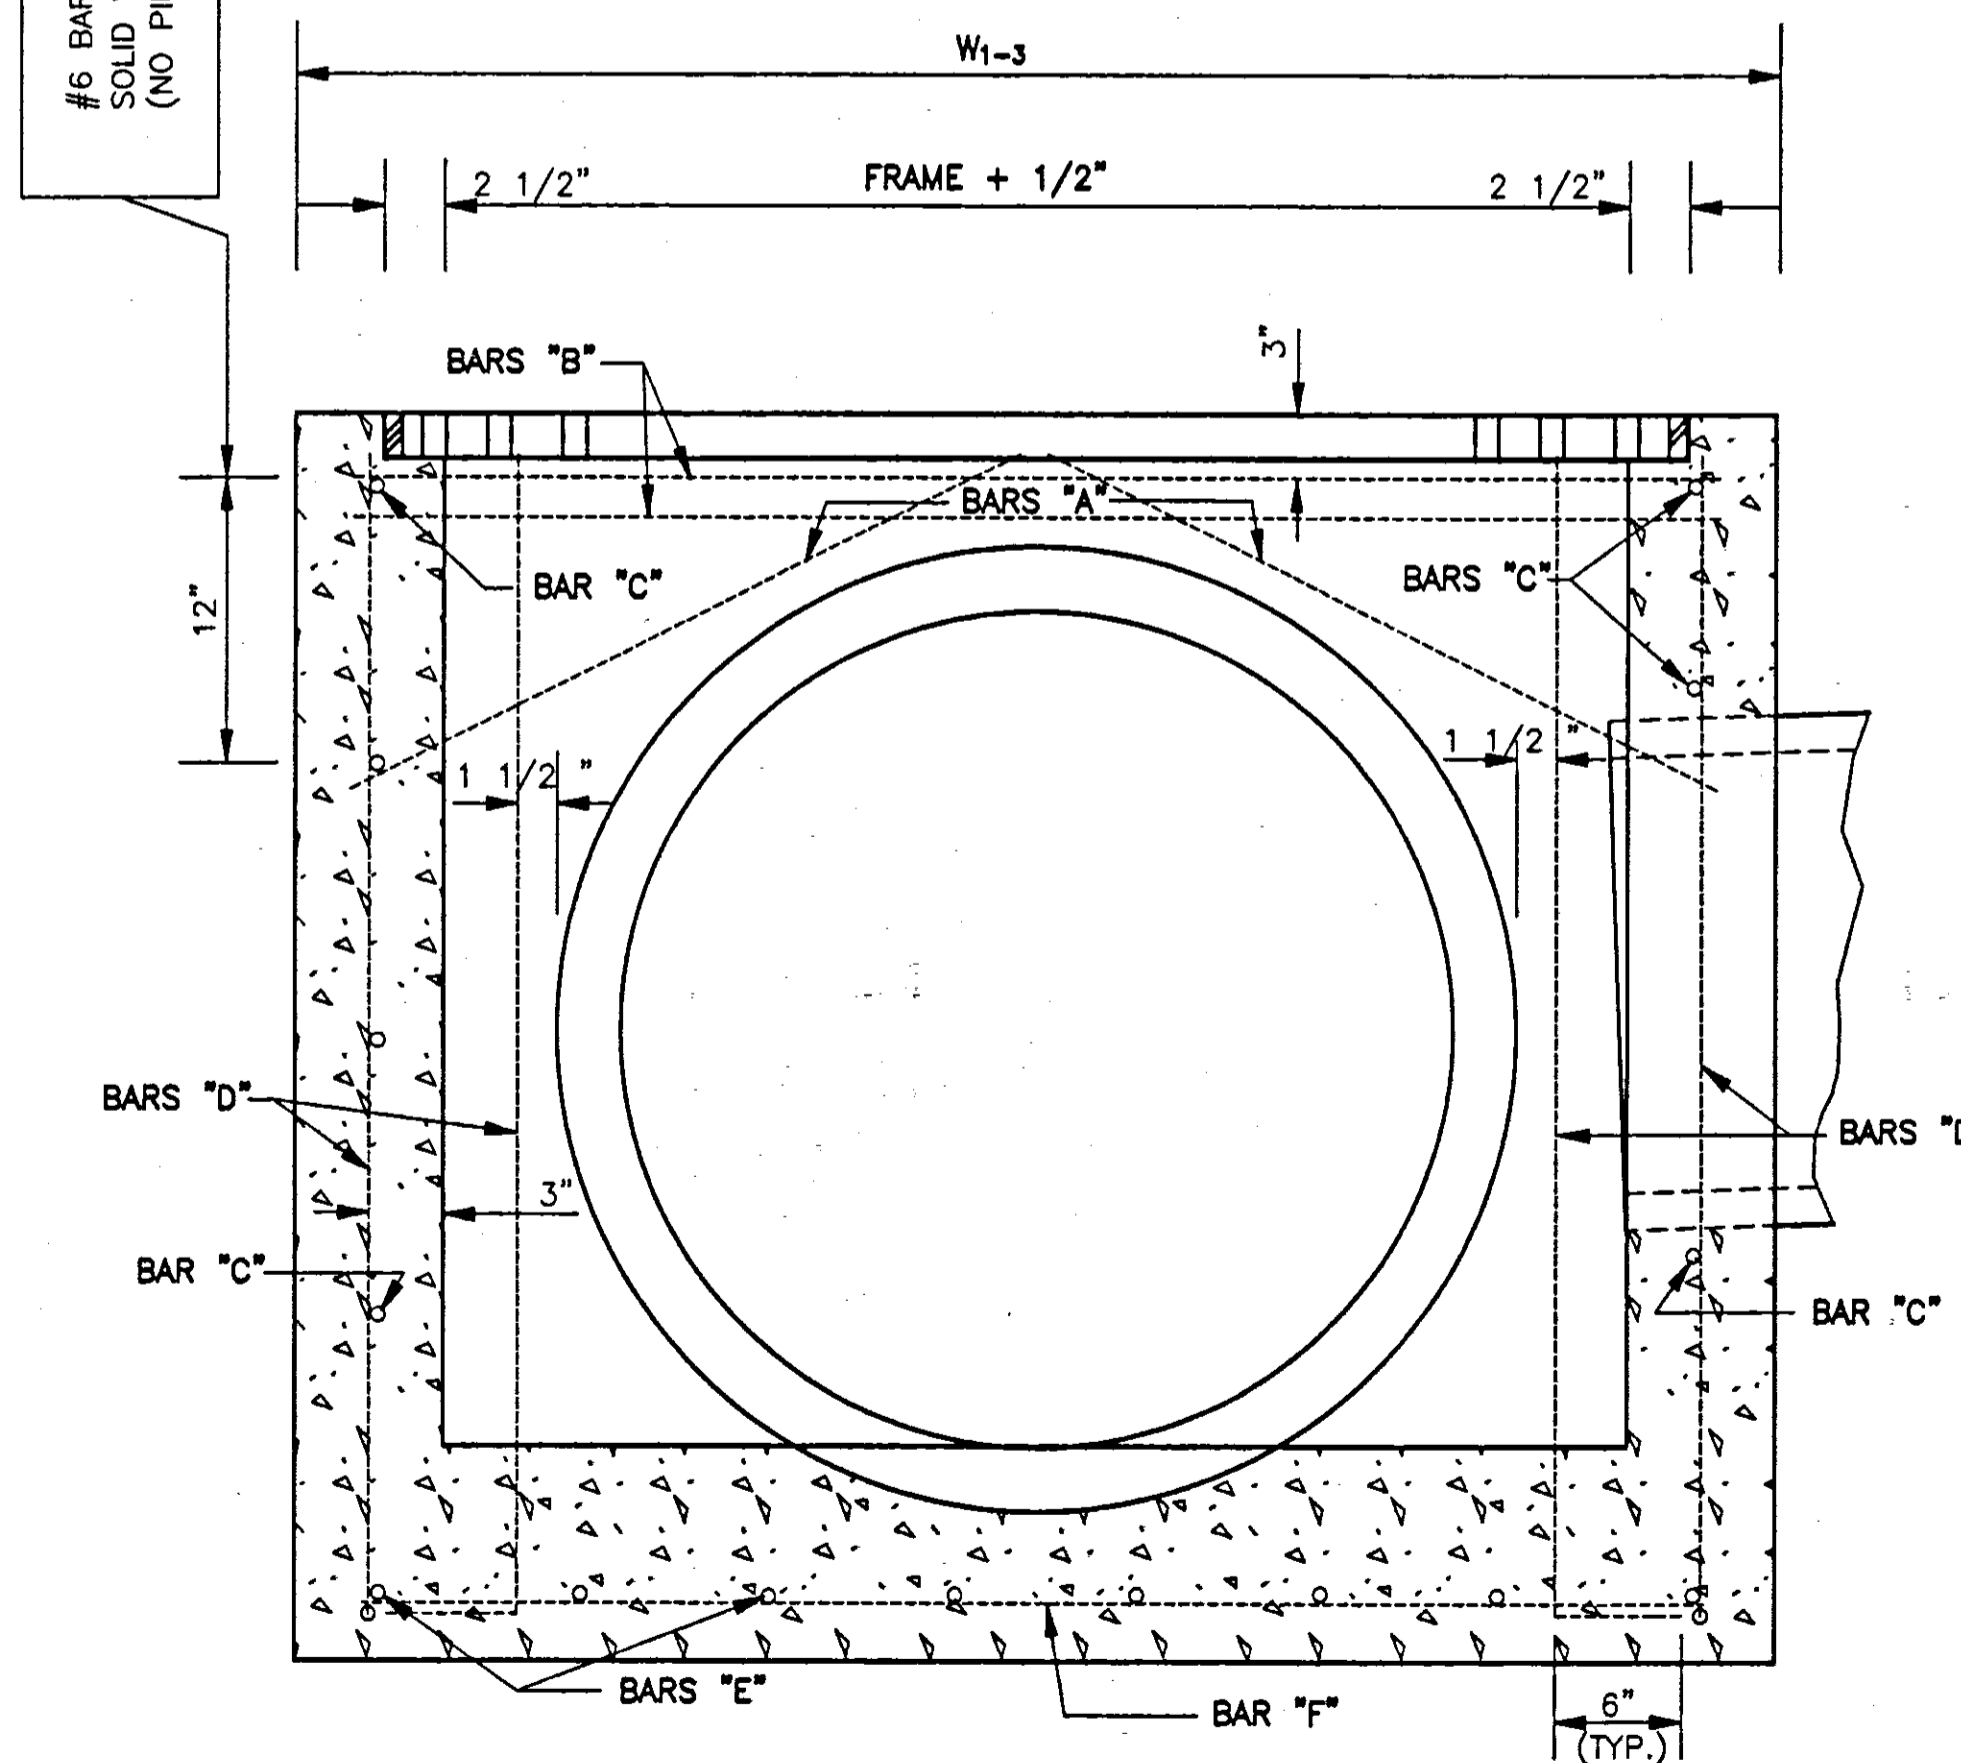

SECTION A-A

GENERAL NOTES:


- CONCRETE SHALL BE CLASS "B" AND REINFORCING STEEL SHALL BE DEFORMED BARS, ASTM A 615, GRADE 60 OR AASHTO M 31, GRADE 60.
- IF PIPES ARE SKEWED MORE THAN 15° OR IF SKEWED PIPES PRODUCE CONFLICTS WITH ANOTHER OPENING, THE PIPE SHALL BE BROKEN BACK TO THE WALL OF THE JUNCTION BOX.

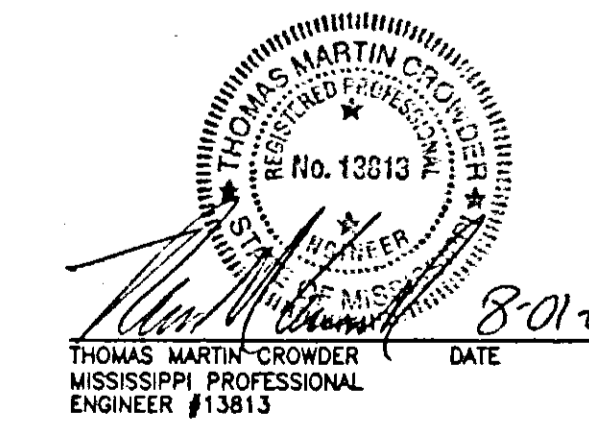

CLIENT	<b>CHURCH OF THE HIGHLANDS</b> RIDGELAND, MISSISSIPPI		PROJECT	<b>CHURCH OF THE HIGHLANDS</b> RIDGELAND, MISSISSIPPI	
	RECORD	PROJECT #		145	SHEET #
DWG. NO.		DETAILS	DATE:	07-23-01	
	DRAWN BY:	DH	REVISION:	0	
	CHECKED BY:	MC	SCALE:	N.T.S.	




Crowder Engineering & Surveying, Inc.  
P.O. Box 1209  
Ackerman, MS 39735-1209  
662-285-2062

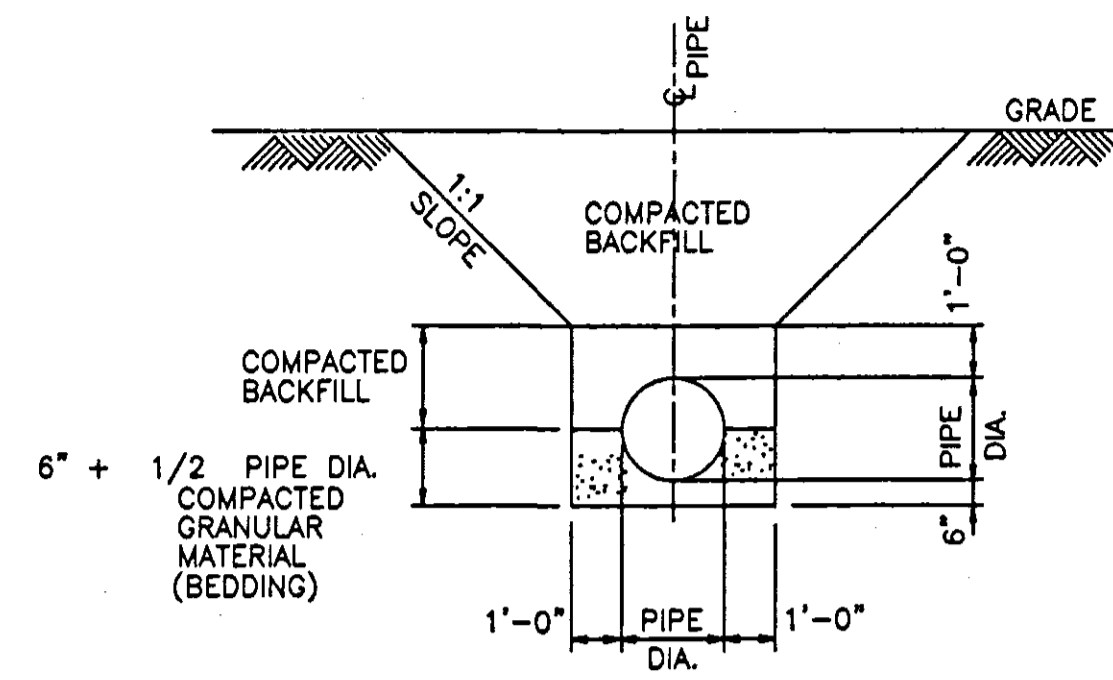


TYPICAL CULVERT & STORM DRAIN  
INSTALLATION DETAIL

NTS

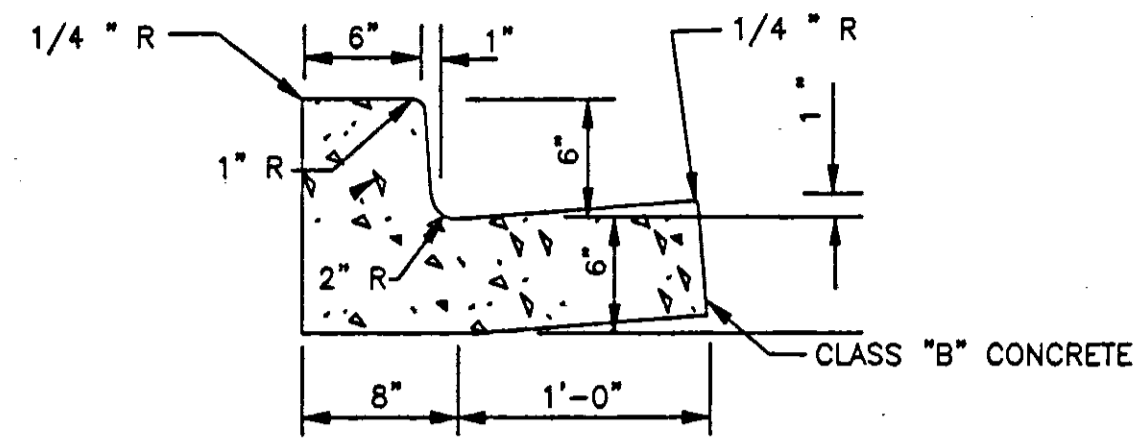


DETAIL OF COMBINATION  
CURB & GUTTER

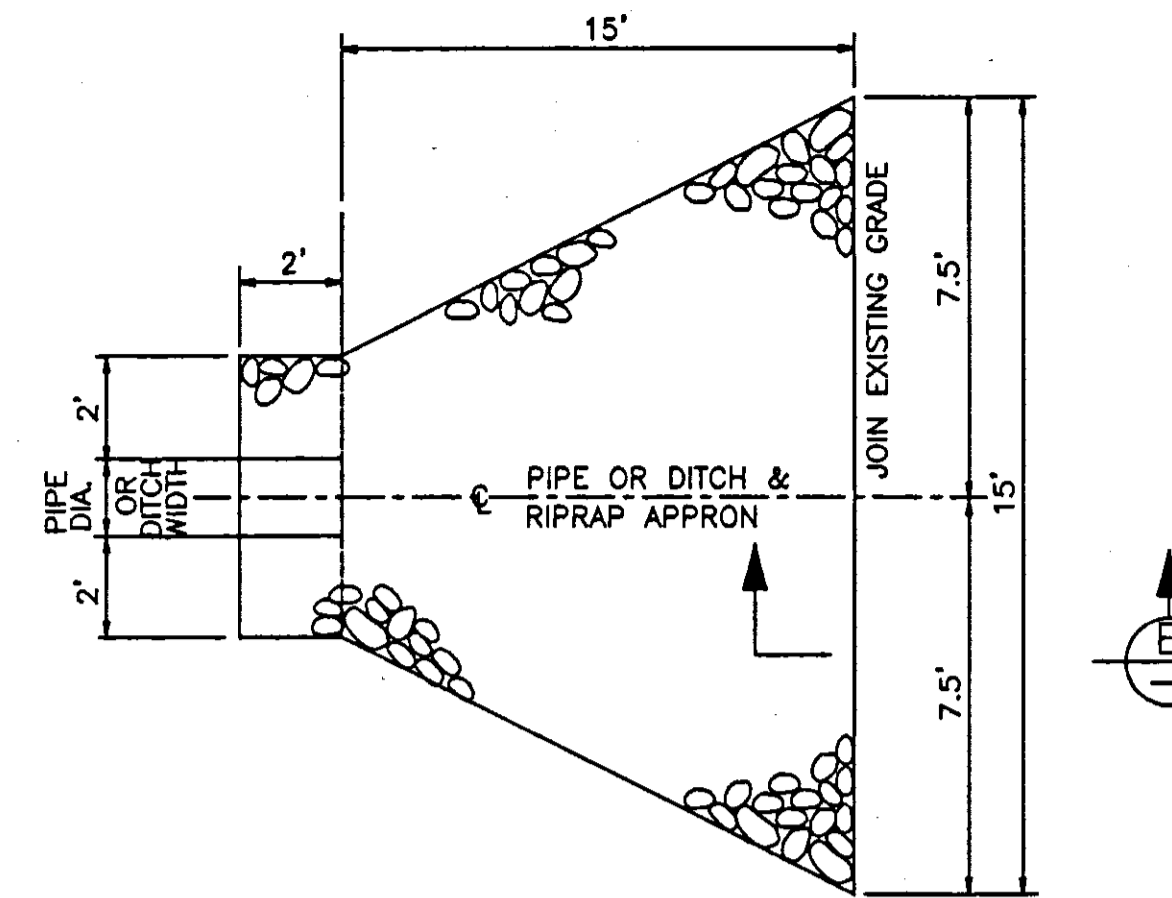


RIPRAP APRON DETAIL  
(P3, P7, P12)

NTS

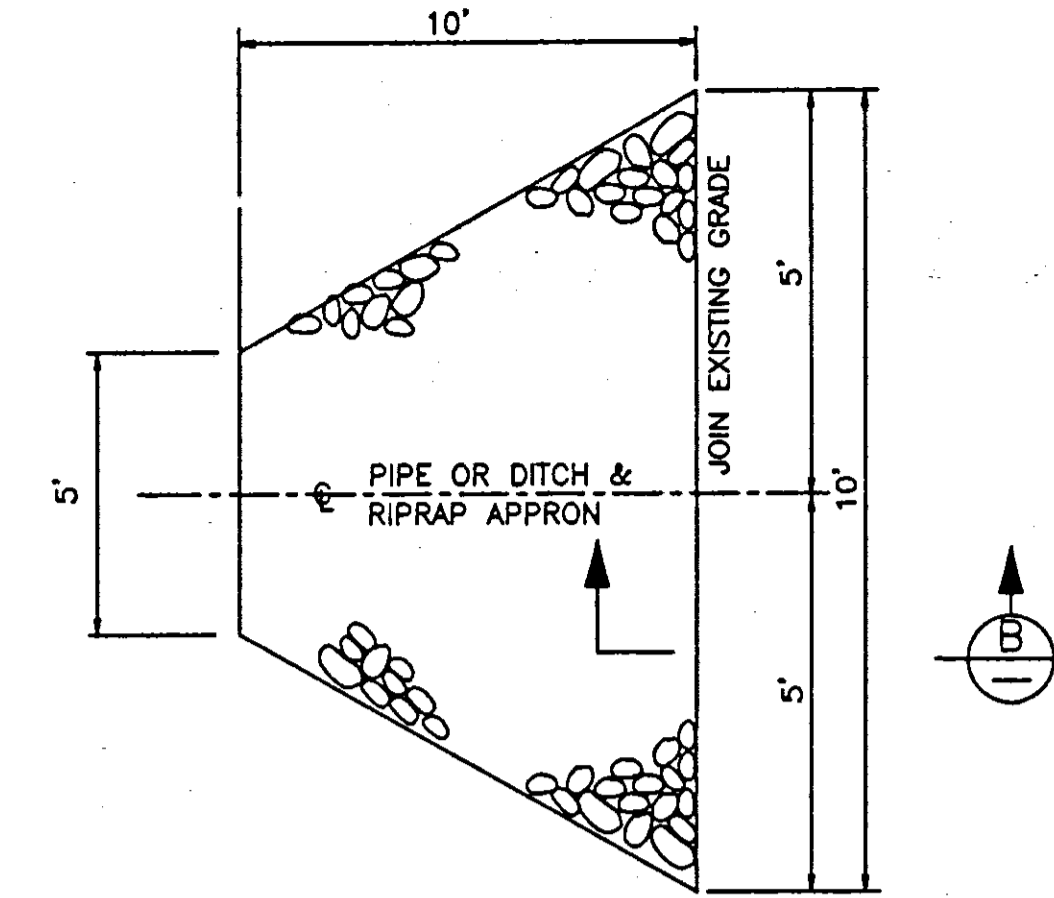


RIPRAP APRON DETAIL  
(P13)


NTS

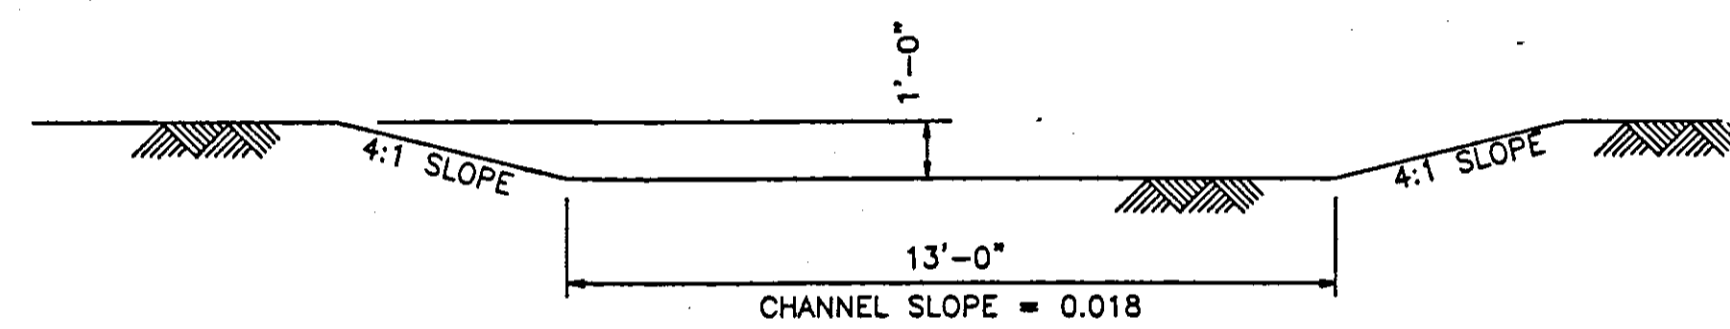

GRASSED WATERWAY

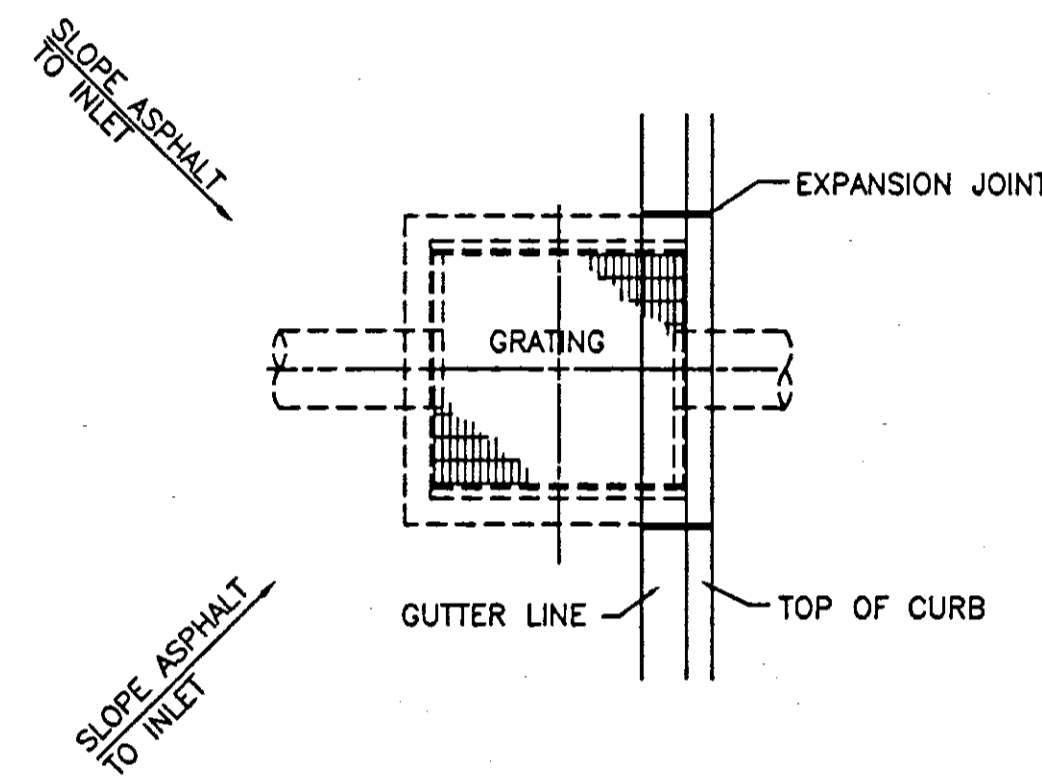


GRATE INLET AT CURB

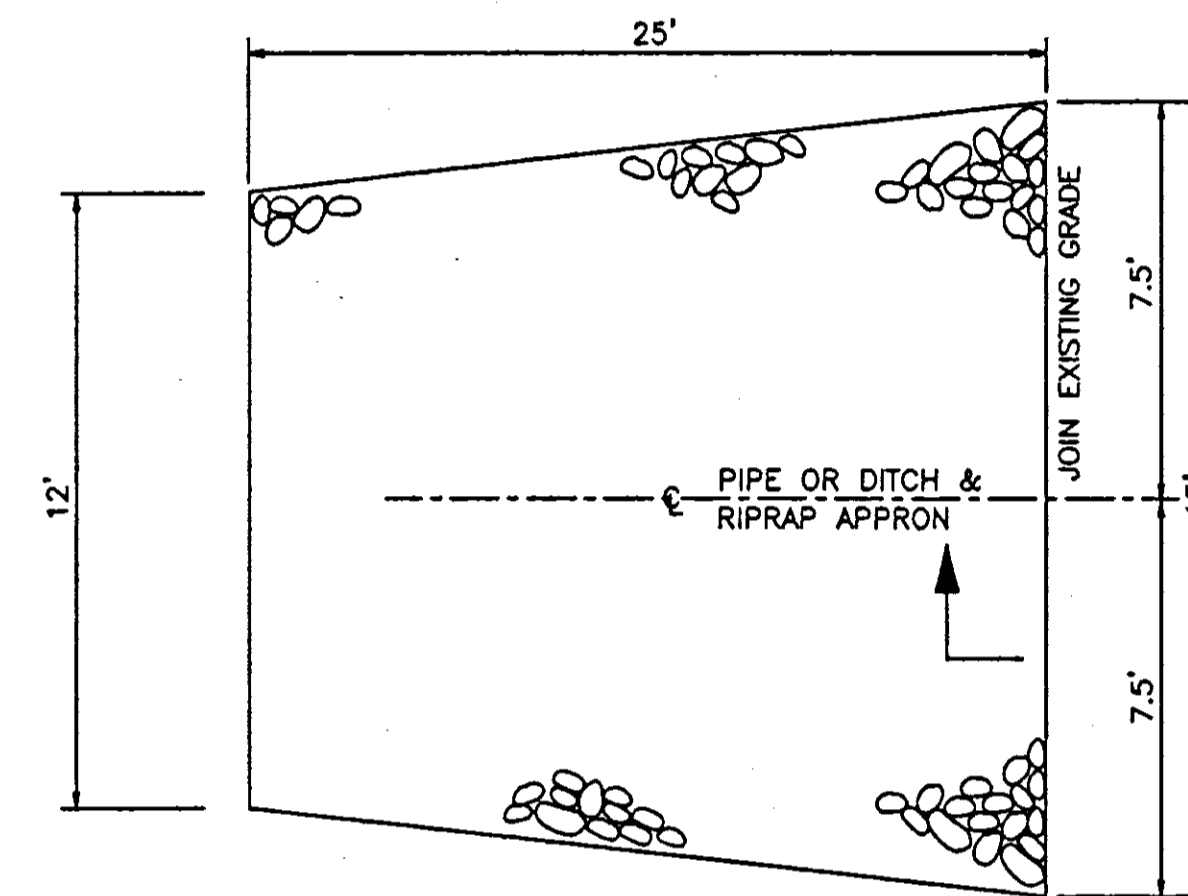


RIPRAP APRON DETAIL  
(POND OUTFLOW)

NTS

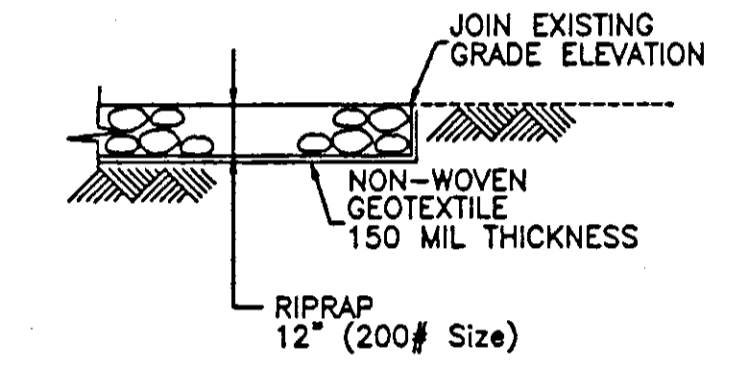


SECTION B

NTS

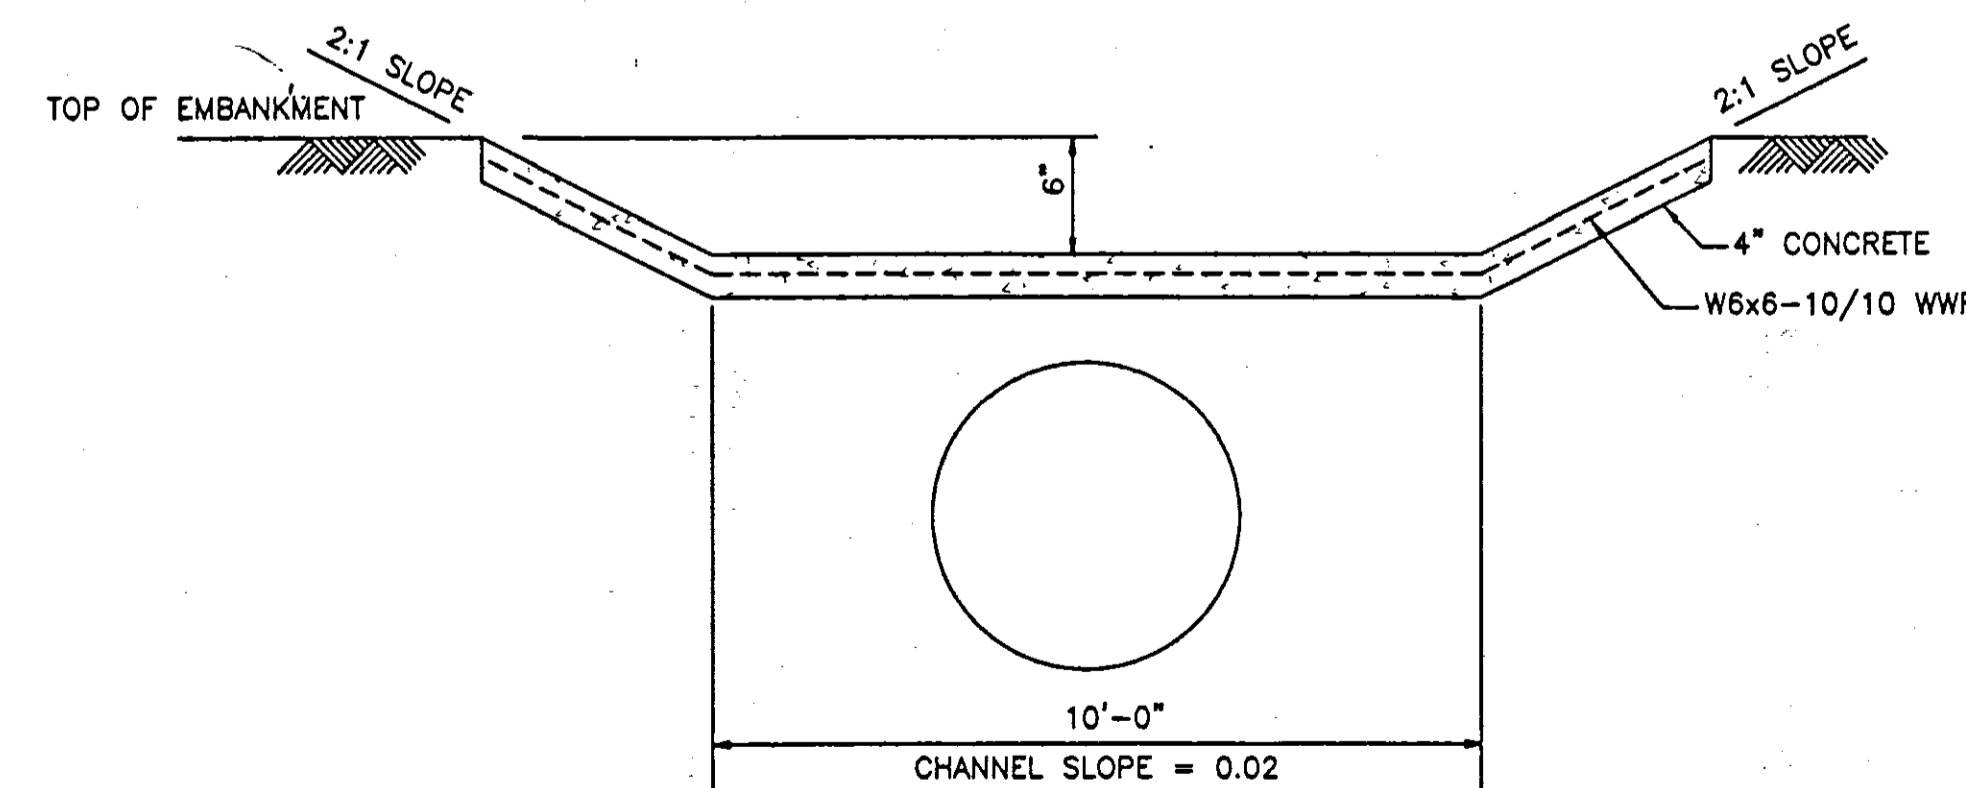

EMERGENCY SPILLWAY

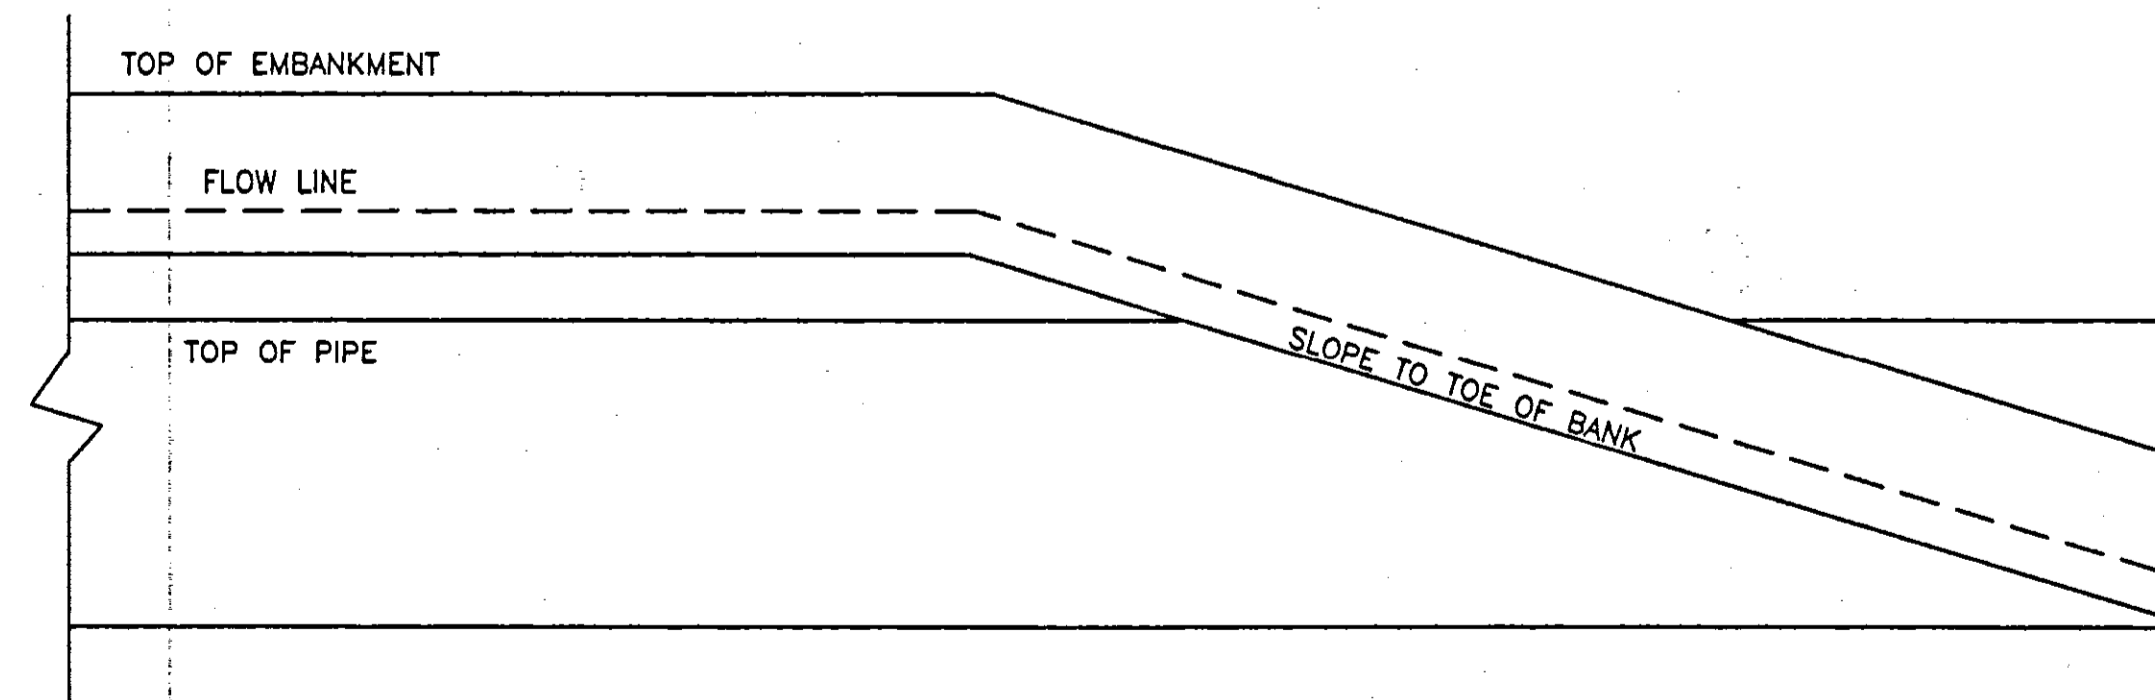

EMERGENCY SPILLWAY  
(SOUTH ELEVATION)


PIPE SCHEDULE				
PIPE	TYPE	SIZE	LENGTH	SLOPE (%)
P1	HDPE	18"	121.8'±	2.5
P2	HDPE	18"	37.5'±	2.6
P3	HDPE	24"	149.6'±	1.7
P4	HDPE	18"	176.7'±	1.4
P5	HDPE	18"	155.5'±	1.5
P6	HDPE	18"	176.7'±	2.0
P7	HDPE	18"	110.5'±	5.0
P8	HDPE	18"	176.5'±	1.5
P9	HDPE	18"	86.5'±	2.7
P10	HDPE	18"	75.3'±	1.6
P11	HDPE	24"	53.2'±	2.6
P12	HDPE	18"	163.0'±	2.2
P13	HDPE	36"	171.0'±	2.6
P14	RCP	24"	56.0'	3.3
P15	RCP	30"	32.0'	2.6

THOMAS MARTIN CROWDER  
MISSISSIPPI PROFESSIONAL  
ENGINEER #13813  
DATE 07-23-01

CLIENT	<b>CHURCH OF THE HIGHLANDS</b> RIDGELAND, MISSISSIPPI		PROJECT	<b>CHURCH OF THE HIGHLANDS</b> RIDGELAND, MISSISSIPPI	
	RECORD	PROJECT #		145	SHEET #
DWG. NO.		DETAILS	DATE:	07-23-01	REVISION:
DRAWN BY:	DH	CHECKED BY:	MC	SCALE:	N.T.S.

**CES**  
ENGINEERING SURVEYING

Crowder Engineering &  
Surveying, Inc.  
P.O. Box 1209  
Ackerman, MS 39735-1209  
662-285-2062

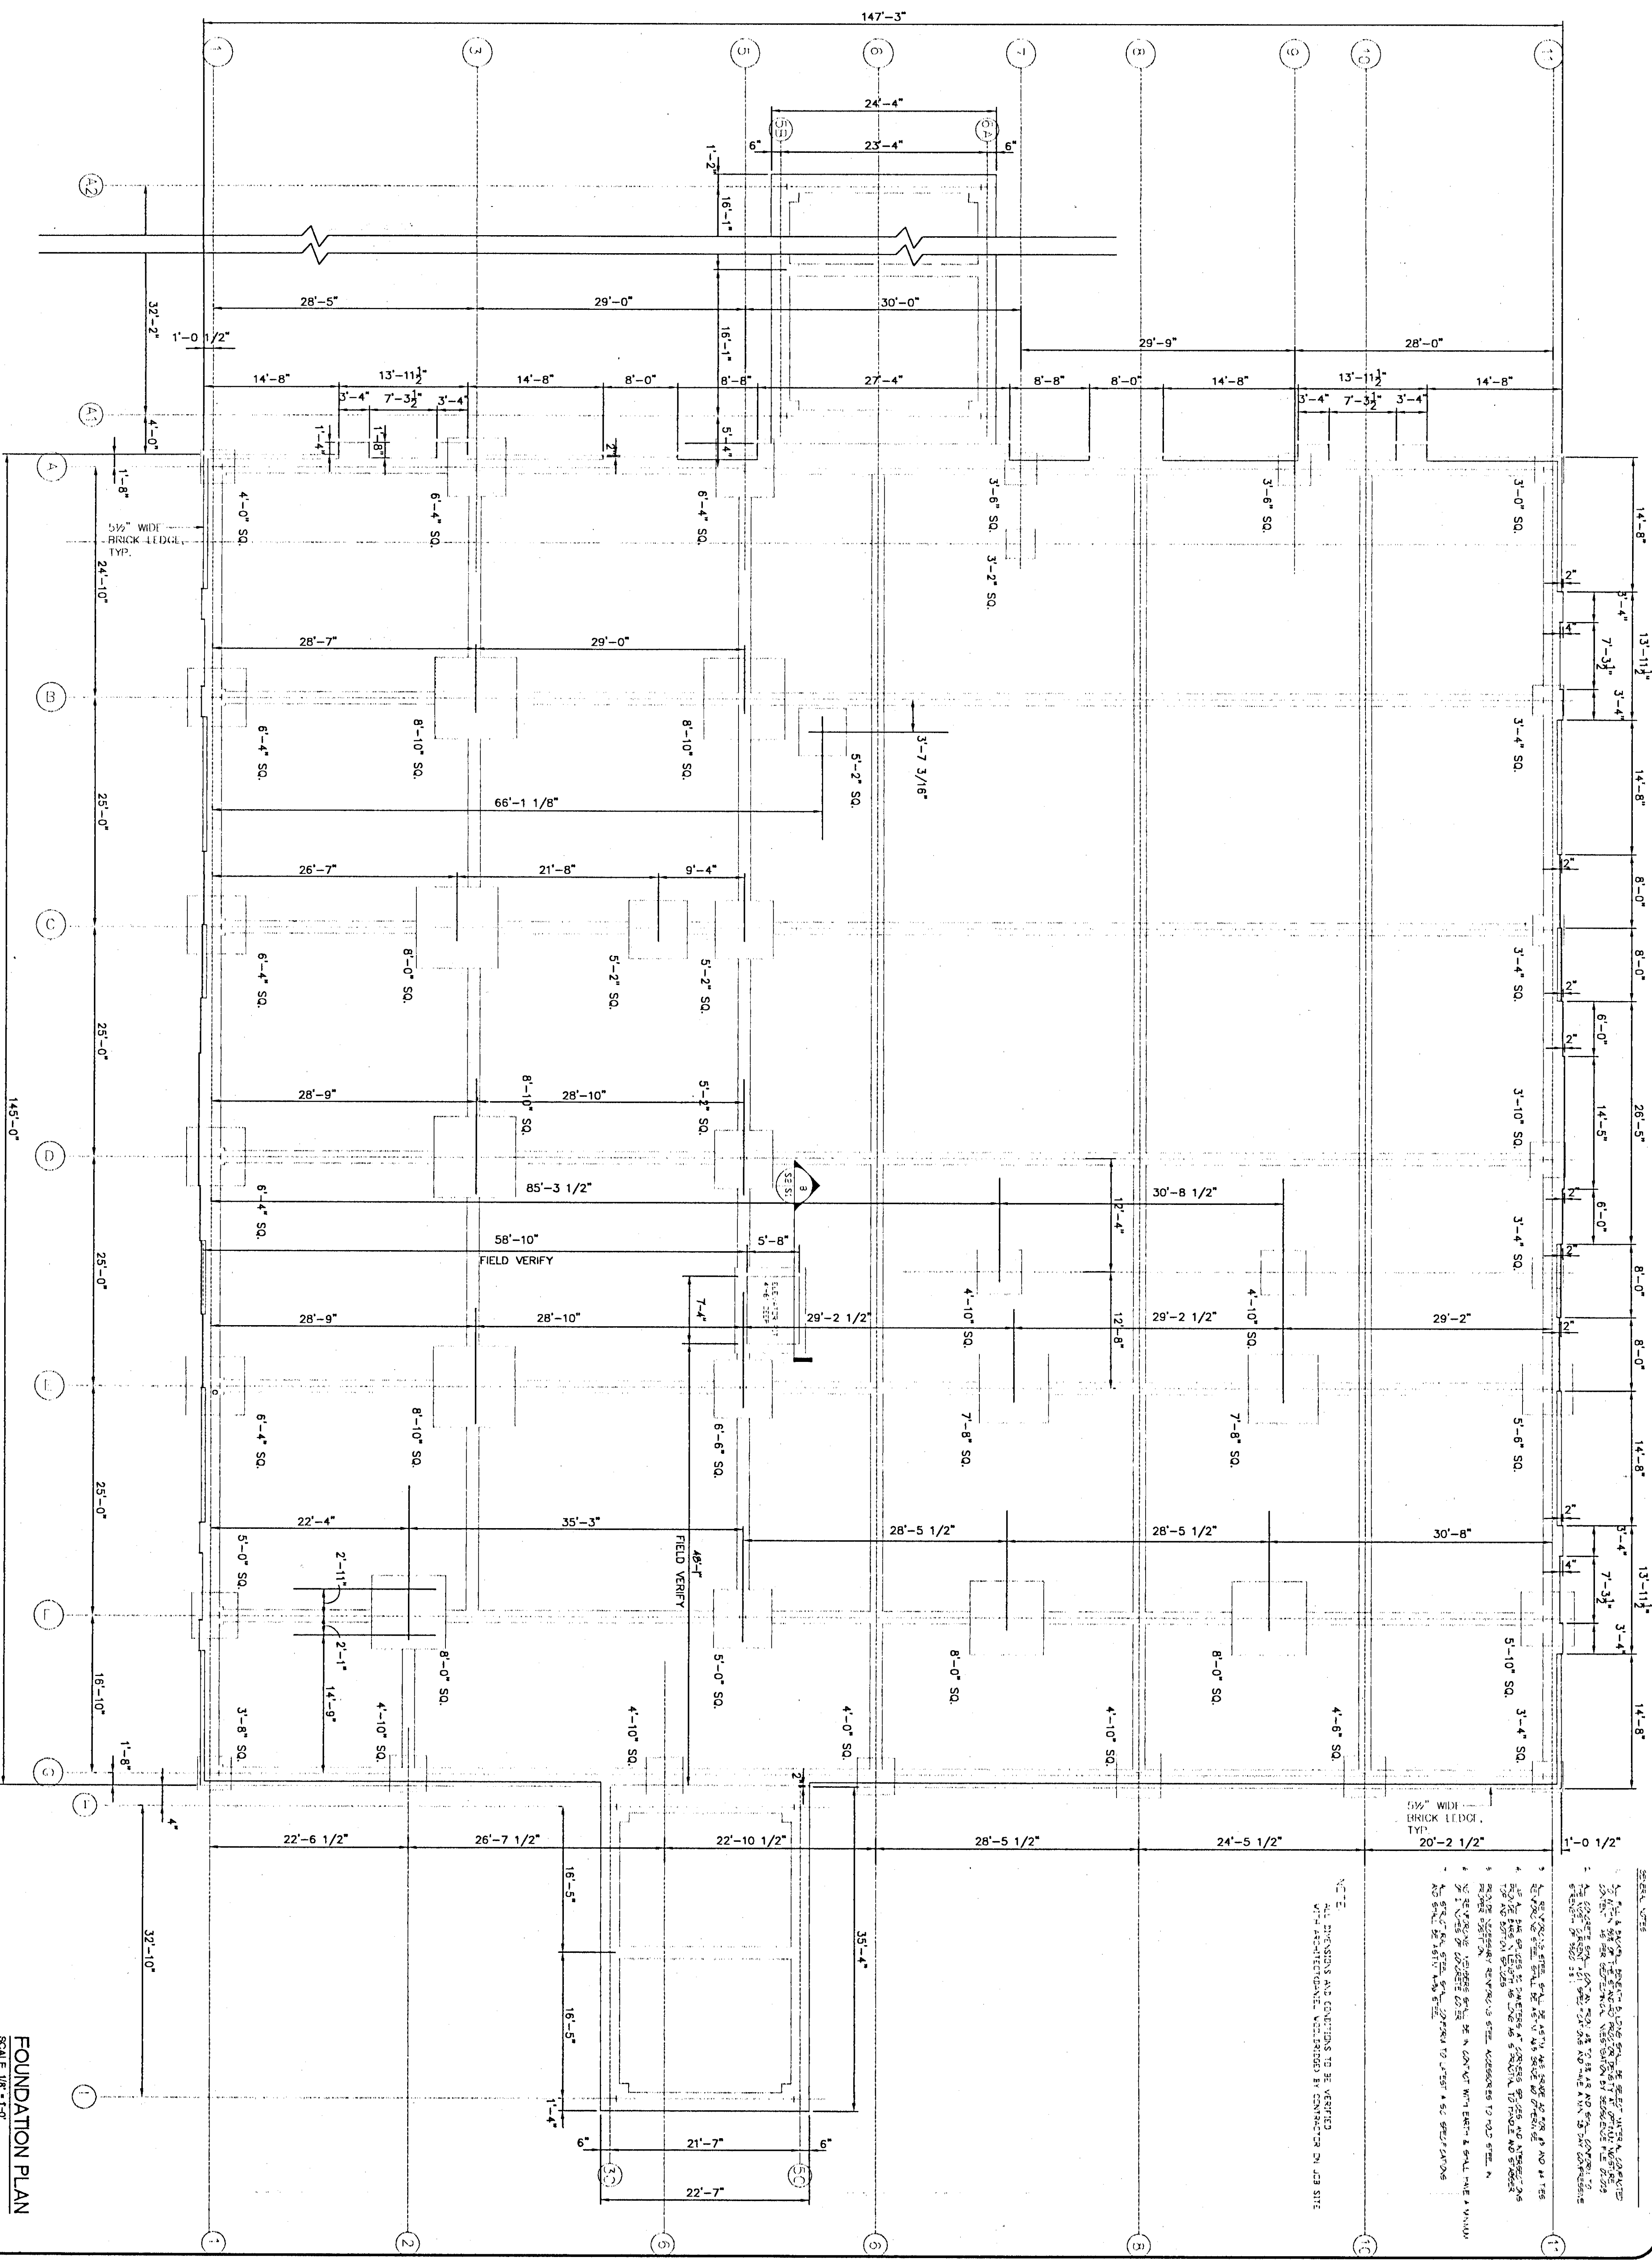

FOUNDATION PLAN  
SCALE 1/8" = 1'-0"

5/8" WIDE BRICK LEDG. TYP.  
20'-2 1/2"


NOTES:  
1. ALL DIMENSIONS AND CONDITIONS TO BE VERIFIED BY THE ARCHITECT/ENGINEER, WELL BEFORE BY CONTRACTOR ON JOB SITE.  
2. ALL DIMENSIONS ARE TO FACE UNLESS OTHERWISE NOTED.  
3. ALL DIMENSIONS ARE TO FACE UNLESS OTHERWISE NOTED.  
4. ALL DIMENSIONS ARE TO FACE UNLESS OTHERWISE NOTED.  
5. ALL DIMENSIONS ARE TO FACE UNLESS OTHERWISE NOTED.  
6. ALL DIMENSIONS ARE TO FACE UNLESS OTHERWISE NOTED.  
7. ALL DIMENSIONS ARE TO FACE UNLESS OTHERWISE NOTED.  
8. ALL DIMENSIONS ARE TO FACE UNLESS OTHERWISE NOTED.  
9. ALL DIMENSIONS ARE TO FACE UNLESS OTHERWISE NOTED.  
10. ALL DIMENSIONS ARE TO FACE UNLESS OTHERWISE NOTED.

SHEET NO. S1  
OF TWO

PROJECT NO. 01.28  
CAD FILE: COTE


FOUNDATION FOR  
CHURCH OF THE HIGHLANDS  
RIDGELAND, MISSISSIPPI

DATE: 5/23/2001  
DRAWN: ELK  
DESIGNED: ELK  
CHECKED: 8/22/2002  
REVISED: 9/12/2002

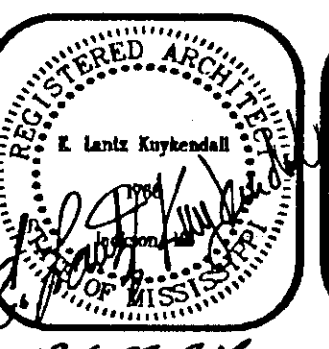


kuykendall & associates, pc  
Architects  
210 INDUSTRIAL DRIVE, SUITE 4  
RIDGELAND, MS. 39157 PH. (601) 898-0012


12.587.2002

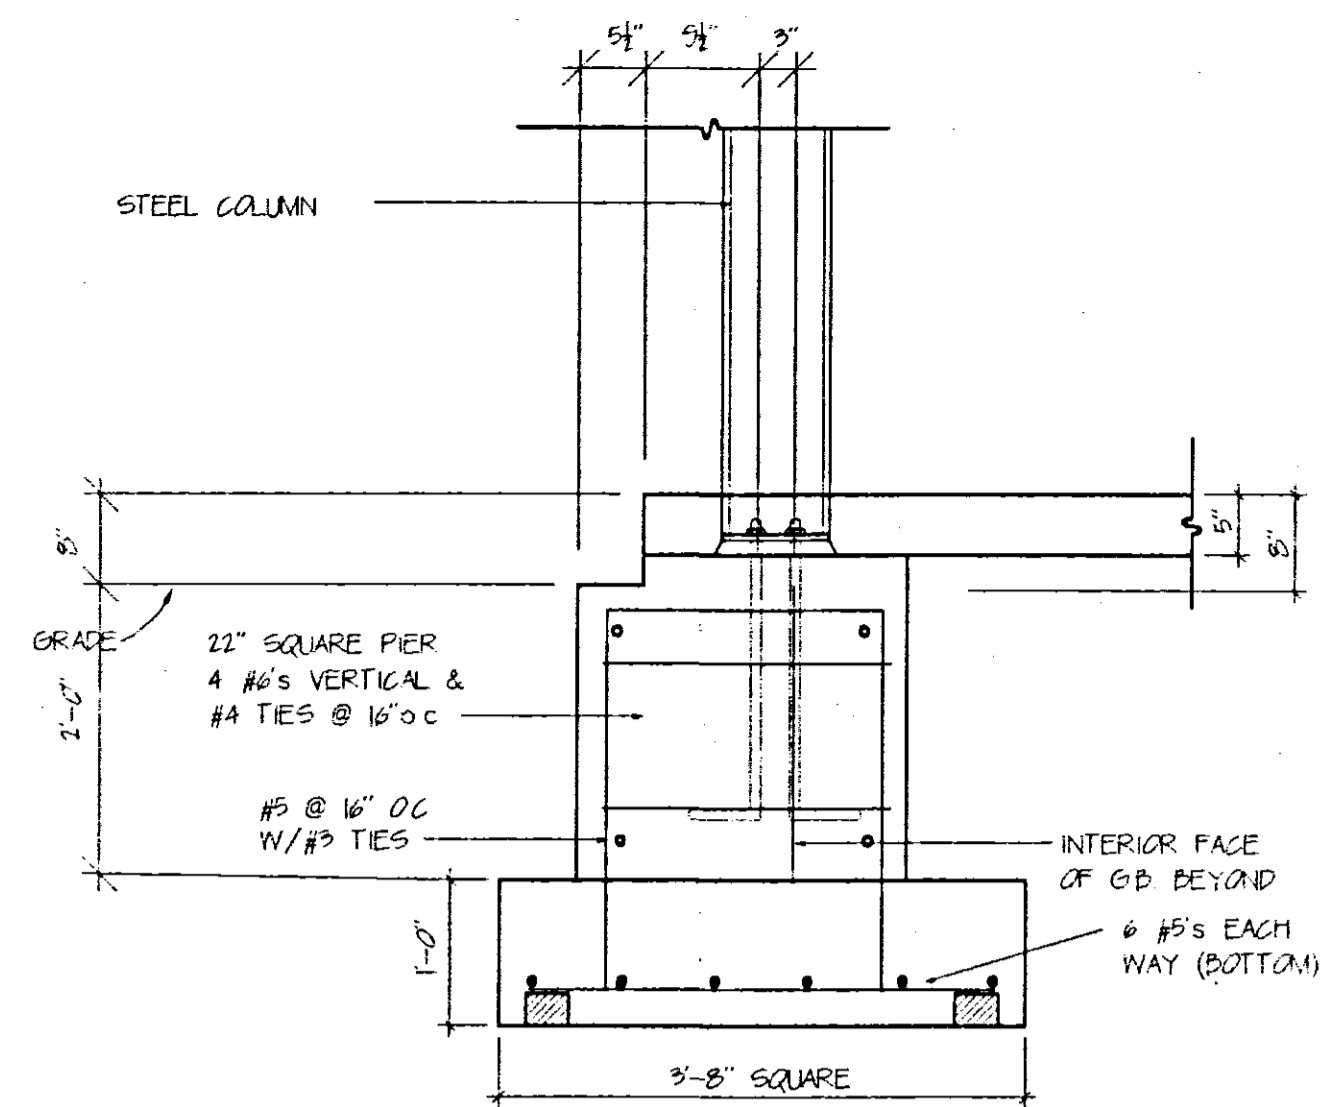


1 COLUMN DETAIL  
3/4" = 1'-0"

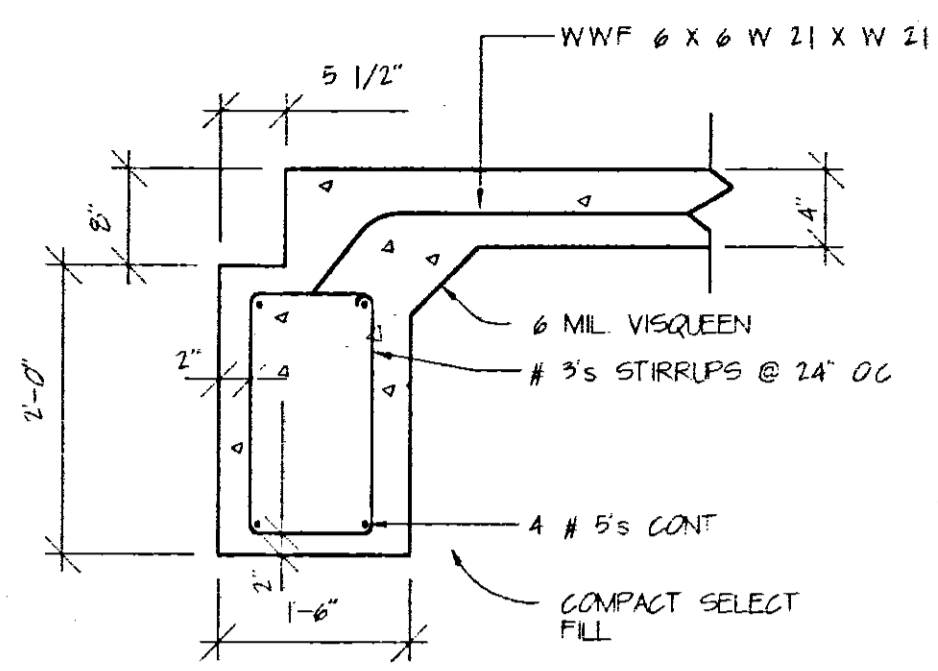


2 FOOTING DETAIL  
3/4" = 1'-0"

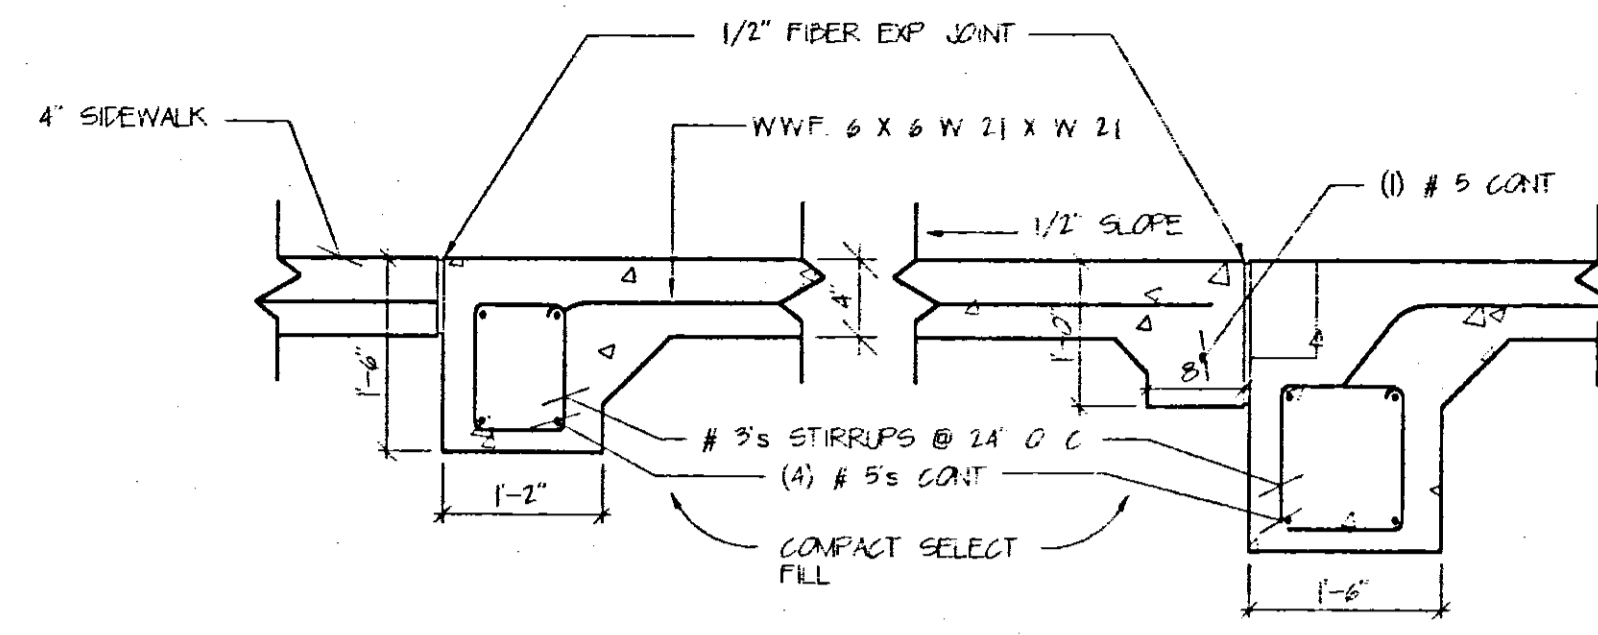


3 FOOTING DETAIL  
3/4" = 1'-0"

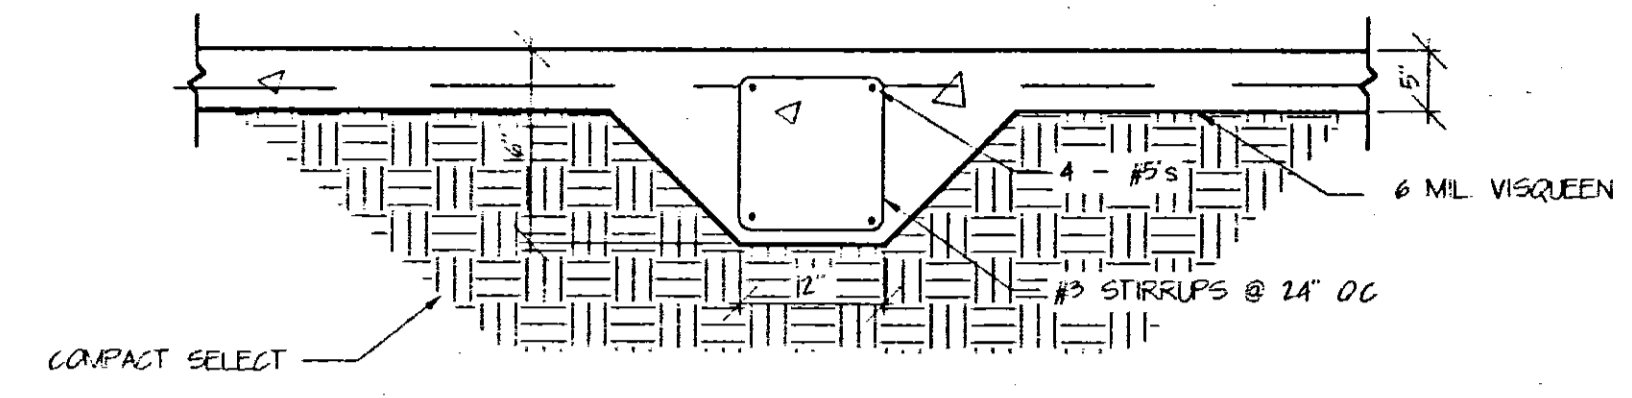


4 TIE BEAM  
3/4" = 1'-0"

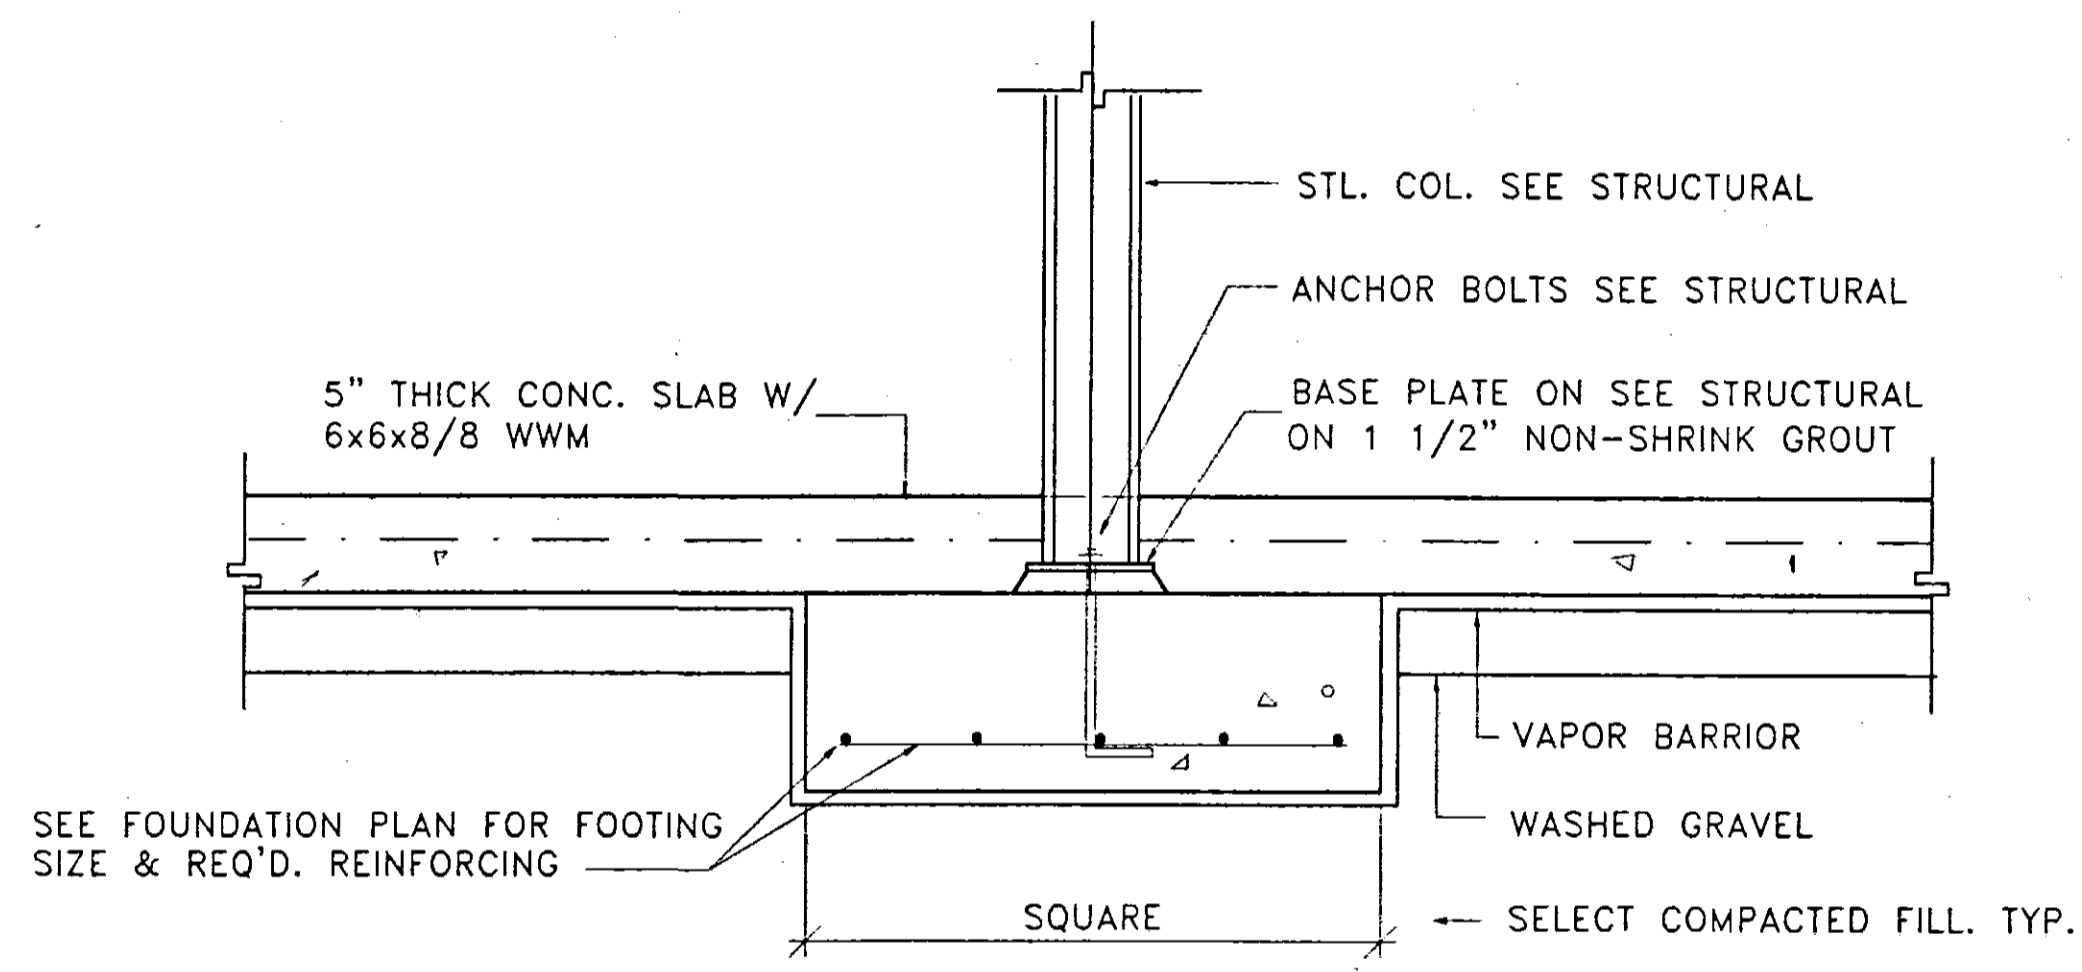


5 SECTION  
3/4" = 1'-0"

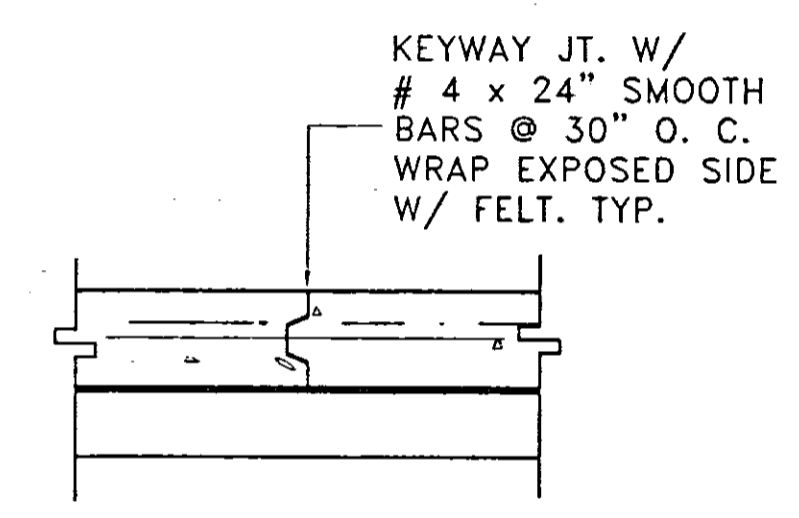

6 TYP. CONTROL JT.  
3/4" = 1'-0"

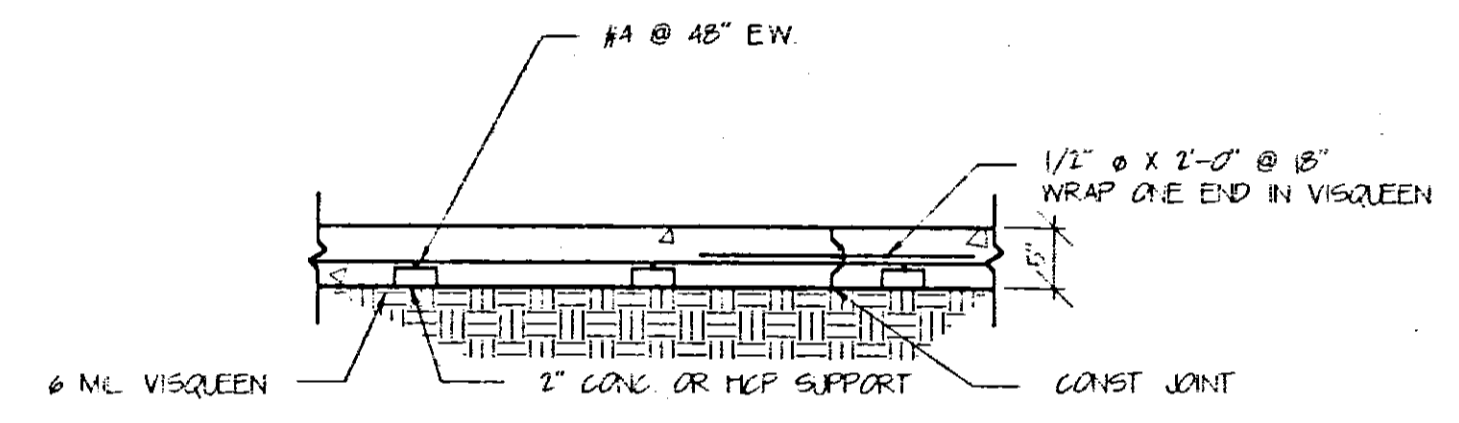


7 TYPICAL SLAB SECTION  
3/4" = 1'-0"

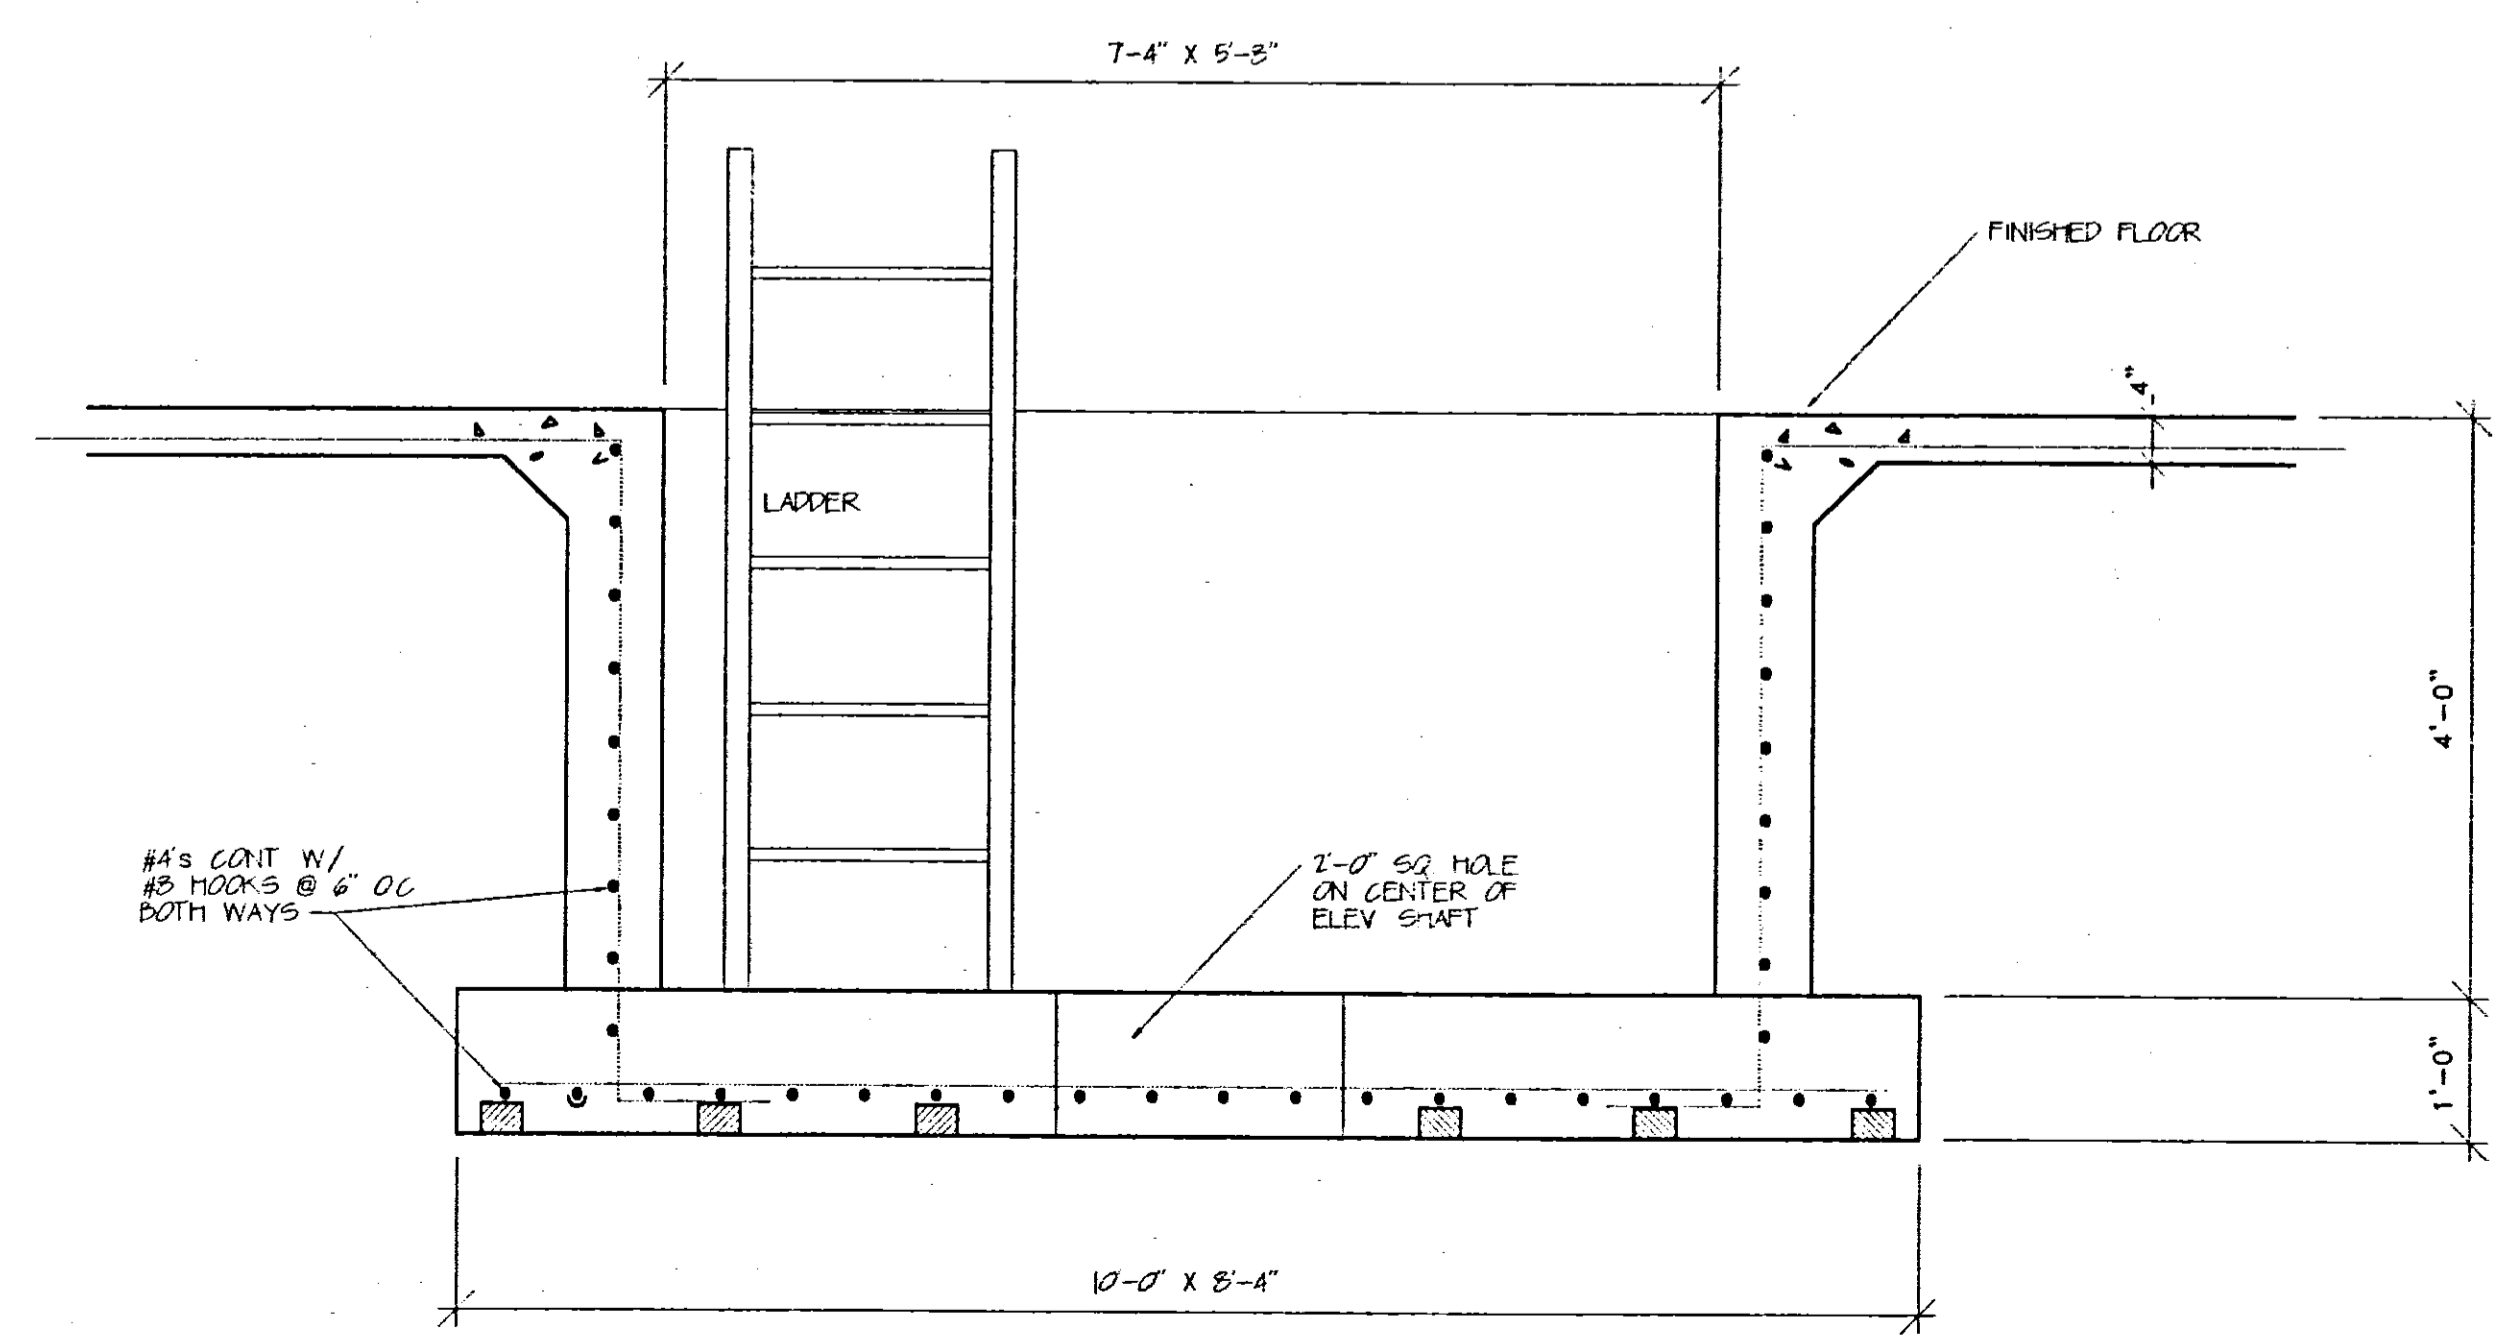

8 ELEVATOR PIT  
3/4" = 1'-0"

FOOTING SCHEDULE			
SIZE	DEEP	REINF. (BOTTOM)	
3'-0" SQ.	12"	5#4 EACH WAY	
3'-4" SQ.	12"	5#4 EACH WAY	
3'-8" SQ.	12"	6#5 EACH WAY	
4'-0" SQ.	12"	6#5 EACH WAY	
4'-4" SQ.	12"	7#5 EACH WAY	
4'-8" SQ.	12"	7#6 EACH WAY	
5'-0" SQ.	12"	7#6 EACH WAY	
5'-4" SQ.	15"	7#7 EACH WAY	
5'-8" SQ.	15"	7#7 EACH WAY	
6'-0" SQ.	18"	7#7 EACH WAY	
6'-4" SQ.	18"	9#7 EACH WAY	
6'-8" SQ.	18"	9#7 EACH WAY	
7'-0" SQ.	21"	10#7 EACH WAY	
7'-4" SQ.	21"	10#7 EACH WAY	
7'-8" SQ.	21"	11#7 EACH WAY	
8'-0" SQ.	24"	13#7 EACH WAY	
8'-4" SQ.	24"	13#7 EACH WAY	
8'-8" SQ.	24"	13#8 EACH WAY	
9'-0" SQ.	24"	13#8 EACH WAY	
9'-4" SQ.	24"	14#8 EACH WAY	
4'-0" x 10'-0"	12"	#5 @ 8" OC EA. WAY	

**kuykendall & associates, pc**  
Architects  
210 INDUSTRIAL DRIVE, SUITE 4  
RIDGELAND, MS. 39157 PH. (601) 898-0012

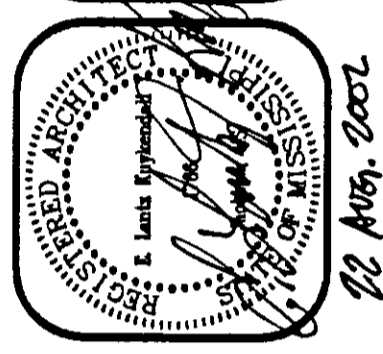


DATE	5/21/02	BY	ELK
DRAWN	ELK	DESIGNED	ELK
CHECKED	ELK	REVIEWED	ELK

FOUNDATION FOR  
**CHURCH OF THE HIGHLANDS**  
RIDGELAND, MISSISSIPPI

PROJECT NO.  
**01.28**  
CAD FILE CODE

SHEET NO.  
**S2**  
OF TWO

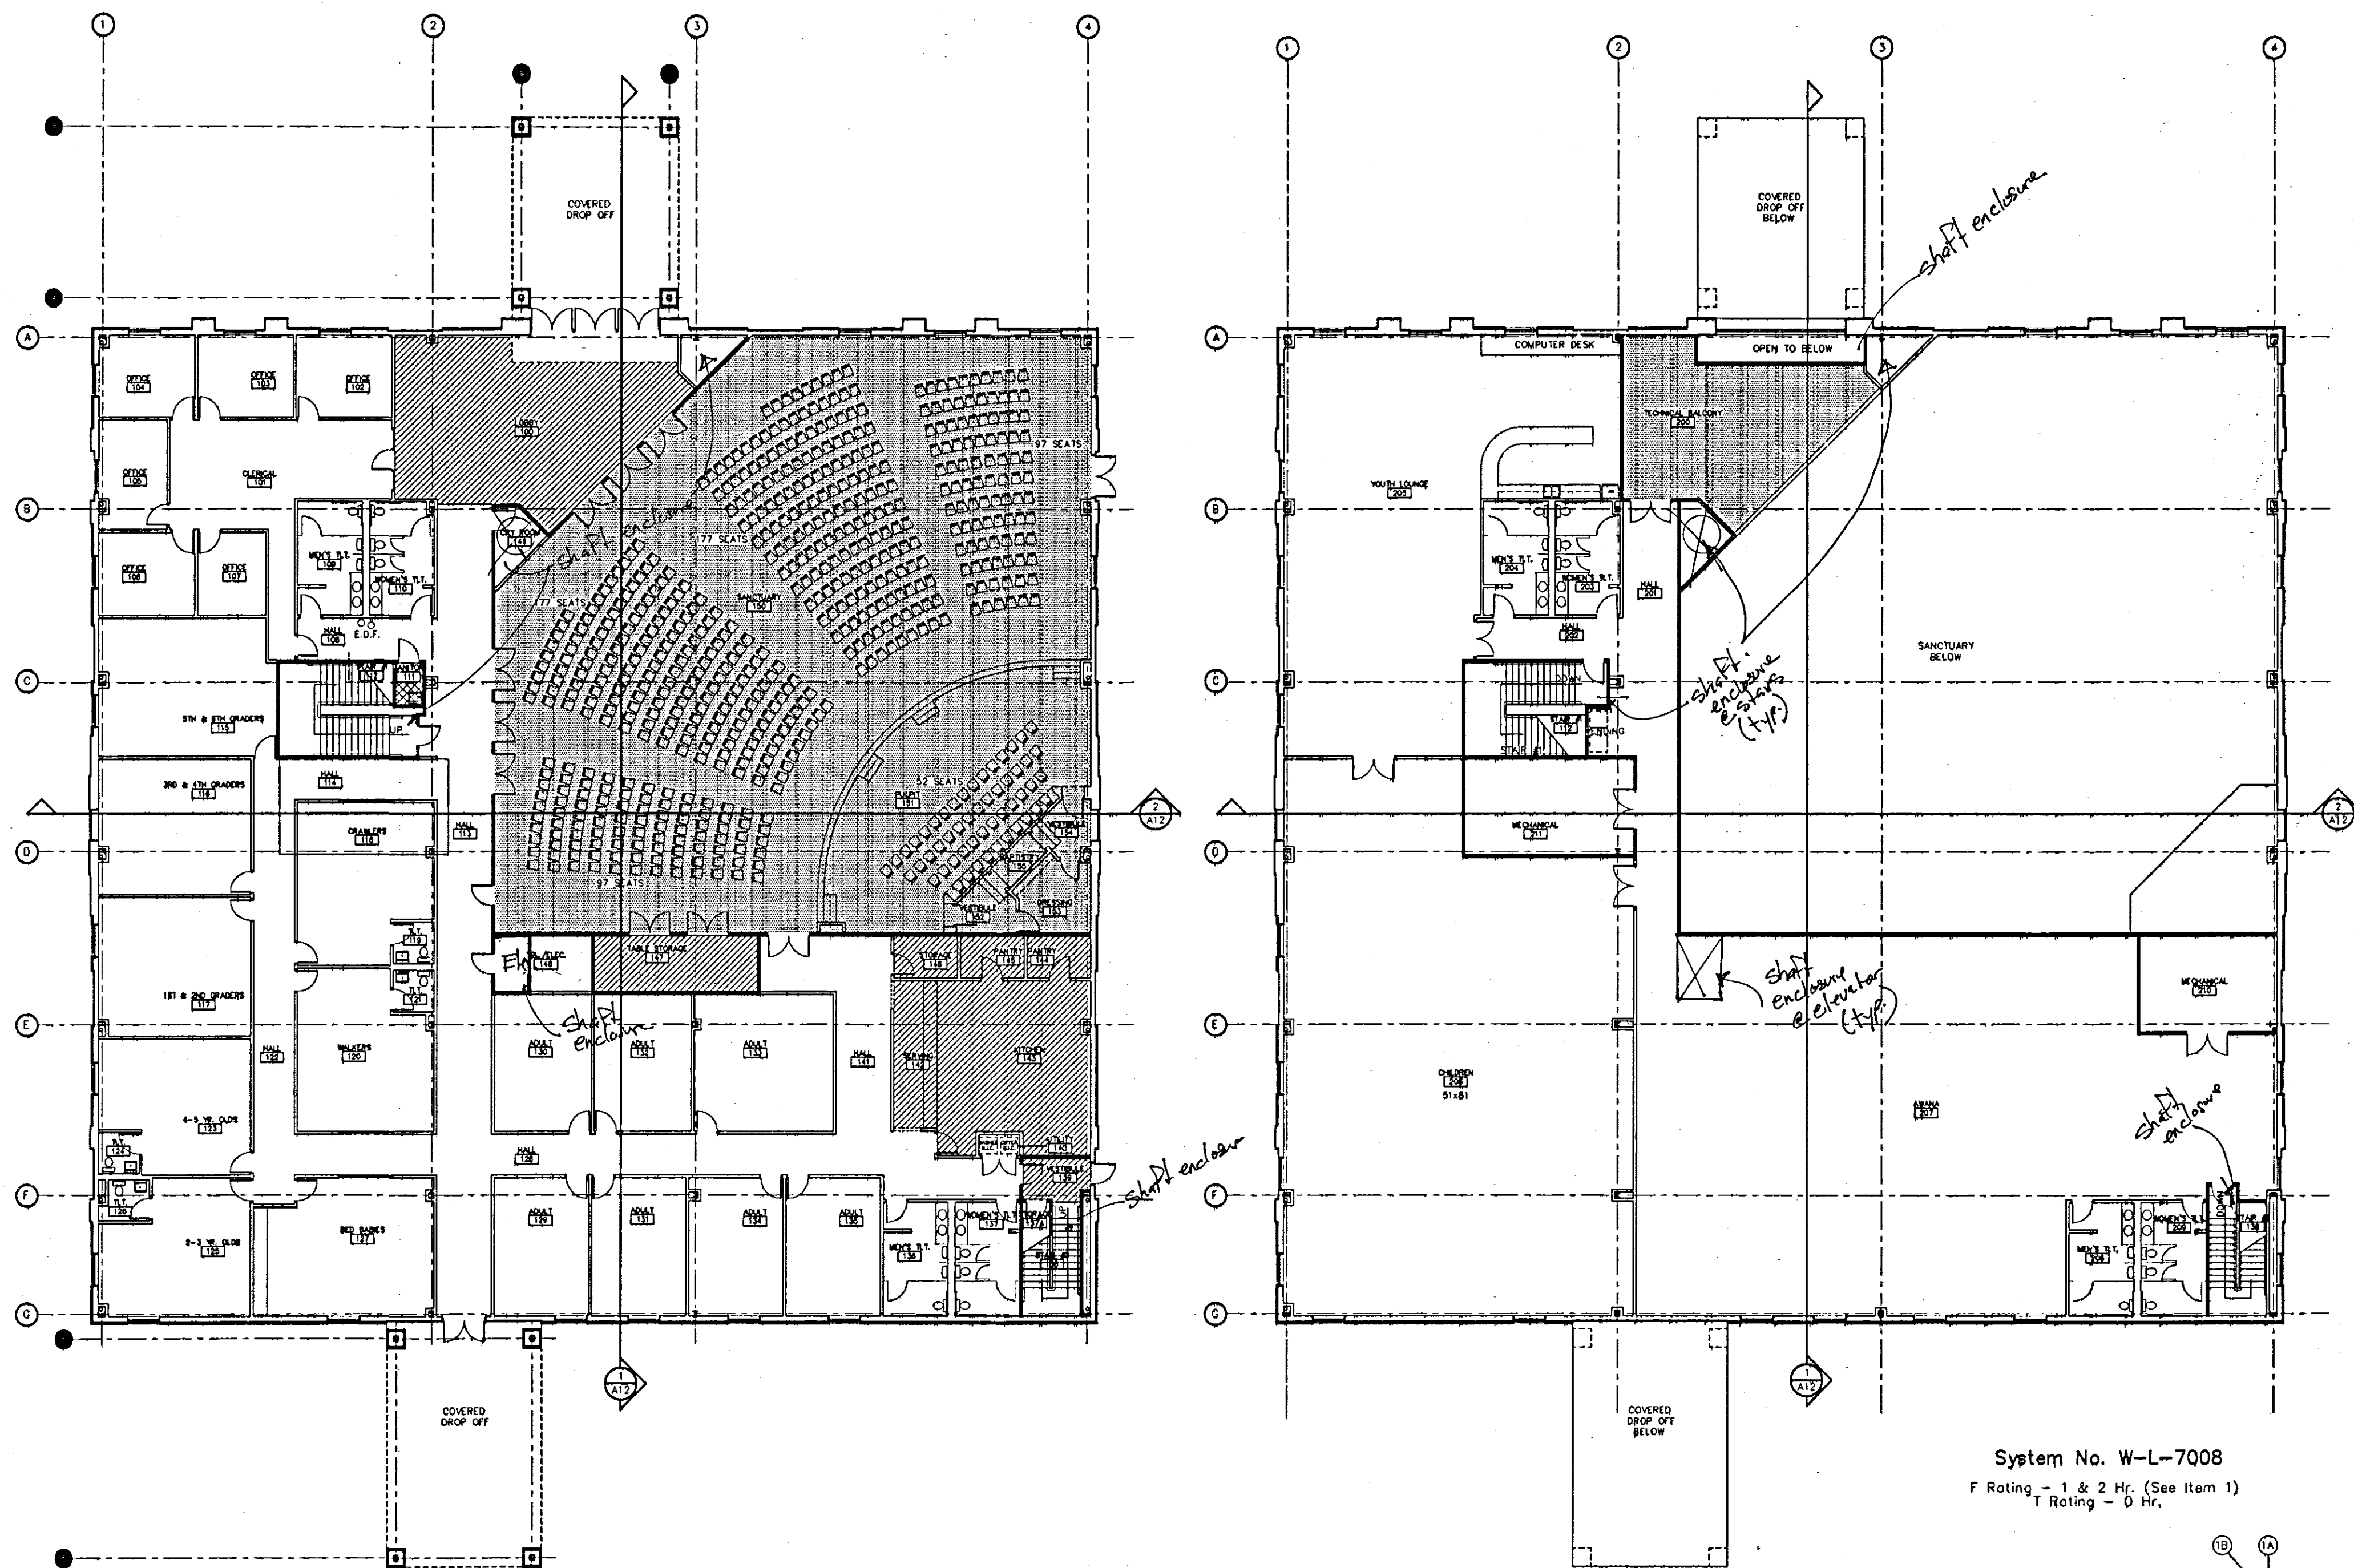


- 1 HOUR FIRE SEPARATION CONTINUED TO UNDERSIDE OF DECK U.L. DES. NO. U-465
- ASSEMBLY A3 7,040 S.F. SANCTUARY 834 S.F. BALCONY
- EDUCATIONAL FIRST FLOOR 14,310 S.F. SECOND FLOOR 13,476 S.F.
- 1 HOUR RATED CEILING ASSEMBLY U.L. DES. NO. A202
- 1 1/2 HOUR RATED CEILING ASSEMBLY U.L. DES. NO. G528

Construction Type 3B sprinkled

NOTES:

- ALL PIPE PENETRATIONS OF 1 HR. FIRE SEPARATION SHALL CONFORM TO U.L. DES. NO. W-L-1039
- ALL DUCT PENETRATIONS OF 1 HR. FIRE SEPARATION SHALL CONFORM TO U.L. DES. NO. W-L-7008
- BATT INSULATION IN WALLS AND CEILINGS TO HAVE A FLAME SPREAD OF 25 OR LESS, AND A SMOKE DEVELOPMENT OF 25 OR LESS, TYPICAL.

System No. W-L-7008  
F Rating - 1 & 2 Hr. (See Item 1)  
T Rating - 0 Hr.

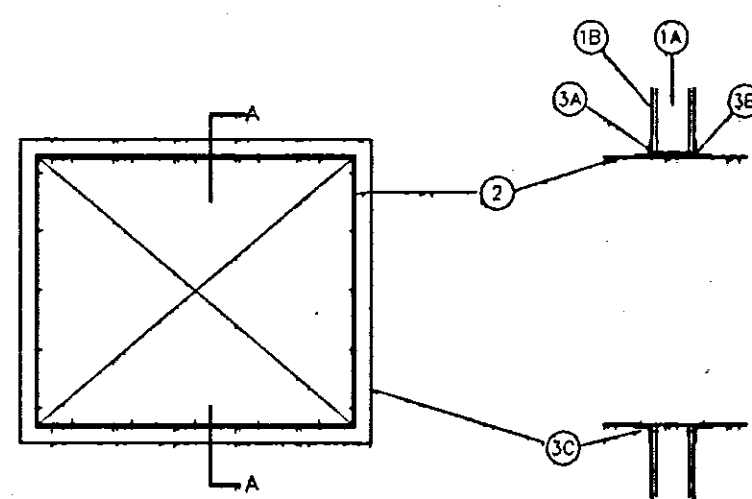


SECTION AA

- WALL ASSEMBLY - The 1 and 2 hr. fire rated gypsum wallboard/stud wall assembly shall be constructed of the materials and in the manner specified in the individual U300 or U400 Series Wall and Partition Designs in the U.L. Fire Resistance Directory and shall include the following construction features:
  - STUDS - WALL FRAMING SHALL CONSIST OF STEEL CHANNEL STUDS TO BE MIN. 3/4 IN. WIDE AND SPACED MAX. 24 IN. O.C. ADDITIONAL 3/4 IN. WIDE STEEL STUDS SHALL BE USED TO COMPLETELY FRAME OPENING.
  - WALLBOARD, GYPSUM\* - THICKNESS, TYPE, NUMBER OF LAYERS AND FASTENERS AS REQUIRED IN THE INDIVIDUAL WALL AND PARTITION DESIGN. MAX. SIZE OF OPENING TO BE 1218 SQ. IN. WITH A MAX. DIMENSION OF 38 IN.
 THE HOURLY F RATING OF THE FIRESTOP SYSTEM IS EQUAL TO THE HOURLY FIRE RATING OF THE WALL ASSEMBLY IN WHICH IT IS INSTALLED.
- THROUGH-PENETRANT - NOW 36 IN. BY 36 (OR SMALLER) 24 GAUGE (OR HEAVIER) GALV. STEEL DUCT TO BE INSTALLED EITHER CONCENTRICALLY OR ECCENTRICALLY WITHIN THE FIRESTOP SYSTEM. AN ANNULAR SPACE OF MIN. 0 IN. (POINT CONTACT) TO MAX. 2 IN. IS REQUIRED WITHIN THE FIRESTOP SYSTEM. STEEL DUCT TO BE RIGIDLY SUPPORTED ON BOTH SIDES OF FLOOR OR WALL ASSEMBLY.
- FIRESTOP SYSTEM - THE DETAILS OF THE FIRESTOP SYSTEM SHALL BE AS FOLLOWS:
  - PACKING MATERIAL (OPTIONAL) - POLYETHYLENE BACKER ROD, MINERAL WOOL BATT INSULATION OR FIBERGLASS BATT INSULATION-FIT INTO ANNULAR SPACE FOR 2 HR. RATED WALL ASSEMBLY ONLY. PACKING MATERIAL TO BE RECESSED FROM BOTH SURFACES OF WALL TO ACCOMMODATE THE REQUIRED THICKNESS OF FILL MATERIAL (ITEM 3B).
  - FILL VOID OR CAVITY MATERIAL - CALK - MIN. 3/8 IN. THICKNESS OF FILL MATERIAL APPLIED WITHIN ANNULUS, FLUSH WITH BOTH SURFACES OF WALL ASSEMBLY. AT THE POINT CONTACT LOCATION BETWEEN DUCT AND WALLBOARD, A MIN. 1/4 IN. DIAM. BEAD OF SEALANT SHALL BE APPLIED AT THE WALLBOARD/DUCT INTERFACE ON BOTH SURFACES OF WALL ASSEMBLY. MINNESOTA MINING & MFG. CO. - CP-25 MB+
- RETAINING ANGLES - MIN. 16 GAUGE DALV. STEEL ANGLES SIZED TO LAP DUCT. A MIN. OF 2 IN. AND LAP WALL SURFACES OF A MIN. OF 1 IN. ANGLES ATTACHED TO DUCT ON BOTH SIDES OF WALL WITH MIN. 1/4 IN. LONG, NO. 10 (OR LARGER) SHEET METAL SCREWS SPACES A MAX. OF 1 IN. FROM EACH END OF DUCT AND SPACED A MAX. OF 6 IN. O.C.

\*BEARING THE UL CLASSIFICATION MARKING


Design No. U465  
Nonbearing Wall Rating - 1 HR.

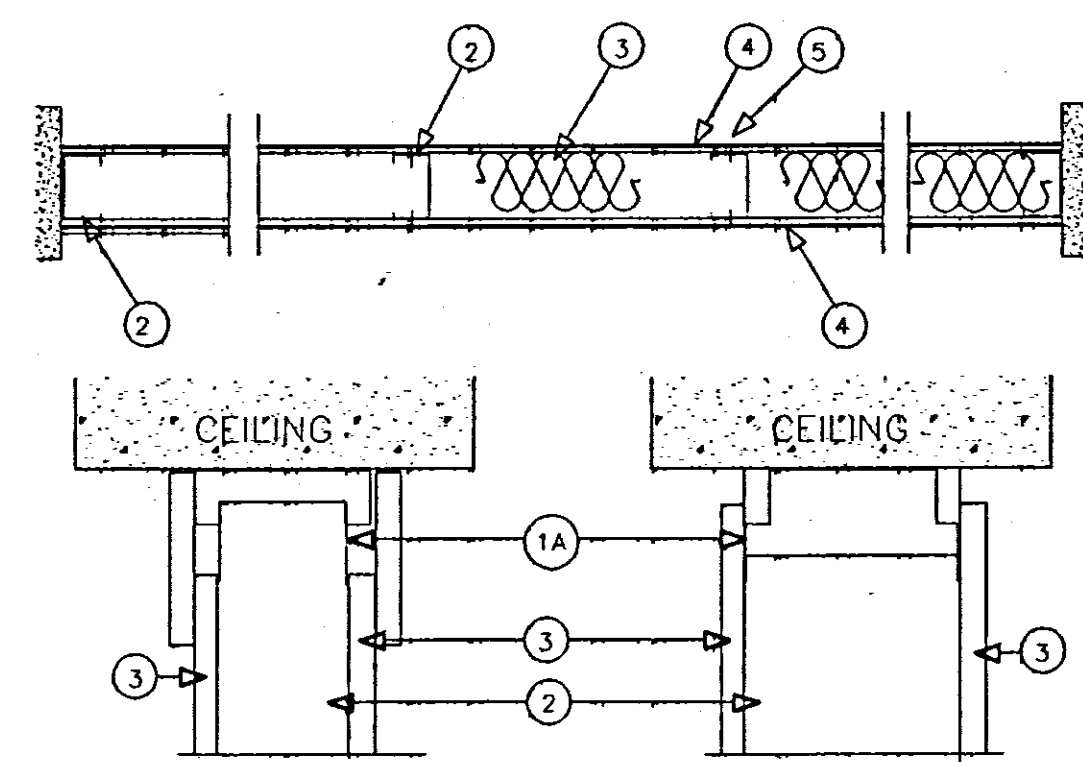

- Floor and Ceiling Runners - (not shown) - Channel shaped runners, 3- 5/8 in. wide (min), 1- 1/4 in. legs, formed from No. 25 MSG (min) galv steel, attached to floor and ceiling with fasteners spaced 24 in. O.C. max.
- Steel Studs - Channel shaped 3-5/8 in. wide (min), 1-1/4 in. legs, 3/8 in. folded back returns, formed from No. 25 MSG (min) galv steel spaced 24 in. O.C. max.
- Batts and Blankets\* - (Optional) - Mineral wool or glass fiber batts partially or completely filling stud cavity. See Batts and Blankets (B7J2) category for names of Classified companies.
- Wallboard, Gypsum\* - 5/8 in. thick, 4 ft wide, attached to steel studs and floor and ceiling track with 1 in. long, type 5 self-lapping steel screws spaced 8 in. O.C. along edges of board and 12 in. O.C. in the field of the board. Joints oriented vertically and staggered on opposite sides of assembly. When attached to item 6 (furring channels), wallboard is screw attached to furring channels with 1 in. long, type 5 self-lapping screws spaced 12 in. O.C.
  - Boral Gypsum Inc. - Type BG-C.
  - Canadian Gypsum Co., Ltd. - Types C, SCX, SHX, WRX.
  - Continental Gypsum Company - Type CG-C.
  - Domtar Gypsum Inc. - Type 5 or C.
  - Eagle-Gypsum Products-Type EG-C.
  - Georgia Pacific Corp., Gypsum Div. - Type GPFS-6 or GPFS-G.
  - National Gypsum Co., Charlotte, NC - Types FSK-G, FSW-G.
  - National Gypsum Co., Riyadh, Saudi Arabia - Type FR or WR.
  - Pasco Gypsum Co. - Type PG-C.
  - Republic Gypsum Co. - Type RG-C.
  - Standard Gypsum Corp. - Type SG-C.
  - Temple-Inland Forest Products Corp. - Type TP-5.
  - United States Gypsum Co. - Type AR, C, IP-X2, SCX, SHX, WRC or WRX.
  - Westroc Industries Ltd. - Type Westroc Fireboard.
- Wallboard, Gypsum\* - (As an alternate to item 4) - Nom 3/4 in. thick, 4 ft wide, installed as described in item 4 with screw length increased to 1-1/4 in.
- Wallboard, Gypsum\* - (As an alternate to item 4 and 4A) - 5/8 in. thick installed as described in item 4. Joint covering (item 5) not required.
  - United States Gypsum Co. - Type WSX.
- Joint Tape and Compound - Vinyl, dry or premixed joint compound, applied in two coats to joints and screw heads; paper tape, 2 in. wide, embedded in first layer of compound over all joints. As an alternate, nonmetallic 5/32 in. thick gypsum garter plaster may be applied to the entire surface of classified veneer baseboard. Joints reinforced.
- Furring Channel - (Optional - Not Shown) - Resilient 25 MSG galv steel furring channels, spaced vertically max. 24 in. O.C. flange portion attached to each intersecting stud with 1/2 in. long type S-12 pan-head steel screws.

\*Bearing the UL Classification Marking

System No. W-L-1039  
(Formerly System No. 605)  
F Rating - 1 Hr.  
T Rating - 0 and 1 Hr. (See Item 2)

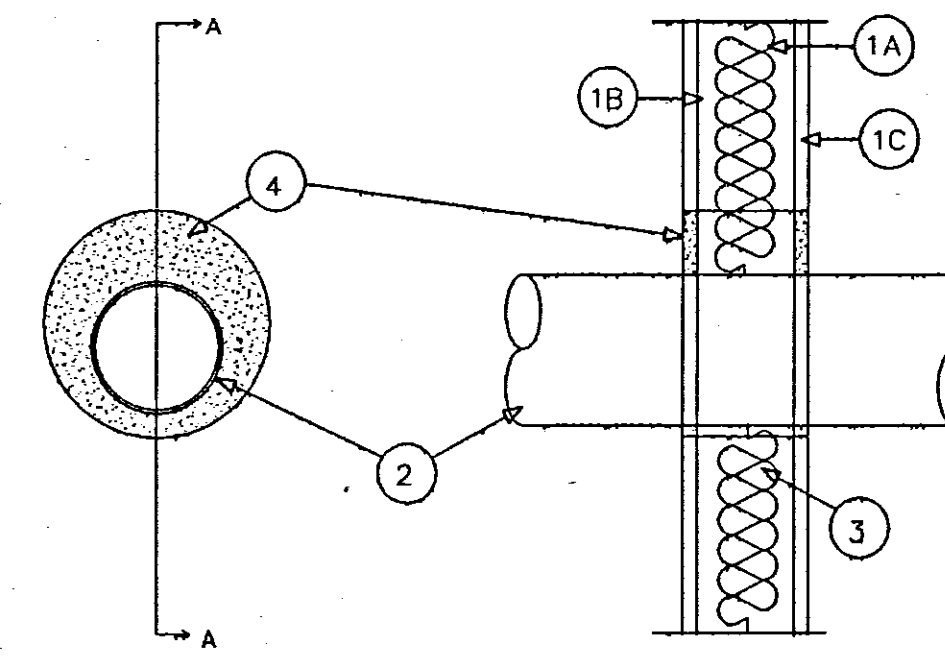


SECTION A-A

- Wall Assembly - The fire rated gypsum wallboard/stud wall assembly shall be constructed of the materials and in the manner specified in the individual U300 or U400 Series Wall and Partition Designs in the U.L. Fire Resistance Directory and shall include the following construction features:
  - STUDS - WALL FRAMING MAY CONSIST OF EITHER WOOD STUD OR STEEL CHANNEL STUDS. WOOD STUDS TO CONSIST OF NOM. 2 x 4 IN. LUMBER SPACED 16 IN. O.C. STEEL STUDS TO BE MIN. 2-1/2 IN. WIDE AND SPACED MAX. 24 IN. O.C.
  - Batts and Blankets\* - Nom 1-1/2 in. thick wool batts friction fitted to fill interior of stud cavity.
  - Wallboard, Gypsum\* - The gypsum wallboard type, thickness, number of layers, and orientation shall be as specified in the individual Wall and Partition Design. Max diam of opening is 7 in.
- Through Penetrants - One metallic pipe, conduit, or tubing to be installed in either concentrically or eccentrically within the firestop system. Pipe, conduit, or tubing to be rigidly supported on both sides of wall assembly. The following types and sizes of metallic pipes, conduits, or tubing may be used:
  - Steel Pipe - Nom 4 in. diam (or smaller) Schedule 10 (or heavier) steel pipe. The annular space shall be min 1/4 to 1-1/8 in. when steel pipe is used. T Rating is 0 hr.
  - Conduit - Nom 4 in. diam or smaller steel electrical metallic tubing or steel conduit. The annular space shall be min 1/4 to max 1-5/8 in. When conduit is 1/2 in. diam or less, T Rating is 1 hr.
  - Copper Tubing - Nom 4 in. diam (or smaller) Type L (or heavier) copper tubing. The annular space shall be min 1/4 to max 1-5/8 in. When copper tubing is used T Rating is 0 hr.
- Forming Material\* - Min 2-1/2 in. thickness of min 3.5 pcf mineral wool batt insulation firmly packed into opening as a permanent form. Forming material to be recessed from both surfaces of wall to accommodate the required thickness of fill material.
  - USC Interiors Inc. - Type SAF
- Fill Void, or Cavity Material\* - Min 1/2 in. thickness of fill material applied within the annulus, flush with both surfaces of wall. Dry mix material mixed at a rate of 2.1 parts dry mix to 1 part water by weight in accordance with the accompanying installation instructions.
  - United States Gypsum Co. - Type FC
  - 4A. Fill, Void, or Cavity Material\* - Not Shown - Two component fill material used as an alternate to item 4. Min 1/2 in. thickness of fill material applied within the annulus, flush with both surfaces of wall. Ready-mixed component mixed with accelerator component at a rate of 65 parts of ready-mixed component to 1 part of accelerator component by weight in accordance with the accompanying installation instructions.
    - United States Gypsum Co. - Type RFC

\*Bearing the UL Classification Marking

REVISIONS	BY

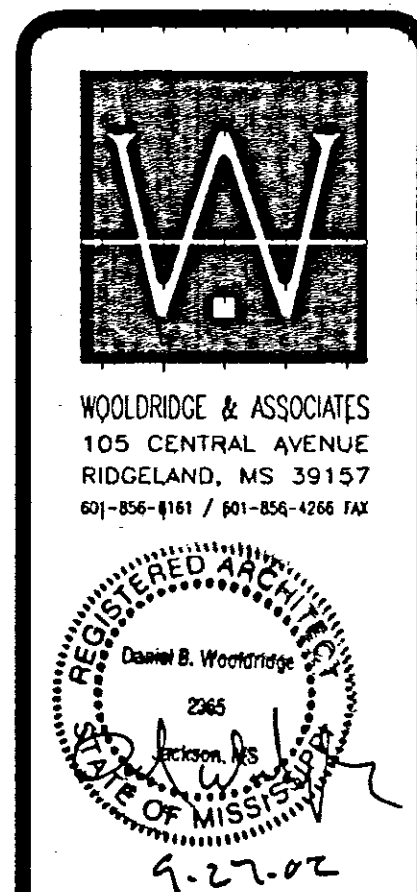

A New Building for  
**CHURCH OF THE HIGHLANDS**  
Ridgeland, Mississippi


THIS DESIGN IS THE COPYRIGHTED PROPERTY OF WOODBRIDGE & ASSOCIATES. IT MAY NOT BE REPRODUCED FROM THIS DESIGN WITHOUT THE EXPRESS WRITTEN PERMISSION OF WOODBRIDGE & ASSOCIATES.

DRAWN	CHECKED	DATE	SCALE	JOB NO.	SHEET

CR1





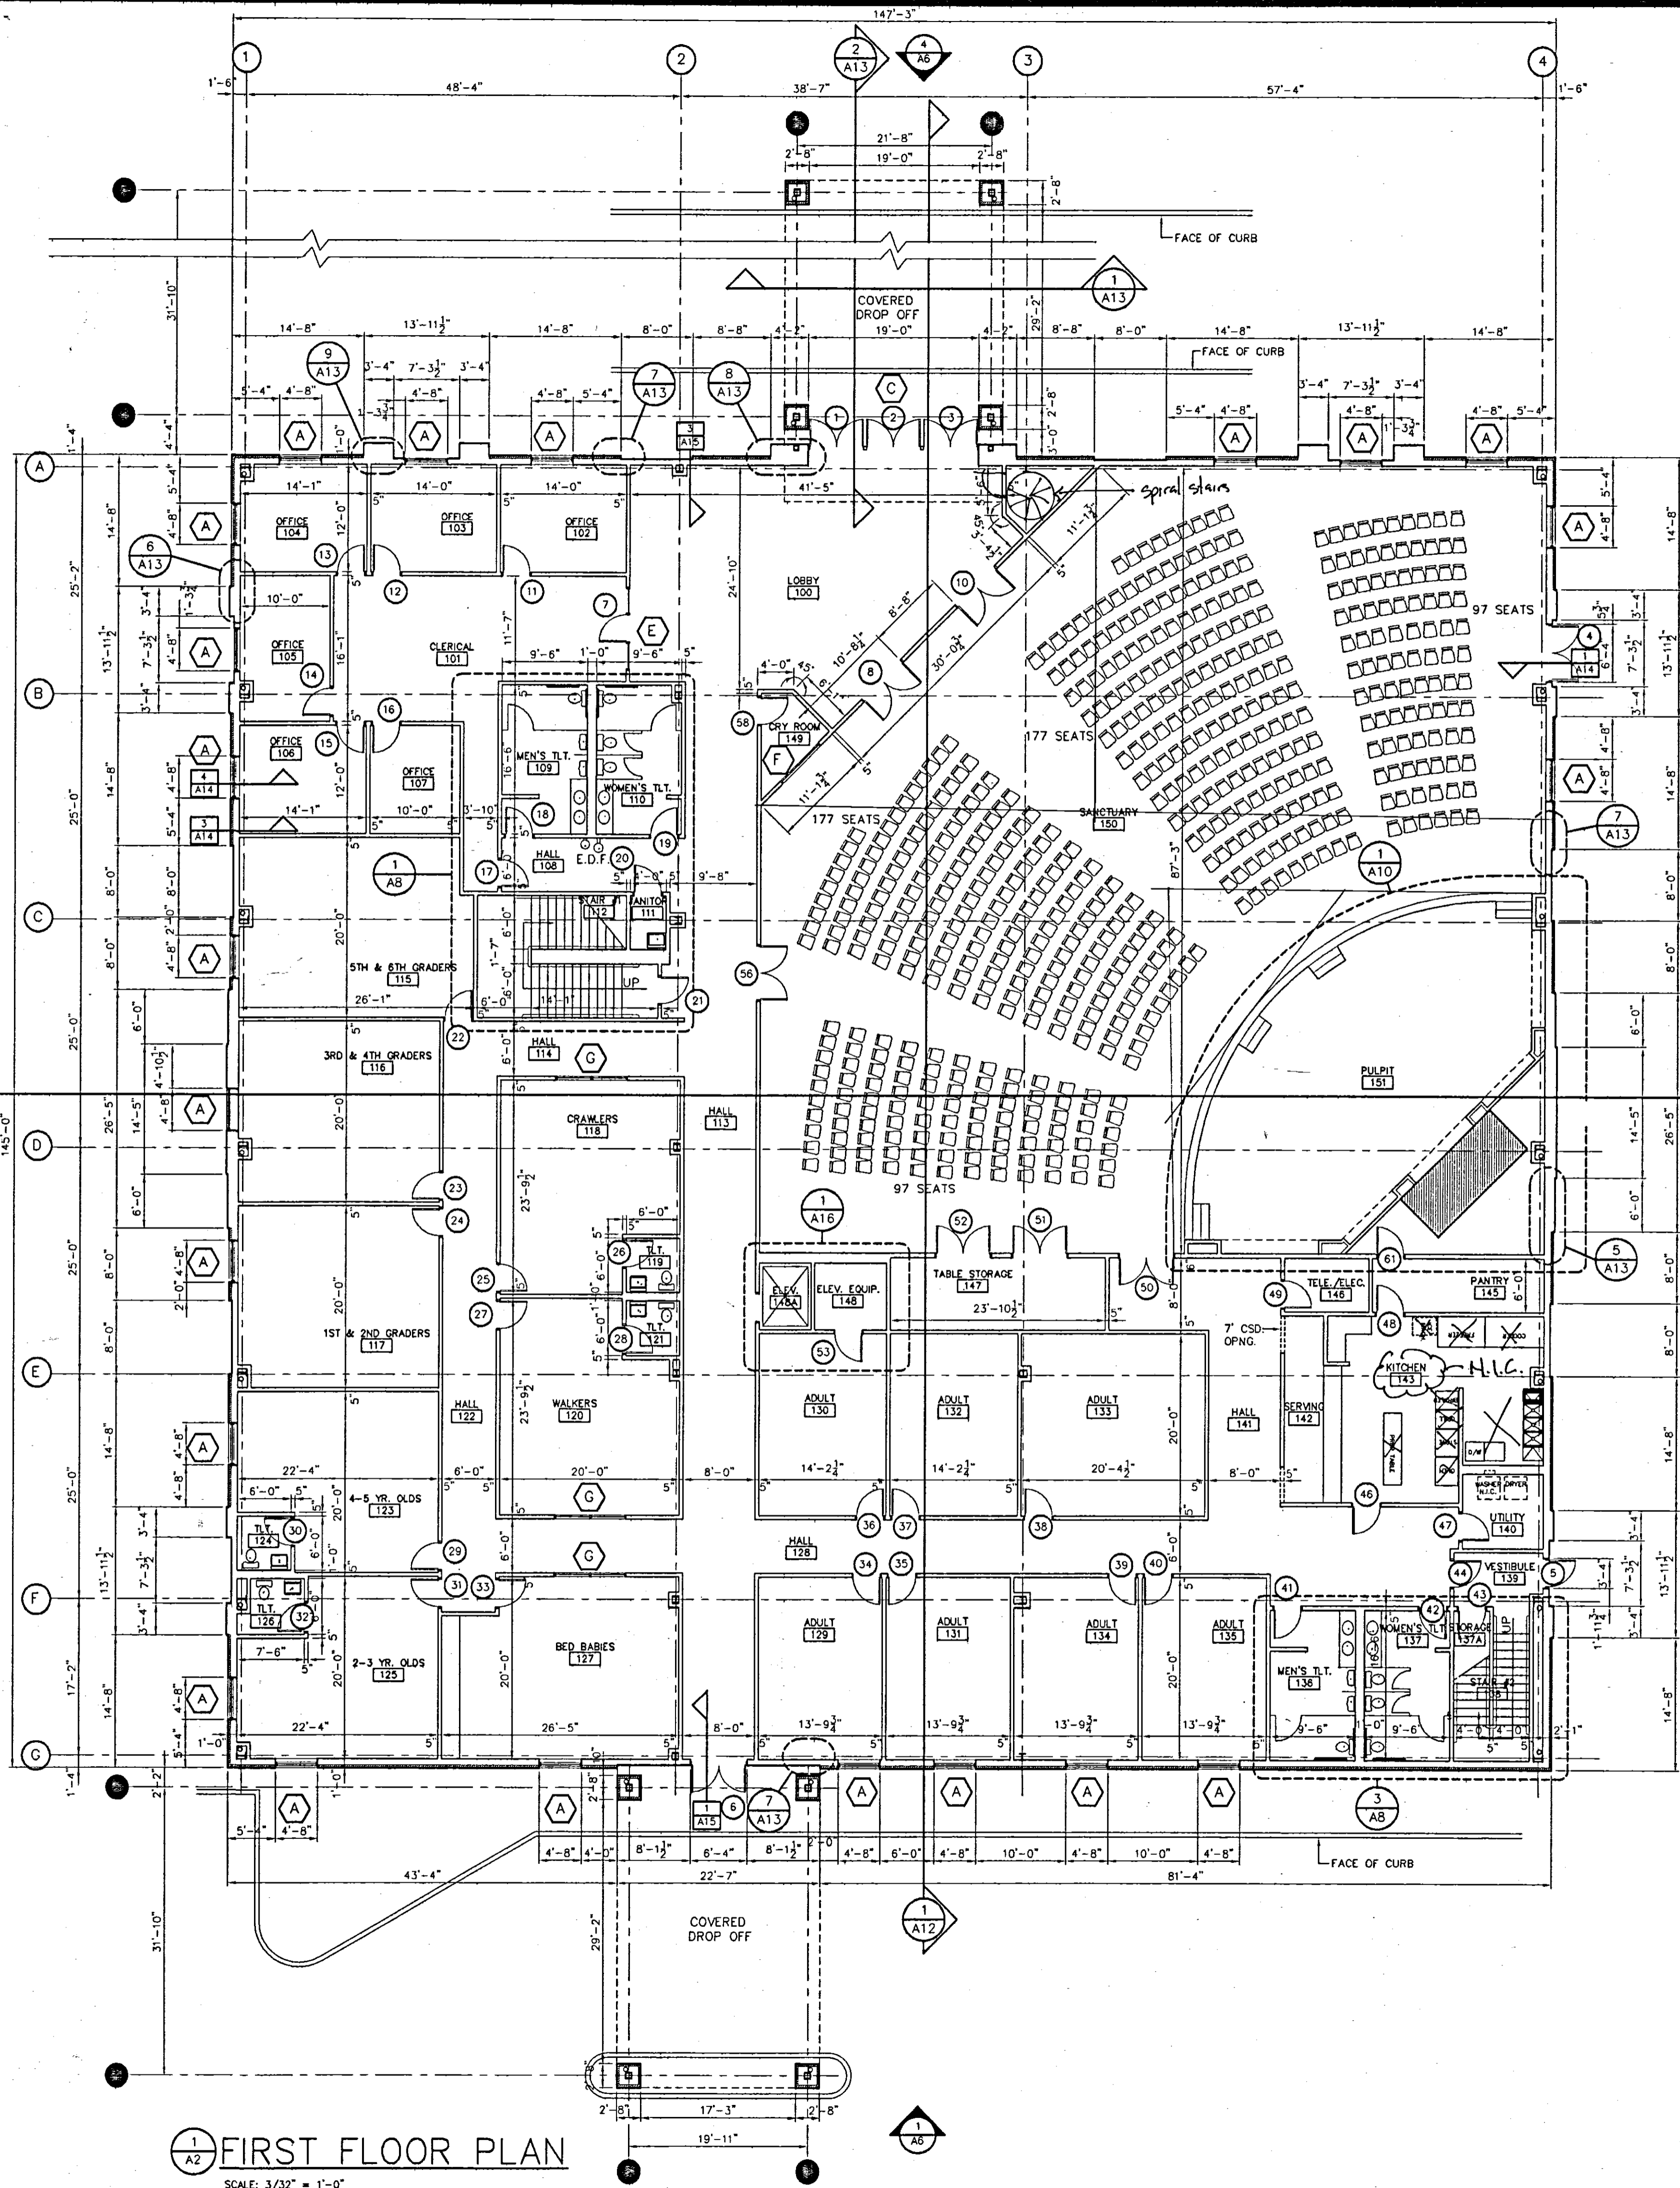

**FIRST FLOOR PLAN**  
SCALE: 3/32" = 1'-0"

**NOTES:**

1. CONTRACTOR TO FIELD VERIFY ALL CONDITIONS HEREIN AND NOTIFY THE ARCHITECT OF ANY DISCREPANCIES OR CONFLICTS WITHIN DOCUMENTS PRIOR TO BID AND CONSTRUCTION OR INSTALLATION.
2. CONTRACTOR IS TO COORDINATE SUBCONTRACTORS WORK SO AS NOT TO CONFLICT WITH GYP. BOARD FURRING, CEILINGS, STEEL BEAMS, BRACING, DUCTWORK, CONDUIT, ECT. VERIFY CLEARANCES REQUIRED BY ALL TRADES PRIOR TO WORK.
3. ALL EXTERIOR DIMENSIONS ARE TO FACE OF E.I.F.S. UNLESS OTHERWISE INDICATED.
4. F.E. ON PLANS REFER TO FIRE EXTINGUISHER WITH WALL MOUNTED BRACKET.
5. SQUARE FOOTAGES GIVEN HEREIN SHOULD BE VERIFIED AND ARE NOT INTENDED FOR BIDDING PURPOSES.
6. ALL INTERIOR FINISHES SHALL MEET OR EXCEED CHAPTER 8 SECTION 803 OF THE 2000 INTERNATIONAL BUILDING CODE.
7. CONTRACTOR IS TO COORDINATE ALL PERIMETER BUILDING SLAB WITH INTERFACE OF EXTERIOR SITE WORK. PROVIDE PROPER SEPARATION WITH EXPANSION JOINT FILLER AND SEALANT WHERE REQUIRED.
8. PROVIDE GYP. BD. FURRING AROUND COLUMNS WITH A MINIMUM DIMENSION.
9. INSTALL GYPSUM BOARD CONTROL JOINTS AS REQUIRED.
10. ALL EXTERIOR STUD WALLS TO HAVE HORIZONTAL BRACING AT 48" O.C. VERTICALLY.
11. EXTEND ALL GYP. BD. INTERIOR WALLS AND PARTITIONS UP 6" ABOVE ADJACENT CEILINGS UNLESS OTHERWISE INDICATED.
12. INSTALL 6" 14GA. STEEL STRAPPING OR 2X4 WOOD BLOCKING IN CHASE WALLS FOR ALL ACCESSORIES AND WHERE TOILET PARTITIONS ARE ANCHORED TO WALL.
13. FIRE SEAL BOTTOMS OF ALL RATED STUD/GYPSUM BOARD WALLS BEFORE BASE MATERIAL IS INSTALLED.

**DESIGN CONCEPT**

THE STRUCTURE OF THE BUILDING IS A PRE-ENGINEERED STEEL STRUCTURE. ALL COLUMNS, BEAMS AND ANY OTHER SUPPORTING STRUCTURE SHALL BE DESIGNED, SIZED AND SUPPLIED BY THE PRE-ENGINEERED MANUFACTURER. THE ARCHITECTURAL DRAWINGS SHOW COLUMNS AND BEAMS FOR DESIGN PURPOSES ONLY AND SHALL NOT BE USED FOR THE BUILDING STRUCTURE. ANY AND ALL STRUCTURE NOT SHOWN ON DRAWINGS SHALL BE PROVIDED BY THE PRE-ENGINEERED MANUFACTURER. THE CONTRACTOR SHALL PROVIDE TEMPORARY BRACING AS NEEDED FOR ERECTION UNTIL ALL STRUCTURAL ELEMENTS ARE INSTALLED. CONNECTIONS NOT SHOWN ON THE DRAWINGS SHALL BE DESIGNED BY THE FABRICATOR. PROVIDE # 4 CORNER BARS AT INTERSECTIONS OF GRADEBEAMS.


THE FOUNDATION DESIGN IS BASED ON SUBSURFACE EXPLORATION BY BURNS COOLEY DENNIS, INC. STRIP ALL TOPSOIL, VEGETATION, DEBRIS, ROOTS AND DELETERIOUS MATERIAL FROM UNDER BUILDING PAD AND WITHIN 5 FEET OUTSIDE BUILDING PAD. PROVIDE 7" OF SELECT FILL BETWEEN BOTTOM OF FOUNDATION AND NONEXPANSIVE SOILS.

**NOTES**


- ALL WORK SHALL CONFORM TO THE LATEST REQUIRMENTS OF ACI 318, CRSI AND THE STANDARD BUILDING CODE.
- ALL CONCRETE SHALL OBTAIN A 28 DAY STRENGTH OF 3,000 PSI.
- SUBMIT MIX DESIGN TO THE A/E FOR APPROVAL. THIS SUBMITTAL SHALL CONFORM TO SECTION 5.3 OF ACI 318-95 AND SECTION 1905 OF THE 2000 INTERNATIONAL BUILDING CODE. MIX DESIGN WILL NOT BE APPROVED WITHOUT BREAK DATA AS REQUIRED BY A/E. IF BREAK DATA IS NOT AVAILABLE INCREASE STRENGTH SHOWN ABOVE BY 1200.
- REINFORCING STEEL SHALL CONFORM TO ASTM A615 GRADE 60.
- WELDED WIRE FABRIC (WWF) SHALL CONFORM TO ASTM A185. SUPPORT WWF AT THE PROPER DEPTH PRIOR TO PLACING CONCRETE. PULLING UP WWF WHILE THE CONCRETE IS BEING PLACED WILL NOT BE ALLOWED. CMU OR CLAY BRICK SHALL NOT BE USED TO SUPPORT WWF.
- PULLING UP WWF WHILE THE CONCRETE IS BEING PLACED WILL NOT BE ALLOWED. CMU OR CLAY BRICK SHALL NOT BE USED TO SUPPORT WWF.

**NOTE**  
BUILDING STRUCTURE IS SHOWN ON THESE PLANS. BUILDING MANUFACTURER MAY REQUIRE MORE STRUCTURE THAN SHOWN. CONTRACTOR MUST COORDINATE STRUCTURE WITH PLANS. SOME MODIFICATIONS TO DETAILS MAY OCCURE. CONTRACTOR SHALL NOTIFY ARCHITECT OF ANY SUCH CHANGES.

REVISIONS BY

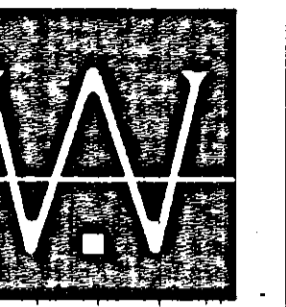

WOODRIDGE & ASSOCIATES  
105 CENTRAL AVENUE  
RIDGELAND, MS 39157  
601-858-6181 / 601-858-196 FAX

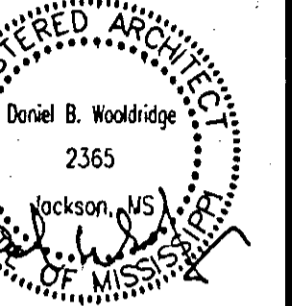


A New Building for  
**CHURCH OF THE HIGHLANDS**  
Ridgeland, Mississippi

THIS DESIGN IS THE COPYRIGHTED PROPERTY OF WOODRIDGE & ASSOCIATES. IT MAY NOT BE REPRODUCED FROM THIS DESIGN WITHOUT THE EXPRESS WRITTEN PERMISSION OF WOODRIDGE & ASSOCIATES.

DRAWN	24
CHECKED	
DATE	
SCALE	
JOB NO.	
SHEET	A2
OF SHEETS	



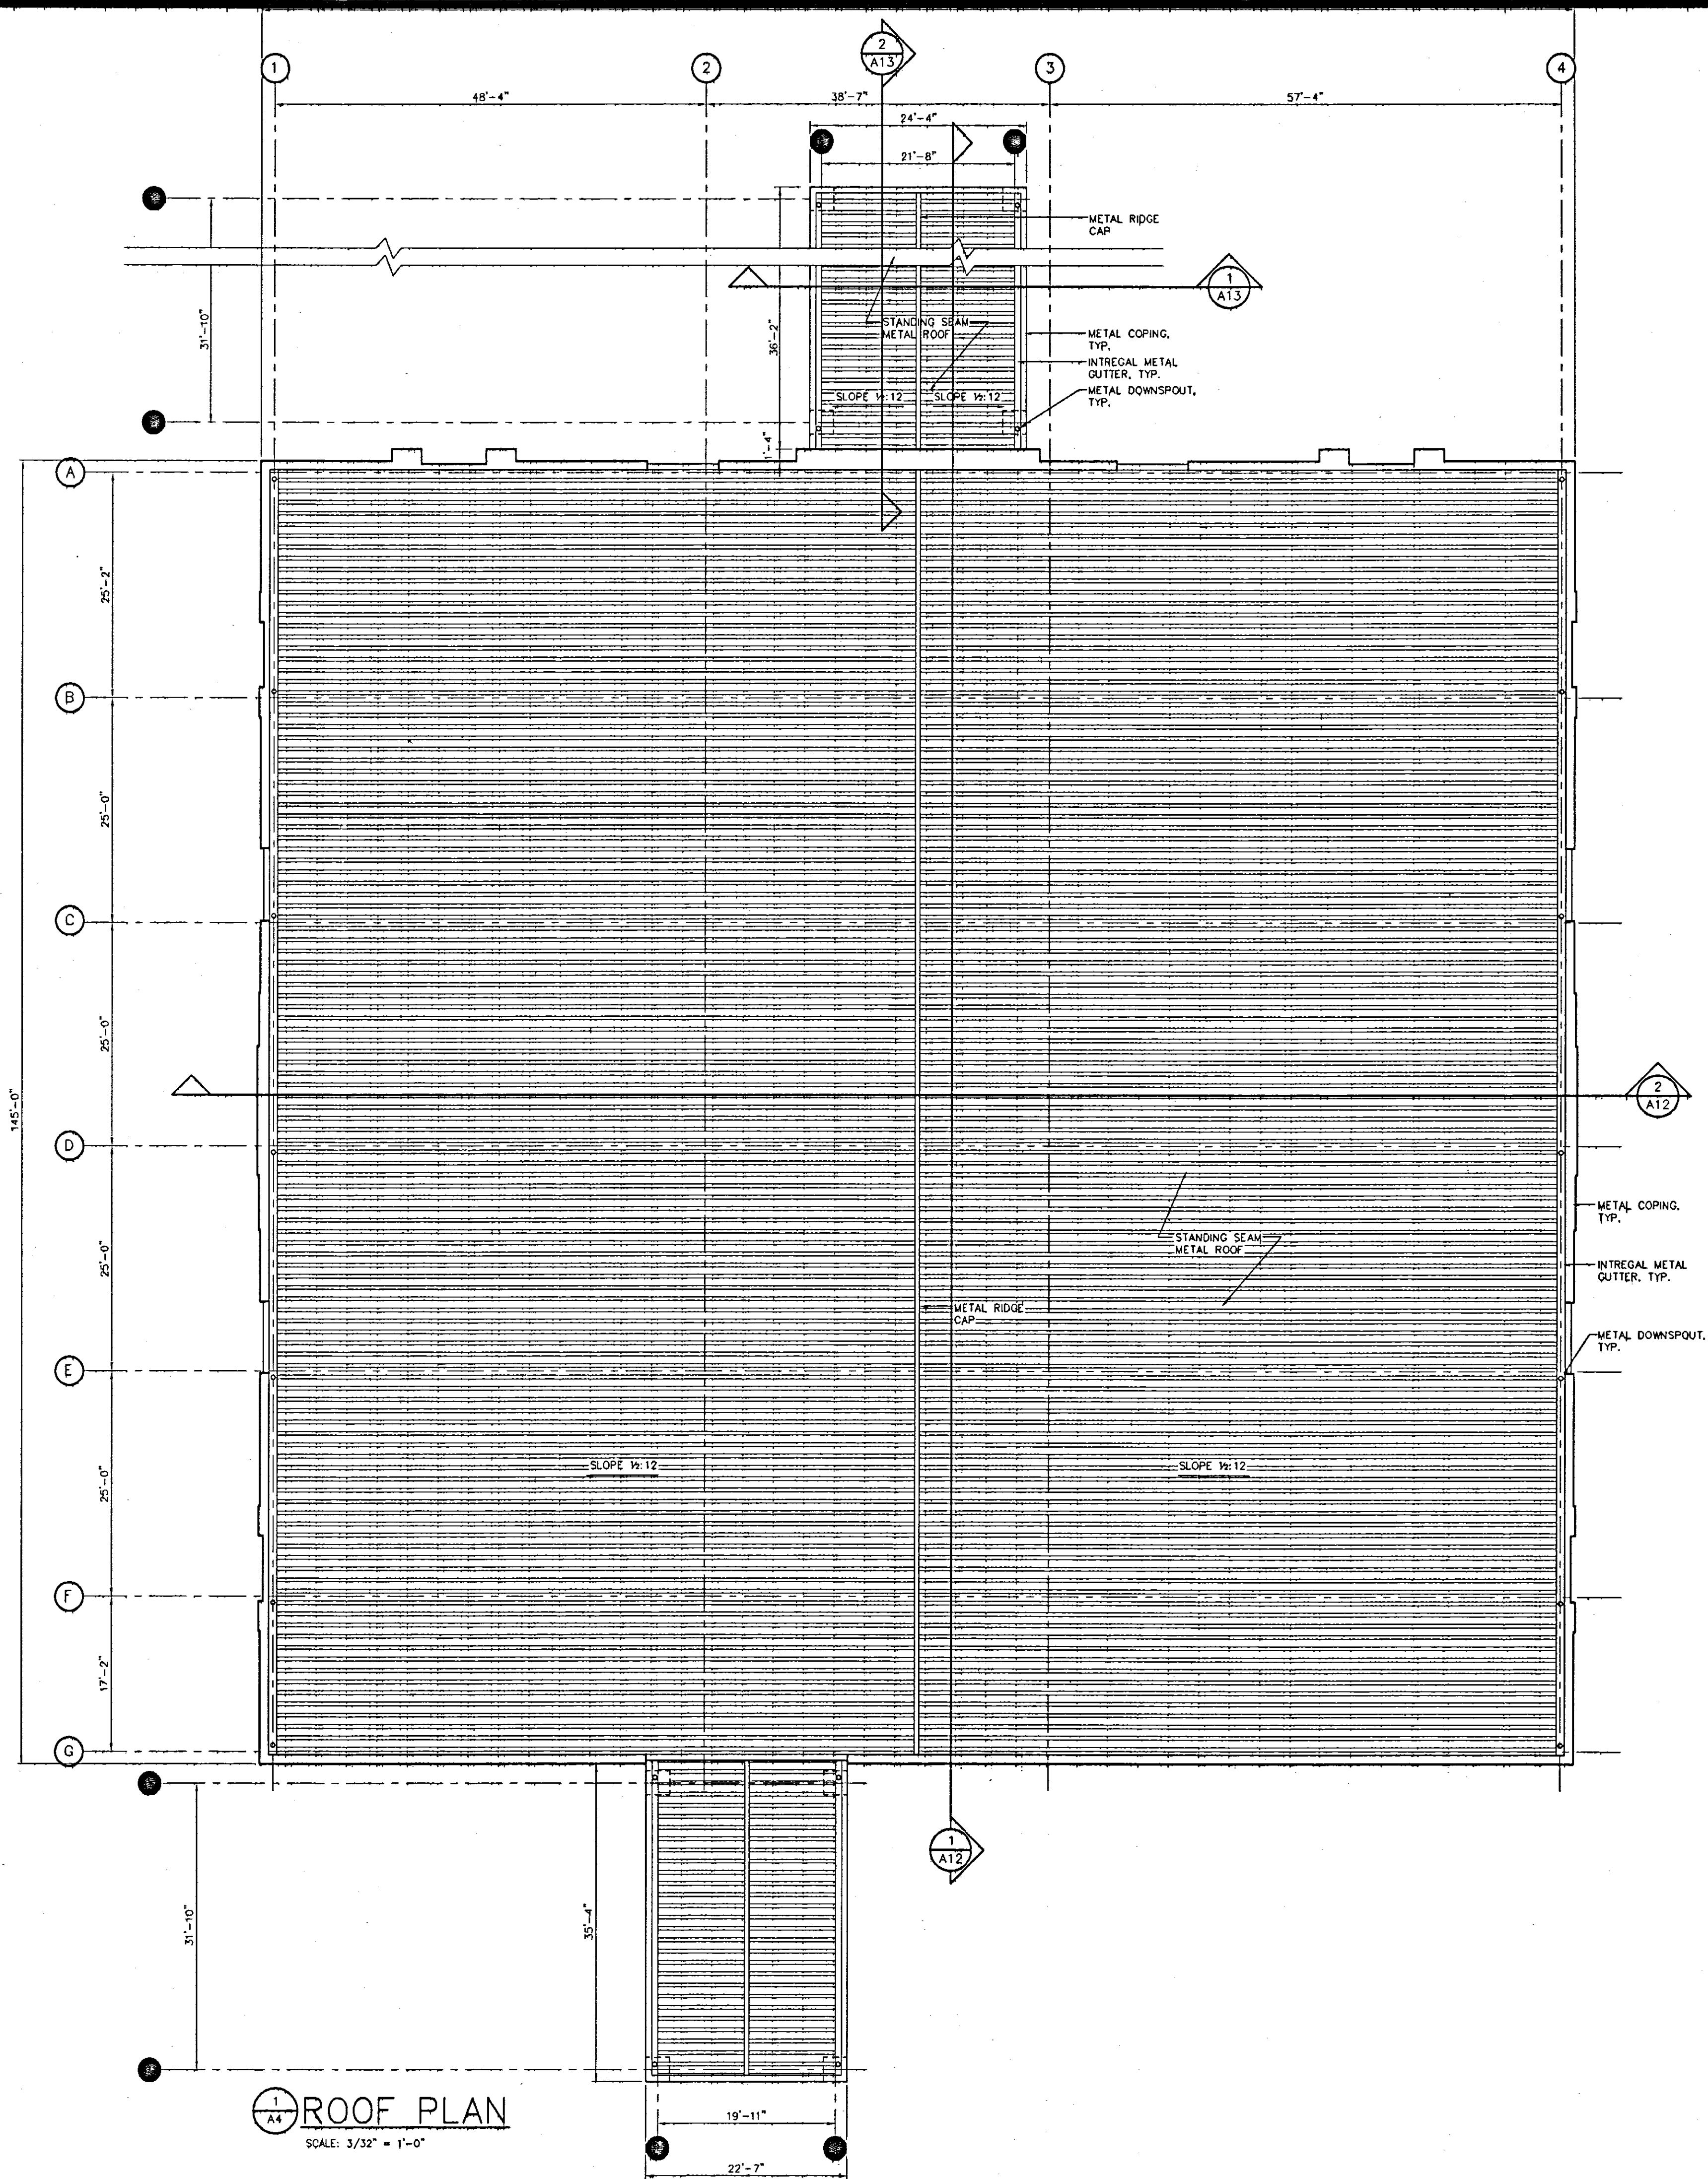

REVISIONS	BY

**W.A.**

WOOLDRIDGE & ASSOCIATES  
 105 CENTRAL AVENUE  
 RIDGELAND, MS 39157  
 601-856-8161 / 601-856-1266 FAX

REGISTERED ARCHITECT  
 Daniel B. Wooldridge  
 2865  
 State of Mississippi  
 6.12.07


A New Building for  
**CHURCH OF THE HIGHLANDS**  
 Ridgeland, Mississippi

THIS DESIGN IS THE COPYRIGHTED PROPERTY OF WOOLDRIDGE & ASSOCIATES. IT MAY NOT BE REPRODUCED FROM THIS DESIGN WITHOUT THE EXPRESS WRITTEN PERMISSION OF WOOLDRIDGE & ASSOCIATES.

	DOWN
	CHECKED
	DATE
	SCALE
	JOB NO.
	SHEET
	A4
	OF SHEETS




REVISIONS	BY

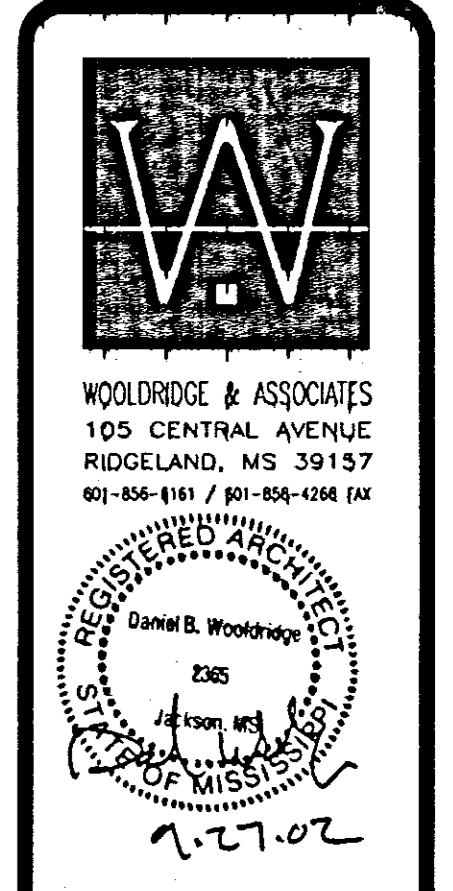


A New Building for  
**CHURCH OF THE HIGHLANDS**  
 Ridgeland, Mississippi

THIS DESIGN IS THE COPYRIGHTED PROPERTY OF WOOLDRIDGE & ASSOCIATES. IT MAY NOT BE REPRODUCED FROM THIS DESIGN WITHOUT THE EXPRESS WRITTEN PERMISSION OF WOOLDRIDGE & ASSOCIATES.


DRAWN	
CHECKED	
DATE	
SCALE	
JOB NO.	
SHEET	
A6	
OF	SHEETS

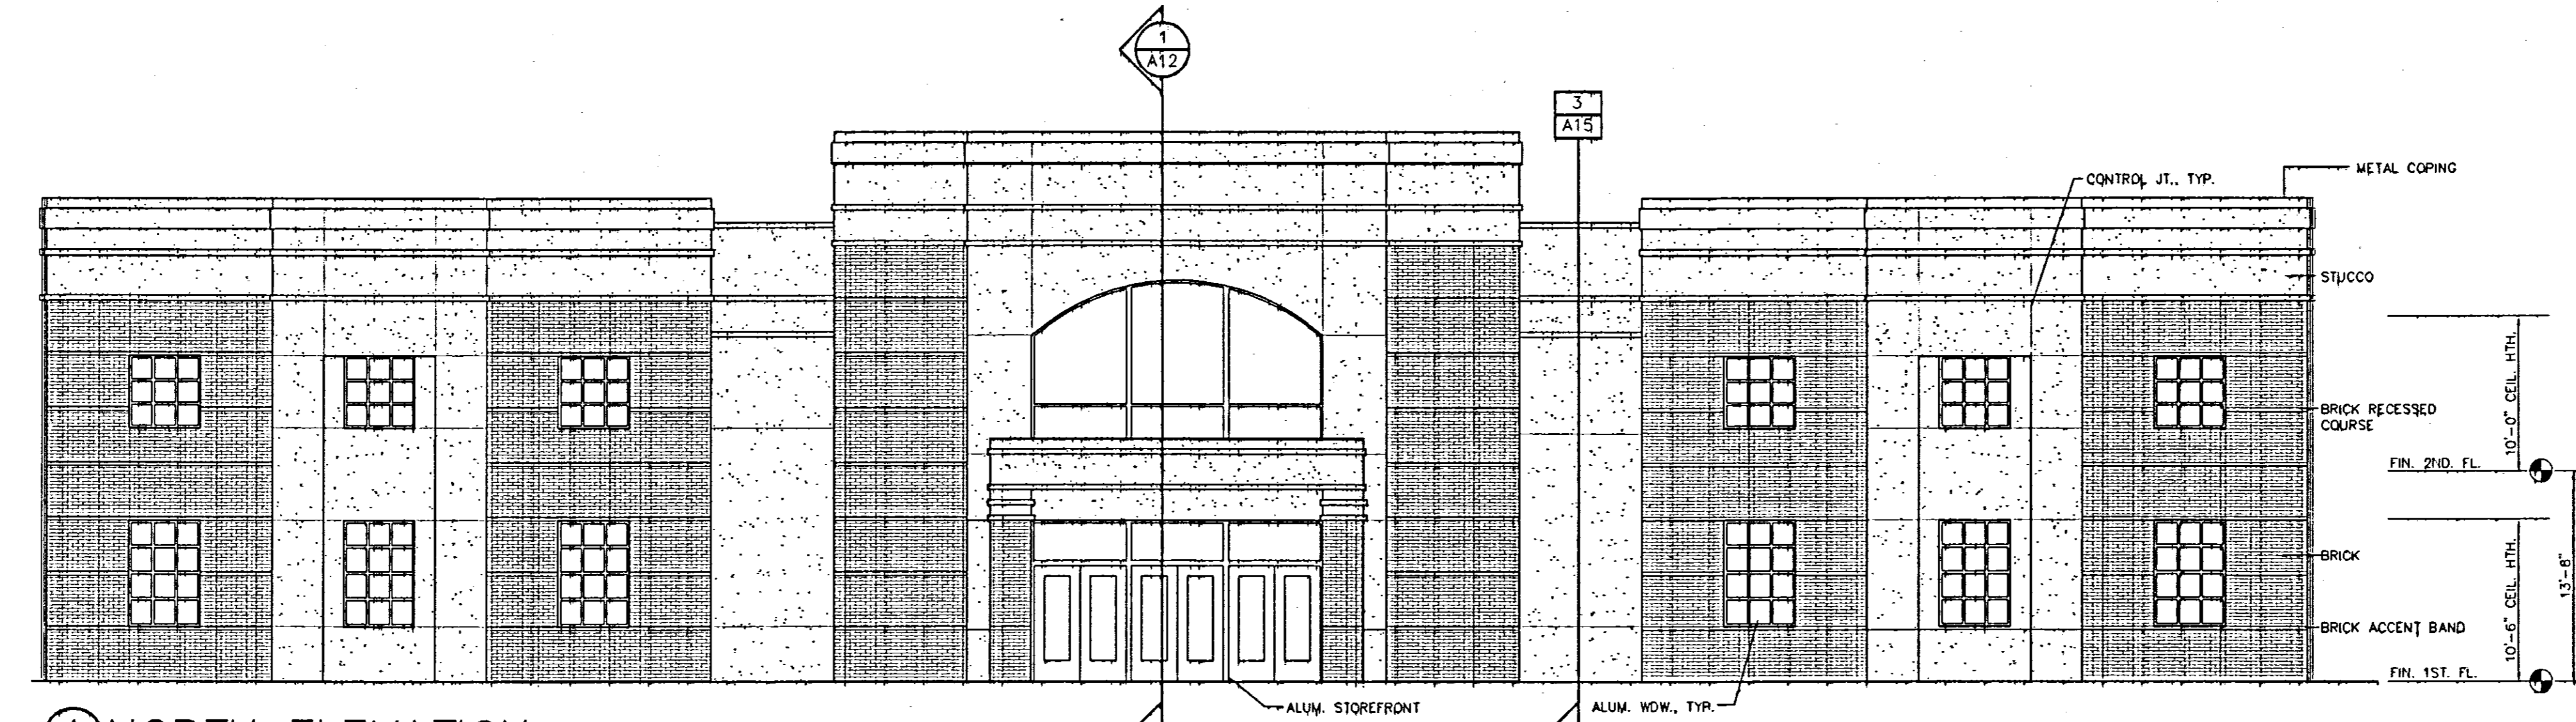


**1 NORTH ELEVATION**  
 SCALE: 1/8" = 1'-0"

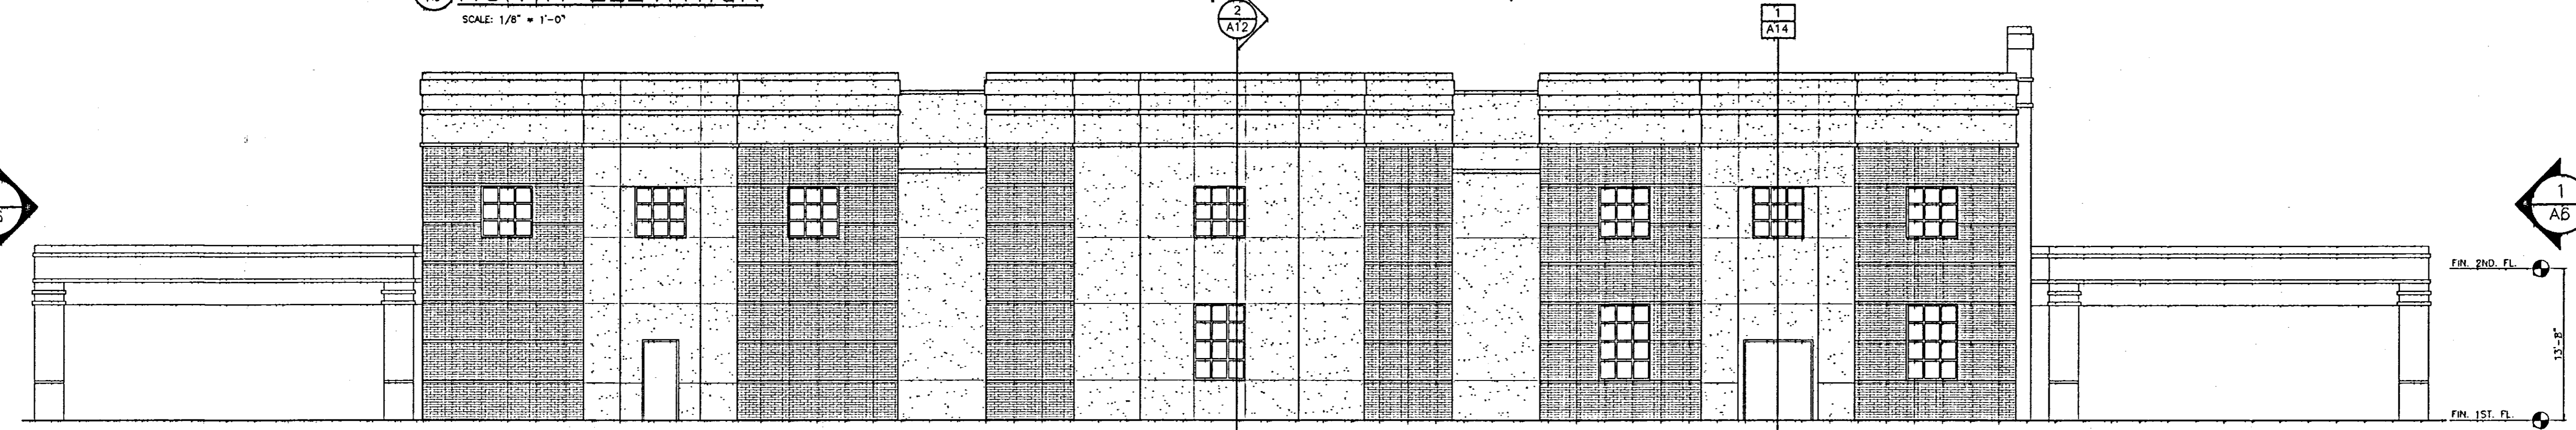

**2 EAST ELEVATION**  
 SCALE: 1/8" = 1'-0"

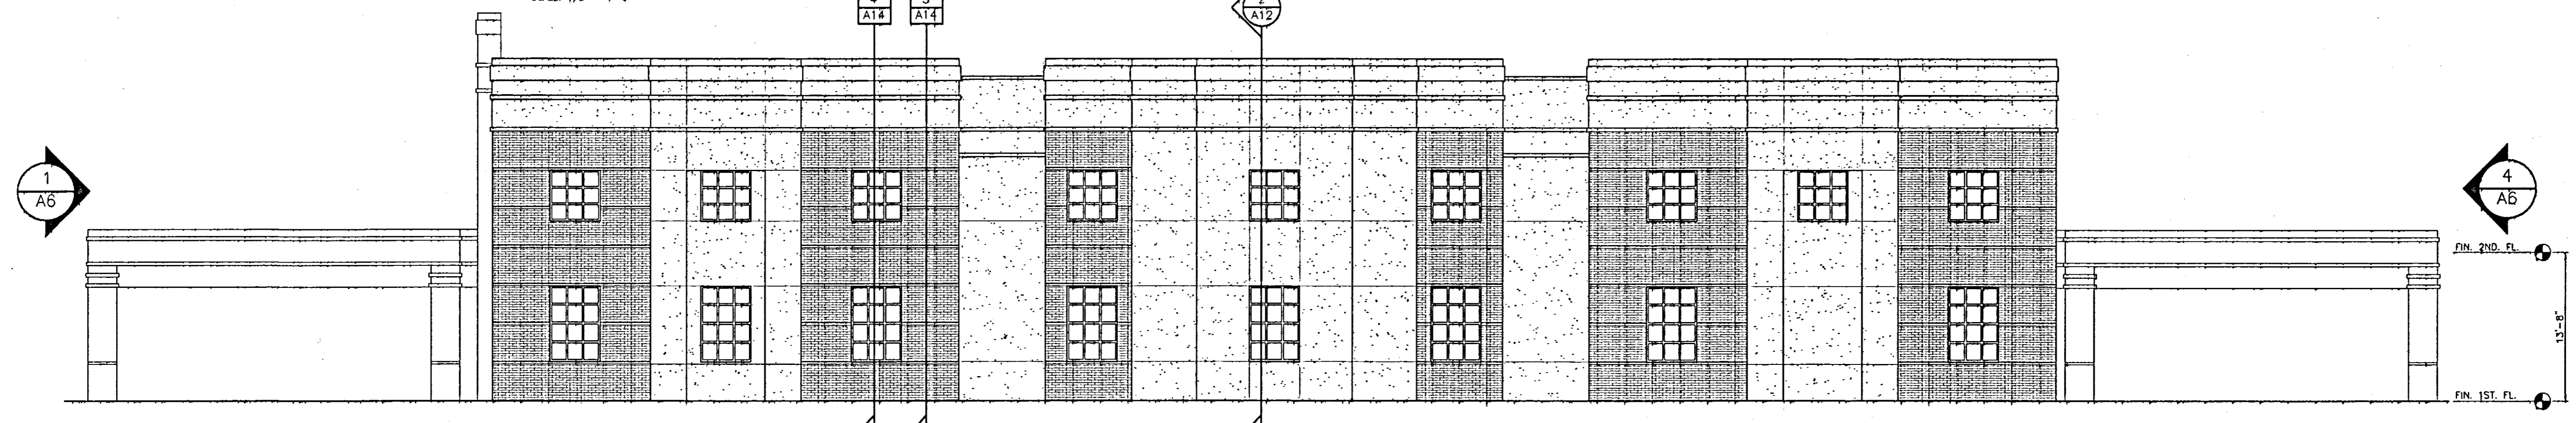

**3 WEST ELEVATION**  
 SCALE: 1/8" = 1'-0"

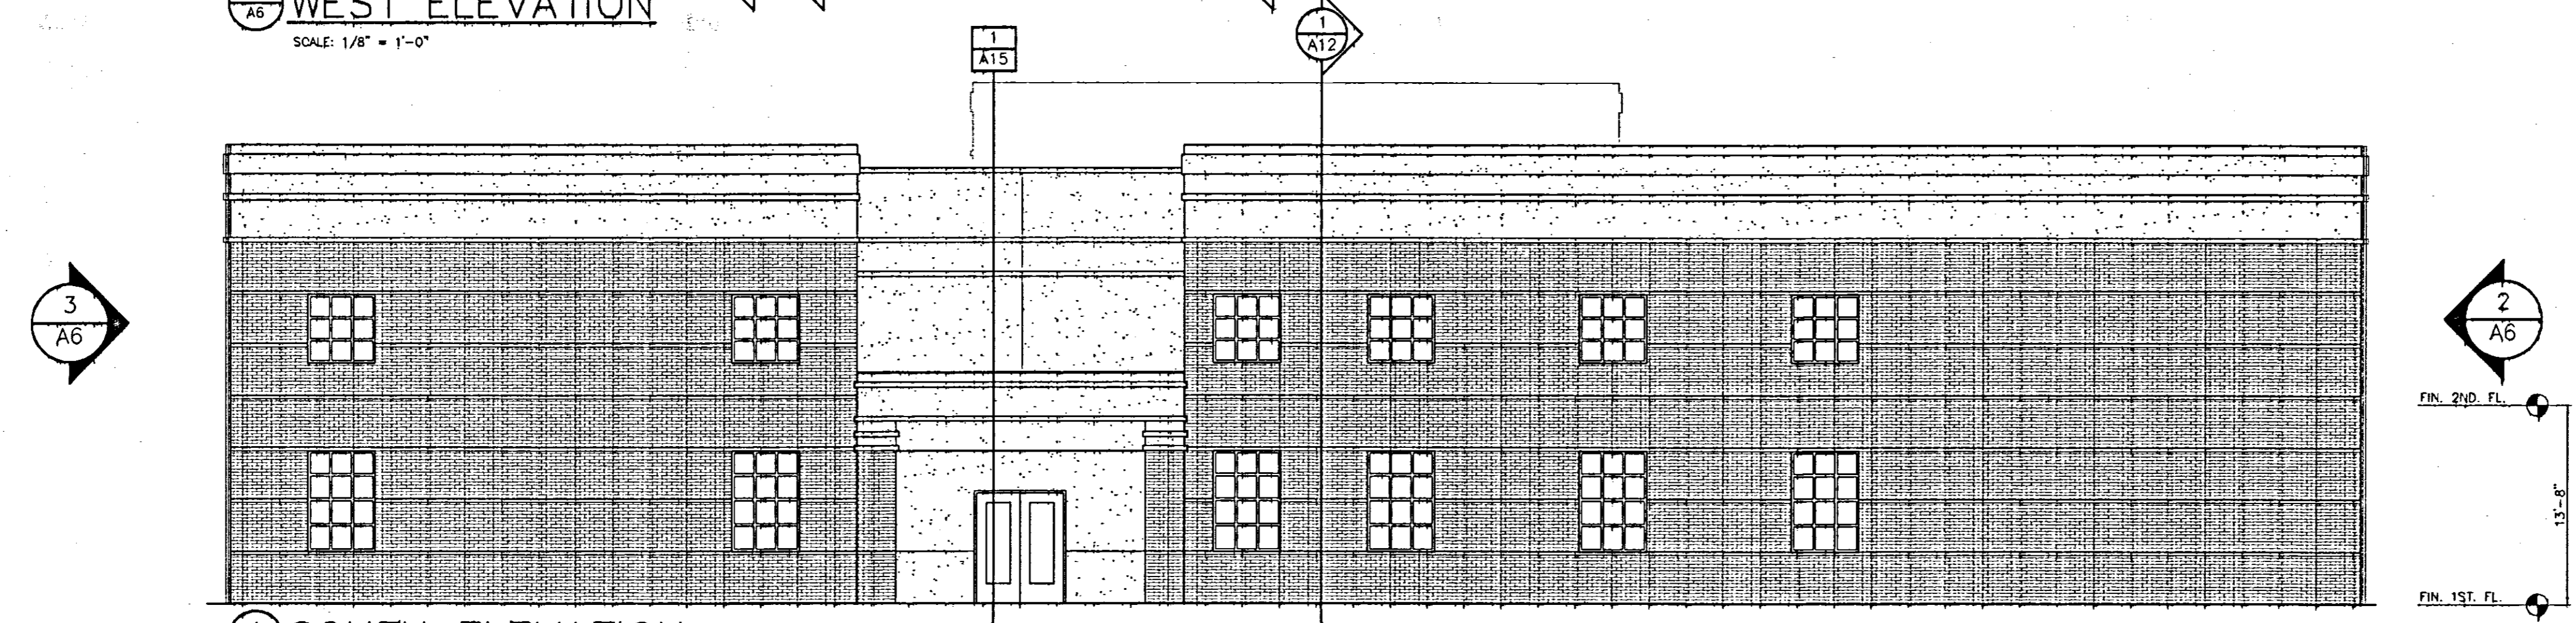

**4 SOUTH ELEVATION**  
 SCALE: 1/8" = 1'-0"

Woodriddle & Associates 6/15/2001 9:49 AM base sheet2.dwg


# DOOR SCHEDULE

DOOR NO.	DOOR SIZE			DOOR TYPE	MATERIALS		LABEL	REMARKS
	WIDTH	HEIGHT	THICK		DOOR	FRAME		
1	PR.3-0	7-6	1 1/4	1	WD./GL.	ALUM.		
2	PR.3-0	7-6	1 1/4	1	WD./GL.	ALUM.		
3	PR.3-0	7-6	1 1/4	1	WD./GL.	ALUM.		
4	PR.3-0	7-0	1 1/4	3	H.M.	H.M.		
5	3-0	7-0	1 1/4	2	H.M.	H.M.		
6	PR.3-0	7-6	1 1/4	1	WD./GL.	H.M.		
7	3-0	7-0	1 1/4	2	S.C. WOOD	ALUM.		
8	PR.3-0	7-0	1 1/4	5	S.C. WOOD	H.M.	45 MIN	
9	3-0	7-0	1 1/4	5	S.C. WOOD	H.M.	45 MIN	
10	3-0	7-0	1 1/4	5	S.C. WOOD	H.M.	45 MIN	
11	3-0	7-0	1 1/4	2	S.C. WOOD	H.M.		
12	3-0	7-0	1 1/4	2	S.C. WOOD	H.M.		
13	3-0	7-0	1 1/4	2	S.C. WOOD	H.M.		
14	3-0	7-0	1 1/4	2	S.C. WOOD	H.M.		
15	3-0	7-0	1 1/4	2	S.C. WOOD	H.M.		
16	3-0	7-0	1 1/4	2	S.C. WOOD	H.M.		
17	3-0	7-0	1 1/4	2	S.C. WOOD	H.M.		
18	3-0	7-0	1 1/4	2	S.C. WOOD	H.M.		
19	3-0	7-0	1 1/4	2	S.C. WOOD	H.M.		
20	3-0	7-0	1 1/4	2	S.C. WOOD	H.M.	45 MIN	
21	3-0	7-0	1 1/4	6	S.C. WOOD	H.M.	45 MIN	
22	3-0	7-0	1 1/4	4	S.C. WOOD	H.M.		
23	3-0	7-0	1 1/4	4	S.C. WOOD	H.M.		
24	3-0	7-0	1 1/4	4	S.C. WOOD	H.M.		
25	3-0	7-0	1 1/4	4	S.C. WOOD	H.M.		
26	3-0	7-0	1 1/4	2	S.C. WOOD	H.M.		
27	3-0	7-0	1 1/4	4	S.C. WOOD	H.M.		
28	3-0	7-0	1 1/4	2	S.C. WOOD	H.M.		
29	3-0	7-0	1 1/4	4	S.C. WOOD	H.M.		
30	3-0	7-0	1 1/4	2	S.C. WOOD	H.M.		
31	3-0	7-0	1 1/4	4	S.C. WOOD	H.M.		
32	3-0	7-0	1 1/4	2	S.C. WOOD	H.M.		
33	3-0	7-0	1 1/4	4	S.C. WOOD	H.M.		
34	3-0	7-0	1 1/4	4	S.C. WOOD	H.M.		
35	3-0	7-0	1 1/4	4	S.C. WOOD	H.M.		
36	3-0	7-0	1 1/4	4	S.C. WOOD	H.M.		
37	3-0	7-0	1 1/4	4	S.C. WOOD	H.M.		
38	3-0	7-0	1 1/4	4	S.C. WOOD	H.M.		
39	3-0	7-0	1 1/4	4	S.C. WOOD	H.M.		
40	3-0	7-0	1 1/4	4	S.C. WOOD	H.M.		
41	3-0	7-0	1 1/4	2	S.C. WOOD	H.M.		
42	3-0	7-0	1 1/4	2	S.C. WOOD	H.M.		
43	3-0	7-0	1 1/4	2	S.C. WOOD	H.M.	45 MIN	
44	3-0	7-0	1 1/4	6	S.C. WOOD	H.M.	45 MIN	
45	PR.2-6	7-0	1 1/4	3	S.C. WOOD	H.M.		
46	3-0	7-0	1 1/4	2	S.C. WOOD	H.M.		
47	3-0	7-0	1 1/4	2	S.C. WOOD	H.M.		
48	3-0	7-0	1 1/4	2	S.C. WOOD	H.M.		
49	3-0	7-0	1 1/4	2	S.C. WOOD	H.M.		
50	PR.3-0	7-0	1 1/4	3	S.C. WOOD	H.M.	45 MIN	

DOOR NO.	DOOR SIZE			DOOR TYPE	MATERIALS		LABEL	REMARKS
	WIDTH	HEIGHT	THICK		DOOR	FRAME		
51	PR.3-0	7-0	1 1/4	3	S.C. WOOD	H.M.	45 MIN	
52	PR.3-0	7-0	1 1/4	3	S.C. WOOD	H.M.	45 MIN	
53	3-0	7-0	1 1/4	2	S.C. WOOD	H.M.		
54	3-0	7-0	1 1/4	2	S.C. WOOD	H.M.	45 MIN	
55	PR.3-0	7-0	1 1/4	3	S.C. WOOD	H.M.	45 MIN	
56	PR.3-0	7-0	1 1/4	3	S.C. WOOD	H.M.	45 MIN	
57	PR.3-0	7-0	1 1/4	3	S.C. WOOD	H.M.	45 MIN	
58	3-0	7-0	1 1/4	2	S.C. WOOD	H.M.	45 MIN	
59	3-0	7-0	1 1/4	2	S.C. WOOD	H.M.		
60	3-0	7-0	1 1/4	2	S.C. WOOD	H.M.		
61	2-8	7-0	1 1/4	2	S.C. WOOD	H.M.		
62	3-0	7-0	1 1/4	2	S.C. WOOD	H.M.		
63	PR.3-0	7-0	1 1/4	3	S.C. WOOD	H.M.	45 MIN	
64	3-0	7-0	1 1/4	2	S.C. WOOD	H.M.		
65	3-0	7-0	1 1/4	2	S.C. WOOD	H.M.		
66	PR.2-6	7-0	1 1/4	3	S.C. WOOD	H.M.		
67	3-0	7-0	1 1/4	6	S.C. WOOD	H.M.	45 MIN	
68	PR.3-0	7-0	1 1/4	3	S.C. WOOD	H.M.		
69	PR.3-0	7-0	1 1/4	3	S.C. WOOD	H.M.		
70	3-0	7-0	1 1/4	2	S.C. WOOD	H.M.		
71	3-0	7-0	1 1/4	2	S.C. WOOD	H.M.		
72	3-0	7-0	1 1/4	6	S.C. WOOD	H.M.	45 MIN	
73	PR.3-0	7-0	1 1/4	3	S.C. WOOD	H.M.	45 MIN	
74	PR.3-0	7-0	1 1/4	3	S.C. WOOD	H.M.	45 MIN	


FINISH NOTES:  
 1. ALL INTERIOR FINISHES SHALL MEET OR EXCEED CHAPTER 8 SECTION 803 OF THE STANDARD BUILDING CODE 2000 EDITION.  
 2. ALL WET AREAS SHALL HAVE A FINISHED SURFACE THAT IS NON-ABSORBENT.  
 3. PAINT TO HAVE AN A CLASSIFICATION, FLAME SPREAD AND SMOKE DEVELOPMENT INDEXES TO COMPLY WITH SECTION 803.4, STANDARD BUILDING CODE, 2000 EDITION.

## ALUMINUM WINDOW & STOREFRONT SCHEDULE

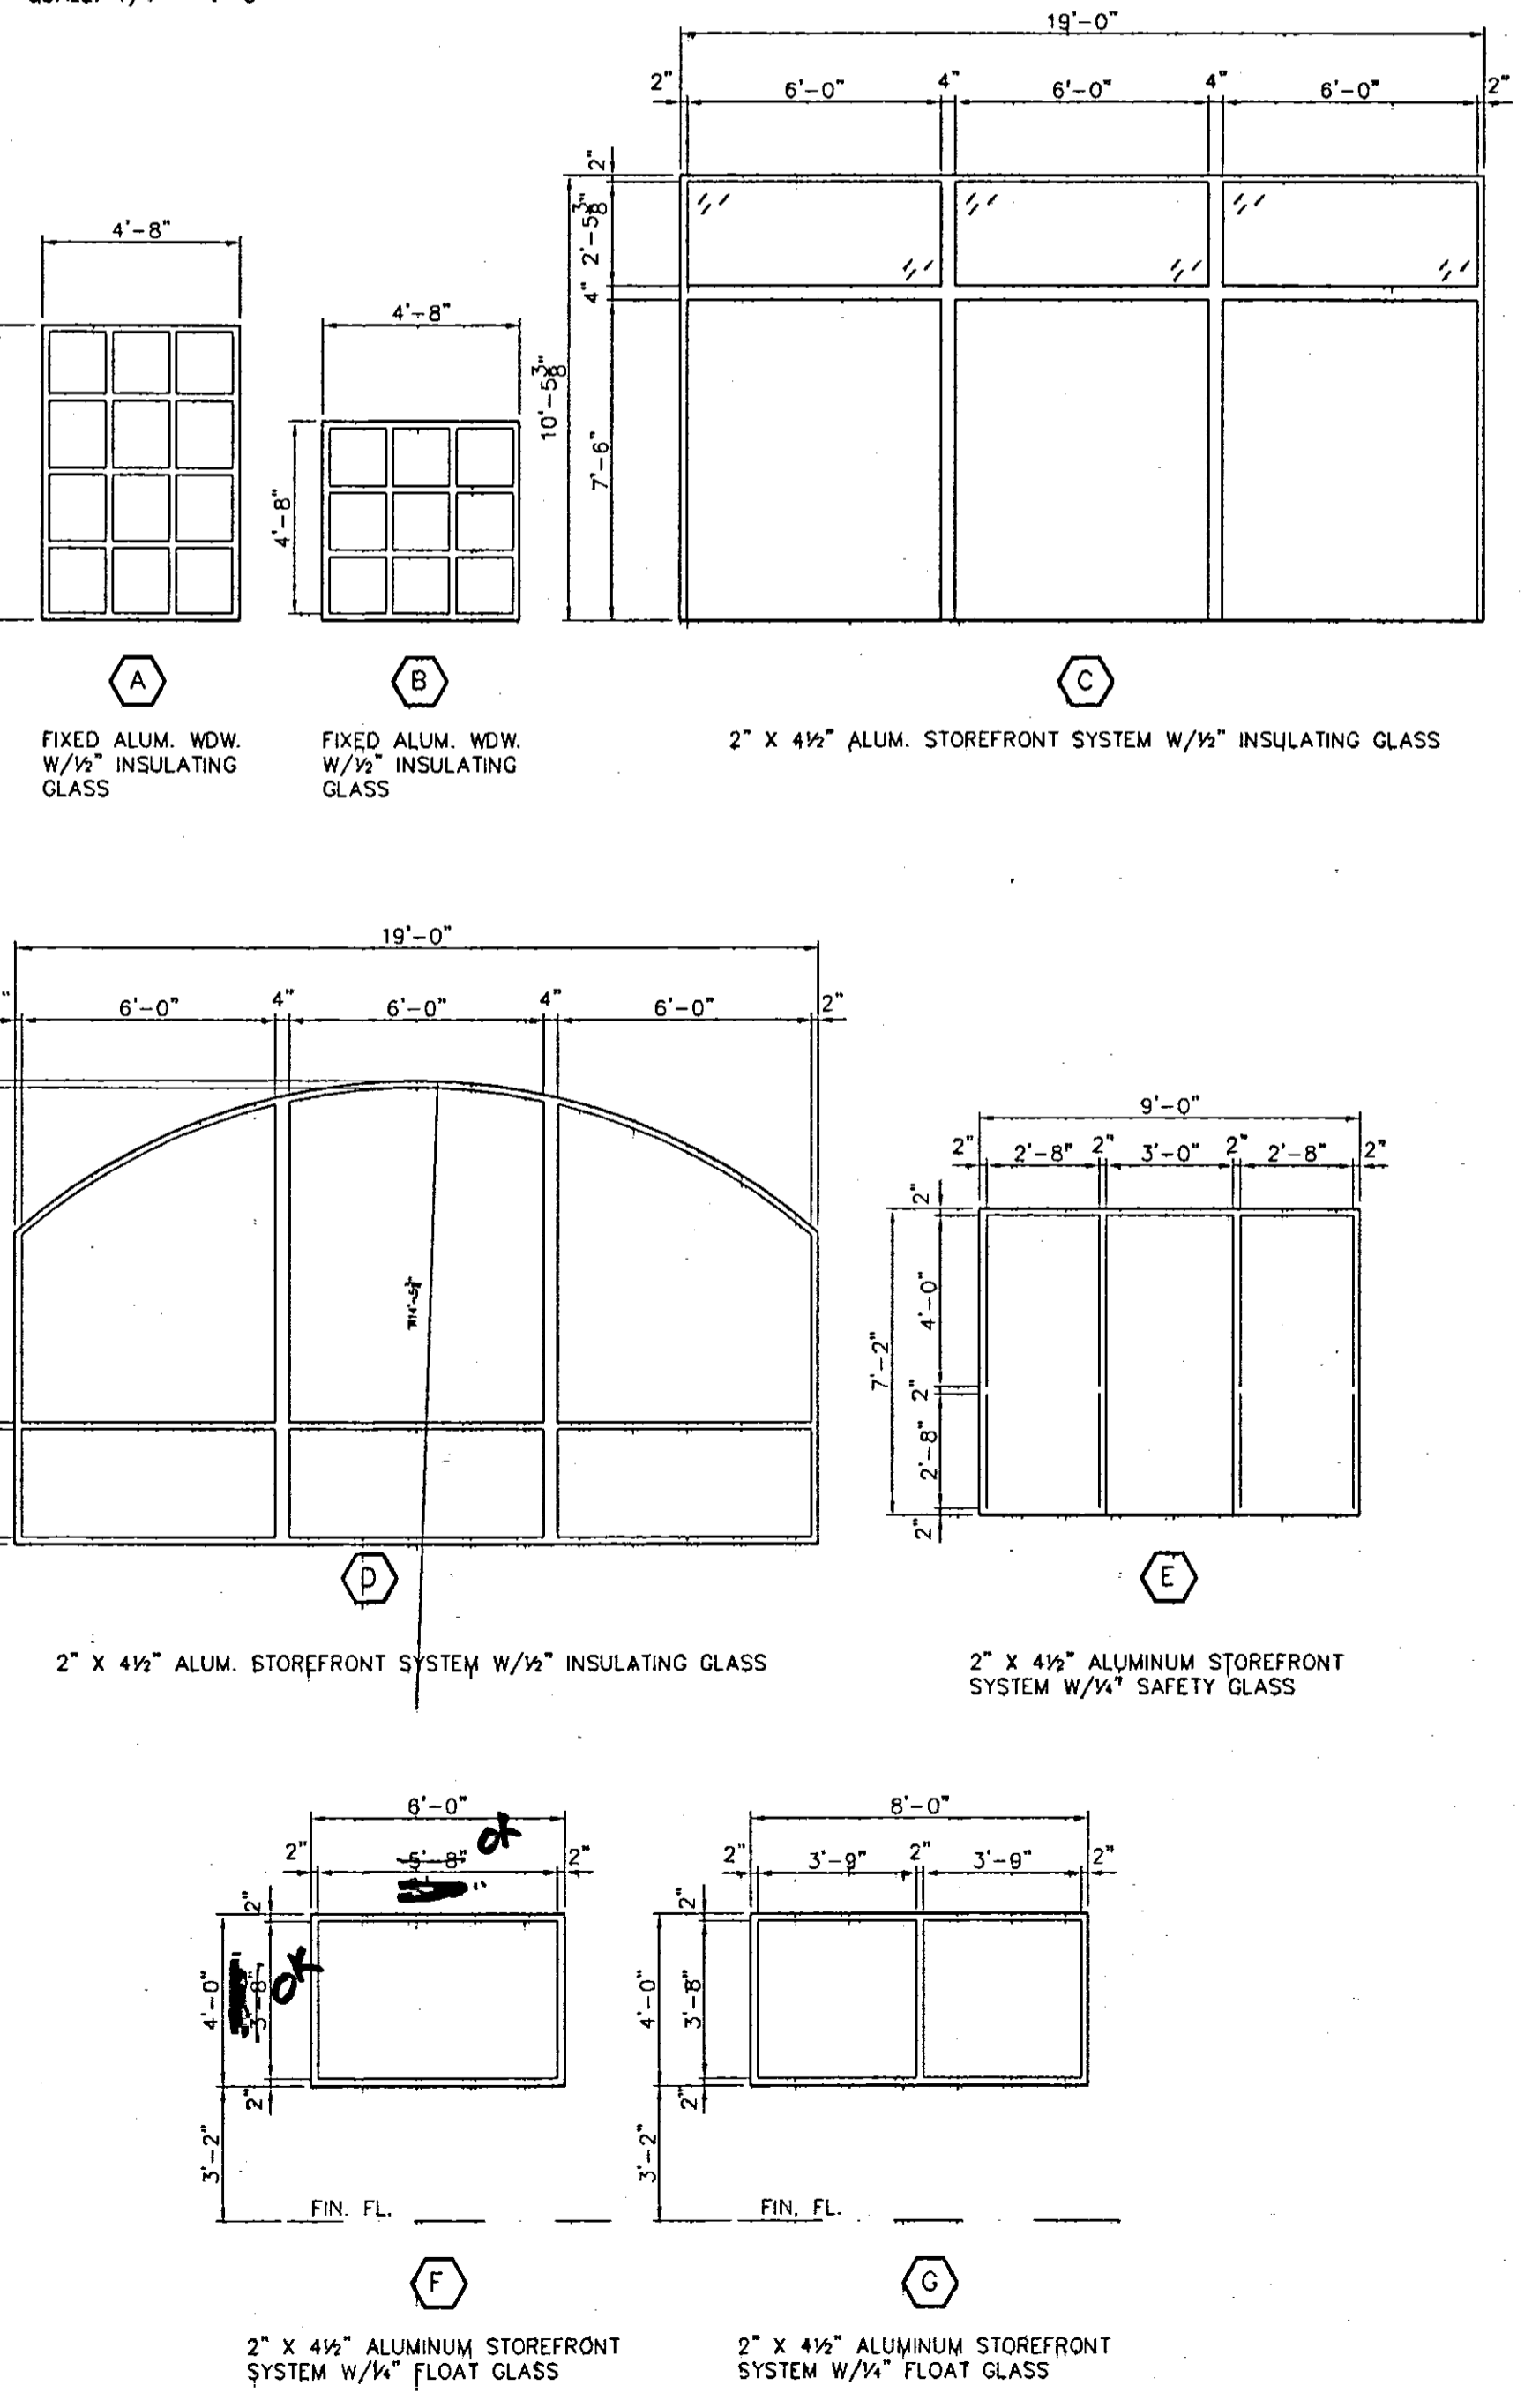

DOOR SCHEDULE ABBREVIATIONS:  
 ALUM. ALUMINUM  
 H.M. HOLLOW METAL  
 S.C. WOOD SOLID CORE WOOD  
 WD./GL. WOOD/GLASS

## DOOR TYPES

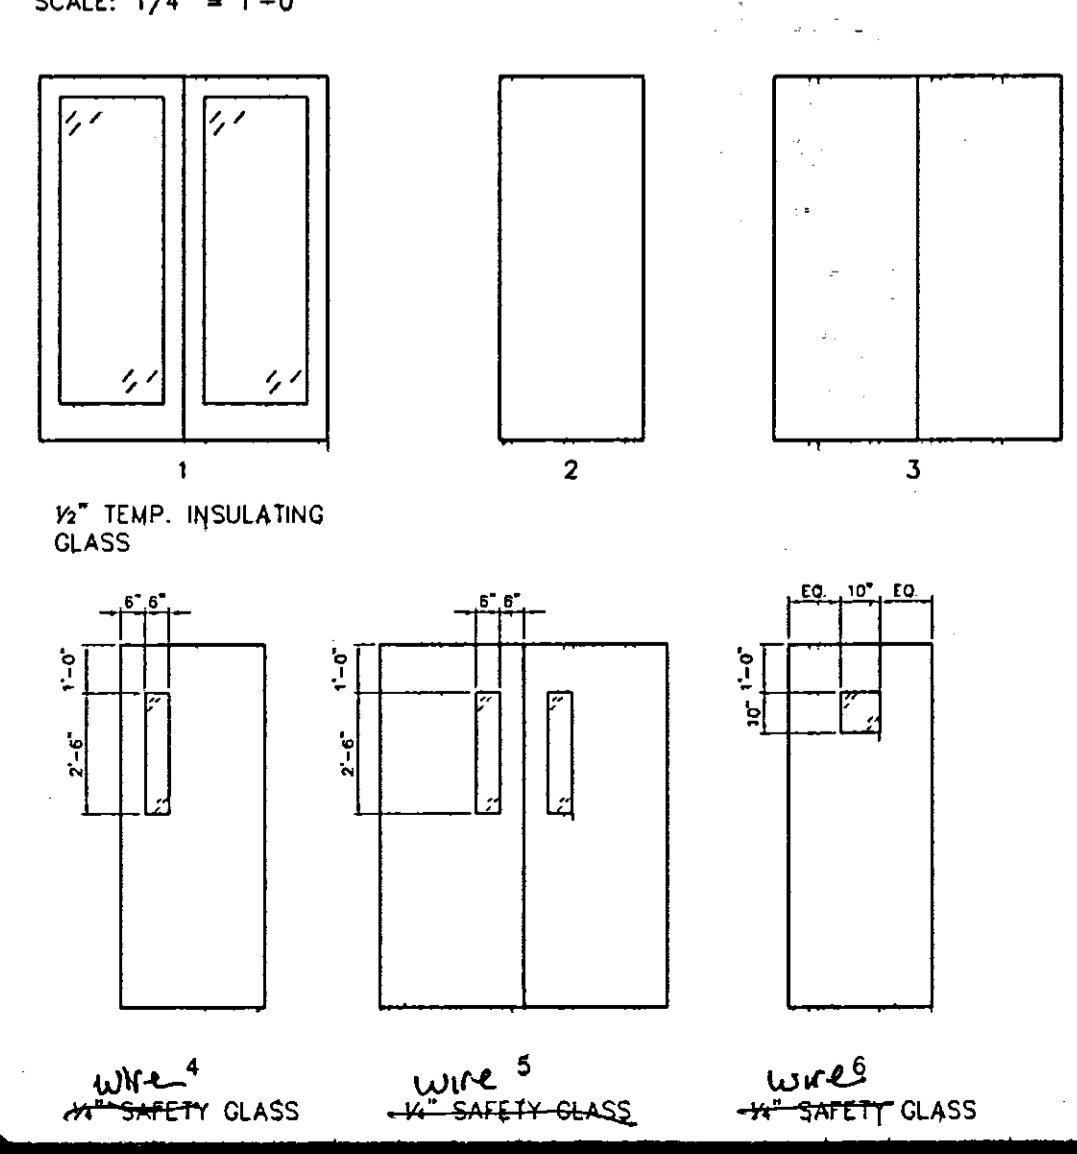


# ROOM FINISH SCHEDULE

ROOM #	ROOM NAME	FLOOR	BASE	WALLS	CEILING	CEILING HEIGHT	REMARKS
				MATERIAL/FINISH			
100	LOBBY		CERAMIC TILE	1 X 6 WOOD	GYP. BD.-PAINT	2 X 2 L.A.T.	10'-6"
101	CLERICAL		CARPET	6" RUBBER	GYP. BD.-PAINT	2 X 4 L.A.T.	9'-0"
102	OFFICE		CARPET	6" RUBBER	GYP. BD.-PAINT	2 X 4 L.A.T.	9'-0"
103	OFFICE		CARPET	6" RUBBER	GYP. BD.-PAINT	2 X 4 L.A.T.	9'-0"
104	OFFICE		CARPET	6" RUBBER	GYP. BD.-PAINT	2 X 4 L.A.T.	9'-0"
105	OFFICE		CARPET	6" RUBBER	GYP. BD.-PAINT	2 X 4 L.A.T.	9'-0"
106	OFFICE		CARPET	6" RUBBER	GYP. BD.-PAINT	2 X 4 L.A.T.	9'-0"
107	OFFICE		CARPET	6" RUBBER	GYP. BD.-PAINT	2 X 4 L.A.T.	9'-0"
108	HALL		CARPET	6" RUBBER	GYP. BD.-PAINT	2 X 2 L.A.T.	9'-0"
109	MEN'S TL.		CERAMIC TILE	6" CERAMIC	CER. TILE / GYP. BD.-V.W.C.	2 X 4 L.A.T.	9'-0" MOISTURE RESISTANT GYP. BD. & L.A.T. 4" CERAMIC TILE WAINSCOT
110	WOMEN'S TL.		CERAMIC TILE	6" CERAMIC	CER. TILE / GYP. BD.-V.W.C.	2 X 4 L.A.T.	9'-0" MOISTURE RESISTANT GYP. BD. & L.A.T. 4" CERAMIC TILE WAINSCOT
111	JANITOR		V.C.T.	6" RUBBER	GYP. BD.-PAINT	GYP. BD.	9'-0" MOISTURE RESISTANT GYP. BD.
112	STAIR #1		CARPET	6" RUBBER	GYP. BD.-PAINT	GYP. BD.	23'-8"
113	HALL		CARPET	6" RUBBER	GYP. BD.-PAINT	2 X 2 L.A.T.	10'-6"
114	HALL		CARPET	6" RUBBER	GYP. BD.-PAINT	2 X 2 L.A.T.	10'-6"
115	5TH & 6TH GRADERS		CARPET	6" RUBBER	GYP. BD.-PAINT	2 X 4 L.A.T.	10'-6"
116	JRD & 4TH GRADERS		CARPET	6" RUBBER	GYP. BD.-PAINT	2 X 4 L.A.T.	10'-6"
117	1ST & 2ND GRADERS		CARPET	6" RUBBER	GYP. BD.-PAINT	2 X 4 L.A.T.	10'-6"
118	CRAWLERS		CARPET	6" RUBBER	GYP. BD.-PAINT	2 X 4 L.A.T.	10'-6"
119	TLT.		CERAMIC TILE	6" CERAMIC	CER. TILE / GYP. BD.-PAINT	2 X 4 L.A.T.	9'-0" MOISTURE RESISTANT GYP. BD. & L.A.T. 4" CERAMIC TILE WAINSCOT
120	WALKERS		CARPET	6" RUBBER	GYP. BD.-PAINT	2 X 4 L.A.T.	10'-6"
121	TLT.		CERAMIC TILE	6" CERAMIC	CER. TILE / GYP. BD.-PAINT	2 X 4 L.A.T.	9'-0" MOISTURE RESISTANT GYP. BD. & L.A.T. 4" CERAMIC TILE WAINSCOT
122	HALL		CARPET	6" RUBBER	GYP. BD.-PAINT	2 X 2 L.A.T.	10'-6"
123	4-5 YR. QLDS		CARPET	6" RUBBER	GYP. BD.-PAINT	2 X 4 L.A.T.	10'-6"
124	TLT.		CERAMIC TILE	6" CERAMIC	CER. TILE / GYP. BD.-PAINT	2 X 4 L.A.T.	9'-0" MOISTURE RESISTANT GYP. BD. & L.A.T. 4" CERAMIC TILE WAINSCOT
125	2-3 YR. QLDS		CARPET	6" RUBBER	GYP. BD.-PAINT	2 X 4 L.A.T.	10'-6"
126	TLT.		CERAMIC TILE	6" CERAMIC	CER. TILE / GYP. BD.-PAINT	2 X 4 L.A.T.	9'-0" MOISTURE RESISTANT GYP. BD. & L.A.T. 4" CERAMIC TILE WAINSCOT
127	BED BABIES		CARPET	6" RUBBER	GYP. BD.-PAINT	2 X 4 L.A.T.	10'-6"
128	HALL		CARPET	6" RUBBER	GYP. BD.-PAINT	2 X 2 L.A.T.	10'-6"
129	ADULT		CARPET	6" RUBBER	GYP. BD.-PAINT	2 X 4 L.A.T.	10'-6"
130	ADULT		CARPET	6" RUBBER	GYP. BD.-PAINT	2 X 4 L.A.T.	10'-6"
131	ADULT		CARPET	6" RUBBER	GYP. BD.-PAINT	2 X 4 L.A.T.	10'-6"
132	ADULT		CARPET	6" RUBBER	GYP. BD.-PAINT	2 X 4 L.A.T.	10'-6"
133	ADULT		CARPET	6" RUBBER	GYP. BD.-PAINT	2 X 4 L.A.T.	10'-6"
134	ADULT		CARPET	6" RUBBER	GYP. BD.-PAINT	2 X 4 L.A.T.	10'-6"
135	ADULT		CARPET	6" RUBBER	GYP. BD.-PAINT	2 X 4 L.A.T.	10'-6"
136	MEN'S TL.		CERAMIC TILE	6" CERAMIC	CER. TILE / GYP. BD.-V.W.C.	2 X 4 L.A.T.	9'-0" MOISTURE RESISTANT GYP. BD. & L.A.T. 4" CERAMIC TILE WAINSCOT
137	WOMEN'S TL.		CERAMIC TILE	6" CERAMIC	CER. TILE / GYP. BD.-V.W.C.	2 X 4 L.A.T.	9'-0" MOISTURE RESISTANT GYP. BD. & L.A.T. 4" CERAMIC TILE WAINSCOT
137A	STORAGE		CARPET	6" RUBBER	GYP. BD.-PAINT	GYP. BD.	VARIES
138	STAIR #2		CARPET	6" RUBBER	GYP. BD.-PAINT	GYP. BD.	23'-8"
139	VESTIBULE		CARPET	6" RUBBER	GYP. BD.-PAINT	2 X 4 L.A.T.	10'-6"
140	UTILITY		V.C.T.	6" RUBBER	GYP. BD.-PAINT	2 X 4 L.A.T.	9'-0"
141	HALL		CARPET	6" RUBBER	GYP. BD.-PAINT	2 X 2 L.A.T.	10'-6"
142	SERVING		CARPET	6" RUBBER	GYP. BD.-PAINT	2 X 4 L.A.T.	10'-6"
143	KITCHEN		CERAMIC TILE	6" RUBBER	GYP. BD.-PAINT	2 X 4 L.A.T.	10'-6" MOISTURE RESISTANT GYP. BD. & L.A.T.
144	PANTRY		CARPET	6" RUBBER	GYP. BD.-PAINT	2 X 4 L.A.T.	9'-0"
145	PANTRY		CARPET	6" RUBBER	GYP. BD.-PAINT	2 X 4 L.A.T.	9'-0"
146	TELE./ELEC.		CARPET	6" RUBBER	GYP. BD.-PAINT	2 X 4 L.A.T.	9'-0"
147	TABLE STORAGE		CARPET	6" RUBBER	GYP. BD.-PAINT	2 X 4 L.A.T.	9'-0"
148	ELEV. EQUIP.		SEALED CONC.	6" RUBBER	GYP. BD.-PAINT	EXP. STRUCT.	9'-0"
148A	ELEVATOR		SEALED CONC.				
149	CRY ROOM		CARPET	6" RUBBER	GYP. BD.-PAINT	2 X 4 L.A.T.	10'-6"
150	SANCTUARY		CARPET	1 X 6 WOOD	GYP. BD.-PAINT	2 X 2 L.A.T.	23'-8"
151	PULPIT		CARPET	1 X 6 WOOD	GYP. BD.-PAINT	2 X 2 L.A.T.	23'-8"
152	VESTIBULE		CARPET	6" RUBBER	GYP. BD.-PAINT	2 X 2 L.A.T.	9'-0"
153	DRESSING		CARPET	6" RUBBER	GYP. BD.-PAINT	2 X 4 L.A.T.	9'-0"
154	VESTIBULE		CARPET	6" RUBBER	GYP. BD.-PAINT	2 X 2 L.A.T.	9'-0"
155	BAPTISTRY		SEALED CONC.	6" RUBBER	GYP. BD.-PAINT	GYP. BD.	10'-6"
200	TECHNICAL BALCONY		CARPET	6" RUBBER	GYP. BD.-PAINT	2 X 4 L.A.T.	10'-0"
201	HALL		CARPET	6" RUBBER	GYP. BD.-PAINT	2 X 4 L.A.T.	10'-0"
202	HALL		CARPET	6" RUBBER	GYP. BD.-PAINT	2 X 4 L.A.T.	10'-0"
203	WOMEN'S TL.		CERAMIC TILE	6" CERAMIC	CER. TILE / GYP. BD.-PAINT	2 X 4 L.A.T.	9'-0" MOISTURE RESISTANT GYP. BD. & L.A.T. 4" CERAMIC TILE WAINSCOT
204	MEN'S TL.		CERAMIC TILE	6" CERAMIC	CER. TILE / GYP. BD.-PAINT	2 X 4 L.A.T.	9'-0" MOISTURE RESISTANT GYP. BD. & L.A.T. 4" CERAMIC TILE WAINSCOT
205	YOUTH LOUNGE		CARPET	6" RUBBER	GYP. BD.-PAINT	2 X 4 L.A.T.	10'-0"
206	CHILDREN		CARPET	6" RUBBER	GYP. BD.-PAINT	2 X 4 L.A.T.	10'-0"
207	AWANA		CARPET	6" RUBBER	GYP. BD.-PAINT	2 X 4 L.A.T.	10'-0"
208	MEN'S TL.		CERAMIC TILE	6" CERAMIC	CER. TILE / GYP. BD.-PAINT	2 X 4 L.A.T.	9'-0" MOISTURE RESISTANT GYP. BD. & L.A.T. 4" CERAMIC TILE WAINSCOT
209	WOMEN'S TL.		CERAMIC TILE	6" CERAMIC	CER. TILE / GYP. BD.-PAINT	2 X 4 L.A.T.	9'-0" MOISTURE RESISTANT GYP. BD. & L.A.T. 4" CERAMIC TILE WAINSCOT
210	MECHANICAL		SEALED CONC.	6" RUBBER	GYP. BD.-PAINT	EXP. STRUCTURE	VARIES
211	MECHANICAL		SEALED CONC.	6" RUBBER	GYP. BD.-PAINT	EXP. STRUCTURE	VARIES

FINISH SCHEDULE ABBREVIATIONS:  
 EXP. STRUCT. EXPOSED STRUCTURE  
 GYP. BD. GYPSUM WALLBOARD  
 L.A.T. LAY-IN ACOUSTICAL CEILING TILE  
 V.C.T. VINYL COMPOSITION TILE  
 V.W.C. VINYL WALL COVERING

REVISIONS	BY

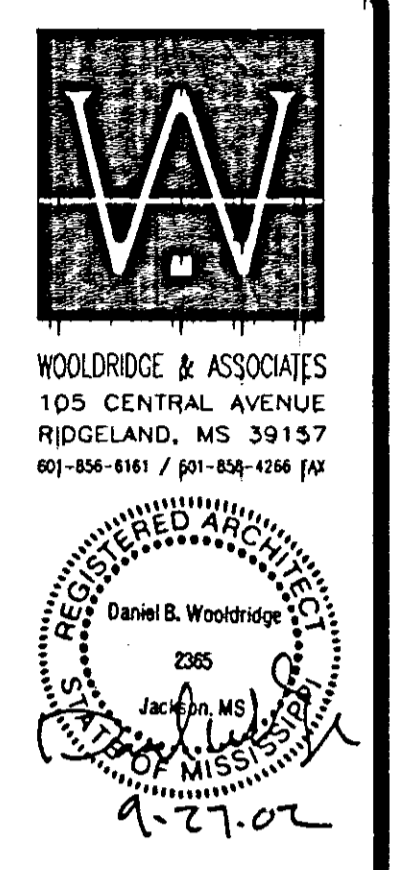

A New Building for  
**CHURCH OF THE HIGHLANDS**  
 Ridgeland, Mississippi

REVISIONS	BY

WOOLDRIDGE & ASSOCIATES  
105 CENTRAL AVENUE  
RIDGELAND, MS 39157  
601-956-1161 / 601-956-1268 FAX


REGISTERED ARCHITECT  
Daniel B. Woolridge  
2385  
Jackson, Mississippi  
1.2.2007

A New Building for  
**CHURCH OF THE HIGHLANDS**  
Ridgeland, Mississippi


THIS DESIGN IS THE COPYRIGHTED PROPERTY OF WOOLDRIDGE & ASSOCIATES. IT MAY NOT BE REPRODUCED FROM THIS DESIGN WITHOUT THE EXPRESS WRITTEN PERMISSION OF WOOLDRIDGE & ASSOCIATES.

NO.	DATE	SCALE	JOB NO.	SHEET


A8

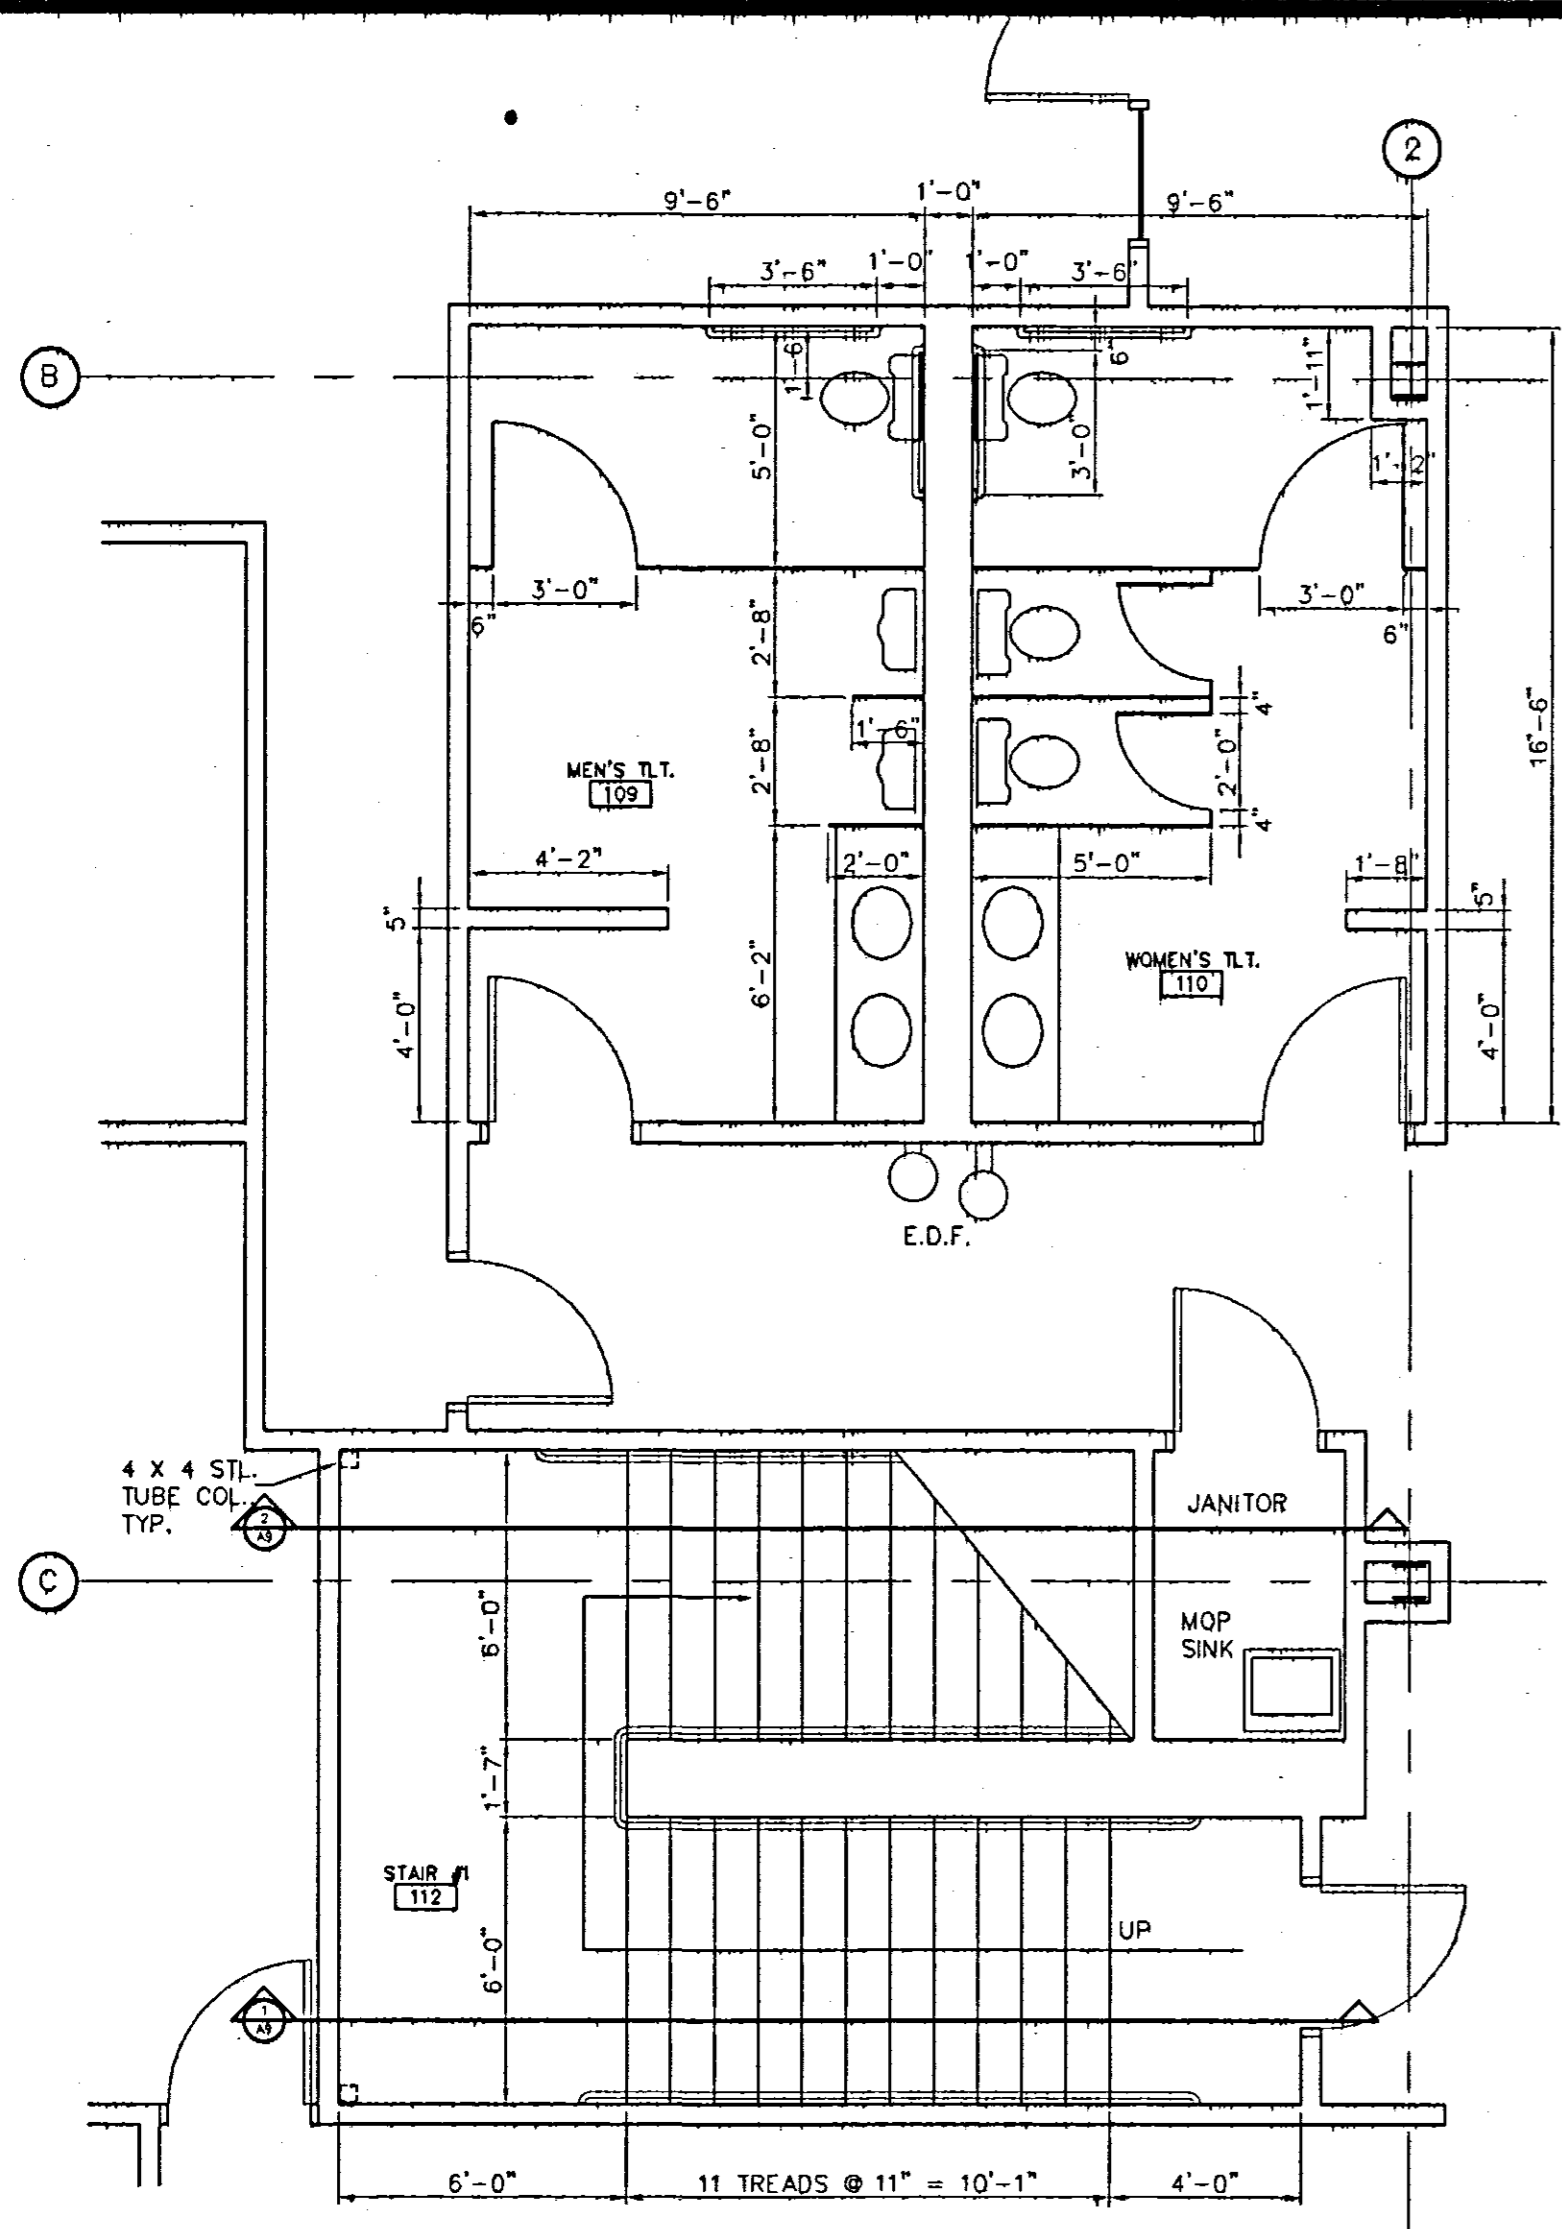


1 ENLG. MEN'S TLT. 109, WOMEN'S TLT. 110, STAIR 112  
SCALE: 1/4" = 1'-0"  
MEN'S TLT. 204, WOMEN'S TLT. 203, SIM.

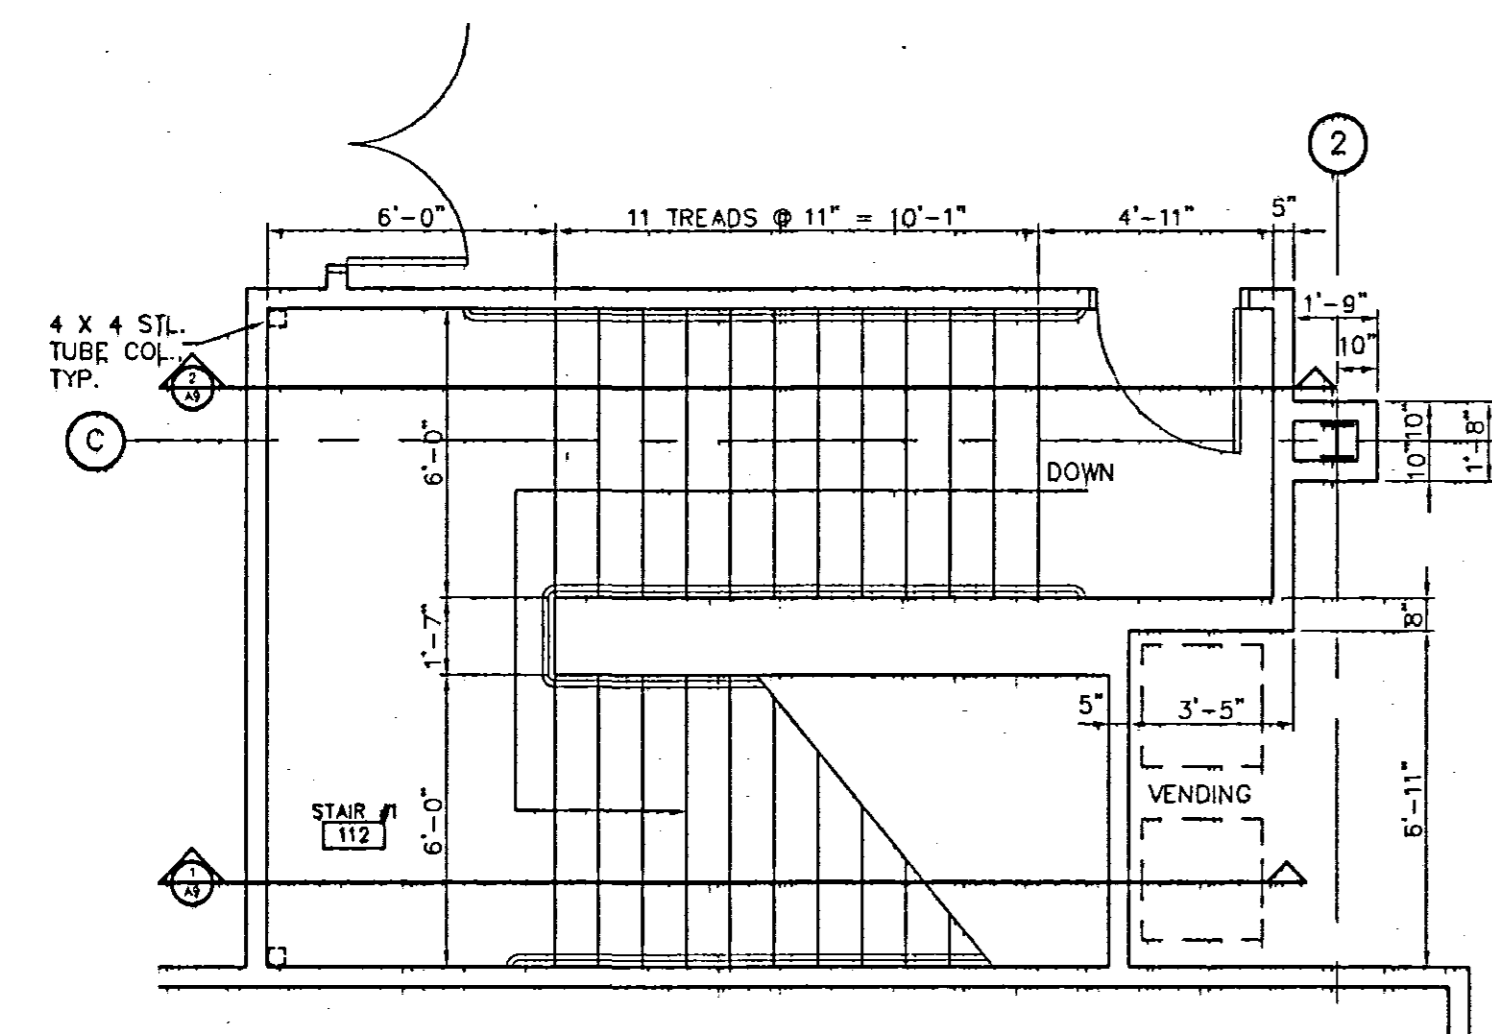


2 ENLG. STAIR 112 @ 2ND. FL.  
SCALE: 1/4" = 1'-0"

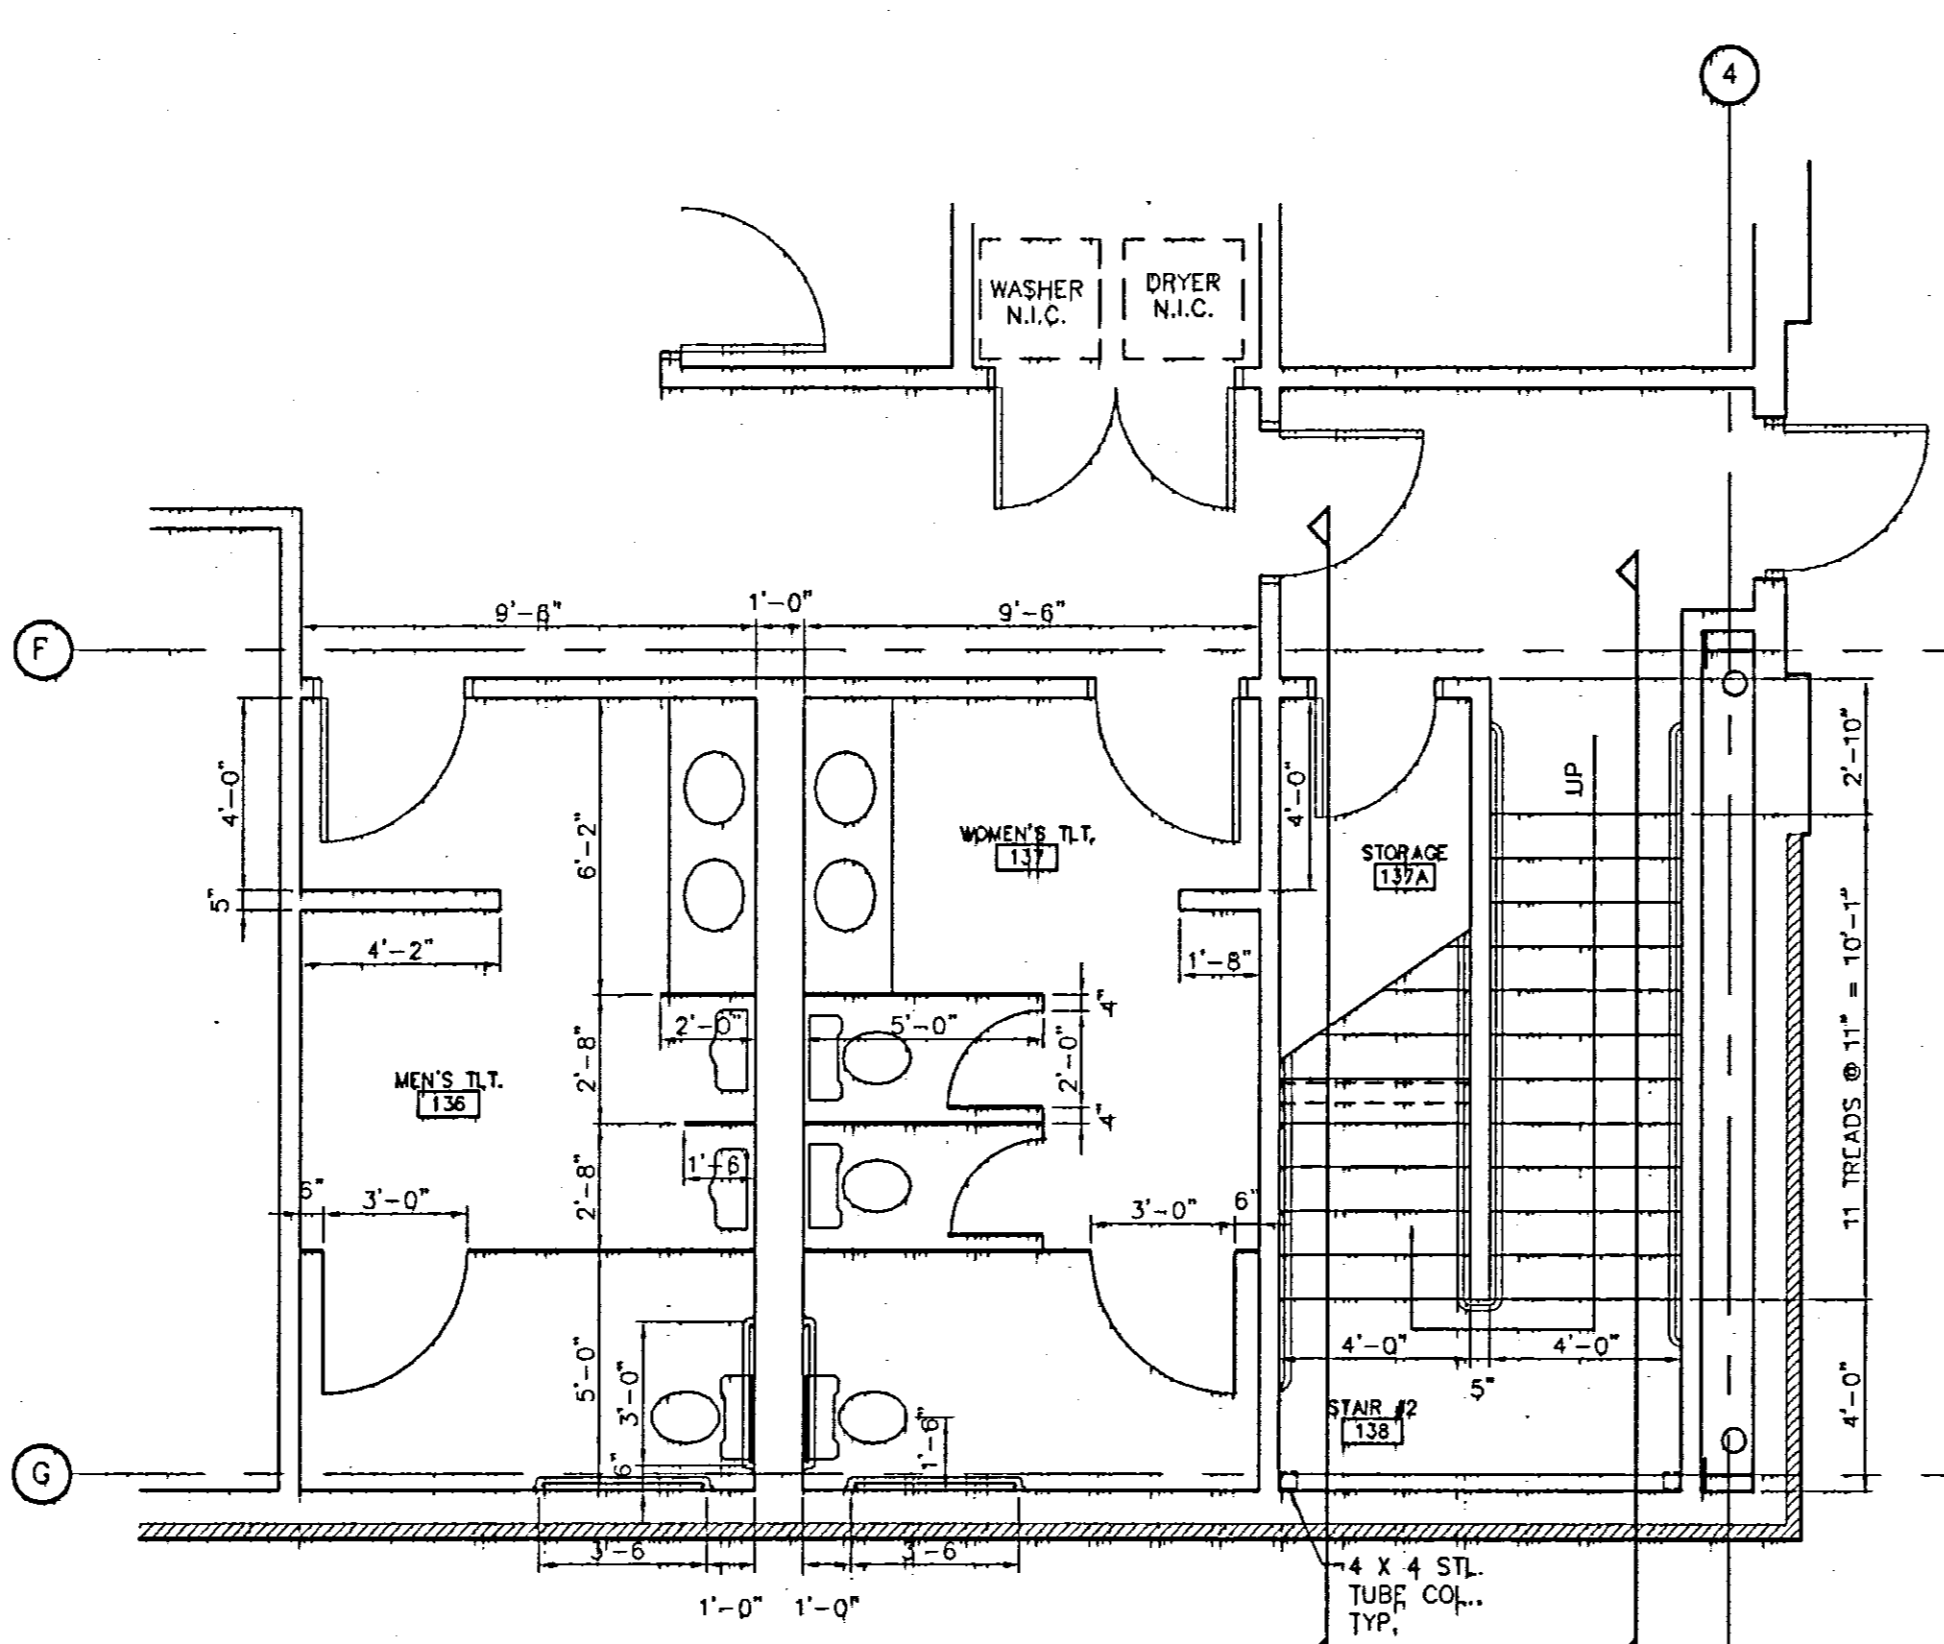


3 ENLG. MEN'S TLT. 136, WOMEN'S TLT. 137, STAIR 138  
SCALE: 1/4" = 1'-0"  
MEN'S TLT. 208, WOMEN'S TLT. 209, SIM.

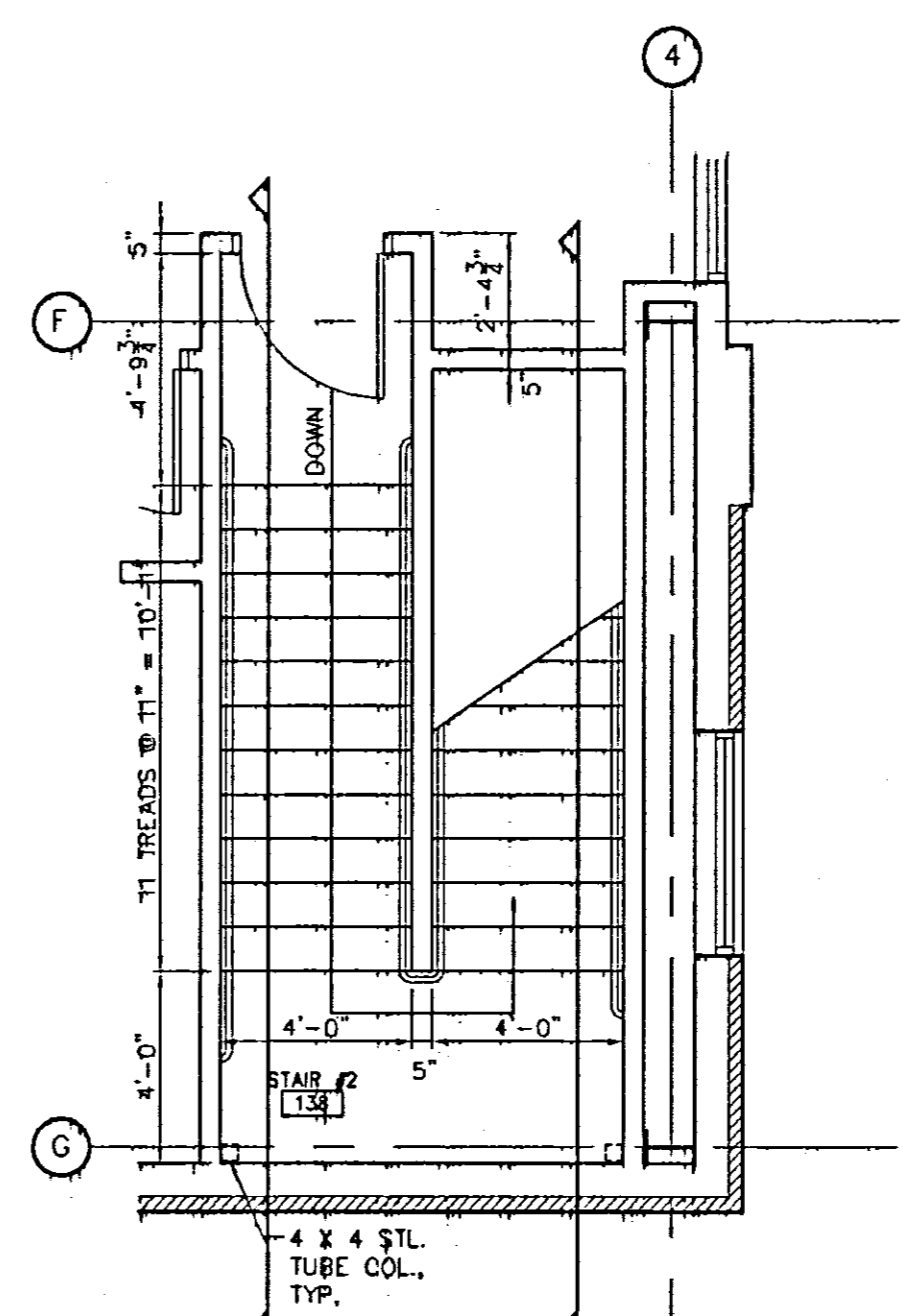


4 ENLG. STAIR 138 @ 2ND. FL.  
SCALE: 1/4" = 1'-0"

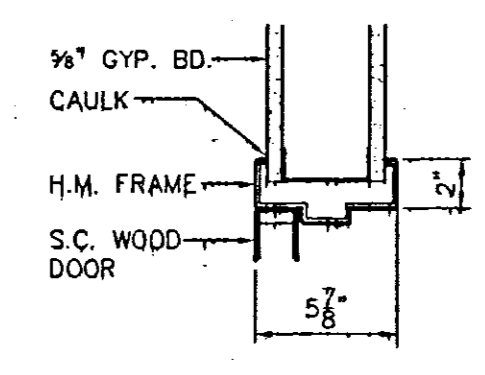


5 TYP. INT. DOOR HEAD  
SCALE: 1 1/2" = 1'-0"  
JAMB SIM.

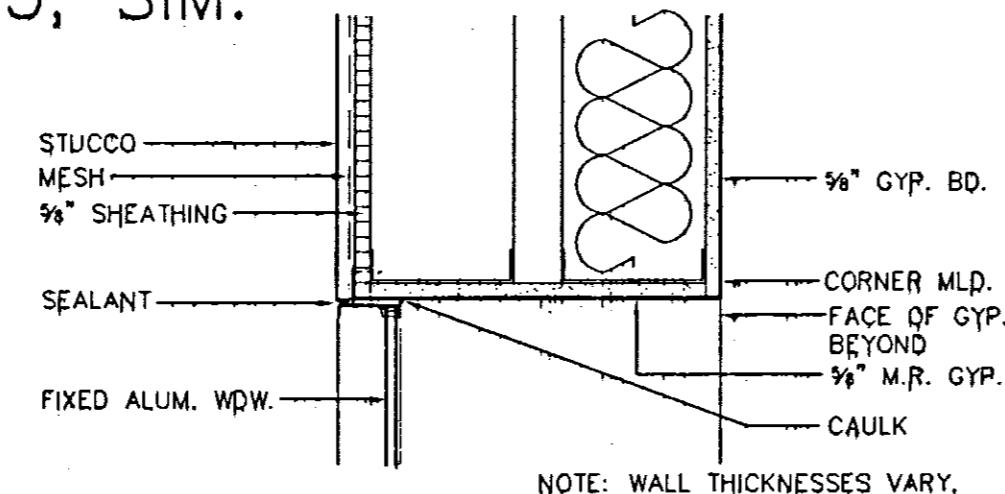


6 TYP. WDW. HD. @  
SCALE: 1 1/2" = 1'-0"  
STUCCO WALL

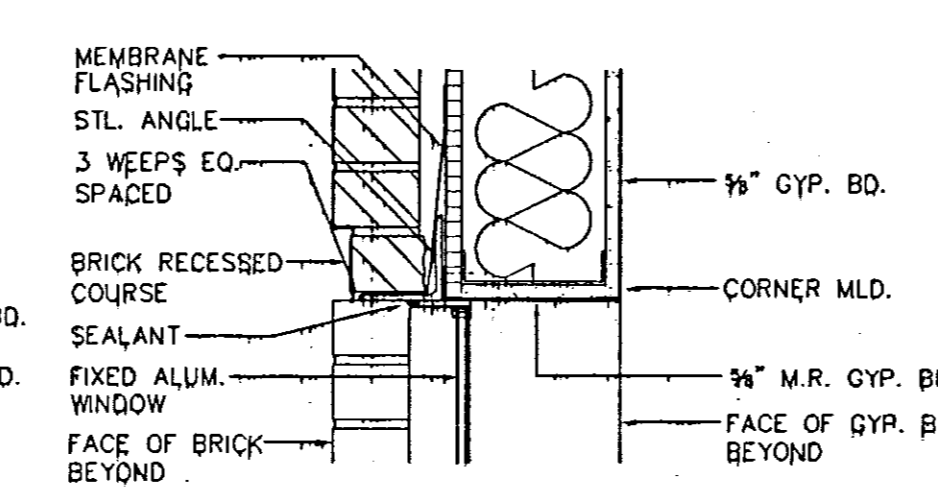


8 TYP. WDW. HD. @  
SCALE: 1 1/2" = 1'-0"  
BRICK WALL

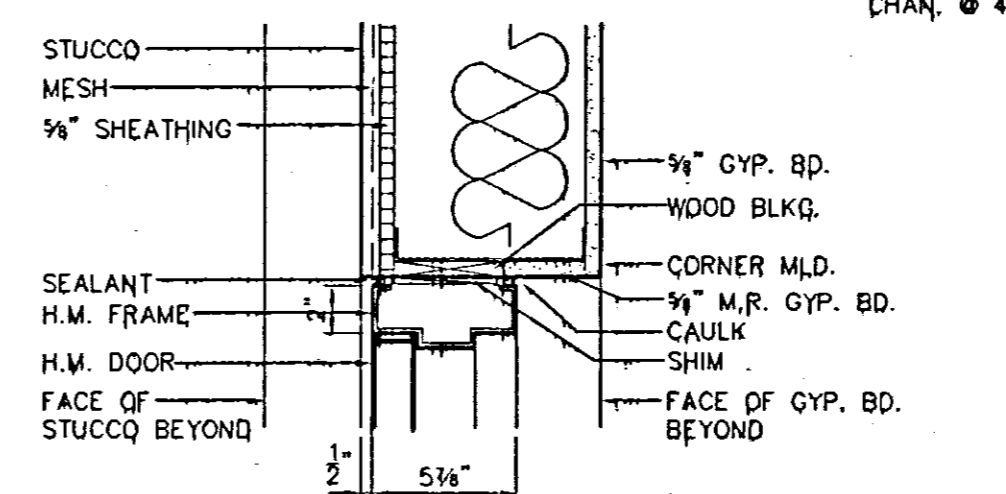


10 HEAD @ DOORS 4 & 5  
SCALE: 1 1/2" = 1'-0"  
6 SIM.

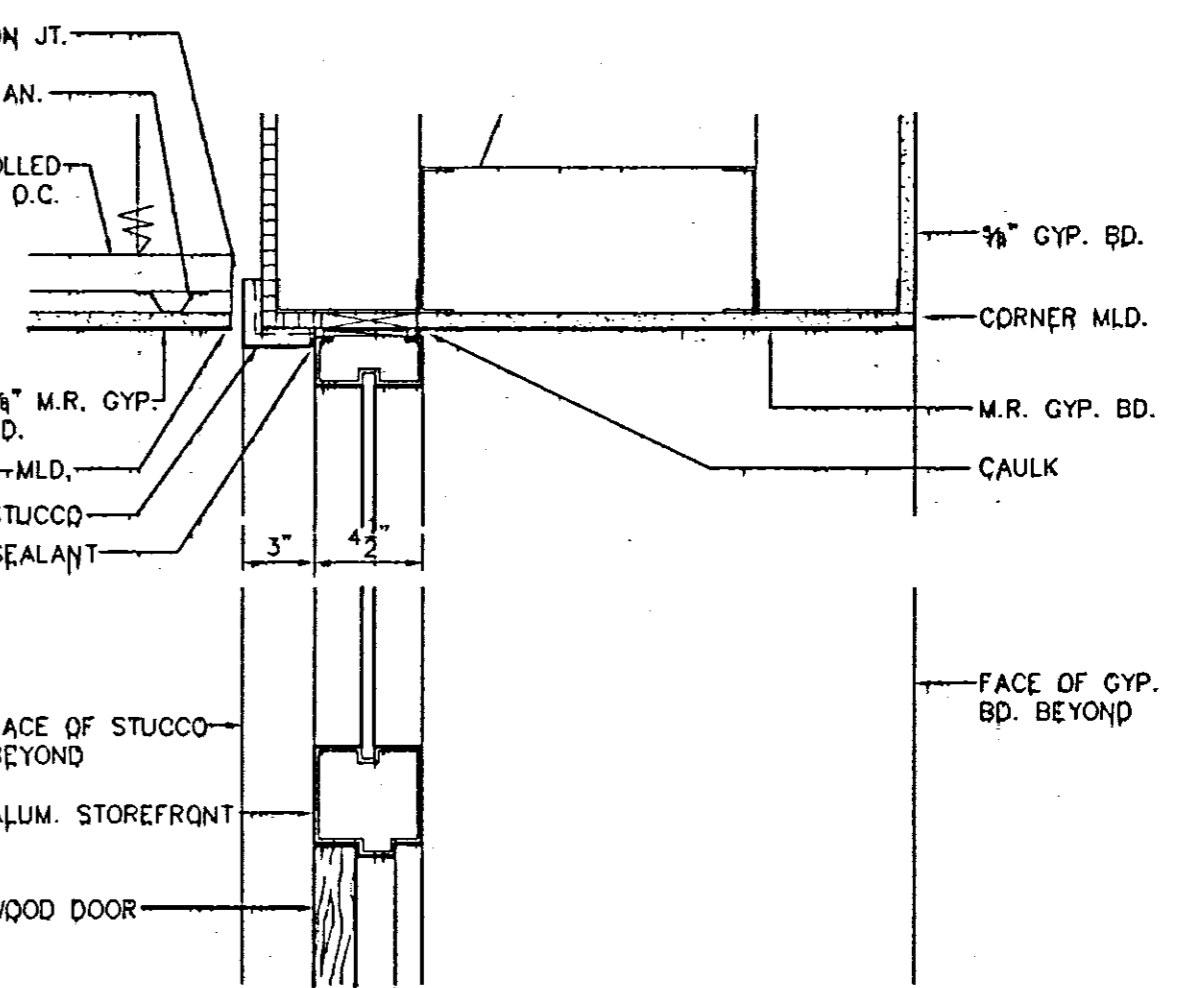


12 HEAD @ DOORS 1, 2 & 3  
SCALE: 1 1/2" = 1'-0"

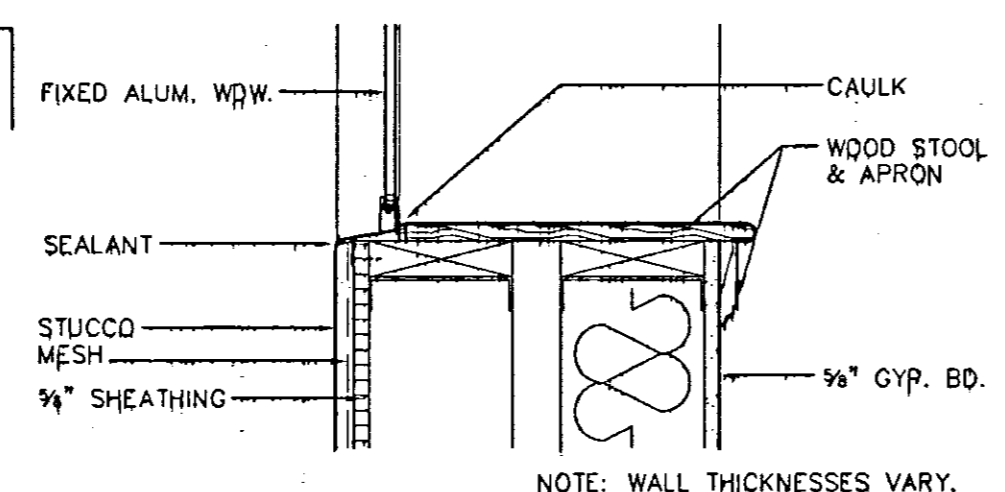


7 TYP. WDW. SILL @  
SCALE: 1 1/2" = 1'-0"  
STUCCO WALL

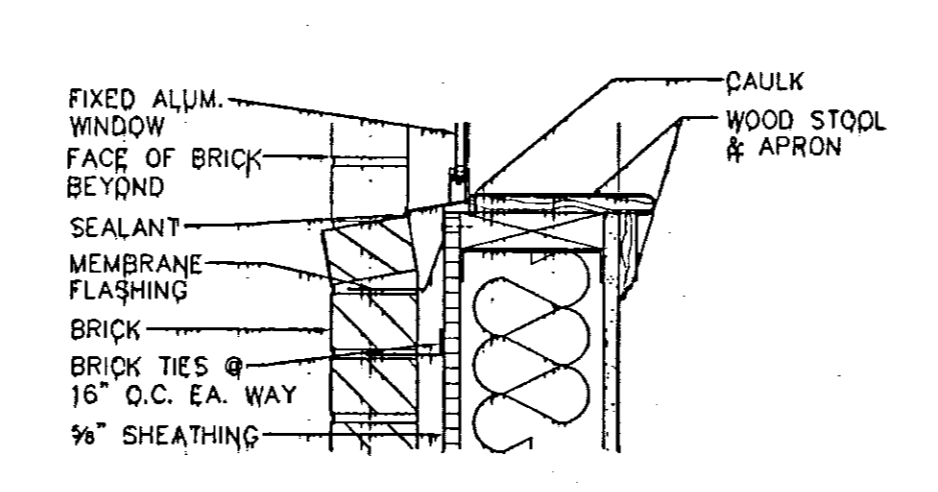

9 TYP. WDW. SILL @  
SCALE: 1 1/2" = 1'-0"  
BRICK WALL

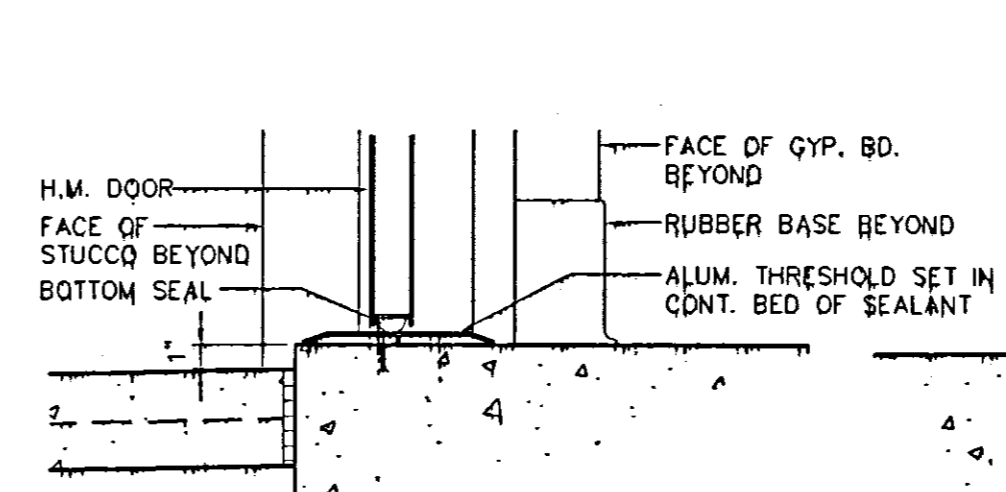


11 THRESHOLD @ DOORS  
SCALE: 1 1/2" = 1'-0"  
4 & 5

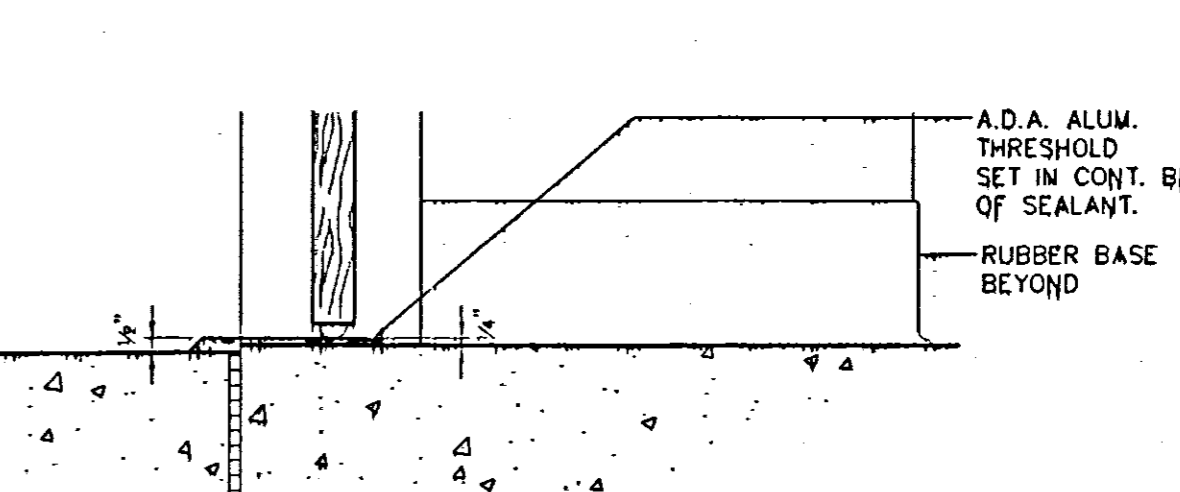

13 THRESHOLD @ DOORS  
SCALE: 1 1/2" = 1'-0"  
1, 2, 3 & 6

Woolridge & Associates 6/15/2001 9:49 AM basesheet2.dwg


REVISIONS	BY

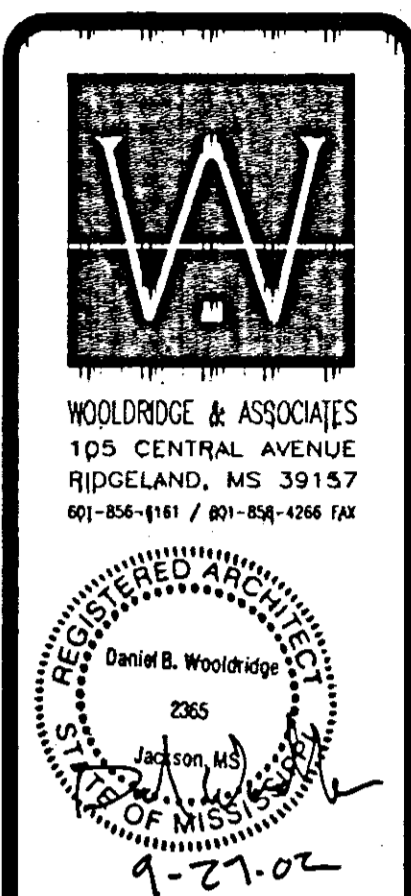


A New Building for  
**CHURCH OF THE HIGHLANDS**  
 Ridgeland, Mississippi

THIS DESIGN IS THE COPYRIGHTED  
 PROPERTY OF WOOLDRIDGE  
 & ASSOCIATES. IT MAY NOT BE  
 REPRODUCED FROM THIS DESIGN  
 WITHOUT THE EXPRESS WRITTEN  
 PERMISSION OF WOOLDRIDGE  
 & ASSOCIATES.


CHECKED	
DATE	
SCALE	
JOB NO.	
SHEET	

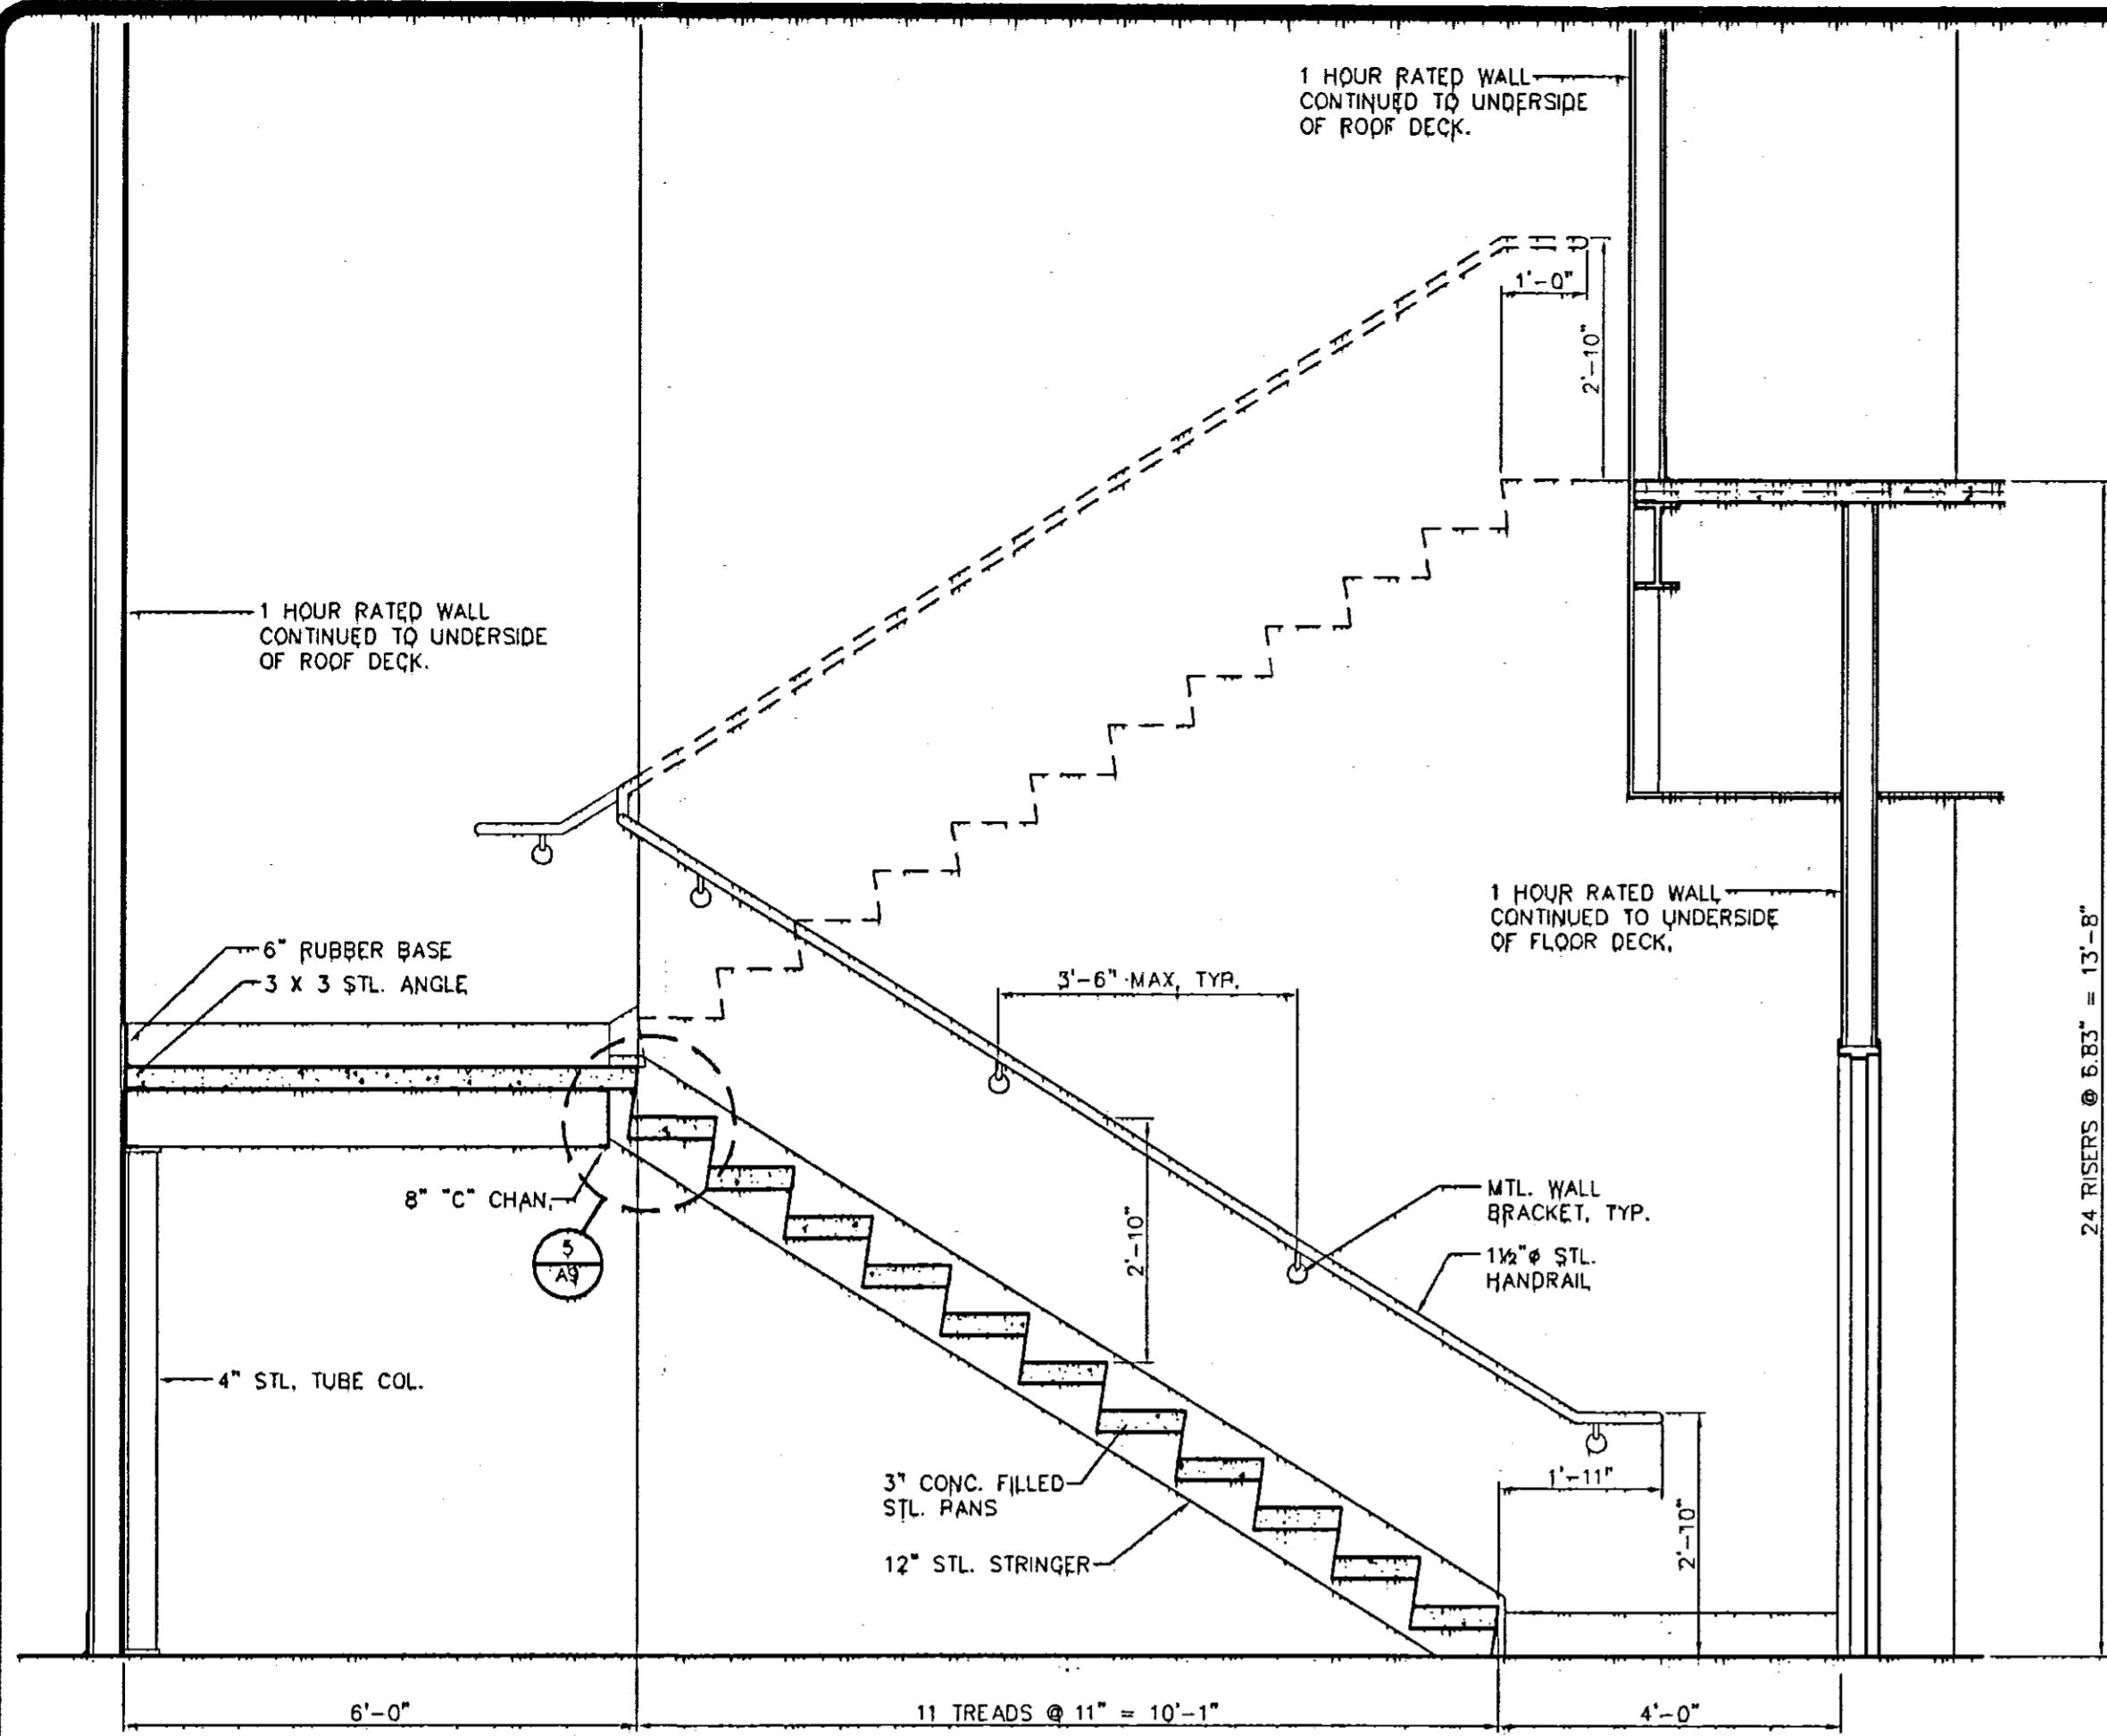


**1**  
**A9** STAIR SECTION  
 SCALE: 1/2" = 1'-0"

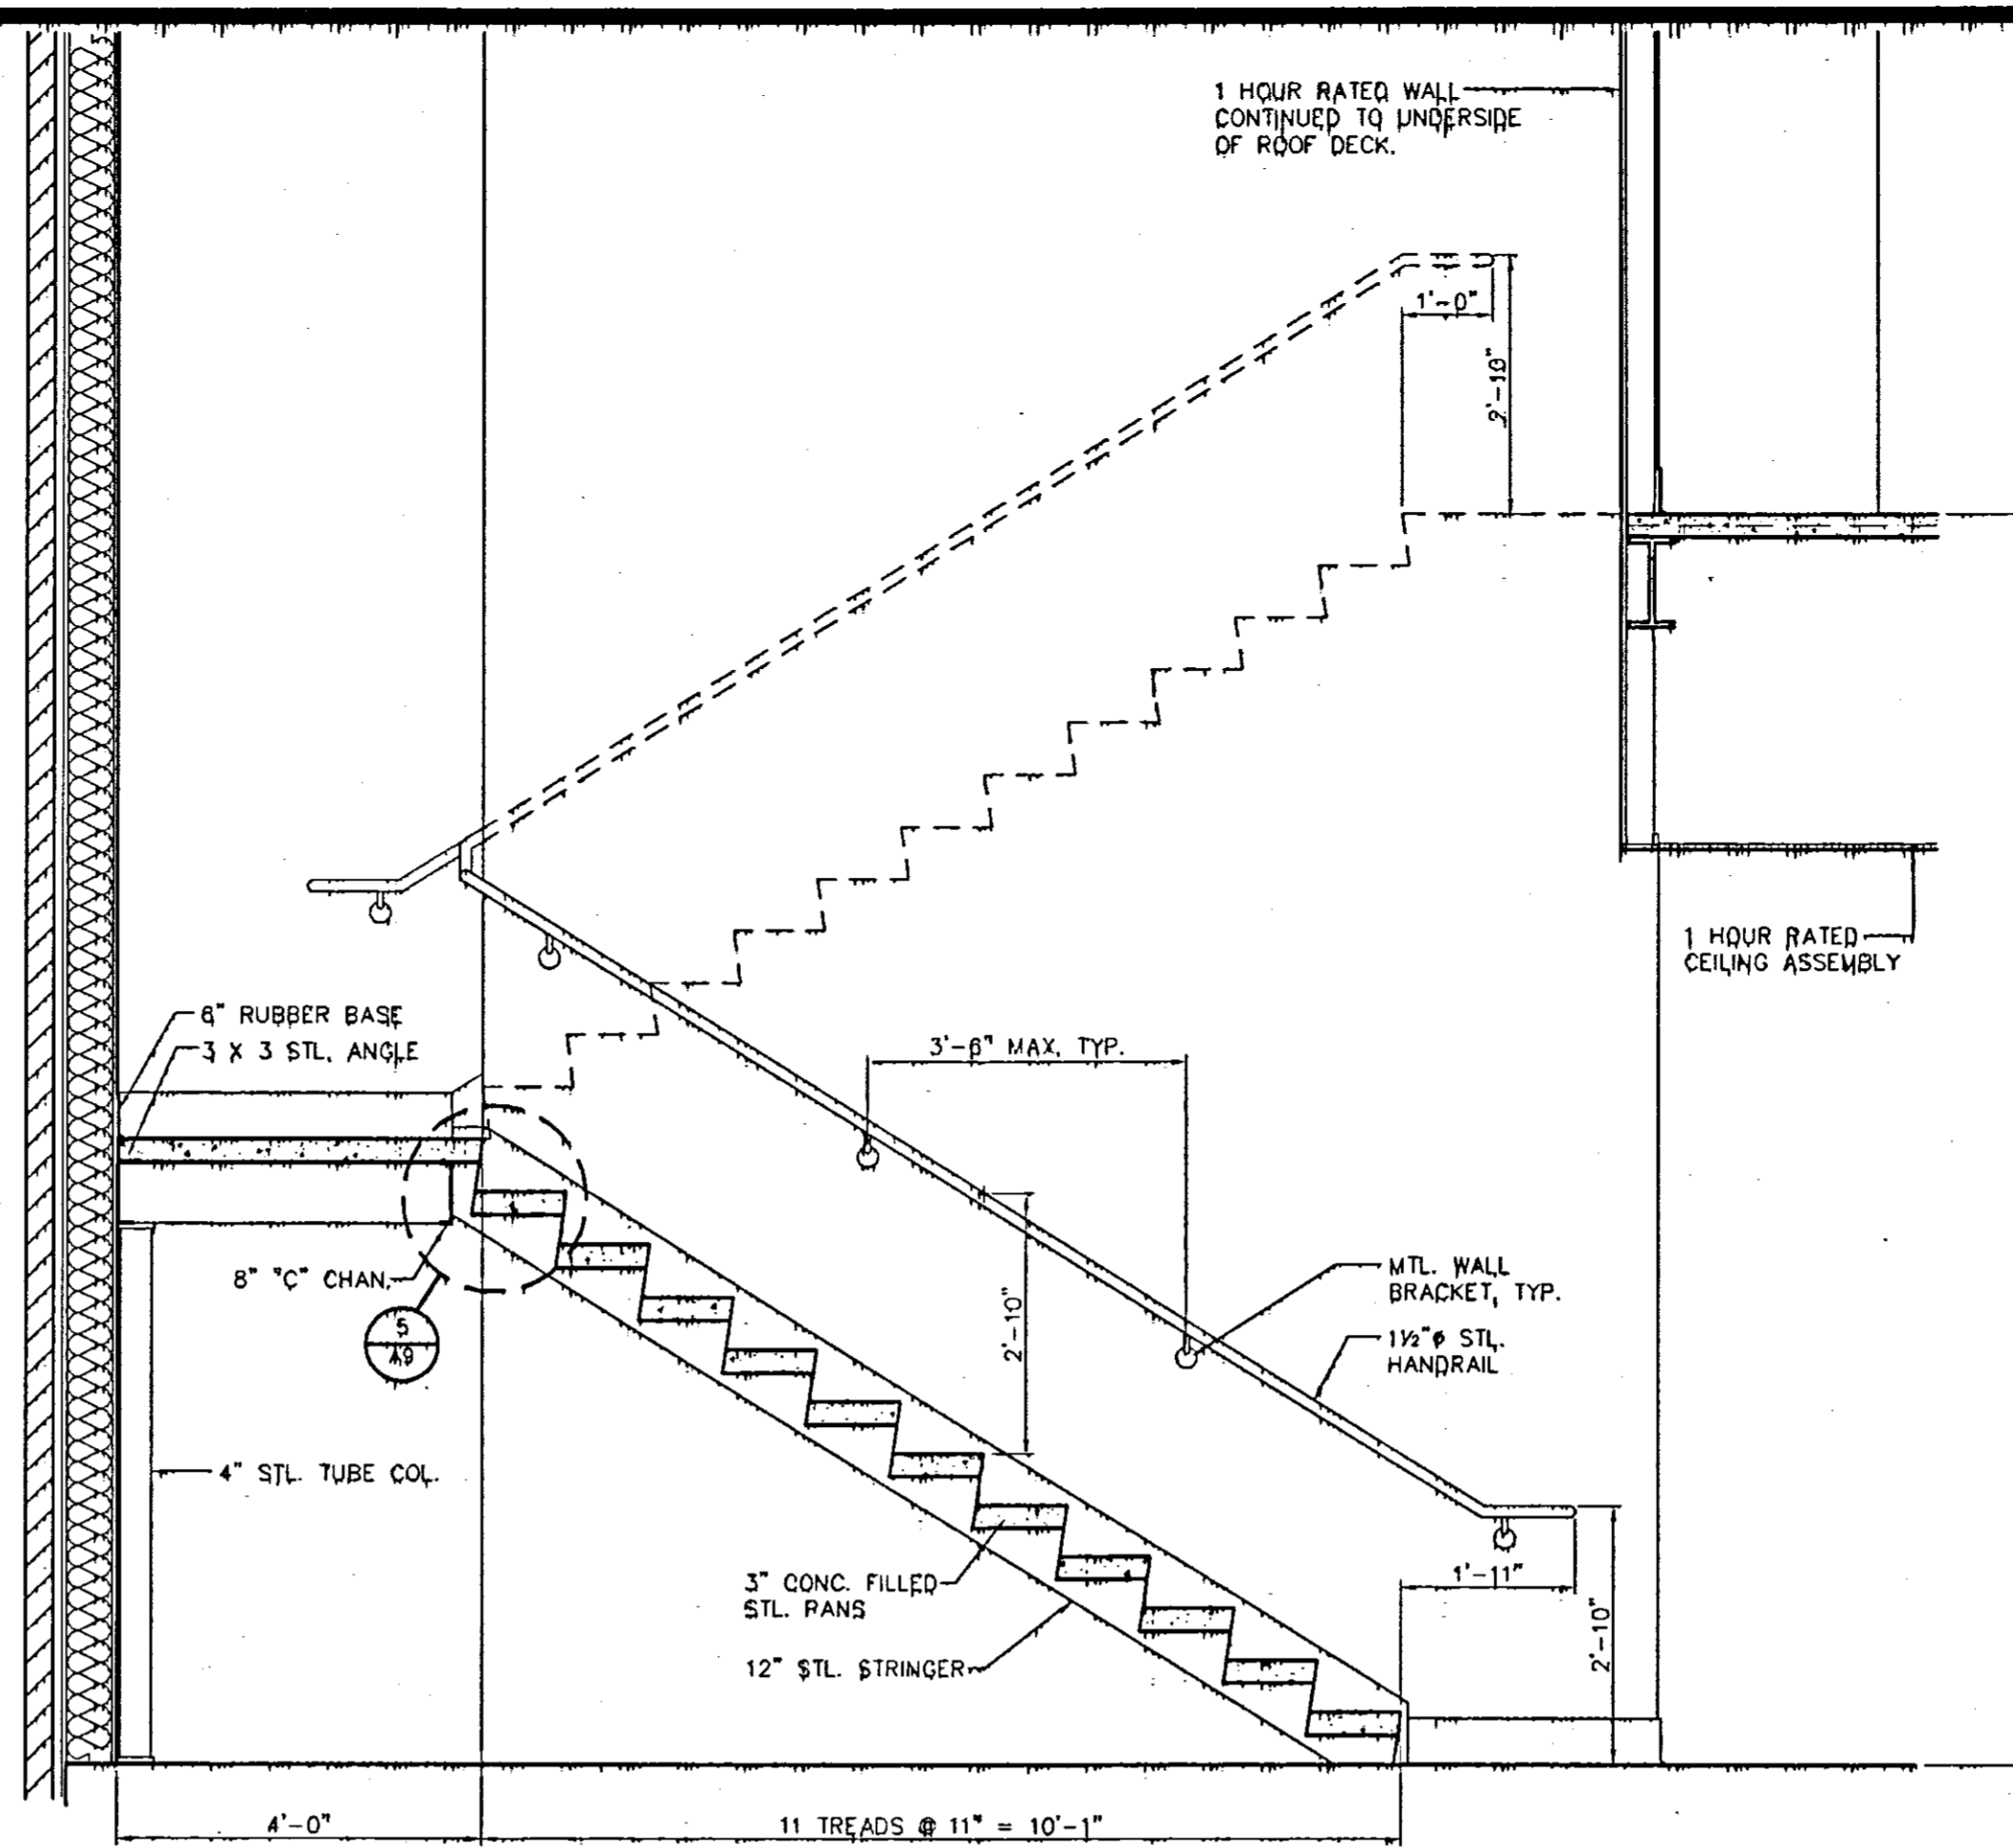


**3**  
**A9** STAIR SECTION  
 SCALE: 1/2" = 1'-0"

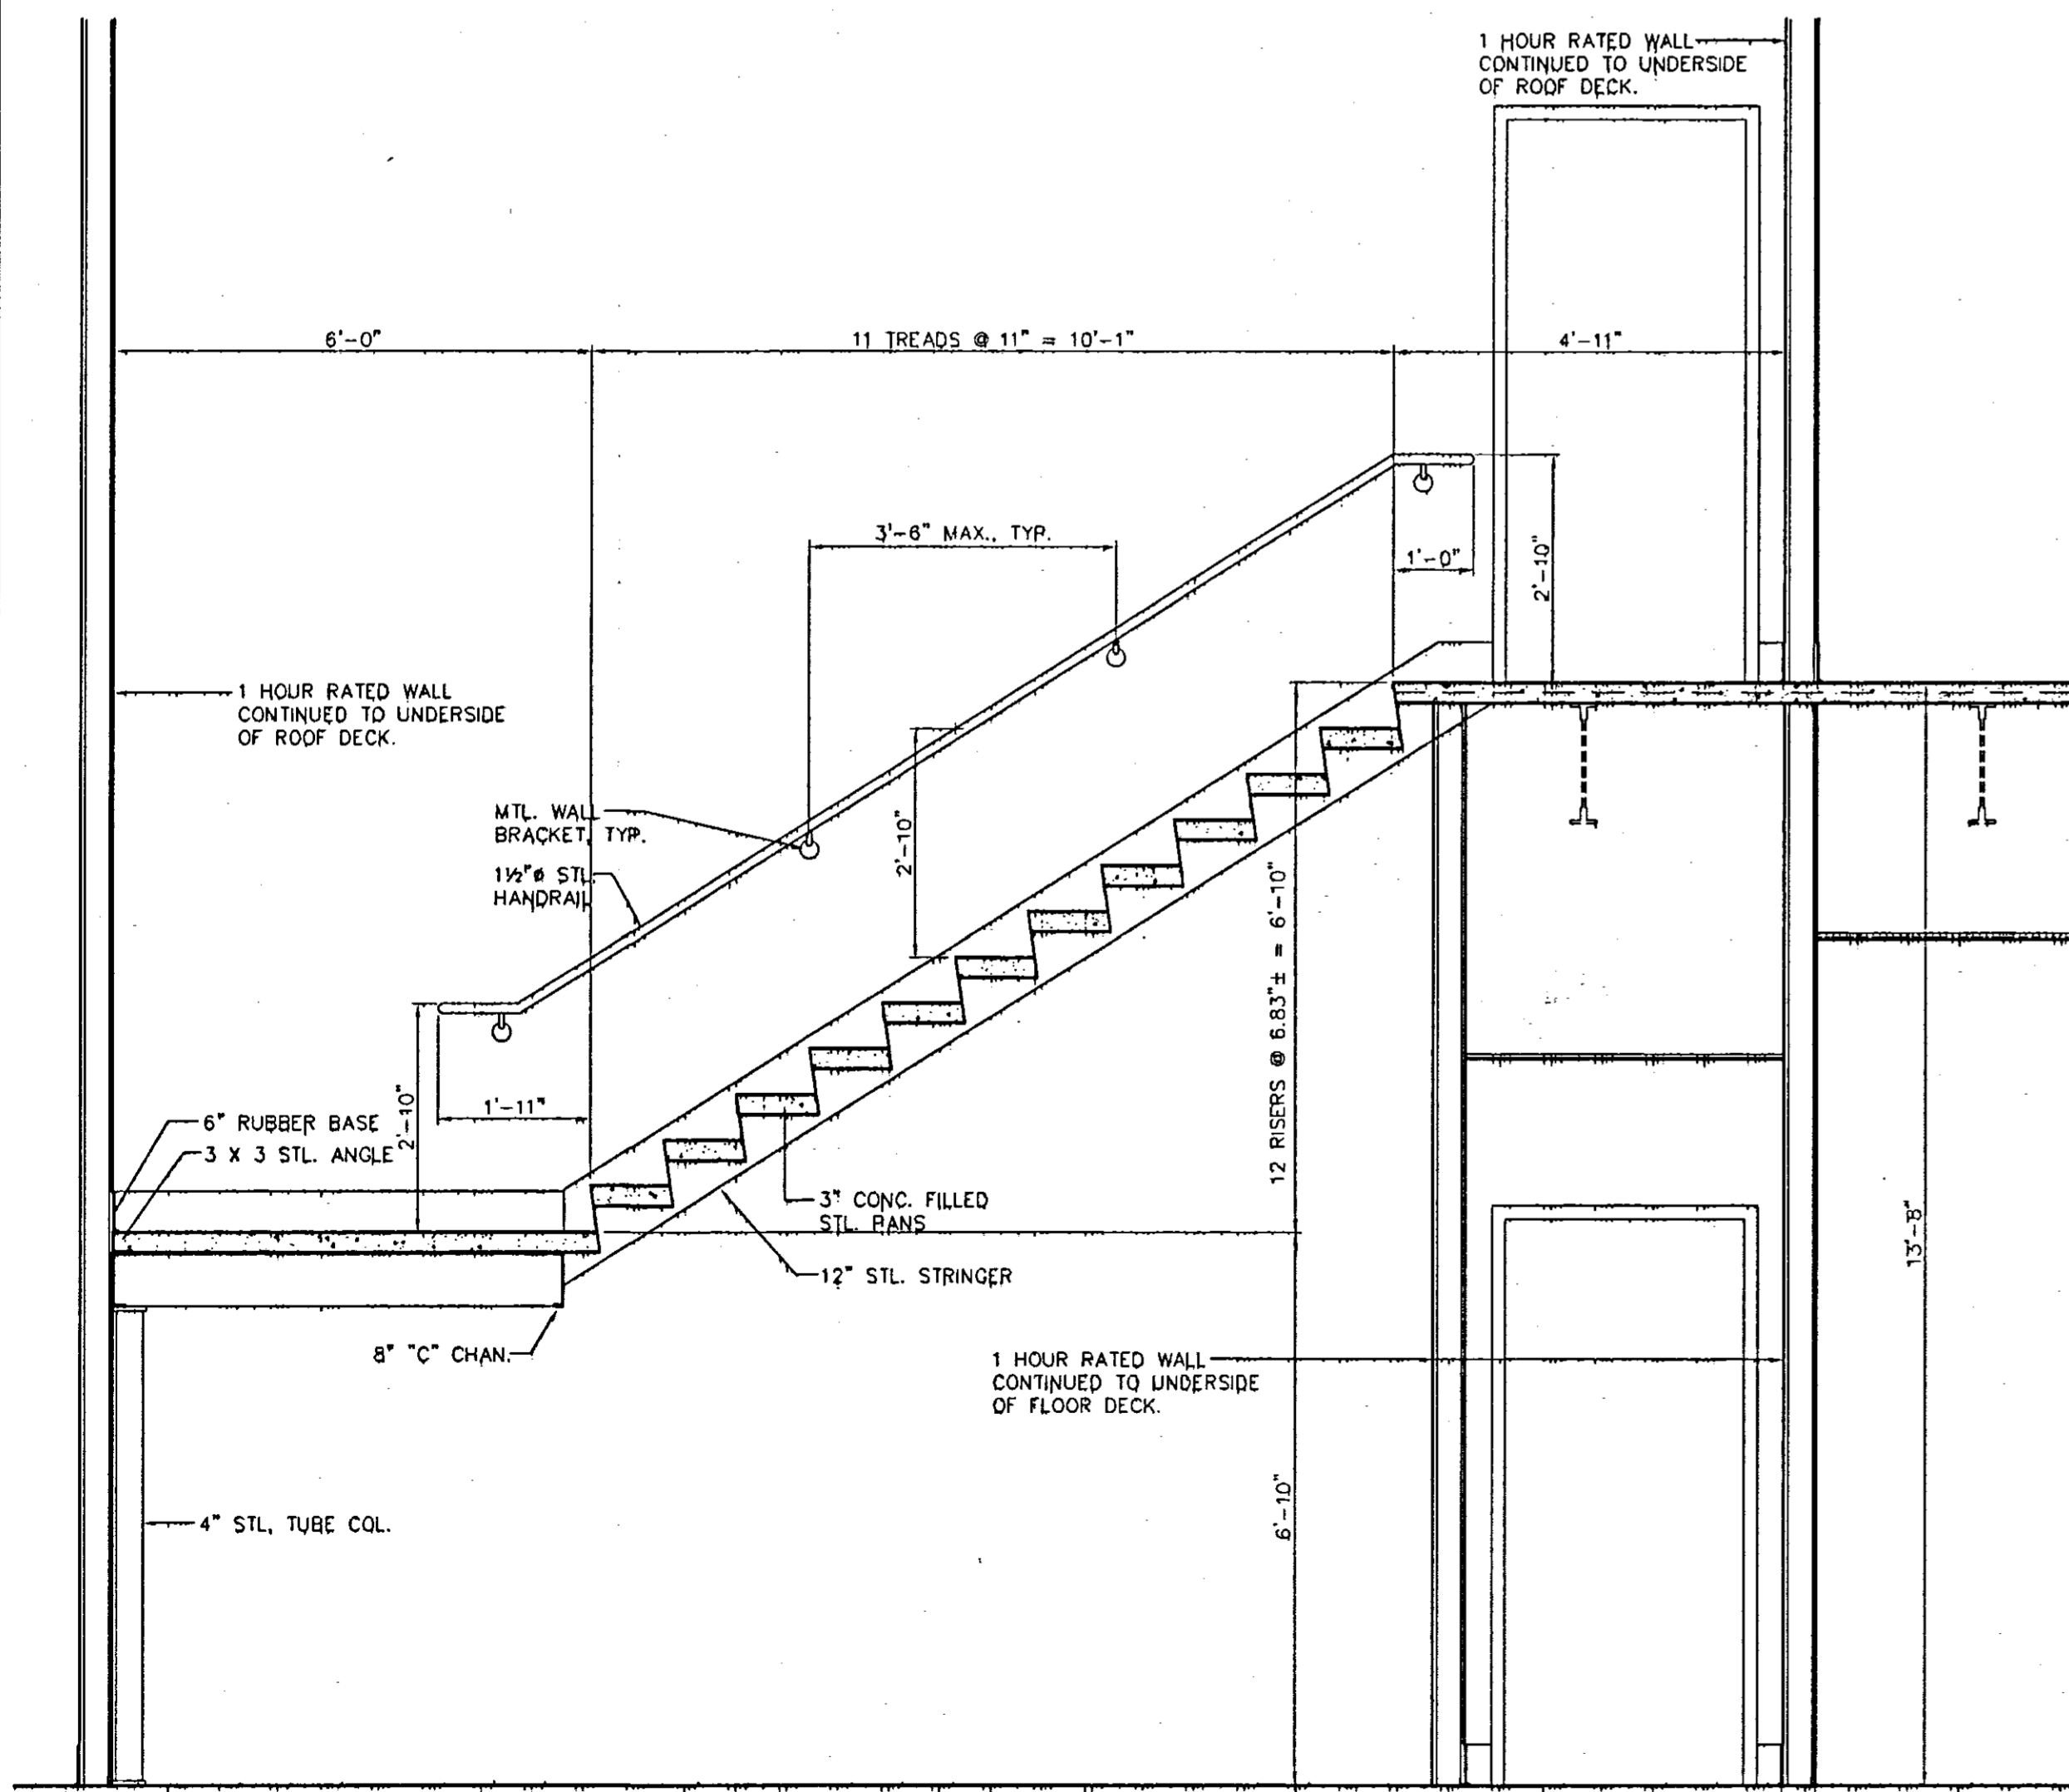

**2**  
**A9** STAIR SECTION  
 SCALE: 1/2" = 1'-0"

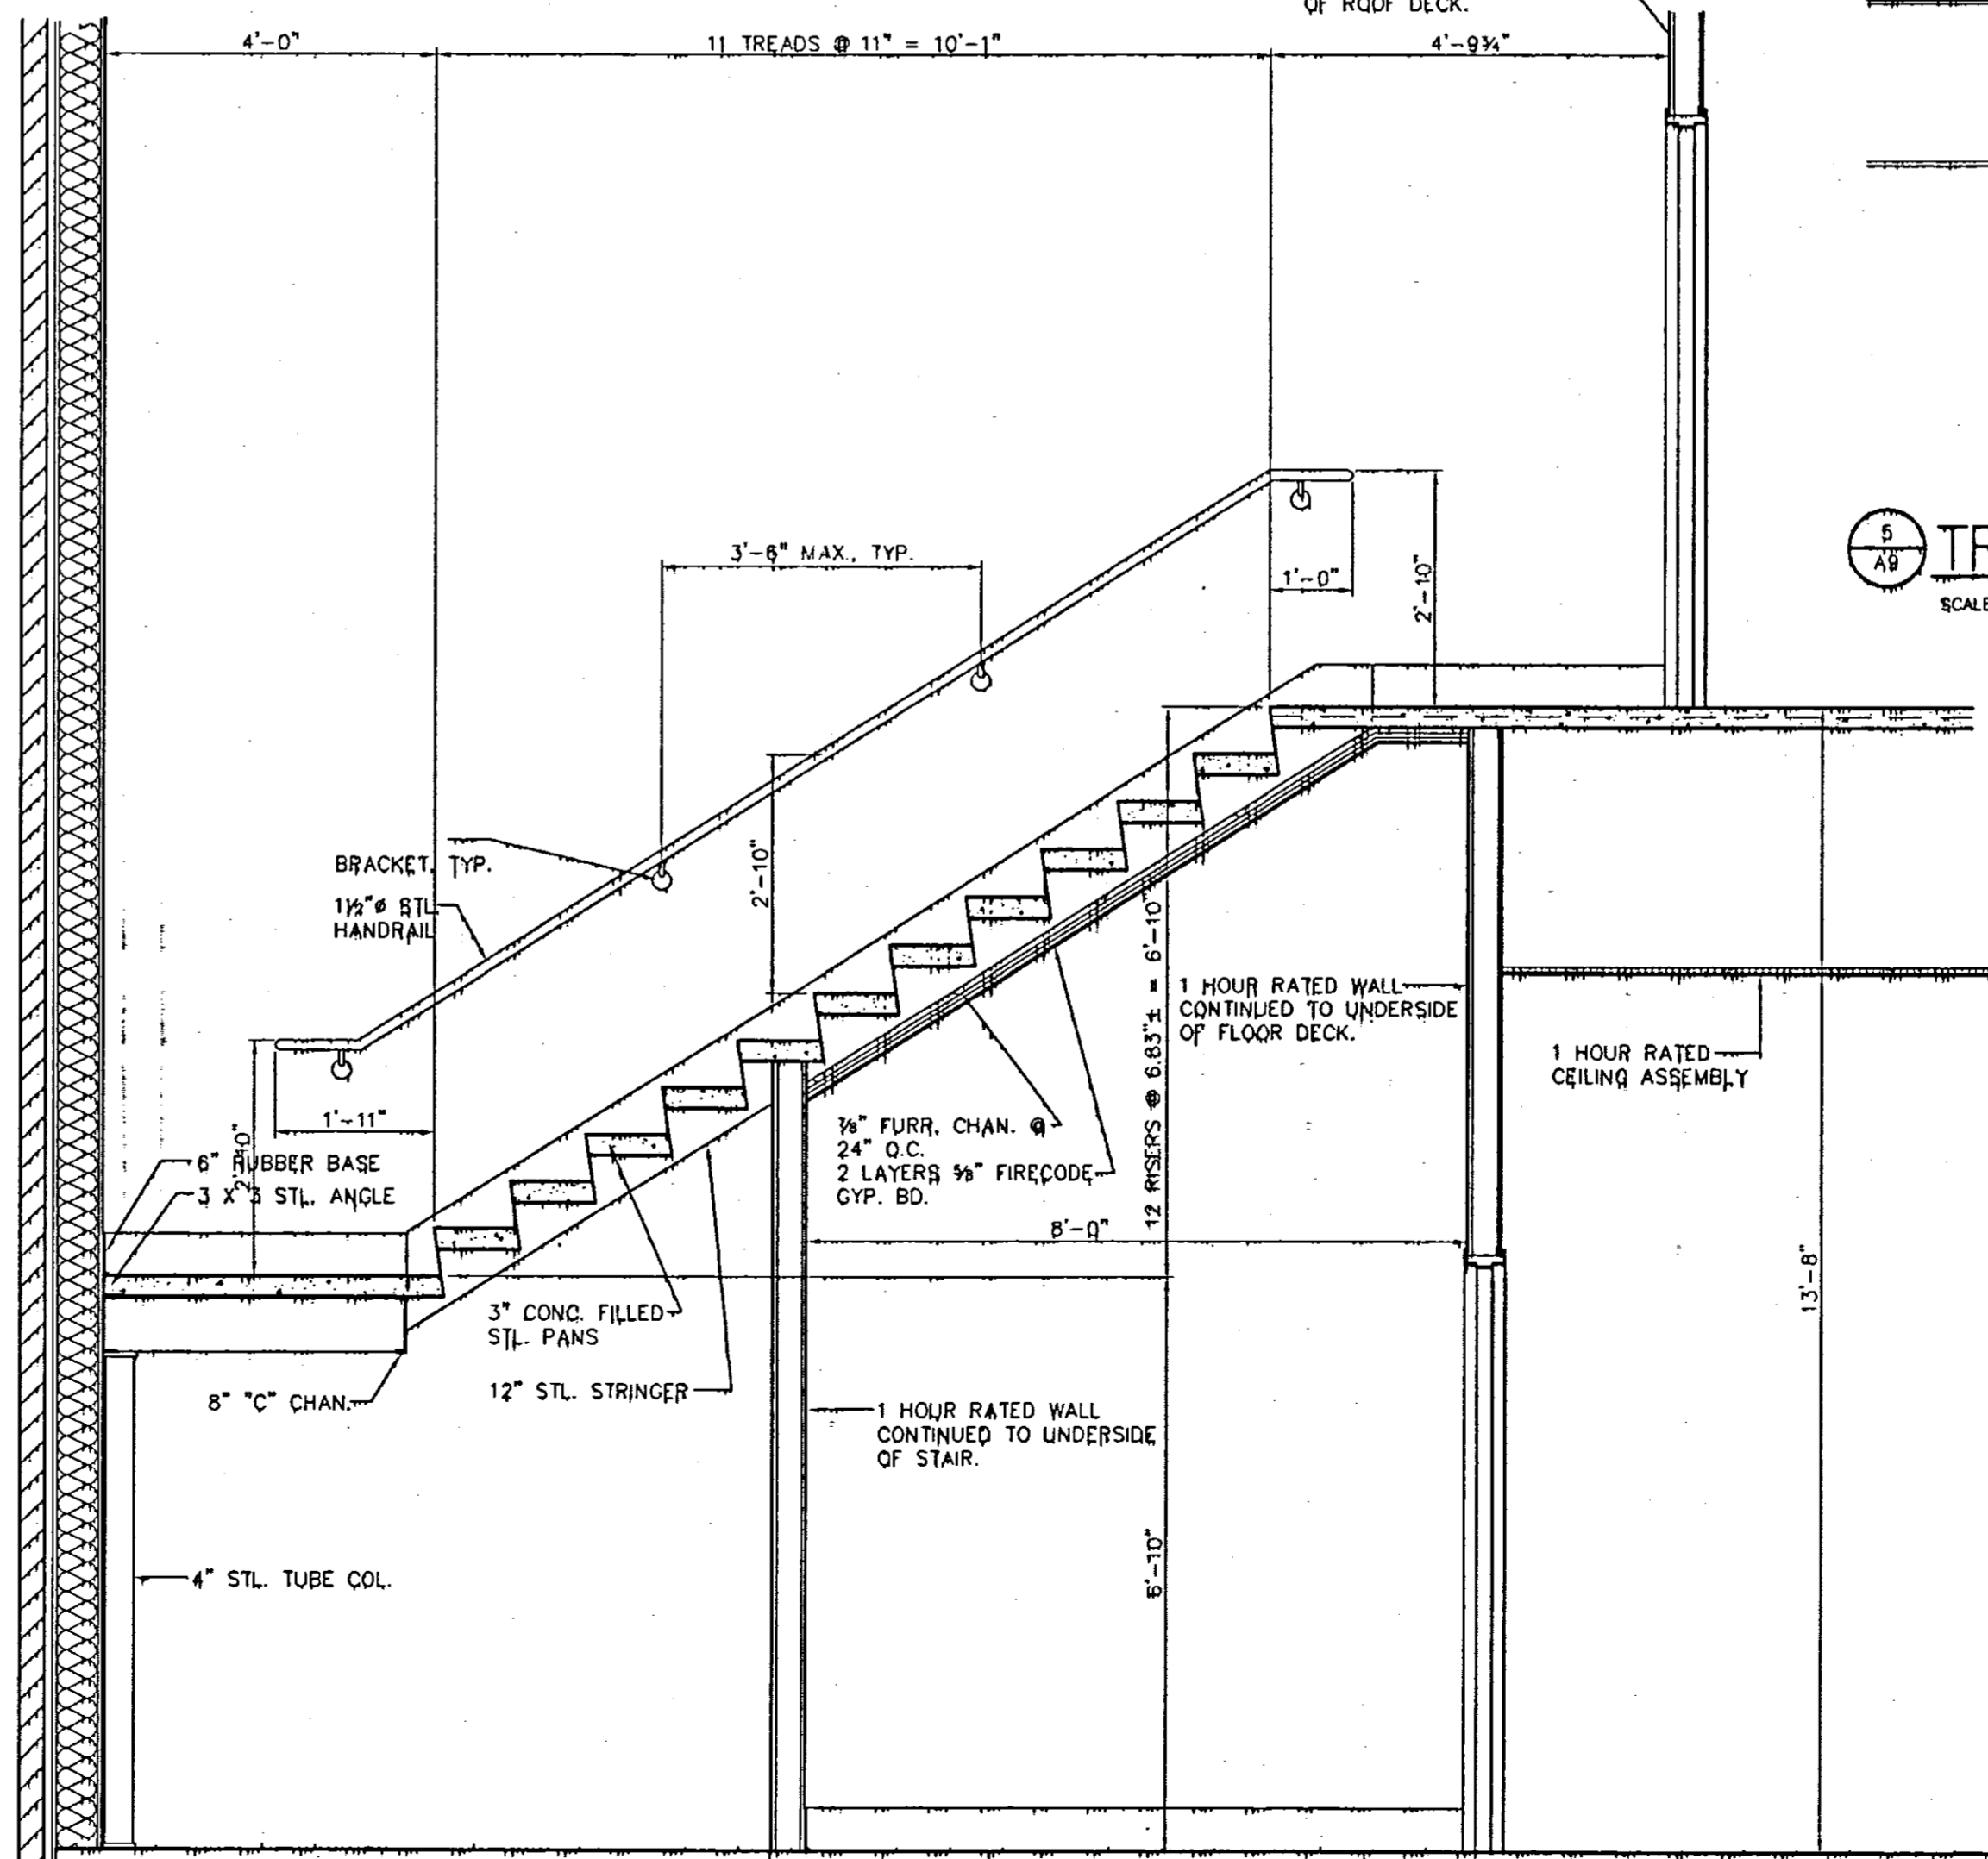

**4**  
**A9** STAIR SECTION  
 SCALE: 1/2" = 1'-0"

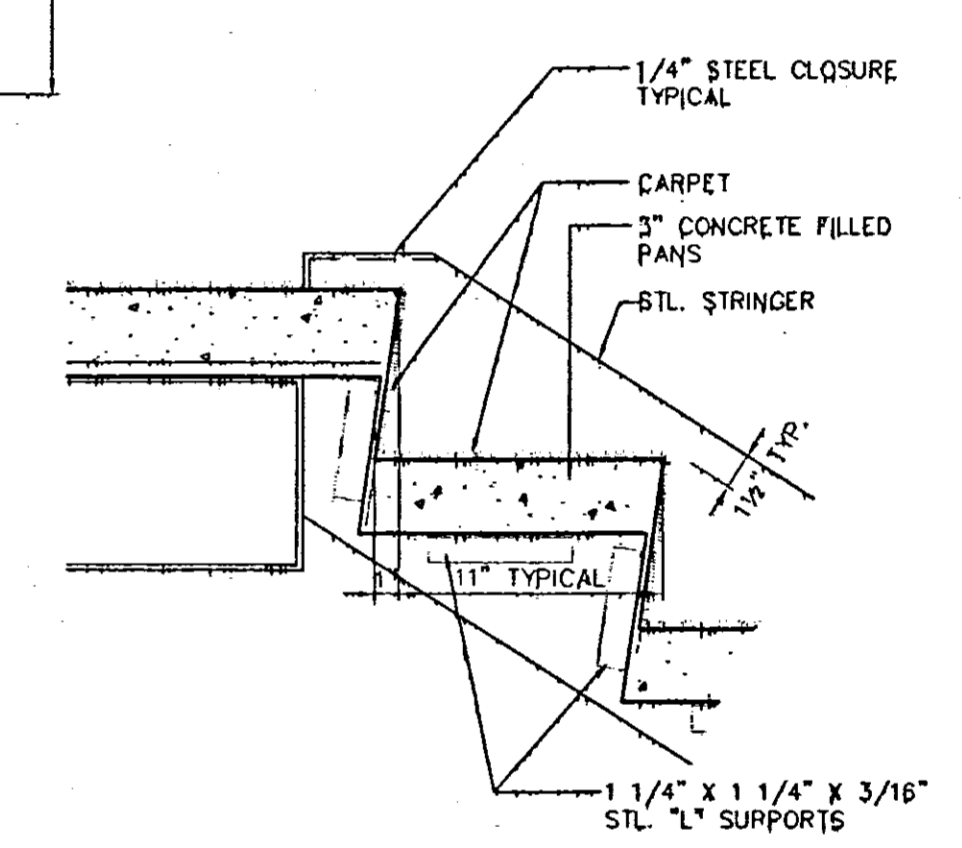


**5**  
**A9** TREAD/RISER DETAIL  
 SCALE: 1 1/2" = 1'-0"

Woolridge & Associates 6/15/2001 9:49 AM base sheet 2.dwg






REVISIONS	BY

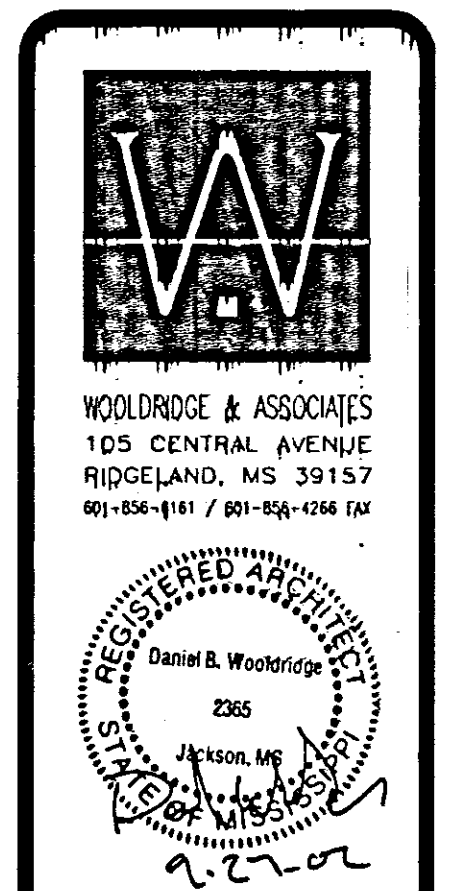


A New Building for  
**CHURCH OF THE HIGHLANDS**  
Ridgeland, Mississippi

THIS DESIGN IS THE COPYRIGHTED PROPERTY OF WOOLDRIDGE & ASSOCIATES. IT MAY NOT BE REPRODUCED FROM THIS DESIGN WITHOUT THE EXPRESS WRITTEN PERMISSION OF WOOLDRIDGE & ASSOCIATES.


DRAWN	
CHECKED	
DATE	
SCALE	
JOB NO.	
SHEET	
A11	
OF	SHEETS

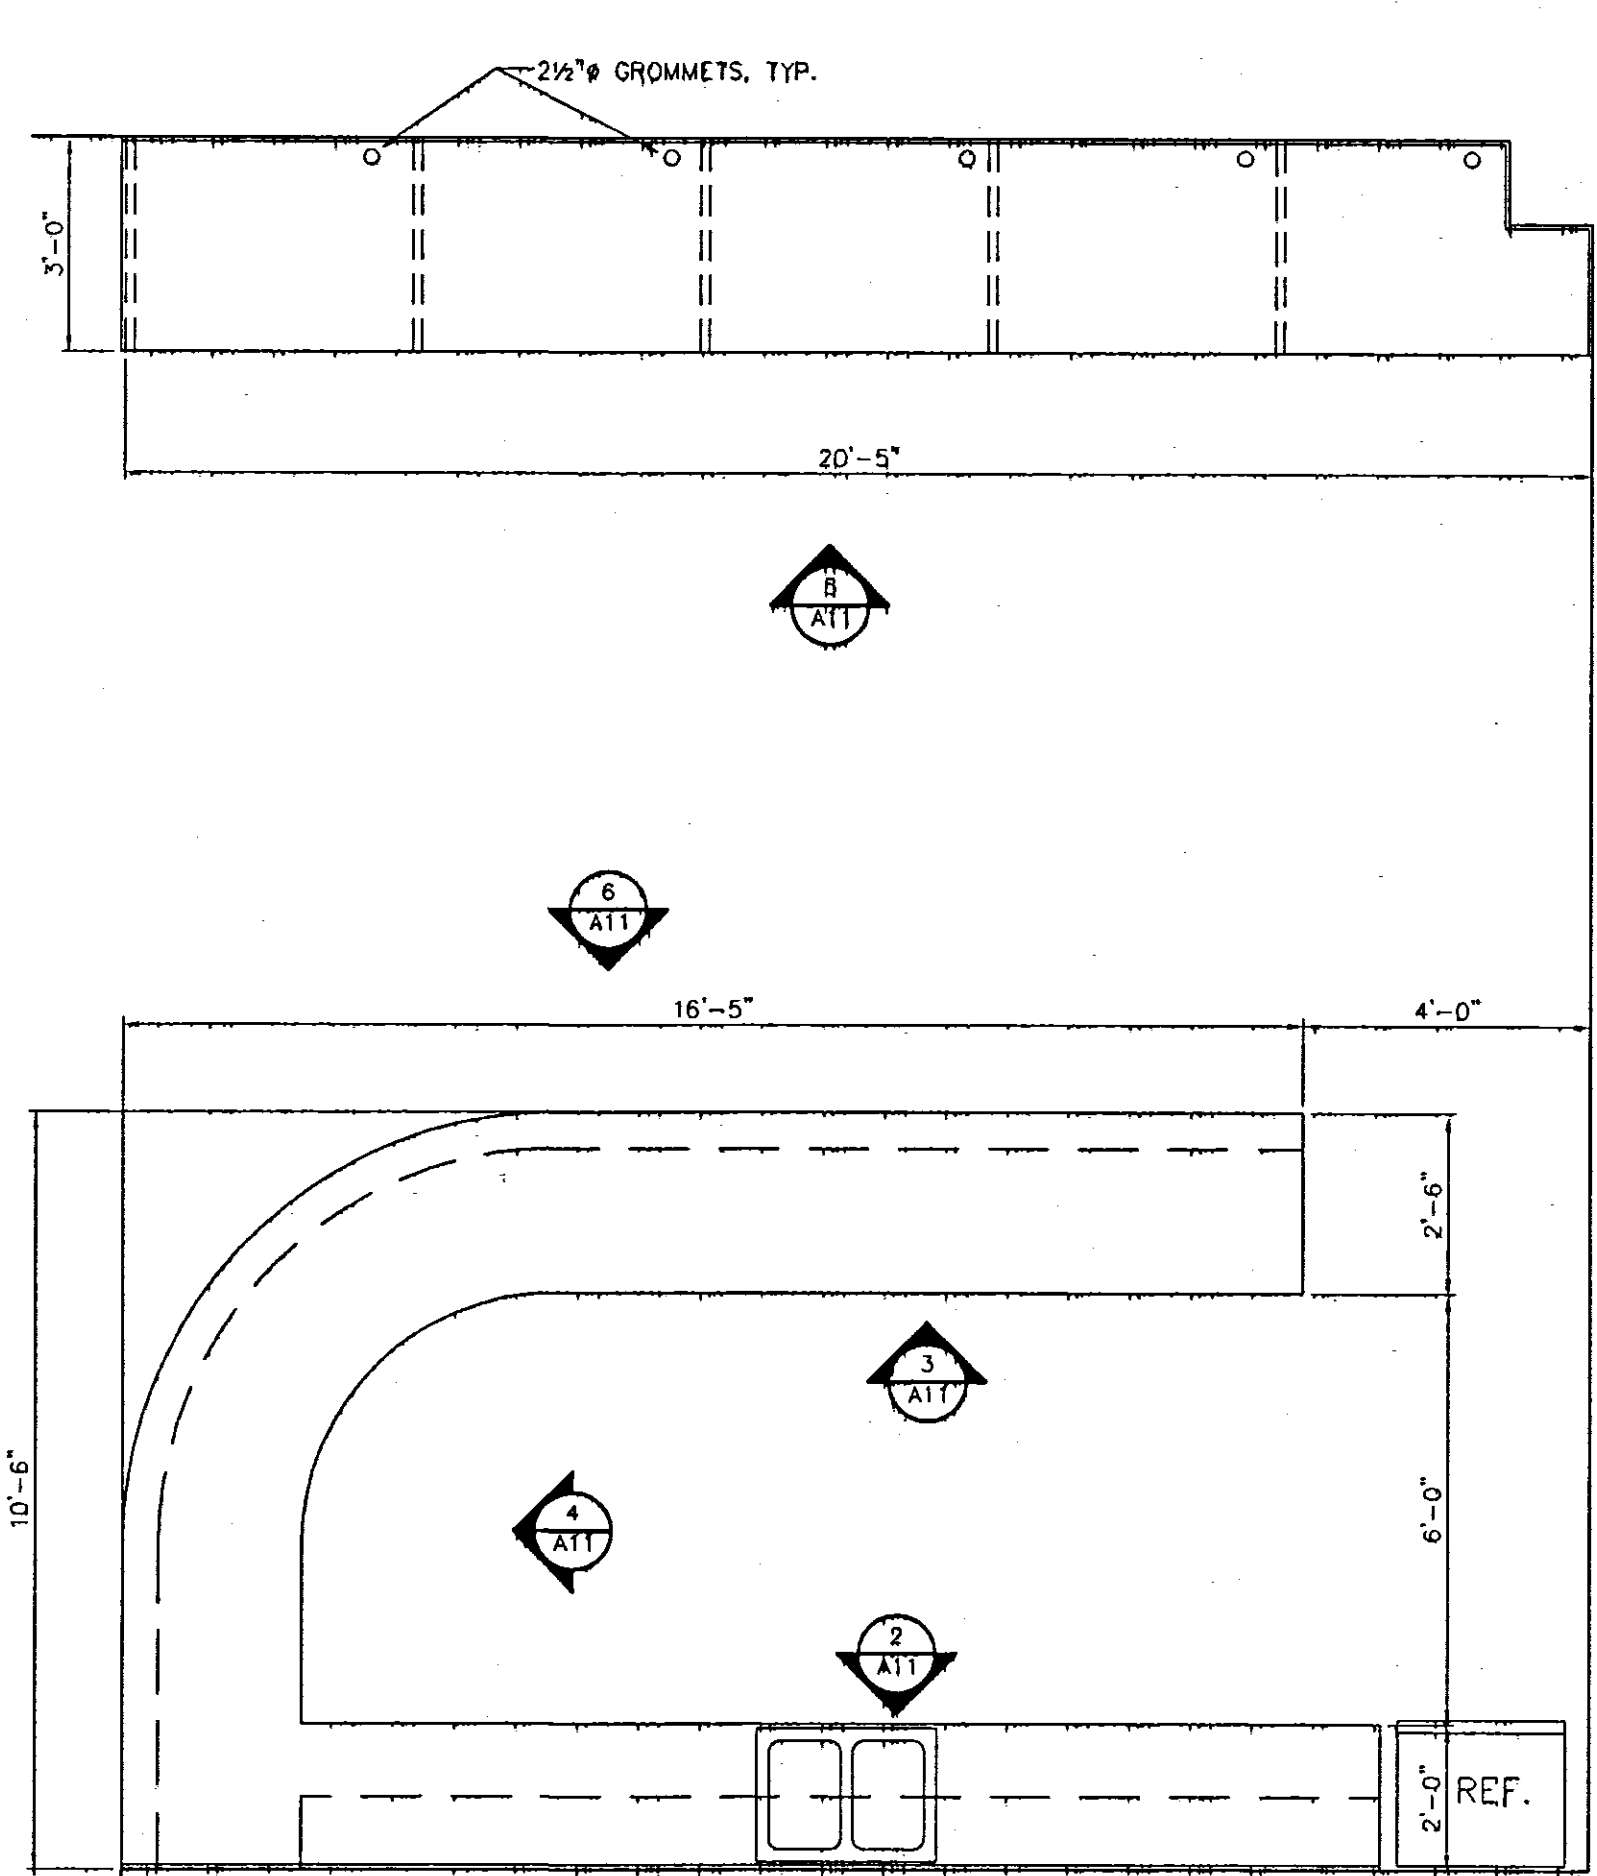


**1 PLAN-CAB. @ YOUTH LOUNGE, RM. 205**  
SCALE: 3/8" = 1'-0"

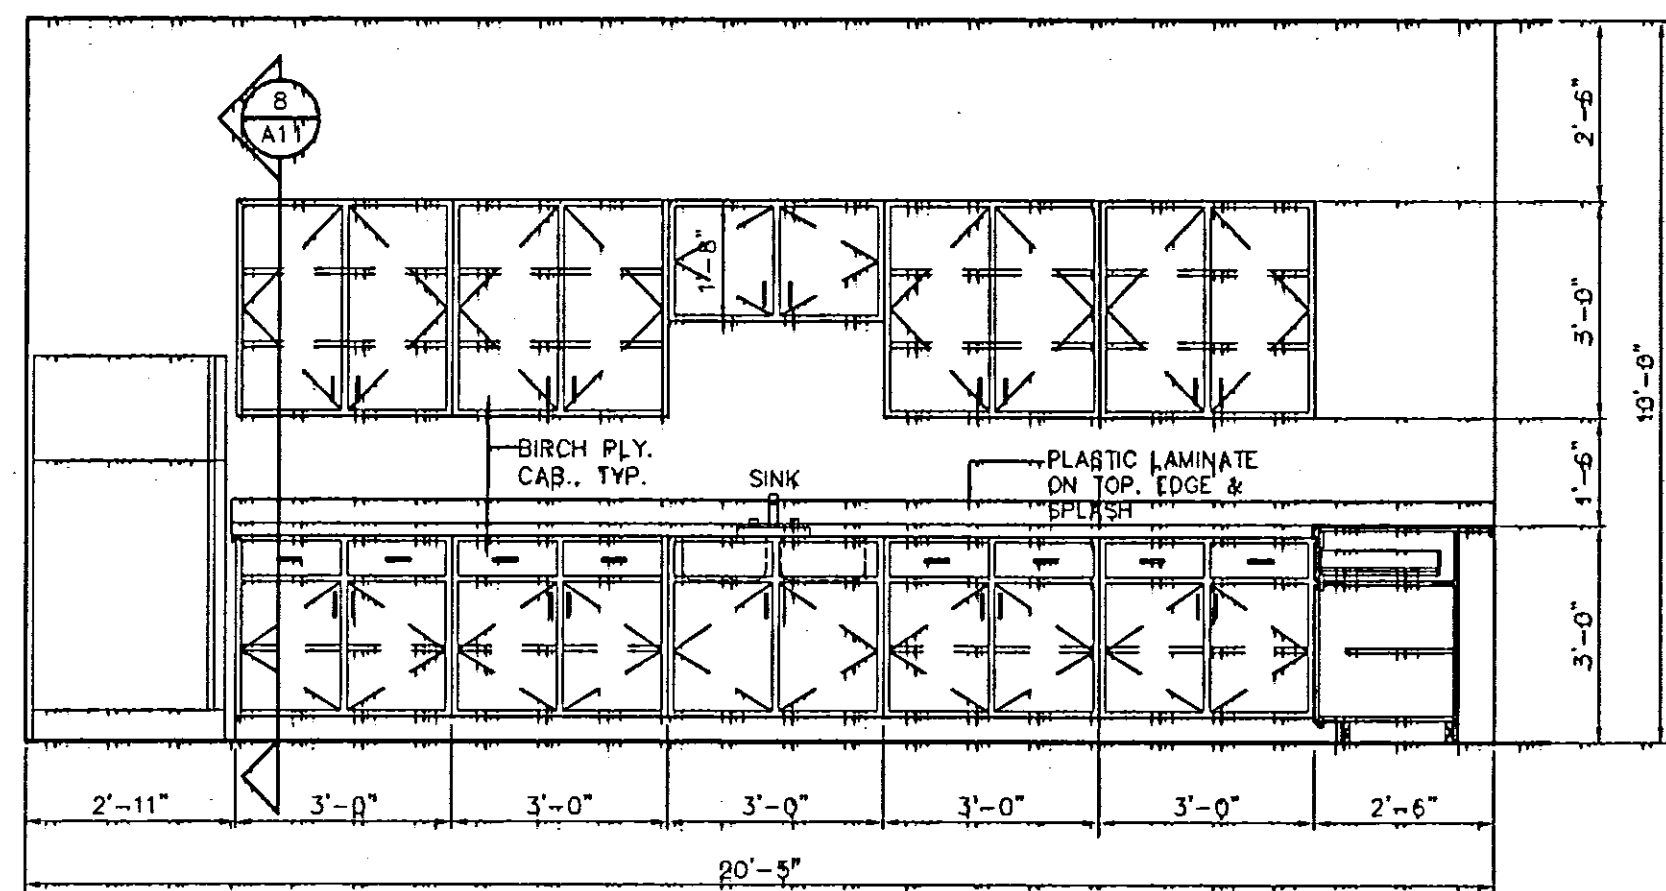


**2 ELEVATION**  
SCALE: 3/8" = 1'-0"

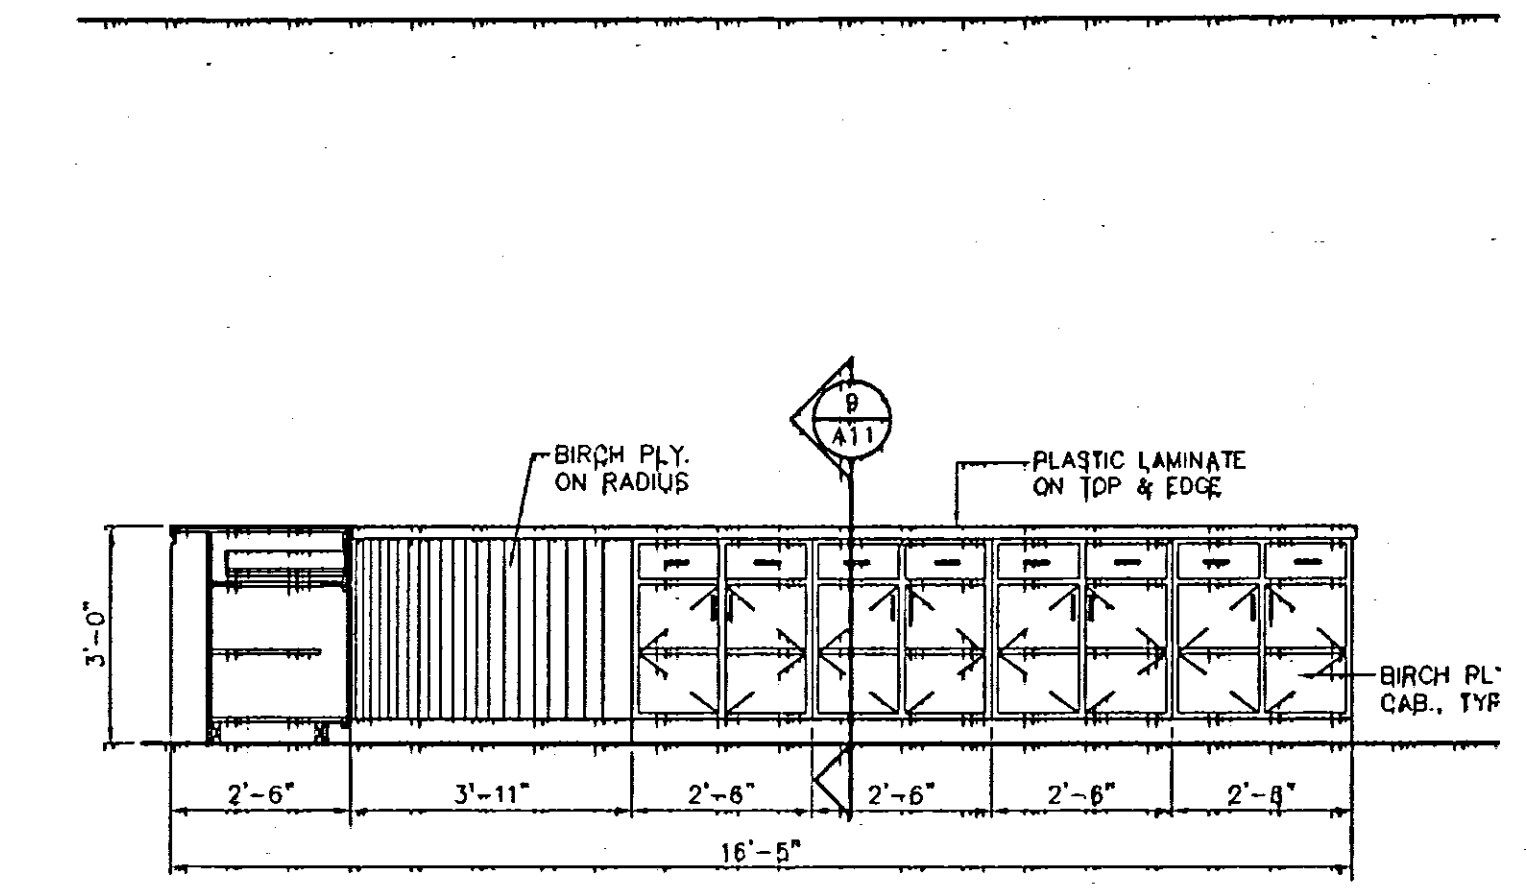


**3 ELEVATION**  
SCALE: 3/8" = 1'-0"

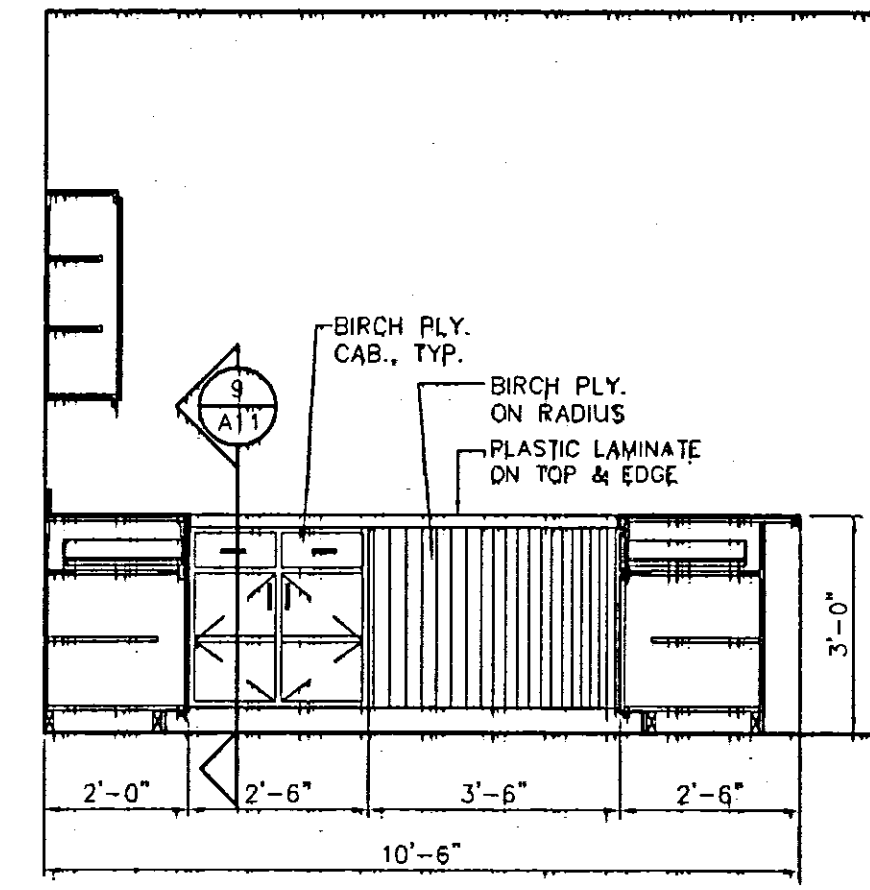


**4 ELEVATION**  
SCALE: 3/8" = 1'-0"

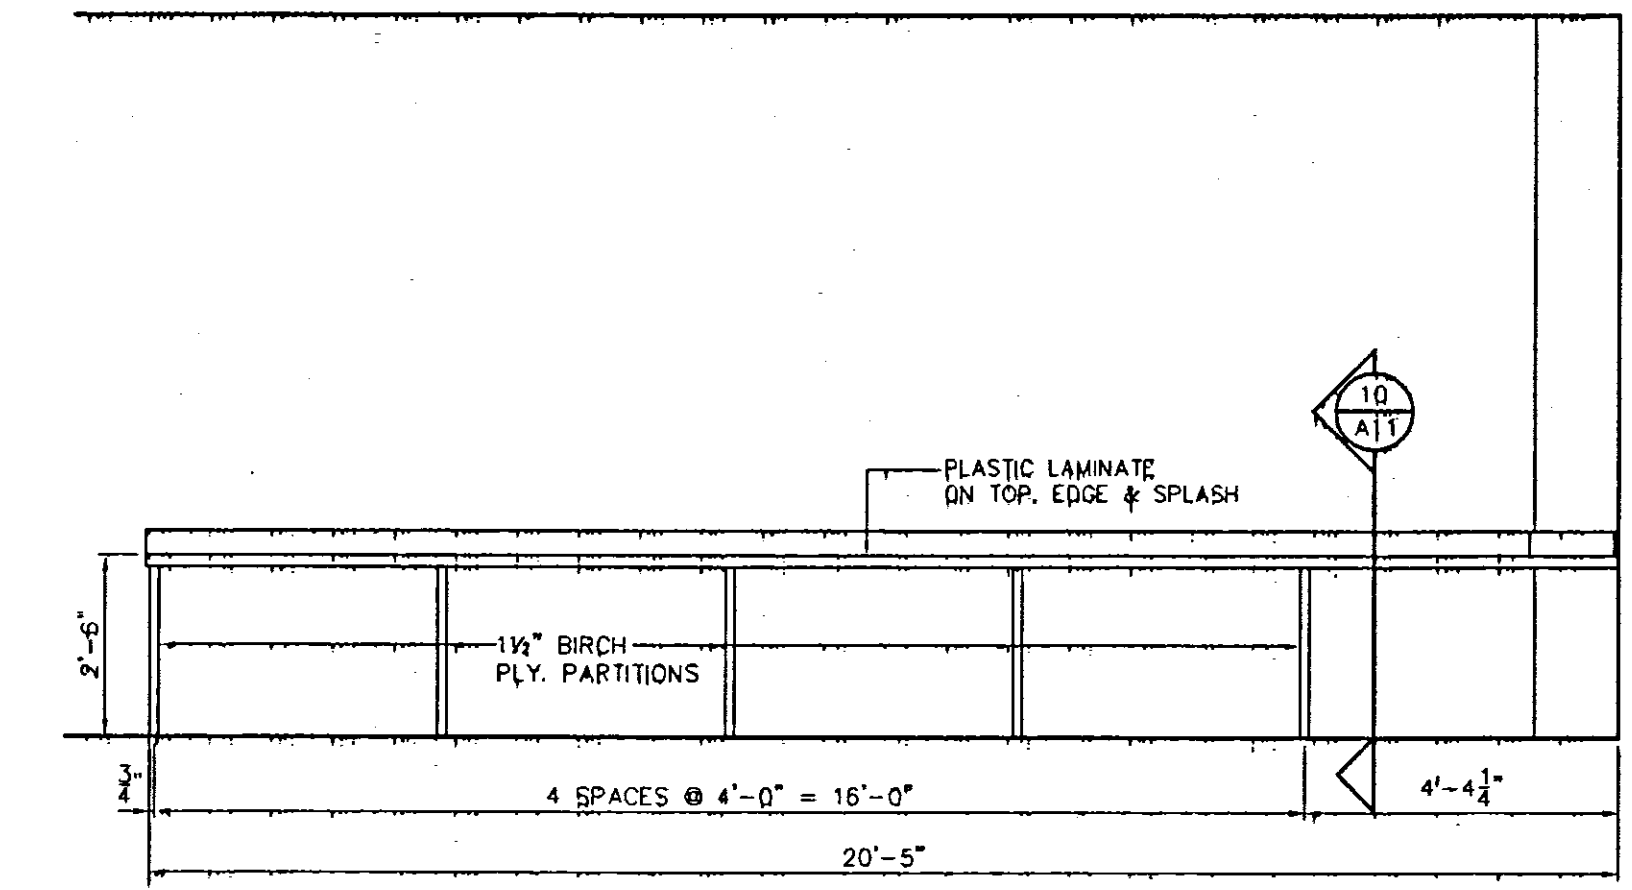


**5 ELEVATION**  
SCALE: 3/8" = 1'-0"

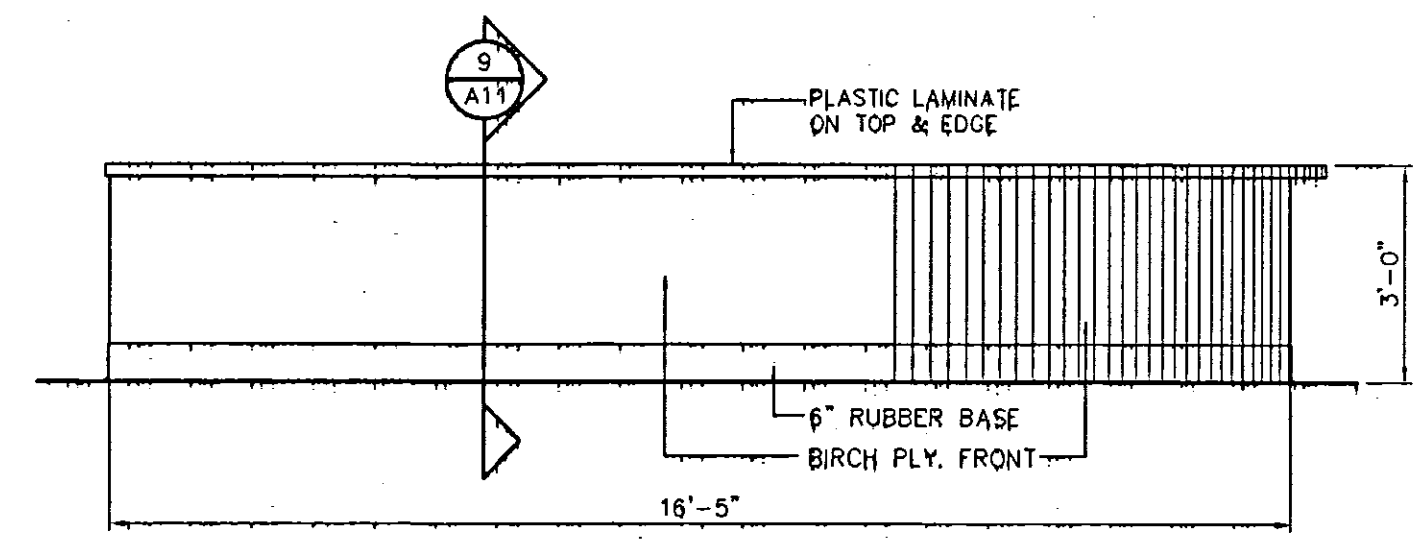


**6 ELEVATION**  
SCALE: 3/8" = 1'-0"

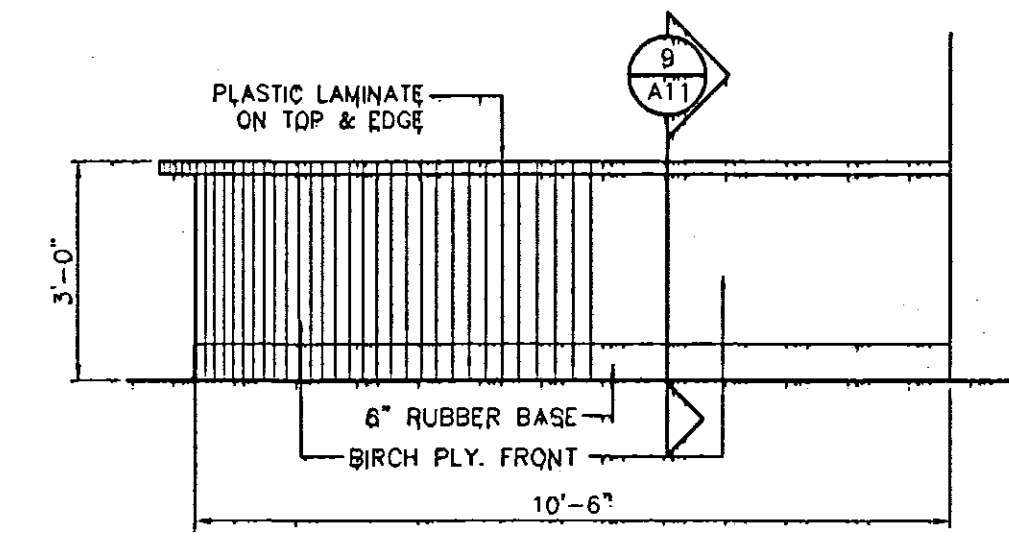


**7 ELEVATION**  
SCALE: 3/8" = 1'-0"

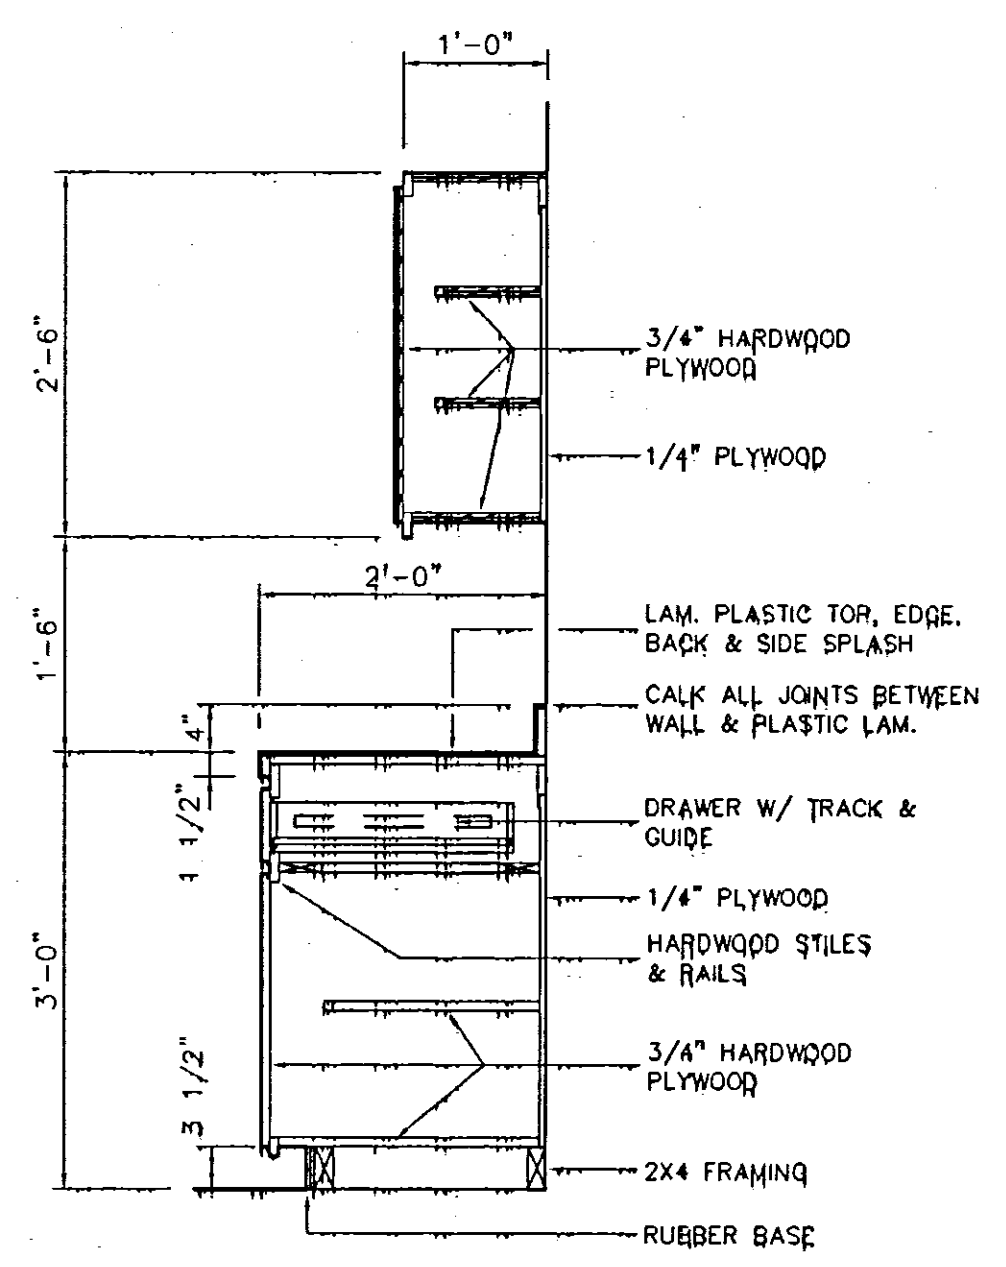

**8 SECTION**  
SCALE: 3/4" = 1'-0"

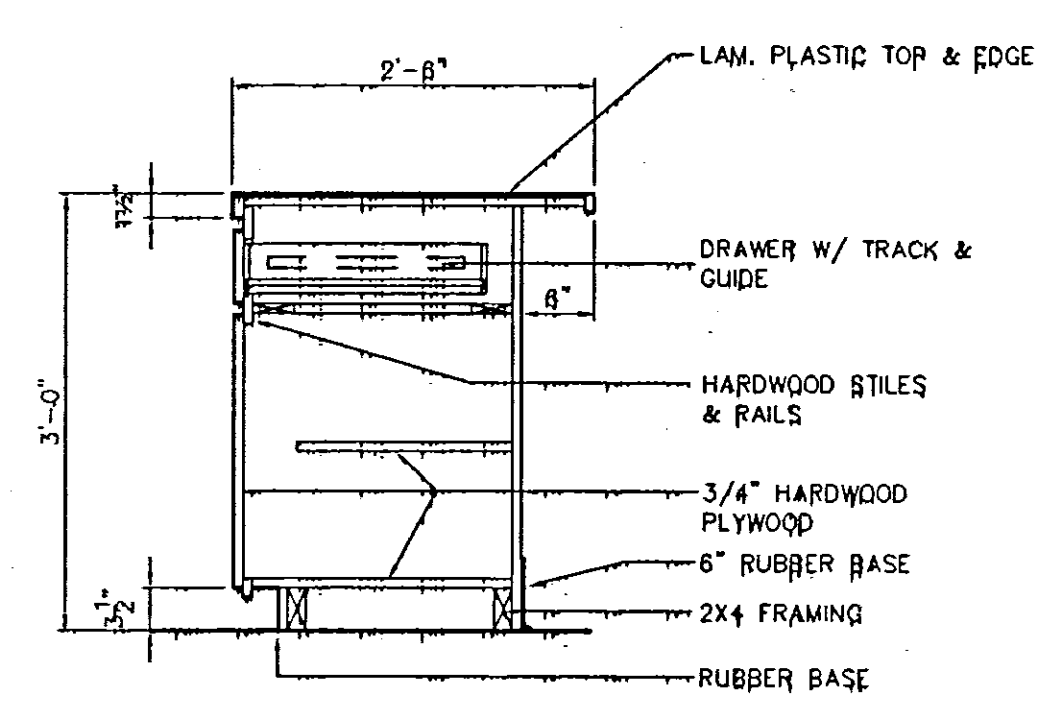


**9 SECTION**  
SCALE: 3/4" = 1'-0"

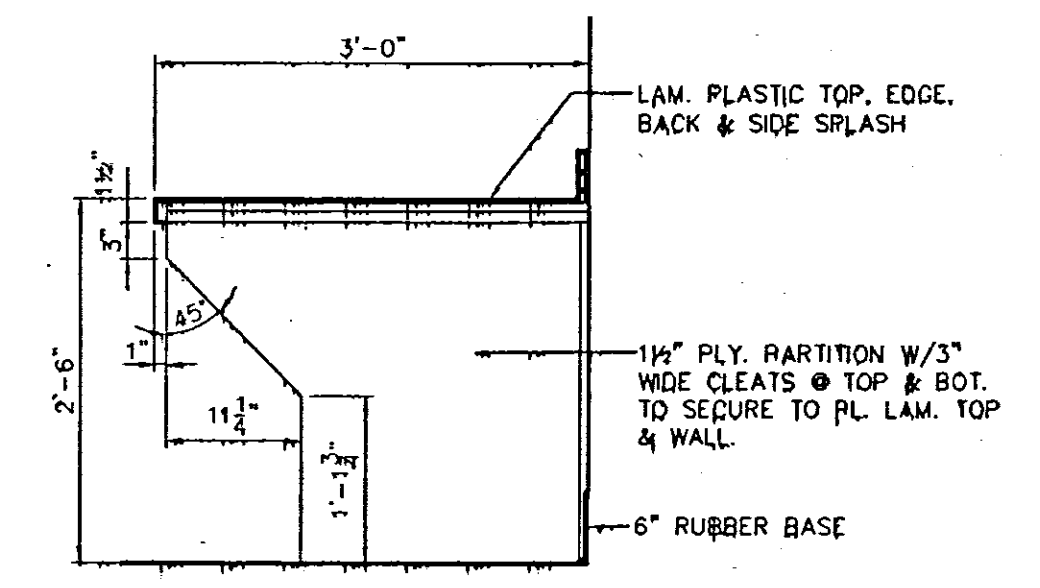


**10 SECTION**  
SCALE: 3/4" = 1'-0"

Woodriddle & Associates 6/15/2001 9:49 AM basesheet2.dwg

REVISIONS	BY

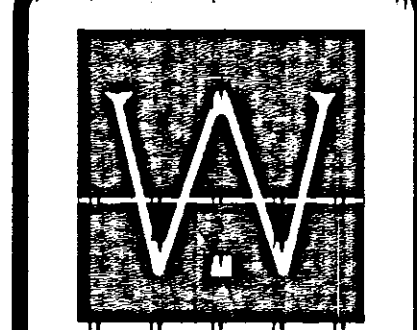


WOODRIDDLE & ASSOCIATES  
 105 CENTRAL AVENUE  
 RIDGELAND, MS 39157  
 601-856-1161 / 601-856-1266 fax

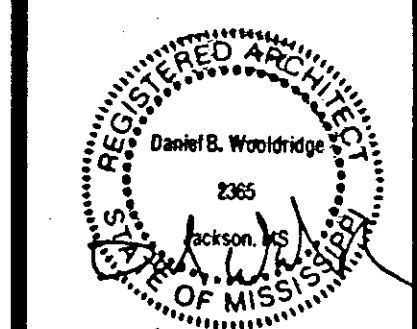


A New Building for  
**CHURCH OF THE HIGHLANDS**  
 Ridgeland, Mississippi

THIS DESIGN IS THE COPYRIGHTED PROPERTY OF WOODRIDDLE & ASSOCIATES. IT MAY NOT BE REPRODUCED FROM THIS DESIGN WITHOUT THE EXPRESS WRITTEN PERMISSION OF WOODRIDDLE & ASSOCIATES.

DRAWN	
CHECKED	
DATE	
SCALE	
JOB NO.	
SHEET	
A12	
OF	SHEETS

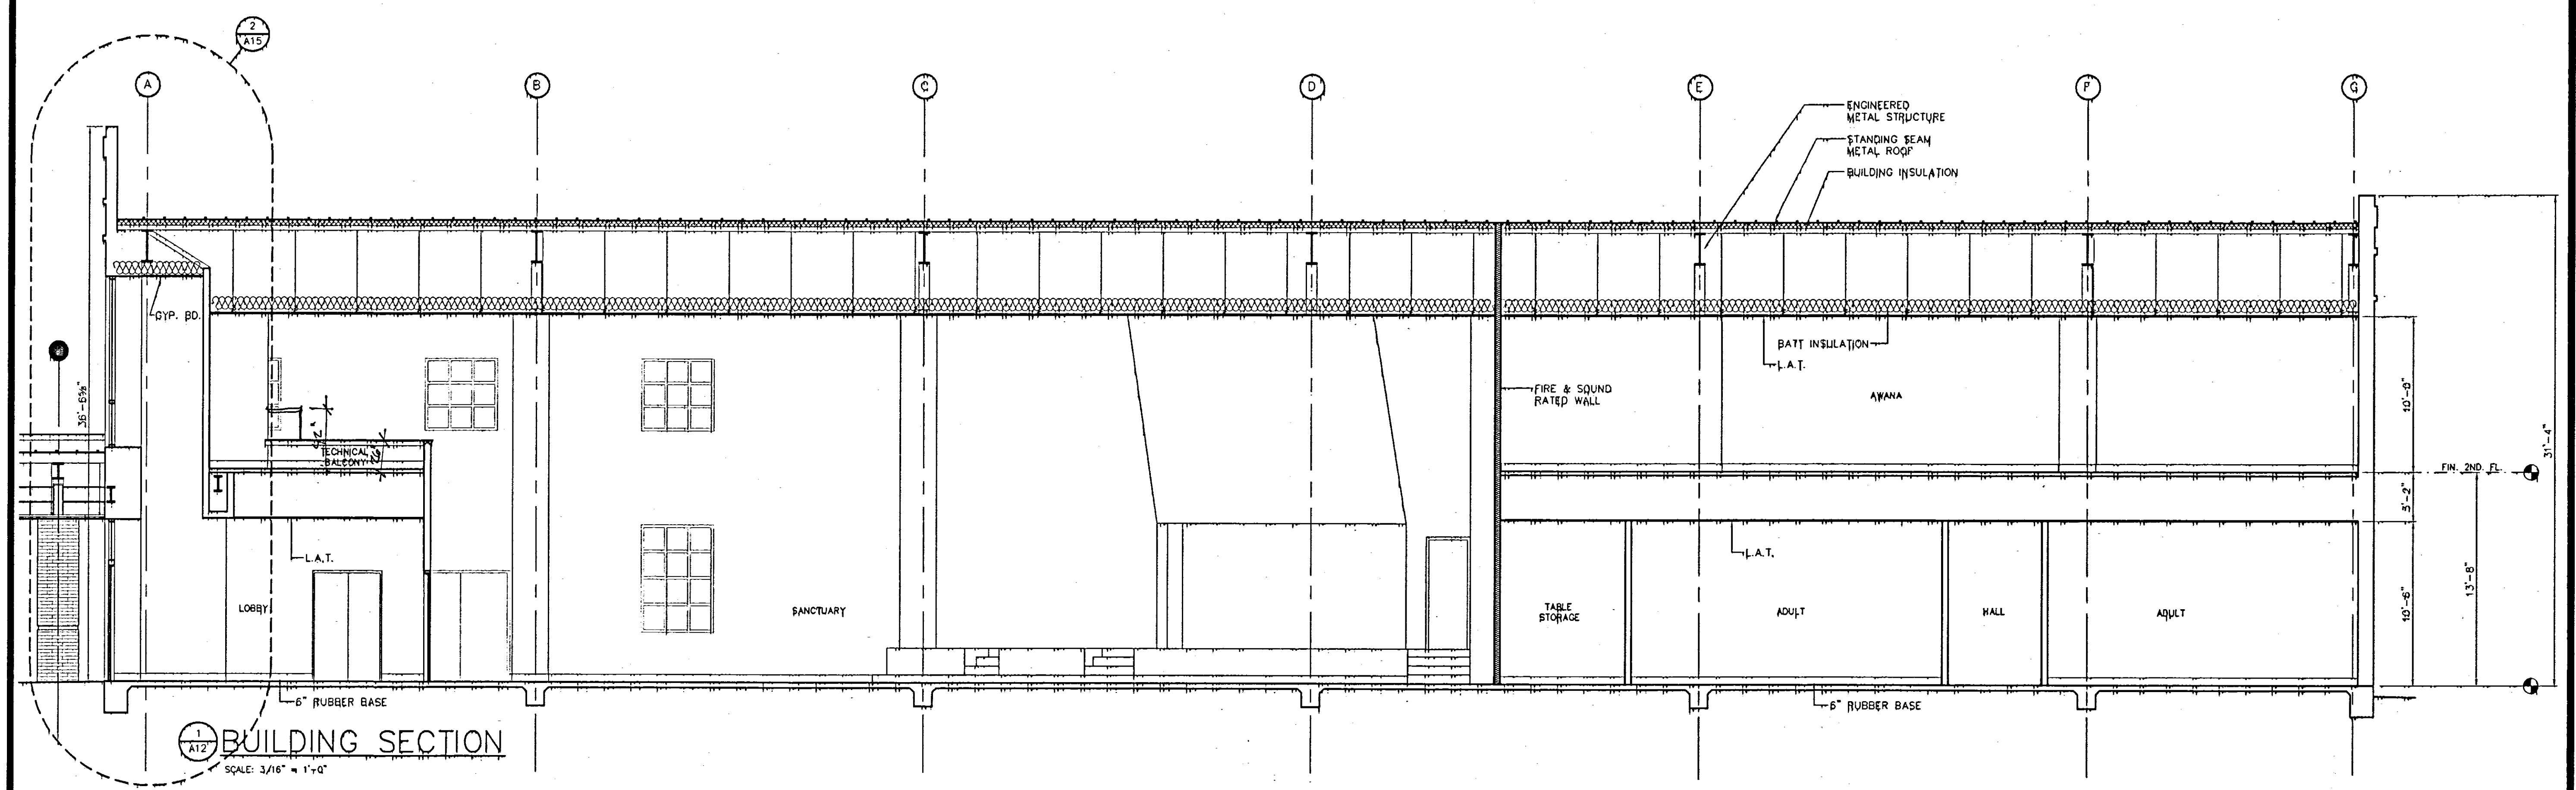


**1 BUILDING SECTION**  
 SCALE: 3/16" = 1'-0"

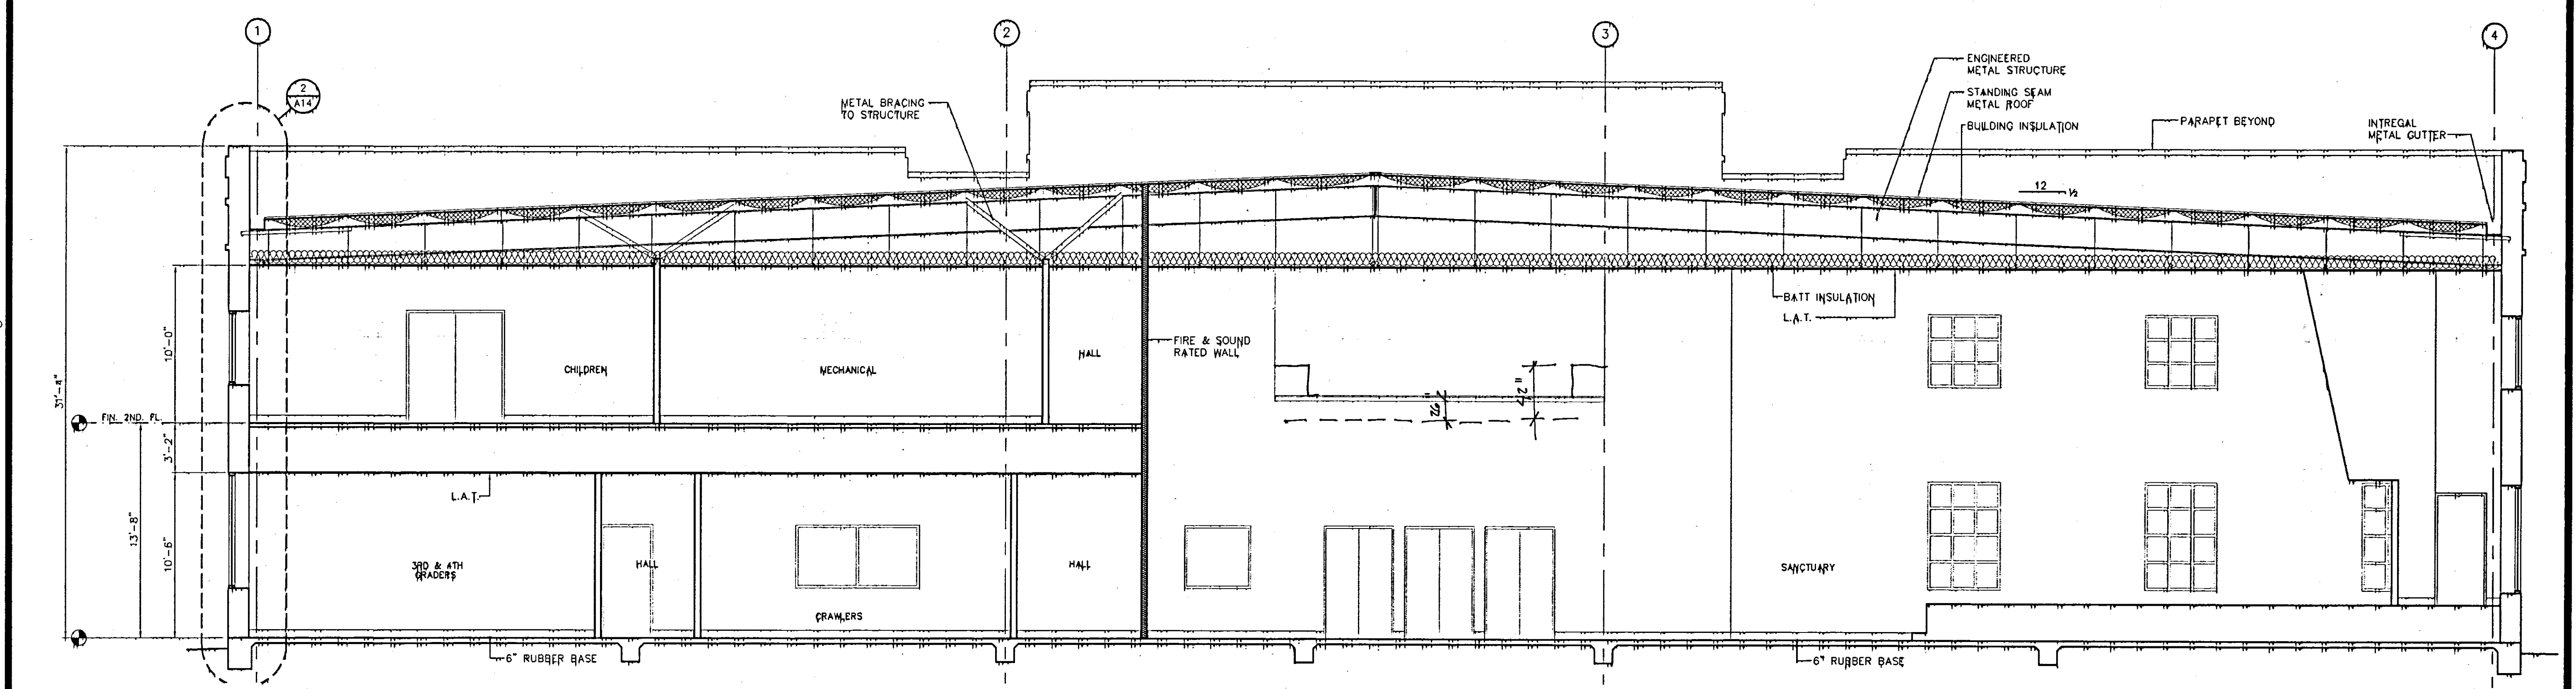


**2 BUILDING SECTION**  
 SCALE: 3/16" = 1'-0"

Woodriddle & Associates 6/15/2001 9:49 AM base sheet 12.dwg


Woolridge & Associates 6/15/2001 949 - AM Base sheet 2.dwg

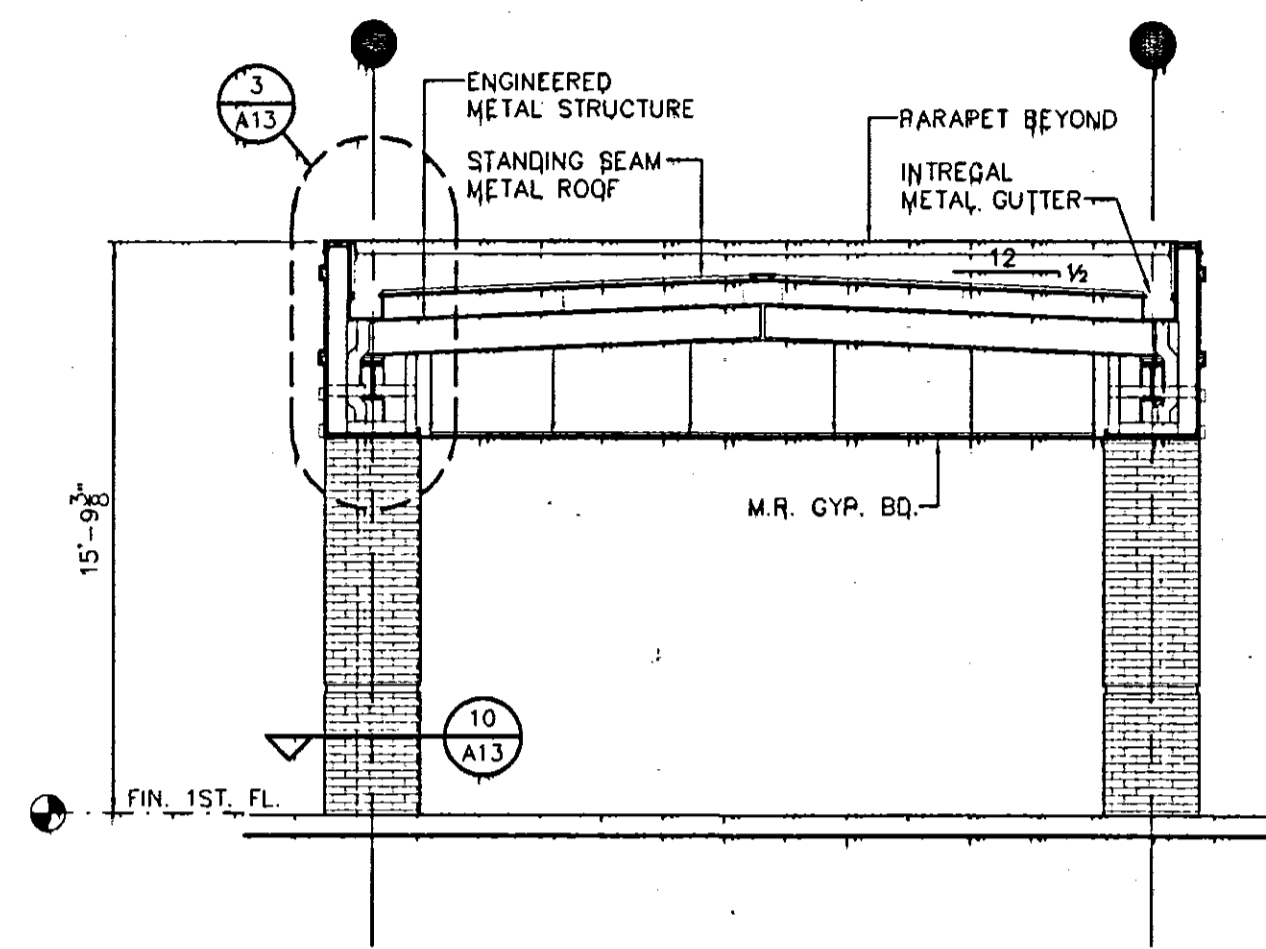


1 CANOPY TRANSVERSE SECTION  
SCALE: 3/16" = 1'-0"

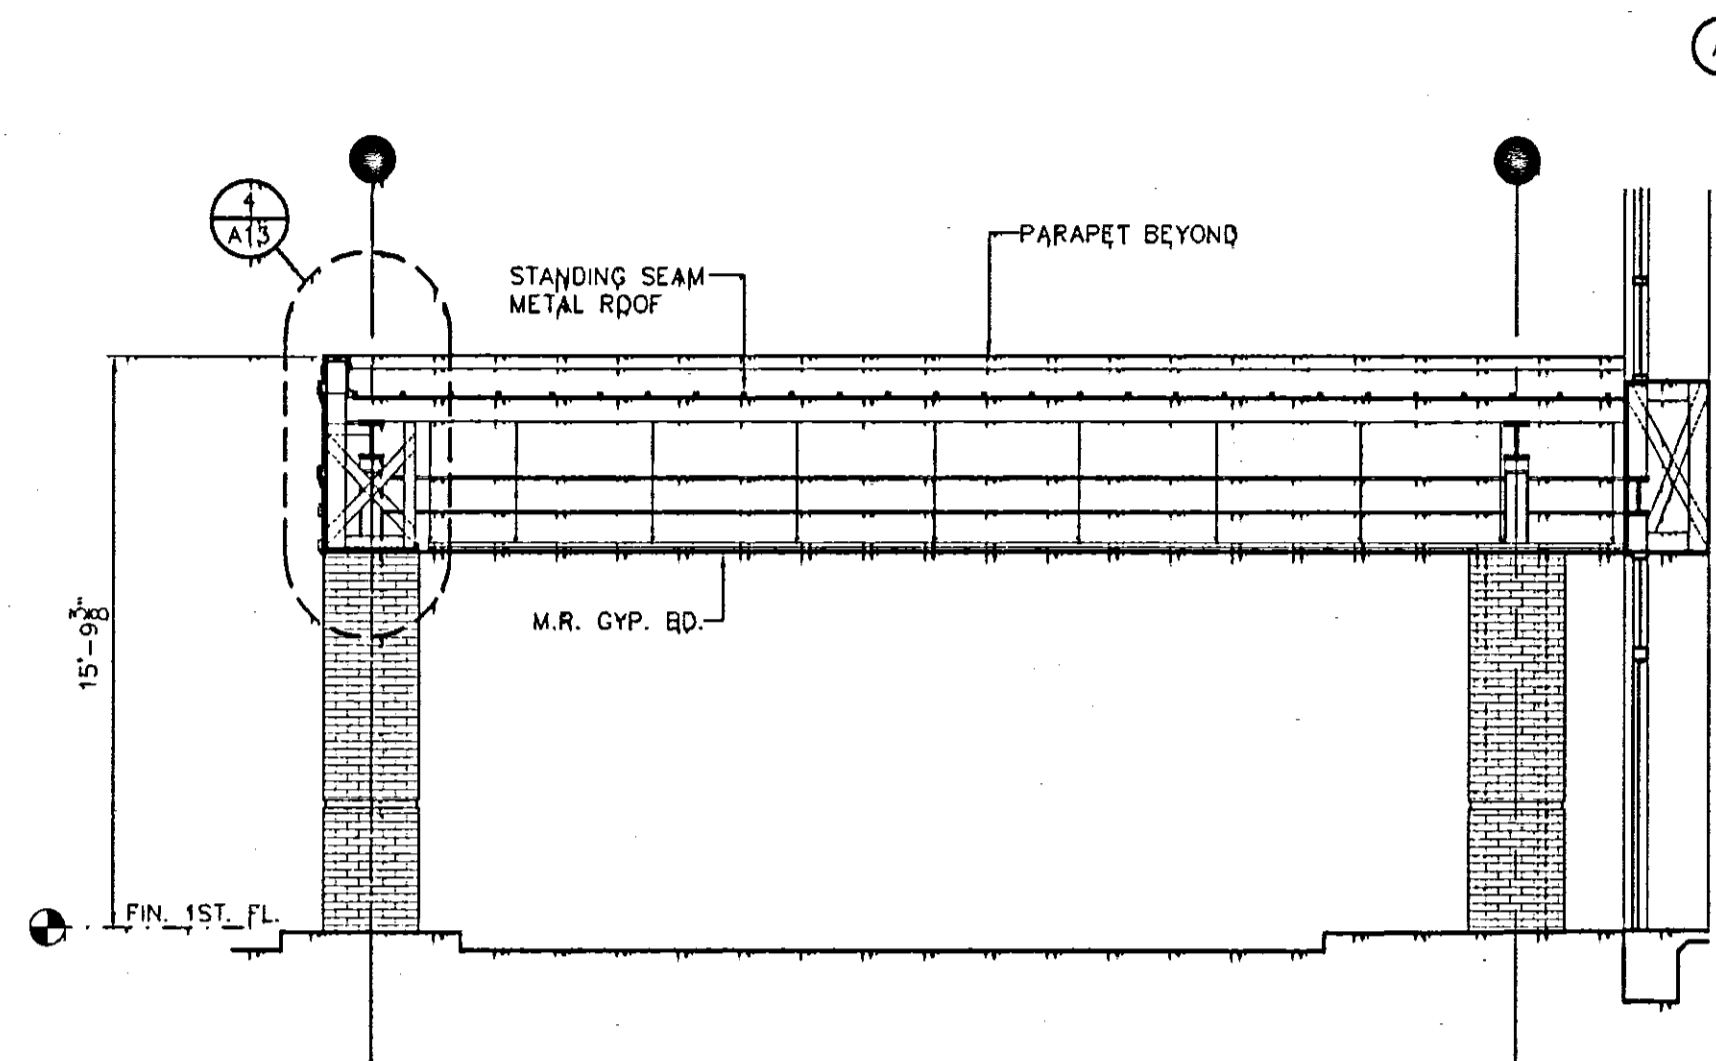


2 CANOPY LONGITUDINAL SECTION  
SCALE: 3/16" = 1'-0"

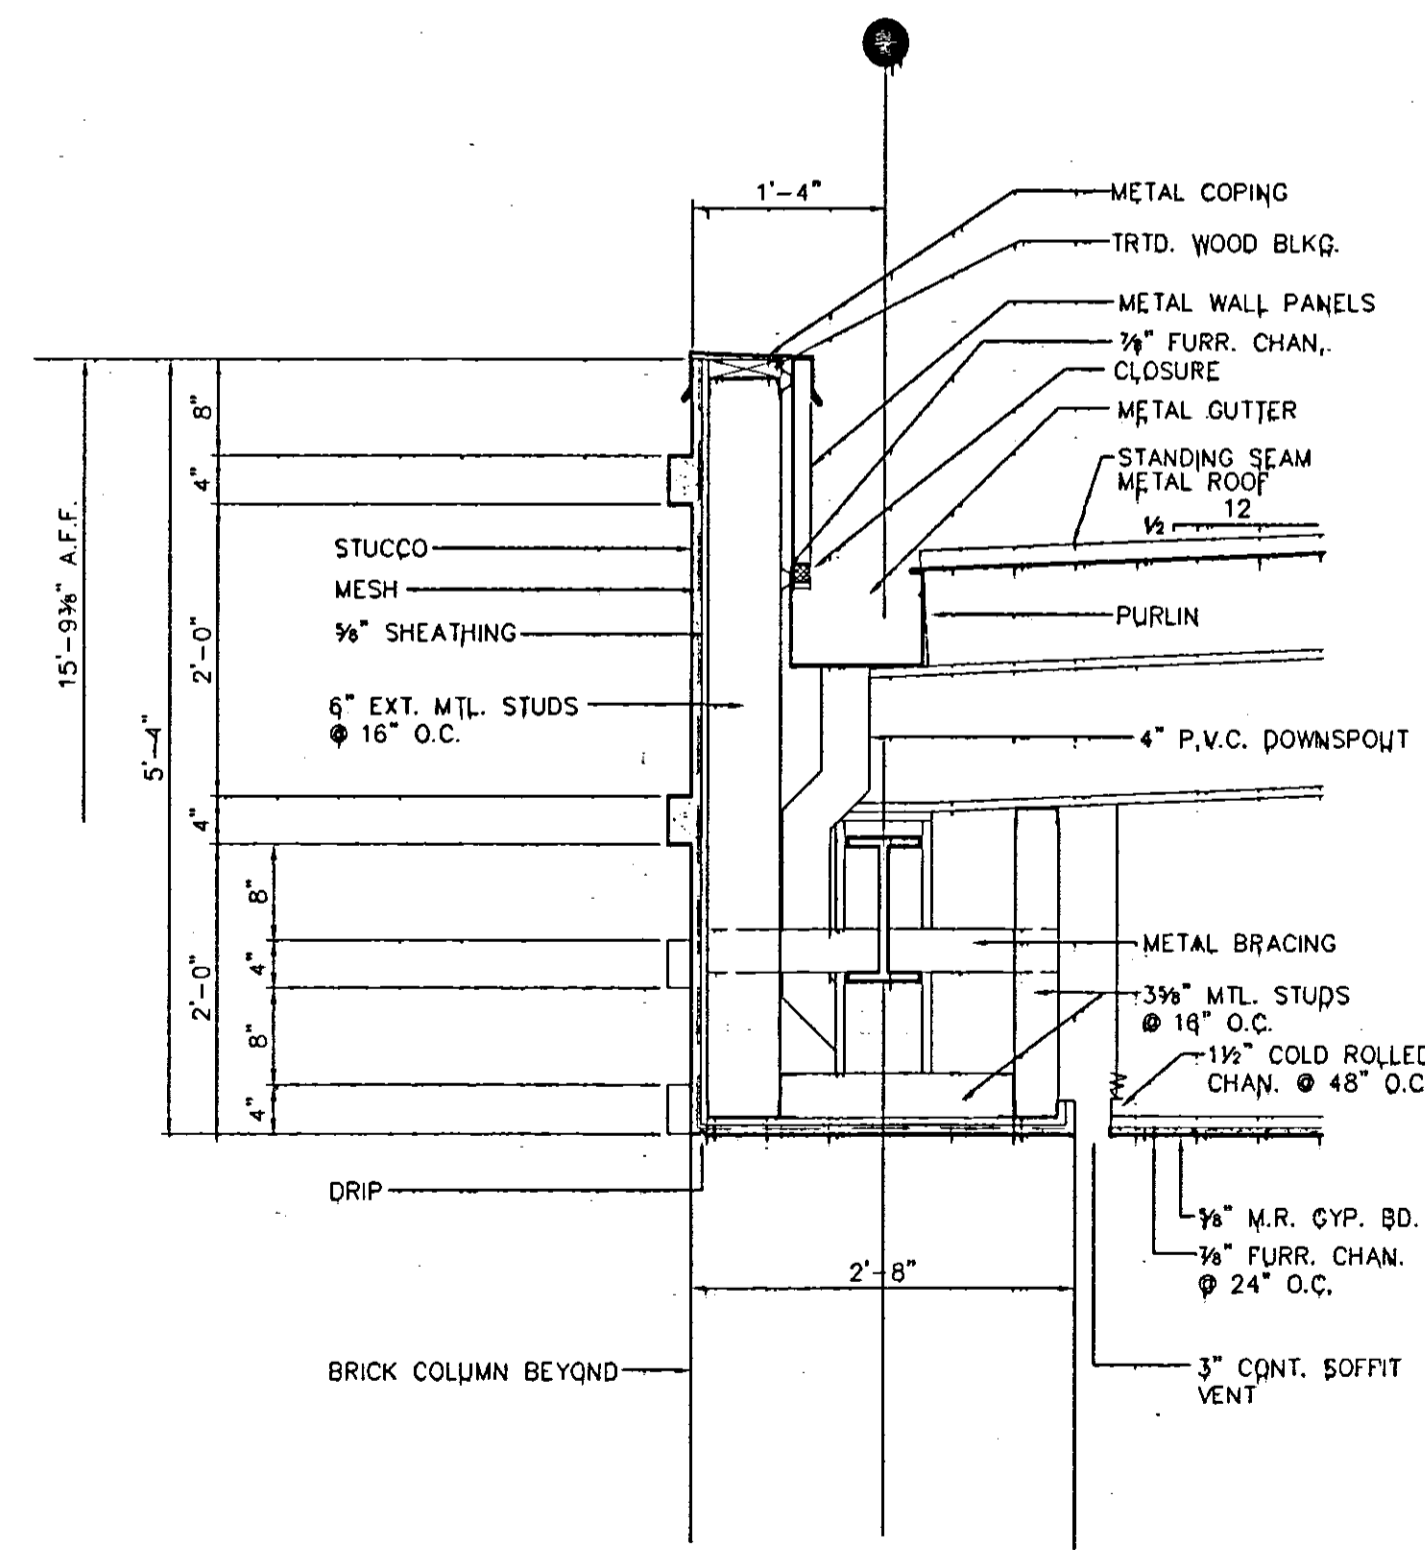


3 CANOPY RAKE DETAIL  
SCALE: 3/4" = 1'-0"

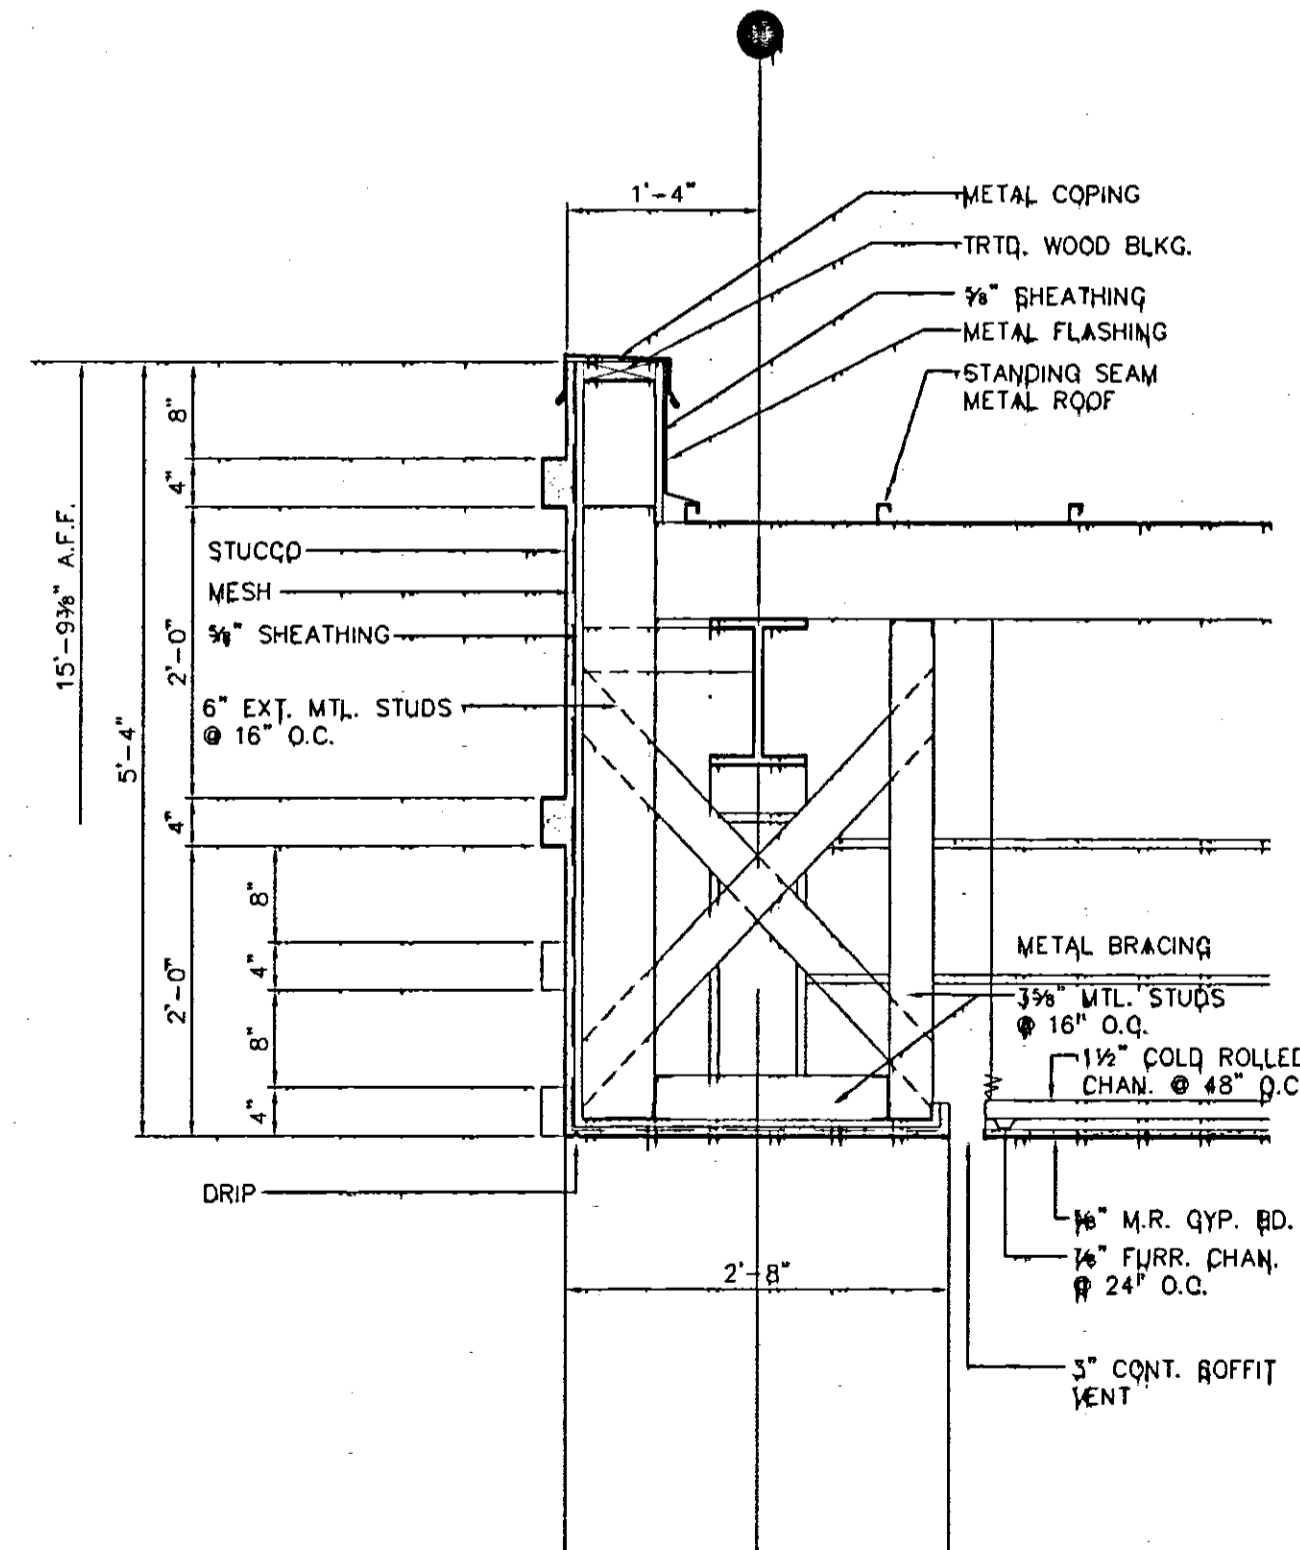


4 CANOPY EAVE DETAIL  
SCALE: 3/4" = 1'-0"

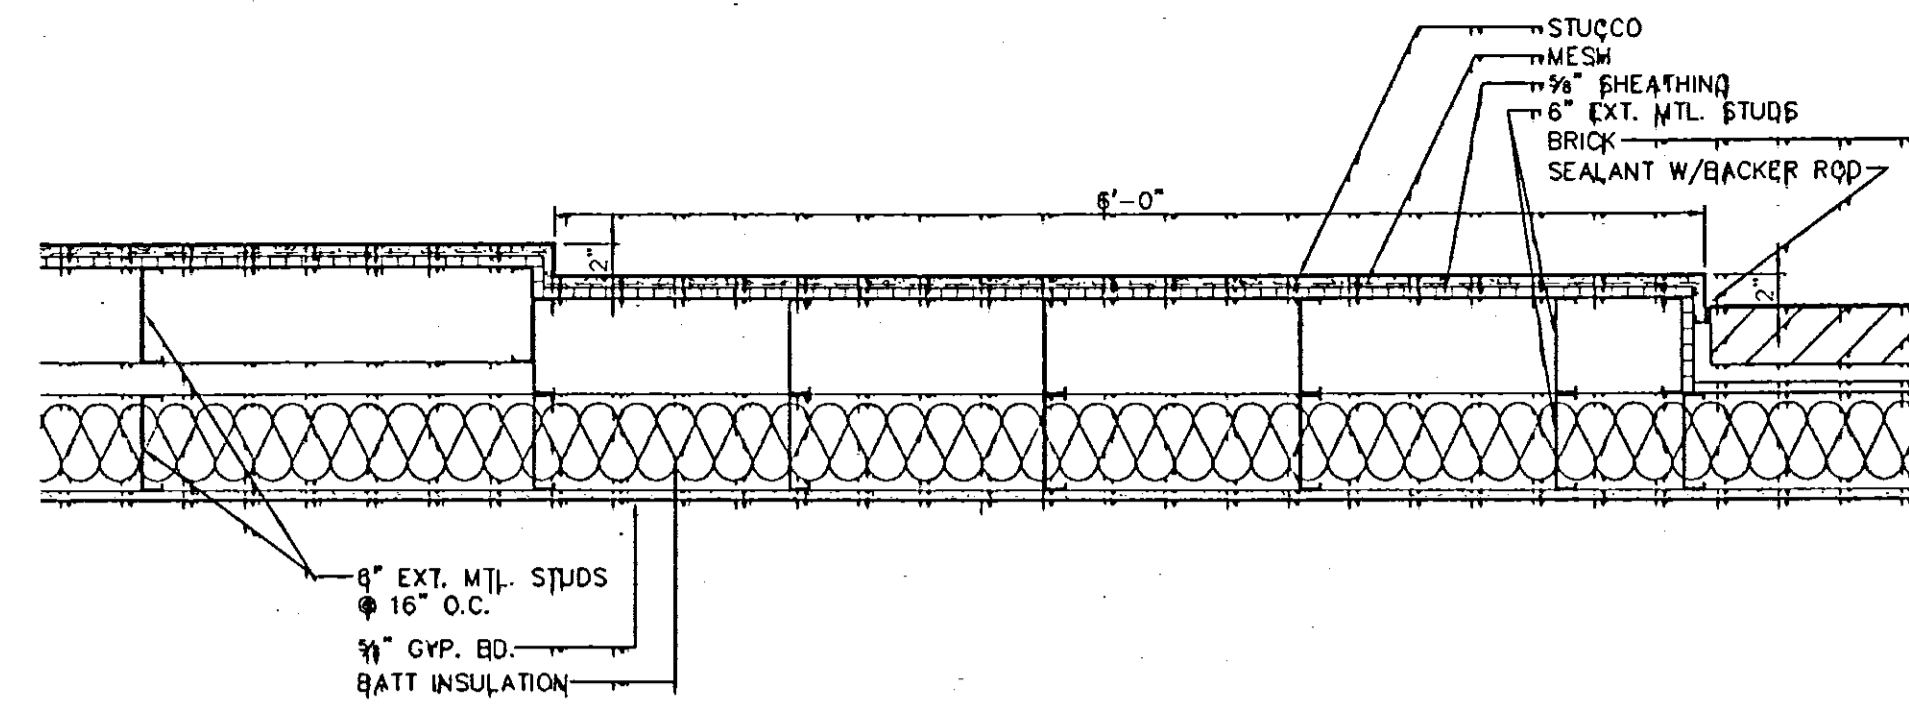


5 EXT. WALL DETAIL  
SCALE: 1" = 1'-0"

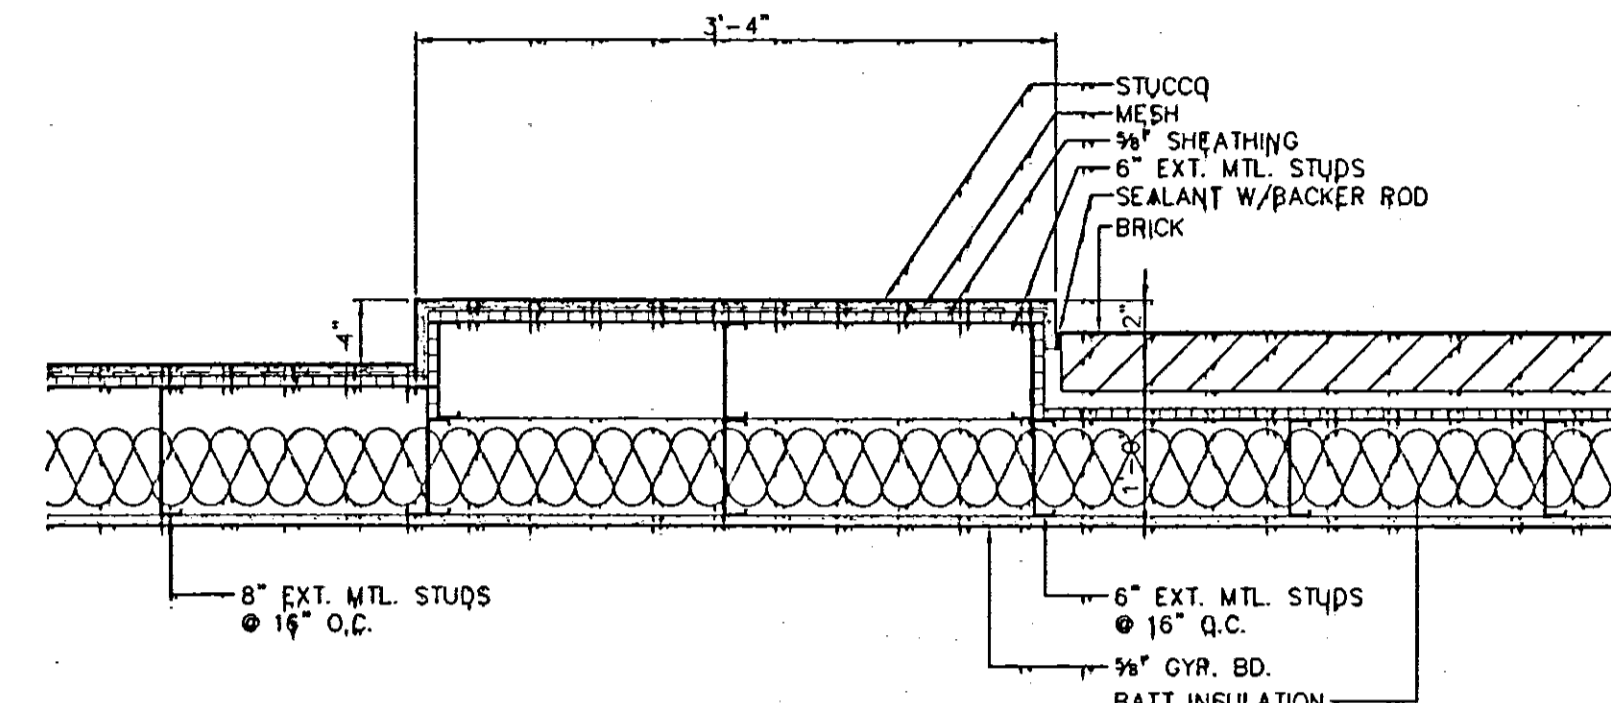


6 EXT. WALL DETAIL  
SCALE: 1" = 1'-0"

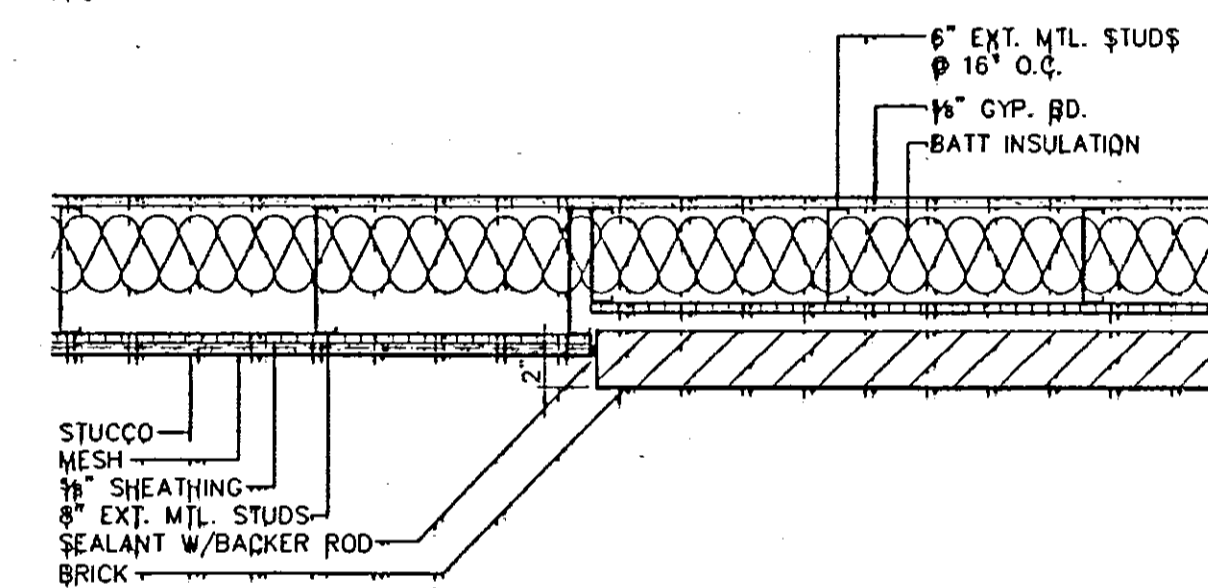


7 EXT. WALL DETAIL  
SCALE: 1" = 1'-0"

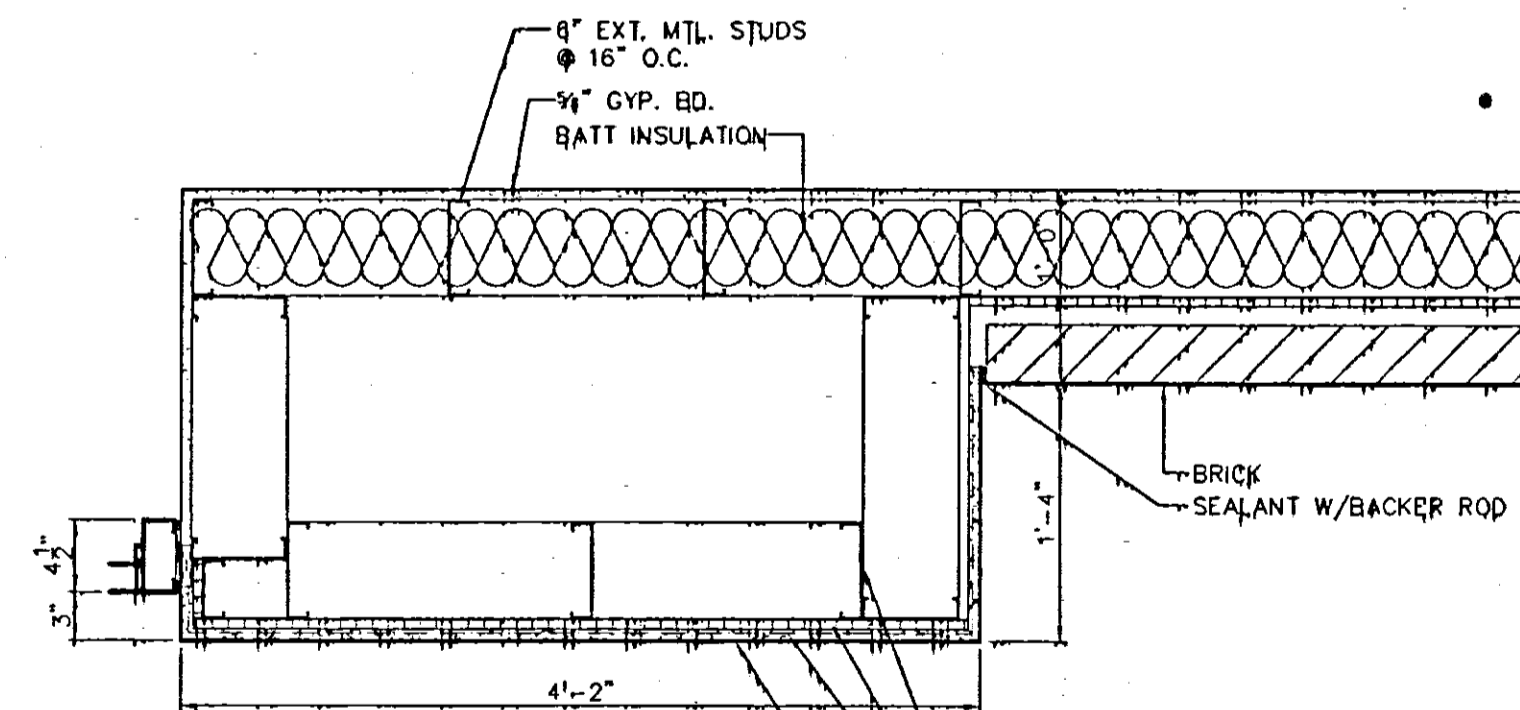

8 EXT. WALL DETAIL  
SCALE: 1" = 1'-0"

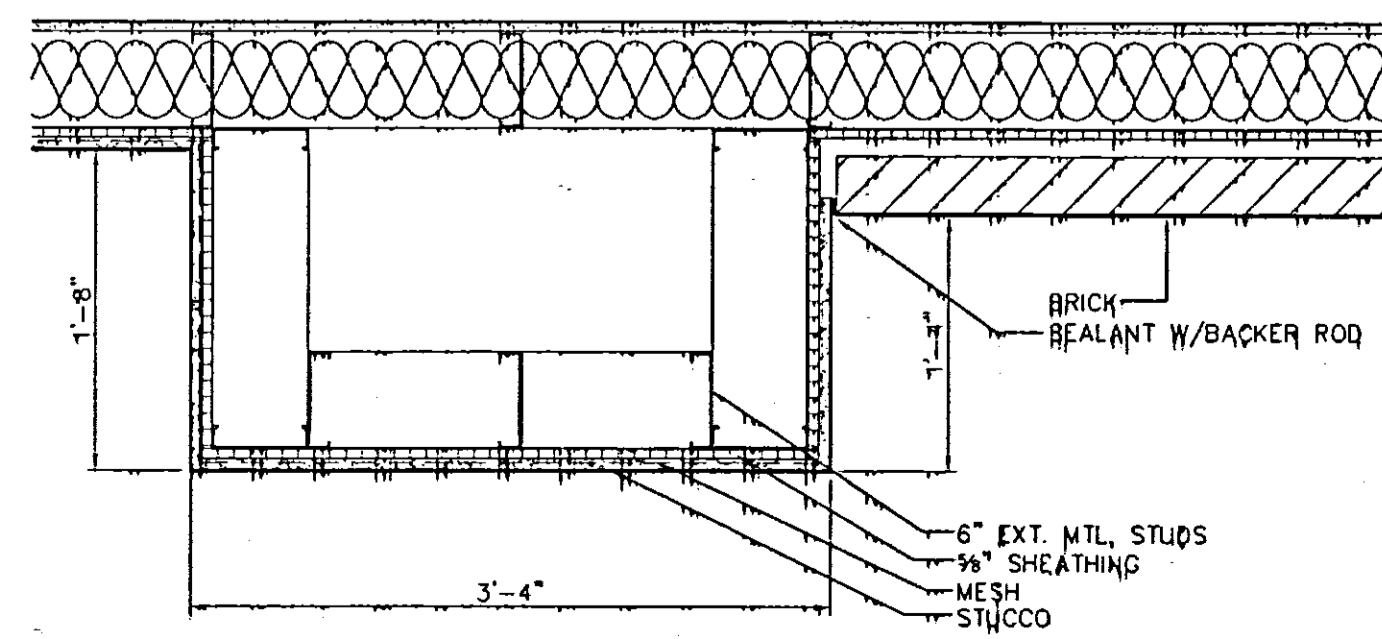

9 EXT. WALL DETAIL  
SCALE: 1" = 1'-0"

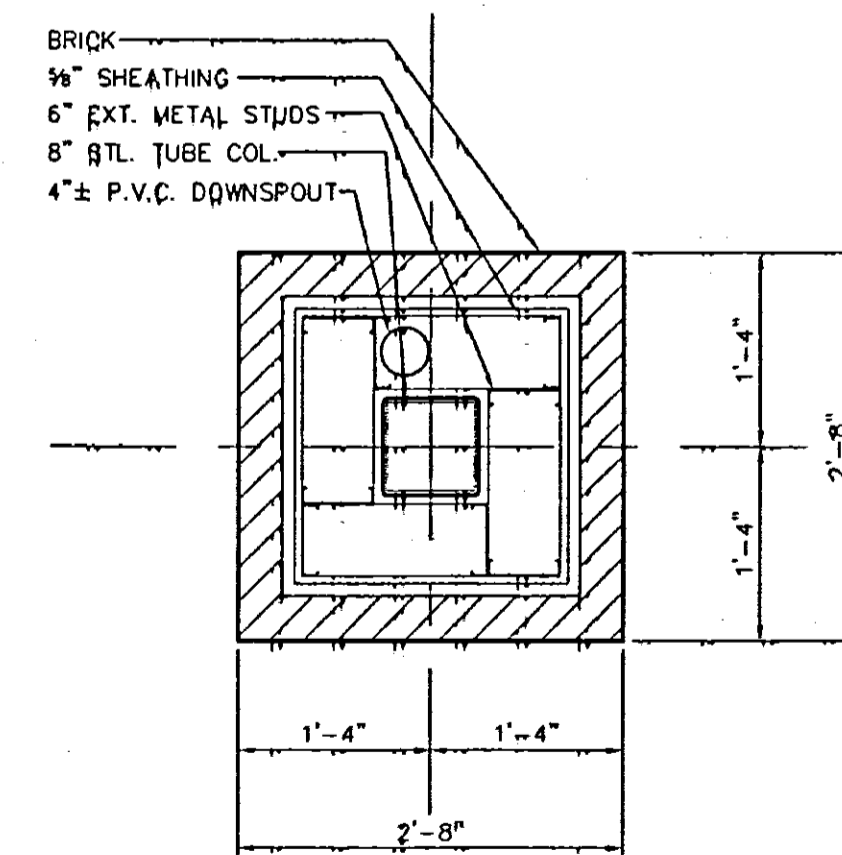

10 COLUMN DETAIL  
SCALE: 3/4" = 1'-0"

Table with columns for REVISIONS and BY.


Logo for Woolridge & Associates, 105 Central Avenue, Ridgeland, MS 39157. Includes a circular seal with 'REGISTERED ARCHITECT' and 'Mississippi'.

A New Building for  
CHURCH OF THE HIGHLANDS  
Ridgeland, Mississippi


THIS DESIGN IS THE COPYRIGHTED PROPERTY OF WOOLDRIDGE & ASSOCIATES. IT MAY NOT BE REPRODUCED FROM THIS DESIGN WITHOUT THE EXPRESS WRITTEN PERMISSION OF WOOLDRIDGE & ASSOCIATES.

Table with columns for DRAWN, CHECKED, DATE, SCALE, JOB NO., SHEET, and SHEETS.


Woodbridge & Associates 6/15/2001 9:49 AM baosesheet2.dwg

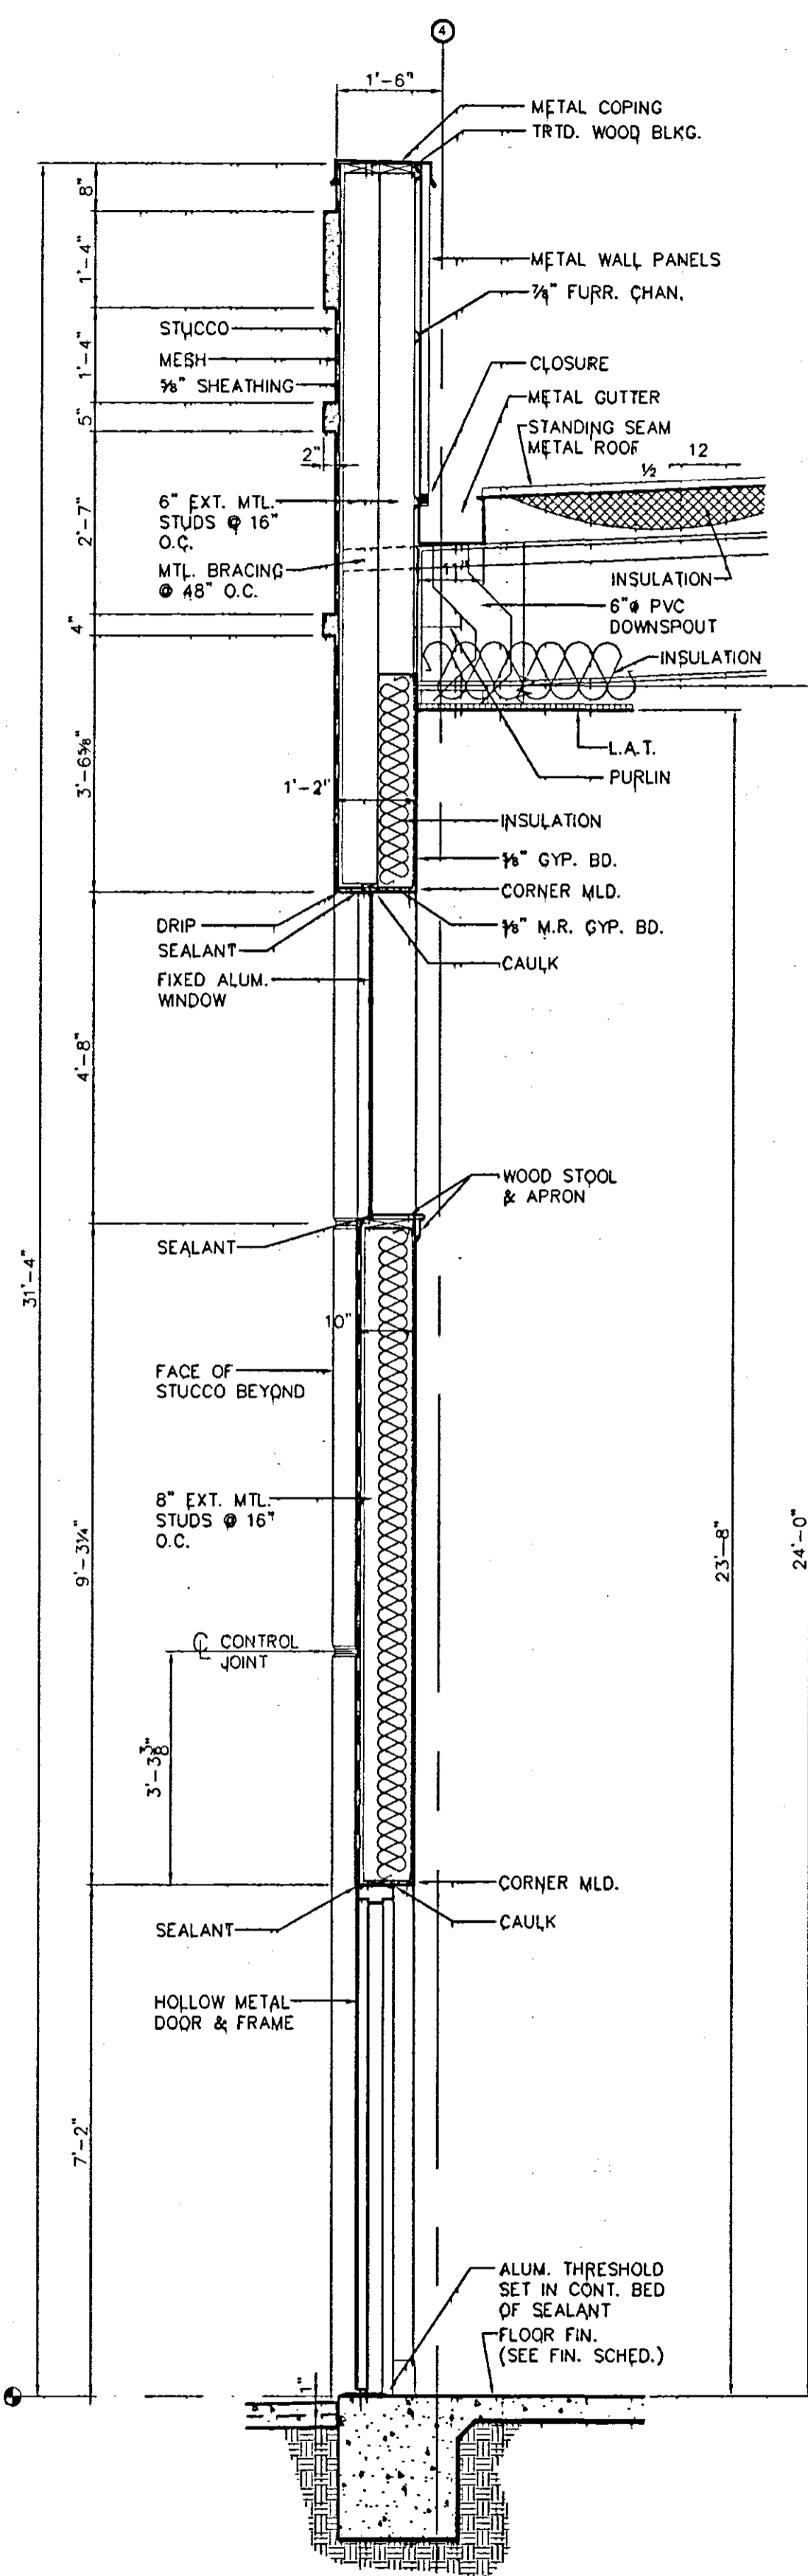


1 WALL SECTION  
SCALE: 3/4" = 1'-0"

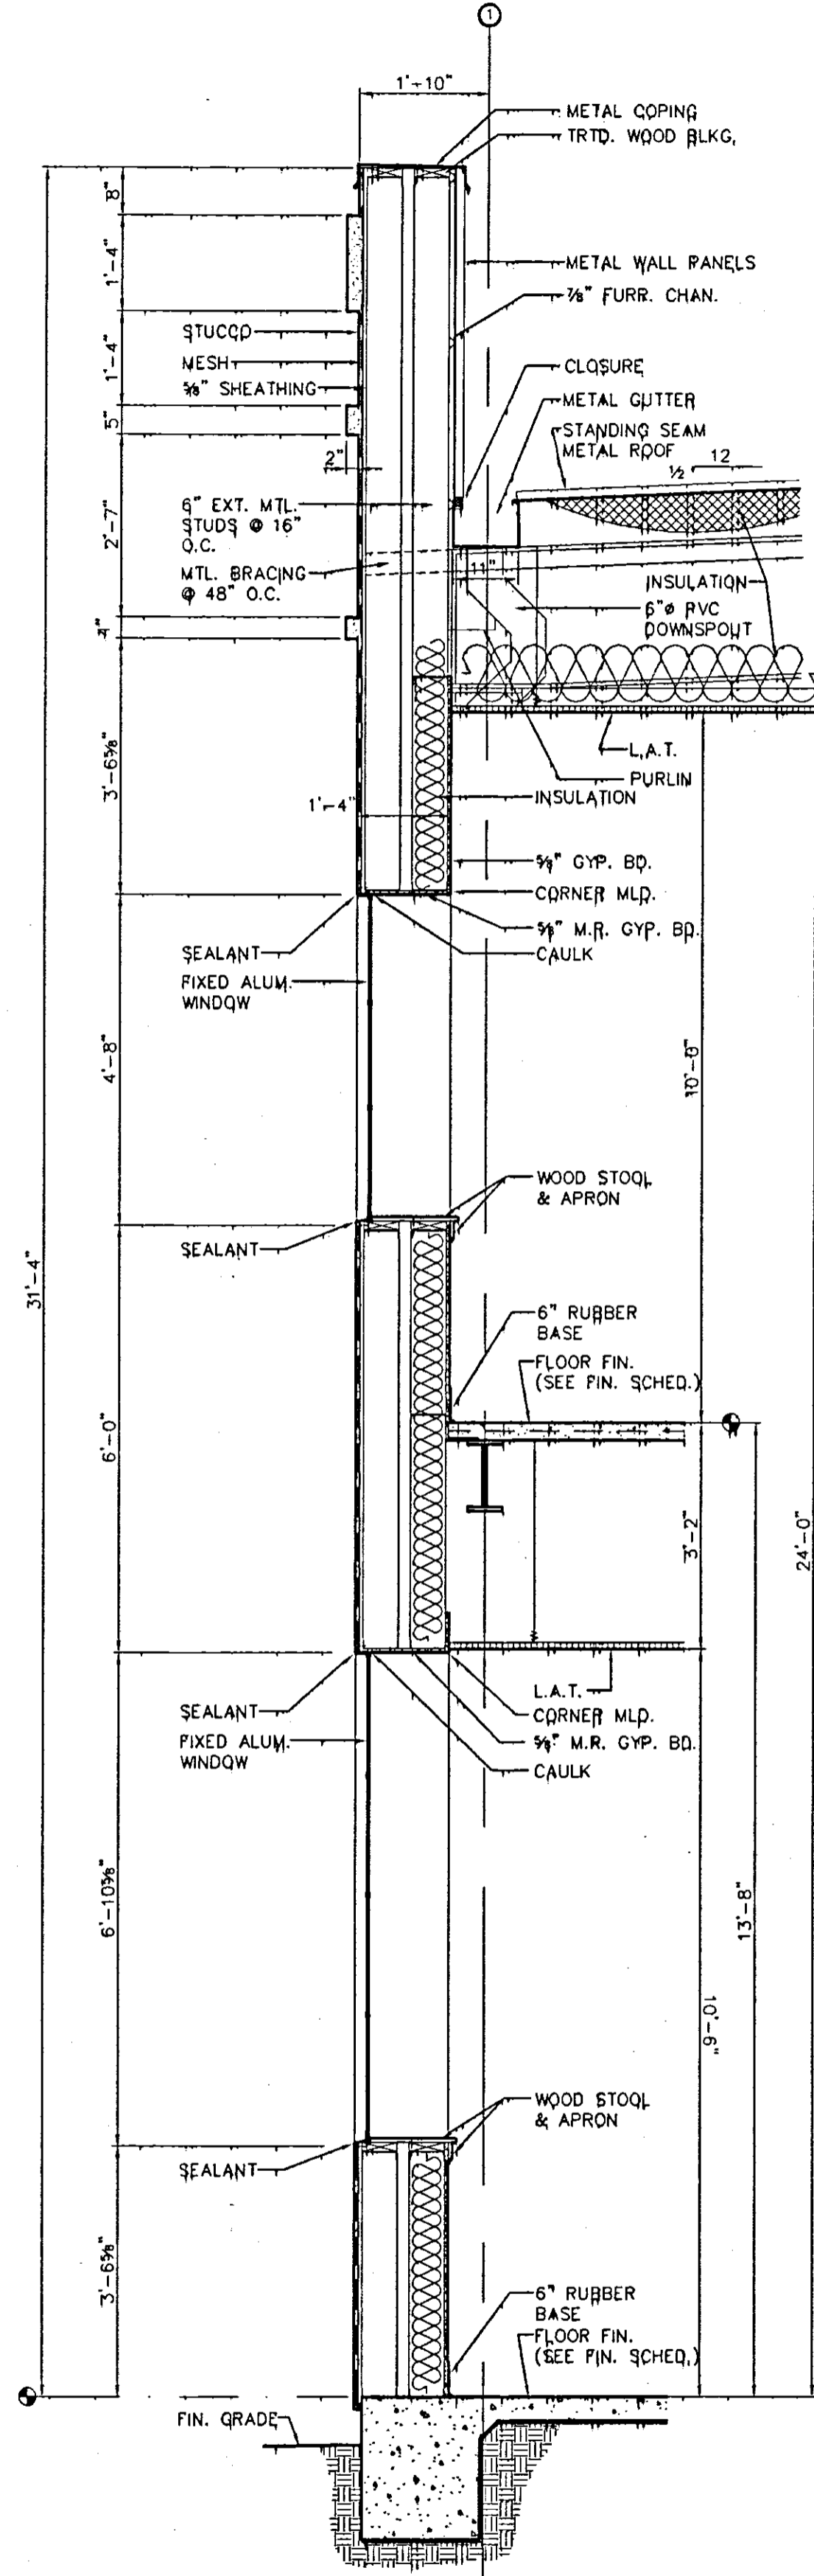

2 WALL SECTION  
SCALE: 3/4" = 1'-0"

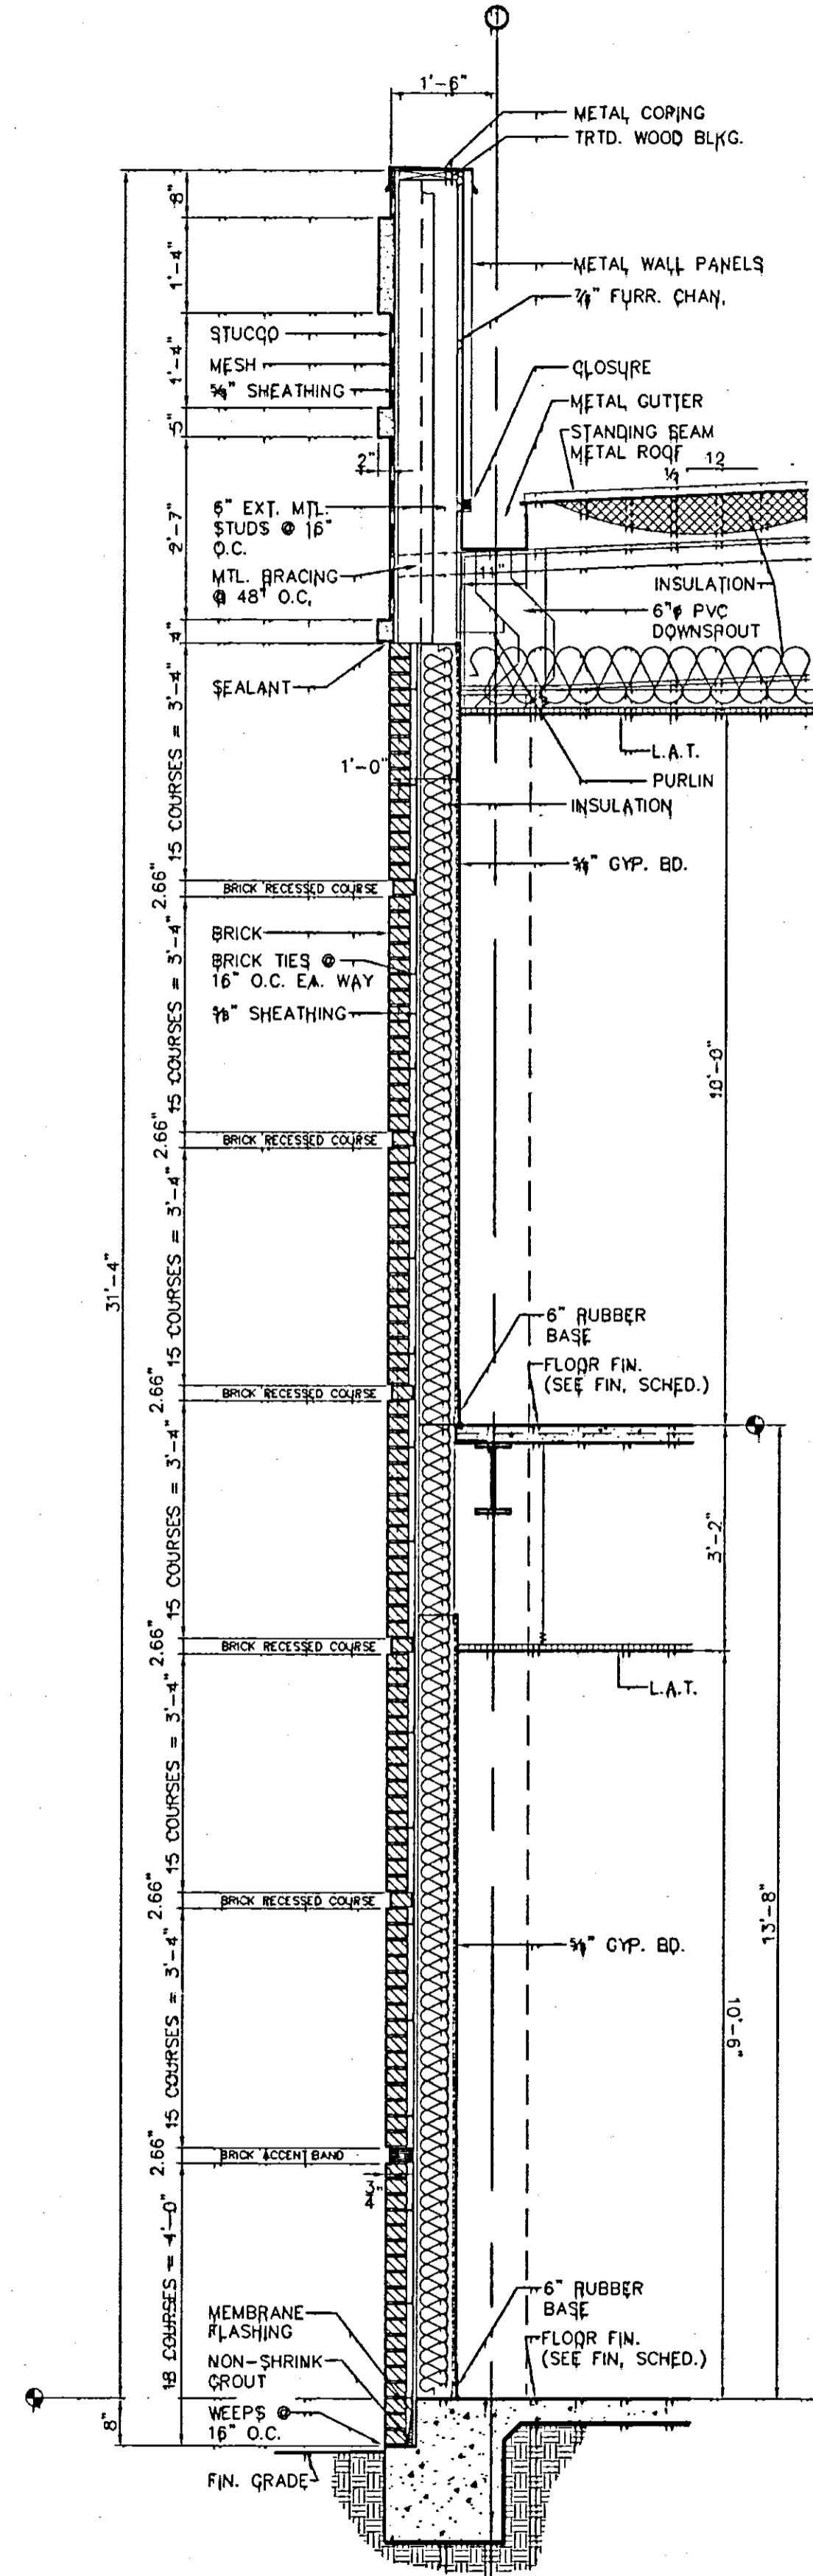


3 WALL SECTION  
SCALE: 3/4" = 1'-0"

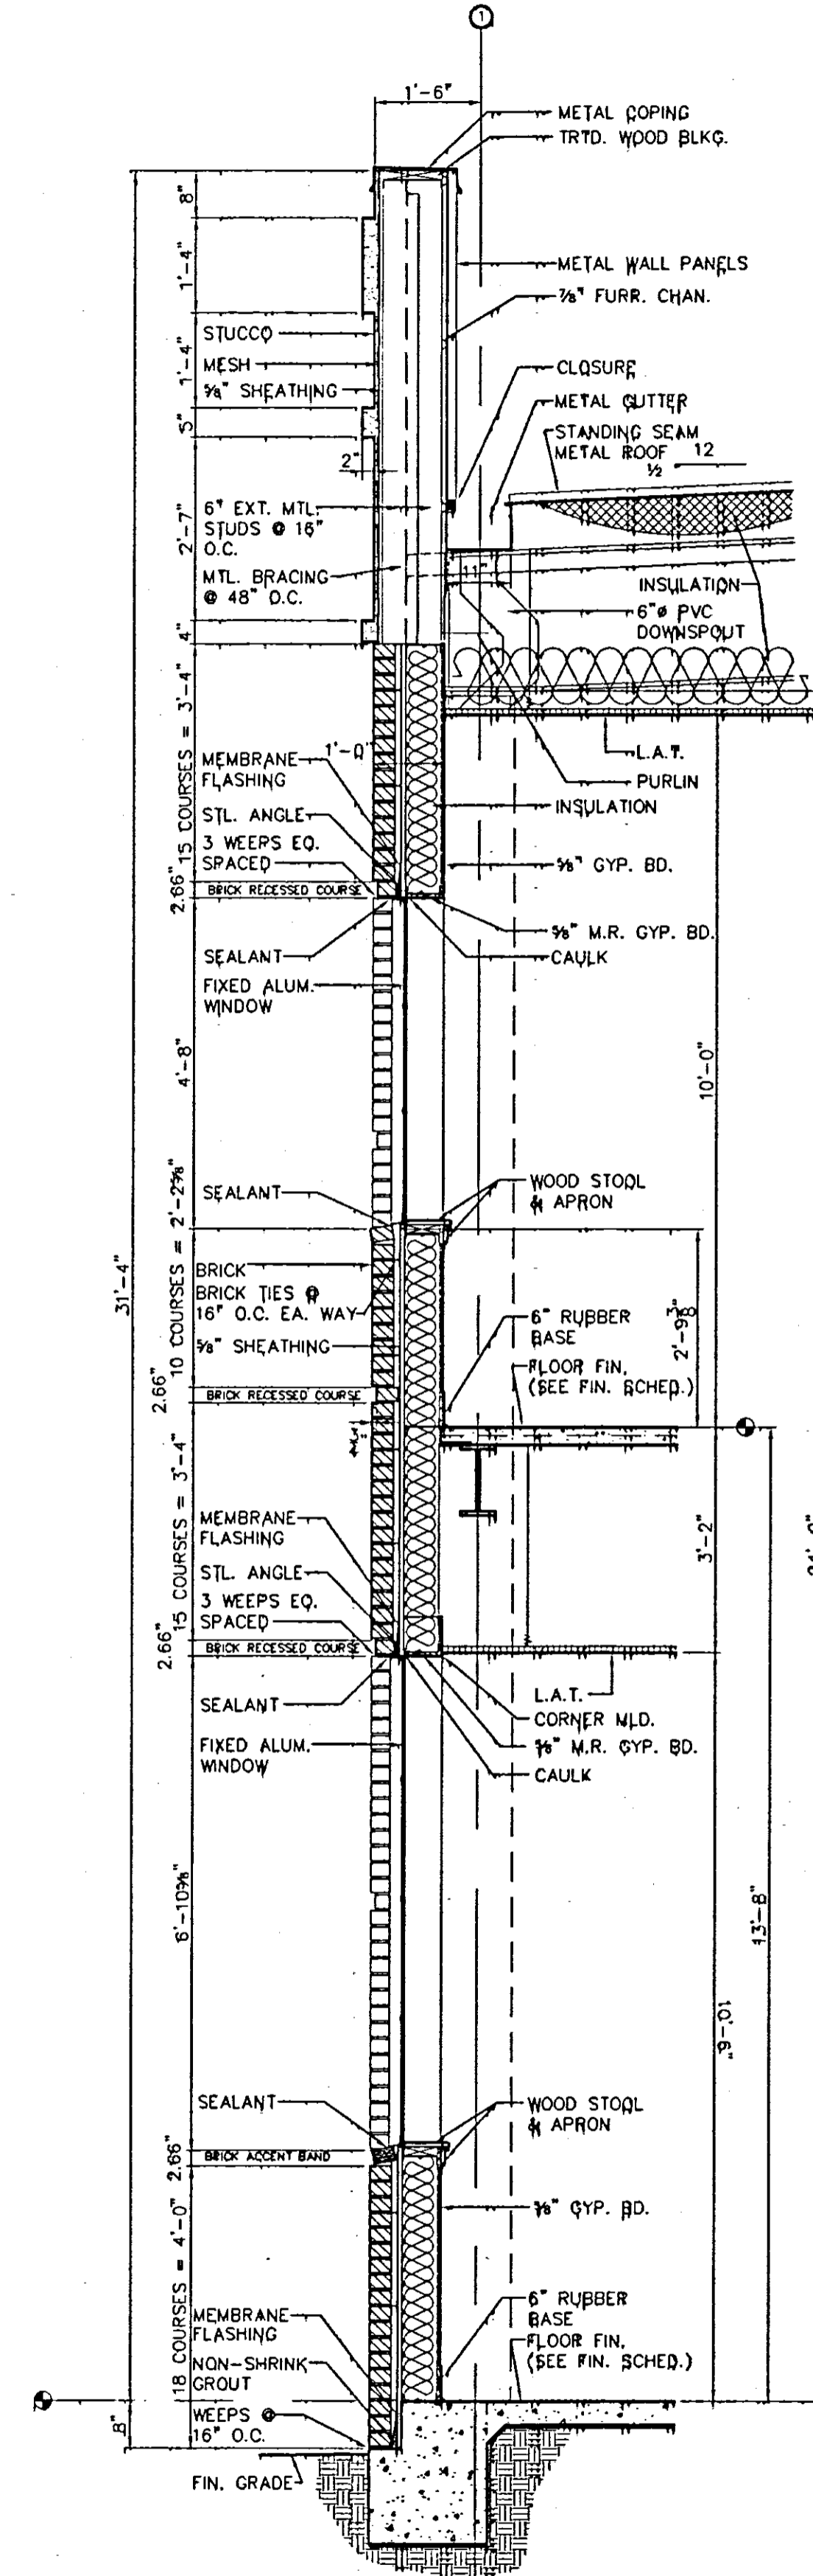

4 WALL SECTION  
SCALE: 3/4" = 1'-0"

REVISIONS	BY

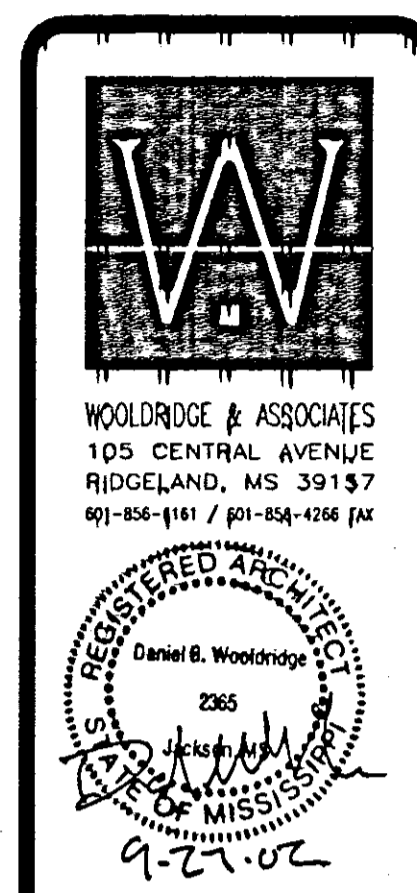


A New Building for  
**CHURCH OF THE HIGHLANDS**  
Ridgeland, Mississippi

THIS DESIGN IS THE COPYRIGHTED PROPERTY OF WOODBRIDGE & ASSOCIATES. IT MAY NOT BE REPRODUCED FROM THIS DESIGN WITHOUT THE EXPRESS WRITTEN PERMISSION OF WOODBRIDGE & ASSOCIATES.

CHECKED
DATE
SCALE
JOB NO.
SHEET
A14
OF SHEETS

REVISIONS	BY

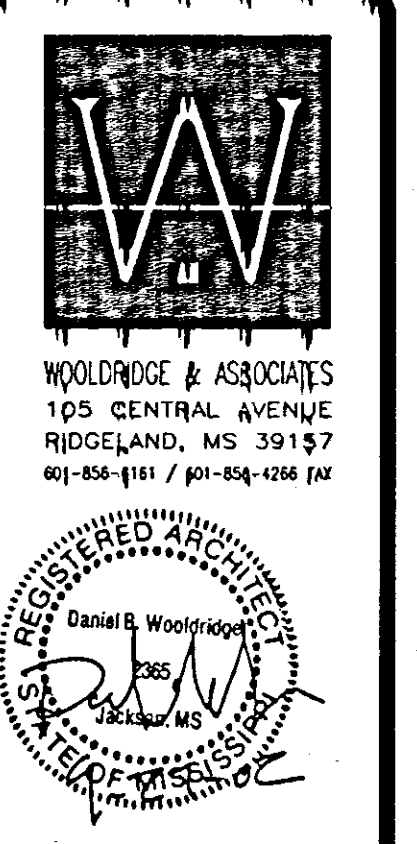


A New Building for  
**CHURCH OF THE HIGHLANDS**  
 Ridgeland, Mississippi


THIS DESIGN IS THE COPYRIGHTED PROPERTY OF WOODBRIDGE & ASSOCIATES. IT MAY NOT BE REPRODUCED FROM THIS DESIGN WITHOUT THE EXPRESS WRITTEN PERMISSION OF WOODBRIDGE & ASSOCIATES.

	DRAN
	CHECKED
	DATE
	SCALE
	JOB NO.
	SHEET


A15

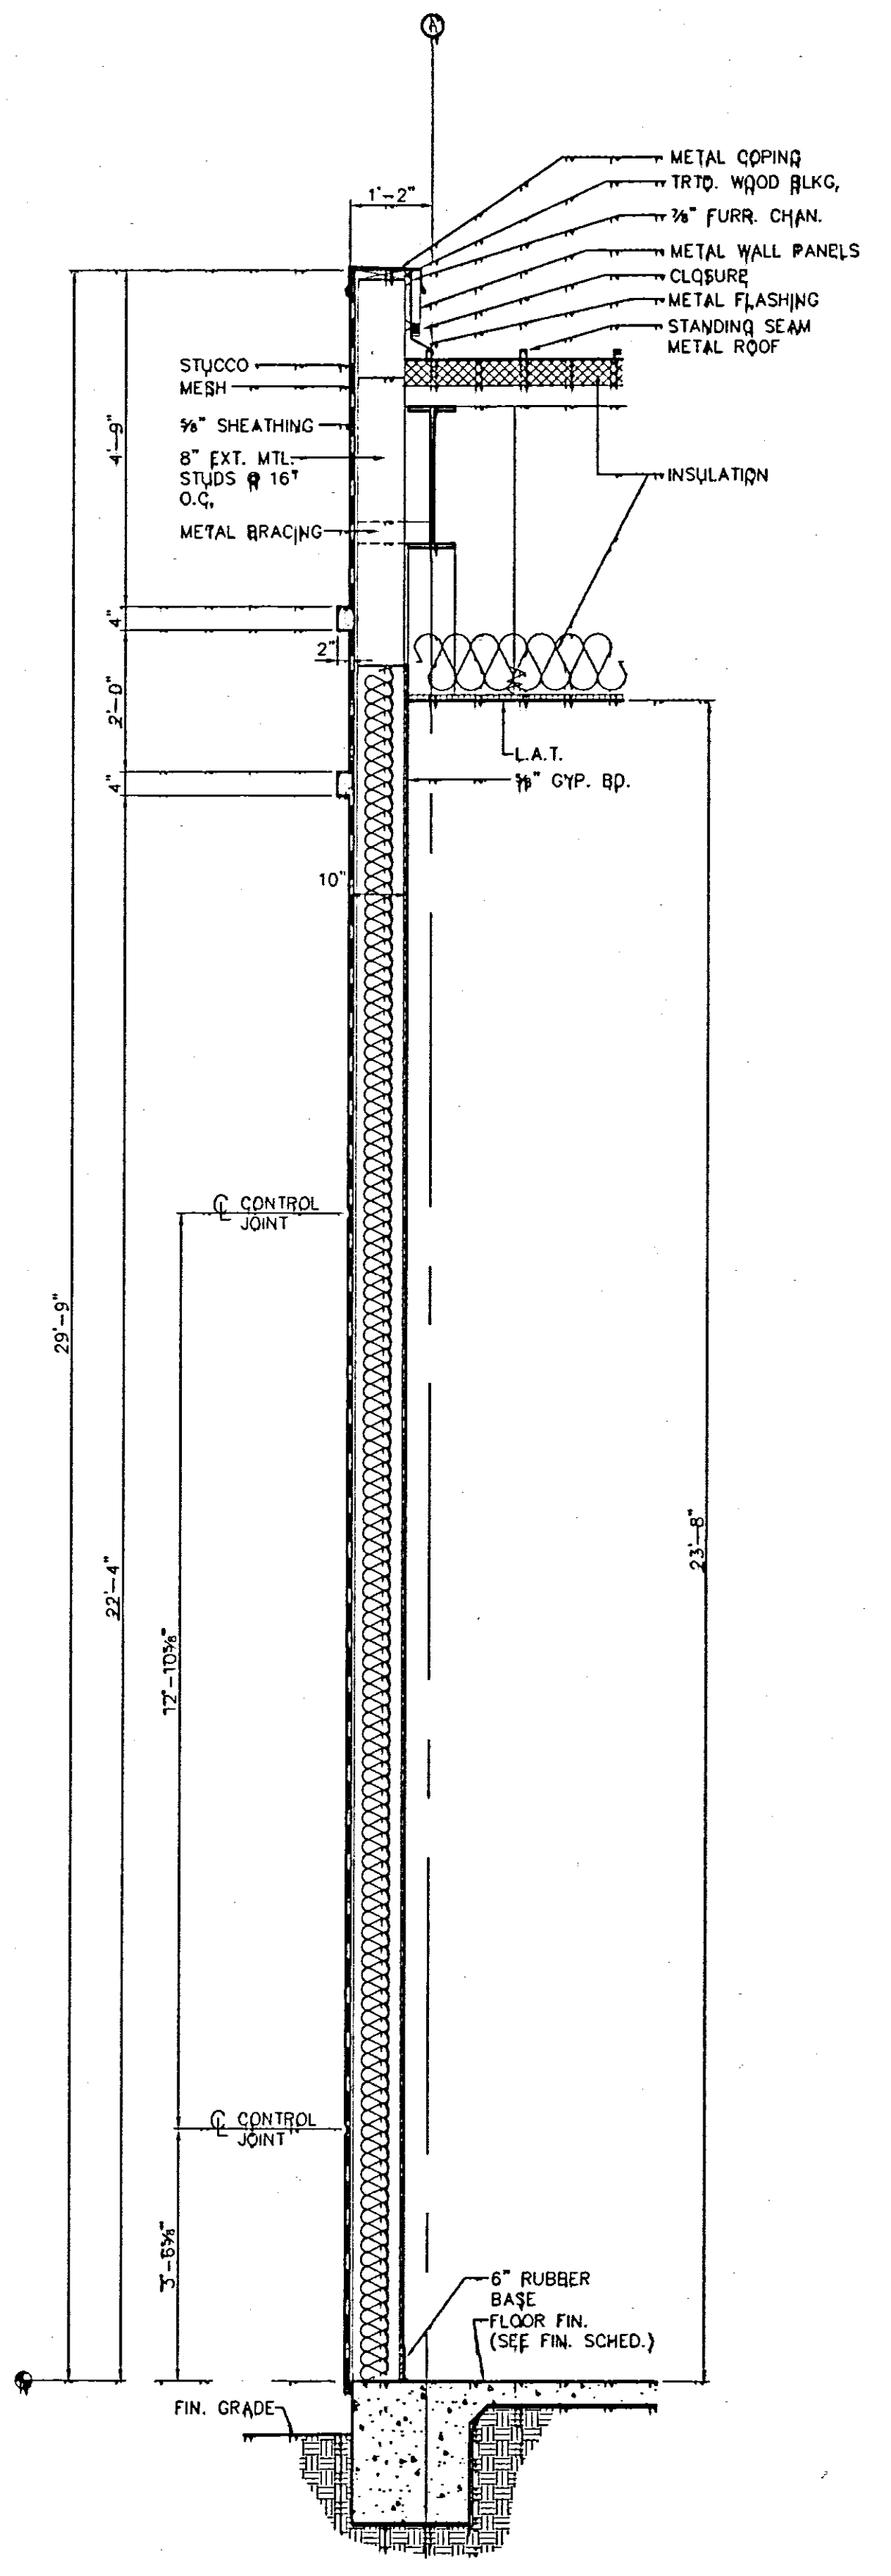

3  
 A15 WALL SECTION  
 SCALE: 3/4" = 1'-0"

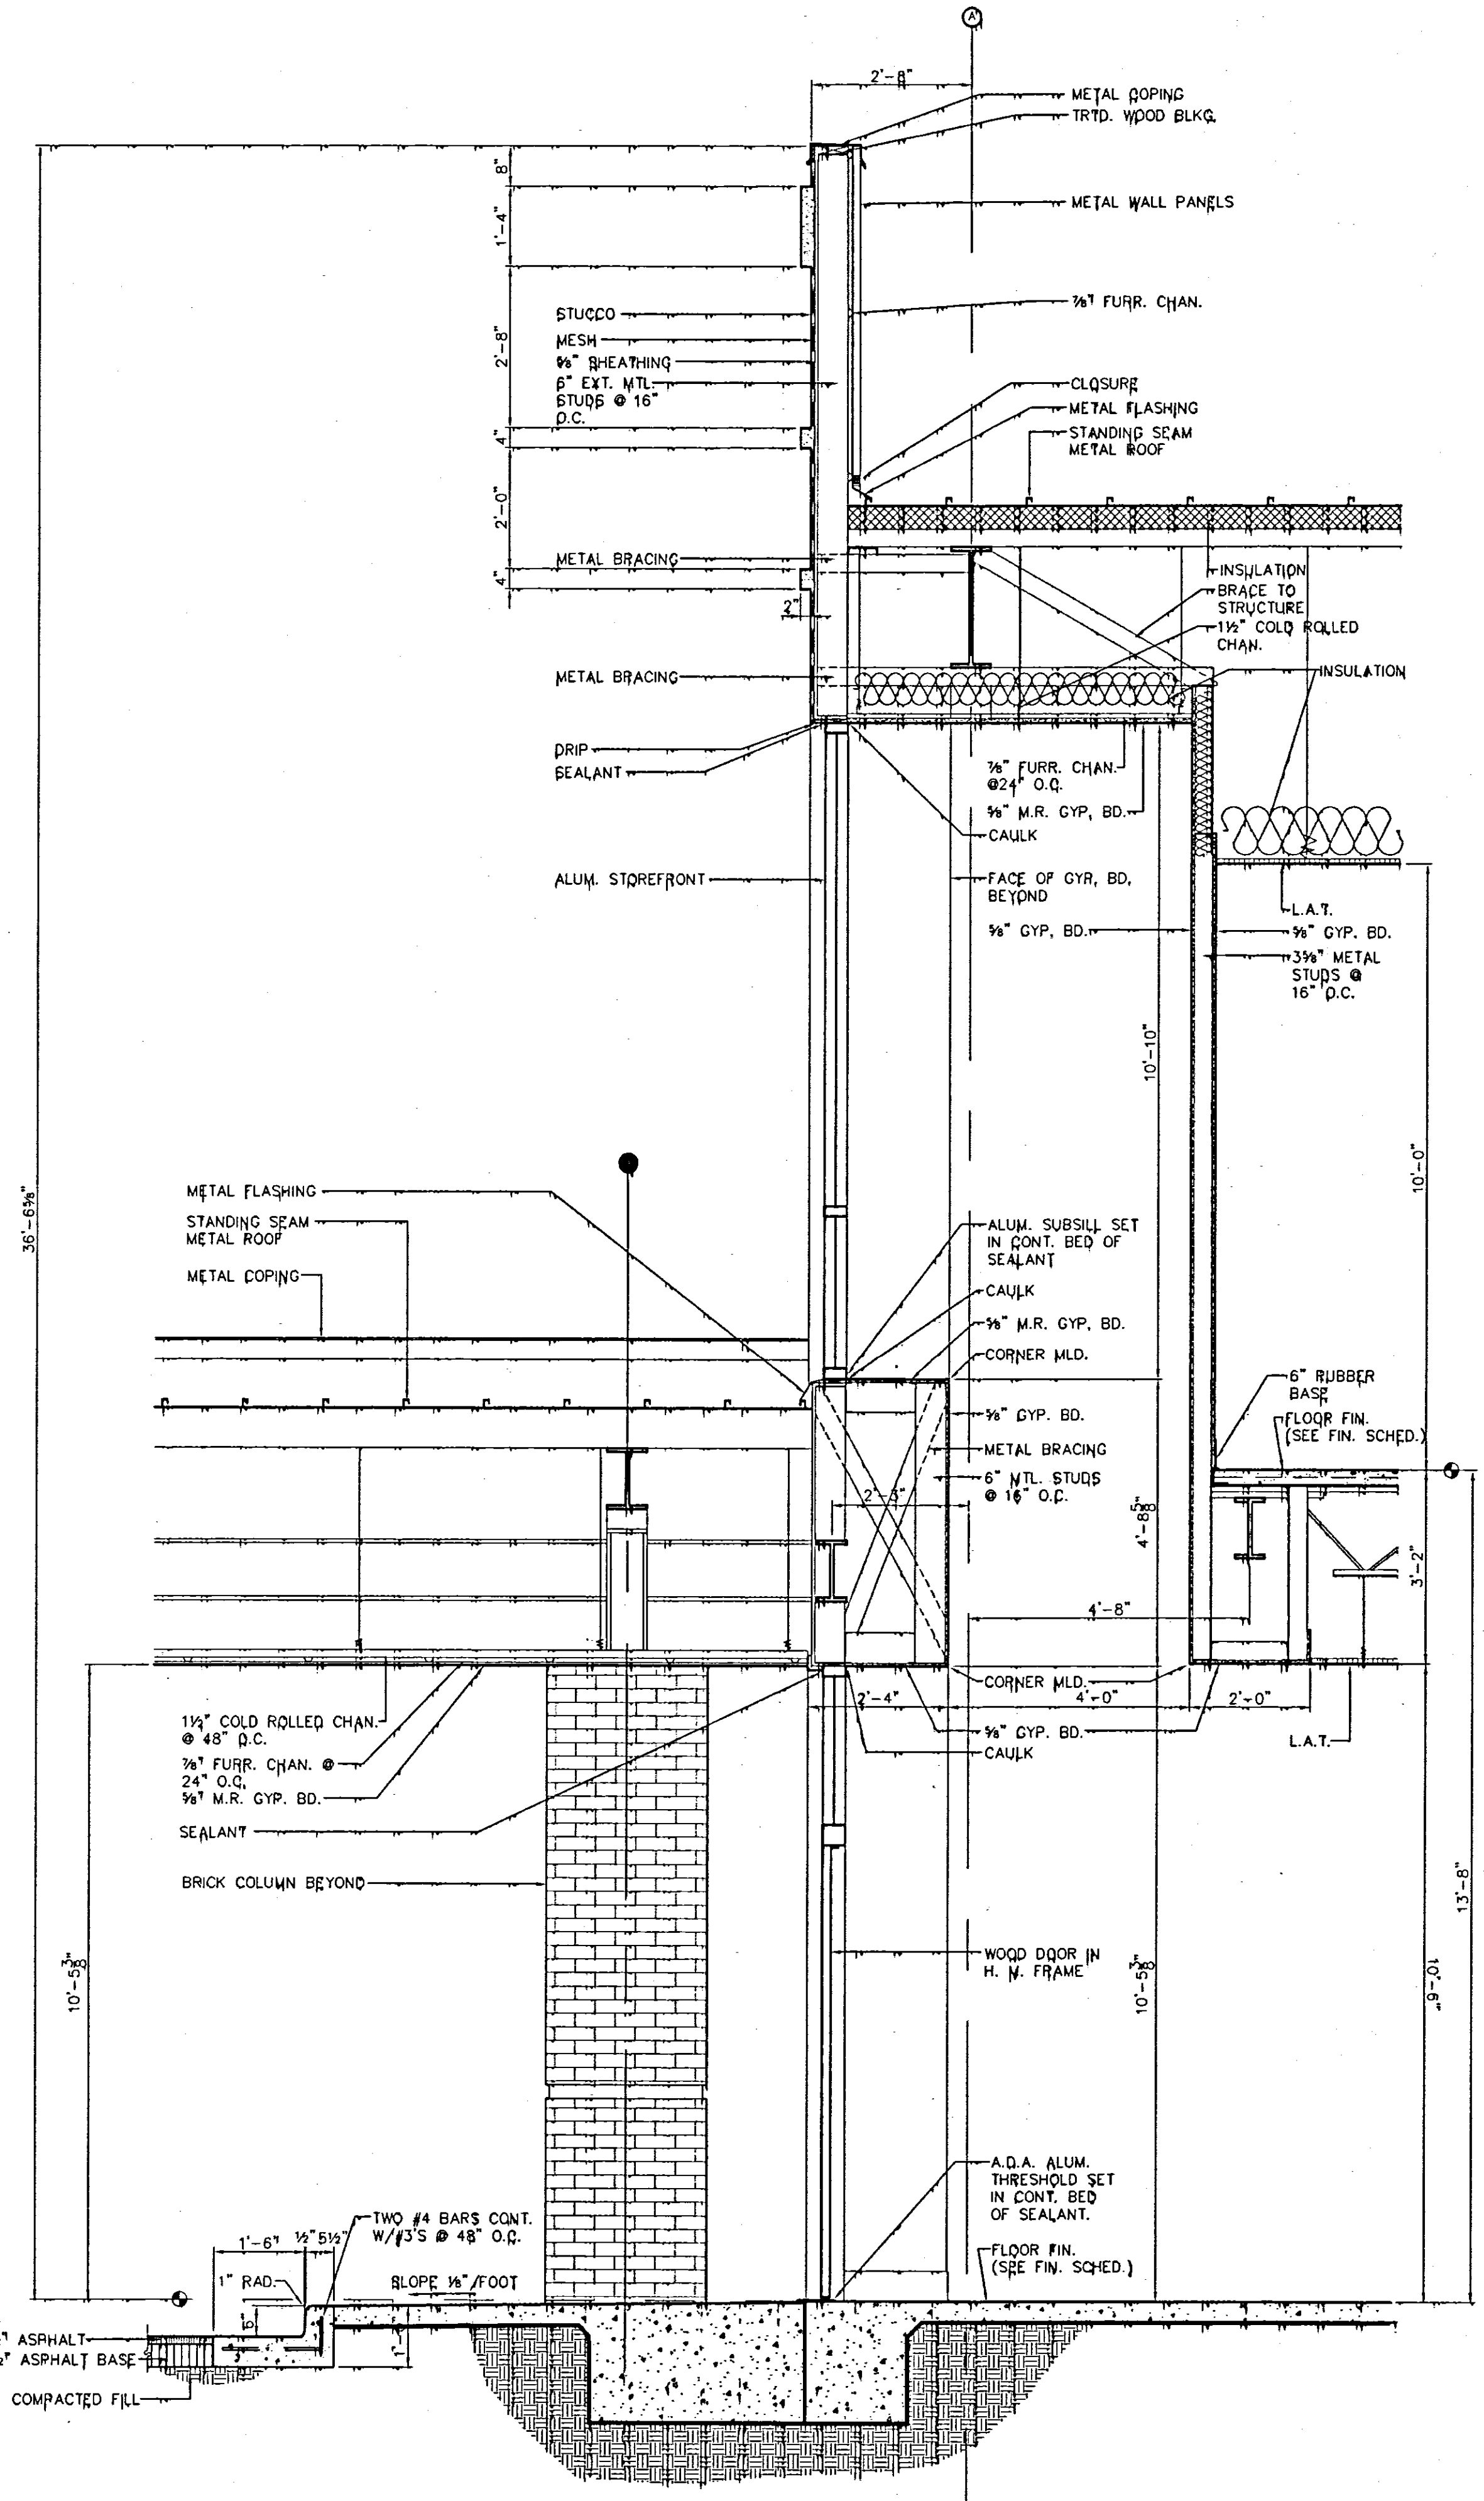



2  
 A15 WALL SECTION @ FRONT CANOPY  
 SCALE: 3/4" = 1'-0"

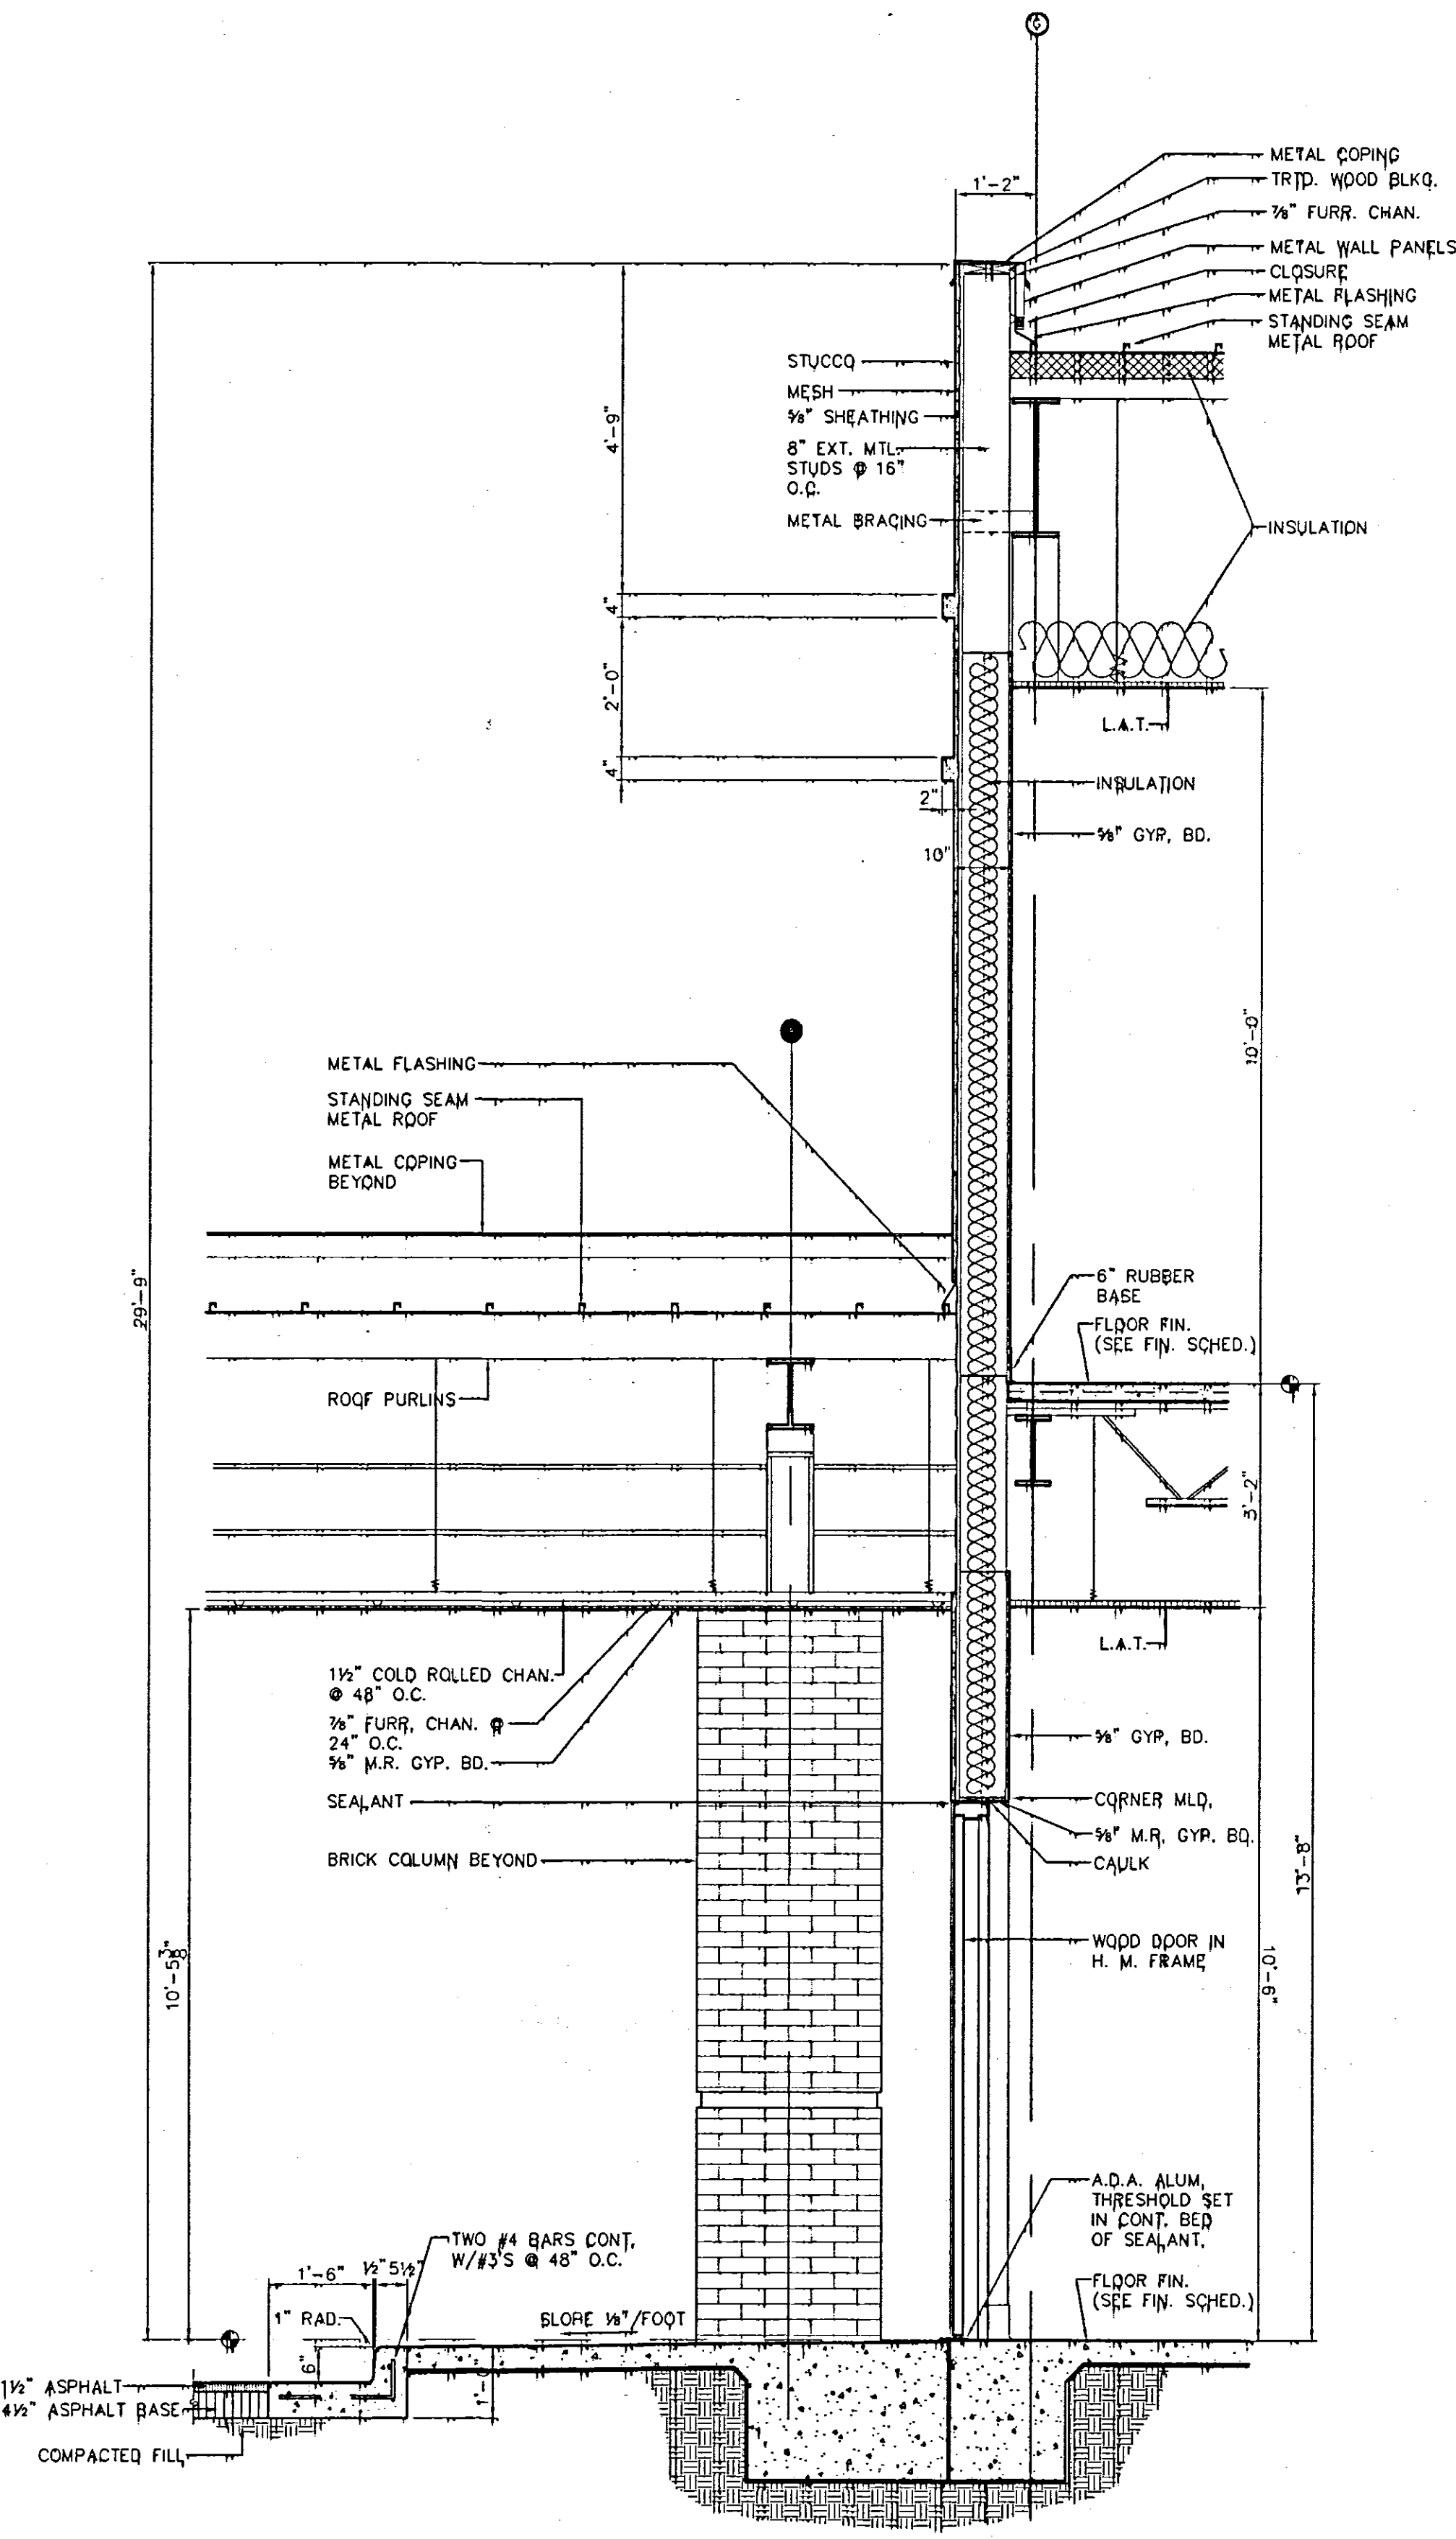


1  
 A15 WALL SECTION @ REAR CANOPY  
 SCALE: 3/4" = 1'-0"

Woodbridge & Associates 6/15/2001 949 -AM-basesthee12.dwg



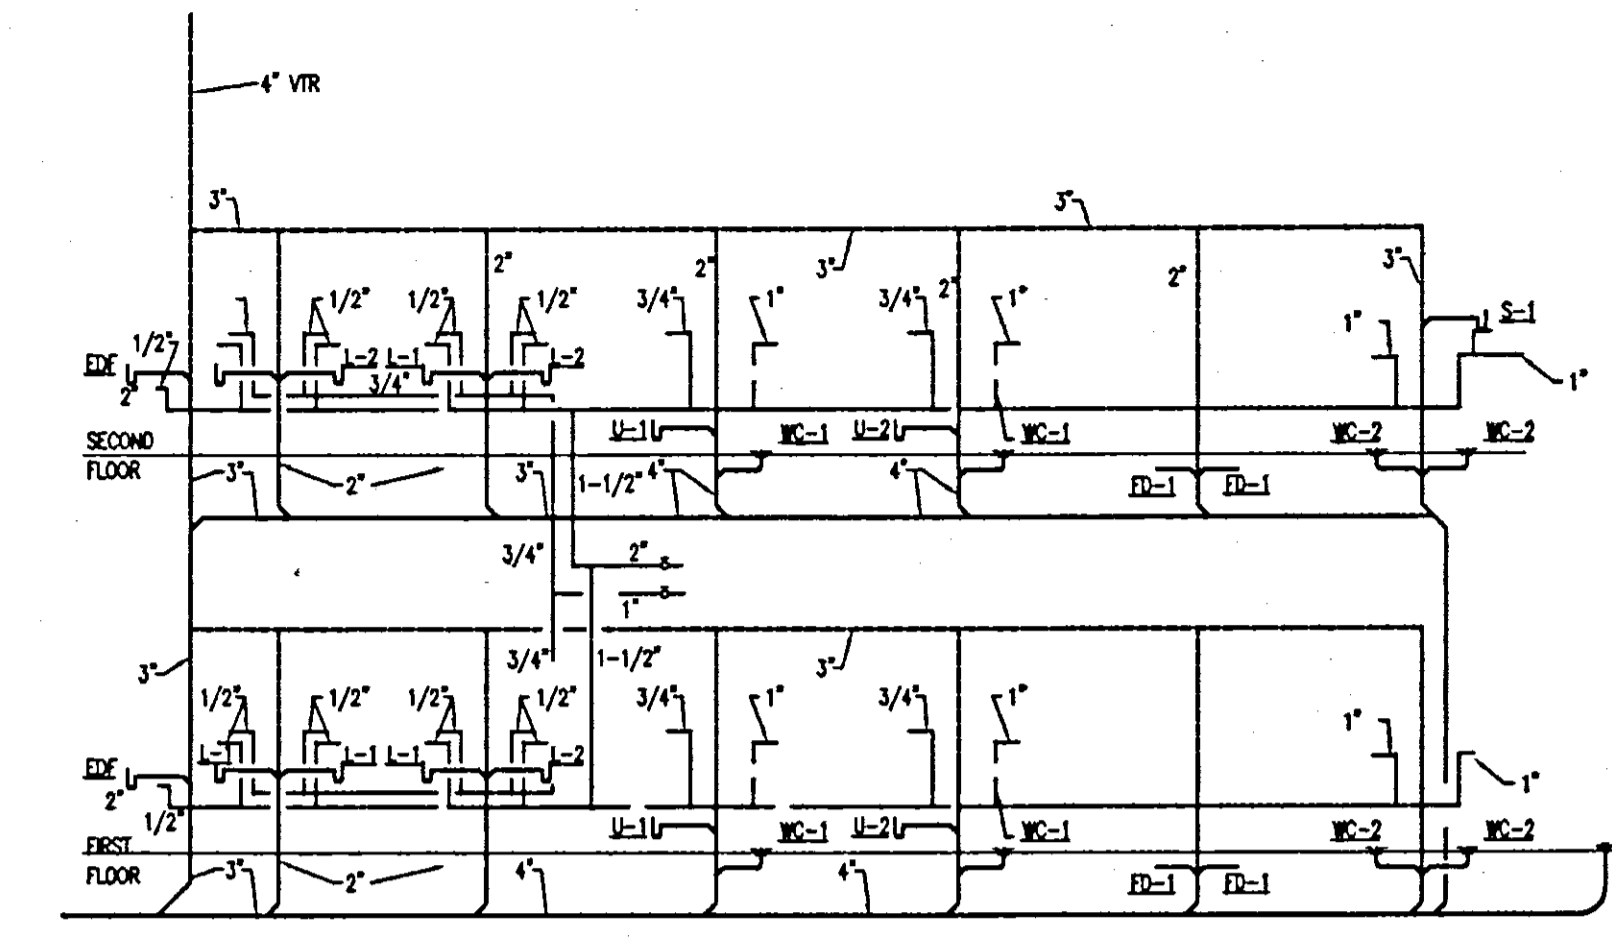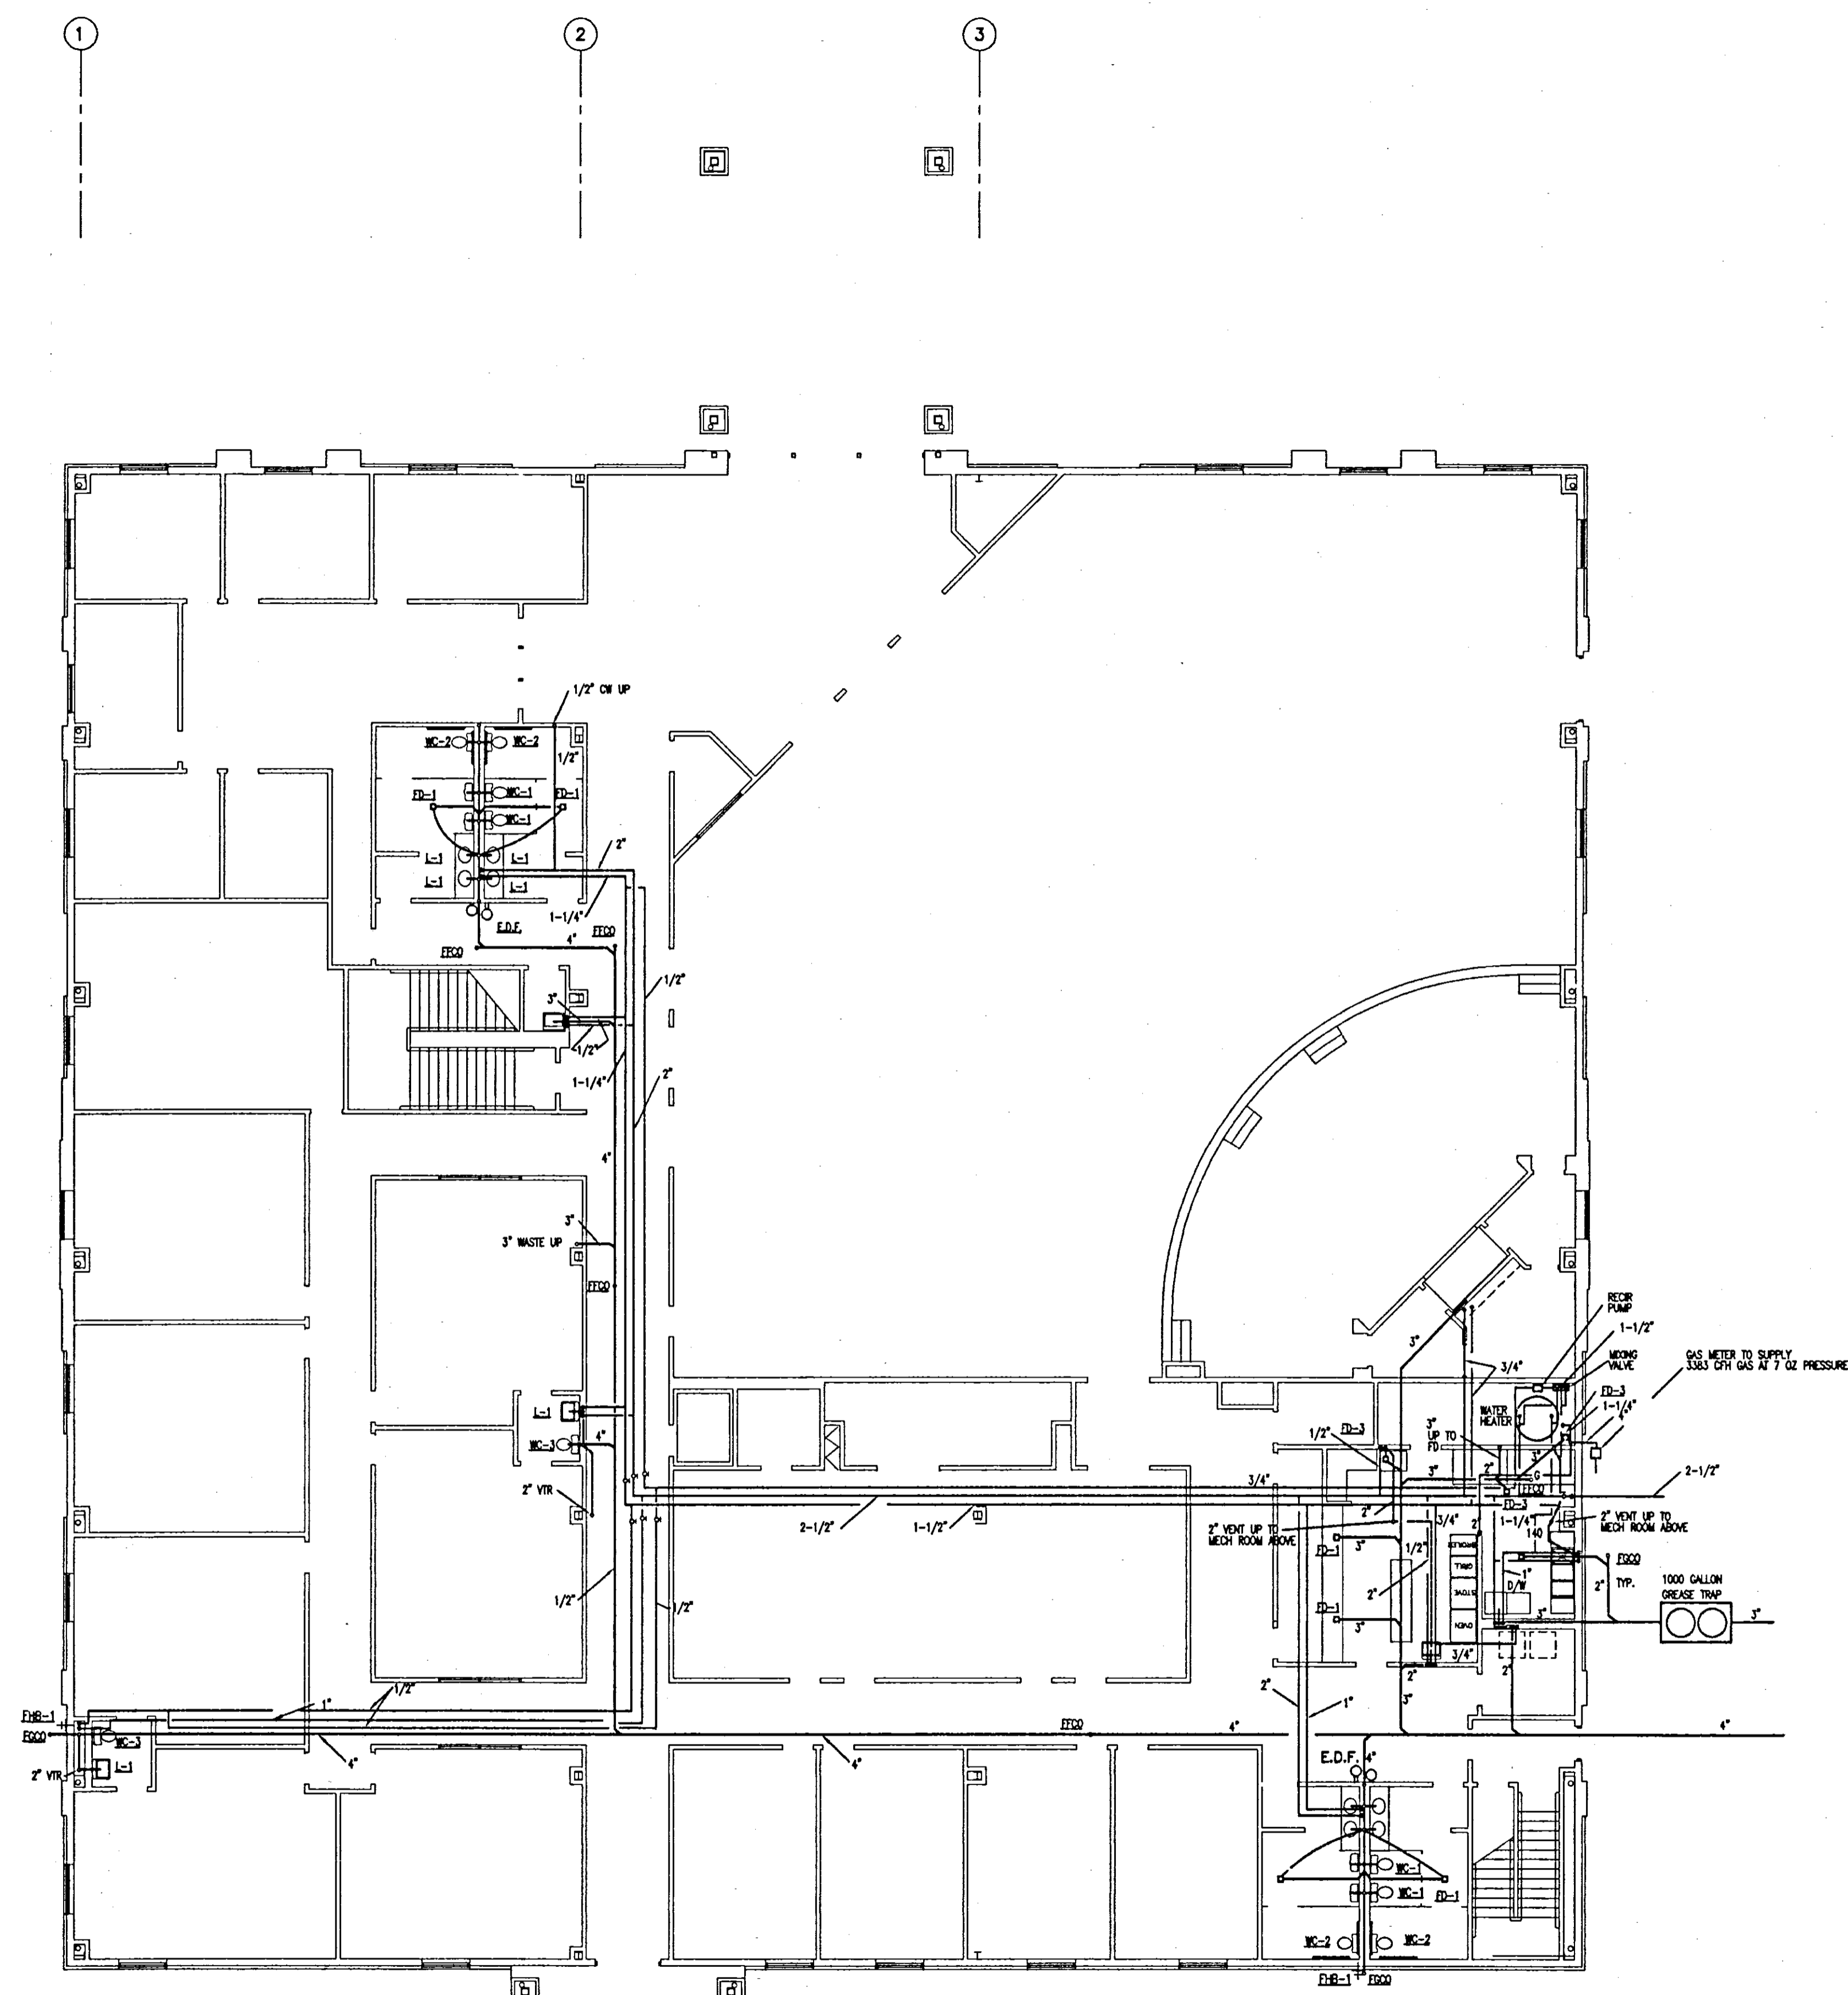


PLUMBING RISER PR/1

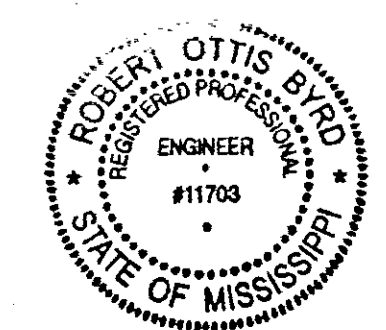

PLUMBING PLAN FOR HIGHLAND CHURCH	
DATE 09/20/02	DRAWING # P2.1



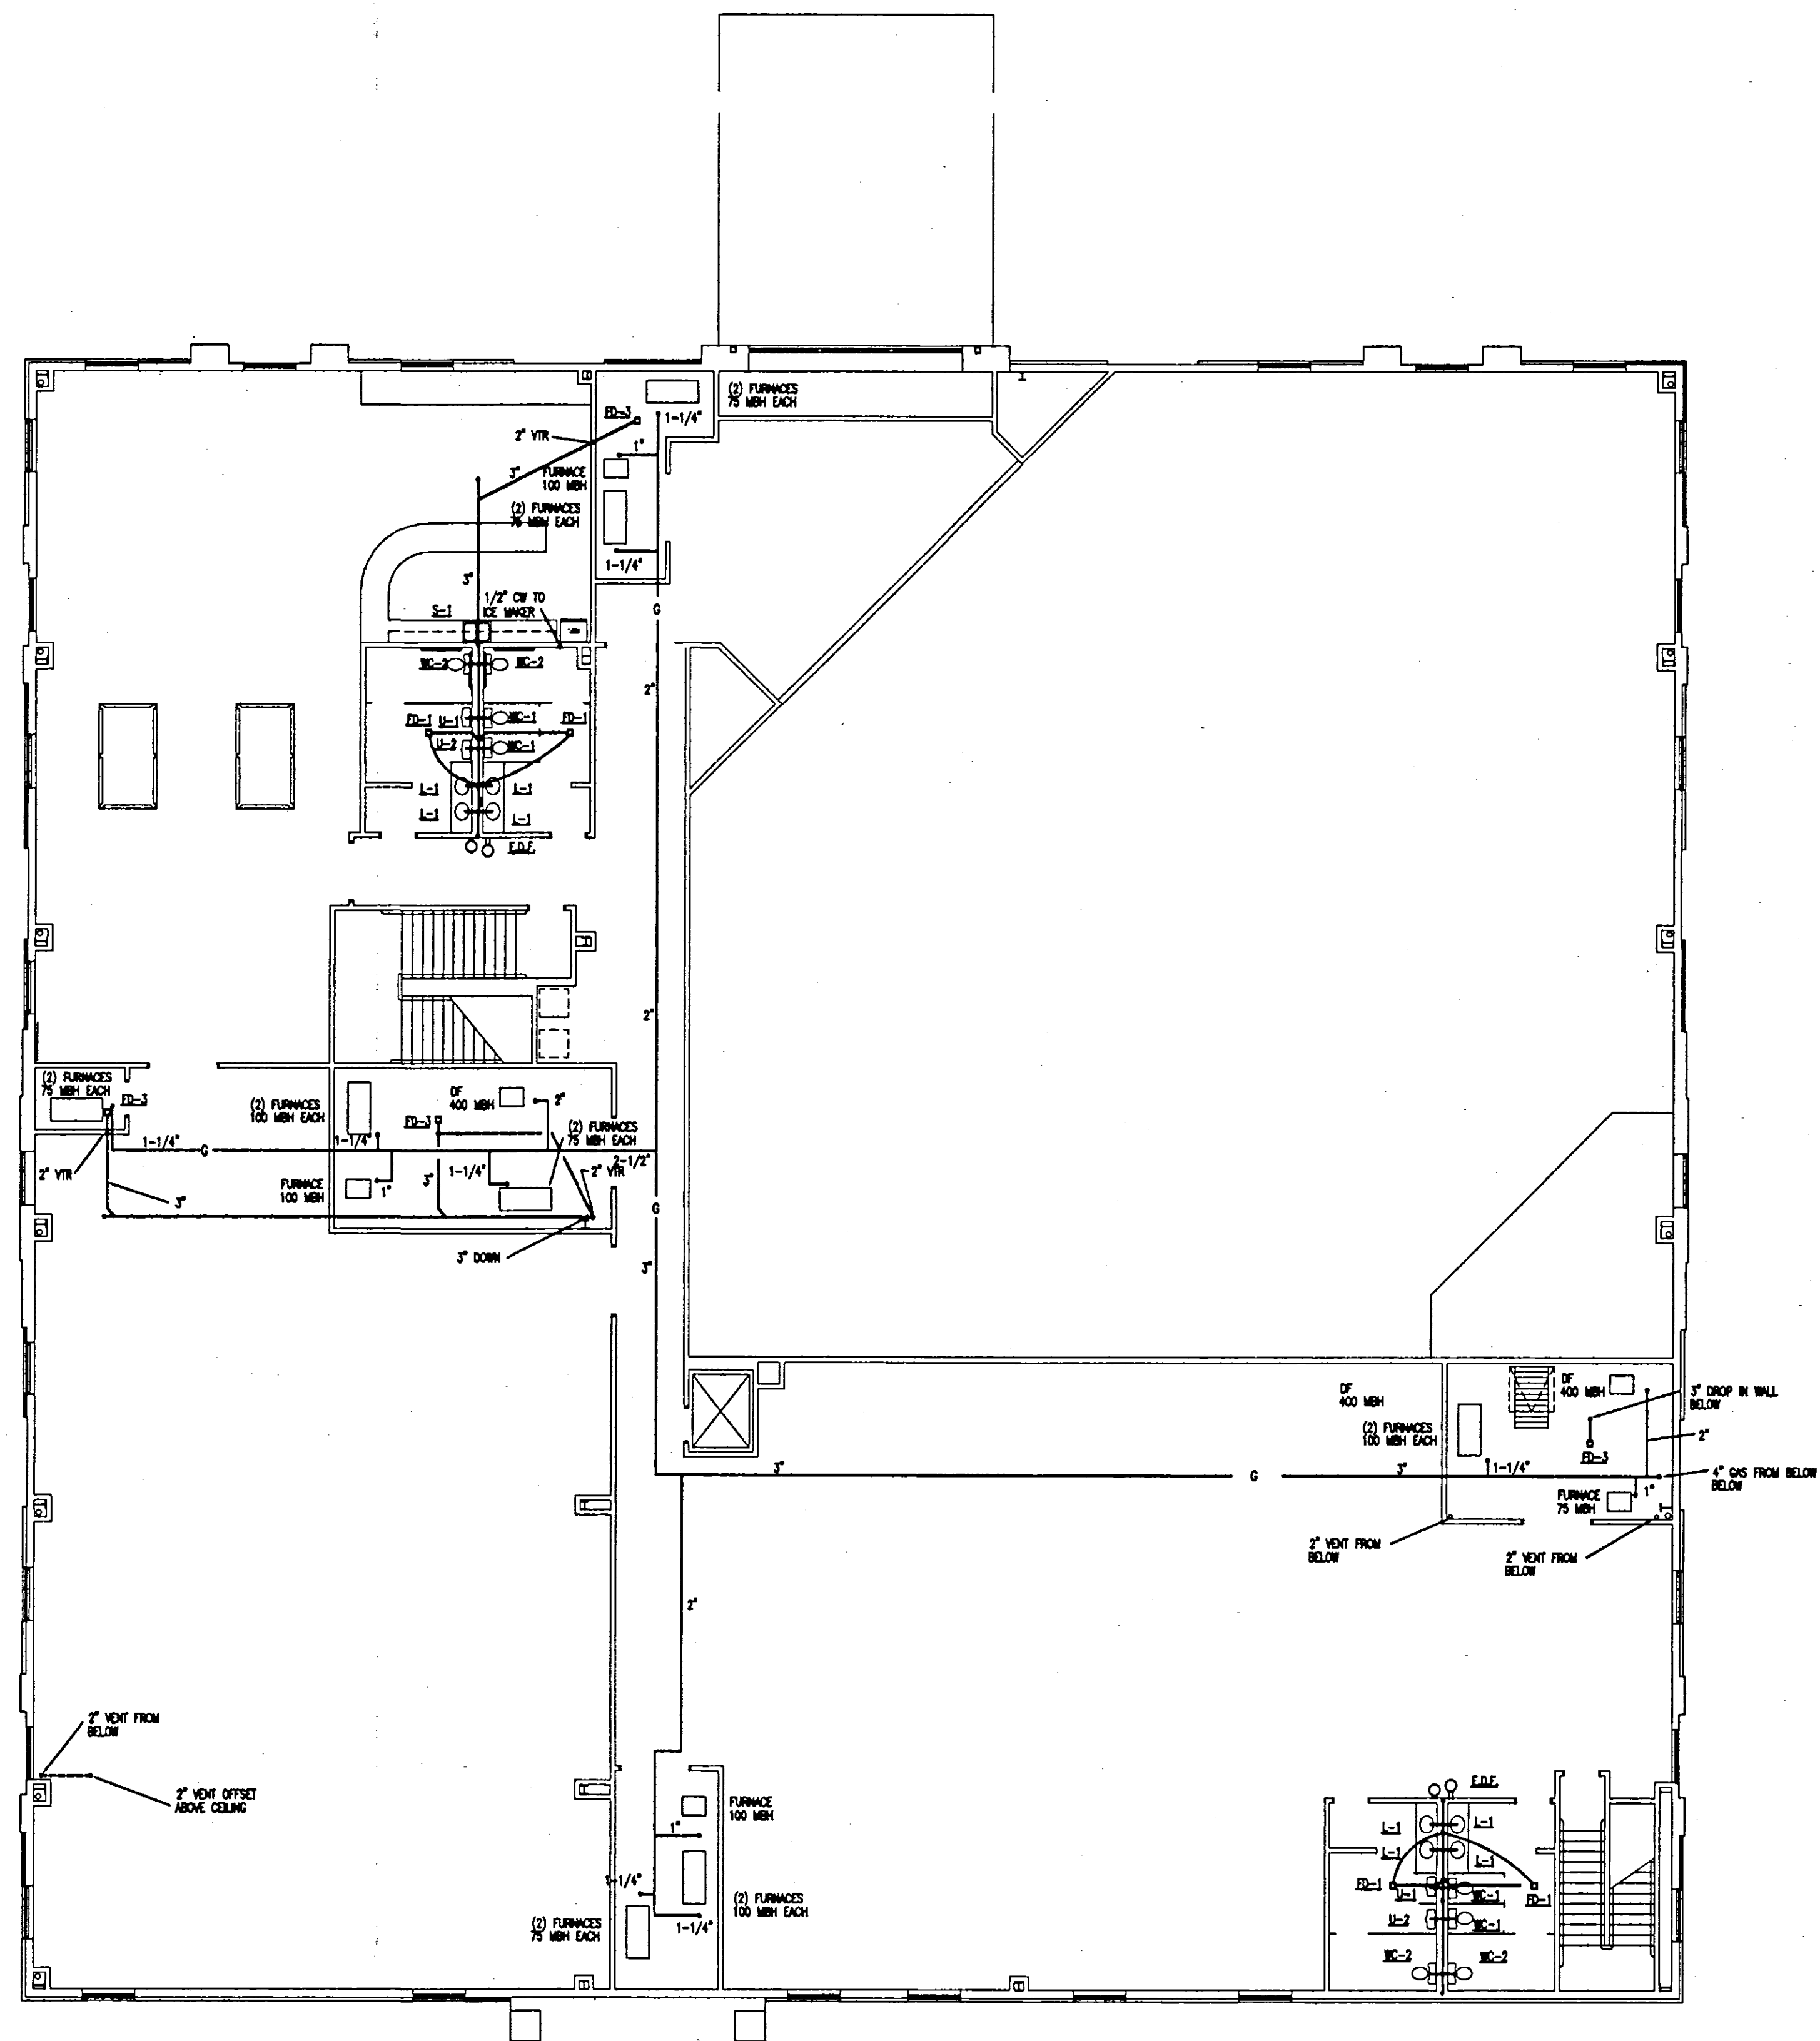

WATER SERVICE PIPE	
MATERIAL	STANDARD
COPPER OR COPPER-ALLOY PIPE	ASTM B 42; ASTM B 302
COPPER OR COPPER-ALLOY TUBING (TYPE K, W, L, W, M, OR WM)	ASTM B 75; ASTM B 88; ASTM B 251; ASTM B 447
DUCTILE IRON WATER PIPE	APMA C151; APMA C115
POLYVINYL CHLORIDE (PVC) PLASTIC PIPE	ASTM D 1785; ASTM D2241; ASTM D 2672; CSA CAN/CSA-B137.3

WATER SERVICE PIPE FITTINGS	
MATERIAL	STANDARD
COPPER OR COPPER-ALLOY PIPE	ASME B16.15; ASME B16.18; ASME B16.22; ASME B16.23; ASME B16.26; ASME B16.29; ASME B16.32
GRAY IRON AND DUCTILE IRON	APMA C110; APMA C153
POLYVINYL CHLORIDE (PVC) PLASTIC PIPE	ASTM D 2484; ASTM D 2486; ASTM D 2487; CSA CAN/CSA-B137.2

WATER DISTRIBUTION PIPE	
MATERIAL	STANDARD
COPPER OR COPPER-ALLOY TUBING (TYPE K, W, L, W, M, OR WM)	ASTM B 75; ASTM B 88; ASTM B 251; ASTM B 447


WATER DISTRIBUTION PIPE FITTINGS	
MATERIAL	STANDARD
COPPER OR COPPER-ALLOY PIPE	ASME B16.15; ASME B16.18; ASME B16.22; ASME B16.23; ASME B16.26; ASME B16.29; ASME B16.32

BUILDING SEWER PIPE (BELOW GROUND)	
MATERIAL	STANDARD
CAST-IRON PIPE	ASTM A 74; ASTM A 886; CSPI 301
POLYVINYL CHLORIDE (PVC) PLASTIC PIPE (TYPE DWV, SDR26, SDR35, SDR41, P50 OR P5100)	ASTM D 2665; ASTM D 2946; ASTM D 3034; ASTM F 881; CSA B182.2; CSA CAN/CSA-B182.4

BUILDING SEWER PIPE FITTINGS (BELOW GROUND)	
MATERIAL	STANDARD
CAST IRON	ASME B 16.4; ASME B 16.12; ASTM A 74; ASTM A 886; CSPI 301
POLYVINYL CHLORIDE (PVC) PLASTIC	ASTM D 3311; ASTM D 2965


DRAINAGE AND VENT PIPE (ABOVE-GROUND)	
MATERIAL	STANDARD
CAST-IRON PIPE	ASTM A 74; ASTM A 886; CSPI 301

DRAINAGE AND VENT PIPE FITTINGS (ABOVE-GROUND)	
MATERIAL	STANDARD
CAST-IRON PIPE	ASTM A 886; CSPI 301

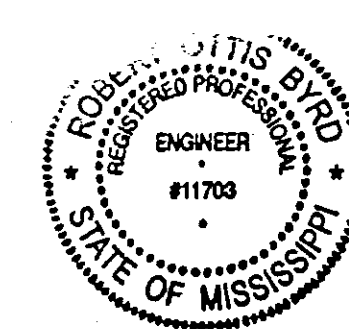


PLUMBING PLAN FOR  
HIGHLAND CHURCH


DATE 09/20/02 DRAWING # P2.2

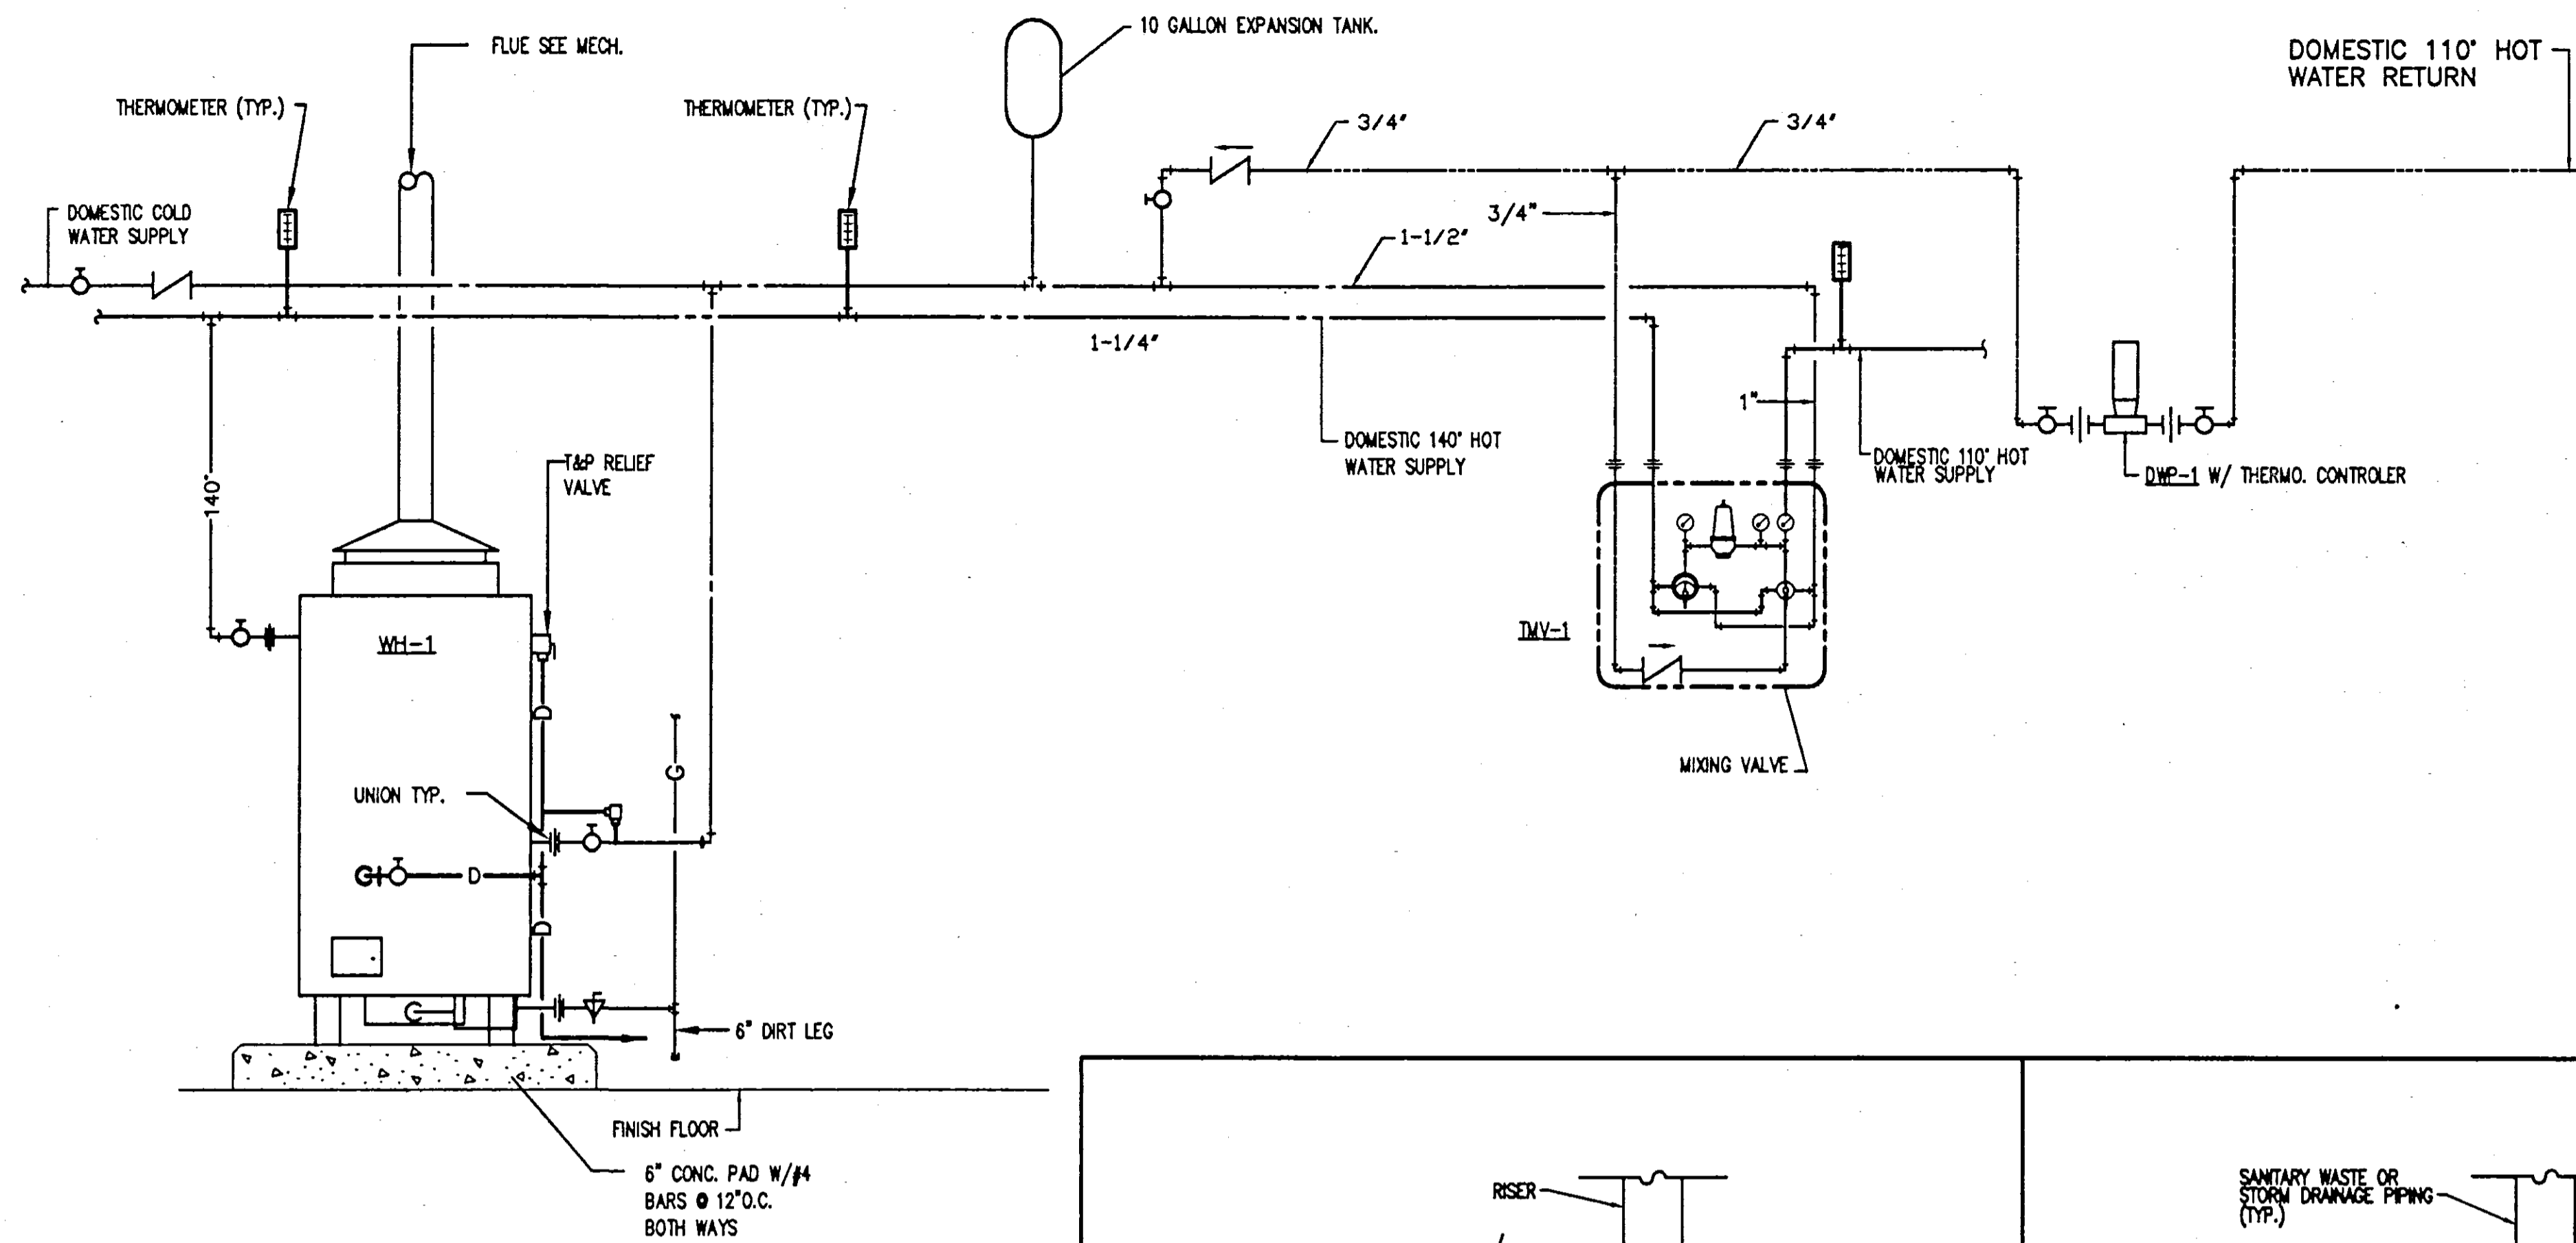


**WATER HEATER DETAIL**  
NO SCALE

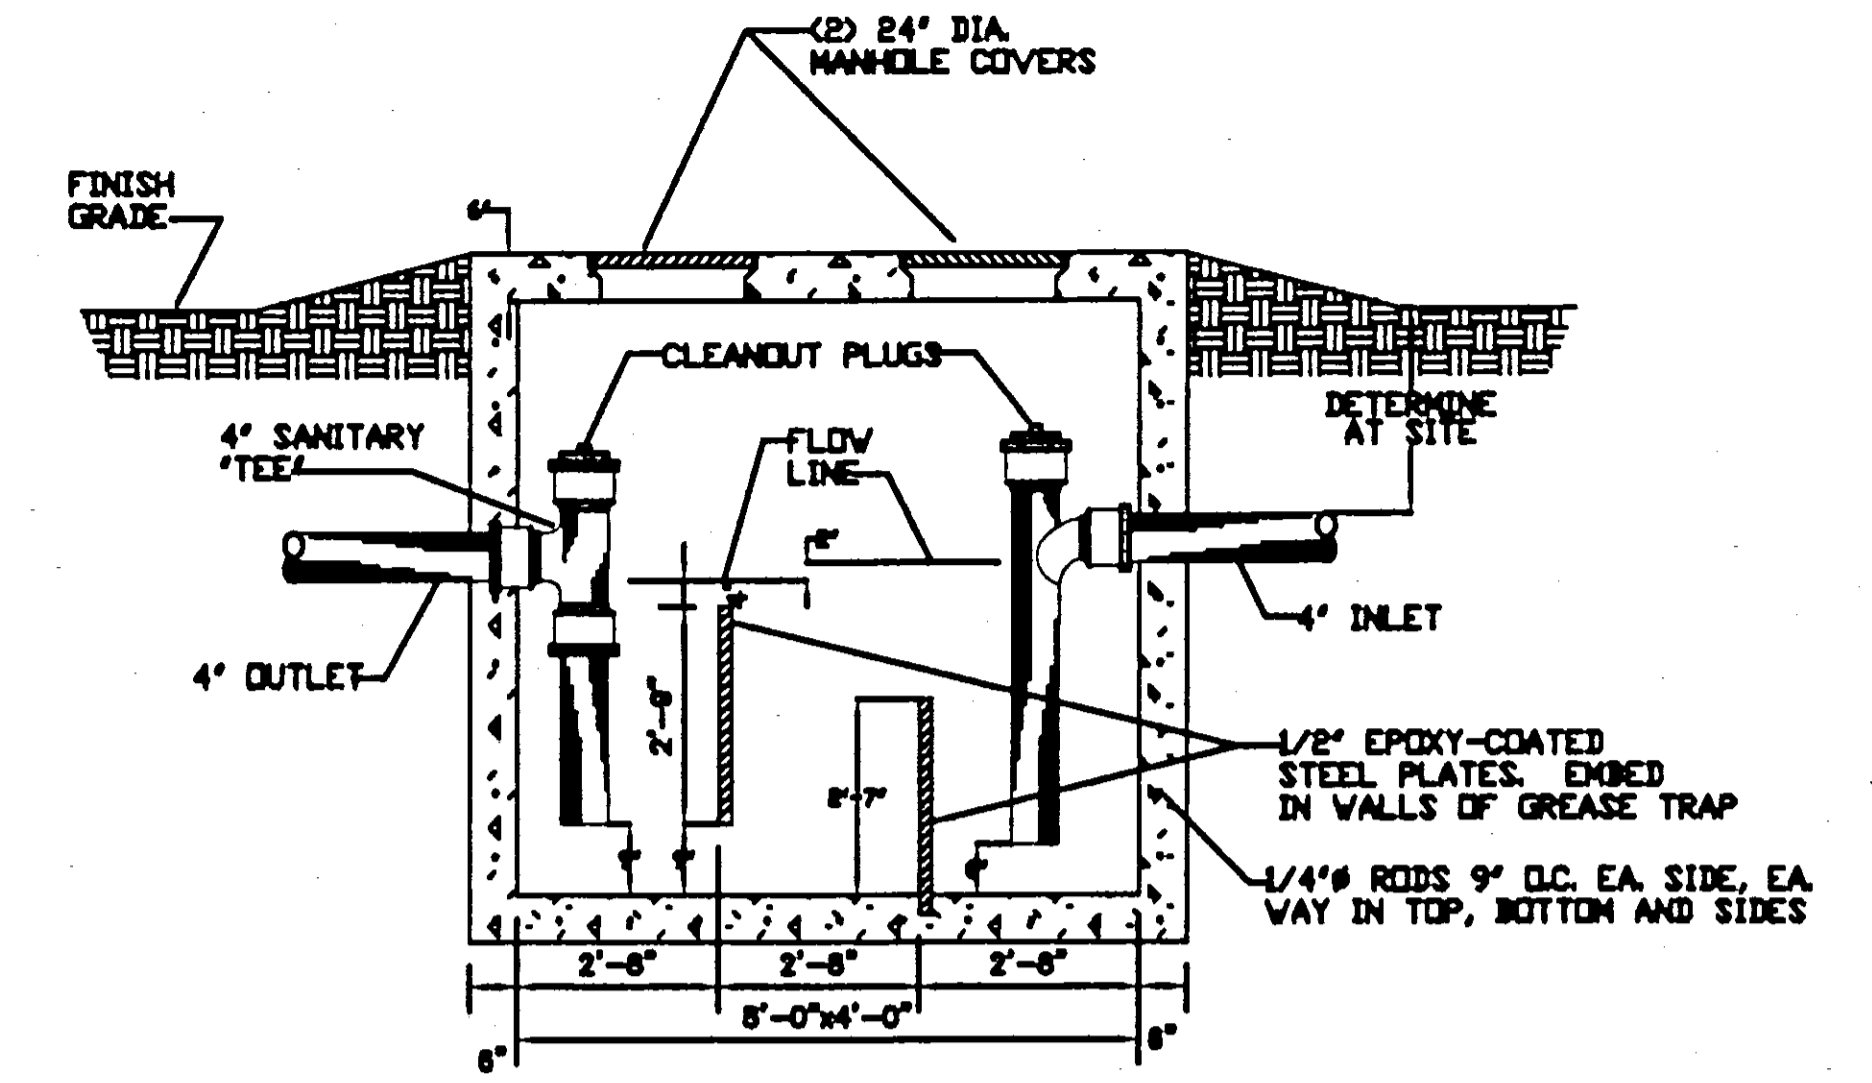


**GREASE TRAP DETAIL**  
NOT TO SCALE

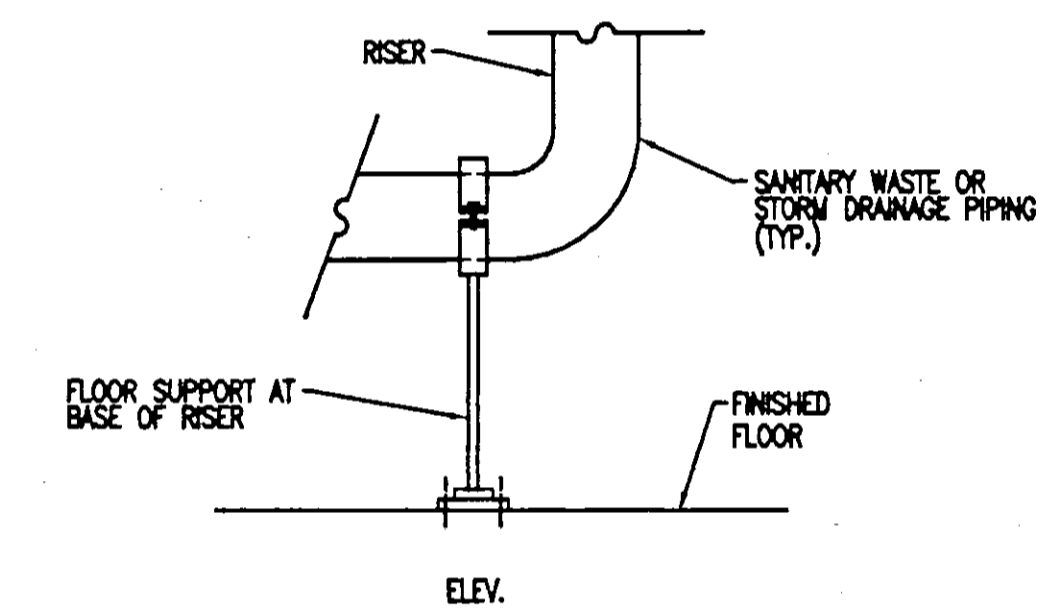


**PIPE FLOOR SUPPORT AT BASE OF RISER DETAIL**  
NO SCALE

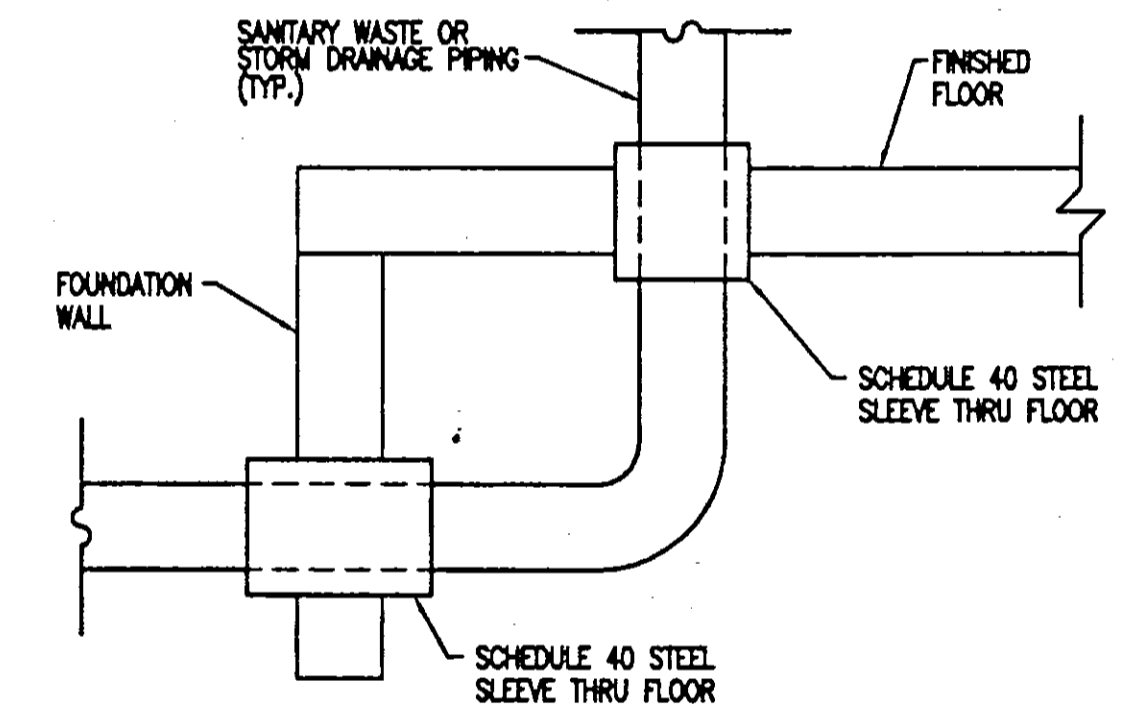


**PIPE SLEEVE THRU FLOOR DETAIL**  
NO SCALE

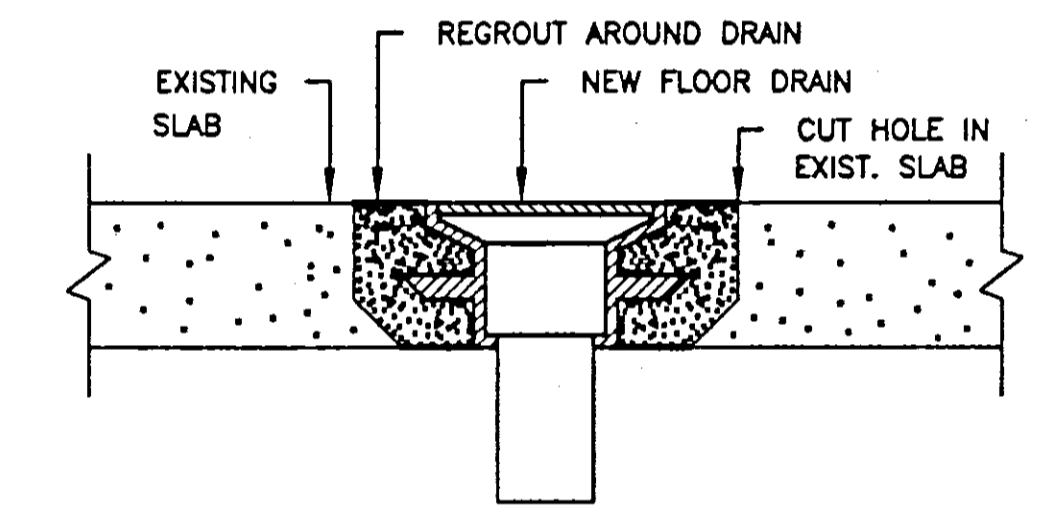


**FLOOR DRAIN DETAIL**  
NO SCALE

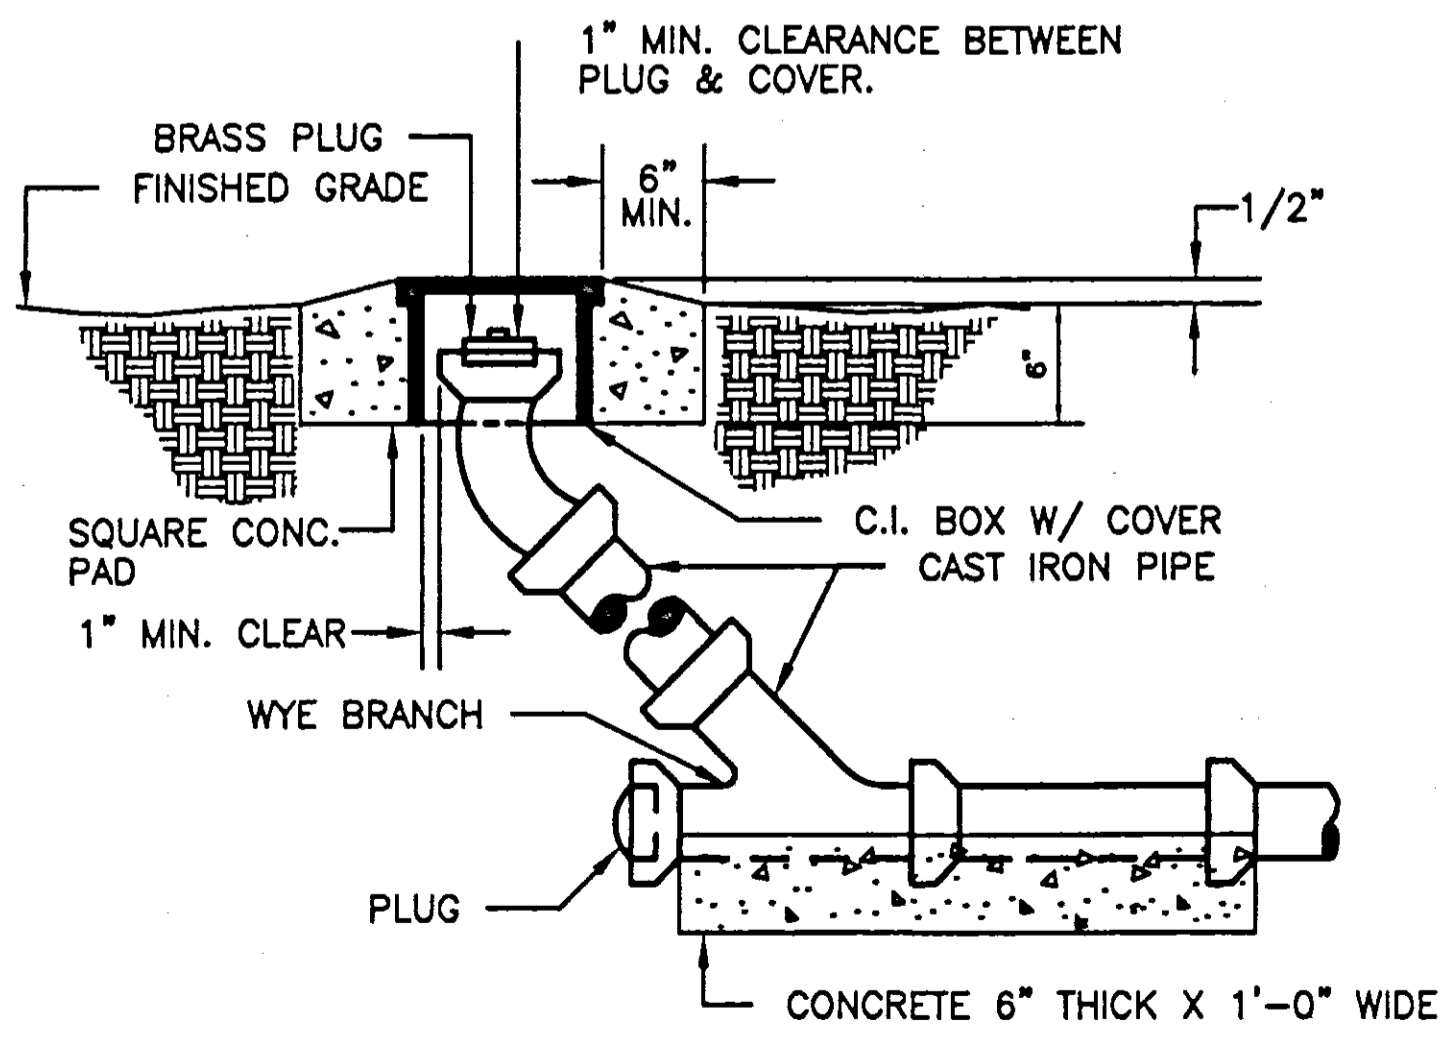

**FLUSH GRADE CLEANOUT**  
NO SCALE

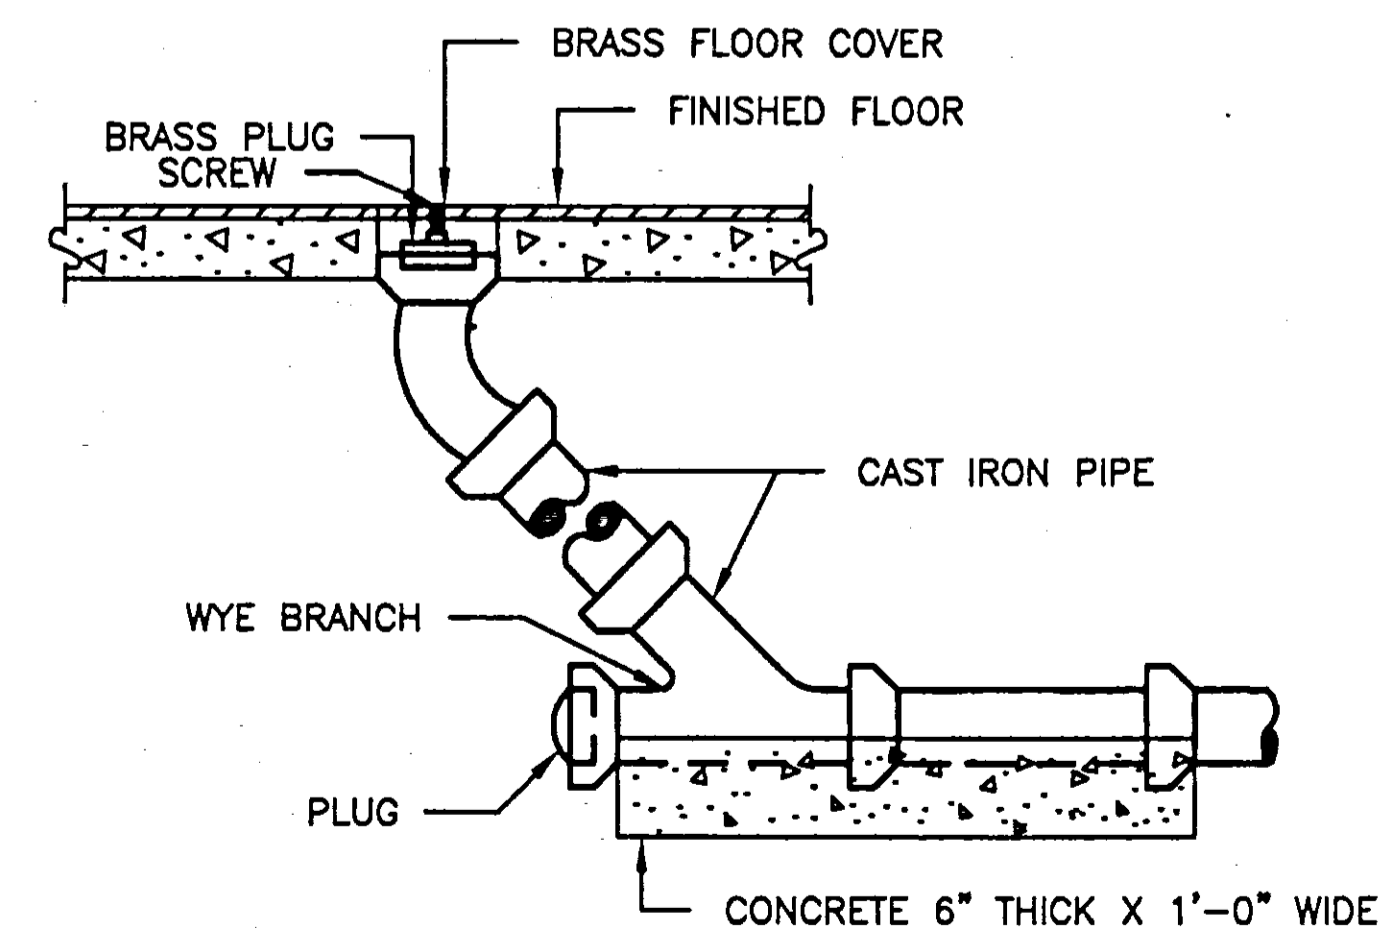


**FINISHED FLOOR CLEANOUT**  
NO SCALE

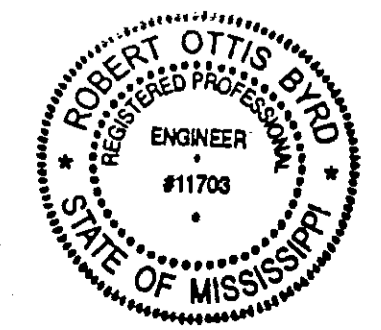

PLUMBING PLAN FOR HIGHLAND CHURCH	
DATE 09/20/02	DRAWING # P3.1

NO.	REVISIONS	DATE

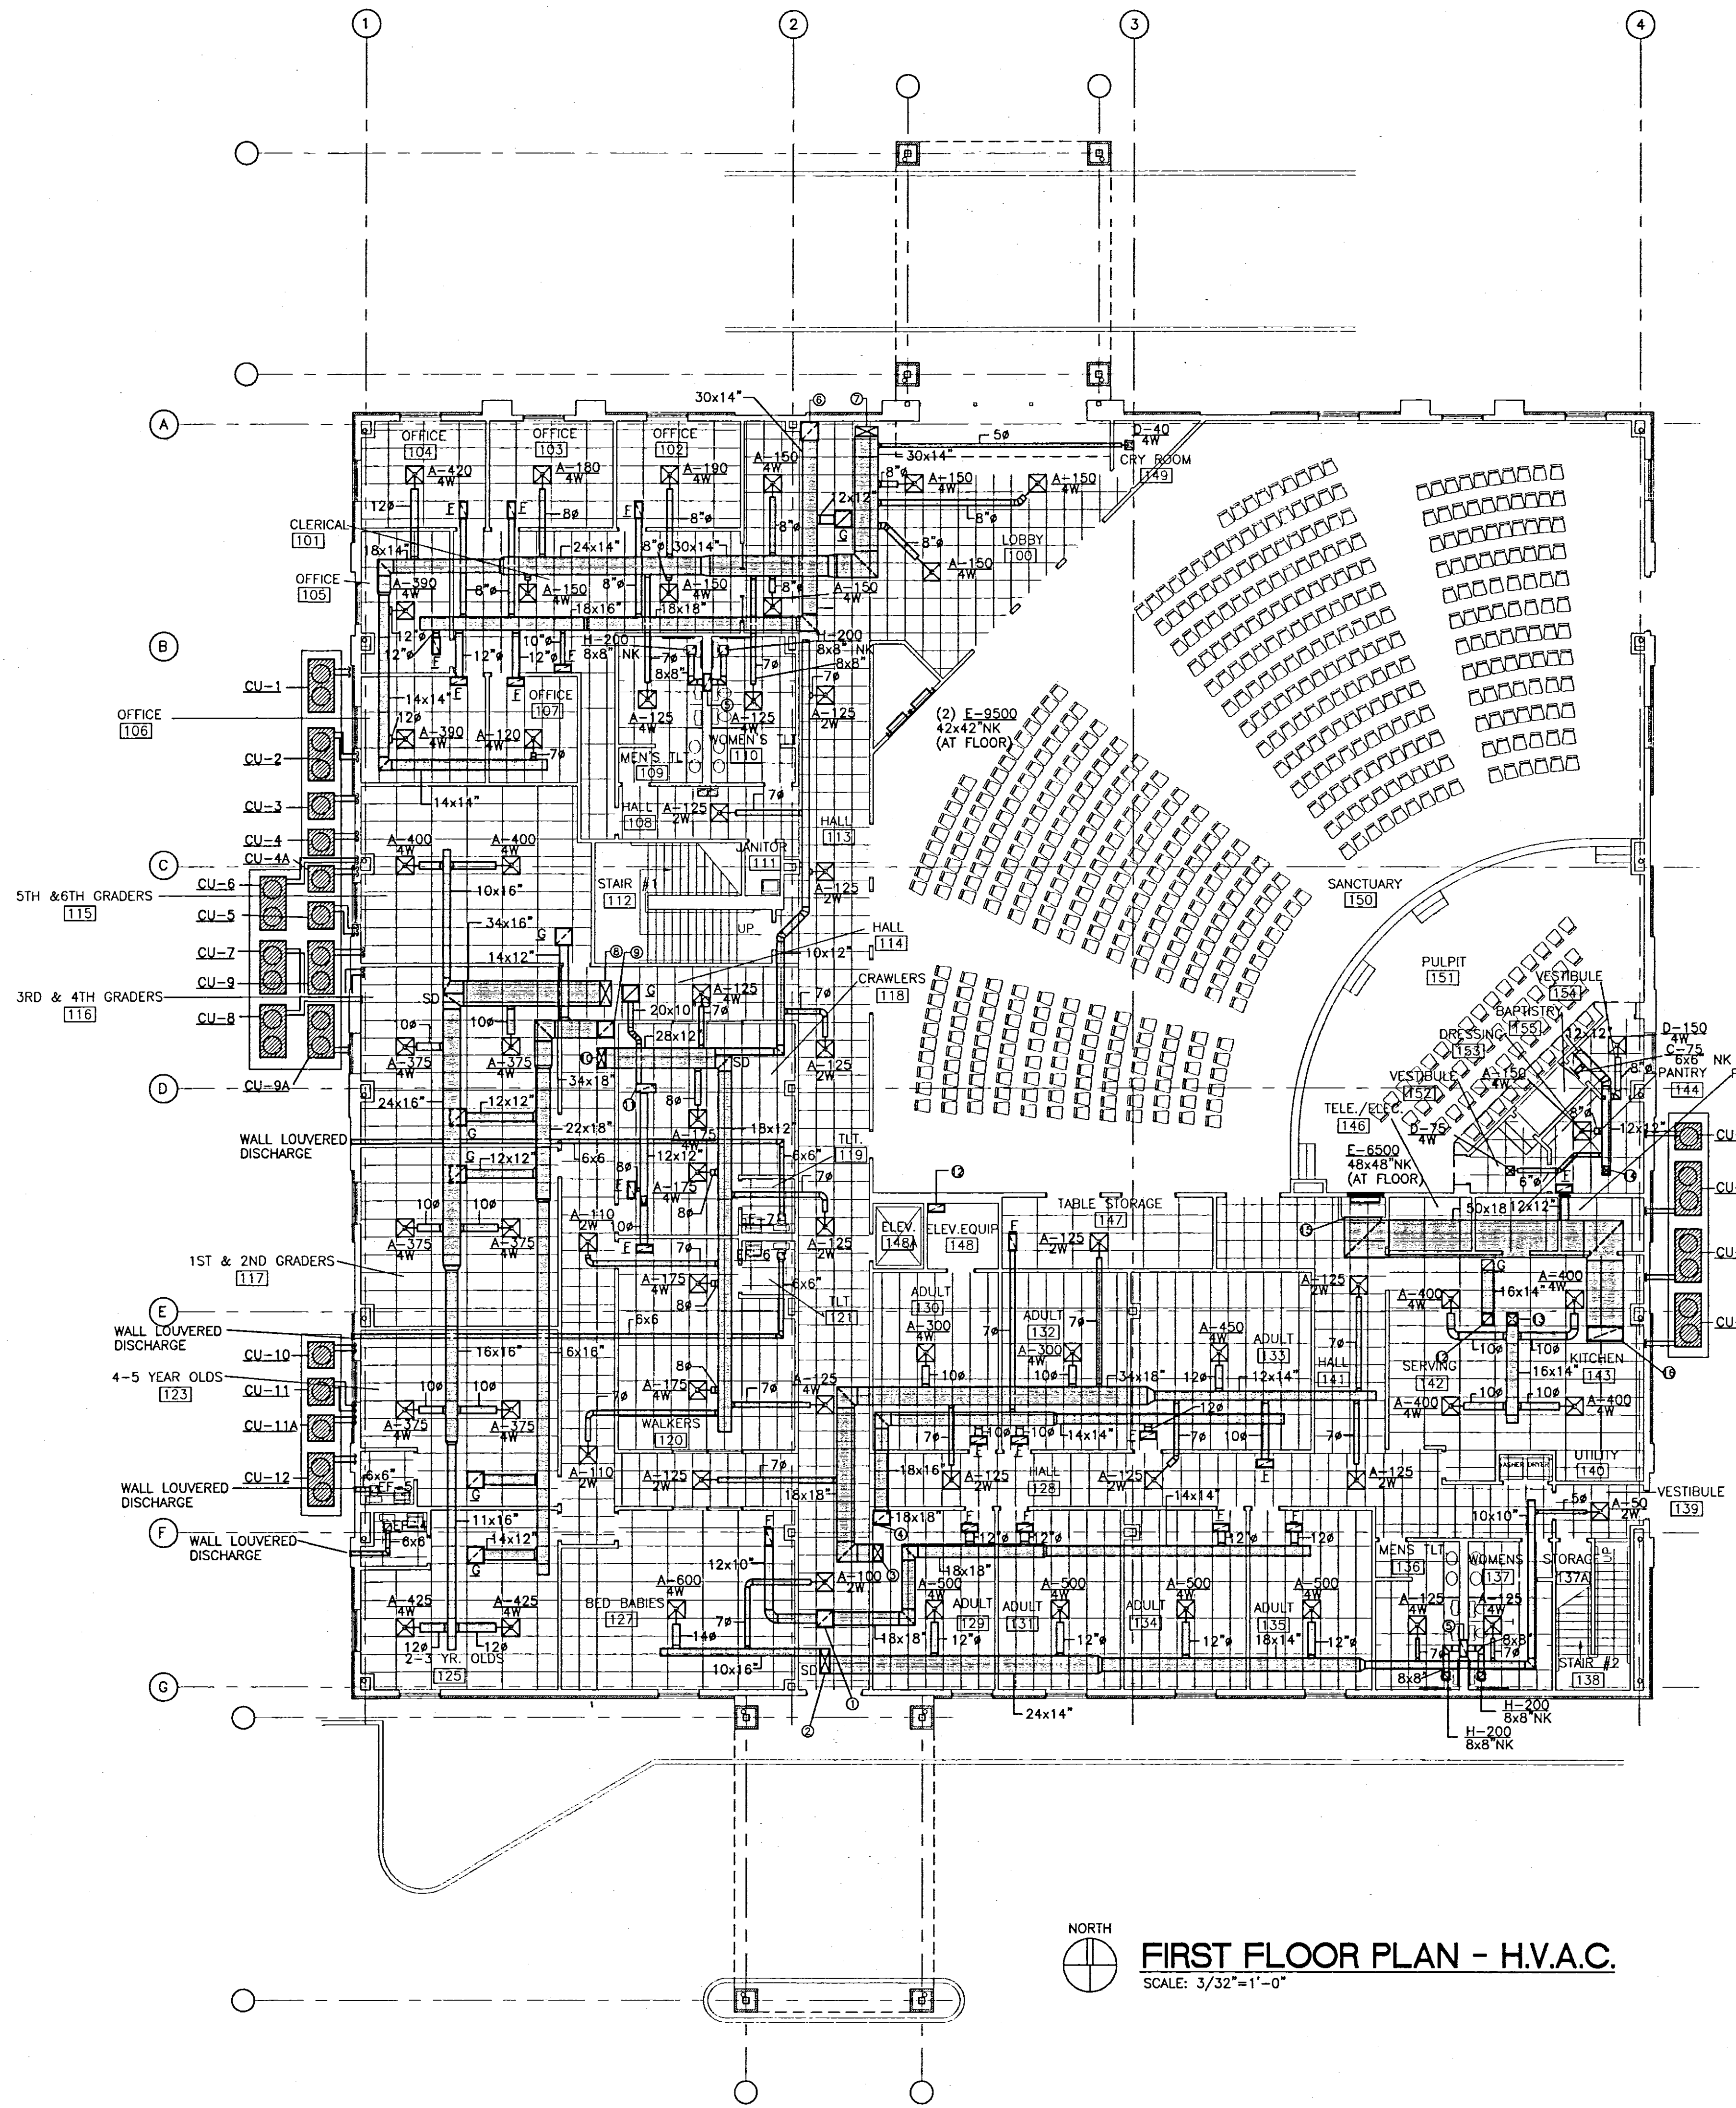

- H.V.A.C. NOTES**
- INDICATES 22x18" R.A. DUCT UP TO SECOND FLOOR. PROVIDE FIRE DAMPER AT FLOOR PENETRATION.
  - INDICATES 34x16" S.A. DUCT DN. FROM SECOND FLOOR. PROVIDE FIRE DAMPER AT FLOOR PENETRATION.
  - INDICATES 18x18" S.A. DUCT DN. FROM SECOND FLOOR. PROVIDE FIRE DAMPER AT FLOOR PENETRATION.
  - INDICATES 18x18" R.A. DUCT UP TO SECOND FLOOR. PROVIDE FIRE DAMPER AT FLOOR PENETRATION.
  - INDICATES 10x10" EXH. DUCT UP TO SECOND FLOOR. PROVIDE FIRE DAMPER AT FLOOR PENETRATION.
  - INDICATES 30x14" S.A. DUCT DOWN FROM SECOND FLOOR. PROVIDE FIRE DAMPER AT FLOOR PENETRATION.
  - INDICATES 30x14" R.A. DUCT UP TO SECOND FLOOR. PROVIDE FIRE DAMPER AT FLOOR PENETRATION.
  - INDICATES 34x16" S.A. DUCT DOWN FROM SECOND FLOOR. PROVIDE FIRE DAMPER AT FLOOR PENETRATION.
  - INDICATES 34x16" R.A. DUCT UP TO SECOND FLOOR. PROVIDE FIRE DAMPER AT FLOOR PENETRATION.
  - INDICATES 28x12" S.A. DUCT DOWN FROM SECOND FLOOR. PROVIDE FIRE DAMPER AT FLOOR PENETRATION.
  - INDICATES 18x18" R.A. DUCT UP TO SECOND FLOOR. PROVIDE FIRE DAMPER AT FLOOR PENETRATION.
  - INDICATES 16x14" R.A. DUCT UP TO SECOND FLOOR. PROVIDE FIRE DAMPER AT FLOOR PENETRATION.
  - INDICATES 16x14" S.A. DUCT DOWN FROM SECOND FLOOR. PROVIDE FIRE DAMPER AT FLOOR PENETRATION.
  - INDICATES 12x12" S.A. DUCT DOWN FROM SECOND FLOOR.
  - INDICATES 50x18" R.A. DUCT TO BE STUBBED INTO R.A. PLENUM. SEAL PENETRATION AIR TIGHT.
  - INDICATES 50x18" R.A. DUCT UP TO SECOND FLOOR. PROVIDE FIRE DAMPER AT FLOOR PENETRATION.
  - INDICATES 8x8" EXH. AIR DUCT UP TO 2nd FLOOR. PROVIDE FIRE DAMPER AT FLOOR PENETRATION.

**SIZING SCHEDULE**

CFM	DIFFUSER	
	NECK SIZE	LOUVER FACE
0-150	6x6"	
151-300	9x9"	
301-600	12x12"	
600-1100	15x15"	

Fire Dampers with a min. 1.5 hr. Fire resistance

**FIRST FLOOR PLAN - H.V.A.C.**  
SCALE: 3/32"=1'-0"

Scott C. Woods and Associates



112 Lone Wolf Dr./Madison, Ms 39110  
Ph. (601)859-9864/Fax (601)859-2564/Email scweng@aol.com


**CHURCH OF THE  
THE HIGHLANDS**  
NEW BUILDING  
RIDGELAND, MISSISSIPPI

**FIRST FLOOR PLAN  
H.V.A.C.**

	PROJECT NO.	01072	<b>M1</b> of 5
	DATE	07/13/01	
	DRAWN	CSH	
	CHECKED	GDT	

S:\101072\DRAWINGS\MECH\101072M1.dwg Mod Jul 19 14:23:36 2001

NO.	REVISIONS	DATE

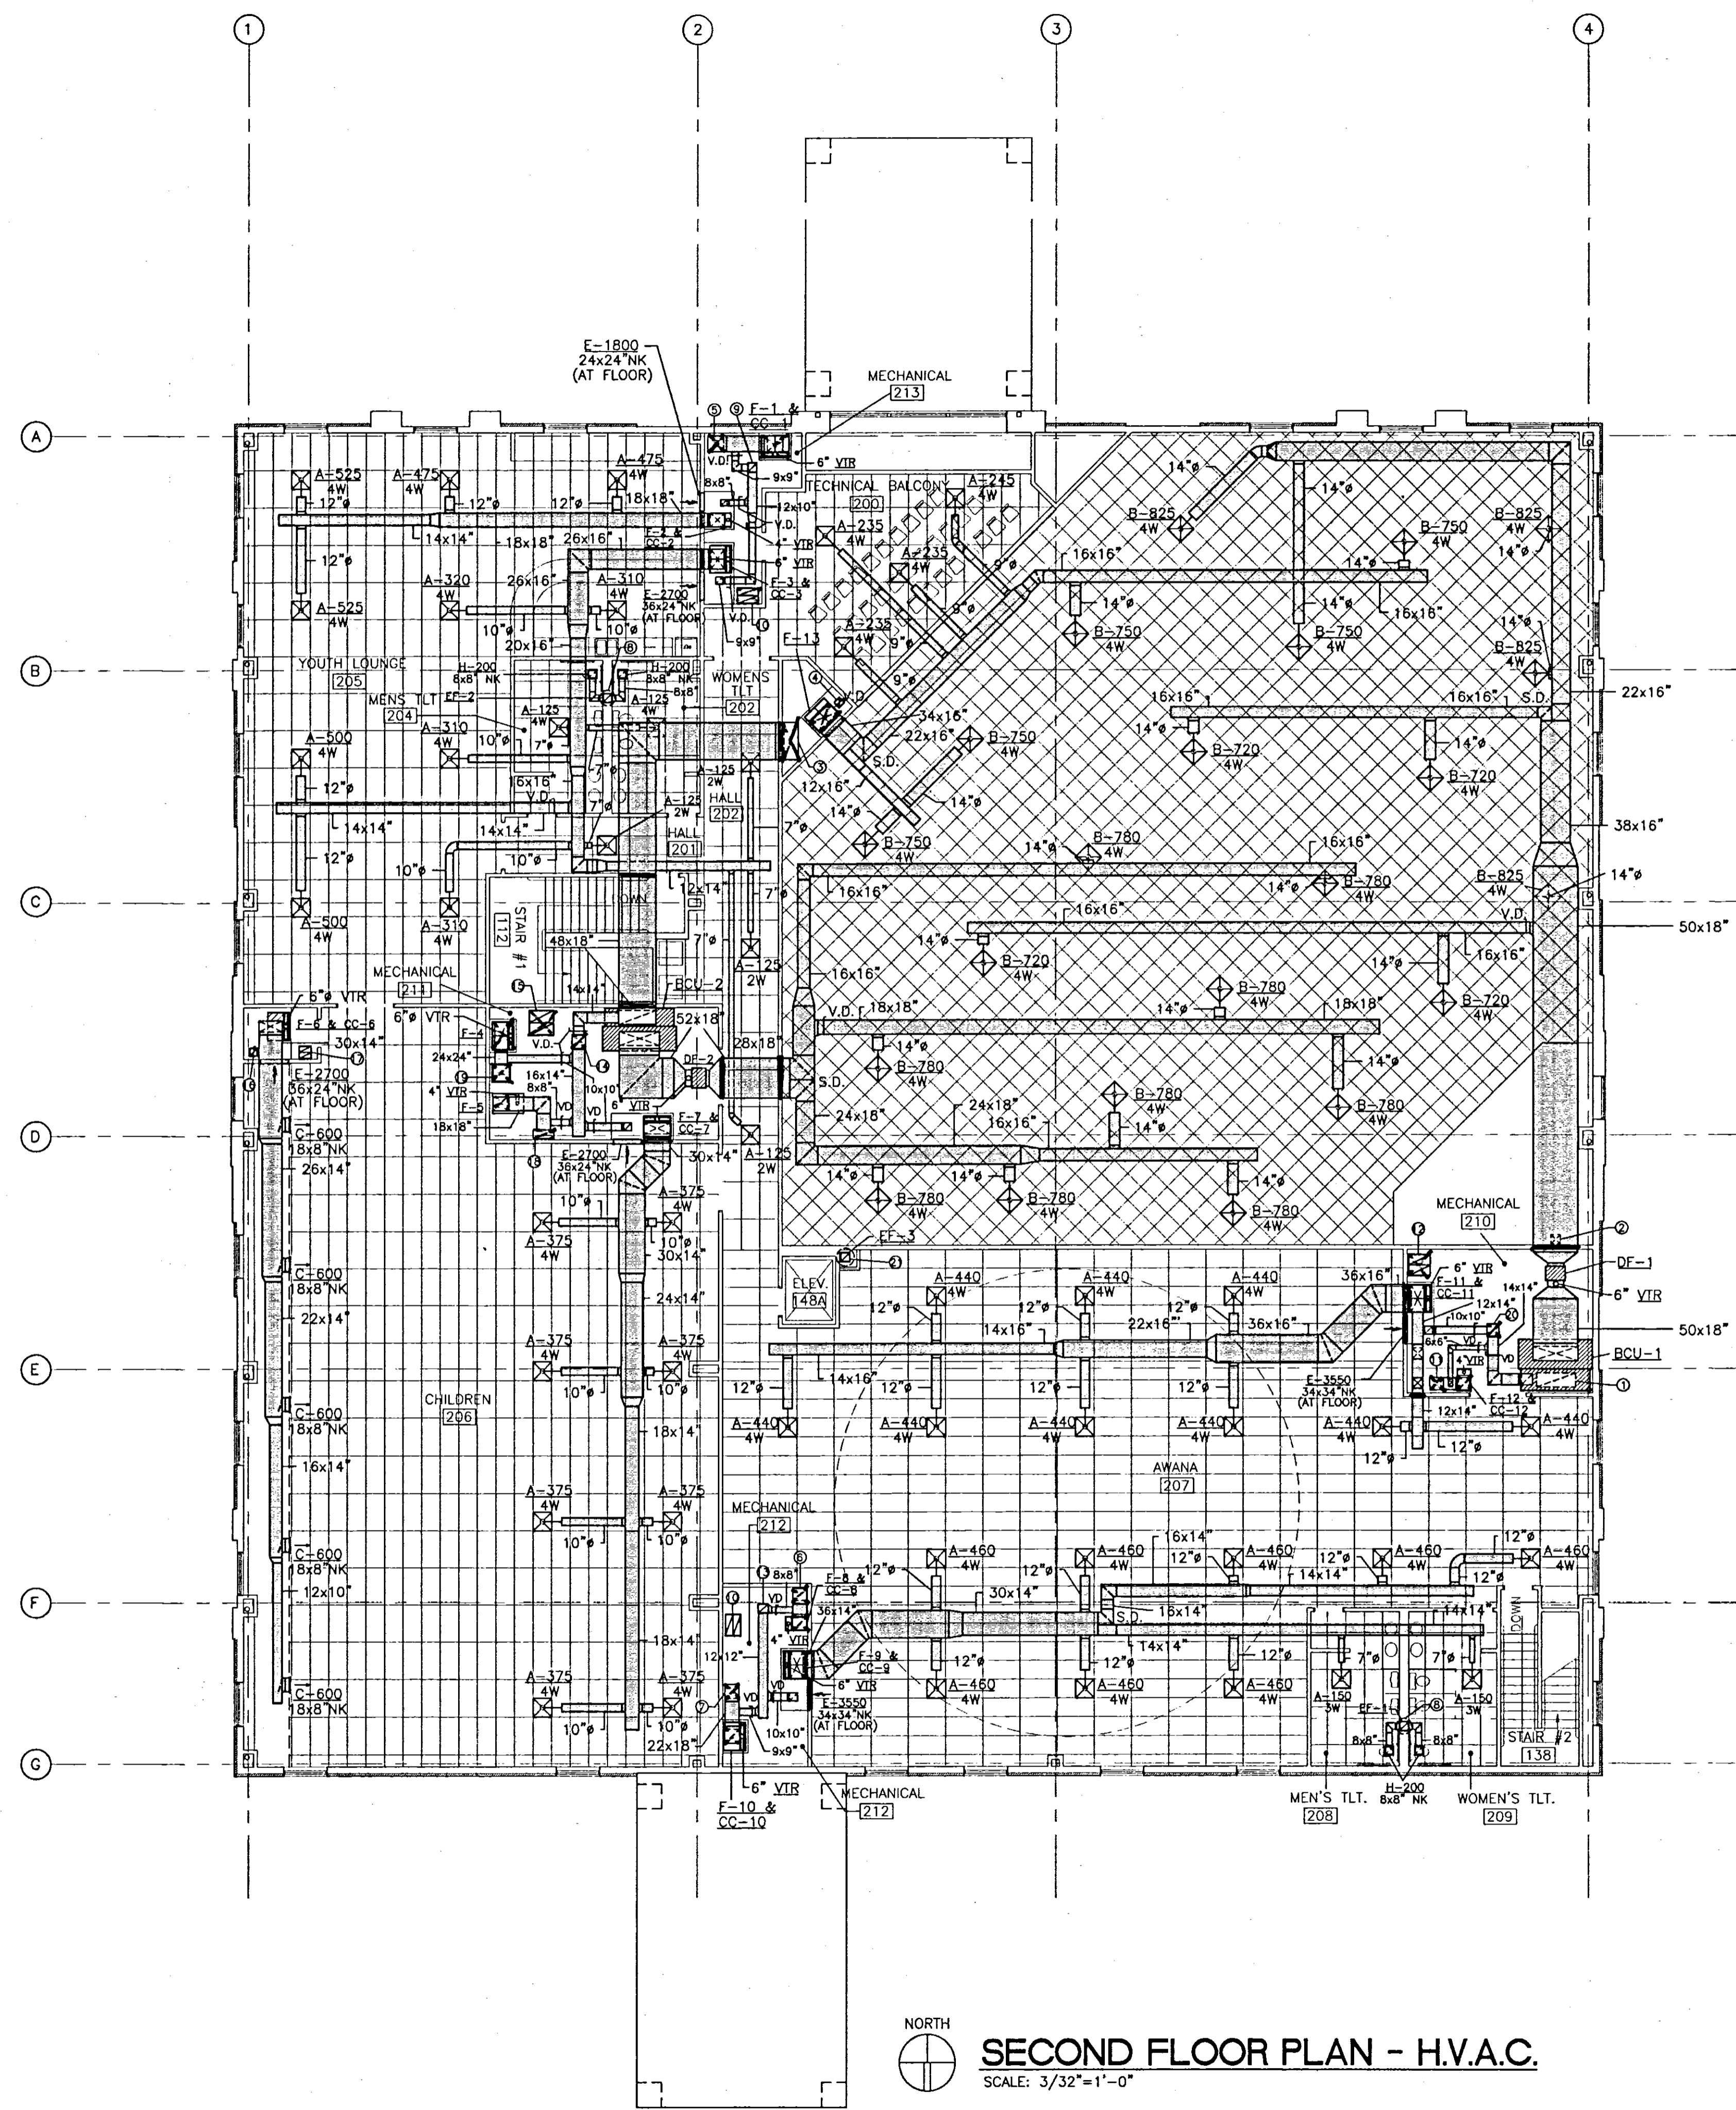

SIZING SCHEDULE	
DIFFUSER	
CFM	NECK SIZE (LOUVER FACE)
0-150	6x6"
151-300	9x9"
301-600	12x12"
600-1100	15x15"

- H.V.A.C. NOTES:**
- ① INDICATES A 50x18" RA DUCT UP FROM FIRST FLOOR.
  - ② INDICATES A 12x10" SA DUCT DOWN TO FIRST FLOOR. PROVIDE FIRE DAMPER AT FLOOR PENETRATION.
  - ③ INDICATES A 48x18" RA DUCT TO BE STUBBED THROUGH SECOND FLOOR INTO RA PLENUM SPACE BELOW. PROVIDE FIRE DAMPER AT FLOOR PENETRATION.
  - ④ INDICATES A 10x10" OA DUCT UP THROUGH ROOF. TERMINATE WITH PITCHED ROOF INTAKE CAP.
  - ⑤ INDICATES A 22x18" RA DUCT UP FROM FIRST FLOOR.
  - ⑥ INDICATES A 18x16" RA DUCT UP FROM FIRST FLOOR.
  - ⑦ INDICATES A 22x18" RA DUCT UP FROM FIRST FLOOR.
  - ⑧ INDICATES A 12x12" EXHAUST DUCT UP THROUGH ROOF TO EF-1 AND A 10x10" EXHAUST DUCT DOWN TO FIRST FLOOR. PROVIDE FIRE DAMPER AT FLOOR PENETRATION.
  - ⑨ INDICATES A 12x12" OA DUCT UP THROUGH ROOF. TERMINATE WITH PITCHED ROOF CAP.
  - ⑩ INDICATES A 28x20" COMBUSTION AIR DUCT UP THROUGH ROOF. TERMINATE WITH PITCHED ROOF INTAKE CAP. TERMINATE ONE 14x10" PORTION 12" BELOW CEILING STRUCTURE AND THE OTHER 14x10" PORTION 12" ABOVE FINISH FLOOR.
  - ⑪ INDICATES A 16x14" RA DUCT UP FROM FIRST FLOOR.
  - ⑫ INDICATES A 28x28" COMBUSTION AIR DUCT UP THROUGH ROOF. TERMINATE WITH PITCHED ROOF INTAKE CAP. TERMINATE ONE 14x14" PORTION 12" BELOW CEILING STRUCTURE AND THE OTHER 14x14" PORTION 12" ABOVE FINISH FLOOR.
  - ⑬ INDICATES A 14x12" OA DUCT UP THROUGH ROOF. TERMINATE WITH PITCHED ROOF INTAKE CAP.
  - ⑭ INDICATES A 18x18" OA DUCT UP THROUGH ROOF. TERMINATE WITH A PITCHED ROOF INTAKE CAP.
  - ⑮ INDICATES A 32x32" COMBUSTION AIR DUCT UP THROUGH ROOF. TERMINATE WITH A PITCHED ROOF INTAKE CAP. TERMINATE ONE 16x16" PORTION 12" BELOW CEILING STRUCTURE AND THE OTHER 16x16" PORTION 12" ABOVE FINISH FLOOR.
  - ⑯ INDICATES A 10x10" OA DUCT UP THROUGH ROOF. TERMINATE WITH A PITCHED ROOF INTAKE CAP.
  - ⑰ INDICATES A 16x16" COMBUSTION AIR DUCT UP THROUGH ROOF. TERMINATE WITH A PITCHED ROOF INTAKE CAP. TERMINATE ONE 8x8" PORTION 12" BELOW CEILING STRUCTURE AND THE OTHER 8x8" PORTION 12" BELOW FINISH FLOOR.
  - ⑱ INDICATES A 18x18" RA DUCT UP FROM FIRST FLOOR.
  - ⑲ INDICATES A 34x16" RA DUCT UP FROM FIRST FLOOR, TRANSITION TO 24x24" IN VERT.
  - ⑳ INDICATES A 16x16" OA DUCT UP THROUGH ROOF. TERMINATE WITH A PITCHED ROOF INTAKE CAP.
  - ㉑ INDICATES A 8x8" EXHAUST DUCT UP FROM FIRST FLOOR. EXTEND THROUGH ROOF TO EF-1.

**X** Fire dampers with a Min. 1.5hr. Fire Resistance

**Scott C. Woods and Associates**

112 Lone Wolf Dr./Madison, Ms 39110  
Ph. (601)859-9864/Fax (601)859-2564/Email scweng@aol.com

**PROJECT**

**CHURCH OF THE HIGHLANDS**

**NEW BUILDING**

RIDGELAND, MISSISSIPPI

**SHEET TITLE**

SECOND FLOOR PLAN  
H.V.A.C.


	PROJECT NO.	01072
	DATE	07/13/01
	DRAWN	TYJ
	CHECKED	GDT

**SHEET NUMBER**


M2

OF 6


E:\101072\DRAWINGS\MECH\101072P2.dwg Wed Jul 18 14:53:33 2001

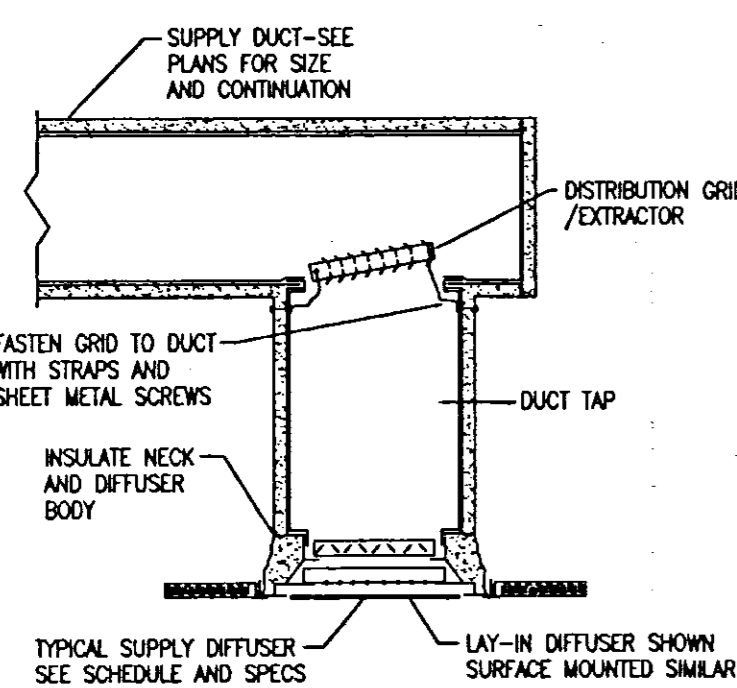


**TYPICAL DIFFUSER MOUNTING**  
N.T.S.

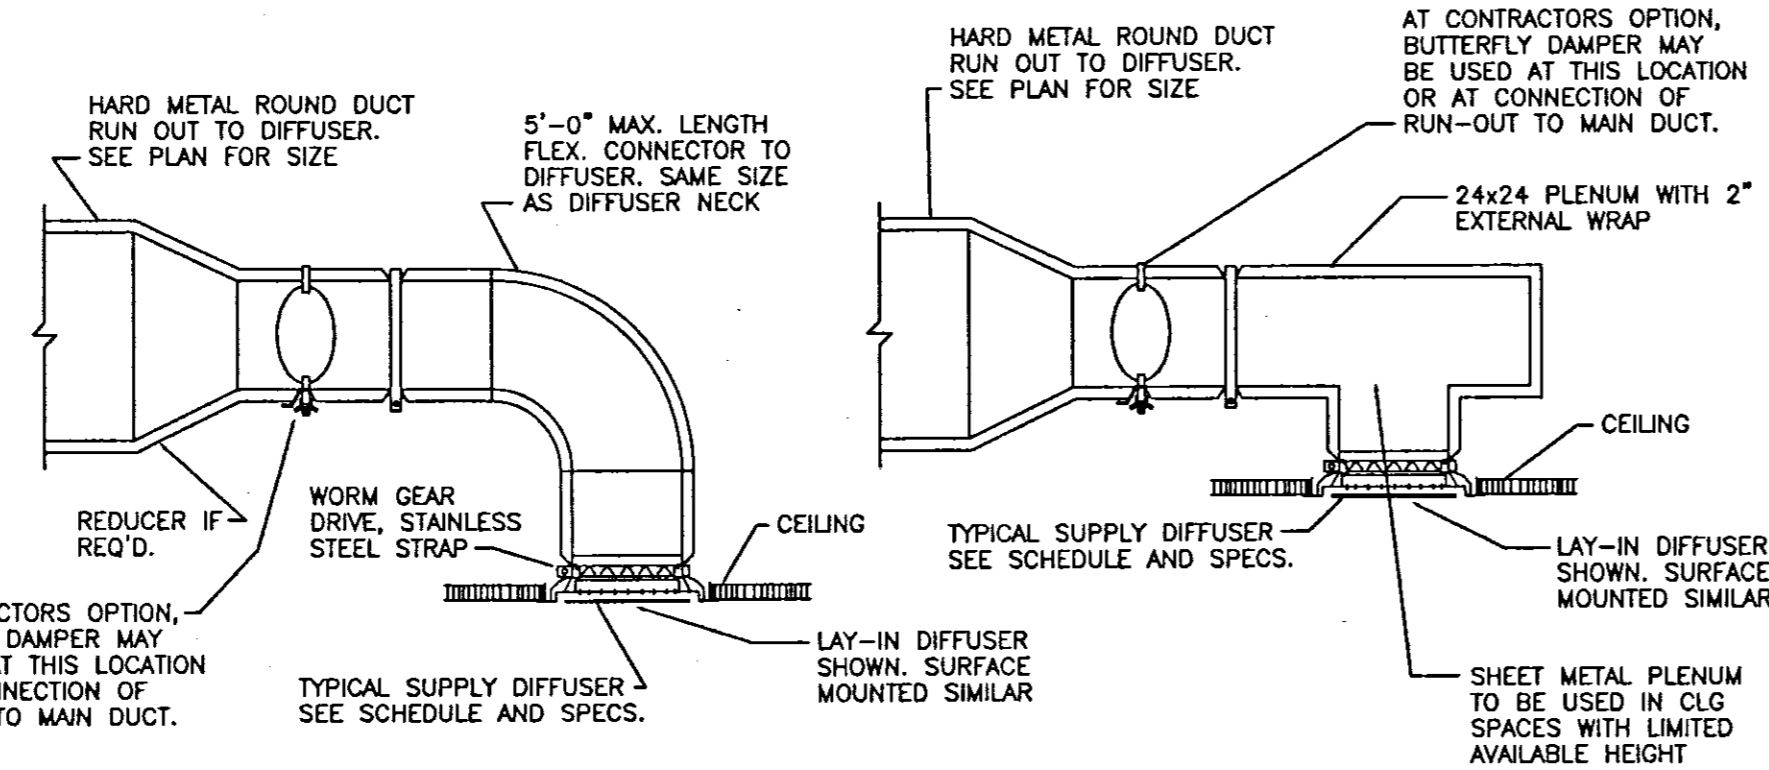


**TYPICAL DIFFUSER MOUNTING**  
N.T.S.

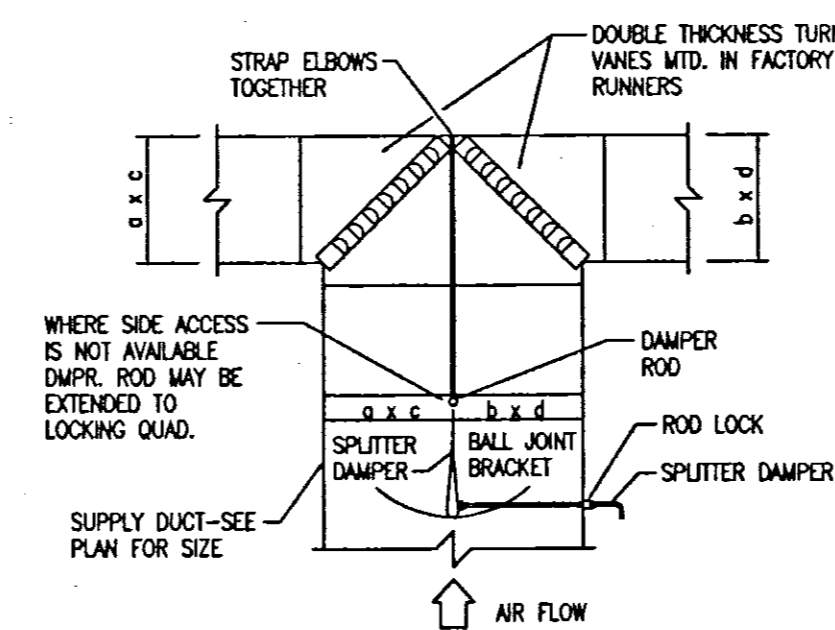


**SPLITTER DAMPER DETAIL**  
N.T.S.

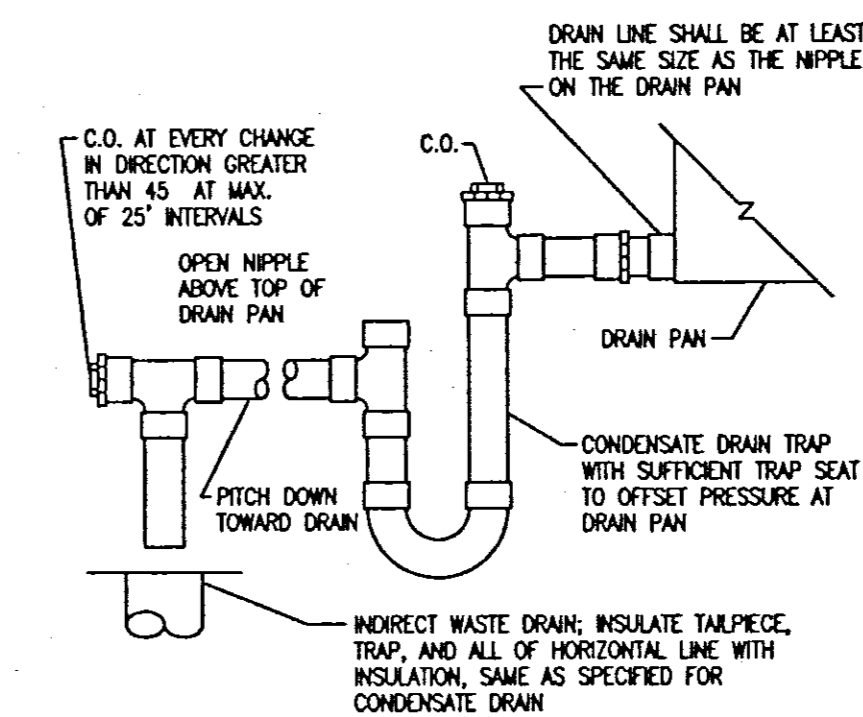


**CONDENSATE DRAIN TRAP DETAIL**  
N.T.S.

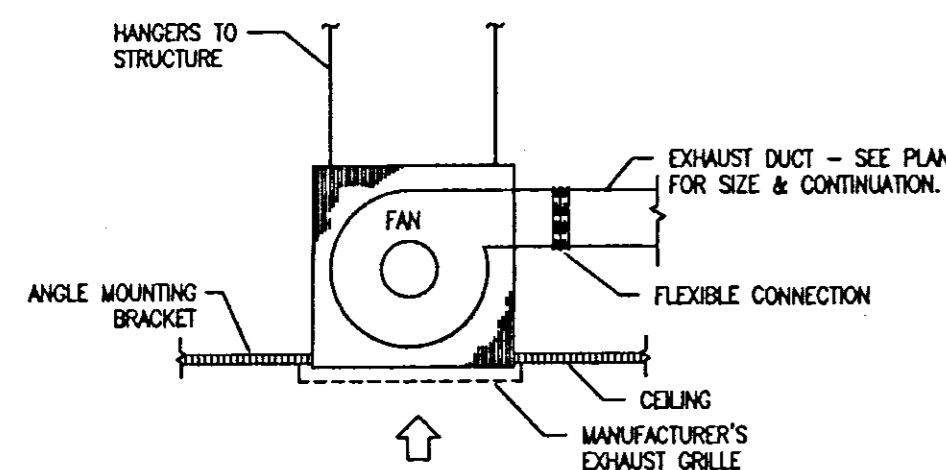


**CEILING MOUNTED EXHAUST FAN DETAIL**  
N.T.S.

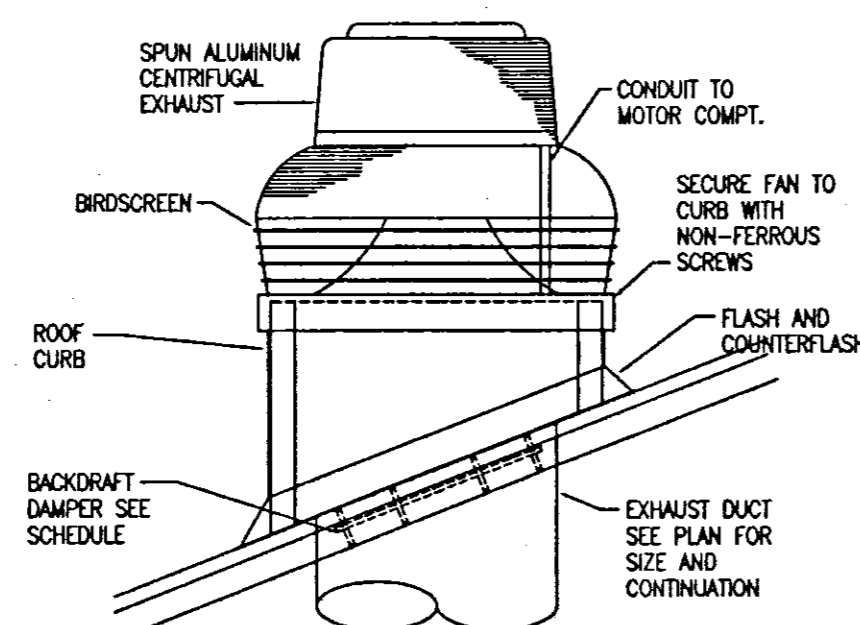


**ROOF MTD. FAN DETAIL**  
N.T.S.

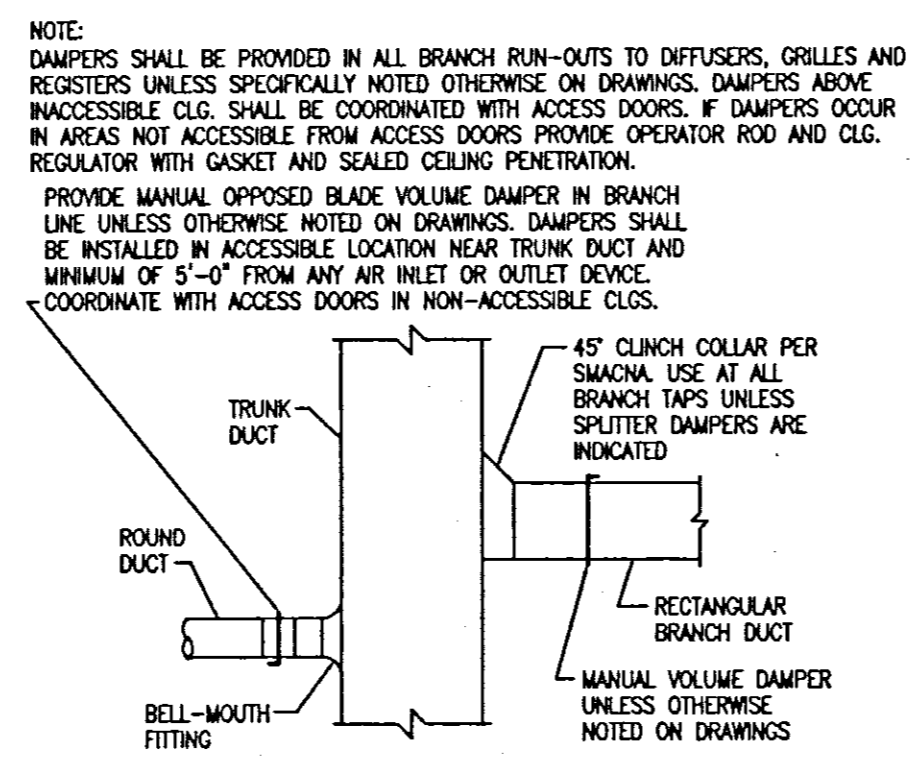


**BRANCH DUCT TAP DETAIL**  
N.T.S.

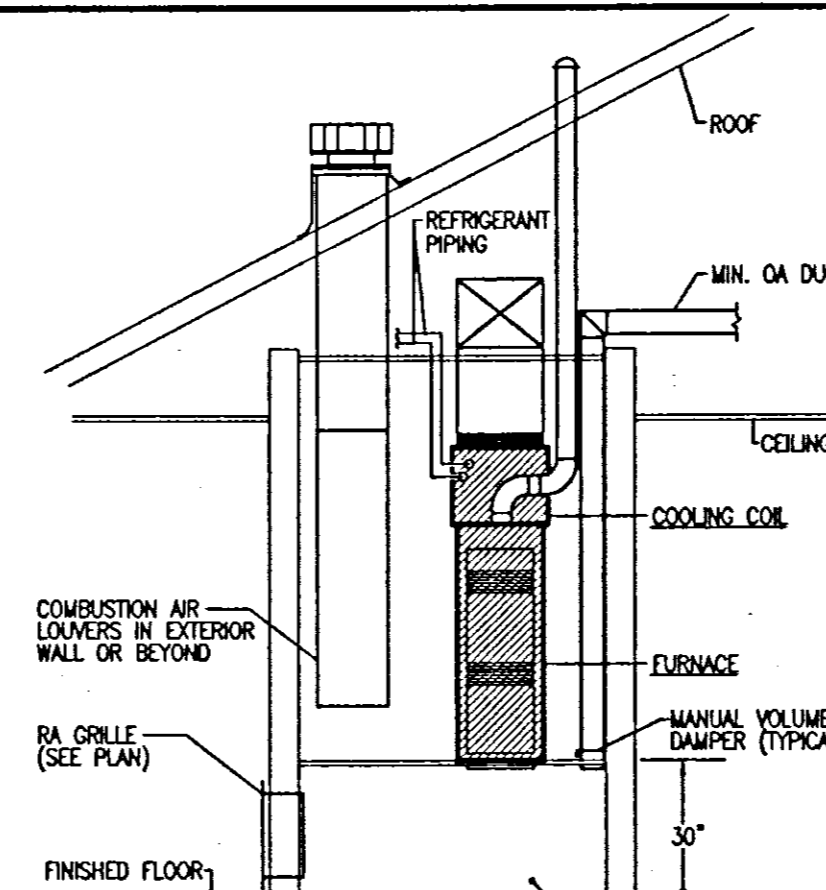


**ELEVATION AT FURNACE**  
N.T.S.

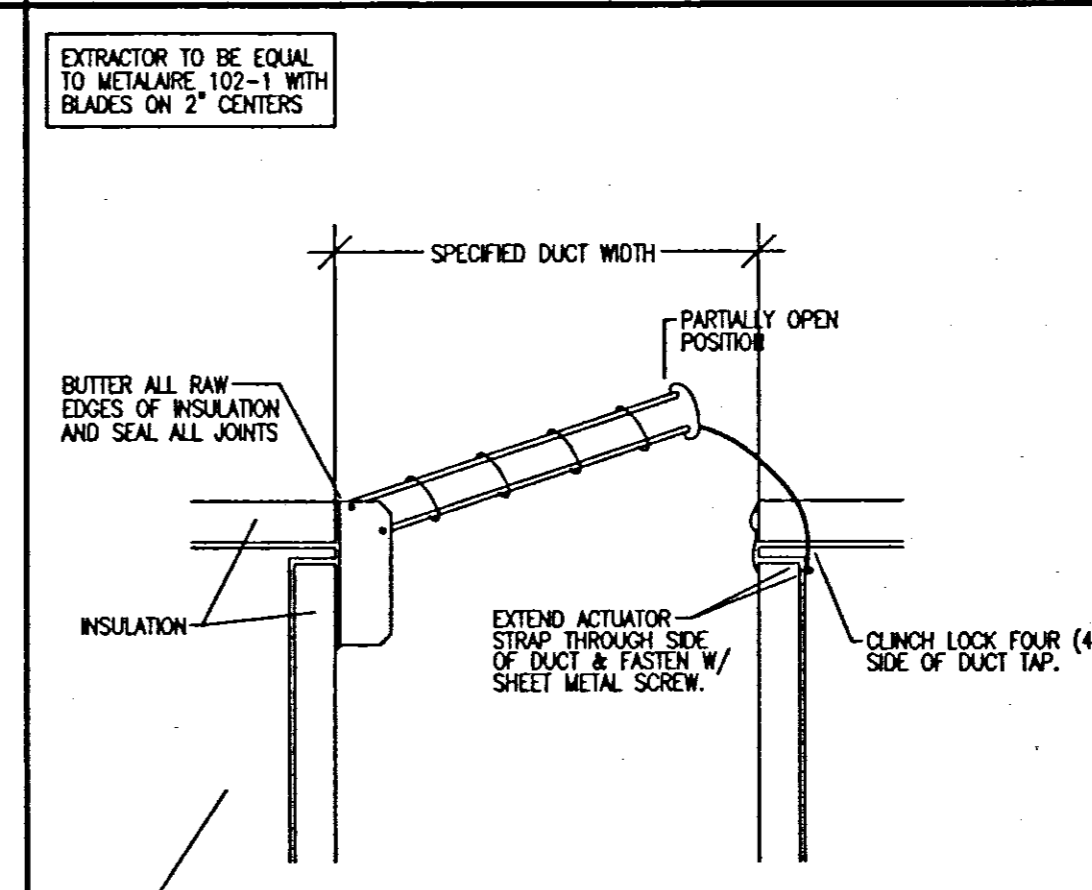


**VOLUME EXTRACTOR**  
N.T.S.

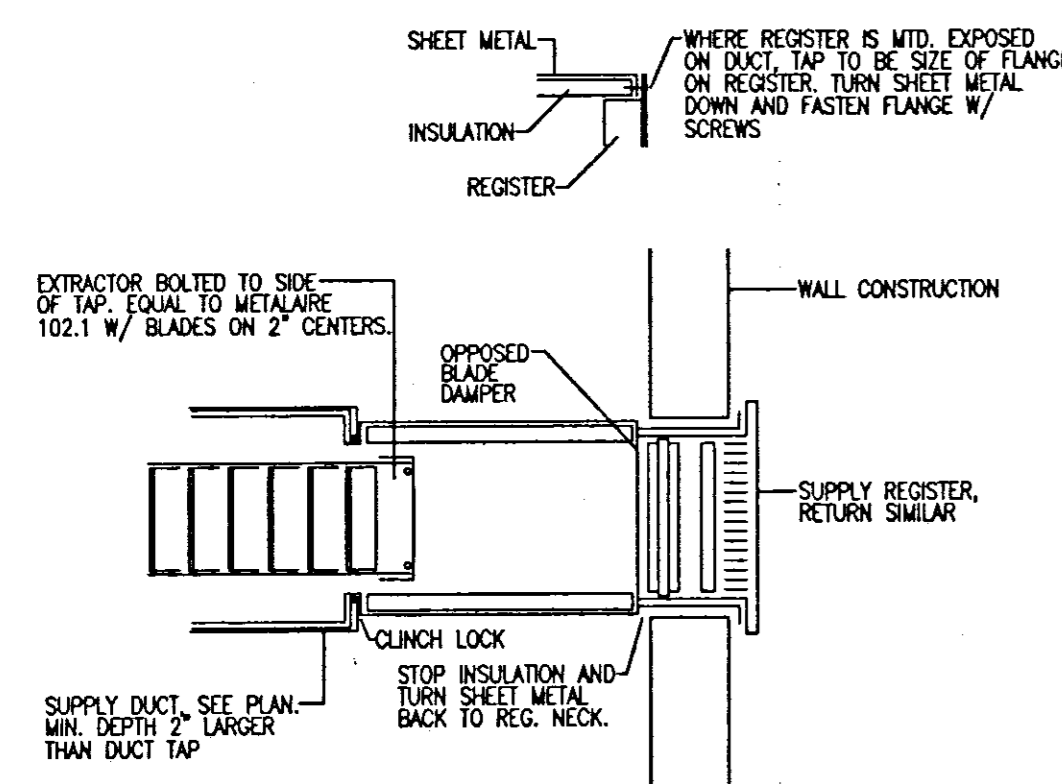


**SIDEWALL REGISTER**  
N.T.S.

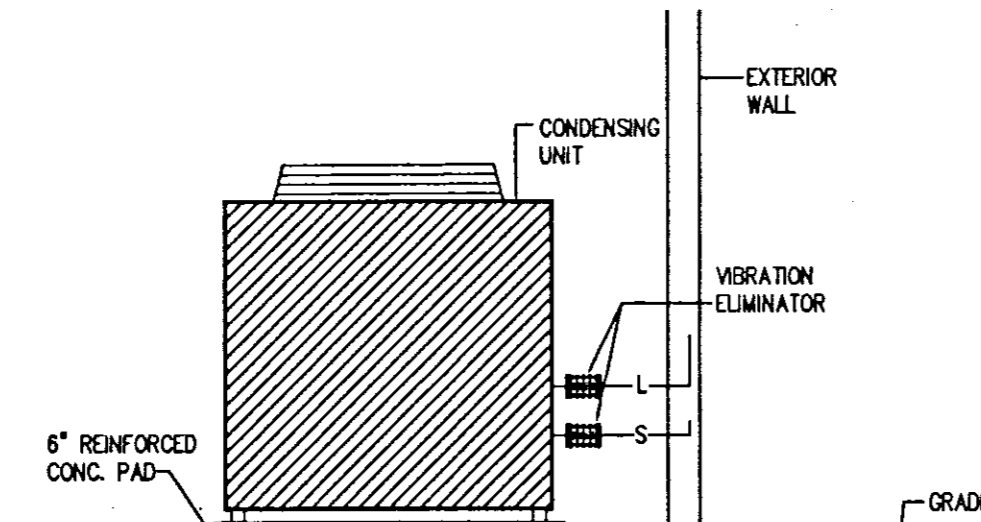


**DETAIL AT CONDENSING UNIT**  
N.T.S.

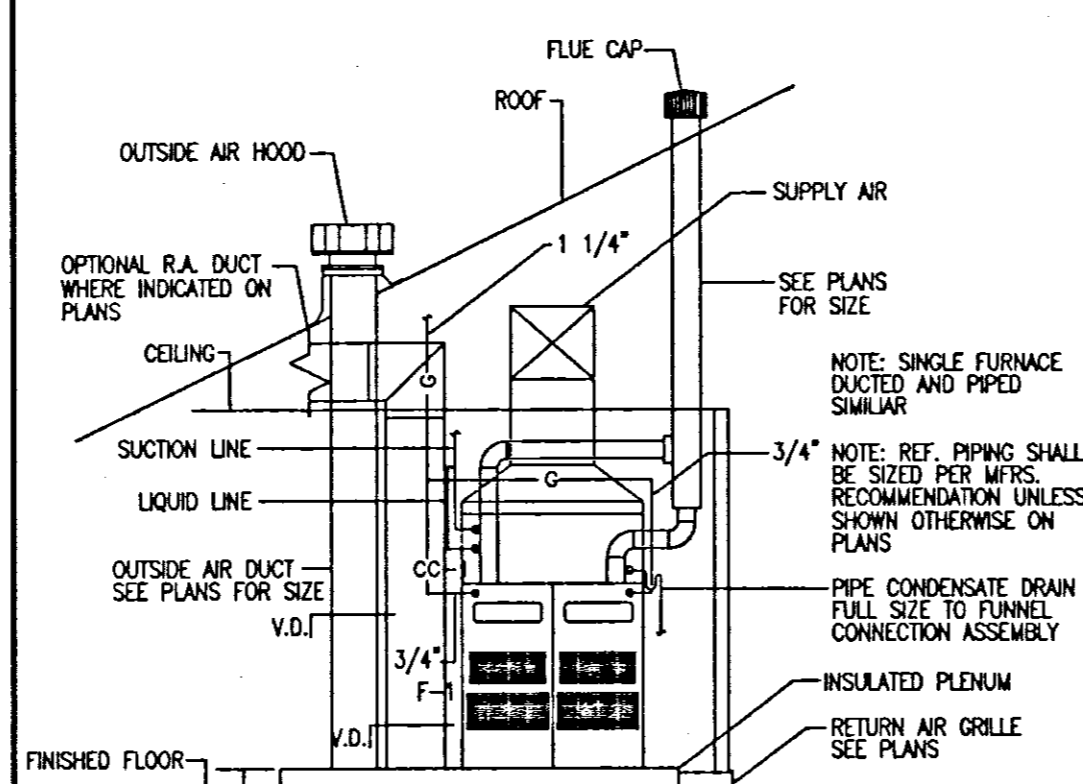


**TYPICAL ELEVATION TWINNING FURNACE**  
N.T.S.

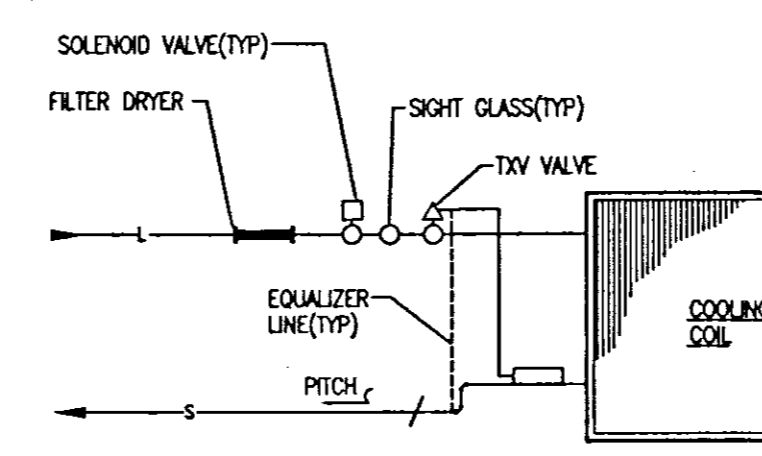


**PIPING AT DX COIL**  
N.T.S.

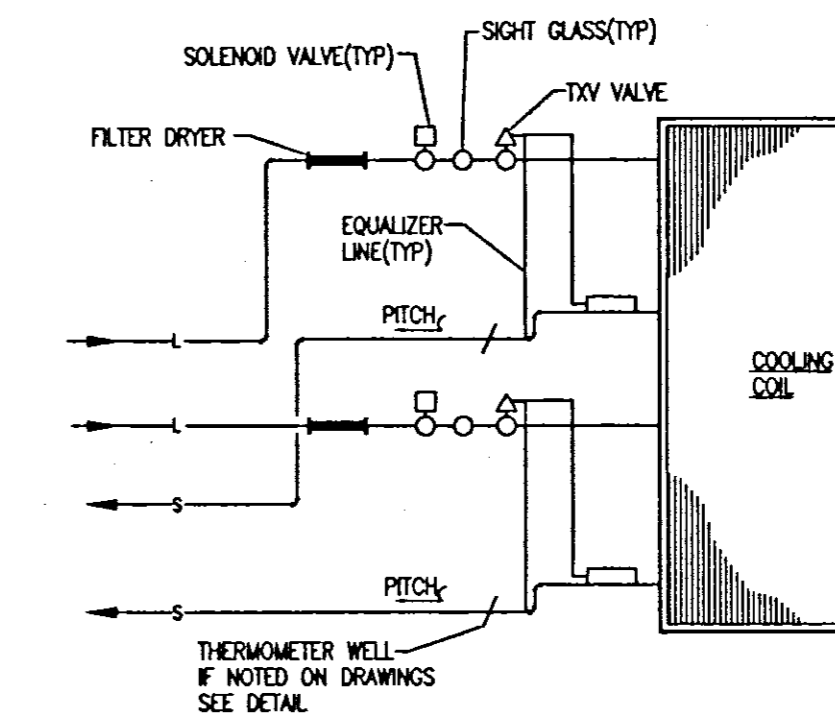


**PIPING AT DX COIL**  
N.T.S.

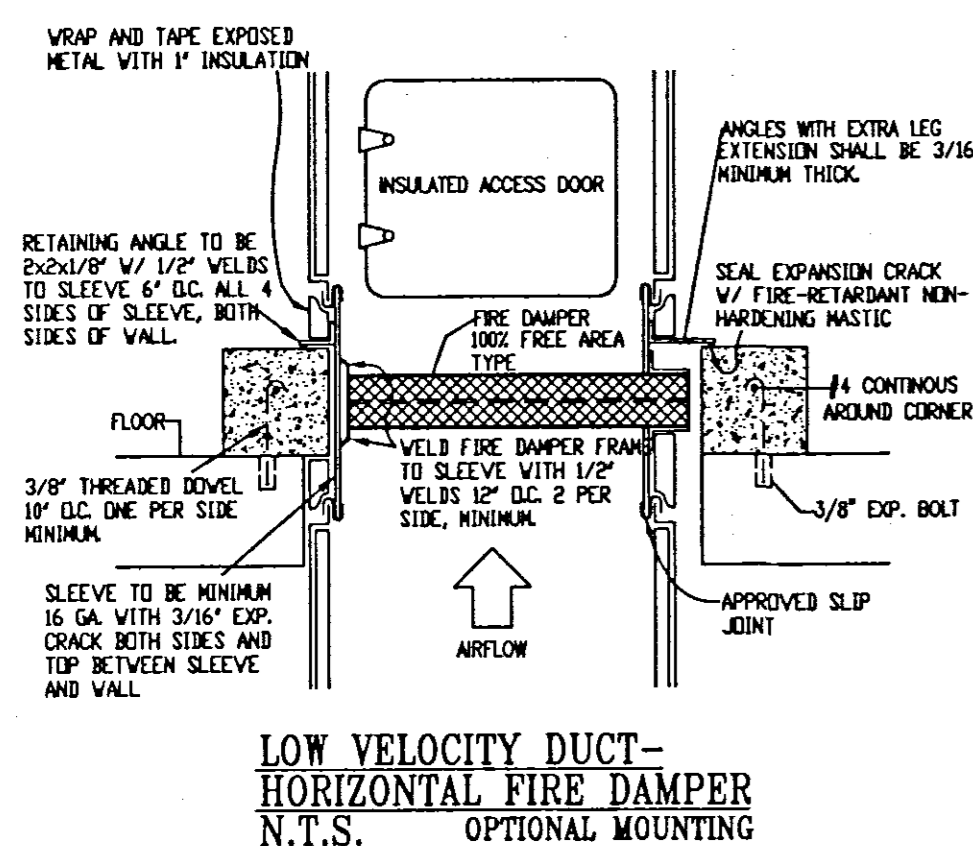

**LOW VELOCITY DUCT-HORIZONTAL FIRE DAMPER**  
N.T.S. OPTIONAL MOUNTING

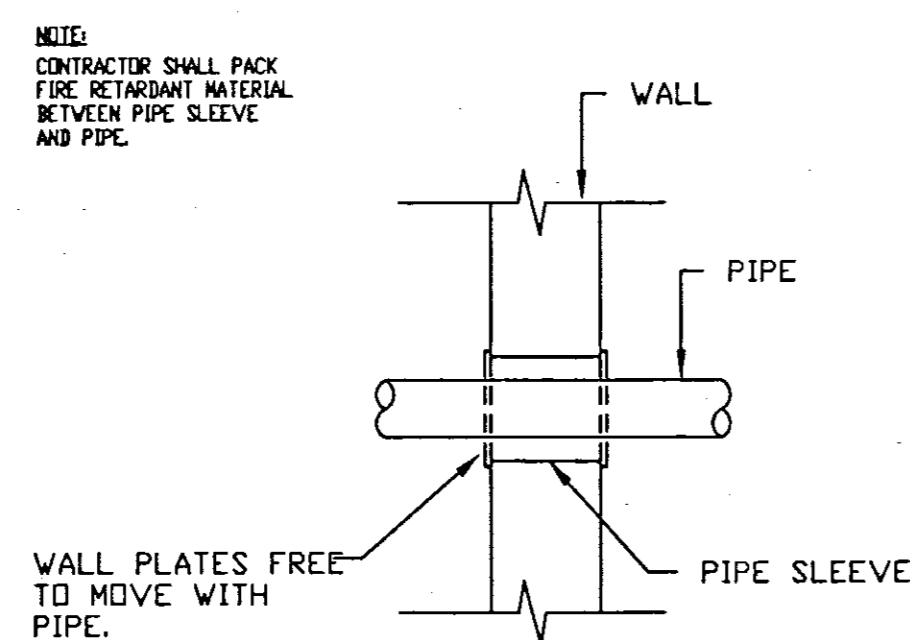

**PIPE SLEEVE DETAIL**  
N.T.S.

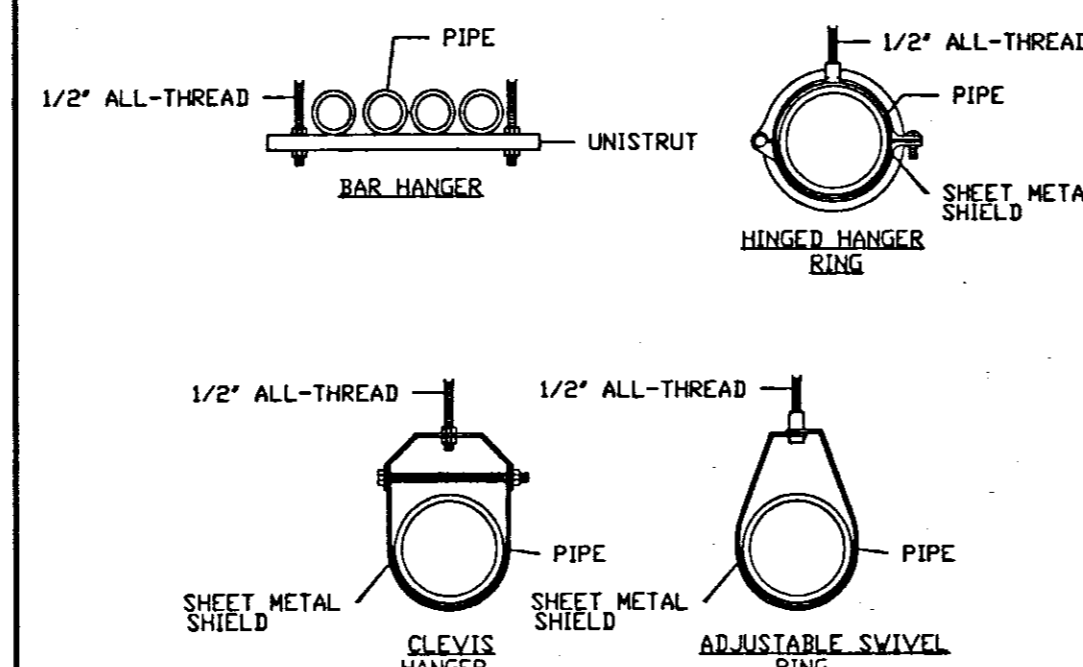

**PIPE HANGER DETAIL**  
N.T.S.

NO.	REVISIONS	DATE

**Scott C. Woods and Associates**

**SCWA**  
Mechanical Engineers

112 Lone Wolf Dr./Madison, Ms 39110  
Ph. (601)859-9864/Fax (601)859-2564/E-mail scweng@aol.com

PROJECT  
**CHURCH OF THE HIGHLANDS**  
NEW BUILDING  
RIDGELAND, MISSISSIPPI

SHEET TITLE  
H.V.A.C. DETAILS

SCALE	PROJECT NO. 01072	SHEET NUMBER
	DATE 07/13/01	<b>M3</b> of 5
	DRAWN TYJ	
	CHECKED GDT	

GAS FURNACE SCHEDULE														
MARK	MAKE	MODEL	TYPE	MBH INPUT	MBH OUTPUT	TOTAL CFM	OA CFM	ESP	MOTOR			TYPE GAS	VENT SIZE	REMARKS
									HP	VOLTS	PHASE			
F-1	GOODMAN	(2)GMP075-4	DOWNFLOW	75.0 EA	60.0 EA	3000	300	.50"	(2)1/2	115	1	NATURAL	4" EA	W/ ELECTRONIC IGNITER
F-2	GOODMAN	GMP100-5	UPFLOW	100.0	80.0	2000	200	.50"	3/4	115	1	NATURAL	4" EA	W/ ELECTRONIC IGNITER
F-3	GOODMAN	(2)GMP075-4	UPFLOW	75.0 EA	60.0 EA	3000	300	.50"	(2)1/2	115	1	NATURAL	4" EA	W/ ELECTRONIC IGNITER
F-4	GOODMAN	(2)GMP100-5	DOWNFLOW	100 EA	80.0 EA	4000	400	.50"	(2)3/4	115	1	NATURAL	4" EA	W/ ELECTRONIC IGNITER
F-5	GOODMAN	GMP100-5	DOWNFLOW	100.0	80.0	2000	200	.50"	3/4	115	1	NATURAL	4" EA	W/ ELECTRONIC IGNITER
F-6	GOODMAN	(2)GMP075-4	UPFLOW	75.0 EA	60.0 EA	3000	300	.50"	(2)1/2	115	1	NATURAL	4" EA	W/ ELECTRONIC IGNITER
F-7	GOODMAN	(2)GMP075-4	UPFLOW	75.0 EA	60.0 EA	3000	300	.50"	(2)1/2	115	1	NATURAL	4" EA	W/ ELECTRONIC IGNITER
F-8	GOODMAN	GMP100-5	DOWNFLOW	100.0	80.0	2000	200	.50"	3/4	115	1	NATURAL	4" EA	W/ ELECTRONIC IGNITER
F-9	GOODMAN	(2)GMP100-5	UPFLOW	100 EA	80.0 EA	4000	400	.50"	(2)3/4	115	1	NATURAL	4" EA	W/ ELECTRONIC IGNITER
F-10	GOODMAN	(2)GMP075-4	DOWNFLOW	75.0 EA	60.0 EA	3000	300	.50"	(2)1/2	115	1	NATURAL	4" EA	W/ ELECTRONIC IGNITER
F-11	GOODMAN	(2)GMP100-5	UPFLOW	100 EA	80.0 EA	4000	400	.50"	(2)3/4	115	1	NATURAL	4" EA	W/ ELECTRONIC IGNITER
F-12	GOODMAN	GMP075-4	DOWNFLOW	75.0	60.0	1600	160	.50"	1/2	115	1	NATURAL	4" EA	W/ ELECTRONIC IGNITER

ELECTRIC FURNACE SCHEDULE										
MARK	MAKE	MODEL	TYPE	TOTAL CFM	OA CFM	ESP	MOTOR			REMARKS
							HP	VOLTS	PHASE	
F-13	GOODMAN	(2)A60	UPFLOW	4000	400	.50"	3/4	115	1	

COOLING COIL SCHEDULE									
LOCATION	MAKE	MODEL	CFM	EA DB	EA WB	TOT MBH	SENS MBH	APD IN WG	REMARKS
CC-1	MAGIC AIRE	VX-7.5	3000	80"	67"	106.0	76.0	.20"	
CC-2	GOODMAN	U-60	2000	80"	67"	55.0	39.6	.20"	
CC-3	MAGIC AIRE	VX-7.5	3000	80"	67"	106.0	76.0	.20"	
CC-4	MAGIC AIRE	VX-10	4000	80"	67"	144.0	103.0	.20"	
CC-5	GOODMAN	U-60	2000	80"	67"	55.0	39.6	.20"	
CC-6	MAGIC AIRE	VX-7.5	3000	80"	67"	106.0	76.0	.20"	
CC-7	MAGIC AIRE	VX-7.5	3000	80"	67"	106.0	76.0	.20"	
CC-8	GOODMAN	U-60	2000	80"	67"	55.0	39.6	.20"	
CC-9	MAGIC AIRE	VX-10	4000	80"	67"	144.0	103.0	.20"	
CC-10	MAGIC AIRE	VX-7.5	3000	80"	67"	106.0	76.0	.20"	
CC-11	MAGIC AIRE	VX-10	4000	80"	67"	144.0	103.0	.20"	
CC-12	GOODMAN	U-49	1600	80"	67"	45.0	34.2	.20"	

BLOWER COIL SCHEDULE																
MARK	MAKE	MODEL	TYPE	FAN AND MOTOR					COOLING			HEATING		REMARKS		
				CFM	O.A.	ESP	H.P.	V	Ø	TMBH	SMBH	SUCTION	KW		VOLTS	Ø
BCU-1	MAGIC AIRE	BMX-240	VERTICAL	7500	1000	1.5"	5	208	3	227.5	175.5	45"	---	---	---	---
BCU-2	MAGIC AIRE	BMX-240	VERTICAL	7000	1100	1.5"	5	208	3	222.0	168.0	45"	---	---	---	---

CONDENSING UNIT SCHEDULE																	
MARK	MAKE	MODEL	TYPE	MBH @ ARI	COMPRESSOR				CONDENSER FANS				MIN. CIRCUIT AMPACITY	MAX FUSE SIZE (AMPS)	REMARKS		
					AMBIENT	NO	VOLTS	PHASE	FLA	NO	HP	VOLTS				PHASE	FLA
CU-1	GOODMAN	CE-90	RECIP	88.0	95"	1	208	3	28.8	2	1/4EA	208	1	1.8 EA	39.6	65	
CU-2	GOODMAN	CE-90	RECIP	88.0	95"	1	208	3	28.8	2	1/4EA	208	1	1.8 EA	39.6	65	
CU-3	GOODMAN	CK-60	RECIP	55.0	95"	1	208	3	15.5	1	1/4	208	1	1.8	21.2	35	
CU-4	GOODMAN	CK-60	RECIP	55.0	95"	1	208	3	15.5	1	1/4	208	1	1.8	21.2	35	
CU-4A	GOODMAN	CK-60	RECIP	55.0	95"	1	208	3	15.5	1	1/4	208	1	1.8	21.2	35	
CU-5	GOODMAN	CK-60	RECIP	55.0	95"	1	208	3	15.5	1	1/4	208	1	1.8	21.2	35	
CU-6	GOODMAN	CE-90	RECIP	88.0	95"	1	208	3	28.8	2	1/4EA	208	1	1.8 EA	39.6	65	
CU-7	GOODMAN	CE-90	RECIP	88.0	95"	1	208	3	28.8	2	1/4EA	208	1	1.8 EA	39.6	65	
CU-8	GOODMAN	CE-120	RECIP	110.0	95"	1	208	3	37.8	2	1/3EA	208	1	2.3 EA	51.9	85	
CU-9	GOODMAN	CE-120	RECIP	110.0	95"	1	208	3	37.8	2	1/3EA	208	1	2.3 EA	51.9	85	
CU-9A	GOODMAN	CE-120	RECIP	110.0	95"	1	208	3	37.8	2	1/3EA	208	1	2.3 EA	51.9	85	
CU-10	GOODMAN	CK-60	RECIP	55.0	95"	1	208	3	15.5	1	1/4	208	1	1.8	21.2	35	
CU-11	GOODMAN	CE-120	RECIP	110.0	95"	1	208	3	37.8	2	1/3EA	208	1	2.3 EA	51.9	85	
CU-12	GOODMAN	CE-90	RECIP	88.0	95"	1	208	3	28.8	2	1/4EA	208	1	1.8 EA	39.6	65	
CU-13	GOODMAN	CE-120	RECIP	110.0	95"	1	208	3	37.8	2	1/3EA	208	1	2.3 EA	51.9	85	
CU-14	GOODMAN	CE-120	RECIP	110.0	95"	1	208	3	37.8	2	1/3EA	208	1	2.3 EA	51.9	85	
CU-14A	GOODMAN	CE-120	RECIP	110.0	95"	1	208	3	37.8	2	1/3EA	208	1	2.3 EA	51.9	85	
CU-15	GOODMAN	CK-49	RECIP	45.0	95"	1	208	3	12.8	1	1/4	208	1	1.8	17.8	30	

Note:  
Smoke duct detector shall be provided as required.

NO.	REVISIONS	DATE

Scott C. Woods and Associates




112 Lone Wolf Dr./Madison, Ms 39110  
Ph. (601)859-9864/Fax (601)859-2564/Email scweng@aol.com

PROJECT  
**CHURCH OF THE THE HIGHLANDS**  
NEW BUILDING  
RIDGELAND, MISSISSIPPI

SHEET TITLE  
H.V.A.C. SCHEDULES

PROJECT NO. 01072	SHEET NUMBER M4
DATE 07/13/01	
DRAWN TYJ	
CHECKED GDT	OF 5

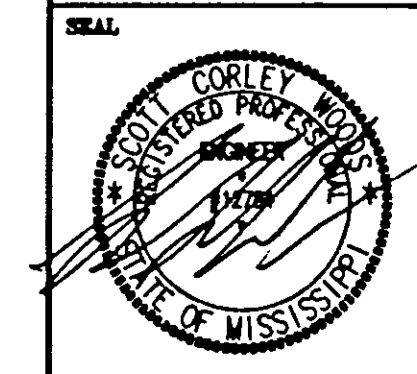

G:\01072\DRAMT\NGS\MECA\01072M4.dwg Wed Jul 18 14:19:20 2001

### GAS FIRED DUCT HEATER SCHEDULE

LOCATION	MAKE	MODEL	TYPE	CFM	SP	INPUT	OUTPUT	VENT SIZE	REMARKS
DF-1	STERLING	QVED400	DUCT MTD.	7500	.50"	400	320	6"	
DF-2	STERLING	QVED400	DUCT MTD.	7000	.425"	400	320	6"	

### FAN SCHEDULE

MARK	MAKE	MODEL	TYPE	CFM	RPM	ESP	WHEEL		DRIVE	SONES	MOTOR			REMARKS
							TYPE	MIN DIA			HP	VOLTS	PHASE	
EF-1	GREENHECK	GB-120	ROOF MOUNTED	800	938	.25"	BI	----	BELT	6.0	1/4	208	3	A, B, C
EF-2	GREENHECK	GB-120	ROOF MOUNTED	800	938	.25"	BI	----	BELT	6.0	1/4	208	3	A, B, C
EF-3	GREENHECK	GB-70	ROOF MOUNTED	200	1247	.25"	BI	----	BELT	6.3	1/6	208	3	A, B, C
EF-4	GREENHECK	SP-7	CEILING MOUNTED	100	950	.125"	FC	----	DIRECT	2.2	1.14 AMP	120	1	
EF-5	GREENHECK	SP-7	CEILING MOUNTED	100	950	.125"	FC	----	DIRECT	2.2	1.14 AMP	120	1	
EF-6	GREENHECK	SP-7	CEILING MOUNTED	100	950	.25"	FC	----	DIRECT	2.3	1.14 AMP	120	1	
EF-7	GREENHECK	SP-7	CEILING MOUNTED	100	950	.25"	FC	----	DIRECT	2.3	1.14 AMP	120	1	

### GRILLE, REGISTER AND DIFFUSER SCHEDULE

MARK	MAKE	MODEL	TYPE	USE			MTG	PANEL SIZE	NECK SIZE	MAX CFM	MAX PD	DAMPER	FINISH	PATTERN	REMARKS
				S	R	E									
A	PRICE	AMD	LOUVER FACE	X			LAY-IN	24x24"	SEE PLAN	SEE PLAN	.07"	OBD	OFF WHITE	SEE PLAN	
B	PRICE	AMD	LOUVER FACE	X			LAY-IN	24x24"	SEE PLAN	SEE PLAN	.07"	OBD	OFF WHITE	SEE PLAN	
C	PRICE	620	DOUBLE DEFLECTION	X			SIDEWALL	MFGR'S STANDARD	SEE PLAN	SEE PLAN	.07"	OBD	ALUM. ENAMEL	FULLY ADJ.	
D	PRICE	AMD	LOUVER FACE	X			SURFACE	MFGR'S STANDARD	SEE PLAN	SEE PLAN	.07"	OBD	OFF WHITE	SEE PLAN	
E	PRICE	630	FIXED BLADE		X		SURFACE	MFGR'S STANDARD	SEE PLAN	SEE PLAN	.05"	----	ALUM. ENAMEL	45° BLADES	
F	PRICE	APDDR	PERF. FACE		X		LAY-IN	24x12"	22x10"	610	.05"	----	OFF WHITE	----	
G	PRICE	APDDR	PERF. FACE		X		LAY-IN	24x24"	22x22"	1350	.05"	----	OFF WHITE	----	
H	PRICE	APDDR	PERF. FACE			X	SURFACE	MFGR'S STANDARD	SEE PLAN	SEE PLAN	.05"	----	OFF WHITE	----	

*Note:  
Duct smoke detectors  
shall be provided as  
required.*

NO.	REVISIONS	DATE

**Scott C. Woods and Associates**




112 Lone Wolf Dr./Madison, Ms 39110  
Ph. (601)859-9864/Fax (601)859-2564/Email scweng@aol.com


**PROJECT**  
**CHURCH OF THE  
THE HIGHLANDS**  
**NEW BUILDING**  
RIDGELAND, MISSISSIPPI

**SHEET TITLE**  
H.V.A.C. SCHEDULES

	PROJECT NO.	01072	<b>M5</b>
	DATE	07/13/01	
	DRAWN	TYJ	
	CHECKED	GDT	
SHEET NUMBER		of 5	

S:\1012\DRAWINGS\MECH\10102HG.dwg Mod Jul 18 14:45:34 2001

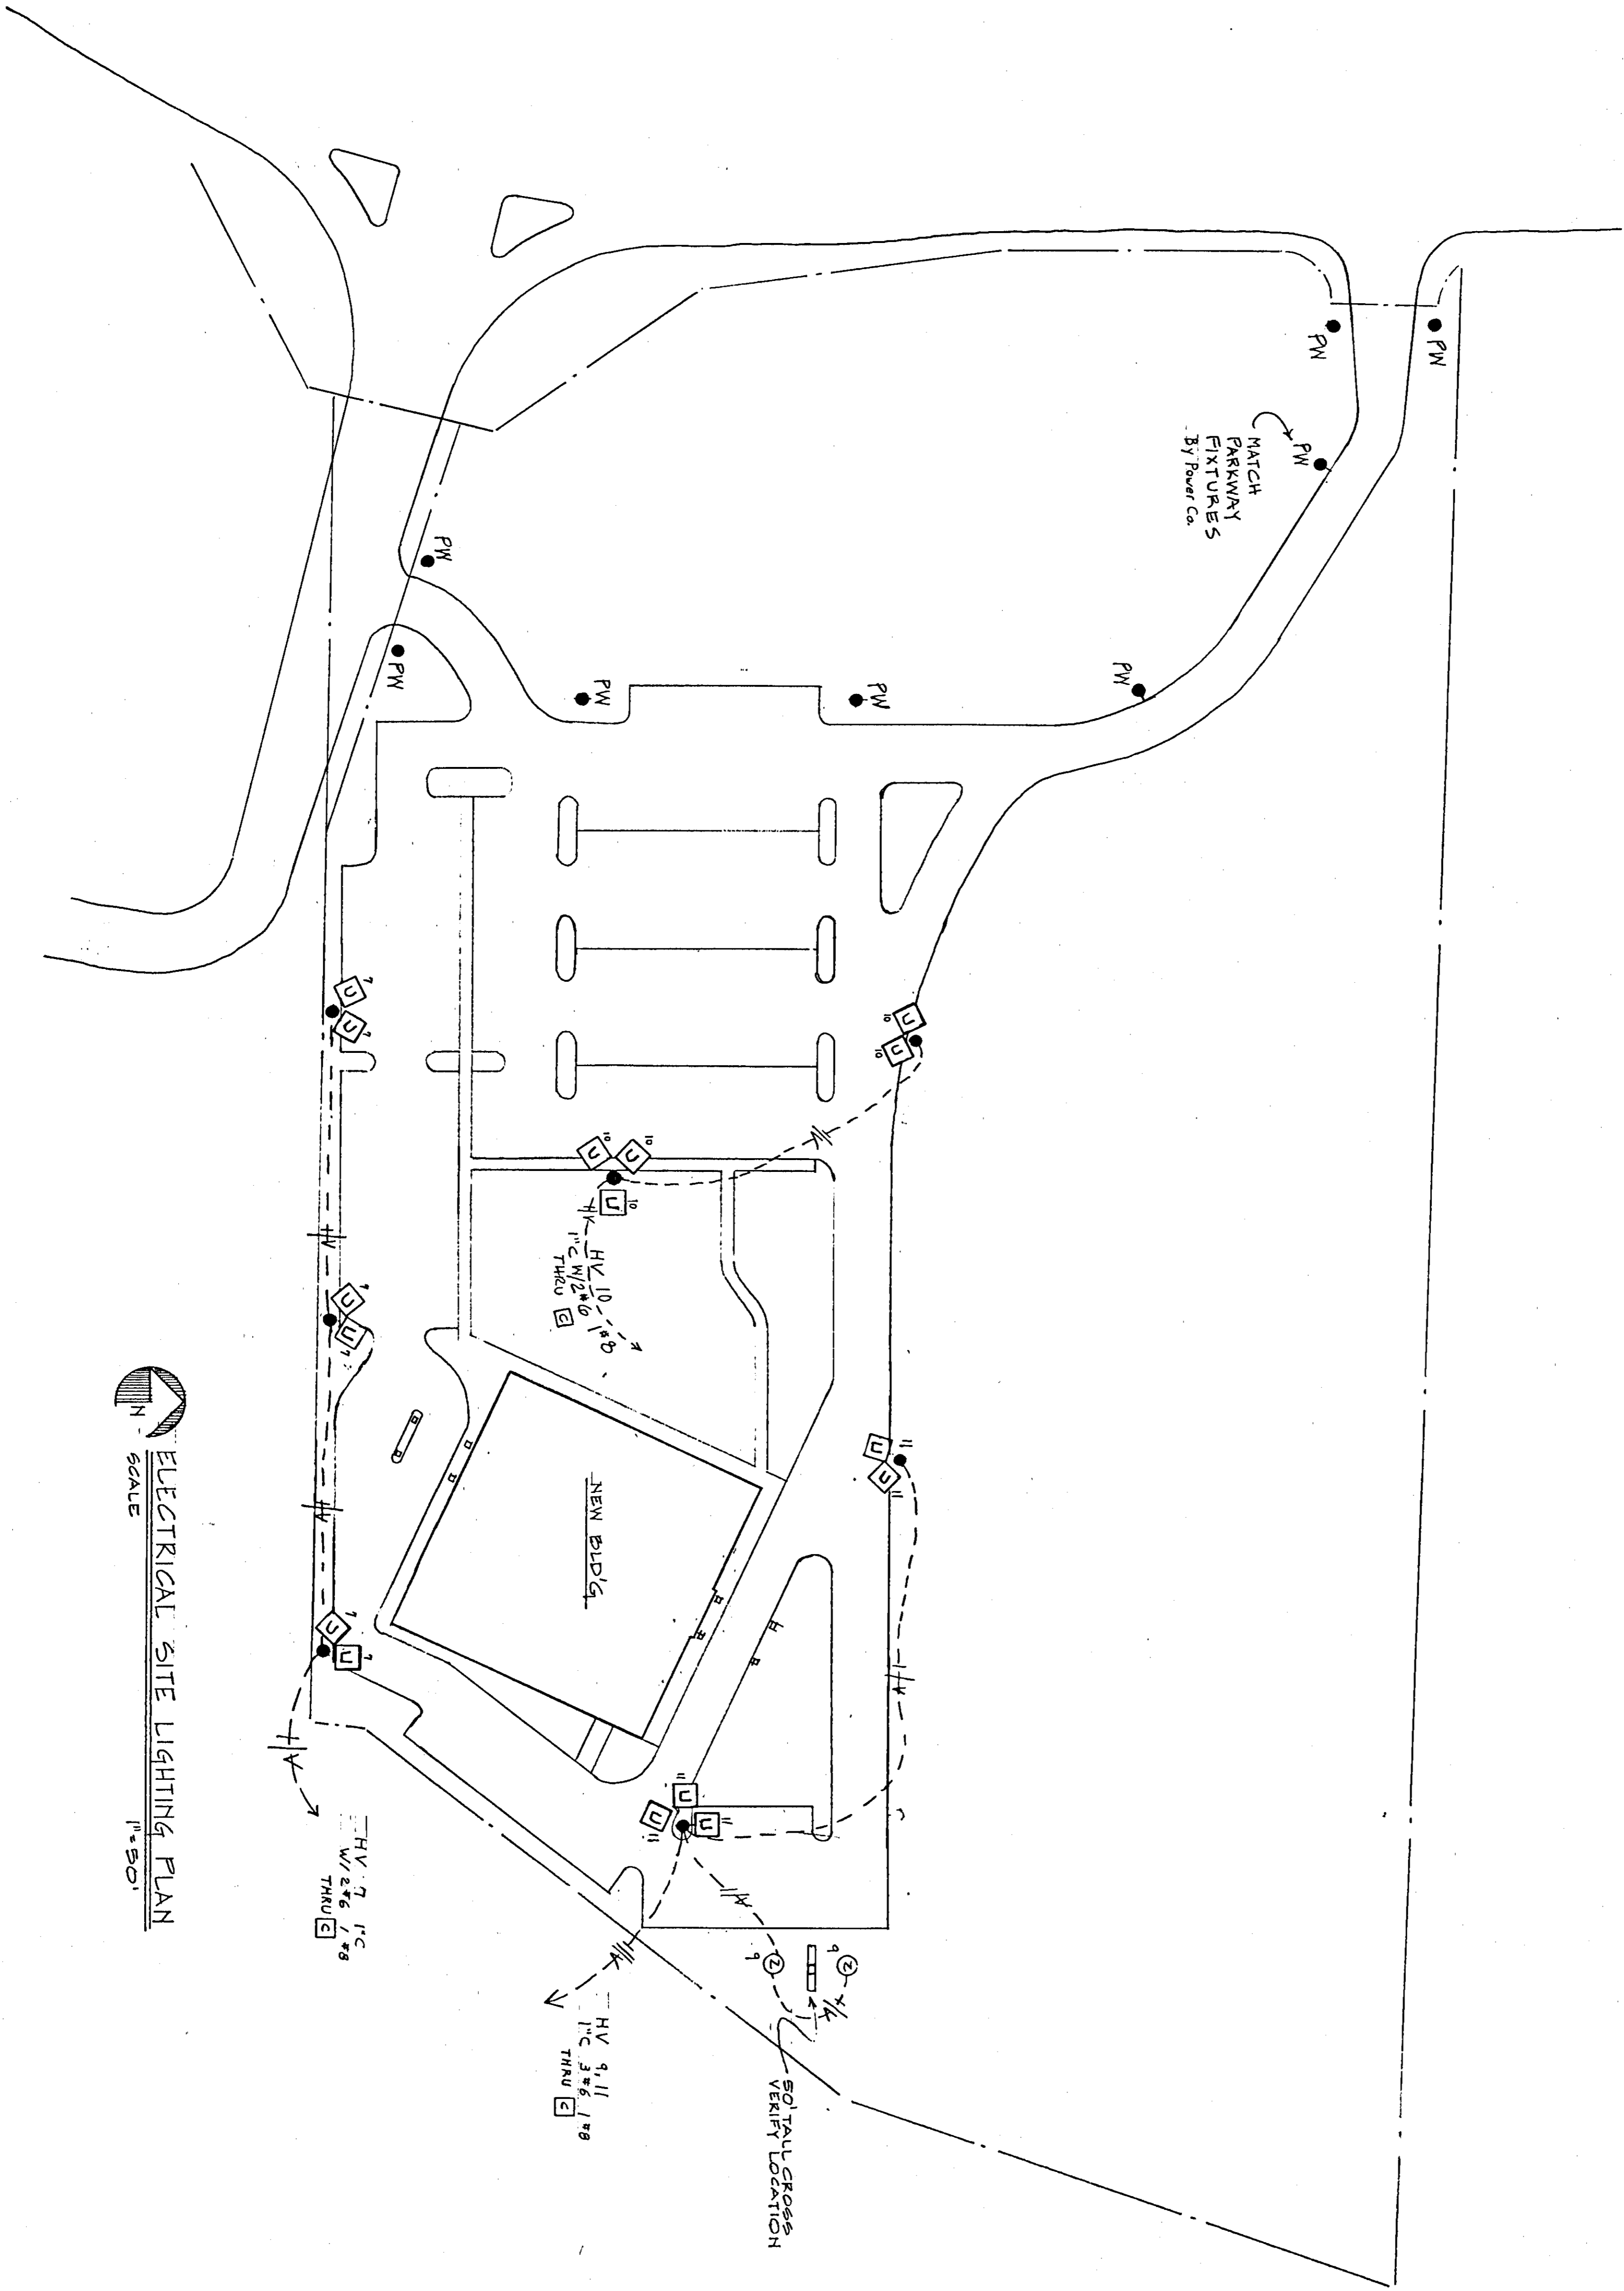

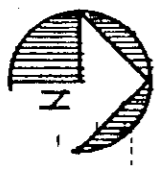
  
 ELECTRICAL SITE LIGHTING PLAN
   
 SCALE 1" = 50'

PROJECT NO:

**A NEW BUILDING FOR  
 CHURCH OF THE HIGHLANDS**

RIDGELAND, MISSISSIPPI

PROJECT NAME: 14011


DATE: 12/1/2001

DESIGN:

DRAWN: *ch*

CHECKED:


REVISED: 31 JUNE 2002

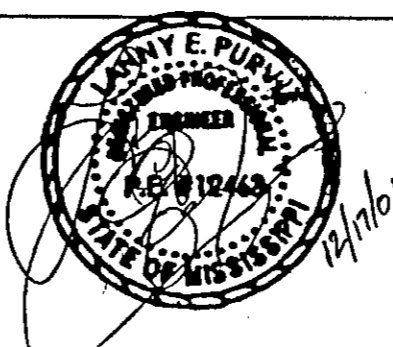

**GULF STATES ELECTRIC**

P.O. BOX 2034, RIDGELAND, MS. 39158  
 601-957-7493



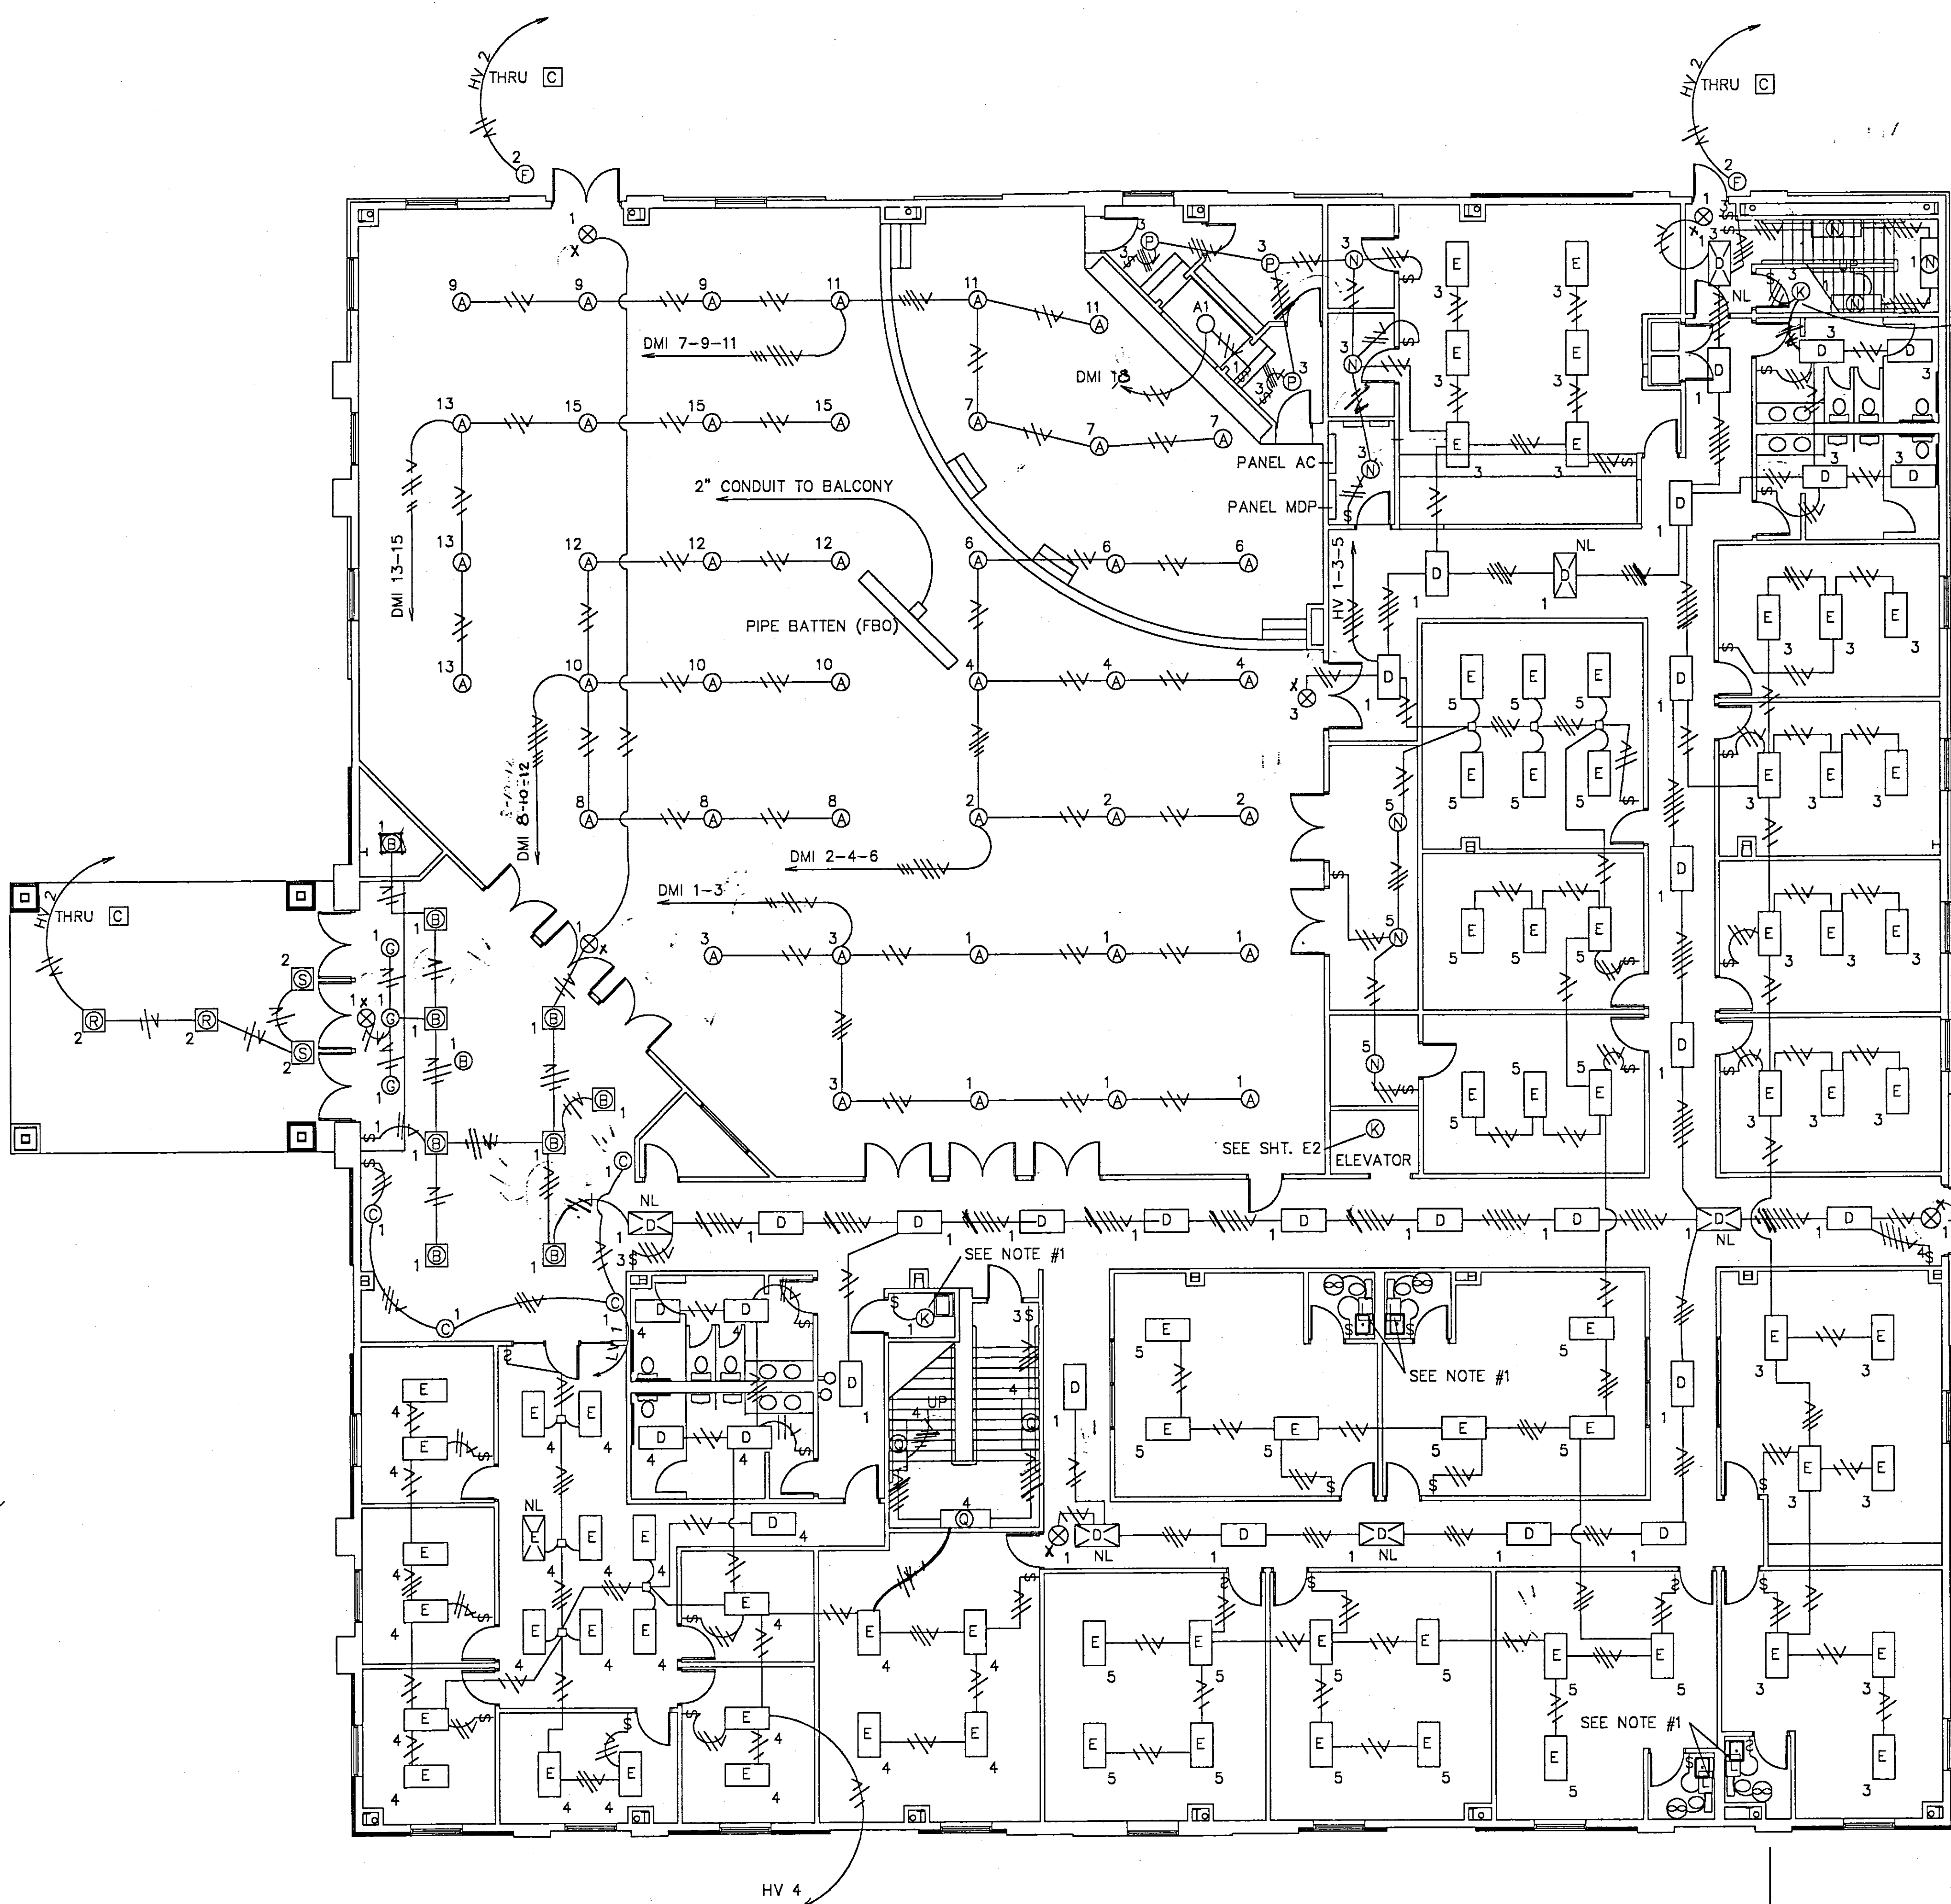

NOTE #1: SEE POWER DRAWING FOR CIRCUITRY


FIXTURE SCHEDULE

SYM	VOLT	LAMP	MFG	CATALOG #	MOUNTING NOTE
A	120	500/EYX	Lithonia	EQ5MBP3	Recess
A1		250/ESM		EQ5MBP2	
B	277	2-CF26TRT		AF26TRT10AR 277GEB	
C	120	1-60A	DM Lighting	4351 Wall Sconce	Wall 60"
D	277	2-F032	Lithonia	2GT8232 A12277GEB PWS1836LP735	Lay in
E		4-F032		2GT8432 A12277GEB PWS1836LP735	
F		1-CF26DD		TWL 26 DTT 277 GEB	Wall 84"
G		1-F032	SPI	EKI 4813-277- WHT (Indirect)	144"
H	120	1-100A/SL	BaseLite	W514 / 49	Cord Pendant 72"
K		1-100A	Canlet	GC1F15G - GSC	Surface/ Ceiling
L		2-F017	Lithonia	WC217 120OEB	
M					
N	277	2-F032	Lithonia	C232 277 GEB SB232 277GEB used in vestibule	Surface
Q				WC232A12 277GEBEL	Wall #1
R		1- M100/U/MED		AH100M 9AR 277	Recess
S		1- M50/U/MED		AH50M 7AR 277	
T		2-F096		L296 T8 277GEB	Surface
U		2-M1000U- 1000 WATT		KVE31000M- SYM 277 SPV12	Pole-35' #2
V		1-M1000U		KVE31000M ASYM 277	#3
W		2-M1000U		KVE31000M ASYM 277	#2
X		LED		LHQMSW1R 120/277 (Combo)	Ceiling


Y		LED		LQMSW3R 120/277 ELN	
Z		1M400/U		TV 400M GP3 277	#4
AA		1-CF/8DD G249-2	Canlet	BFWR18H277- D-GSC	
NOTES:					
1) Battery to be fed with unswitched hot conductor.					
2) Pole - 35' Valmont-DS330-600W350-D2DB					
3) Pole - 35' Valmont-DS330-600W350-D1-DB					
4) Ground Mid - Aim up ± 10°					

1ST FLOOR LIGHTING PLAN  
1/8" = 1'-0"

GULF STATES ELECTRIC  
P.O. BOX 2034, RIDGELAND, MS. 39158  
601-957-7493

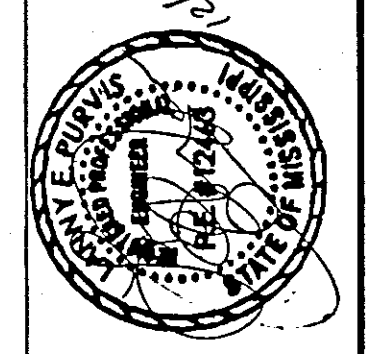

A NEW BUILDING FOR  
CHURCH OF THE HIGHLANDS  
RIDGELAND, MISSISSIPPI  
DATE 11/17/01  
DESIGN  
CHECKED  
REVISED

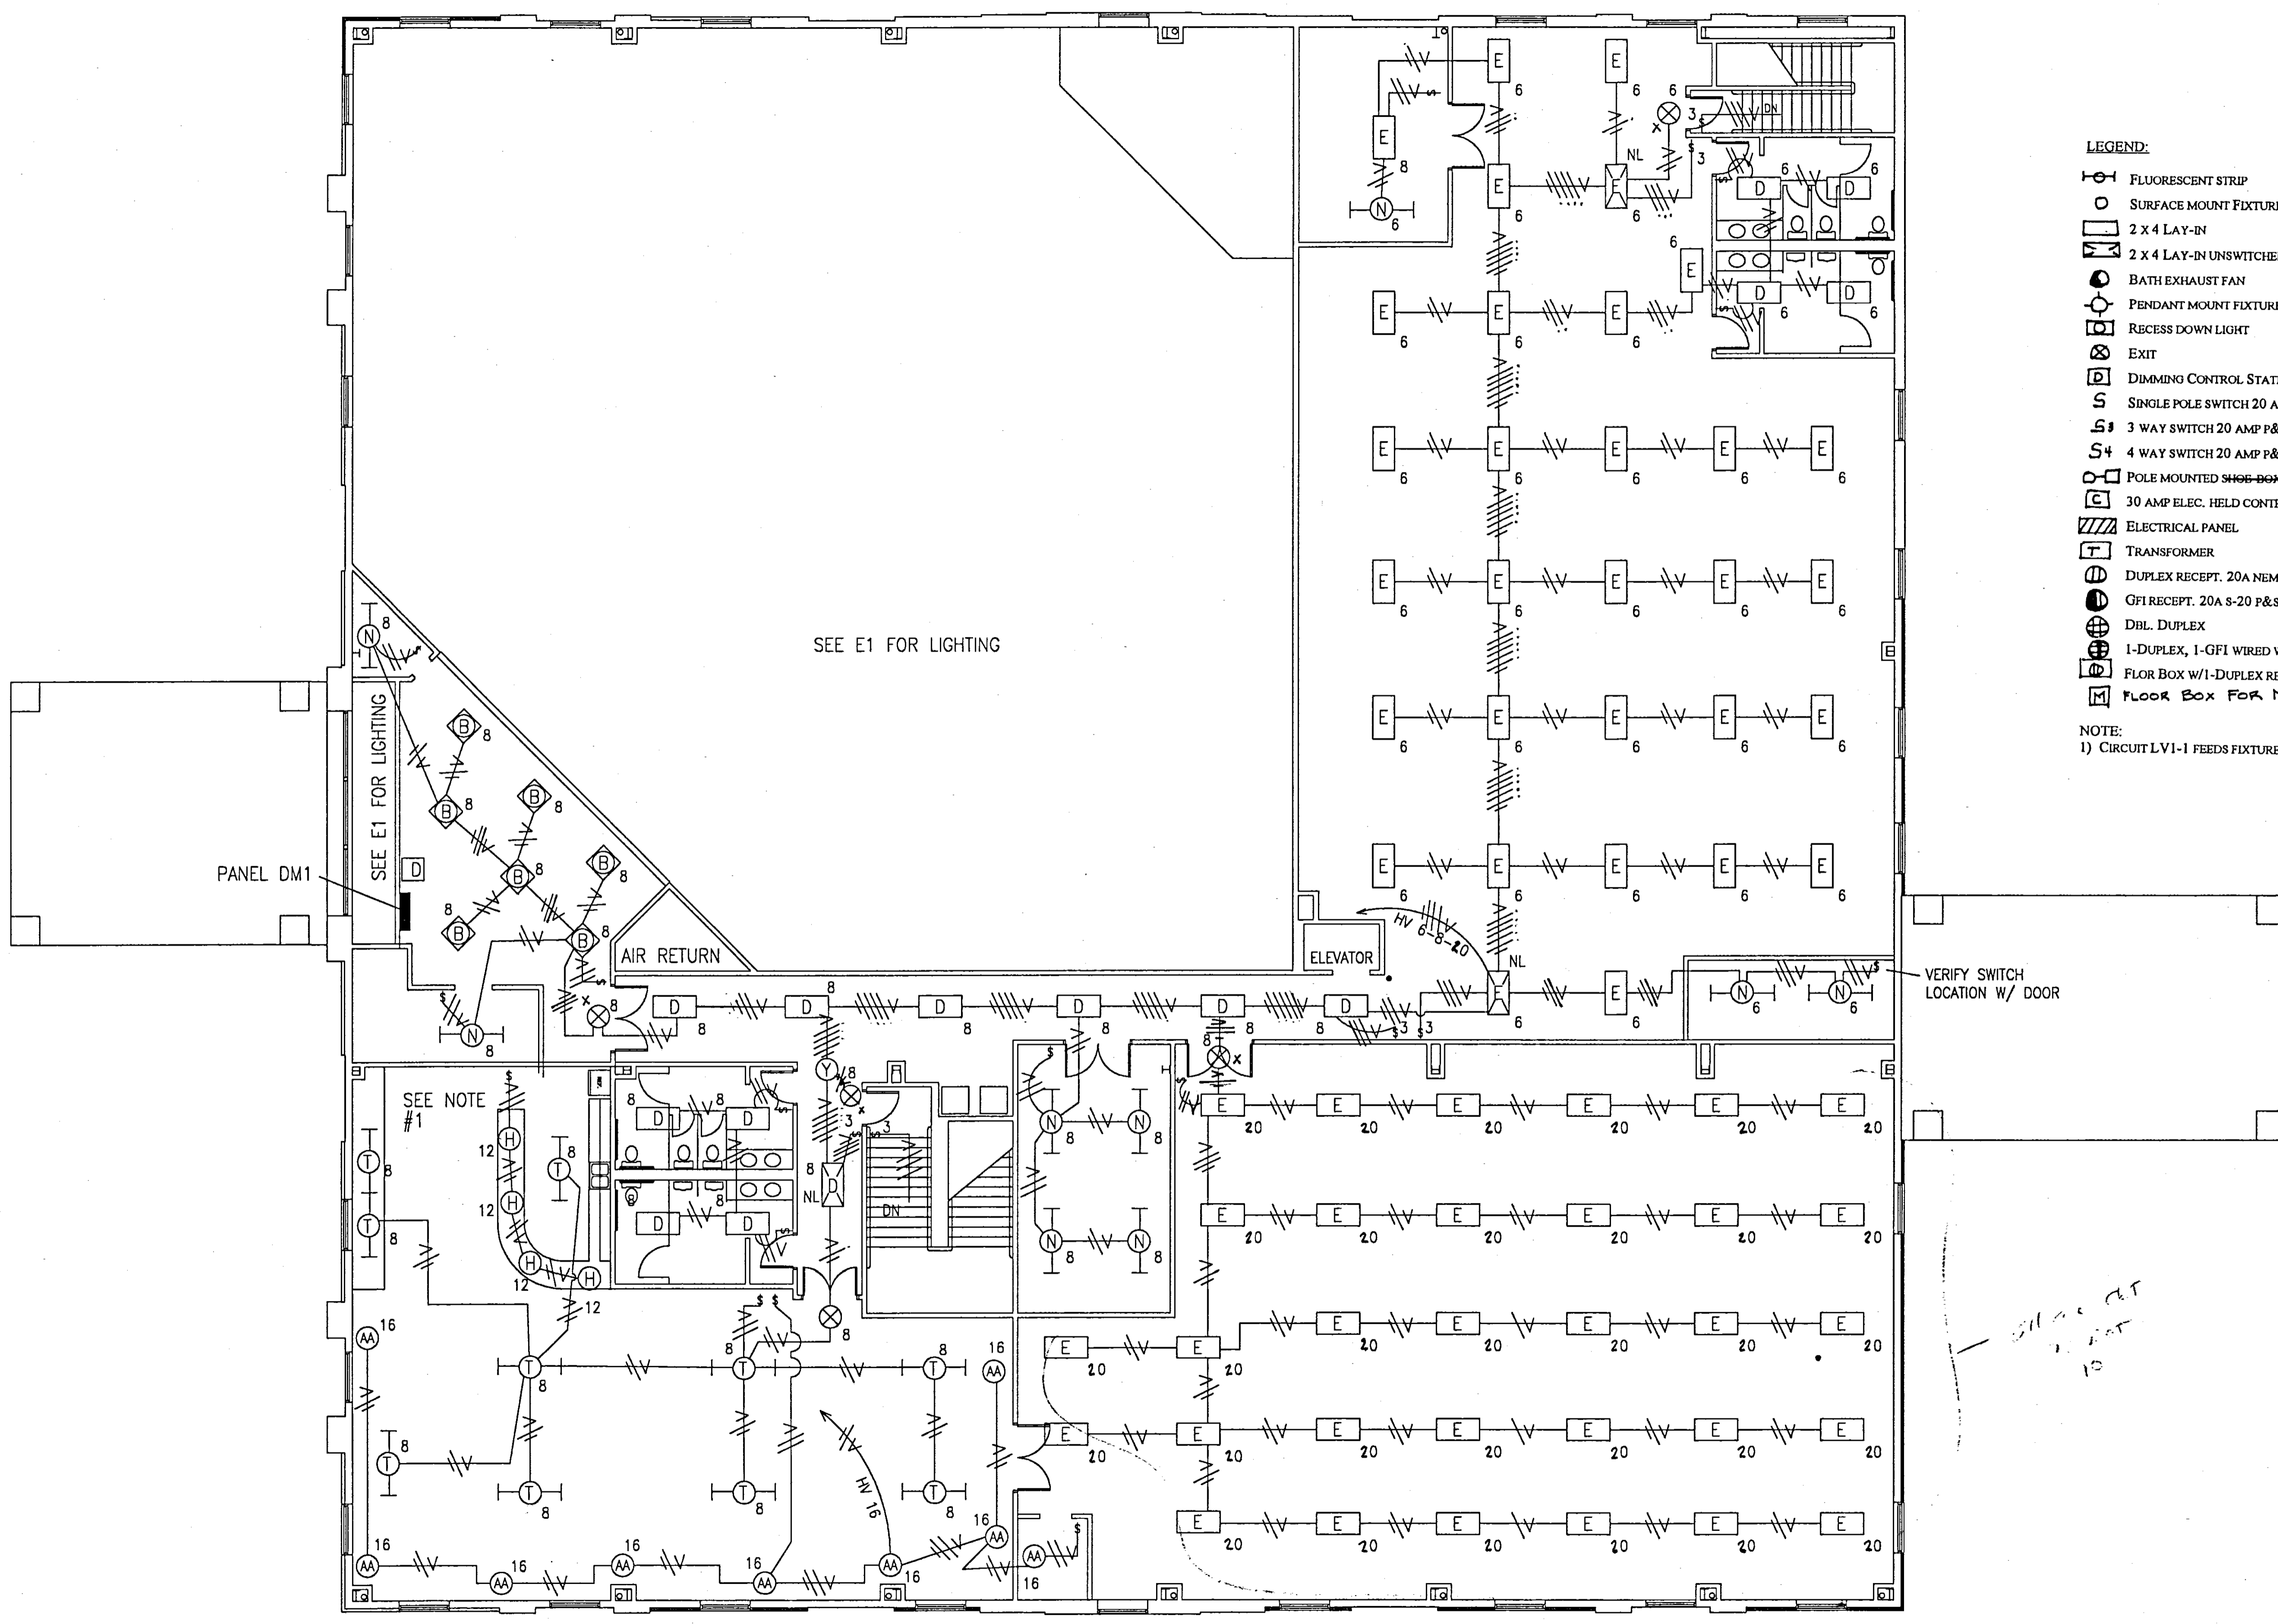


NOTE #1: SEE POWER DRAWING FOR CIRCUITRY

- LEGEND:**
- FLUORESCENT STRIP
  - SURFACE MOUNT FIXTURE
  - 2 X 4 LAY-IN
  - 2 X 4 LAY-IN UNSWITCHED (NIGHT LIGHT)
  - BATH EXHAUST FAN
  - PENDANT MOUNT FIXTURE
  - RECESS DOWN LIGHT
  - EXIT
  - DIMMING CONTROL STATION
  - SINGLE POLE SWITCH 20 AMP P7S CS1201
  - 3 WAY SWITCH 20 AMP P&S CS3201
  - 4 WAY SWITCH 20 AMP P&S CS4201
  - POLE MOUNTED ~~SHOE BOX FIXTURE~~ FLOOD LIGHT
  - 30 AMP ELEC. HELD CONTRACTOR
  - ELECTRICAL PANEL
  - TRANSFORMER
  - DUPLEX RECEPT. 20A NEMA S-20 P&S CR201
  - GFI RECEPT. 20A S-20 P&S 20911
  - DBL. DUPLEX
  - 1-DUPLEX, 1-GFI WIRED W/DUPLEX ON LOAD SIDE OF GFI
  - FLOR BOX W/1-DUPLEX RECEPT. 641 & P64CPDU
  - FLOOR BOX FOR MICROPHONE
- NOTE:**
- 1) CIRCUIT LV1-1 FEEDS FIXTURE "C" IN LOBBY AREA ALSO.

2 | 2 2ND FLOOR LIGHTING PLAN  
1/8" = 1'-0"

**GULF STATES ELECTRIC**  
P.O. BOX 2034, RIDGELAND, MS. 39158  
601-957-7493

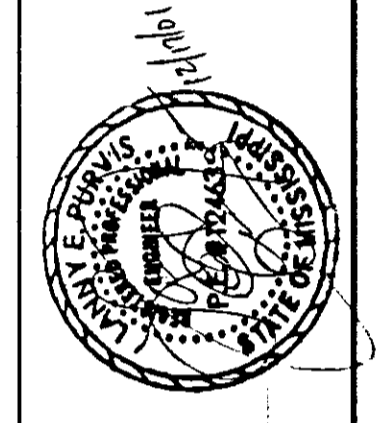


**A NEW BUILDING FOR  
CHURCH OF THE HIGHLANDS**  
RIDGELAND, MISSISSIPPI

PROJECT NO. \_\_\_\_\_  
PROJECT NAME: MUDS \_\_\_\_\_  
DATE: 12/1/98 \_\_\_\_\_  
DESIGN: \_\_\_\_\_  
CHECKED: \_\_\_\_\_  
REVISED: \_\_\_\_\_

3  
E-3  
6



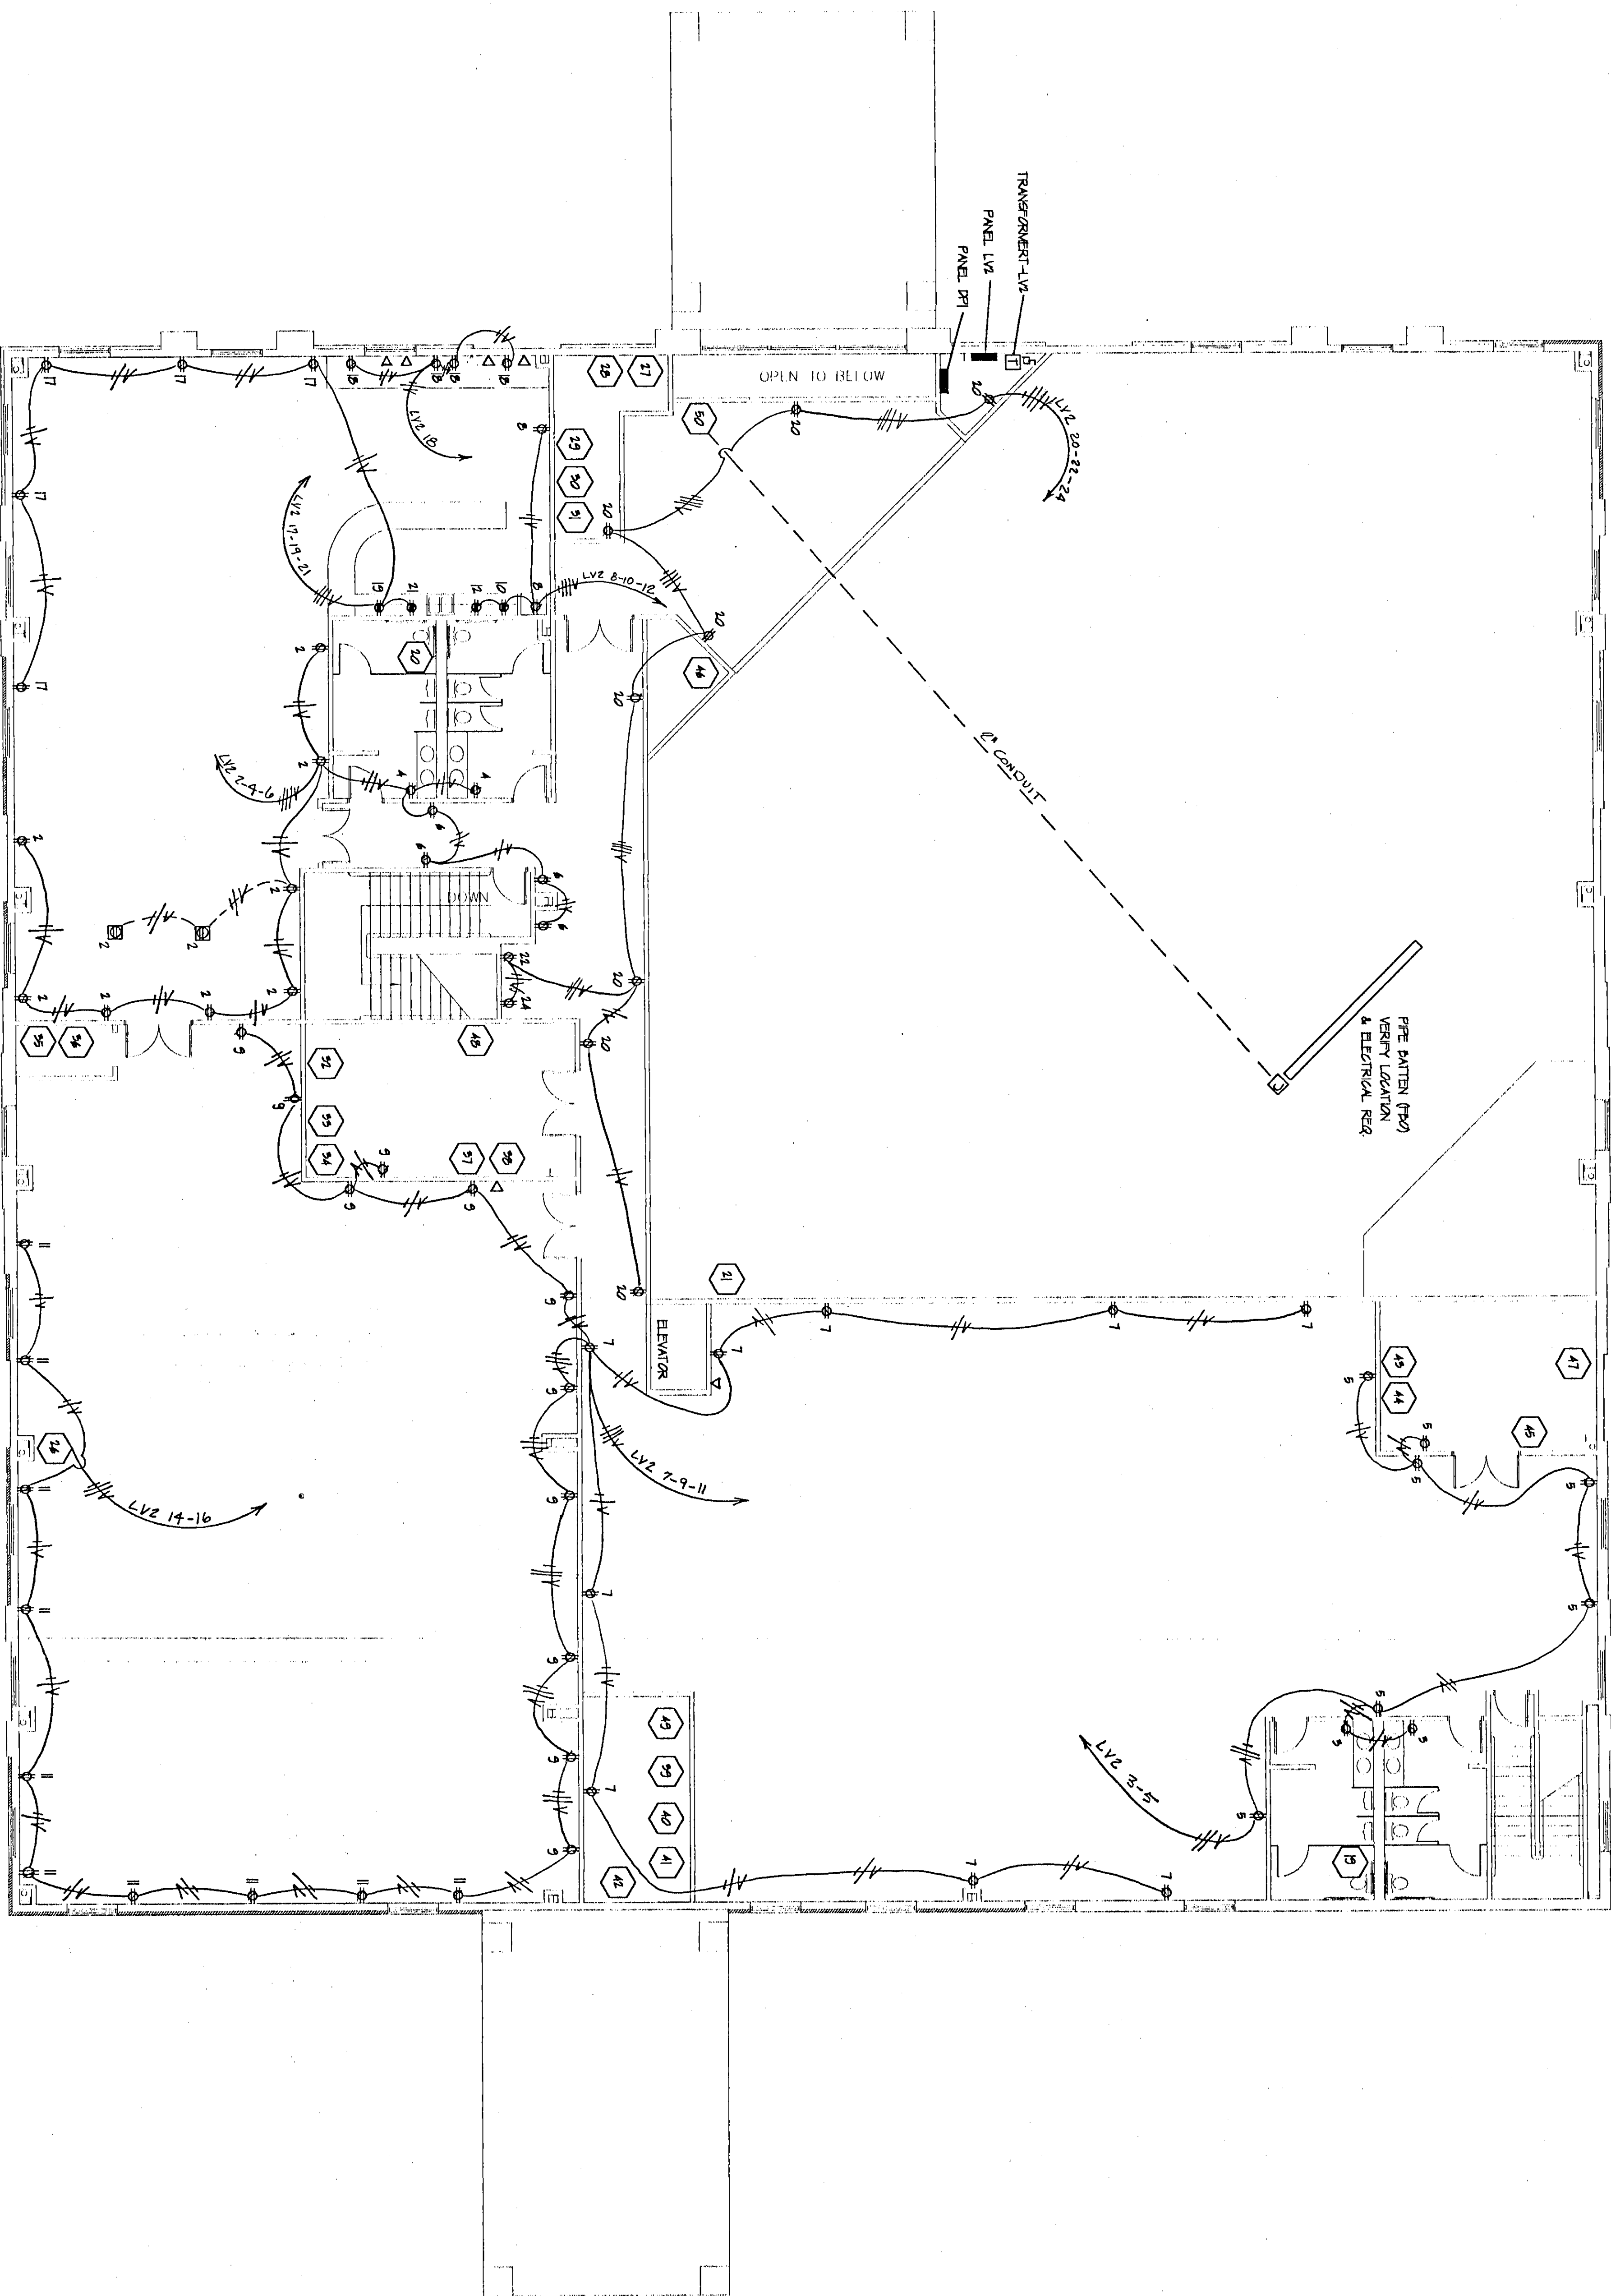

2ND FLOOR POWER & COMMUNICATION PLAN  
1/5 = 1'-0"

PROJECT NO:

**A NEW BUILDING FOR  
CHURCH OF THE HIGHLANDS**  
RIDGELAND, MISSISSIPPI

PROJECT NAME: Initial


DATE: 12/1/2001

DESIGN:

DRAWN: all

CHECKED:

REVISED:

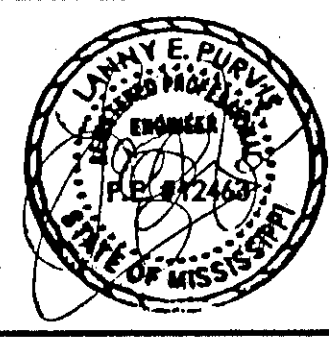

**GULF STATES ELECTRIC**

P.O. BOX 2034, RIDGELAND, MS. 39158  
601-957-7493



POWER CONNECTION SCHEDULE

Mark	Descr.	Feeder	Volts	Phase	FLA	Conduit	Wire	Disconnect	Remarks
1	CU1	AC1	480	3	14	1/2	#10	30A/3P	Nema 3R
2	CU2	AC2							
3	CU3	AC3			7.5		#14		
4	CU4	AC4							
5	CU4A	AC5							
6	CU5	AC6							
7	CU6	AC7			14		#10		
8	CU7	AC8							
9	CU8	AC9			18.3	3/4	3#8 & #10	60A/3P	
10	CU9	AC10							
11	CU9A	AC11							
12	CU10	AC12			7.5	1/2	#14	30A/3P	
13	CU11	AC13			18.3	3/4	3#8 & #10	60A/3P	
14	CU12	AC14			14	1/2	#10	30A/3P	
15	CU13	AC15			18.3	3/4	3#8 & #10	60A/3P	
16	CU14	AC16							
17	CU14A	AC17							
18	CU15	AC18			7.5	1/2	#14	30A/3P	
19	EF1	LV2	208		1.2				
20	EF1	LV2	208						
21	EF3	LV2	208		.90				
22	EF4	LV1	110	1	1.14		3#12	Switch	Switch w/L fixture
23	EF5	LV1	110						
24	EF6	LV1	110						
25	EF7	LV1	110						
26	Stage Conn.	LV2	208					Receptacle	Nema 5-20R
27	F1	LV2	120	1	9.8	1/2	3#12		5-20R
28	F1	LV2							
29	F2	LV2			13.0				
30	F3	LV2			9.8				
31		LV2							
32	F4	LV2			13.0				
33		LV2							
34	F5	LV2							
35	F6	LV2			9.8				
36		LV2							
37	F7	LV2							
38		LV2							
39	F9	LV2			13.0				
40		LV2							
41	F10	LV2			9.8				
42		LV2							
43	F11	LV2			13.0				
44		LV2							
45	F12	LV2			9.8				
46	F13	LV2			13.0				
47	BCU1	HV	480	3	7.6		#12	30A/3P	Nema 1
48	BCU2	HV							
49	F8	LV2	120	1	13.0				5-20R RECEPTACLE
50	Stage control	LV2	208	1	20	1/2	3#6, 1#8	60A/2P	Fused
51	Elevator	MSB	480	3	21	1/2	3#6, 1#8	60A/3P	@ 40A
52	Elevator Cab Lights	LV1	120	1	3.3	1/2	3#12		
53	Washer	LV1			4			Recept.	
54	Dryer	LV1	208		22	3/4	#10	Recept.	
55	Steam bar	LV1			12			30A/2P	
56	Steam bar	LV1			12				
57	Steam bar	LV1			12				
58	Range	LV1			20		3#10, 1#12	Recept.	

PANEL HV NOTE: PROVIDE 3 SPARE 1/2" C TO ACCESS CEILING  
 125 AMP / MLO / 277-480V / 3Ø / 4W / 14 KAIC  
 BOTTOM FEED / SURFACE MOUNT / LOCATION: 1<sup>ST</sup> FLOOR ELECT. ROOM

#	AMP	POLE	DESCRIPTION	AØ	BØ	CØ	DESCRIPTION	POLE	AMP	#
1	20A	1	HALLWAYS 1 <sup>ST</sup> FLOOR	3496			CANOPY LIGHTS	1	20	2
3			SOUTH ROOMS LIGHTS	3628	3096		NORTH & WEST LIGHTS			4
5			SOUTH & WEST LIGHTS		3628	3989	2 <sup>ND</sup> FLOOR AWANA			6
7	30		PARKING LOT S-SE	4432			2 <sup>ND</sup> FLOOR HALL BALCONY			8
9			PARKING LOT SOUTH	4432	4432		PARKING LOT WEST		30	10
11			PARKING - NW ENTRANCE		4432	4432	PARKING LOT WEST			12
13	15	3	BCU - 1	2105		5374	PARKING LOT NORTH			14
15				2105		192	AA FIXT. IN YOUTH			16
17				2105			CROSS LIGHTS			18
19	15	3	BCU - 2	2105			SEE #2 NOTE 1	1	20	20
21				2105			SPARE			22
23						2105				24
25										26
27										28
29										30
				21870	19990	20691				

TOTAL 62551 + 831 = 75,382 AMPS

PANEL AC TOP 400 AMPS / MLO / 480 / 3Ø / 3W  
 FEED / SURFACE / A/C 25,000

CIRC DESCRIP. AMP POLE A B C POLE AMP DESCRIP CIRC

#	AMP	POLE	DESCRIPTION	AØ	BØ	CØ	DESCRIPTION	POLE	AMP	#	
1	CU1	30	3	3878				3	30	CU2	2
3	CU3	15		2078				15		CU4	4
5	CU4			2078						CU5	6
7	CU6	30		3878				30		CU7	8
9	CU8	40		5070				40		CU9	10
11	CU9A			5070						CU10	12
13	CU11			5078						CU12	14
15	CU13			5070						CU14	16
17	CU124A			5070						CU15	18
				67348	67348	67348					

202044 + 831

LV1 225 AMP / MCB / THRU FEED LUGS / 208Y-120 / 3Ø 4W  
 FLUSHMOUNT / BOTTOM FEED / A/C 10,000  
 (2 SECTION)

CIRC DESCRIP. AMP POLE A B C POLE AMP DESCRIP. CIRC.

#	AMP	POLE	DESCRIPTION	AØ	BØ	CØ	DESCRIPTION	POLE	AMP	#	
1	Lobby Light & C.O.	20	1	960				1	20	103, 104 Recept	2
3	Lobby C.O.			1620						107 Recept	4
5	102 Recept.			340						108 Water Cooler	6
7	105 Recept.			1440						108 Recept.	8
9	105, 106 Recept.			1620						Outdoor Recept	8
11	107 Recept.			800						Elevator Cab lite	10*
13	Dryer	30	2	2200						Range	12
15				2520							14
17	Steam Bar	20	2	2200						Steam Bar	16
19				1250						Steam Bar	20
21	113 Hall C.O.	20	1	1620							22
23	116 Recept.			1250							24
25	117 Recept.			1620						125 Recept. & Bath	26
27	118 Recept.			1620						127 Recept. & Bath	28
29	120 Recept.			1620						129, 131 Recept.	30
31	132 Recept.			1620						134, 135, Recept.	32
33	143 Coffee			1200						136, 137, GFI Recept.	34
35	143 Coffee			1620						133, 147 Recept.	36
37	143 Refrig & Freezer			1200						141, 146, 142	38
39	143 Clothes Washer			500						150-154 Recept.	40
41	143 Spare Space			500						143 C.O. Space	42
43				1080							44
45											46
47											48
				20440	17420	20160					
				58020	+ 360	= 161,140					

\* Non-Pad Lockable Lock On

PANEL MDP 800 AMP / MLO / 277-480V / 3Ø / 4W / 35 KAIC  
 BOTTOM FEED / SURFACE MOUNT / LOCATION: 1<sup>ST</sup> FLOOR ELECT. ROOM

#	AMP	POLE	DESCRIPTION	AØ	BØ	CØ	DESCRIPTION	POLE	AMP	#
1	150	3	T-LV1 FEEDER	25700			PANEL AC	3	350	2
3				67348						
5				28831						
7				67348						
9				26498						
11				67348						
13	50	3	ELEVATOR EQUIPMENT	5817			T-LV1 FEEDER	3	100	4
15				20440						
17				5817						
19				17420						
21				5817						
23	200	3	SPACE	21870			PANEL H	3	125	6
25				19990						
27				20691						
				141175	139406	140514				

42,095 ÷ 480 X 3 = 506.73

PAENL LV2 400 AMP / MCB / THRU FEED LUGS / 208Y-120  
 3Ø / 4W / BOTTOM FEED / SURFACE MNT.

CIRC DESCRIP. AMP POLE A B C POLE AMP DESCRIP. CIRC.

#	AMP	POLE	DESCRIPTION	AØ	BØ	CØ	DESCRIPTION	POLE	AMP	#	
1	Room 210 Mark 45	20	1	1176				20	1	205 C.O. Barlight	2
3	208, 209 GFI			1620						203/204 GFI	4
5	207, Recept.			360						202 Recept.	6
7	207, Recept.			360						205 Refrig.	8
9	206, Recept.			1500						205 Bar	10
11	206, Recept.			1620						205 Mixer	12
13	210 Mark 43			500						Children Stage Mark 26	14
15	210 Mark 44			1620						Children Stage Mark 26	16
17	205 Recept.			1560						205 Computers	18
19	205 Coffee			1600						201 C.O.	20
21	205 Microwave			900						205 Vending	22
23	Mark 27 F1			1600						201 Vending	24
25	Mark 28 F1			1200						Mark 30 F3	26
27	Mark 29 F2			1176						Mark 31 F3	28
29	Mark 33 F4			1560						Mark 32 F4	30
31	Mark 34 F5			1560						Mark 37 F7	32
33	Mark 35 F6			1176						Mark 38 F7	34
35	Mark 36 F6			1176						Mark 49 F8	36
37	Mark 39 F9			1560						Mark 40 F9	38
39	Mark 42 F10			1560						Mark 41 F10	40
41	Mark 46			1176						Spare	42
43	Panel DPI	80	3	1560							44
45				500						Mark 50 Fresnel	46
47				7500							48
49	EF1	15	3	2000							50
51				6250							52
53				2000							54
55	EF3	15	3	144						Space	56
57				144							58
59				144							60
				25700	28836	26498					

TOTAL 21250 + 360 = 59,013 AMPS

PANEL DM1 (DIMMING PANEL) 10kaic  
 100 Amp / MLO / 1