
RIDGELAND WATER SYSTEM CONNECTION AT HIGHLAND PARK BOULEVARD

CITY OF RIDGELAND, MISSISSIPPI

SHEET NO. G.1 COVER SHEET C.1 PROPOSED WATER CONNECTION LAYOUT CD.1 CONSTRUCTION DETAILS CD.2 CONSTRUCTION DETAILS	
C.1 PROPOSED WATER CONNECTION LAYOUT CD.1 CONSTRUCTION DETAILS	
CD.1 CONSTRUCTION DETAILS	
CD.2 CONSTRUCTION DETAILS	

	Superputation and deleter more description and account of the superputation of the superputat



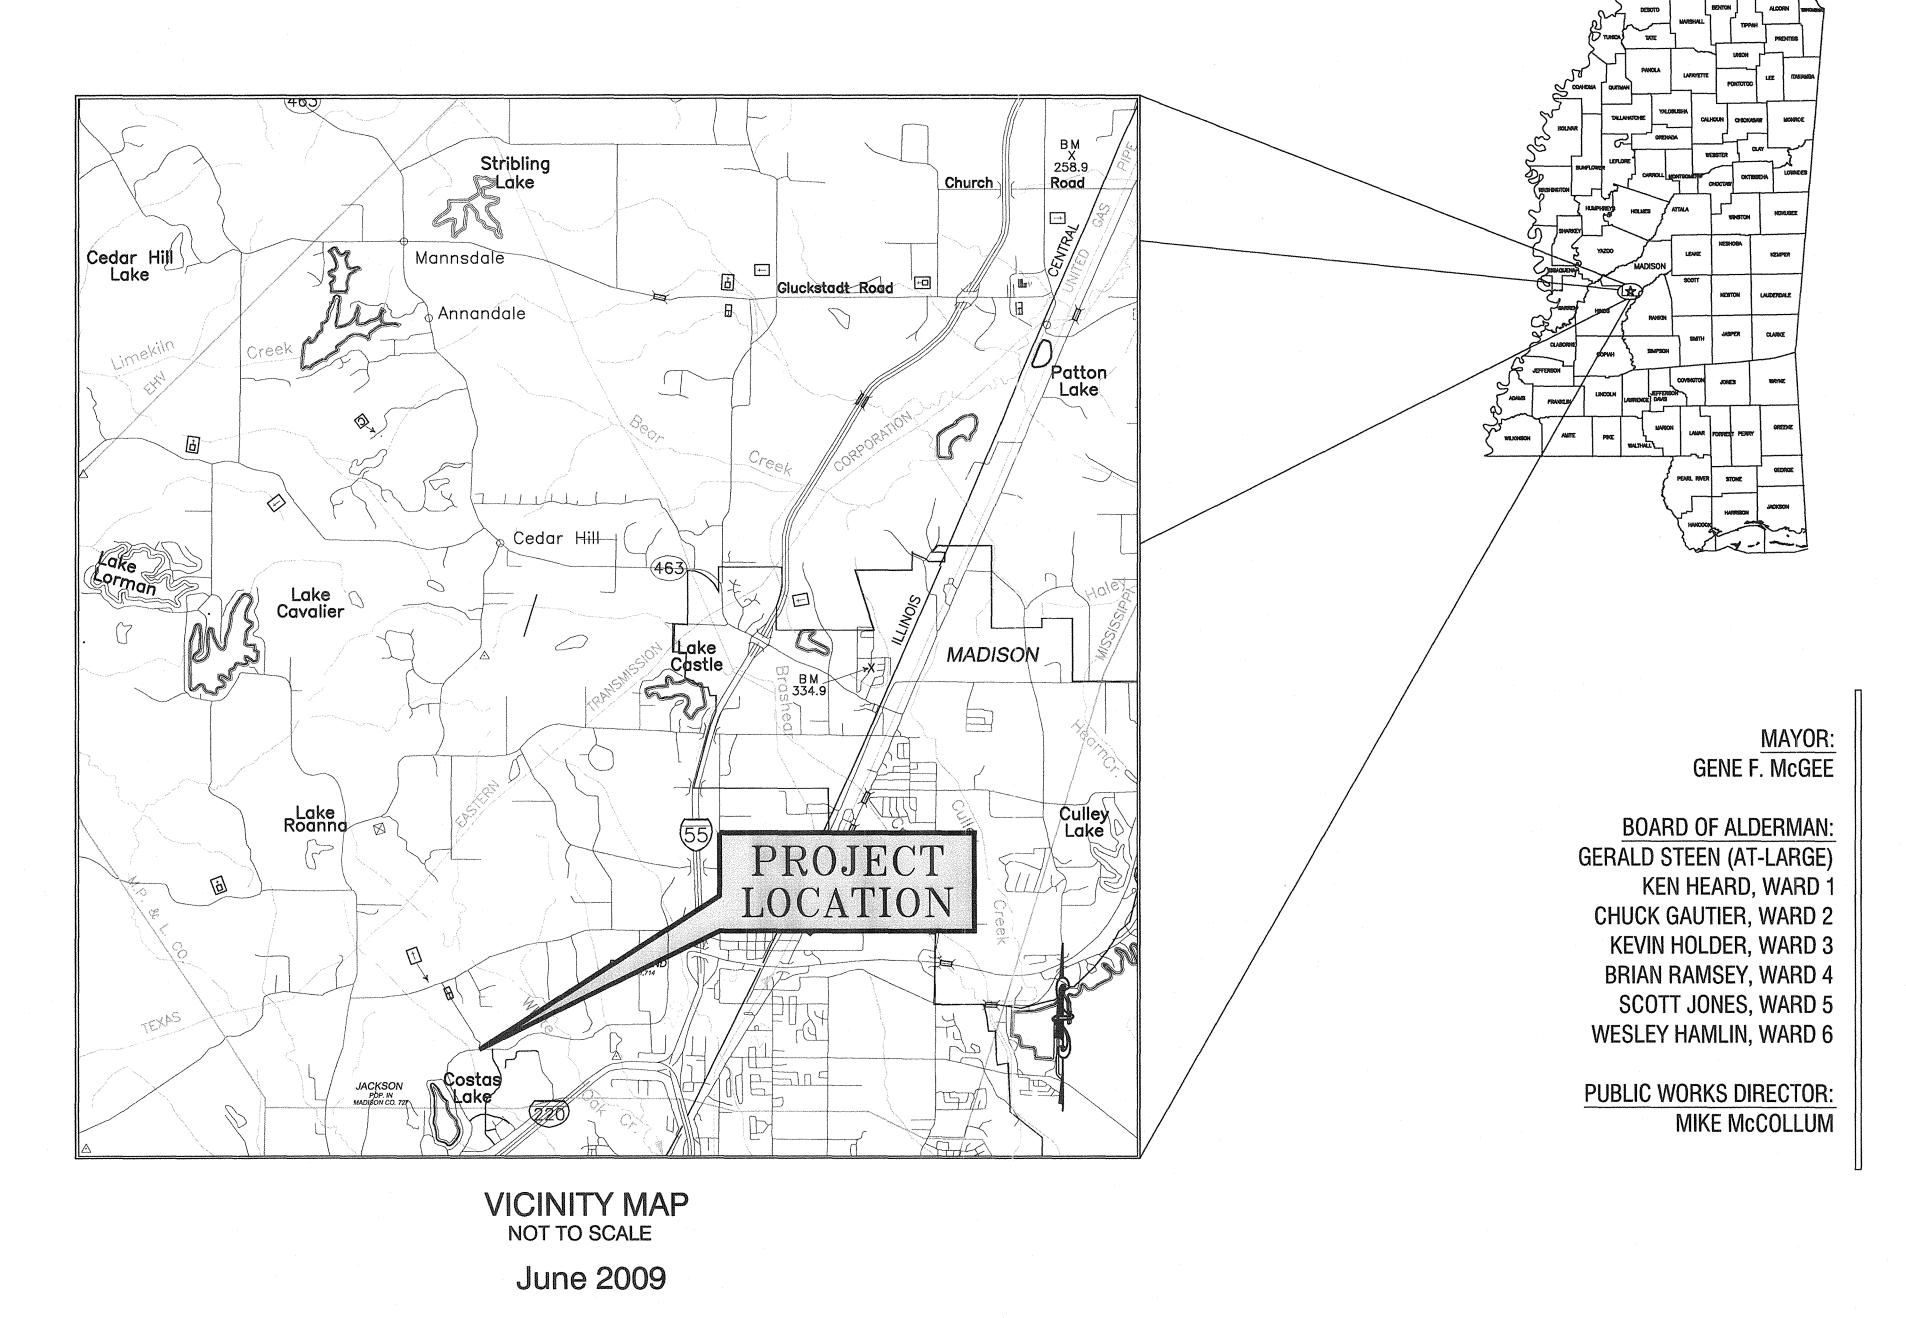

DGELAND WATER SYSTEM CONNECTIC AT HIGHLAND PARK BOULEVARD FOR CITY OF RIDGELAND, MISSISSIPPI

	<u> </u>							
		***************************************		***************************************				
SEAL: SE								
DRAWN BY	····	CWB	SCALE:	N.T.S.				
DESIGNED		СТК	DATE:	June 2009				
CHECKED I		СТК	PROJECT:					
Cover Sheet								
)								


G1.0


DRAWING REVISIONS
REMARKS


DATE

Record Drawing

April 6, 2010

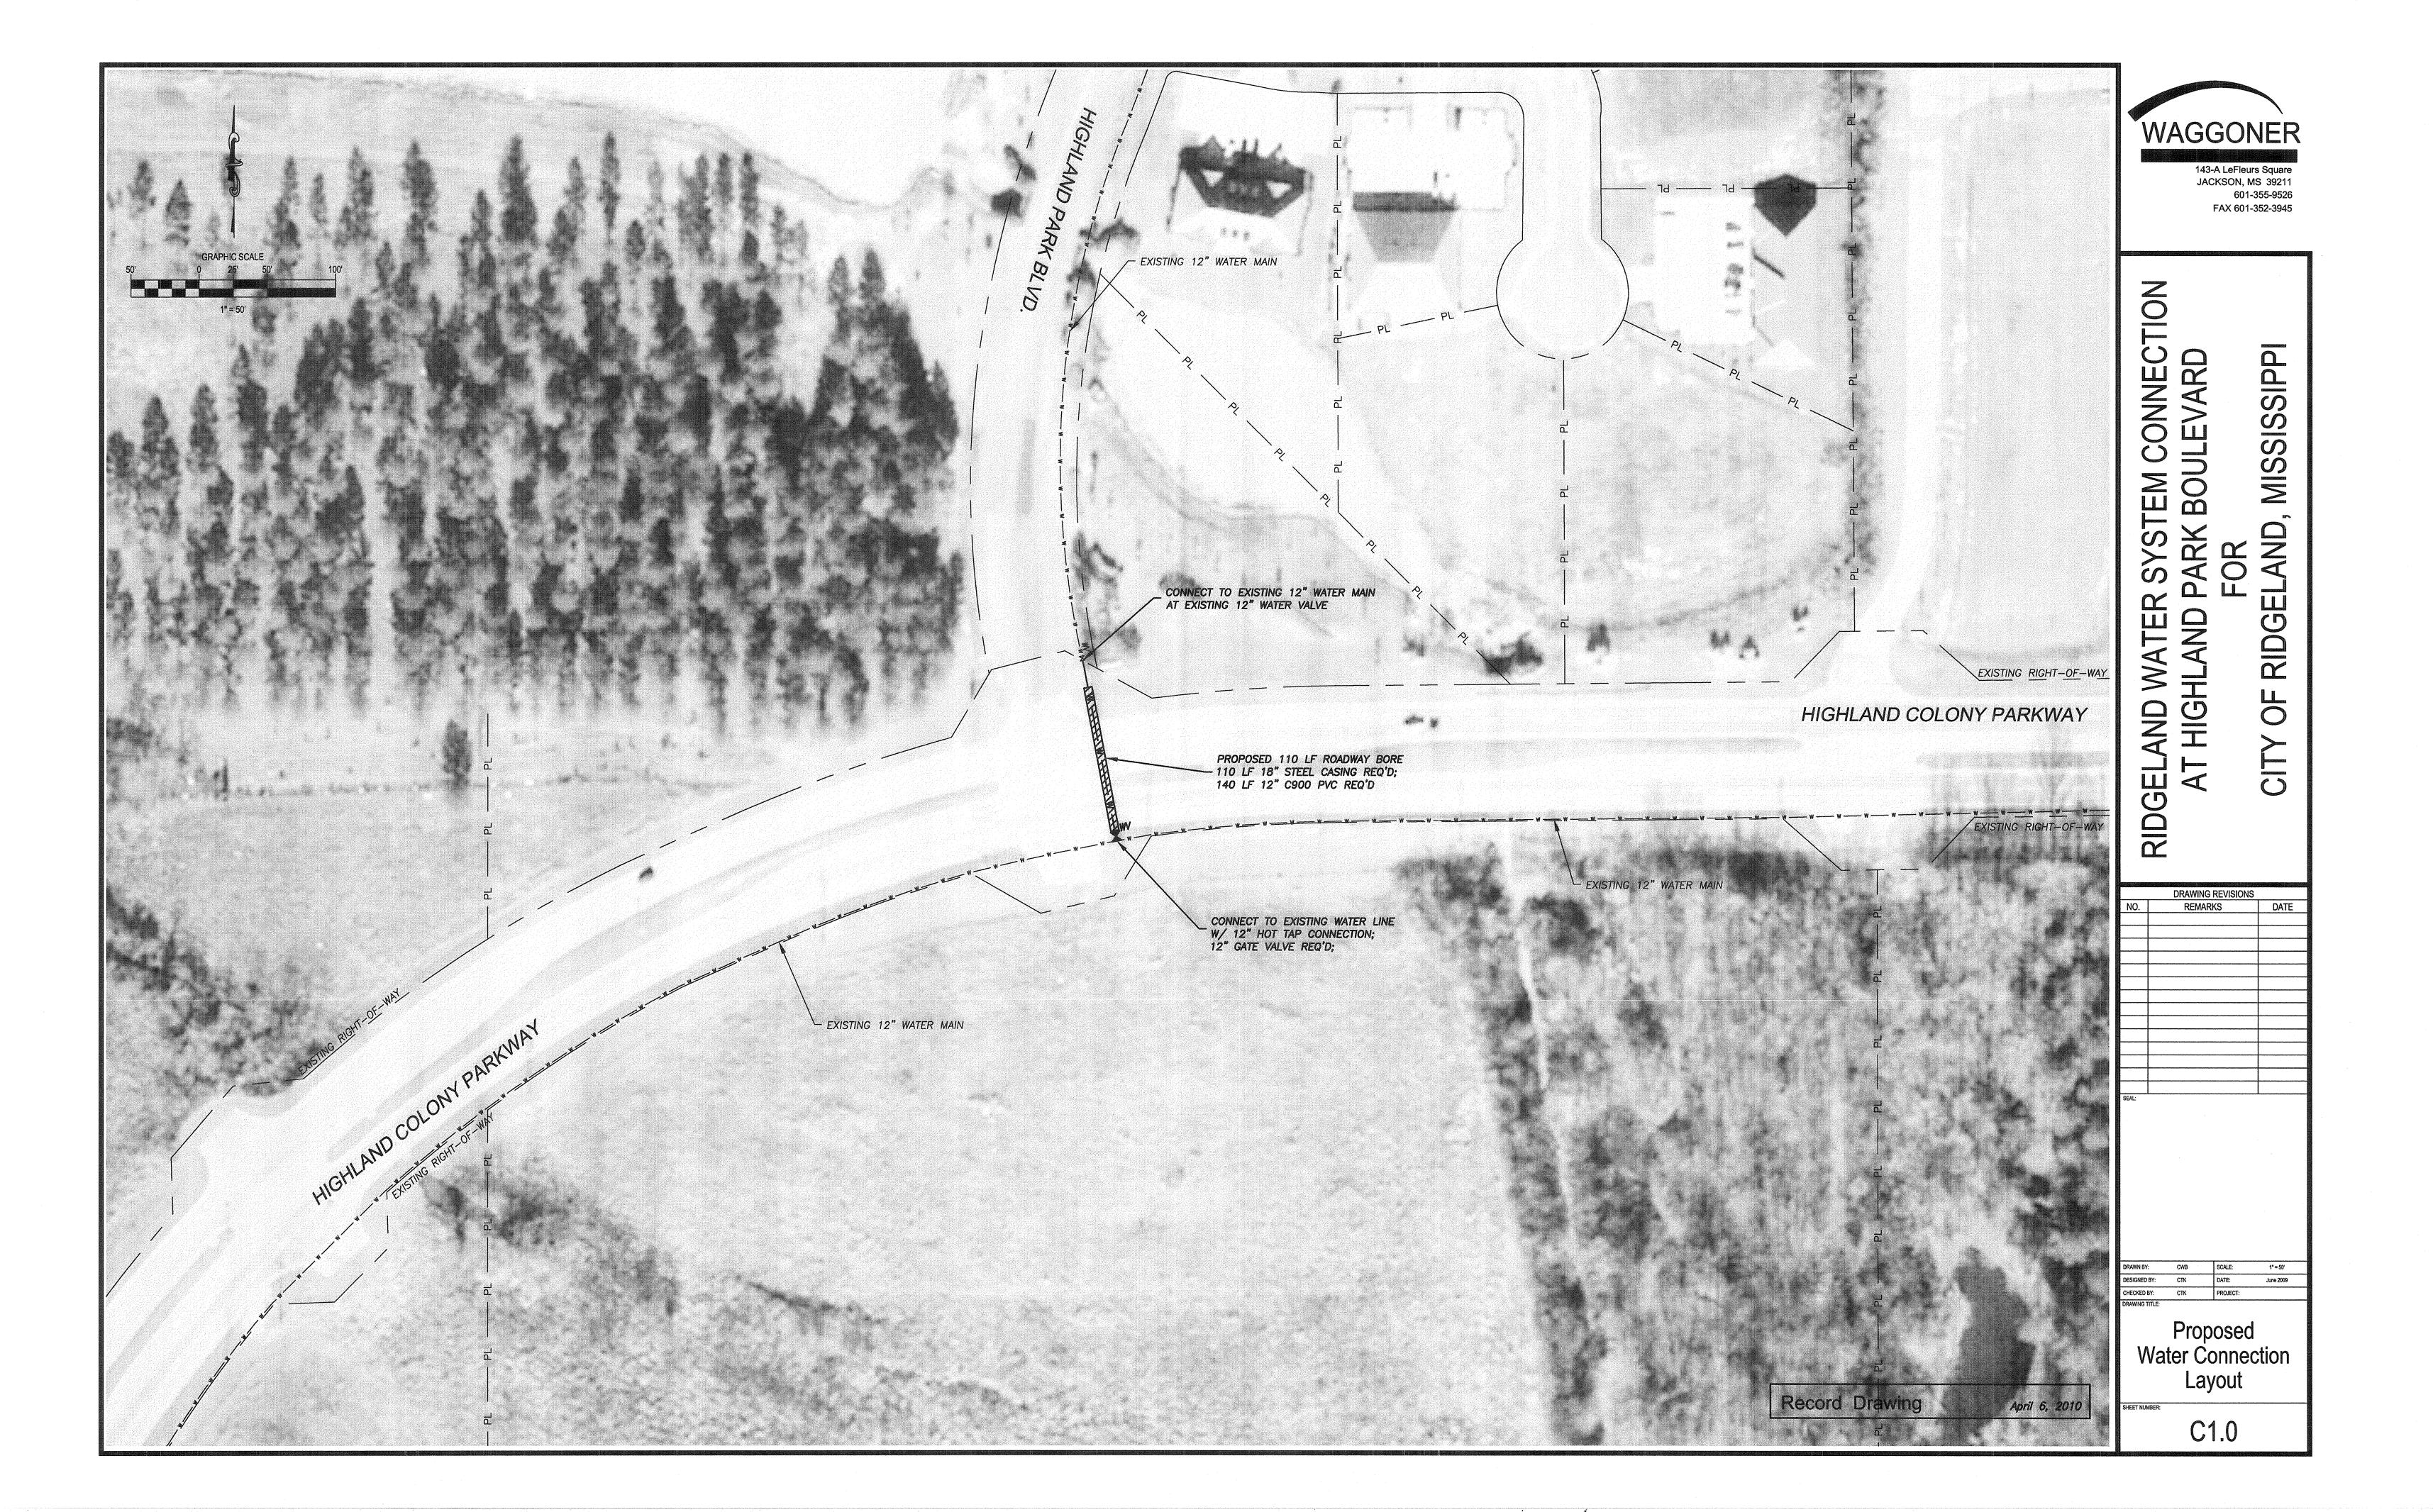

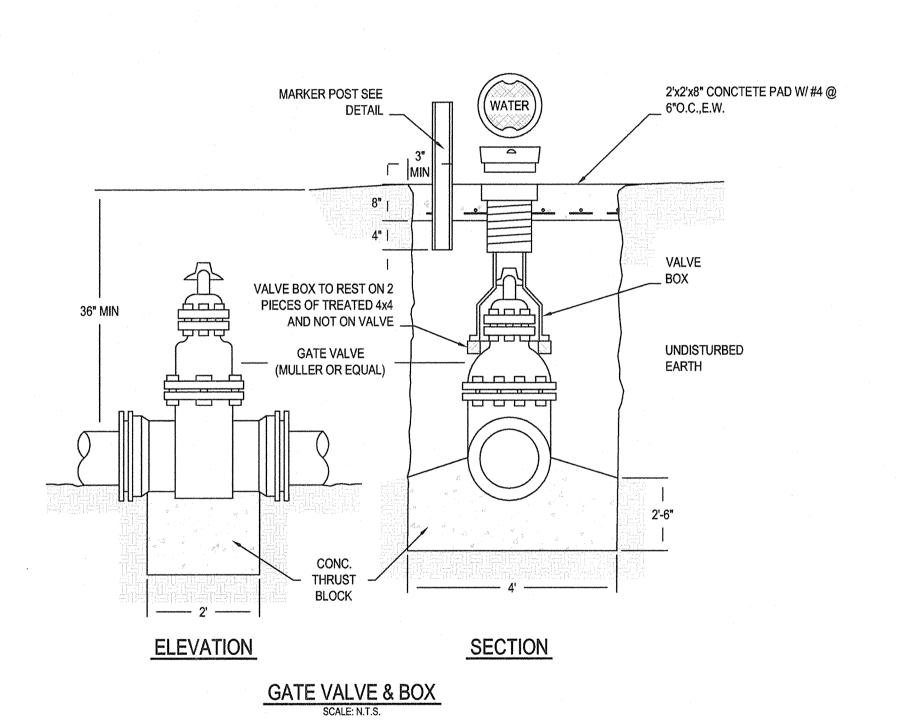


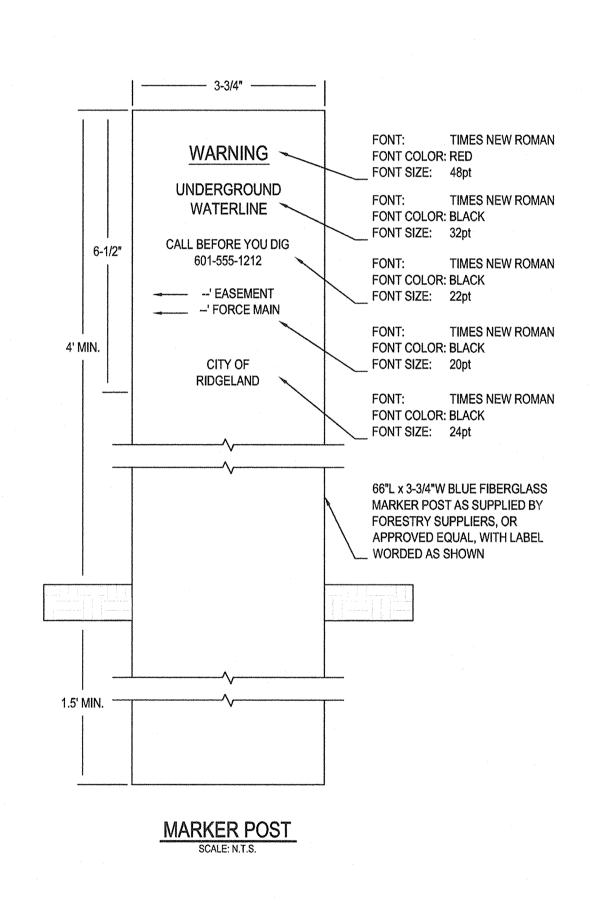



1) DEWATERING REQUIRED TO THIS LEVEL (MIN.). THE CONTRACTOR SHALL MAINTAIN WATER LEVEL TO A LEVEL OF 18" OR GREATER BELOW THE UNDERCUT DEPTH OR THE TRENCH SUBGRADE, WHICHEVER IS DEEPER, BEFORE PIPE PLACEMENT WILL BE ALLOWED.

2) SEE SPECIFICATIONS FOR COMPACTION REQUIREMENTS AND MIN/MAX TRENCH WIDTH

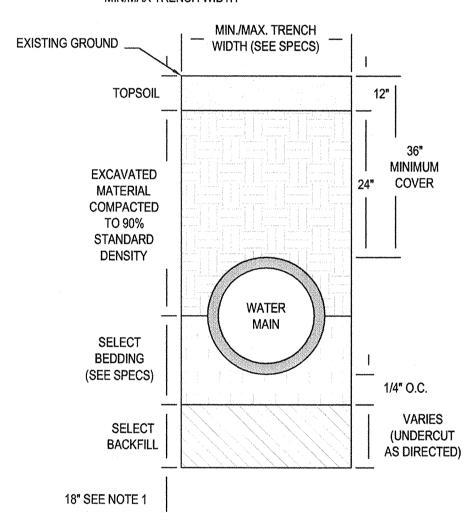

TRENCH DETAIL
SCALE: N.T.S.

RIDGELAND WATER SYSTEM CONNECTION AT HIGHLAND PARK BOULEVARD FOR

WAGGONER

143-A LeFleurs Square JACKSON, MS 39211

601-355-9526 FAX 601-352-3945

MISSISSIPPI

2

0

	DRAWIN	G REVISION	S
NO.	REMA		DATE
SEAL:			
DRAWN BY:	CWB	SCALE:	As Shown
DRAWN BY: DESIGNED BY:	CWB	SCALE: DATE:	As Shown June 2009


Record Drawing

April 6, 2010

CD.1

Construction

Details

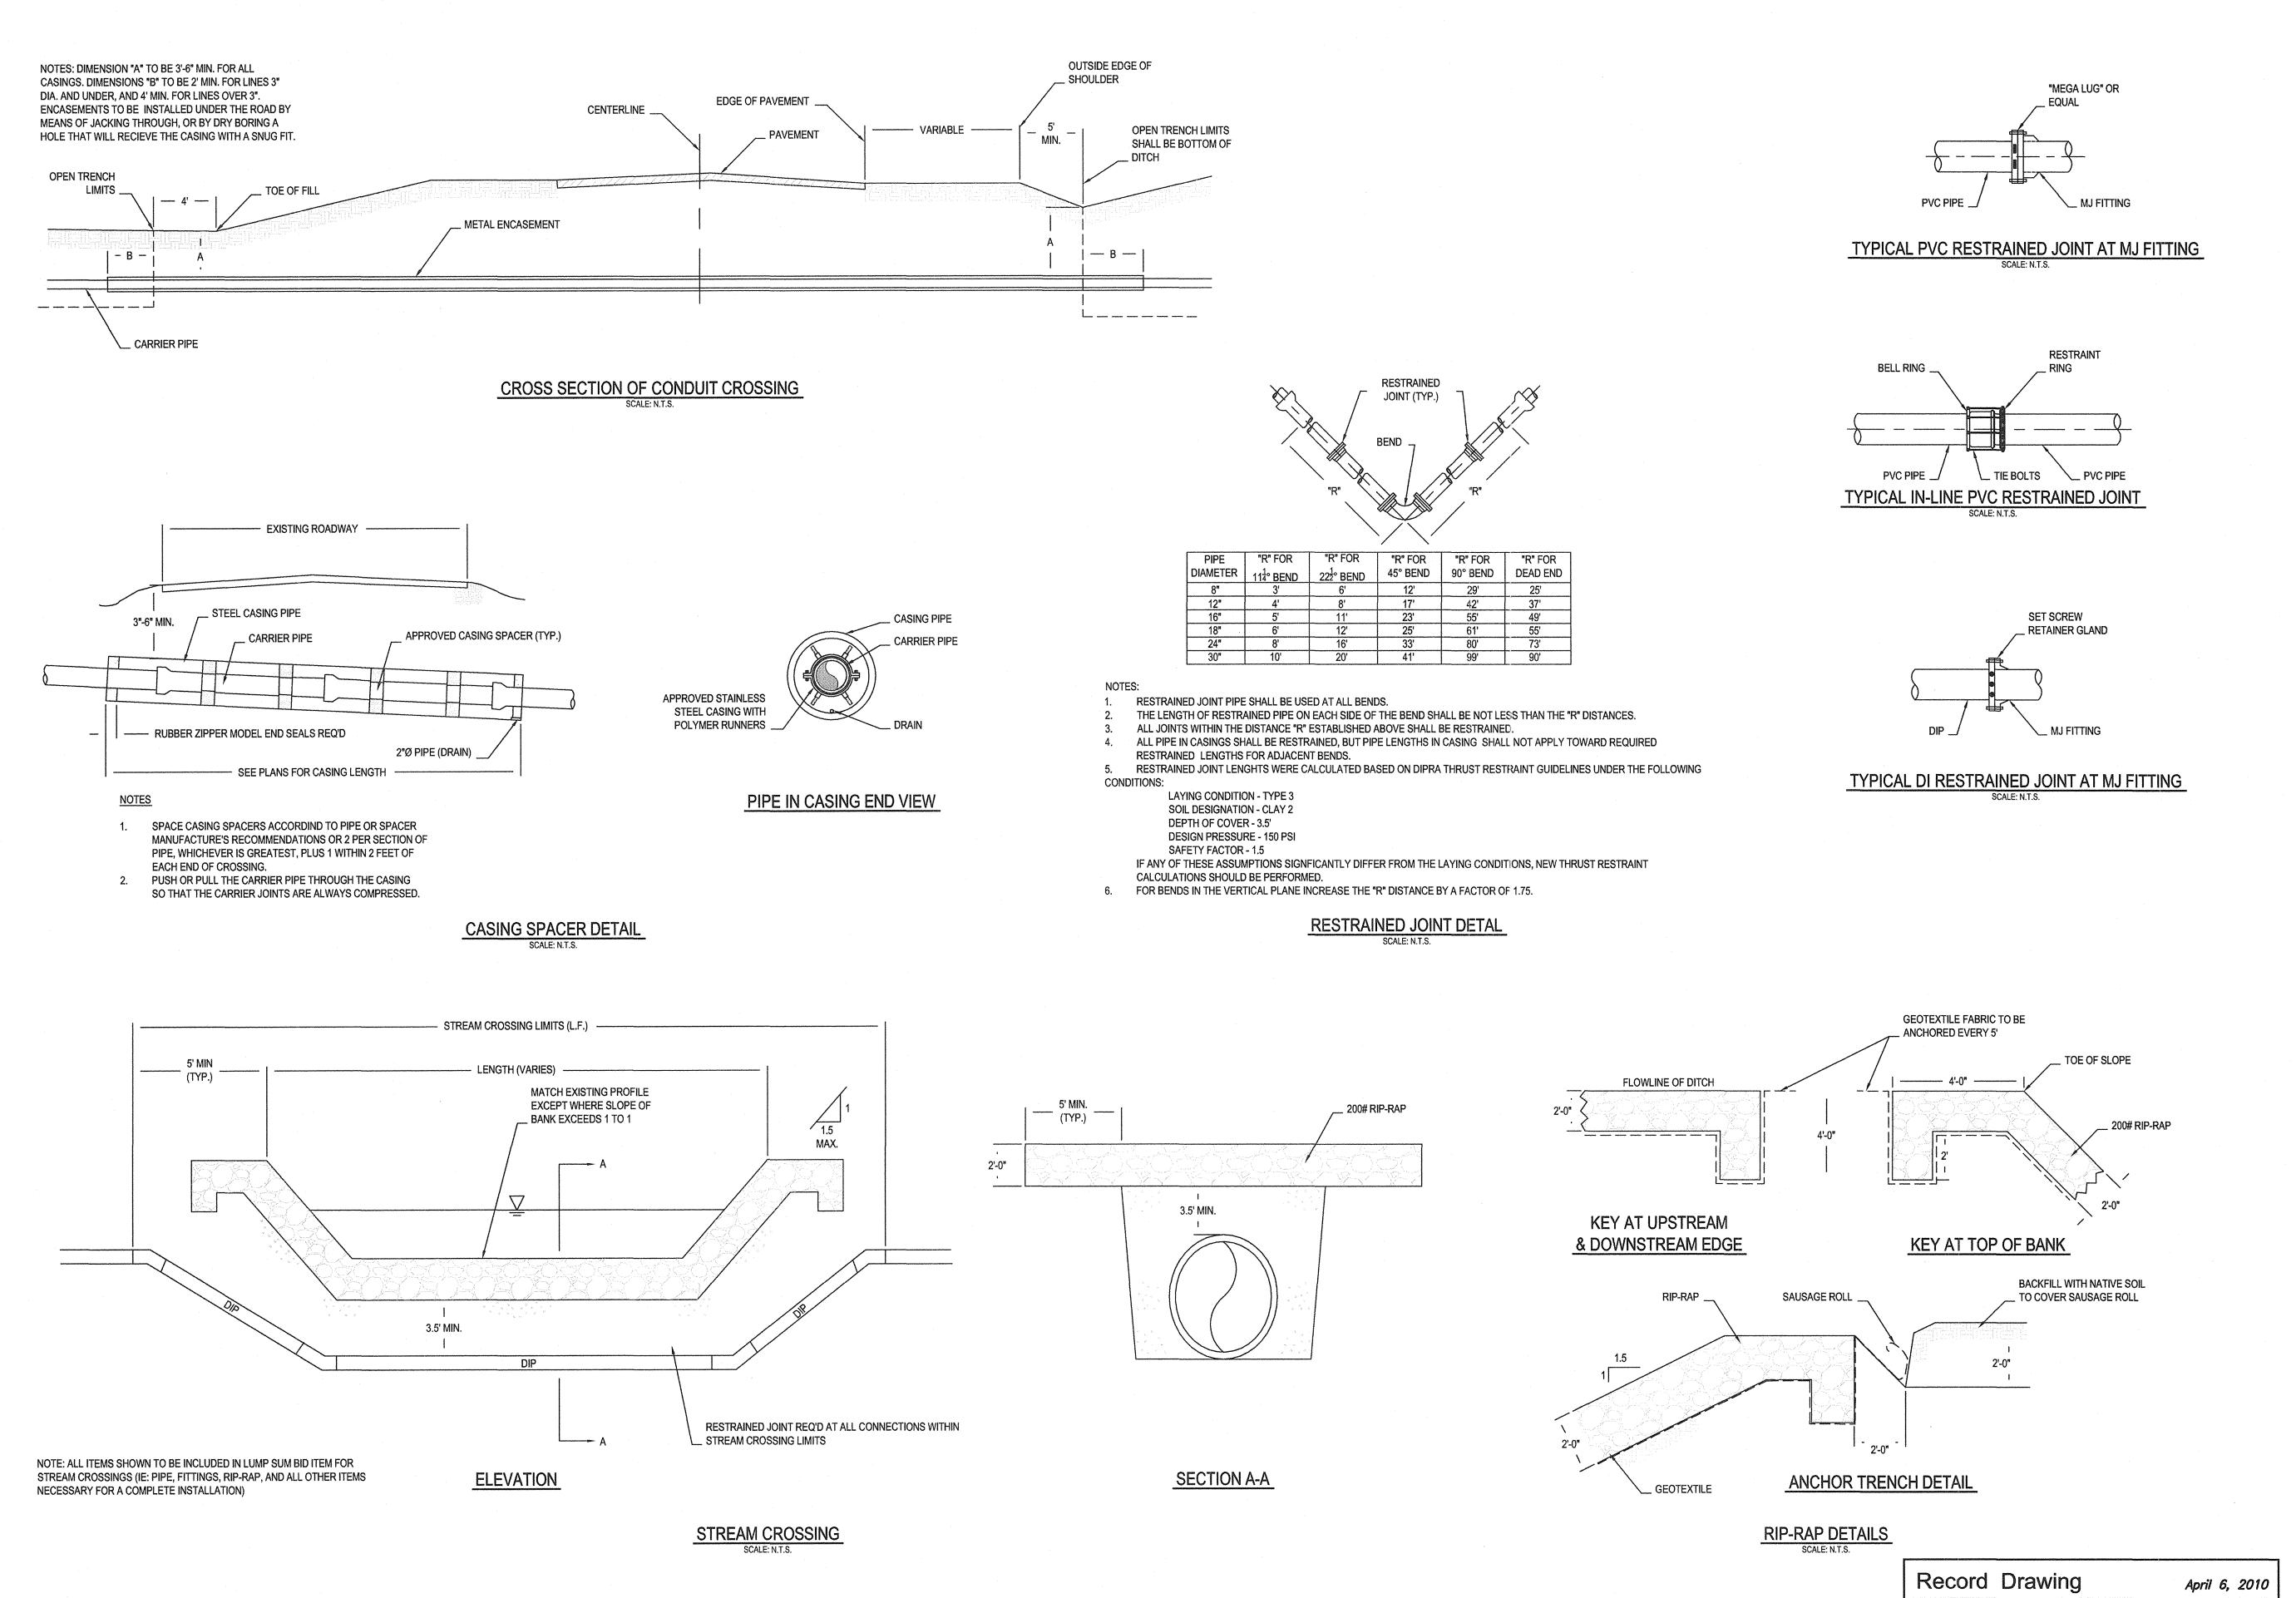



143-A LeFleurs Square JACKSON, MS 39211 601-355-9526

FAX 601-352-3945

5 TEM CONNECT BOULEVARD SPP <u>い</u> S A D ARK (D)

DRAWING REVISIONS								
NO.		REMARI		DATE				
			-,,,,,,,,,,,,,,,,,,,,,,,,,,,,,,,,,,,,,,					
·		······································						
			······································					

				<u> </u>				
			.,					
		***************************************	*************					
	·							
EAL:								
EAL:								
DRAWN BY	; (CWB	SCALE:	As Shown				
ESIGNED	BY:	СТК	DATE:	June 2009				
HECKED	3Y: (СТК	PROJECT:					
RAWING 1	TTLE:							
			4.8					
Construction								
Details								