



Part "A" — Roadway Improvements CDBG. Proj. # 4-99-169-08-01
 Part "B" — Water & Sewer Improvements S.D.B.G. # B-83-SP-28-0001

SHEET INDEX AND PROJECT LAYOUT			
JOE A. WAGNER Civil Engineer - B.C.E.C.			
DESIGNED BY	DATE	SCALE	SHEET
CHECKED BY	DATE	SCALE	1 of 18
APPROVED BY			

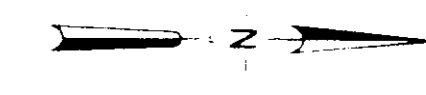


DATE	
BY	
PLAN	
NO.	
NO. OF WAY CHECKED	
ALIGNMENT CHECKED	
NOTES	
NO.	

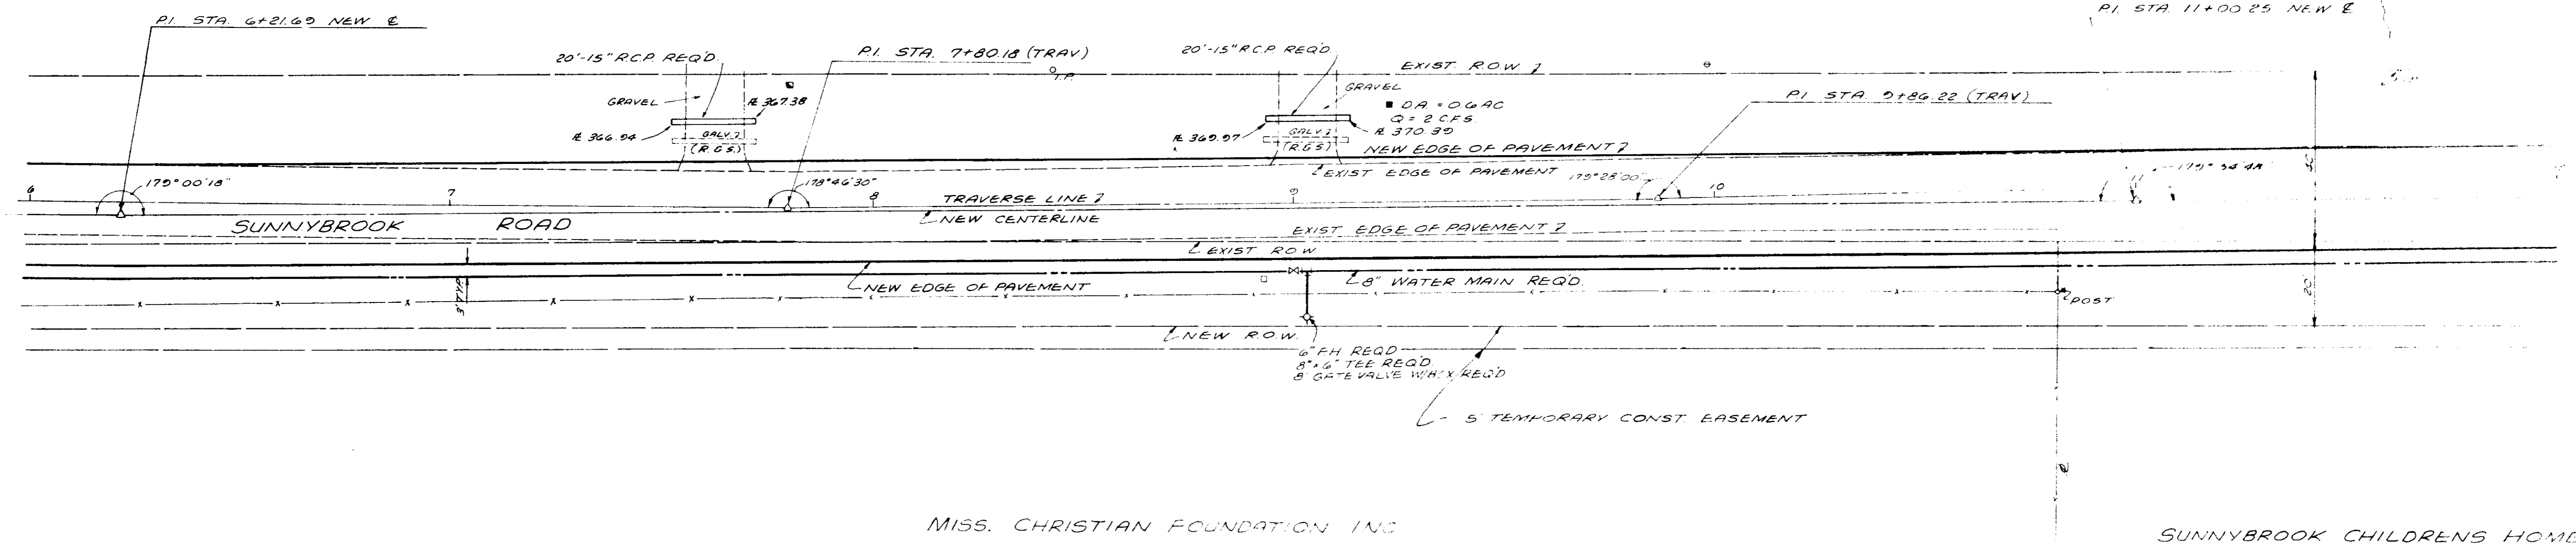

MISS. CHRISTIAN FOUNDATION INC

SUNNYBROOK CHILDRENS HOME

DATE	
BY	
PROFILE	
NO.	
NO. OF WAY CHECKED	
ALIGNMENT CHECKED	
NOTES	
NO.	

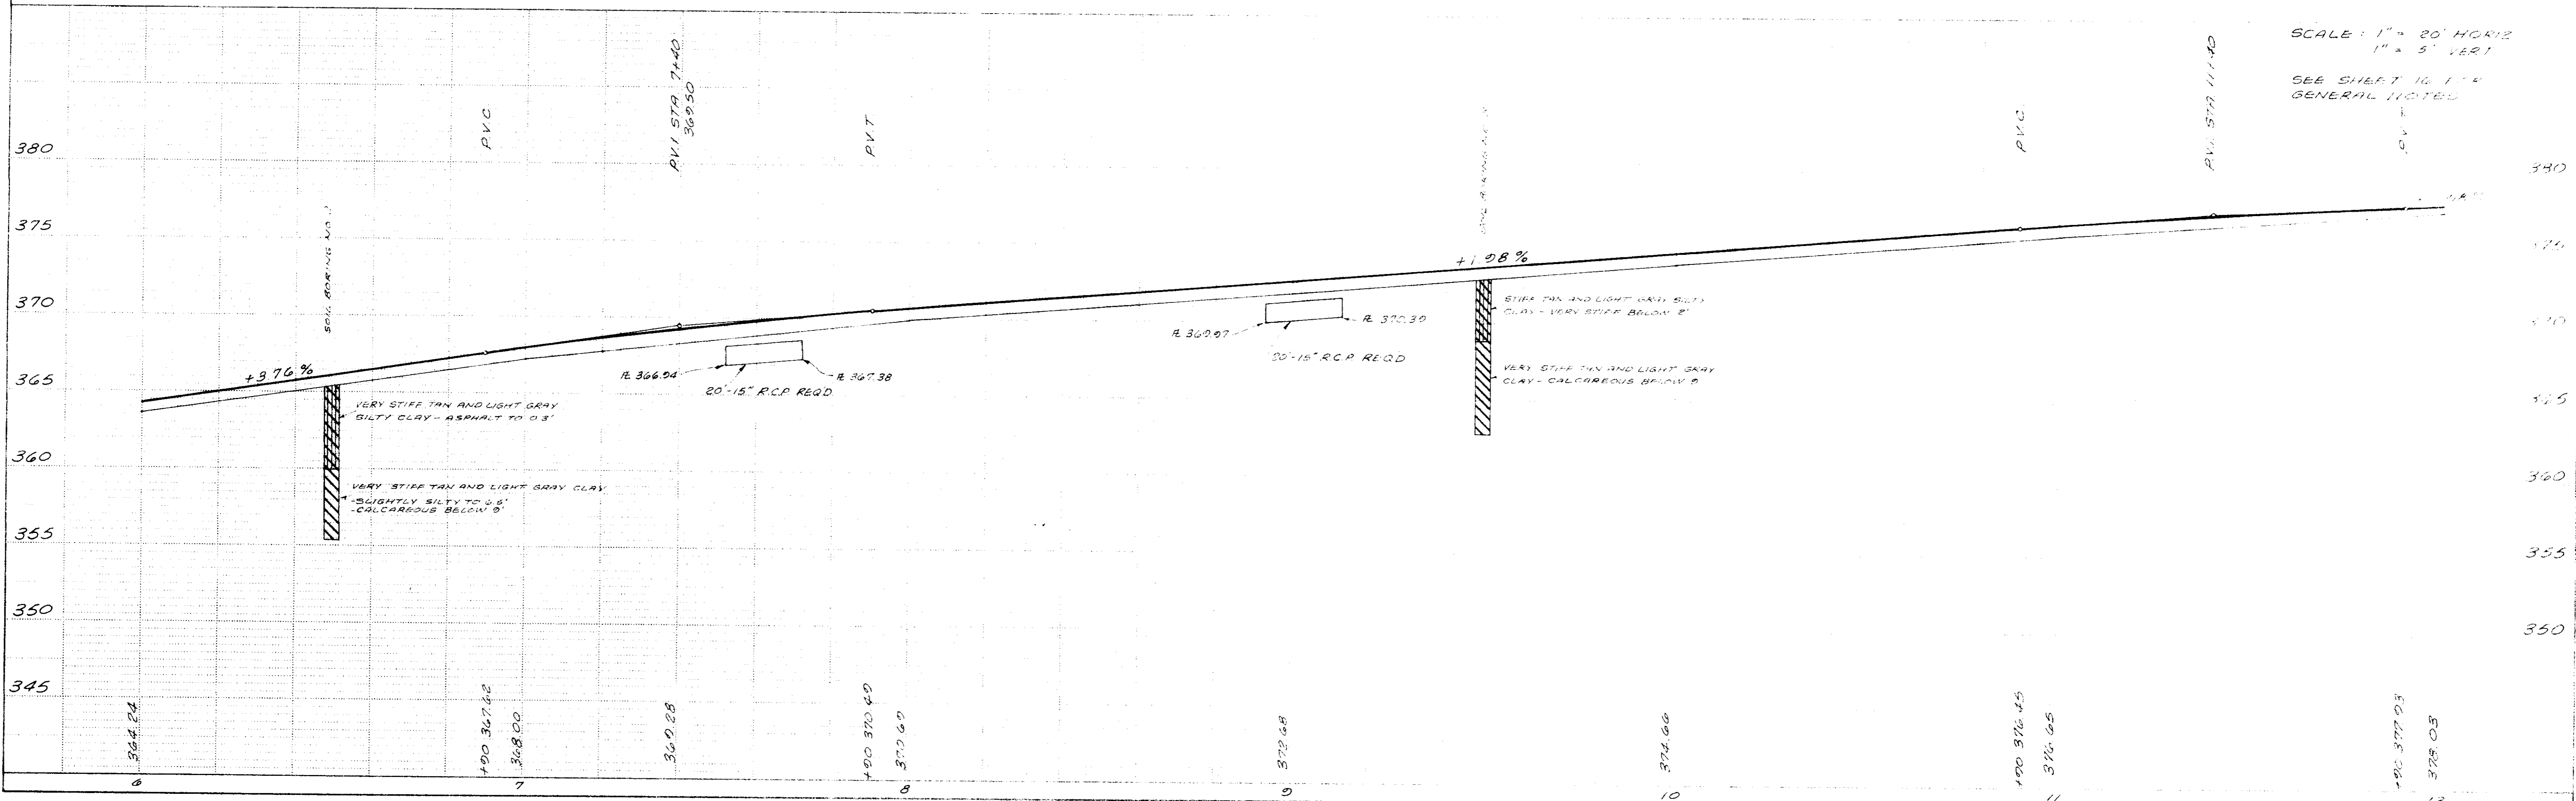


SCALE: 1" = 20' HORIZ
 1" = 5' VERT
 SEE SHEET 16 FOR
 GENERAL NOTES


PLATE 1-SINGLE PLAN AND PROFILE FULL SIZE

JOE A. WAGGONER
 Civil Engineer - Brandon, Jackson, Miss.


SHEET NO.
 3 OF 18

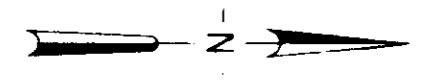

DATE	
BY	
APPROVED	
ALIGNMENT CHECKED	
RT OF WAY CHECKED	
PLAN	
NOTE BOOK	
NO	


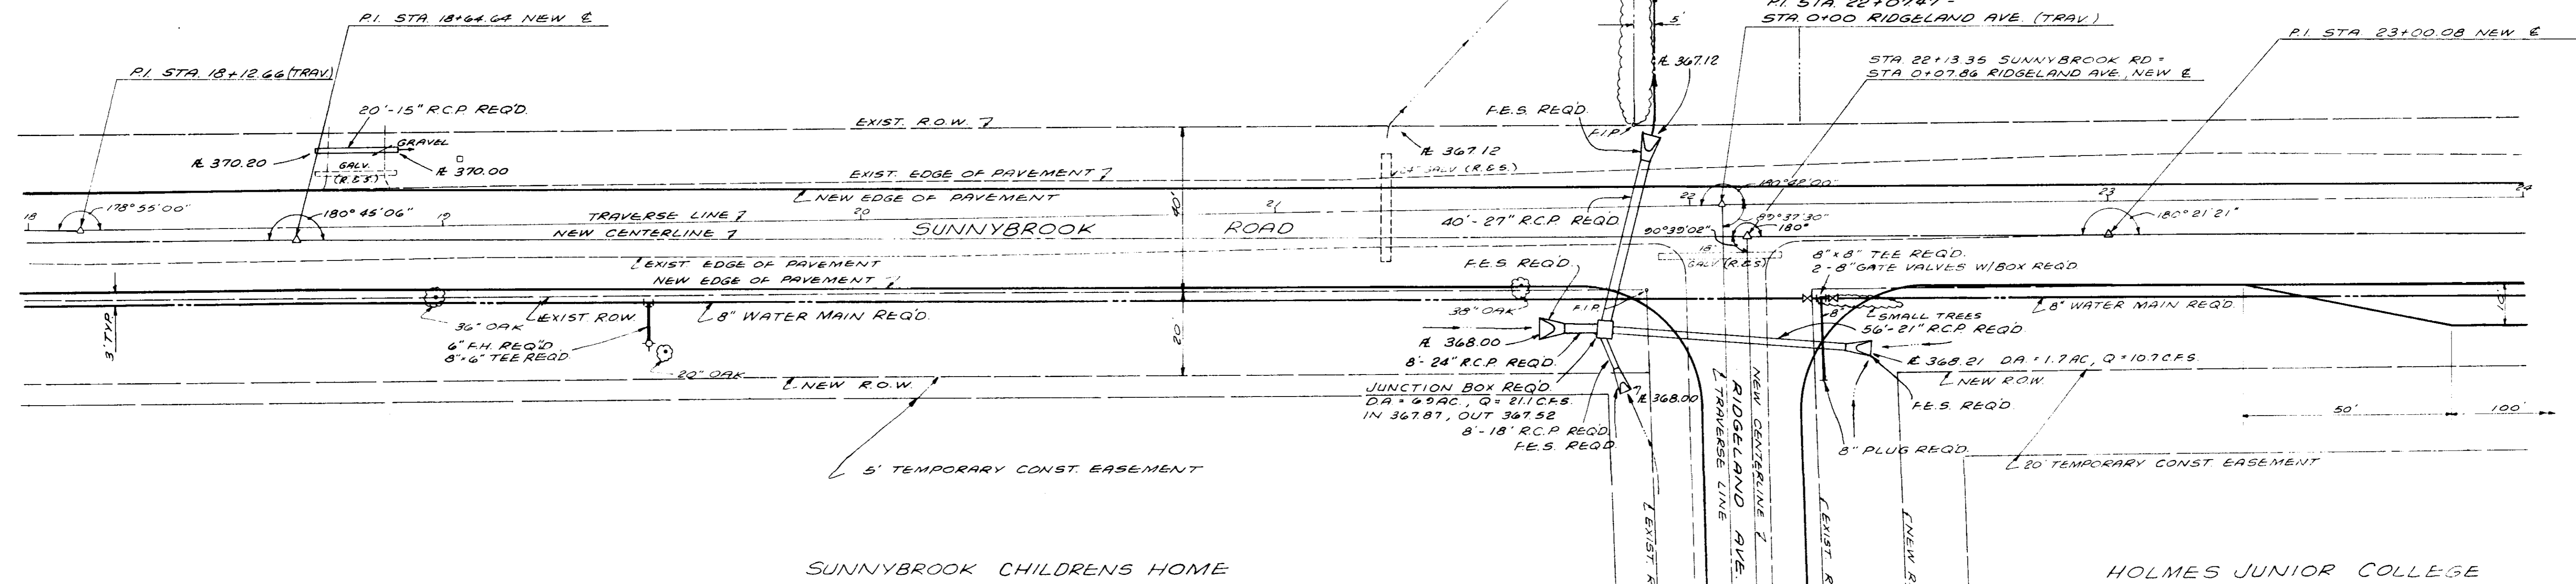


DATE	
BY	
APPROVED	
PLOTTED	
GRADES CHECKED	
STRUCTURE NOTATIONS	
PROFILE	
NOTE BOOK	
NO	

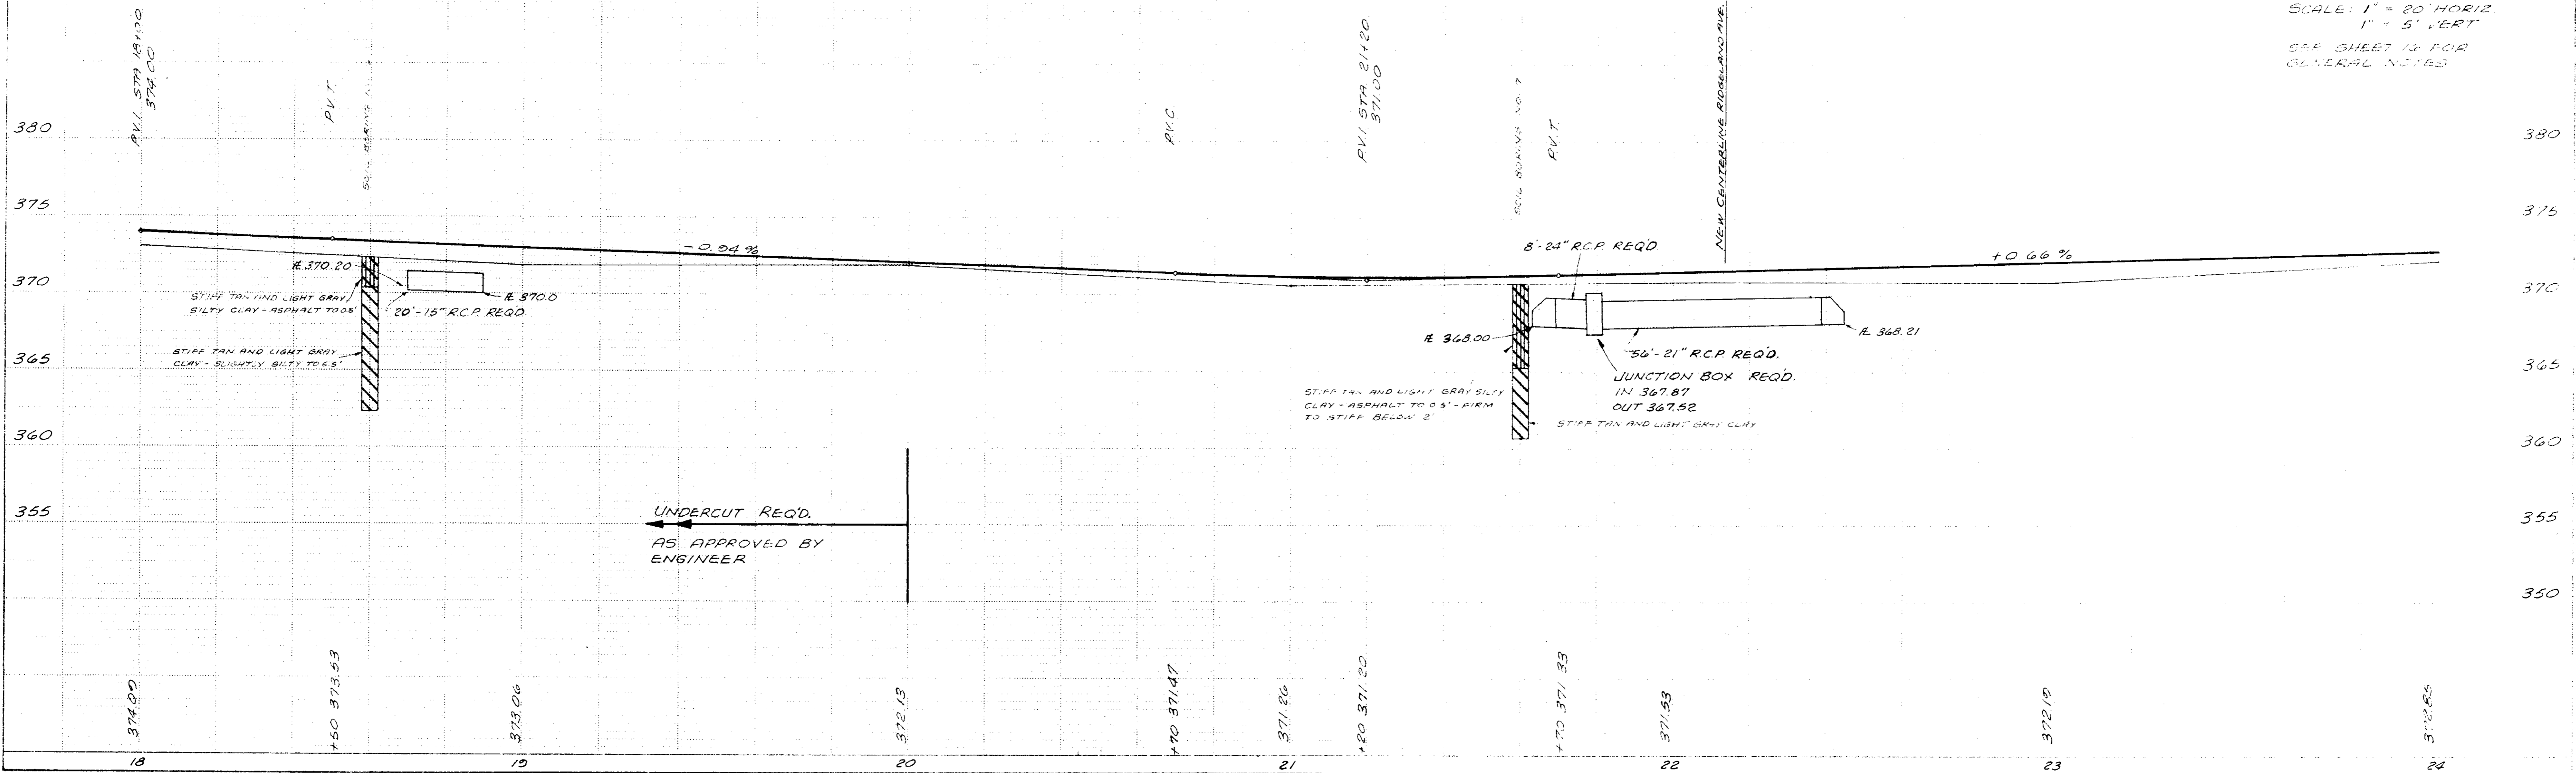


SCALE: 1" = 20' HORIZ
1" = 5' VERT
SEE SHEET 16 FOR
GENERAL NOTES

PLATE 1-SINGLE PLAN AND PROFILE-FULL DOWNS
TELEPHONE
PRINTED IN U.S.A.

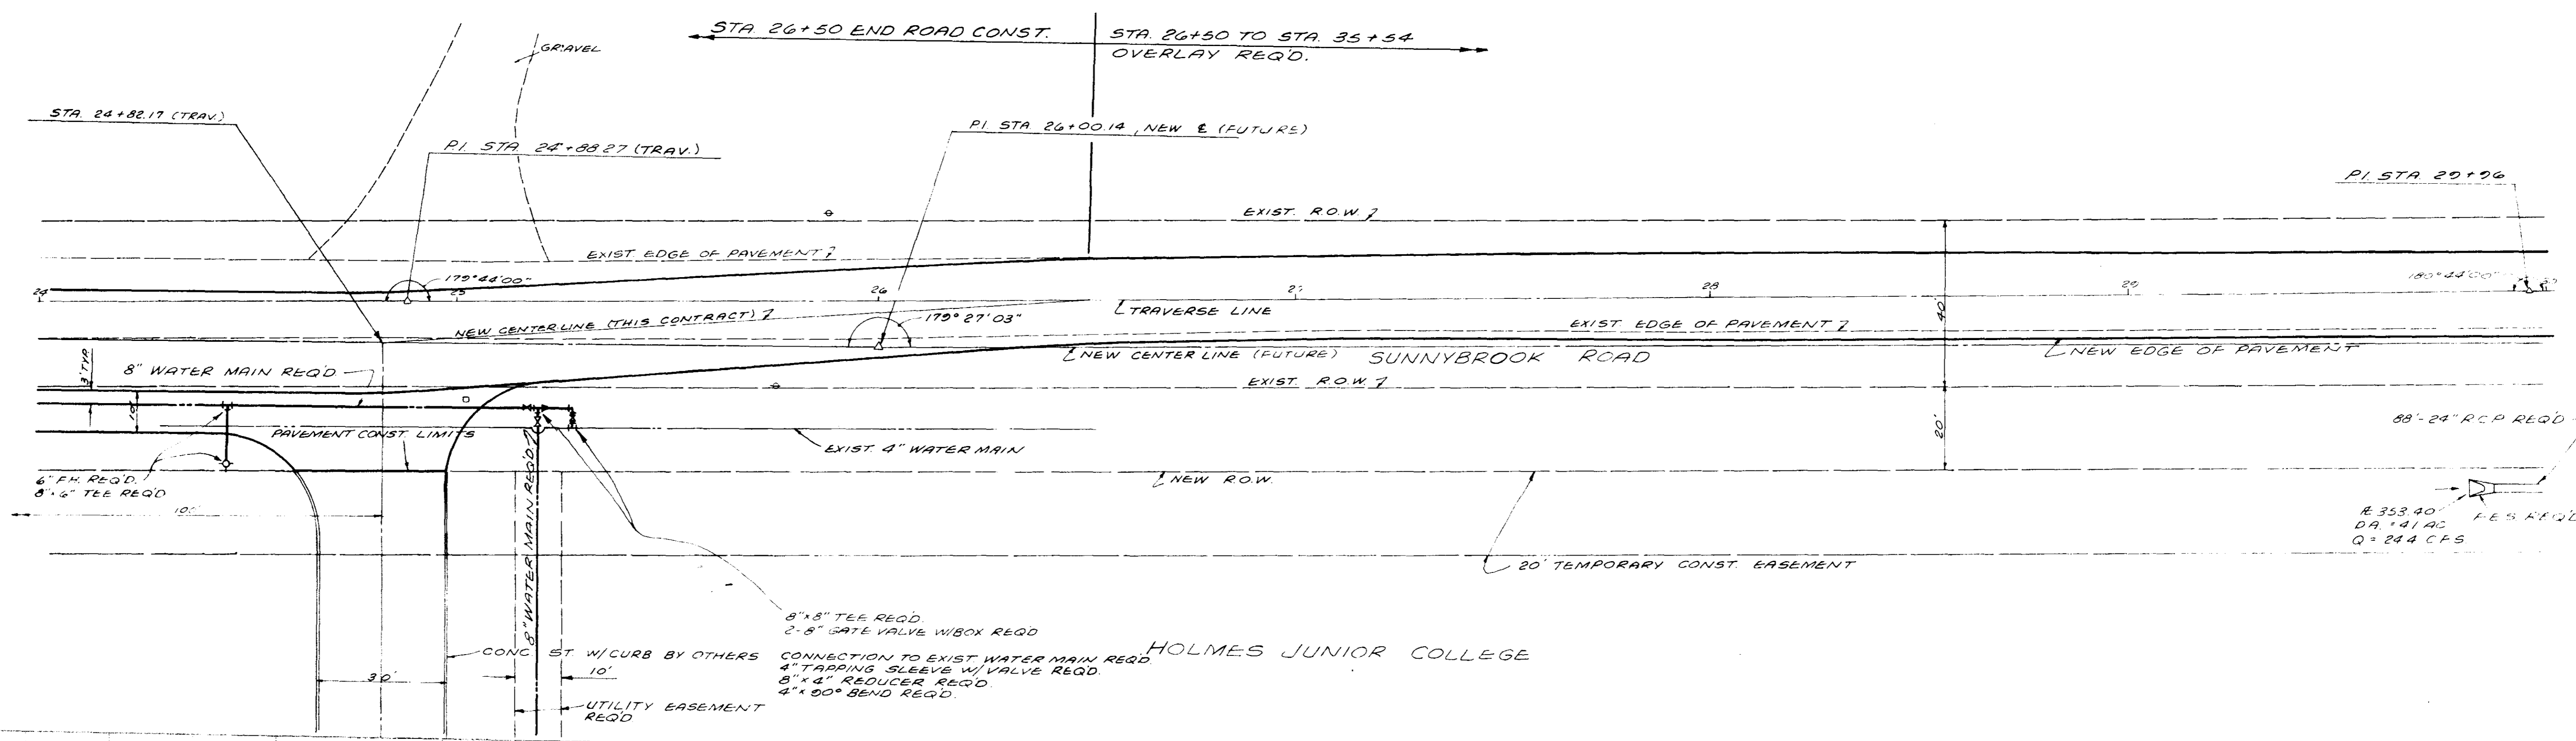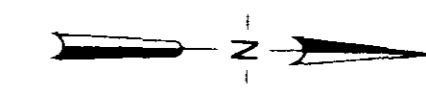

DATE	
BY	
DESIGNED	
CHECKED	
APPROVED	
BY	
NO.	

DATE	
BY	
DESIGNED	
CHECKED	
APPROVED	
BY	
NO.	

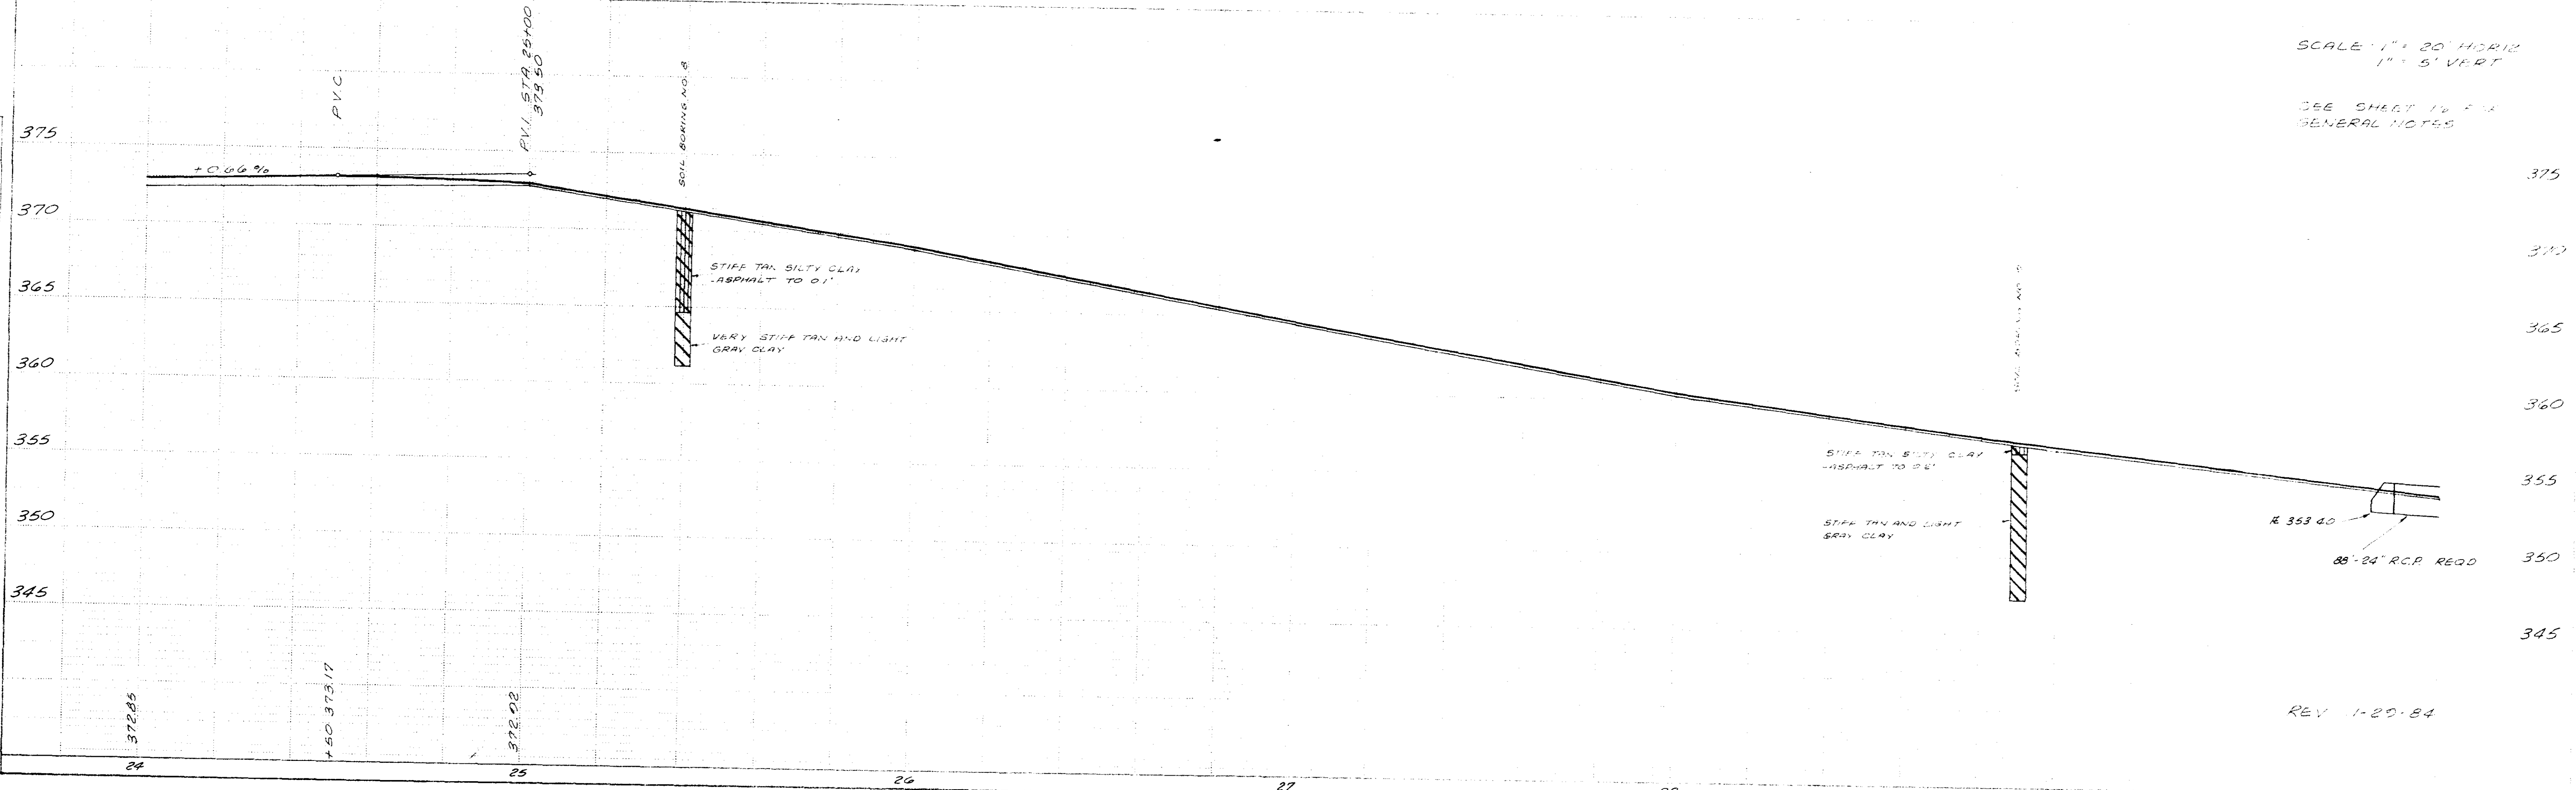


SCALE: 1" = 20' HORIZ
1" = 5' VERT

SEE SHEET 14 FOR
GENERAL NOTES

REV 1-20-84


PLATE 1-SINGLE PLAN AND PROFILE FULL SIZE
PRINTED IN U.S.A.

DATE	
BY	
PLAN	SURVEYED _____ GRADES CHECKED _____ ALIGNMENT CHECKED _____ RT OF WAY CHECKED _____ NOTE BOOK NO. _____

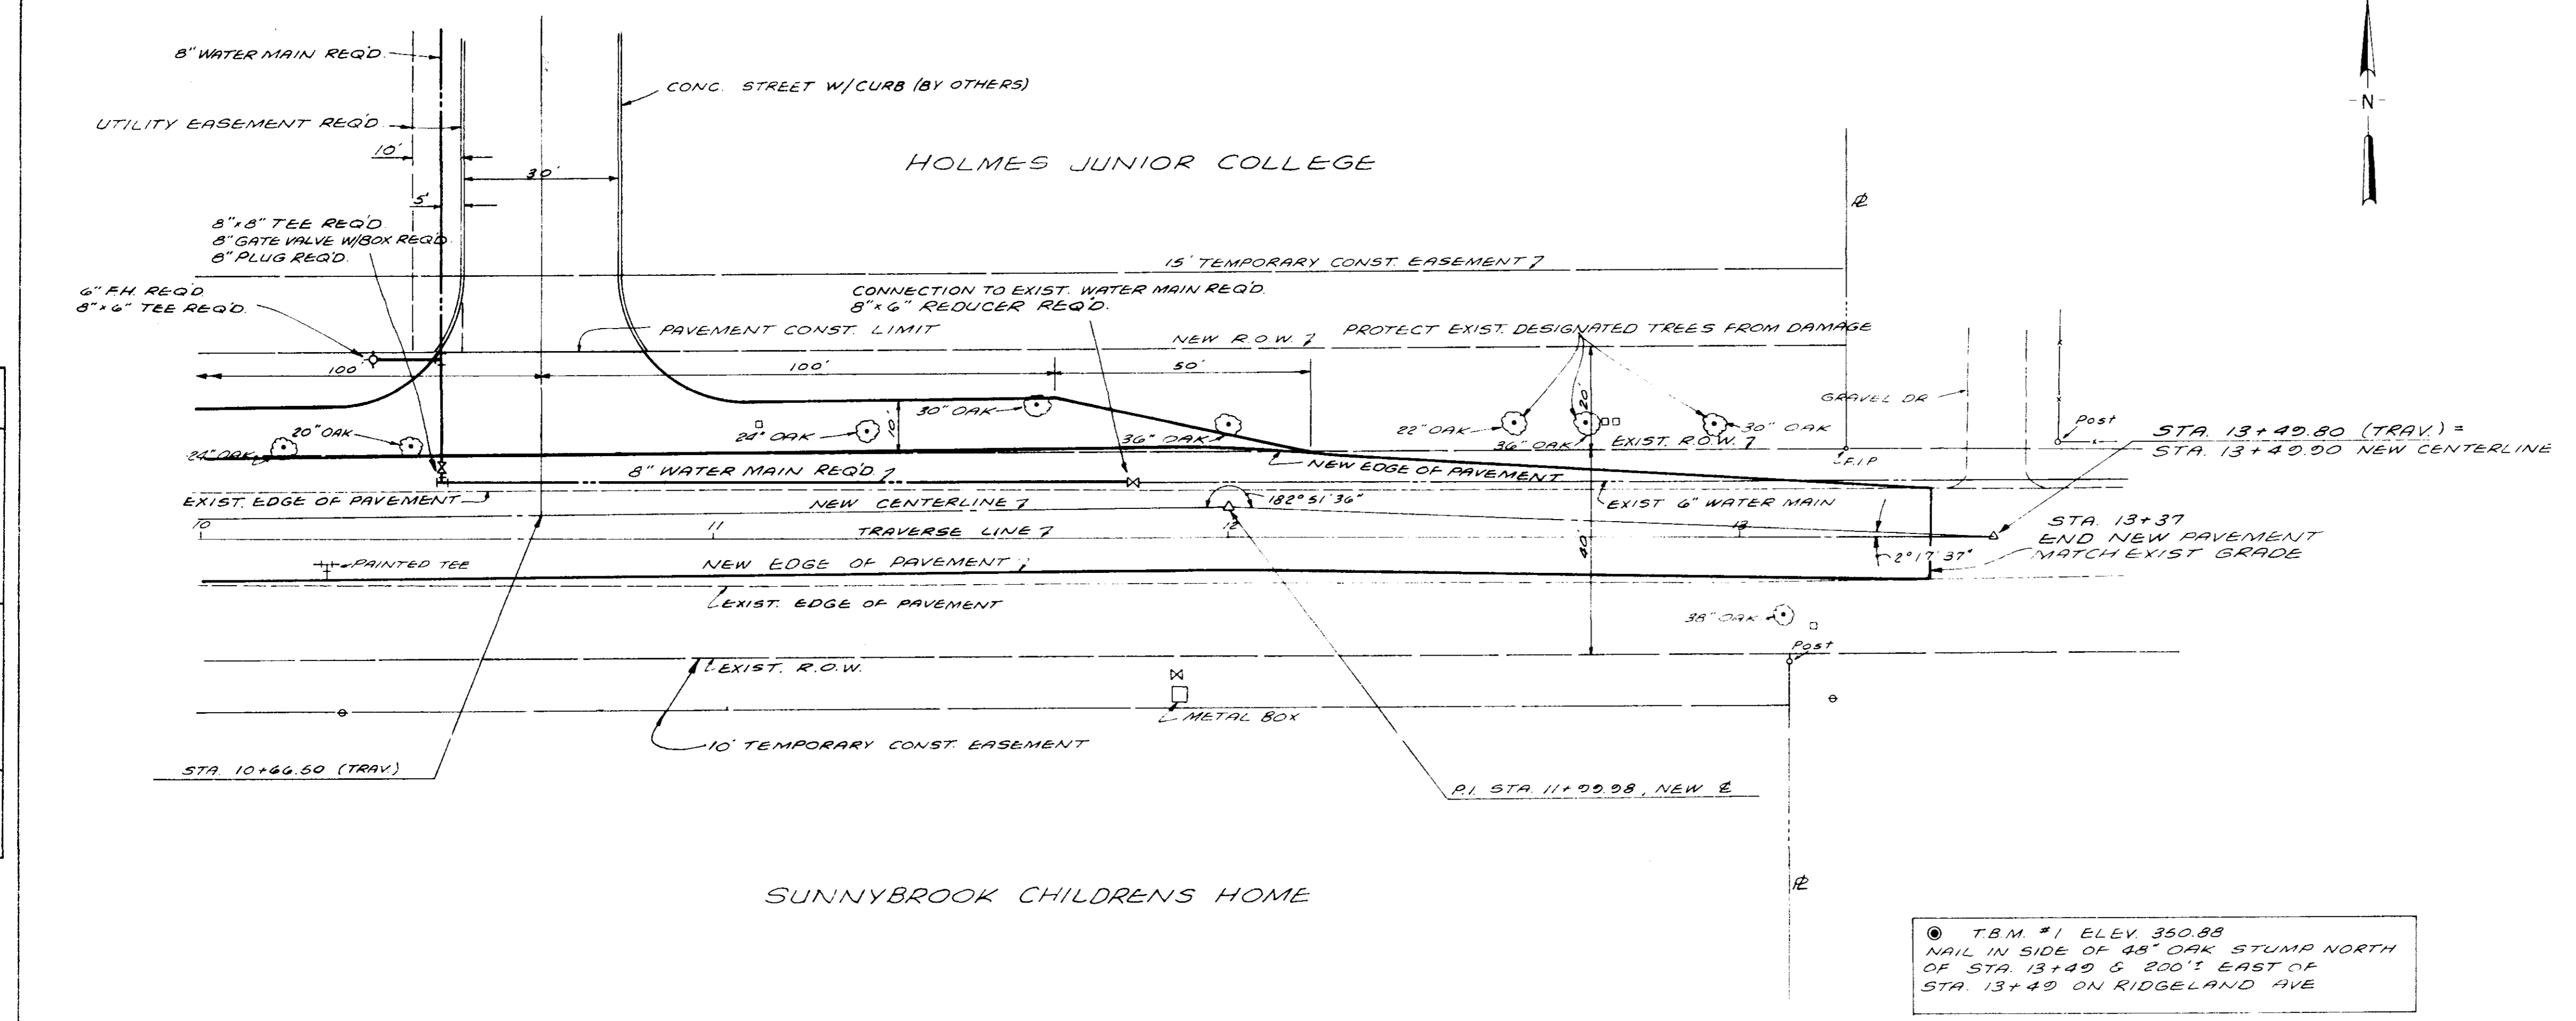


● T.B.M. #1 ELEV. 350.88
NAIL IN SIDE OF 48" OAK STUMP NORTH
OF STA. 13+40 & 200' EAST OF
STA. 13+49 ON RIDGELAND AVE

DATE	
BY	
PROFILE	SURVEYED _____ GRADES CHECKED _____ E. M. S. NOTED _____ STRUCTURE NOTATION, C.P.K. _____ NOTE BOOK NO. _____

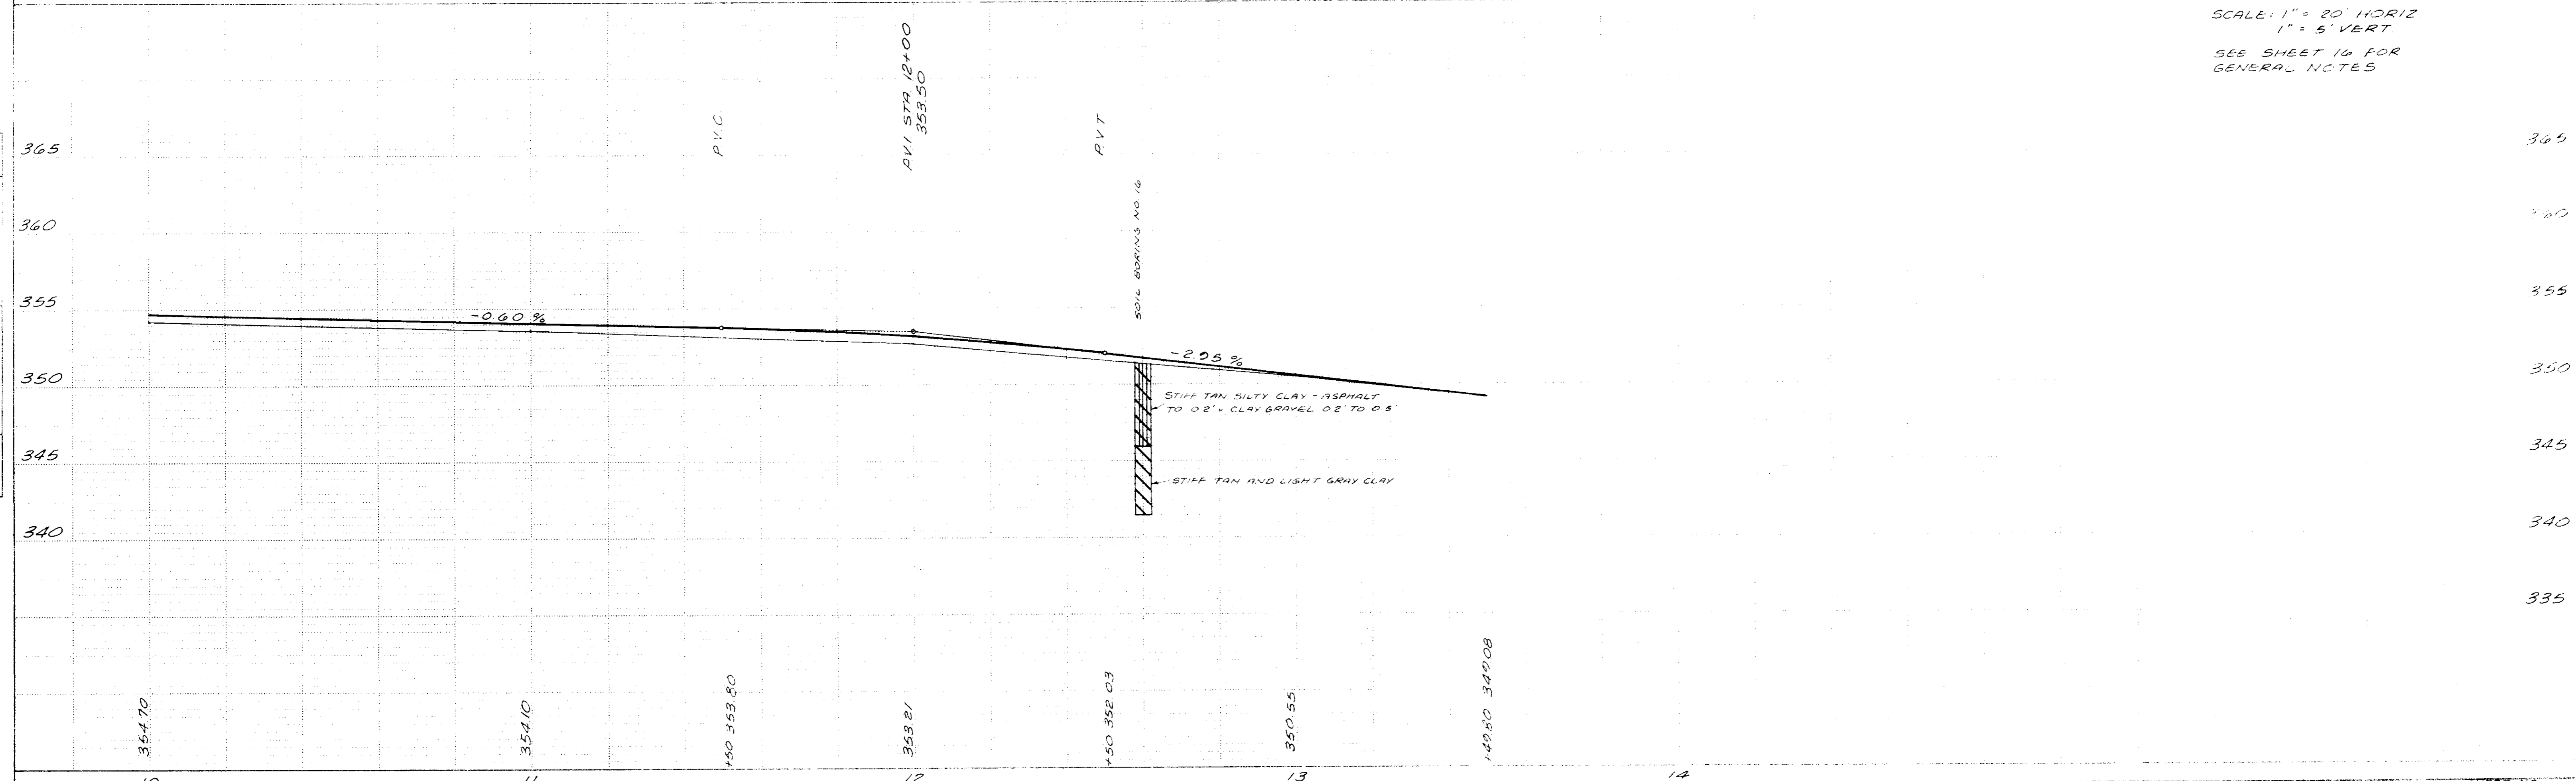

SCALE: 1" = 20' HORIZ
1" = 5' VERT.
SEE SHEET 16 FOR
GENERAL NOTES

STA 30+32.17

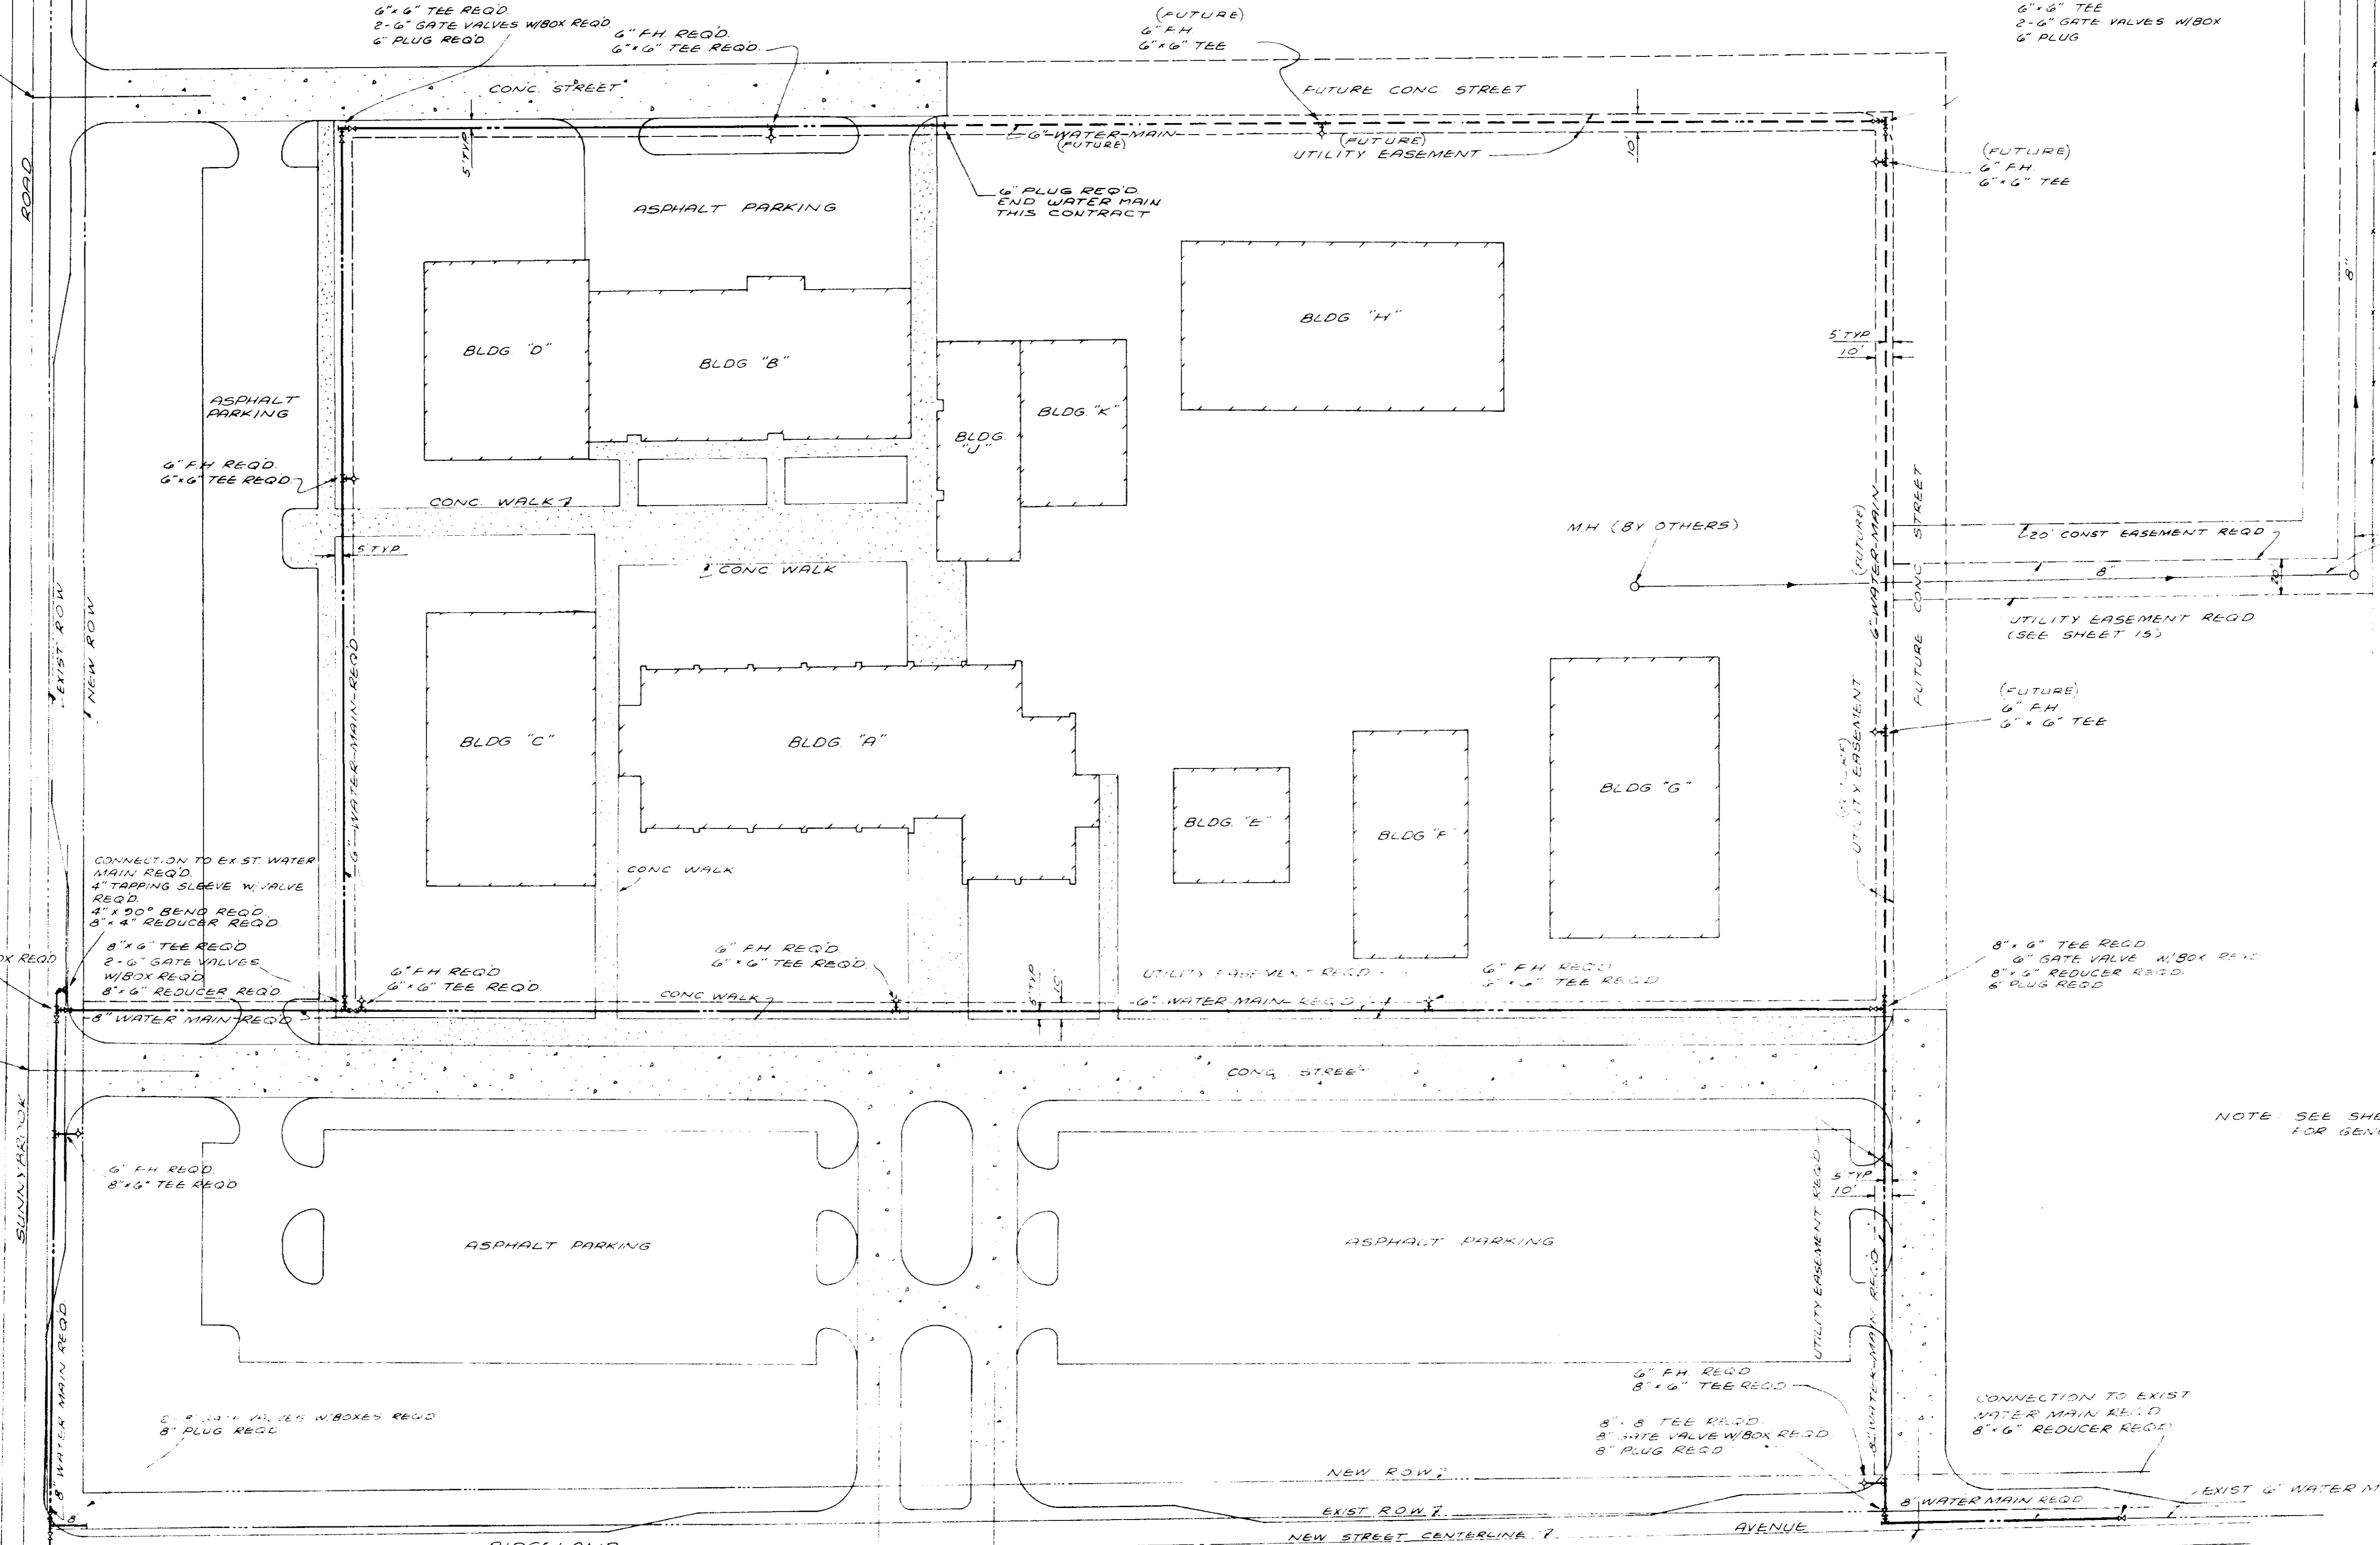

NOTE SEE SHEET 19 FOR GENERAL NOTES

REV 11-25-84
 FEB 10-1-84


**HOLMES JUNIOR COLLEGE CAMPUS
 WATER SYSTEM IMPROVEMENTS**

JOE A. WAGGONER Civil Engineer - Brandon/Jackson, Miss.		
DRAWN BY RC	DATE 7-27-84	SHEET NO.
CHECKED BY CHW	SCALE 1"=50'	11 OF 18
APPROVED BY JRM		

● T.B.M. "B" ELEV. 321.03
 NAIL IN SIDE OF RR
 15' RT. OF STA. 10+30




PLAN	DATE
BY	
NO.	
NO.	
NO.	

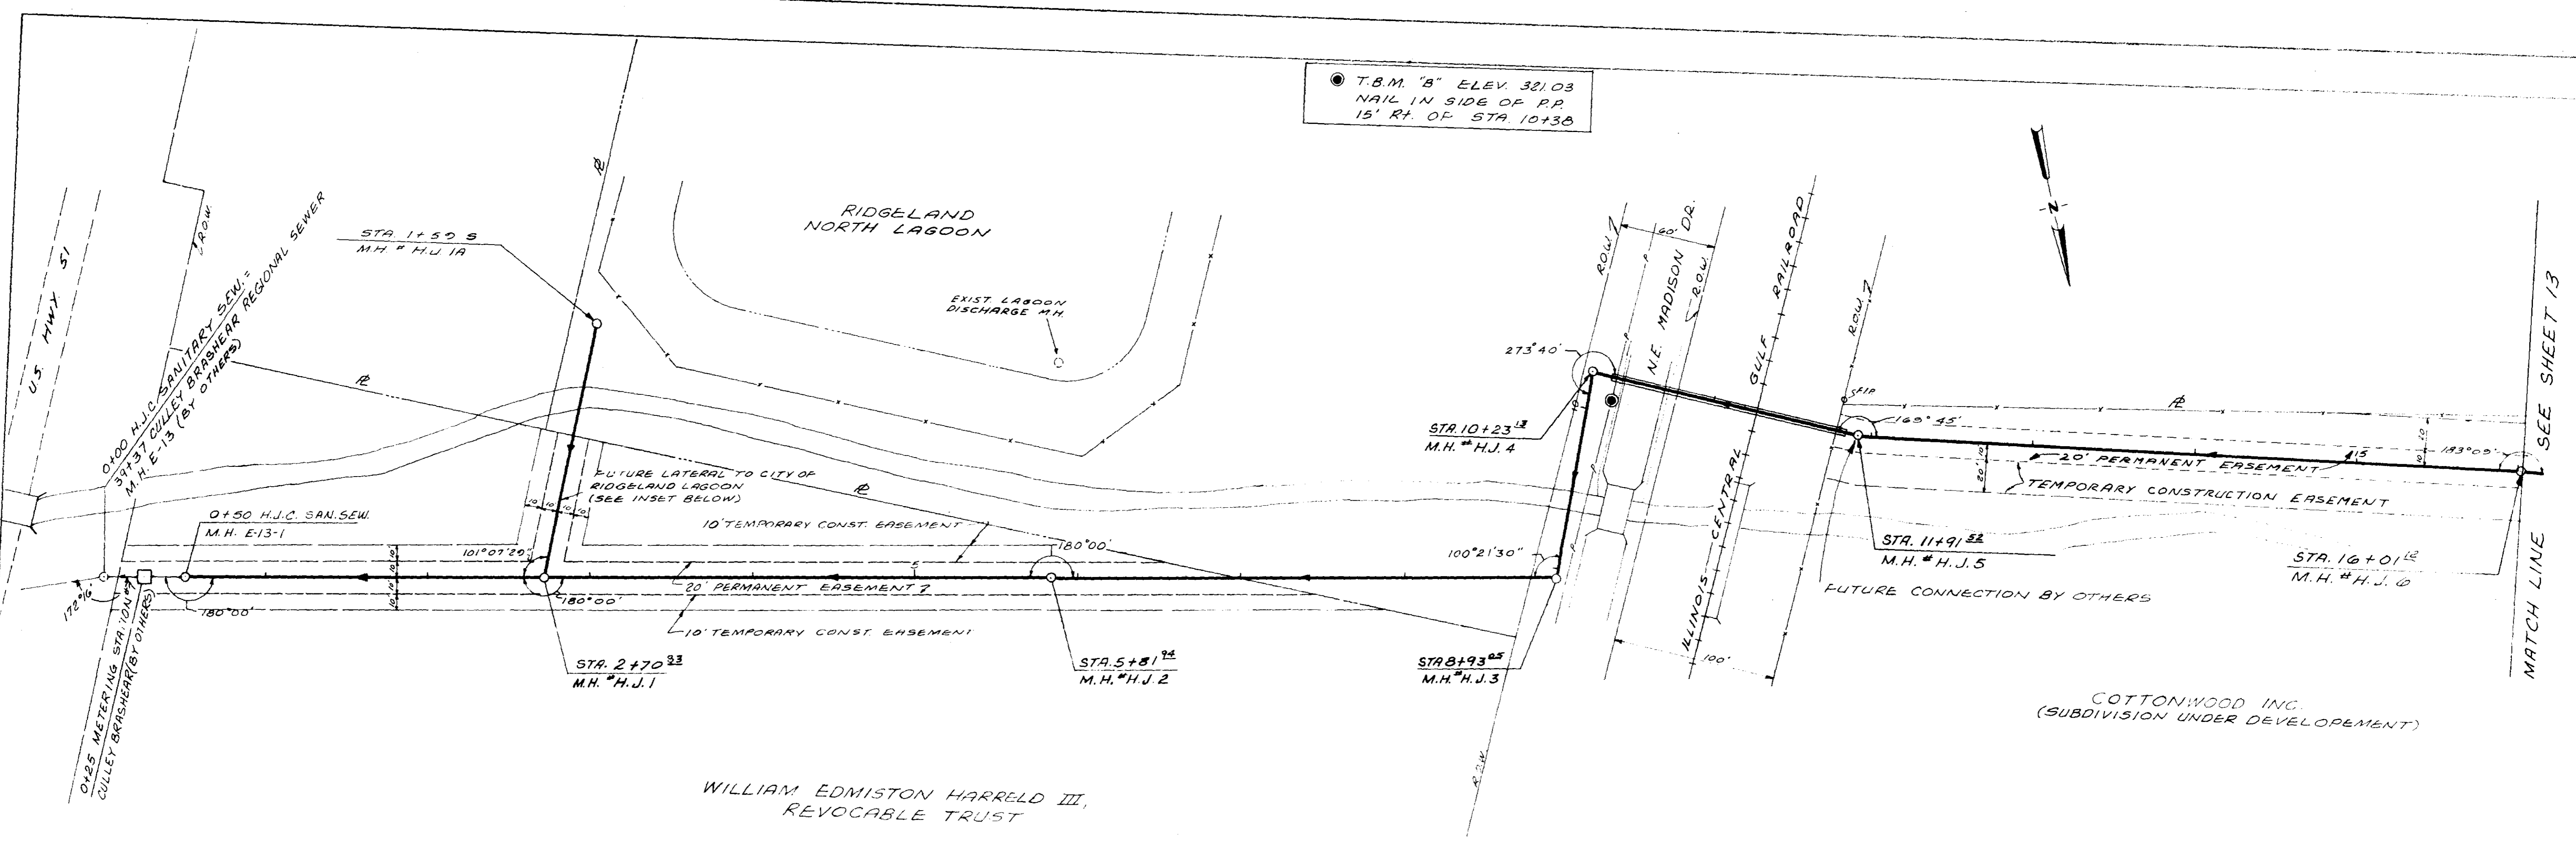

WILLIAM EDMISTON HARRELD III,
 REVOCABLE TRUST

PROFILE	DATE
BY	
NO.	
NO.	
NO.	

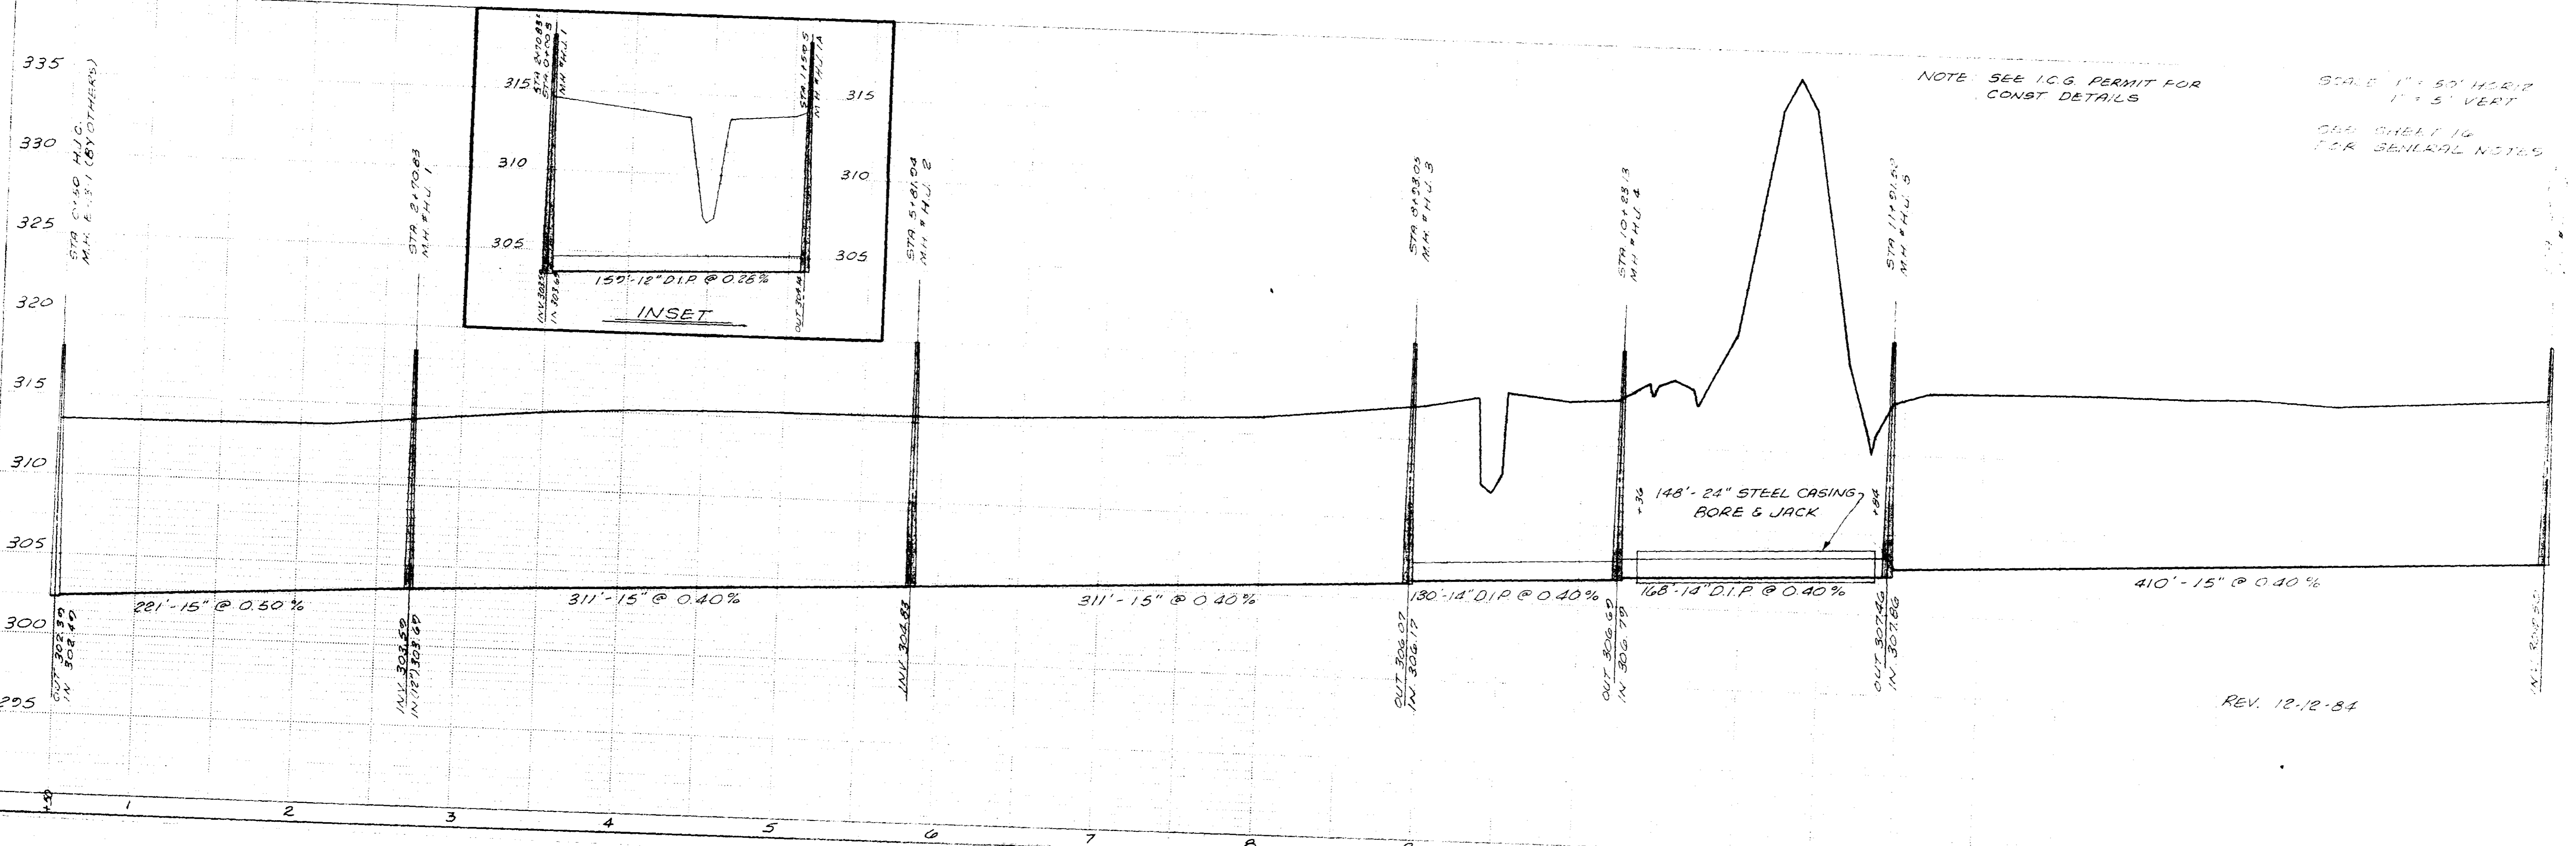


NOTE SEE I.C.G. PERMIT FOR
 CONST. DETAILS

SCALE 1" = 50' HORIZ
 1" = 5' VERT
 SEE SHEET 14
 FOR GENERAL NOTES


REV. 12-12-84

PLATE 1-SINGLE PLAN AND PROFILE JUL 80

● T.B.M. "D" ELEV. 326.23
 NAIL IN SIDE OF 18" HACKBERRY
 25' RT. OF STA. 26+82.1

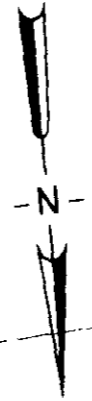

PLAN	DATE
NO.	
BY	
DATE	
NO.	
BY	
DATE	
NO.	
BY	
DATE	

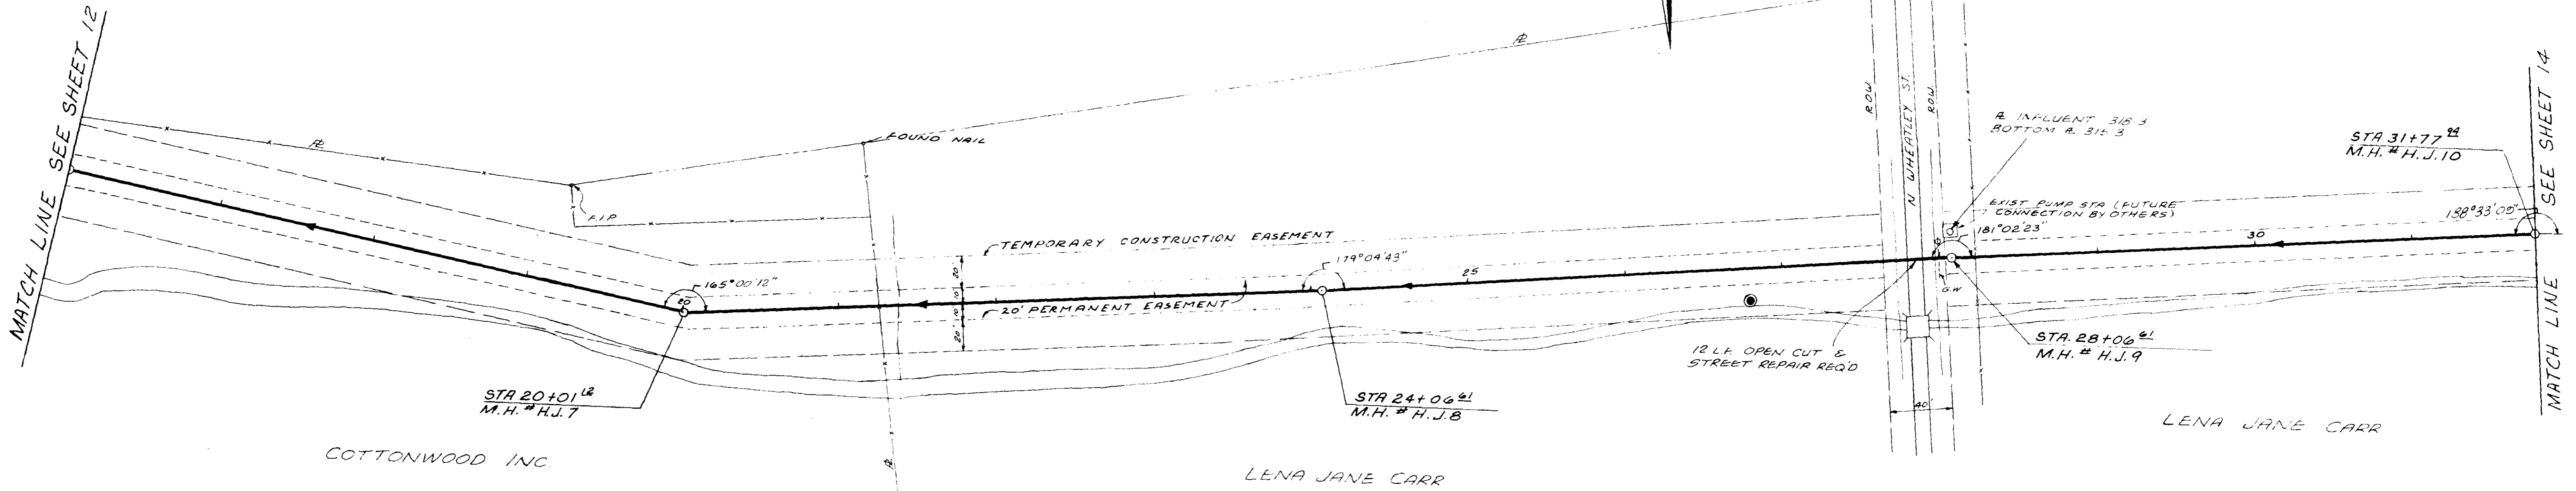

PROFILE	DATE
NO.	
BY	
DATE	
NO.	
BY	
DATE	
NO.	
BY	
DATE	


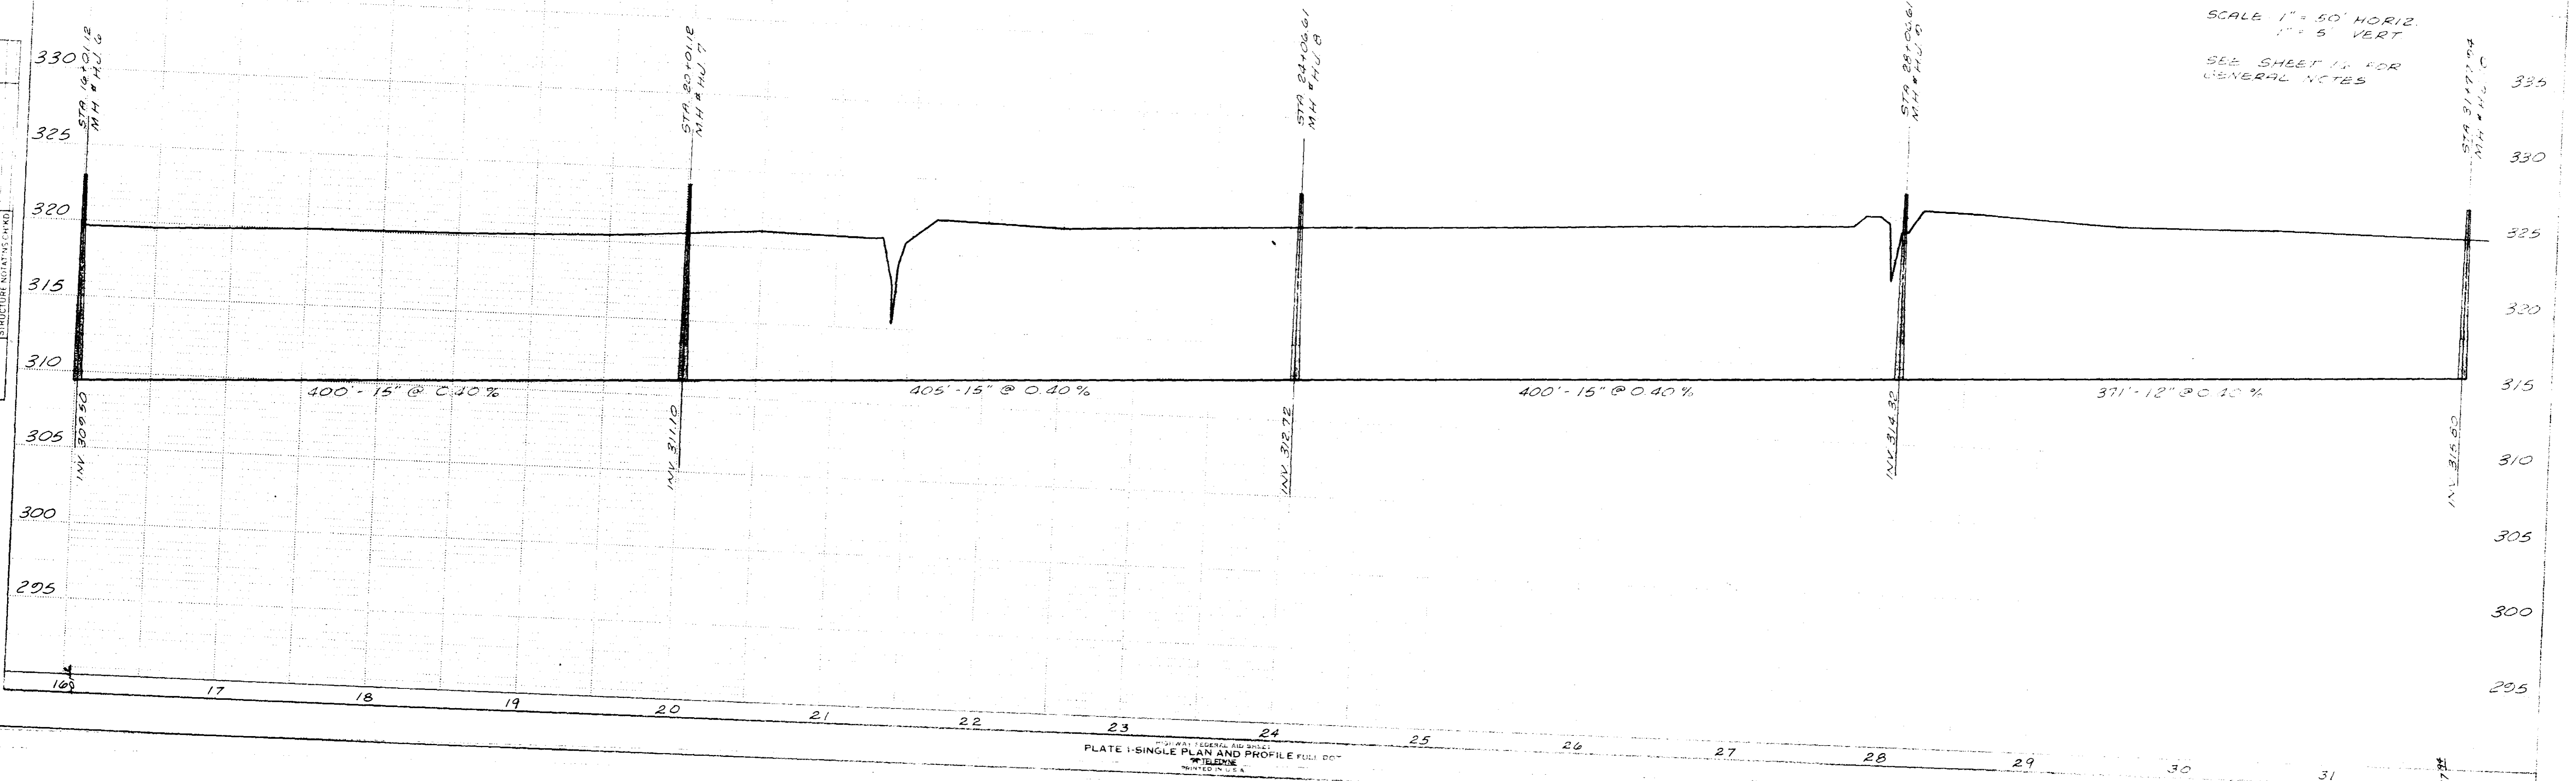


PLATE 1-SINGLE PLAN AND PROFILE FULL DOT
 1/2" = 1' HORIZ. 1/8" = 1' VERT.
 PRINTED IN U.S.A.


● T.B.M. "E" ELEV 328.50
 NAIL IN SIDE OF 8" HACKBERRY
 35' RT. OF STA. 36+25.2

● T.B.M. "F" ELEV 330.02
 NAIL IN SIDE OF P.P. AT
 N.E. CORNER OF COLLEGE SITE

PLAN	DATE
BY	
REVISIONS:	
NO.	DESCRIPTION
1	ALIGNMENT CHECKED
2	BY WAY CHECKED
3	
4	
5	
6	
7	
8	
9	
10	

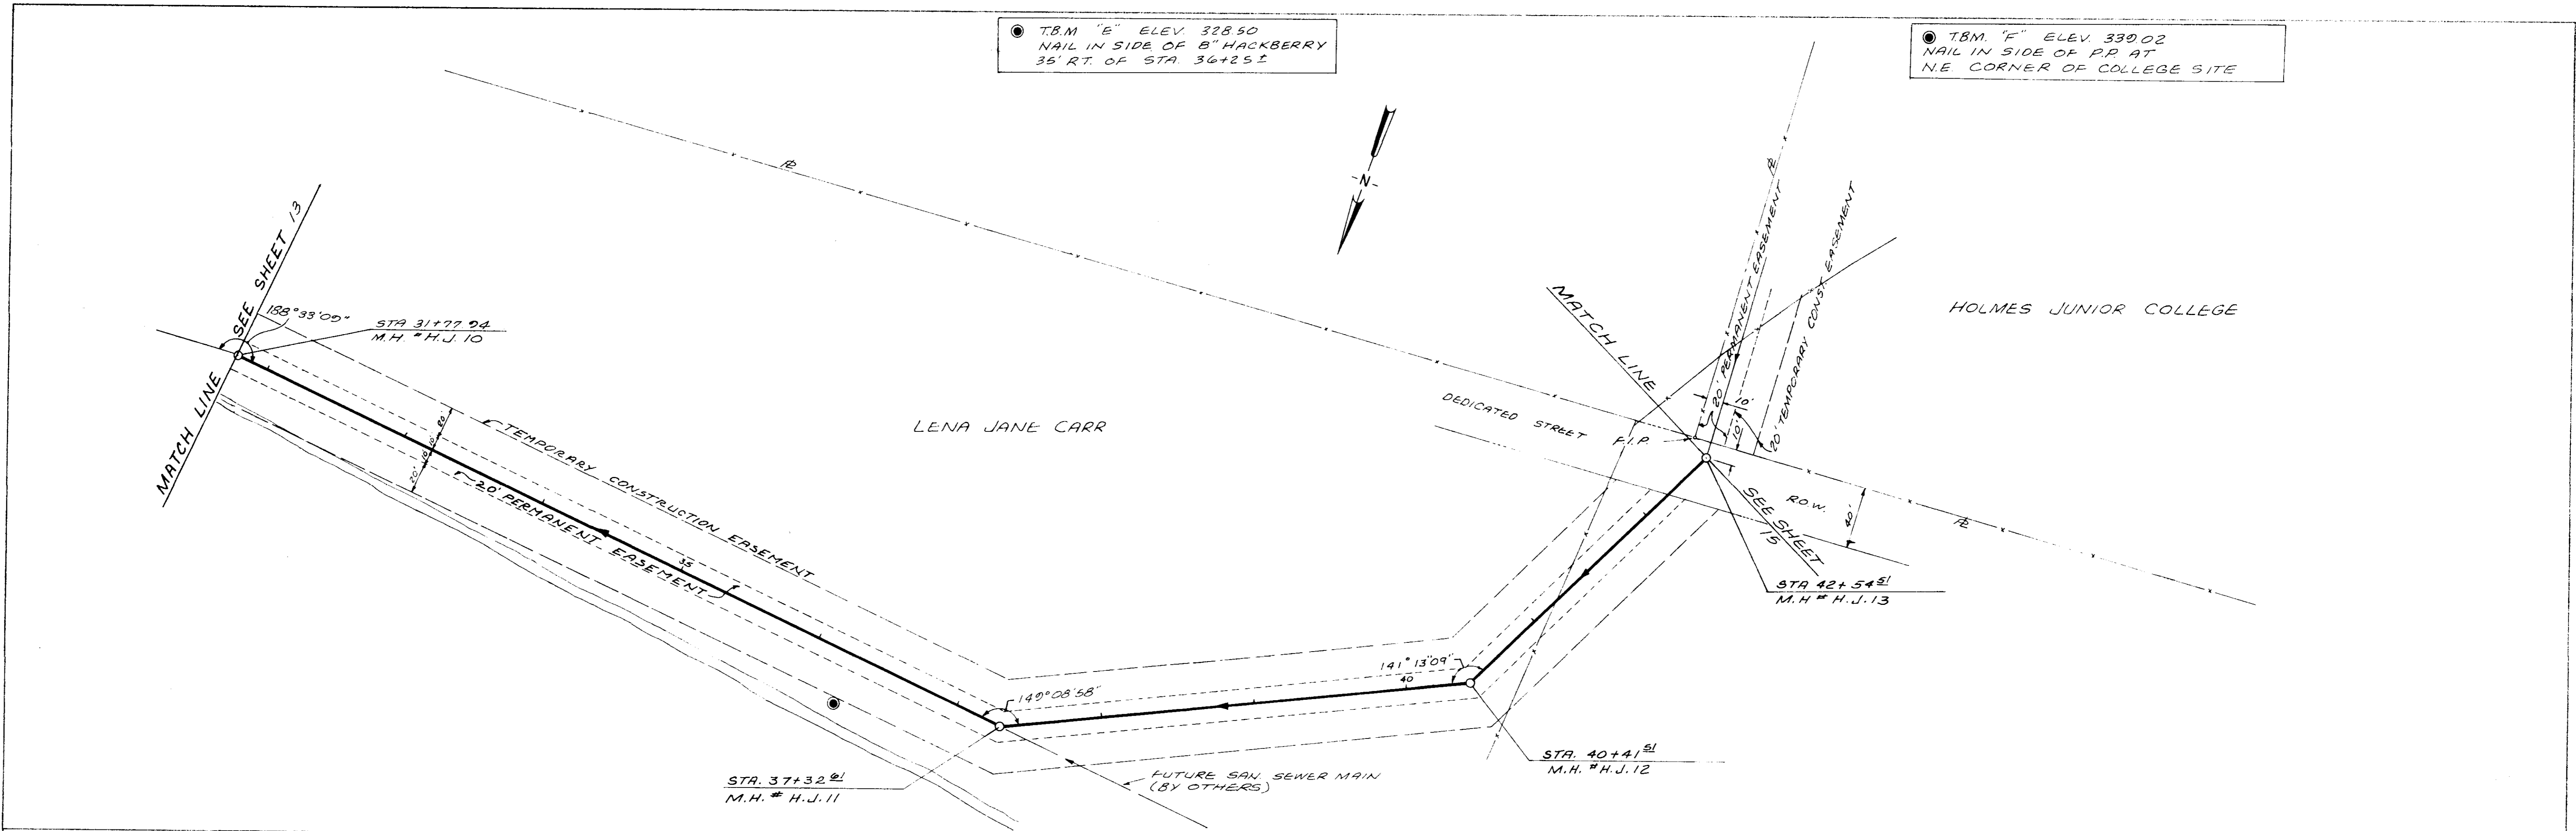

PROFILE	DATE
BY	
REVISIONS:	
NO.	DESCRIPTION
1	GRADES CHECKED
2	BY M.S. NOTED
3	STRUCTURE NOTATIONS
4	
5	
6	
7	
8	
9	
10	

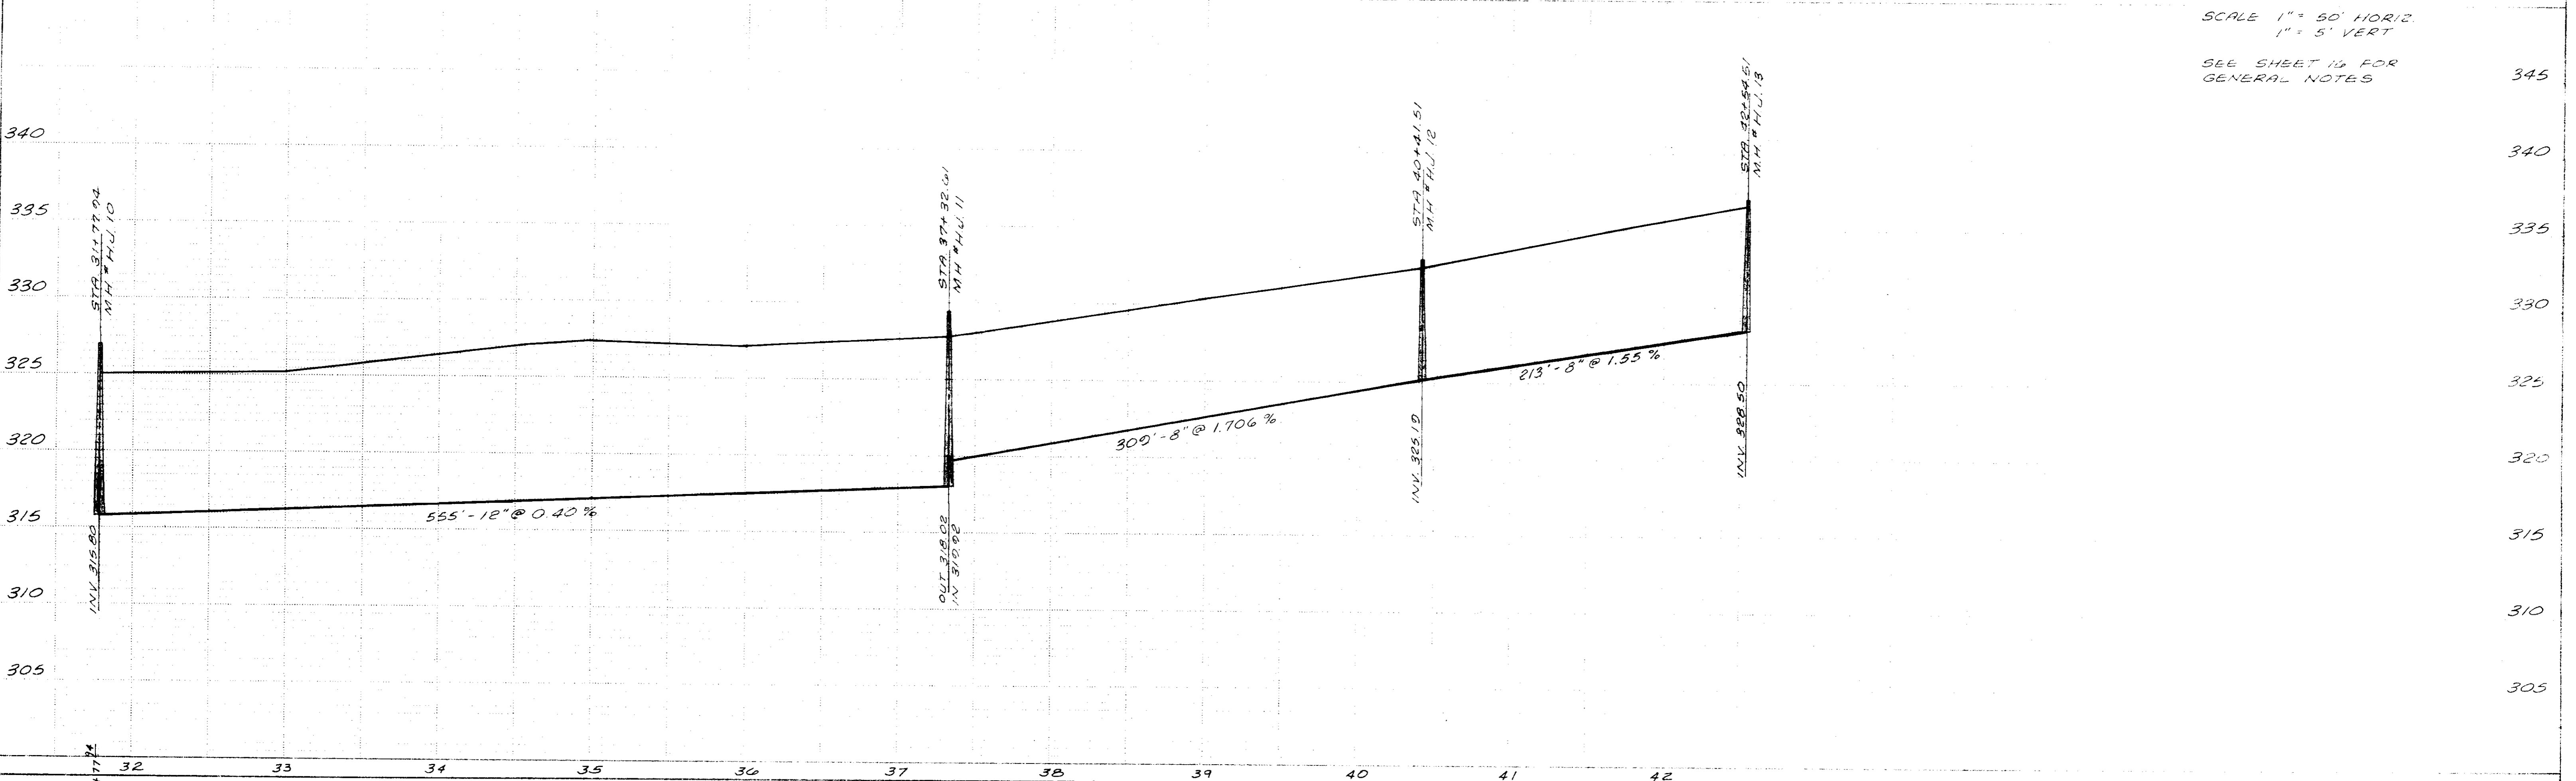


SCALE 1" = 50' HORIZ
 1" = 5' VERT
 SEE SHEET 13 FOR
 GENERAL NOTES


PLATE 1-SINGLE PLAN AND PROFILE FULL DOT
 TELEPHONE
 PRINTED IN U.S.A.

CH 210 Improvement
Holmes Jr College

PLAN	SURVEYED	DATE
	PLOTTED	BY
	ALIGNED	CHECKED
	BY	NO.
	STRUCTURE	NO.
	NOTES	NO.

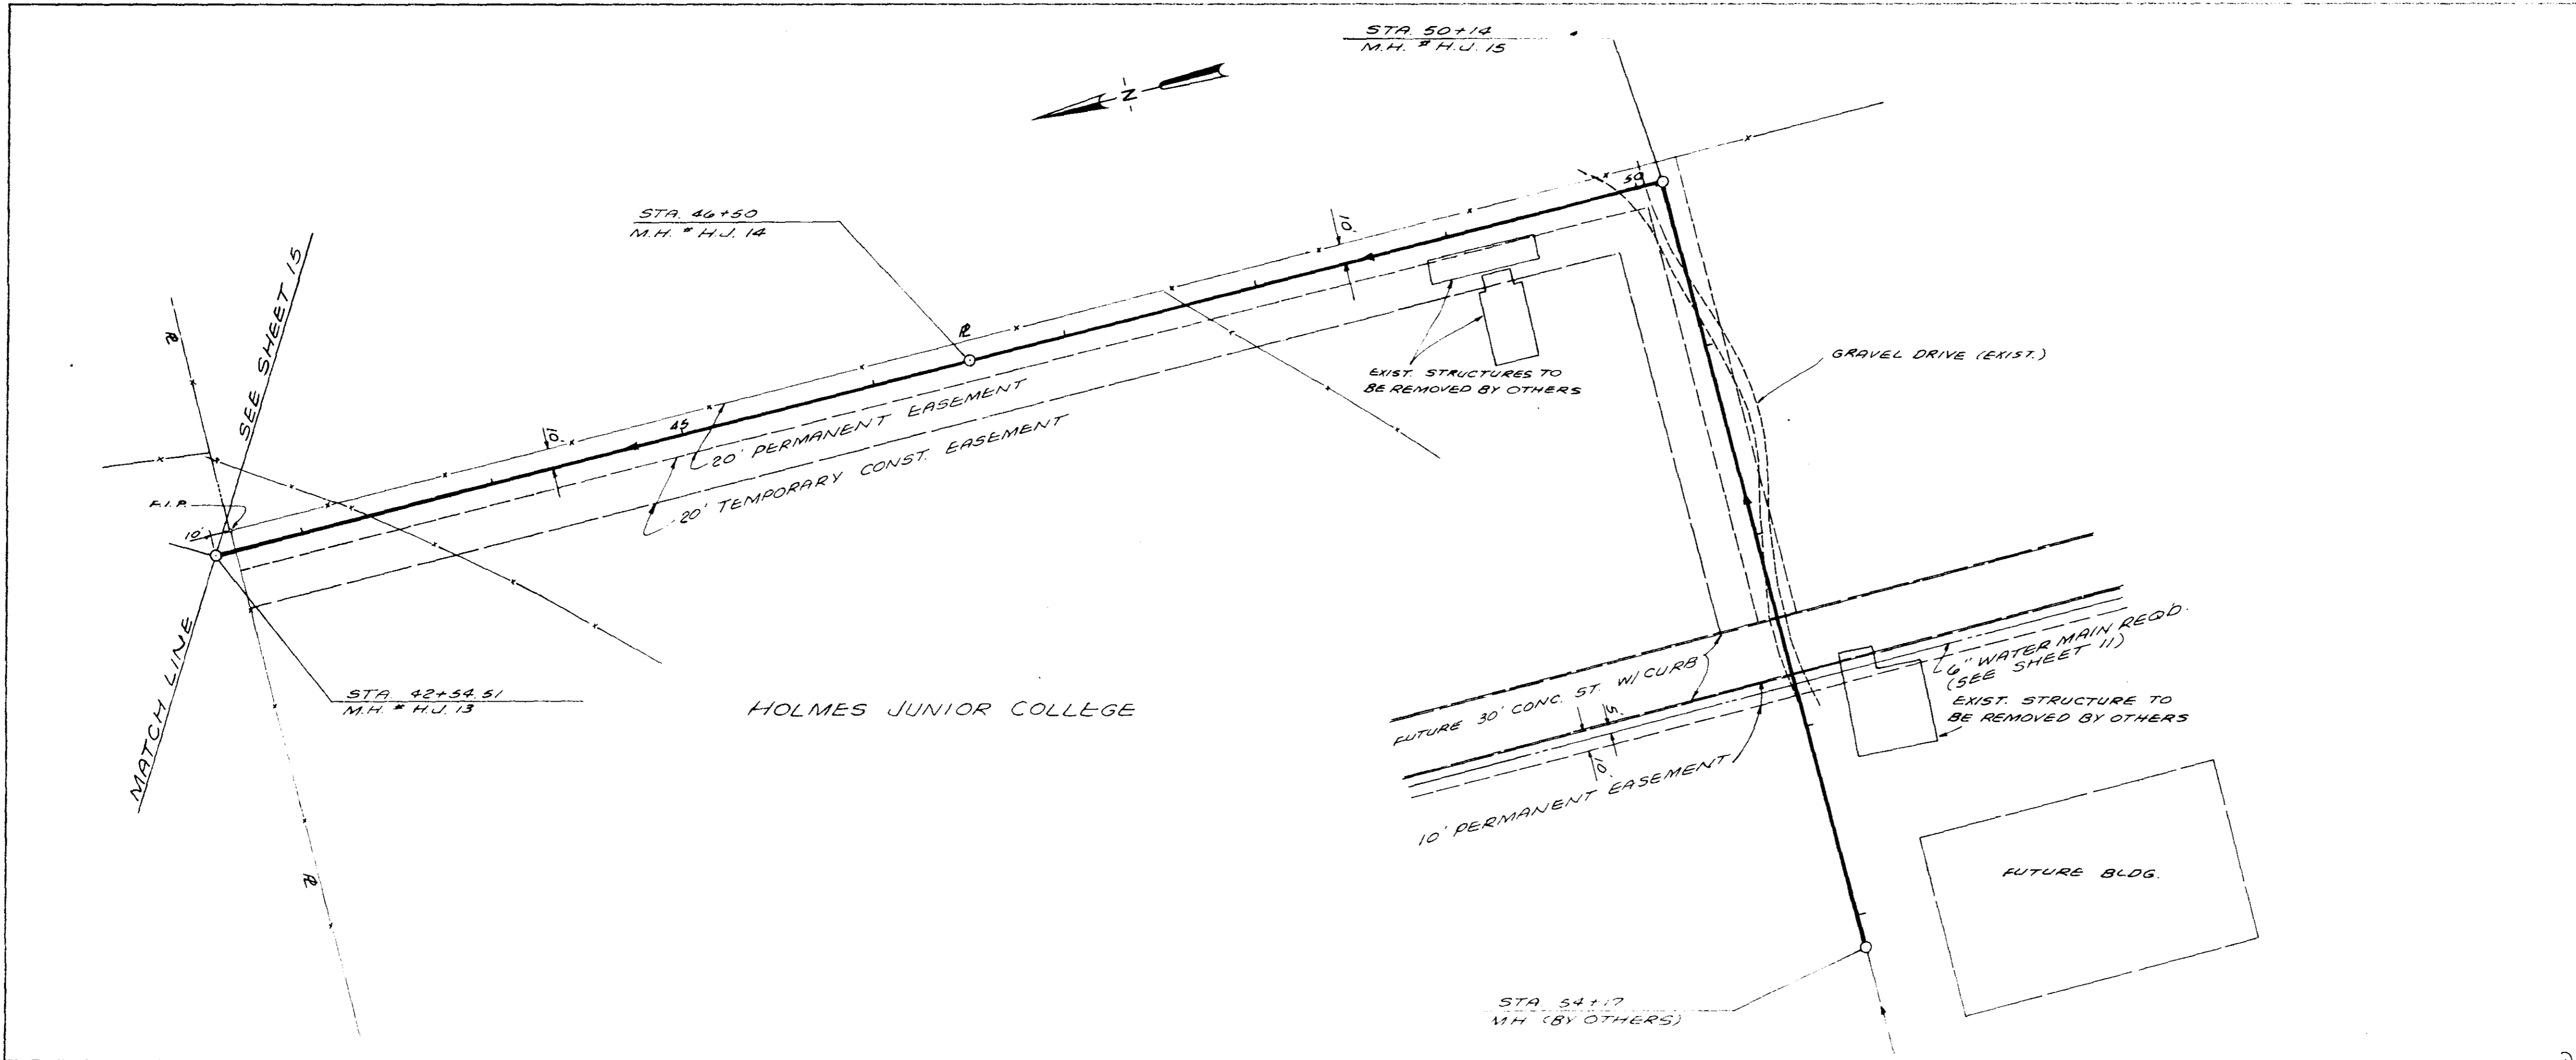

PROFILE	SURVEYED	DATE
	PLOTTED	BY
	ALIGNED	CHECKED
	BY	NO.
	STRUCTURE	NO.
	NOTES	NO.

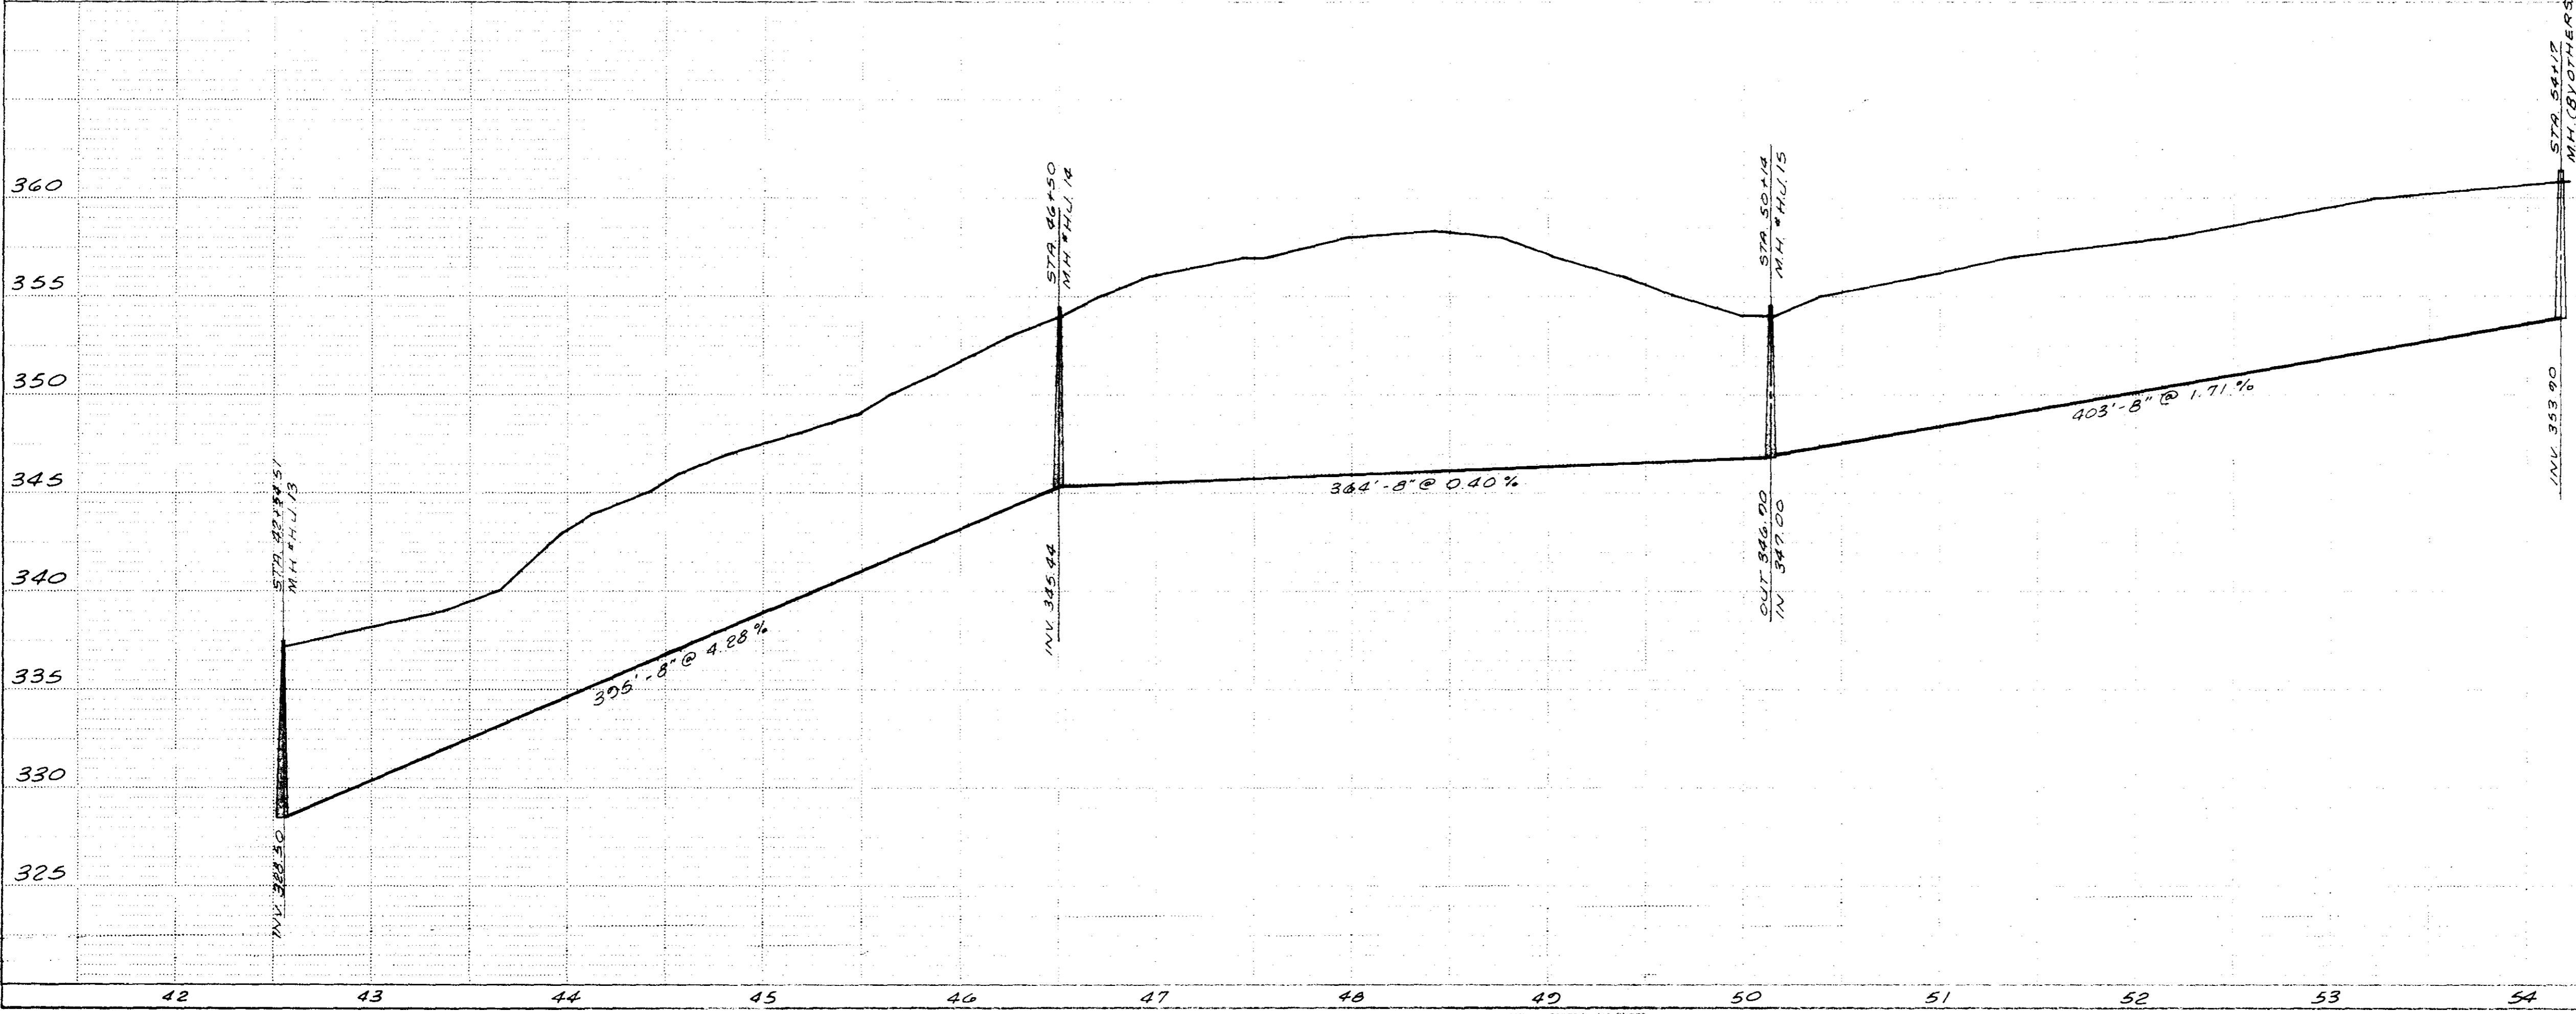

SCALE 1" = 50' HORIZ
1" = 5'
SEE SHEET 16 FOR
GENERAL NOTES