

CITY OF RIDGELAND, MISSISSIPPI

LAKE HARBOUR DRIVE

ROADWAY CONSTRUCTION PLANS

PHASE I (WHEATLEY STREET TO PEAR ORCHARD ROAD)

PHASE II (U.S. HIGHWAY NO. 51 TO WHEATLEY STREET)

Σ CHRISTINE DRIVE

Mayor:


Gene F. McGee

Mayor Pro Tem:

Harvey Carr, Jr.

City Attorney:

Jerry Mills

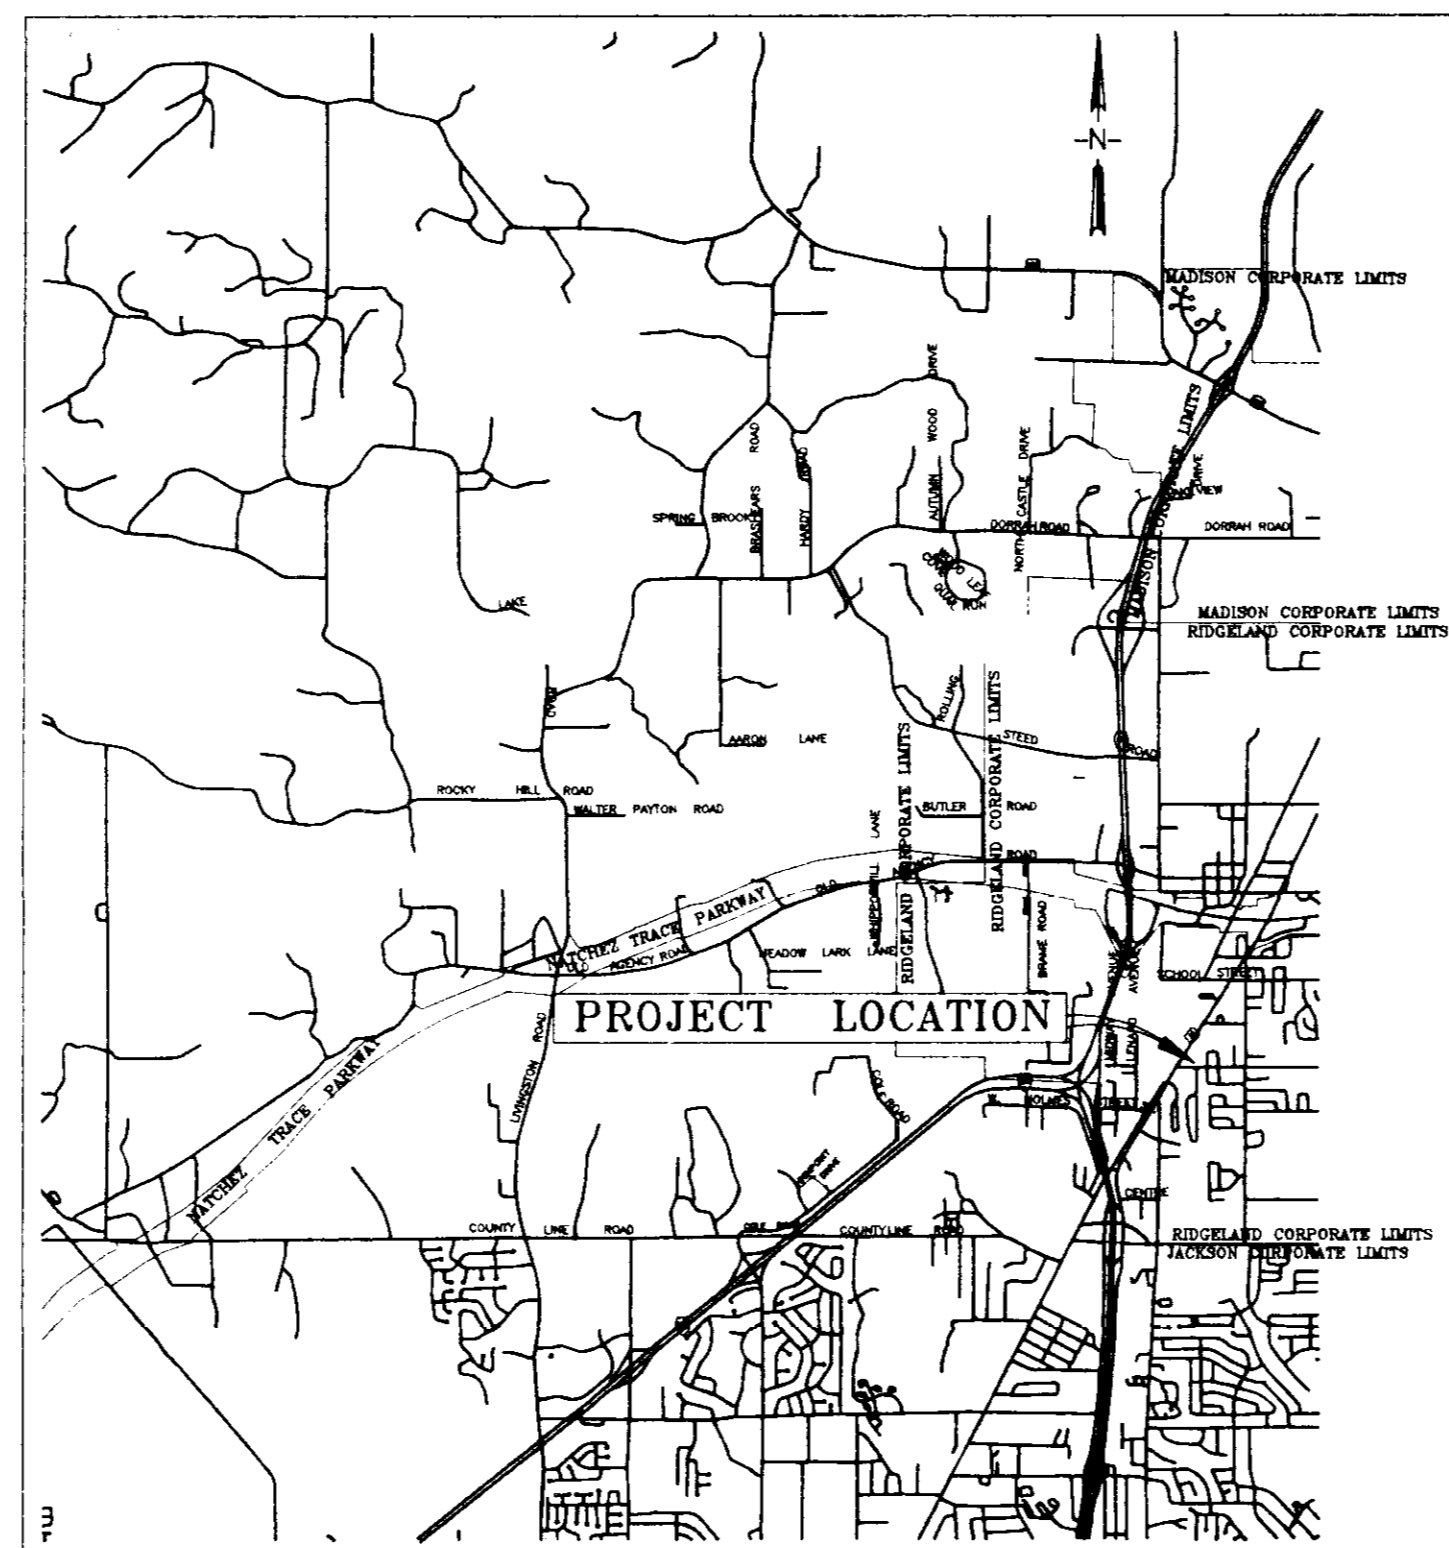

VICINITY MAP

Aldermen:

Brian Barcellona

Al Bible

Harvey Carr, Jr.

Linda Davis

Daryl Smith

Public Works Director:

Sam Vinson

City Clerk:

Micheal McPhearson

RECORD DRAWING

JUNE - 1993

JULY, 1990

WAGGONER ENGINEERING, INC.

Consulting Engineers

Jackson, Mississippi





PWP-01206

W.E.I. JOB NO.
90-046
90-047


TBM ELEV 335.54
CHISELED SQUARE ON SW
CORNER CONC. WALK AT
HOUSE # 132
LAKE HARBOUR DRIVE

TBM ELEV 318.83
PK NAIL IN CL STREET

- NOTE:
1. CONTRACTOR SHALL COORDINATE WITH THE CITY OF RIDGELAND AND NOTIFY PROPERTY OWNERS OF SCHEDULE AND EXTENT OF WORK TO BE PERFORMED ON THEIR PROPERTY.
 2. CONTRACTOR SHALL TAKE SPECIAL PRECAUTIONS IN ORDER TO AVOID DAMAGE TO TREES, SHRUBS, ETC. THAT ARE TO REMAIN. PLANT MATERIALS DAMAGED OR DESTROYED SHALL BE REPLACED AT CONTRACTORS EXPENSE.
 3. CONTRACTOR SHALL NOTIFY ENGINEER WHEN CURB GRADES ARE STARTED AND PRIOR TO PLACING CURB AND GUTTER.
 4. CONTRACTOR SHALL NOTIFY ENGINEER PRIOR TO REMOVAL OF EXISTING STREET BETWEEN STATION 12+30 AND 13+00.
 5. CONTRACTOR SHALL GRADE LOTS TO DRAIN TO THE NEW STREET AND SHALL BACKFILL BEHIND NEW CURB AND GUTTER WITH TOPSOIL AND REPLACE GRASS WITH SOLID SOD TO MATCH EXISTING TYPE.

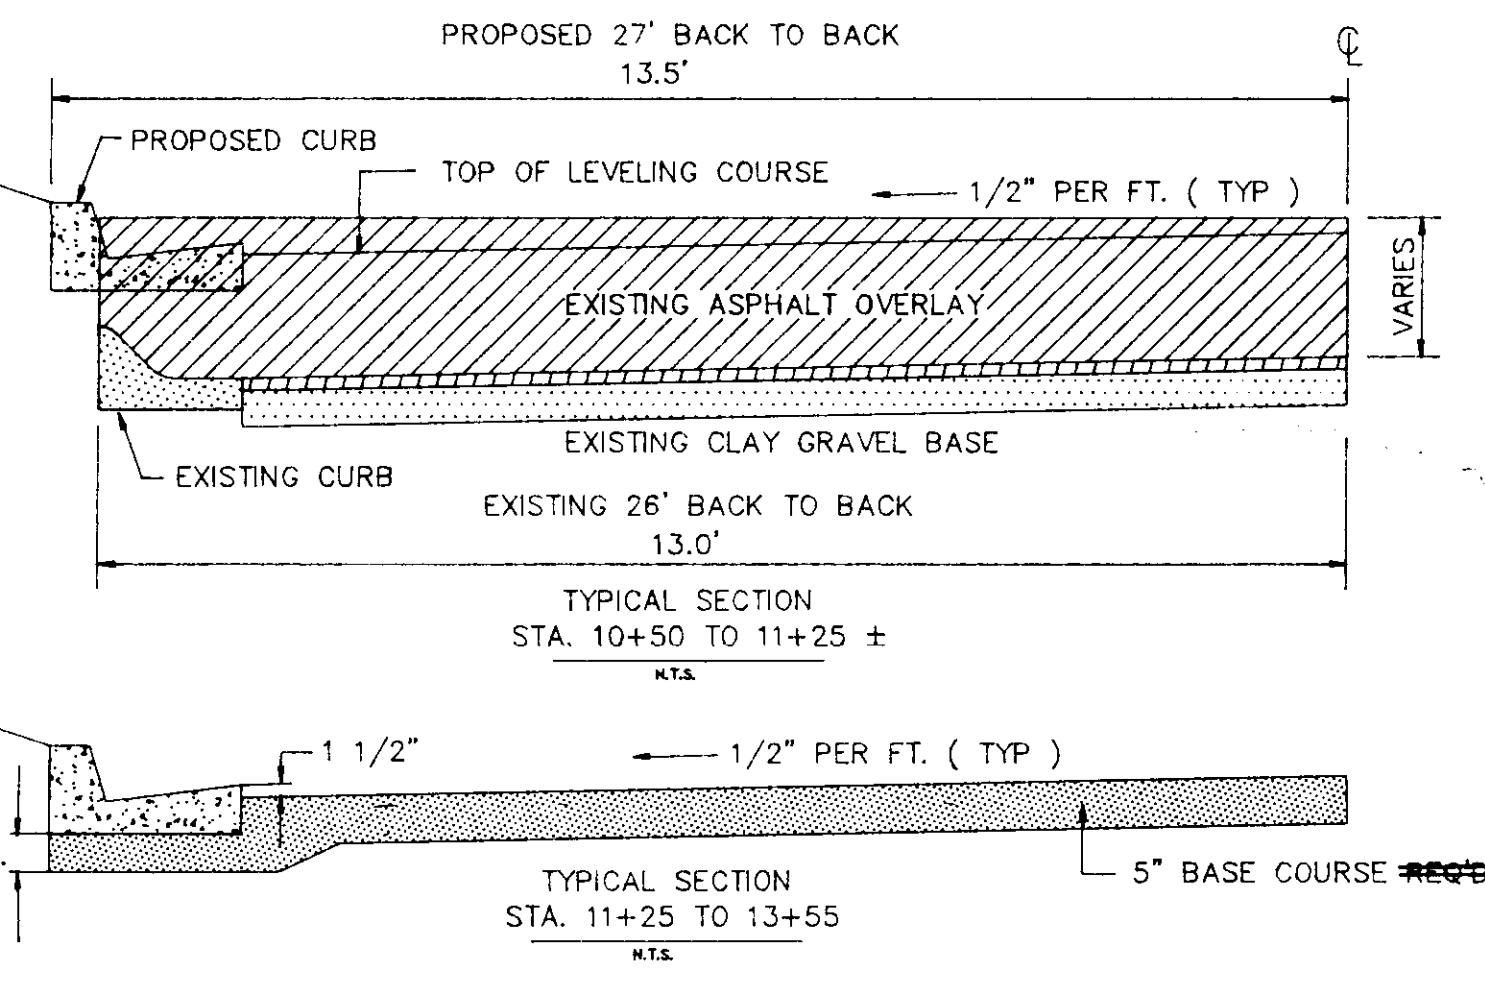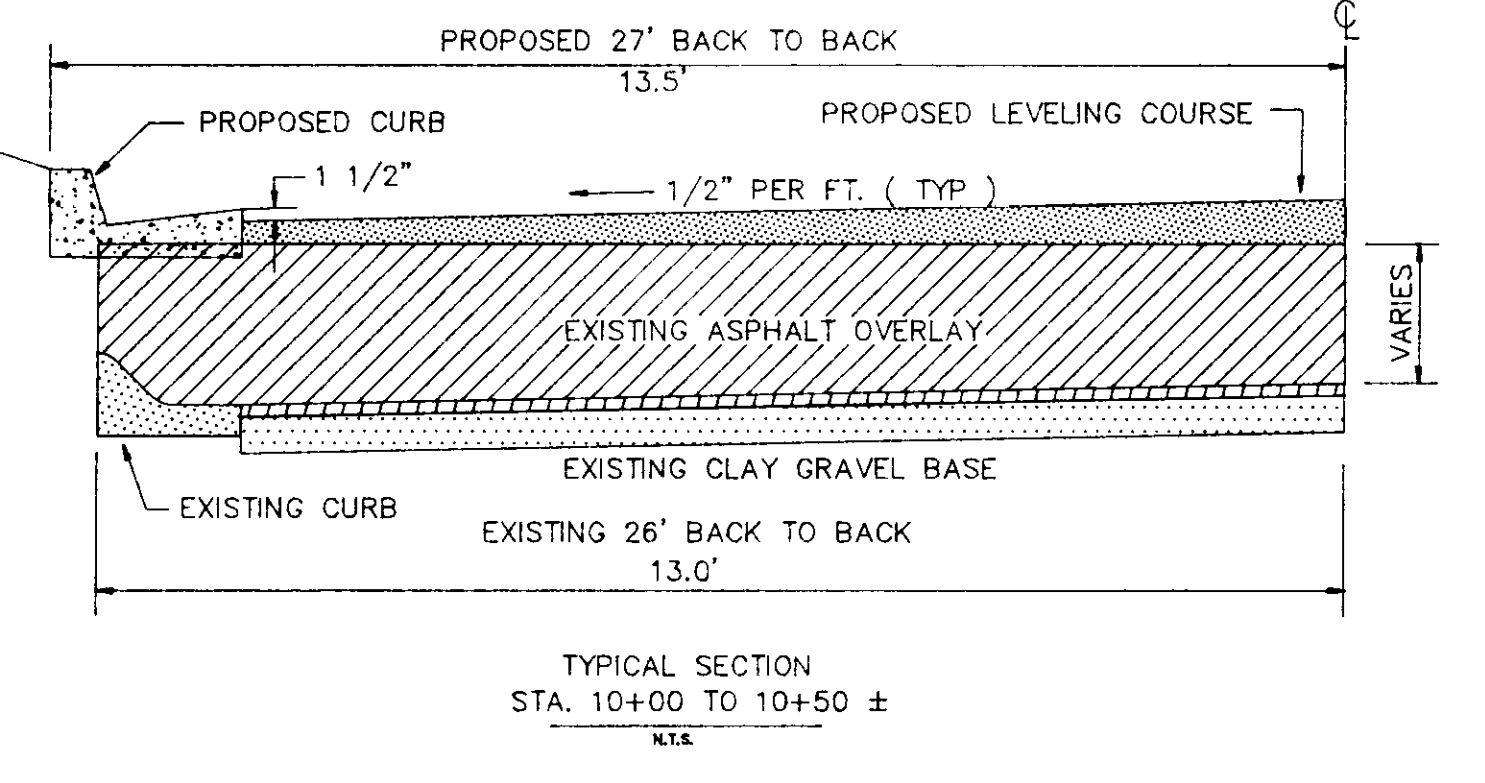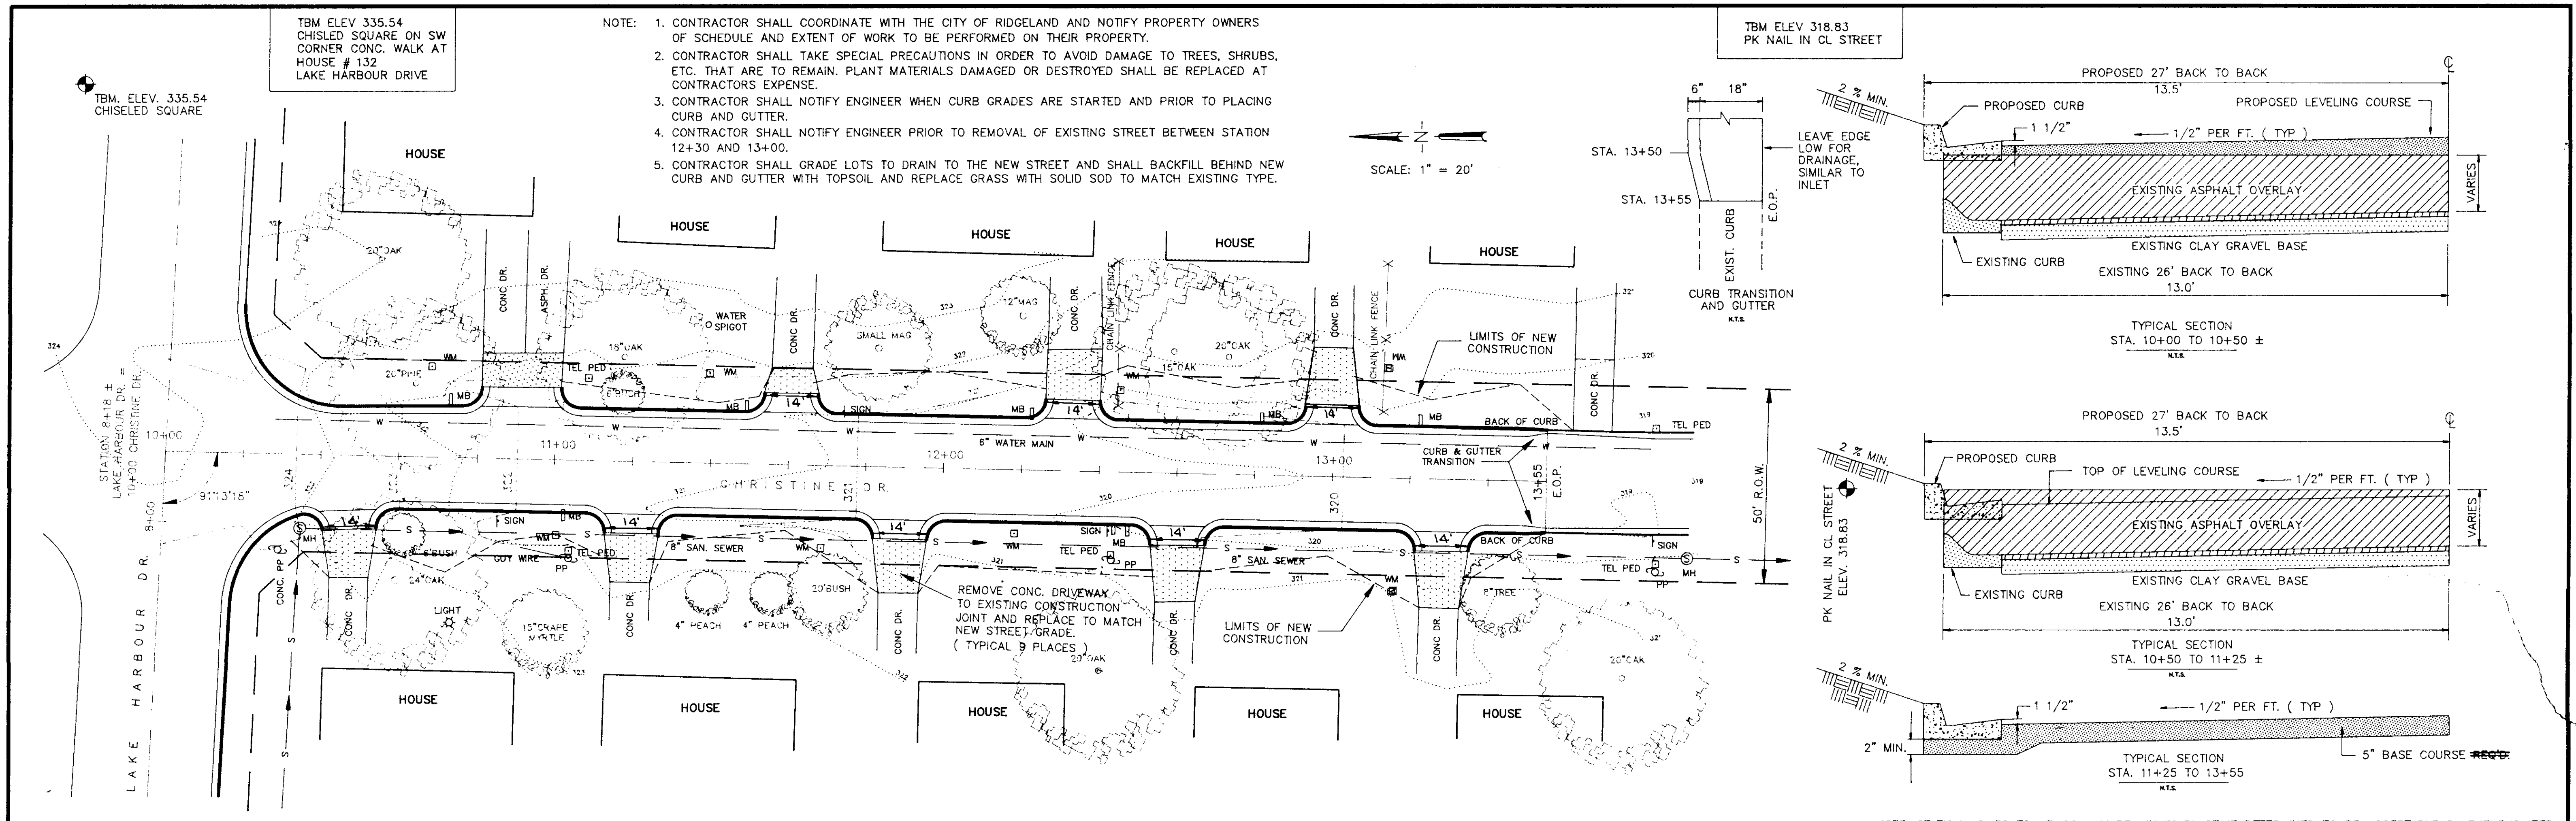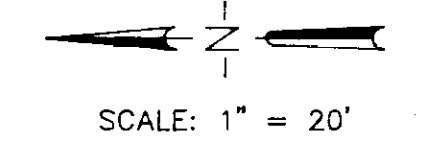

NOTE: STATION 12+30 TO 13+00 MAY REMAIN IN PLACE IF DETERMINED TO BE ACCEPTABLE BY THE ENGINEER.

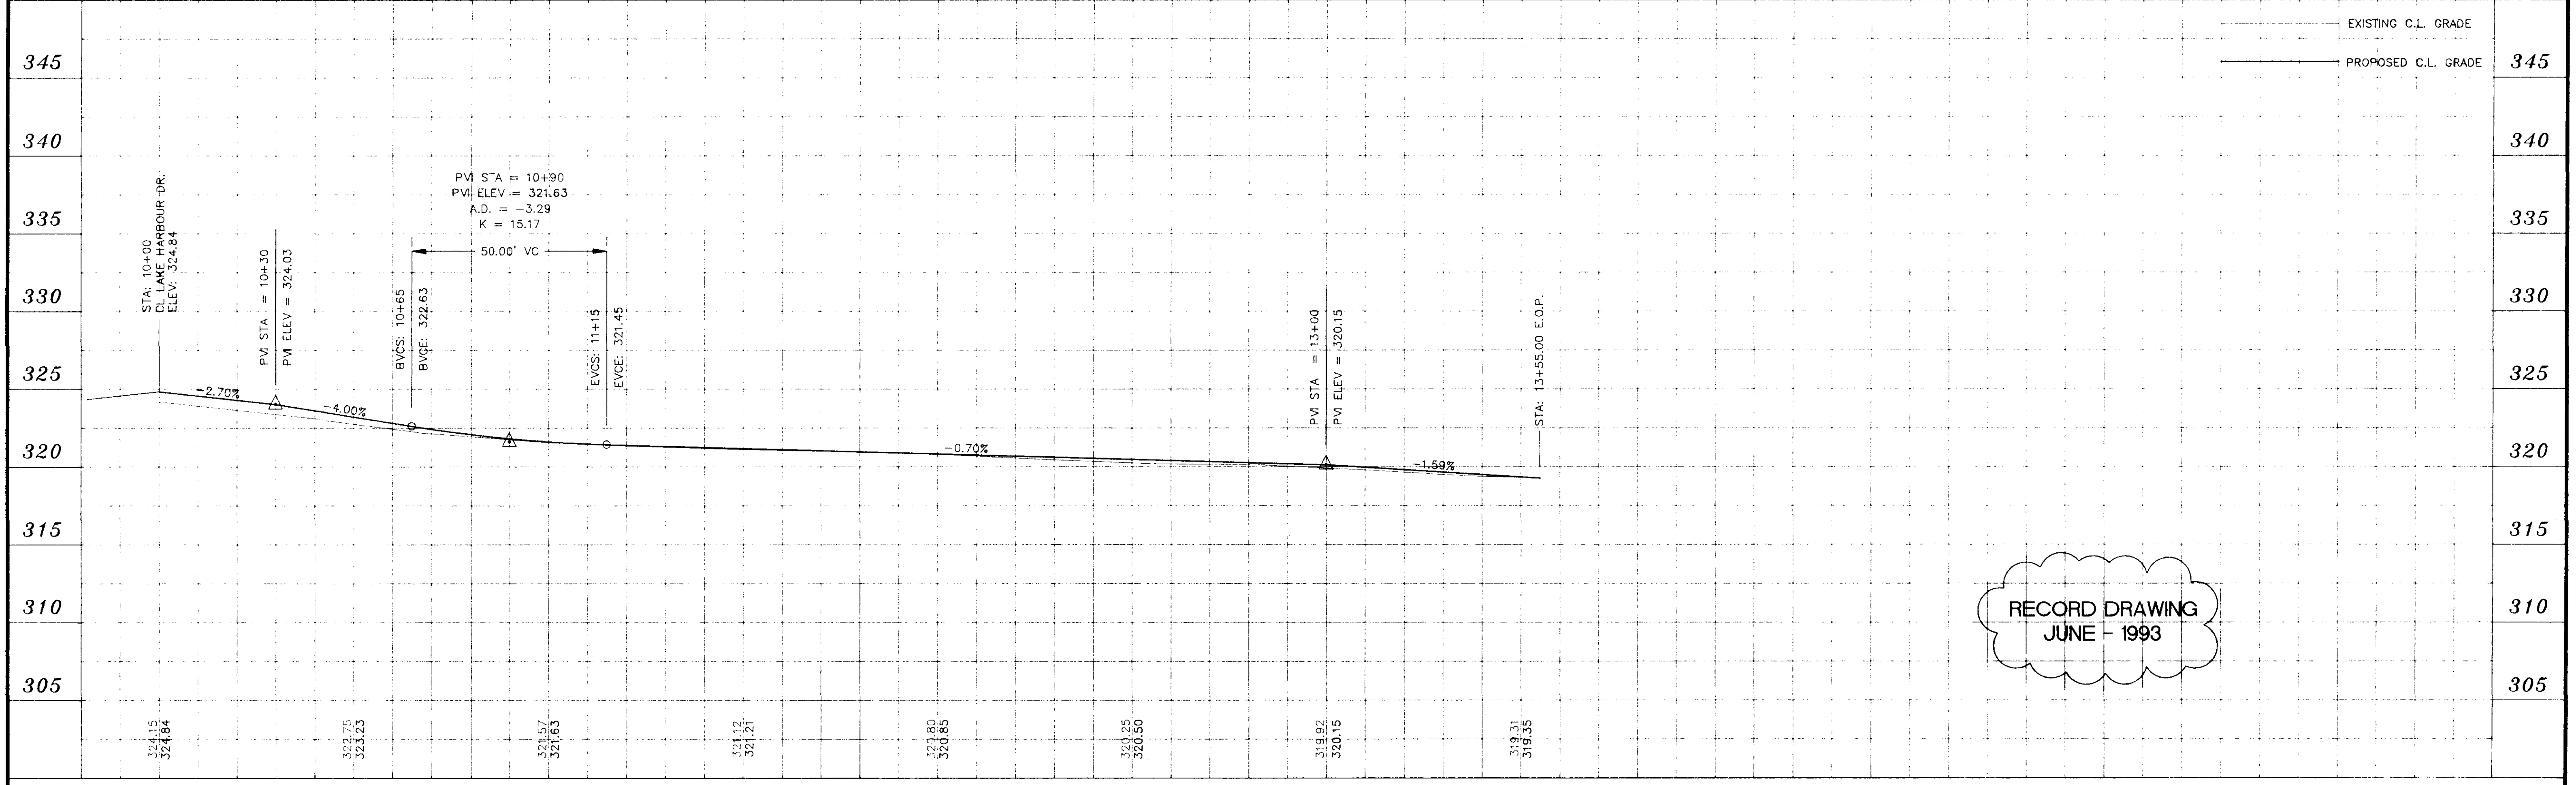


RECORD DRAWING
JUNE - 1993

DESIGNED J.W.P.	DATE 11-92	<p>WAGGONER ENGINEERING INC. CONSULTING ENGINEERS JACKSON, MISSISSIPPI</p>	<p>CITY OF RIDGELAND CHRISTINE DRIVE</p>	<p>ACAD PATH ROUTE 90046 CHRIS(PPR01)</p>	
DRAWN J.W.P.	SCALE 1" = 20' HORIZ 1" = 5' VERT			<p>W.E.I. JOB NO. 90-046</p>	<p>SHEET NO. 1 OF 1</p>
NO. DATE	REVISIONS	BY			


GENERAL CONSTRUCTION NOTES

- The existing utility locations shown on plans are approximate only. The Contractor shall coordinate the location of the existing utilities (power, telephone, gas, water, sewer, etc.) with the appropriate utility company before construction begins.
- Any utility line or service line encountered during construction, whether shown or not, shall be protected by the Contractor and any repairs necessary due to damage to same by the Contractor shall be at no additional cost to the Owner.
- The Contractor shall be responsible for verifying horizontal and vertical clearances on all utility crossings before installation.
- The Contractor shall fertilize and seed all areas where the existing vegetation was removed or disturbed during construction and not required to be sold sodded by the Engineer. The fertilizer shall be applied and seeding shall be completed in accordance with these specifications. Where required by the Engineer, solid sodding shall be the same type grass as existed prior to disturbance.
- Unsuitable bedding, backfill or roadway subgrade material which may be encountered shall be excavated to the limits directed by the Engineer and backfilled with approved material to the lines and grades shown on the plans.
- The Contractor shall maintain local traffic to all residences and businesses fronting along the project for the duration of the work.
- Any TBM's indicated on plans which are or may be in conflict with construction activities will be relocated by Engineer prior to commencement of construction in the immediate area.
- All detailed construction staking will be by Engineer - one time only. Maintenance or replacement of staking subsequently shall be the responsibility of the Contractor.
- Engineer will provide off-set hubs for curb and gutter, centerline hubs, off-set hubs for inlets and manholes, off-set grade stakes and cut sheets for all storm and sanitary sewer lines, manholes, junction boxes and specials.
- All sanitary sewer manhole castings and storm manhole castings shall be traffic duty type unless noted otherwise.
- The Contractor shall be responsible for completing all sampling and testing of materials, and for submission of same to Engineer for approval prior to their use. This shall include select backfill, concrete, asphalt, aggregates and other items as specified by the Engineer. This prior use testing shall be an absorbed item.
- The Contractor shall obtain and furnish to the Engineer copies of manufacturers certifications for all sewer piping, storm culverts, castings, specials and seed. Such certification shall state that the subject material meets the specified quality, grade, purity, class or weight, or that the subject material meets or exceeds the requirements of the applicable ASTM, AASHTO, or other standards. Certifications shall be submitted to and reviewed by the Engineer prior to incorporation of the subject material into the project.
- The Contractor shall verify the invert elevations of existing sanitary sewer mains to be adjusted or incorporated into the work prior to initiation of construction of any new lines connecting thereto. Any variations from plan grades shall be reported to the Engineer.
- All ductile iron pipe utilized in gravity mains is to be polyethylene lined and wrapped.
- All pipe fittings except where otherwise specifically indicated in the plans are to be mechanical joints cast on ductile iron, cement lined and polywrapped.
- The Contractor shall repair any existing fence damaged, removed or disturbed during construction. The fence shall be restored to its original condition or better.

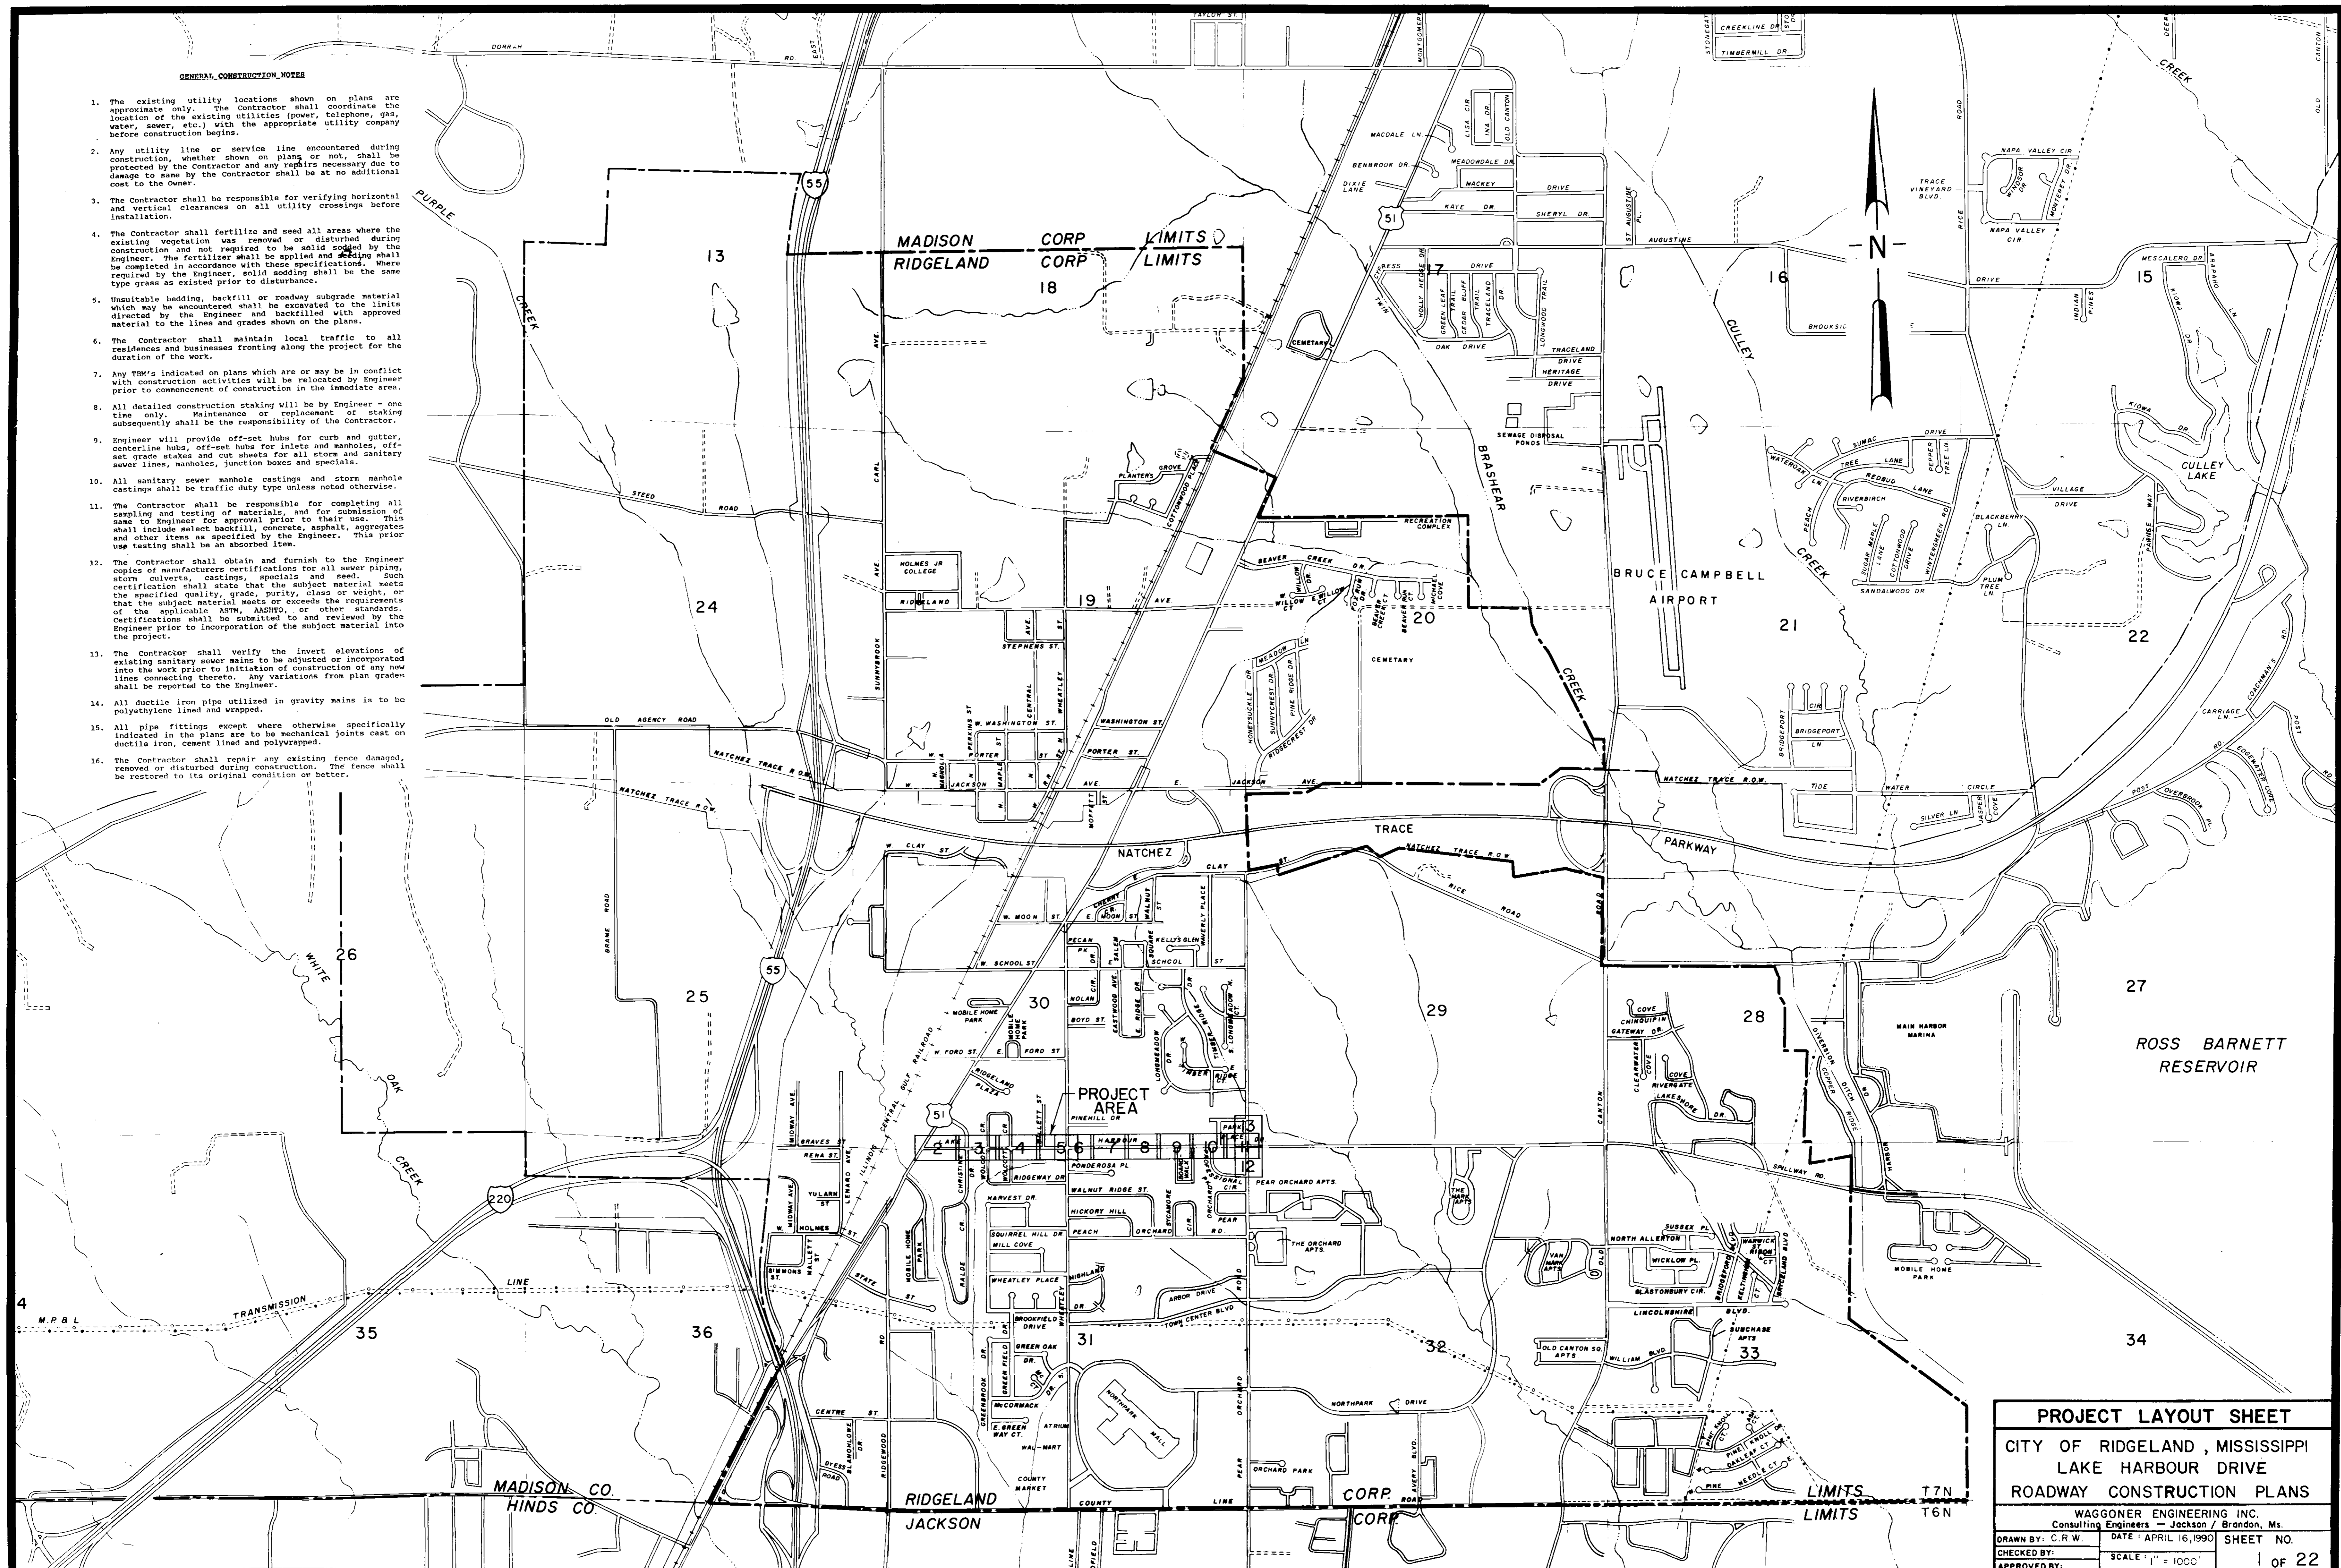


PROJECT LAYOUT SHEET			
CITY OF RIDGELAND, MISSISSIPPI			
LAKE HARBOUR DRIVE			
ROADWAY CONSTRUCTION PLANS			
WAGGONER ENGINEERING INC.			
Consulting Engineers - Jackson / Brandon, Ms.			
DRAWN BY: C.R.W.	DATE: APRIL 16, 1990	SHEET NO.	
CHECKED BY:	SCALE: 1" = 1000'	1 OF 22	
APPROVED BY:			

NO.	DATE	REVISION	BY
1	10-2-90	CHANGE DRIVEWAY	C.R.H.
2	2-20-92	ADDED SAN SEWER & REVISED DRIVEWAY	MAL

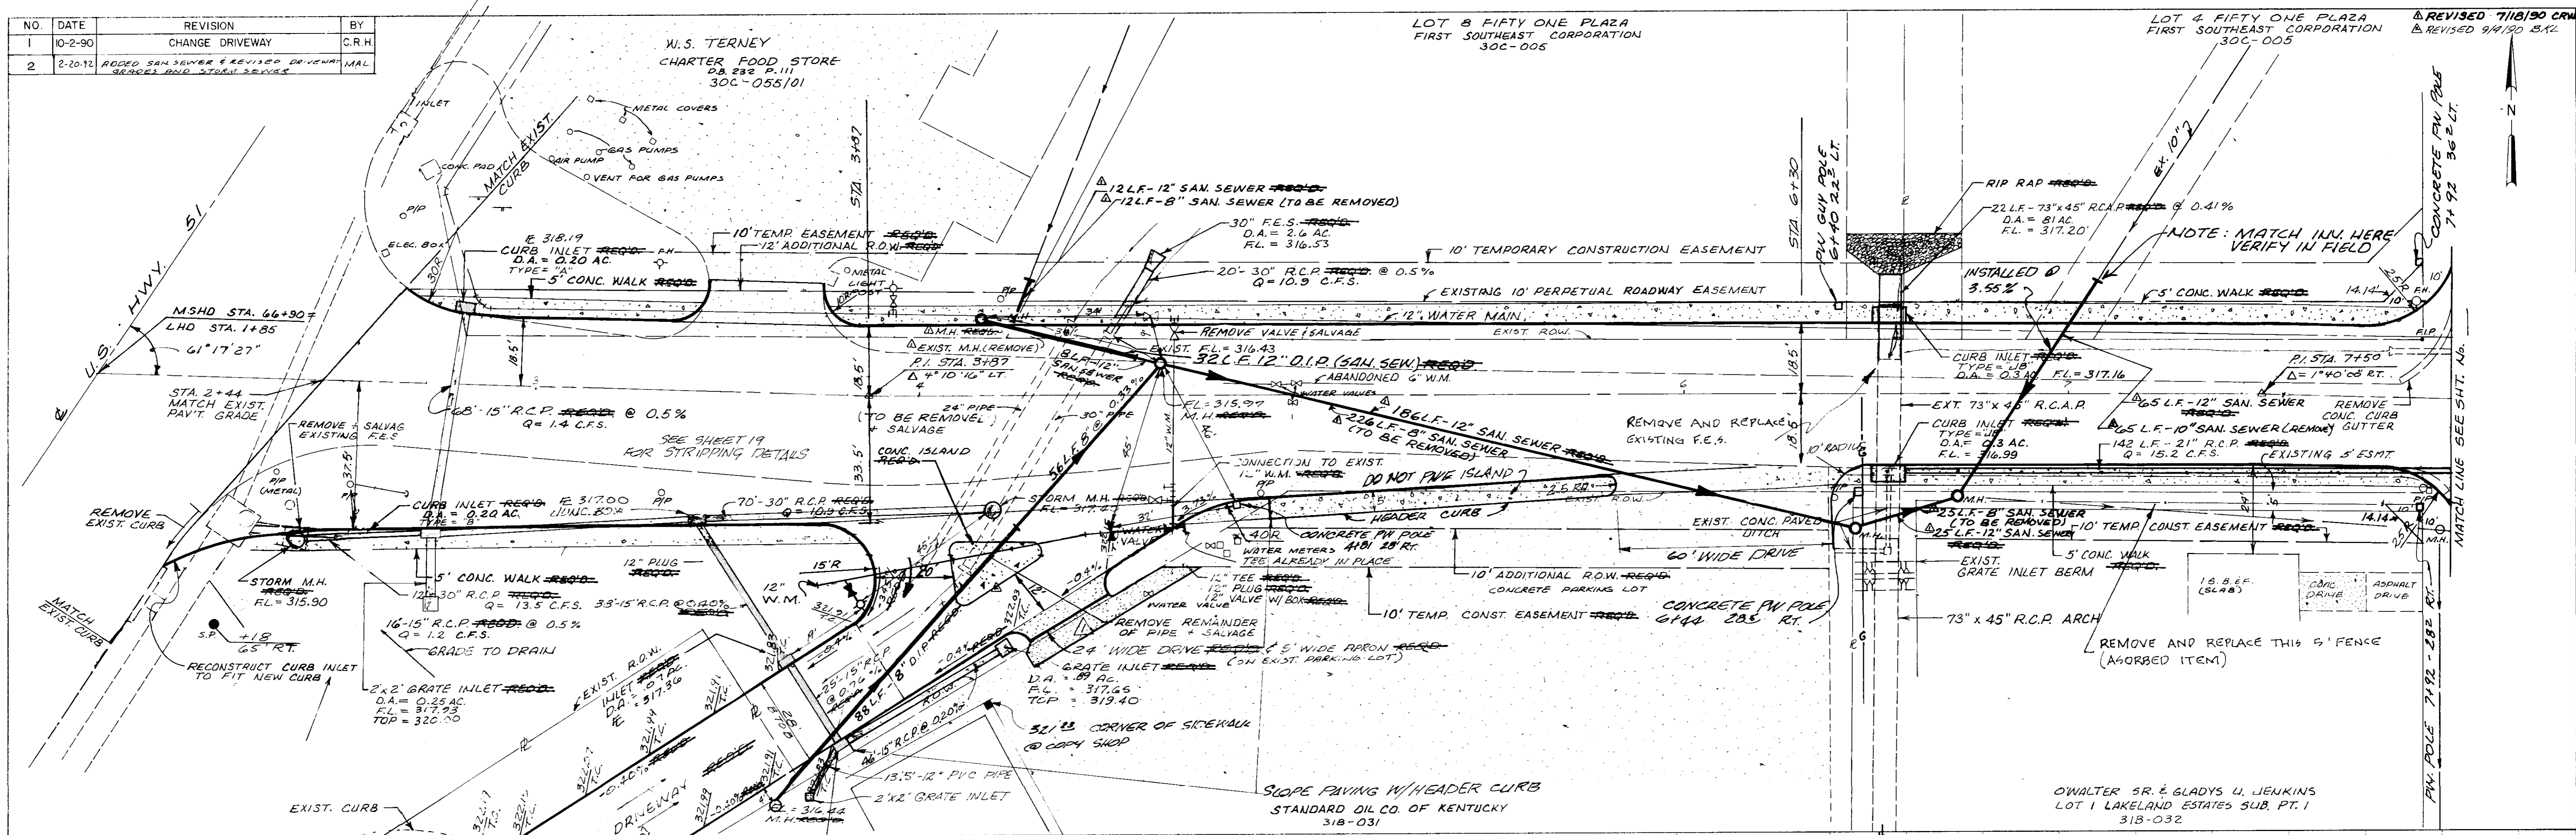

NO.	DATE	REVISION	BY
1			



NO.	DATE	REVISION	BY
1			

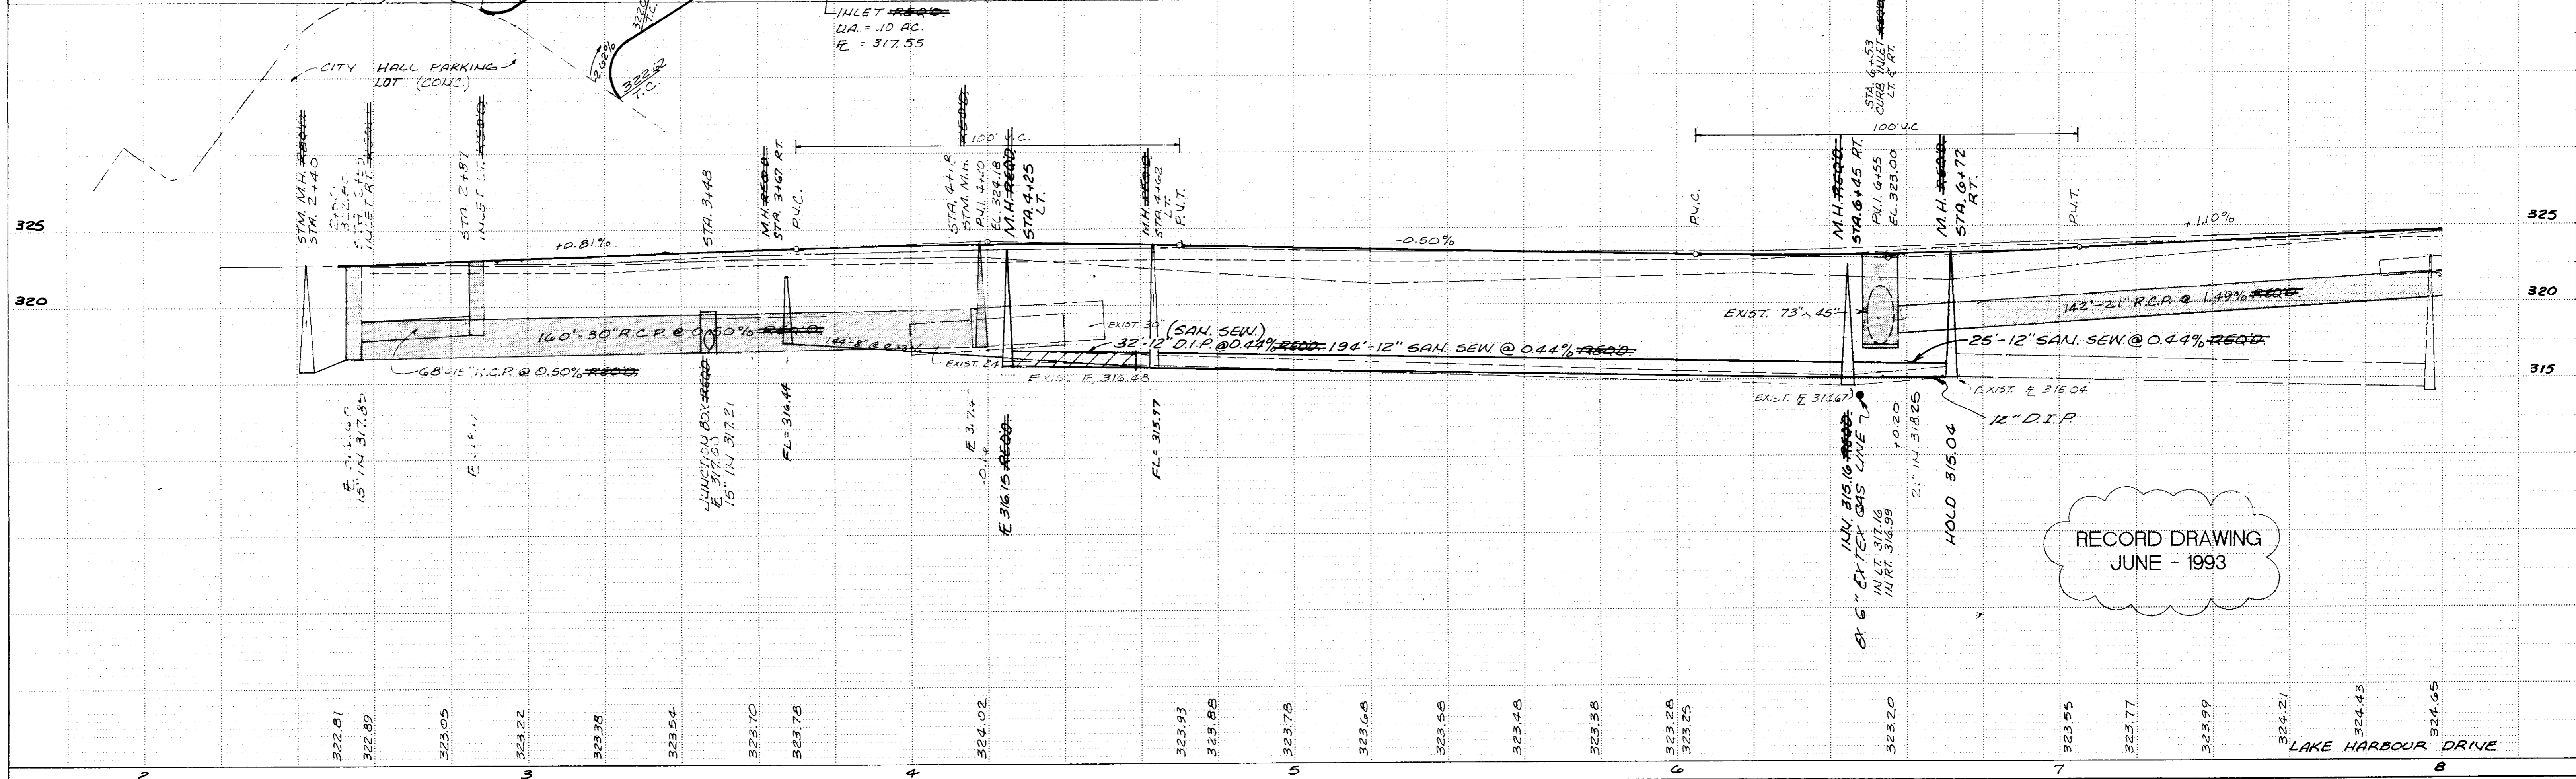


RECORD DRAWING
JUNE - 1993

PLATE 1-SINGLE PLAN AND PROFILE-FULL DOT

DATE	BY	REVISION
		1. APPROVED FOR CONSTRUCTION
		2. AUTOMATICALLY CHECKED
		3. AT 1/2" X 1/2" SCALE
PLAN		
NOTE BOOK		
NO		

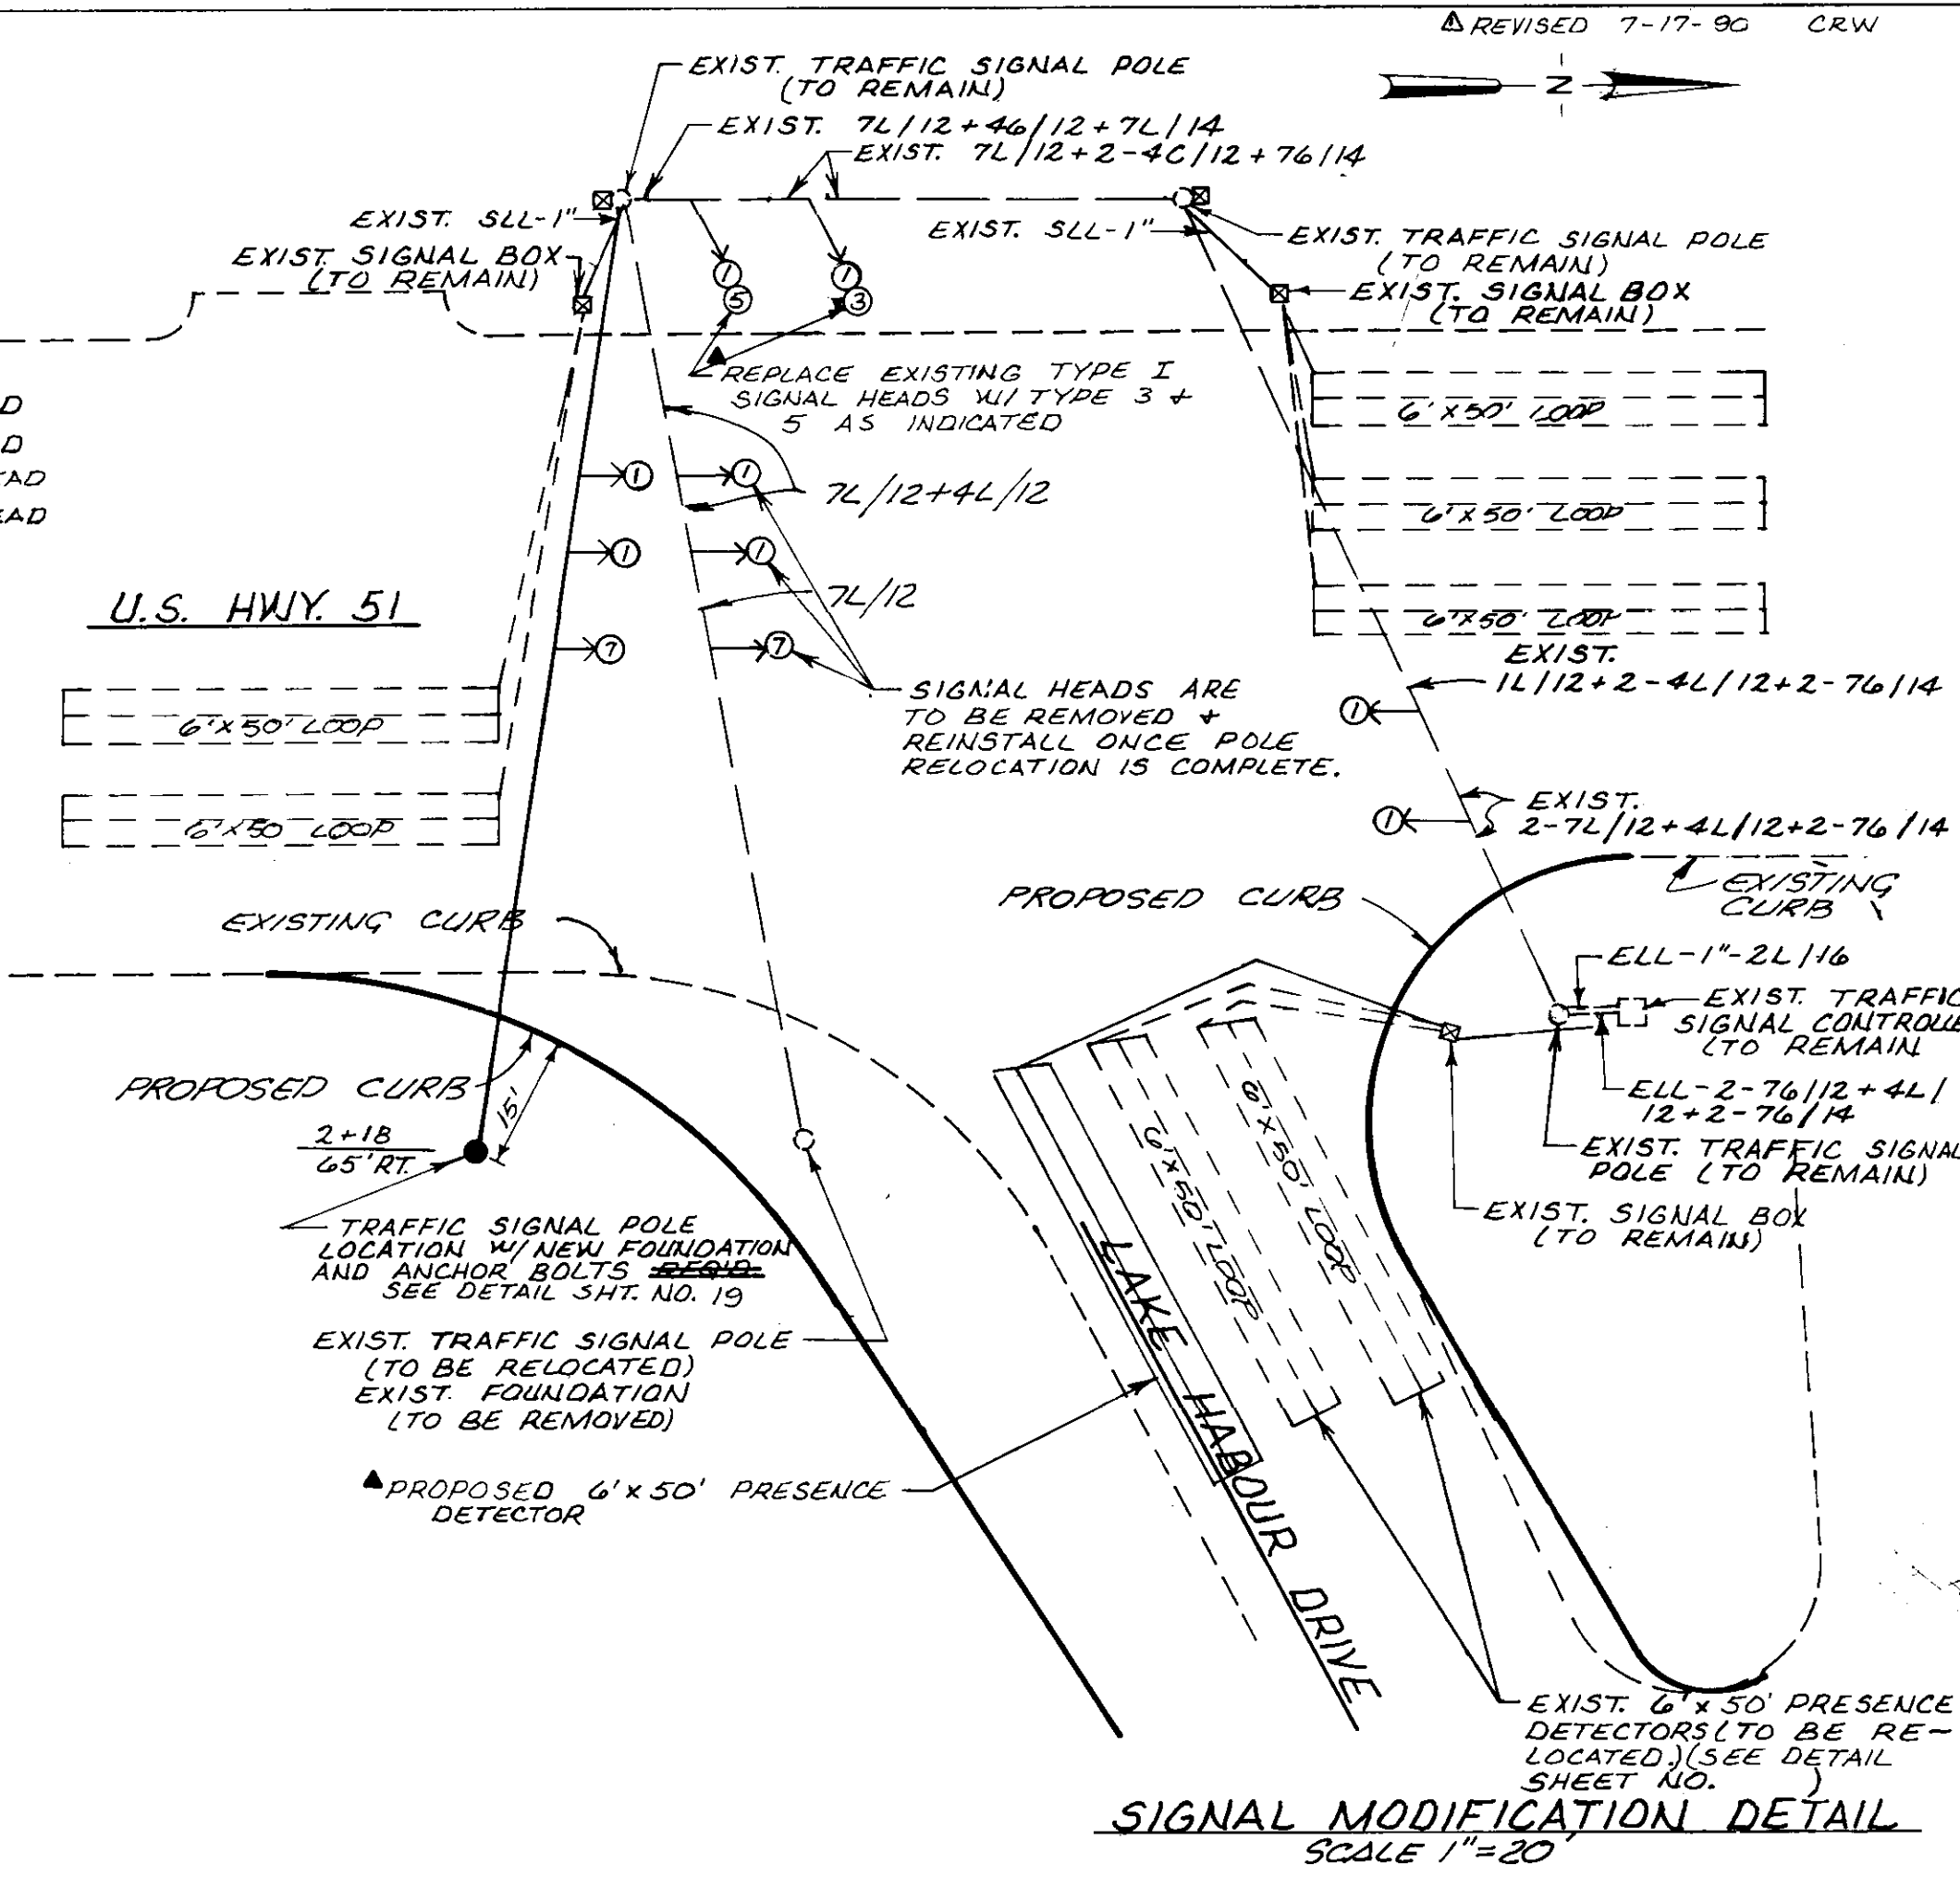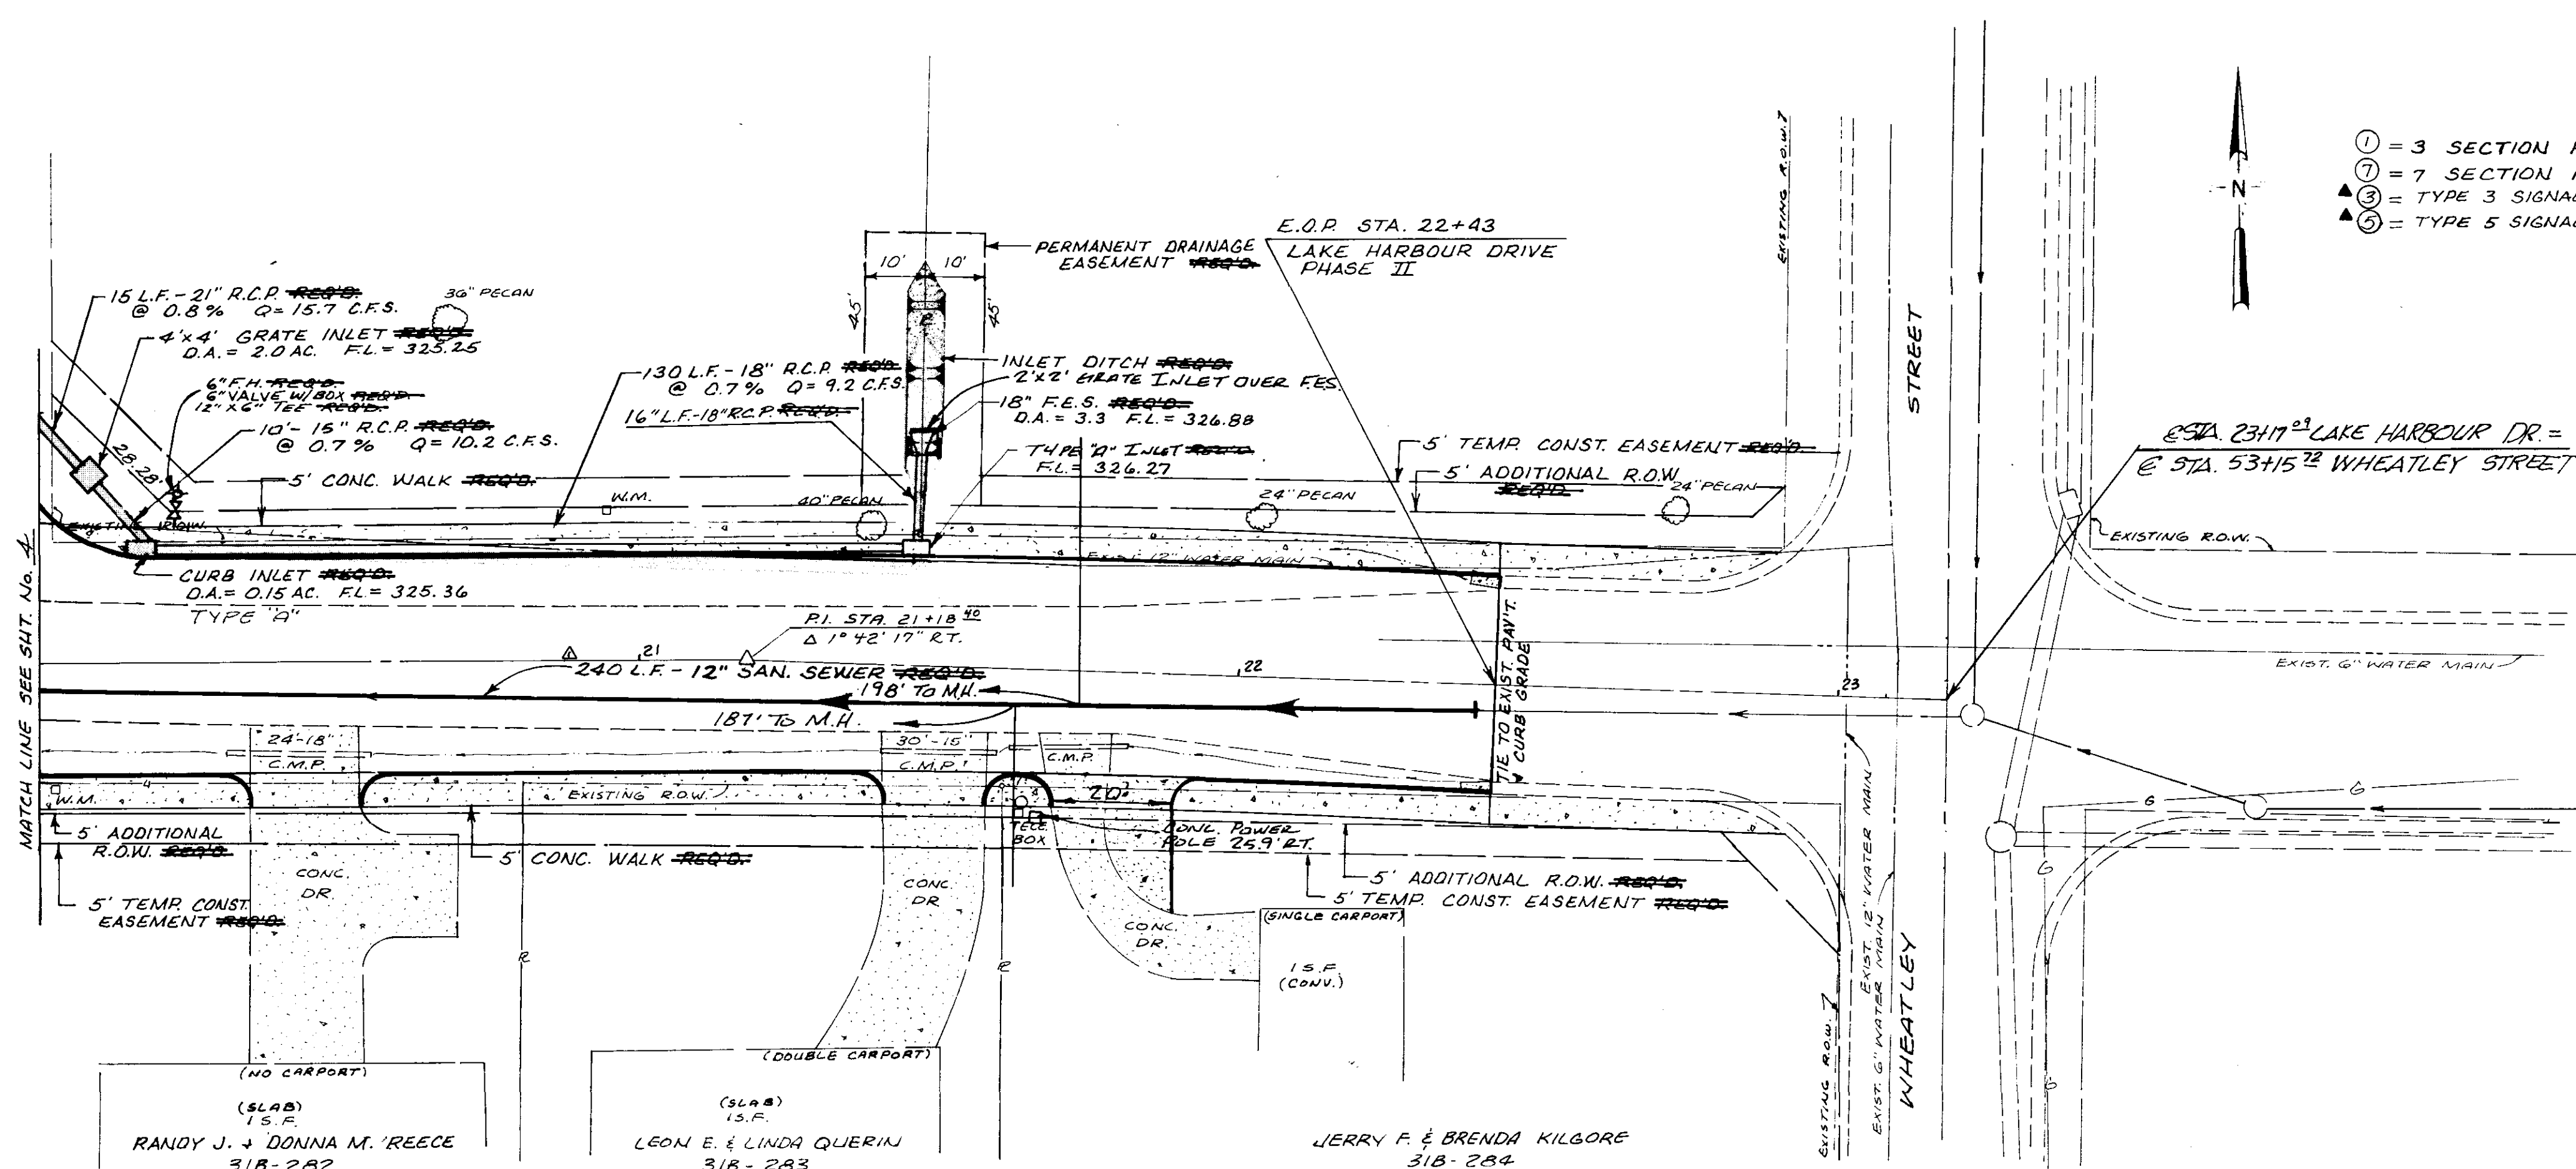

DATE	BY	REVISION
		1. APPROVED FOR CONSTRUCTION
		2. AUTOMATICALLY CHECKED
		3. AT 1/2" X 1/2" SCALE
PROFILE		
NOTE BOOK		
NO		

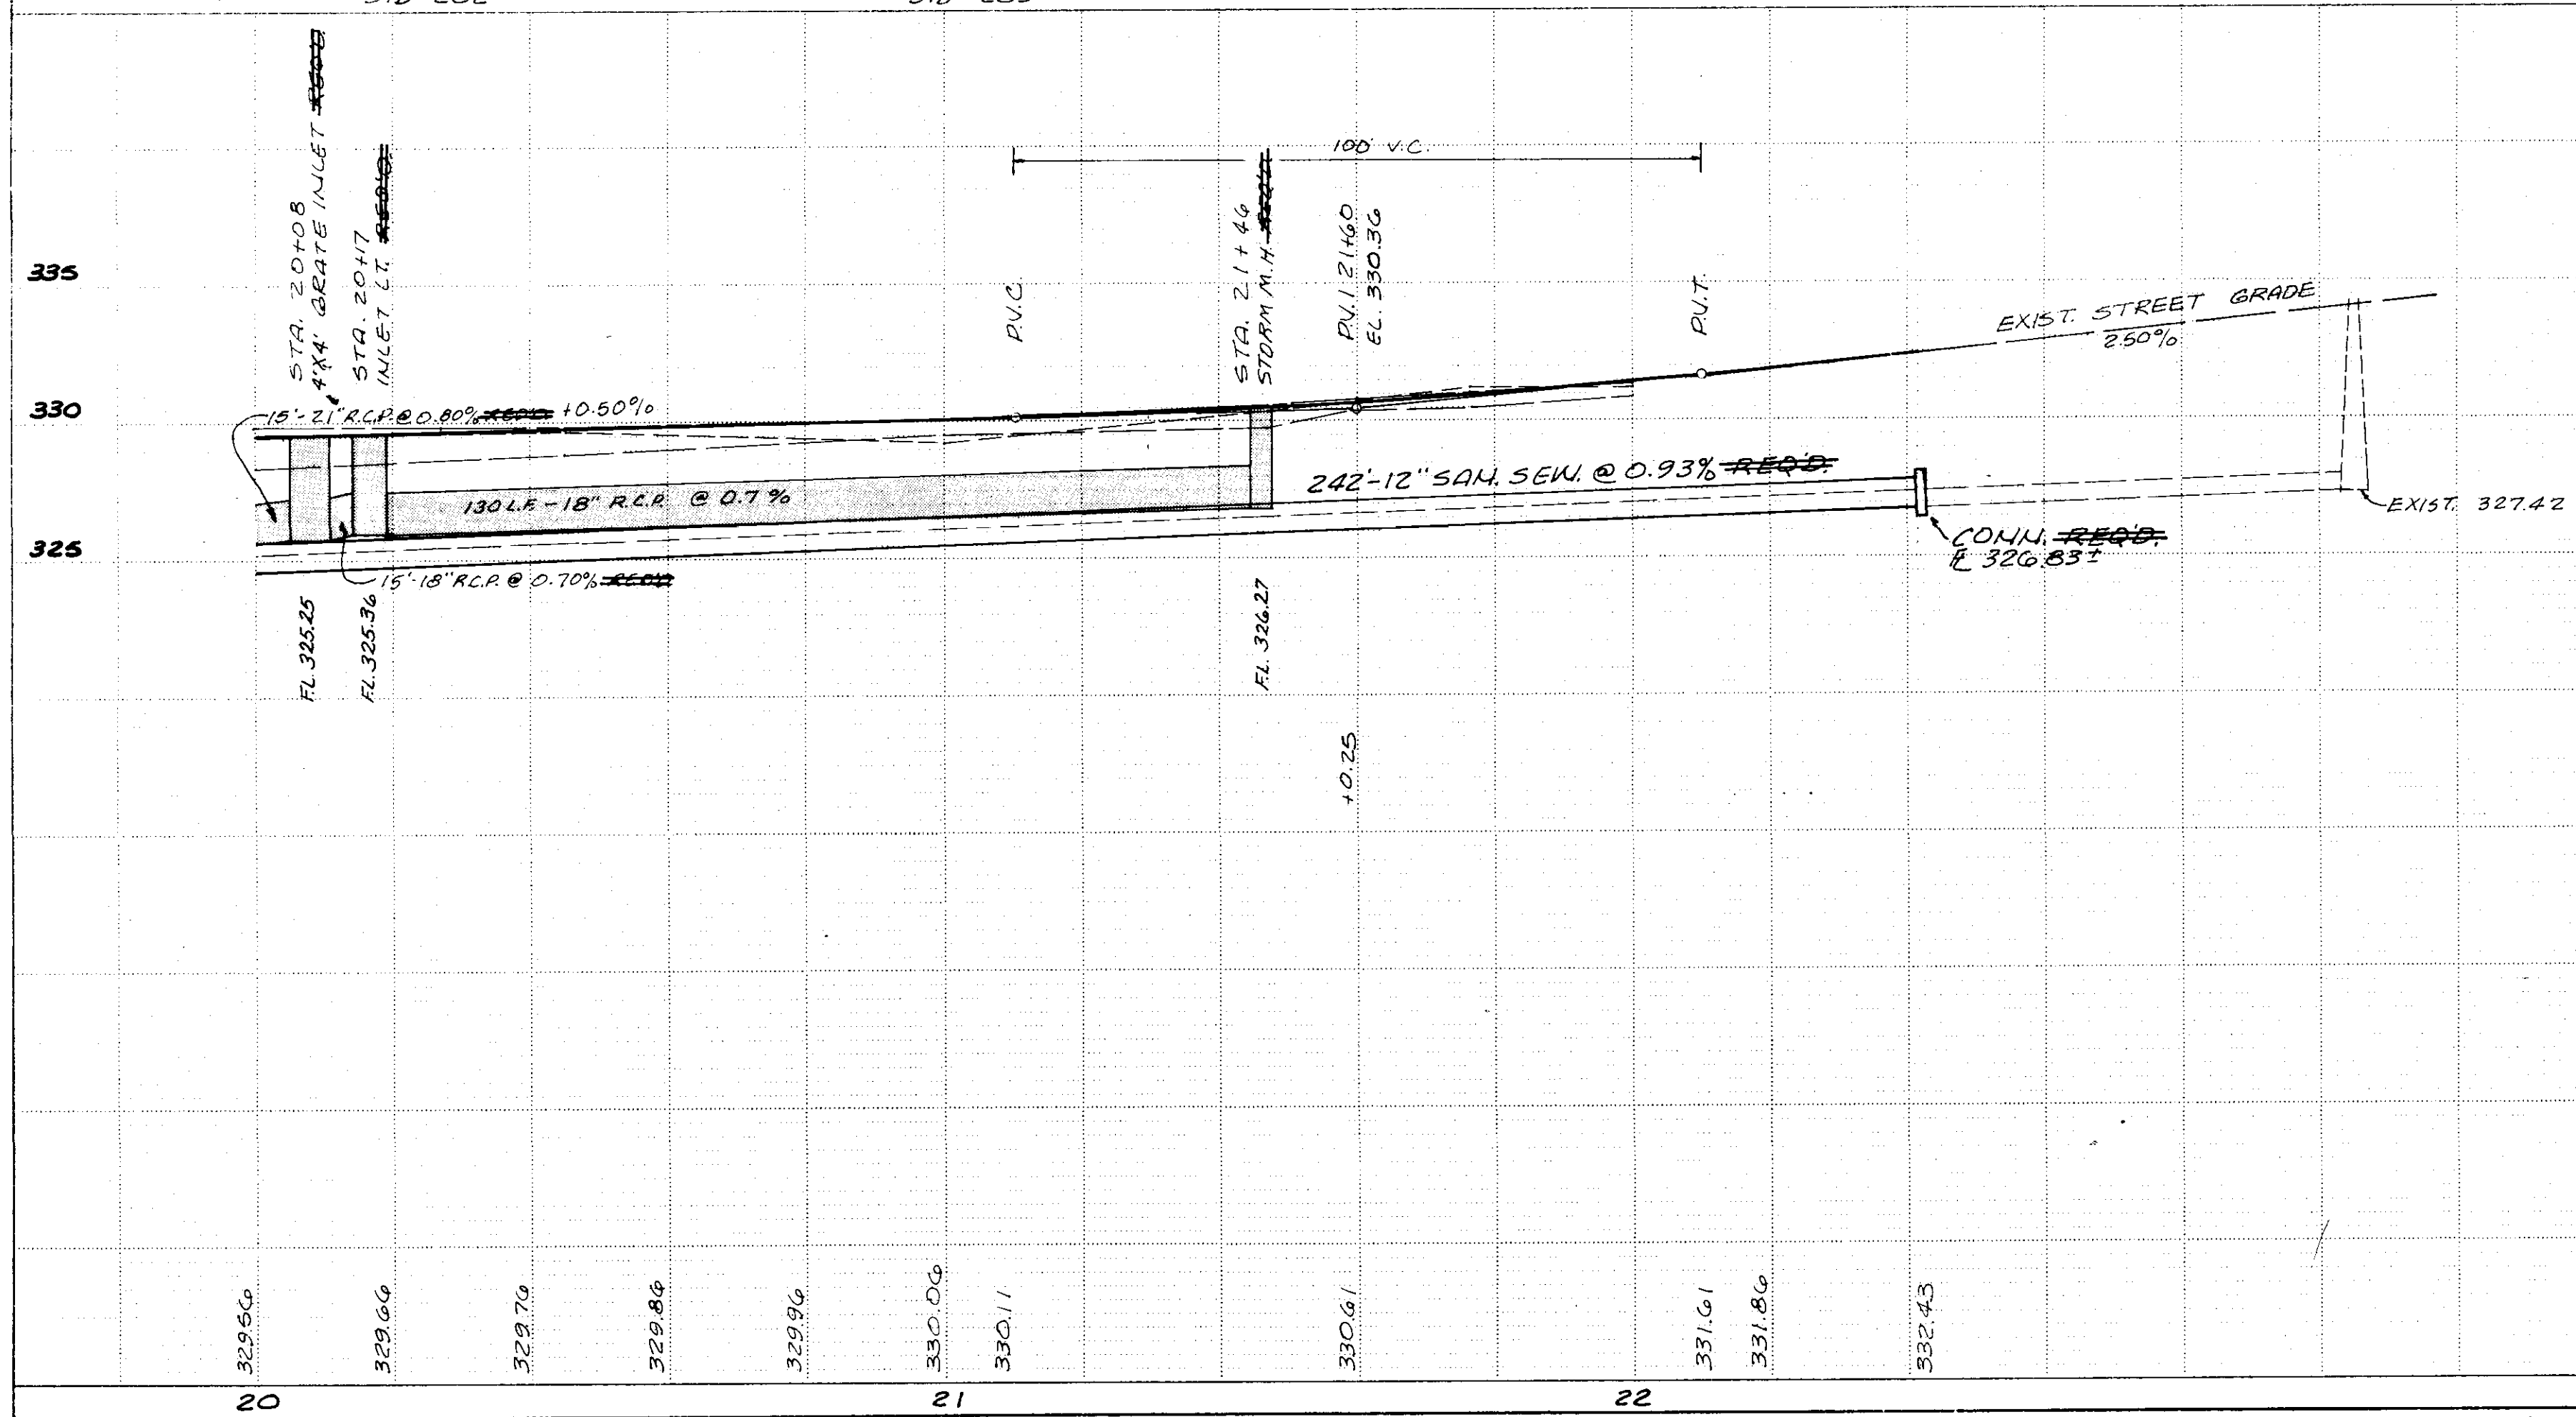

RECORD DRAWING
JUNE - 1993


LAKE HARBOUR DRIVE PH. II

PLAN

DATE	
BY	
CHECKED	
APPROVED	
NO.	


PROFILE

DATE	
BY	
CHECKED	
APPROVED	
NO.	

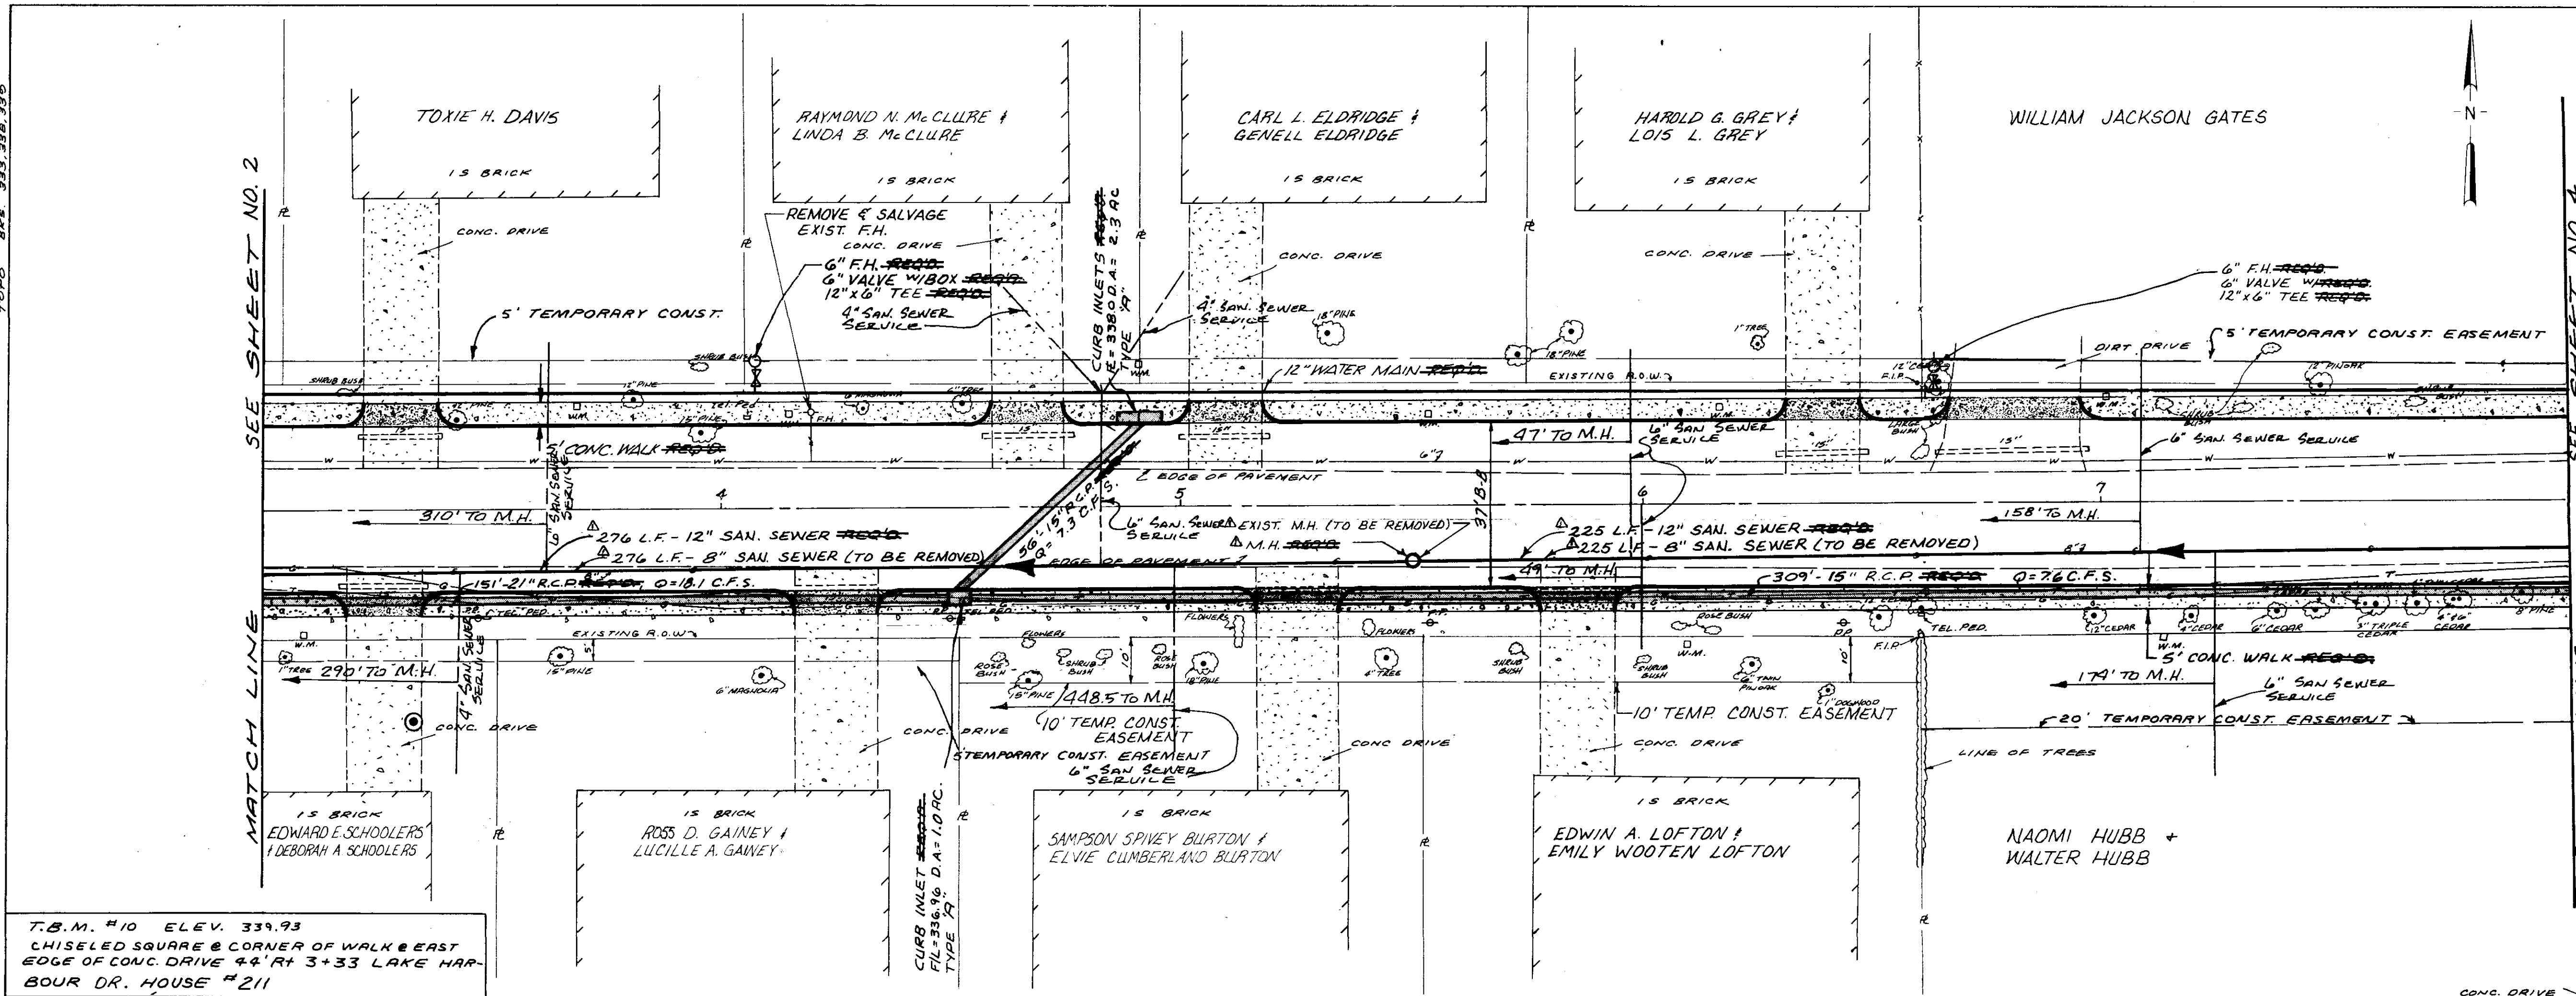

T.B.M. #10 ELEV. 339.93
 CHISELED SQUARE @ CORNER OF WALK & EAST
 EDGE OF CONC. DRIVE 44' RT +33 LAKE HAR-
 BOUR DR. HOUSE #211


LAKE HARBOUR DRIVE
 PHASE I
 SCALE: 1" = 20' HORIZ.
 1" = 5' VERT.

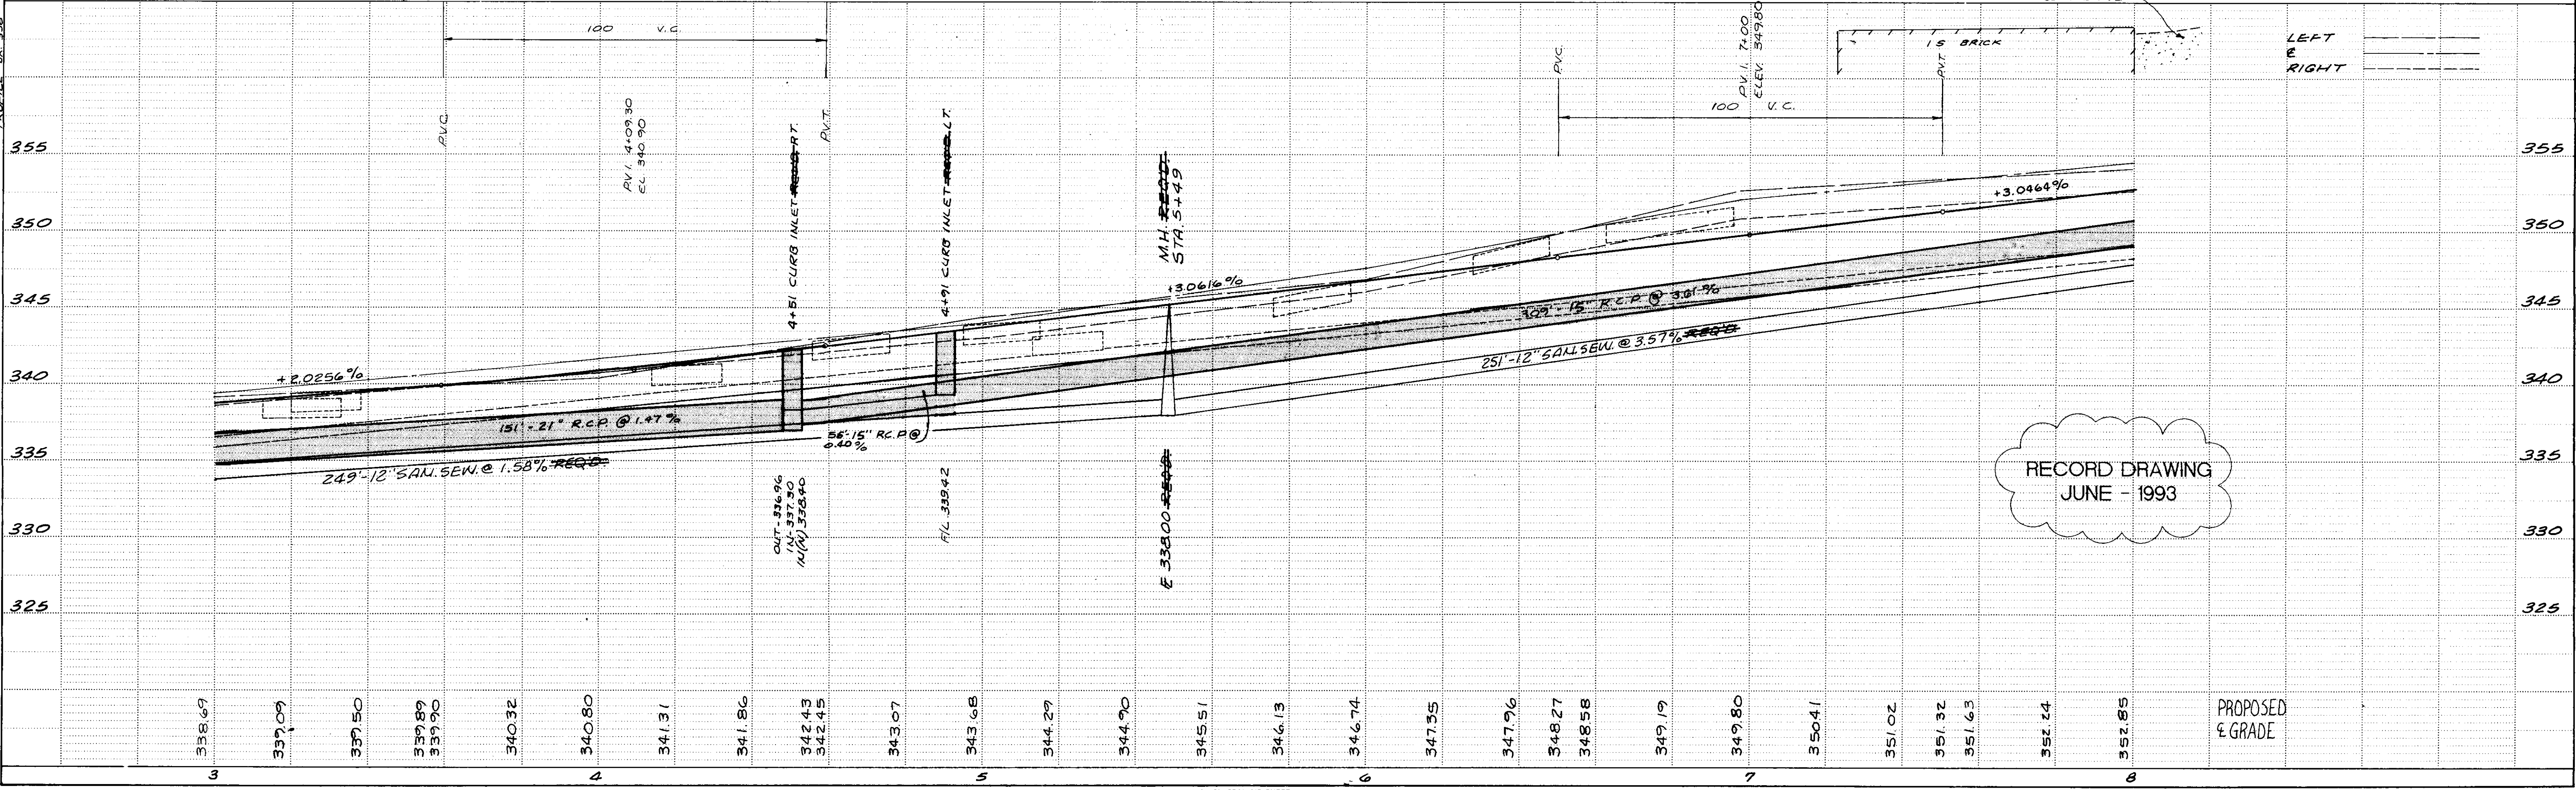

RECORD DRAWING
 JUNE - 1993

PROPOSED
 & GRADE


DATE	
BY	
NO.	
PLAN	
SURVEYED	
ALIGNED	
CHECKED	
RT. OF WAY	
NOTE	
BOOK	
NO.	

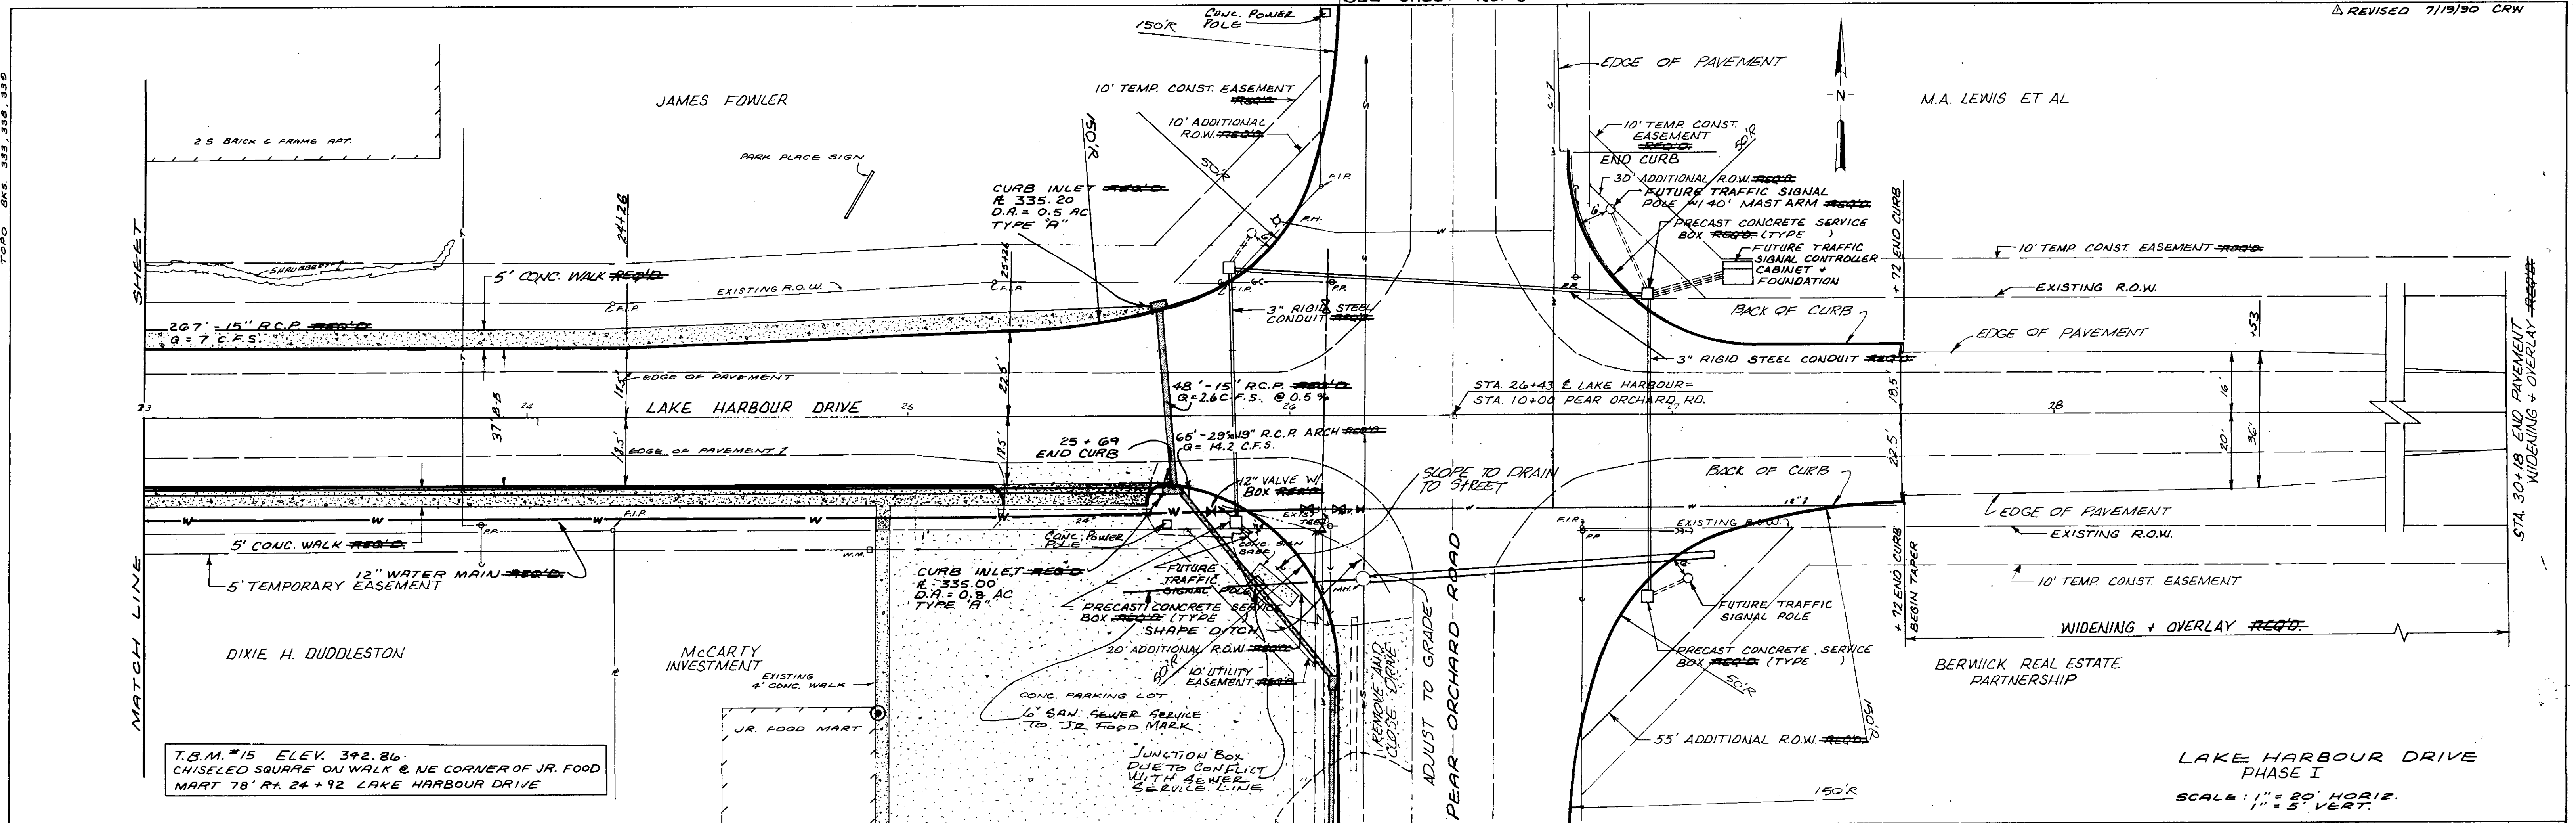

T.B.M. #15 ELEV. 342.80
 CHISELED SQUARE ON WALK @ NE CORNER OF JR. FOOD
 MART 78' RT. 24 + 92 LAKE HARBOUR DRIVE







LAKE HARBOUR DRIVE
 PHASE I
 SCALE: 1" = 20' HORIZ.
 1" = 5' VERT.

DATE	
BY	
NO.	
PROFILE	
DESIGNED	
PLOTTED	
GRADES CHECKED	
B. ME. NOTED	
STANDARD NOTATIONS CHYD	
NOTE	
BOOK	
NO.	

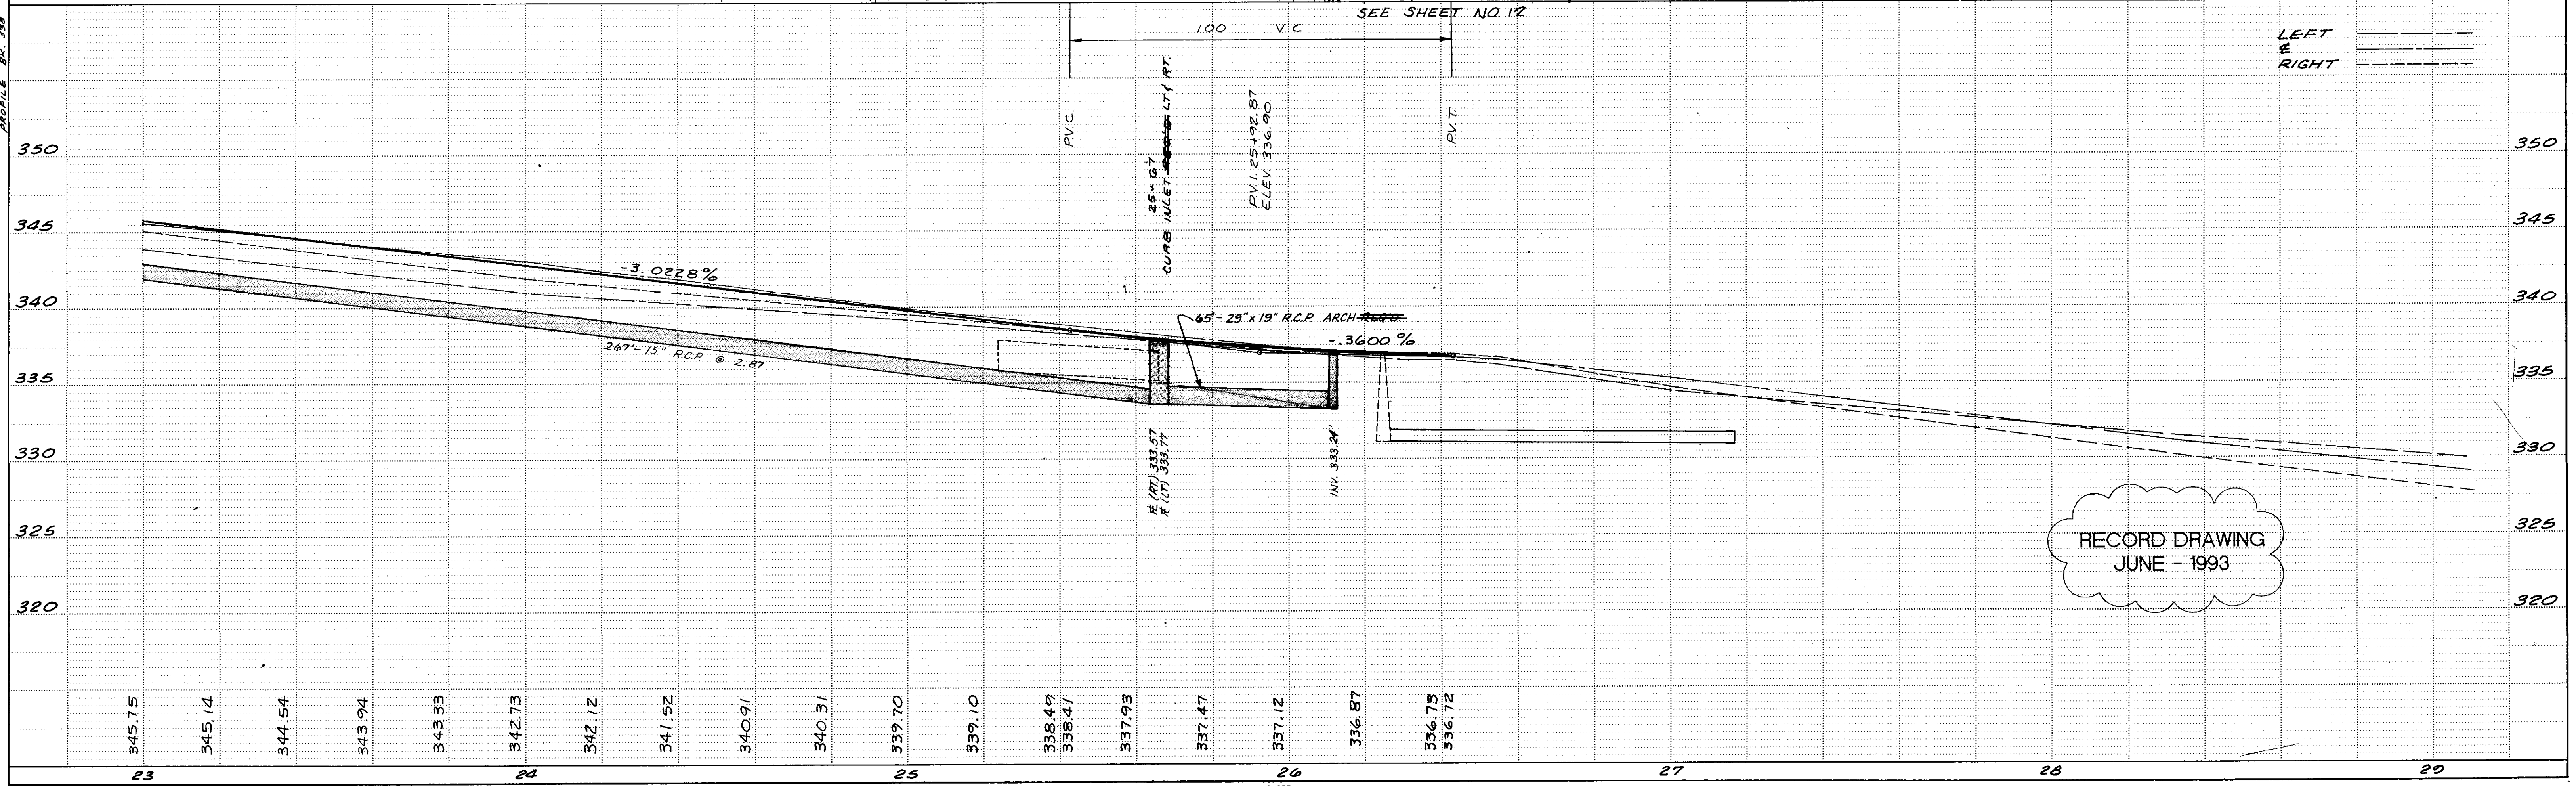


RECORD DRAWING
 JUNE - 1993

NO	DATE	REVISION
1	1/17/90	PRESENCE DETECTOR 1,2
2	3/4/90	ADDED ISLAND STRIPPING
3	4/16/90	SHIFTED STRIPPING @ INTERSECTION

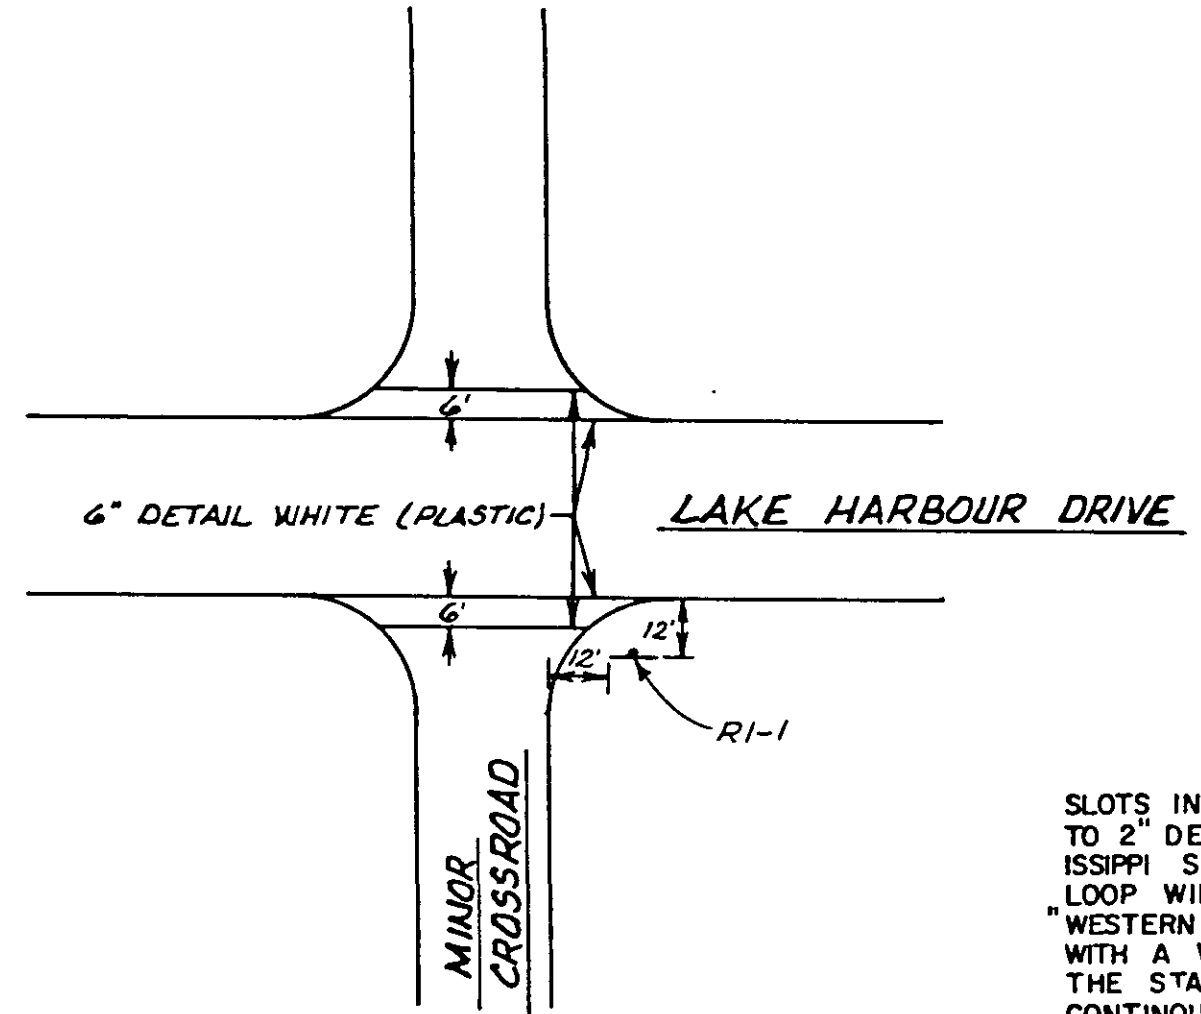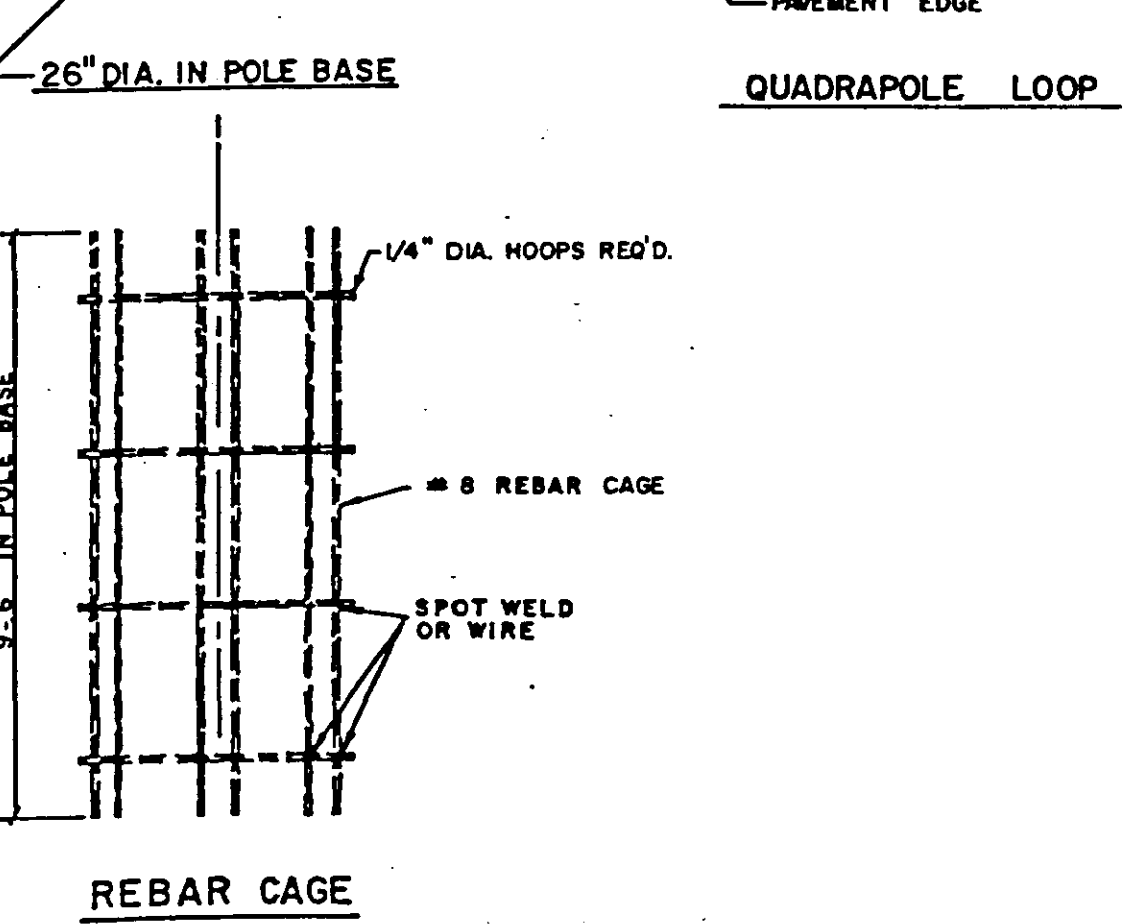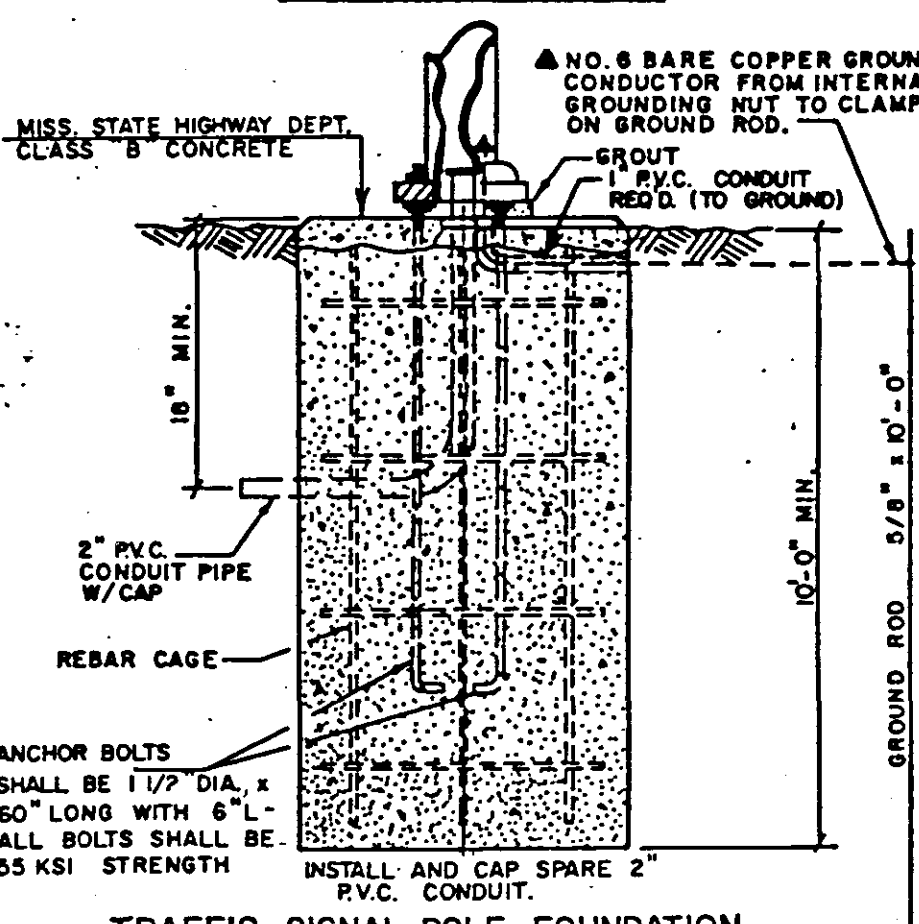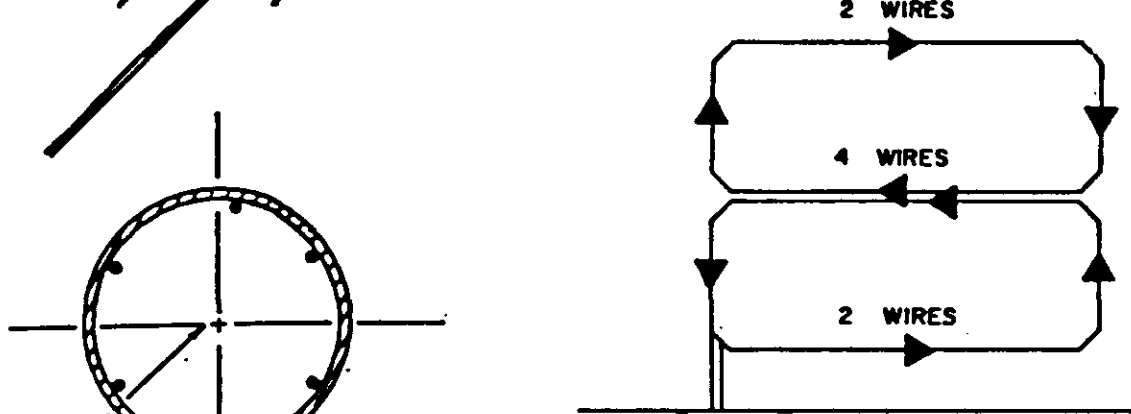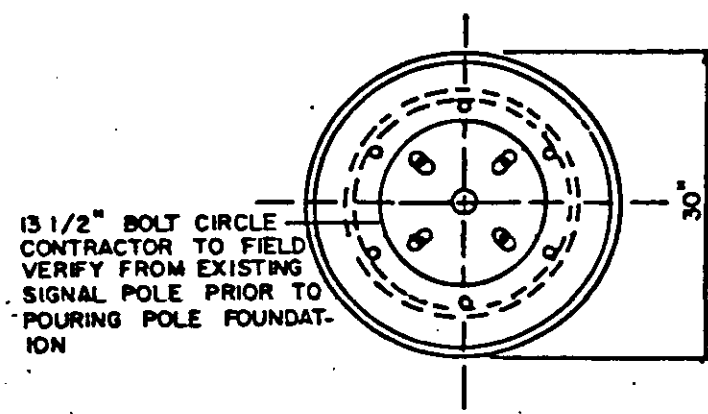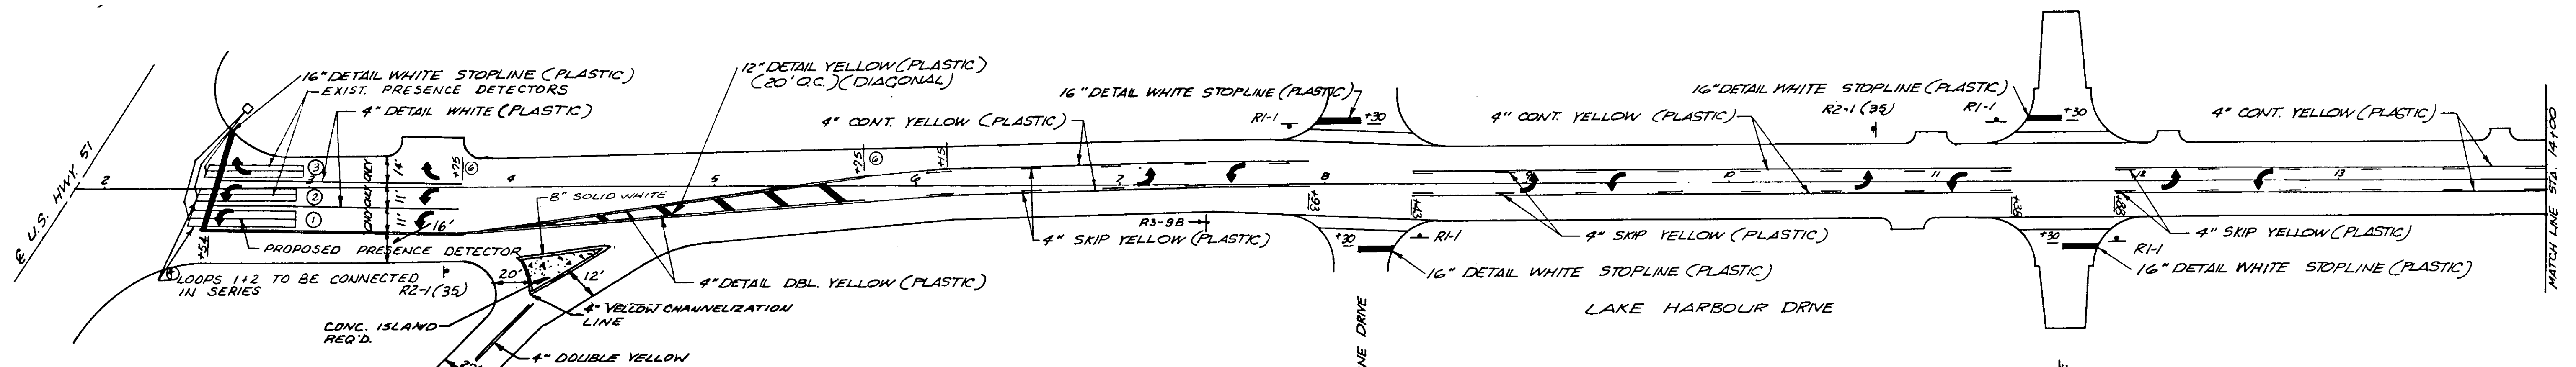



SLOTS IN PAVEMENT FOR LOOPS TO BE CUT A MINIMUM OF 1/4" WIDE AND 1/2" TO 2" DEEP. SLOTS TO BE FILLED WITH LOOP SEALANT MATERIAL PER MISSISSIPPI STATE HIGHWAY DEPARTMENT SPECIFICATIONS. THE CONNECTION OF THE LOOP WIRE WITH THE FEEDER CABLE SHALL BE MADE WITH A SOLDERED WESTERN UNION TYPE SPLICE, WRAPPED WITH WATERPROOF TAPE AND COATED WITH A WATER-TIGHT PROTECTIVE COVERING OR APPROVED EQUAL METHOD BY THE STATE HIGHWAY DEPARTMENT. FEEDER CABLE AND LOOP WIRE SHALL BE CONTINUOUS RUN WITH NO SPLICE.

- NOTES
- ALL WIRING INSTALLED SHALL CONFORM TO THE NATIONAL ELECTRICAL CODE AND LOCAL ORDINANCES AND REQUIREMENTS OF THE MSHD.
 - MINIMUM 17 FEET VERTICAL CLEARANCE REQUIRED BETWEEN BOTTOM OF LOWEST SIGNAL HEAD AND ROADWAY SURFACE.
 - MESSENGER CABLE TO SUPPORT SIGNALS AND ELECTRIC CABLE SHALL BE INSTALLED TO HAVE 5% SAG.
 - CONTRACTOR TO RE-USE ALL EXISTING SIGNAL MOUNTING HARDWARE, CLAMPS, SPAN WIRE, SIGNAL CABLE, ECT. ON THE SIGNAL POLE RELOCATION. COMPONENTS DAMAGED OR NOT RE-USEABLE SHALL BE REPLACED BY THE CONTRACTOR PRICE FOR SAID EQUIPMENT SHALL BE INCLUDED IN THE LUMP SUM PRICE BID FOR TRAFFIC SIGNAL POLE RELOCATION.
 - SIGNAL CABLE TO BE RE-ATTACHED TO MESSENGER CABLE WITH BLACK HEAVY DUTY CABLE TIES (2 FOOT MAXIMUM SPACING) OR LASHING.
 - ALL CONSTRUCTION METHODS AND EQUIPMENT REQUIRED FOR THE TRAFFIC SIGNAL POLE RELOCATION SHALL BE IN ACCORDANCE WITH EXISTING MISSISSIPPI STATE HIGHWAY DEPT. SPECIFICATION.

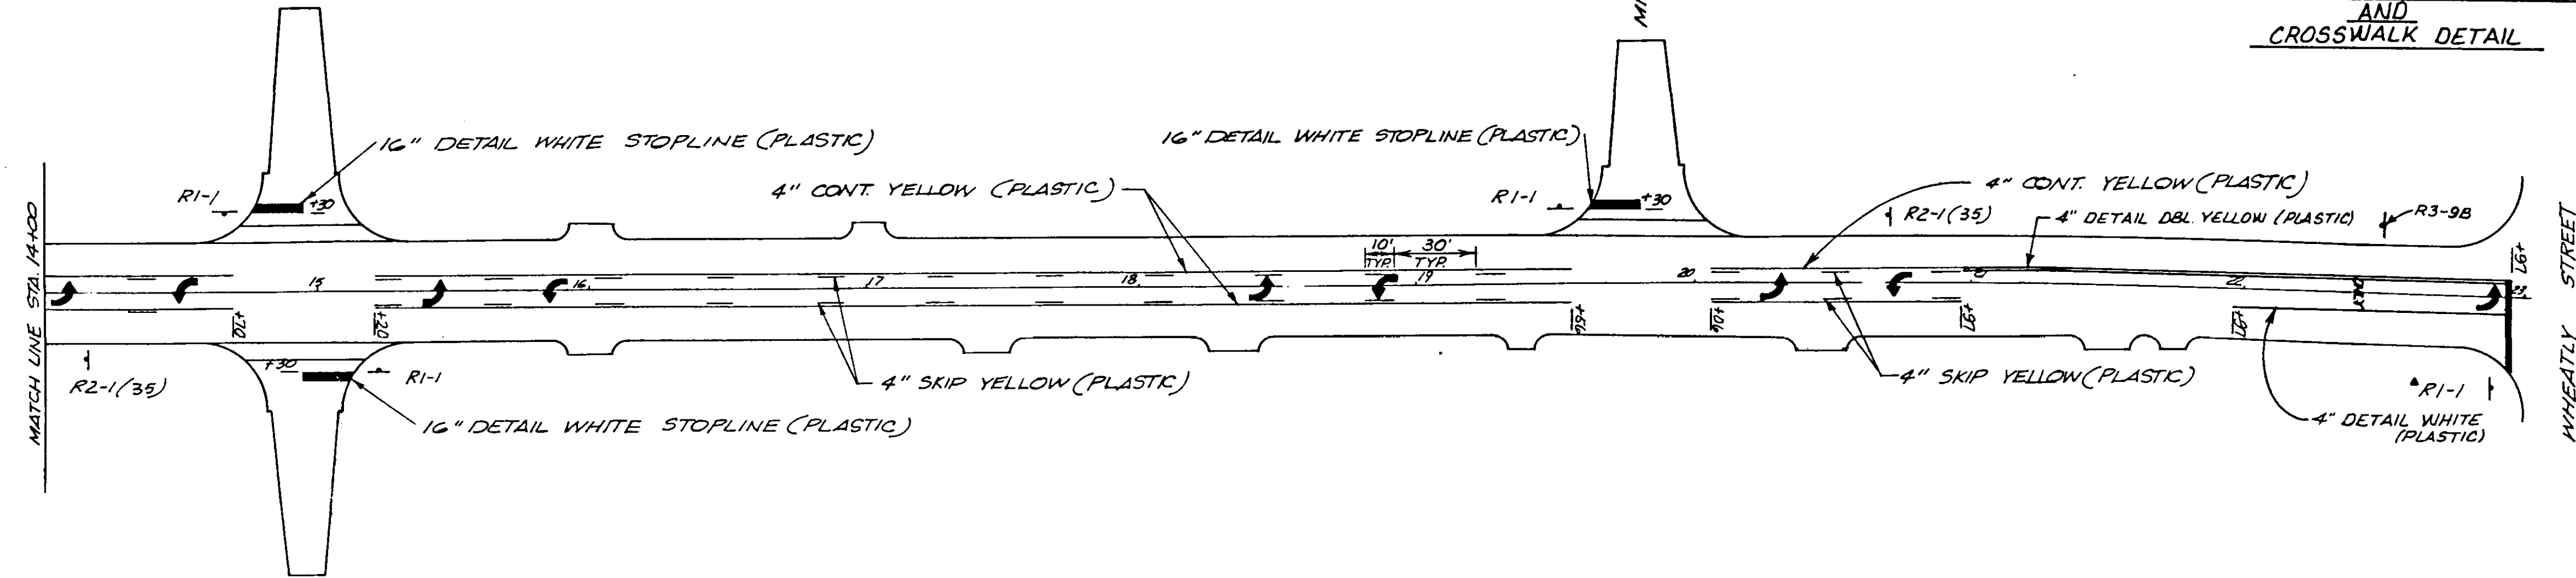


NOTE:
 ALL REGULATORY SIGNS SHALL BE INSTALLED IN ACCORDANCE WITH THE 1988 EDITION OF THE MANUAL ON UNIFORM TRAFFIC CONTROL DEVICES.

CITY OF RIDGELAND		
PAVEMENT MARKING PLAN		
LAKE HARBOUR DRIVE		
WAGGONER ENGINEERING INC. Consulting Engineers - Jackson, Ms.		
DRAWN BY: C.R.H.	DATE: APRIL, 1990	SHEET NO.
CHECKED BY:	SCALE: 1" = 40'	19 OF 22
APPROVED BY:		

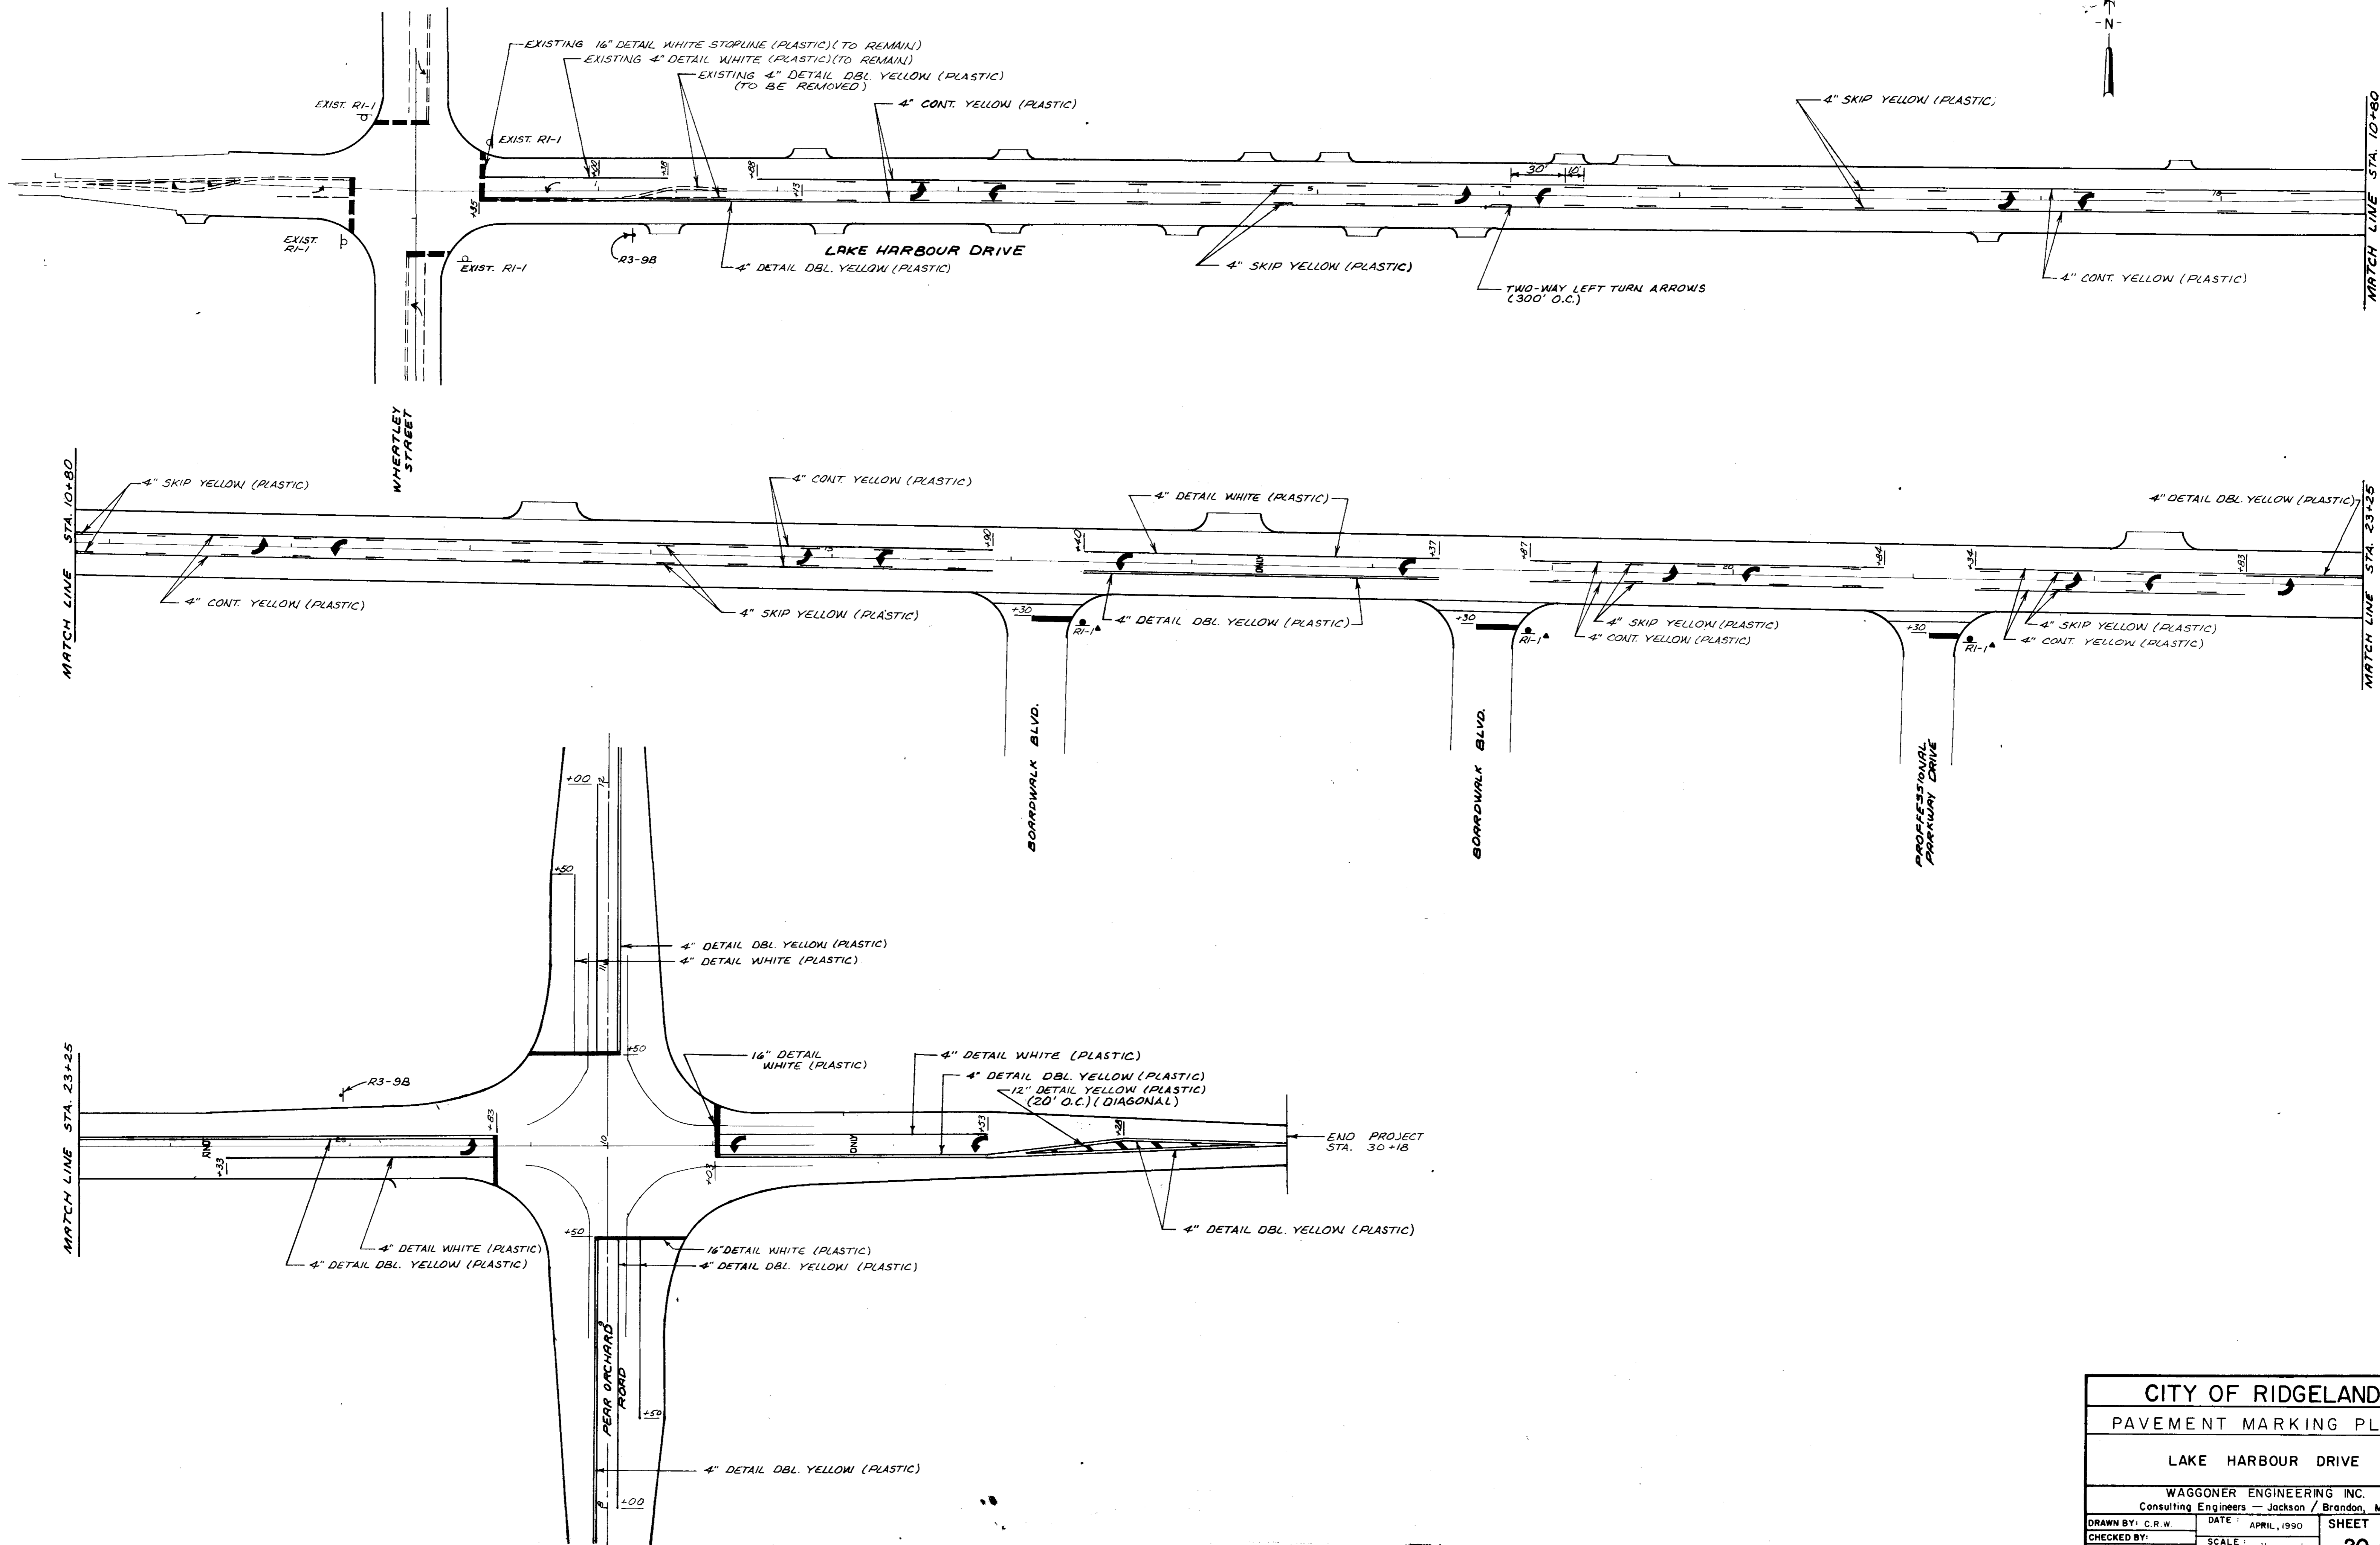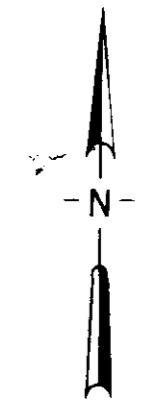


CITY OF RIDGELAND		
PAVEMENT MARKING PLAN		
LAKE HARBOUR DRIVE		
WAGGONER ENGINEERING INC. Consulting Engineers — Jackson / Brandon, Ms.		
DRAWN BY: C.R.W.	DATE: APRIL, 1990	SHEET NO.
CHECKED BY:	SCALE: 1" = 40'	20 OF 22
APPROVED BY:		

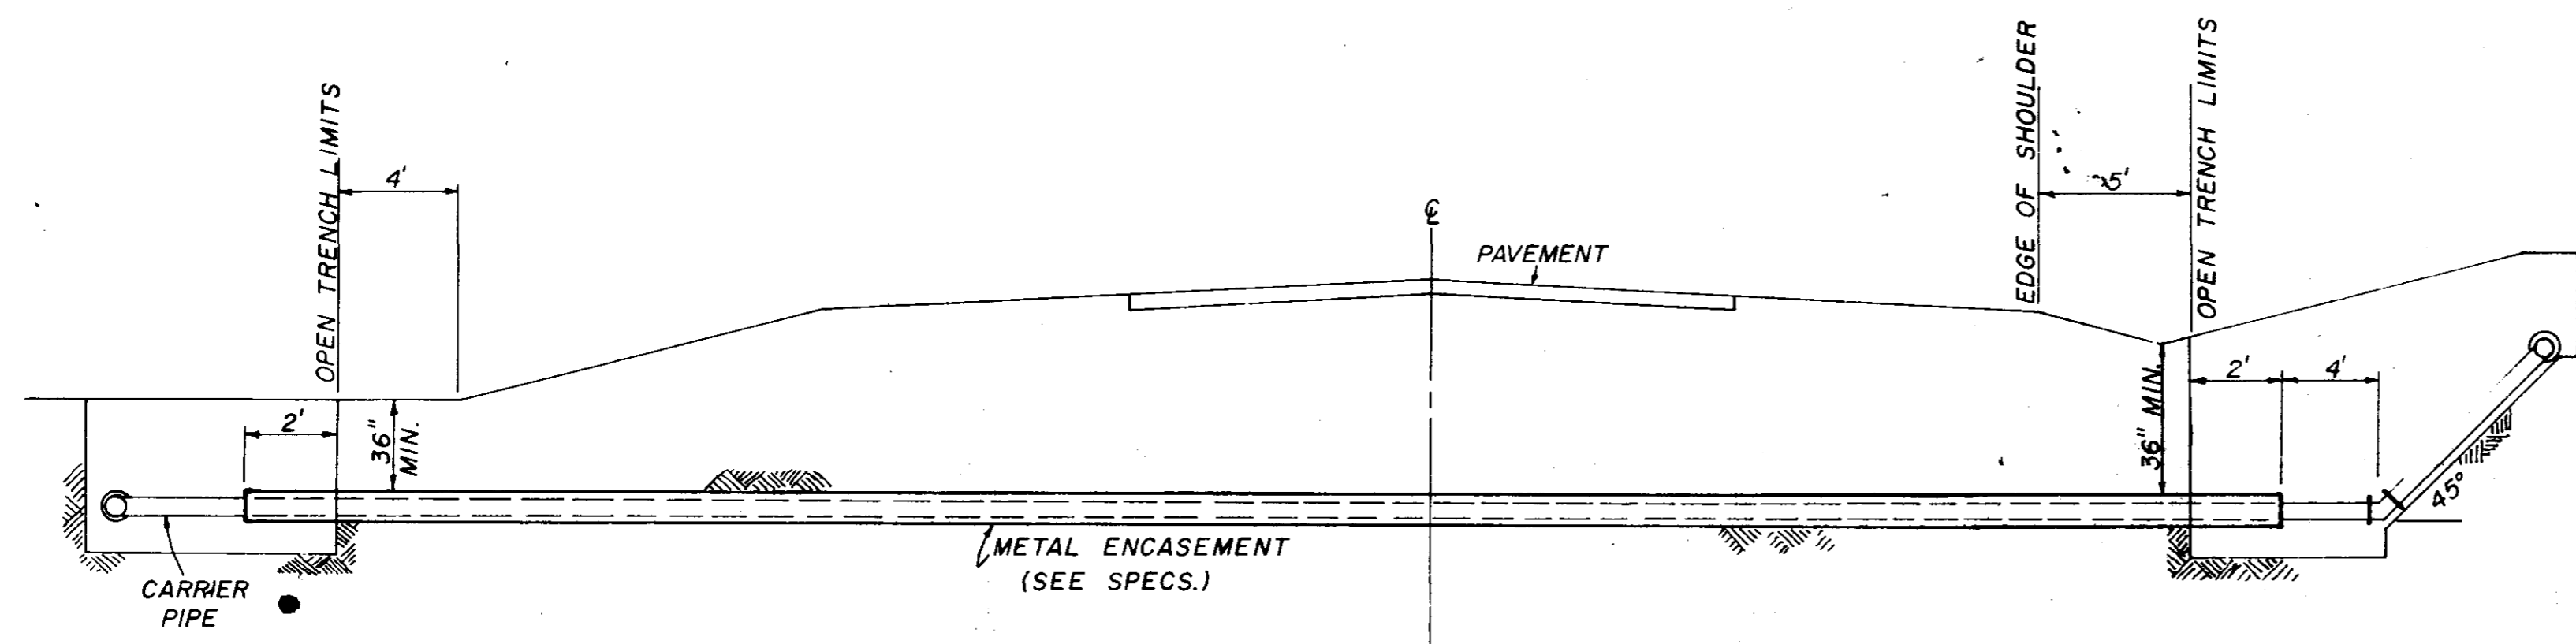


TYPICAL CASSED CROSSING

NOTE: COMPENSATION FOR CONCRETE THRUST BLOCKS SHALL BE INCLUDED IN THE UNIT PRICE BID FOR VALVES, FIRE HYDRANTS AND FITTINGS.

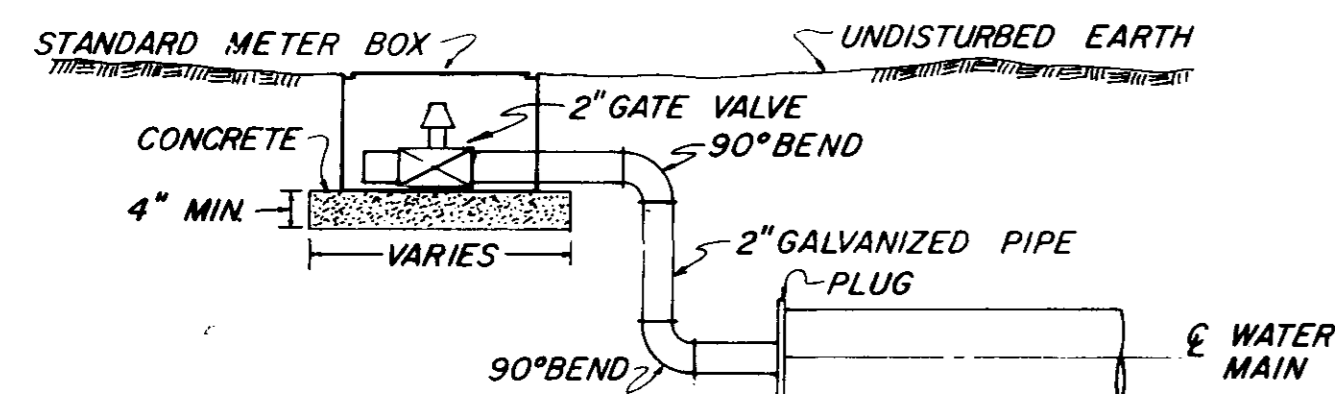

TYPICAL 2" BLOW-OFF DETAIL

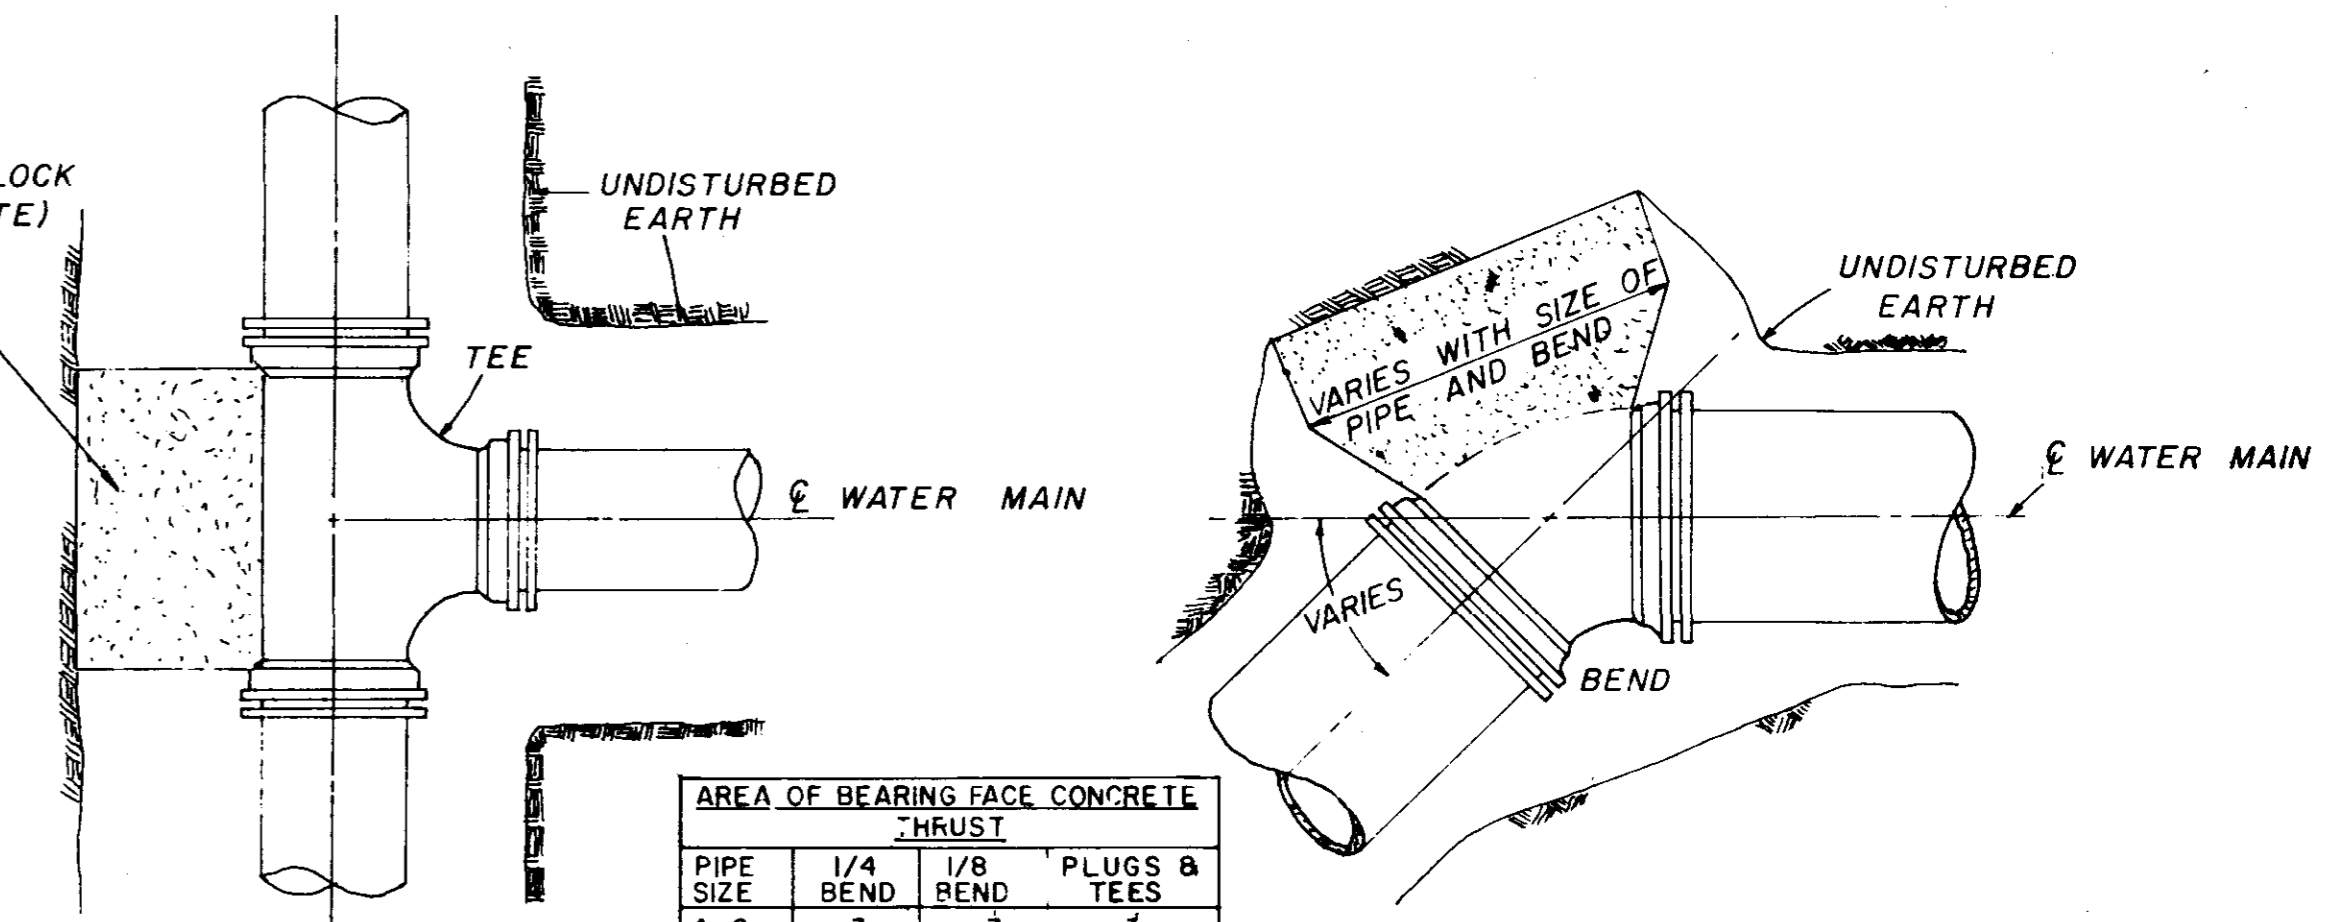


PLAN


PLAN

PIPE SIZE	1/4 BEND	1/8 BEND	PLUGS & TEES
4-6	3	3	3
8	3	3	3
10	4	3	3
12	6	3	4
16	11	4	7

NOTE: AREA OF BEARING FACE IN SQUARE FEET.

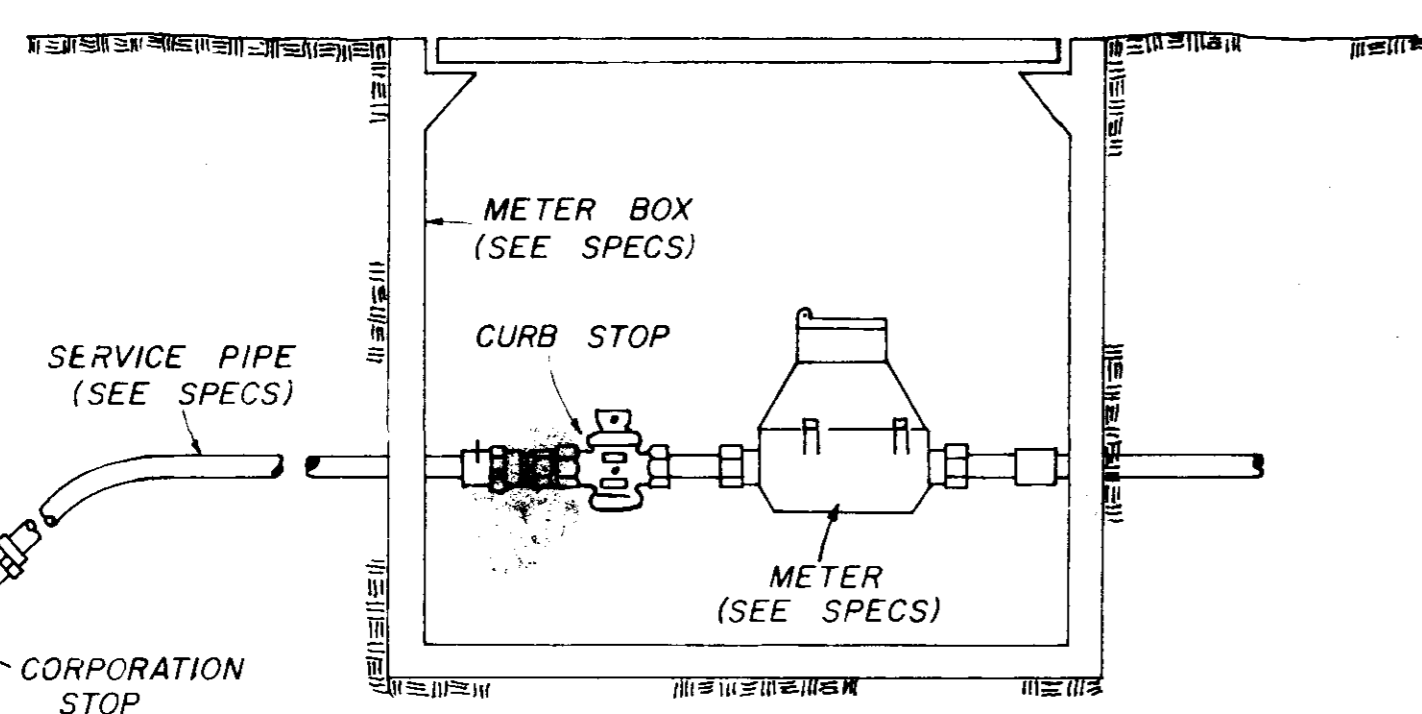

TYPICAL SERVICE ASSEMBLY

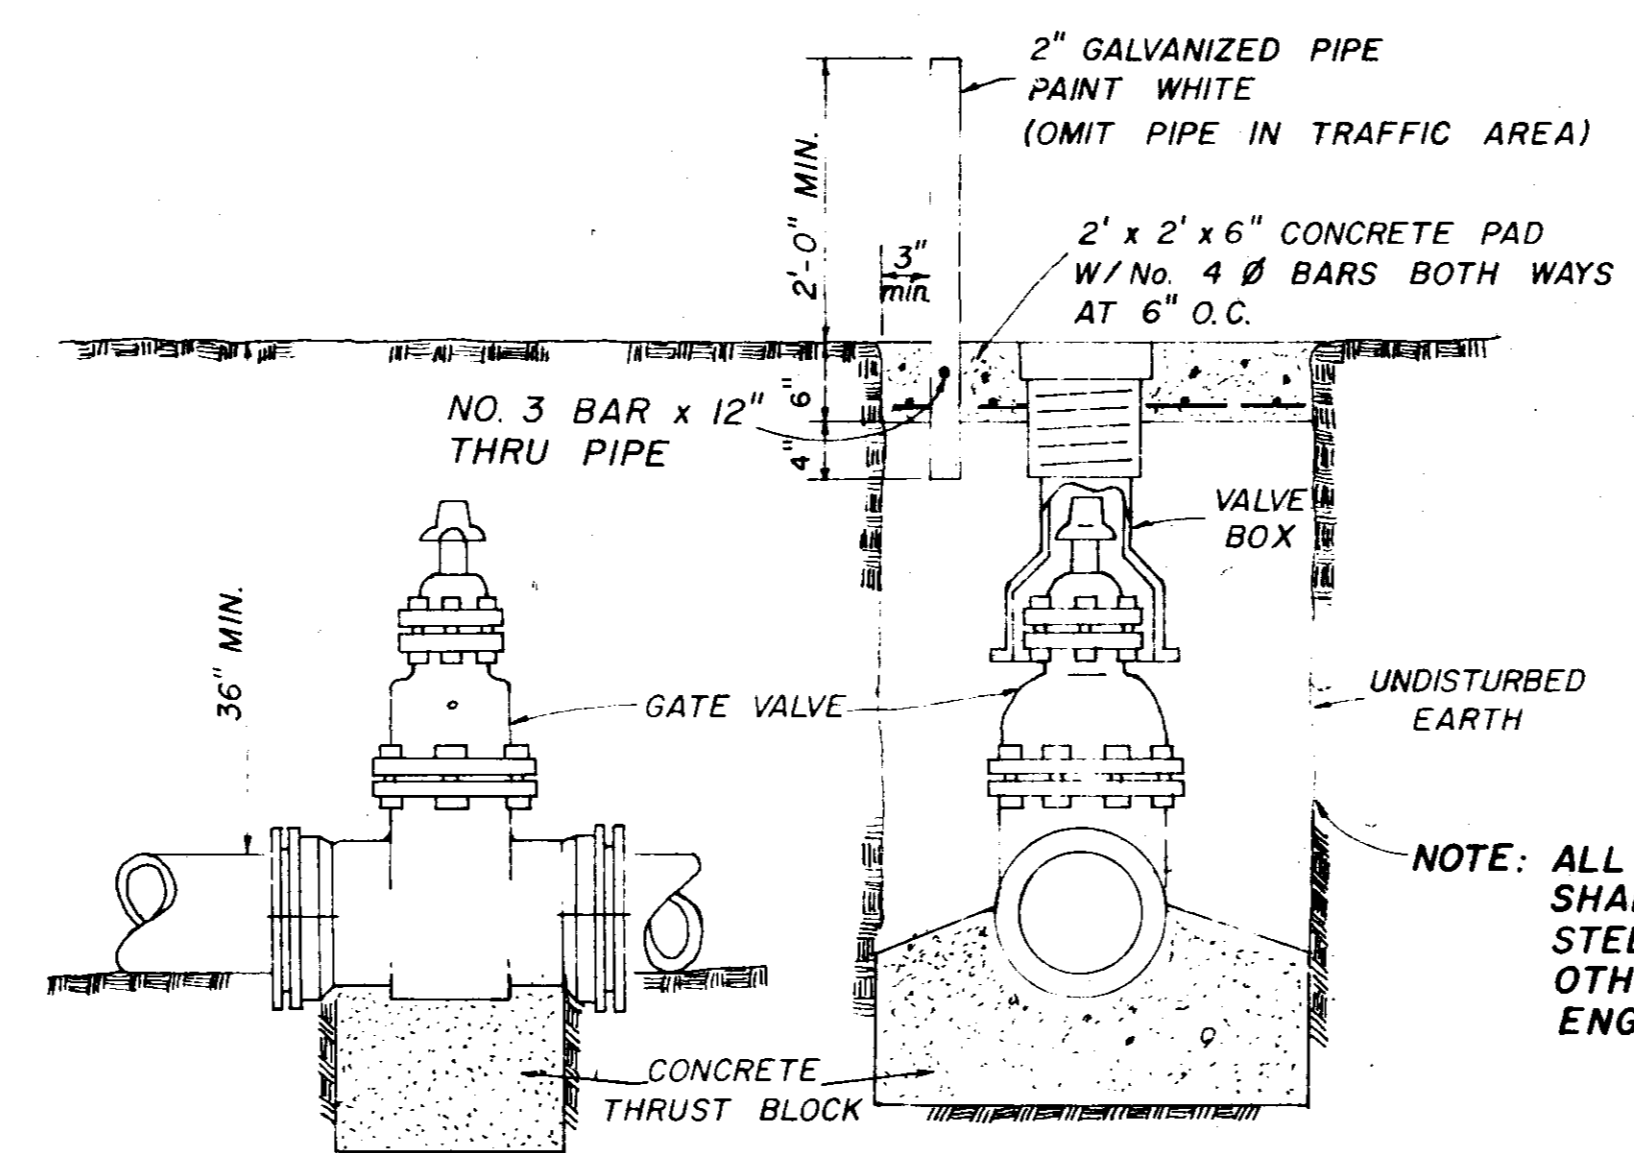


ELEVATION

SECTION

TYPICAL VALVE & BOX


NOTE: ALL WATER MAIN CONNECTIONS SHALL BE RODDED WITH ALL STEEL RODS (3/4" MIN) UNLESS OTHERWISE INSTRUCTED BY ENGINEER.

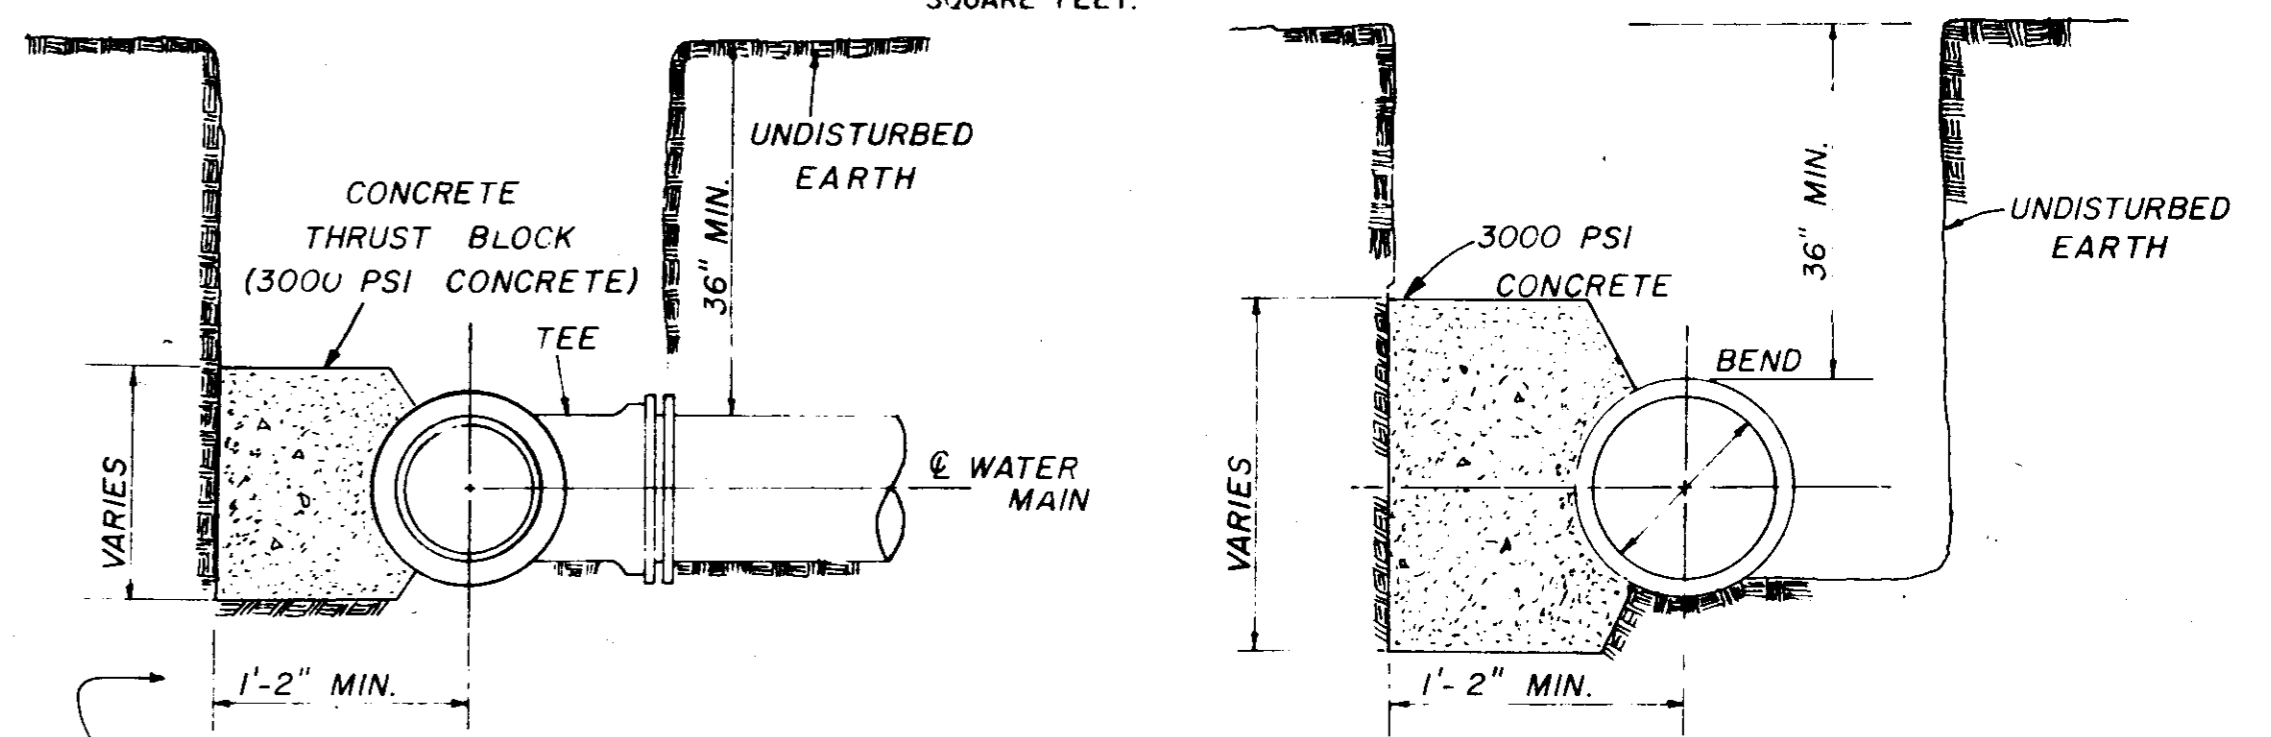



SECTION

SECTION


BLOCKING DETAILS FOR TEES & BENDS

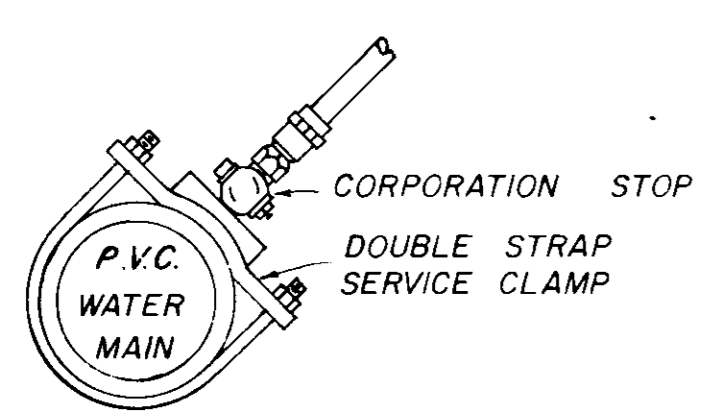

STREET REPAIR OF OPEN CUT

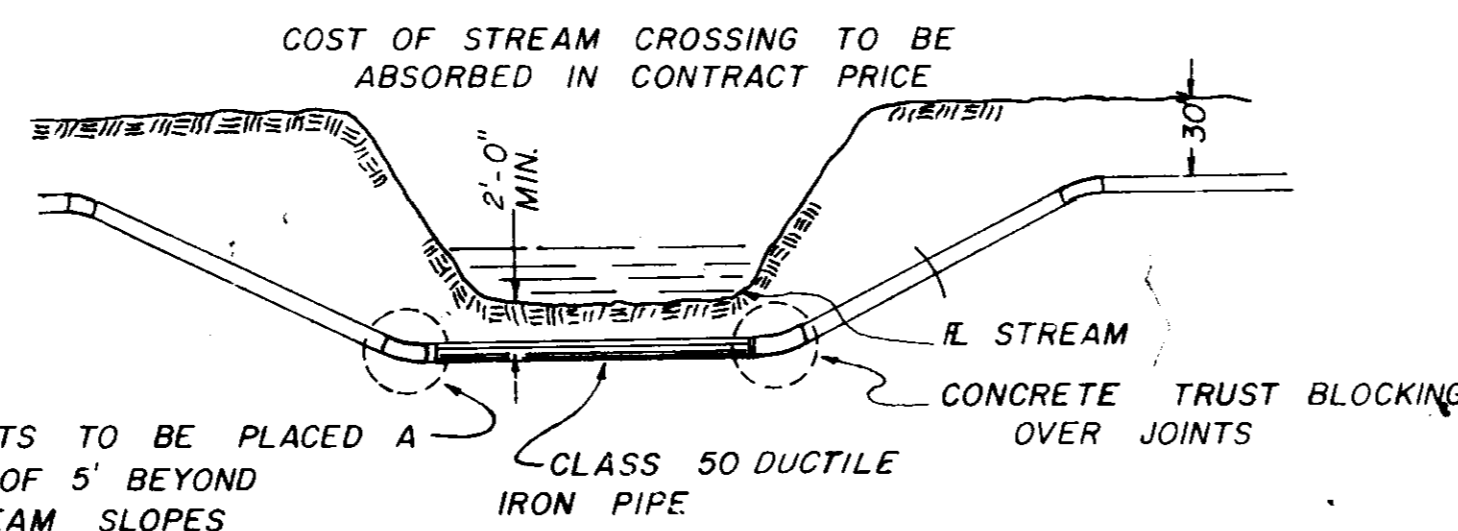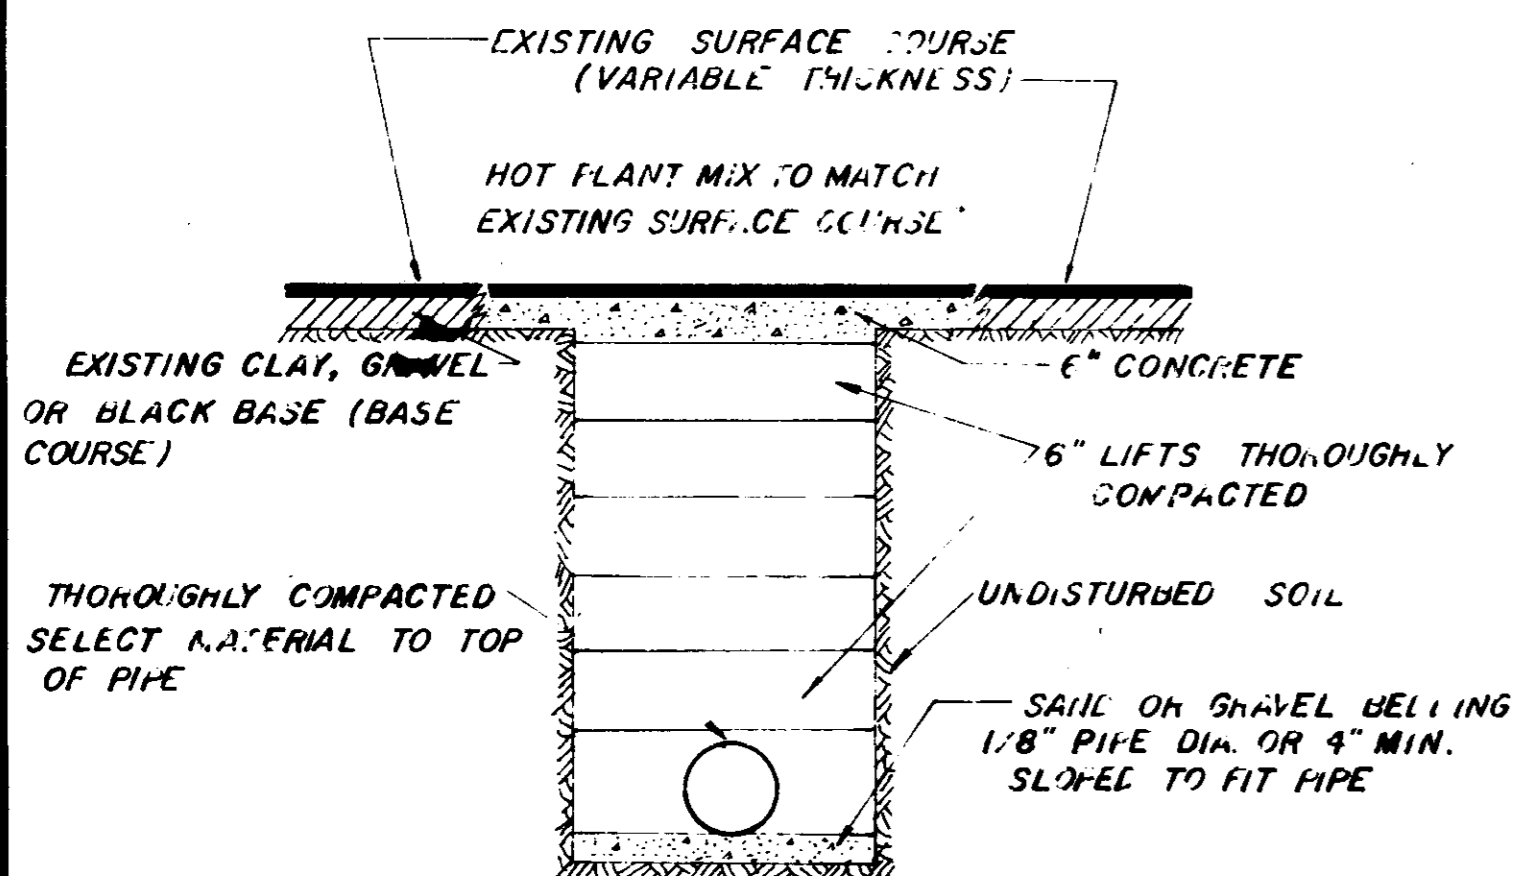


TYPICAL STREAM CROSSING

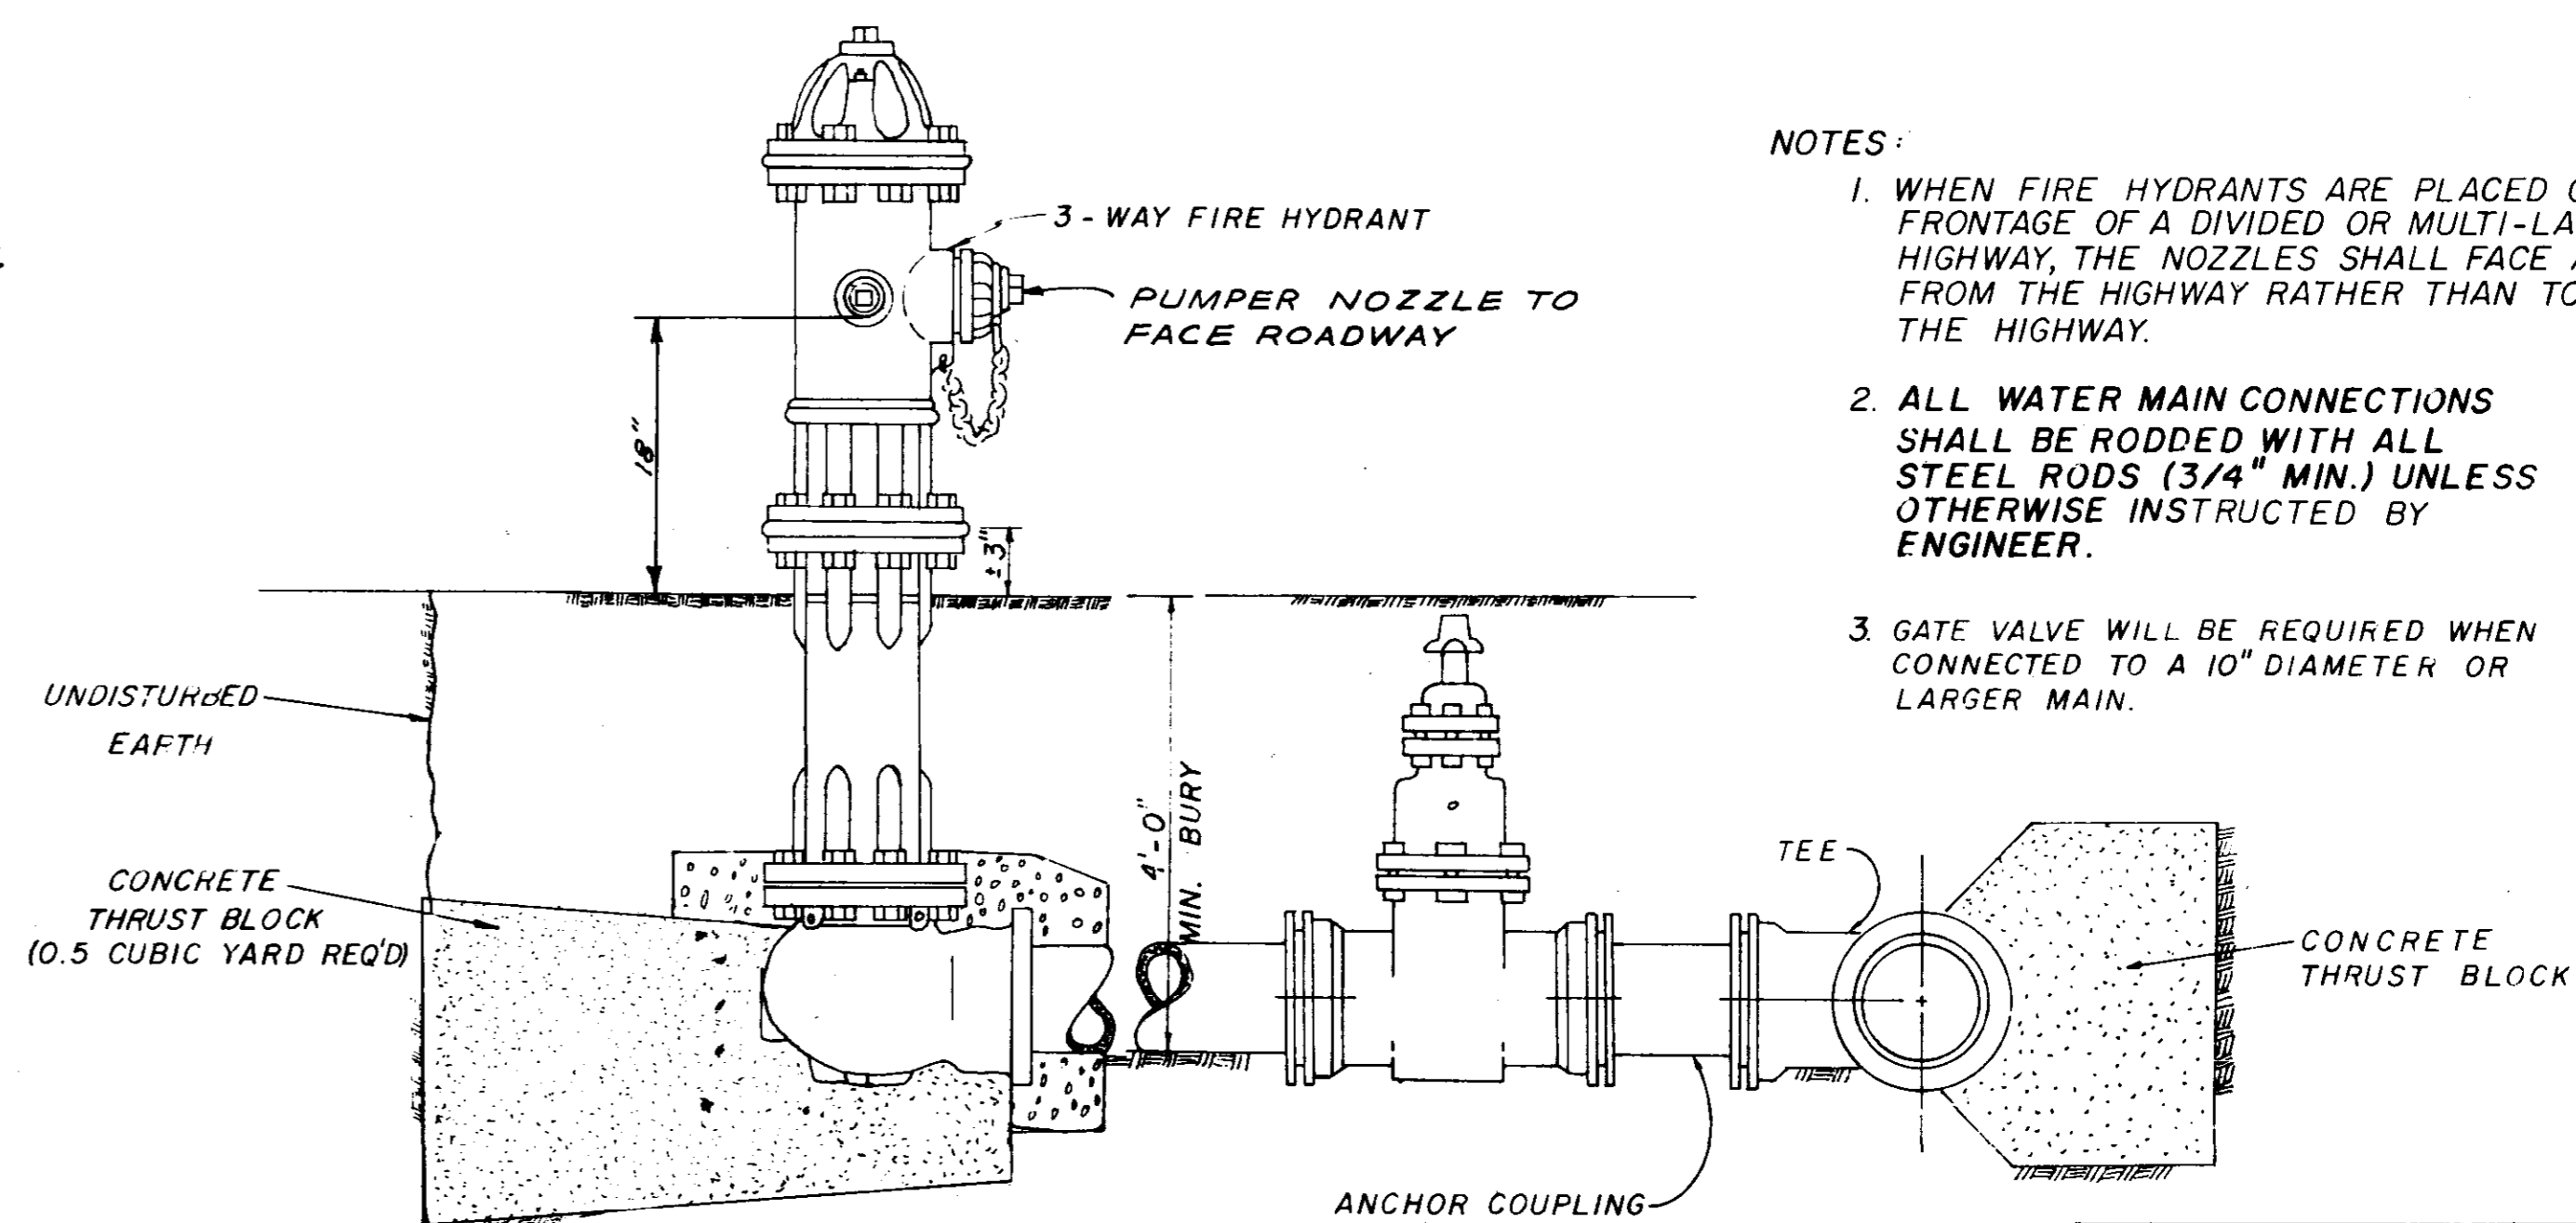


TYPICAL FIRE HYDRANT

- NOTES:
1. WHEN FIRE HYDRANTS ARE PLACED ON THE FRONTAGE OF A DIVIDED OR MULTI-LANE HIGHWAY, THE NOZZLES SHALL FACE AWAY FROM THE HIGHWAY RATHER THAN TOWARD THE HIGHWAY.
 2. ALL WATER MAIN CONNECTIONS SHALL BE RODDED WITH ALL STEEL RODS (3/4" MIN.) UNLESS OTHERWISE INSTRUCTED BY ENGINEER.
 3. GATE VALVE WILL BE REQUIRED WHEN CONNECTED TO A 10" DIAMETER OR LARGER MAIN.

WATER SYSTEM STANDARD DETAILS

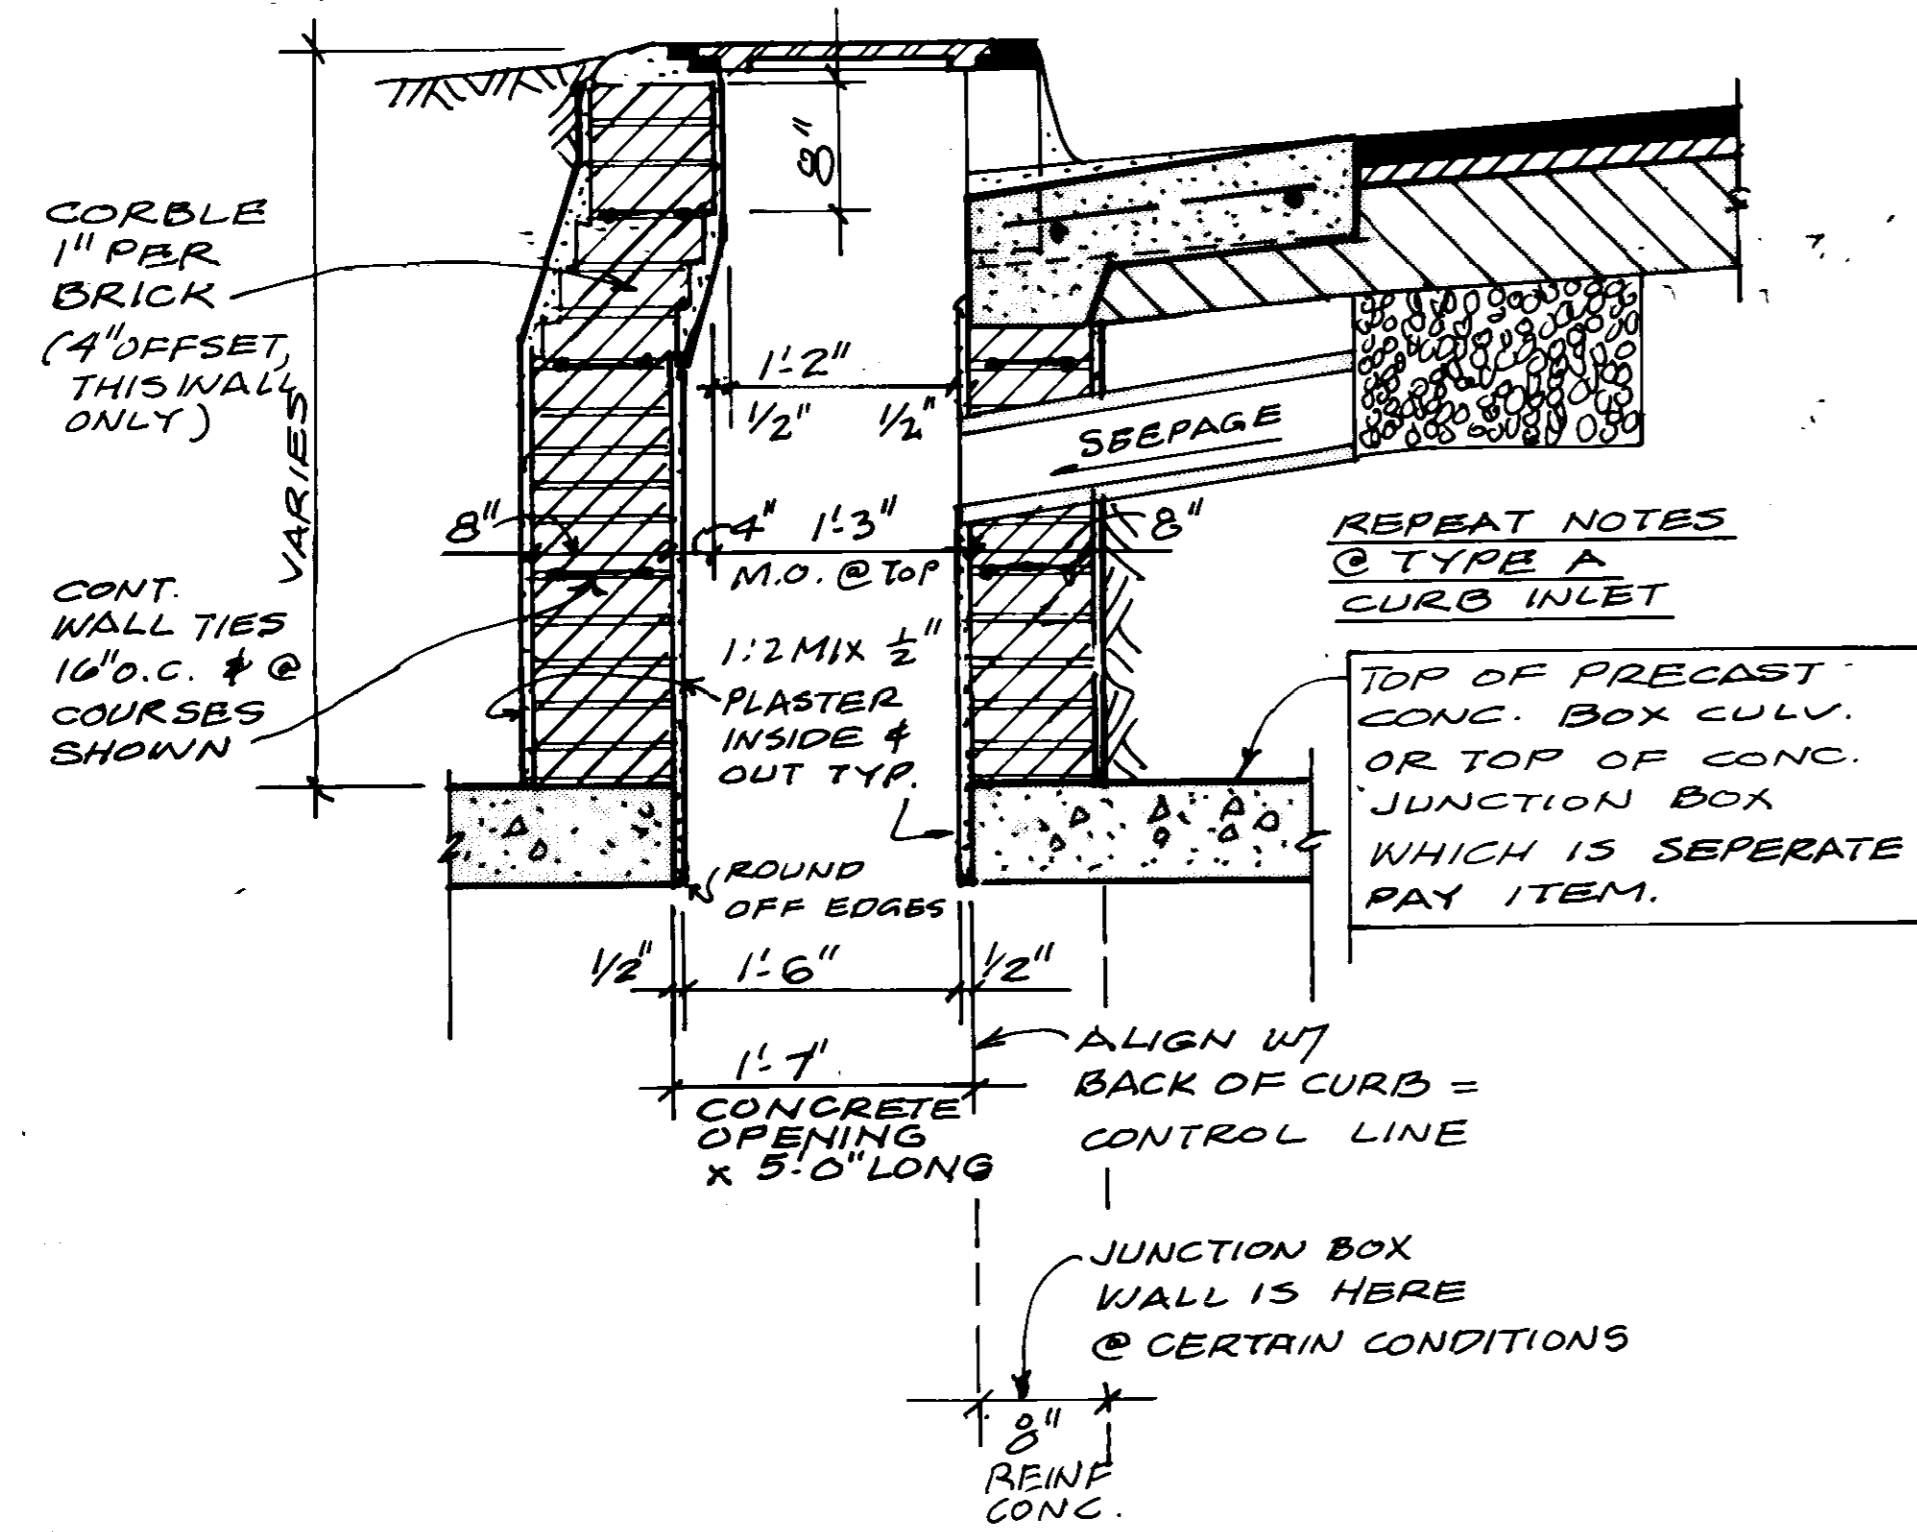


CURB INLET TYPE B
SCALE: 1" = 1'-0"

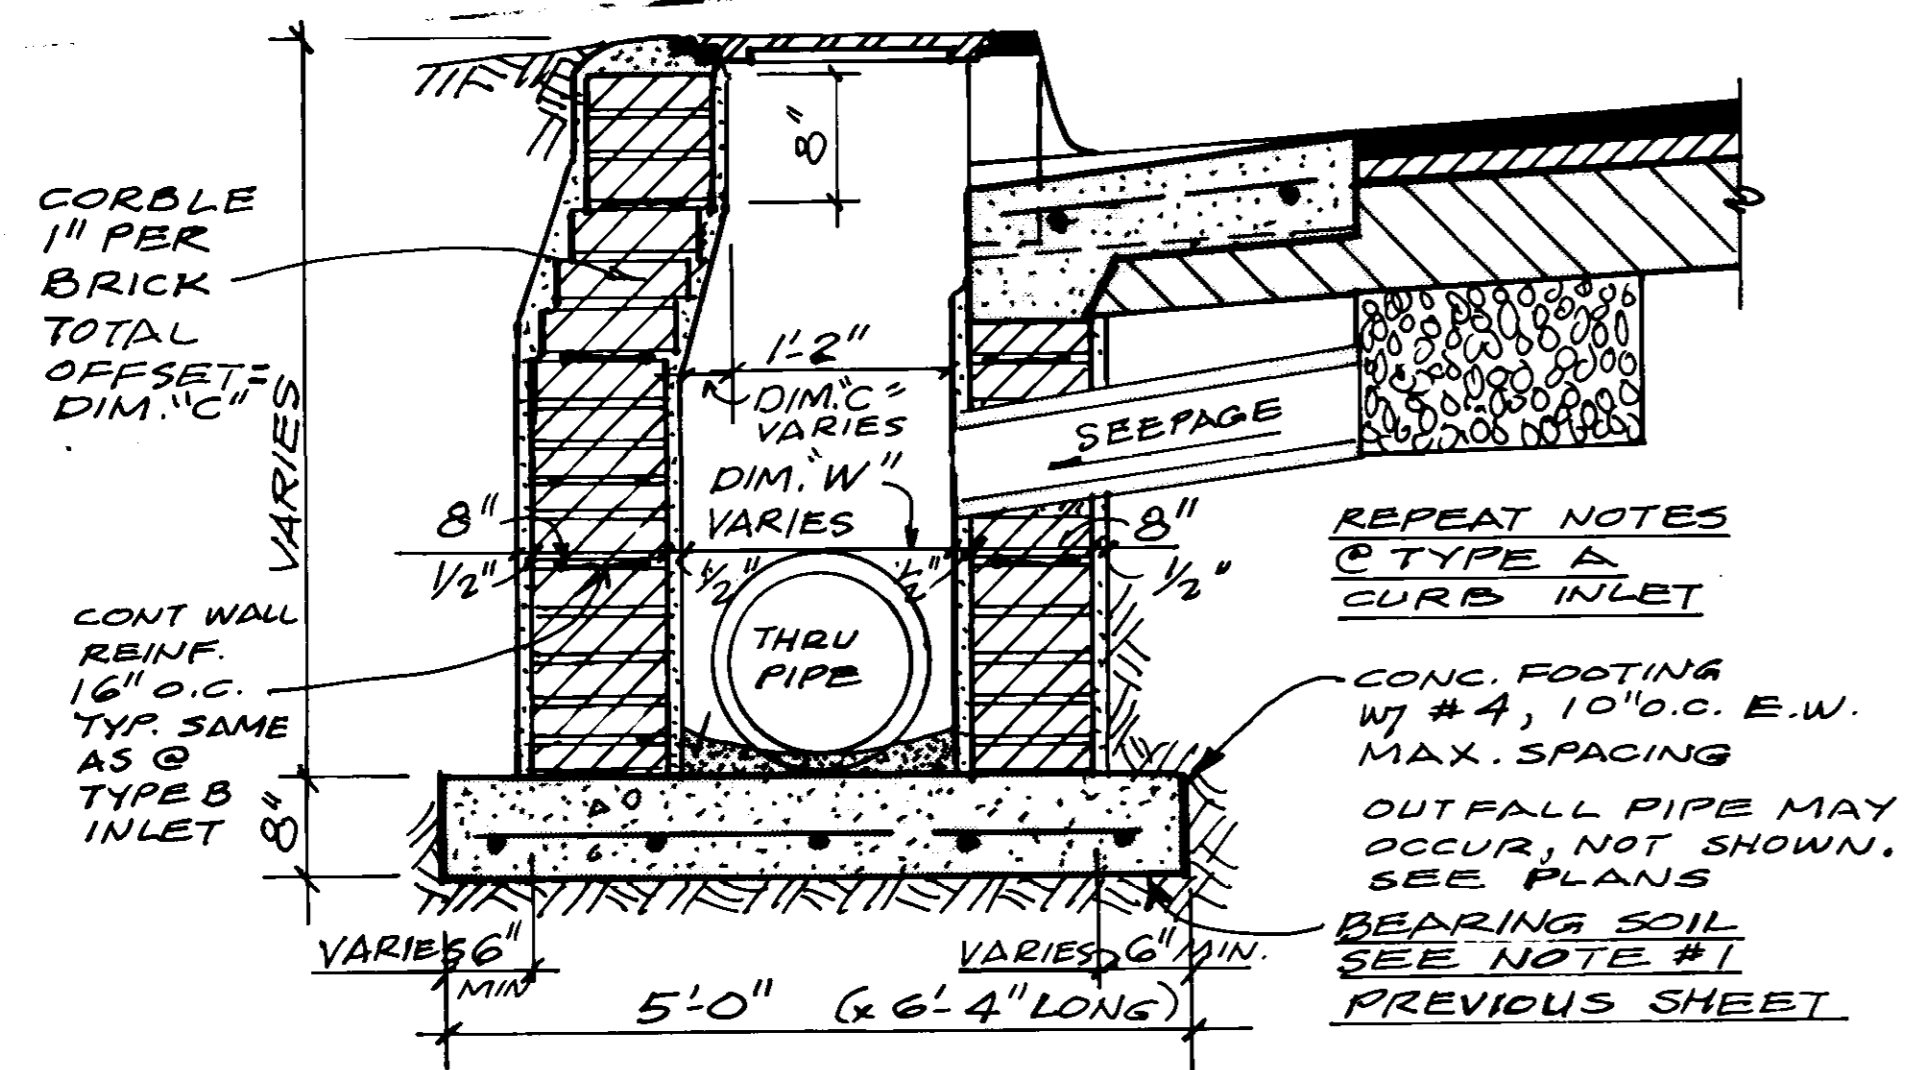


CURB INLET TYPE C
SCALE: 1" = 1'-0" (FOR THRU PIPES 15", 18" OR 21" DIA.)

PIPE I.D. *	DIM. "W" PLASTER TO PLAST. FINISHED WIDTH	DIM. "C" CORBEL OFFSET	NOTES FOR CORBELS
15"	2'-1"	1 1/2"	11 BRICK @ 1" CORBEL EA.
18"	2'-5"	1'-2"	14 BRICK @ 1" CORBEL EACH
21"	2'-7"	1'-5"	17 BRICK @ 1" CORBEL EACH


* LARGEST PIPE @ INLET

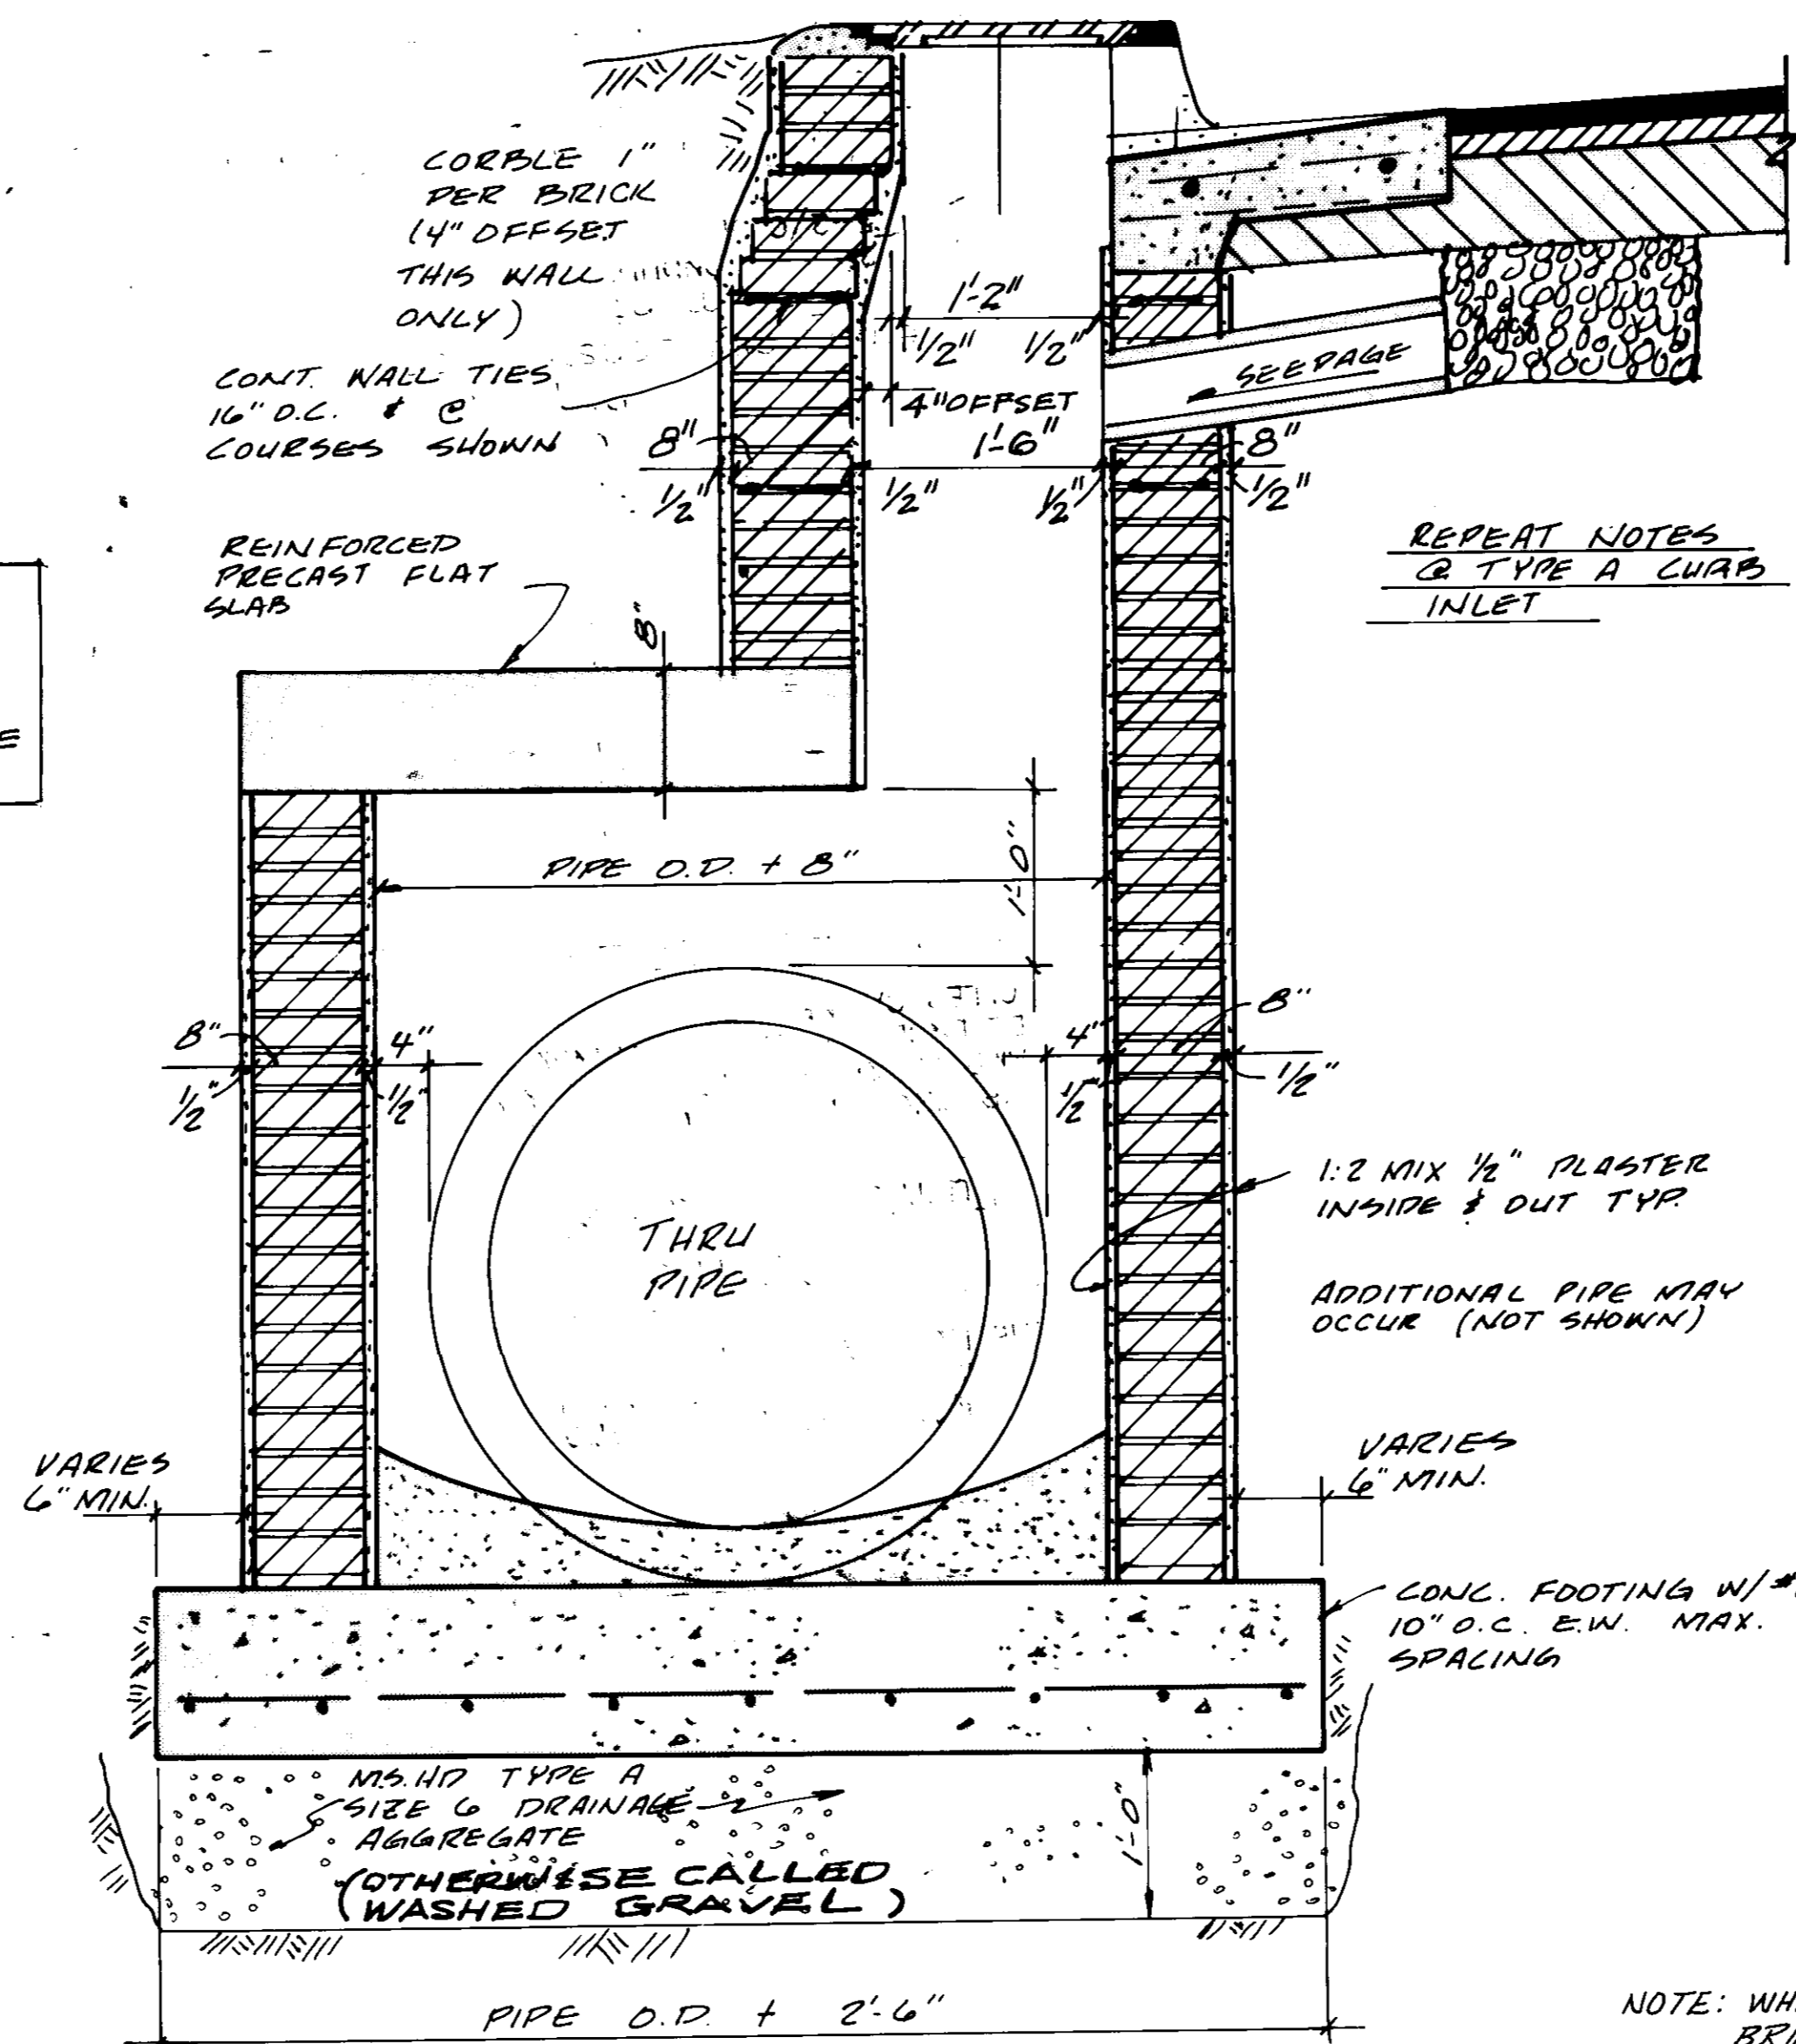

CURB INLET TYPE D
SCALE: 1 1/2" = 1'-0" (FOR THRU PIPES 24" & TO 36" DIA.)

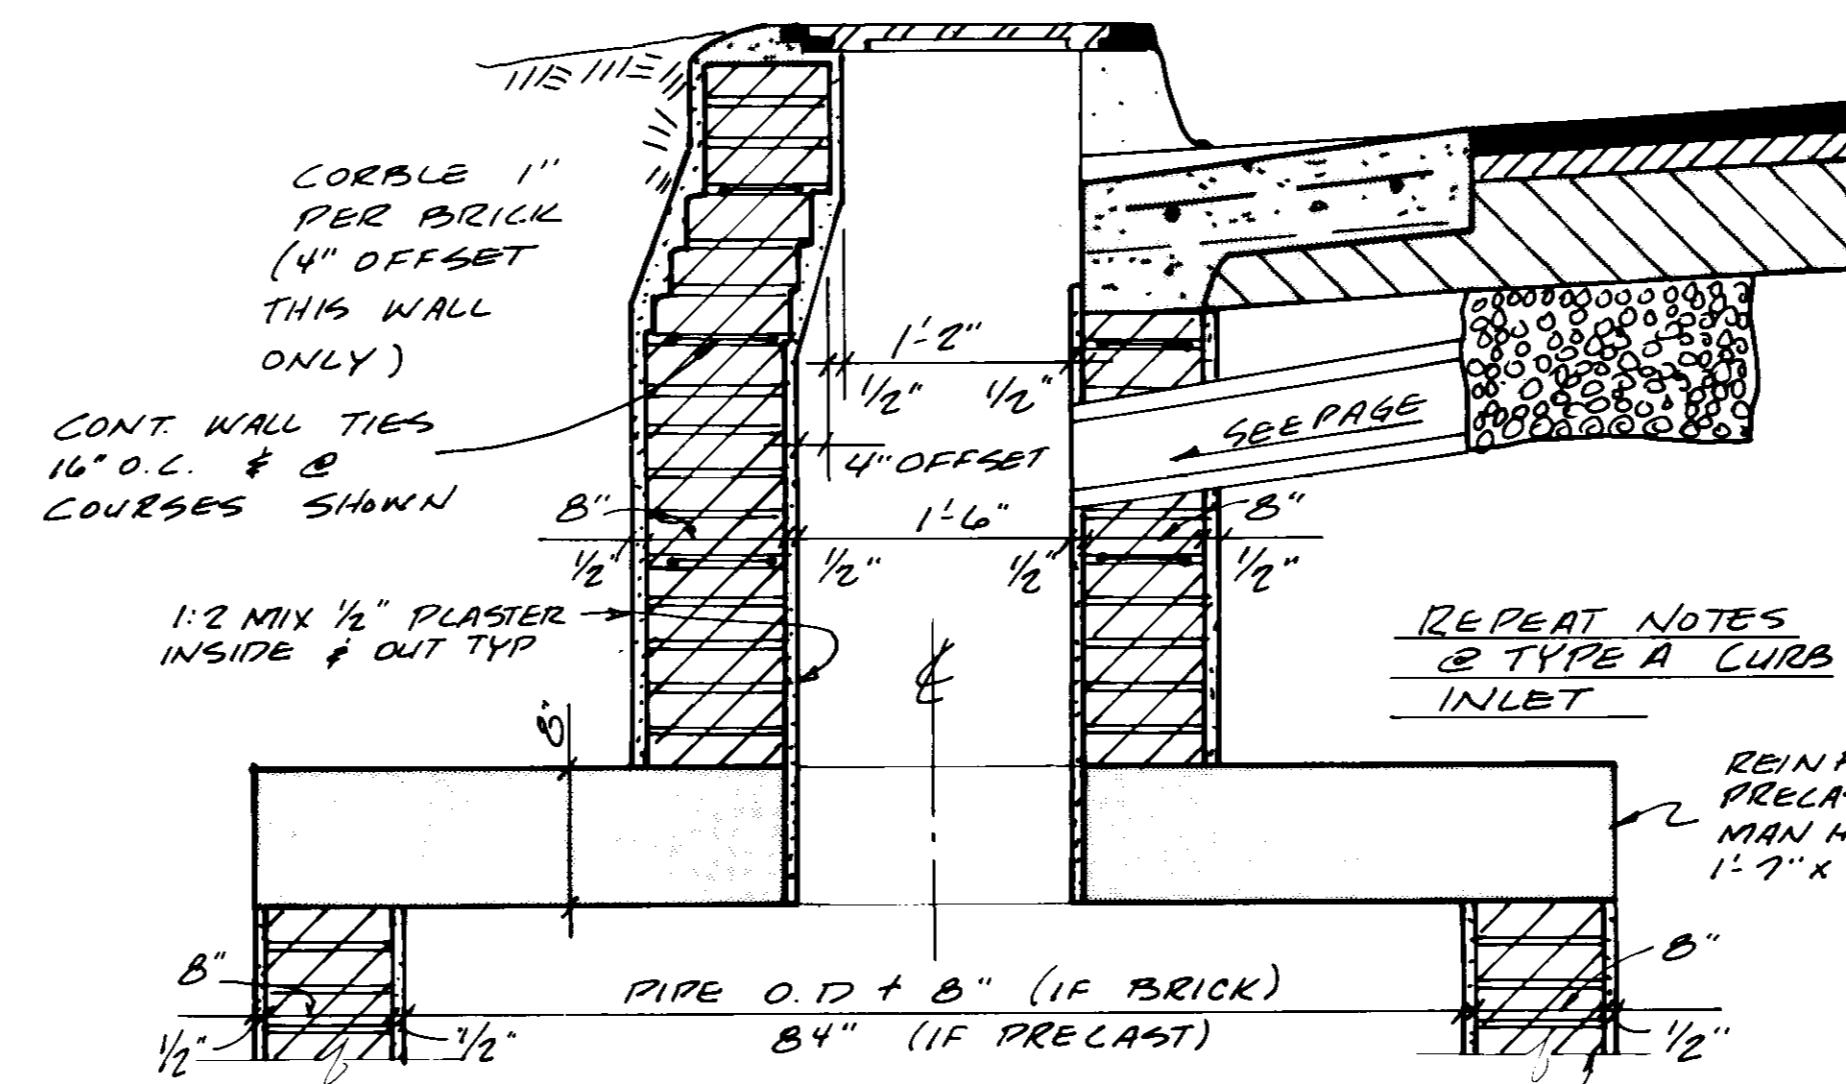


CURB INLET TYPE E
SCALE: 1" = 1'-0" (FOR THRU PIPES 42" & UP)

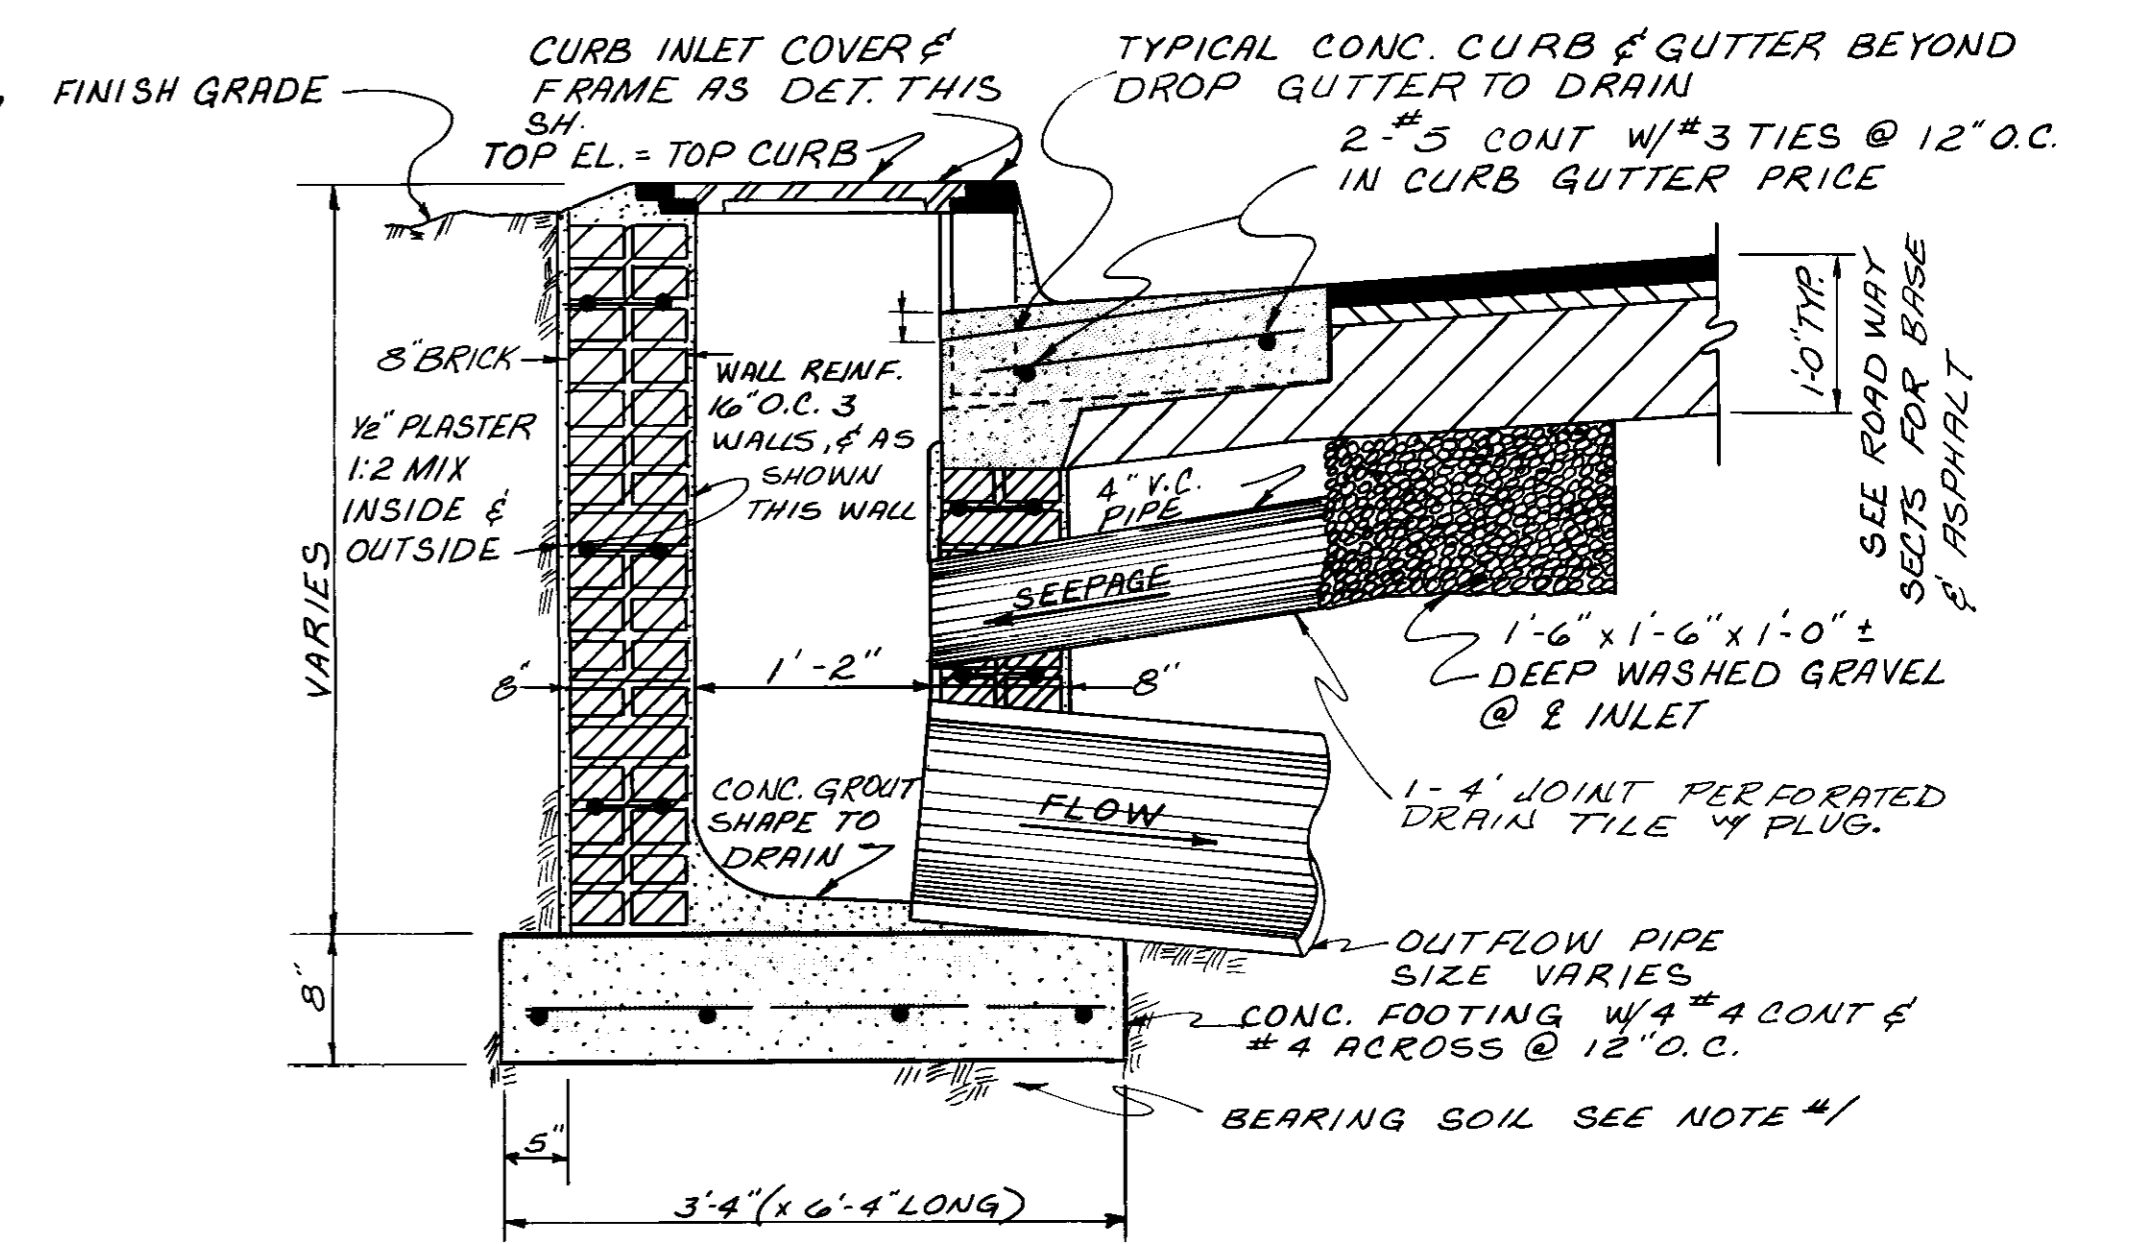


CURB INLET TYPE A

SCALE: 1" = 1'-0"
NOTE: 4" DIA. X 4'-0" LONG PIPE AND WASHED GRAVEL INCLUDED W/ COST OF INLET.

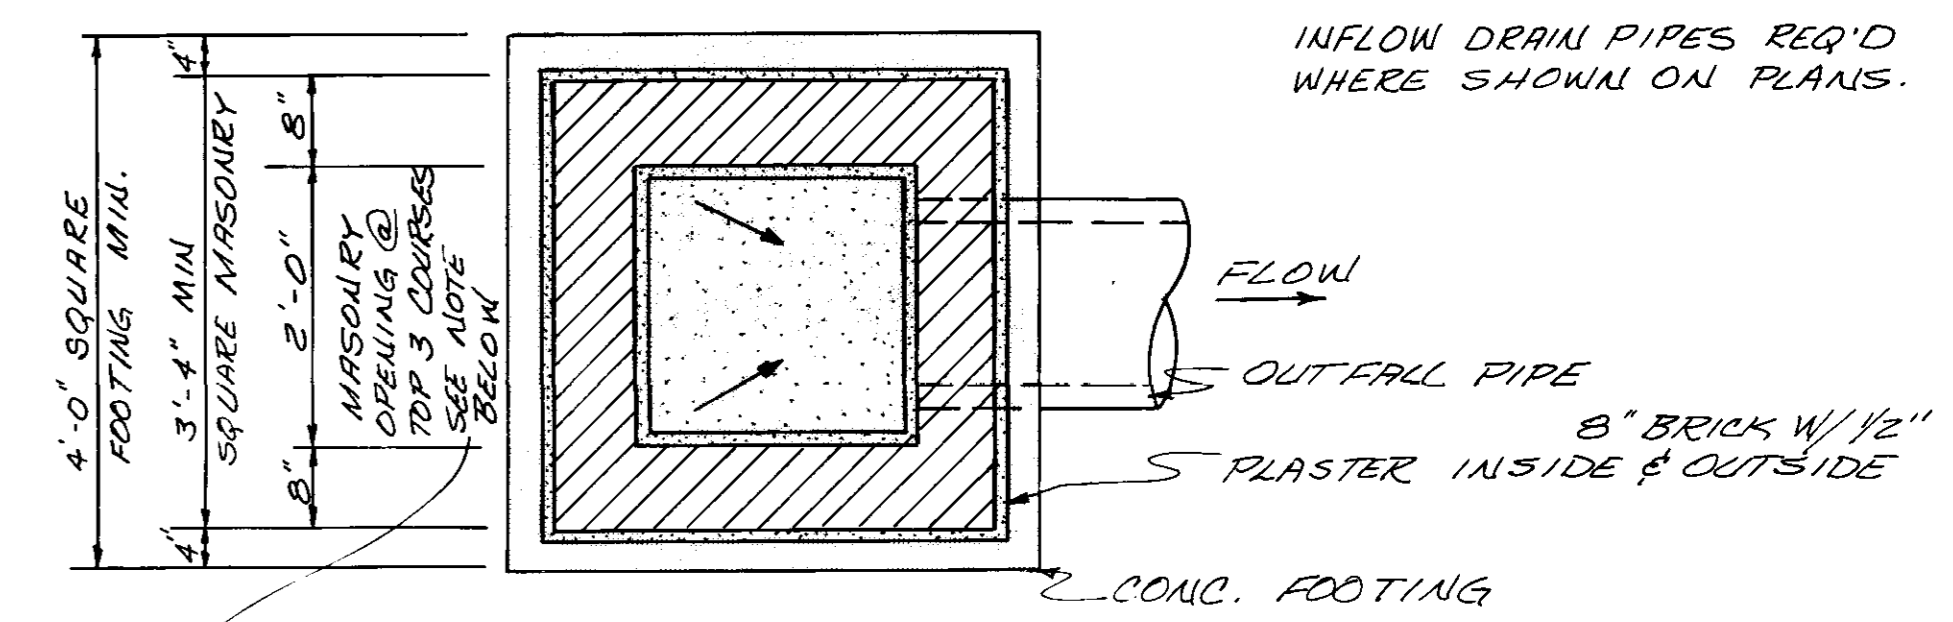

PLAN SECTION

NOTE: WHERE 24" DIA. PIPE OCCURS, CORBEL BRICK BACK 1" PER BRICK, BEGINNING 8" BELOW GRATE FRAME TO INCREASE BOX SIZE TO ACCOMMODATE PIPE O.D. + 4" I. INCREASE FOOTING AS REQ'D. TO MAINTAIN 4"

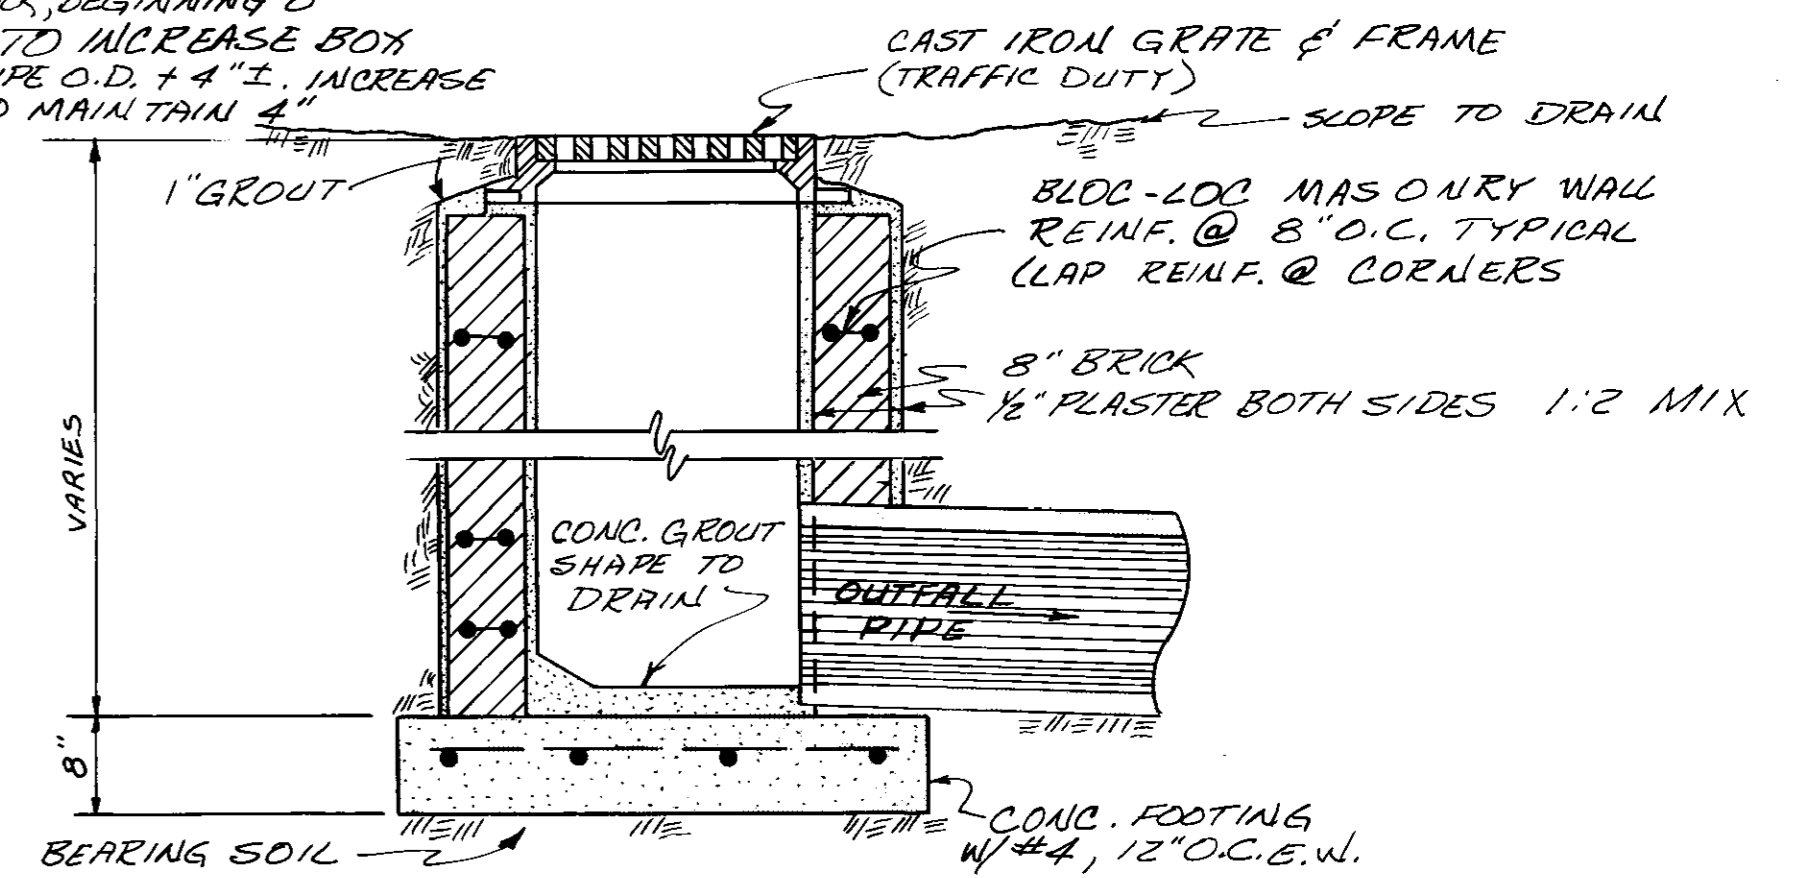

GRATE INLET

TYPICAL INLET DETAILS			
JOE A. WAGGONER Civil Engineer - Brandon/Jackson, Miss.			
DRAWN BY: H.R./R.G.N.	DATE: MARCH, 1983	SHEET NO. 22 OF 22	
CHECKED BY: JAW	SCALE: AS NOTED		