

REGISTERED PROFESSIONAL ENGINEER  
STATE OF MISSISSIPPI  
6430

Matrix	Date
1 GENERAL	5-23-07
2 GENERAL	6-5-07
3 GENERAL	7-3-07


**TOMPKINS BARRON, PLLC**  
6520 DOGWOOD VIEW PARKWAY  
GARDEN OFFICE, SUITE E  
JACKSON, MS 39213

**GRADING AND DRAINAGE PLAN**  
RETAIL/OFFICE BUILDING  
NORTH PARK DRIVE  
RIDGELAND  
MISSISSIPPI 39157

PROJ. • 200605  
DATE: 02/23/07  
BY: K.T.C.

**1.3**

**GRADING AND DRAINAGE PLAN**  
SCALE: 1" = 20'

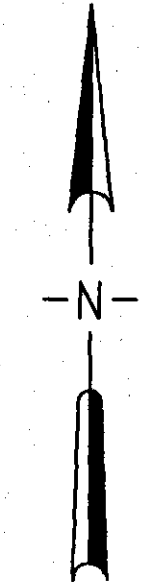

NOTE: THE CONTRACT DRAWINGS ARE NOT ORGANIZED SPECIFICALLY FOR ANY CRAFT, TRADE, DISCIPLINE, OR SUBCONTRACT. THEREFORE, ADDITIONAL RELATED INFORMATION MAY BE INCLUDED IN OTHER CONTRACT DRAWINGS AND SPECIFICATIONS EVEN THOUGH NOT SPECIFICALLY NOTED ON THIS DOCUMENT. IT IS THE RESPONSIBILITY OF EACH PARTY TO REFER TO THE COMPLETE SET OF CONTRACT DRAWINGS AND SPECIFICATIONS AND NOT TO A PARTIAL OR INCOMPLETE SET OF DOCUMENTS.

SE #06114  
**Spencer-Engineers, Inc. Consultants**  
P.O. Box 4328 Jackson, MS 39216  
(601) 982-7766