



CITY OF MADISON

CITY OF RIDGELAND

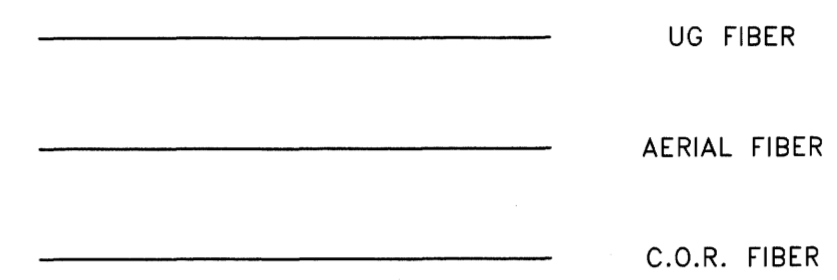


ALL FIBER IS
AERIAL UNLESS
MARKED UG

PWP-01216

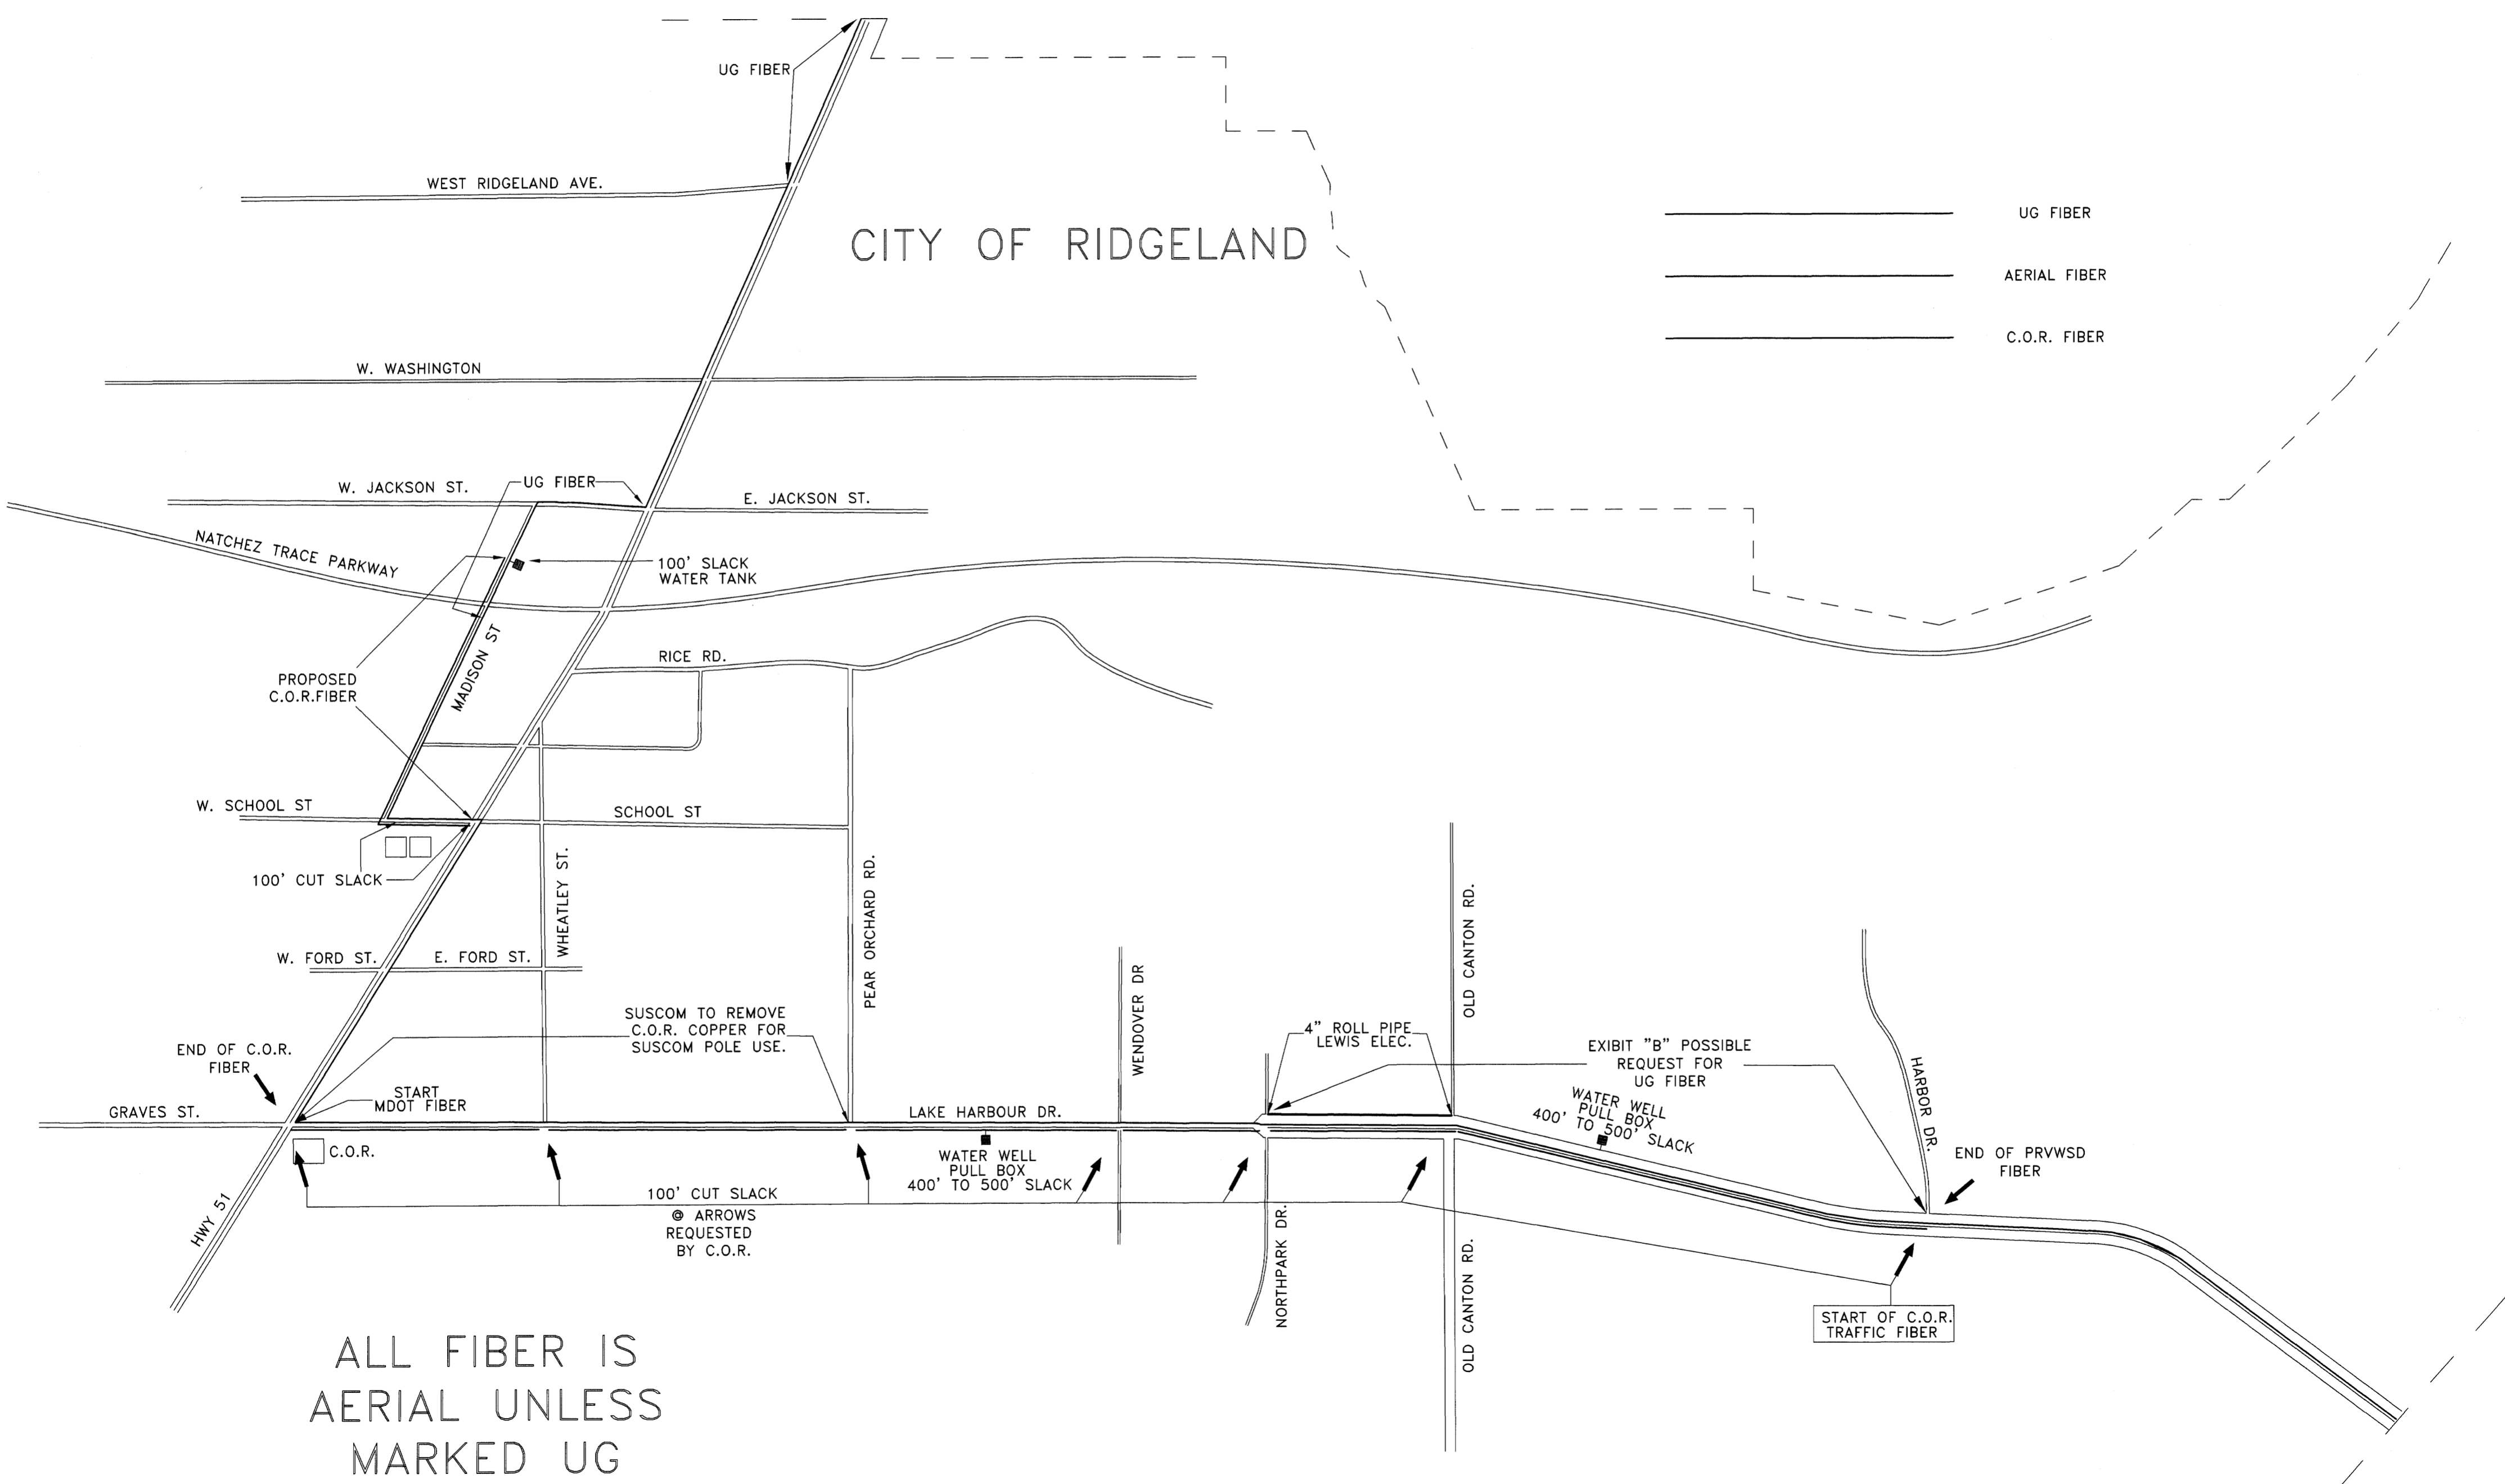

CITY OF MADISON

CITY OF RIDGELAND

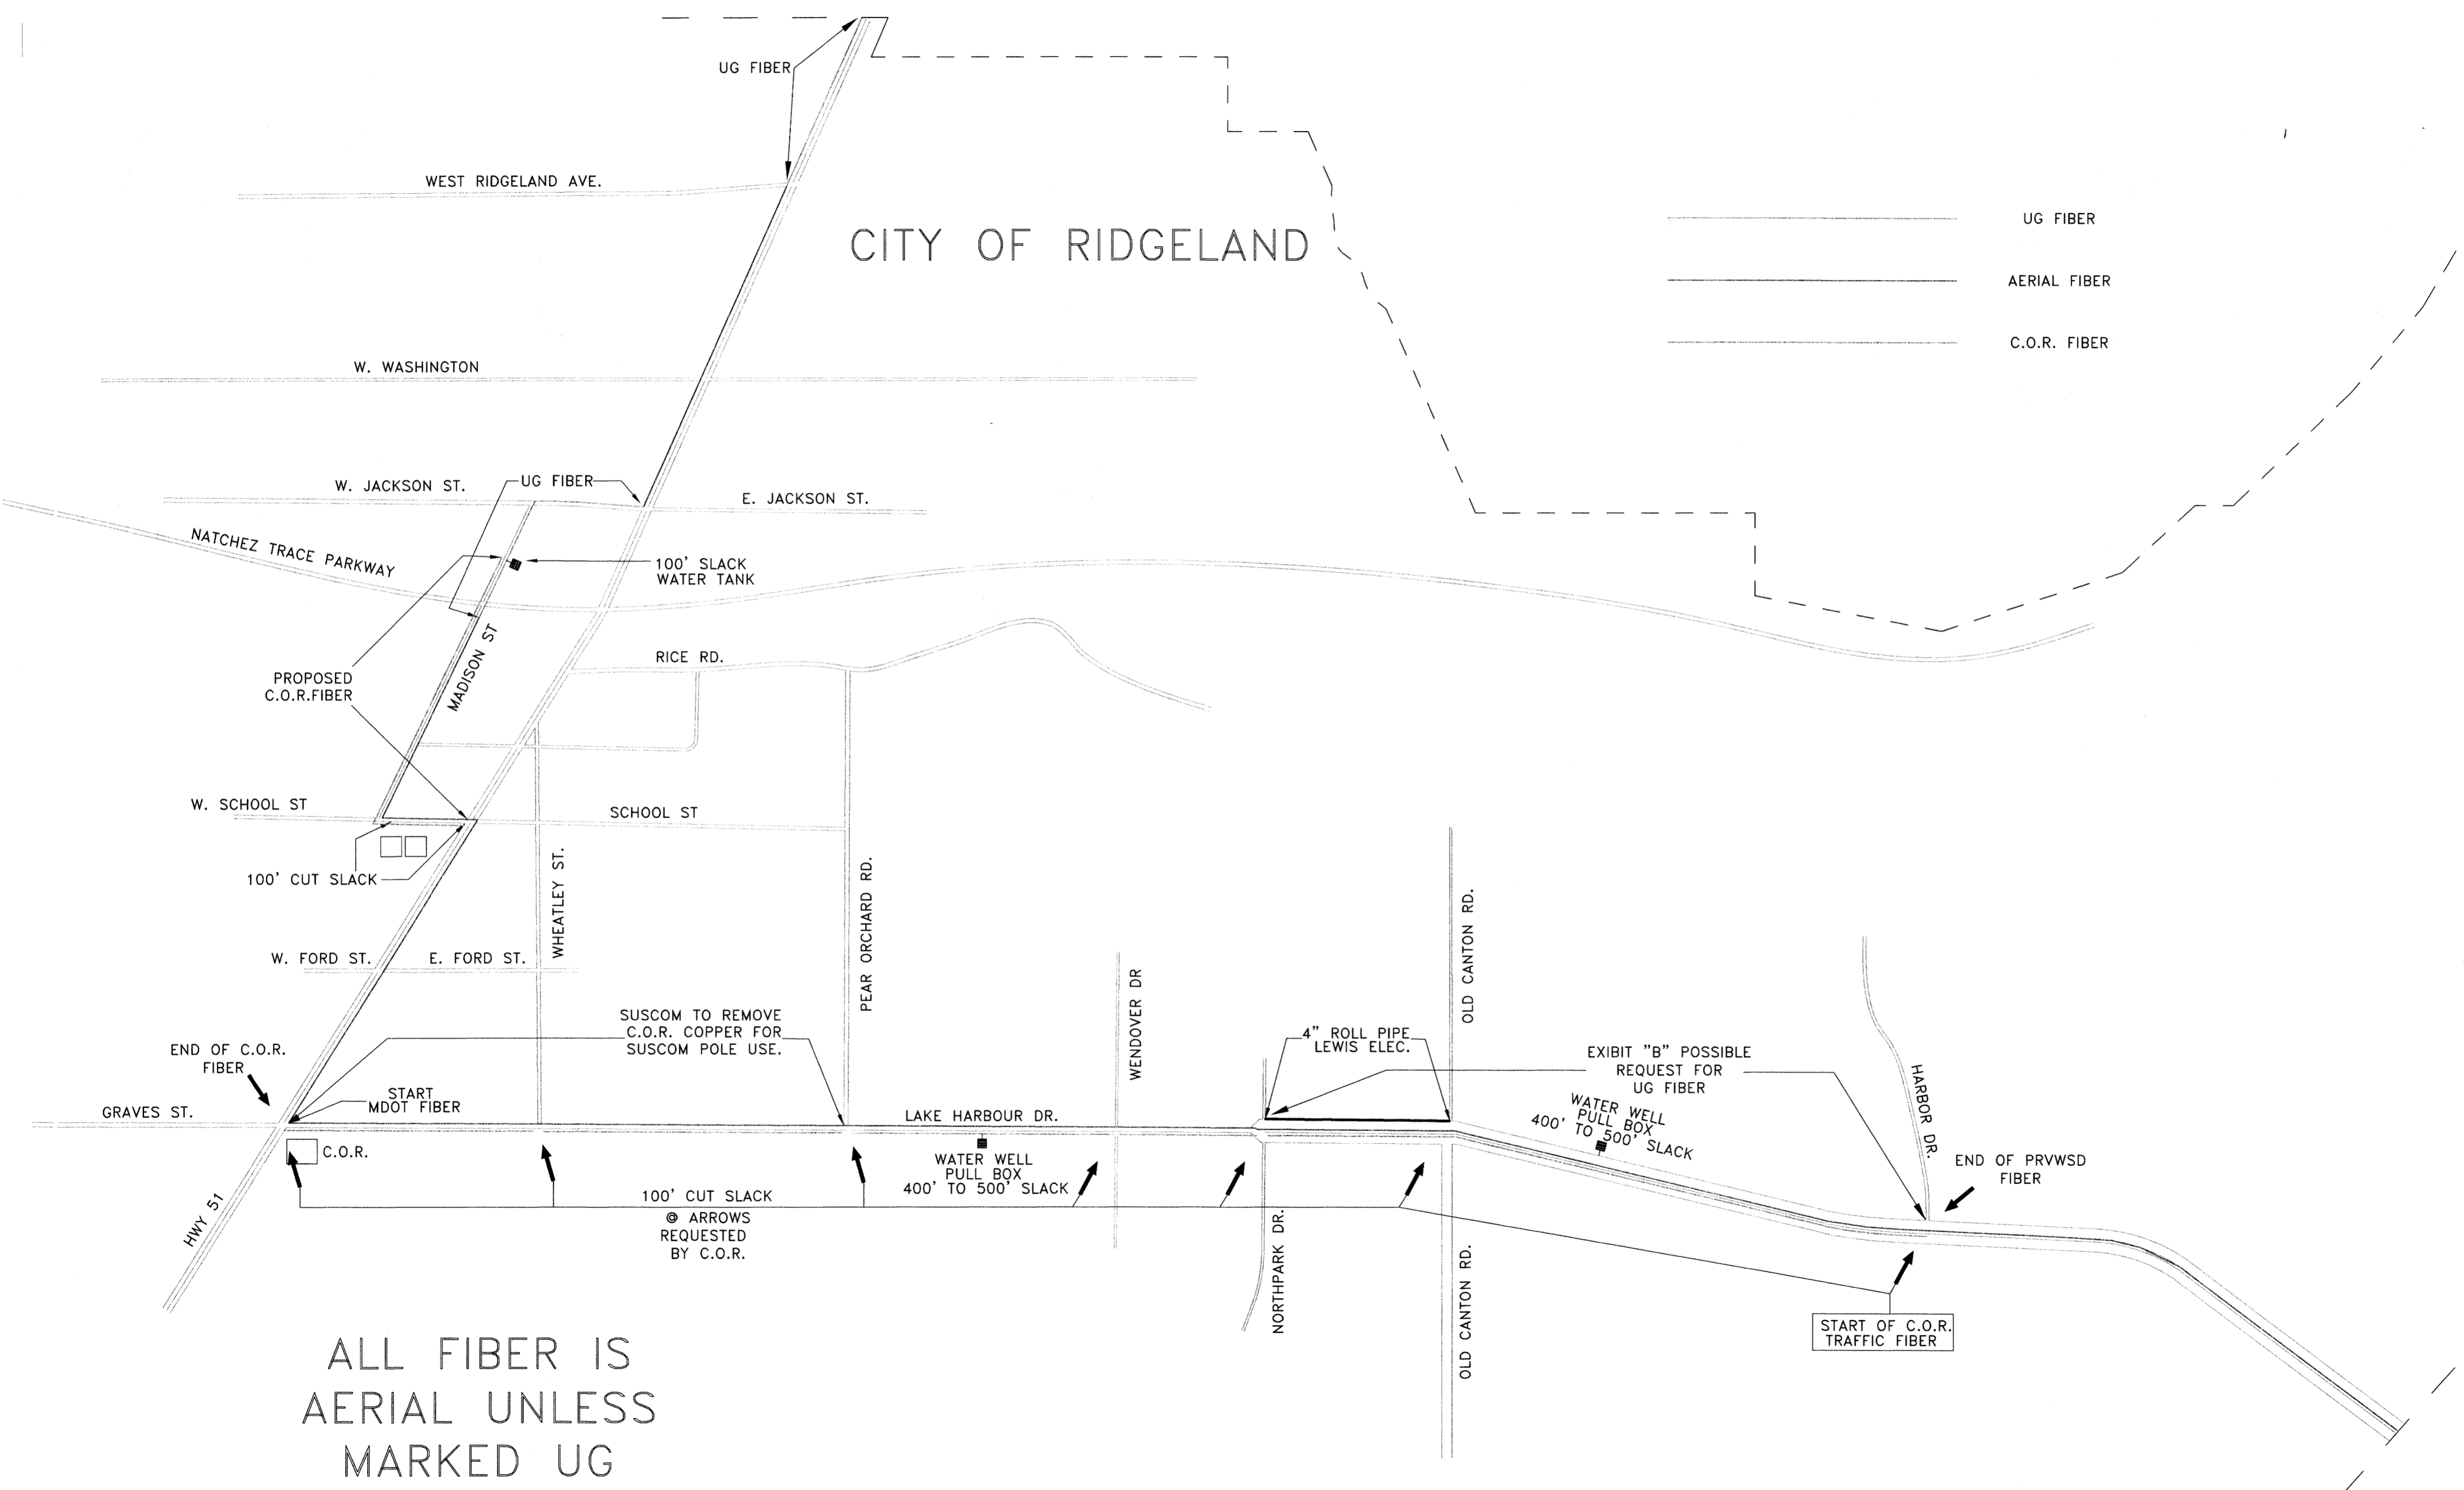

UG FIBER
AERIAL FIBER
C.O.R. FIBER

ALL FIBER IS
AERIAL UNLESS
MARKED UG