
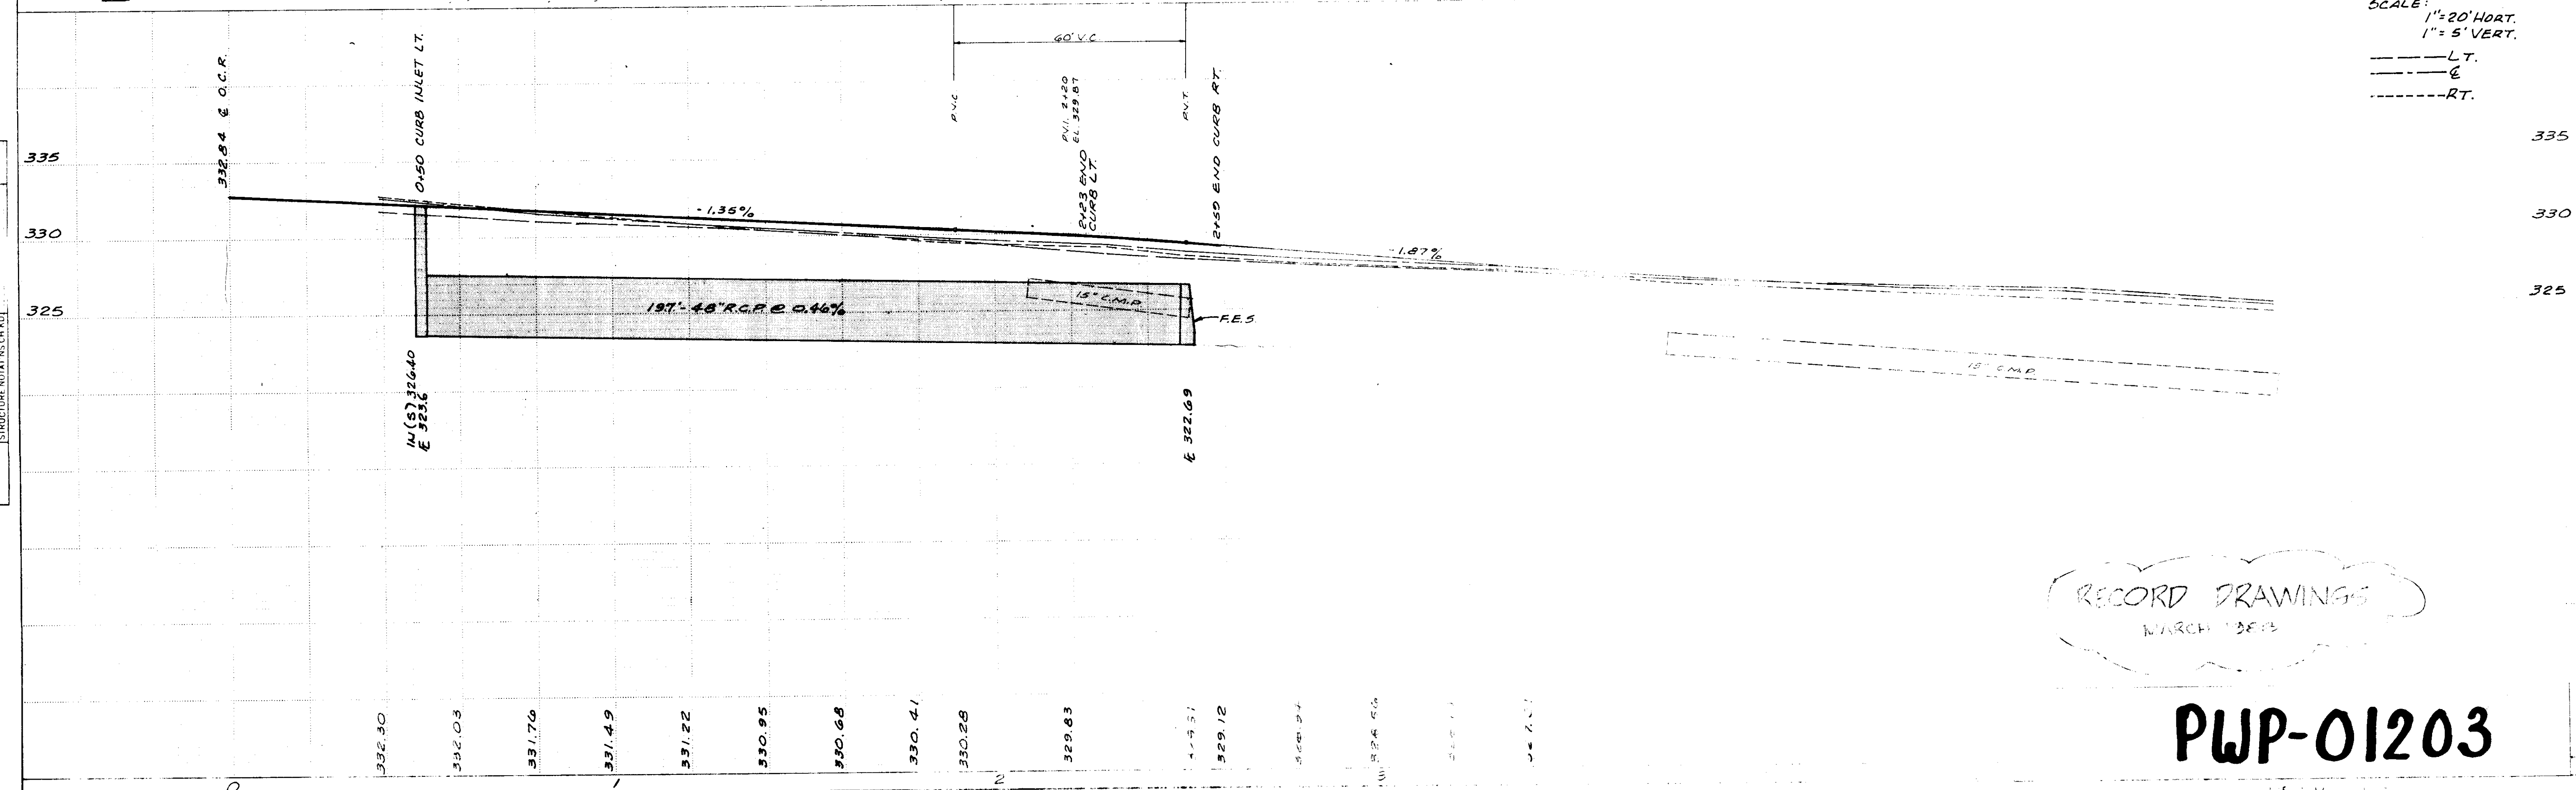


PLAN	DATE
SURVEYED	BY
PLOTTED	BY
CHECKED	BY
NO.	


PROFILE	DATE
SURVEYED	BY
PLOTTED	BY
CHECKED	BY
NO.	

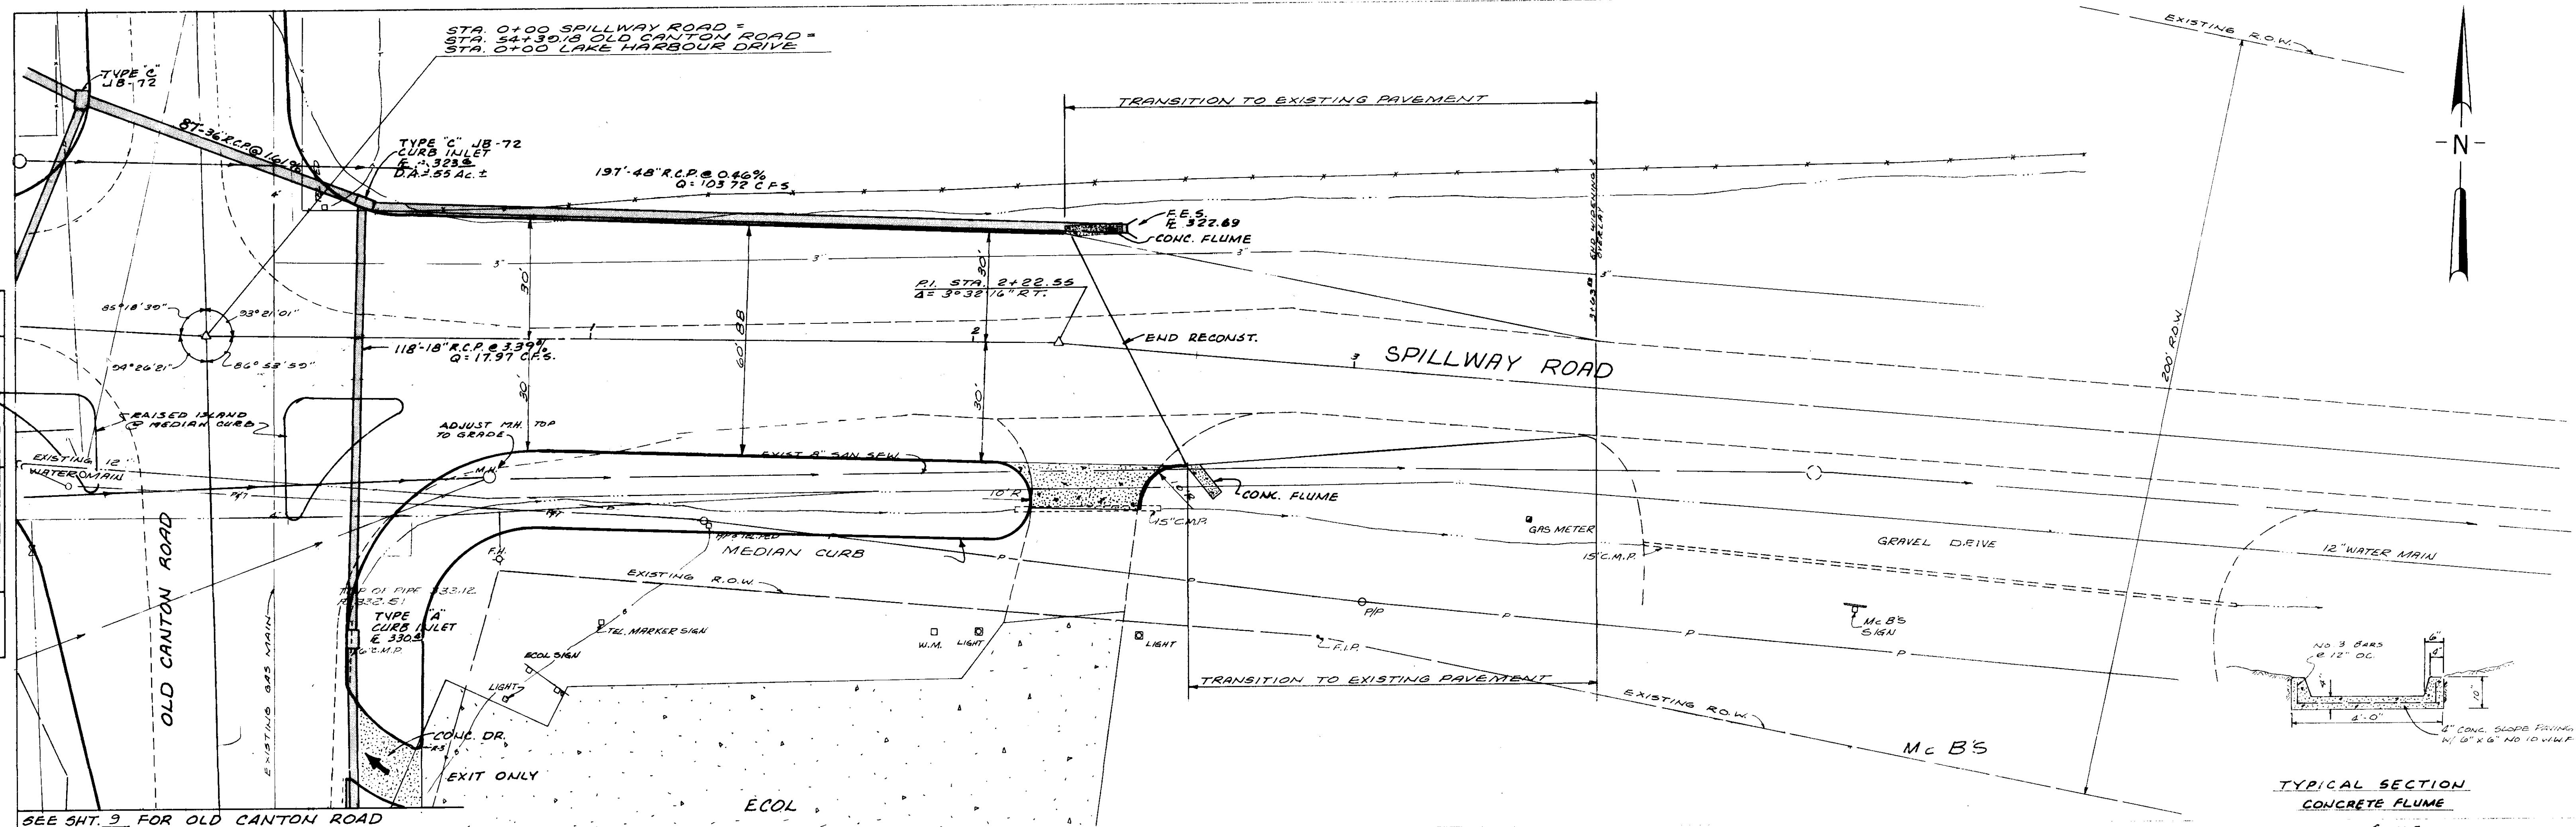

RECORD DRAWINGS
 MARCH 1983

PWP-01203

SEE SHT. 9 FOR OLD CANTON ROAD

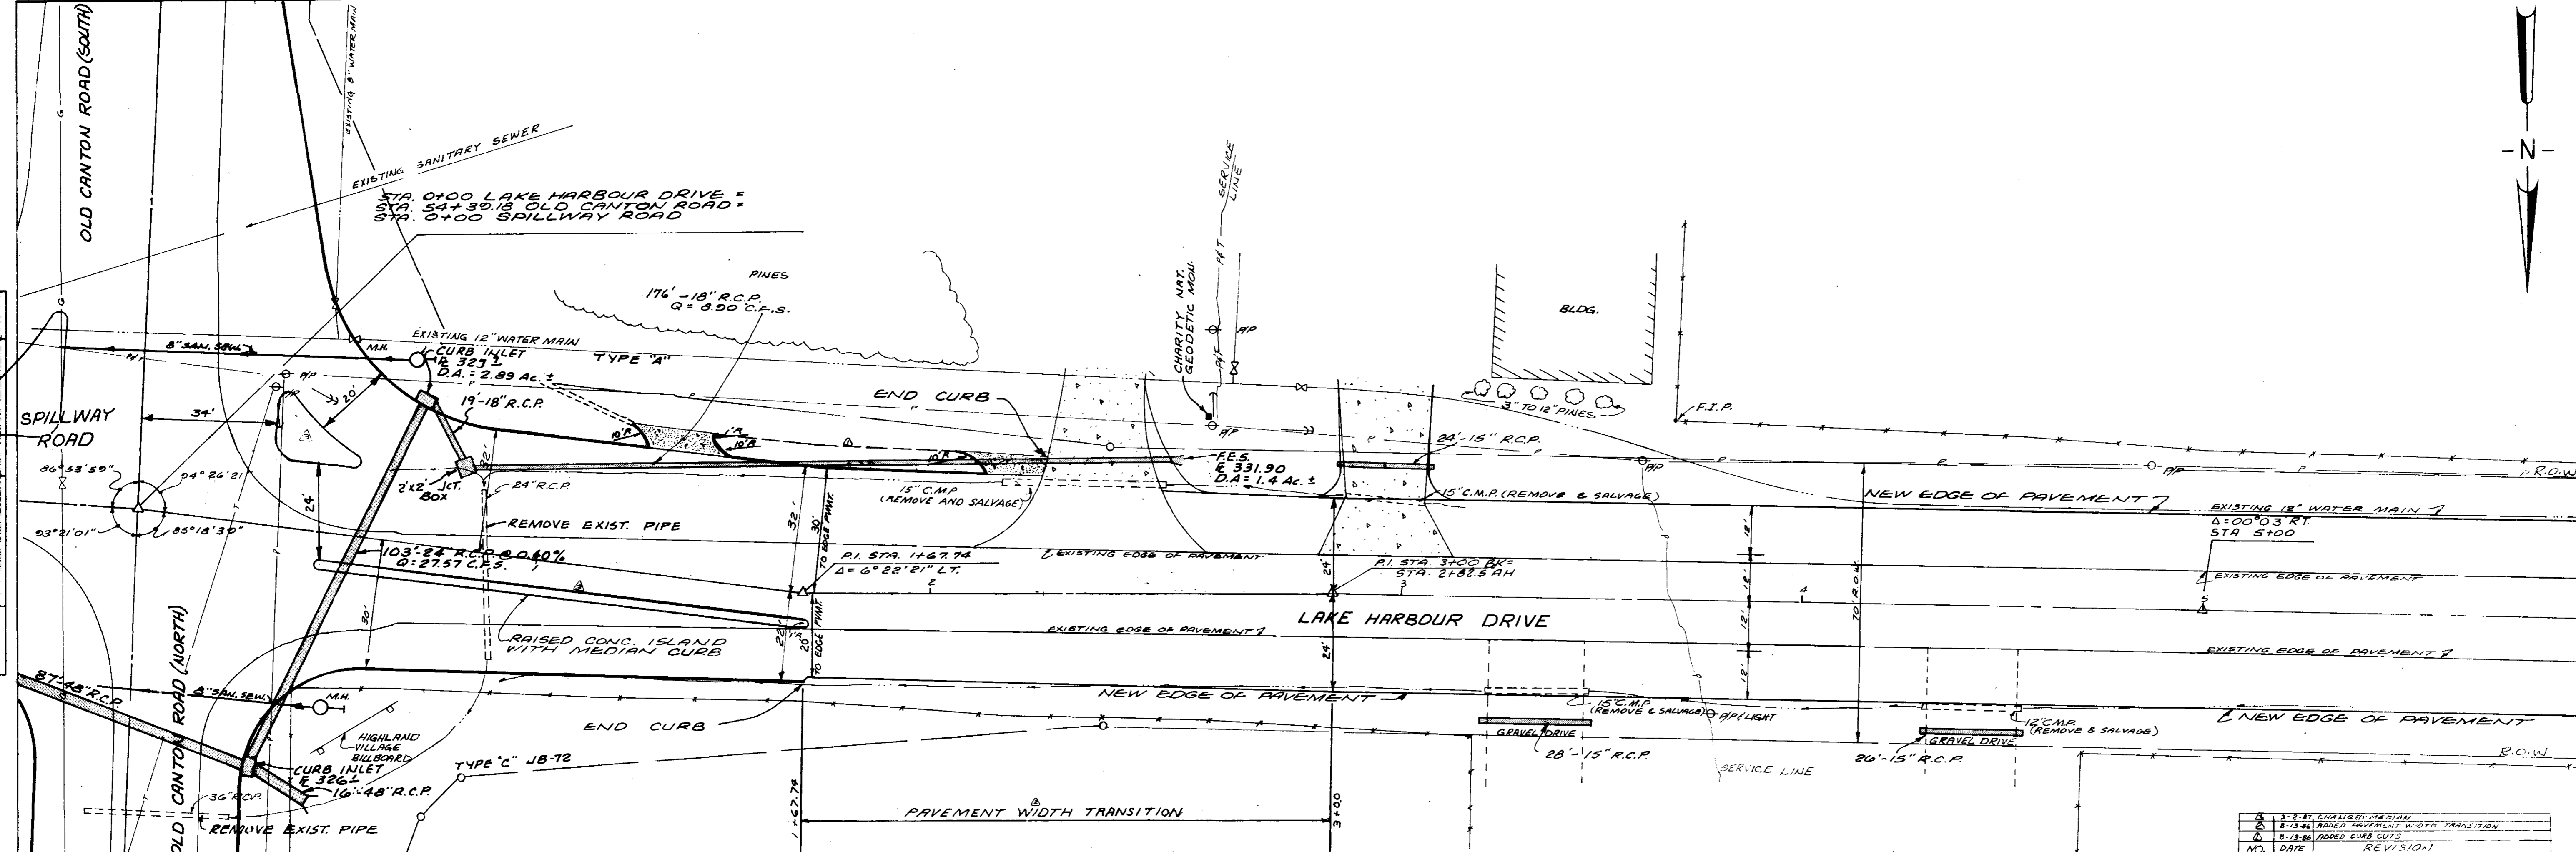


MATCH LINE STA 0+00 SEE SHEET 15

NO.	DATE	REVISION
1		BY: ENR/10/10/10/10
2		BY: ENR/10/10/10/10
3		BY: ENR/10/10/10/10

SCALE: 1" = 20' HORT. 1" = 5' VERT.

--- LT --- RT

SEE SHT. 10 FOR OLD CANTON ROAD

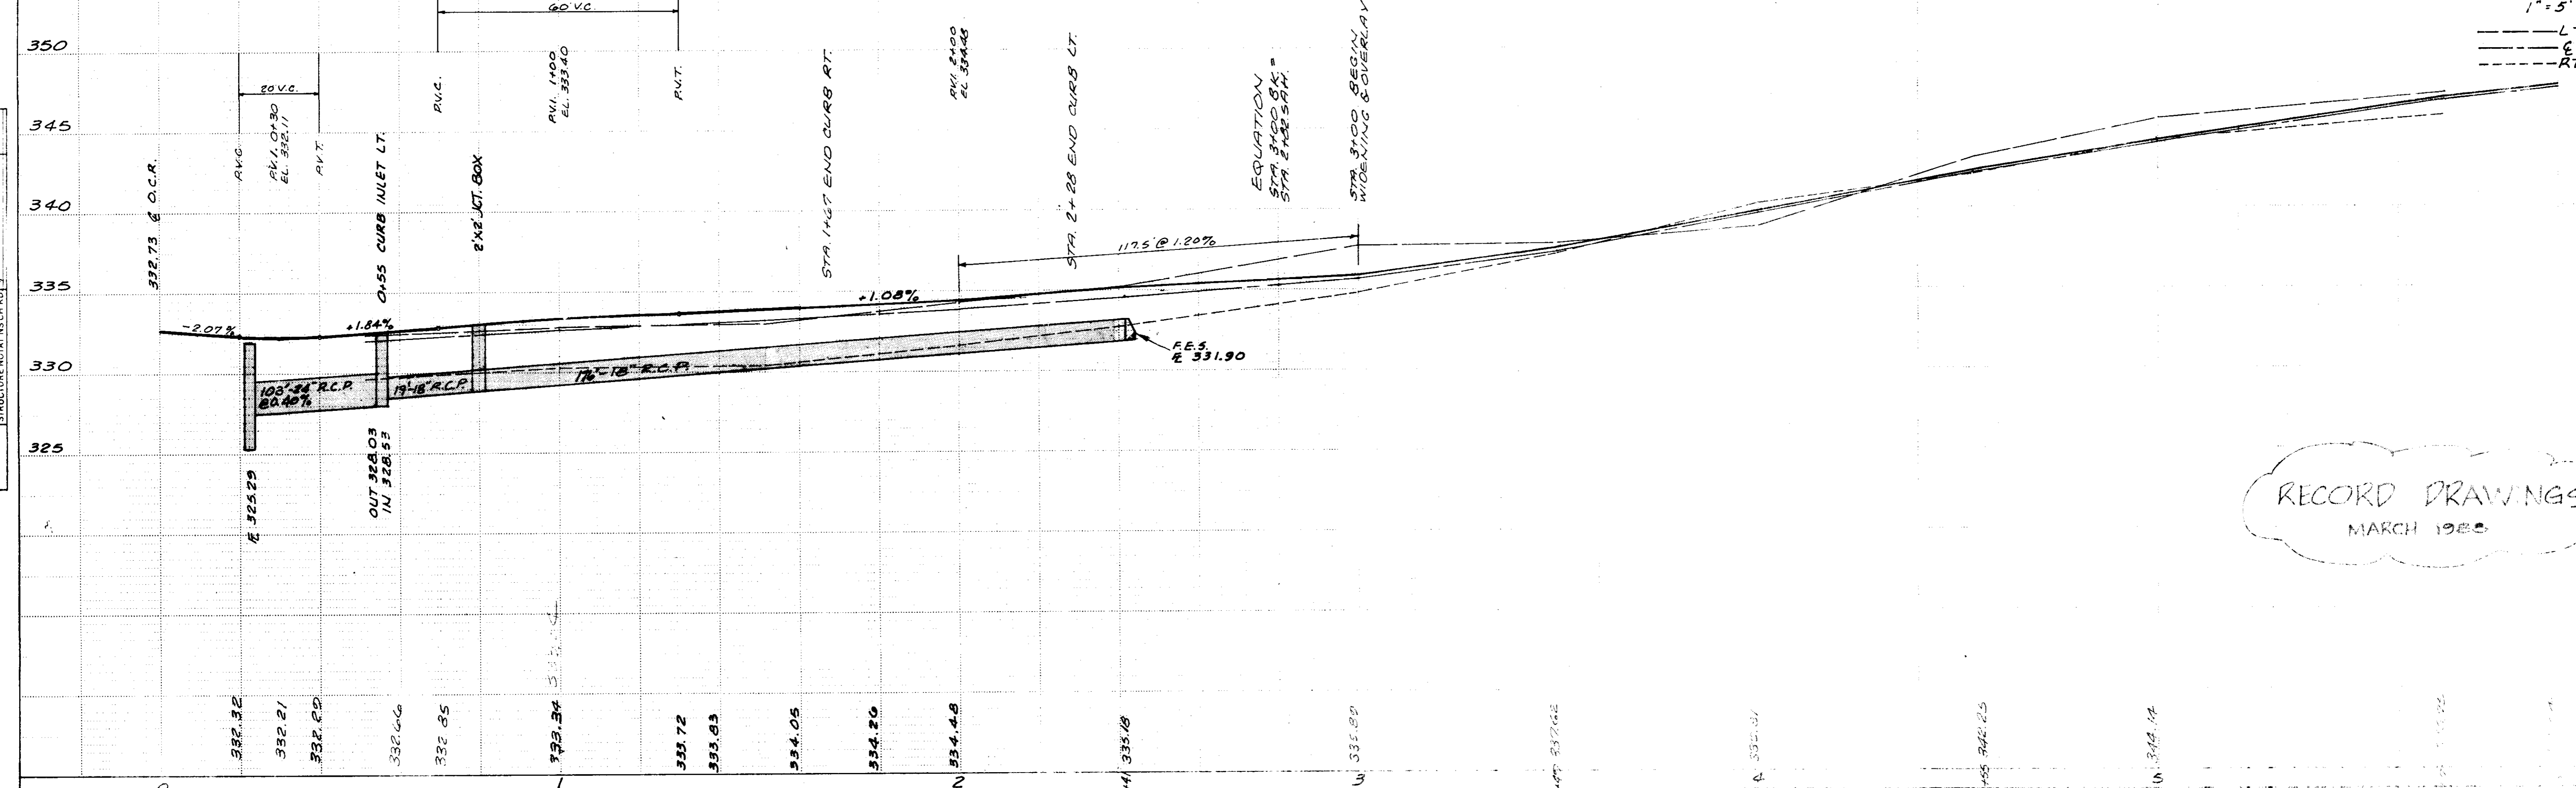


RECORD DRAWINGS MARCH 1955

DATE	BY	REVISION



DATE	BY	REVISION

@ CURVE DATA
 EAST BOUND LANE
 NORTH PARK DRIVE
 $\Delta = 25^{\circ}30'$
 $D = 6,047.8'$
 $T = 195'$
 $L = 323.50'$
 $R = 861.98'$

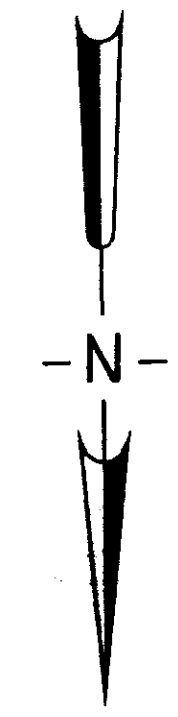

DATE	
BY	
DESIGNED	
PLOTTED	
ALIGNMENT CHECKED	
NOTE BOOK	
NO.	



DATE	
BY	
DESIGNED	
PLOTTED	
GRADES CHECKED	
STRUCTURE NOTATION	
NOTE BOOK	
NO.	

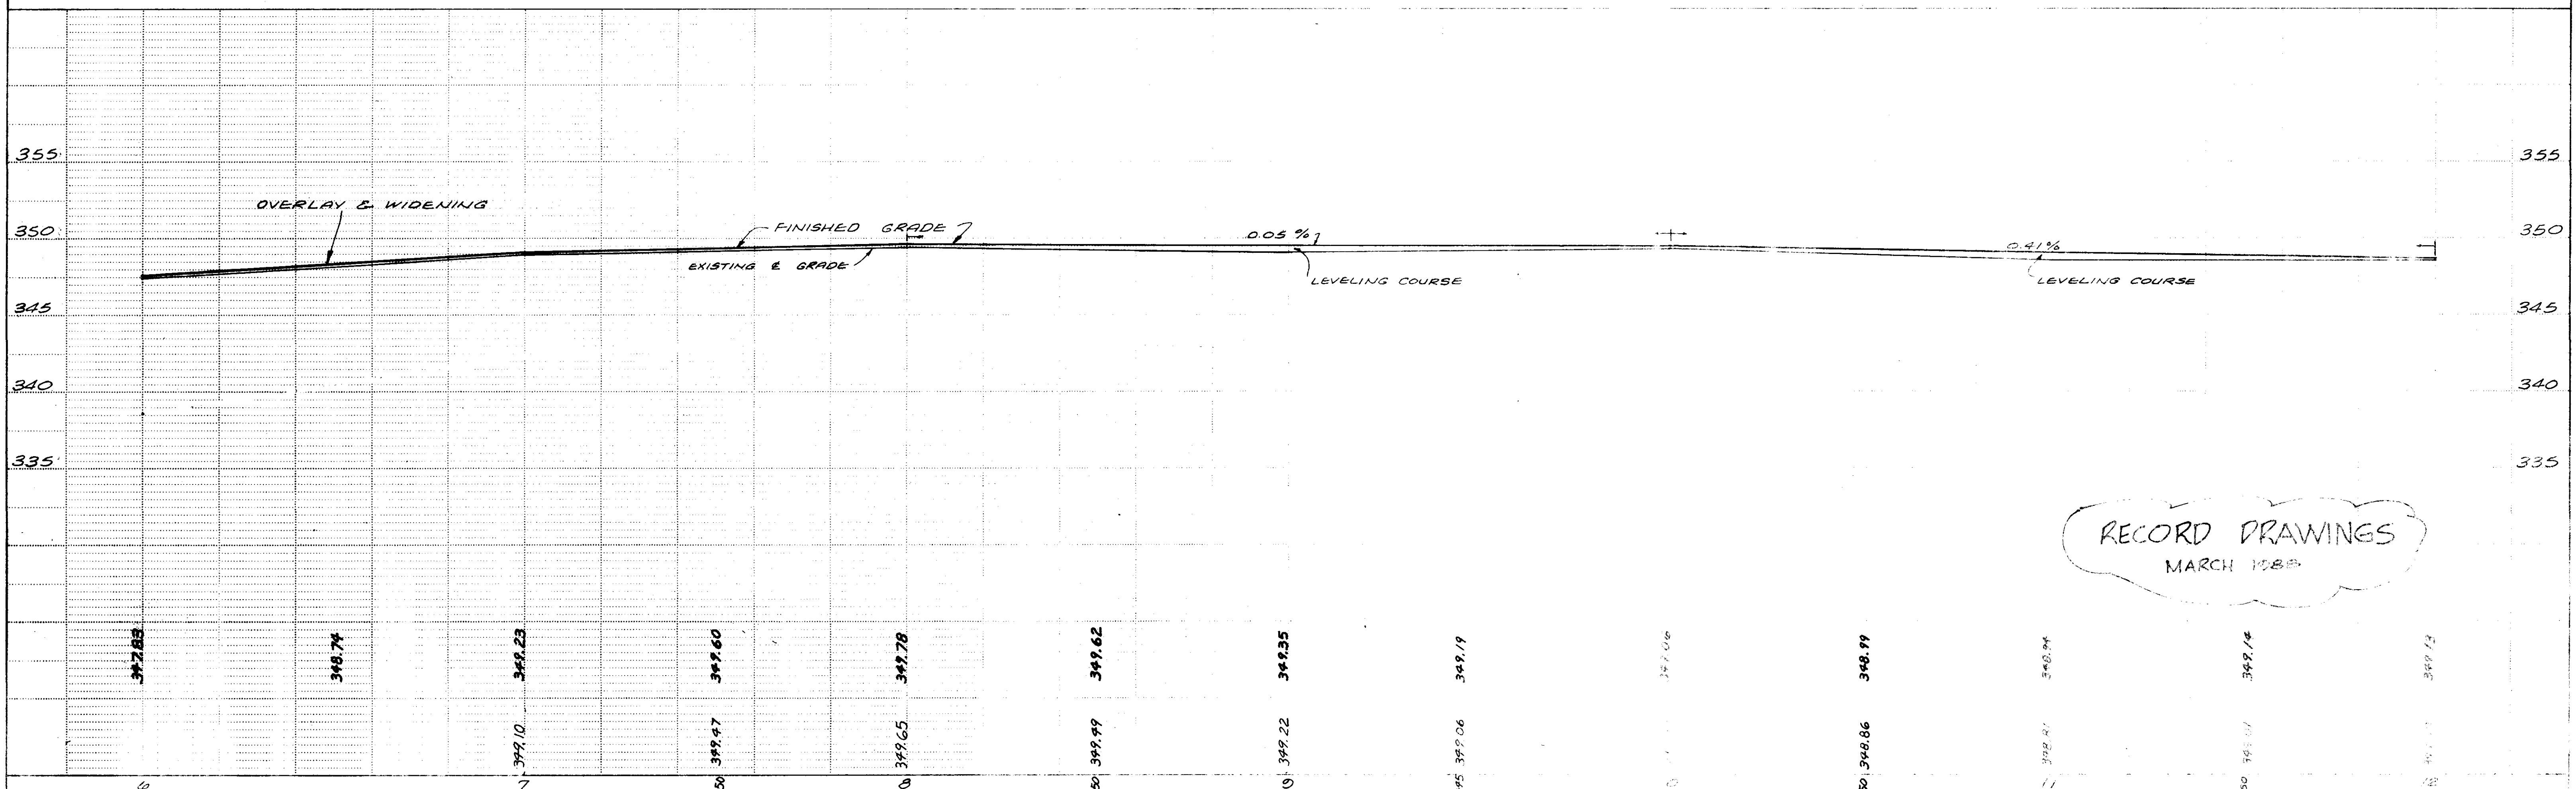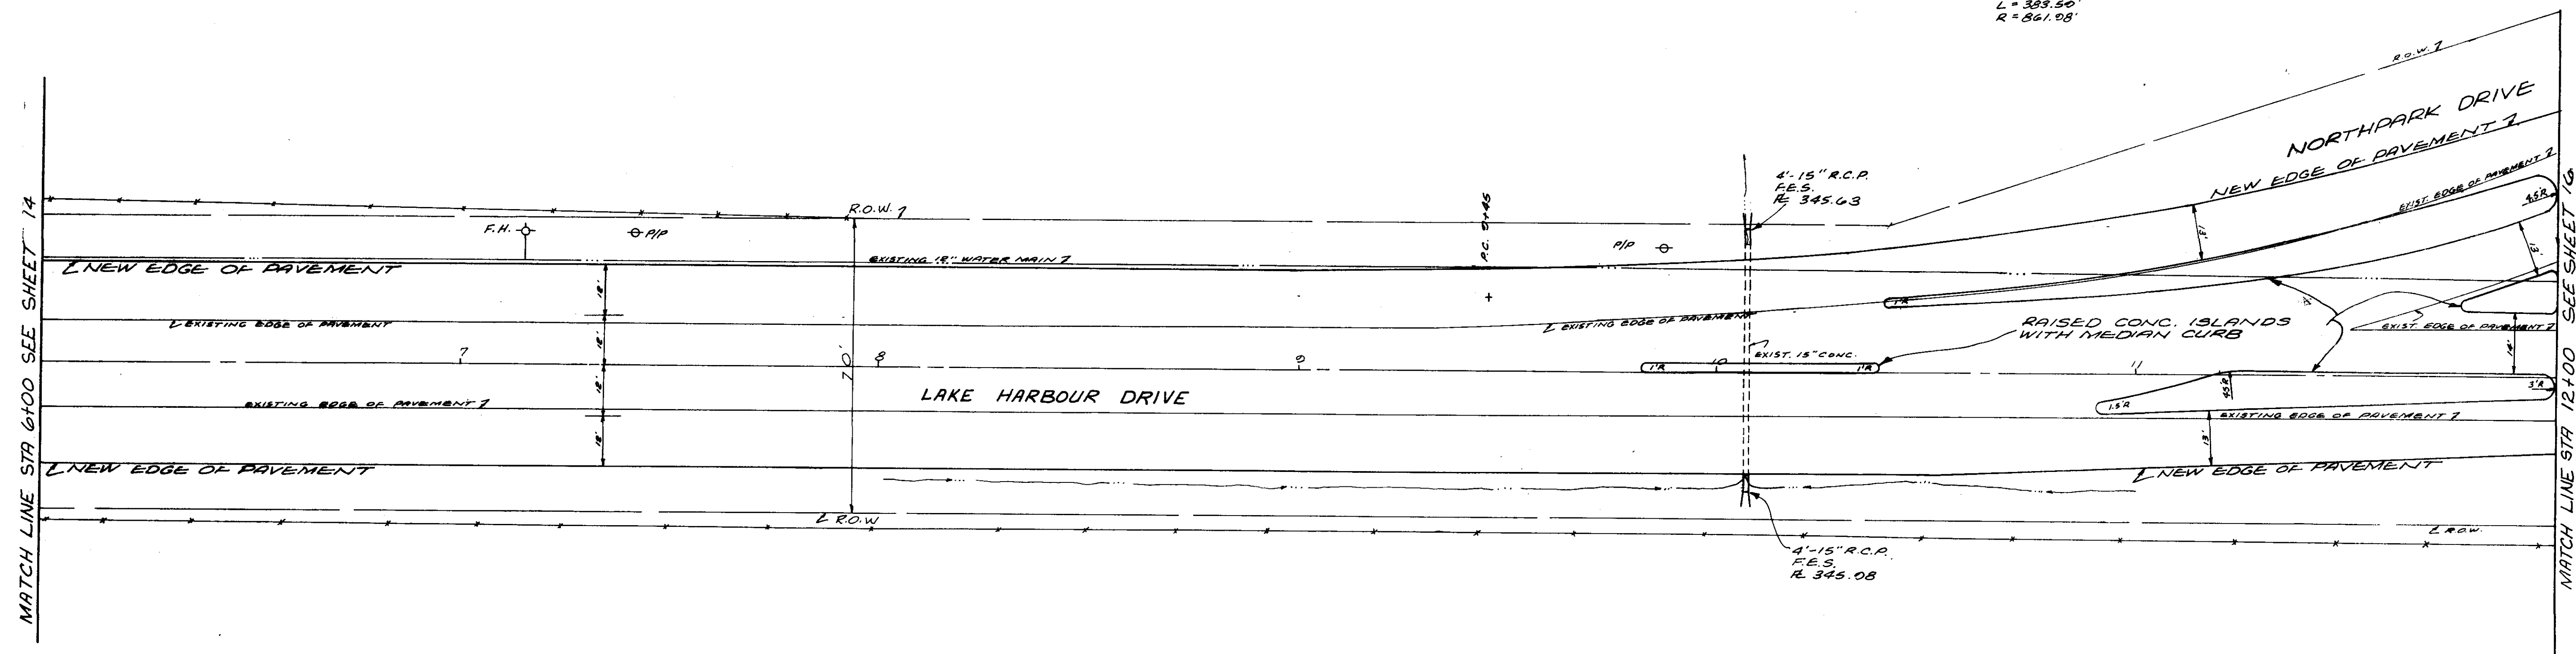

RECORD DRAWINGS
 MARCH 1988

PROFILE		BY	DATE
SURVEYED			
PLOTTED			
GRADES CHECKED			
B. M.'S NOTED			
STRUCTURE NOTATIONS CHECKED			

PLAN		BY	DATE
SURVEYED			
PLOTTED			
ALIGNMENT CHECKED			
RT OF WAY CHECKED			

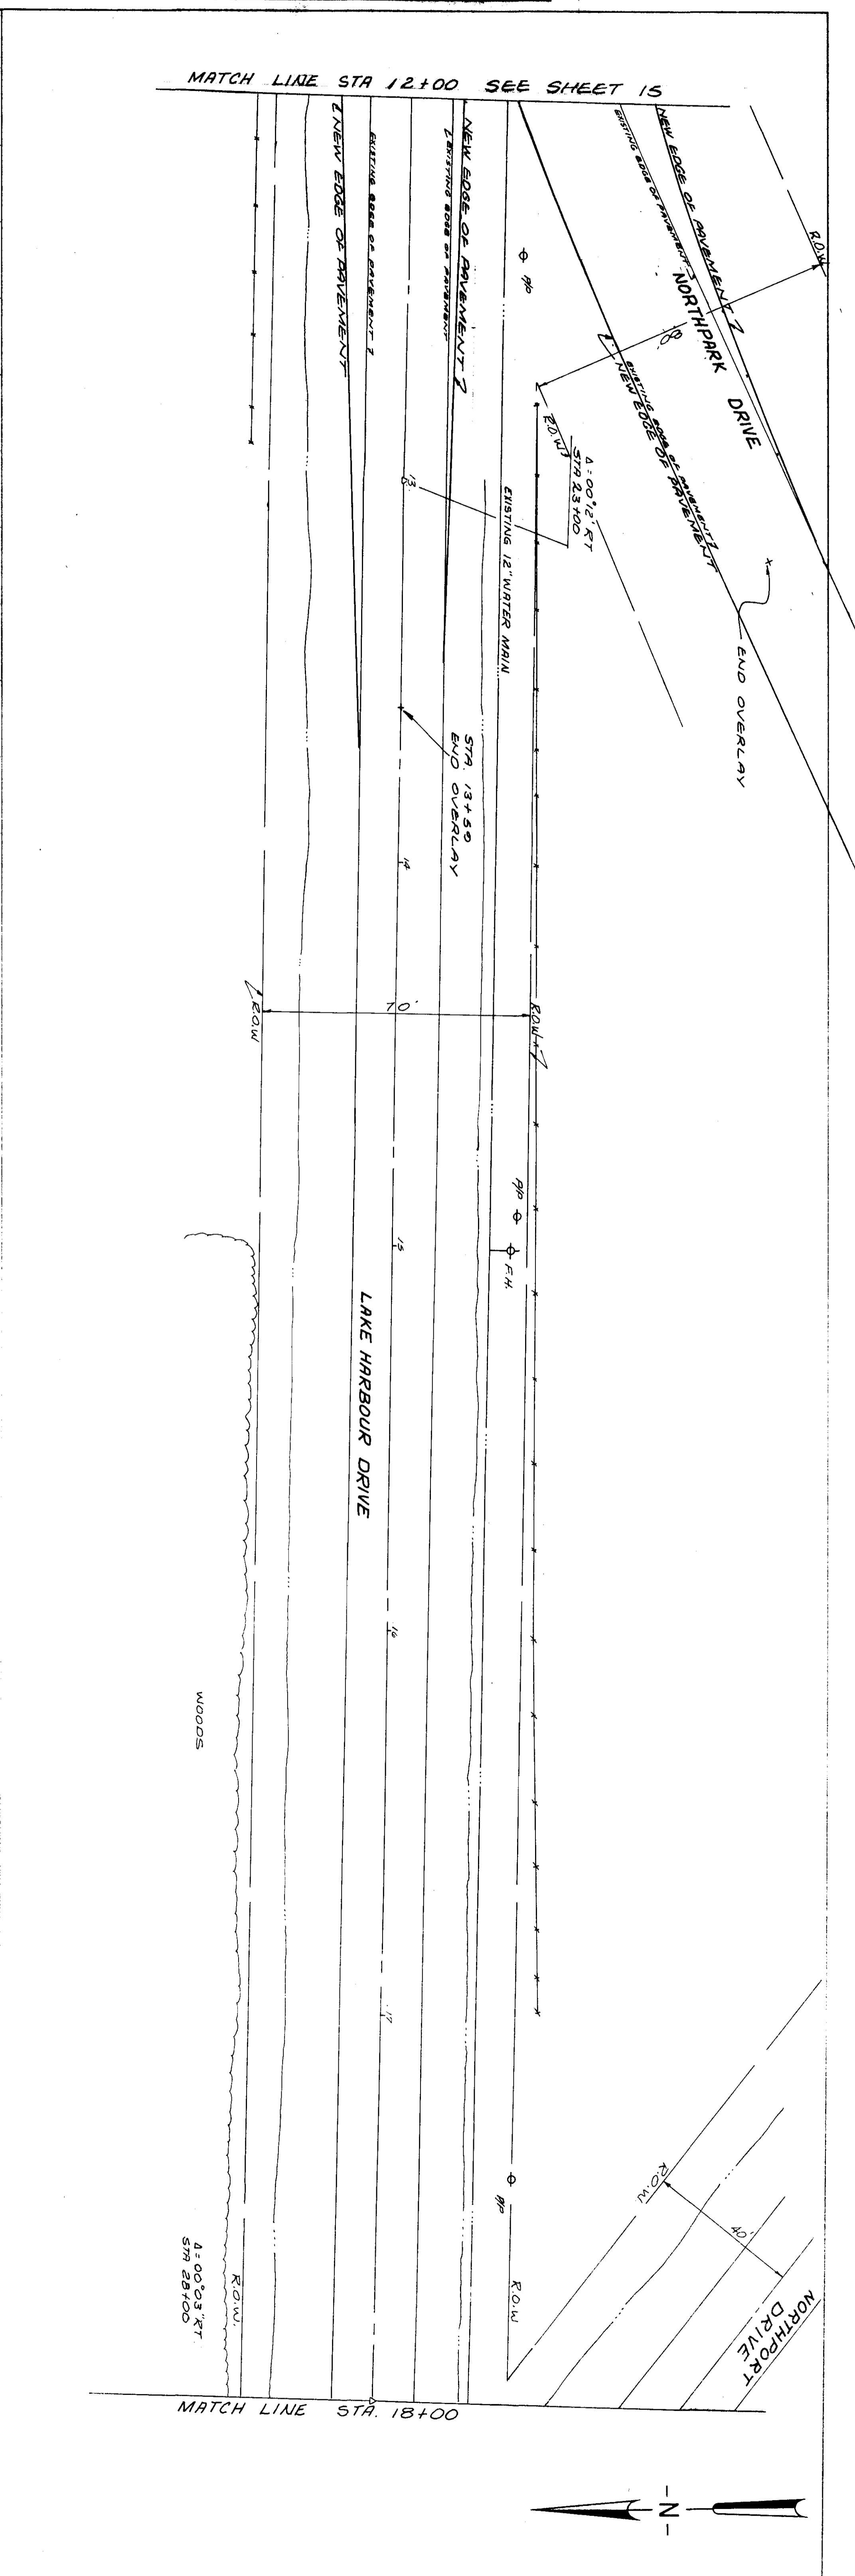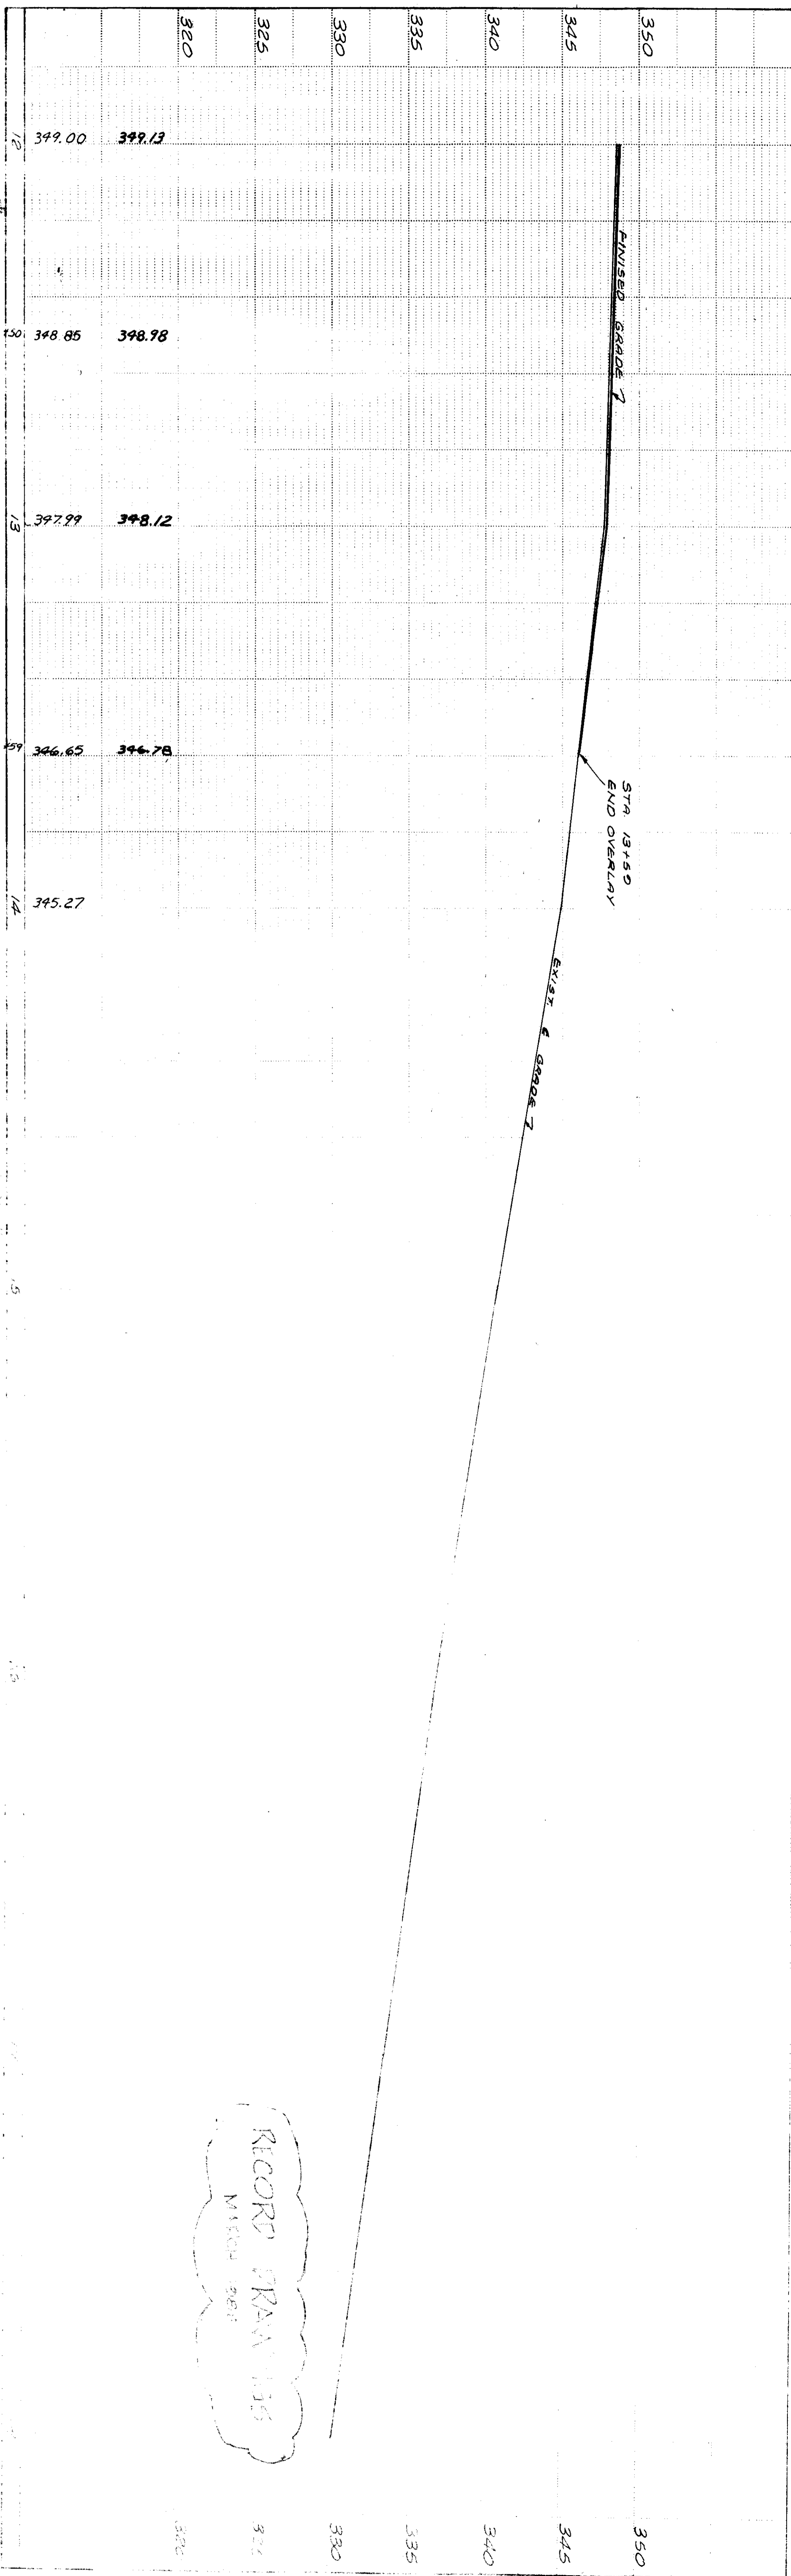

RECORD GRAN 135
MISC 581

