


| ORIGINAL SURVEY | SURVEYED | BY | DATE |
|-----------------|--------------|-------|-------|
| NO. _____ | NO. _____ | _____ | _____ |
| NOTE BOOK | TEMPLATE | | |
| AREA | AREA | | |
| AREA CHECKED | AREA CHECKED | | |

| FINAL SURVEY | SURVEYED | BY | DATE |
|--------------|--------------|-------|-------|
| NO. _____ | NO. _____ | _____ | _____ |
| NOTE BOOK | TEMPLATE | | |
| AREA | AREA | | |
| AREA CHECKED | AREA CHECKED | | |



KE

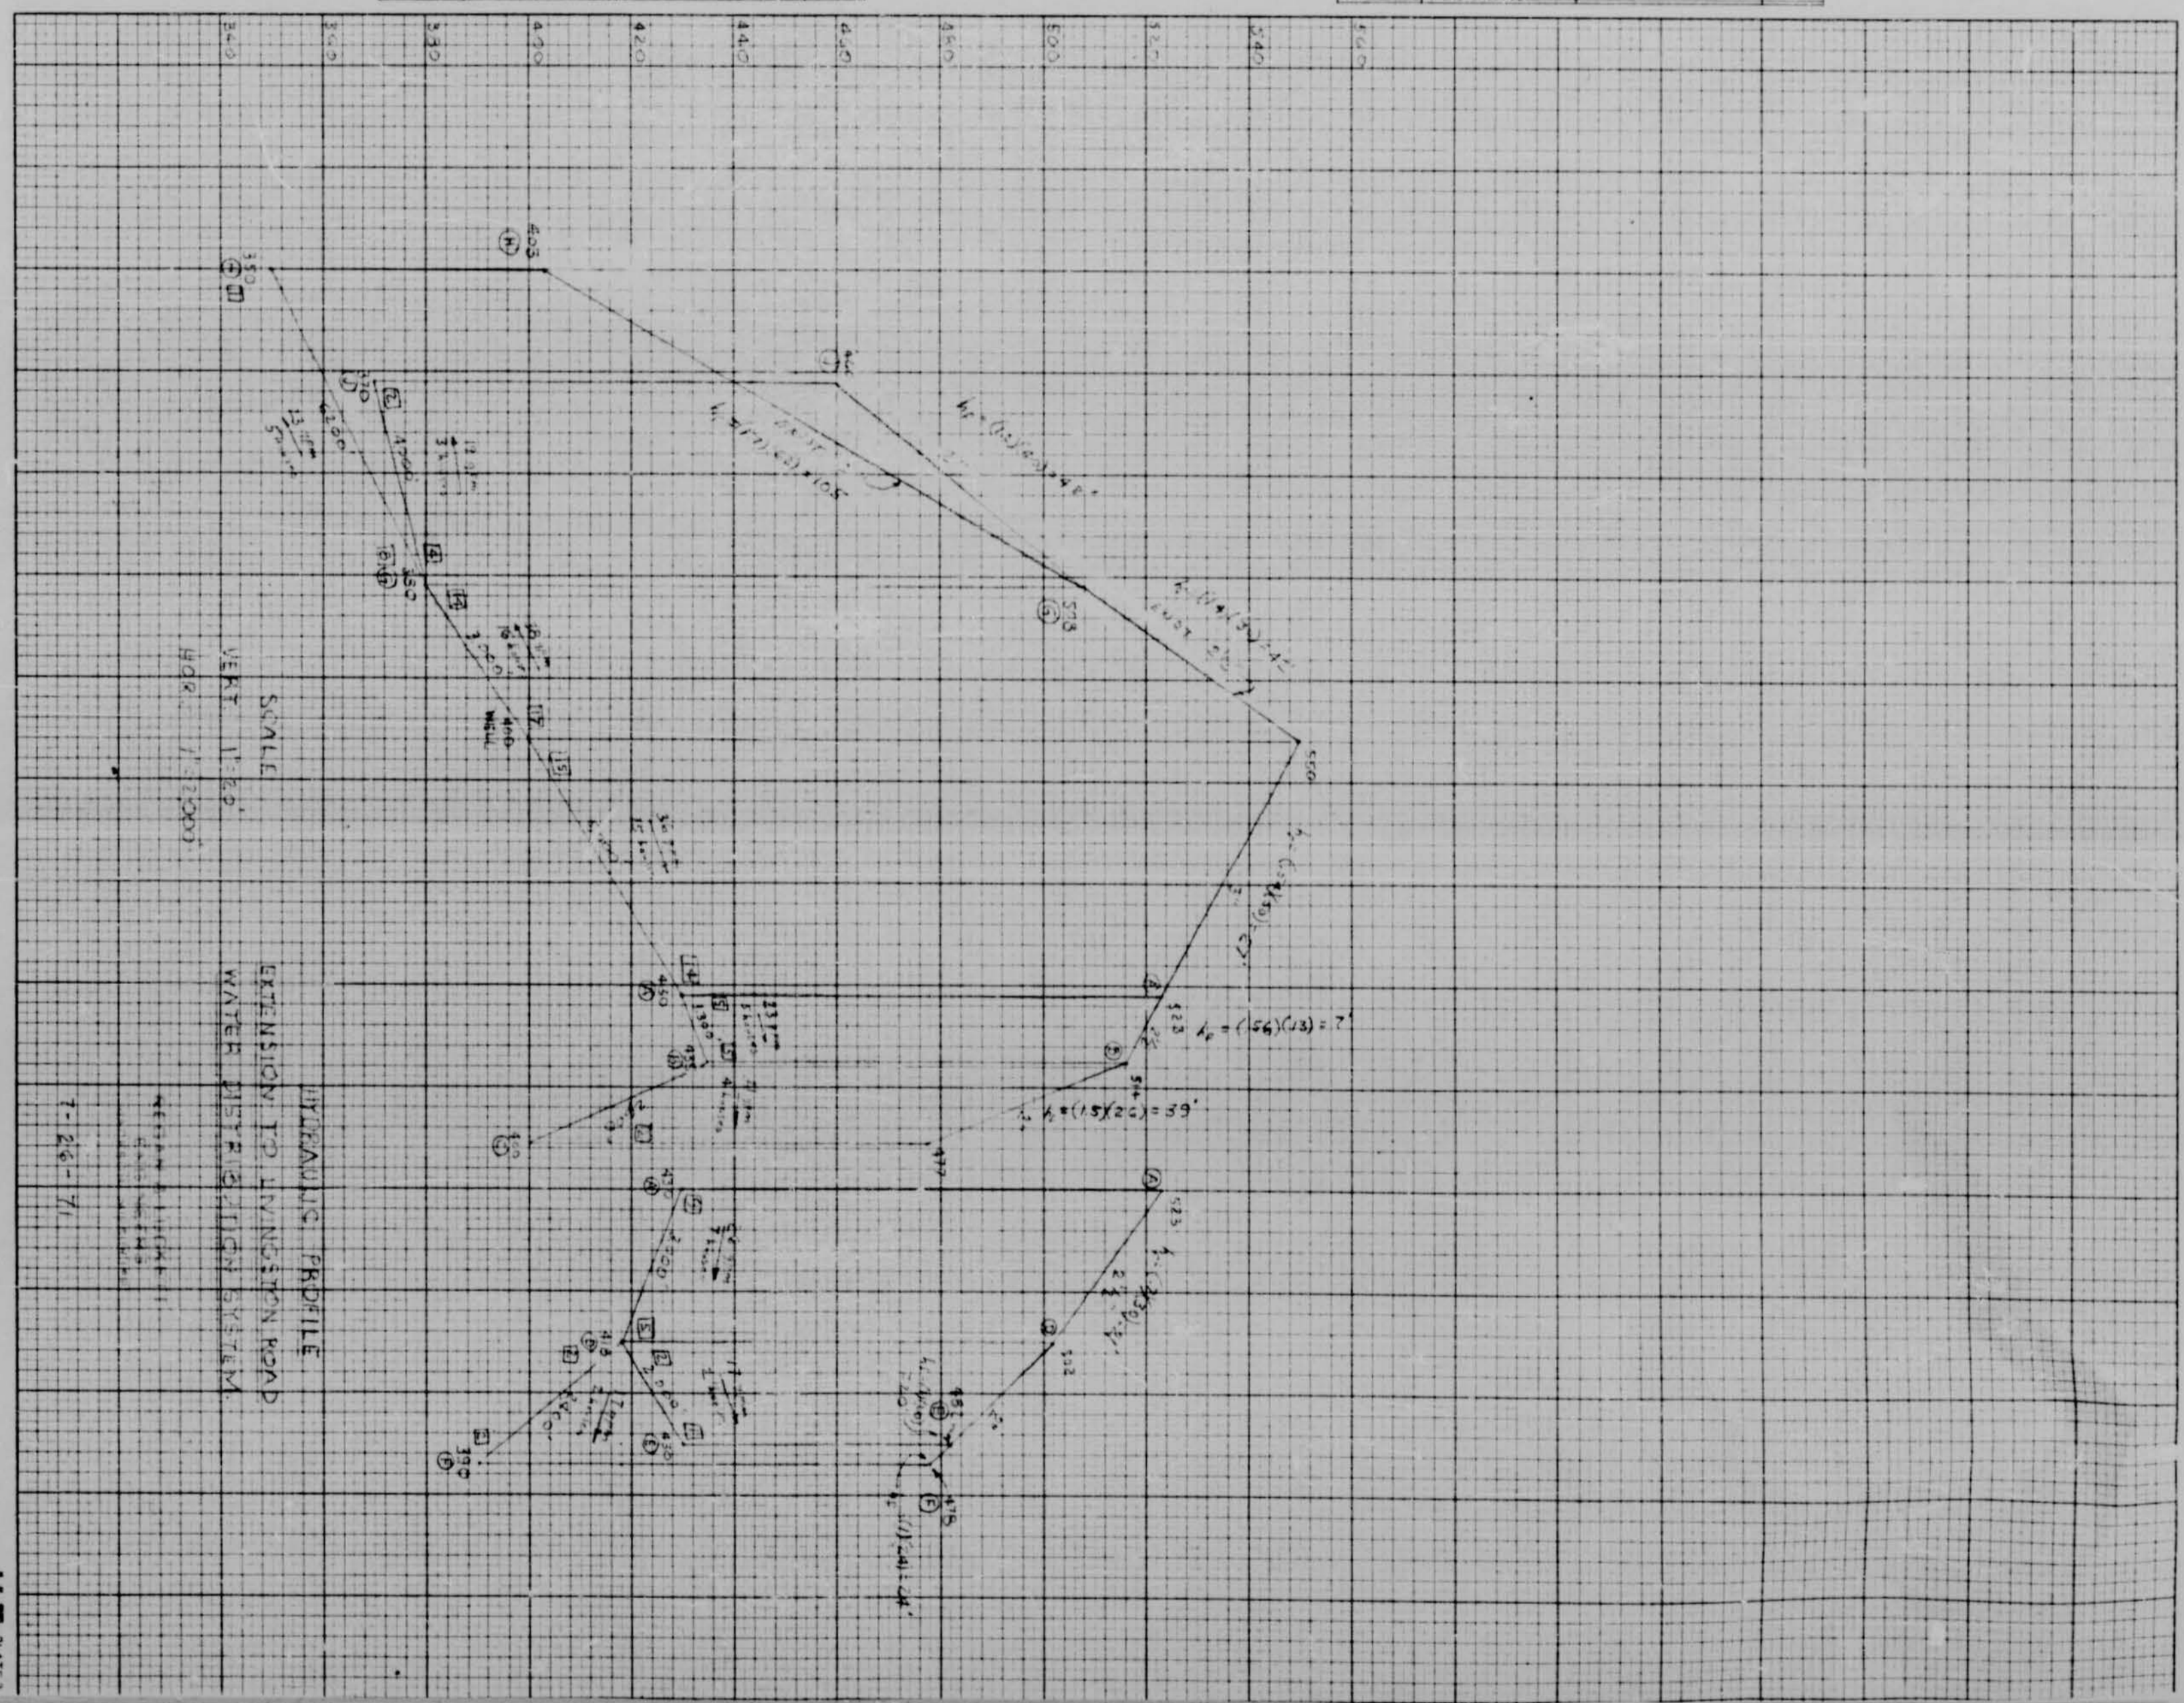