


ALLEN HOME

EXISTING MH  
EXISTING SEWER

6" C.I. SEWER

0.25

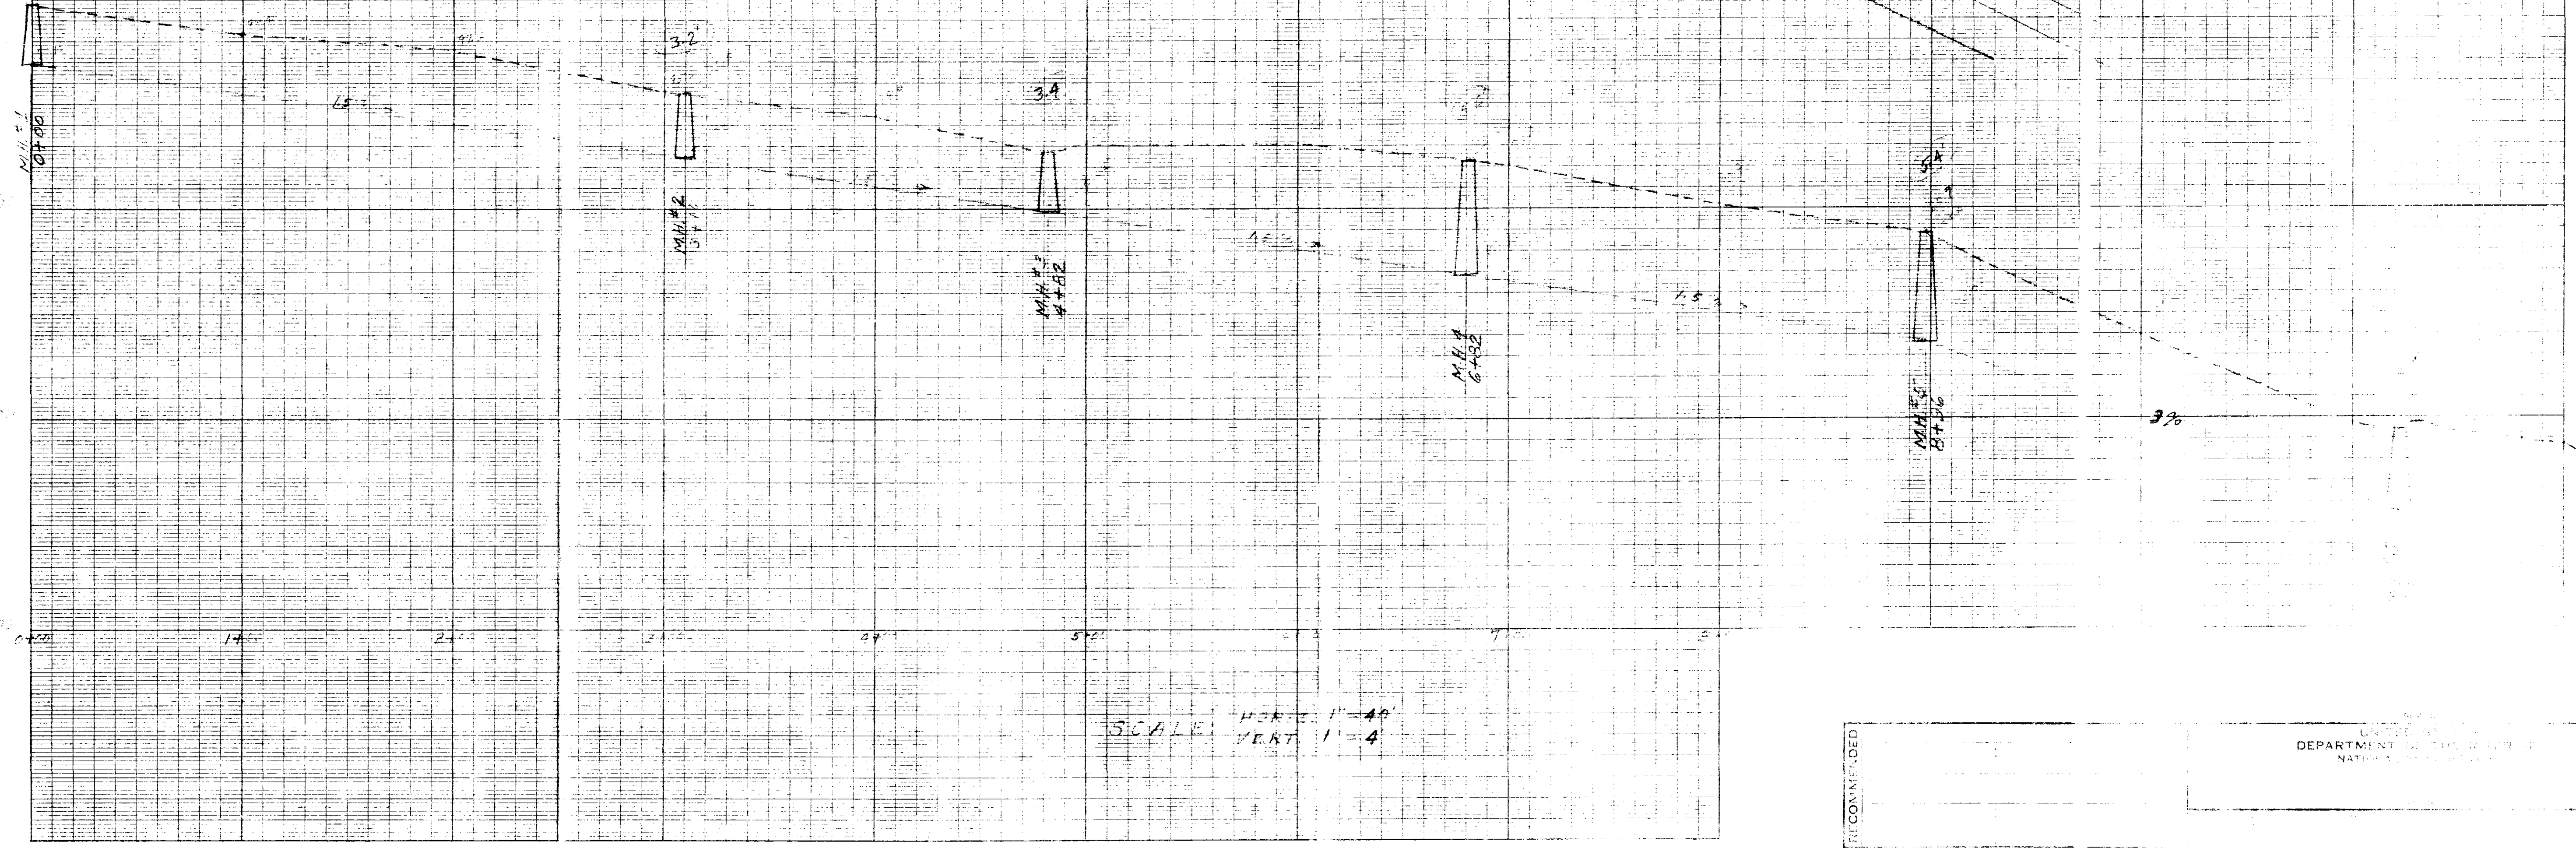

SCALE: HORIZ. 1"=40'  
VERT. 1"=4'

BASIC DATA

RECOMMENDED \_\_\_\_\_  
 APPROVED \_\_\_\_\_

UNIVERSITY OF WASHINGTON  
 DEPARTMENT OF CIVIL ENGINEERING  
 NATIONAL CENTER FOR WATER RESEARCH

ORIENTATION
REVIEWED
OPERATIONS REGION
WASHINGTON
INTERP. REGION
WASHINGTON
COOP. ACT. V. REGION
WASHINGTON
DES. SECT. TITLE
WASHINGTON
DATE
PROJECT