




- SYMBOL LEGEND:**
- Sprinkler
 - Clean Out
 - Electrical Outlet
 - Irrigation Control Valve
 - Down Spout
 - Water Valve
 - Water Meter

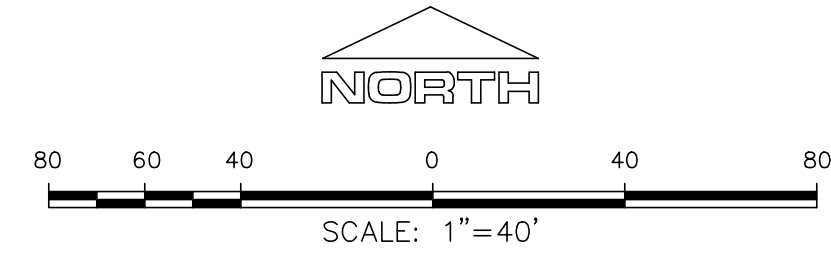

ELEVATIONS ARE NAVD88
DATE OF FIELD SURVEY: 9-04-21

<p>PROJECT NUMBER B-7985</p>	<p>CLIENT: J.M. WILLIAMS</p>	<p>PROJECT: AS-BUILT SURVEY STORAGE MAX, CITY OF RIDGELAND, MADISON COUNTY, MISSISSIPPI</p>	<table border="1" style="width: 100%; border-collapse: collapse;"> <tr> <td>DATE: 9-24-21</td> <td>DWG. NO: B-7985</td> </tr> <tr> <td>DRAWN: MTB</td> <td>PROJ: B-7985</td> </tr> <tr> <td>CHECKED: MRL</td> <td>CREW: NELSON</td> </tr> </table>	DATE: 9-24-21	DWG. NO: B-7985	DRAWN: MTB	PROJ: B-7985	CHECKED: MRL	CREW: NELSON
DATE: 9-24-21	DWG. NO: B-7985								
DRAWN: MTB	PROJ: B-7985								
CHECKED: MRL	CREW: NELSON								
<p>BENCHMARK ENGINEERING & SURVEYING, LLC</p> <p>101 Highpointe Court, Suite B Brandon, Mississippi 39042 601-591-1077</p> <p>660 Katherine Drive, Suite 302 Flowood, Mississippi 39232 601-627-7780</p> <p>www.benchmarkms.net</p>									