


PWP-01520



OAKMONT PART ONE-A EDWARDS HOMES, INC. OWNER AND DEVELOPER	
WATER & SEWER LAYOUT	
CITY OF RIDGELAND MADISON COUNTY, MISSISSIPPI	
DSGN: RCV	DATE: 04/18/95
DRWN: RDB	DATE: 04/18/95
CHKD:	DATE:
SCALE: 1"=60'	

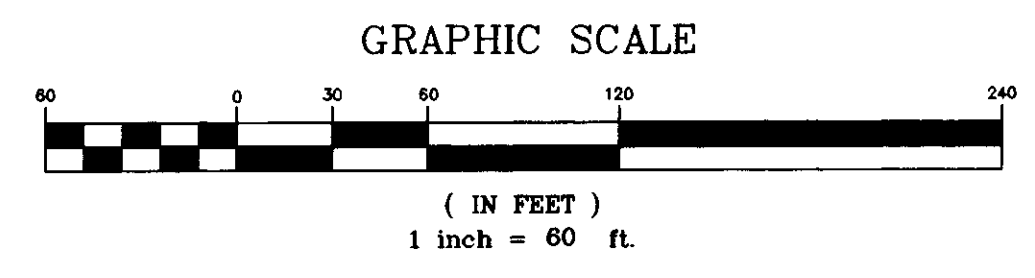

DRAWING NO.
1 of 1

REVISION	BY	DATE