


CONSTRUCTION PLANS

OLDE TOWN SUBDIVISION , PHASE I

BLOCK 27 - TOWN OF RIDGELAND
SITUATED IN THE SW 1/4 OF SECTION 19, T7N - R2E,
MADISON COUNTY, MISSISSIPPI.

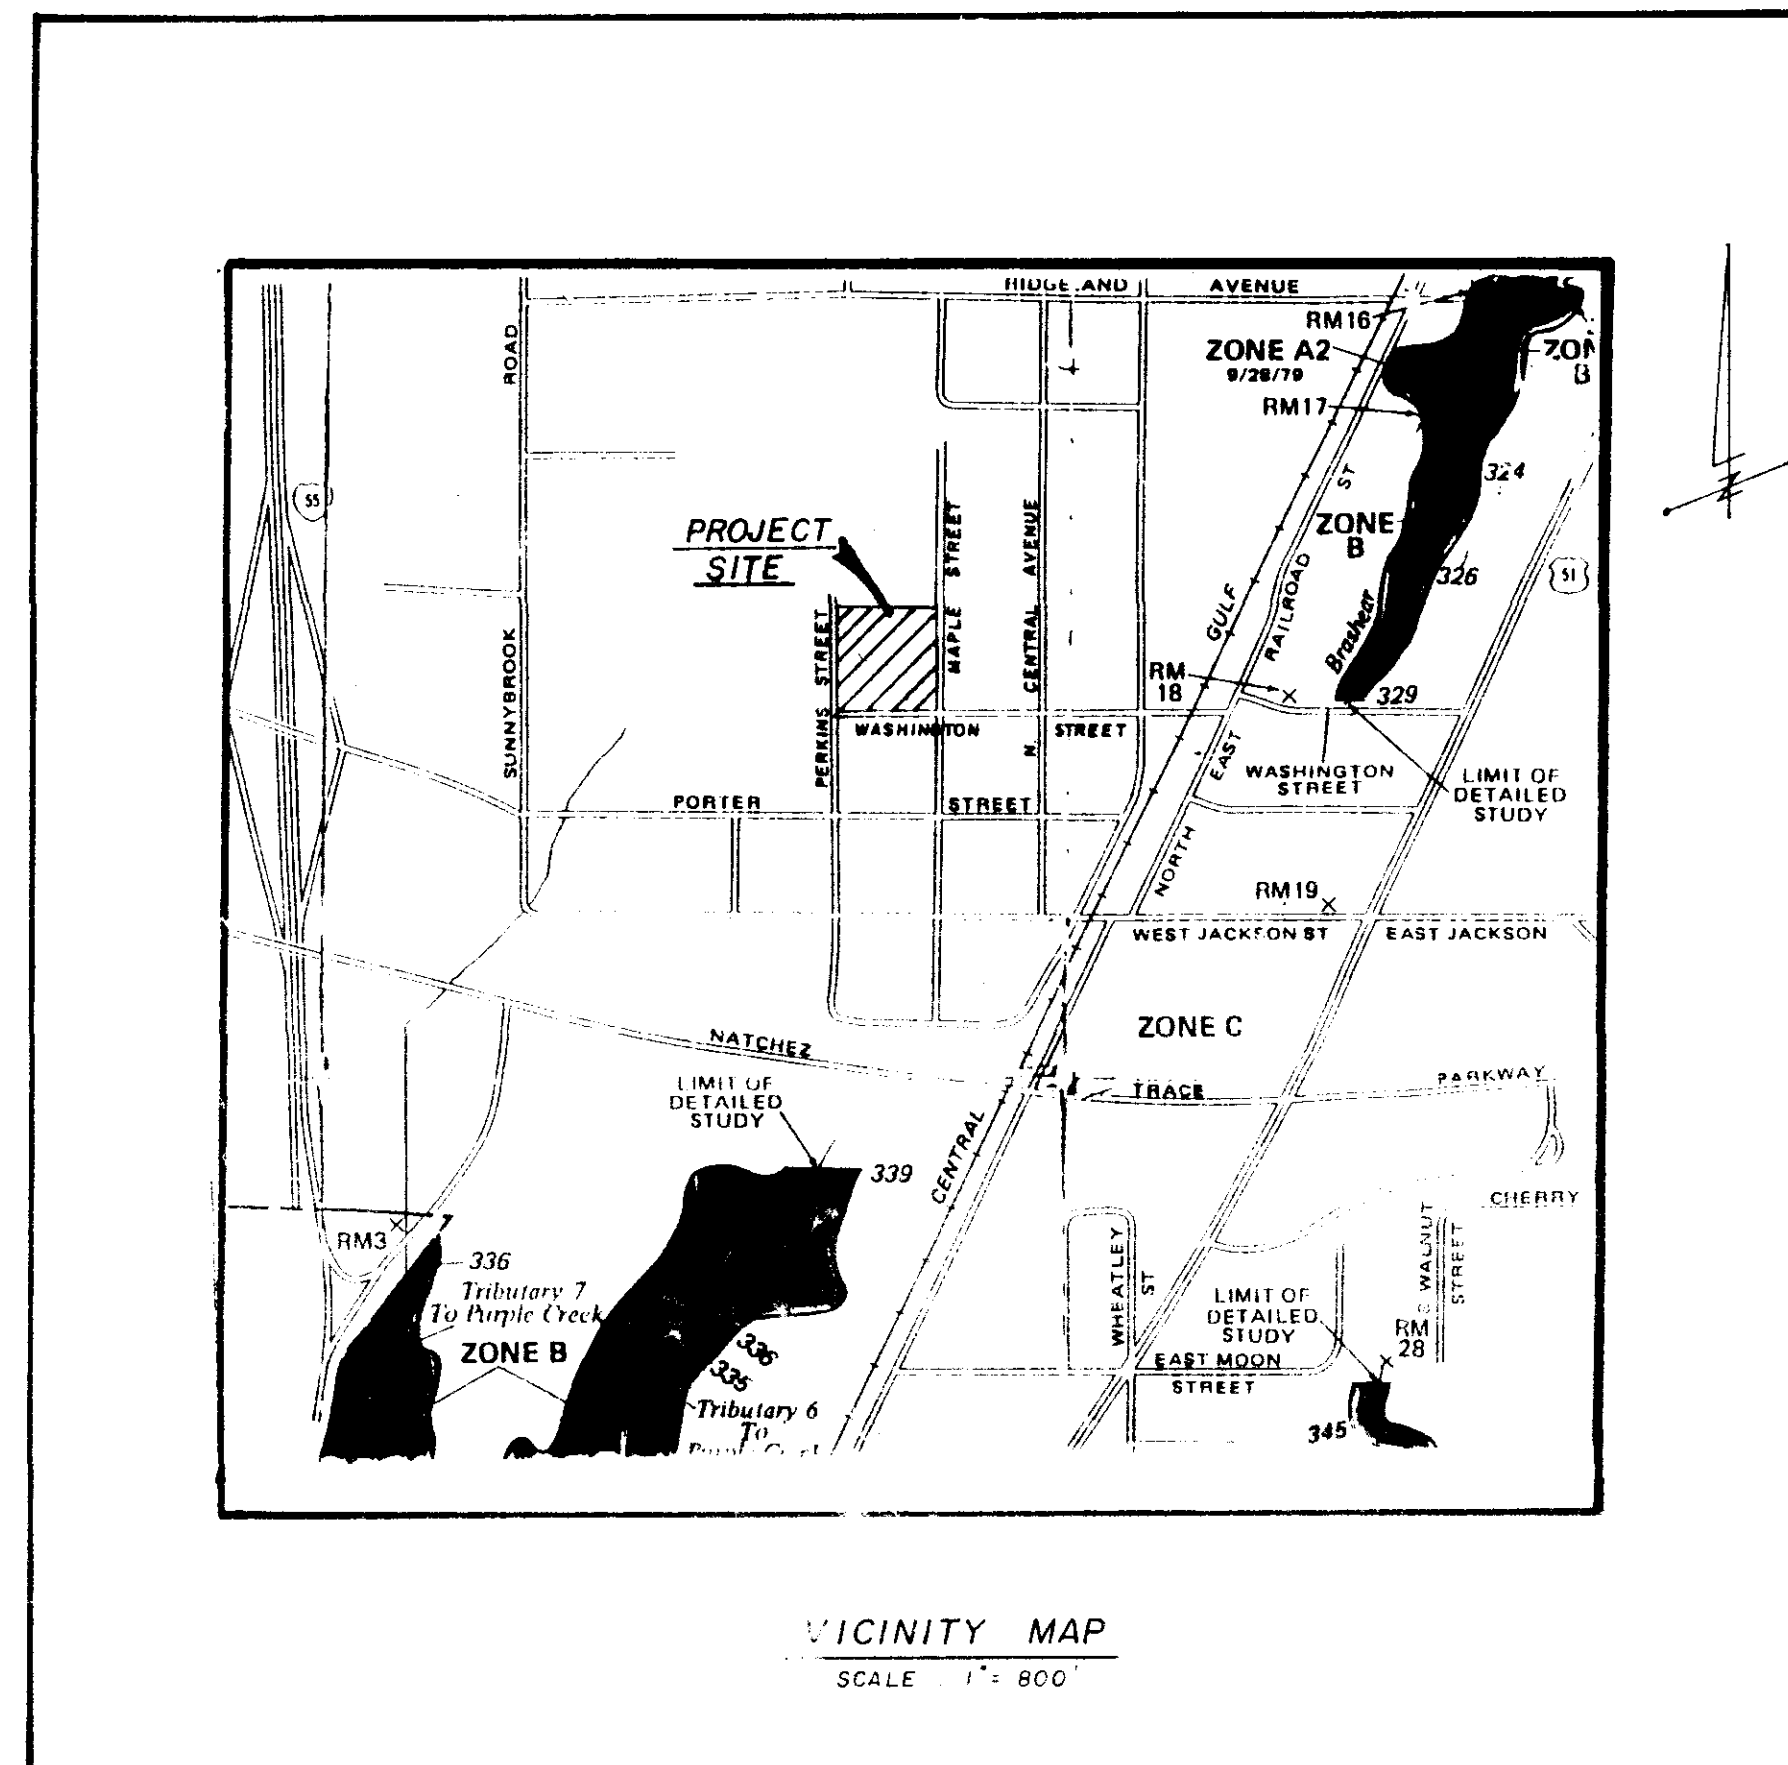

INDEX OF DRAWINGS




SHT. NO.	DESCRIPTION
1.	COVER SHEET
2.	SITE PLAN
3.	PROFILES
4.	STANDARD SANITARY SEWER CONSTRUCTION DETAILS.
5.	STANDARD WATER CONSTRUCTION DETAILS.

DEVELOPED BY : JAMES WEAVER, INC.
P.O. BOX 1157
MADISON, MISSISSIPPI 39130.

DESIGNED BY : CENTRAL MISSISSIPPI ENGINEERING, INC.
4 RIVER BEND PLACE
FLOWOOD, MISSISSIPPI 39208


FEBRUARY, 1992.

PWP-01508

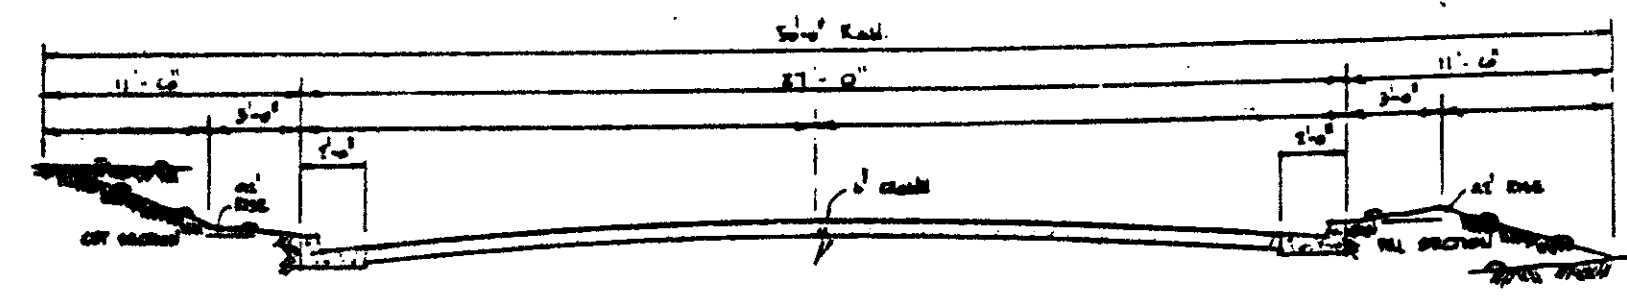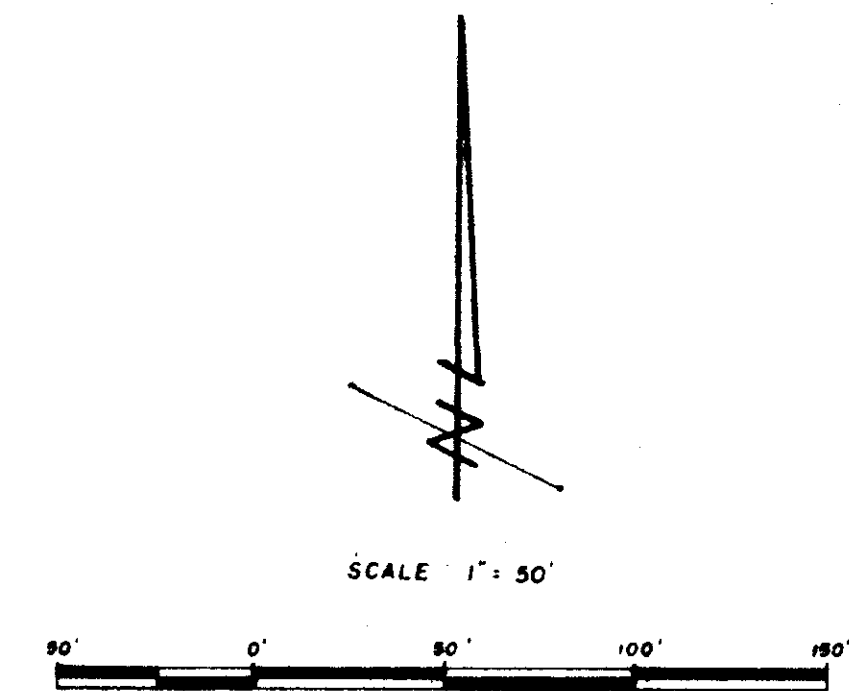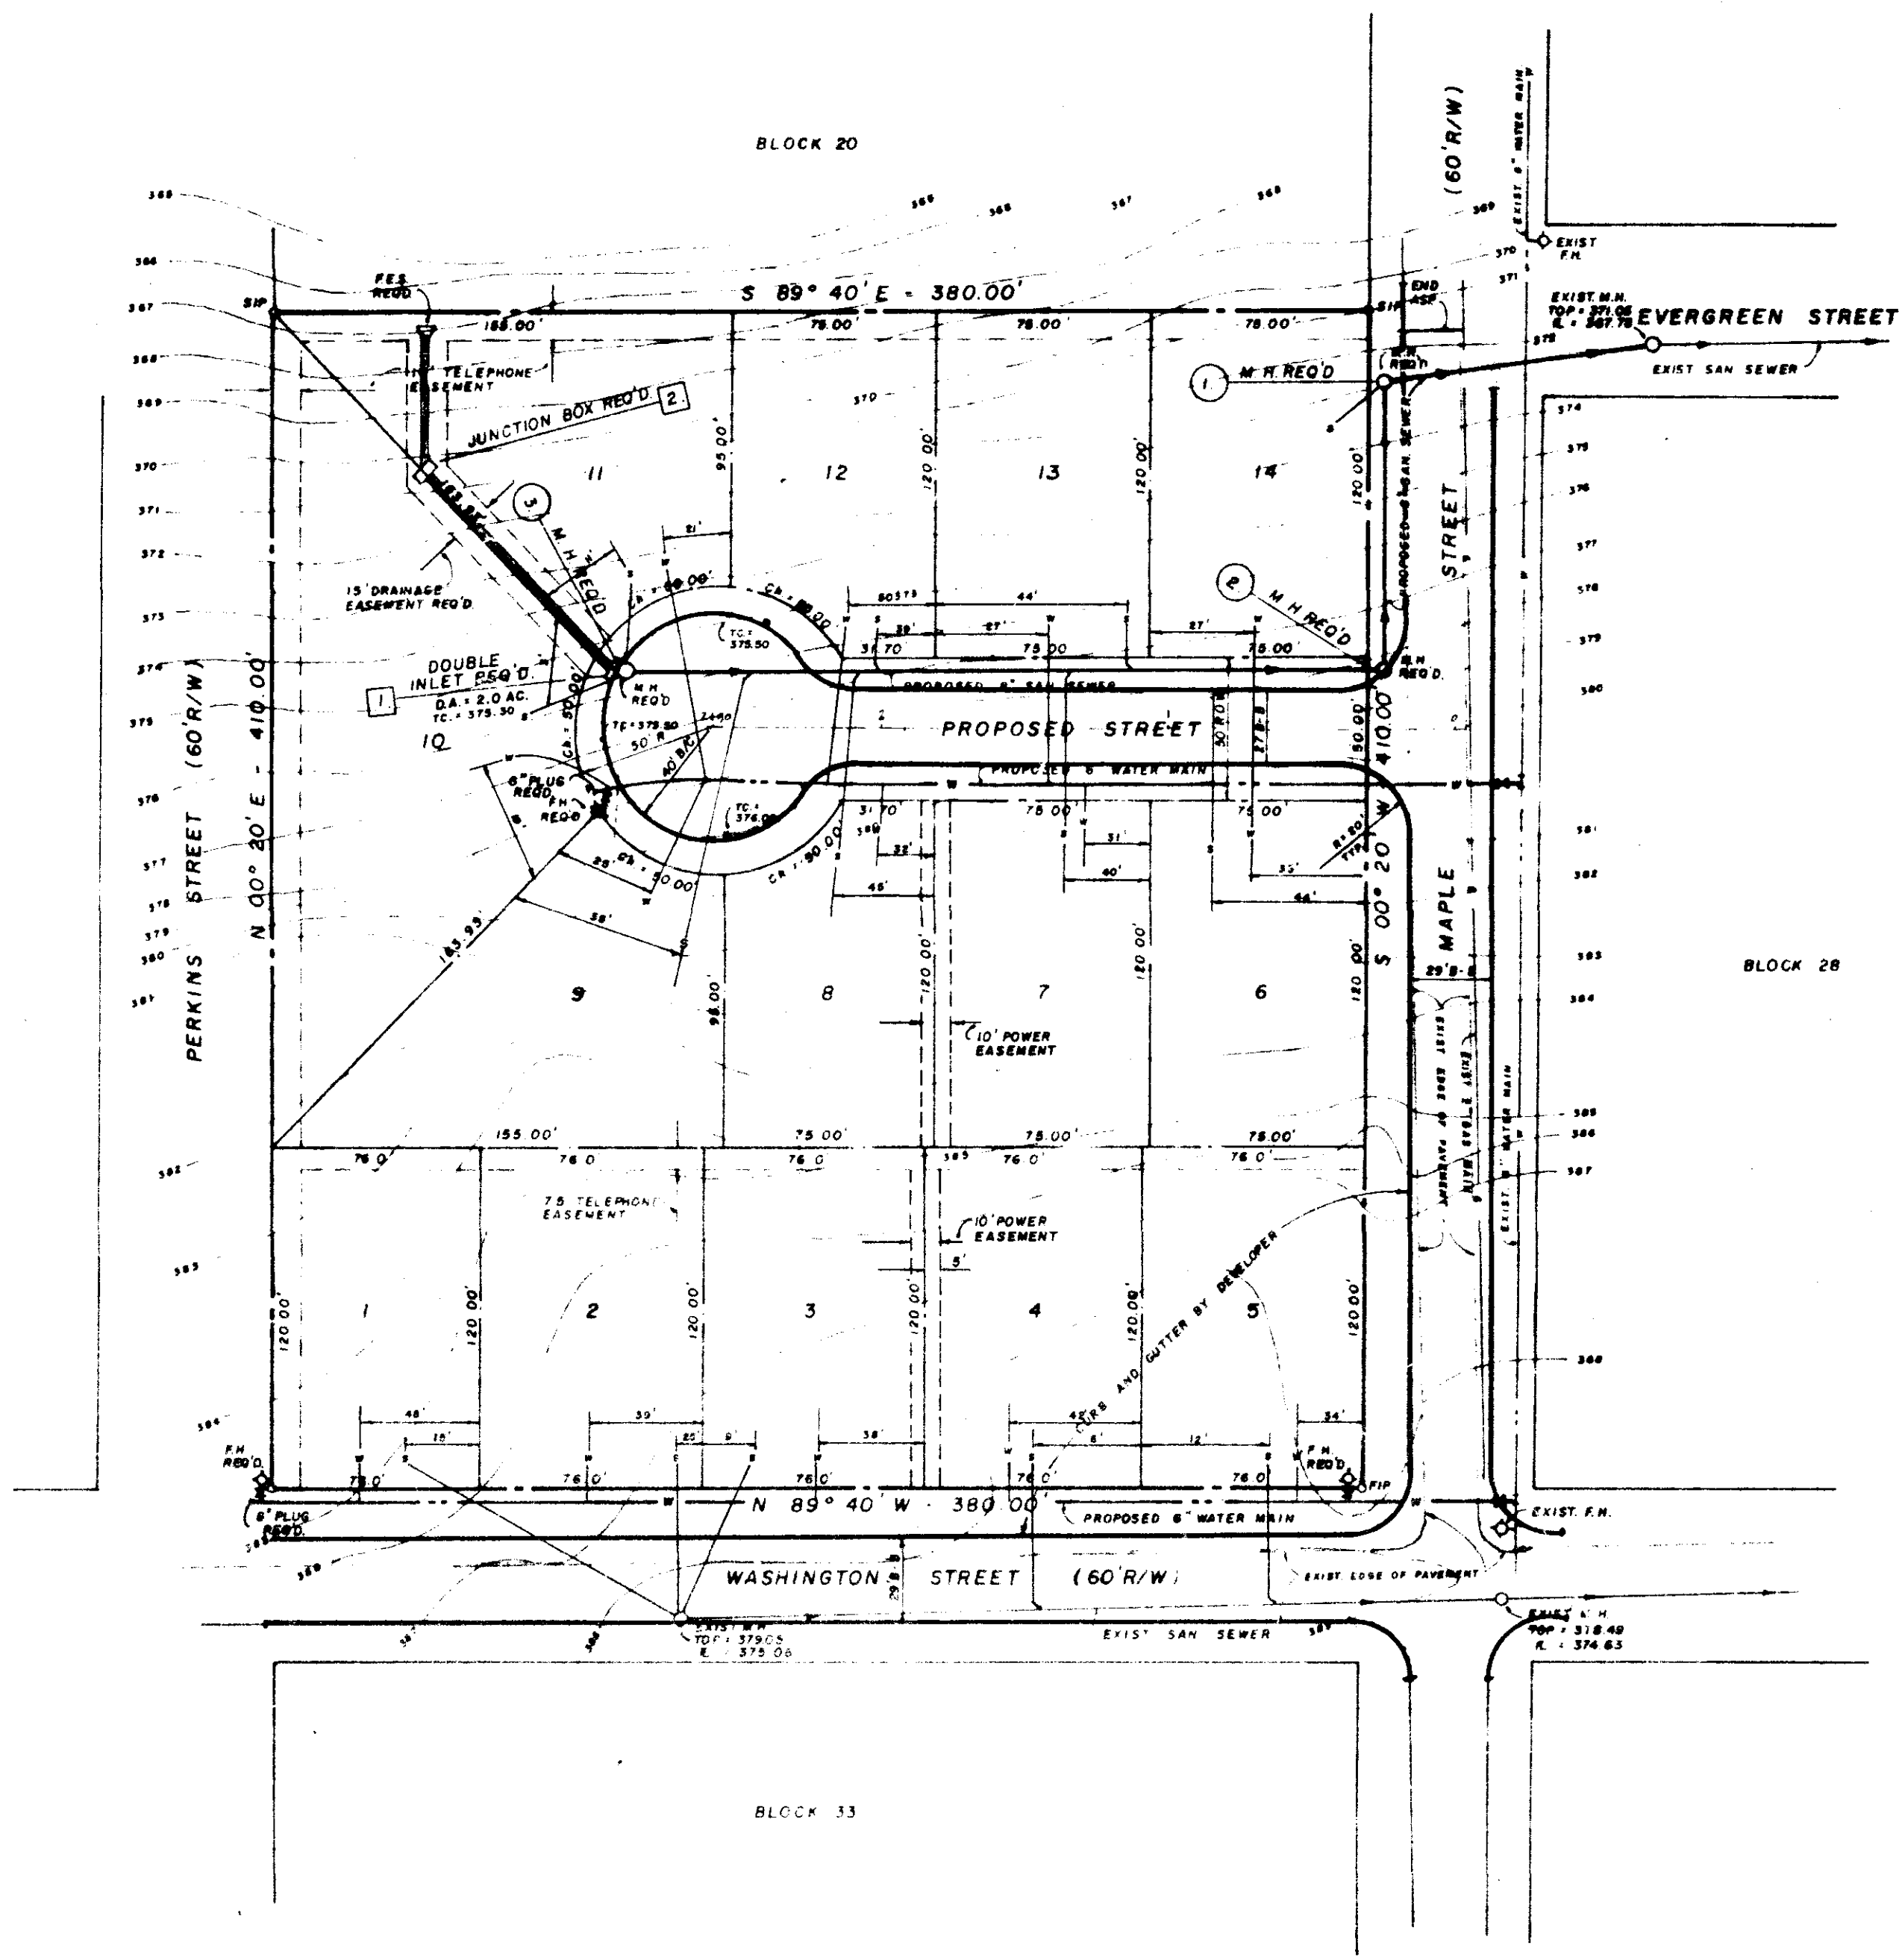


PAVING DESIGN (MINIMUM)
 4" ASPHALT BLACK BASE WITH
 1 1/2" ASPHALT SURFACE

TYPICAL STREET SECTION

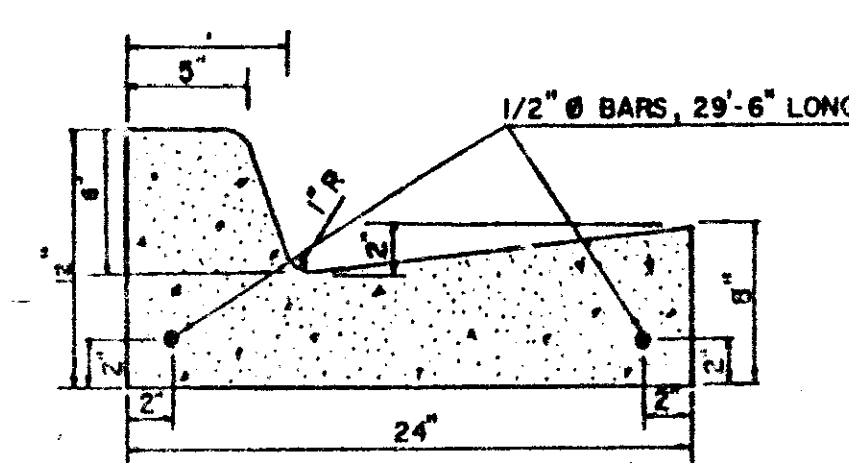


TYPICAL CURB DETAIL
 N.T.S.

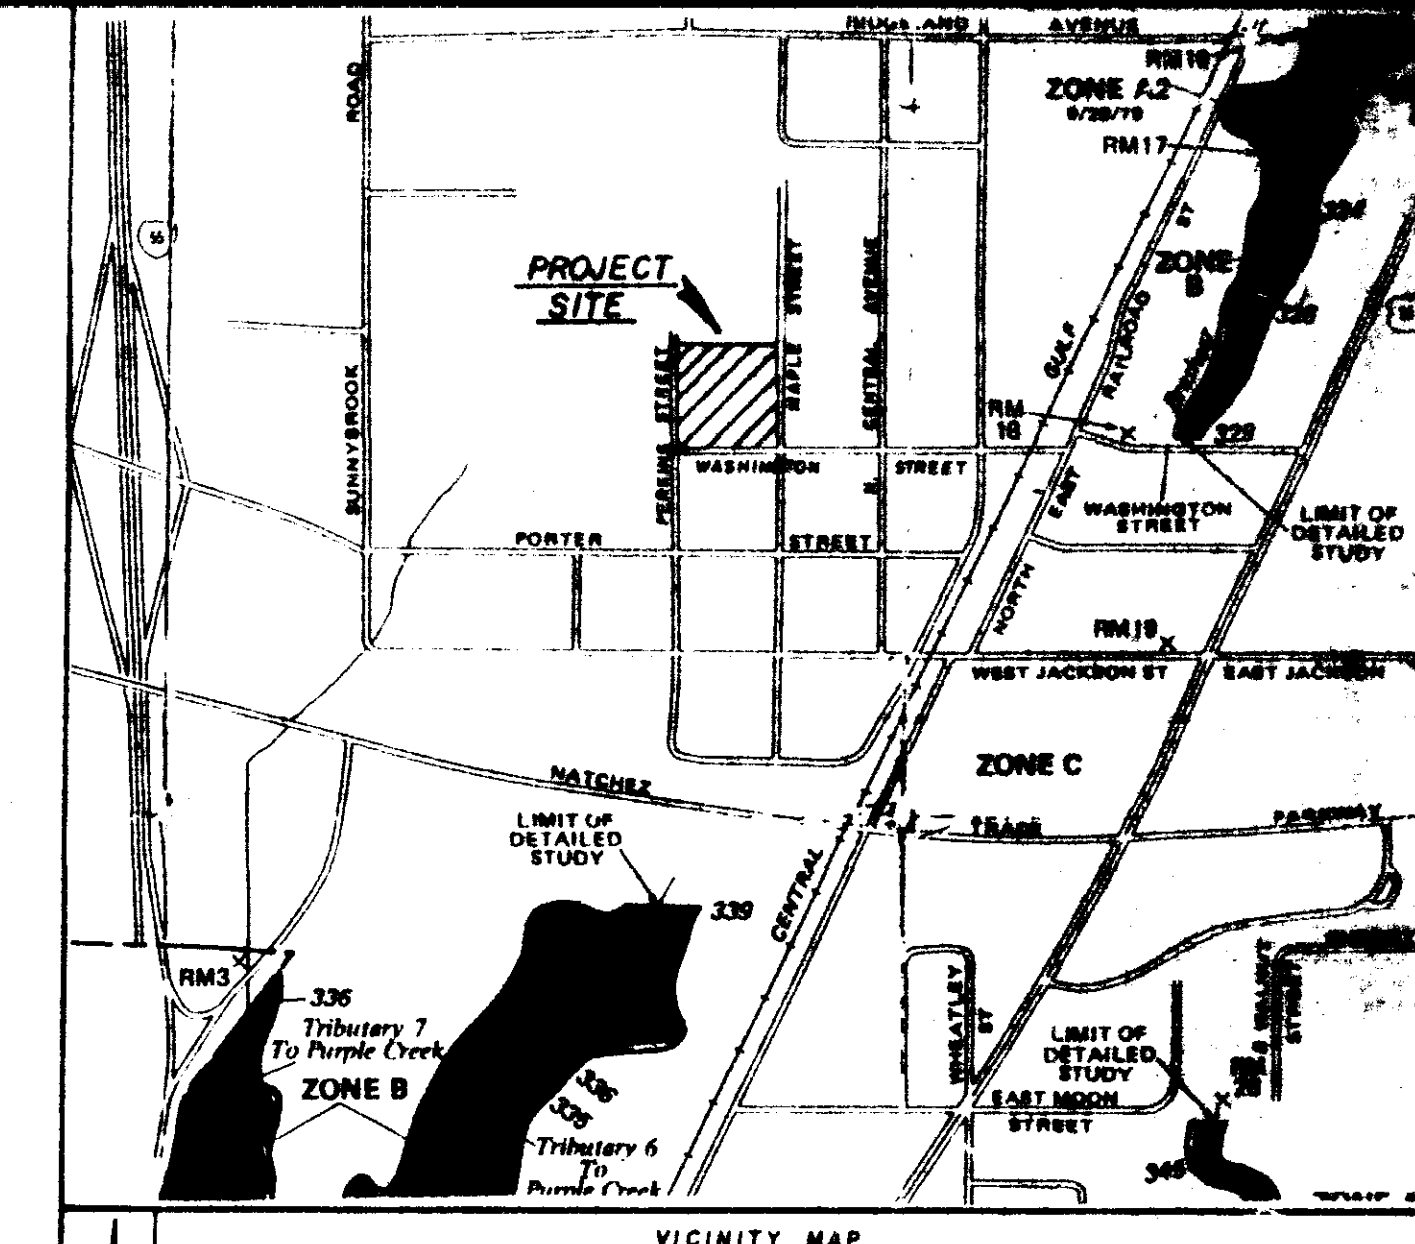

GENERAL NOTES

- THIS PROPERTY IS SITUATED IN ZONE "C" NOT A FLOOD HAZARD AREA, ACCORDING TO FIRM MAP NO 280228-0295-B, DATED JAN. 2, 1980.
- CONSTRUCTION OF STREETS AND UTILITIES WILL BE IN ACCORDANCE WITH CITY OF RIDGELAND REGULATIONS
- LOT SETBACKS
 FRONT - 25'
 SIDE - 5'
 REAR - 25'

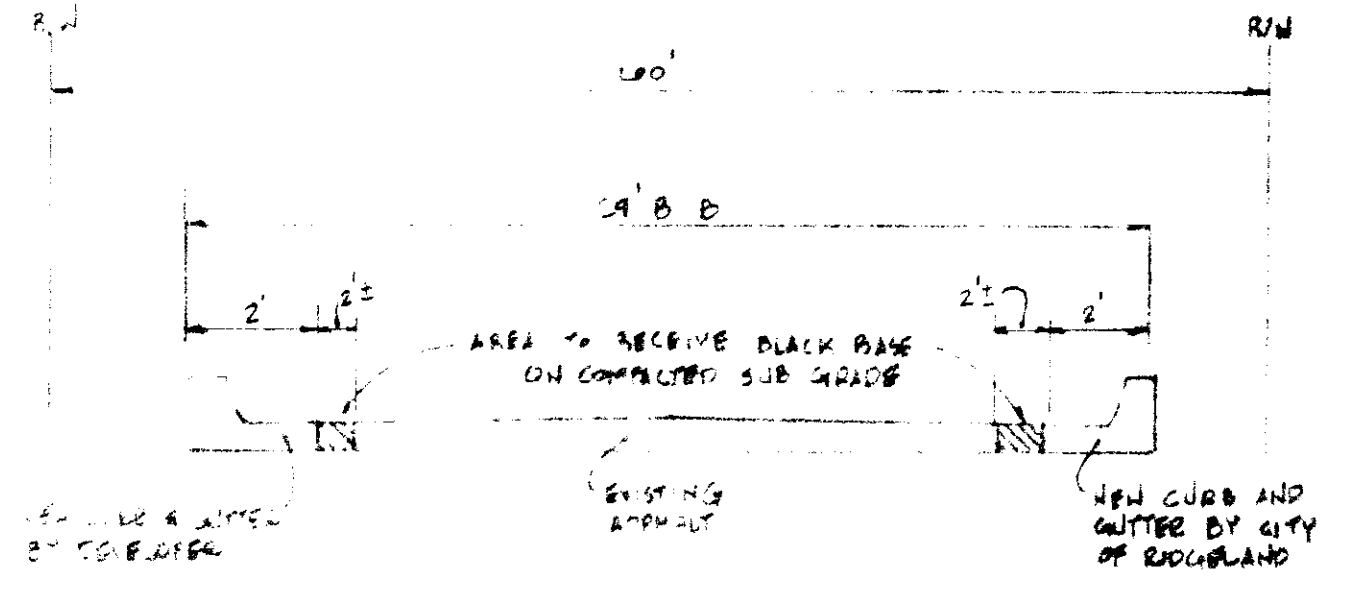

TYPICAL SECTION - EXISTING STREET

NOTE: ALL CURB & GUTTER ON EXISTING STREETS TO BE INSTALLED UNDER THIS PROJECT. THERE WILL BE RELATED EXCAVATION AND GRADING WORK REQUIRED IN ORDER TO MATCH GRADES WITH THE EXISTING PAVEMENT. THIS SHOULD BE INCLUDED IN THE UNIT PRICE FOR CURB & GUTTER. THE ASPHALT BASE REQUIRED TO MATCH PAVEMENT TO NEW CURB SHOULD BE PRICED BY THE TON AND NOT INCLUDED IN THE 5" BASE ON THE NEW STREET. THE CONTRACTOR WILL STOCKPILE SUFFICIENT MATERIAL FROM THE STREET EXCAVATION PROCESS TO BACKFILL ALL CURBS.

DEVELOPED BY: JAMES WEAVER, INC.
 P.O. BOX 1157
 MADISON, MS. 39130


4-24-92
 [Signature]

SITE PLAN
OLDE TOWN SUBDIVISION, PHASE I
 BLOCK 27 - TOWN OF RIDGELAND
 SITUATED IN THE SW 1/4 OF SECTION 19, T7N - R2E,
 MADISON COUNTY, MISSISSIPPI

SCALE: 1" = 50' (HORIZ.)
1" = 5' (VERT.)

DATE _____ BY _____
FINAL SURVEY PLOTTED BY _____
NOTE BOOK NO. _____ AREAS CHECKED _____

DATE _____ BY _____
ORIGINAL SURVEY PLOTTED BY _____
NOTE BOOK NO. _____ AREAS CHECKED _____

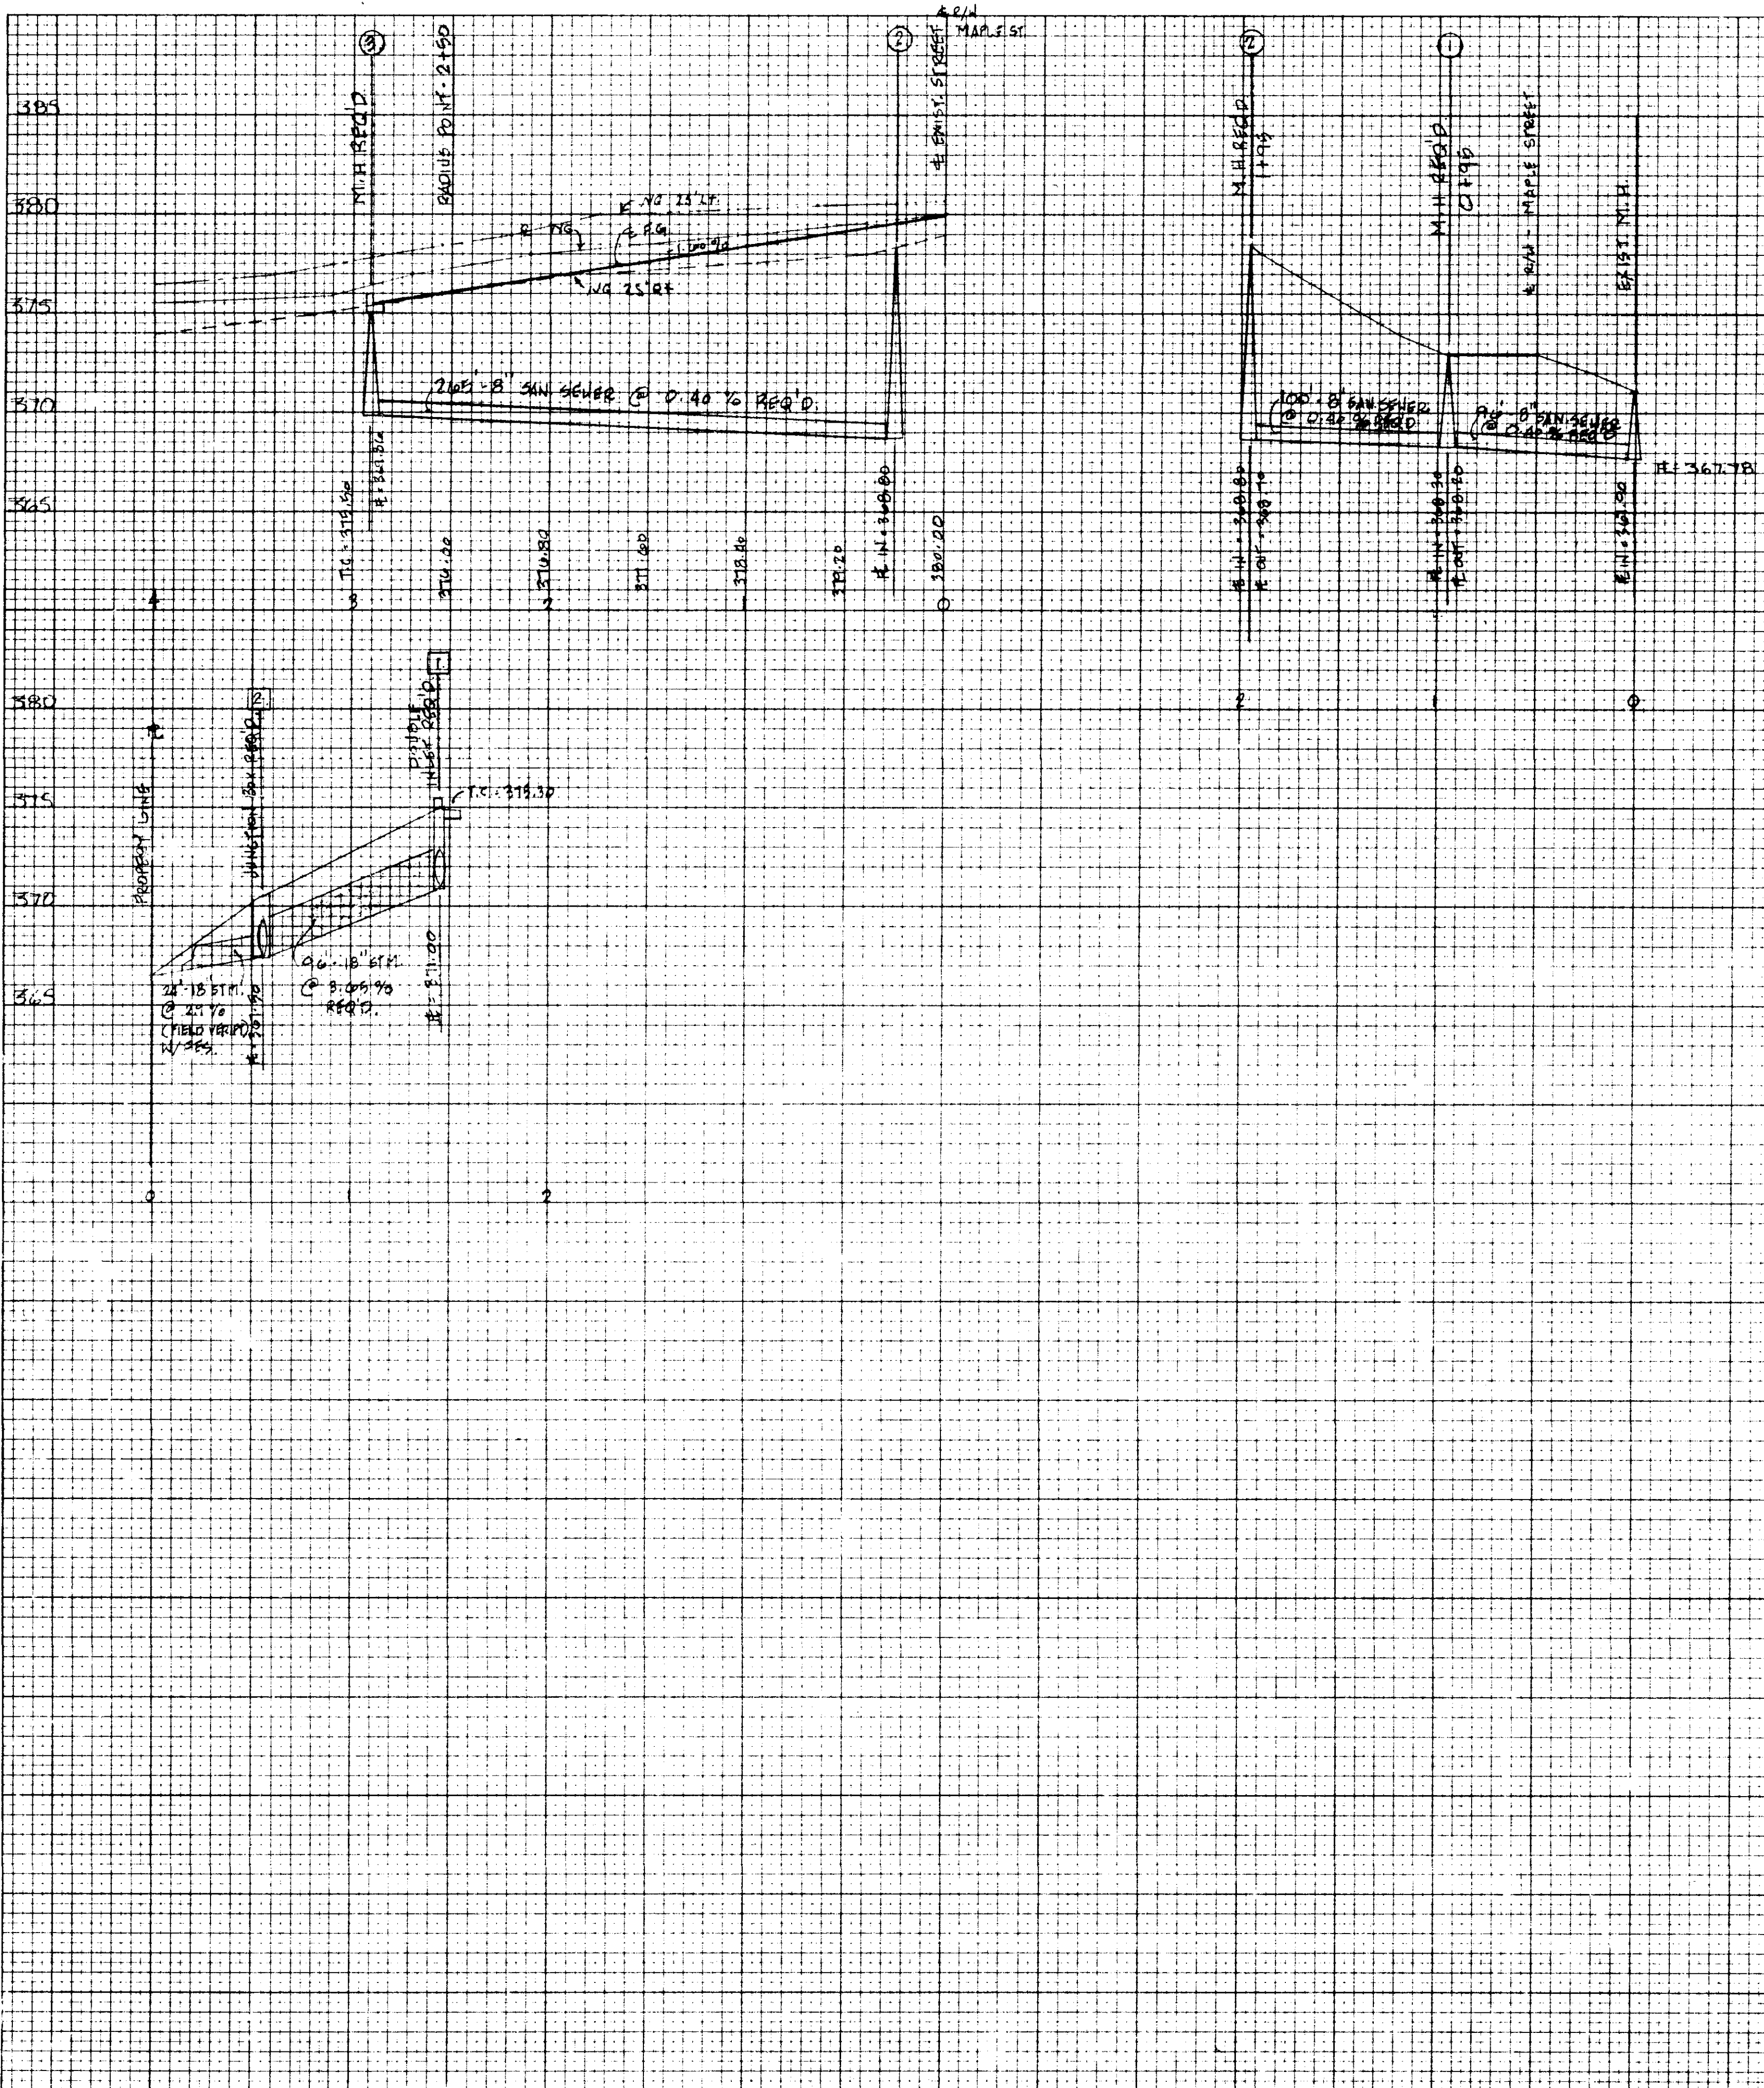

OLD TOWN PHASE I
STORM DRAINAGE COMPUTATIONS

RUNOFF: Q = CIA	CAPACITY: Q = CBS	W. W.
Q = 0.75	Q = 11.40 (1.10)	W = 1.10
I = 0.0008	Q = 11.40	W = 1.10
A = DRAINAGE AREA	Q = 11.40	W = 1.10

NOTE: C, I, A taken from Table 3.1 in the "Concrete Pipe Design Manual" published by the American Concrete Pipe Association

INLET 1: DA = 2.0 AC	12" x 3.55
Q = (0.75)(0.20)	Q = 105 (0.110)
Q = 0.0 CBS	Q = 20.0 CBS

J.B. 2: DA = 0.1 AC	18" x 2.305
Q = 0.0	Q = 104 (0.1703)
Q = 0.10 x 0.10	Q = 17.9 CBS
Q = 0.0 CBS	

SEWER SPECIFICATIONS

- All sewer main and services shall be Extra Strength vitrified clay pipe (ASTM C-700), ABS sewer pipe (ASTM D-2689), or PVC sewer pipe (ASTM D 3034) SDR 26.
- Manholes to be precast concrete conforming to ASTM C-478. All manholes shall be waterproofed and shall have watertight flexible connections at inlets and outlets.
- Manhole castings to be Harper No. 1, MSPE Standard, or approved equal.
- Sewer mains to be tested by air per ASTM C-829, results to be furnished to the OWNER and the UTILITY. PVC sewer pipe to have a maximum of 5 ft deflection as determined by the pulling of a 50' sandfill after the pipe has been backfilled for at least 30 days.
- All sewer services to be marked at the property line with a 2" diameter drop cap or other acceptable marker.
- bedding for sewer pipe shall be Class "C" in accordance with ASTM C-12 for rigid pipe and Class III in accordance with ASTM D-2321 for flexible pipe.
- Manholes shall be waterproofed with an application of MOHRENS 300 M Coal Tar Epoxy or approved equal, inside and outside.
- All sewer 24 inches or less will be laid with straight alignment between manholes and will be checked by either laser or lapping methods.
- All backfill will be of suitable material, hand tamped to (1) foot of the top of the pipe, and otherwise placed in such a manner as not to disturb the alignment of the pipe.
- Sewer and water mains will have a minimum separation of ten (10) feet horizontally and 18 inches vertically with relation to each other.
- Leakage tests shall include appropriate water or low pressure air testing. The leakage outward or inward (exfiltration or infiltration) shall not exceed 200 gallons per inch of pipe diameter per mile per day (0.19 in/cm of pipe dia./hr/day) or any portion of the system. An exfiltration or infiltration test shall be performed with a minimum positive head of 2 feet (0.61 m). The air test, if used, shall, as a minimum conform to the test procedure described in ASTM C-828-76T, entitled "Testative Recommended Practice for Low Pressure Air Test of Vitrified Clay Pipe Lines". The testing methods selected should take into consideration the range in ground water elevations projected and the situation during the test.

WATER SPECIFICATIONS

- Water mains are to be testably finished and installed in accordance with AWWA Standard C-600. Proof of satisfactory bacteriological tests from the Mississippi State Board of Health Laboratory will be furnished to the ENGINEER.
- Water mains are to be pressure tested in accordance with AWWA Standard C-600-77, Section 4 results to be furnished to the ENGINEER.
- Water mains to be 6-900 PVC, Class 350, with 36" manhole cover.
- Pipe Hydrants to be 3-way traffic and 1/2" Mueller A-423 or with NSF threads, with D.I. Anchor Couplings.
- Gate valves to be standard AWWA with non-rising stems, iron bodies, bronze mounted and tested to 350 psi, Mueller or American.
- All services shall include Mueller cooperative stop at the main, Mueller Mack II curb stop, and minimum 3/4" polybutylene tubing.