


CONSTRUCTION PLANS
OLDE TOWN SUBDIVISION, PHASE II

BLOCK 12 & BLOCK 20 - TOWN OF RIDGELAND

SITUATED IN THE SW 1/4 OF SECTION 13 T17N - R2E,
 MADISON COUNTY, MISSISSIPPI

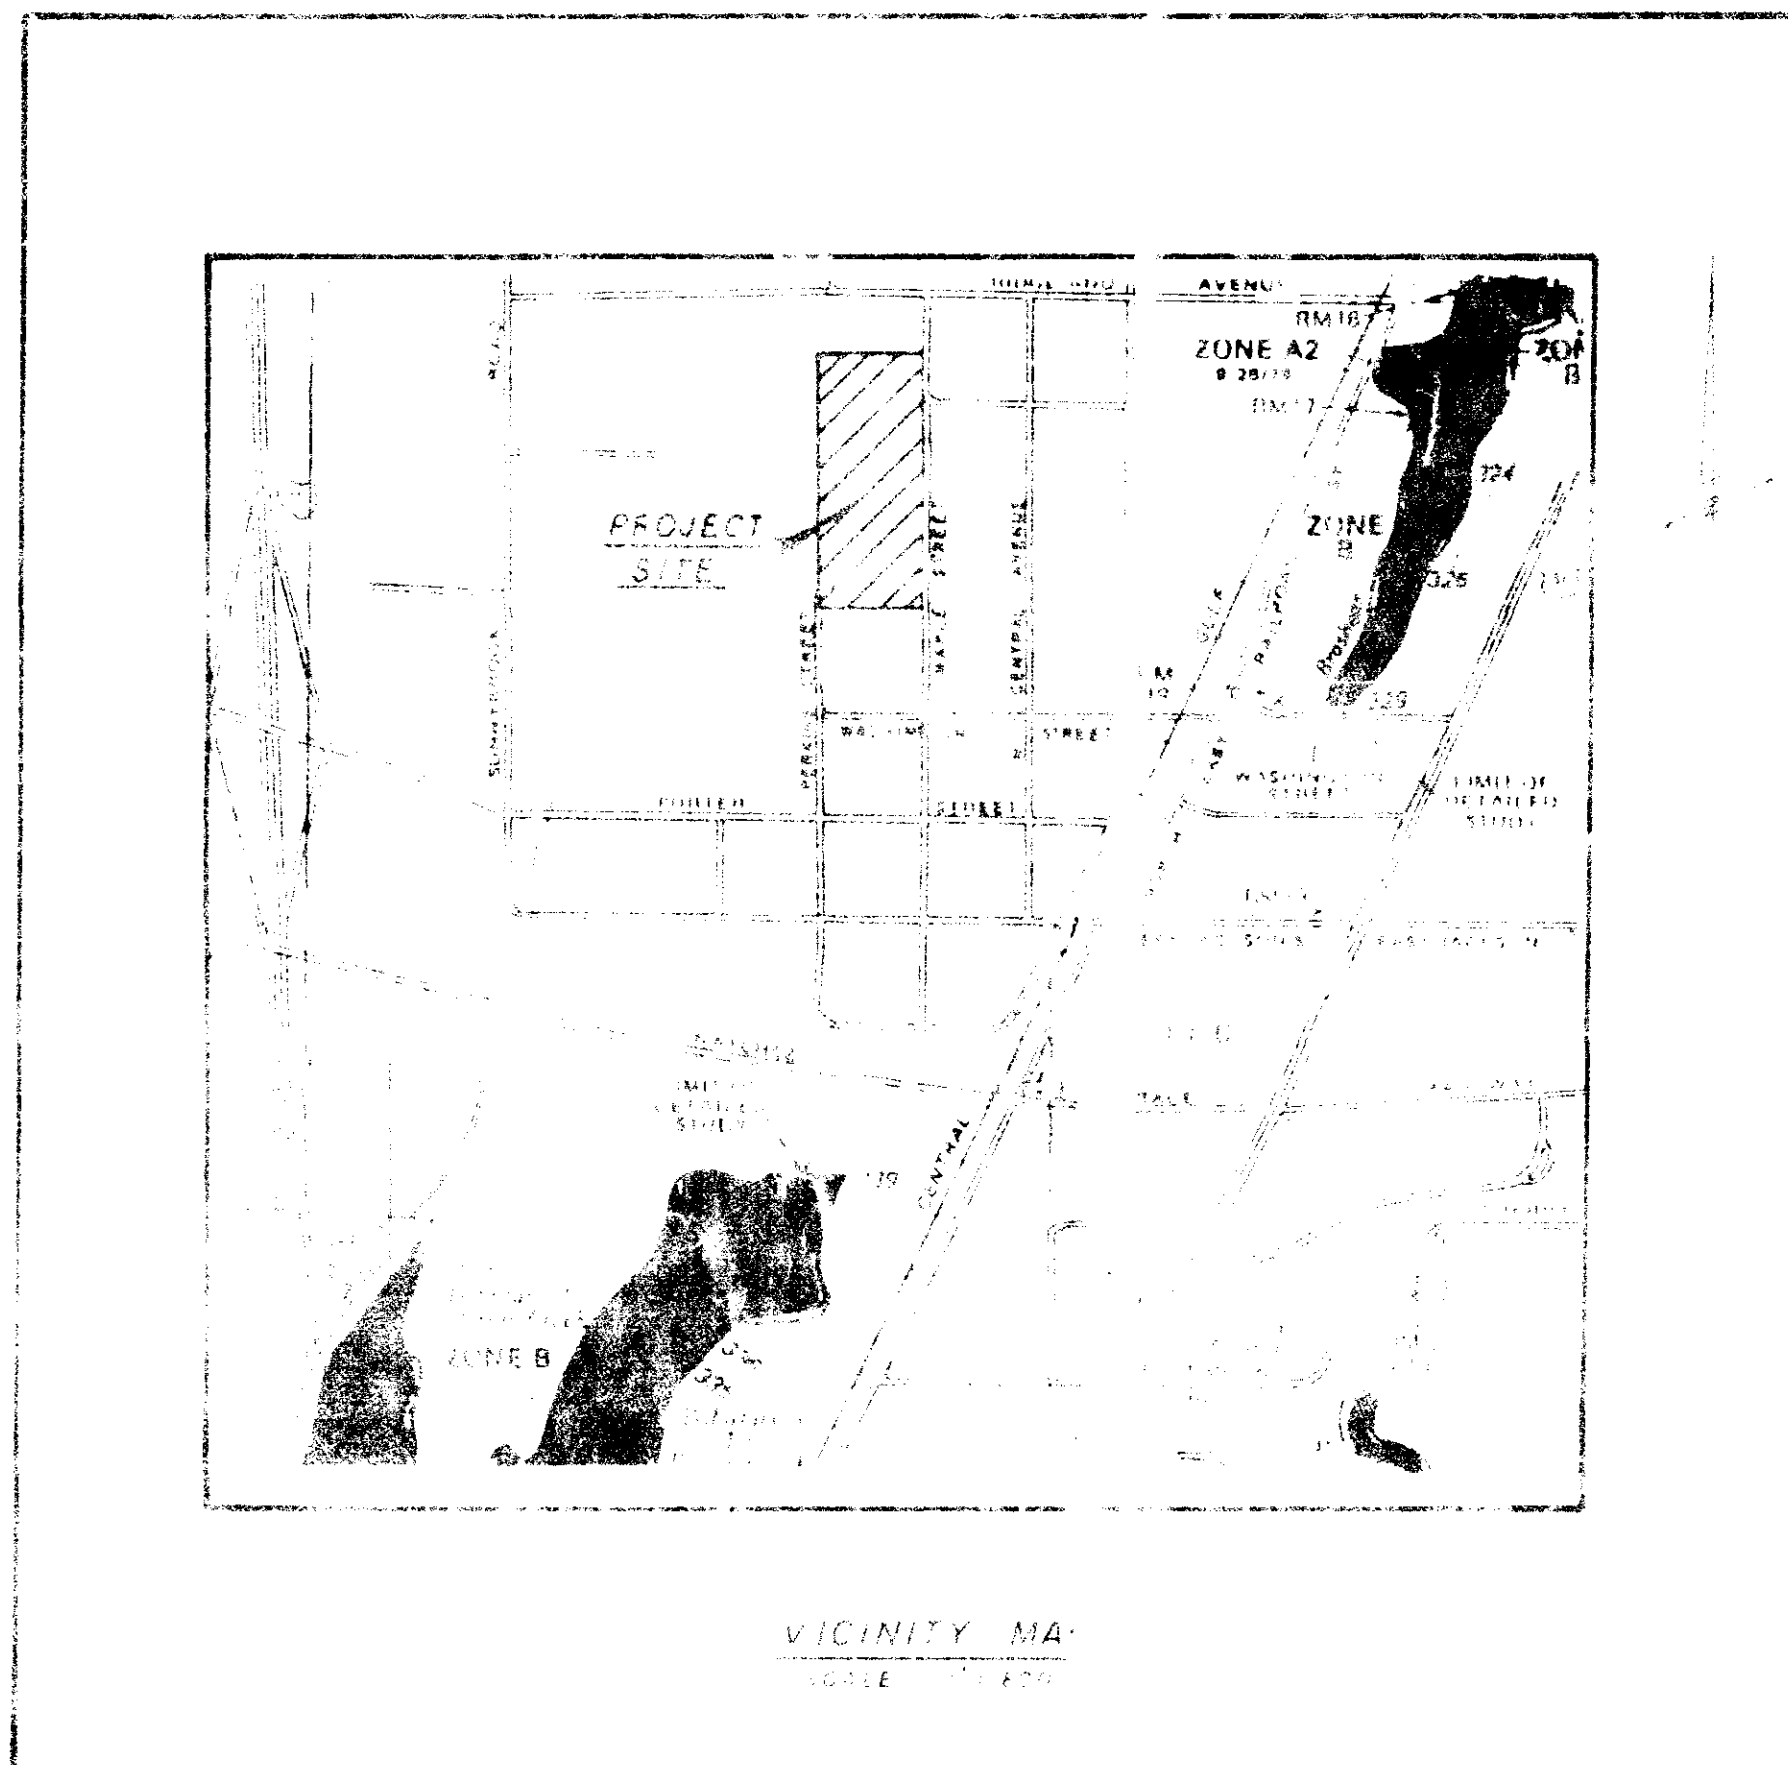

INDEX OF DRAWINGS

| SHT. NO. | DESCRIPTION |
|----------|--|
| 1 | COVER SHEET |
| 2 | PRELIMINARY PLAT |
| 3 | PLAN & PROFILE |
| 4 | PAVEMENT STREET IMPROVEMENTS |
| 5 | STANDARD SANITARY SEWER CONSTRUCTION DETAILS |
| 6 | STANDARD WATER CONSTRUCTION DETAILS |

DEVELOPED BY : OLDE TOWNE BUILDING CO., INC.
 P.O. BOX 1187
 MADISON, MISSISSIPPI 39130

DRAWING CORRECTED
 AS BUILT
 DATE: 1/15/92
 BY: [Signature]

DESIGNED BY : CENTRAL MISSISSIPPI ENGINEERING, INC.
 4000 W. BEND AVENUE
 JACKSON, MISSISSIPPI 39209

PWP-01509

OLDE TOWN PHASE II
RETENTION DESIGN

DA (thru inlet #6) = 9.0 ac


ORIGINAL CONDITIONS:
Q = CIA
Q = (0.5)(6.0)(9.0)
Q = 27.0 cfs

IMPROVED CONDITIONS:
Q = CIA
Q = (0.75)(7.5)(9.0)
Q = 50.6 cfs


NET INCREASE = 23.6 CFS

STORAGE REQUIRED FOR 15 MIN DURATION
V = (23.6)(60)(15)
V = 21,240 cubic feet
Use 4.25' deep pond
Top = 58.5' x 108.5'
Bottom = 41.5' x 91.5'



DISCHARGE REQUIRED FOR 50% OF ORIGINAL CONDITIONS
24" @ 0.40%
Q = (226)(0.0632)
Q = 14.3 cfs

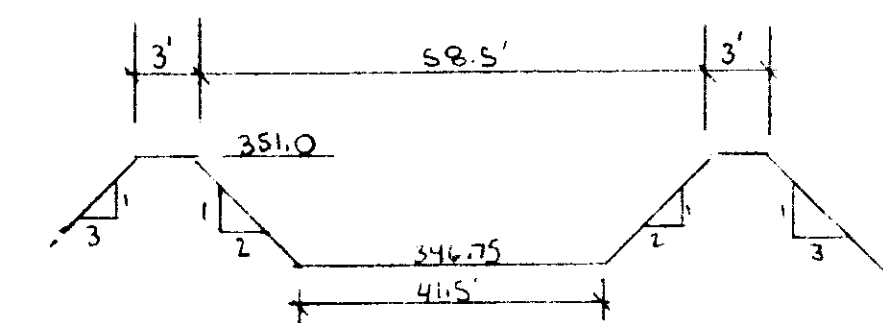


RETENTION POND
SECTION A-A
N.T.S.

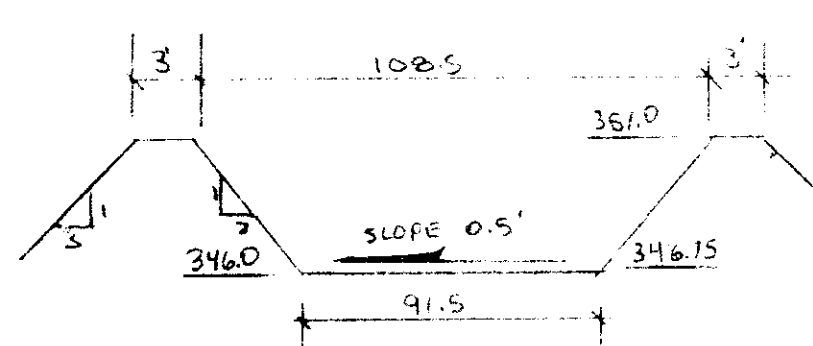


RETENTION POND
SECTION B-B
N.T.S.

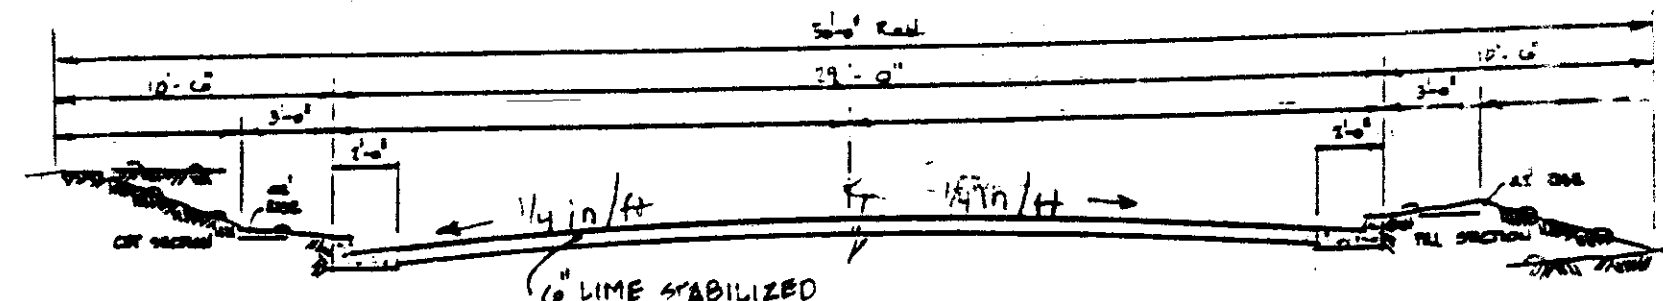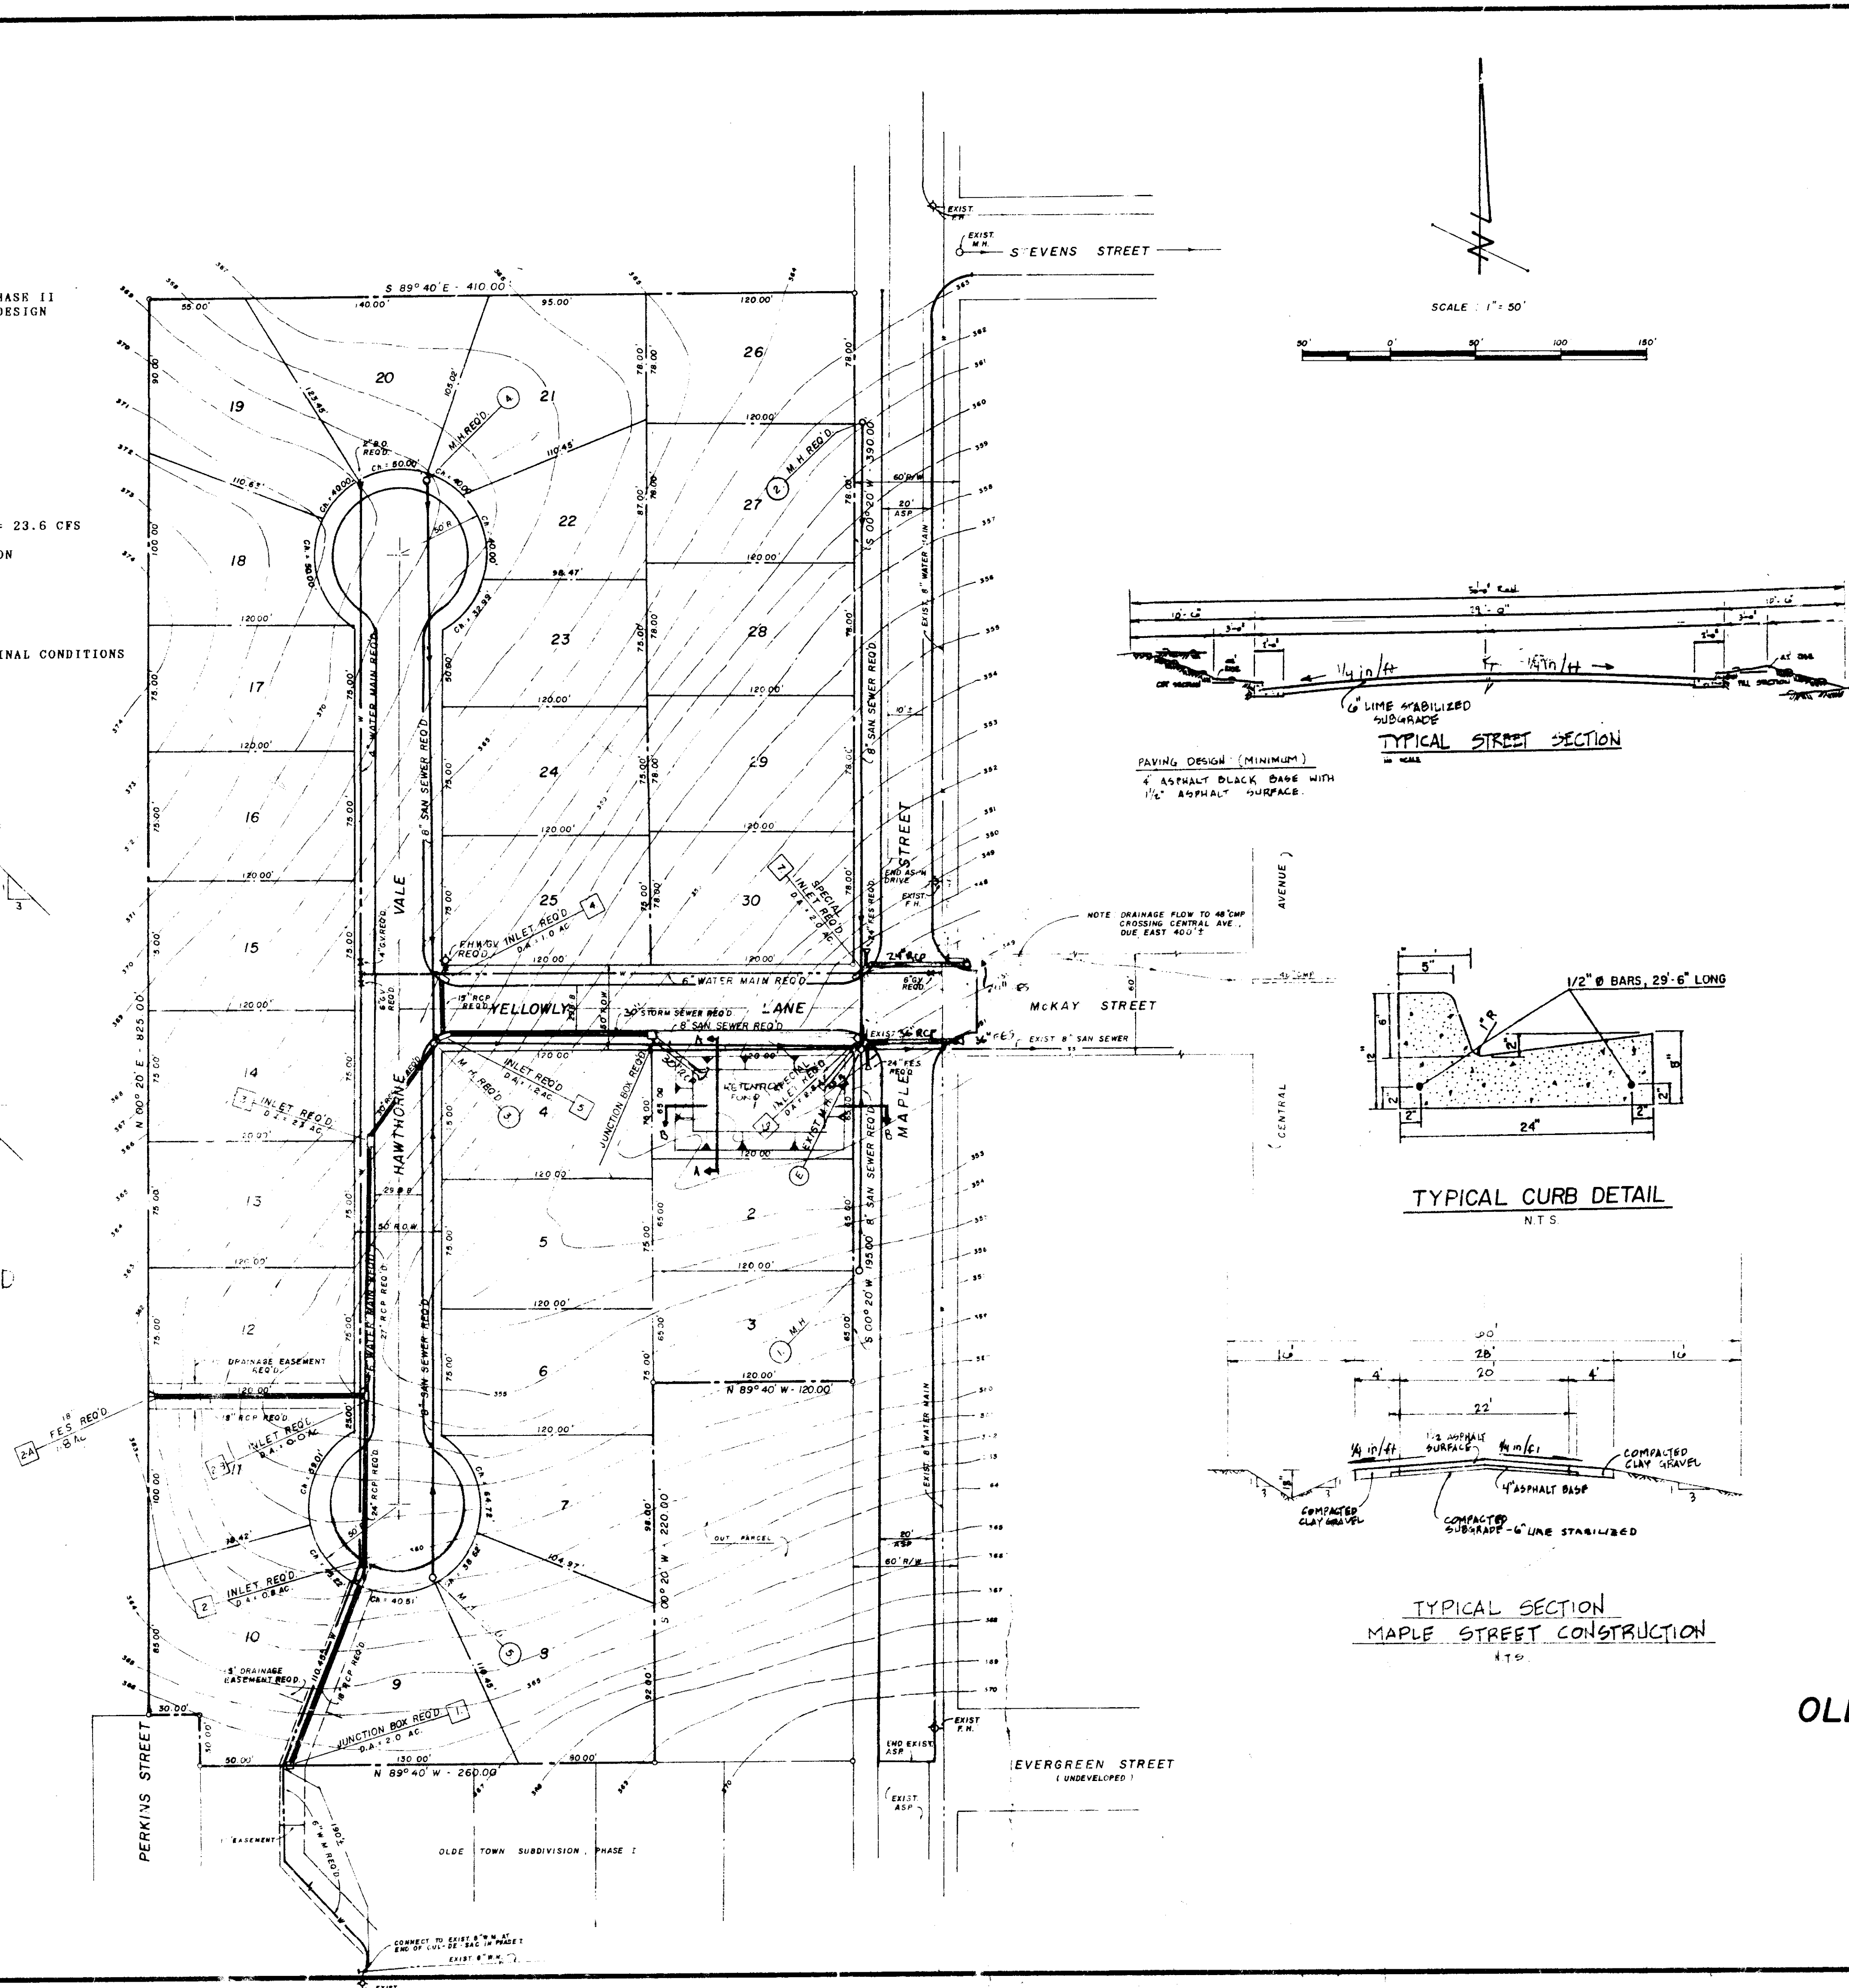


TYPICAL STREET SECTION

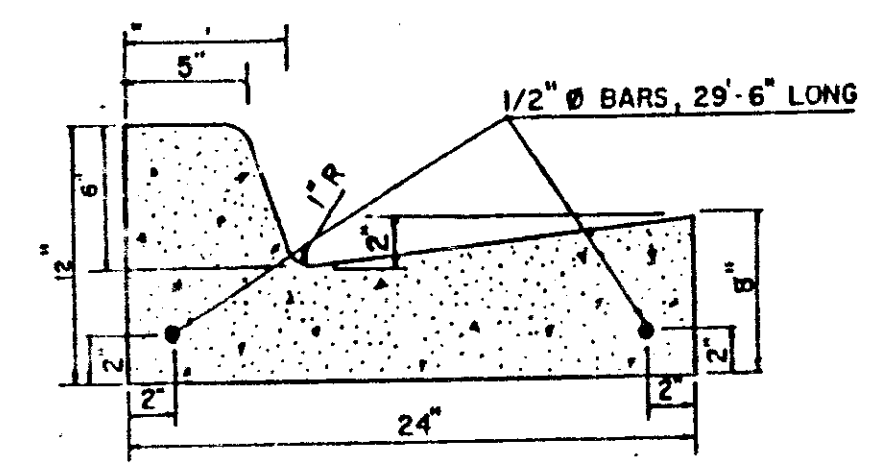

TYPICAL CURB DETAIL
N.T.S.

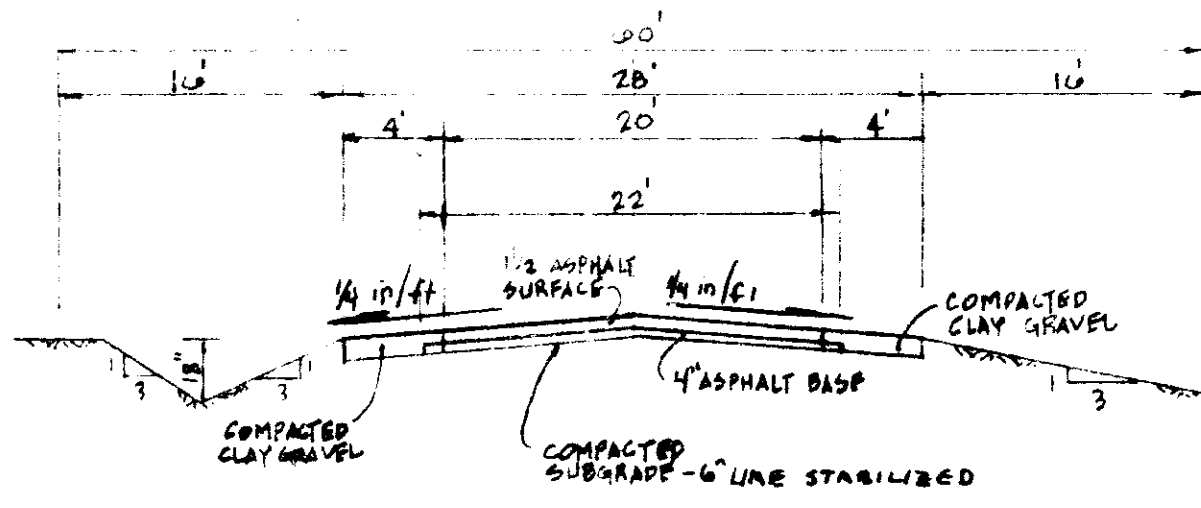

TYPICAL SECTION
MAPLE STREET CONSTRUCTION
1/2"

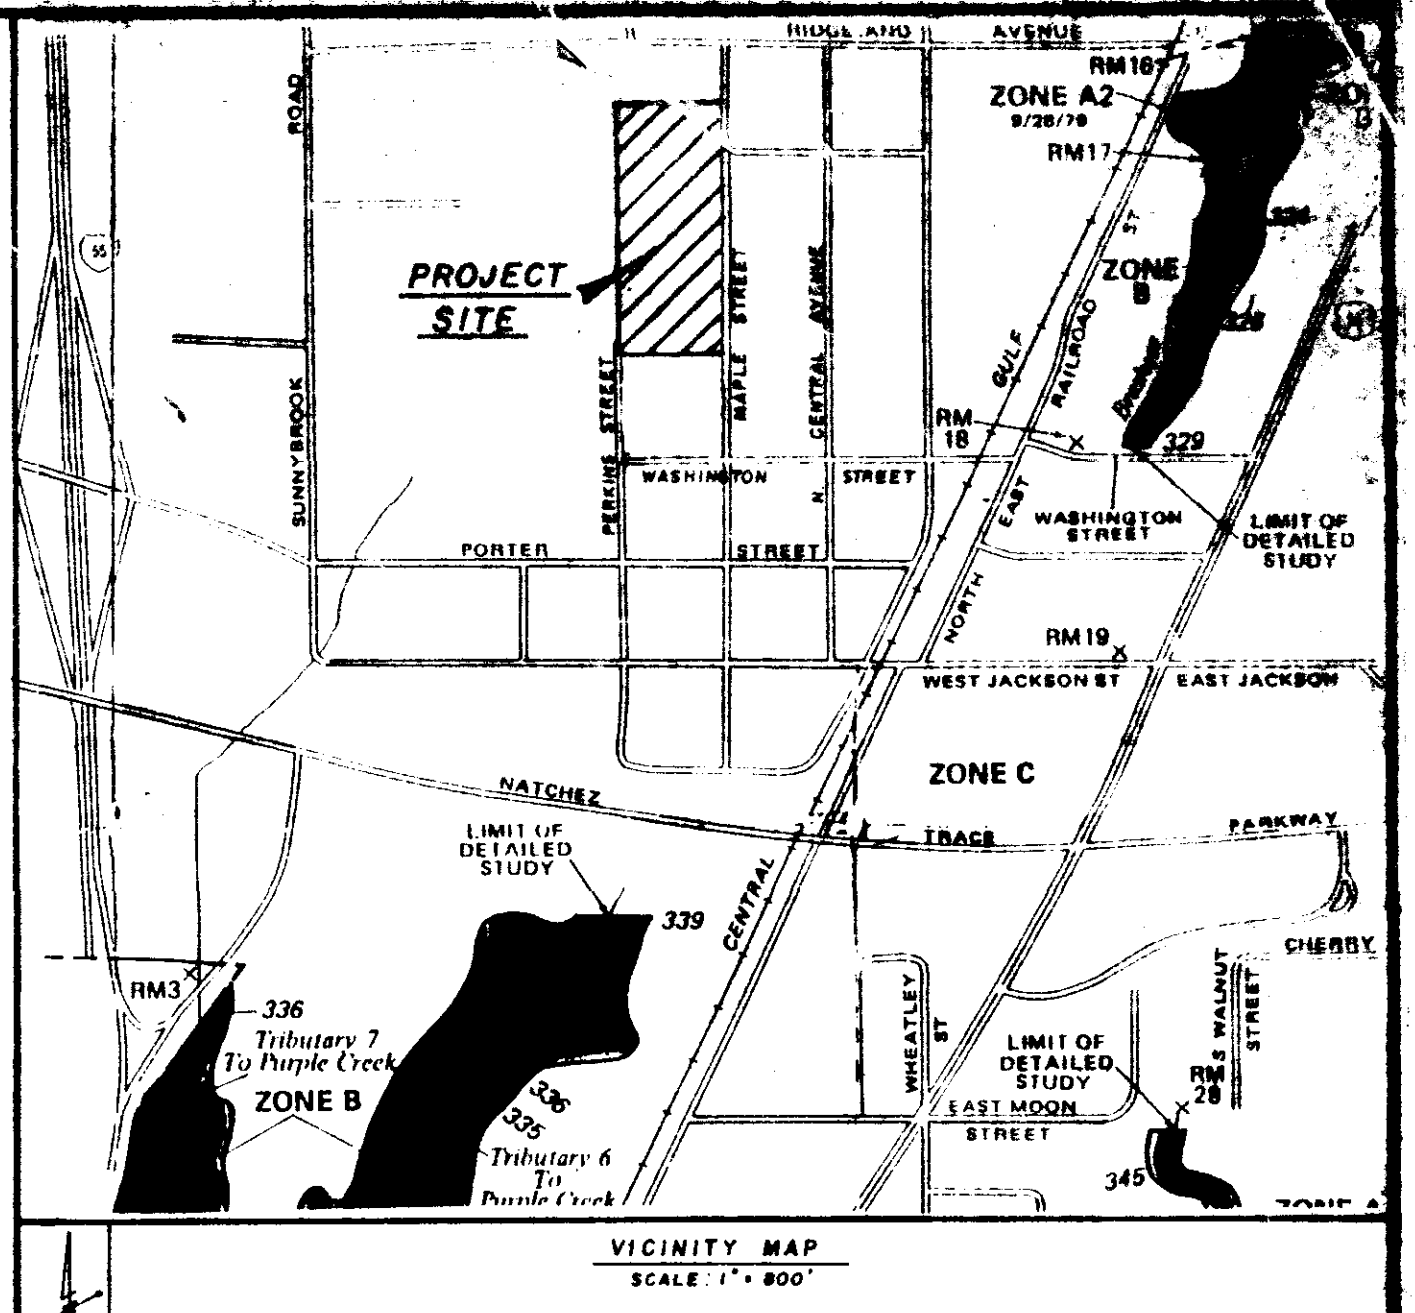

- GENERAL NOTES
- THIS PROPERTY IS SITUATED IN ZONE "C" NOT A FLOOD HAZARD AREA, ACCORDING TO FIRM MAP NO 280228-0295-B, DATED JAN. 2, 1960.
 - CONSTRUCTION OF STREETS AND UTILITIES WILL BE IN ACCORDANCE WITH CITY OF RIDGELAND REGULATIONS
 - LOT SETBACKS:
FRONT - 25'
SIDE - 5'
REAR - 25'
 - TOPOGRAPHIC SURVEY BY OTHERS
 - NEW STREET CONSTRUCTION WILL BE REQUIRED ON MAPLE STREET FROM EVERGREEN STREET TO STEVENS STREET.
 - EXCESS EXCAVATION NOT REQUIRED FOR MAPLE STREET CONSTRUCTION TO BE PLACED ON LOTS 1, 2, 11, 12, 13 & 30

DEVELOPED BY : OLDE TOWNE BUILDING CO., INC.
P.O. BOX 1157
MADISON, MS 39130



PRELIMINARY PLAT
OLDE TOWN SUBDIVISION, PHASE II
BLOCK 12 & BLOCK 20 - TOWN OF RIDGELAND
SITUATED IN THE SW 1/4 OF SECTION 19, T7N - R2E,
MADISON COUNTY, MISSISSIPPI.

CENTRAL MISSISSIPPI ENGINEERING
4 RIVER BEND PLACE, SUITE 110 FLOWOOD, MS 39208 601-932-3068

REV 5-30-92
REV 6-8-92
REVISION 4-24-92
REVISION 4-14-92
FEBRUARY, 1992
REV 7/27/92
REV 7/28/92


| | |
|-----------|--|
| DATE | |
| BY | |
| REVISION | |
| NO. | |
| PLAN | |
| NOTE BOOK | |
| NO. | |

| | |
|-----------|--|
| DATE | |
| BY | |
| REVISION | |
| NO. | |
| PROFILE | |
| NOTE BOOK | |
| NO. | |

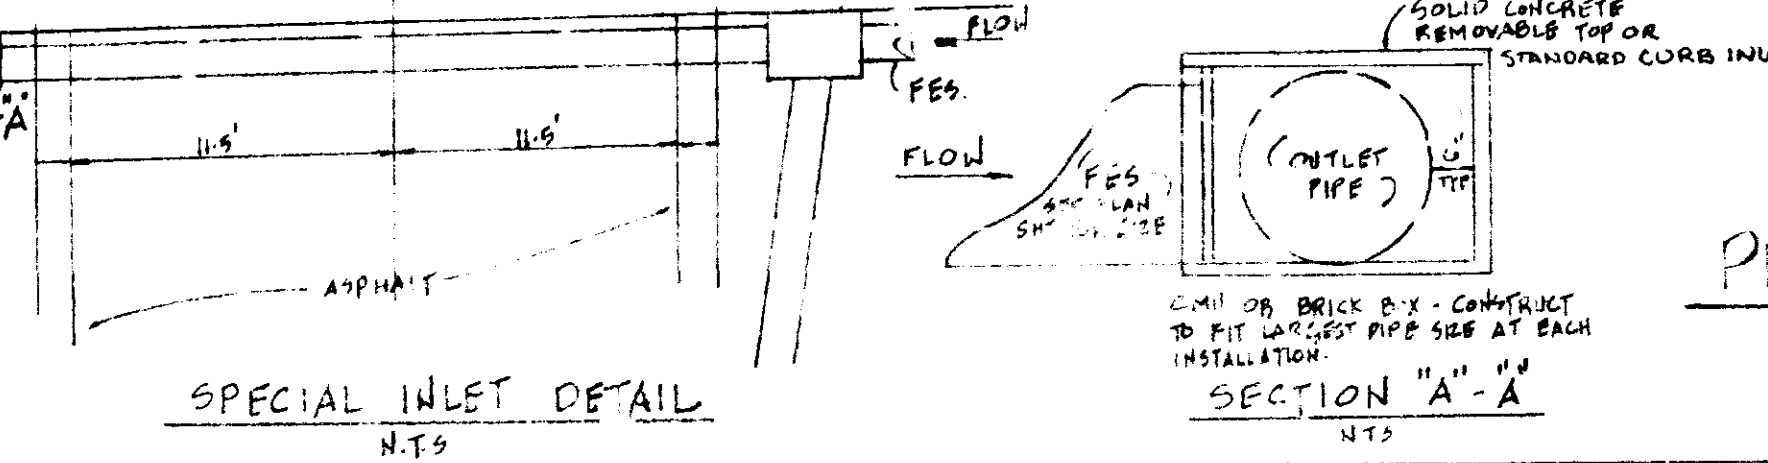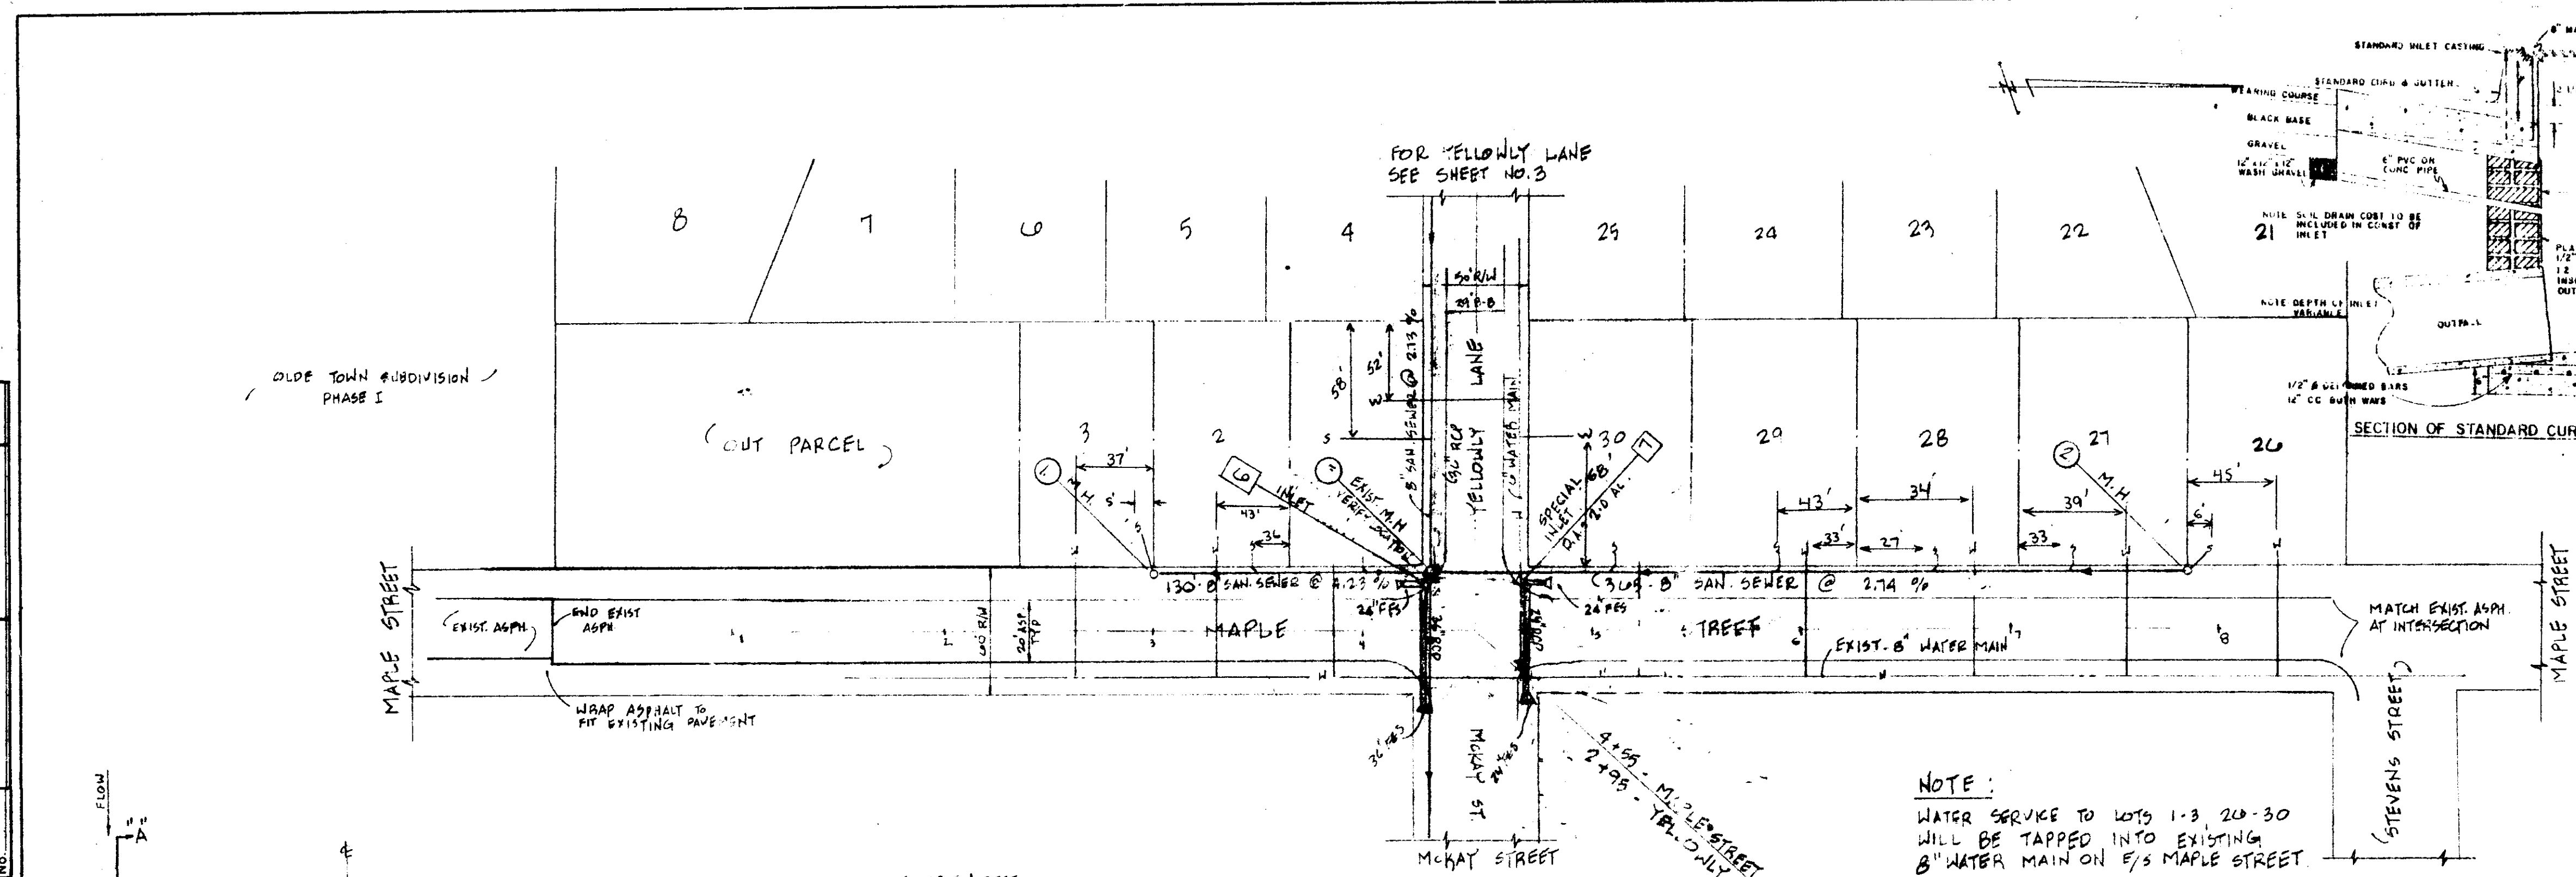

PLAN - PROFILE : MAPLE STREET IMPROVEMENTS

SCALE : 1" = 50' (HORIZ.) / 1" = 5' (VERT.)

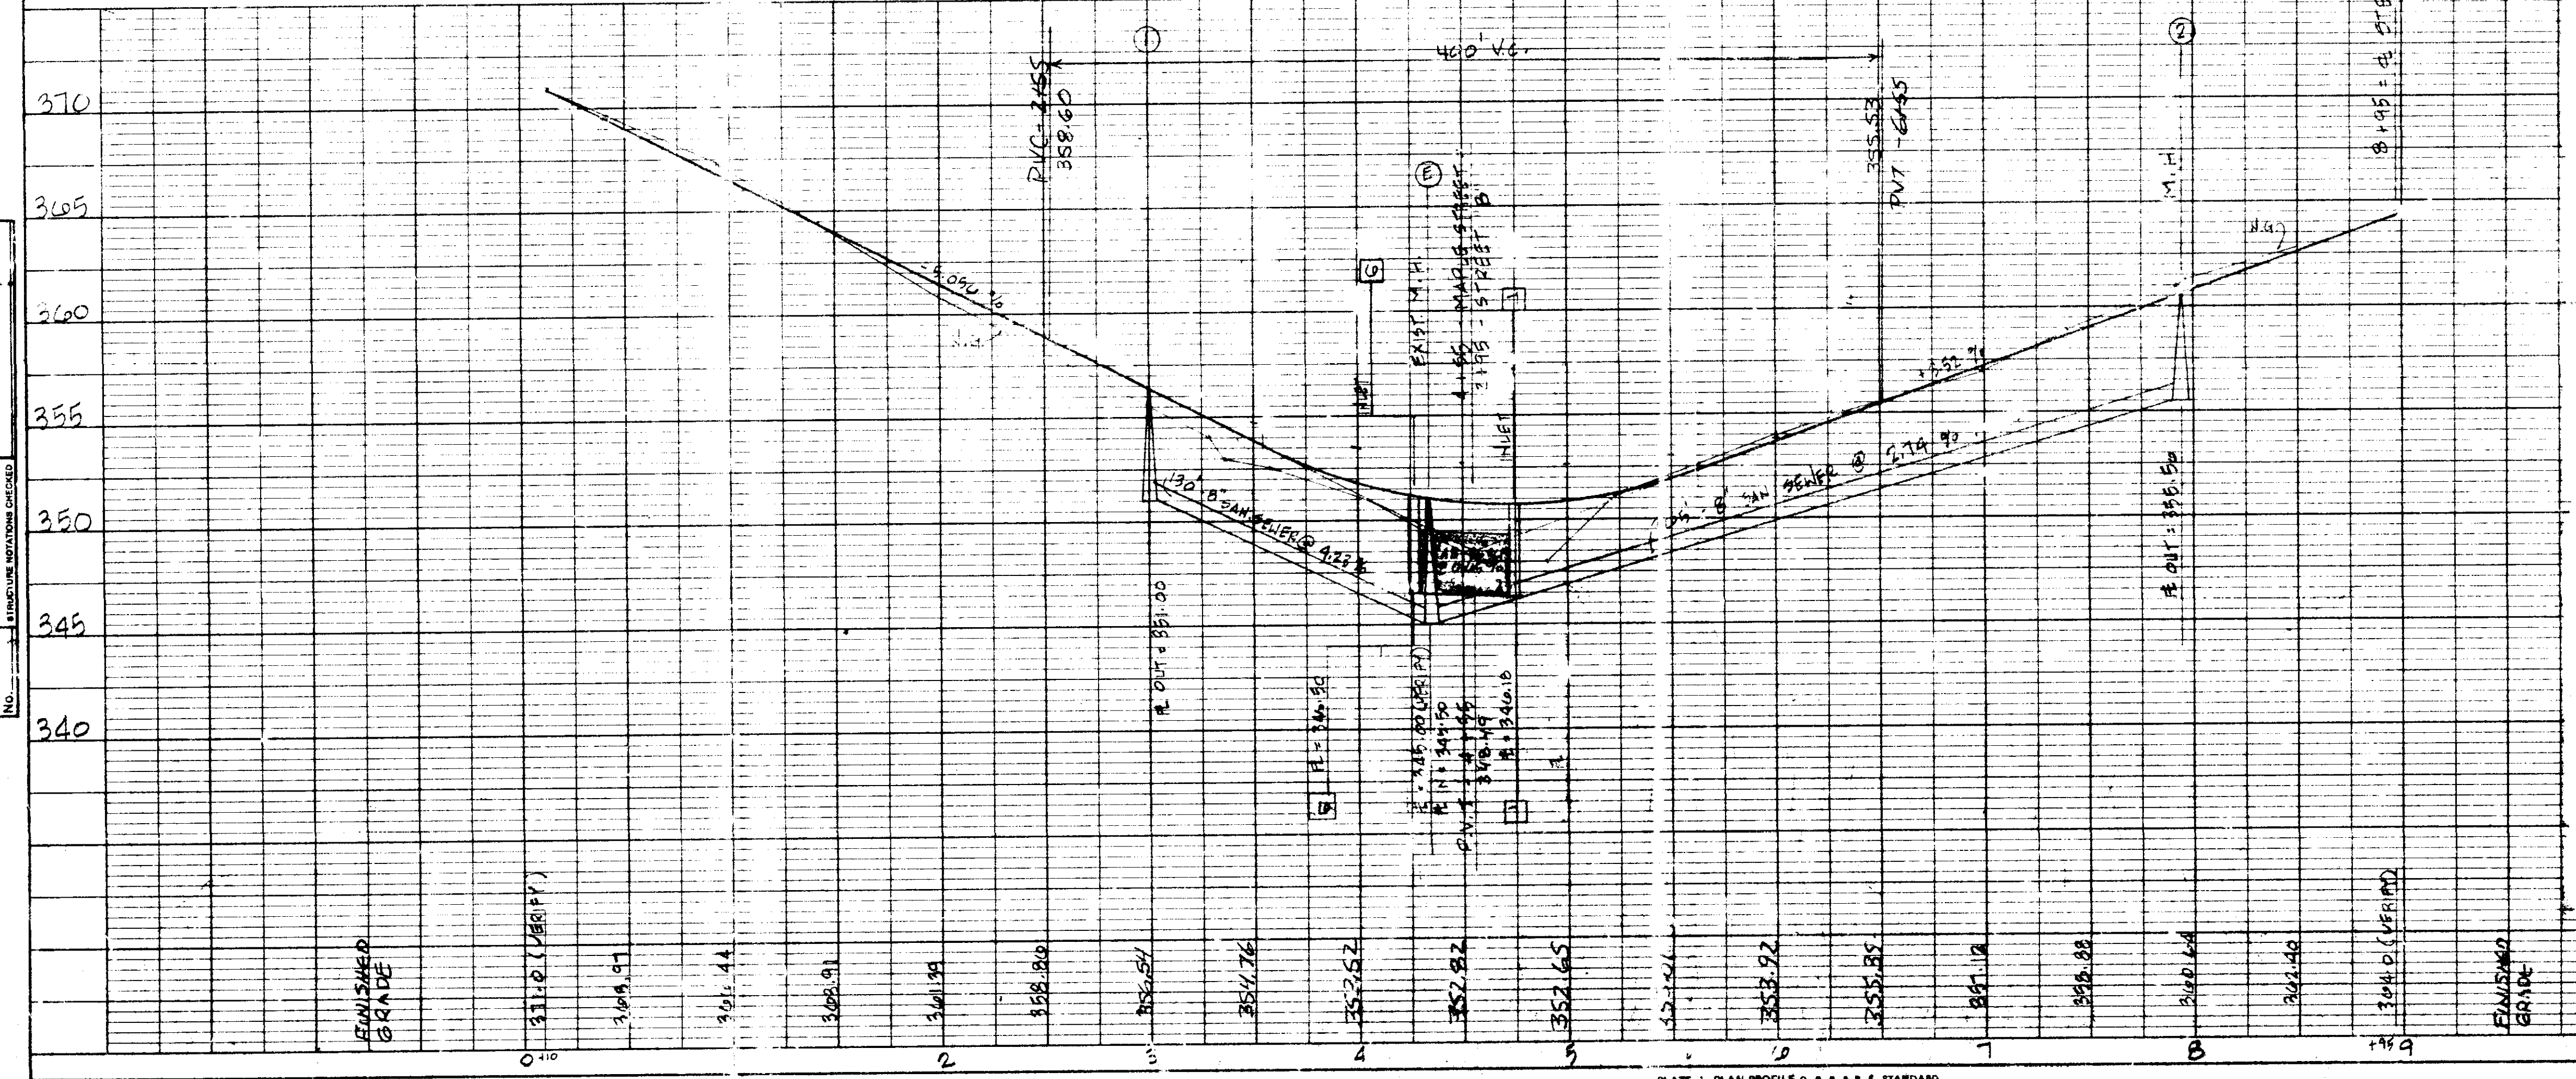

OLDE TOWN PHASE II STORM DRAINAGE COMPUTATIONS

RUNOFF: Q = CIA
C = 0.75
I = 7.5 INCHES/HOUR
A = DRAINAGE AREA

CAPACITY: Q = CxS
C = (1.48/n)xAR
S = SLOPE
N = 0.013

NOTE: This is taken from Table 3 in the "Concrete Pipe Design Manual" published by the American Concrete Pipe Association.

| | | |
|----------|---|--|
| INLET 1 | DA = 2.0 AC Q = (0.75)(7.5)(2.0) Q = 11.3 CFS | 18" @ 0.33% Q = 105 (0.2886) Q = 30.3 CFS |
| INLET 2 | DA = 0.8 AC Q = (0.75)(7.5)(0.8)+Q Q = 4.5 + 11.3 Q = 15.8 CFS | 24" @ 0.50% Q = 226 (0.0707) Q = 16.0 CFS |
| 2-A | DA = 1.8 AC Q = (0.75)(7.5)(1.8) Q = 10.1 CFS | 18" @ 2.21% Q = 105 (0.1487) Q = 15.6 CFS |
| INLET 2B | DA = 0.0 AC Q = Q + Q Q = 10.1 + 15.8 Q = 25.9 CFS | 27" @ 0.70% Q = 310 (0.0837) Q = 25.9 CFS |
| INLET 3 | DA = 2.3 AC Q = (0.75)(7.5)(2.3)+Q Q = 12.9 + 25.9 Q = 38.8 CFS | 30" @ 0.90% Q = 410 (0.0949) Q = 38.9 CFS |
| INLET 4 | DA = 1.0 AC Q = (0.75)(7.5)(1.0) Q = 5.6 CFS | 16" @ 4.59% Q = 64.7 (0.2142) Q = 13.9 CFS |
| INLET 5 | DA = 1.2 AC Q = (0.75)(7.5)(1.2)+Q+Q Q = 6.7 + 38.8 + 5.6 Q = 51.1 CFS | 30" @ 1.56% Q = 410 (0.1245) Q = 51.1 CFS |
| INLET 6 | DA = 2.8 AC Q = (0.75)(7.5)(2.8)+Q Q = 15.7 + 51.1 Q = 66.8 CFS | 36" @ 1.05% Q = 666 (0.125) Q = 68.2 CFS |
| INLET 7 | DA = 2.0 AC Q = (0.75)(7.5)(2.0) Q = 11.3 CFS | 24" @ 0.50% Q = 226 (0.0707) Q = 15.9 CFS |