

GENERAL INDEX

FOR DETAILED INDEX OF PLANS SEE SHEET NO. 2

DESCRIPTION	NUMBER OF SHEETS
TITLE SHEET	1
DETAILED INDEX	1
GENERAL NOTES	1
TYPICAL SECTIONS	
QUANTITIES	
PLAN AND PROFILES	
SPECIAL DESIGN - ROADWAY ITEMS	
BRIDGE DRAWINGS	0
SPECIAL DESIGN - BRIDGES	0
CROSS-SECTIONS	

TOTAL SHEETS _____

Mayor: **Gene F. McGee**

Mayor Pro Tem: **Gerald Steen**

City Attorney: **Jerry Mills**

Alderman:
Joe Barlow
Harvey Carr, Jr.
Linda Davis
Kathi Irons
Larry Roberts
Daryl Smith
Gerald Steed

Public Works Director: **Sam C. Vinson, P.E.**

Asst. Public Works Director: **Sid E Hawthorne**

Asst. City Engineer: **David E. Williams, P.E.**

City Clerk: **David Overey**

Fire Chief: **Elmer Waits**

Police Chief: **Charles Newell**

SURFACE TRANSPORTATION PROGRAM


PROJECT NO.: STP-6926-00(001)

OLD CANTON ROAD RECONSTRUCTION
 CITY OF RIDGELAND, MISSISSIPPI


OLD CANTON ROAD
 BETWEEN LAKE HARBOUR DRIVE
 NATCHEZ TRACE PARKWAY

SCALES

PLAN 1 IN. = 20 FT.
 PROFILE { HOR. 1 IN. = 20 FT.
 VERT. 1 IN. = 5 FT.
 LAYOUT 1 IN. = FT.

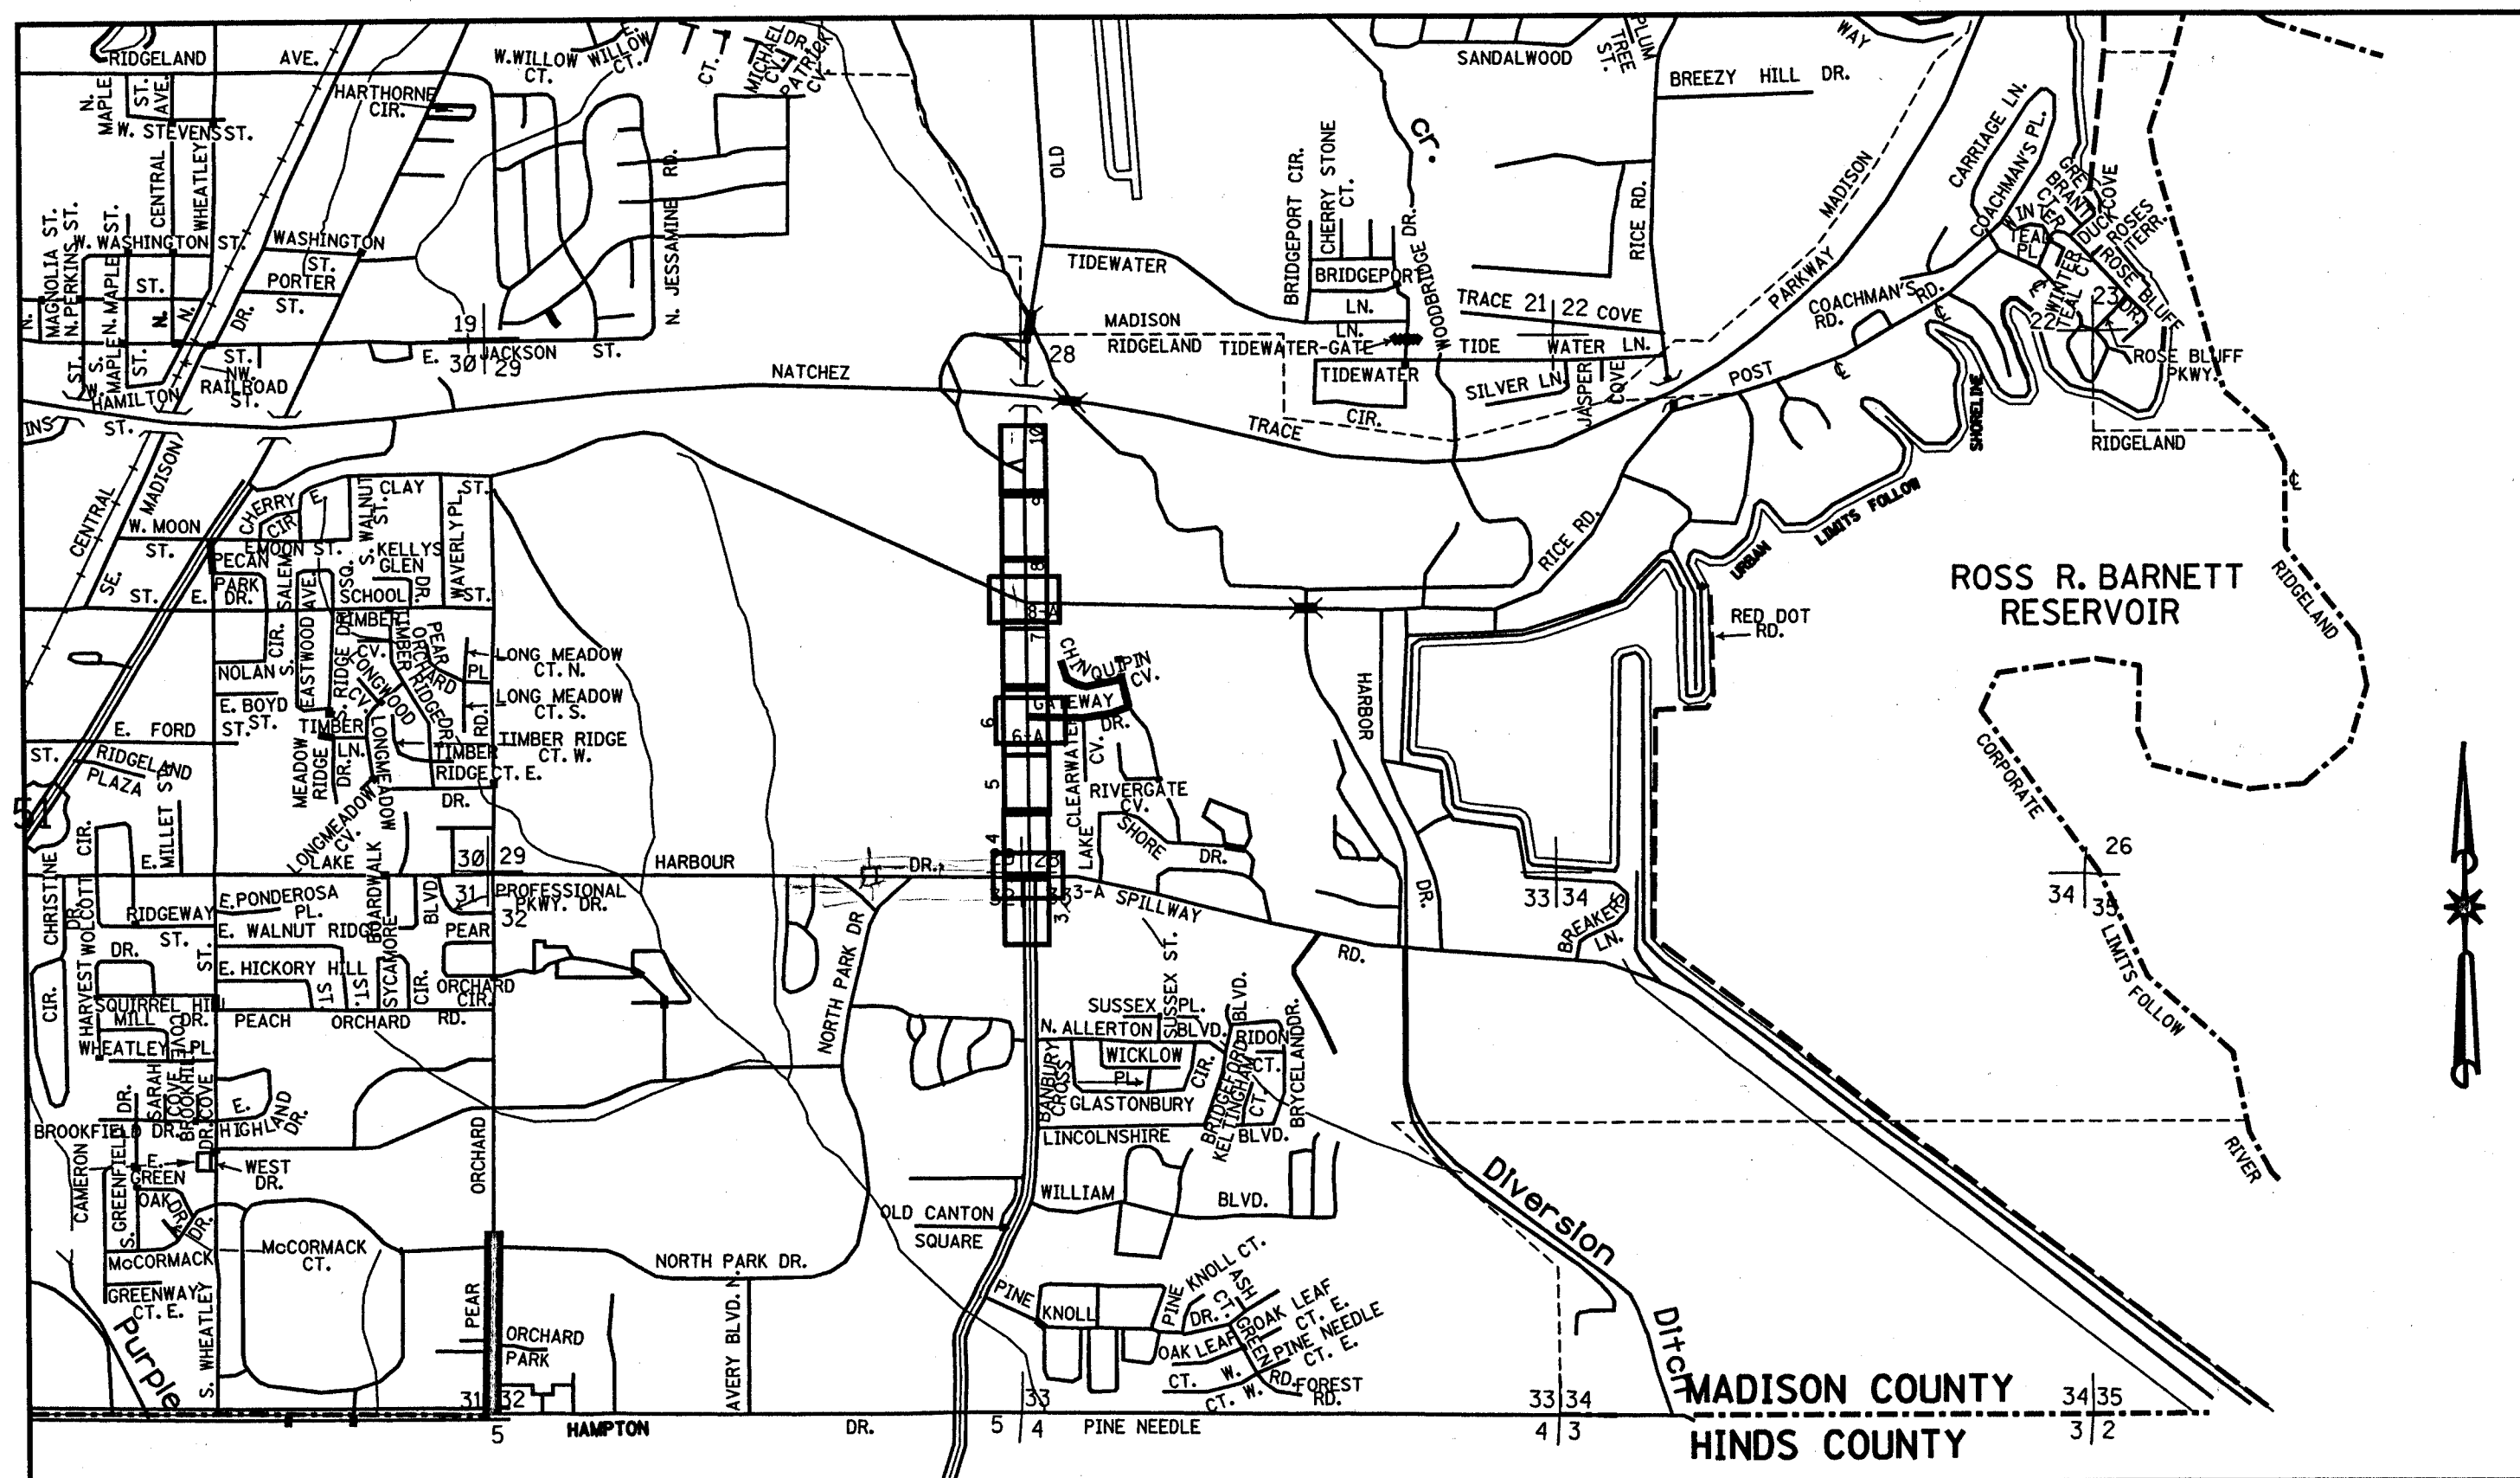

FED. ROAD REG. NO.	STATE	PROJECT NO.	SHEET NO.
4	MISS.	STP-6926-00(001)	1

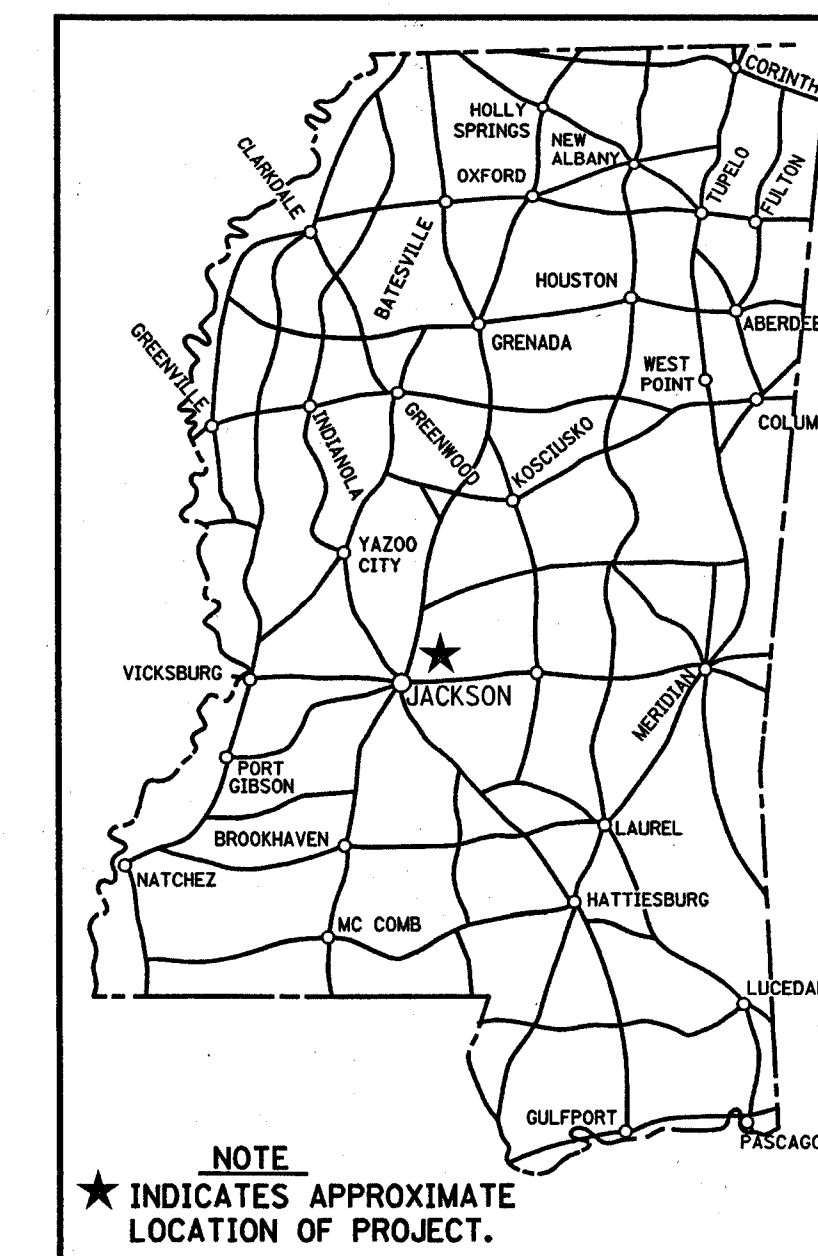

NOTE
 * INDICATES APPROXIMATE LOCATION OF PROJECT.

DESIGN CONTROL

45 MPH = V (SPEED DESIGN)

ADT (2000) = 18,500 ; ADT (2020) = 33,400

DHV = 4.010 ; D = 50 % T = 3 %

ENVIRONMENTAL PERMITS

P.E. NO.	TYPE	REQUIRED	BY
		YES	NO
	N.W. (WATERS OF U.S.)	<input type="checkbox"/>	<input type="checkbox"/>
	N.W. (WETLANDS)	<input type="checkbox"/>	<input type="checkbox"/>
	G.P.	<input type="checkbox"/>	<input type="checkbox"/>
	404	<input type="checkbox"/>	<input type="checkbox"/>
	STORMWATER	<input type="checkbox"/>	<input type="checkbox"/>

CONVENTIONAL SYMBOLS


COUNTY LINE	-----
TOWN CORPORATION LINE	-----
SECTION LINE	-----
EXISTING ROAD OR TRAVELED WAY	-----
PROPOSED ROAD OR TRAVELED WAY	-----
RAILROAD	-----
SURVEY LINE	-----
BRIDGES	-----


LENGTH DATA

LENGTH OF ROADWAY	3.900 FT.	0.74 MI.
LENGTH OF BRIDGES	0 FT.	0 MI.
LENGTH OF PROJECT (NET)	3.900 FT.	0.74 MI.
LENGTH OF EXCEPTIONS	0 FT.	0 MI.
LENGTH OF PROJECT (GROSS)	3.900 FT.	0.74 MI.


APPROVED:

PROJECT ENGINEER	DATE
MAYOR CITY OF RIDGELAND	DATE
CHIEF ENGINEER	DATE
EXECUTIVE DIRECTOR	DATE
MISSISSIPPI DEPARTMENT OF TRANSPORTATION	
DIVISION ADMINISTRATOR	DATE
FEDERAL HIGHWAY ADMINISTRATION	DEPARTMENT OF TRANSPORTATION

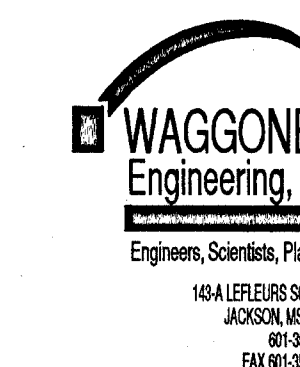


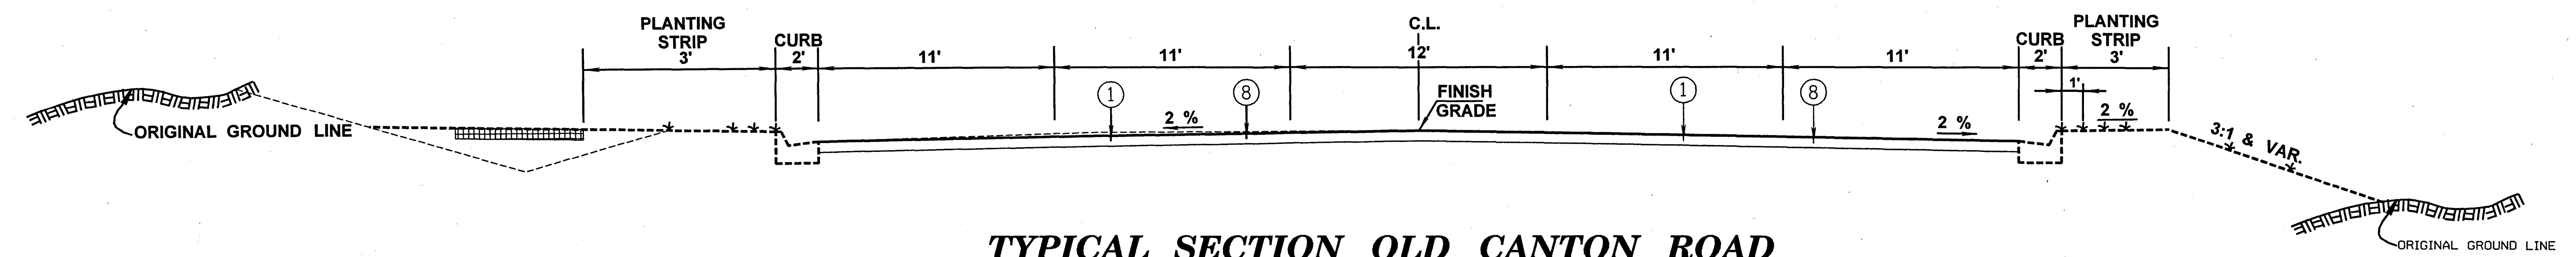

**TYPICAL SECTION OLD CANTON ROAD
STA. 20+40 - 21+10**

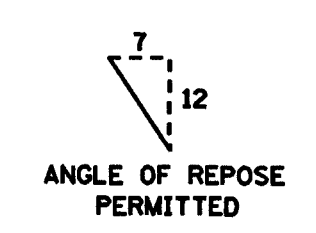


- ① 1.5" HOT MIX ASPHALT, HT (9.5 mm MIXTURE), POLYMER MODIFIED
 - ② 2" HOT MIX ASPHALT, HT (12.5 mm MIXTURE), POLYMER MODIFIED
 - ③ 7.5" HOT MIX ASPHALT, HT (19 mm MIXTURE), POLYMER MODIFIED
 - ④ 6" LIME TREATED SUBGRADE
 - ⑤ 3' MIN. UNDERCUT REQ'D. BORROW EXCAVATION, CLASS B-15-MODIFIED
 - ⑥ COMBINATION CONCRETE CURB AND GUTTER (TYPE 2) REQ'D.
 - ⑦ 3.5" MILLING REQ'D.
 - ⑧ 1.5" MILLING REQ'D.
 - ⑨ GEOTEXTILE FABRIC (UNDERSEAL) (TYPE ---)
- INDICATES AREA TO BE TREATED IN ACCORDANCE WITH THE VEGETATION SCHEDULE. SEE WK. SH. NO. VS-1

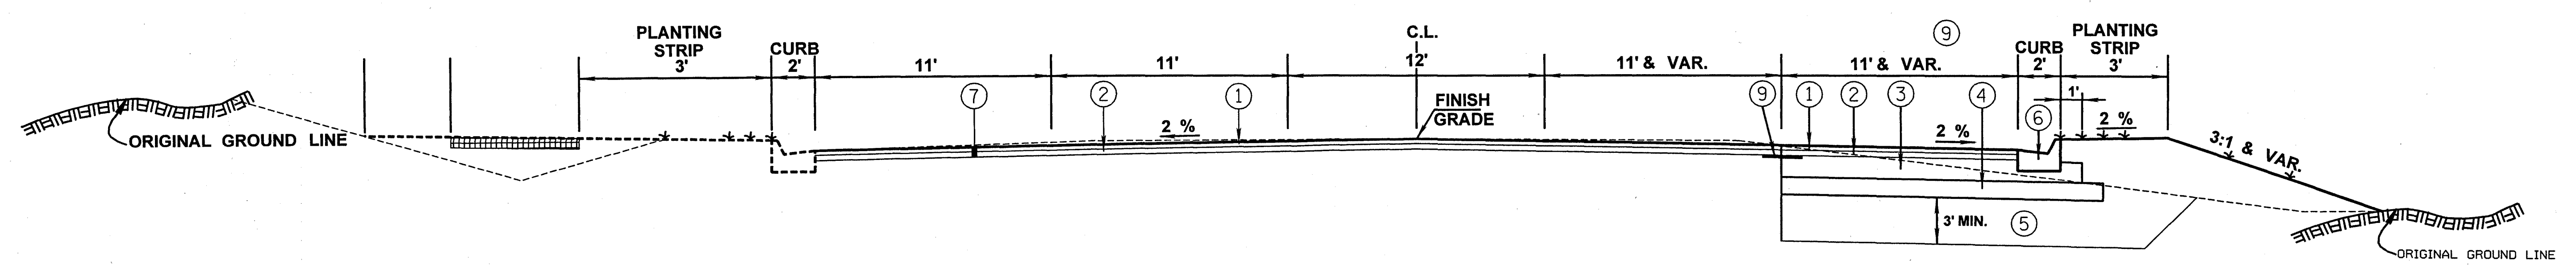

**TYPICAL SECTION OLD CANTON ROAD
STA. 21+10 - 28+10**


BY		PROPOSED TYPICAL SECTION	
REVISION		OLD CANTON ROAD RECONSTRUCTION PROJECT NO.: STP-6926-00(001)	
DATE		CITY OF RIDGELAND, MISSISSIPPI	
DRAWN BY: I.T.		DATE	WORKING NUMBER
REVIEWED BY: S.W.		SCALE: N.T.S.	TS-1
			SHEET NUMBER

7
12
ANGLE OF REPOSE
PERMITTED

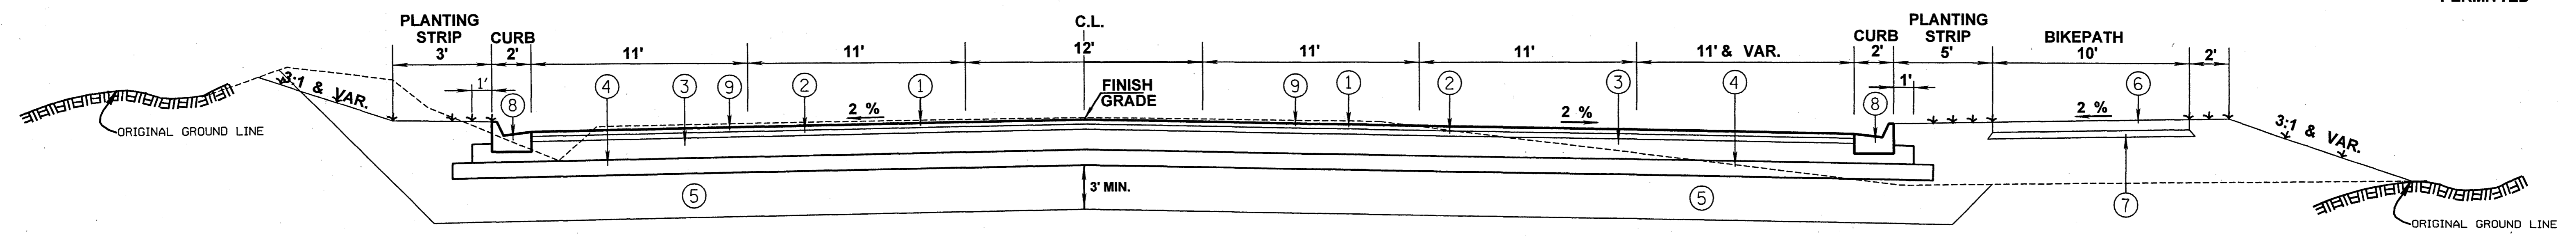

**TYPICAL SECTION OLD CANTON ROAD
STA. 47+50 - 57+25**


- ① 1.5" HOT MIX ASPHALT,HT (9.5 mm MIXTURE), POLYMER MODIFIED
 - ② 2" HOT MIX ASPHALT,HT (12.5 mm MIXTURE), POLYMER MODIFIED
 - ③ 7.5" HOT MIX ASPHALT,HT (19 mm MIXTURE), POLYMER MODIFIED
 - ④ 6" LIME TREATED SUBGRADE
 - ⑤ 3' MIN. UNDERCUT REQ'D. BORROW EXCAVATION, CLASS B-15-MODIFIED
 - ⑥ 2" HOT MIX ASPHALT,HT (9.5 mm MIXTURE), POLYMER MODIFIED (BIKE PATH)
 - ⑦ 4" & VARIABLE DEPTH GRANULAR MATERIAL (CLASS 5, GROUP "C") REQ'D. (BIKE PATH)
 - ⑧ COMBINATION CONCRETE CURB AND GUTTER (TYPE 2) REQ'D.
 - ⑨ EXISTING ASPHALT PAVEMENT TO BE REMOVED VARIABLE DEPTH
- INDICATES AREA TO BE TREATED IN ACCORDANCE WITH THE VEGETATION SCHEDULE. SEE WK. SH. NO. VS-1

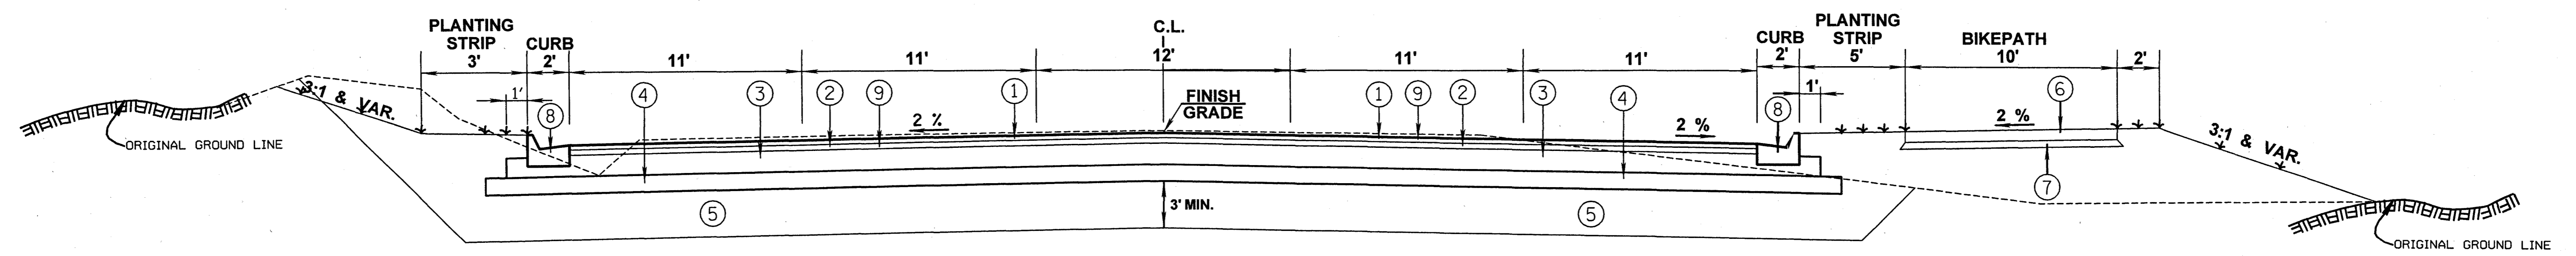

**TYPICAL SECTION OLD CANTON ROAD
STA. 57+25 - E.O.P.**

DATA FOR PAVEMENT DETERMINATION		
(2000) ADT =	18,500	Current
(2020) ADT =	33,400	Design
DHV =	4010	
D =	55	% of DHV
T =	3	% of DHV
T (total) =	3	% of DHV
18K (Rigid) =		/ 1000
18K (Flex) =	375	/ 1000
Design CBR =	5	

BY		PROPOSED TYPICAL SECTION	
REVISION		OLD CANTON ROAD RECONSTRUCTION PROJECT NO.: STP-6926-00(001)	
DATE		CITY OF RIDGELAND, MISSISSIPPI	
DRAWN BY: I.T.		DATE	WORKING NUMBER
REVIEWED BY: S.W.		SCALE: N.T.S.	TS-2
			SHEET NUMBER

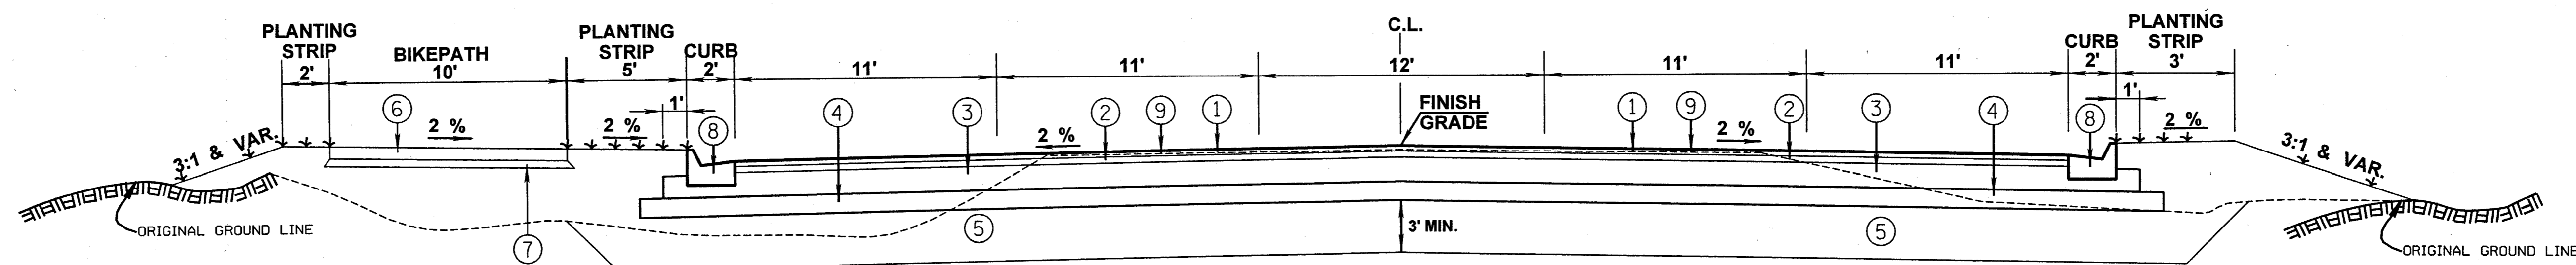

**TYPICAL SECTION OLD CANTON ROAD
STA. 28+10 - 47+50**

- ① 1.5" HOT MIX ASPHALT,HT (9.5 mm MIXTURE), POLYMER MODIFIED
 - ② 2" HOT MIX ASPHALT,HT (12.5 mm MIXTURE), POLYMER MODIFIED
 - ③ 7.5" HOT MIX ASPHALT,HT (19 mm MIXTURE), POLYMER MODIFIED
 - ④ 6" LIME TREATED SUBGRADE
 - ⑤ 3' MIN. UNDERCUT REQ'D.BORROW EXCAVATION, CLASS B-15-MODIFIED
 - ⑥ 2" HOT MIX ASPHALT,HT (9.5 mm MIXTURE), POLYMER MODIFIED (BIKE PATH)
 - ⑦ 4" & VARIABLE DEPTH GRANULAR MATERIAL (CLASS 5, GROUP "C") REQ'D. (BIKE PATH)
 - ⑧ COMBINATION CONCRETE CURB AND GUTTER (TYPE 2) REQ'D.
 - ⑨ EXISTING ASPHALT PAVEMENT TO BE REMOVED VARIABLE DEPTH
- INDICATES AREA TO BE TREATED IN ACCORDANCE WITH THE VEGETATION SCHEDULE. SEE WK. SH. NO. VS-1

DATA FOR PAVEMENT DETERMINATION		
(2000) ADT =	18,500	Current
(2020) ADT =	33,400	Design
DHV =	4010	
D =	55	% of DHV
T =	3	% of DHV
T (total) =	3	% of DHV
18K (Rigid) =		/ 1000
18K (Flex) =	375	/ 1000
Design CBR =	5	

BY		PROPOSED TYPICAL SECTION	
REVISION		OLD CANTON ROAD RECONSTRUCTION PROJECT NO.: STP-6926-00(001)	
		CITY OF RIDGELAND, MISSISSIPPI	
DATE		WAGGONER ENGINEERING, INC. Consulting Engineers - Jackson, Mississippi	WORKING NUMBER TS-3
DRAWN BY:	I.T.	DATE	
REVIEWED BY:	S.W.	SCALE	N.T.S.
SHEET NUMBER		SHEET NUMBER	

SUMMARY OF QUANTITIES

PAY ITEM NO.	PAY ITEM	UNIT	PRELIMINARY	FINAL
***** EARTHWORK ITEMS *****				
201-A	CLEARING AND GRUBBING	LUMP SUM	1	
202-A	REMOVAL OF OBSTRUCTIONS	LUMP SUM	1	
202-B	REMOVAL OF CURB (ALL TYPES)	LIN.FT.	165	
202-B	REMOVAL OF PIPE (ALL SIZES) (8" & ABOVE)	LIN.FT.	452	
202-B	REMOVAL OF ASPHALT PAVEMENT (ALL THICKNESSES)	SQ.YD.	12500	
202-B	REMOVAL OF CONCRETE PAVEMENT (ALL THICKNESSES)	SQ.YD.	645	
203-A	UNCLASSIFIED EXCAVATION (FM)	CU.YD.	7850	
203-EX	BORROW EXCAVATION (FME) (AH) (CLASS B15) (CONTRACTOR FURNISHED)	CU.YD.	65650	
203-G	EXCESS EXCAVATION (FM) (AH)	CU.YD.	44950	
206-A	STRUCTURE EXCAVATION	CU.YD.	1100	
***** ROADSIDE DEVELOPMENT ITEMS *****				
212-B	STANDARD GROUND PREPARATION	SQ.YD.	24500	
213-B	COMBINATION FERTILIZER (13-13-13)	TON	2	
214-A	SEEDING (BERMUDAGRASS)	ACRE	3.5	
214-A	SEEDING (TALL FESCUE)	ACRE	3.5	
214-A	SEEDING (CRIMSON CLOVER)	ACRE	3.5	
214-A	SEEDING (BAHIAGRASS)	ACRE	3.5	
216-A	SOLID SODDING	SQ.YD.	1500	
234-A	TEMPORARY SILT FENCE	LIN.FT.	4600	
235-A	TEMPORARY EROSION CHECKS	BALE	150	
***** SUBBASES & BASE ITEMS *****				
304-C	GRANULAR MATERIAL (AEA) (CLASS 5, GROUP C)	CU.YD.	480	
907-307-D	LIME	TON	500	
907-307-E	6" SOIL LIME WATER MIXING (CLASS C) (SLURRY APPLICATION ONLY)	SQ.YD.	29000	
***** BITUMINOUS PAVING ITEMS *****				
907-403-D	HOT MIX ASPHALT, HT(9.5 mm Mix), POLYMER MODIFIED	TON	3050	
907-403-D	HOT MIX ASPHALT, HT(12.5 mm Mix), POLYMER MODIFIED	TON	3150	
907-403-D	HOT MIX ASPHALT, HT(19 mm Mix), POLYMER MODIFIED	TON	10050	
406-A	COLD MILLING OF BITUMINOUS PAVEMENT (ALL DEPTHS)	SQ.YD.	3800	
409-A	GEOTEXTILE FABRIC (UNDERSEAL) (TYPE IV)	SQ.YD.	400	
***** DRAINAGE ITEMS *****				
603-C-A	15" REINFORCED CONCRETE PIPE, CLASS III	LIN.FT.	616	
603-C-A	18" REINFORCED CONCRETE PIPE, CLASS III	LIN.FT.	2920	
603-C-A	24" REINFORCED CONCRETE PIPE, CLASS III	LIN.FT.	320	
603-C-A	30" REINFORCED CONCRETE PIPE, CLASS III	LIN.FT.	1140	
603-C-A	36" REINFORCED CONCRETE PIPE, CLASS III	LIN.FT.	40	
603-C-B	24" REINFORCED CONCRETE END SECTION	EACH	1	
603-C-B	36" REINFORCED CONCRETE END SECTION	EACH	1	
603-C-E	65" x 40" CONCRETE ARCH PIPE, CLASS AIII	LIN.FT.	20	
603-C-F	65" x 40" CONCRETE ARCH PIPE END SECTION	EACH	2	
907-604-C-PP	TYPE "A" SINGLE INLETS (PER PLANS)	EACH	24	
907-604-D-PP	TYPE "A" DOUBLE INLETS (PER PLANS)	EACH	8	
907-604-E-PP	TYPE "B" SINGLE INLETS (PER PLANS)	EACH	8	
907-604-F-PP	TYPE "B" DOUBLE INLETS (PER PLANS)	EACH	7	

SUMMARY OF QUANTITIES	
OLD CANTON ROAD RECONSTRUCTION PROJECT NO.: STP-6926-00(001)	
CITY OF RIDGELAND, MISSISSIPPI	
WAGGONER ENGINEERING, INC. Consulting Engineers - Jackson, Mississippi	WORKING NUMBER SQ-1
DATE: _____ I.T. _____ DATE: _____ REVIEWED BY: _____ SCALE: N.T.S.	SHEET NUMBER

SUMMARY OF QUANTITIES

PAY ITEM NO.	PAY ITEM	UNIT	PRELIMINARY	FINAL
***** INCIDENTAL CONSTRUCTION ITEMS *****				
609-D	COMBINATION CONCRETE CURB AND GUTTER (TYPE 2)	LIN.FT.	7350	
613-A	ADJUSTMENT OF CASTINGS, GRATINGS AND UTILITY APPURTENANCES	LUMP SUM	1	
614-B	CONCRETE DRIVEWAY (WITH REINFORCEMENT)	SQ.YD.	680	
618-A	MAINTENANCE OF TRAFFIC	LUMP SUM	1	
***** TRAFFIC CONTROL ITEMS *****				
907-619-A1	TEMPORARY TRAFFIC STRIPE (CONTINUOUS WHITE)	LIN.FT.	19663	
907-619-A2	TEMPORARY TRAFFIC STRIPE (CONTINUOUS YELLOW)	LIN.FT.	13174	
907-619-A3	TEMPORARY TRAFFIC STRIPE (SKIP WHITE)	MILE	1.5	
907-619-A4	TEMPORARY TRAFFIC STRIPE (SKIP YELLOW)	MILE	1.1	
907-619-A5	TEMPORARY TRAFFIC STRIPE (DETAIL)	LIN.FT.	700	
907-619-A6	TEMPORARY TRAFFIC STRIPE (LEGEND)	SQ.FT.	502	
907-619-A6	TEMPORARY TRAFFIC STRIPE (LEGEND)	LIN.FT.	604	
619-D1	STANDARD ROADSIDE CONSTRUCTION SIGNS (LESS THAN 10 SQ.FT.)	SQ.FT.	48	
619-D2	STANDARD ROADSIDE CONSTRUCTION SIGNS (10 SQ.FT. OR MORE)	SQ.FT.	560	
619-D3	REMOVE AND RESET SIGNS (ALL SIZES)	EACH	10	
619-F1	CONCRETE MEDIAN BARRIER (PRECAST)	LIN.FT.	2800	
619-F2	REMOVE AND RESET CONCRETE MEDIAN BARRIER (PRECAST)	LIN.FT.	2800	
619-G4	BARRICADES (TYPE III) (DOUBLE FACED)	LIN.FT.	192	
619-G5	FREE STANDING PLASTIC DRUMS	EACH	95	
620-A	MOBILIZATION	LUMP SUM	1	
***** PAVEMENT MARKING ITEMS *****				
907-626-AA OR 907-628-AA	6" THERMOPLASTIC TRAFFIC STRIPE (SKIP WHITE) (90 MIL. MIN.) OR 6" COLD PLASTIC TRAFFIC STRIPE (SKIP WHITE)	MILE	1.5	
907-626-BB OR 907-628-BB	6" THERMOPLASTIC TRAFFIC STRIPE (CONTINUOUS WHITE) (90 MIL. MIN.) OR 6" COLD PLASTIC TRAFFIC STRIPE (CONTINUOUS WHITE)	MILE	0.8	
907-626-DD OR 907-628-DD	6" THERMOPLASTIC TRAFFIC STRIPE (SKIP YELLOW) (90 MIL. MIN.) OR 6" COLD PLASTIC TRAFFIC STRIPE (SKIP YELLOW)	MILE	1.1	
907-626-EE OR 907-628-EE	6" THERMOPLASTIC TRAFFIC STRIPE (CONTINUOUS YELLOW) (90 MIL. MIN.) OR 6" COLD PLASTIC TRAFFIC STRIPE (CONTINUOUS YELLOW)	MILE	1.5	
907-626-GG OR 907-628-GG	THERMOPLASTIC DETAIL STRIPE (6" EQUIVALENT LENGTH) (WHITE) (90 MIL. MIN.) OR COLD PLASTIC DETAIL STRIPE (6" EQUIVALENT LENGTH) (WHITE)	LIN.FT.	1650	
907-626-GG OR 907-628-GG	THERMOPLASTIC DETAIL STRIPE (6" EQUIVALENT LENGTH) (YELLOW) (90 MIL. MIN.) OR COLD PLASTIC DETAIL STRIPE (6" EQUIVALENT LENGTH) (YELLOW)	LIN.FT.	650	
907-626-HH OR 907-628-HH	THERMOPLASTIC LEGEND (WHITE) (120 MIL. MIN.) OR COLD PLASTIC LEGEND (WHITE)	SQ.FT.	2150	
907-626-HH OR 907-628-HH	THERMOPLASTIC LEGEND (WHITE) (120 MIL. MIN.) OR COLD PLASTIC LEGEND (WHITE)	LIN.FT.	604	
907-627-K	RED-CLEAR REFLECTIVE HIGH PERFORMANCE RAISED MARKERS	EACH	220	
907-627-L	TWO-WAY YELLOW REFLECTIVE HIGH PERFORMANCE RAISED MARKERS	EACH	340	
***** TRAFFIC SIGNS AND DELINEATORS *****				
630-A	STANDARD ROADSIDE SIGNS (SHEET ALUMINUM, 0.080" THICKNESS)	SQ.FT.	240	
630-C	STEEL U-SECTION POSTS (3 TO 3.5 POUNDS/LIN.FT.)	LIN.FT.	810	
***** BRIDGE ITEMS *****				
815-A	LOOSE RIPRAP (SIZE 200*)	TON	150	
815-E	GEOTEXTILE FABRIC UNDER RIPRAP (TYPE V) (EOS 70-100)	SQ.YD.	40	
***** TRAFFIC SIGNAL ITEMS *****				
908-635-A	VEHICLE LOOP ASSEMBLIES	LIN.FT.	460	
908-636-A	SHIELDED CABLE	LIN.FT.	560	


REVISION	BY	
SUMMARY OF QUANTITIES		
OLD CANTON ROAD RECONSTRUCTION PROJECT NO.: STP-6926-00(001)		
CITY OF RIDGELAND, MISSISSIPPI		
WAGGONER ENGINEERING, INC. Consulting Engineers - Jackson, Mississippi		WORKING NUMBER SQ-2
DATE	DRAWN BY: I.T.	DATE
	REVIEWED BY:	SCALE: N.T.S.
		SHEET NUMBER

BENJAMIN NEWTON WALKER, III, et al

B.M. ELEV. 350.11
CHIS. SQ. LIGHT PED
87' LT. STA. 28+58

MATCHLINE STA. 26+00 (SEE WK SH 4)

MATCHLINE STA. 32+00 (SEE WK SH 6)

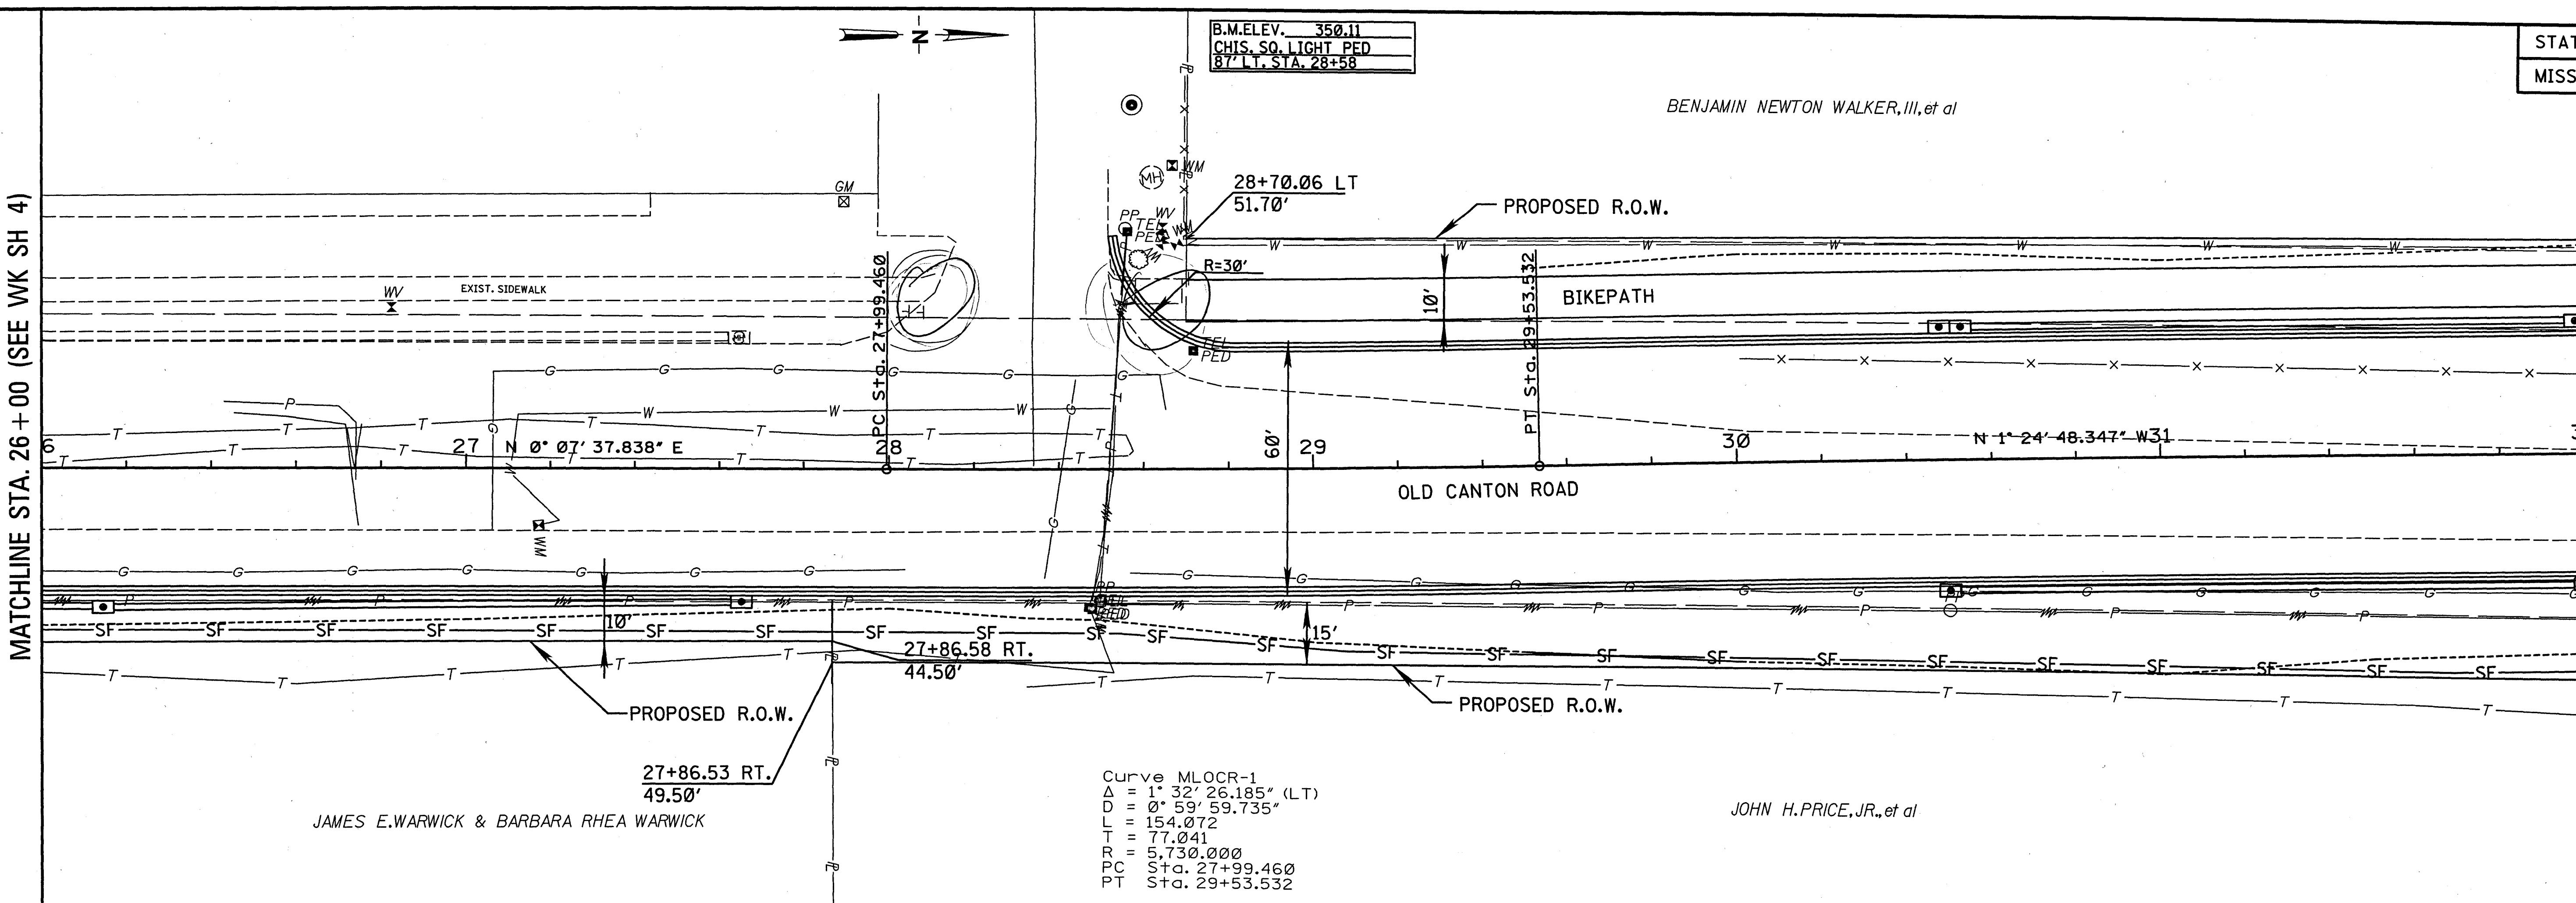

JAMES E. WARWICK & BARBARA RHEA WARWICK

JOHN H. PRICE, JR., et al

Curve MLOC-1
 $\Delta = 1^\circ 32' 26.185''$ (LT)
 $D = 0^\circ 59' 59.735''$
 $L = 154.072$
 $T = 77.041$
 $R = 5,730.000$
 PC Sta. 27+99.460
 PT Sta. 29+53.532

PLAN PROFILE DESIGN SECTION MISSISSIPPI DEPARTMENT OF TRANSPORTATION

	<p>STA. 26+15 INLET REQ'D RT TYPE A I.C. = 345.14 F.L. IN = 340.90 F.L. OUT = 340.80</p>										<p>STA. 27+65 INLET REQ'D RT TYPE A I.C. = 348.04 F.L. IN = F.L. OUT = 343.90</p>										<p>STA. 30+50 DBL INLET REQ'D LT TYPE A I.C. = 348.0 F.L. IN F.L. OUT = 343.9</p>										<p>STA. 30+50 INLET REQ'D RT TYPE A I.C. = 348.0 F.L. OUT = 344.0</p>																															
350	<p>PROPOSED GRADE -1.33%</p>																																																													
340	<p>EXISTING GRADE</p>																																																													
330	<p>Vertical Curve Data: $VPI 26+61.00$, $VPI 30+61.00$</p>																																																													
320	345.17	344.93	345.61	345.46	345.06	345.96	346.54	346.42	346.98	346.84	347.37	347.23	347.76	347.58	348.18	347.90	348.58	348.18	348.83	348.43	349.06	348.64	349.11	348.82	349.16	348.96	349.13	349.07	349.03	349.14	348.93	349.17	348.83	349.17	348.73	349.14	348.64	349.07	348.58	348.96	348.52	348.82	348.38	348.65	348.10	348.44	347.81	348.19	347.62	347.92	347.37	347.66	347.12	347.39	346.86	347.13	346.61	346.86	346.36	346.60	346.10	346.33

BENJAMIN NEWTON WALKER, III, et al

B.M. ELEV. 341.28
SCPS 1' A.C.I. WSPR.
45° RT. STA. 36+11

NOTE:
EXIST. DRIVE & EXIST. FENCE TO
BE REPLACED WHERE NECESSARY
DUE TO CONSTRUCTION AS
DIRECTED BY THE ENGINEER
(COST FOR REMOVAL AND
REPLACEMENT OF FENCE TO BE
INCLUDED IN REMOVAL OF
OBSTRUCTIONS)

2 - TYPE A INLETS REQ'D
SEE NOTE
16 LF - 18" RCP
U.S. FL = 336.20
D.S. FL = 336.00


24 LF - 18" RCP
U.S. FL = 336.20
D.S. FL = 336.00

STATE	PROJECT NO.
MISS.	STP-6926-00(001)

STA. 10+00 C GATEWAY DRIVE=
STA. 35+32 PROPOSED C OLD CANTON RD.

MATCHLINE STA. 32+00 (SEE WK SH 5)

MATCHLINE STA. 38+00 (SEE WK SH 7)

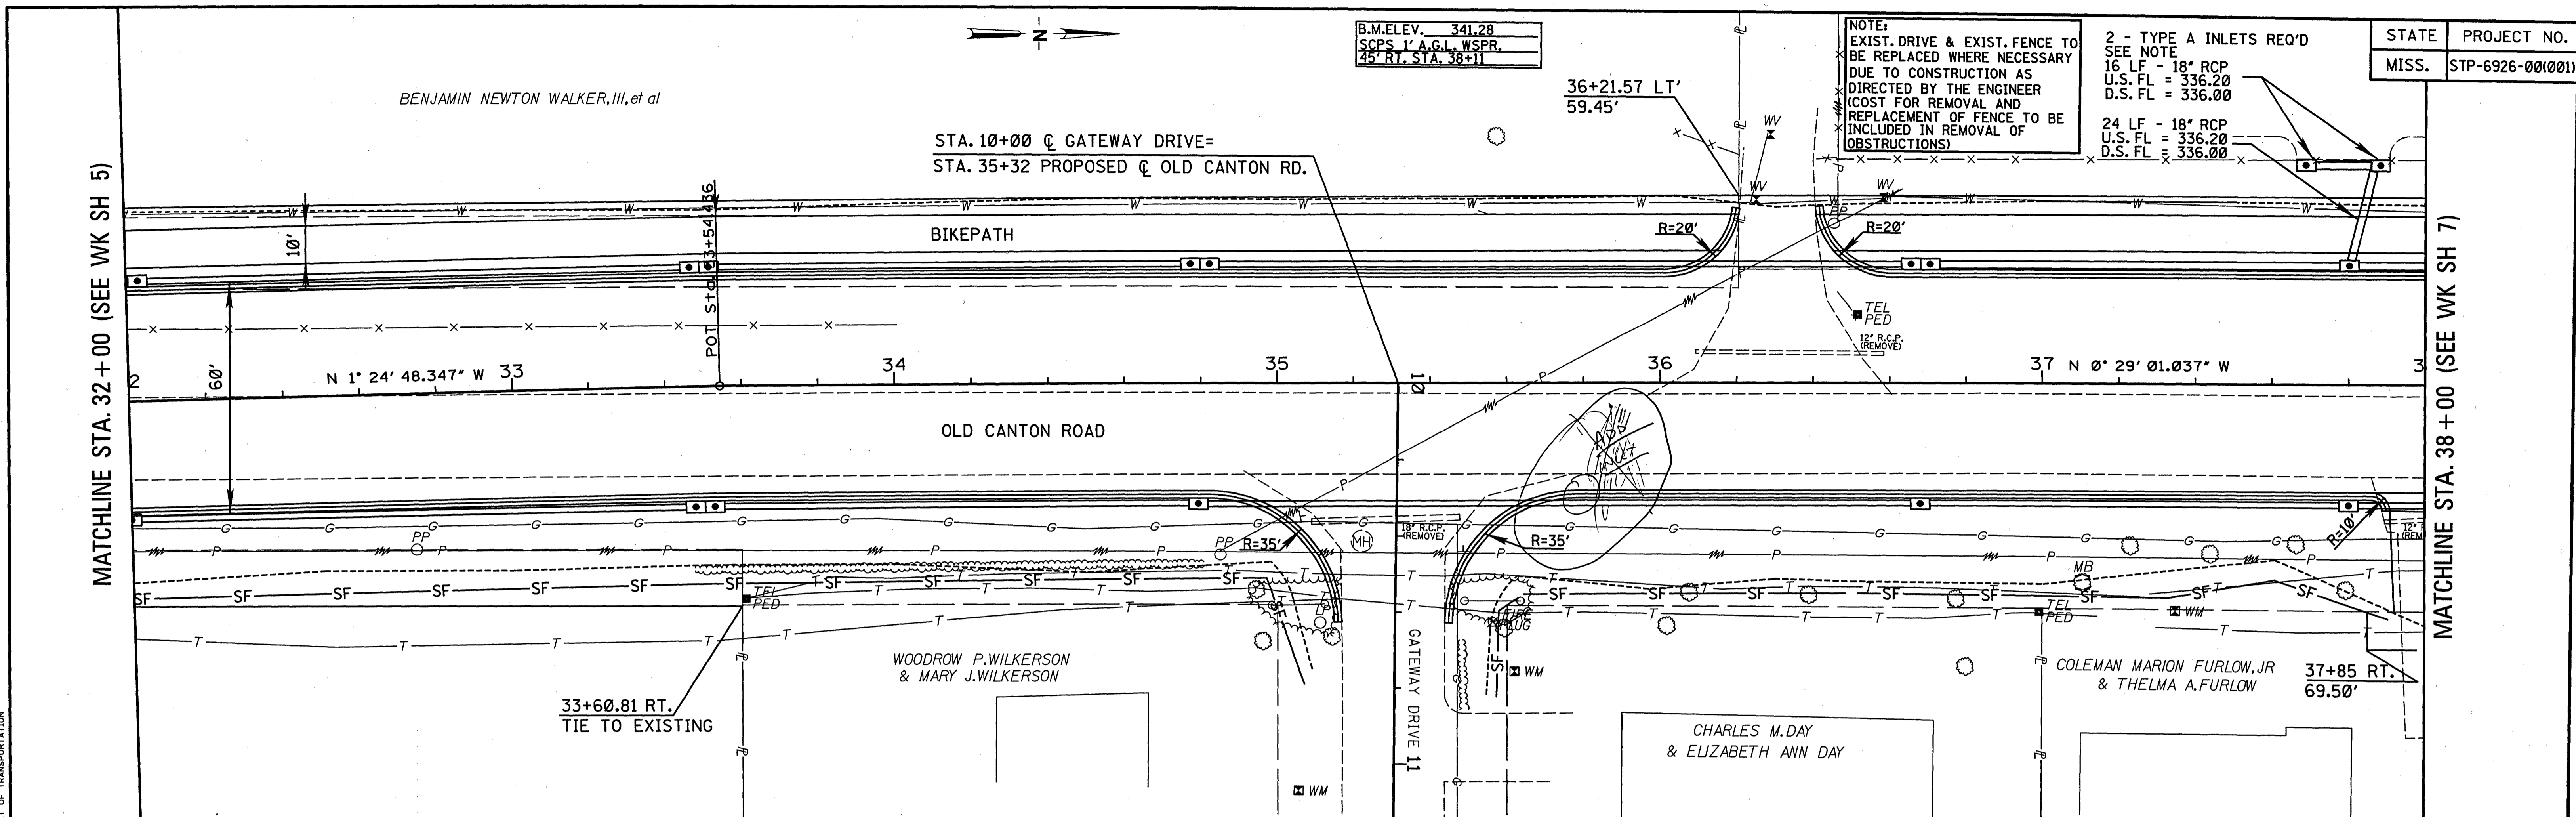

	STA. 32+00 DBL. INLET REQ'D LT TYPE A T.C. = 345.94 F.L. IN = 341.5 F.L. OUT = 341.4	STA. 33+50 DBL. INLET REQ'D LT TYPE B T.C. = 344.42 F.L. IN = 339.6 F.L. OUT = 339.5		STA. 34+80 DBL. INLET REQ'D LT TYPE B T.C. = 343.84 F.L. IN = 338.46 F.L. OUT = 337.36	STA. 36+30 DRIVEWAY REQ'D LT 16' WIDE	STA. 36+68 DBL. INLET REQ'D LT TYPE B T.C. = 343.1 F.L. IN = 336.96 F.L. OUT = 336.86	STA. 37+80 INLET REQ'D LT TYPE B T.C. = 342.64 F.L. IN = 335.74 F.L. OUT = 335.64	STA. 38+00 DRIVEWAY REQ'D RT 16' WIDE																								
	STA. 32+00 INLET REQ'D RT TYPE A T.C. = 345.94 F.L. IN = 342.20 F.L. OUT = 342.10	STA. 33+50 DBL. INLET REQ'D RT TYPE A T.C. = 344.42 F.L. IN = 340.18 F.L. OUT = 340.08		STA. 34+80 INLET REQ'D RT TYPE A T.C. = 343.84 F.L. IN = 339.04 F.L. OUT = 338.94		STA. 34+68 INLET REQ'D RT TYPE A T.C. = 343.10 F.L. IN = 338.19 F.L. OUT = 338.09	STA. 37+80 INLET REQ'D RT TYPE A T.C. = 342.64 F.L. IN = 337.64 F.L. OUT = 338.09																									
350	<p>EXISTING GRADE</p> <p>PROPOSED GRADE</p>									350																						
340	<p>150' - 15° RT. @ 1.28%</p> <p>150' - 18° LT. @ 1.2%</p> <p>150' - 15° RT. @ 0.8%</p> <p>150' - 24° LT. @ 0.8%</p> <p>188' - 15° RT. @ 0.4%</p> <p>188' - 30° LT. @ 0.8%</p> <p>112' - 18° RT. @ 0.4%</p> <p>112' - 30° LT. @ 1.0%</p>									340																						
330										330																						
320										320																						
310	346.10 346.33	345.88 346.07	345.66 345.83	345.44 345.62	345.22 345.41	345.00 345.23	344.76 345.07	344.50 344.92	344.26 344.80	344.08 344.69	343.89 344.60	343.42 344.52	343.27 344.44	343.19 344.36	343.10 344.28	343.01 344.20	342.92 344.12	342.83 344.04	342.75 343.96	342.66 343.88	342.44 343.80	342.39 343.72	342.25 343.64	342.13 343.56	342.00 343.48	341.93 343.40	341.94 343.32	341.94 343.24	341.95 343.16	341.94 343.08	341.67 343.00	310

Curve MLOC2-2
 $\Delta = 22^\circ 17.396''$ (RT)
 $D = 69^\circ 59.735''$
 $L = 237.167'$
 $T = 118.601'$
 $R = 5,730.000'$
 $PC Sta. 40+81.028$
 $PT Sta. 43+18.195$


VAN PETROLEUM, INC.

COLONIAL REALTY, L.P.

PROPOSED R.O.W.

MATCHLINE STA. 38+00 (SEE WK SH 6)

MATCHLINE STA. 44+00 (SEE WK SH 8)

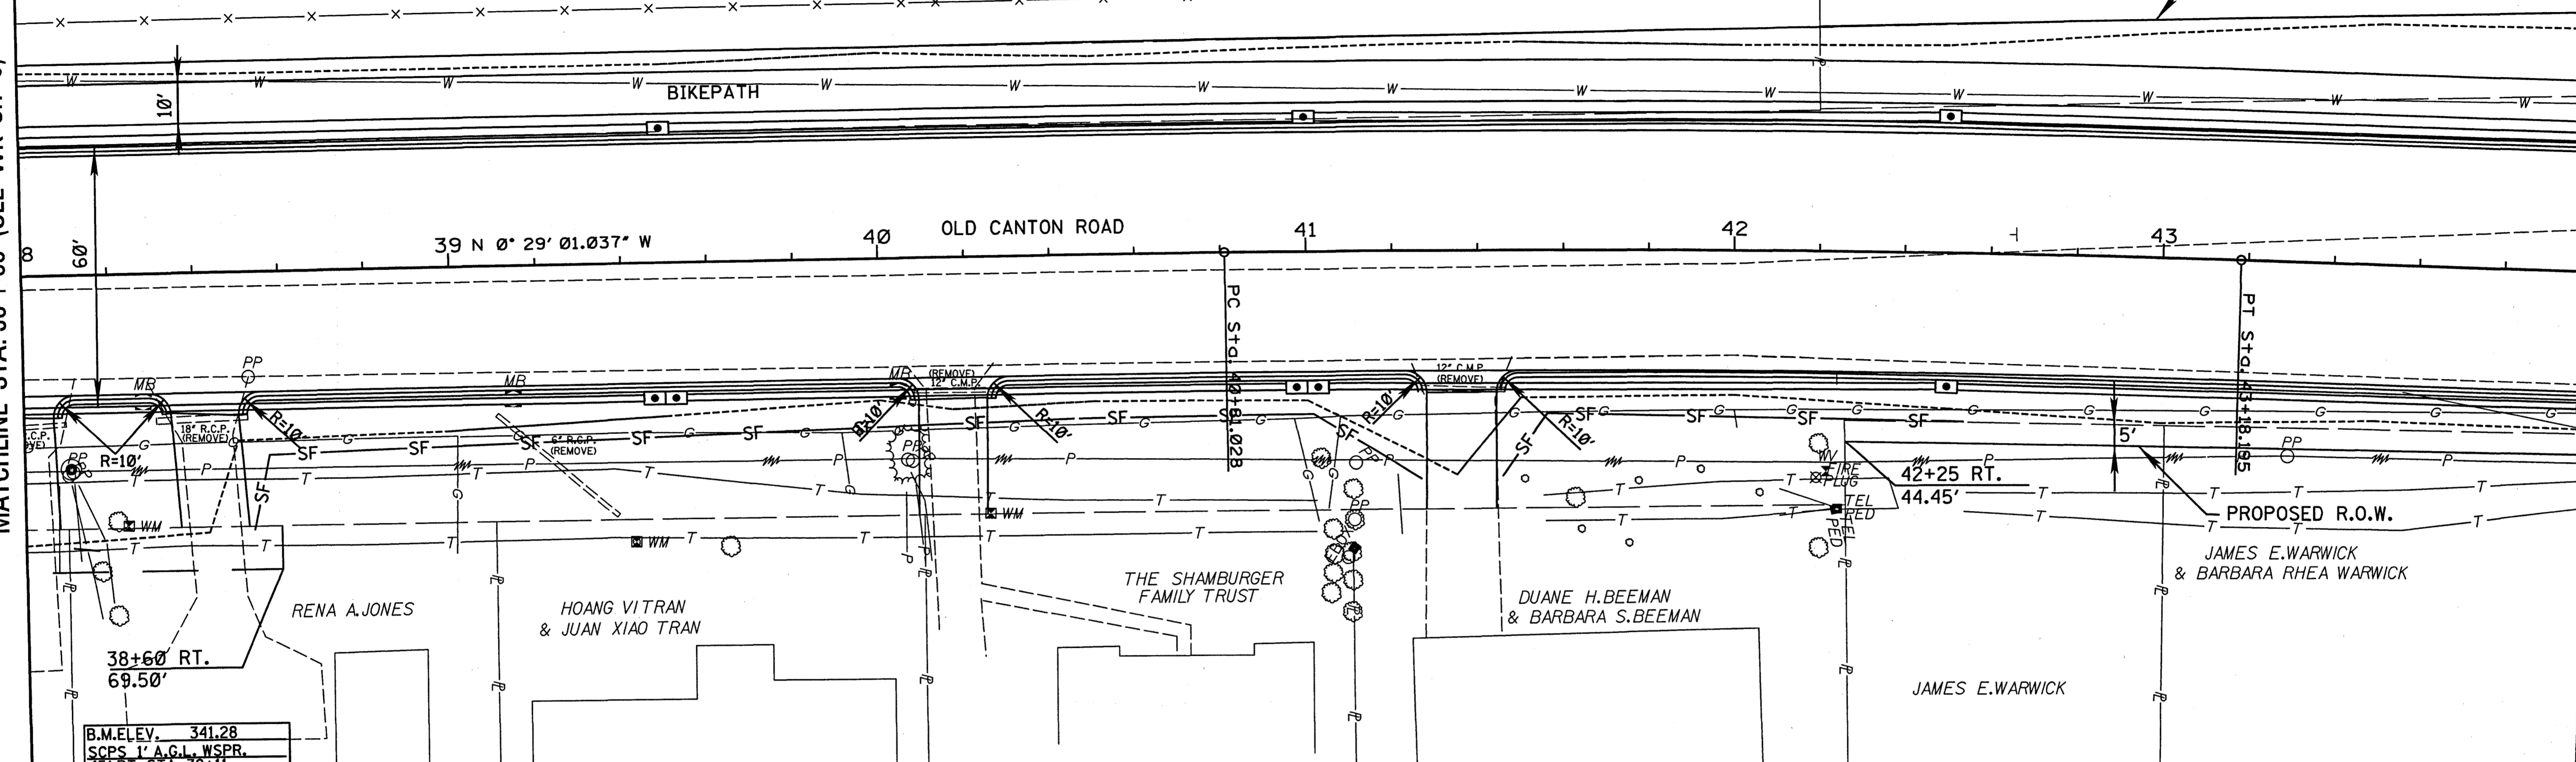

PLAN PROFILE AND SECTION
 MISSISSIPPI DEPARTMENT OF TRANSPORTATION

Station	Proposed Grade	Existing Grade	Notes
38+00	341.67	343.00	STA: 38+43 DRIVEWAY REQ'D RT 16' WIDE
38+10	341.50	342.92	
38+20	341.45	342.84	
38+30	341.39	342.76	
38+40	341.43	342.65	
38+50	341.53	342.51	STA: 39+50 INLET REQ'D LT TYPE B T.C. = 341.62 F.L. IN = 333.46 F.L. OUT = 333.36
38+60	341.63	342.34	STA: 39+50 DBL INLET REQ'D RT TYPE A T.C. = 341.62 F.L. IN = 336.18 F.L. OUT = 336.08
38+70	341.68	342.13	
38+80	341.67	341.88	
38+90	341.66	341.60	
39+00	341.39	341.29	
39+10	340.94	340.94	
39+20	340.28	340.55	
39+30	339.63	340.13	
39+40	338.58	339.68	
39+50	338.07	339.19	
39+60	337.56	338.67	
39+70	337.05	338.11	
39+80	336.55	337.52	
39+90	336.09	336.89	
40+00	335.42	336.23	
40+10	334.24	335.53	
40+20	333.51	334.80	
40+30	332.82	334.04	
40+40	331.89	333.24	
40+50	330.92	332.40	
40+60	329.96	331.53	
40+70	329.00	330.62	
40+80	328.04	329.68	
40+90	327.07	328.71	
41+00	326.07	327.70	
41+10			STA: 40+17 DRIVEWAY REQ'D RT 16' WIDE
41+20			STA: 41+00 INLET REQ'D LT TYPE B T.C. = 338.84 F.L. IN = 330.60 F.L. OUT = 330.56
41+30			STA: 41+00 DBL INLET REQ'D RT TYPE A T.C. = 338.84 F.L. IN = 333.08 F.L. OUT = 332.98
41+40			STA: 41+35 DRIVEWAY REQ'D RT 16' WIDE
41+50			STA: 42+50 INLET REQ'D LT TYPE B T.C. = 334.05 F.L. IN = 326.96 F.L. OUT = 326.86
41+60			STA: 42+50 INLET REQ'D RT TYPE A T.C. = 334.05 F.L. IN = 328.18 F.L. OUT = 328.08
41+70			
41+80			
44+00			STA: 44+00 INLET REQ'D LT TYPE B T.C. = 327.25 F.L. IN = 320.86
44+10			STA: 44+00 INLET REQ'D RT TYPE A T.C. = 327.25 F.L. IN = 320.88

Wk. Sh. 7
Sh. No.

SUMRALL OIL SERVICE, INC.

SHOW FUTURE GAS STATION


PAMELA B. EDWARDS & LARRY W. EDWARDS

STATE	PROJECT NO.
MISS.	STP-6926-00(001)

MATCHLINE STA. 44+00 (SEE WK SH 7)


MATCHLINE STA. 50+00 (SEE WK SH9)

PLAN PROFILE SECTION MISSISSIPPI DEPARTMENT OF TRANSPORTATION

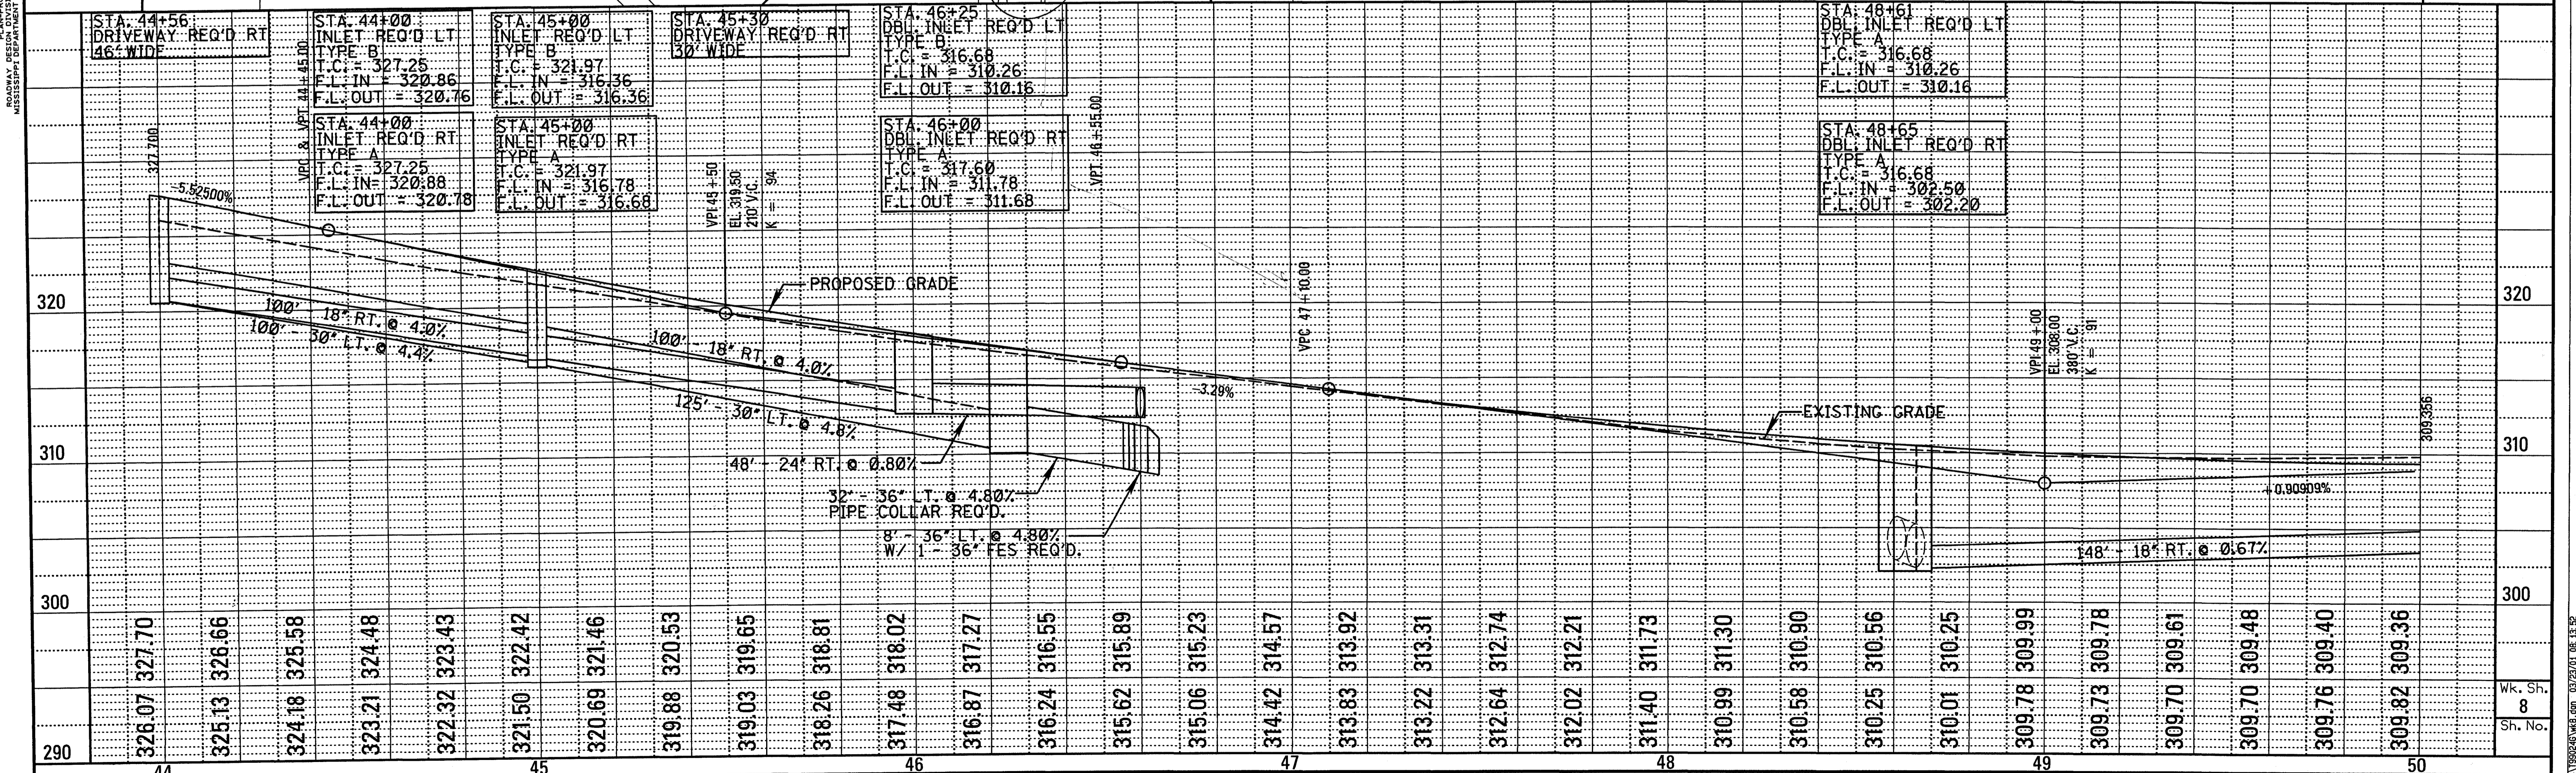

STA. 44+56 DRIVEWAY REQ'D RT 46' WIDE	STA. 44+00 INLET REQ'D LT TYPE B I.C. = 327.25 F.L. IN = 320.86 F.L. OUT = 320.76	STA. 45+00 INLET REQ'D LT TYPE B I.C. = 321.97 F.L. IN = 316.36 F.L. OUT = 316.36	STA. 45+30 DRIVEWAY REQ'D RT 50' WIDE	STA. 46+25 DBL INLET REQ'D LT TYPE B I.C. = 316.68 F.L. IN = 310.26 F.L. OUT = 310.18	STA. 46+00 DBL INLET REQ'D RT TYPE A I.C. = 317.60 F.L. IN = 311.78 F.L. OUT = 311.68	STA. 48+61 DBL INLET REQ'D LT TYPE A I.C. = 316.68 F.L. IN = 310.26 F.L. OUT = 310.16	STA. 48+65 DBL INLET REQ'D RT TYPE A I.C. = 316.68 F.L. IN = 302.50 F.L. OUT = 302.20																																																				
326.07	327.70	325.13	326.66	324.16	325.58	323.21	324.48	322.32	323.43	321.50	322.42	320.69	321.46	319.88	320.53	319.03	319.65	318.26	318.81	317.48	318.02	316.87	317.27	316.24	316.55	315.62	315.89	315.06	315.23	314.42	314.57	313.83	313.92	313.22	313.31	312.64	312.74	312.02	312.21	311.40	311.73	310.99	311.30	310.58	310.90	310.25	310.56	309.78	309.99	309.73	309.78	309.70	309.61	309.70	309.48	309.76	309.40	309.82	309.36

Wk. Sh. 8 Sh. No.

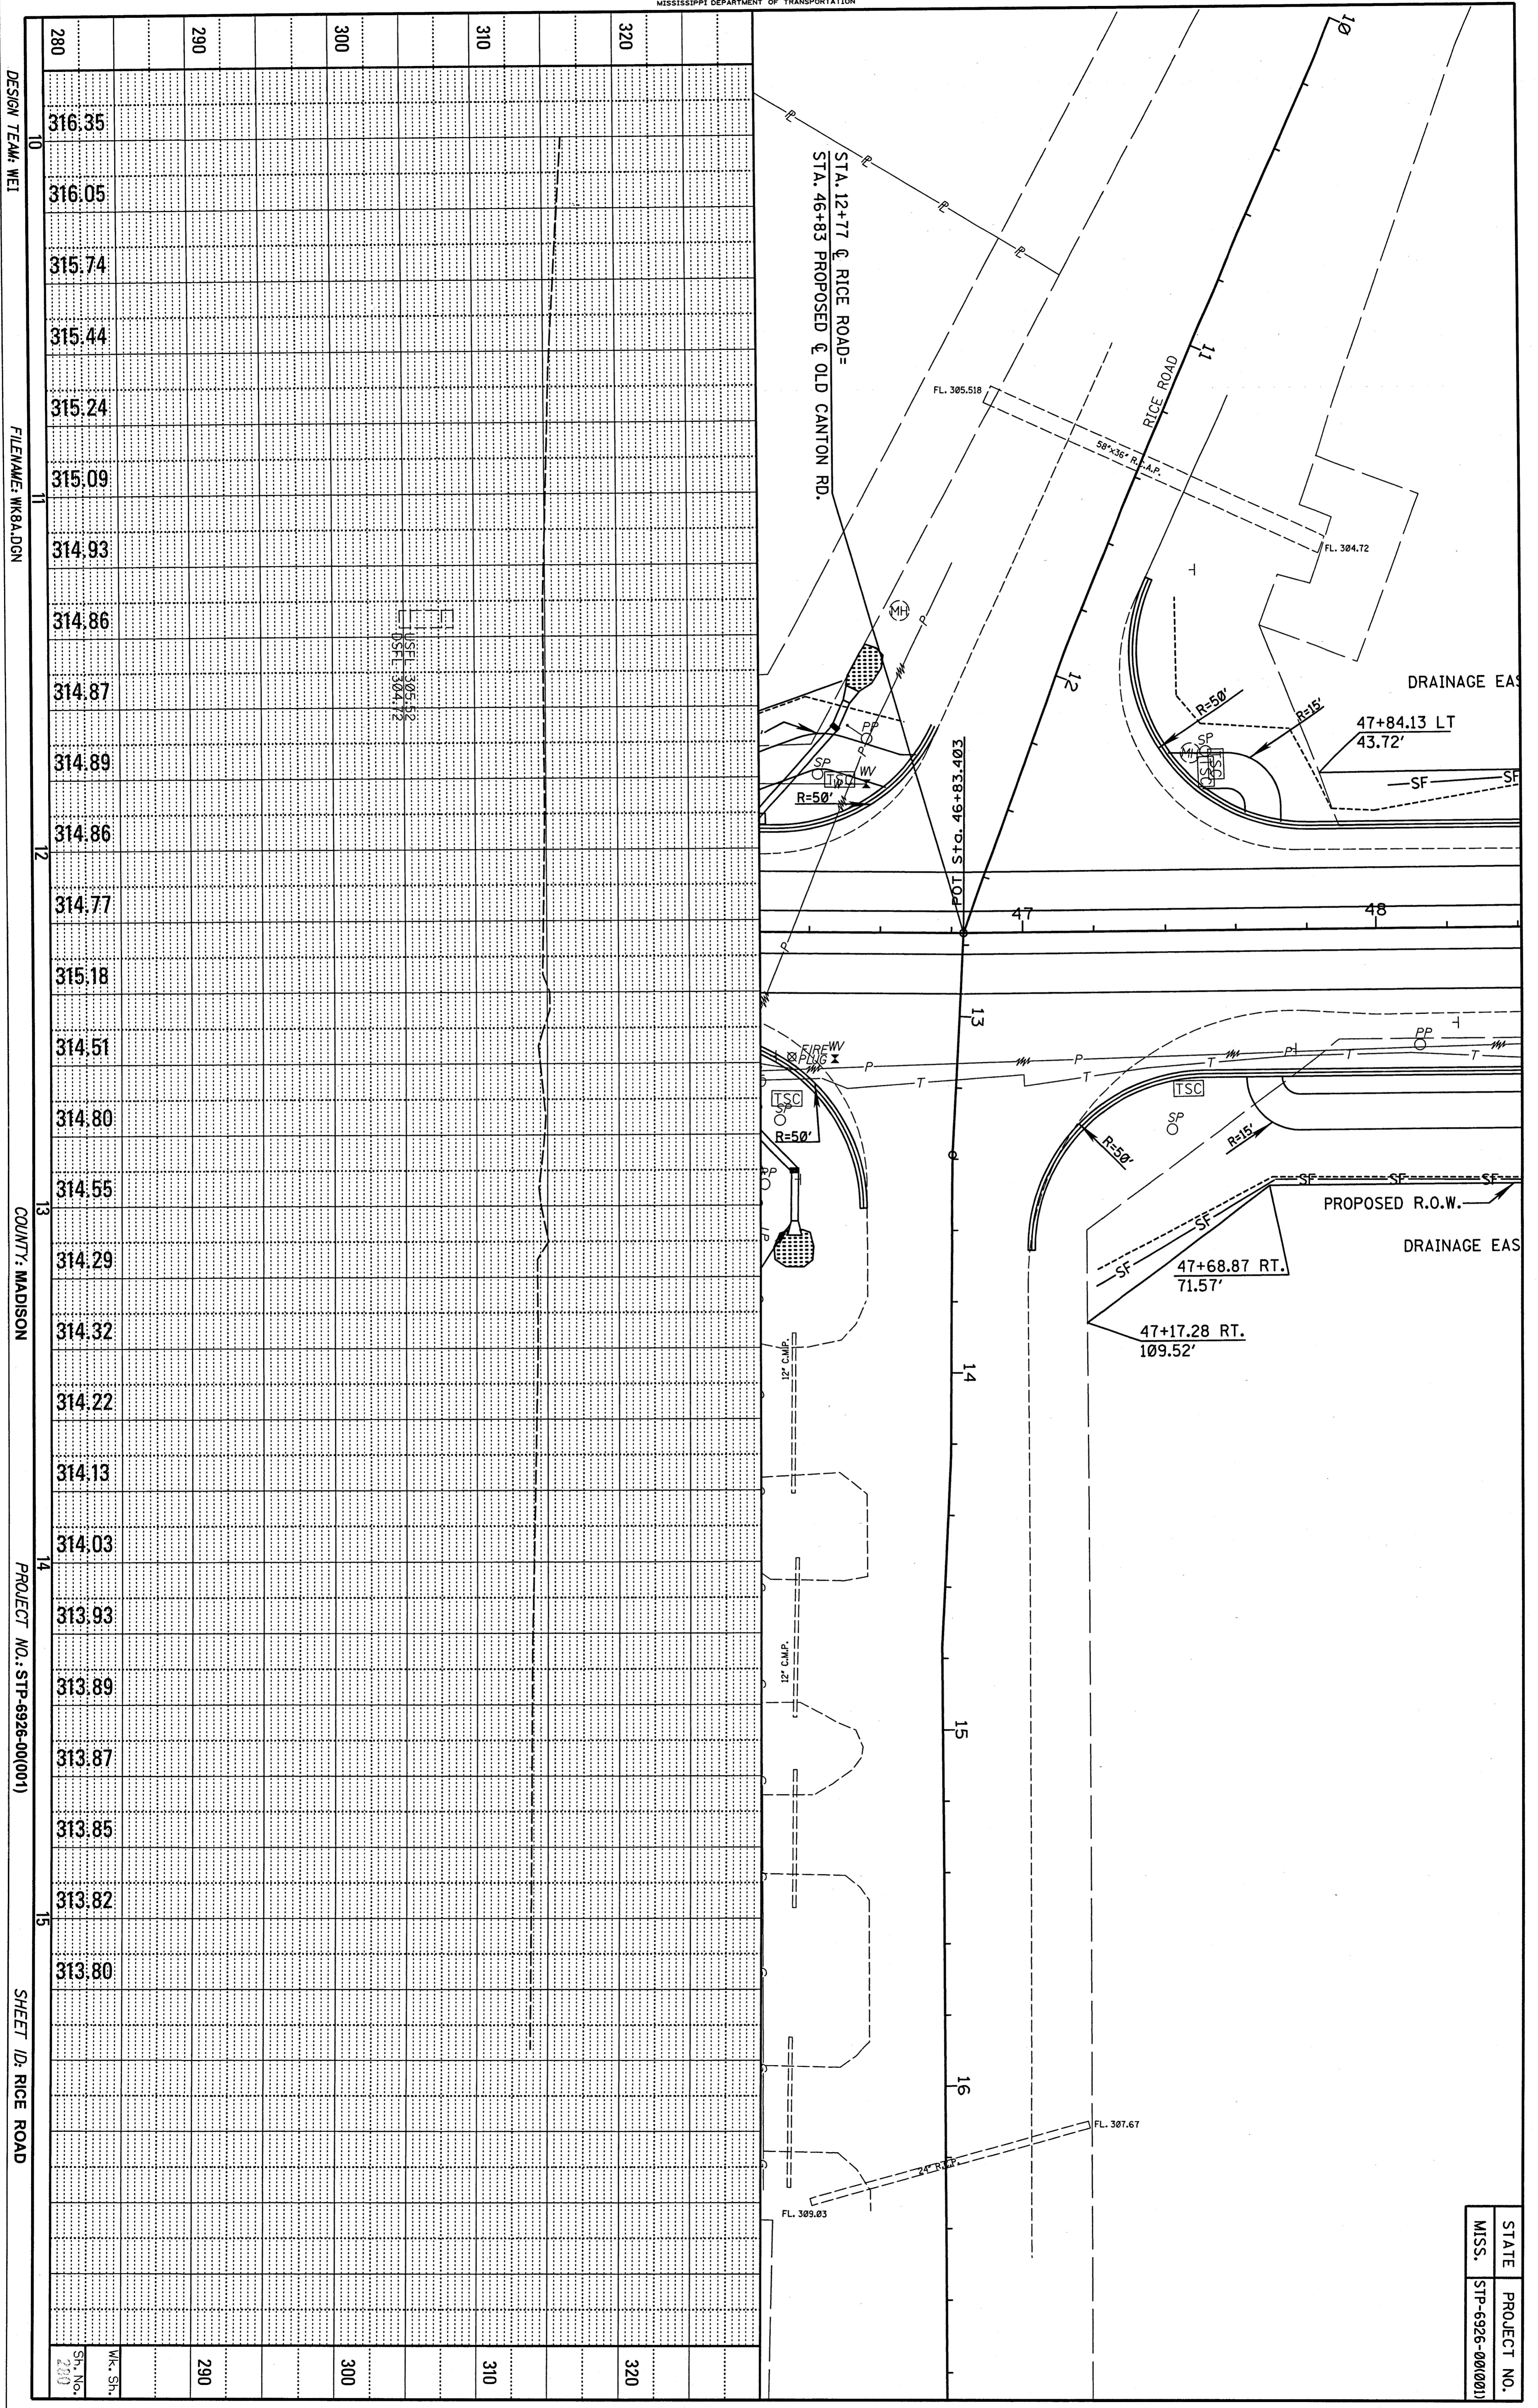

DESIGN TEAM: WEI

FILENAME: WK8A.DGN

COUNTY: MADISON

PROJECT NO.: STP-6926-00(001)

SHEET ID: RICE ROAD

STATE	PROJECT NO.
MISS.	STP-6926-00(001)

STATE	PROJECT NO.
MISS.	STP-6926-00(001)



MATCHLINE STA. 50+00 (SEE WK SH 8)

MATCHLINE STA. 56+00 (SEE WK SH 10)


PAMELA B. EDWARDS &
LARRY W. EDWARDS

LWE PROPERTIES, INC

EDWARD'S HOMES, INC.

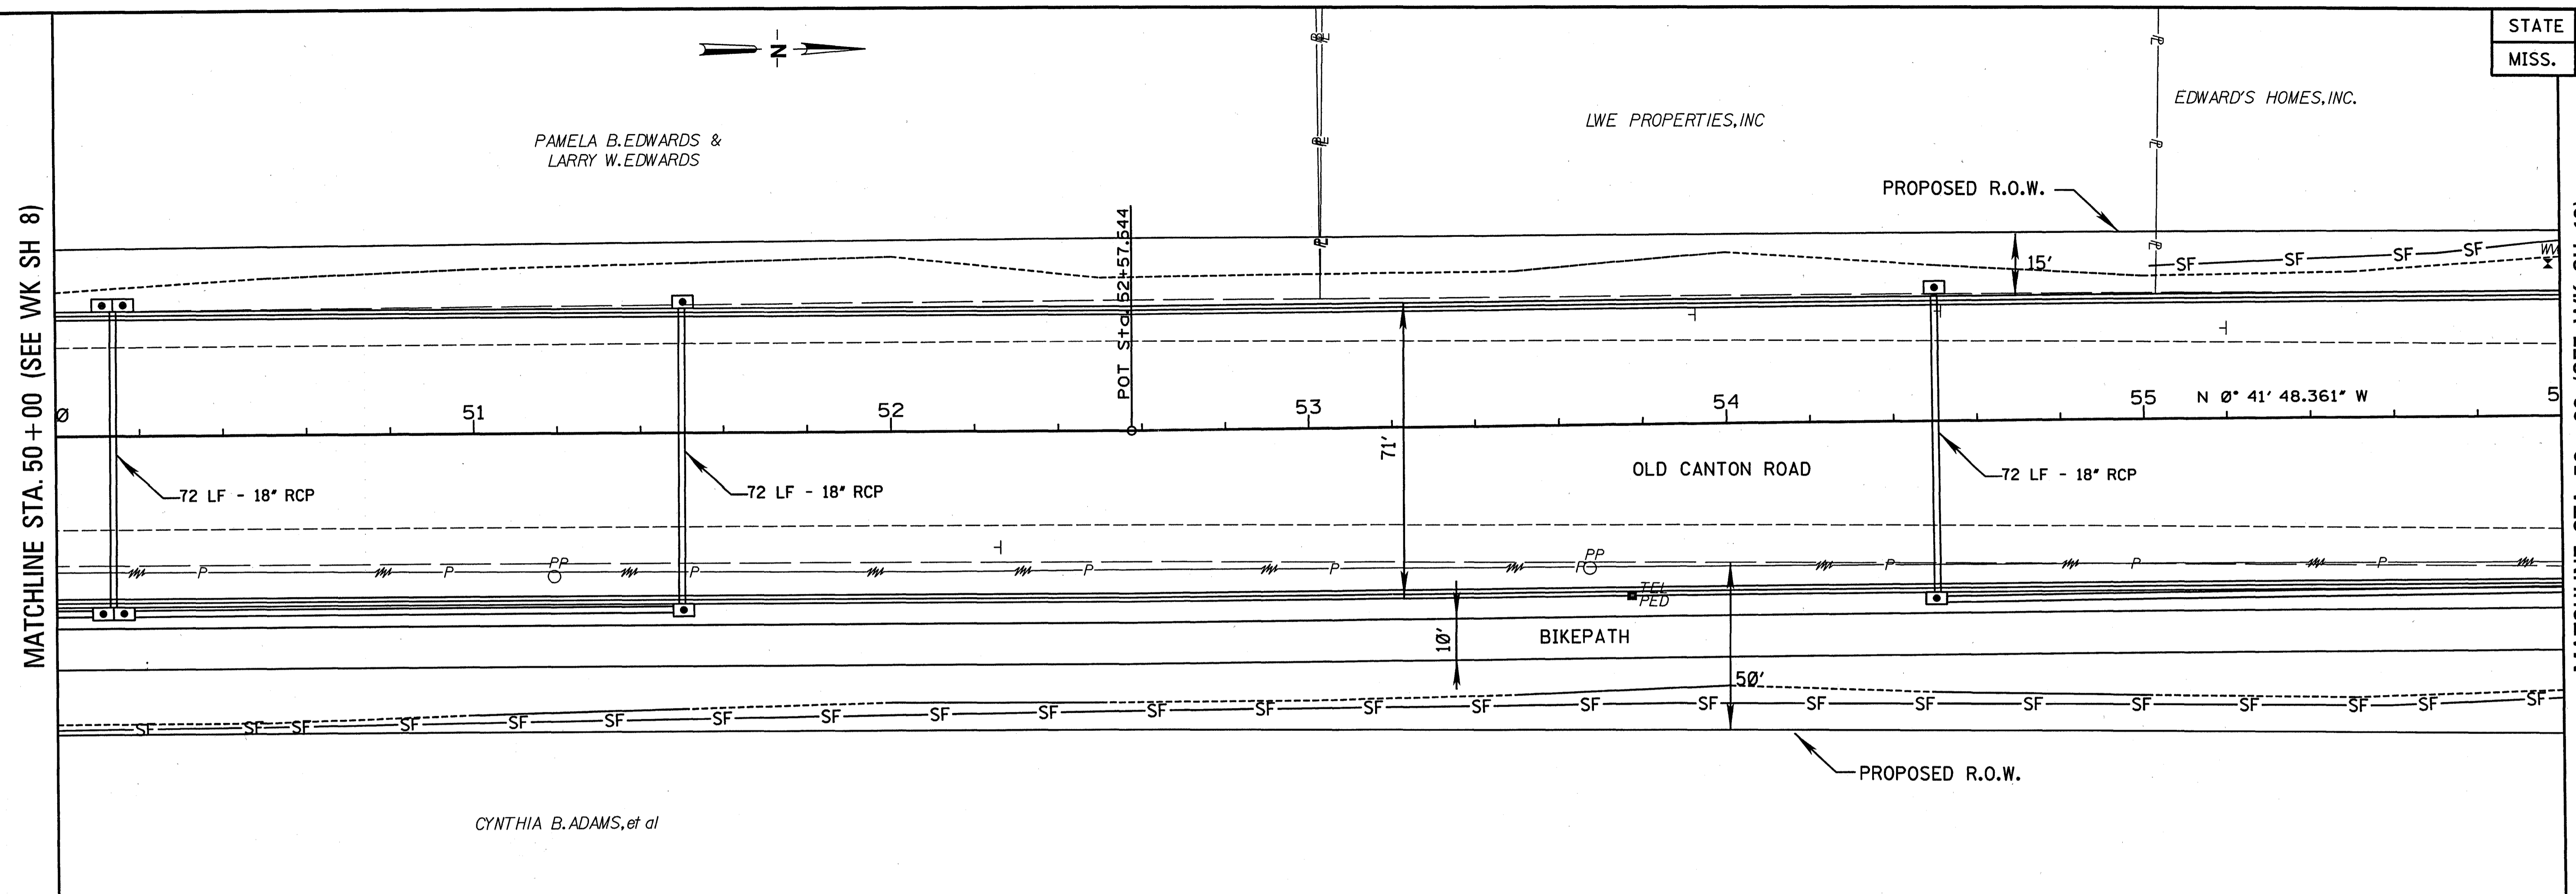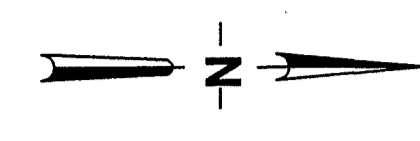


CYNTHIA B. ADAMS, et al

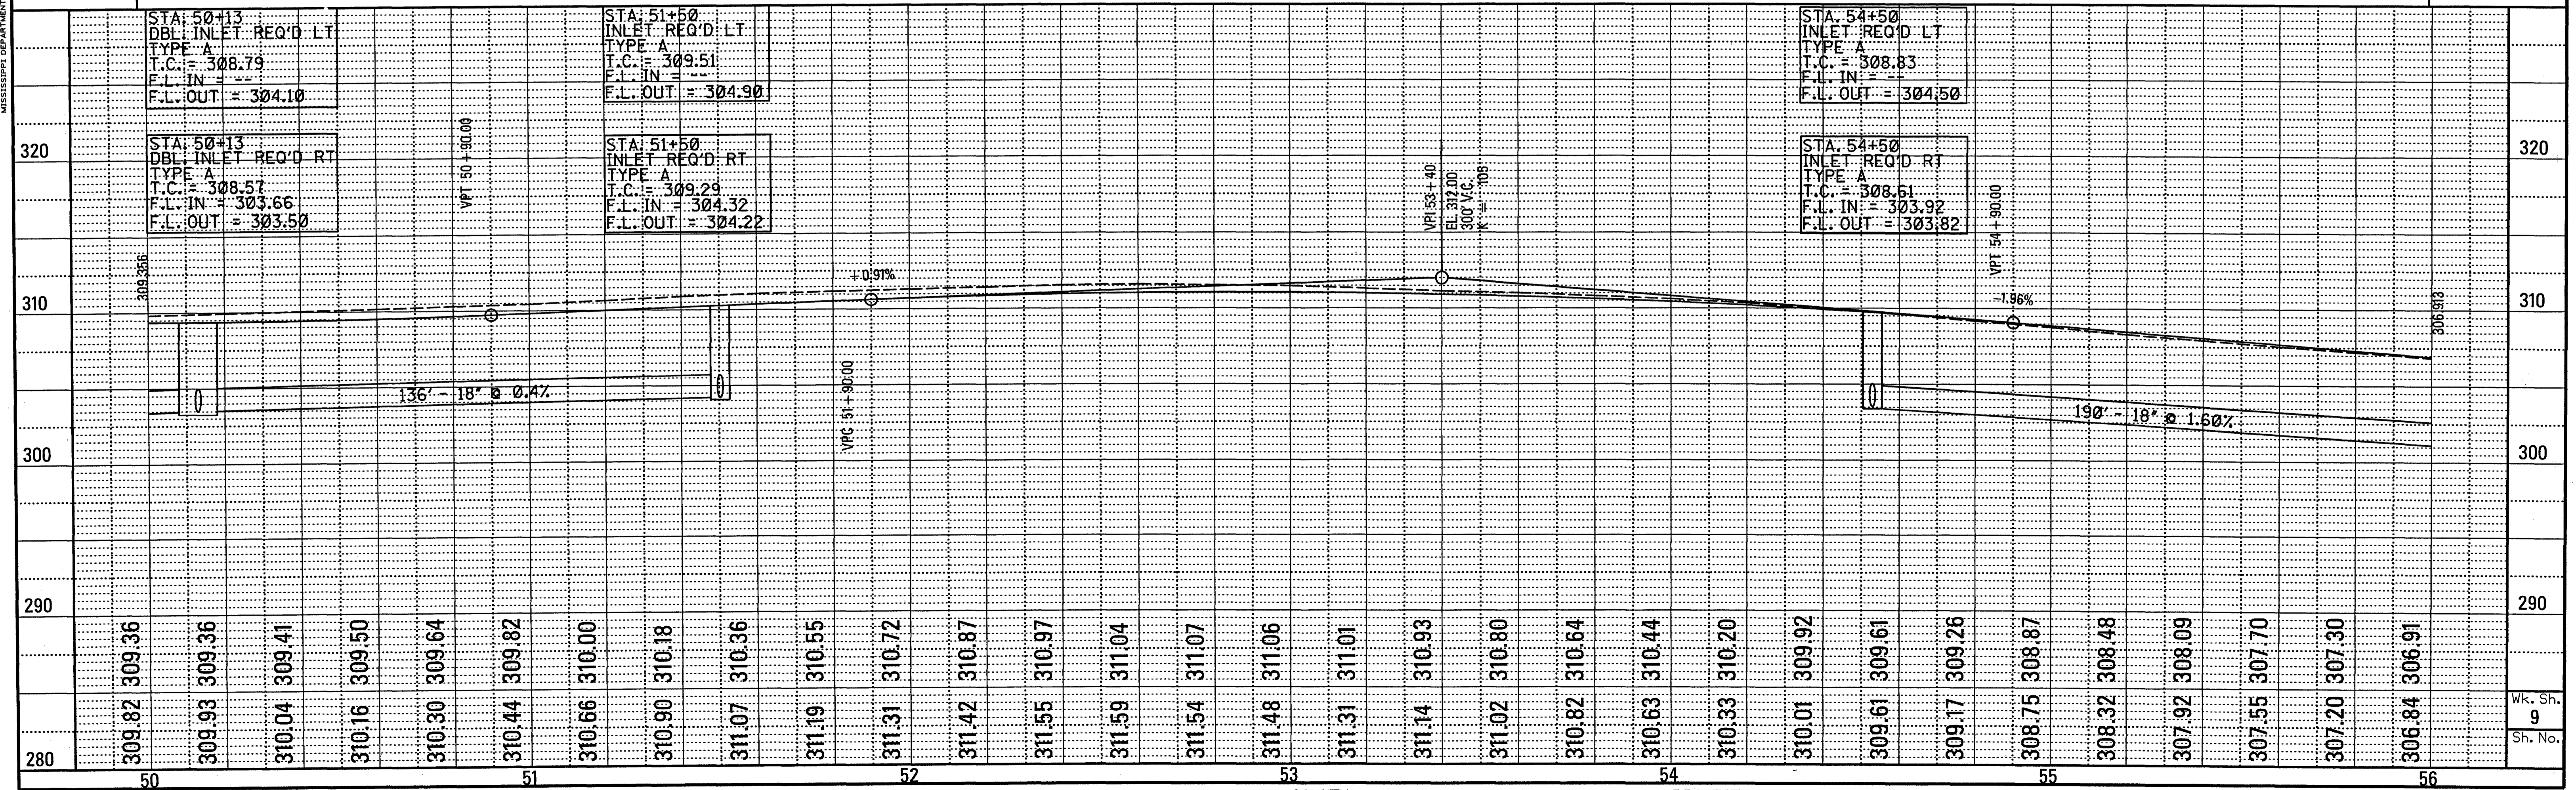

MISSISSIPPI DEPARTMENT OF TRANSPORTATION

11/19/2011 08:15:14

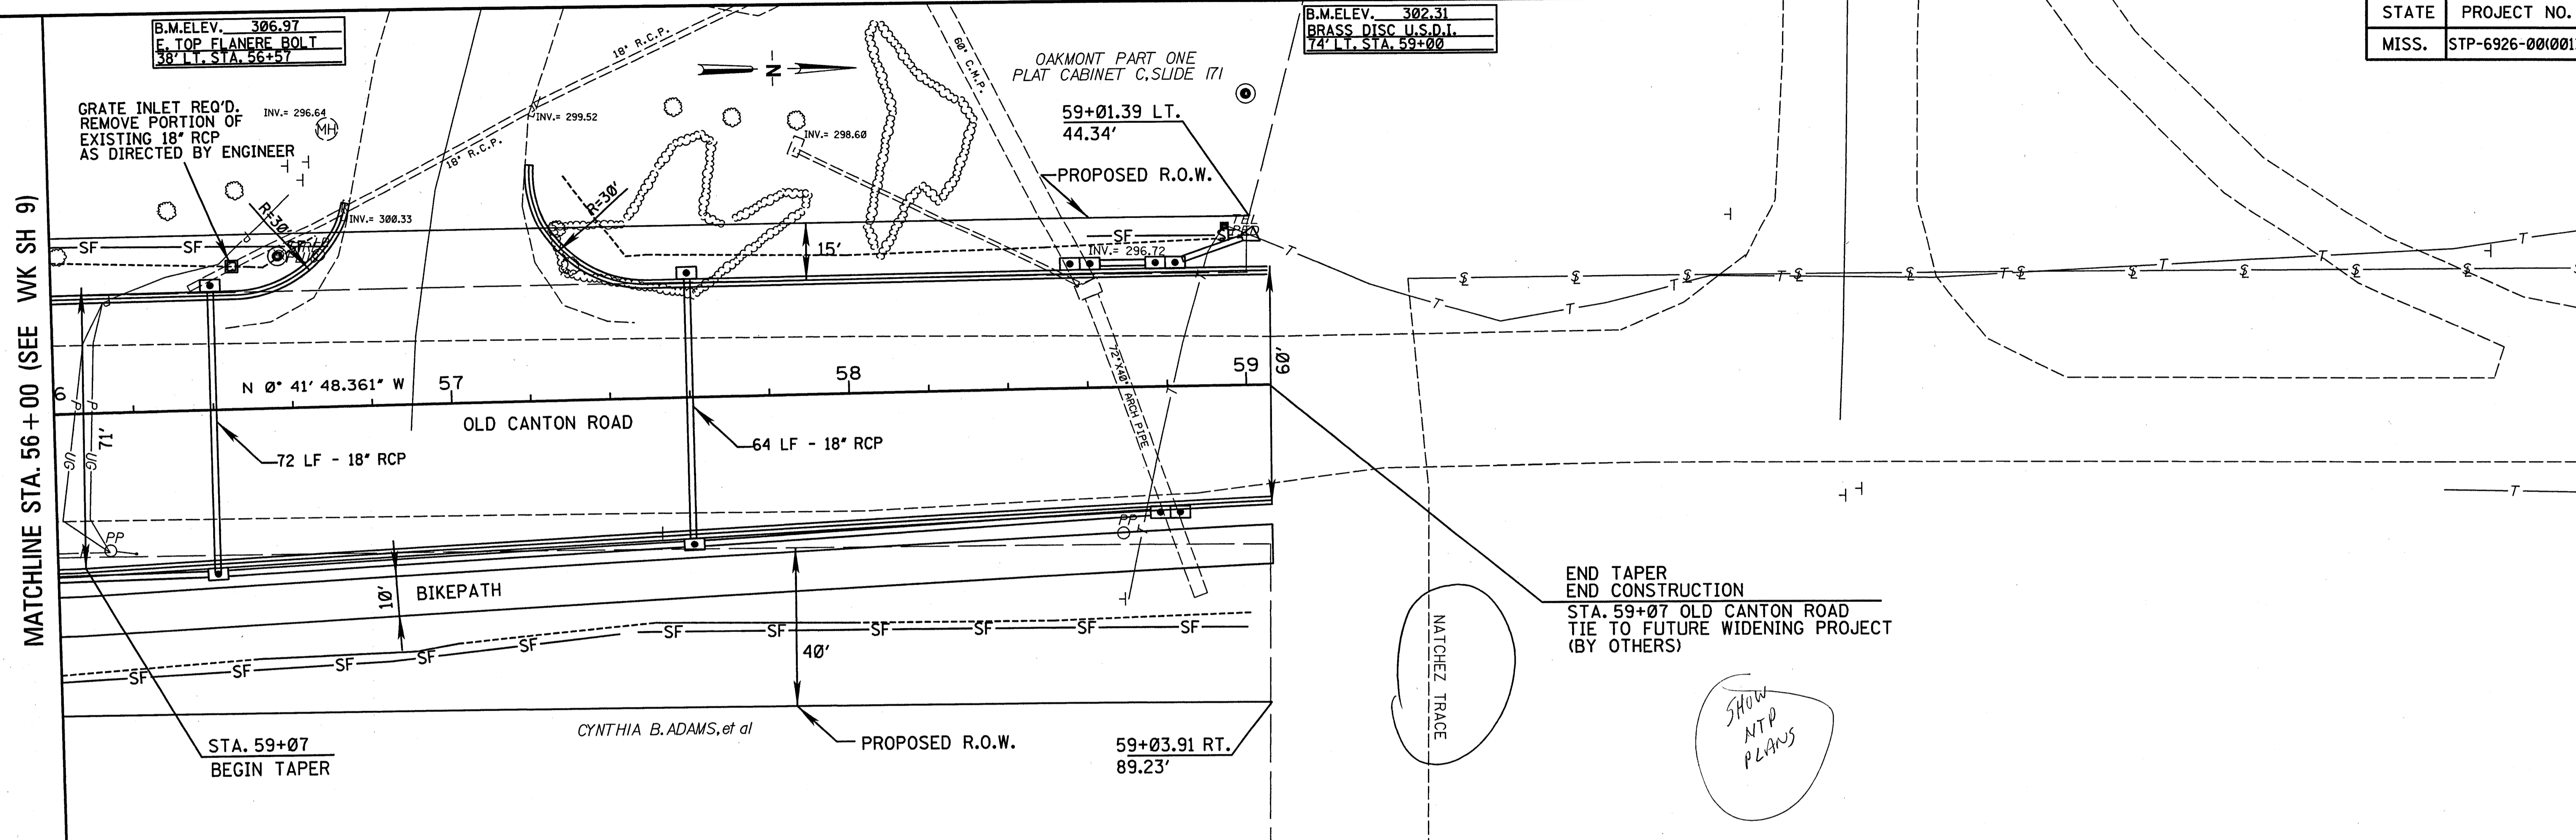

B.M.ELEV. 306.97
E. TOP FLANERE BOLT
38" LT. STA. 56+57

B.M.ELEV. 302.31
BRASS DISC U.S.D.I.
74" LT. STA. 59+00


GRATE INLET REQ'D.
REMOVE PORTION OF
EXISTING 18" RCP
AS DIRECTED BY ENGINEER

OAKMONT PART ONE
PLAT CABINET C.SLIDE 171


END TAPER
END CONSTRUCTION
STA. 59+07 OLD CANTON ROAD
TIE TO FUTURE WIDENING PROJECT
(BY OTHERS)

SHOW
NTP
PLANS

PLAN PROFILE BASE SECTION
DESIGNED BY DEPARTMENT OF TRANSPORTATION

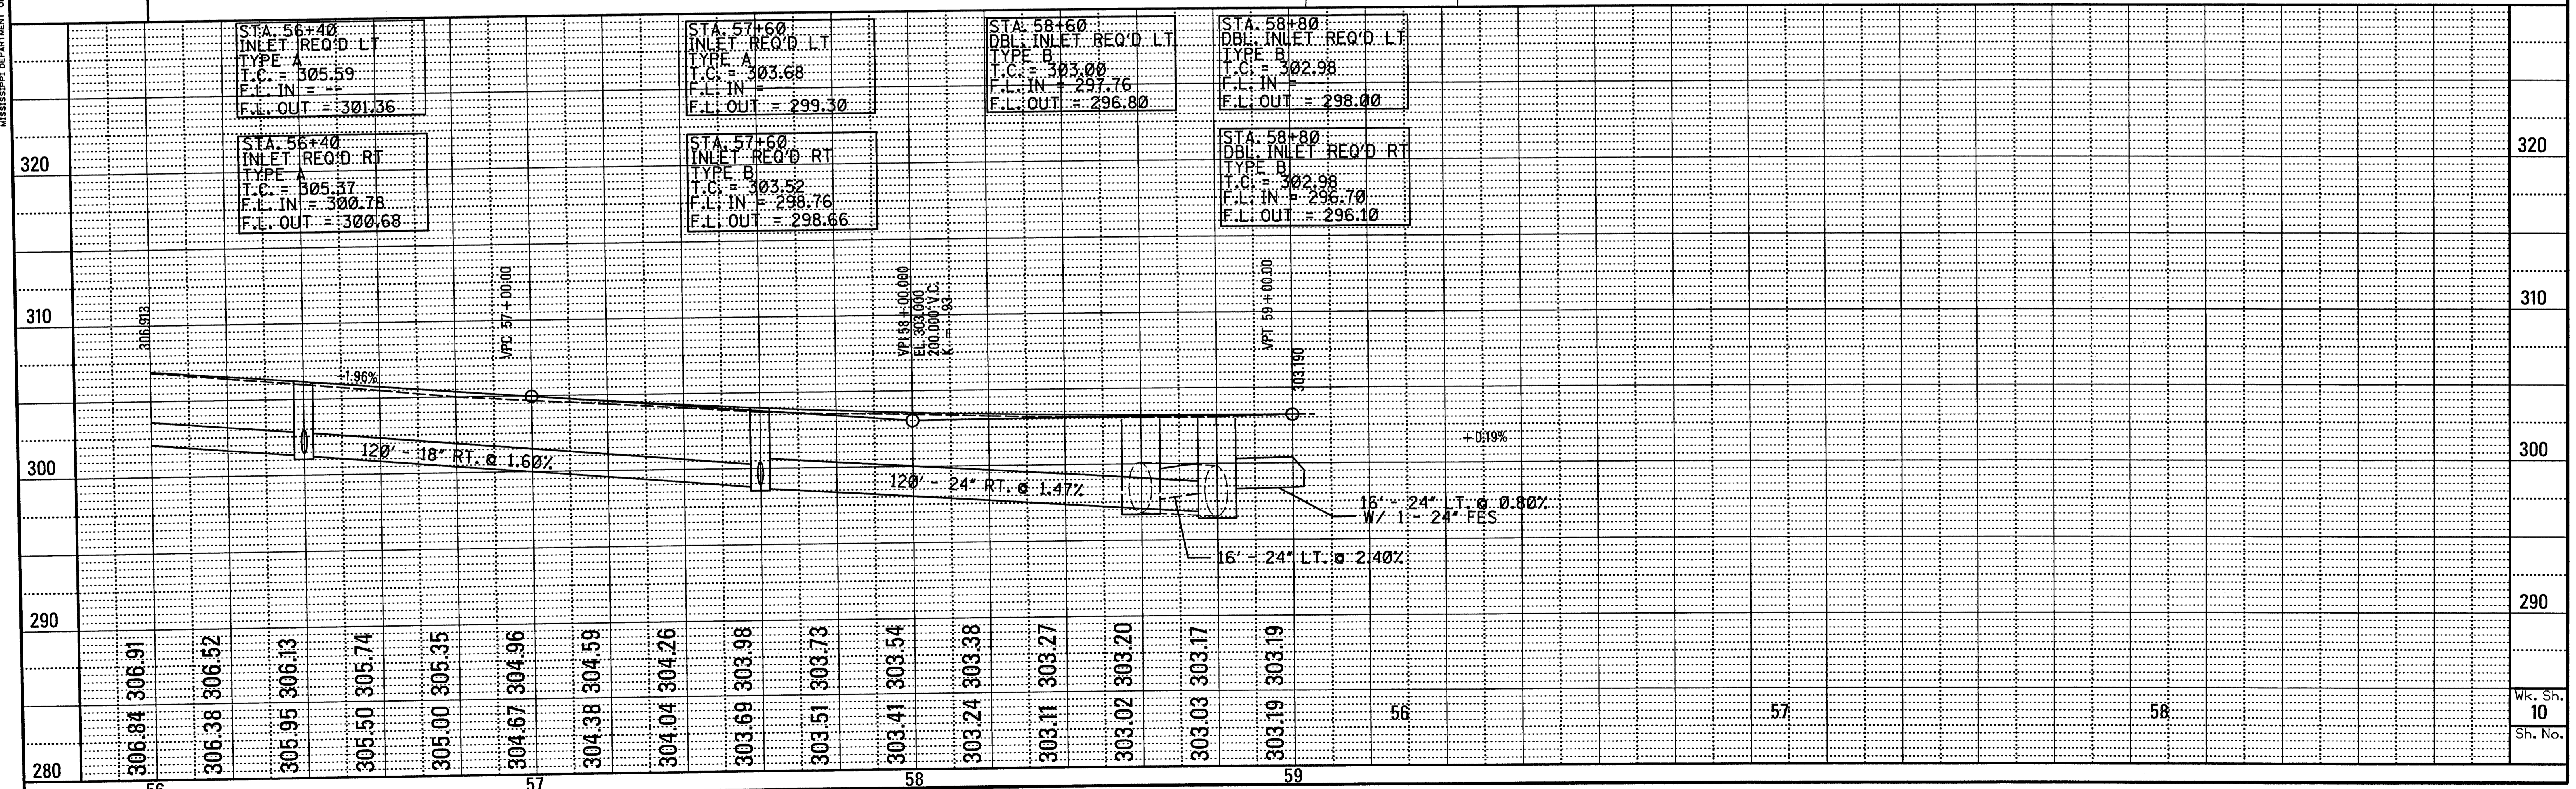


Wk. Sh. 10
Sh. No.

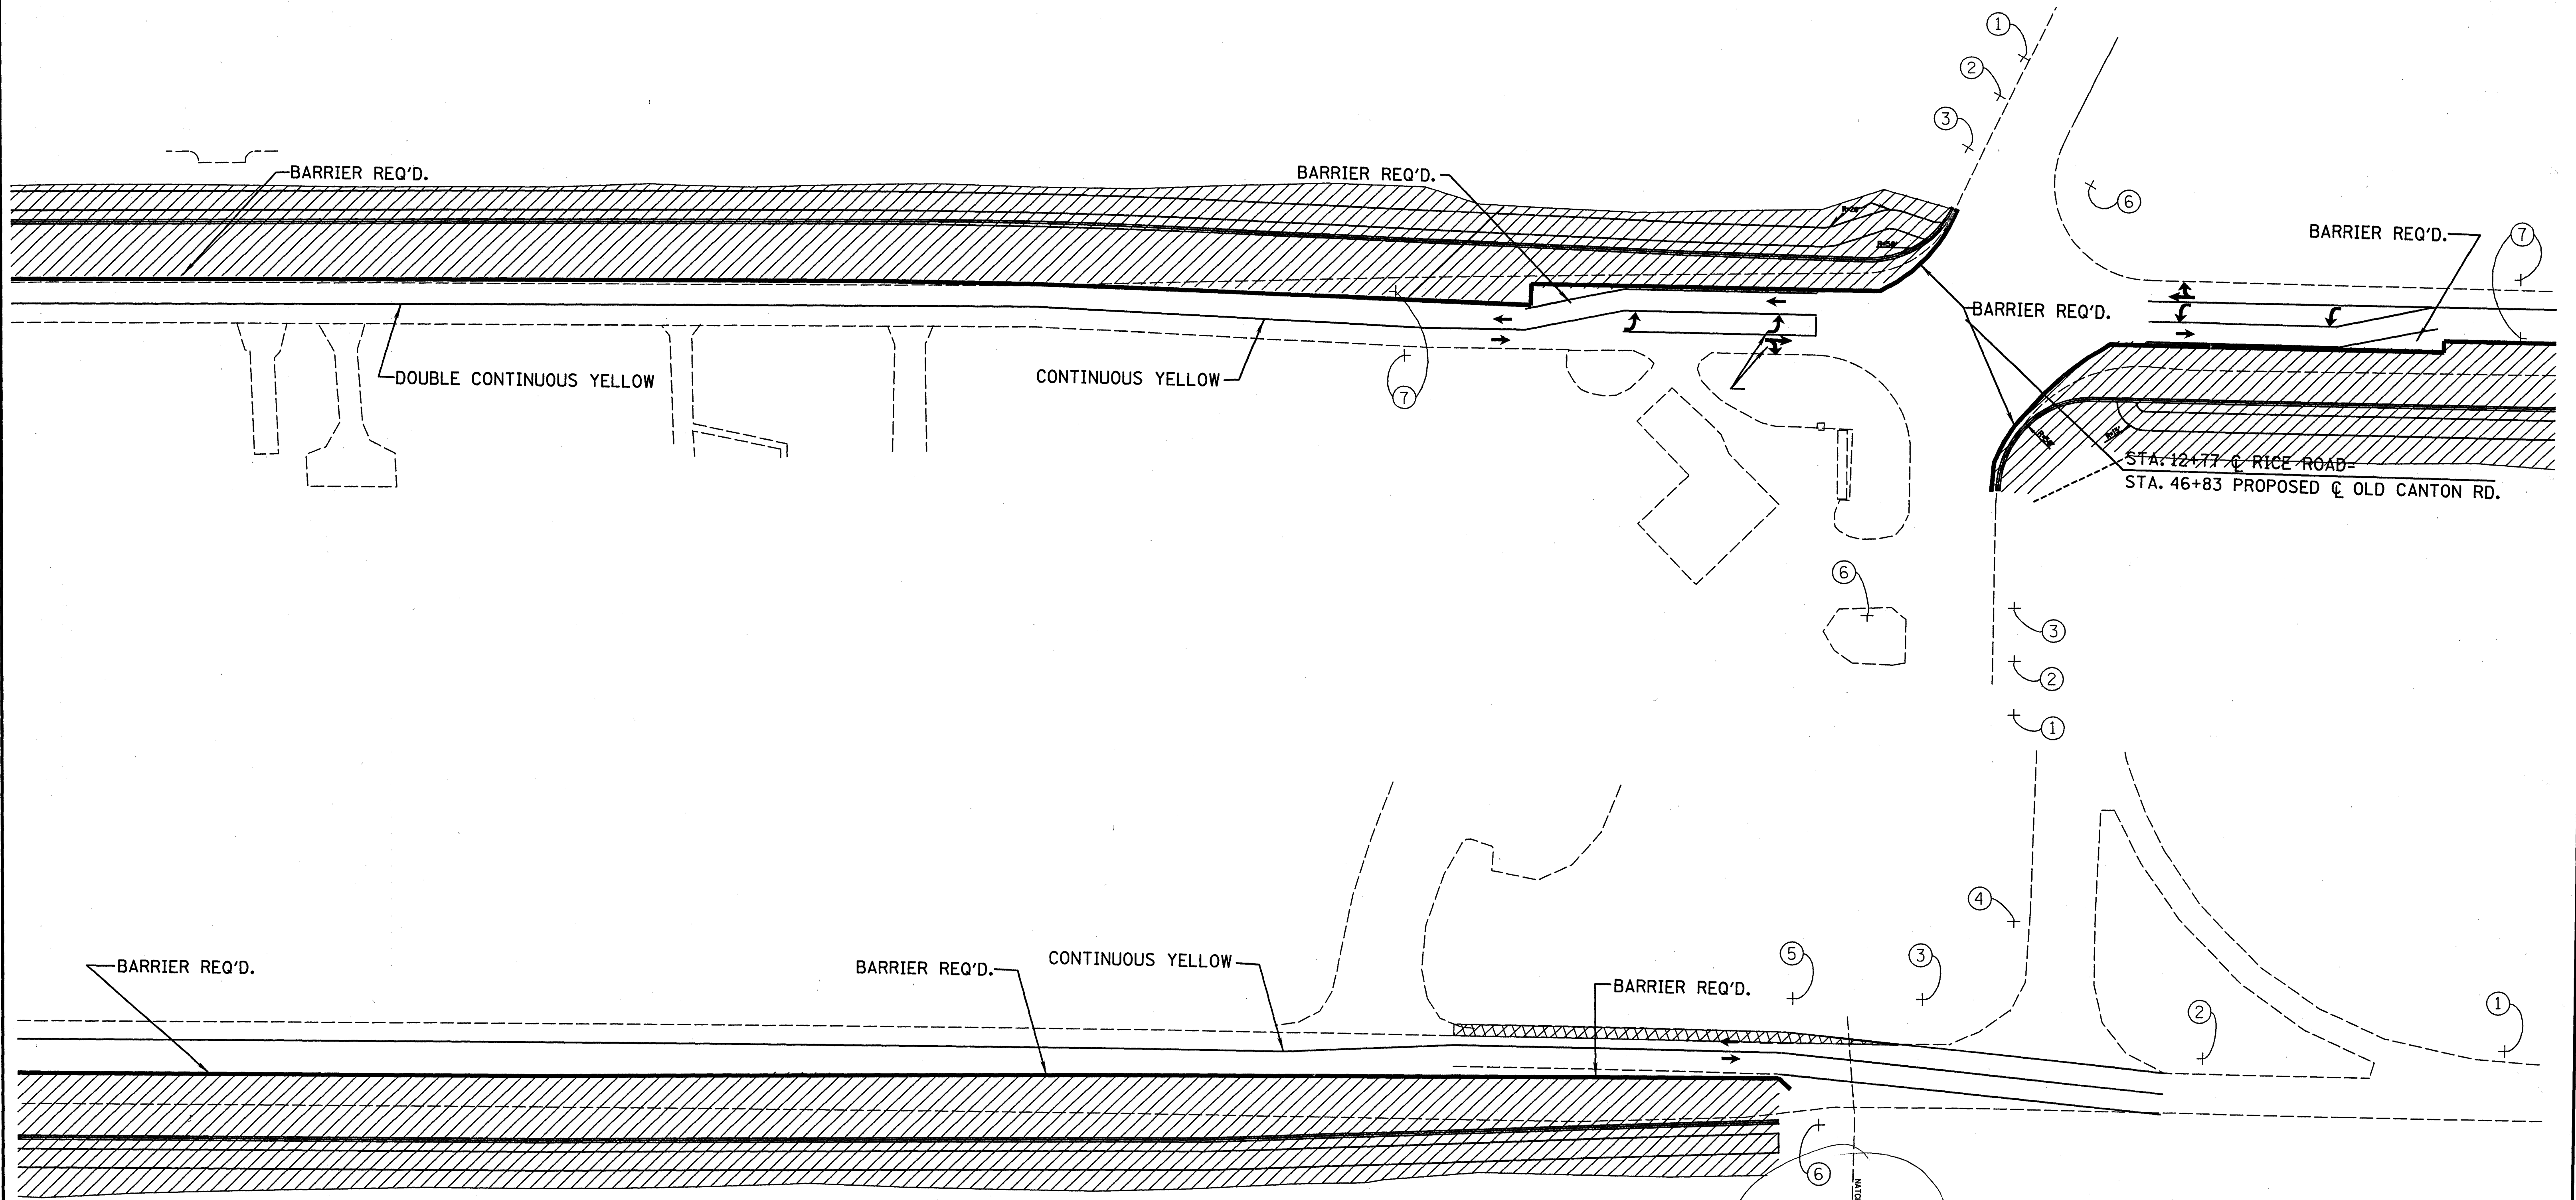

CONSTRUCTION SIGN SCHEDULE		
SIGN NUMBER	MUTCD NUMBER	DESCRIPTION
①	W20-1	ROAD WORK 1500 FEET
②	W20-1	ROAD WORK 1000 FEET
③	W20-1	ROAD WORK 500 FEET
④	W20-1	ROAD WORK 200 FEET
⑤	C20-1	ROAD WORK NEXT --- MILES
⑥	C20-2A	END ROAD WORK
⑦	W6-3	TWO WAY TRAFFIC

- LEGEND
- PHASE I
 - TEMPORARY PAVEMENT WIDENING
 - TRAFFIC DRUMS
 - TYPE III BARRICADES
 - SIGN

<p>TRAFFIC CONTROL PLAN PHASE I</p> <p>OLD CANTON ROAD RECONSTRUCTION CITY OF RIDGELAND, MISSISSIPPI PROJECT NO.: STP-6926-00(001)</p> <p>WAGGONER ENGINEERING, INC. Consulting Engineers - Jackson, Mississippi</p>		WORKING NUMBER
		TC-2
DATE	REVISION	SHEET NUMBER
BY	IT	TC-2
DATE	SCALE	1" = 40'
REVIEWED BY:		

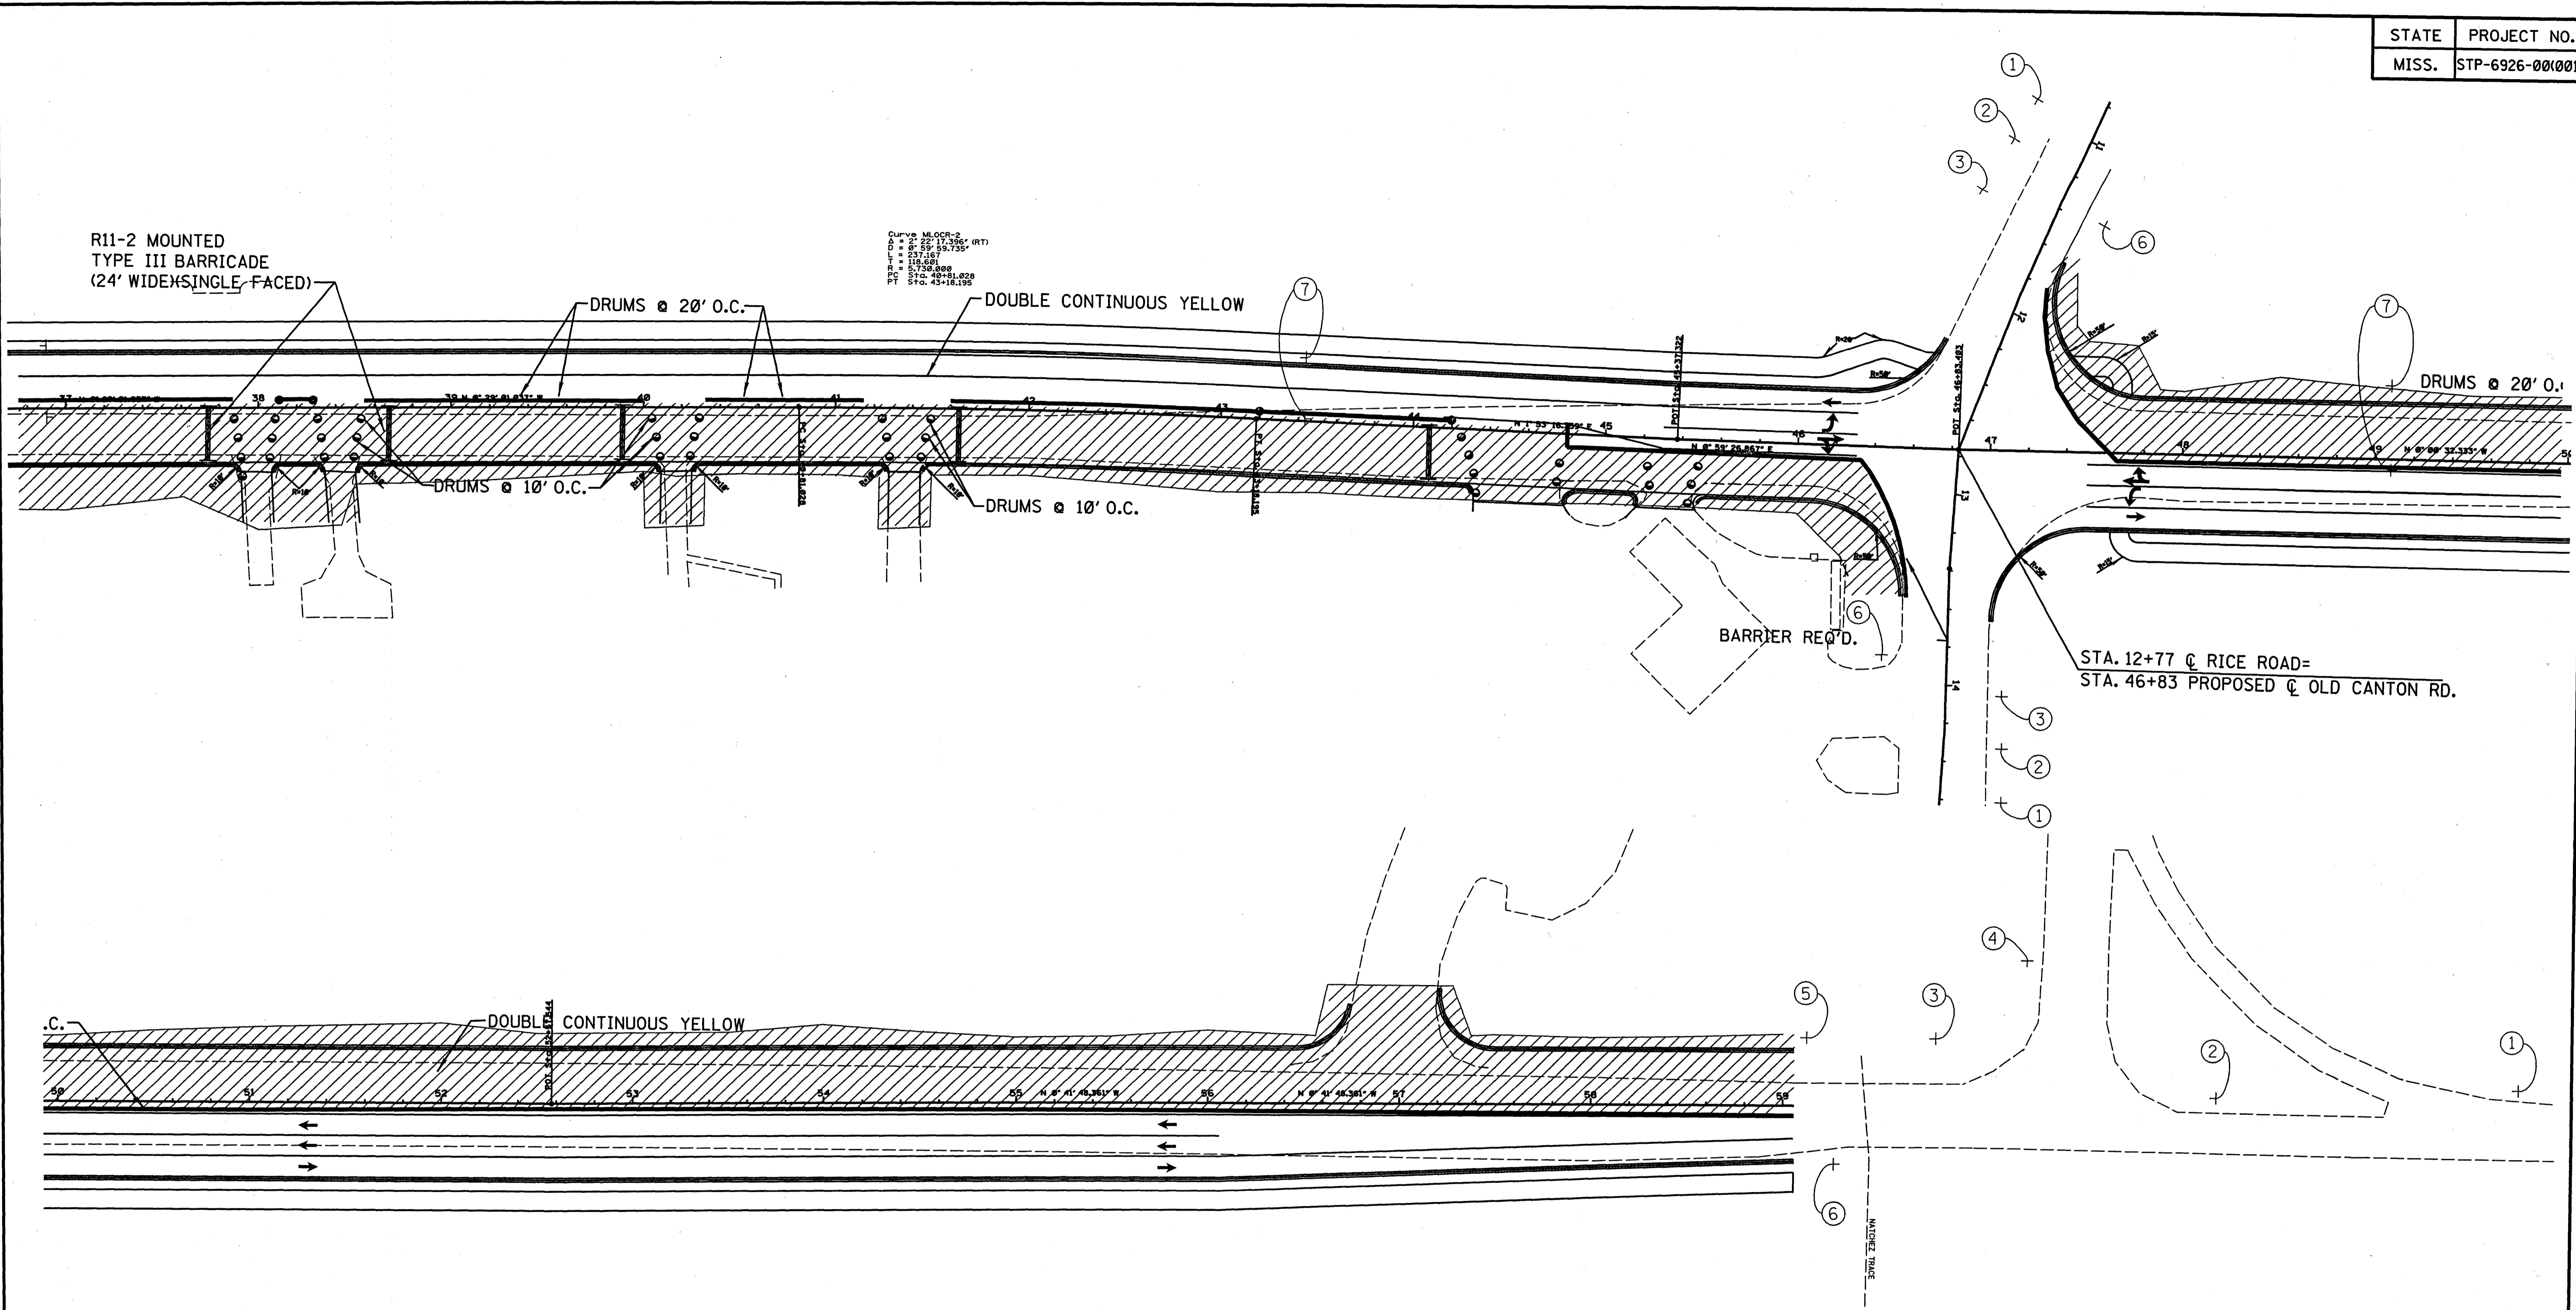


Curve MLOC-2
 D = 22' 17.356' (RT)
 E = 237.167
 L = 115.651
 R = 5.730.000
 S.C. = 48+81.028
 P.T. = 43+18.195

CONSTRUCTION SIGN SCHEDULE		
SIGN NUMBER	MUTCD NUMBER	DESCRIPTION
①	W20-1	ROAD WORK 1500 FEET
②	W20-1	ROAD WORK 1000 FEET
③	W20-1	ROAD WORK 500 FEET
④	W20-1	ROAD WORK 200 FEET
⑤	C20-1	ROAD WORK NEXT --- MILES
⑥	G20-2A	END ROAD WORK
⑦	W6-3	TWO WAY TRAFFIC

- LEGEND
- PHASE I
 - TEMPORARY PAVEMENT WIDENING
 - TRAFFIC DRUMS
 - TYPE III BARRICADES
 - SIGN


BY		TRAFFIC CONTROL PLAN	
REVISION		PHASE II	
OLD CANTON ROAD RECONSTRUCTION			
CITY OF RIDGELAND, MISSISSIPPI			
PROJECT NO.: STP-6926-00(001)			
WAGGONER ENGINEERING, INC.		WORKING NUMBER	
Consulting Engineers - Jackson, Mississippi		TC-4	
DATE	DRAWN BY: IT	DATE	SHEET NUMBER
	REVIEWED BY:	SCALE 1" = 40'	

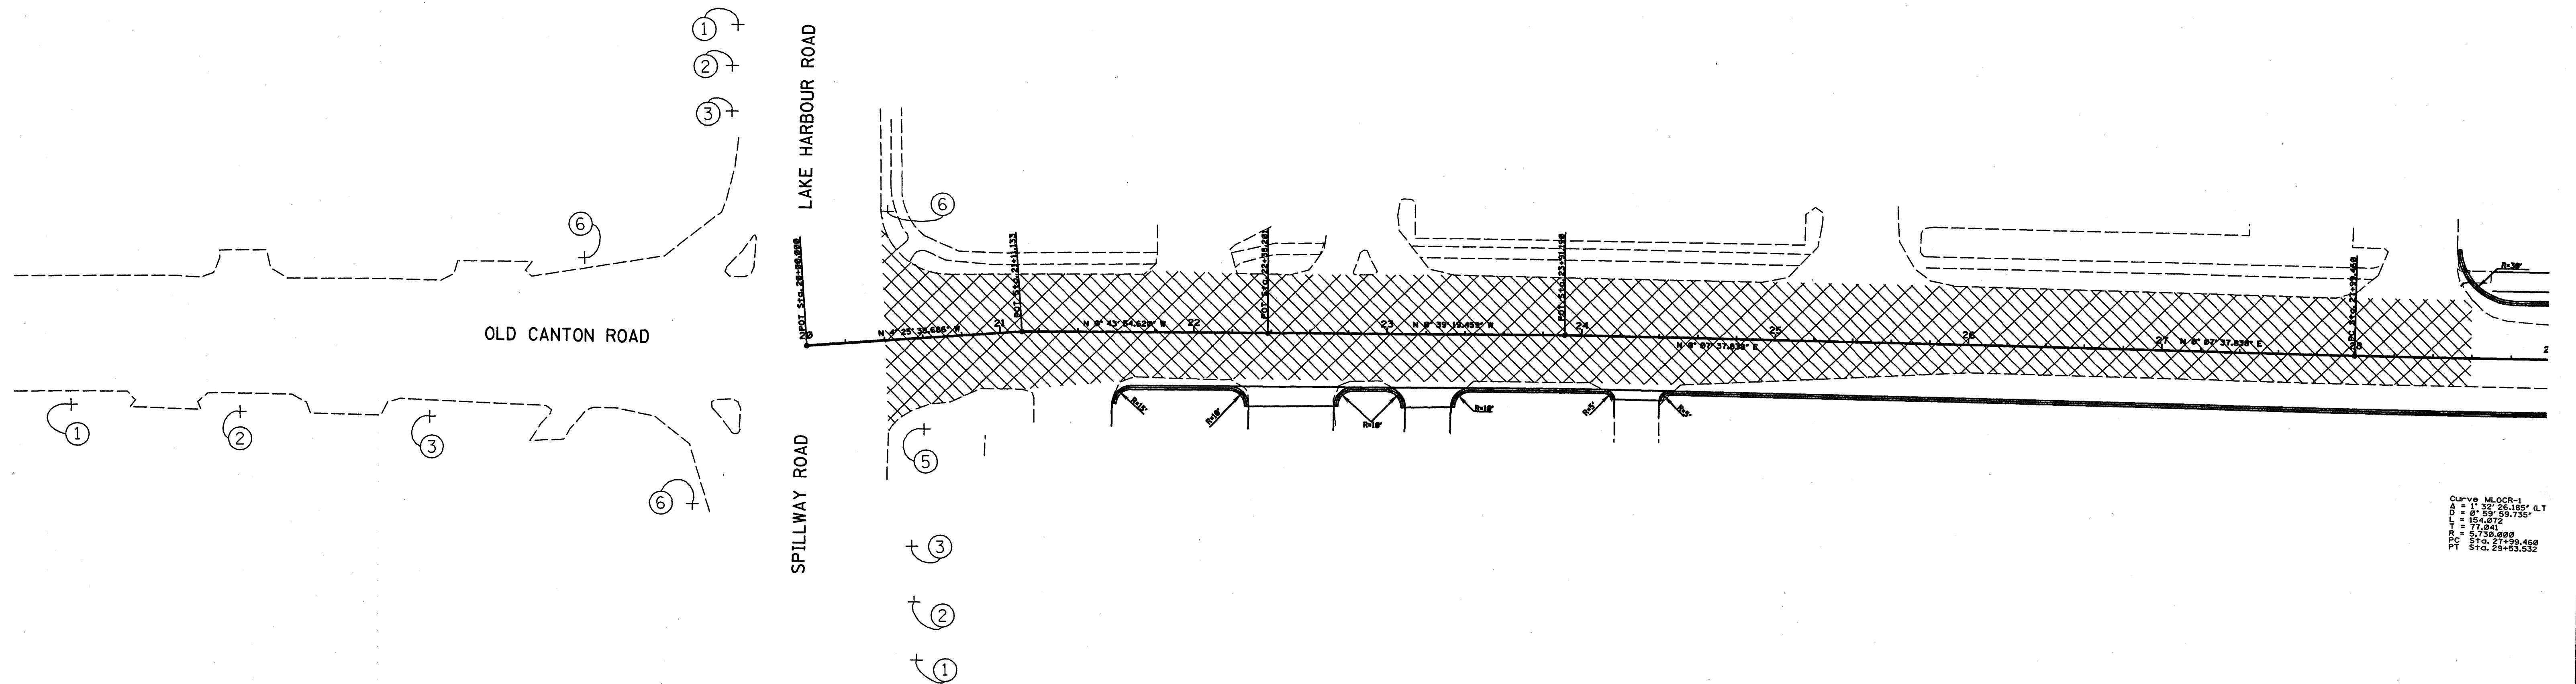

CONSTRUCTION SIGN SCHEDULE		
SIGN NUMBER	MUTCD NUMBER	DESCRIPTION
①	W20-1	ROAD WORK 1500 FEET
②	W20-1	ROAD WORK 1000 FEET
③	W20-1	ROAD WORK 500 FEET
④	W20-1	ROAD WORK 200 FEET
⑤	G20-1	ROAD WORK NEXT --- MILES
⑥	G20-2A	END ROAD WORK
⑦	W6-3	TWO WAY TRAFFIC

▨▨▨▨▨ INDICATES LIMITS OF MILLING

REVISION		TRAFFIC CONTROL PLAN	
		PHASE III	
DATE		OLD CANTON ROAD RECONSTRUCTION	
DRAWN BY: IT		CITY OF RIDGELAND, MISSISSIPPI	
REVIEWED BY:		PROJECT NO.: STP-6926-00(001)	
DATE		WAGGONER ENGINEERING, INC.	
SCALE: 1" = 40'		Consulting Engineers - Jackson, Mississippi	
DATE		WORKING NUMBER	TC-5
DATE		SHEET NUMBER	

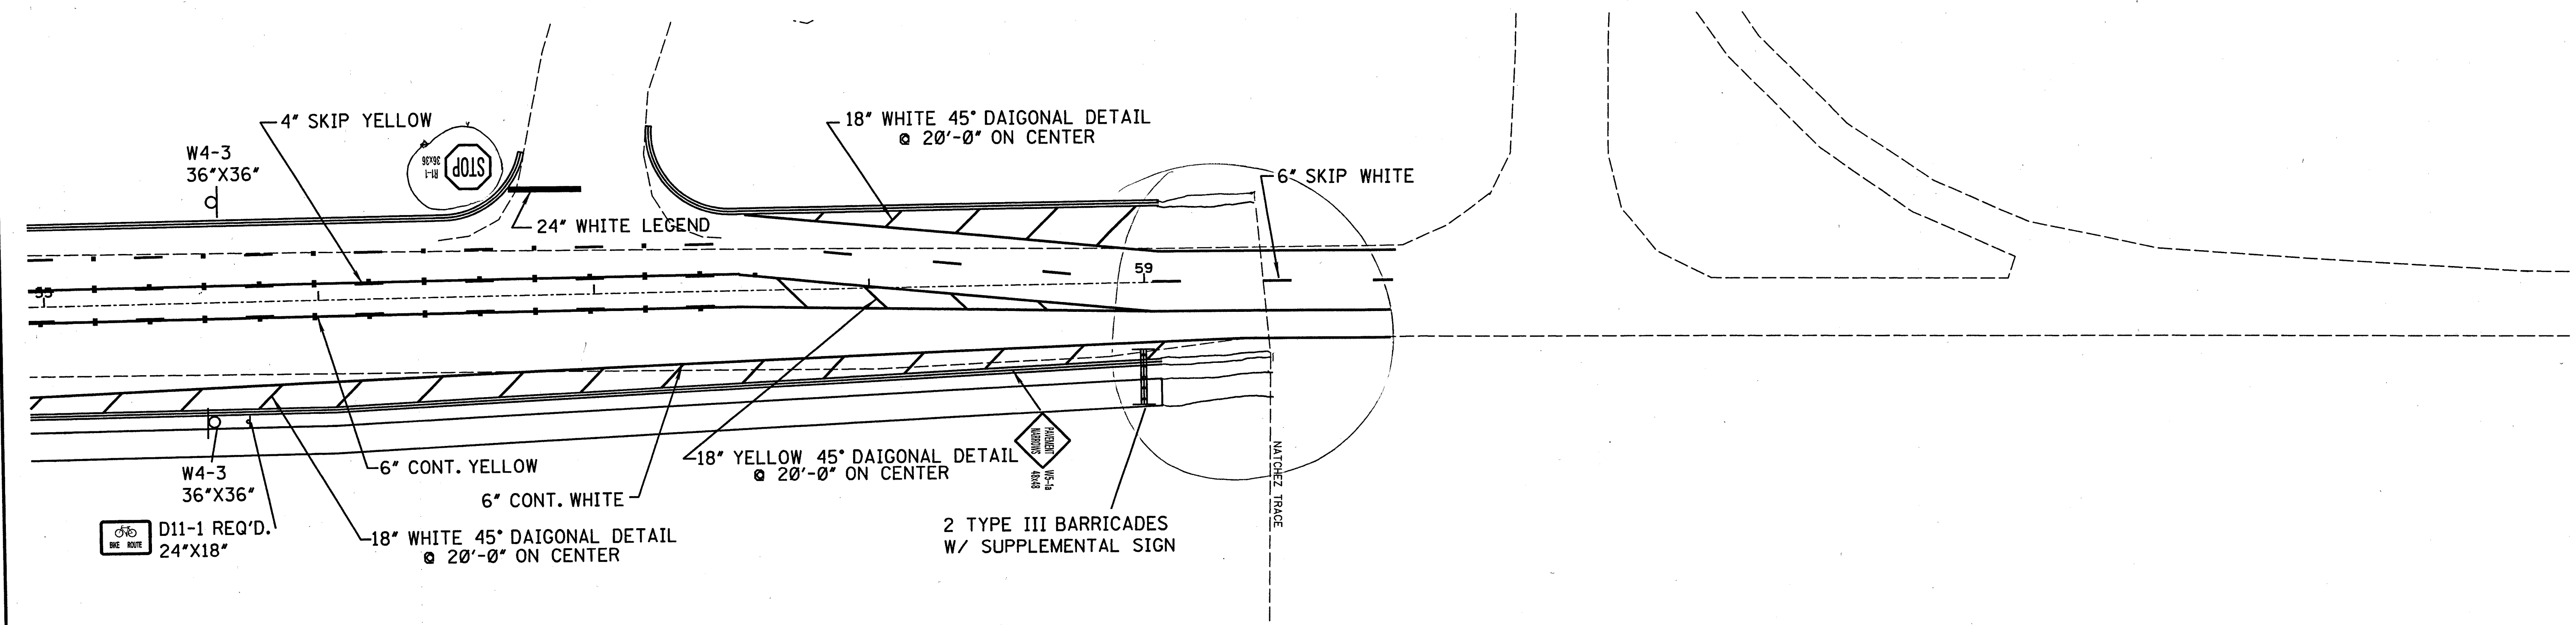


TEMP.
STRIPES
DETAIL

		STRIPING AND SIGNING	
		OLD CANTON ROAD RECONSTRUCTION	
		PROJECT NO.: STP-6926-00(001)	
		CITY OF RIDGELAND, MISSISSIPPI	
		WAGGONER ENGINEERING, INC. <i>Consulting Engineers - Jackson, Mississippi</i>	WORKING NUMBER DS-3
DATE	DRAWN BY: I.T.	DATE	SHEET NUMBER
	REVIEWED BY:	SCALE 1"=30'	

DETECTOR ASSIGNMENT SUMMARY				
DETECTOR NUMBER	LOOP SIZE	PEDESTRIAN PUSH BUTTON	PHASE CALLED	PULSE MODE
8B	6'x 50'		1	X

SIGNAL PHASING

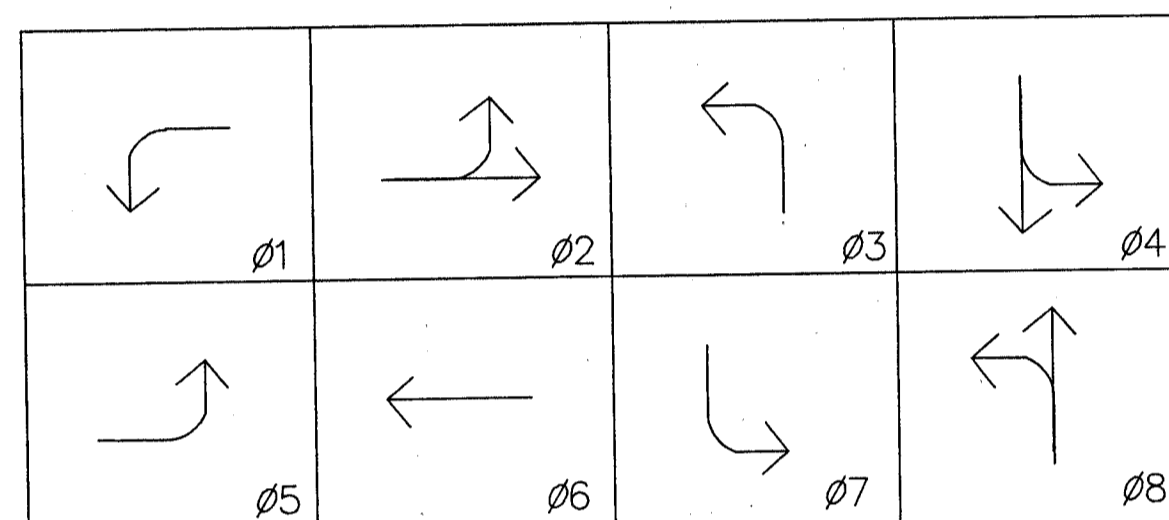

EMERGENCY PRE-EMPT
 CHANNEL 1 - Ø2, Ø5
 CHANNEL 2 - Ø1, Ø6
 CHANNEL 3 - Ø3, Ø8


FLASHING OPERATION
 YELLOW - Ø1, Ø2, Ø5, Ø6
 RED - Ø3, Ø4, Ø7, Ø8

TRAFFIC SIGNAL INSTALLATION
 GENERAL NOTES

- THE PLAN LOCATIONS OF UNDERGROUND UTILITIES ARE APPROXIMATE. THE CONTRACTOR SHALL NOTIFY ALL THE UTILITY COMPANIES PRIOR TO ANY EXCAVATION ON THE PROJECT. IN ORDER TO ESTABLISH EXACT LOCATIONS. THE CONTRACTOR SHALL BE RESPONSIBLE FOR MAKING INDEPENDENT INVESTIGATIONS, AS NECESSARY, TO VERIFY ALL UTILITY LOCATIONS AT NO COST TO THE OWNER.
- ALL SIGNS, SIGNALS, PAVEMENT MARKINGS AND TEMPORARY TRAFFIC CONTROL DEVICES ARE TO CONFORM TO THE MANUAL ON UNIFORM TRAFFIC CONTROL DEVICES (1988) EDITION AND ALL SUBSEQUENT REVISIONS.
- ALL POLES, PULLBOXES, CONTROLLERS AND PAVEMENT MARKINGS SHALL BE FIELD LOCATED BY THE ENGINEER AND THE CONTRACTOR AT THE NEAREST PRACTICAL LOCATION INDICATED ON THE PLAN SHEETS.
- THE SIGNAL CONTROLLER TIMINGS SHALL BE PROVIDED BY THE ENGINEER.
- THE CONTRACTOR IS RESPONSIBLE FOR THE MAINTENANCE OF EXISTING TRAFFIC SIGNALS AND / OR SIGNS. ANY MODIFICATIONS REQUIRED TO THESE DEVICES SHALL BE PERFORMED BY THE CONTRACTOR.
- THE CONTRACTOR IS RESPONSIBLE FOR THE MAINTENANCE OF EXISTING TRAFFIC SIGNALS AND/OR SIGNS. COST TO BE INCLUDED IN OTHER ITEMS BID. CONTRACTOR IS RESPONSIBLE FOR MAINT. OF ALL TRAFFIC IN THE PROJECT, ONCE WORK HAS BEGUN.
- CONTRACTOR SHALL UTILIZE EXISTING EQUIPMENT IN CONTROLLER CABINET FOR IN CONTROLLER CABINET FOR THE INSTALLATION OF ALL NEW MATERIALS.
- TRAFFIC SIGNAL WILL RUN FIXED-TIME OPERATION DURING CONSTRUCTION PHASE.

LEGEND

- CONTROLLER AND CABINET
- NEW MAST ARM POLE
- TYPE 2 PULLBOX
- TRAFFIC SIGNAL HEAD w/BACKPLATE
- OVERHEAD SIGN / STREET NAME SIGN
- VEHICLE LOOP DETECTOR
- 5/c 5 CONDUCTOR SIGNAL CABLE - AWG #14
- 7/c 7 CONDUCTOR SIGNAL CABLE - AWG #14
- s.c. SHIELDED CABLE (2 CONDUCTOR - AWG #14)
- LUM STREET LIGHT CABLE AWG (1 CONDUCTOR - AWG #10)
- CONDUIT RUN
- EMERGENCY VEHICLE DETECTOR
- e.c. EMERGENCY VEHICLE CABLE (3 CONDUCTOR AWG #20)

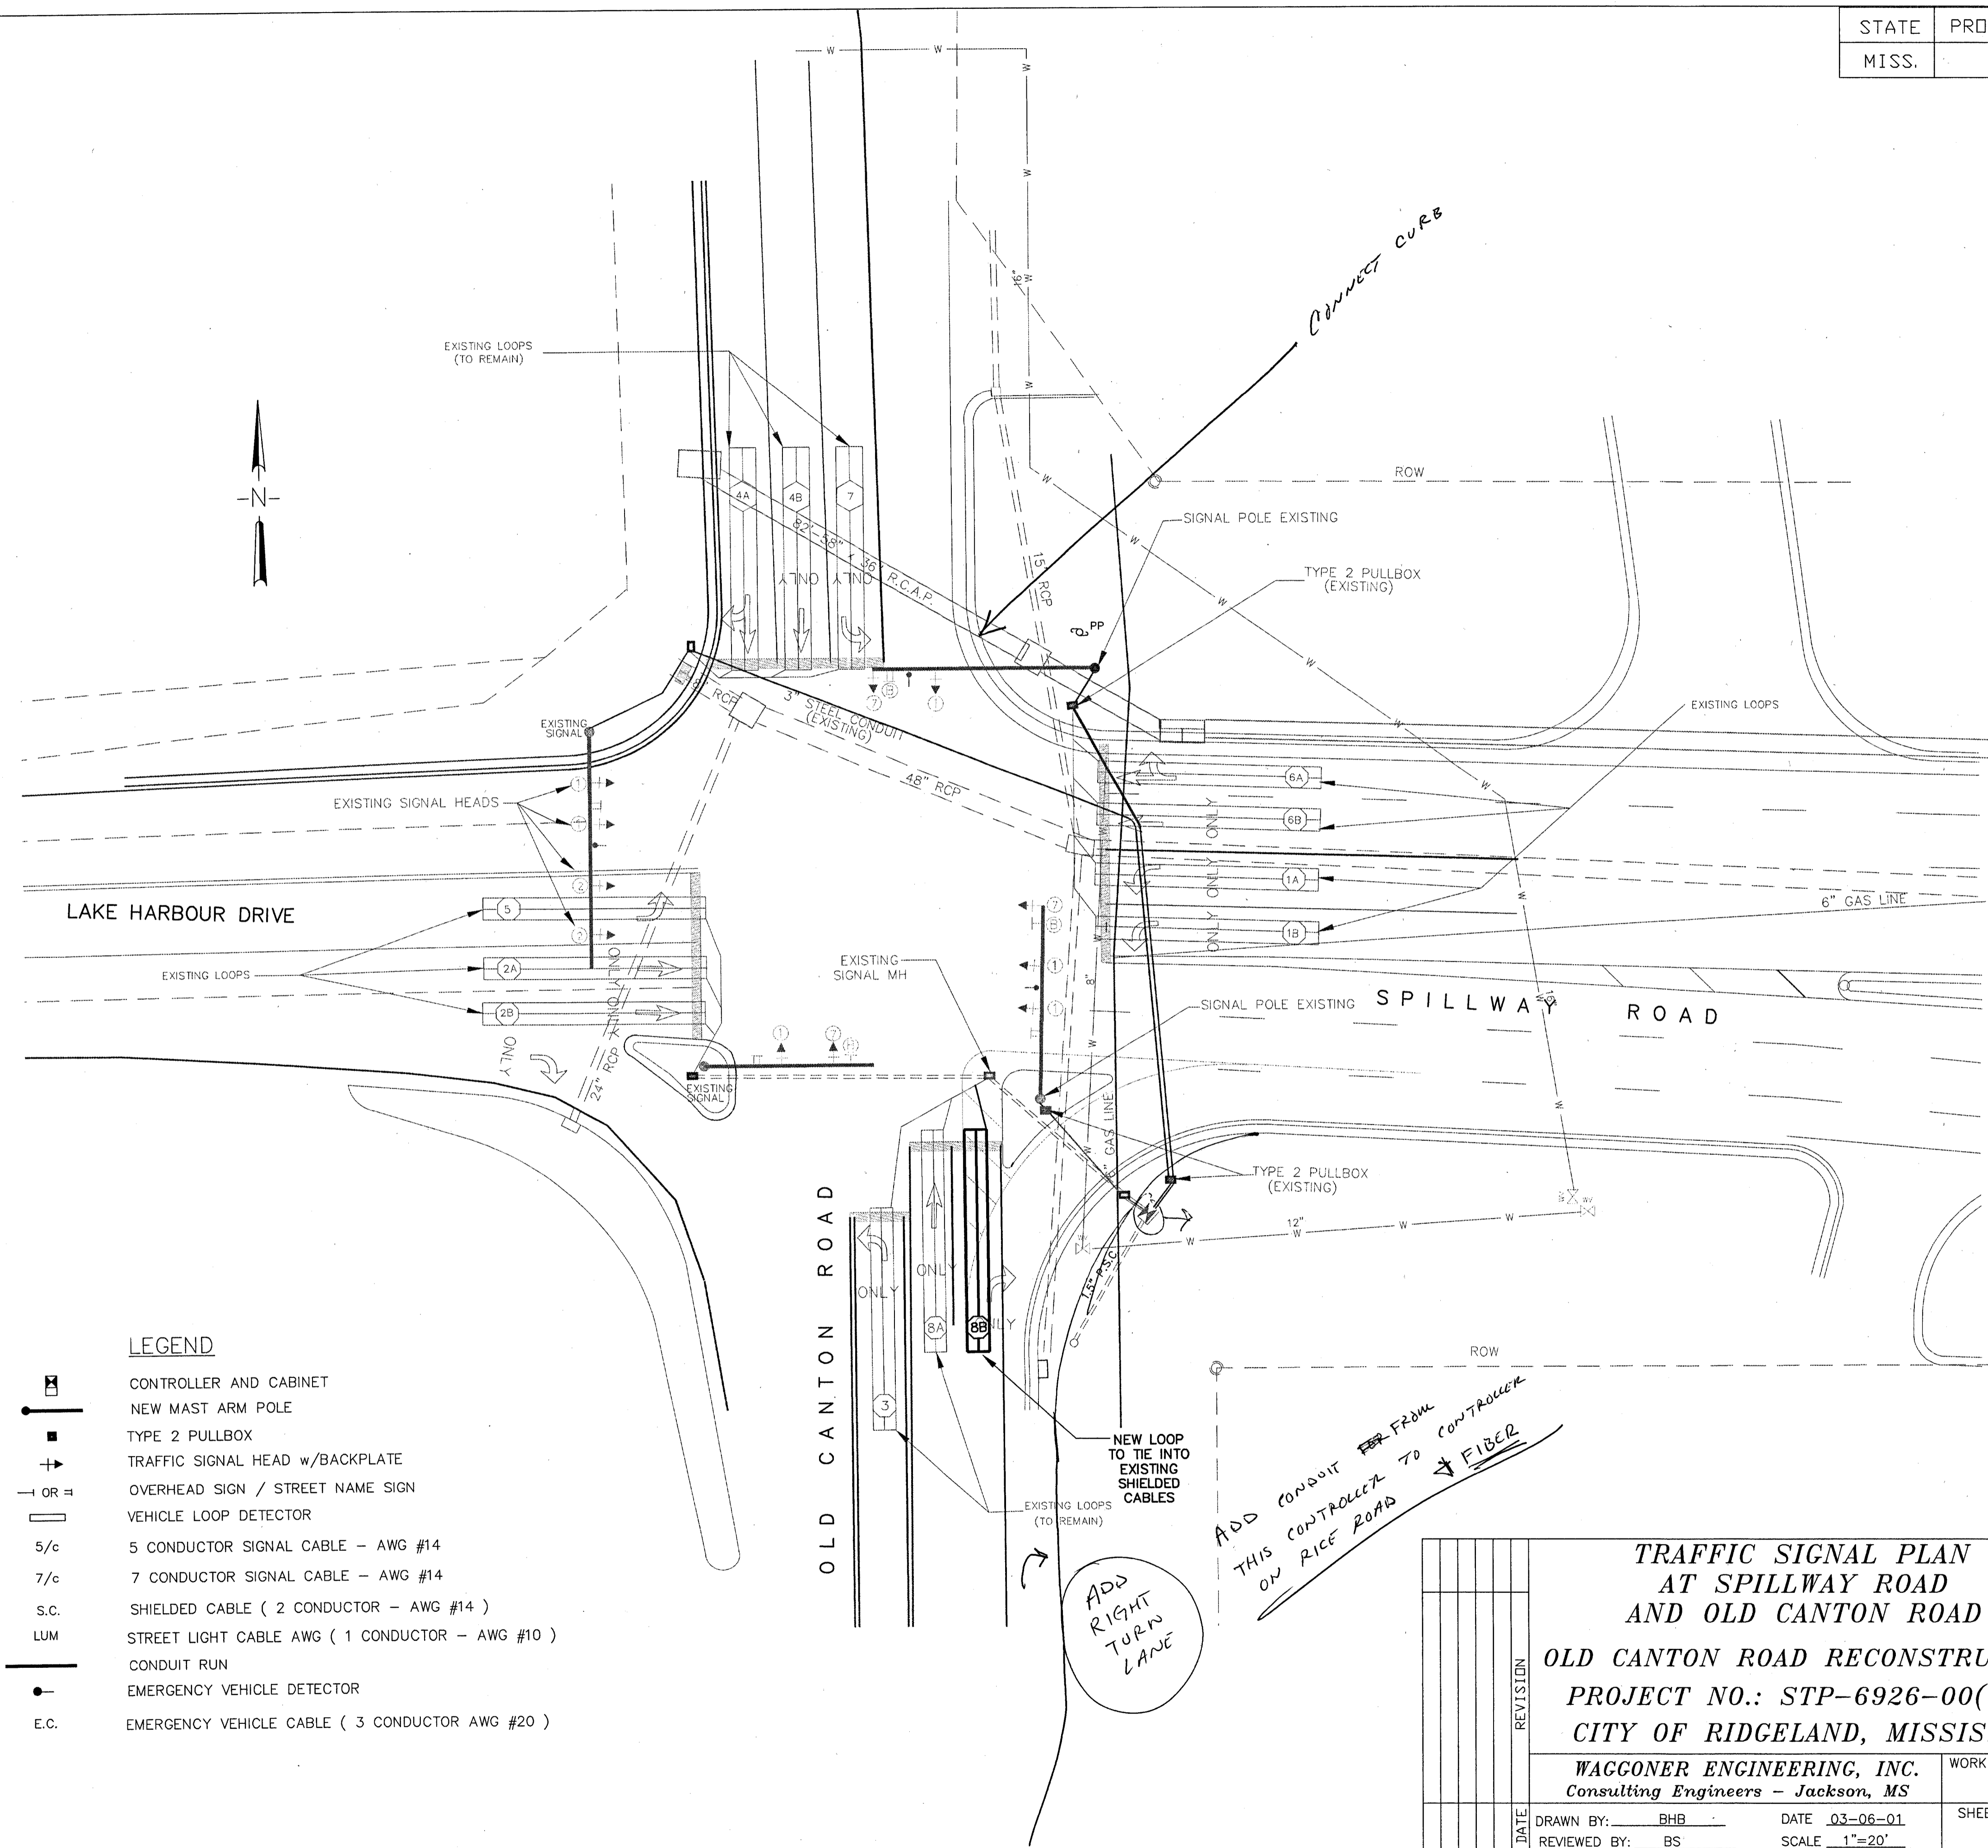


ADD CONDUIT FROM THIS CONTROLLER TO RICE ROAD TO FIBER

ADD RIGHT TURN LANE

<p>TRAFFIC SIGNAL PLAN AT SPILLWAY ROAD AND OLD CANTON ROAD</p>	
<p>OLD CANTON ROAD RECONSTRUCTION PROJECT NO.: STP-6926-00(001) CITY OF RIDGELAND, MISSISSIPPI</p>	
<p>WAGGONER ENGINEERING, INC. Consulting Engineers - Jackson, MS</p>	
DATE	REVISION
<p>DRAWN BY: BHB REVIEWED BY: BS</p>	<p>DATE 03-06-01 SCALE 1"=20'</p>
WORKING NUMBER	SHEET NUMBER

STATE	PROJECT NO.
MISS.	

- LEGEND**
- ☐ CONTROLLER AND CABINET
 - NEW MAST ARM POLE
 - TYPE 2 PULLBOX
 - TRAFFIC SIGNAL HEAD w/BACKPLATE
 - +— OR — OVERHEAD SIGN / STREET NAME SIGN
 - VEHICLE LOOP DETECTOR
 - 5/c 5 CONDUCTOR SIGNAL CABLE
 - 7/c 7 CONDUCTOR SIGNAL CABLE
 - S.C. SHIELDED CABLE (2 CONDUCTOR)
 - LUM STREET LIGHT CABLE AWG
 - CONDUIT RUN
 - EMERGENCY VEHICLE DETECTOR
 - E.C. EMERGENCY VEHICLE CABLE
 - ★ LUMINAIRE

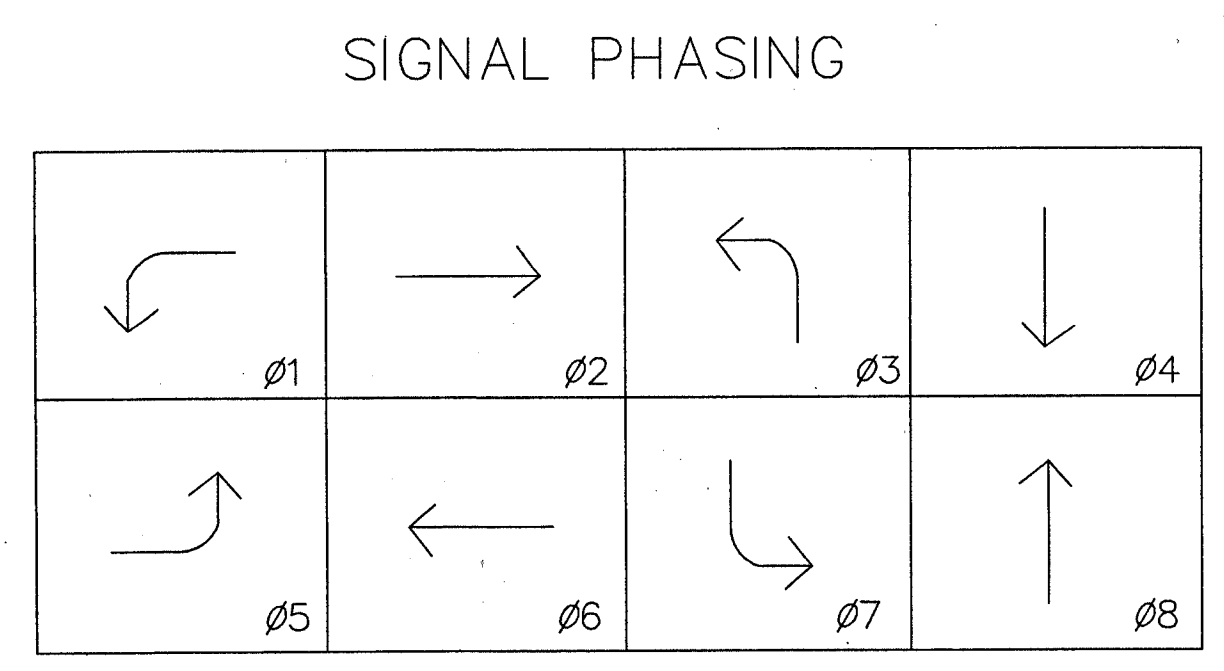

FLASHING OPERATION
 YELLOW - ø3, ø4, ø7, ø8
 RED - ø1, ø2, ø5, ø6


EMERGENCY PRE-EMPT
 CHANNEL 1 - ø2, ø5
 CHANNEL 2 - ø4, ø7
 CHANNEL 3 - ø1, ø6
 CHANNEL 4 - ø3, ø8

DETECTOR ASSIGNMENT SUMMARY

DETECTOR NUMBER	LOOP SIZE	NUMBER OF TURNS	PHASE CALLED	PRESENCE MODE	PULSE MODE
4B	6'x 50'	2	4	X	
8B	6'x 50'	2	8	X	

**TRAFFIC SIGNAL INSTALLATION
GENERAL NOTES**

1. THE PLAN LOCATIONS OF UNDERGROUND UTILITIES ARE APPROXIMATE. THE CONTRACTOR SHALL NOTIFY ALL THE UTILITY COMPANIES PRIOR TO ANY EXCAVATION ON THE PROJECT, IN ORDER TO ESTABLISH EXACT LOCATIONS. THE CONTRACTOR SHALL BE RESPONSIBLE FOR MAKING INDEPENDENT INVESTIGATIONS, AS NECESSARY, TO VERIFY ALL UTILITY LOCATIONS AT NO COST TO THE OWNER.
2. ALL SIGNS, SIGNALS, PAVEMENT MARKINGS AND TEMPORARY TRAFFIC CONTROL DEVICES ARE TO CONFORM TO THE MANUAL ON UNIFORM TRAFFIC CONTROL DEVICES (1988) EDITION AND ALL SUBSEQUENT REVISIONS.
3. ALL RAISED OBJECTS ARE TO BE PLACED A MINIMUM OF 2' BEHIND THE FACE OF CURB. NEW TRAFFIC SIGNAL POLES ARE TO BE PLACED A MINIMUM OF 10' BEHIND THE EDGE OF PAVEMENT, EXCEPT WHERE CONFLICTS WITH UTILITIES AND / OR RIGHTS-OF-WAY EXISTS.
4. ALL POLES, PULLBOXES, CONTROLLERS AND PAVEMENT MARKINGS SHALL BE FIELD LOCATED BY THE ENGINEER AND THE CONTRACTOR AT THE NEAREST PRACTICAL LOCATION INDICATED ON THE PLAN SHEETS.
5. THE SIGNAL CONTROLLER TIMINGS SHALL BE PROVIDED BY THE ENGINEER.
6. THE CONTRACTOR SHALL MAKE APPLICATION FOR POWER SERVICE, COORDINATING WITH CITY OFFICIALS AND UTILITY COMPANY INVOLVED, IN ADVANCE OF REQUIRING THE ELECTRICAL SERVICE.
7. THE CONTRACTOR IS RESPONSIBLE FOR THE MAINTENANCE OF EXISTING TRAFFIC SIGNS. ANY MODIFICATIONS REQUIRED TO THESE DEVICES SHALL BE PERFORMED BY THE CONTRACTOR.
8. CONTRACTOR IS RESPONSIBLE FOR MAINTENANCE OF ALL TRAFFIC IN THE PROJECT.
9. CONTRACTOR SHALL EXTEND THE CONTROLLER POWER WIRE UP THE POWER POLE TO THE NECESSARY HEIGHT AS REQUIRED BY THE UTILITY COMPANY WITH THE APPROPRIATE CONDUIT, STRAPPING, AND WEATHERHEAD. THIS ITEM SHALL BE COST ABSORBED.

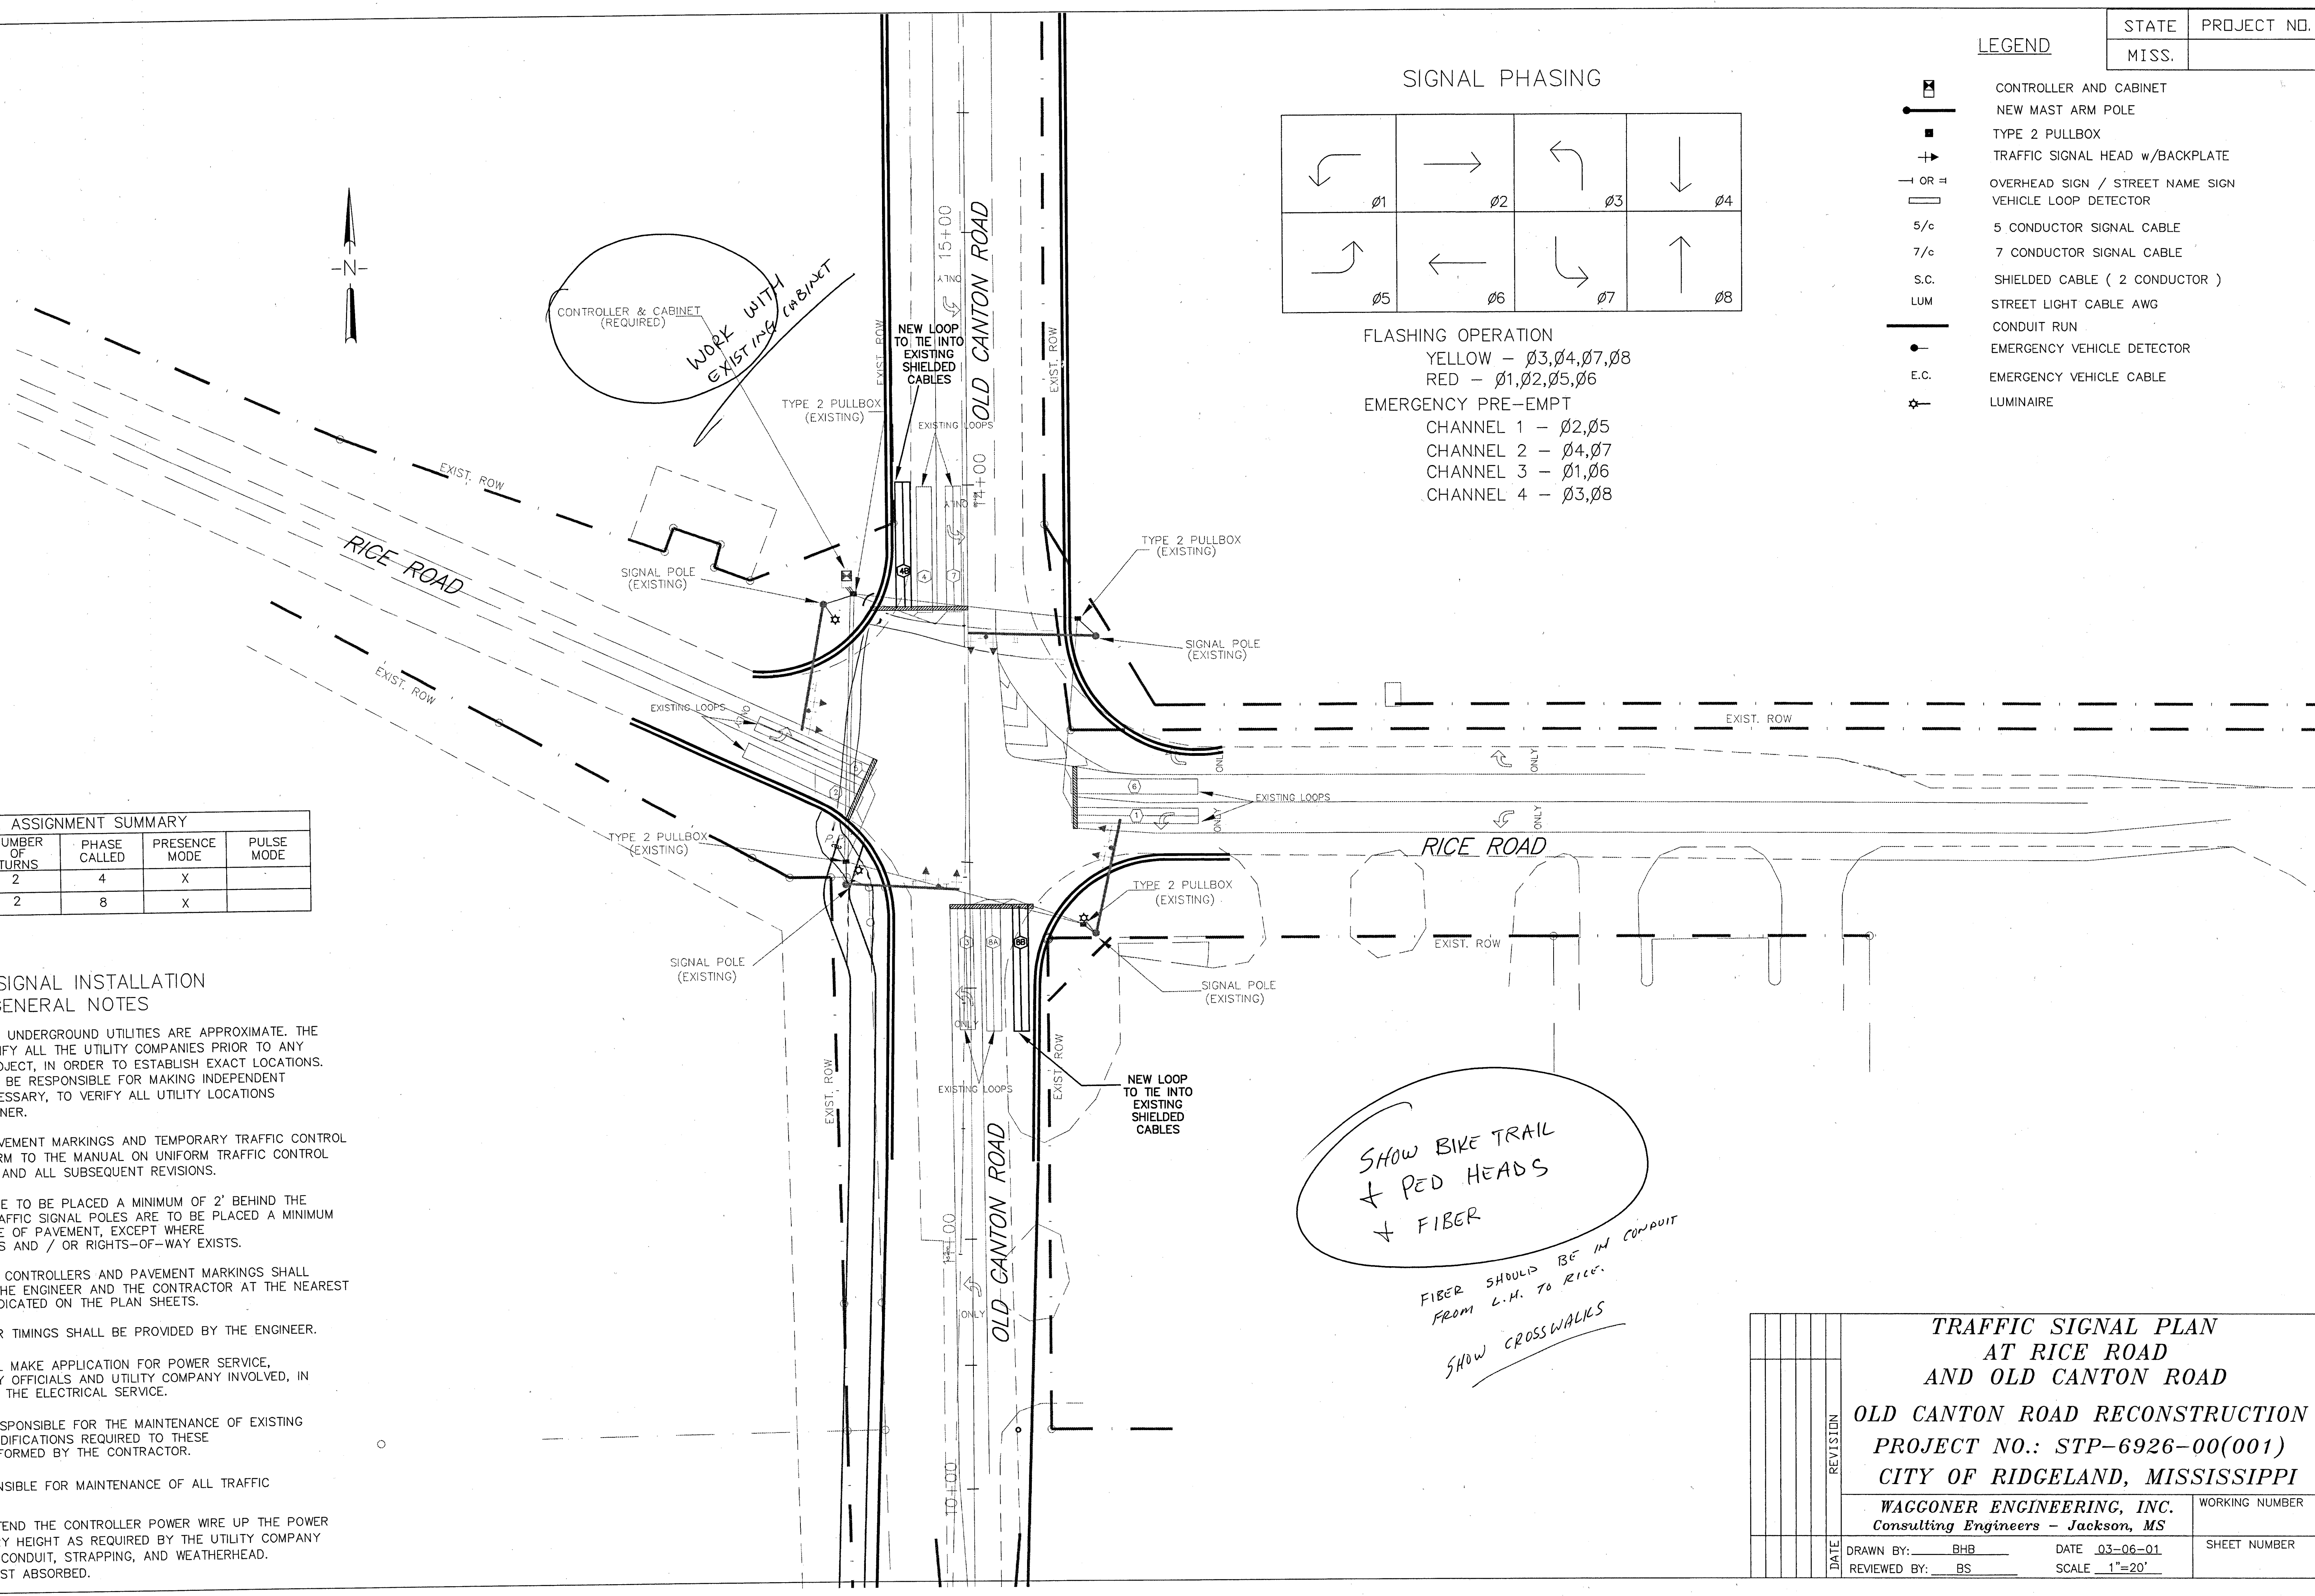


SHOW BIKE TRAIL
+ PED HEADS
+ FIBER

FIBER SHOULD BE IN CONDUIT
FROM L.H. TO RICE.





SHOW CROSSWALKS

TRAFFIC SIGNAL PLAN AT RICE ROAD AND OLD CANTON ROAD		OLD CANTON ROAD RECONSTRUCTION	
		PROJECT NO.: STP-6926-00(001)	
CITY OF RIDGELAND, MISSISSIPPI		WAGGONER ENGINEERING, INC.	
Consulting Engineers - Jackson, MS		WORKING NUMBER	
DATE	DRAWN BY: BHB	DATE 03-06-01	SHEET NUMBER
REVISION	REVIEWED BY: BS	SCALE 1"=20'	

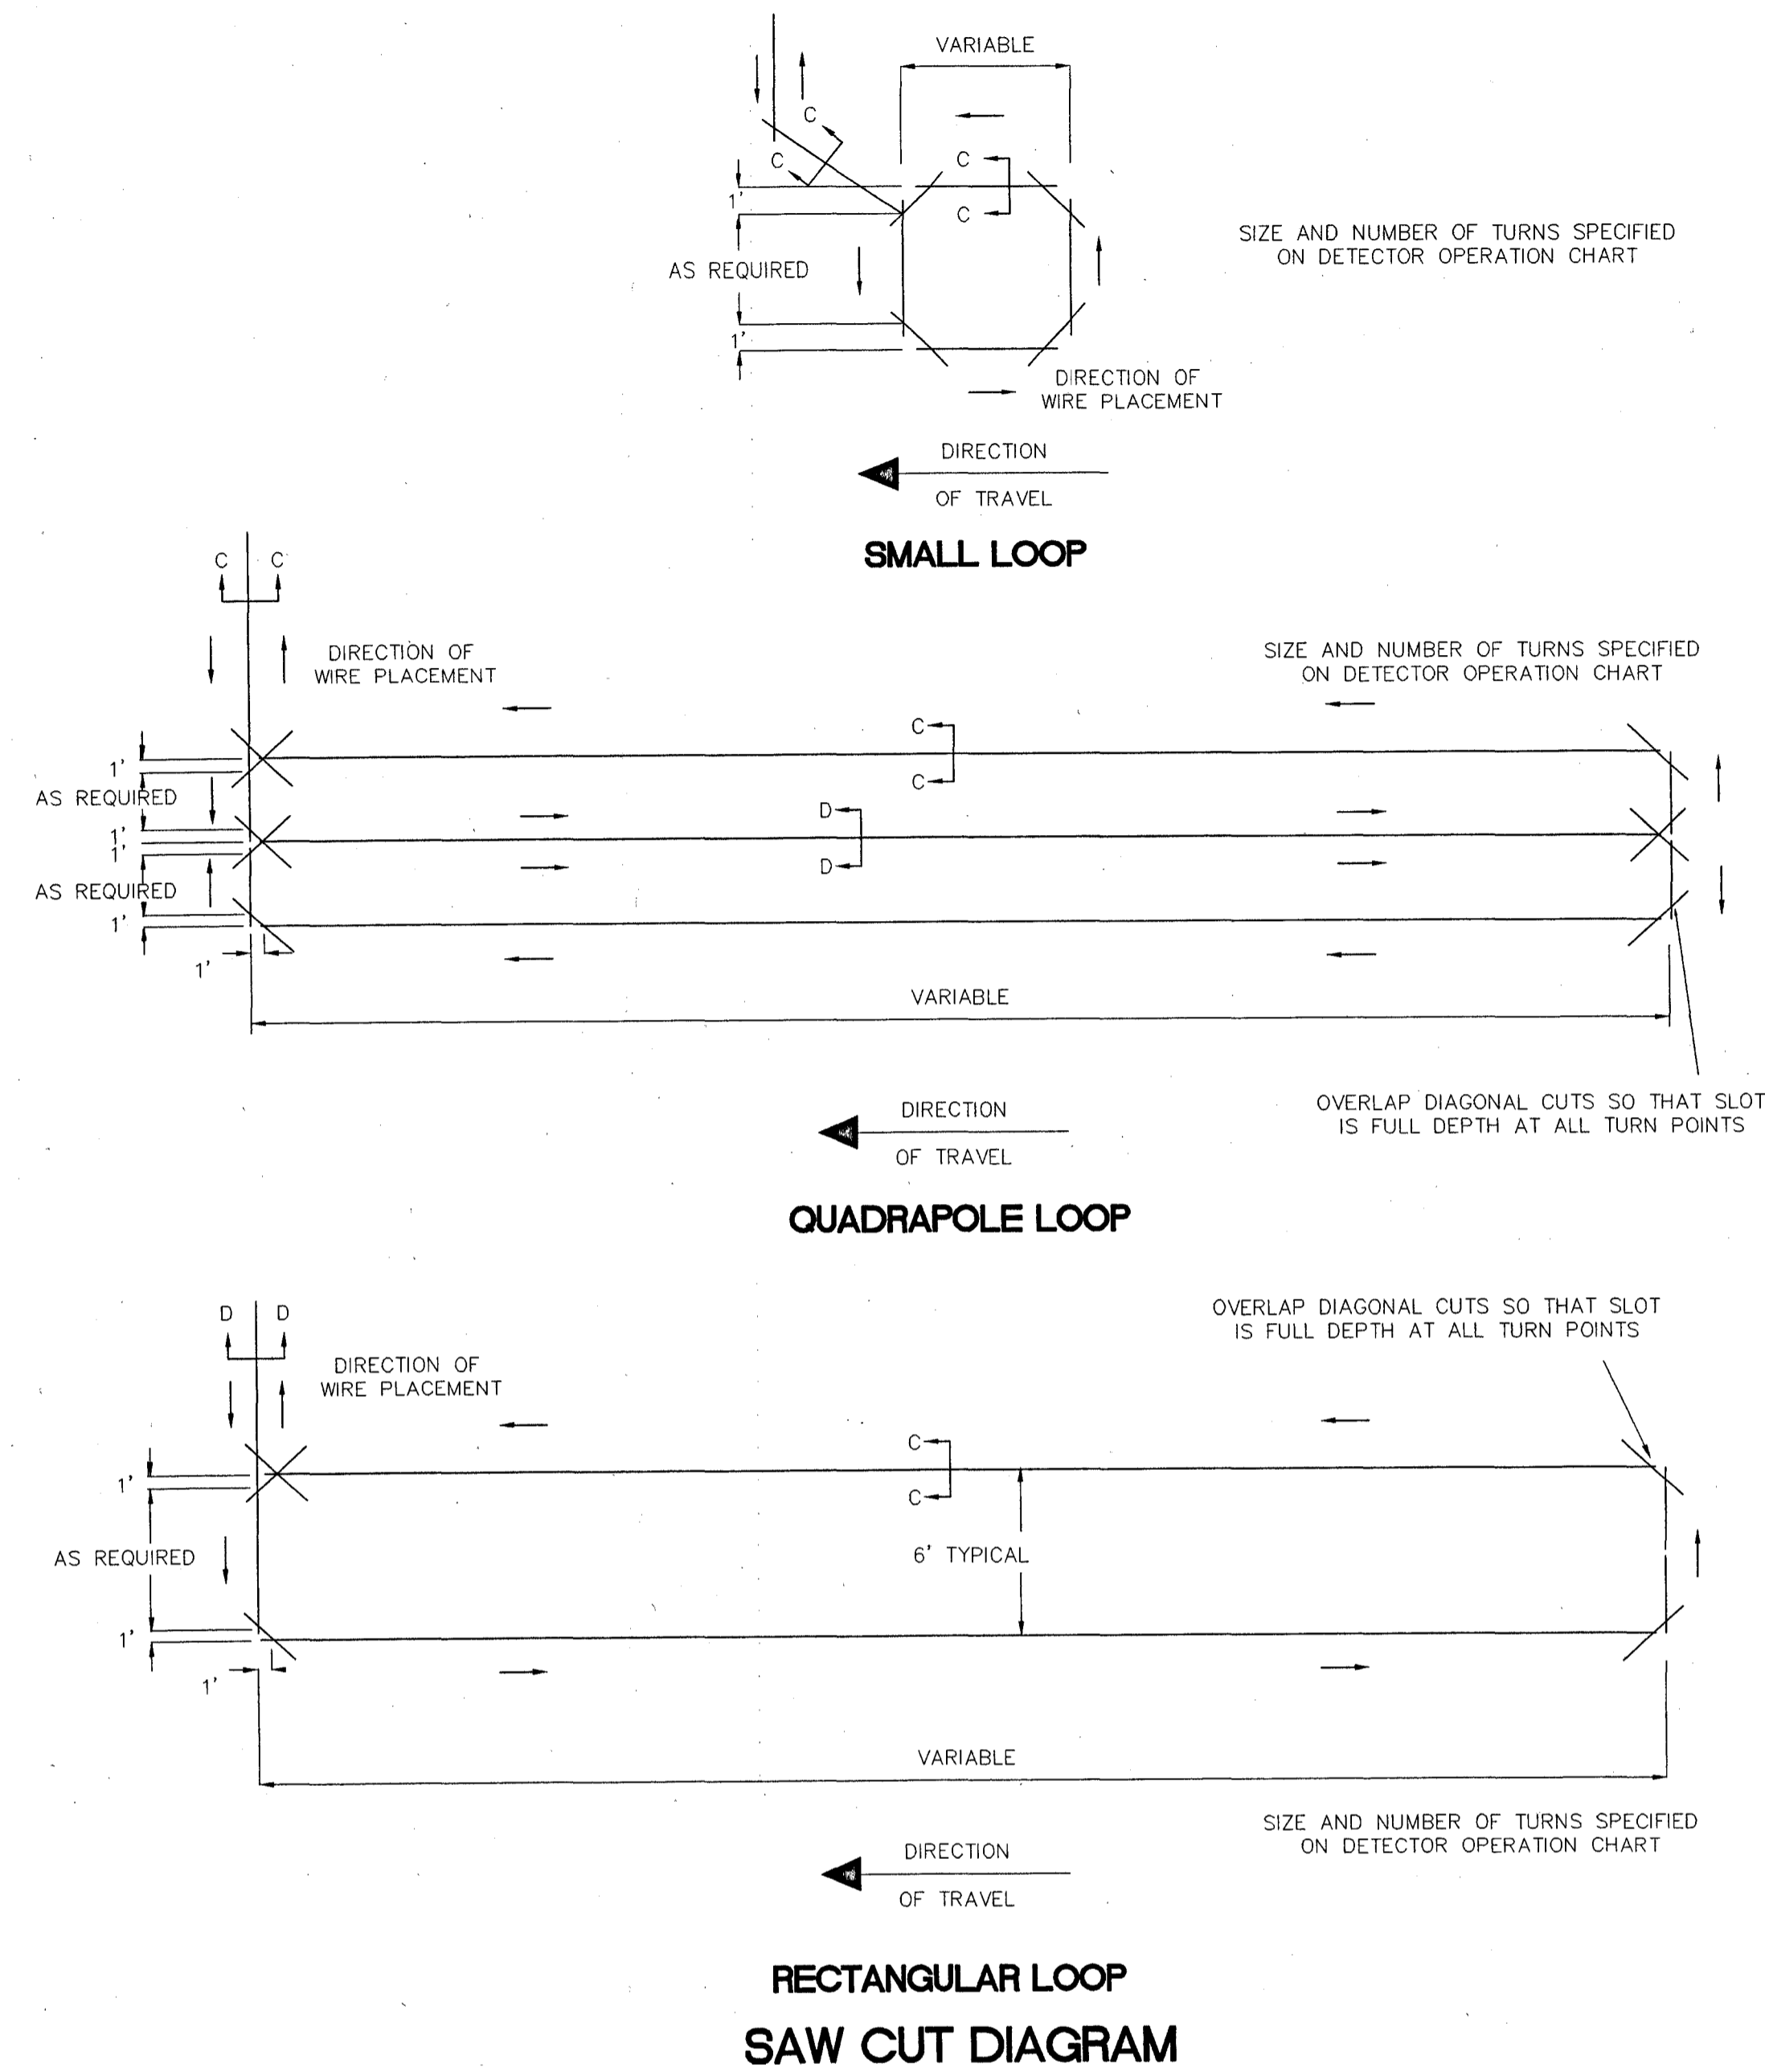

SAW SLOT AND LOOP WIRE INSTALLATION PROCEDURES

- CONCRETE PAVEMENT JOINTS SHALL NOT BE USED FOR EITHER LOOP OR FEEDER WIRE. NO LOOPS ARE TO BE INSTALLED THROUGH, OVER, OR UNDER TRANSVERSE CONCRETE JOINTS IN CONCRETE PAVEMENT. NO MANHOLES, INLETS, VALVES, ETC. MAY BE LOCATED WITHIN A LOOP. IF JOINTS OR MANHOLES ARE ENCOUNTERED, THE LOCATION OF THE LOOP MAY BE VARIED SLIGHTLY AS DIRECTED BY THE ENGINEER. IF THE JOINTS OR MANHOLES ARE UNAVOIDABLE, SMALLER LOOPS, THE SIZE TO BE DETERMINED BY THE ENGINEER, MAY BE USED INSTEAD OF ONE LARGER LOOP AND SHALL PROVIDE THE SAME AREA OF COVERAGE AS THE LARGE LOOP. THE SMALLER LOOPS USED TO REPLACE THE ONE LARGE LOOP MAY BE CONNECTED TO ONE DETECTOR AMPLIFIER.
- WHEN A BEND OR CORNER IS REQUIRED THE SLOTS PRODUCING THE "WOULD-BE" RIGHT ANGLE SHALL NOT OVERLAP.
- WHEN A BEND OR CORNER IS REQUIRED THE SLOTS PRODUCING THE ANGLES APPROXIMATELY 45° SHALL OVERLAP THE SLOTS IT CONNECTS. THIS IS TO INSURE FULL DEPTH OF SLOTS AT BENDS OR CORNERS.
- ALL CORNERS OF THE LOOP SHALL BE CUT AT A 45° ANGLE AND HAVE A MINIMUM DIAGONAL LENGTH OF 16".
- SAW CUTS IN THE PAVEMENT SHALL BE FLUSHED WITH CLEAN WATER UNDER SUFFICIENT PRESSURE TO REMOVE MUD AND SMALL DEBRIS. SAW CUTS SHALL THEN BE DRIED AND CLEANED OF ALL DEBRIS BEFORE INSTALLING THE LOOP WIRE.
- ONE CONTINUOUS, UNBROKEN LENGTH OF WIRE SHALL BE USED TO FORM A LOOP OF THE NUMBER OF TURNS AS SPECIFIED IN THE PLANS. THE CONTINUOUS RUN SHALL BE FROM THE PULLBOX/CONDULET INCLUDING THE LOOP AND RETURN.
- ALL WIRE SHALL BE PUSHED INTO THE SAW CUT WITH WOOD STICKS TO INSURE THE INSULATION IS NOT DAMAGED. THE USE OF METAL TOOLS IS NOT PERMITTED.
- SPLICE BETWEEN LEAD-IN AND SHIELDED CABLE REQUIRED IN PULLBOX OR CONDULET. ALL SPLICES IN THE LEAD-IN WIRE SHALL BE MADE ONLY IN THE PULLBOX OR CONDULET. ALL SPLICES MUST BE CAREFULLY MADE TO INSURE CONSTANT LOW RESISTANCE AND MUST BE INSULATED IN SUCH A MANNER THAT UNDER THE LOCAL PREVAILING CONDITIONS THE INSTALLATION MAINTAINS A RESISTANCE TO GROUND OF NOT LESS THAN 5 MEGOHMS. TO INSURE CONSISTENT LOW RESISTANCE CONNECTIONS, THE SPLICES SHALL BE SOLDERED WITH RESIN FILLED SOLDER AND WATERPROOFED BY SHRINK WRAP OR BY OTHER METHOD APPROVED BY THE ENGINEER. OPEN FLAME SOLDER SHALL NOT BE PERMITTED.
- WHERE THE WIRES LEAVE THE LOOP, EACH PAIR OF LEAD-IN WIRES MUST BE TWISTED TOGETHER WITH A MINIMUM OF THREE TWISTS PER FOOT.
- IF THE LEAD-IN IS TAKEN OVERHEAD THE WIRE MUST BE PROTECTED BY CONDUIT (TYPE I) FROM UNDERGROUND TO SPAN.
- WHEN A PULLBOX IS NOT USED IN THE LEAD-IN (THE WIRE WHICH CONNECTS THE SENSING LOOP TO THE DETECTOR AMPLIFIER), THE LOOP WIRE SHALL BE TWISTED A MINIMUM OF THREE TURNS PER FOOT FROM THE LOOP TO THE DETECTOR AMPLIFIER.

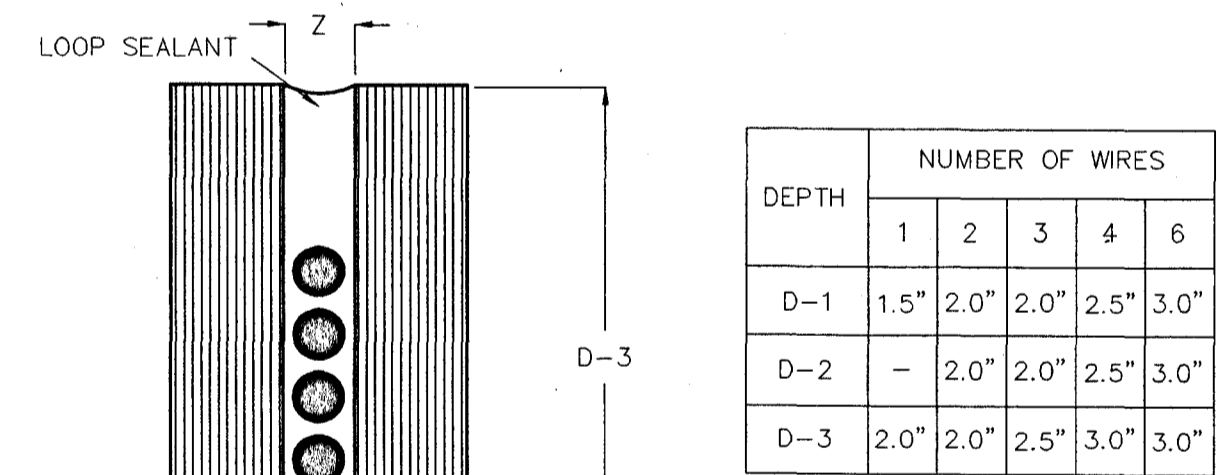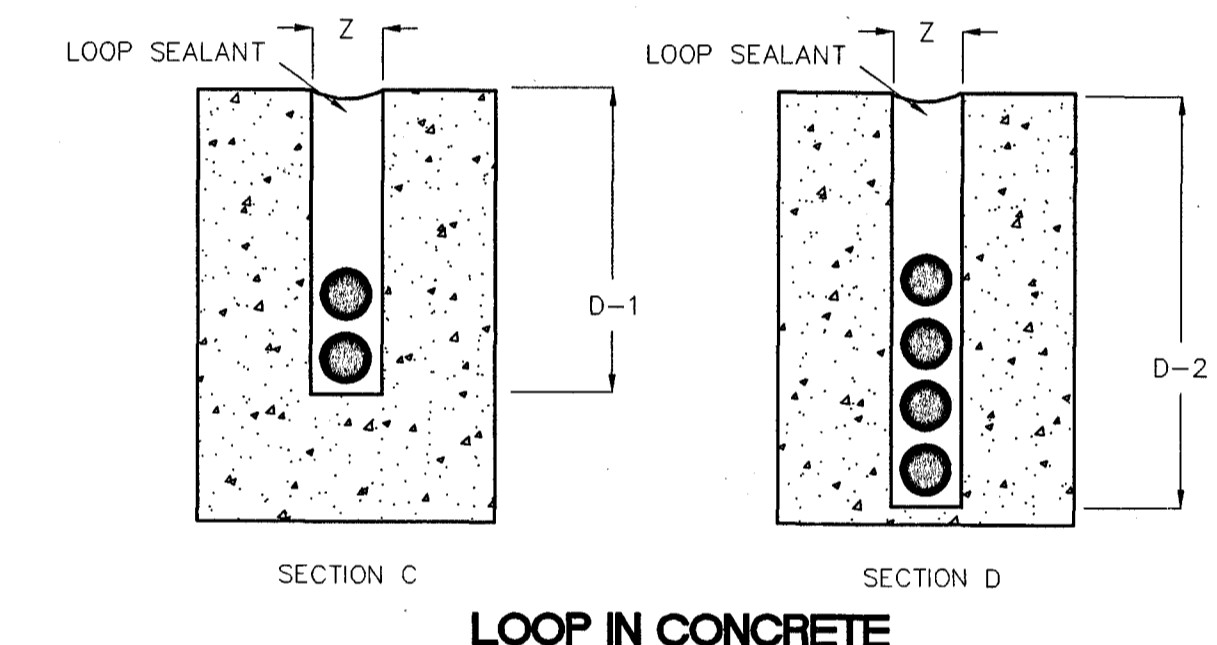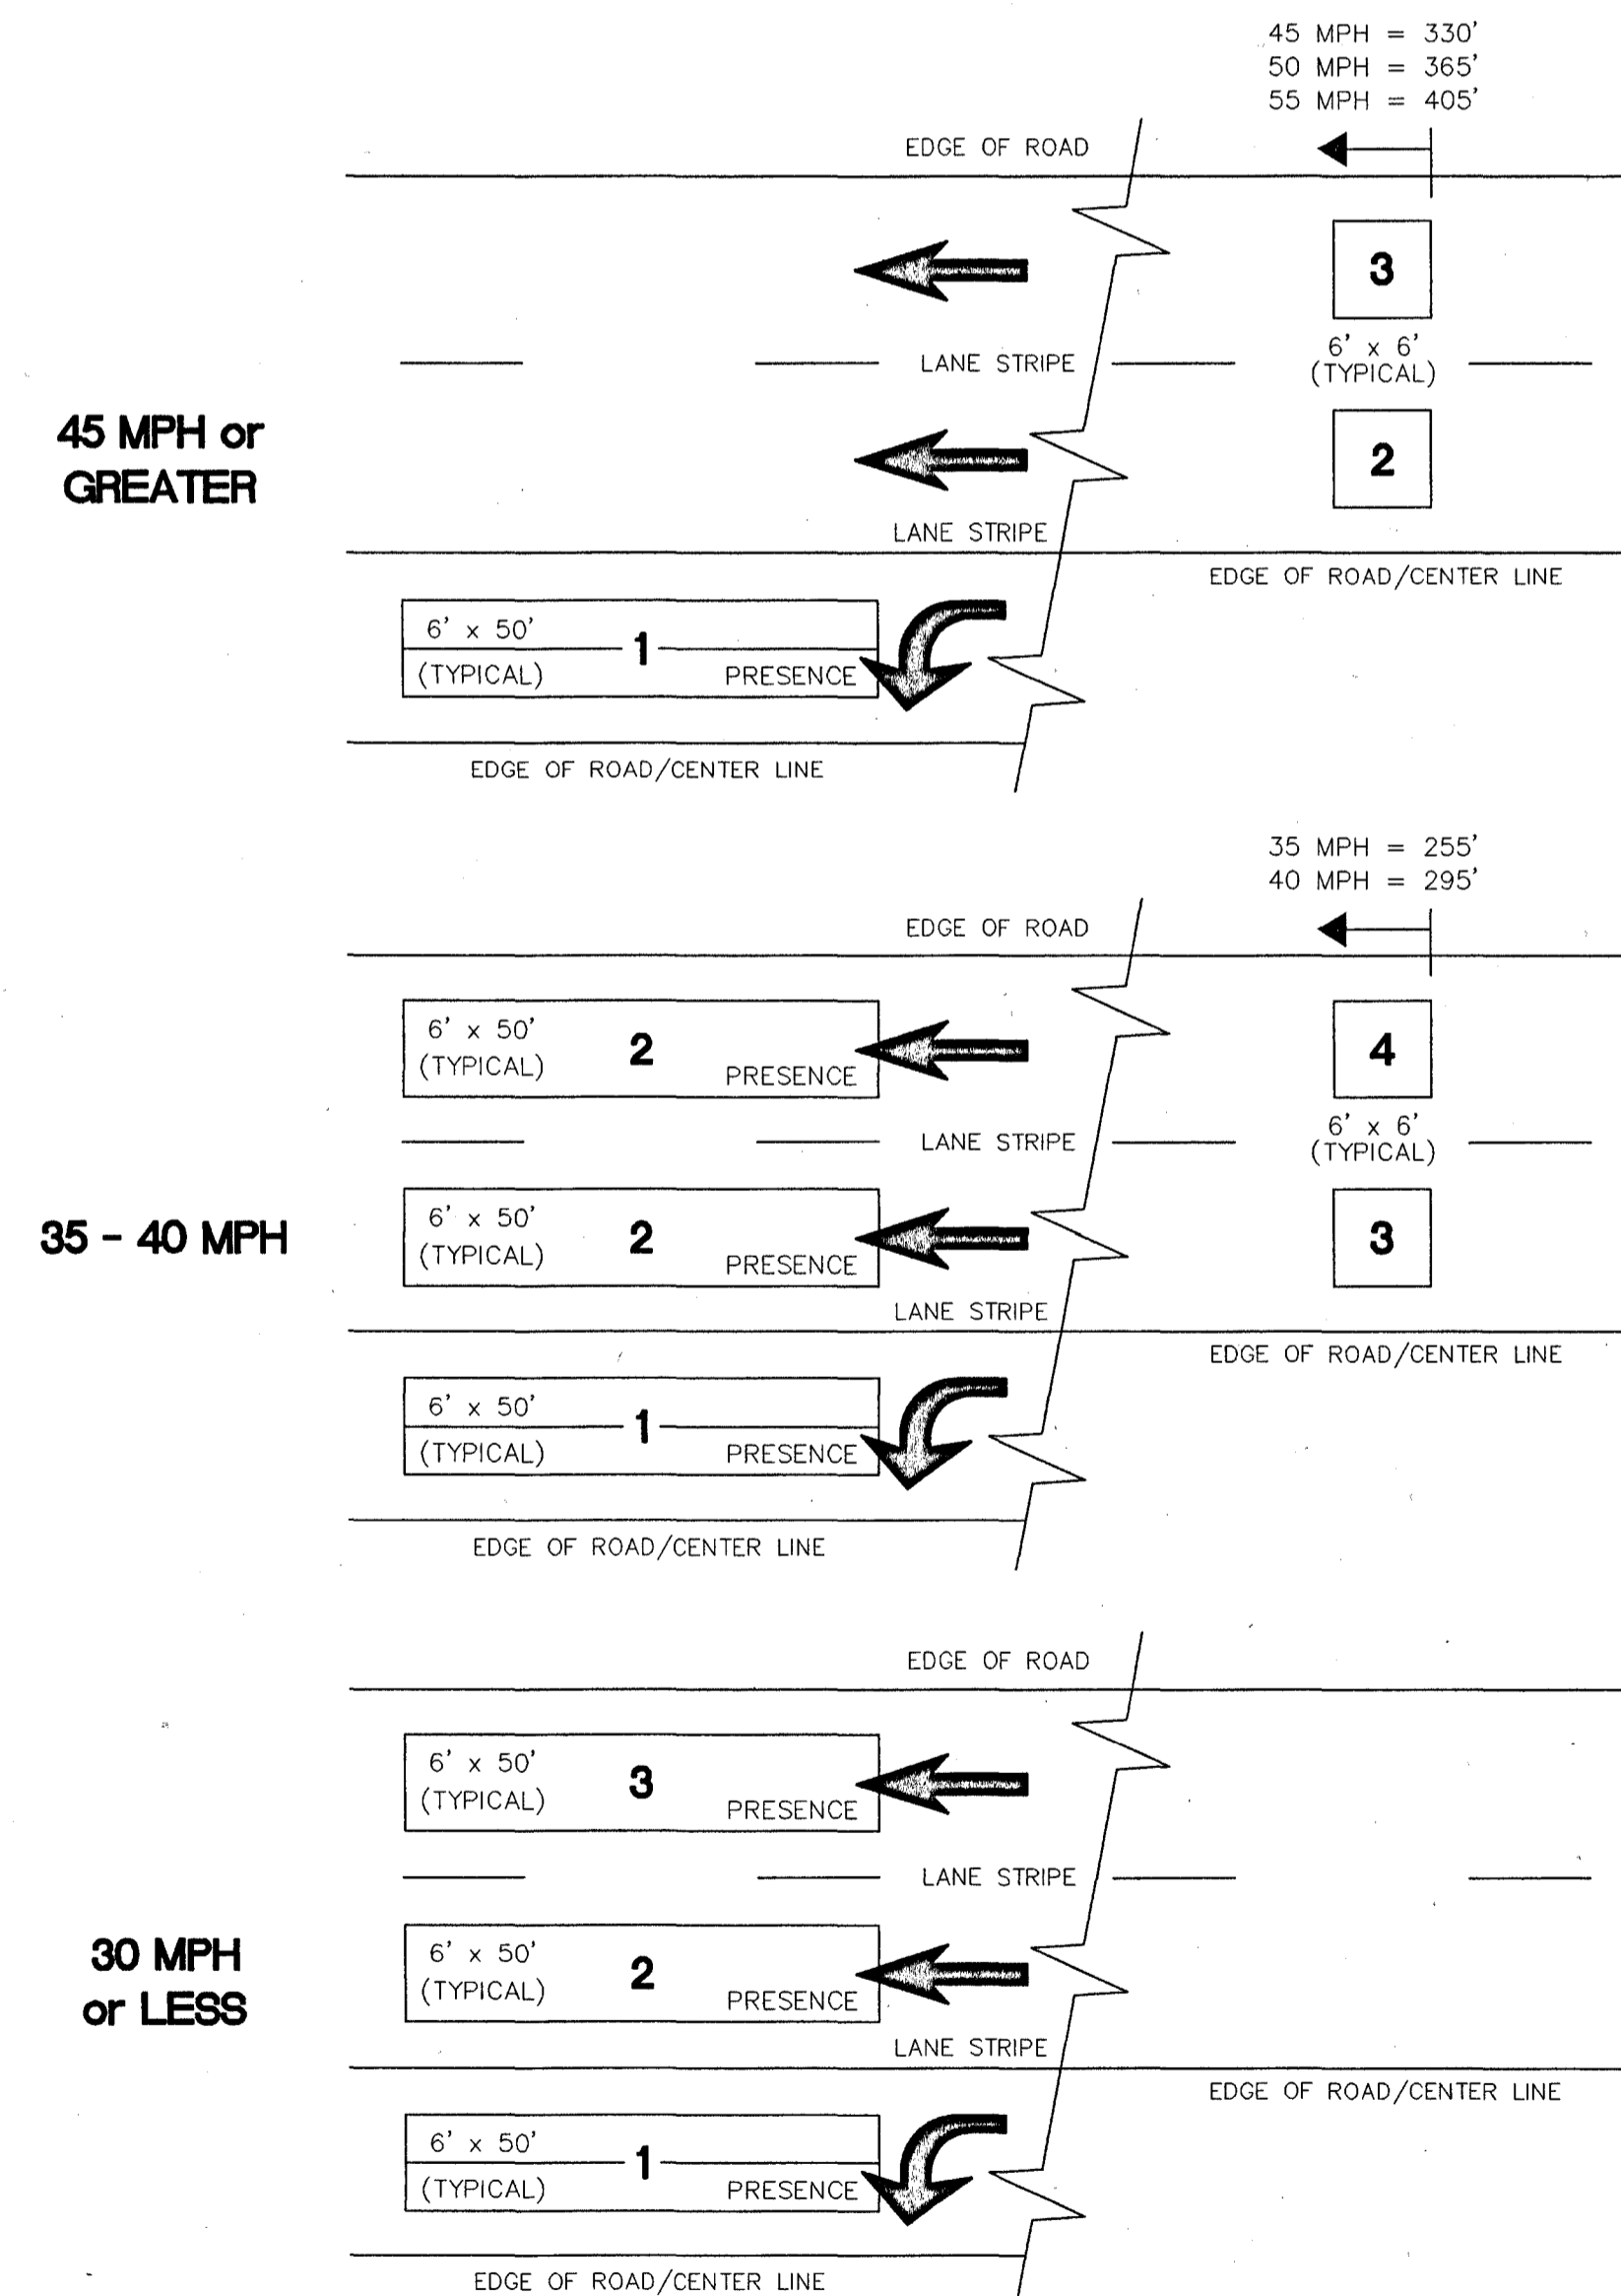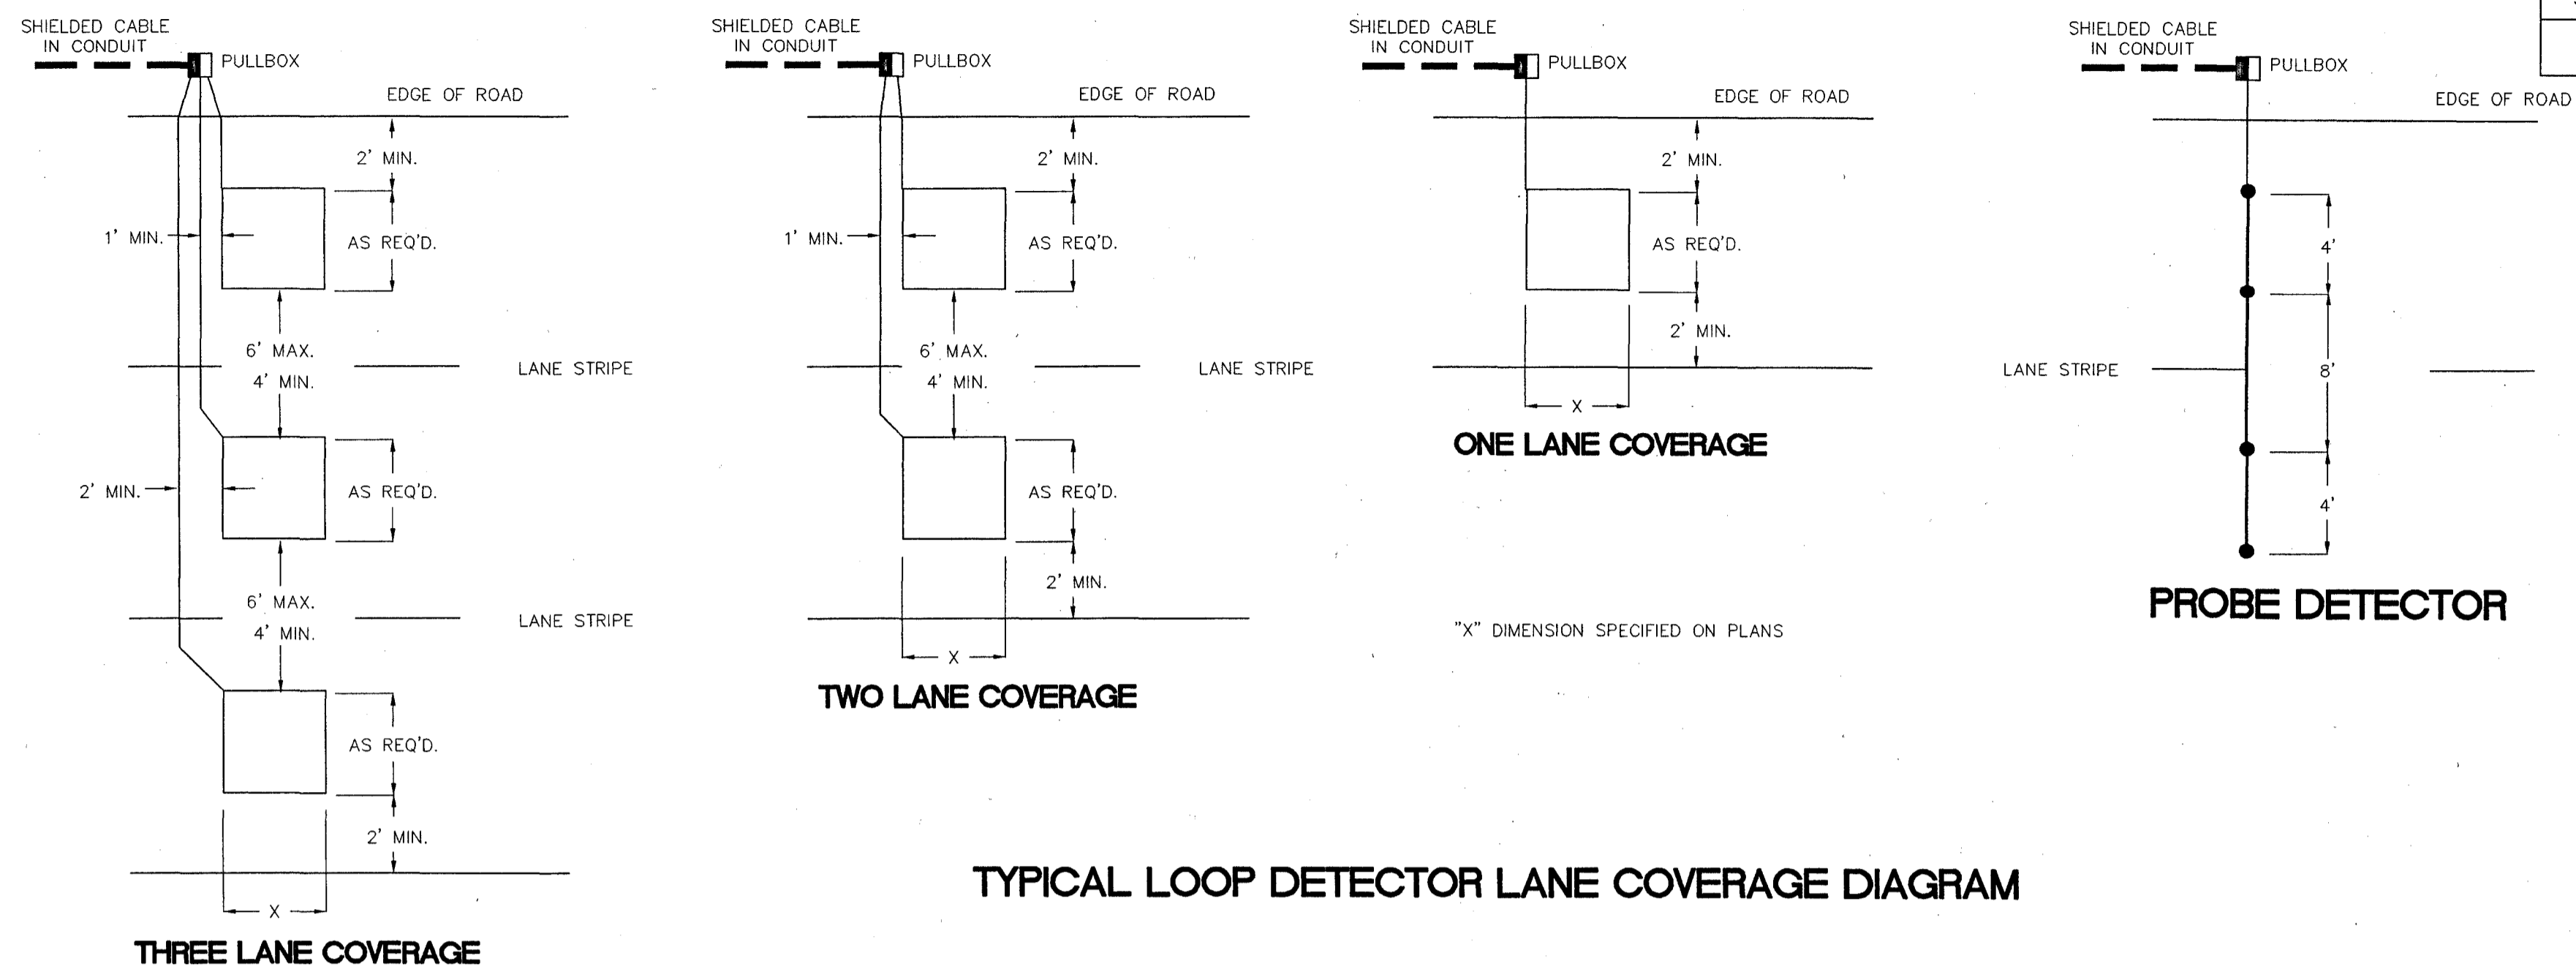

DEPTH	NUMBER OF WIRES				
	1	2	3	4	6
D-1	1.5"	2.0"	2.0"	2.5"	3.0"
D-2	-	2.0"	2.0"	2.5"	3.0"
D-3	2.0"	2.0"	2.5"	3.0"	3.0"

"Z" DIMENSION SHALL BE WIDE ENOUGH TO ACCOMMODATE LOOP WIRE WITHOUT CHAFING THE INSULATION (5/16" NOMINAL).

SAW SLOT DETAIL

TYPICAL LOOP DETECTOR PLACEMENT DIAGRAM

3 = CHANNEL NUMBER
 MPH IS BASED ON SPEED LIMIT
 ALL DISTANCES FROM STOPLINE
 AMP 1-#2, AMP 2-#4, AMP 3-#6, AMP 4-#8

REVISION DATE		VEHICLE LOOP DETECTOR ASSEMBLY OLD CANTON ROAD RECONSTRUCTION PROJECT NO.: STP-6926-00(001) CITY OF RIDGELAND, MISSISSIPPI		WORKING NUMBER
		WAGGONER ENGINEERING, INC. Consulting Engineers - Jackson, MS		SHEET NUMBER
		DRAWN BY: BHB REVIEWED BY: BS	DATE: 03-06-01 SCALE: 1"=20'	

NOTE: BOLLARDS ARE IN "EARTH" ALONG OLD CANTON ROAD.
 "HINGED" BOLLARDS ARE LOCATED AT ALL RICE ROAD INTERSECTION LOCATIONS. (SEE DETAIL)

- NOTE:
1. ALL CONCRETE SHALL MEET THE REQUIREMENTS OF SECTION 601.
 2. ALL LUMBER SHALL MEET THE REQUIREMENTS OF SECTIONS 718 AND 820.
 3. ALL STEEL SHALL MEET THE REQUIREMENTS OF SECTION 810, 718 AND 820.
 4. ALL ITEMS ON THIS SHEET RELATED TO EARTH BOLLARDS ARE TO BE INCLUDED IN PAY ITEM #907-630-N-PP
 5. ALL ITEMS ON THIS SHEET RELATED TO HINGED BOLLARDS ARE TO BE INCLUDED IN PAY ITEM #907-630-O-PP & #907-630-P-PP

NOTE: BOLLARD POST TO BE REFLECTORIZED.


BOLLARD FOOTING TO BE PLACED PRIOR TO FINAL SURFACE COURSE.

BOLLARD PLACEMENT OFFSET FROM INTERSECTIONS IS NOTED IN PLANS.


BOLLARDS TO BE INSTALLED BY THE CONTRACTOR.

ALL THREE BOLLARDS AT PEAR ORCHARD ROAD BRIDGE-ENDS ARE TO BE "BOLLARD IN EARTH" (SEE DETAIL)


BOLLARDS AND POSTS ARE TO BE PRESSURE-TREATED AND GROUND CONTACT RATED

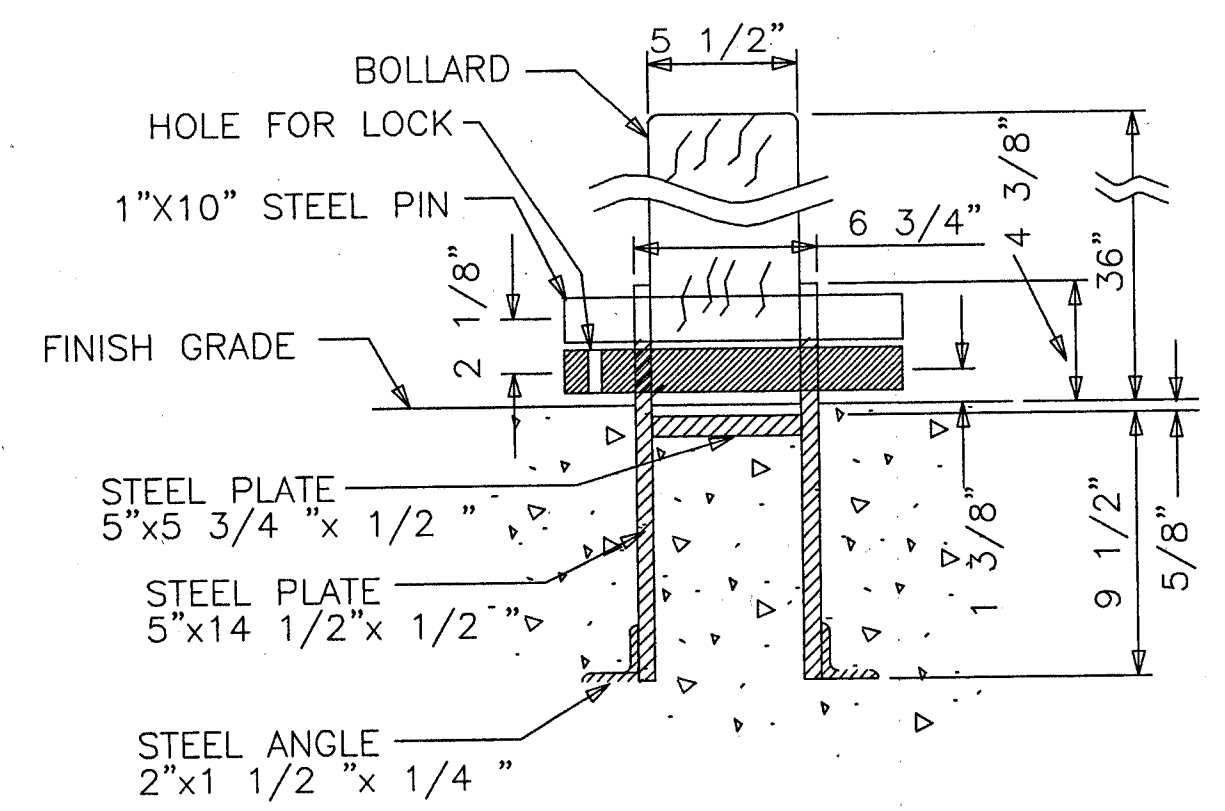


HINGED BARRIER BOLLARD
SECTION THROUGH LOCK PIN

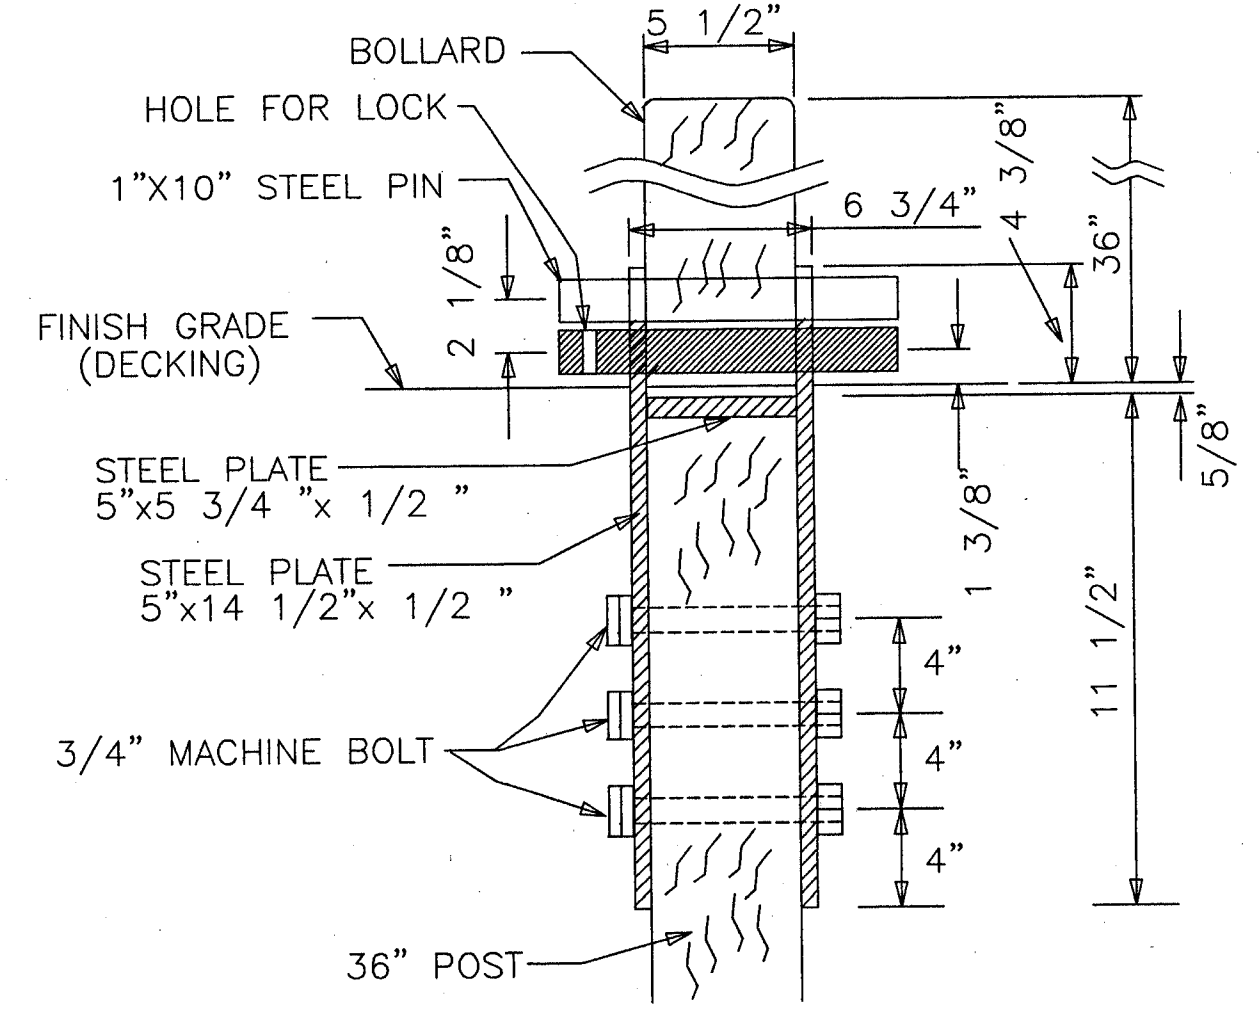


HINGED BARRIER BOLLARD
SECTION THROUGH LOCK PIN

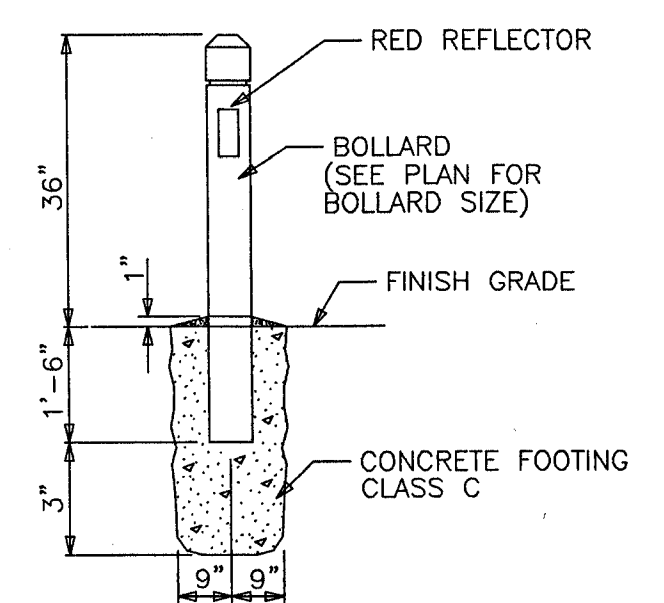


DETAIL
BOLLARD IN EARTH

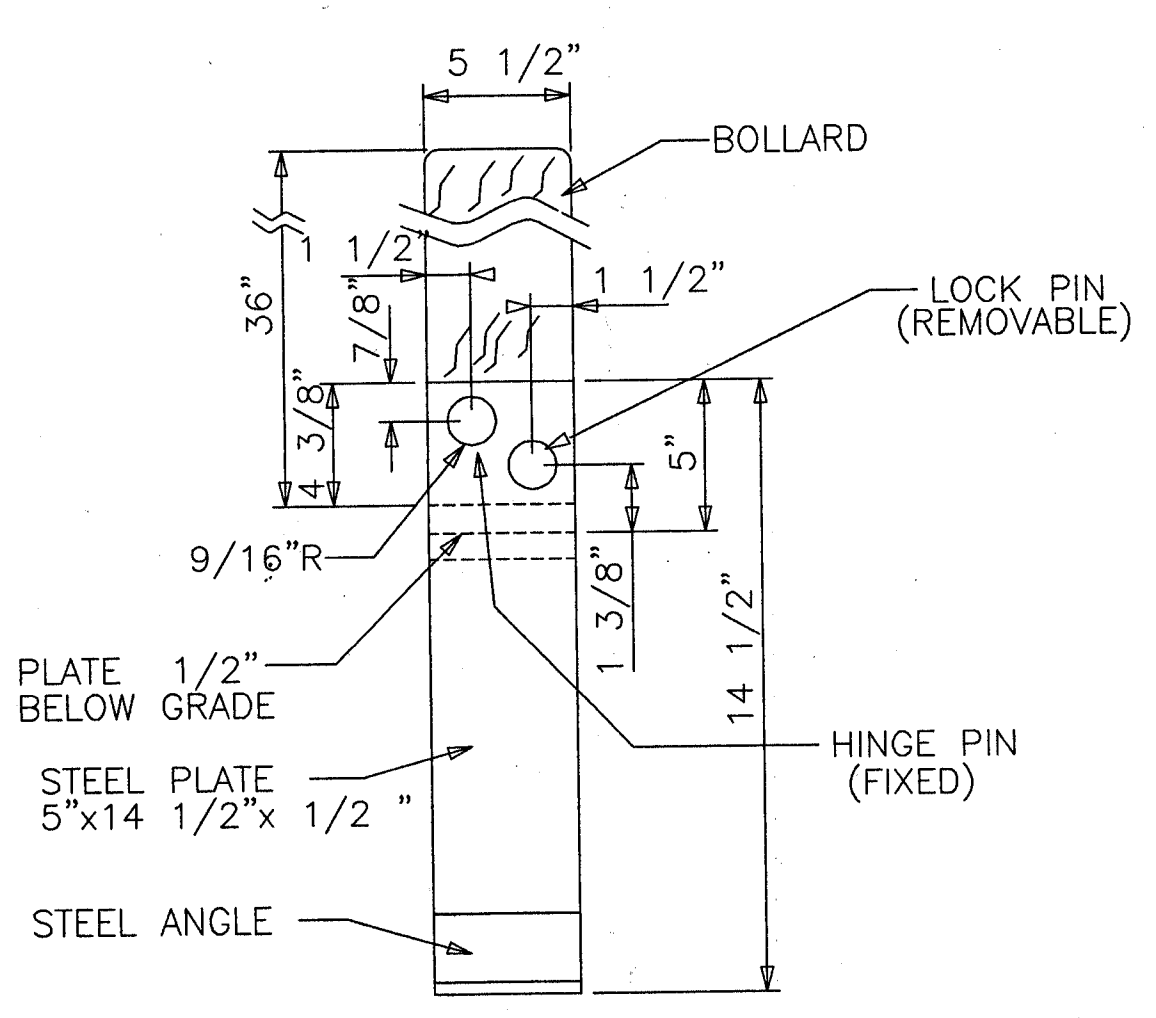


HINGED BARRIER BOLLARD
RIGHT SIDE ELEVATION

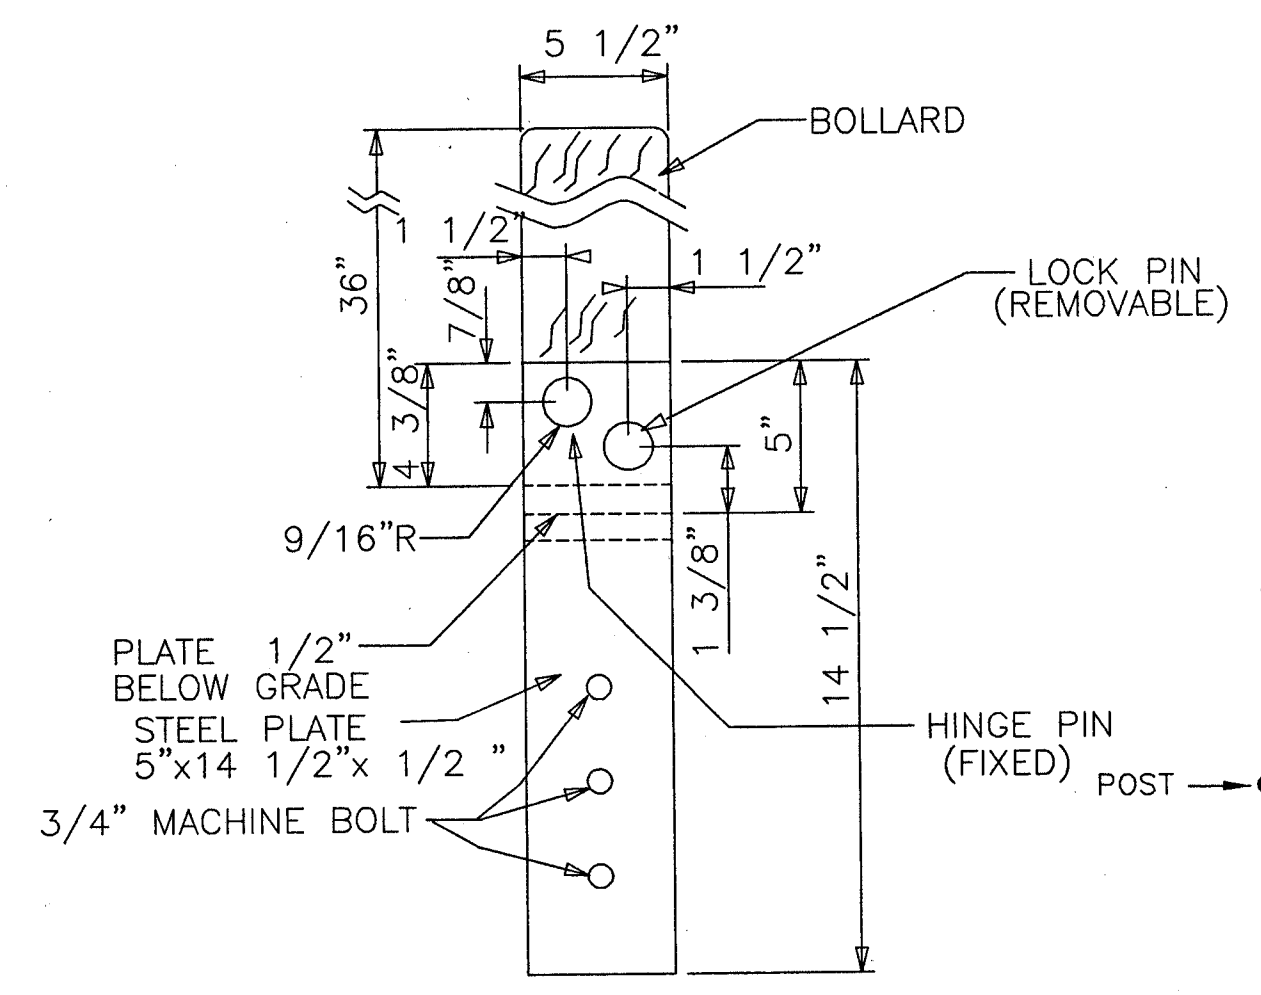


HINGED BARRIER BOLLARD
RIGHT SIDE ELEVATION

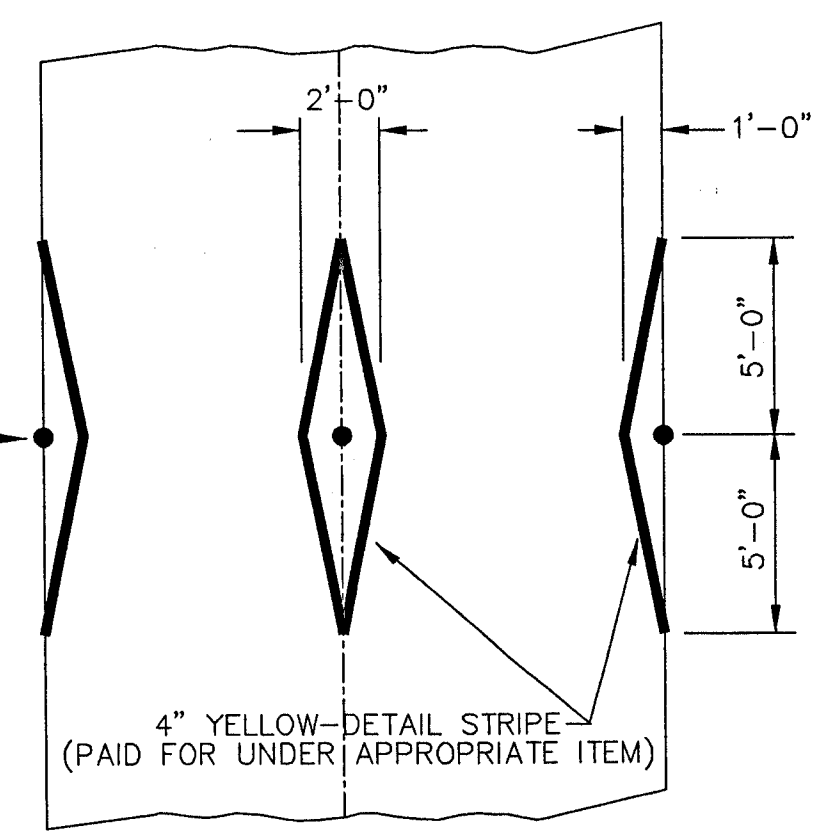


MARKING DETAIL

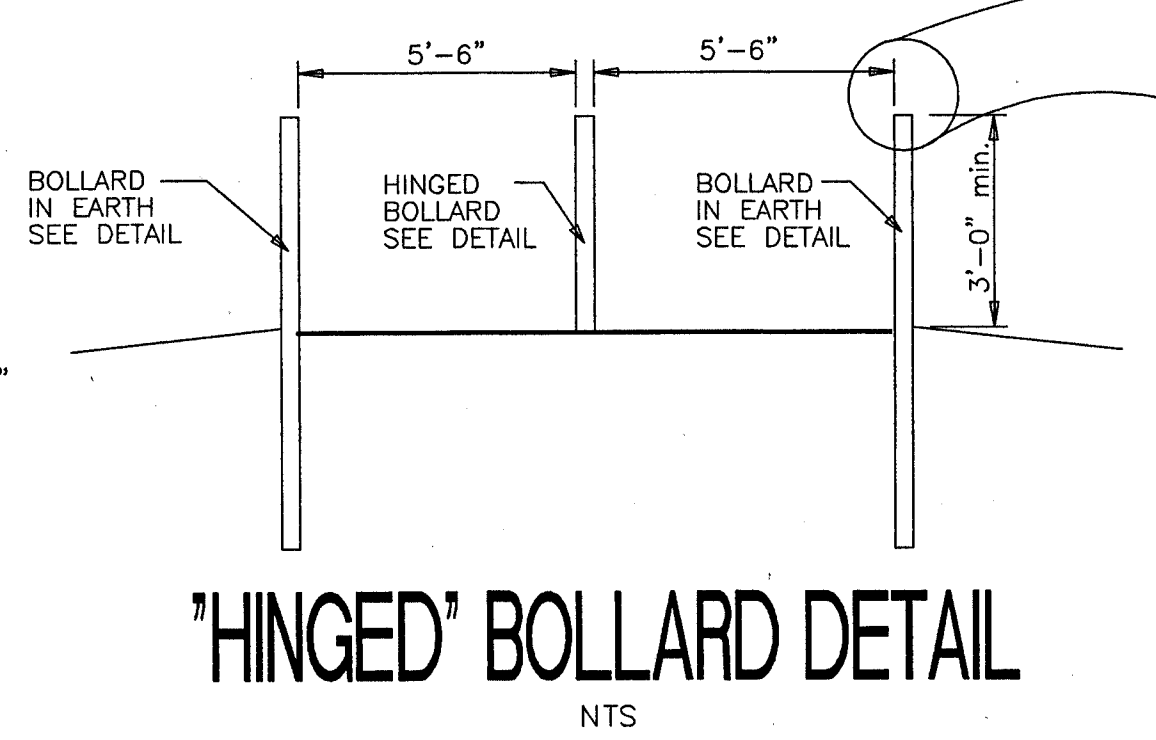


"HINGED" BOLLARD DETAIL
NTS

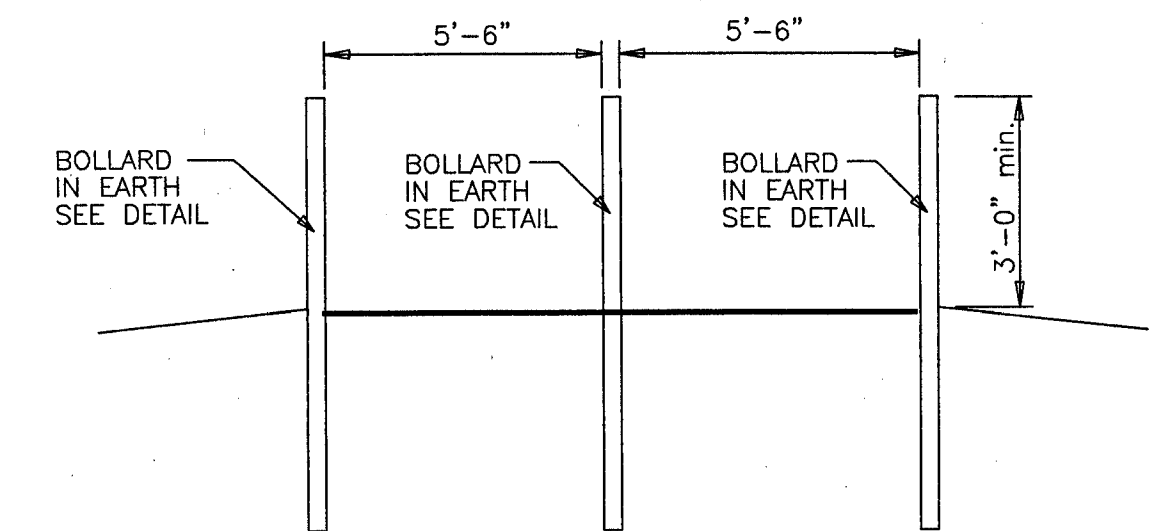


"EARTH" BOLLARD DETAIL
NTS

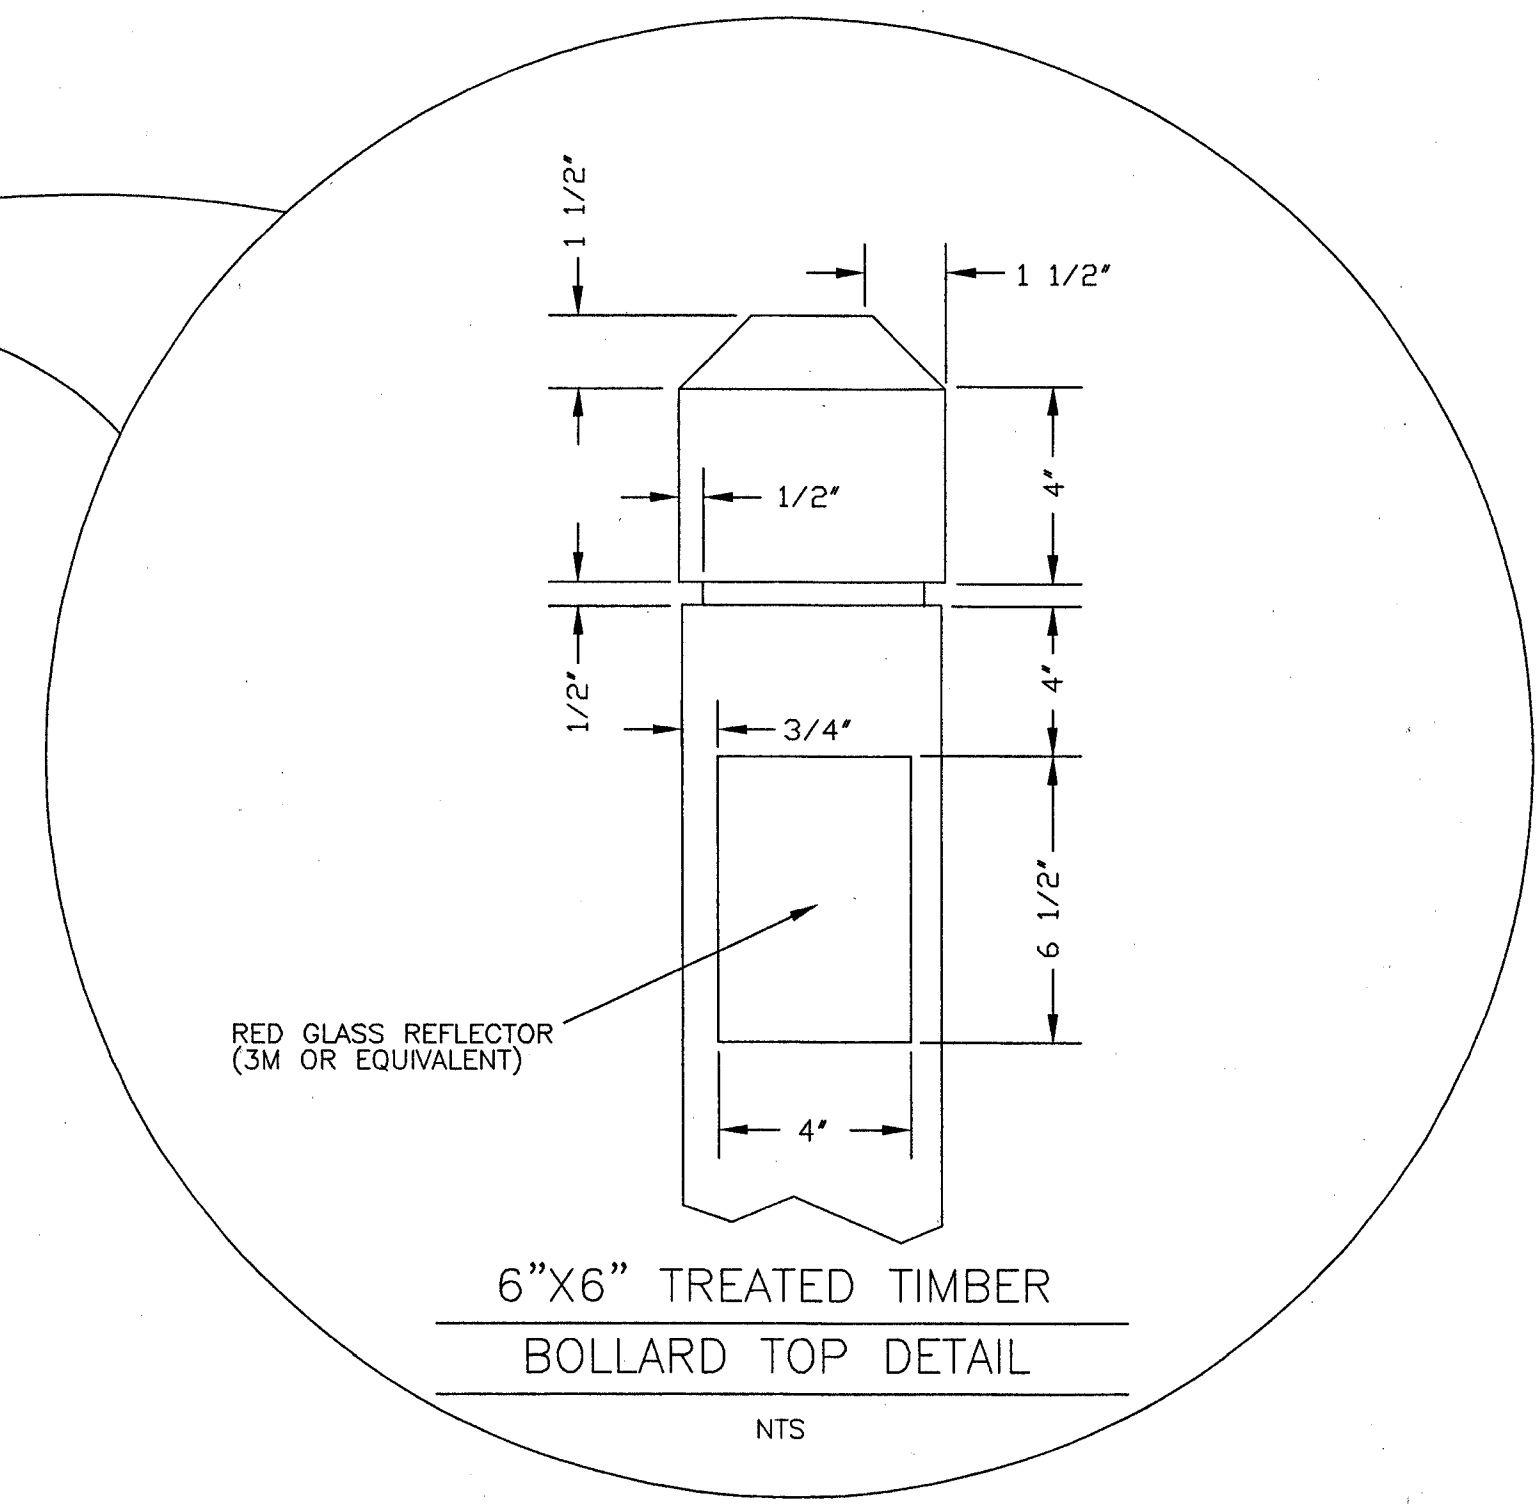

6"x6" TREATED TIMBER
BOLLARD TOP DETAIL
NTS

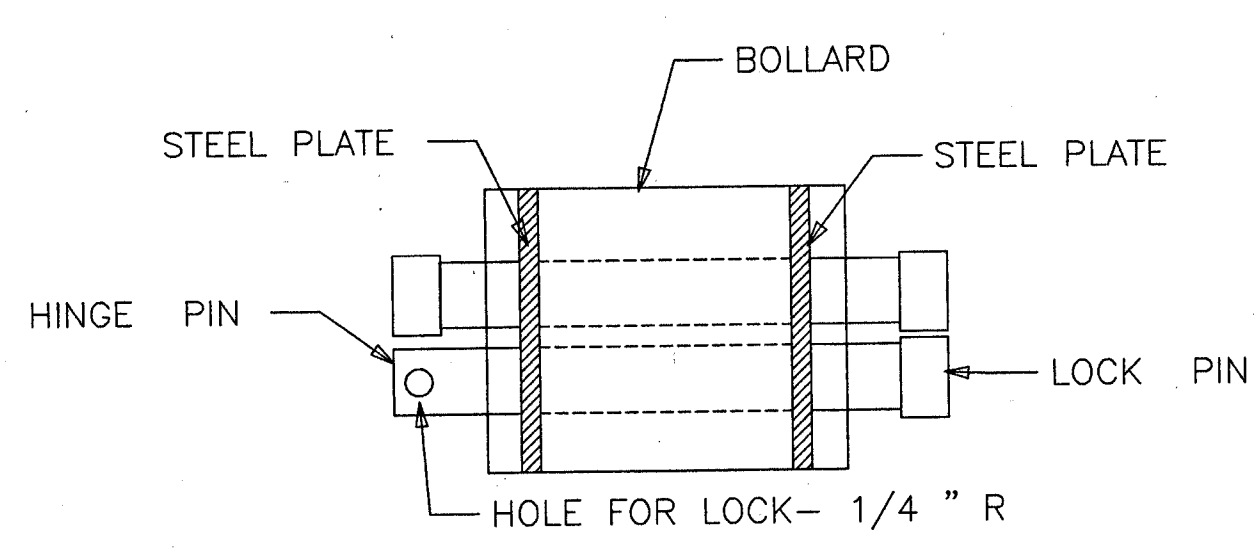

HINGED BARRIER BOLLARD
PLAN VIEW

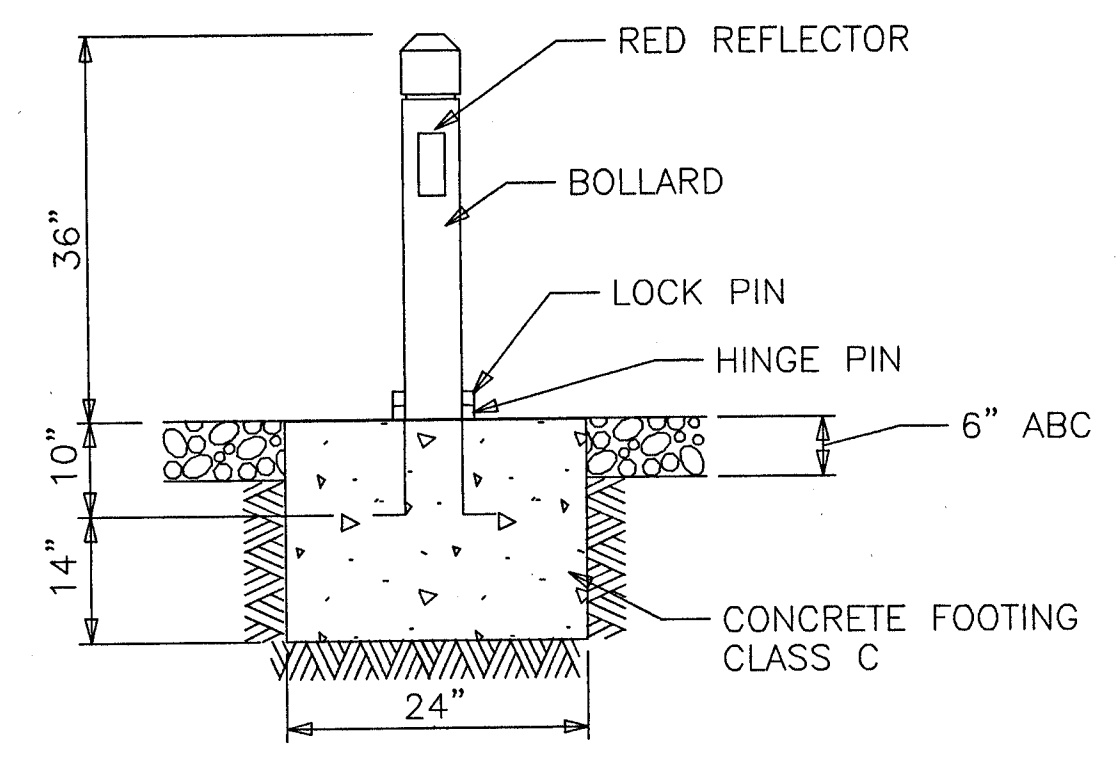

HINGED BARRIER BOLLARD







REVISION		DATE	

**BIKEPATH
BOLLARD DETAILS**

**OLD CANTON ROAD RECONSTRUCTION
PROJECT NO.: STP-6926-00(001)
CITY OF RIDGELAND, MISSISSIPPI**

DRAWN BY: BHB	DATE: 03-06-01
REVIEWED BY: BS	SCALE: N.T.S.

WAGGONER ENGINEERING, INC. Consulting Engineers - Jackson, MS	WORKING NUMBER
	SHEET NUMBER

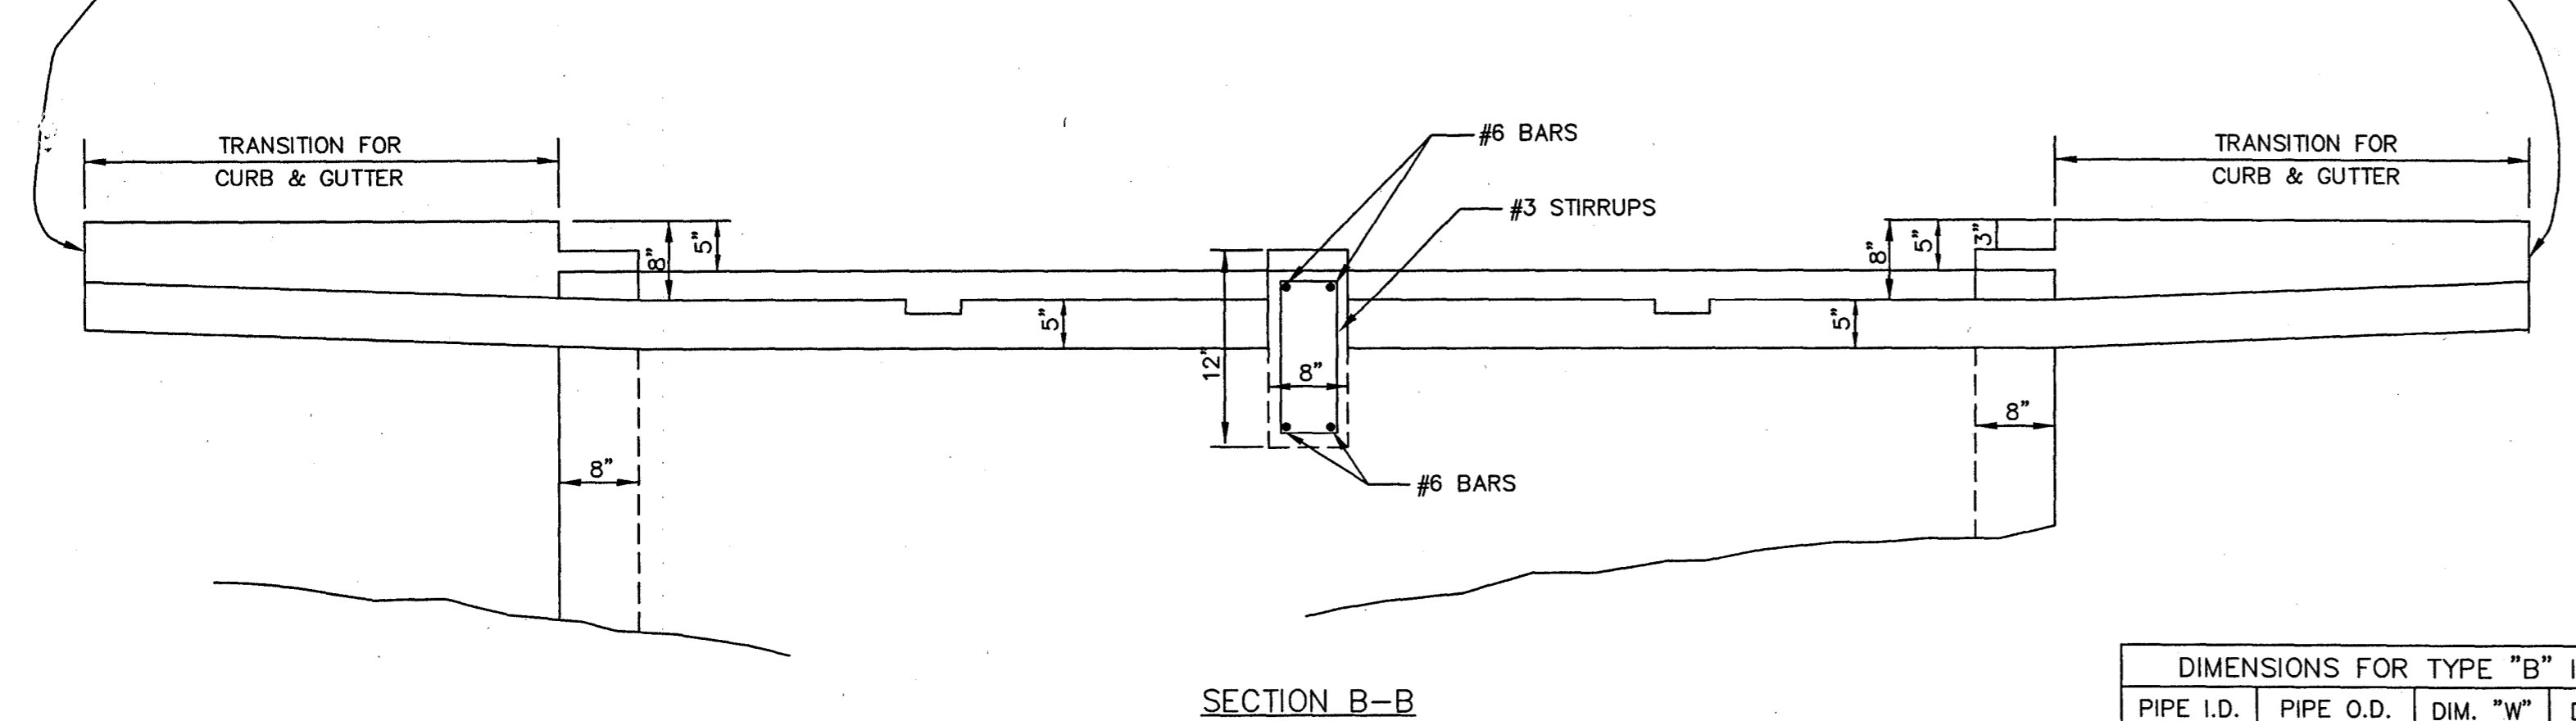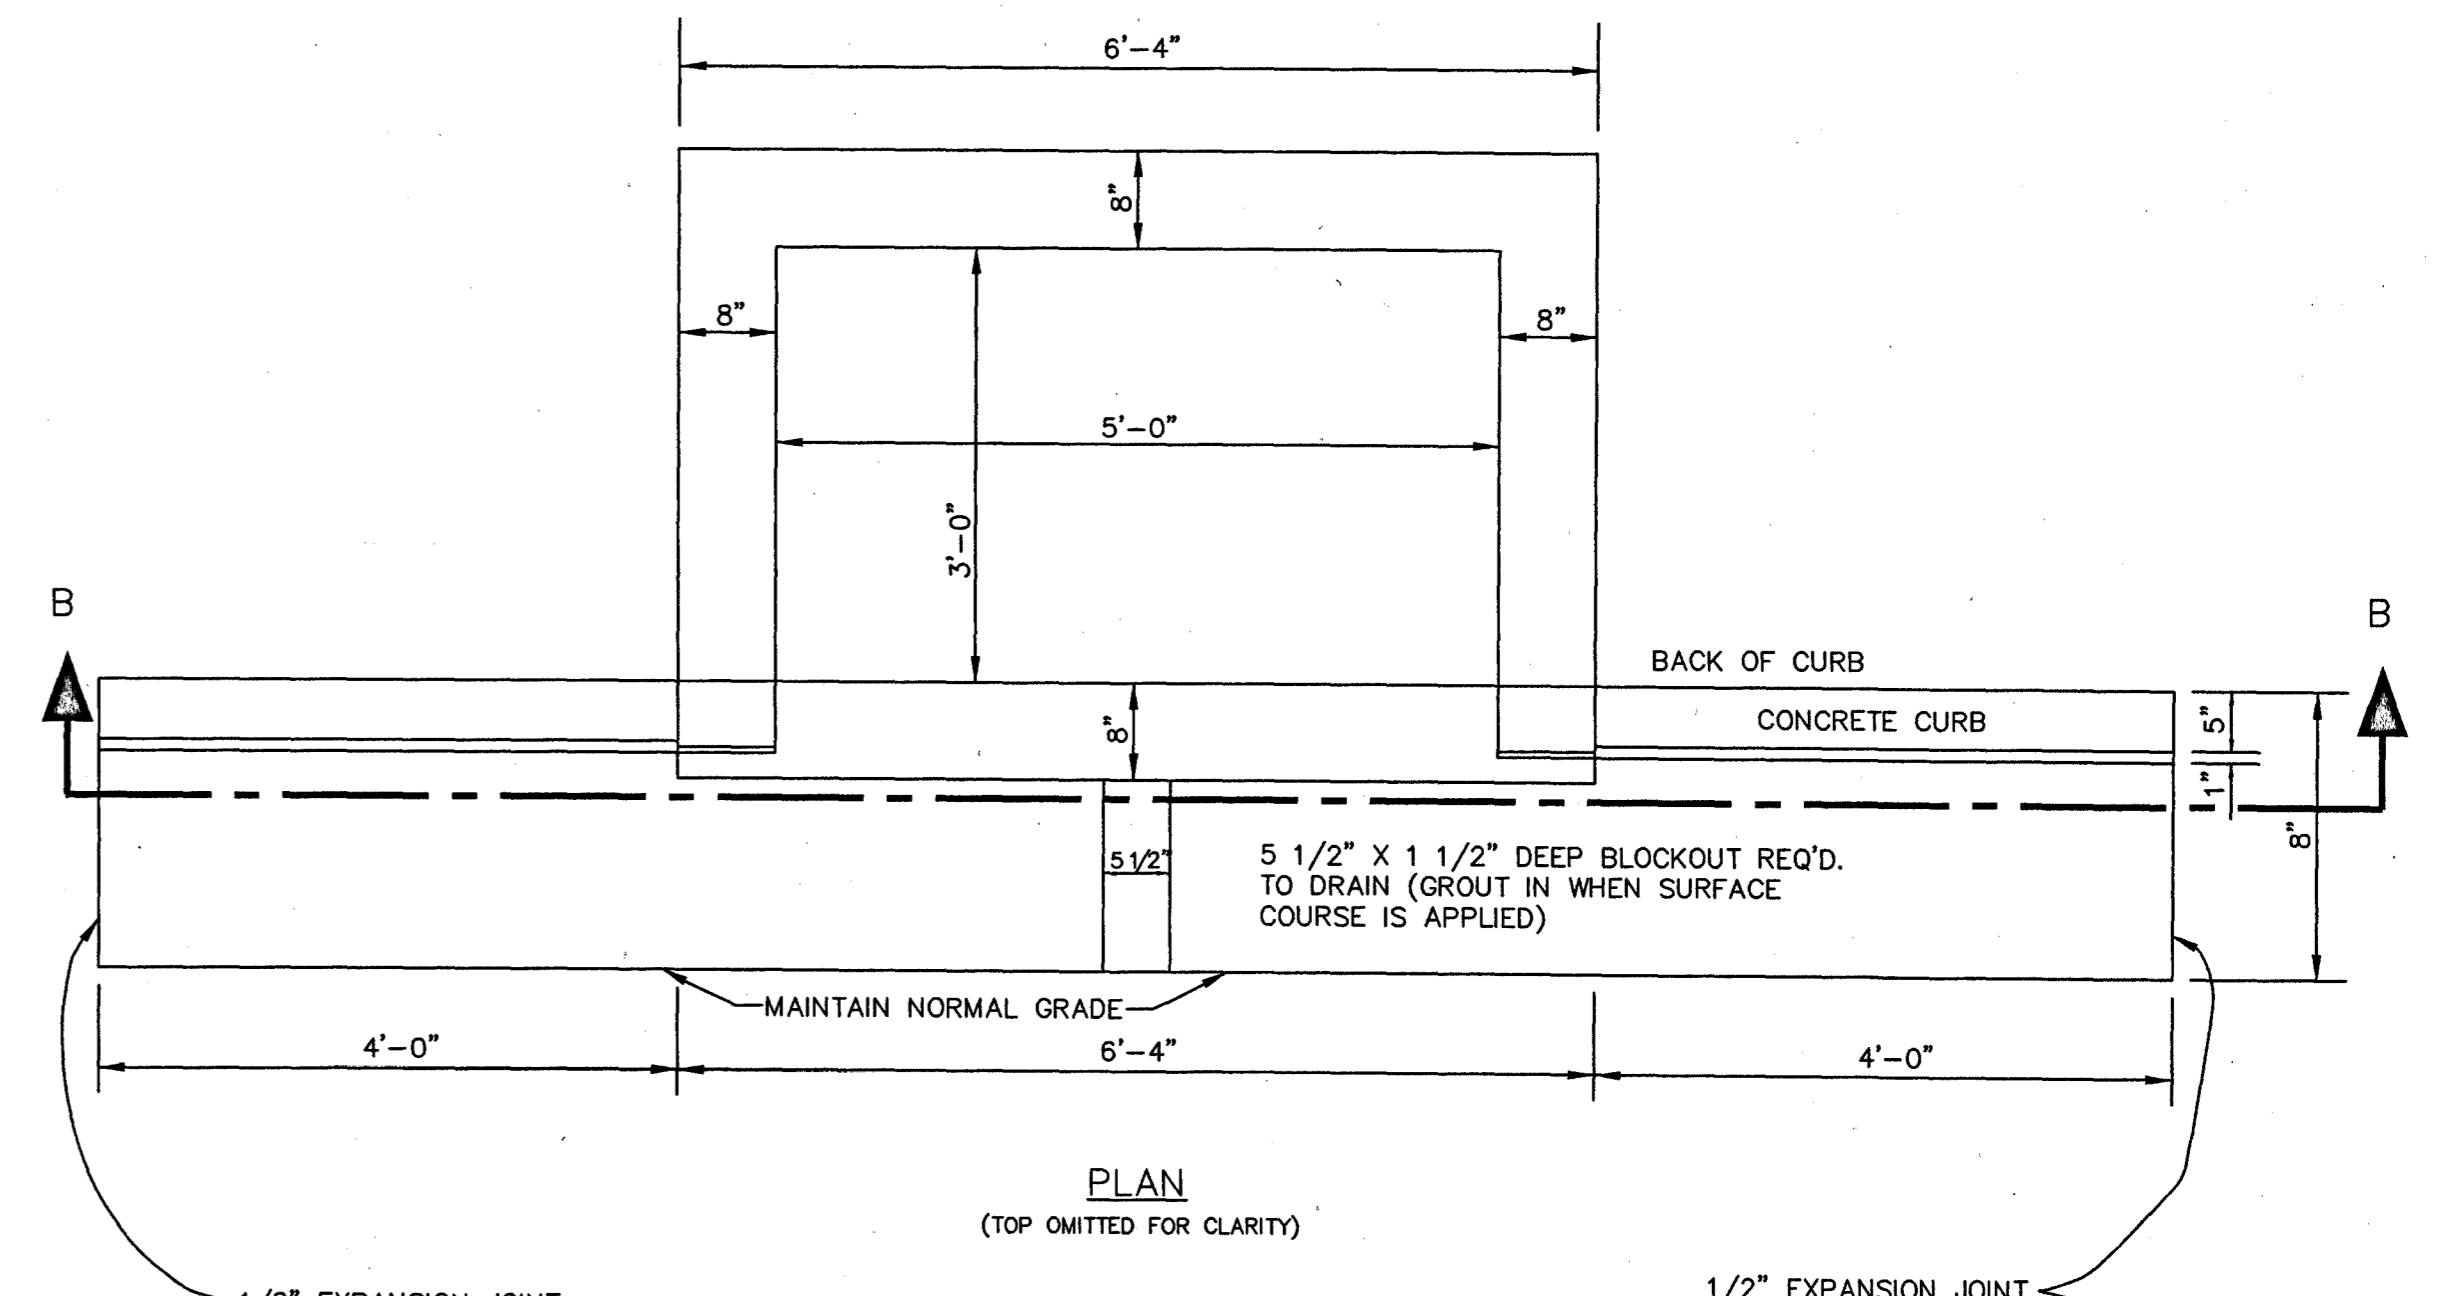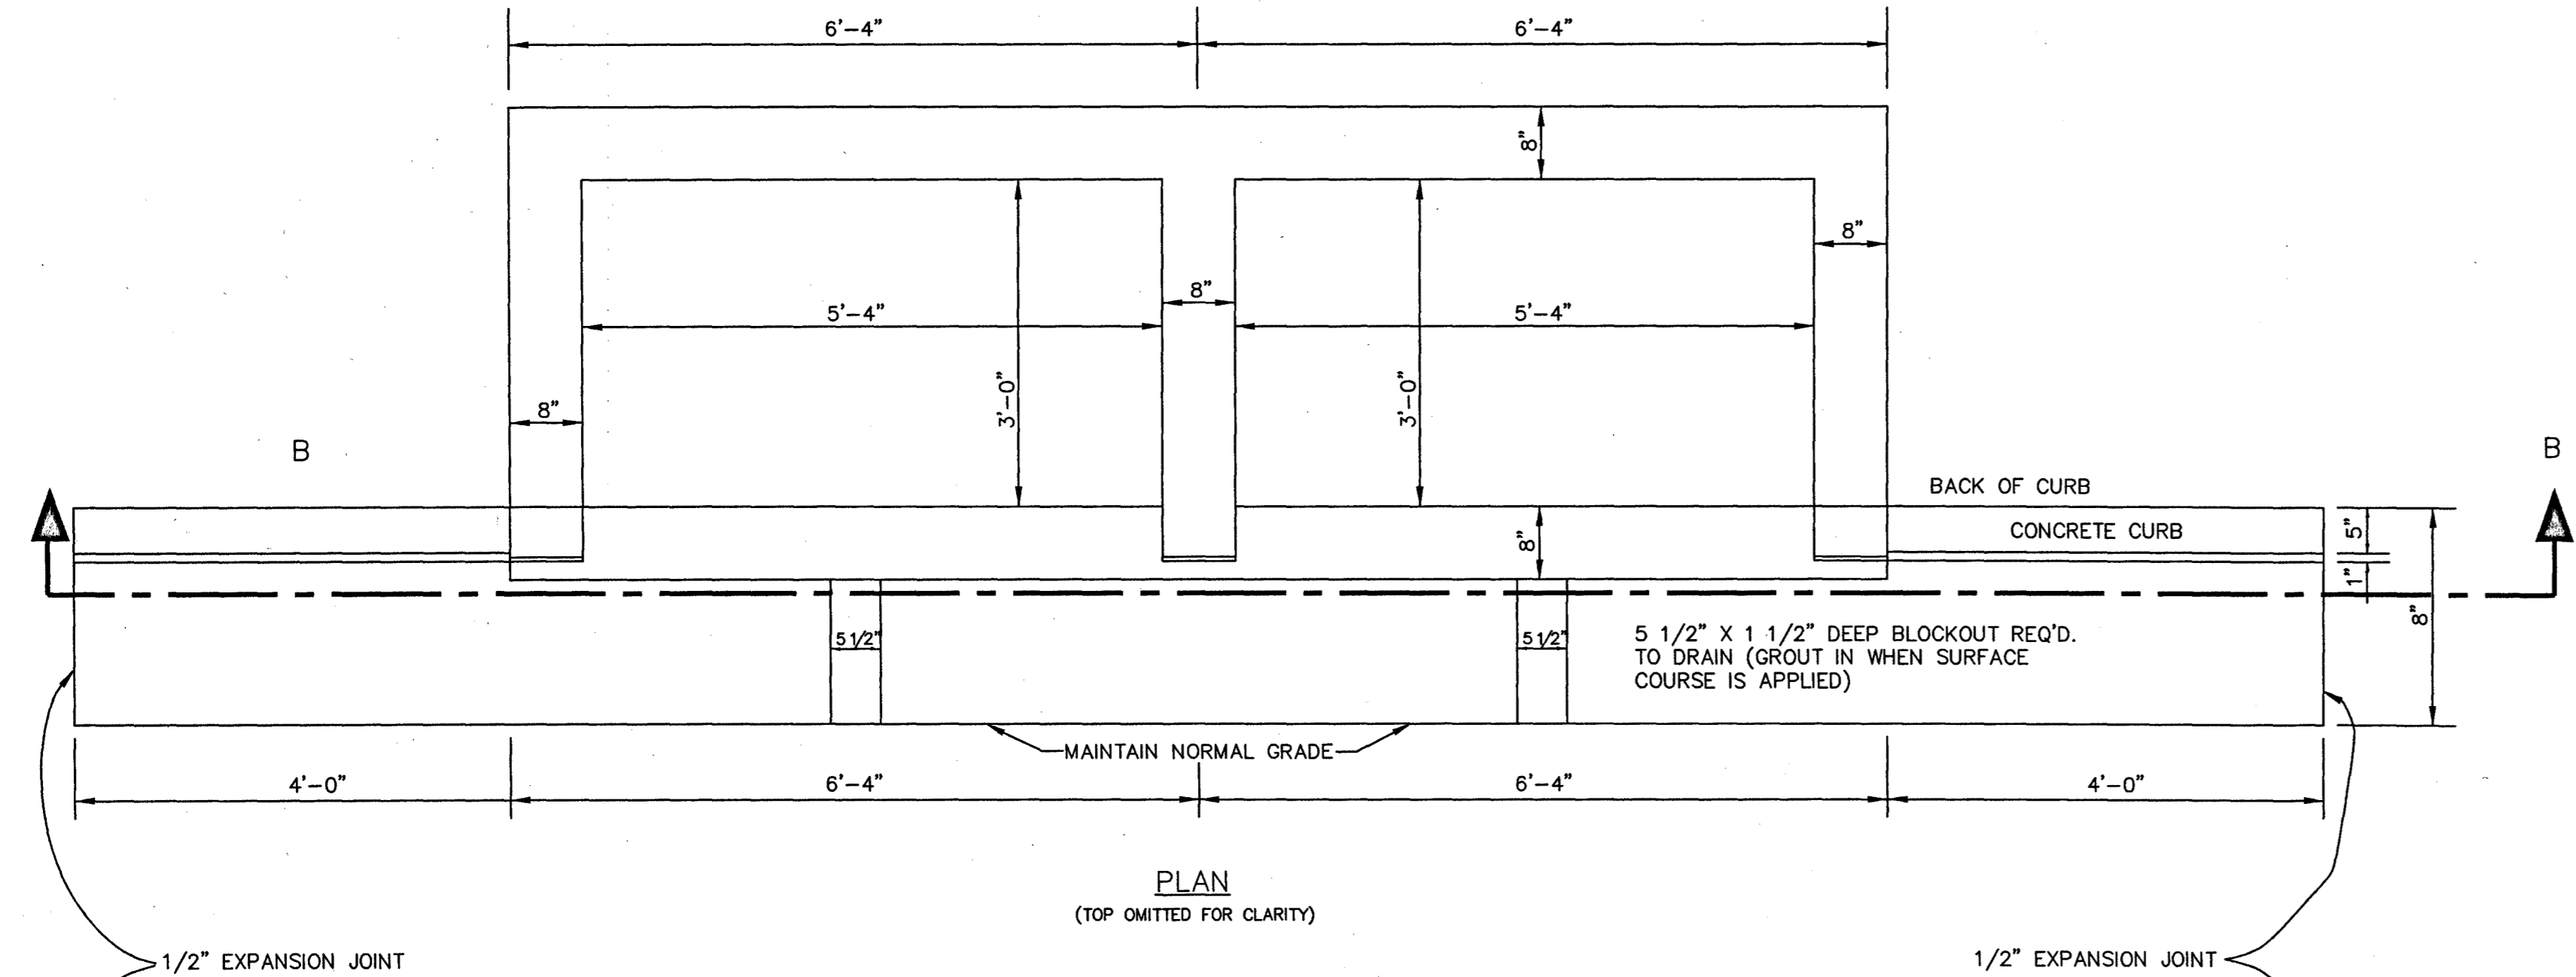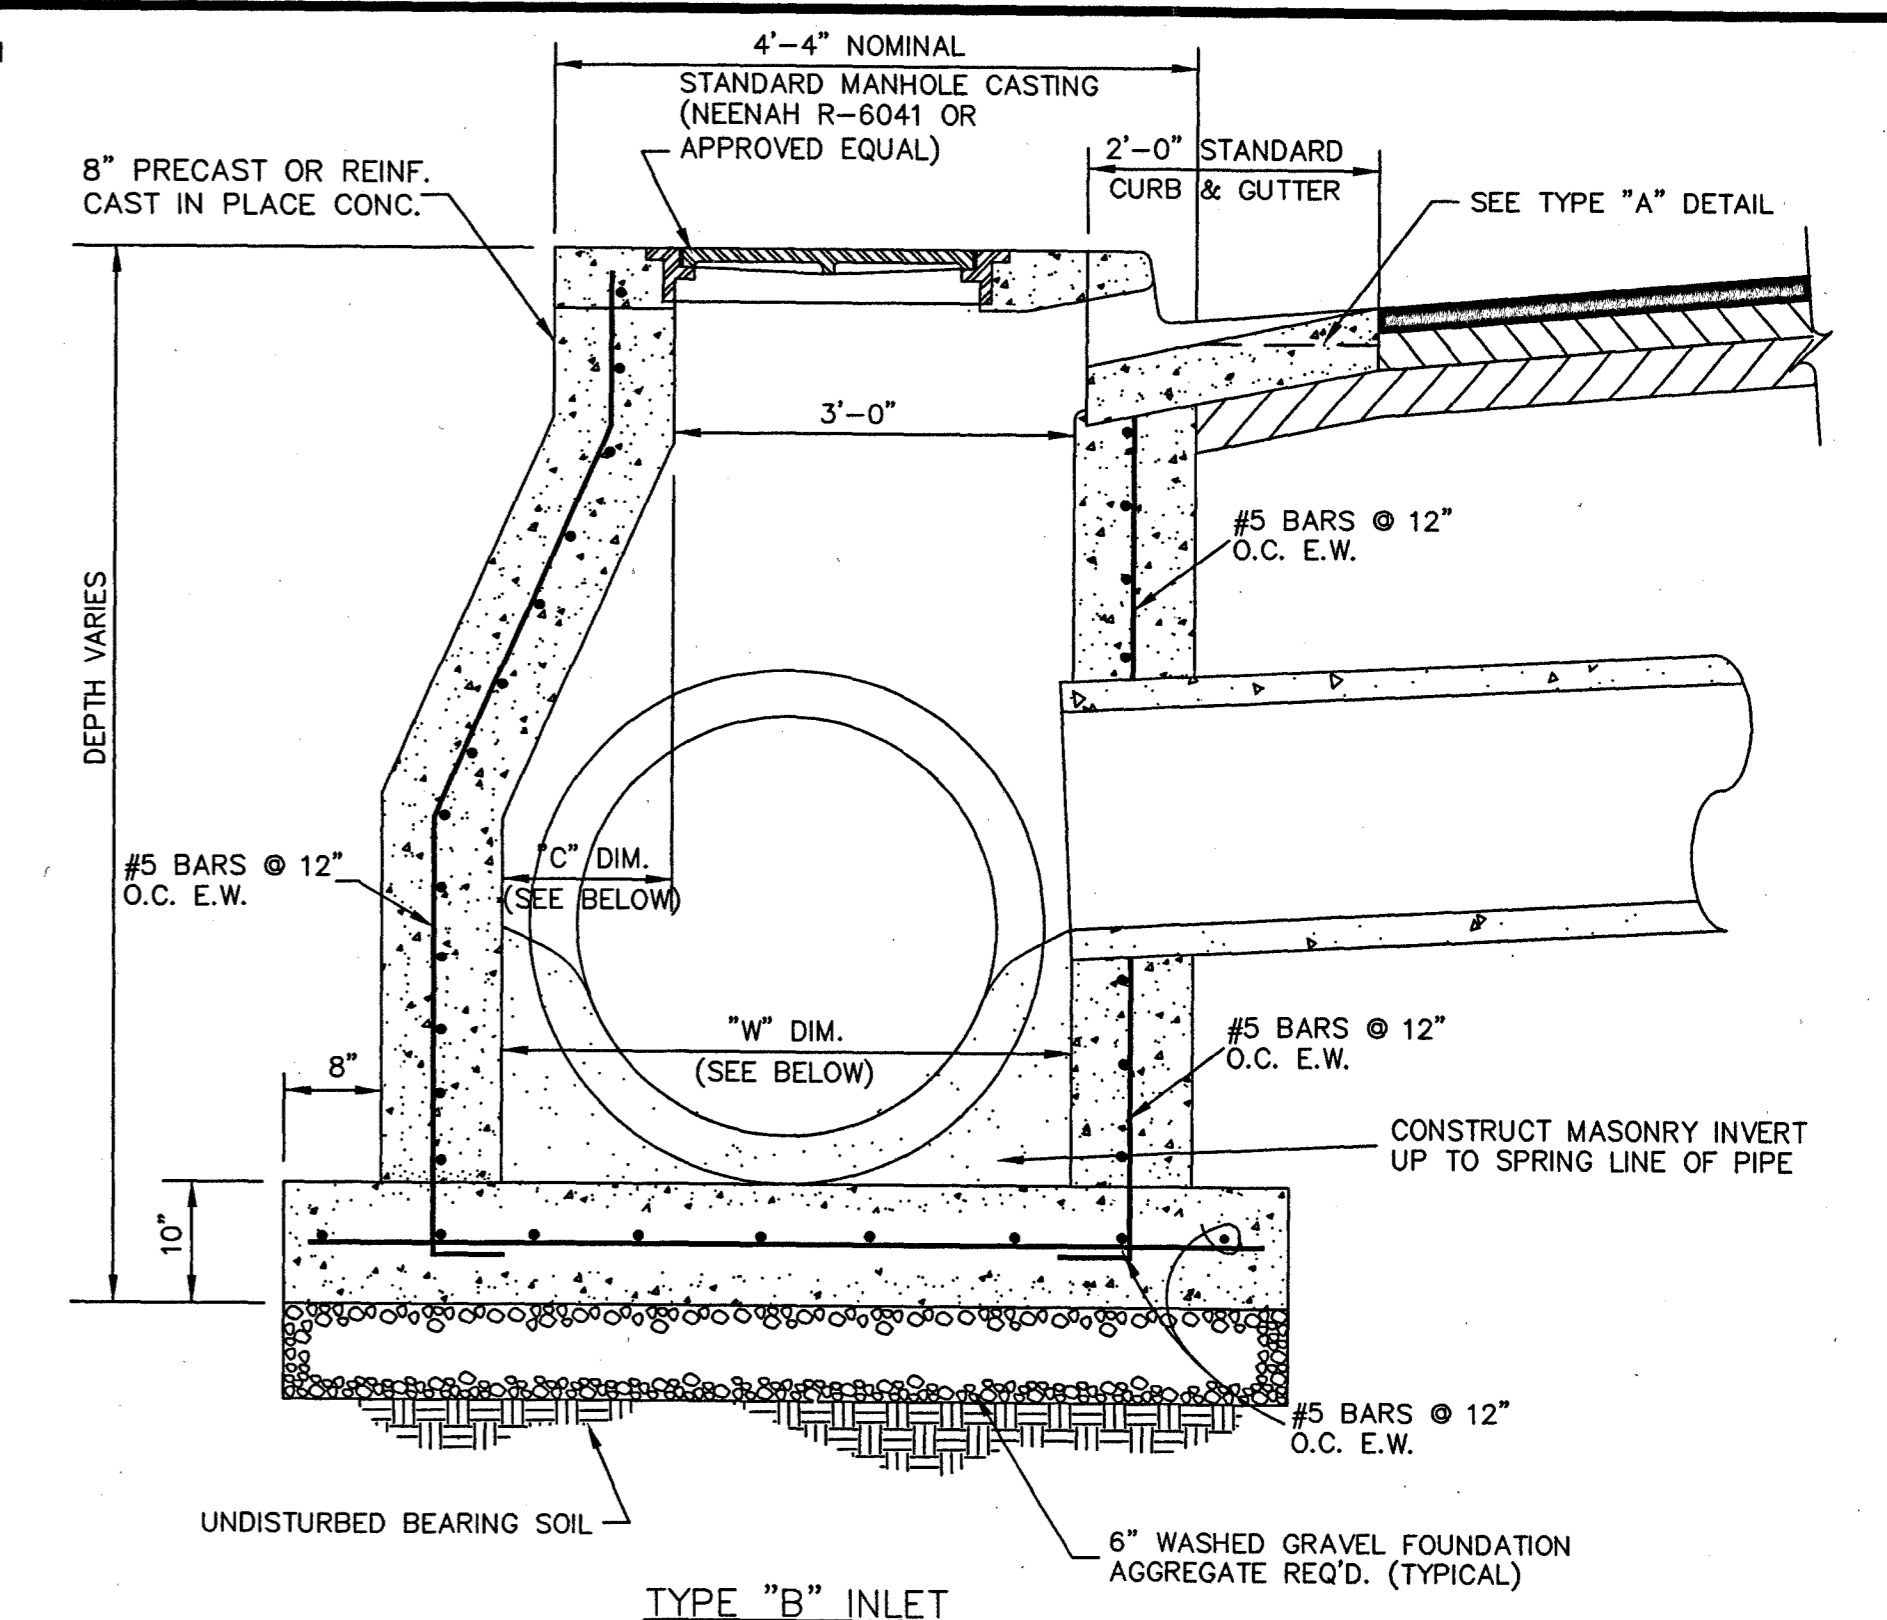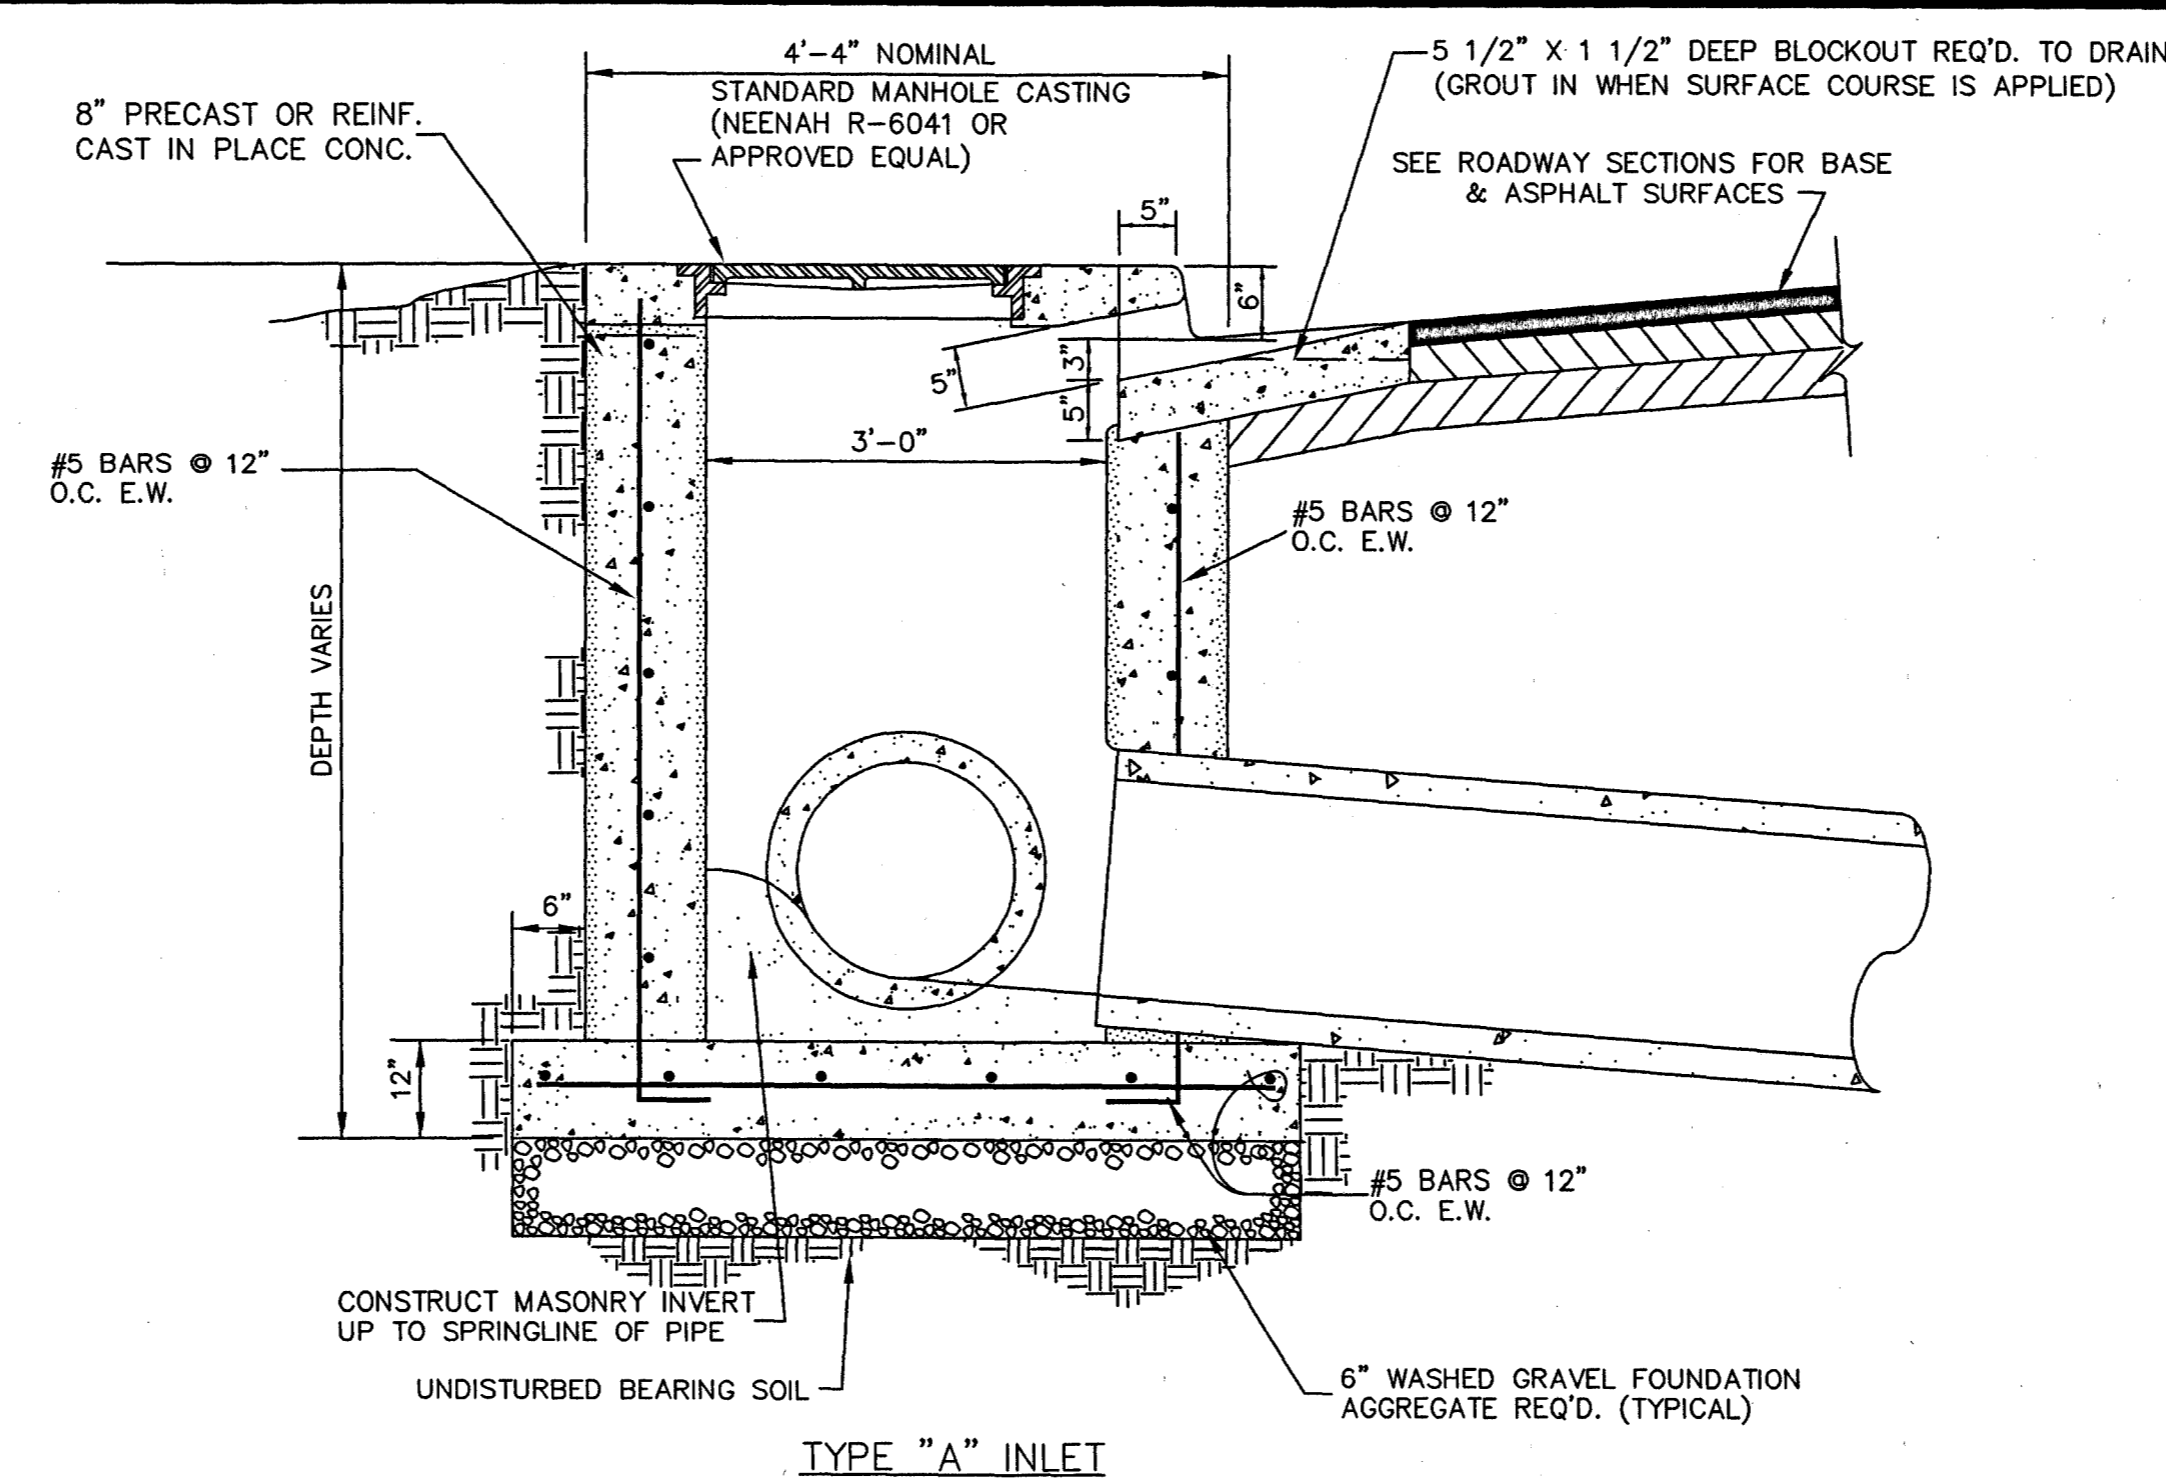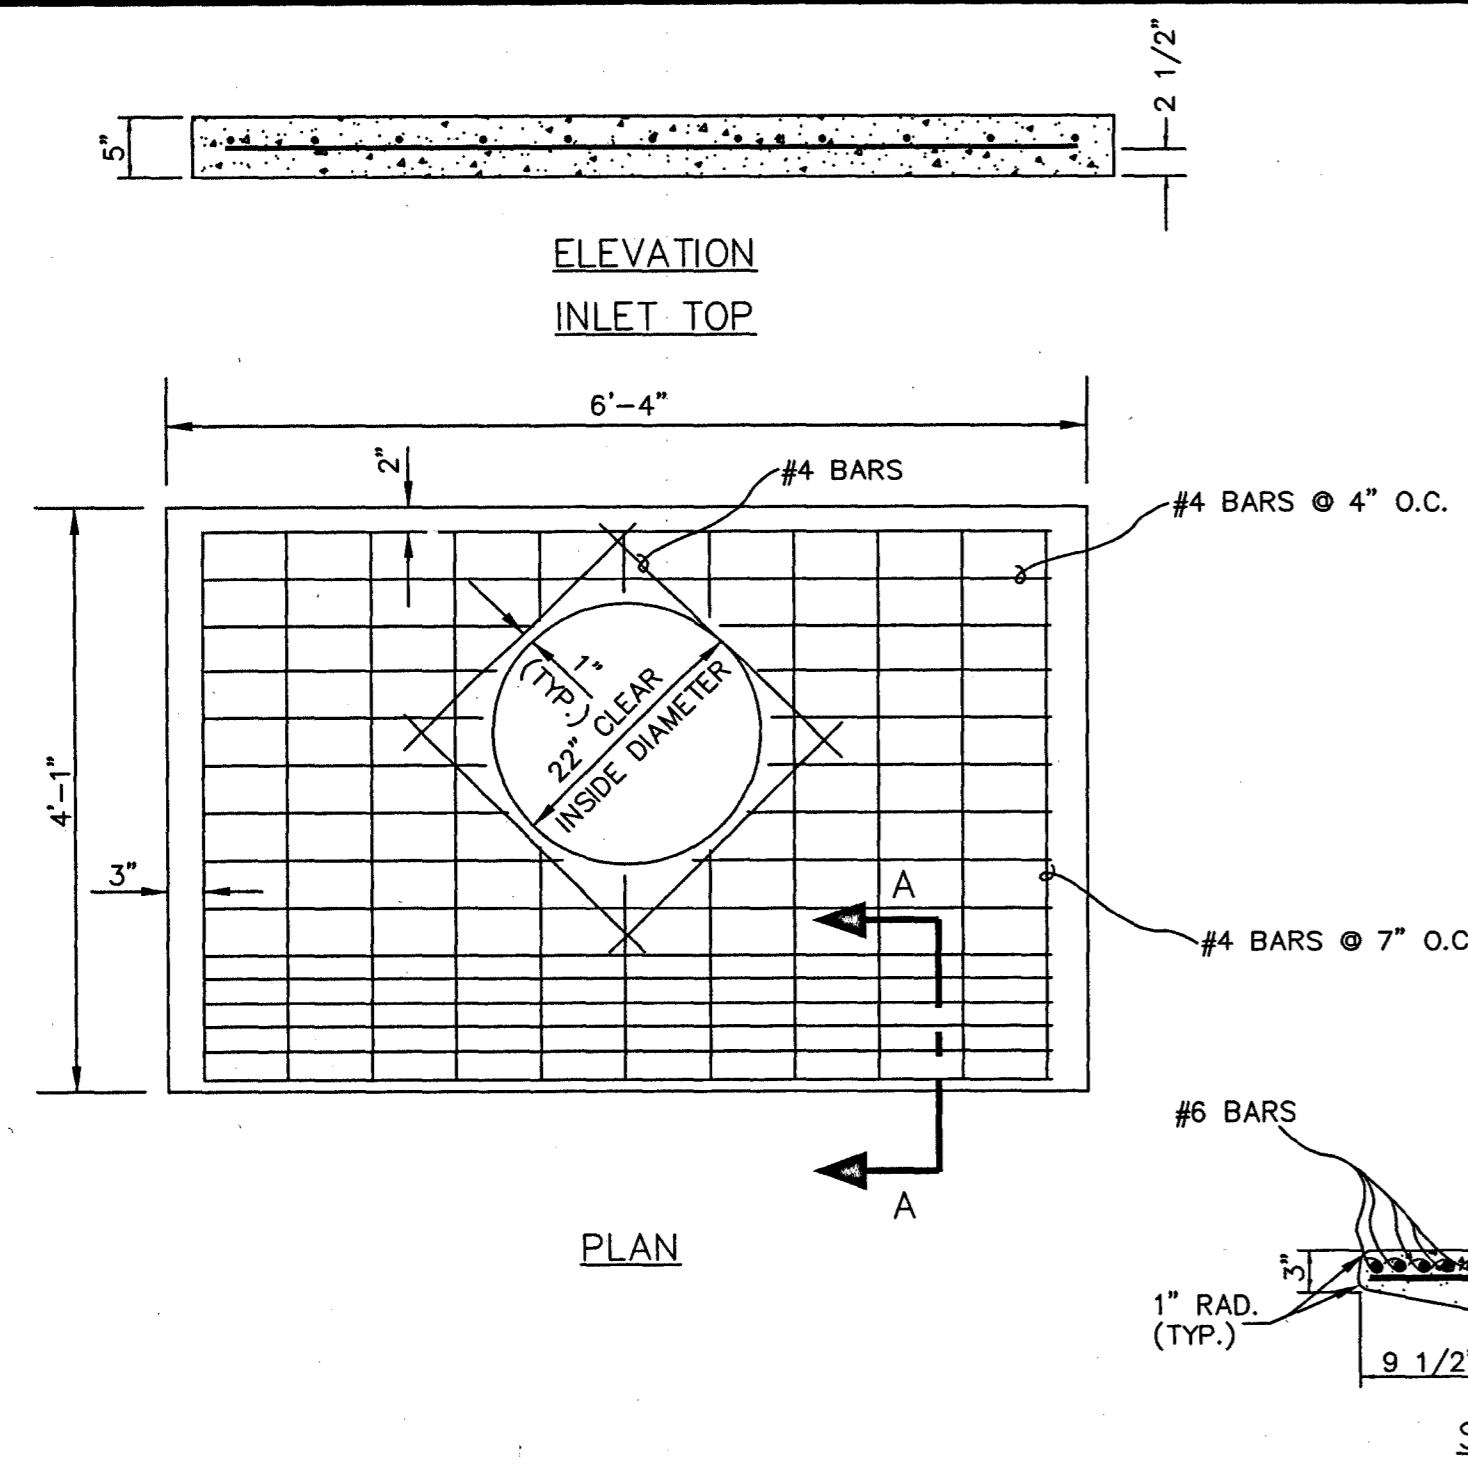

DIMENSIONS FOR TYPE "B" INLET

PIPE I.D.	PIPE O.D.	DIM. "W"	DIM. "C"
24"	33"	37"	1"
27"	36"	40"	4"
30"	39 1/2"	44"	8"
36"	45 1/2"	50"	14"
29"x18"	36"x25"	40"	4"
36"x23"	43"x30"	47"	11"
28"x20"	34"x 26"	38"	2"

SECTION B-B CURB INLET

SINGLE & DOUBLE INLET DETAILS

OLD CANTON ROAD RECONSTRUCTION
PROJECT NO.: STP-6926-00(001)
CITY OF RIDGELAND, MISSISSIPPI

WAGGONER ENGINEERING, INC.
Consulting Engineers - Jackson, MS

DATE	DRAWN BY: ELS	DATE 03-06-01	WORKING NUMBER
REVISION	REVIEWED BY: BS	SCALE 1"=20'	SHEET NUMBER