


I, H.L. Hutchinson, Registered Professional Engineer, do hereby certify that a Final Field Survey was conducted and that these "As Built" are true and correct to the best of my knowledge and belief.

H.L. Hutchinson Date: 11/25/79

NOTE
 All Construction Shall Be In Accordance With Current City of Jackson and State of Mississippi Specifications and Practices.

WATER IMPROVEMENTS ON OLD CANTON ROAD
 MADISON COUNTY, MISS.
H.L. Hutchinson
 CIVIL ENGINEER SURVEYOR
 JACKSON, MISSISSIPPI
 SCALE: 1" = 40' Date: September 28, 1979 SHEET 2 OF 2

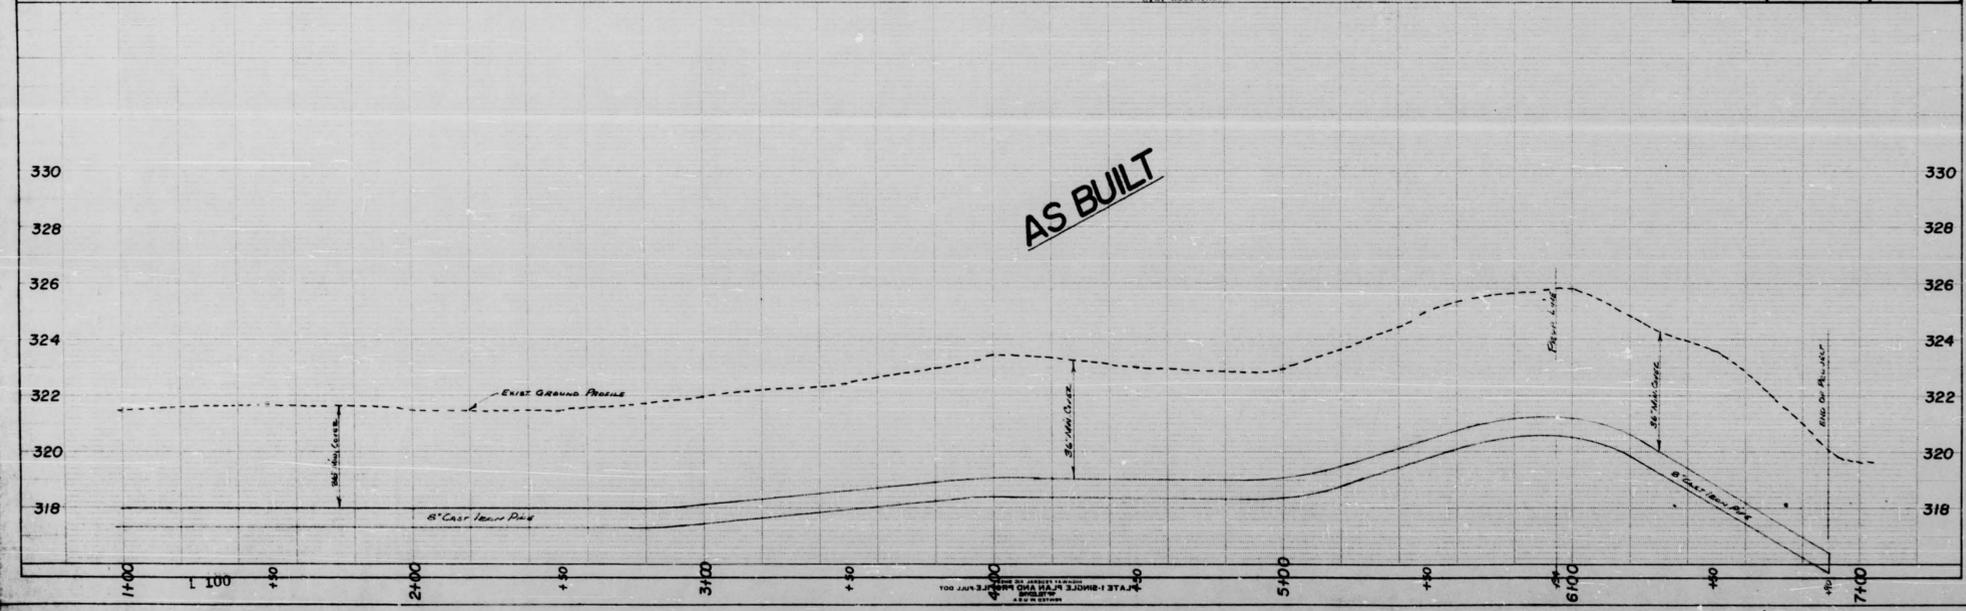

DATE	
BY	
CHECKED	
APPROVED	

DATE	
BY	
CHECKED	
APPROVED	