
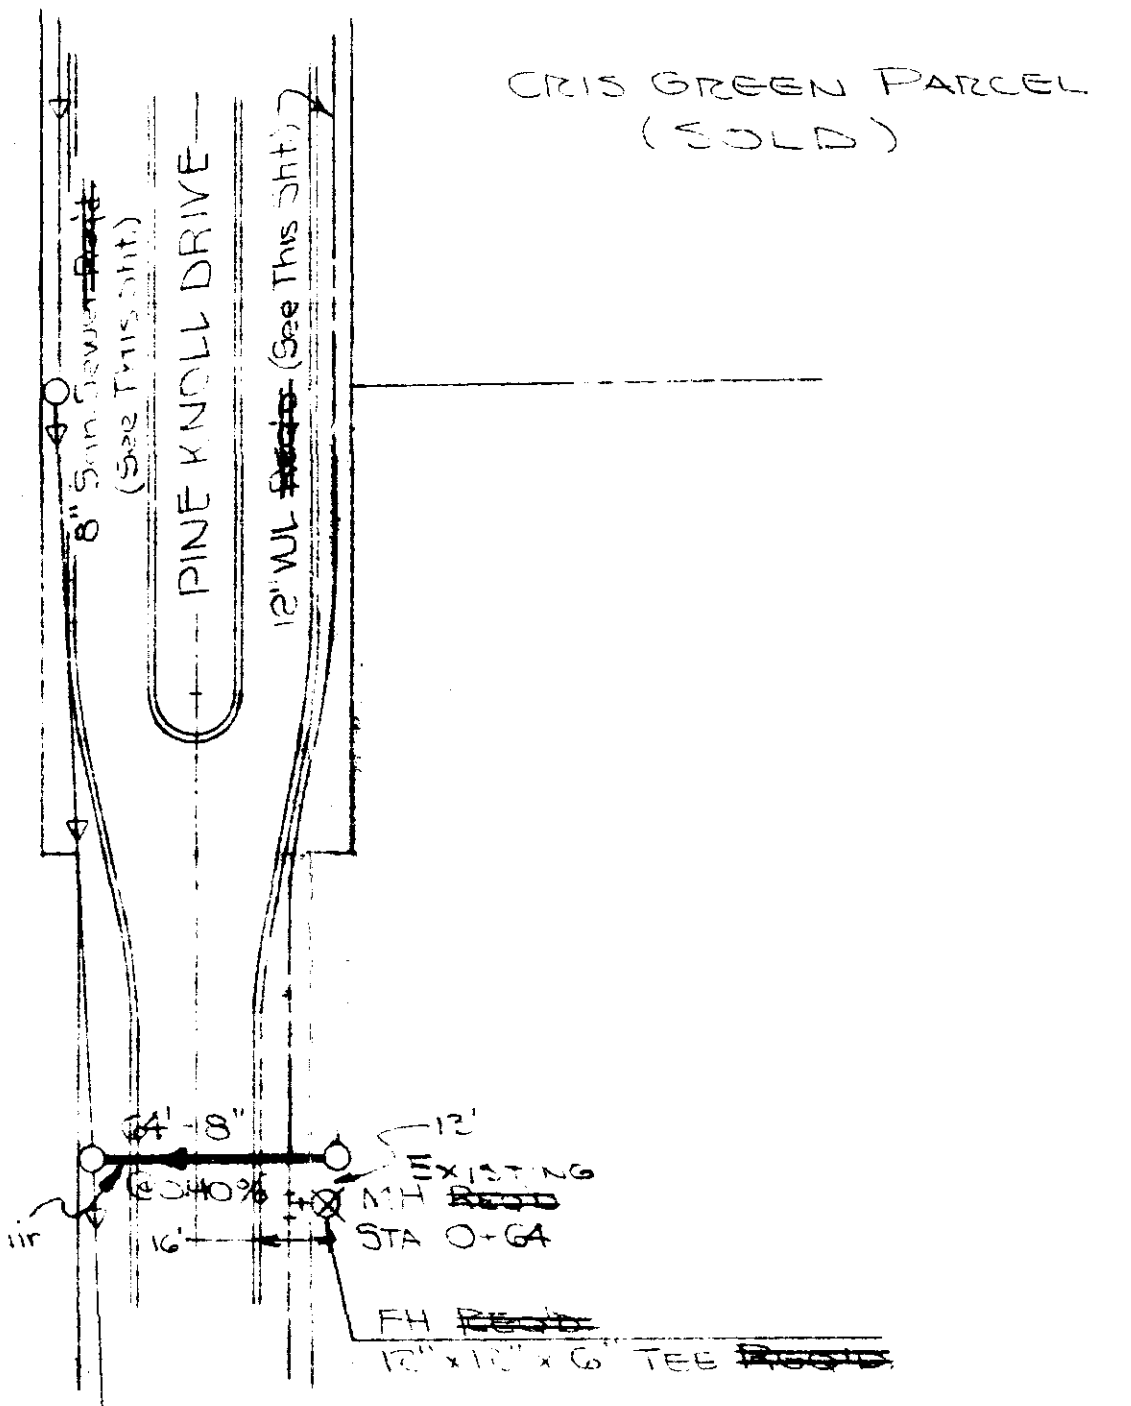
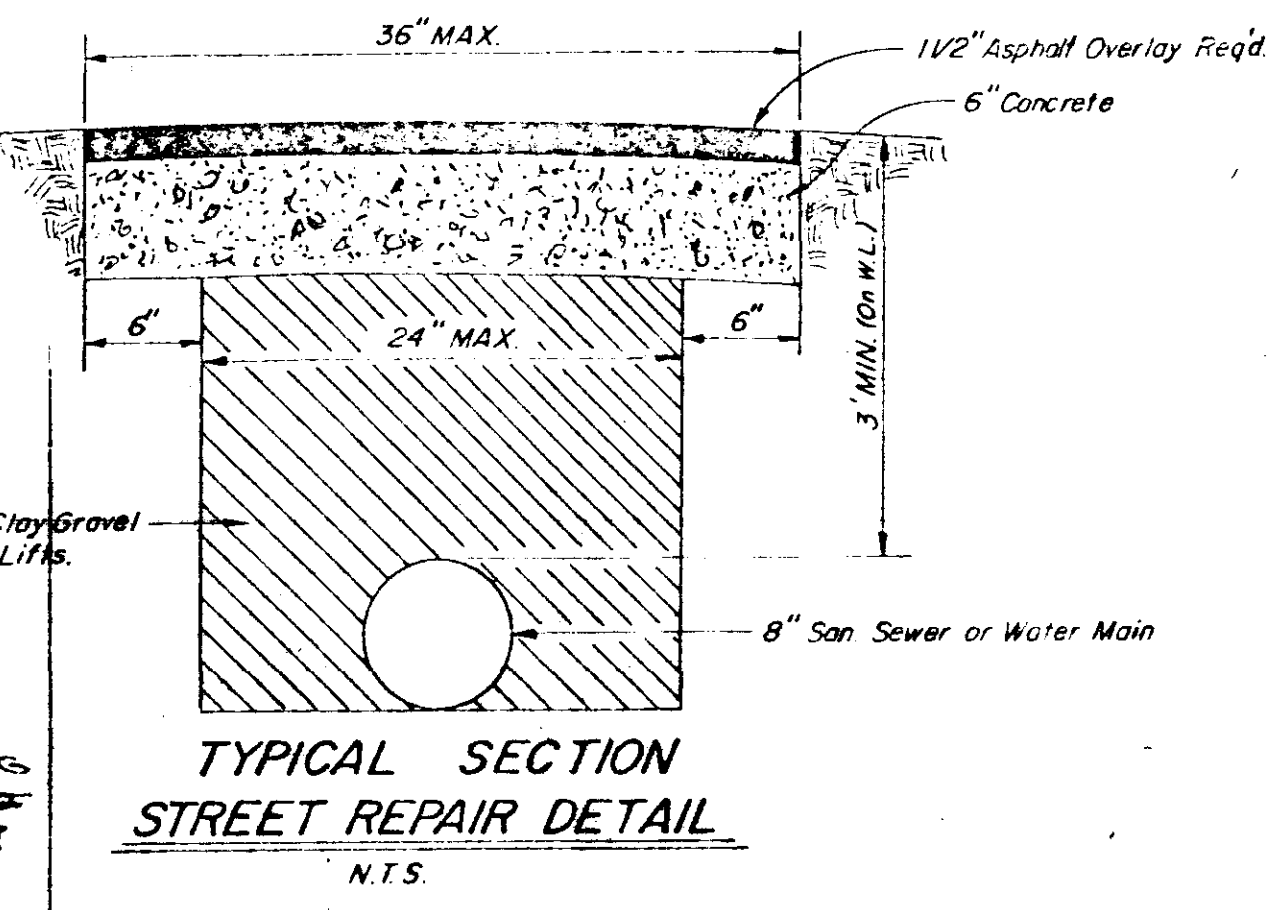


DATE: _____
 BY: _____
 CHECKED: _____
 PLAN
 NOTE BOOK NO. _____
 FT. OF WAY CHECKED: _____

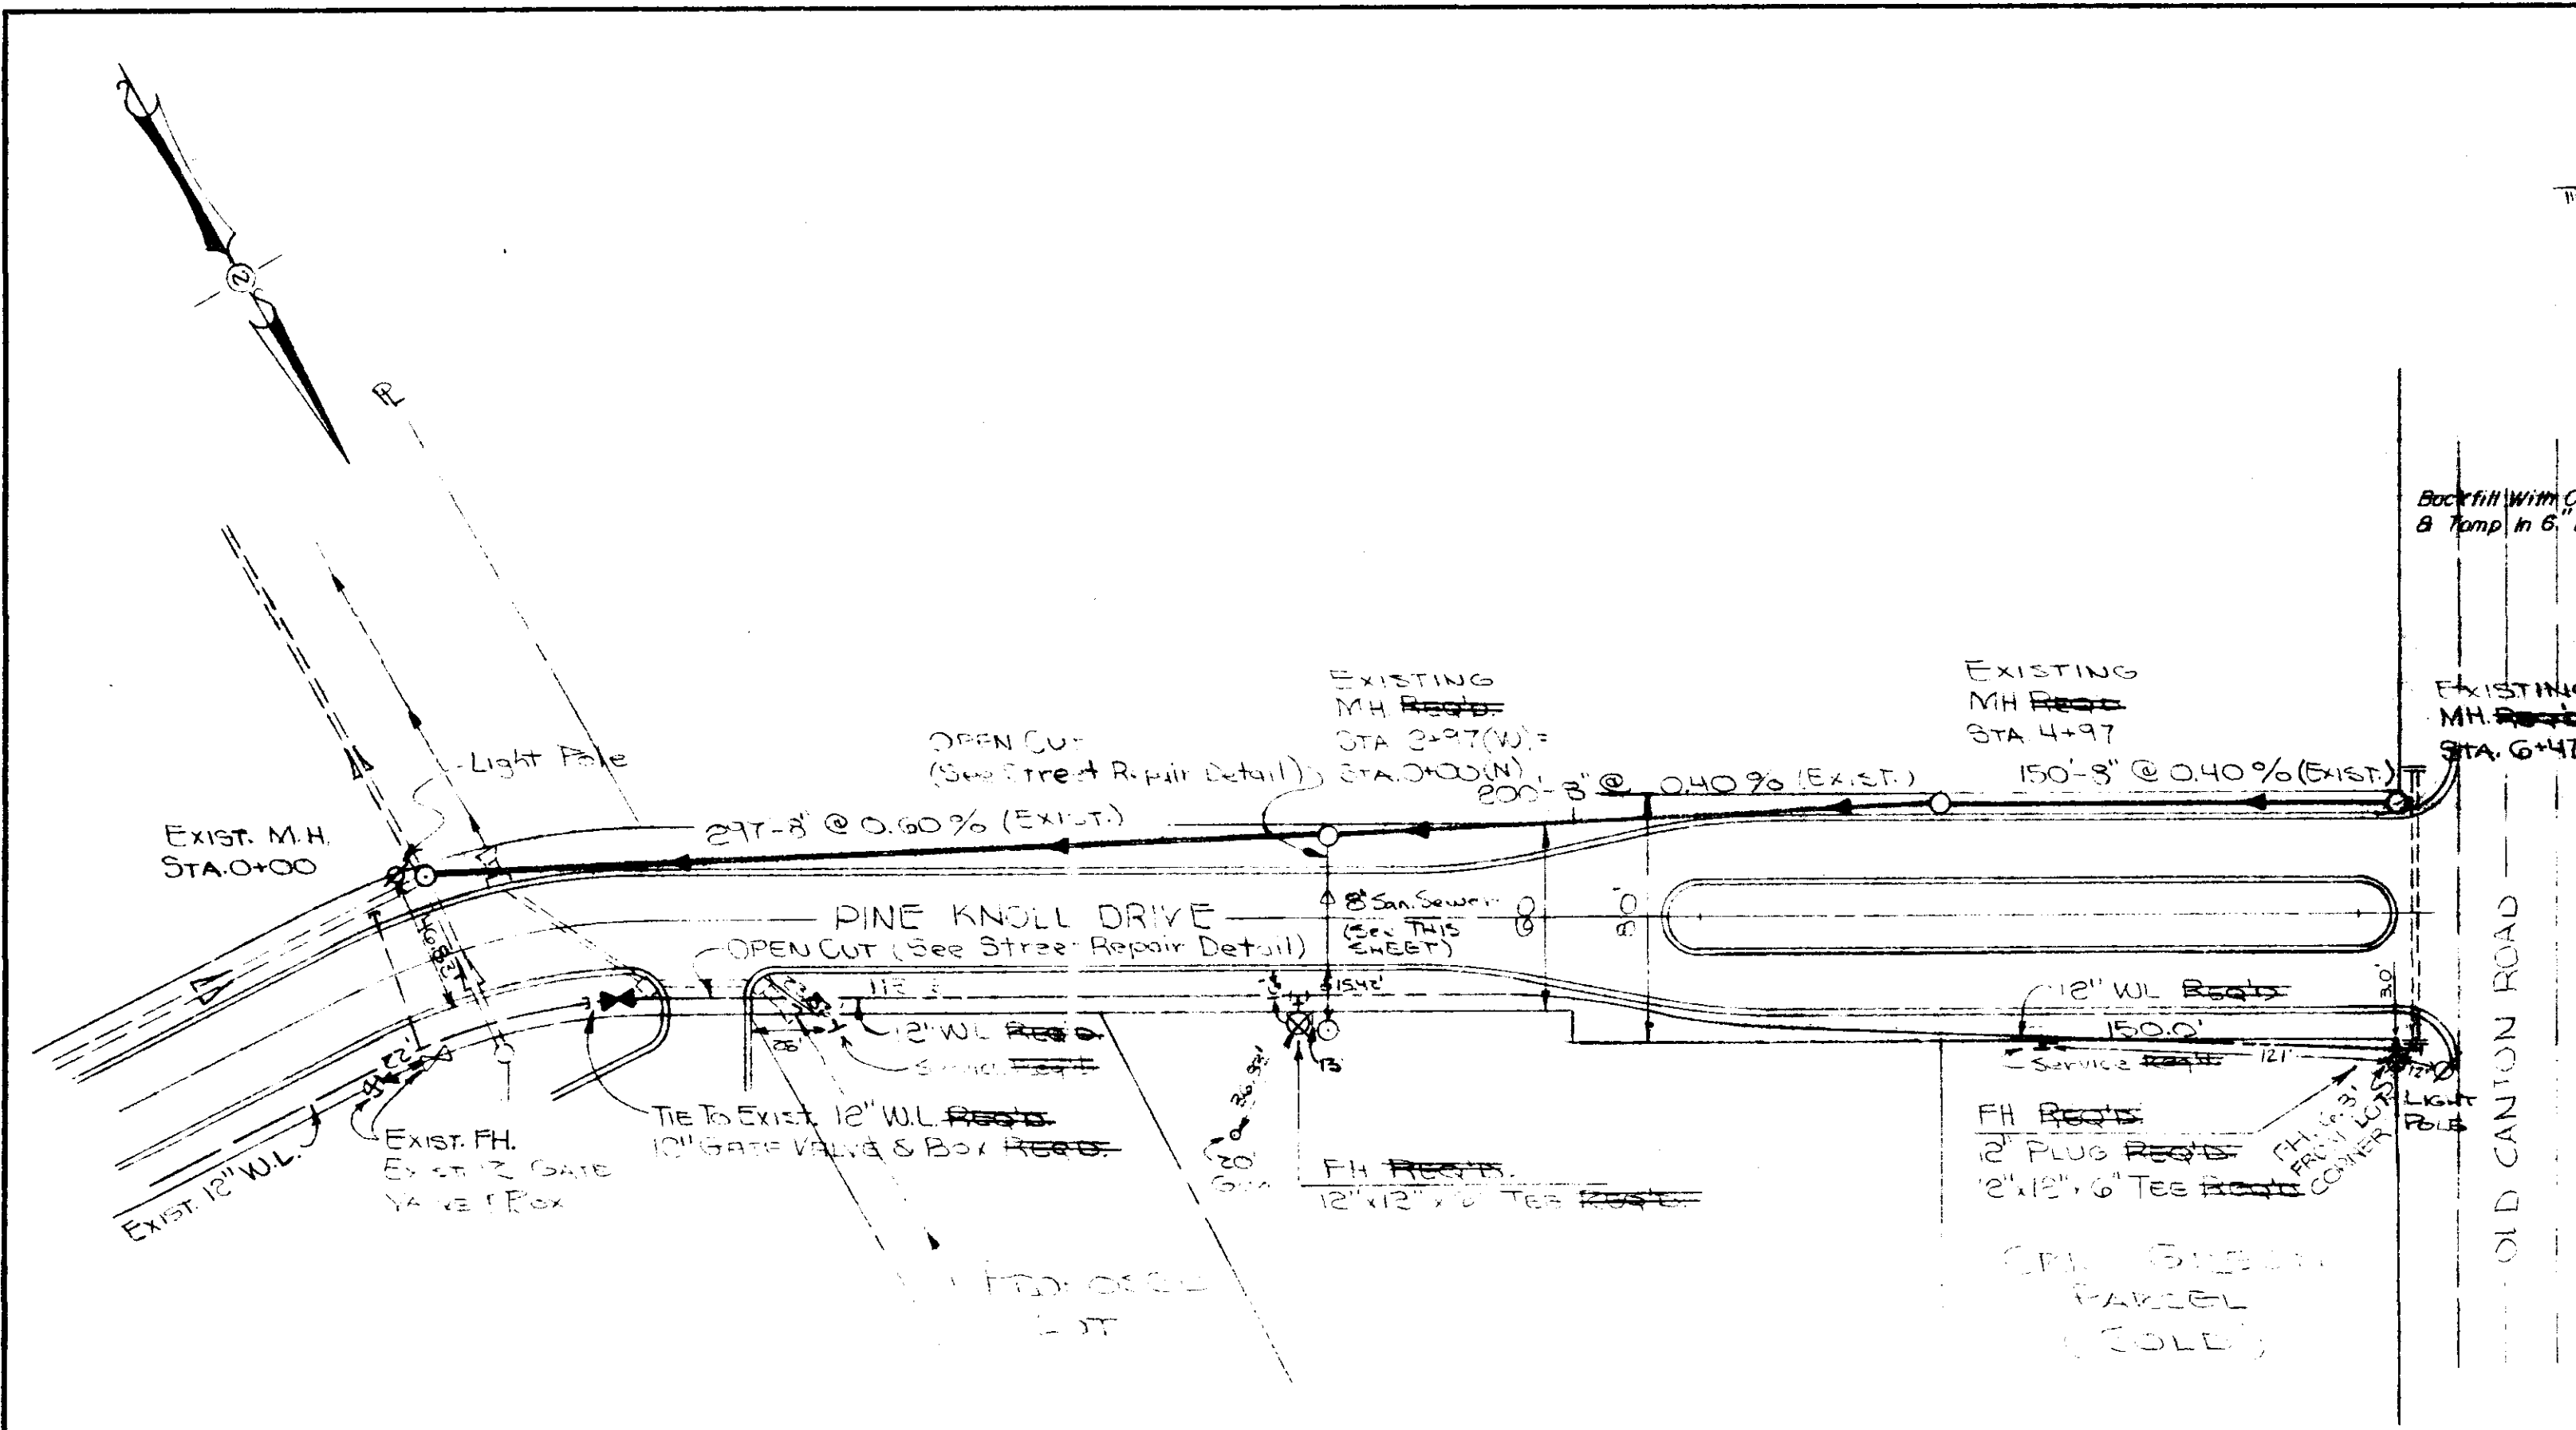

**"OFFICE COPY"
 DO NOT REMOVE**

FINAL PLANS
 OF
 COMPLETED WORK
 5/19/80

DATE: _____
 BY: _____
 CHECKED: _____
 PROFILE
 NOTE BOOK NO. _____
 FT. OF WAY CHECKED: _____

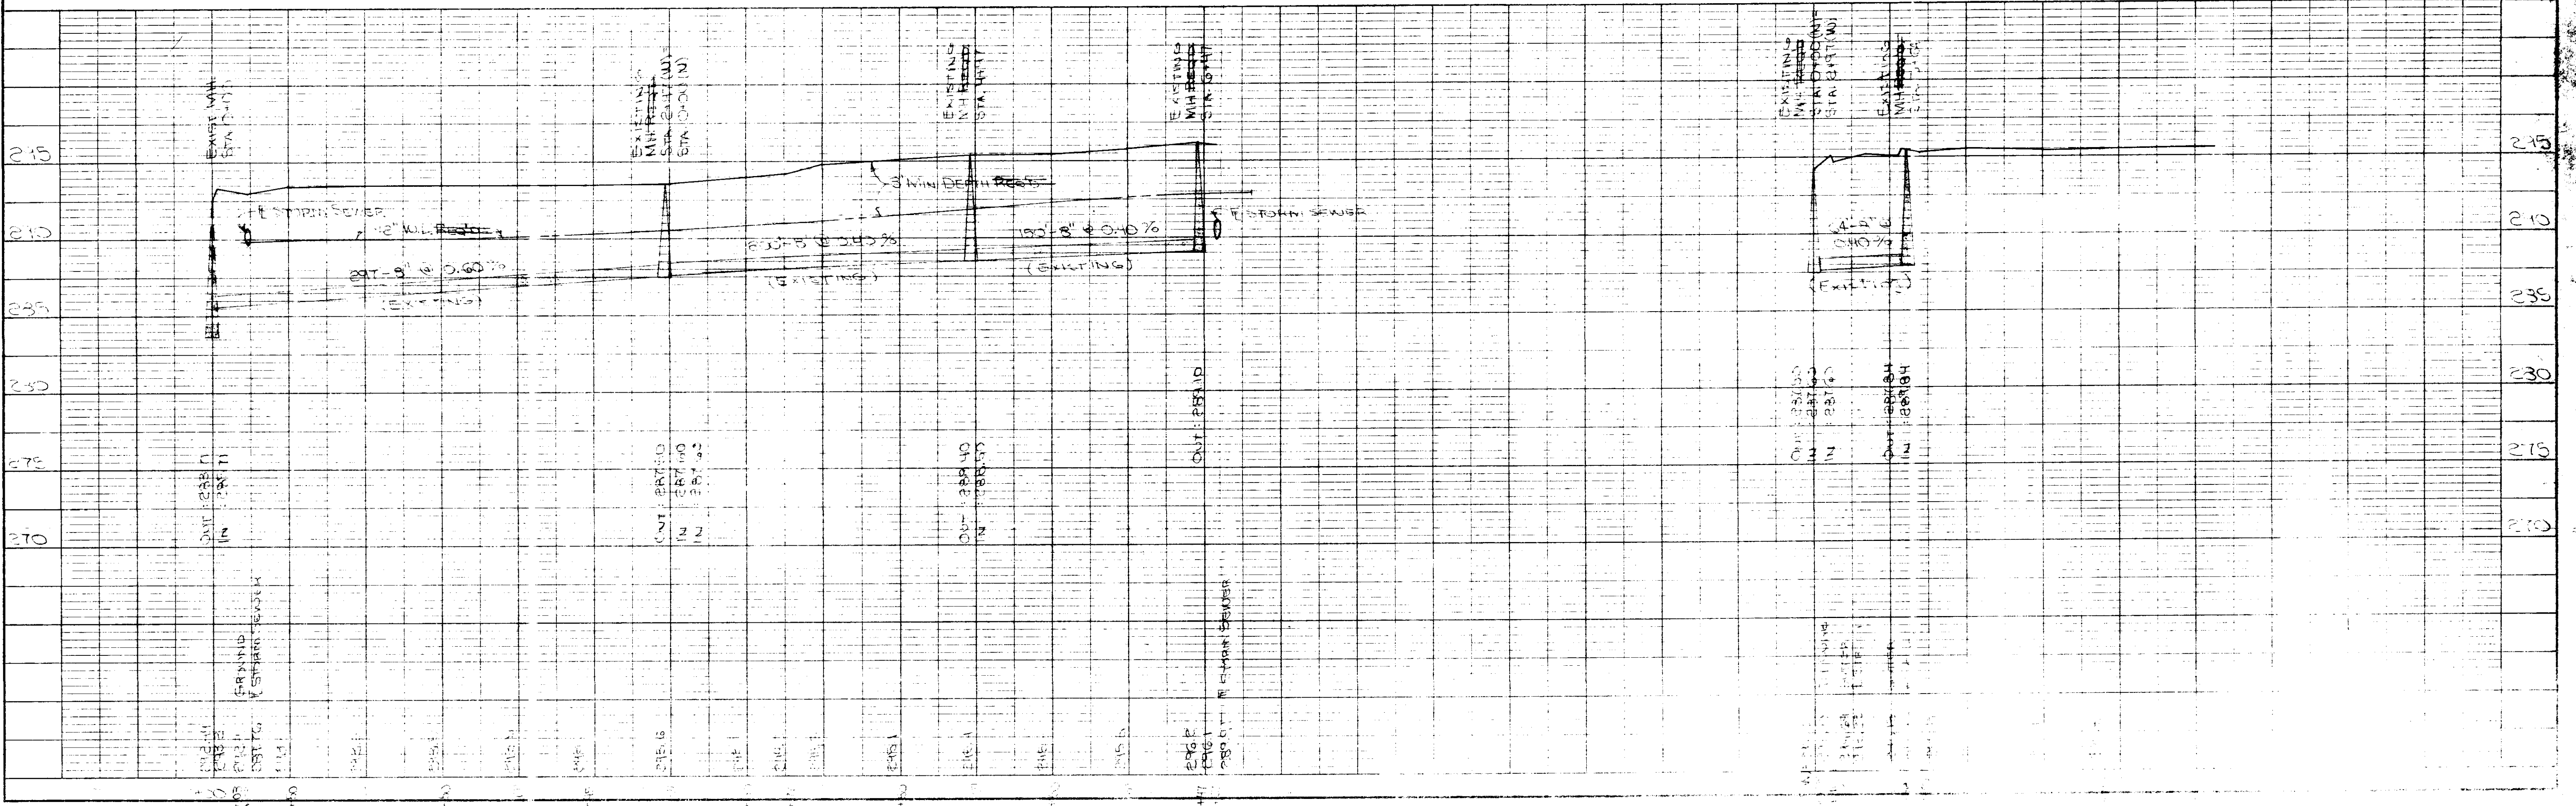


PLATE 1 PLAN PROFILE
 48 7004 MADE IN U.S.A.

PWP-1607