


APPARENT LAND RIGHTS MAP
 NOTE: PROPERTY LINES ARE APPARENT
 NOT SURVEYED


320-013
 George A. & Cherry M. Kalantzis
 147 Winged Foot
 Jackson, Mississippi 39211

320-014/01
 Classic Enterprises, Inc.
 5720 Medallion Drive
 Jackson, Mississippi 39211

— PROPERTY LINE
 — PROPOSED TOP OF BANK
 — EXISTING TOP OF BANK
 — EXISTING TOE

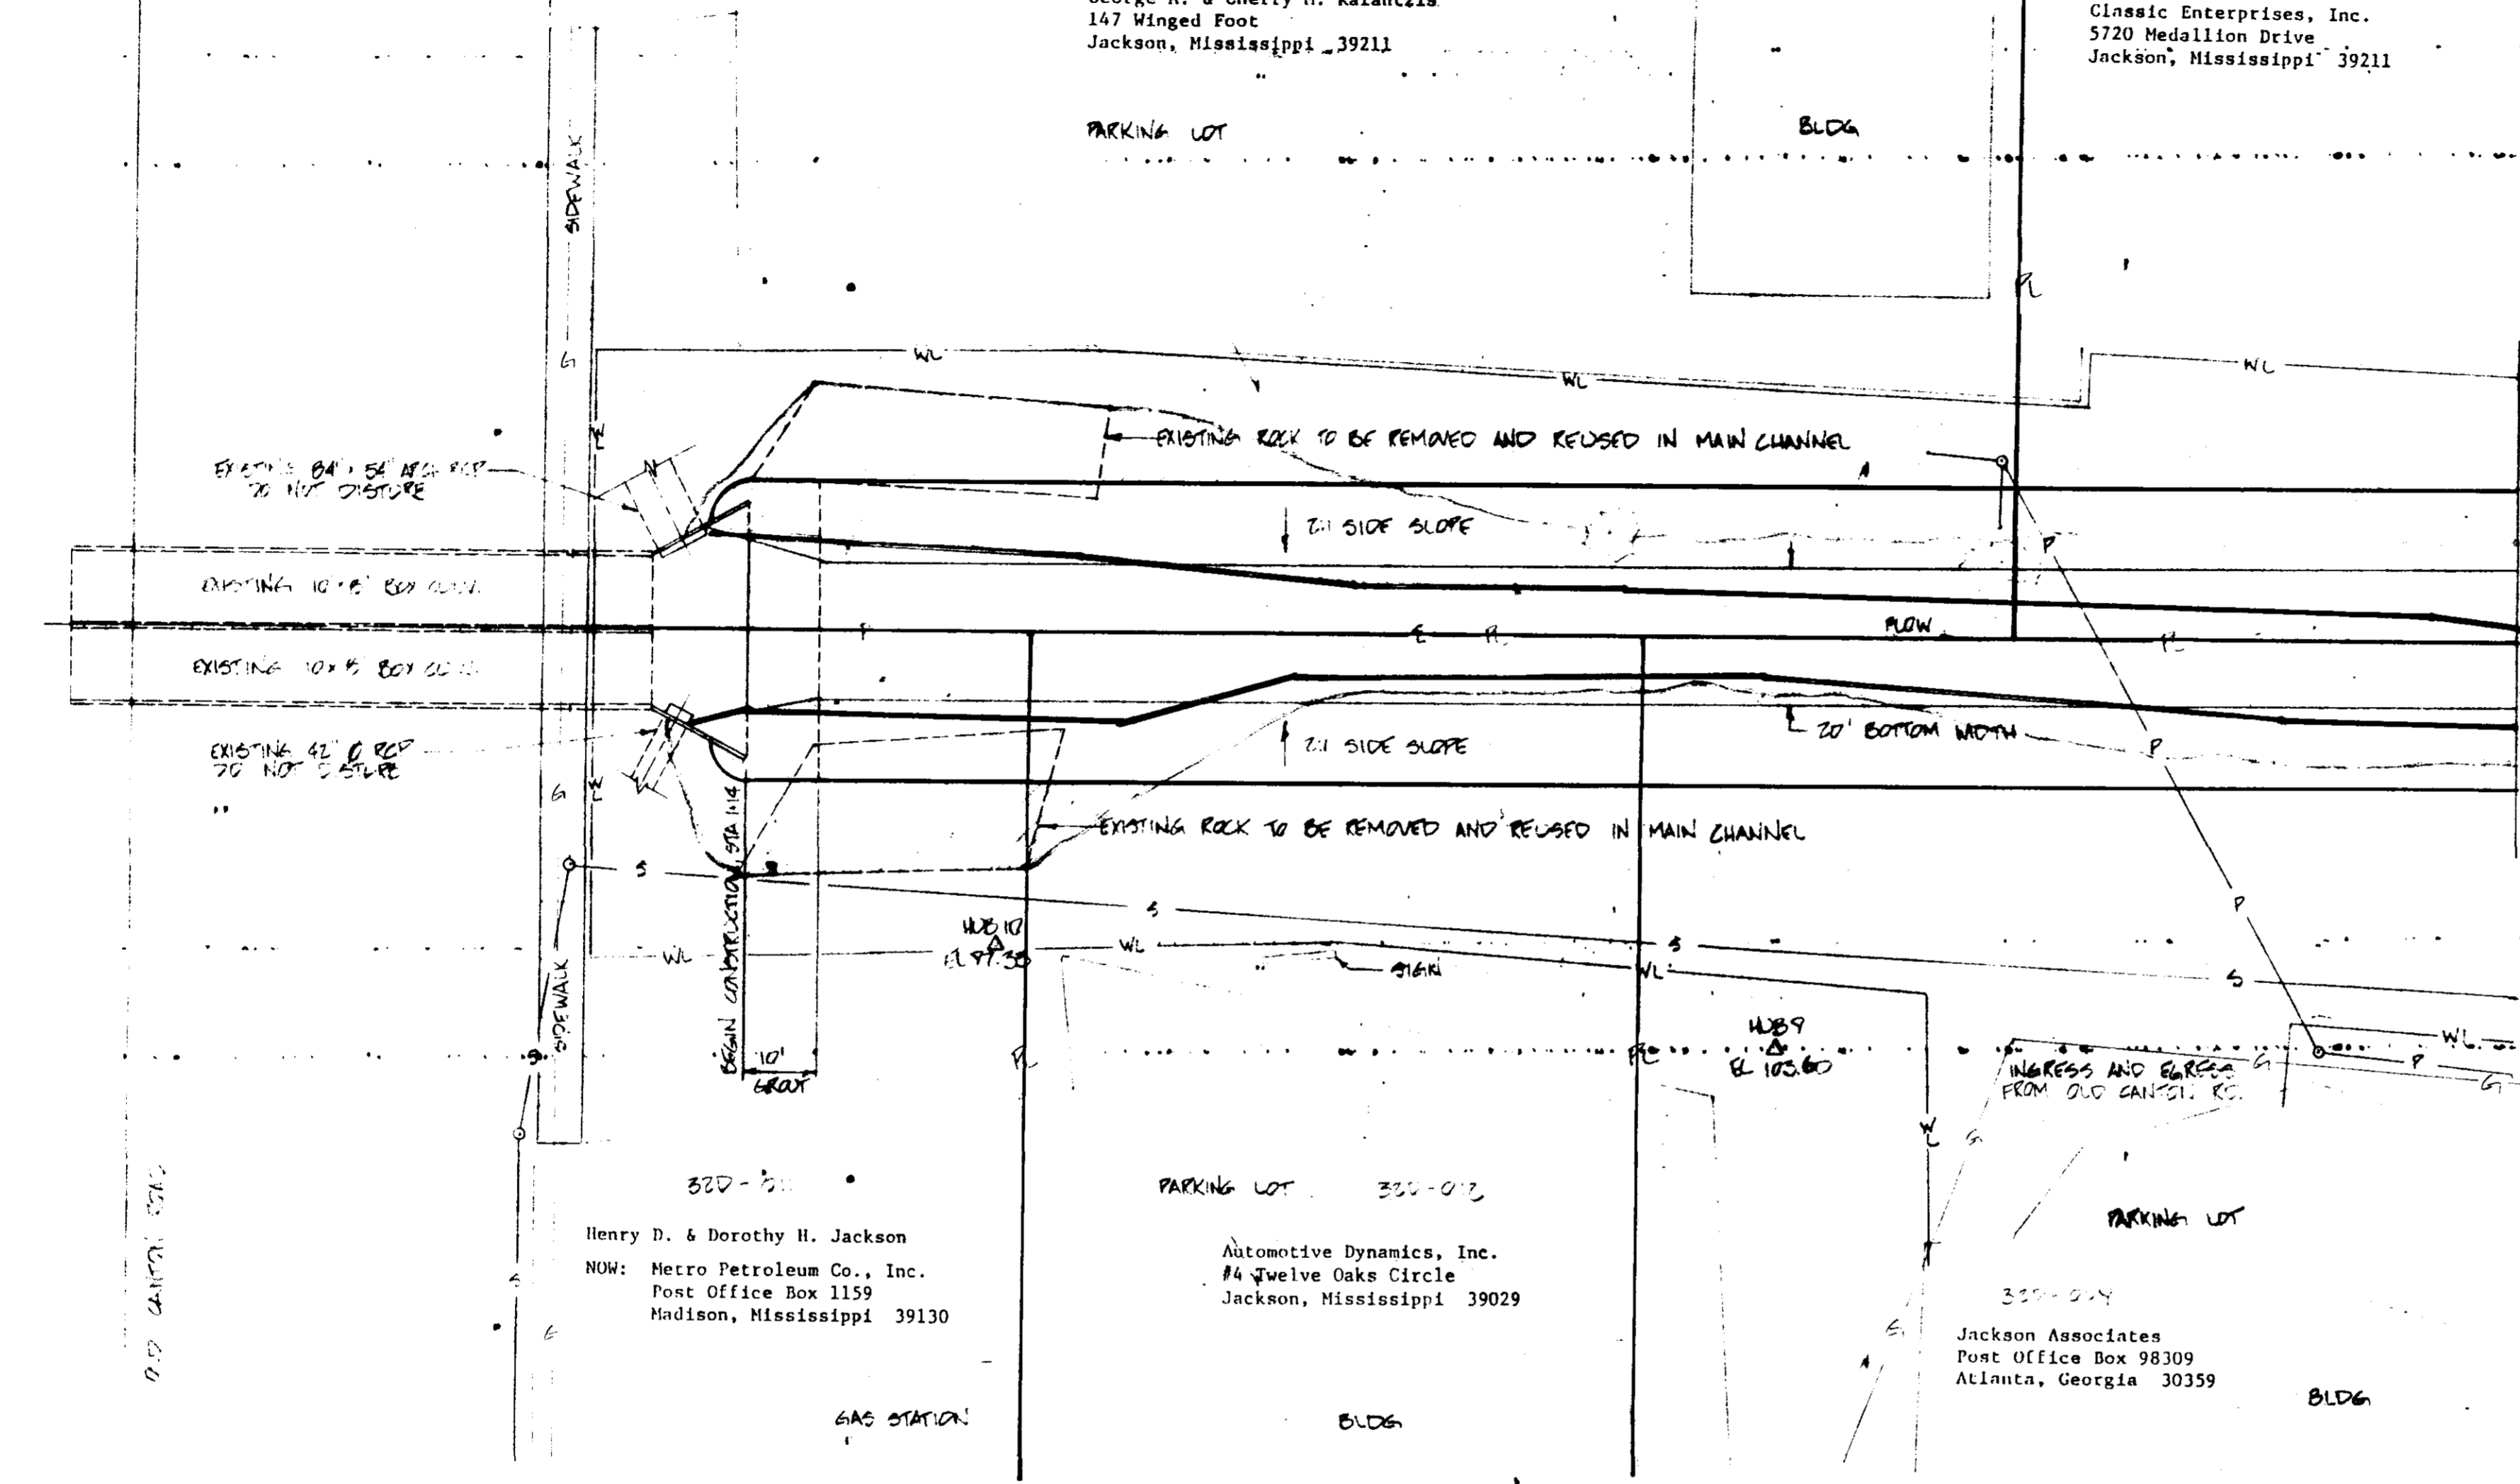


- LEGEND**
- △ TRANSIT STATION
 - PLOTTED POINT
 - SEWER LINE W/ MANHOLE
 - TELEPHONE LINE W/ JUNCTION BOX & POLE
 - POWER LINE W/ POLE
 - WATER LINE W/ METER
 - GAS LINE W/ METER
 - *— EXISTING FENCE LINE
 - EXISTING TOE
 - EXISTING TOP OF BANK
 - APPROX. LIMIT OF CUT
 - APPROX. LIMIT OF WORK
 - /// EARTH FILL
 - CONCRETE GROUT
 - EROSION CONTROL BLANKET

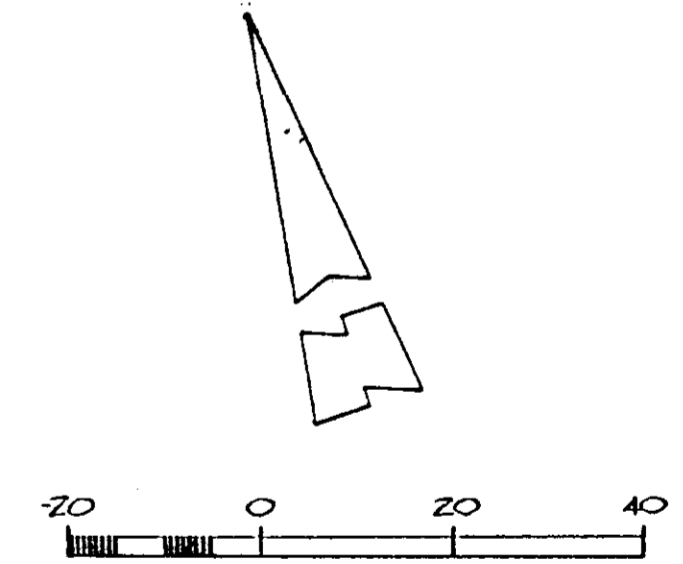

320-011
 Henry D. & Dorothy H. Jackson
 NOW: Metro Petroleum Co., Inc.
 Post Office Box 1159
 Madison, Mississippi 39130

320-012
 Automotive Dynamics, Inc.
 #4 Twelve Oaks Circle
 Jackson, Mississippi 39029

320-014
 Jackson Associates
 Post Office Box 98309
 Atlanta, Georgia 30359

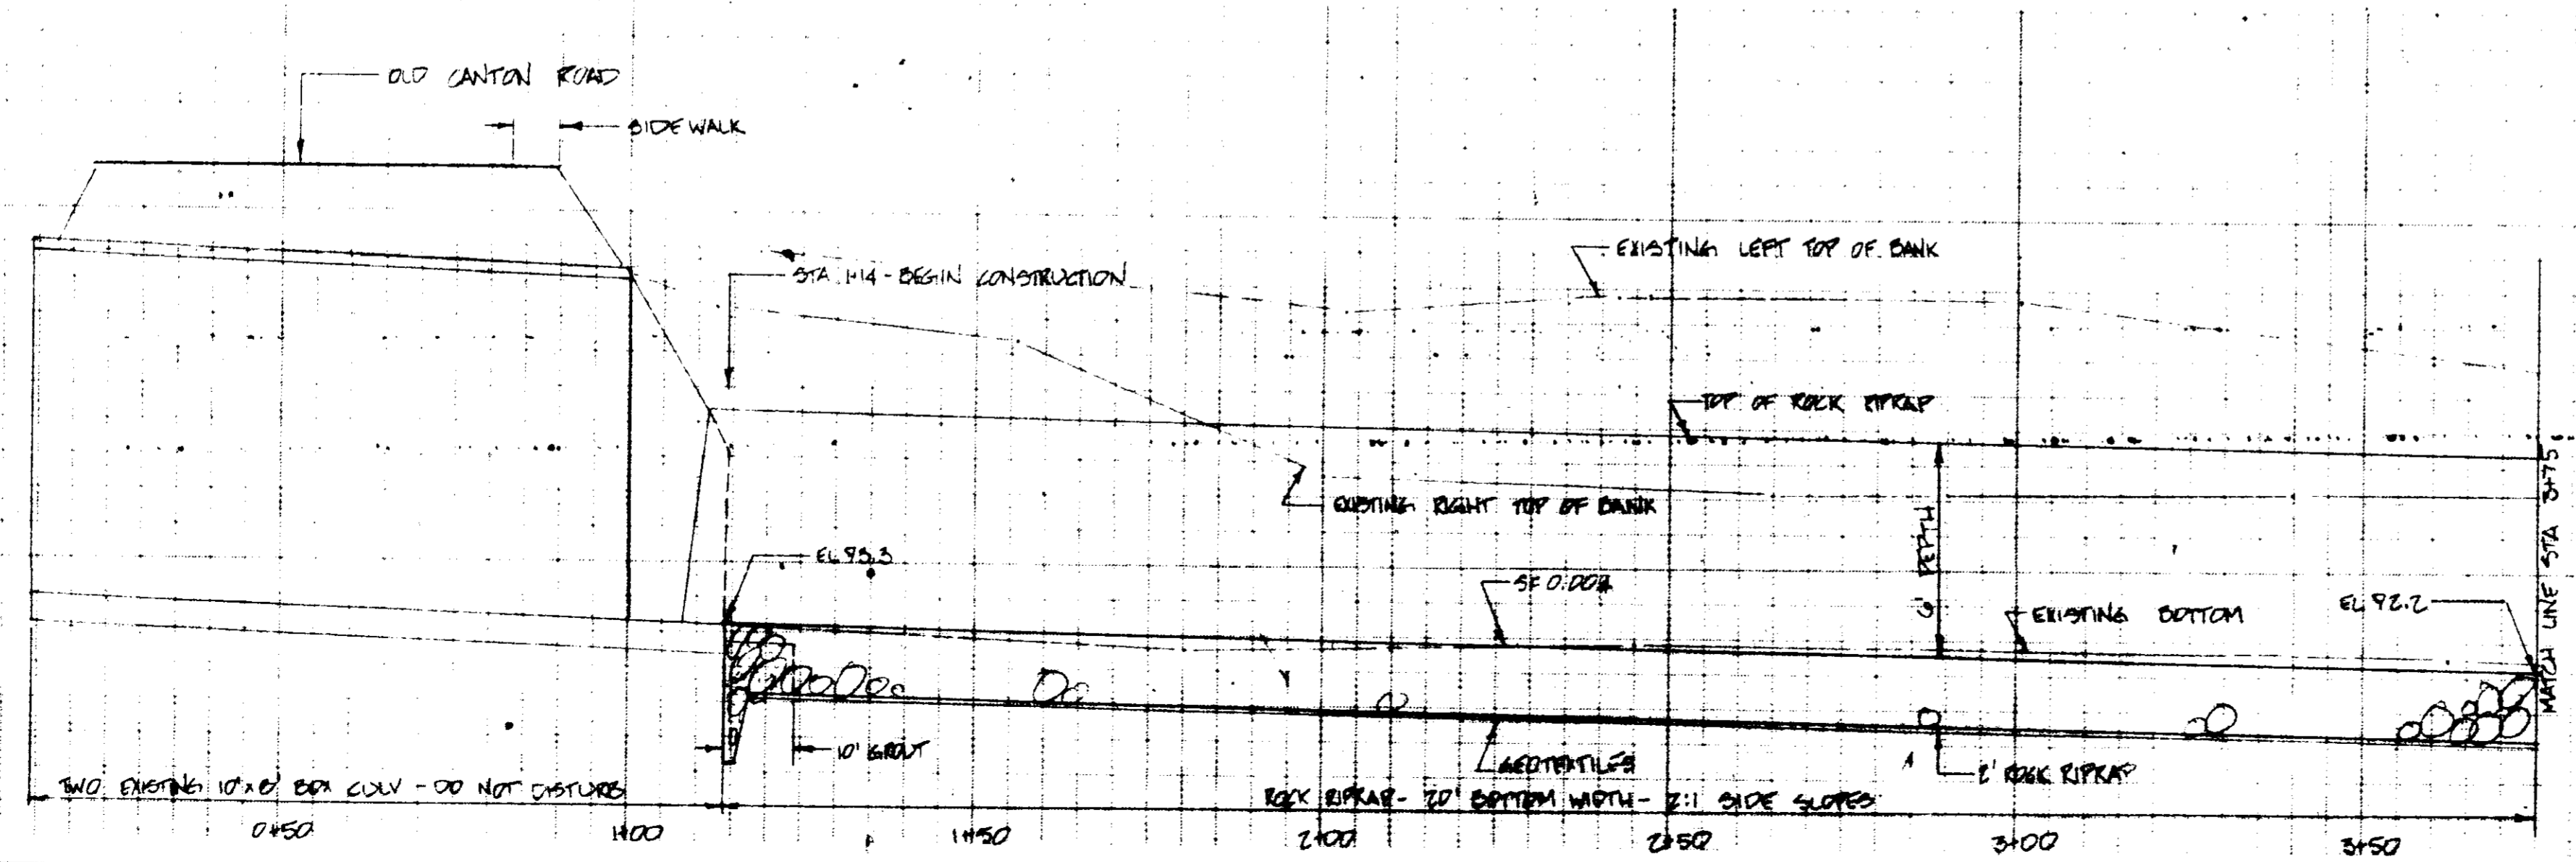

PINE KNOLL
 CITY OF RIDGELAND
 MADISON COUNTY, MISSISSIPPI
 EMERGENCY WATERWAY PROTECTION
 FOR THE PEOPLE

PWP-1608

RE

P STA 4+27.6
 CURVE DATA
 Δ = 22° 55'
 D = 122° 08' 28"
 R = 225.00'
 L = 101.00'
 T = 51.49'
 C = 100.95'
 M = 5.05'
 E = 5.16'

P STA 5+48.5
 CURVE DATA
 Δ = 18° 00'
 D = 40° 00' 00"
 R = 140.50'
 L = 57.23'
 T = 16.77'
 C = 51.05'
 M = 1.46'
 E = 1.47'

Classic Enterprises, Inc.
 5720 Medallion Drive
 Jackson, Mississippi 39211





F. Richard & Marion G. Henshaw
 5355 Fairway
 Jackson, Mississippi 39211

Jackson Associates
 Post Office Box 98309
 Atlanta, Georgia 30359

APPARENT LANDRIGHTS MAP
 NOTE: PROPERTY LINES ARE APPARENT
 NOT SURVEYED.

PROPERTY LINE
 PROPOSED TOP OF BANK
 EXISTING TOP OF BANK
 EXISTING TOE

LEGEND
 Δ TRANSIT STATION
 PLOTTED POINT
 —○— TELEPHONE LINE W/ MANHOLE
 —○— TELEPHONE LINE W/ JUNCTION BOX & POLE
 —○— POWER LINE W/ POLE
 —○— WATER LINE W/ METER
 —○— GAS LINE W/ METER
 —○— EXISTING FENCE LINE
 —○— EXISTING TOE
 —○— EXISTING TOP OF BANK
 —○— APPROX LIMIT OF CUT
 —○— APPROX LIMIT OF WORK
 // EARTH FILL
 - - - CONCRETE GROUT
 [] EROSION CONTROL BLANKET

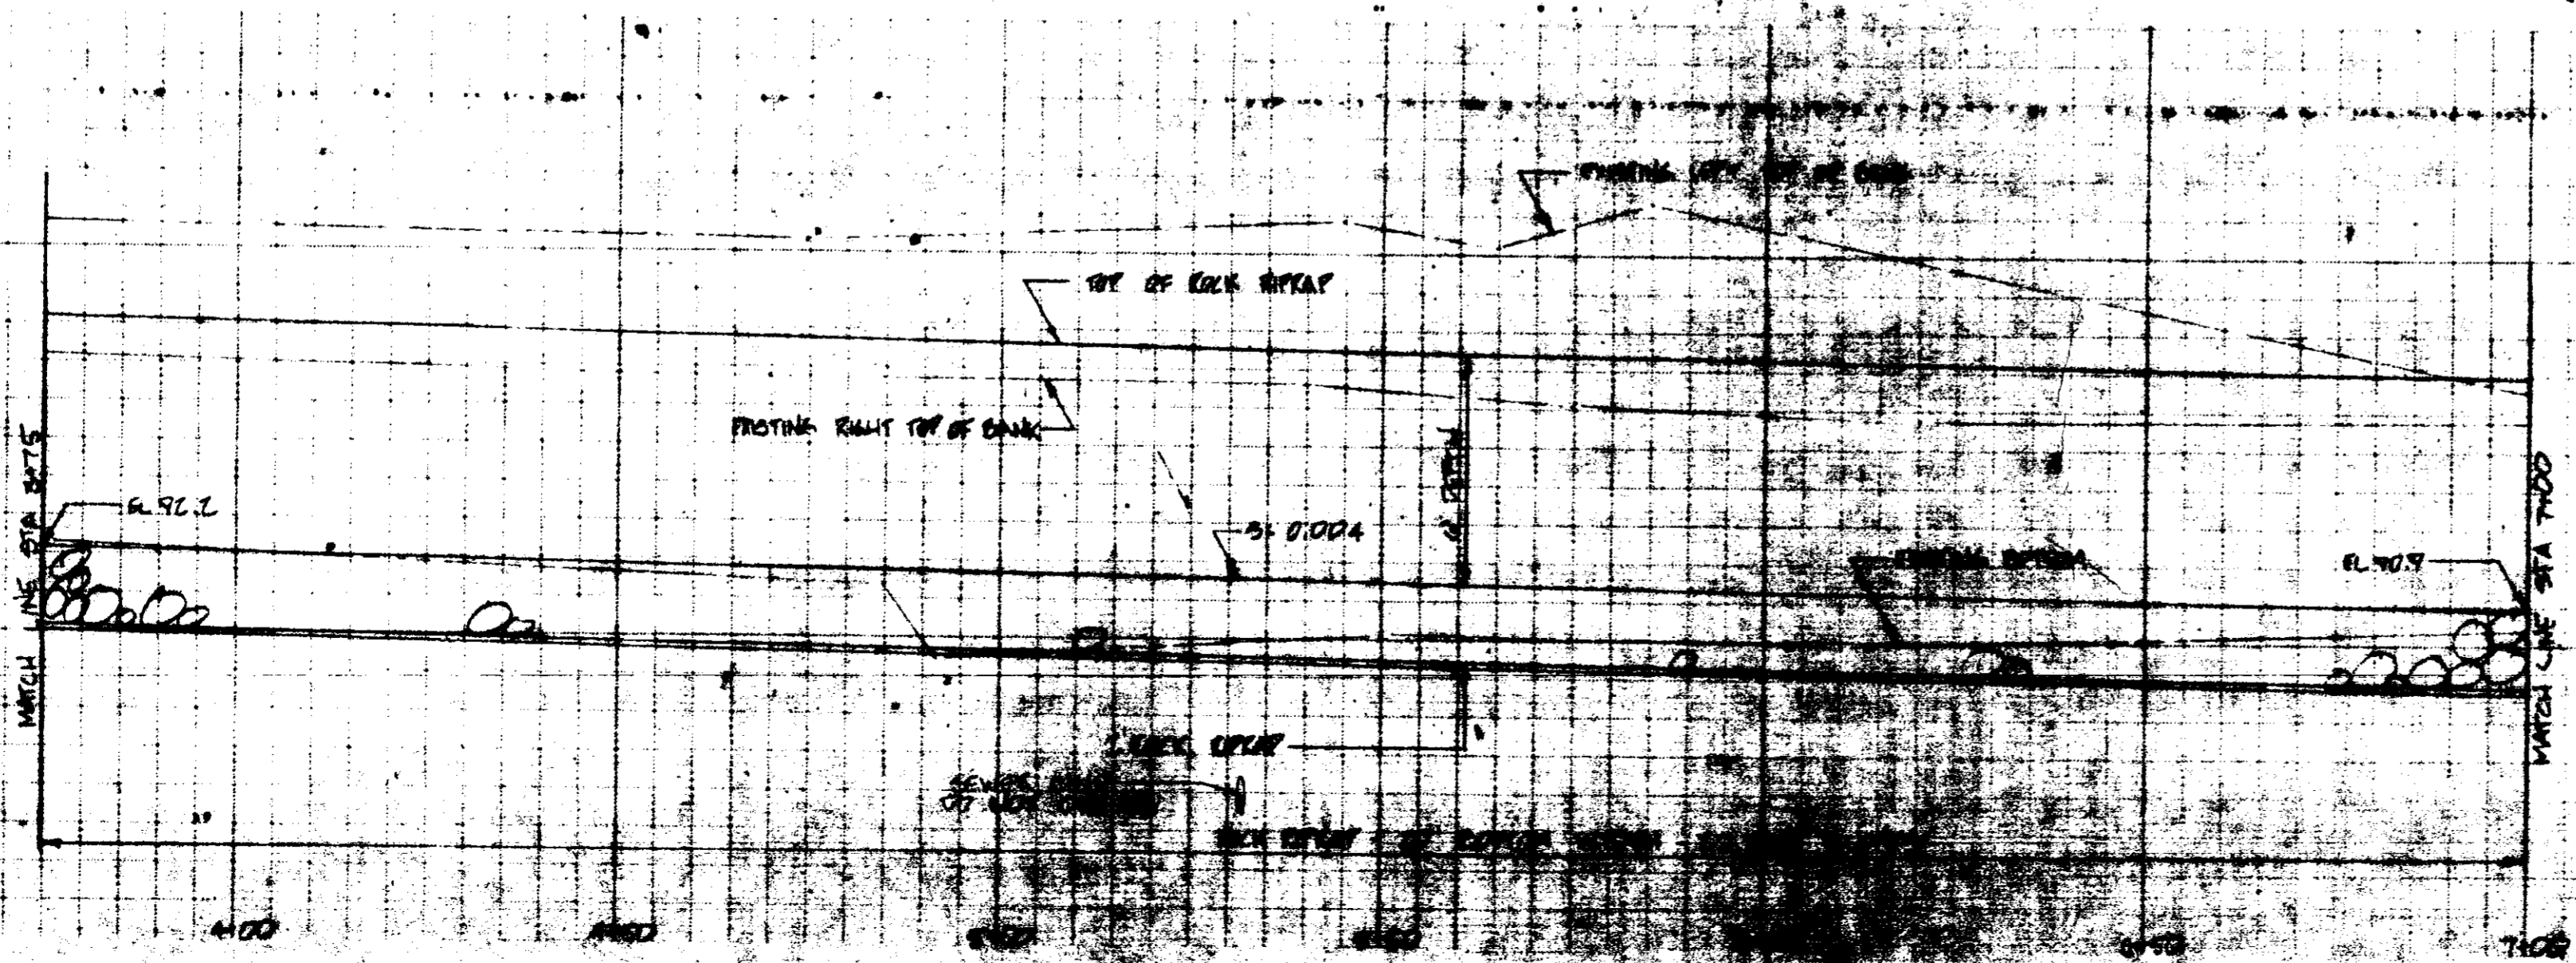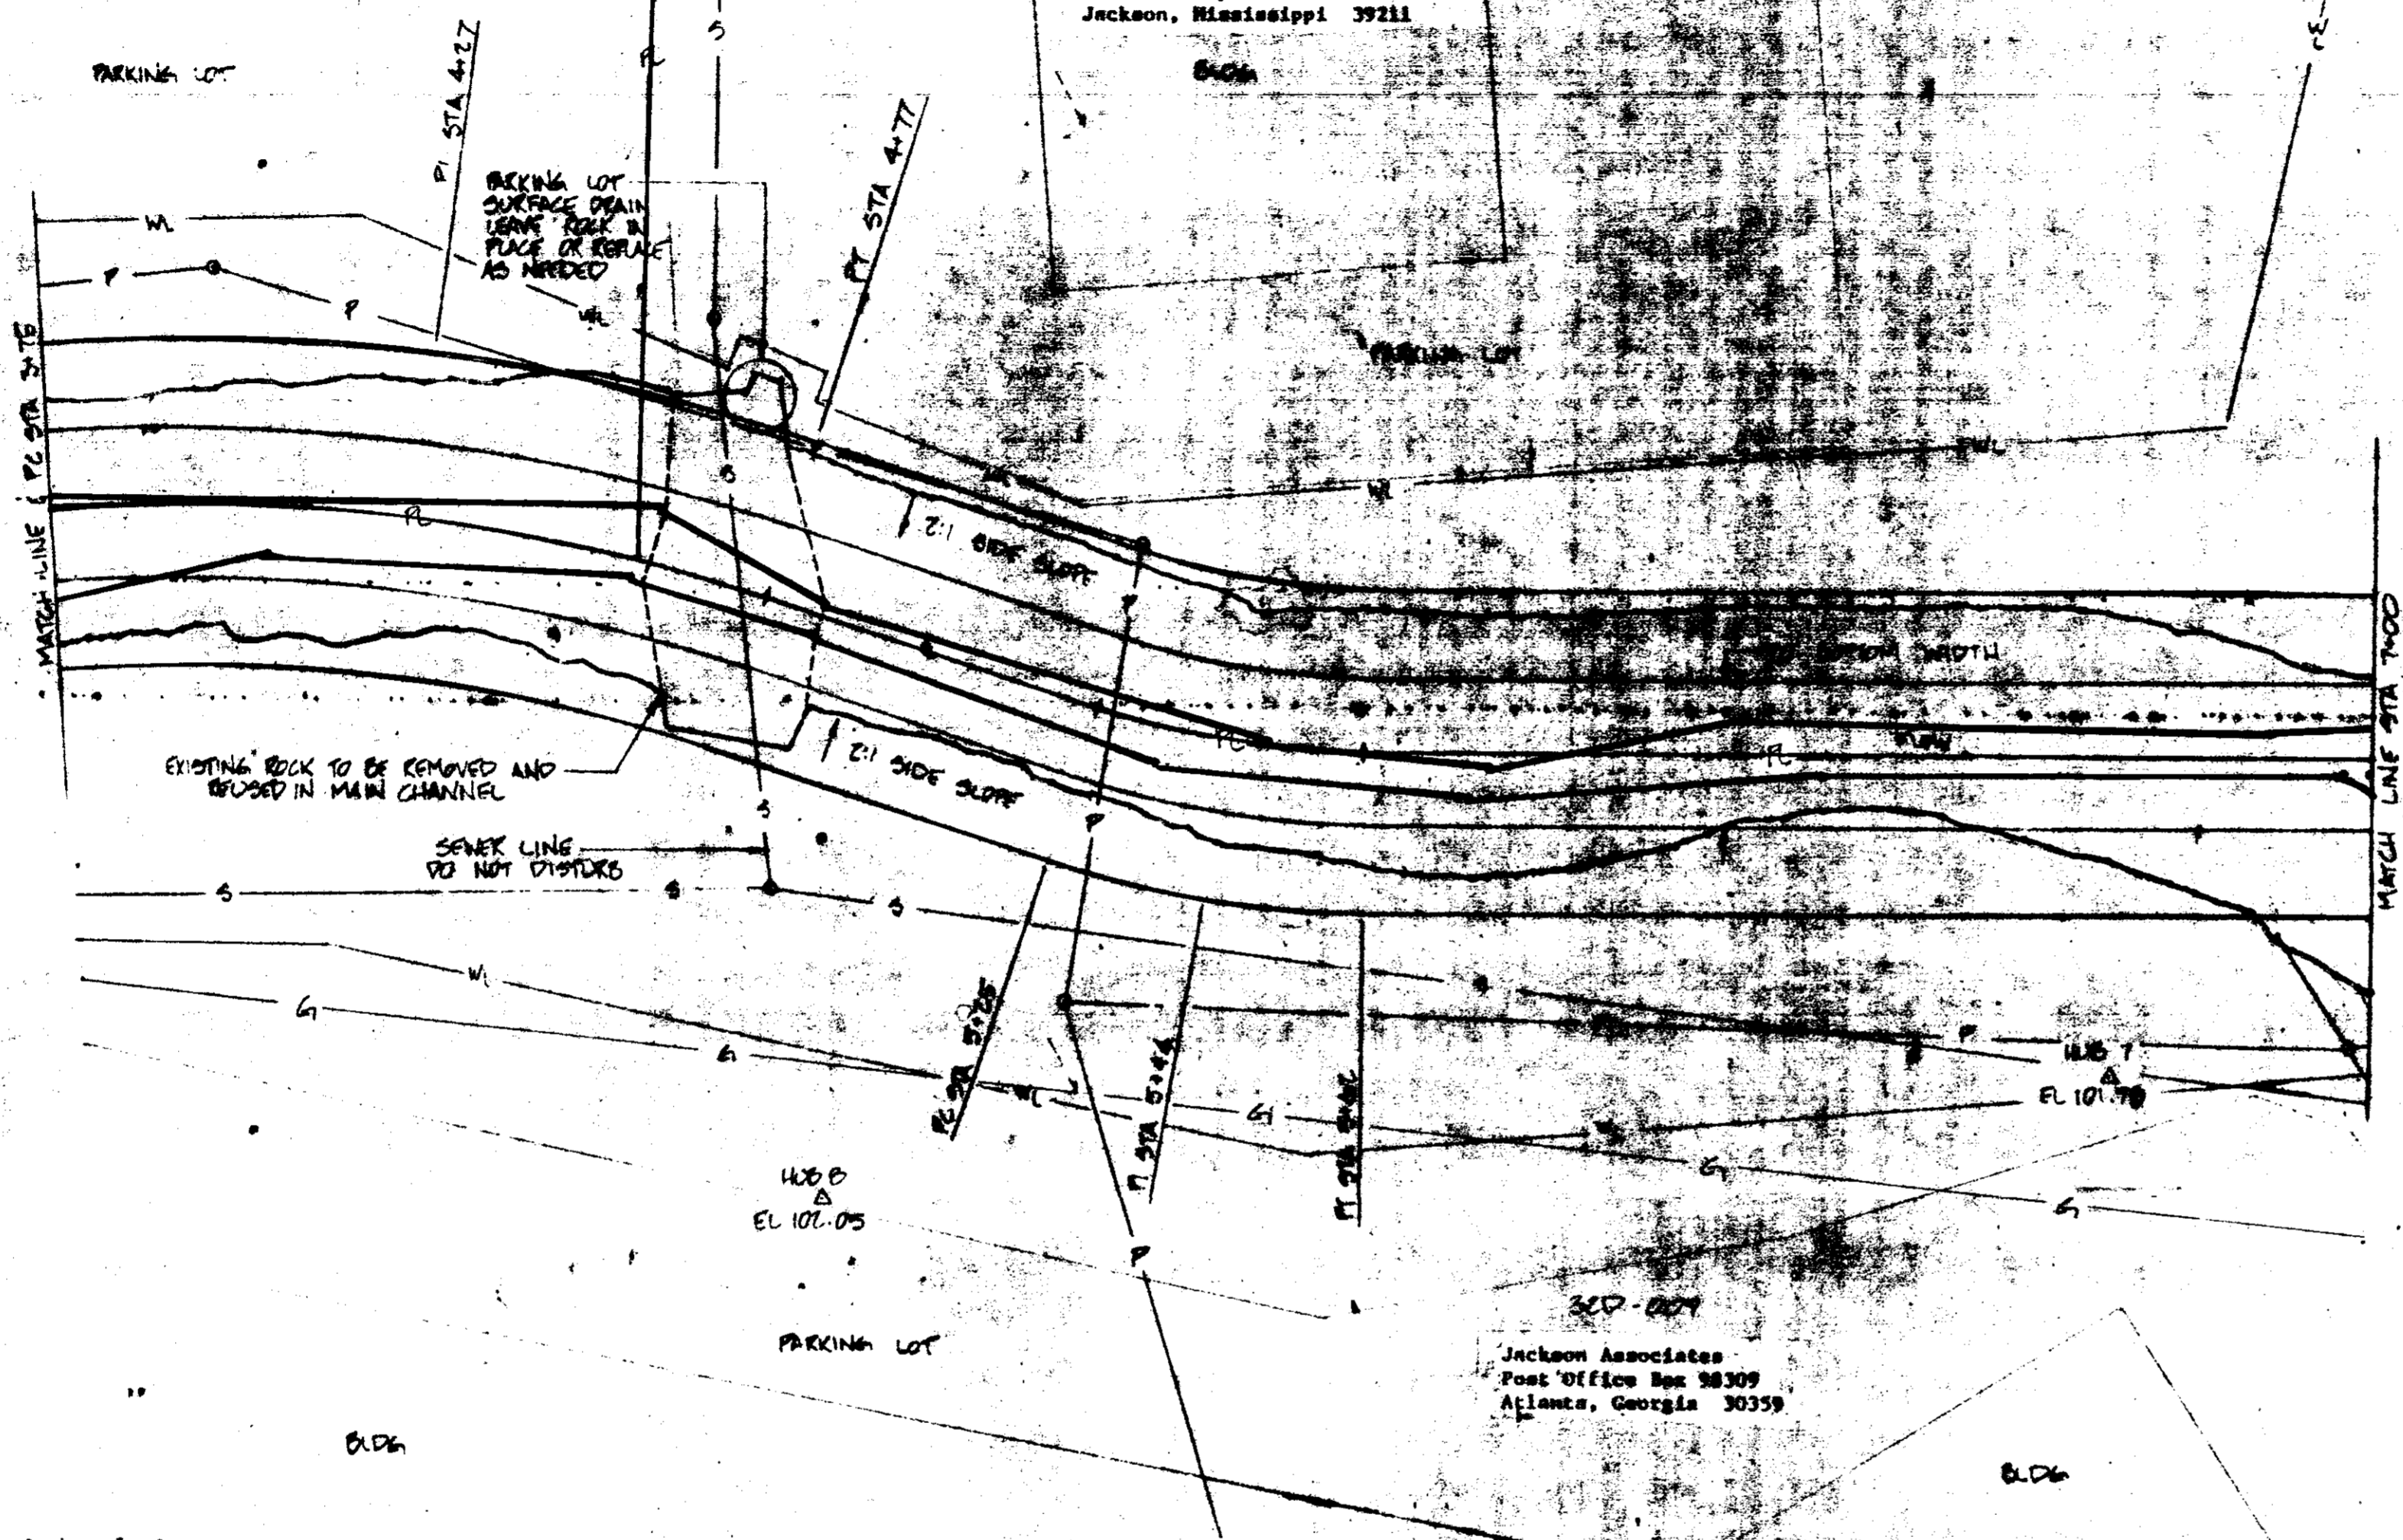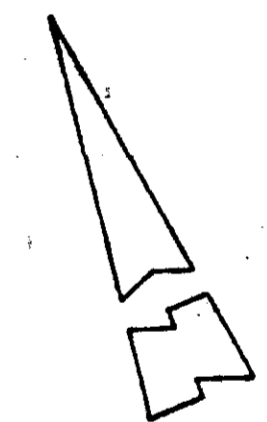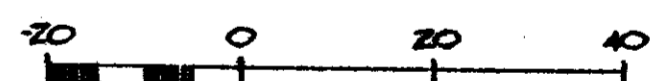


PINE KNOLL
 CITY OF RIDGELAND
 MADISON COUNTY, MISSISSIPPI
 EMERGENCY WATERSHED PROTECTION
 PLAN AND PROFILE

**U. S. DEPARTMENT OF AGRICULTURE
 SOIL CONSERVATION SERVICE**


| | | |
|--------------|-----------|------------------|
| Designed RRL | Date 2-87 | Approved by |
| Drawn NEM | Date 2-87 | Title |
| Traced | | Title |
| Checked RRL | Date 4-87 | Sheet No. 2 of 4 |
| | | Drawing No. |

APPARENT LANDRIGHTS MAP
 NOTE: PROPERTY LINE ARE APPARENT
 NOT SURVEYED

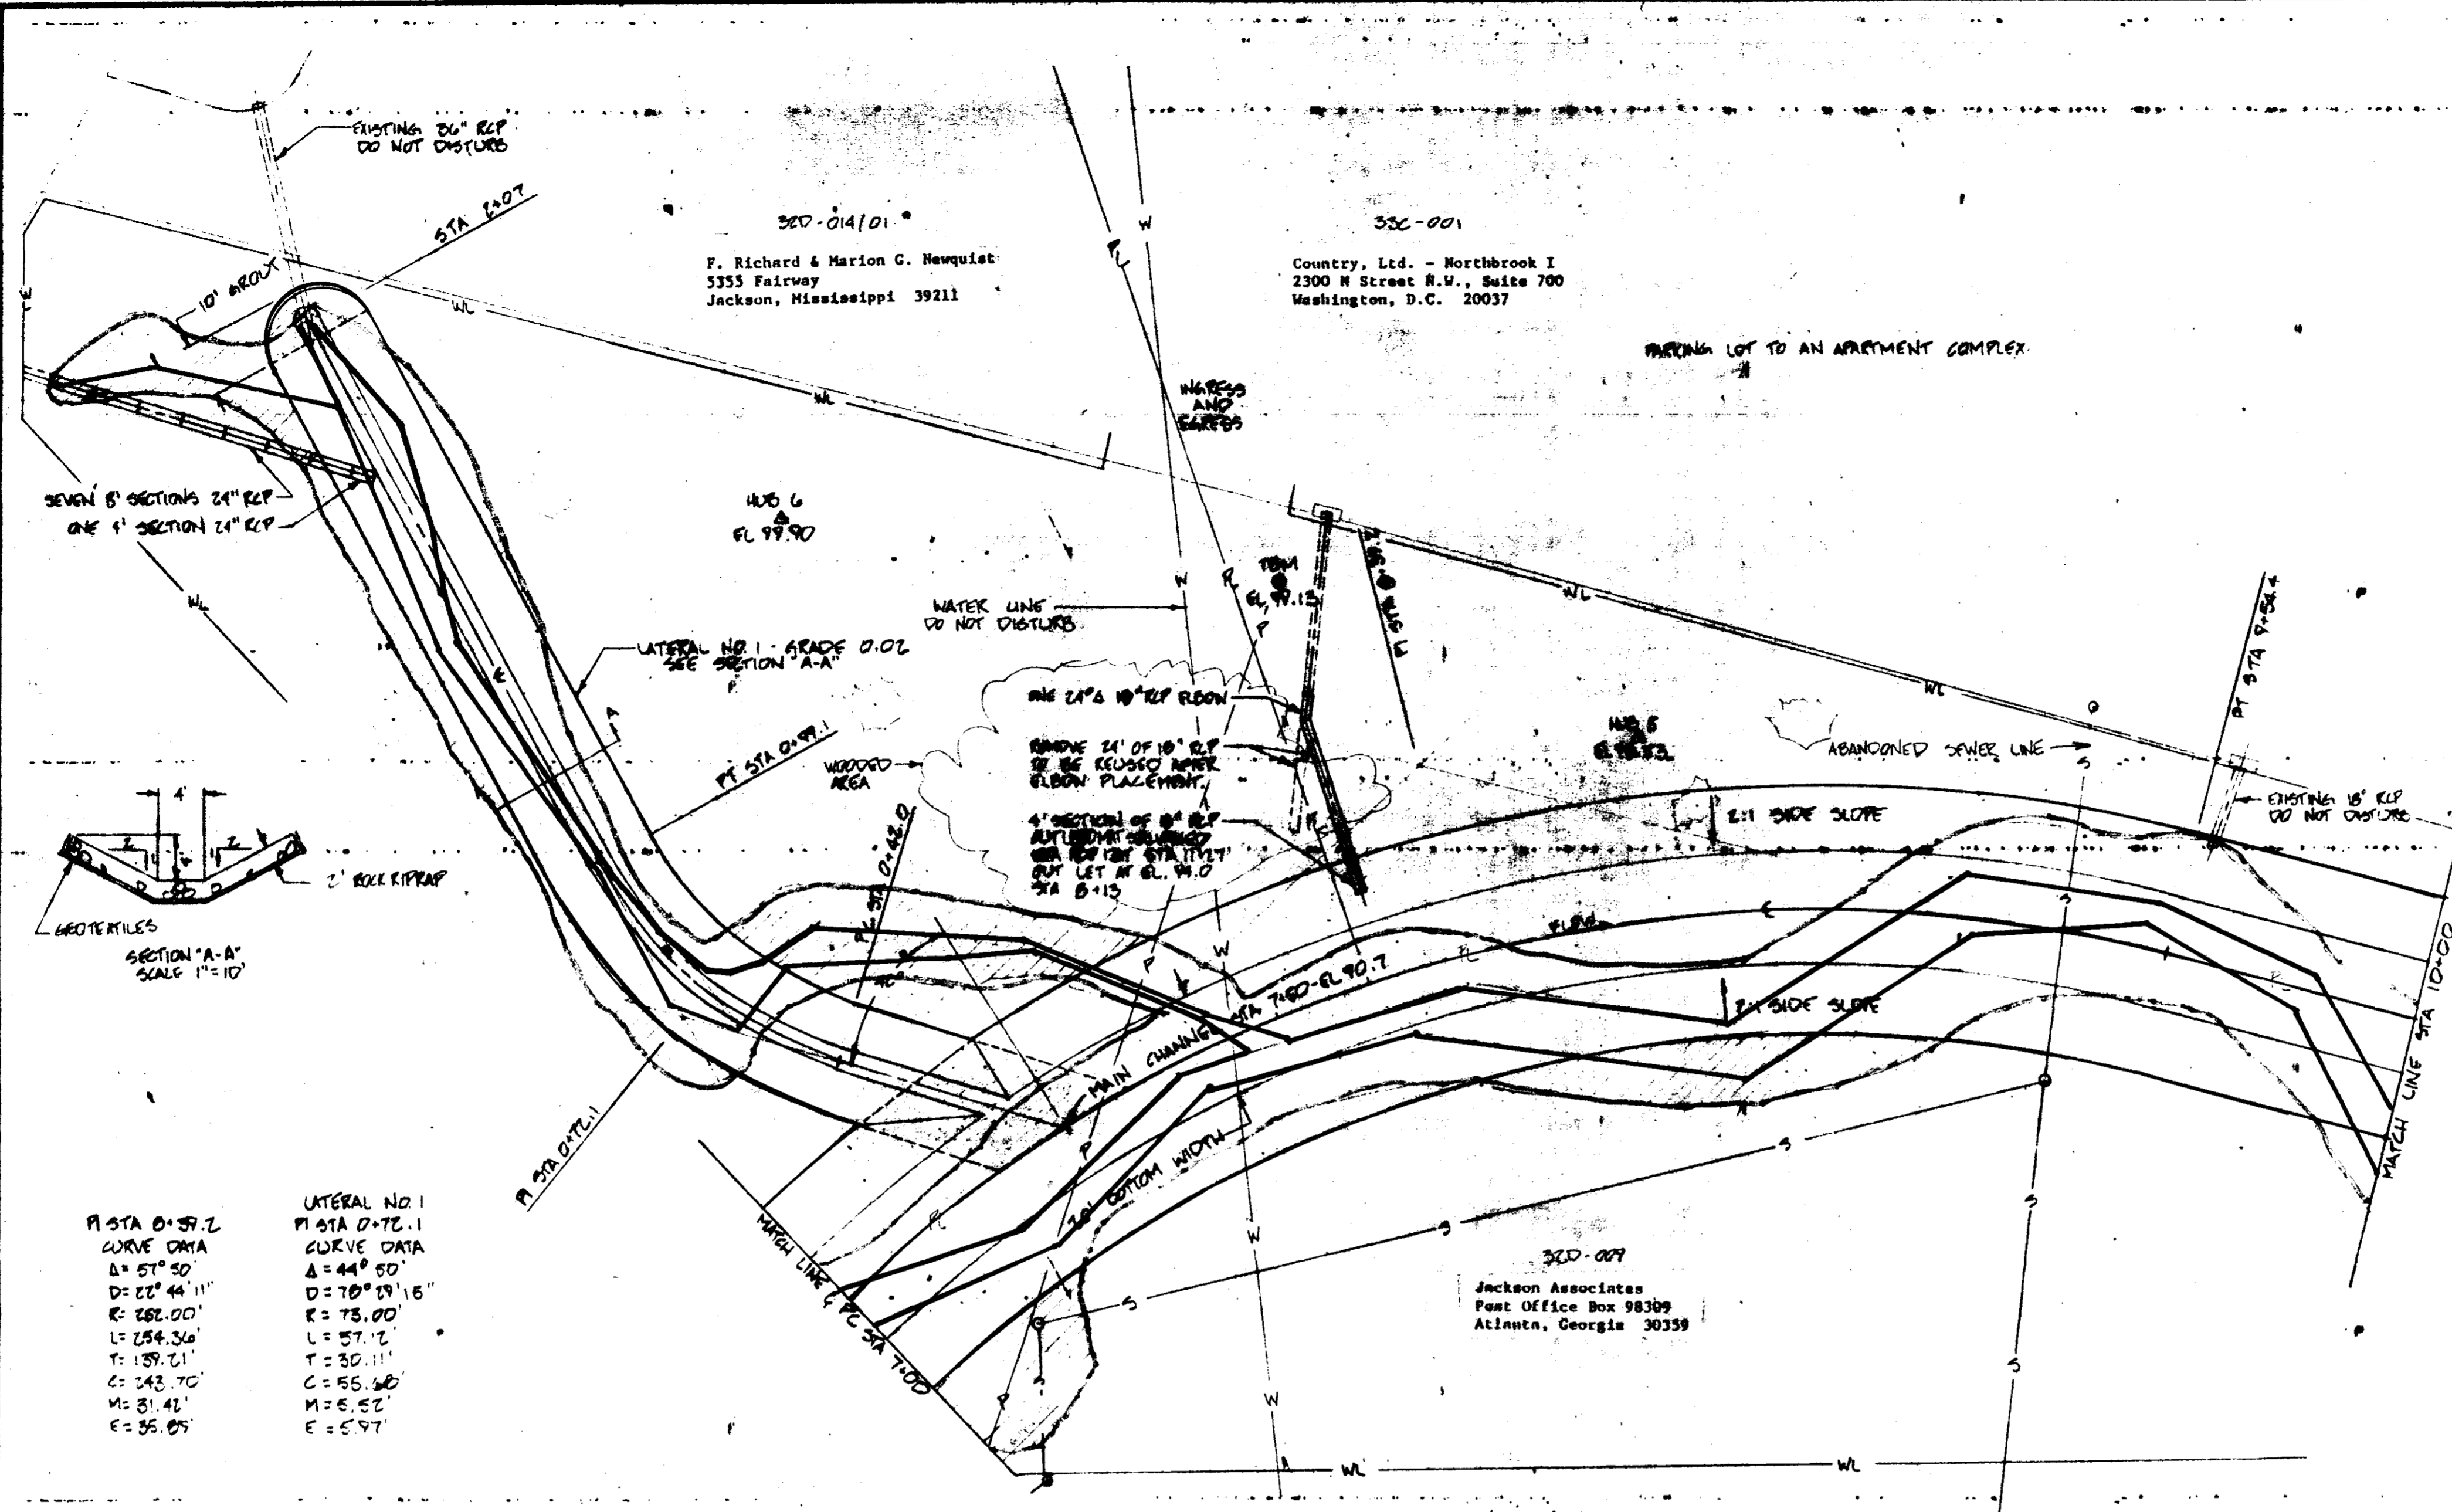


PROPERTY LINE
 PROPOSED TOP OF BANK
 EXISTING TOP OF BANK
 EXISTING TOE

- LEGEND**
- △ TRANSIT STATION PLOTTED POINT
 - POWER LINE W/ MANHOLE
 - TELEPHONE LINE W/ JUNCTION BOX & POLE
 - POWER LINE W/ POLE
 - WATER LINE W/ METER
 - GAS LINE W/ METER
 - EXISTING FENCE LINE
 - EXISTING TOE
 - EXISTING TOP OF BANK
 - APPROX LIMIT OF CUT
 - APPROX LIMIT OF WORK
 - /// EARTH FILL
 - CONCRETE GROUT
 - EROSION CONTROL BLANKET

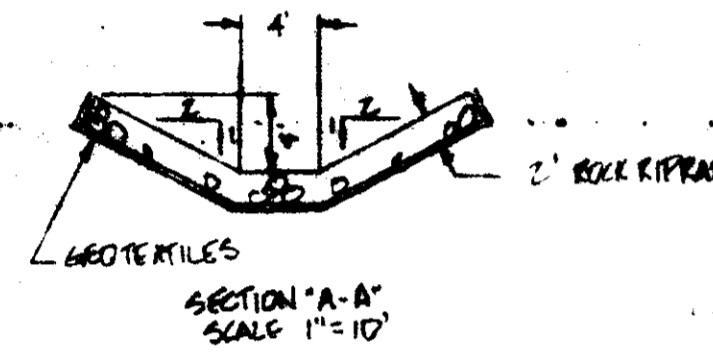

PI STA 0+59.2
 CURVE DATA
 Δ = 57° 50'
 D = 22° 44' 11"
 R = 262.00'
 L = 254.36'
 T = 139.21'
 C = 243.70'
 M = 31.42'
 E = 35.05'

LATERAL NO. 1
 PI STA 0+72.1
 CURVE DATA
 Δ = 44° 50'
 D = 70° 59' 16"
 R = 73.00'
 L = 57.12'
 T = 30.11'
 C = 55.60'
 M = 5.52'
 E = 5.97'

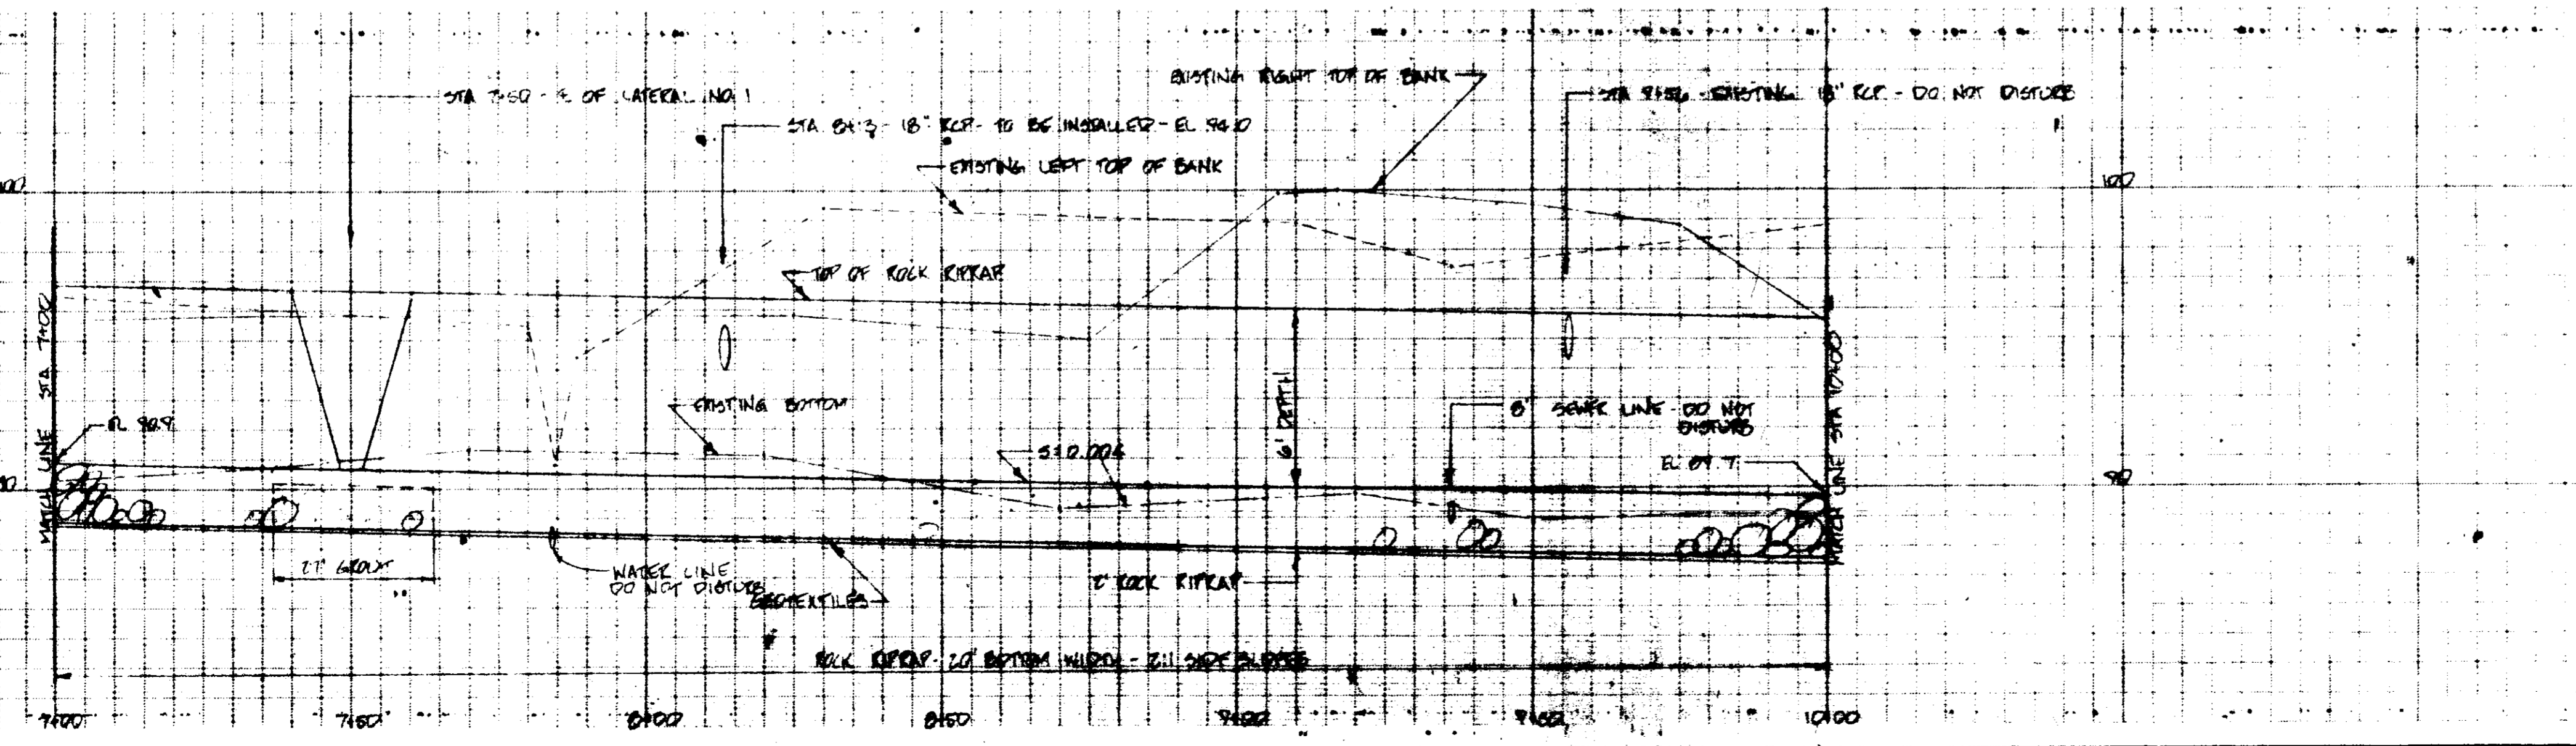

PINE KNOLLS
 CITY OF RICHMOND
 MADISON COUNTY MISSISSIPPI
 EMERGENCY WATERWAYS PROTECTION
 PLAN AND PROFILE

U. S. DEPARTMENT OF AGRICULTURE
 SOIL CONSERVATION SERVICE

| | | |
|---------------------|--------------------|-------------------|
| Designed <i>RLC</i> | Date <i>2-85</i> | Approved by _____ |
| Drawn <i>NEJ</i> | Sheet <i>2</i> | Title _____ |
| Traced _____ | Sheet No. <i>2</i> | Drawing No. _____ |
| Checked <i>RLC</i> | Date <i>4-85</i> | of <i>4</i> |

306-001
 Country, Ltd. - Northbrook I
 2300 N Street N.W. / Suite 708
 Washington, D.C. 20037

PARKWAY LOT FOR APARTMENT COMPLEX

APPARENT LANDRIGHTS MAP
 NOTE: PROPERTY LINES ARE APPARENT
 NOT SURVEYED





PROPERTY LINE
 PROPOSED TOP OF BANK
 EXISTING TOP OF BANK
 EXISTING TOE

- LEGEND**
- △ TRANSIT STATION
 - PLOTTED POINT
 - SEWER LINE W/ MANHOLE
 - TELEPHONE LINE W/ JUNCTION BOX & POLE
 - POWER LINE W/ POLE
 - WATER LINE W/ METER
 - GAS LINE W/ METER
 - EXISTING FENCE LINE
 - EXISTING TOE
 - PROPOSED TOP OF BANK
 - APPROX. LIMIT OF CUT
 - APPROX. LIMIT OF WORK
 - /// EARTH FILL
 - CONCRETE GROUT
 - EROSION CONTROL BLANKET

STA 1150+7
 CURVE DATA
 Δ = 37° 16'
 D = 16' 09" 53"
 R = 471.00'
 L = 326.21'
 T = 150.74'
 C = 340.05'
 M = 74.57'
 E = 26.03'

STA 1151+2
 CURVE DATA
 Δ = 36° 00'
 D = 90' 00" 7"
 R = 54.00'
 L = 34.71'
 T = 7' 95"
 C = 54.12'
 M = 3.75'
 E = 2.15'

530-009
 Jackson Associates
 Post Office Box 98309
 Atlanta, Georgia 30339

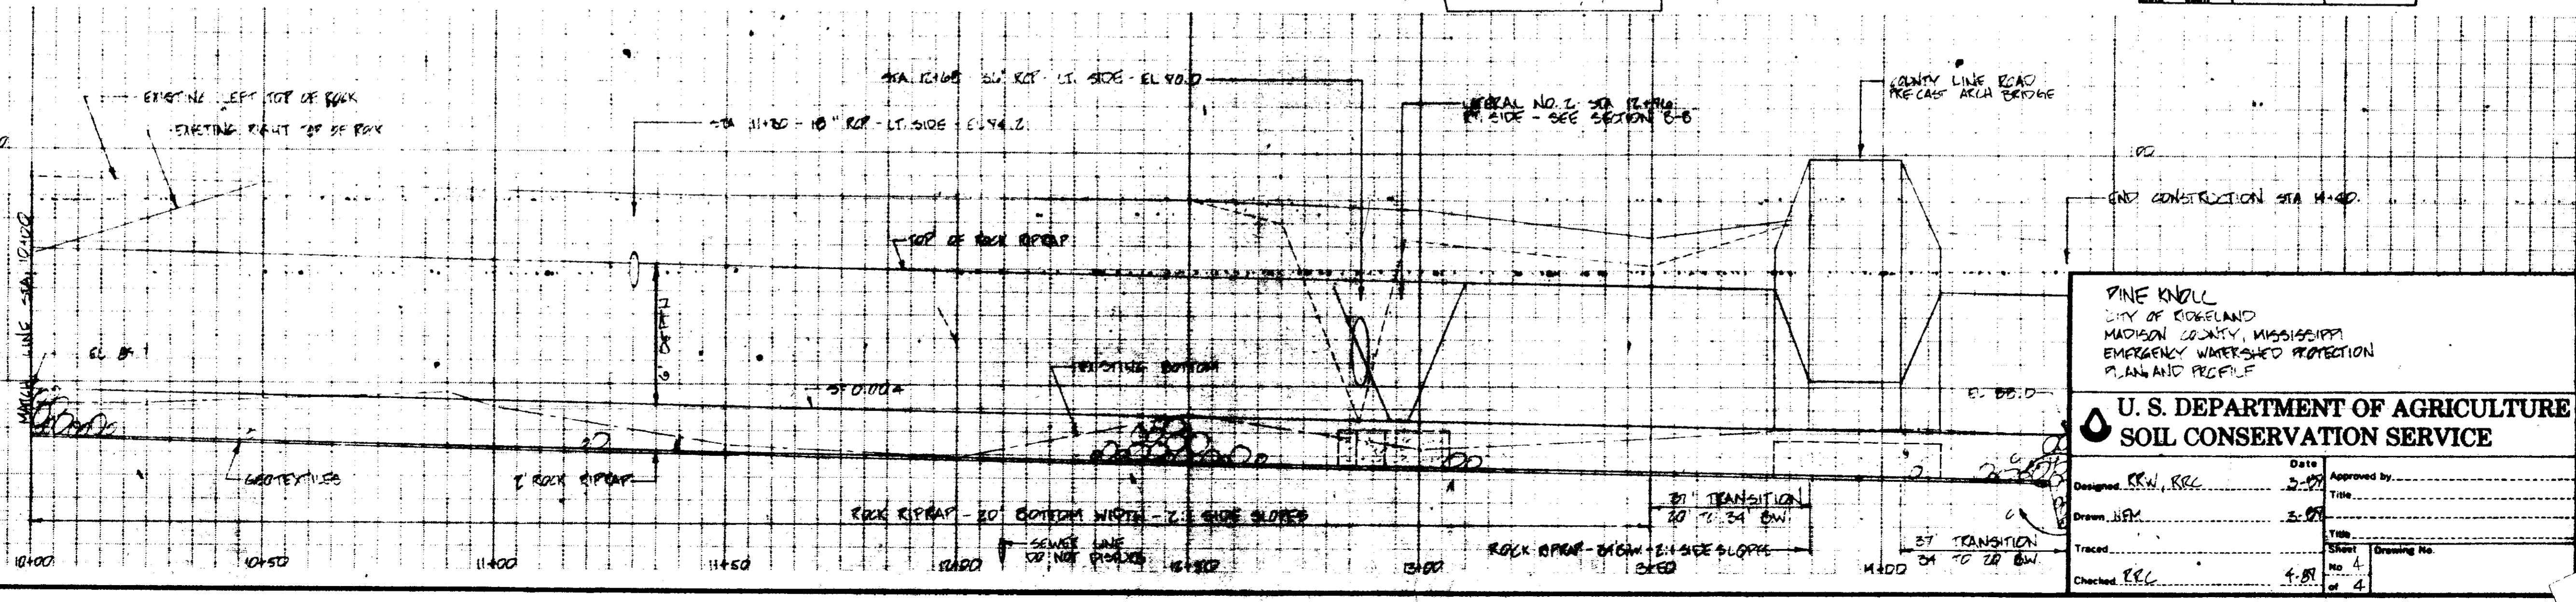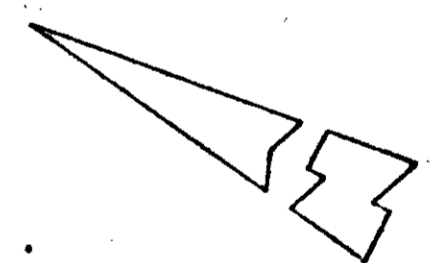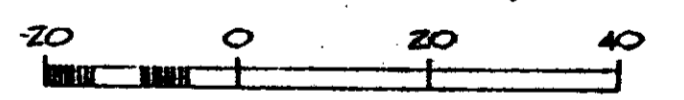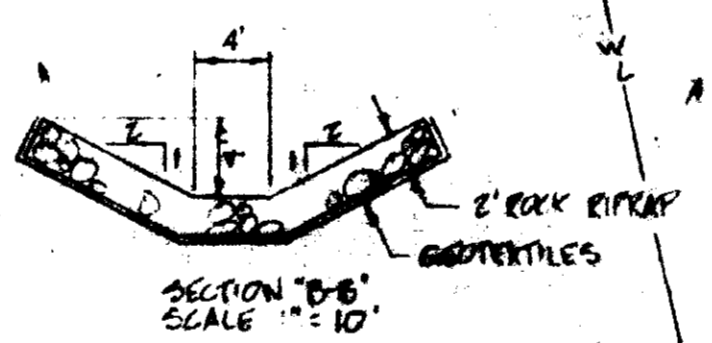

PINE KNOLL
 CITY OF COBLENDA
 MADISON COUNTY, MISSISSIPPI
 EMERGENCY WATERSHED PROTECTION
 PLAN AND PROFILE

**U. S. DEPARTMENT OF AGRICULTURE
 SOIL CONSERVATION SERVICE**

| | | |
|--------------------|--------------|--------------|
| Designed: KRW, RCL | Date: 5-99 | Approved by: |
| Drawn: JRM | Title: | |
| Traced: | Sheet: No. 4 | Drawing No. |
| Checked: RCL | of 4 | |