
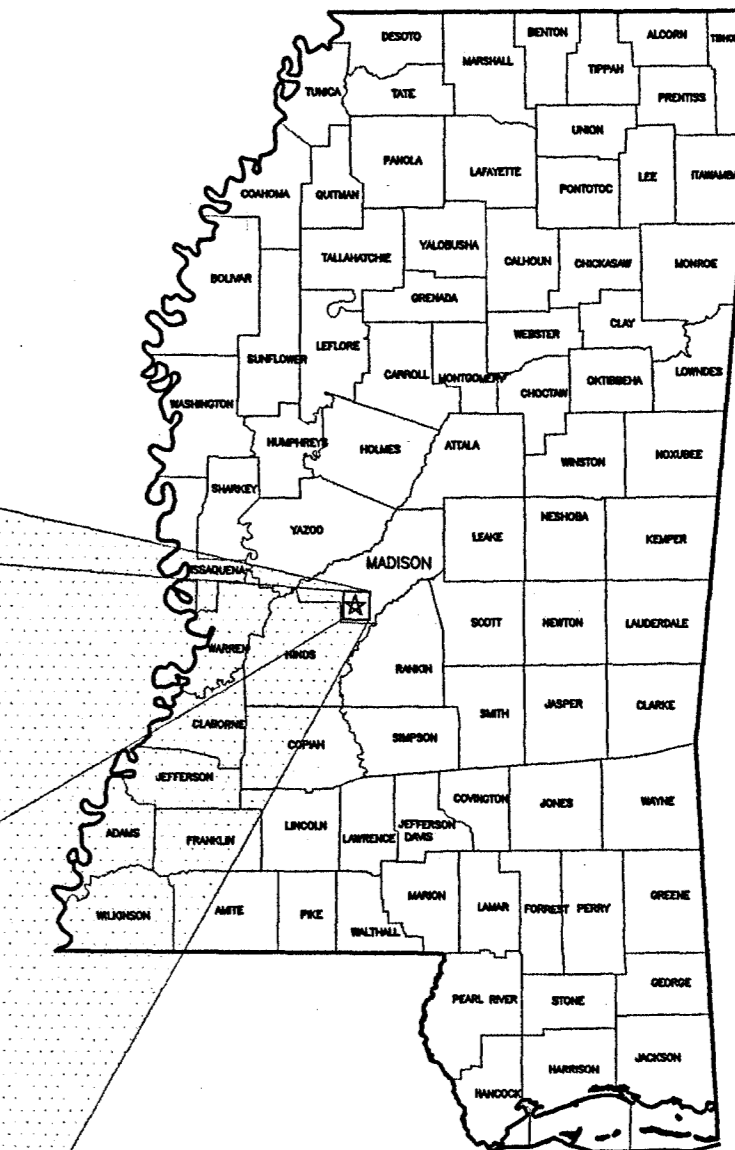


PONDAROSA PLACE DRAINAGE IMPROVEMENTS RIDGELAND, MISSISSIPPI

INDEX TO DRAWINGS	
SHEET NO.	TITLE
L1.1	SHEET LAYOUT & GENERAL NOTES
PP1.1	PLAN AND PROFILE SHEET STA. -2+80 - STA. 0+00
PP1.2	PLAN AND PROFILE SHEET STA. 0+00 - STA. 6+00
PP1.3	PLAN AND PROFILE SHEET STA. 6+00 - STA. 12+00
PP1.4	PLAN AND PROFILE SHEET STA. 12+00 - STA. 18+00
PP1.5	PLAN AND PROFILE SHEET STA. 18+00 - STA. END
C1.1	CROSS SECTIONS
C1.2	CROSS SECTIONS
C1.3	CROSS SECTIONS
D1.1	STANDARD DETAILS
D1.2	STANDARD DETAILS
PBC-1	PRECAST CONCRETE BOX CULVERT
PBC-2	PRECAST CONCRETE BOX CULVERT END SECTIONS

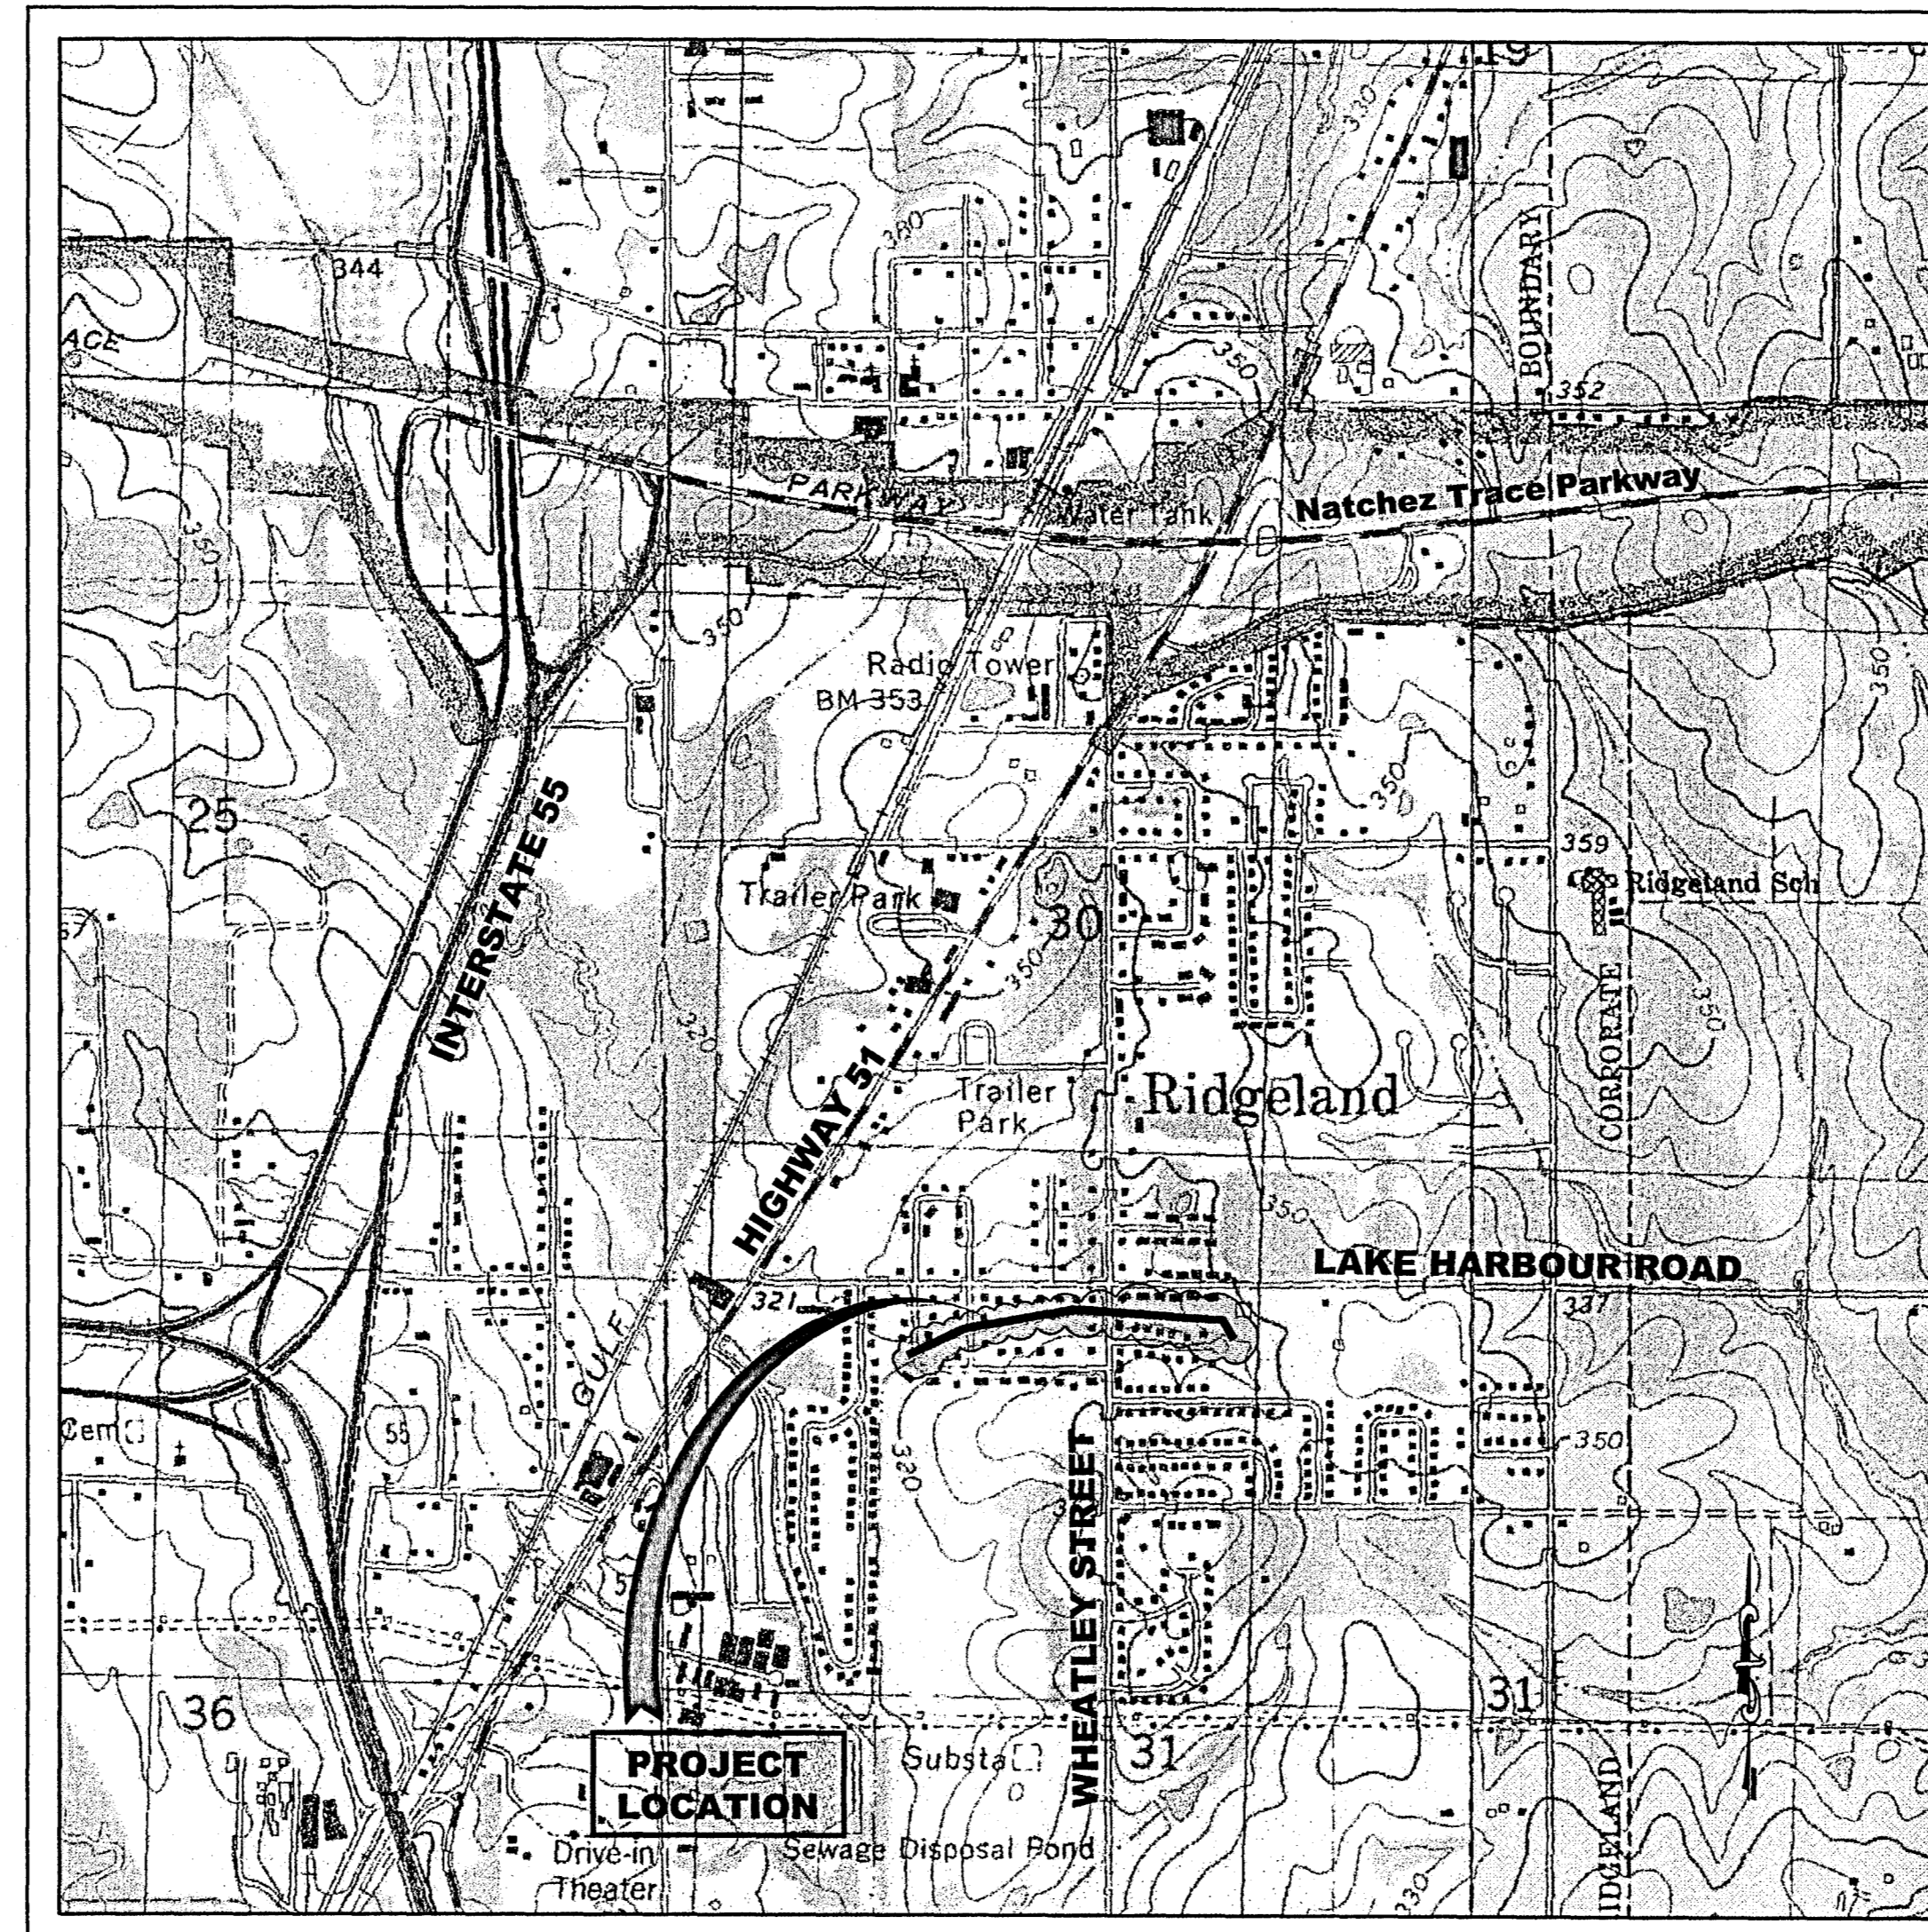

MAYOR
GENE McGEE


PUBLIC WORKS DIRECTOR
MIKE McCOLLUM

ASS. PUBLIC WORKS DIRECTOR
BEN MAYS, CET

CHIEF ENGINEER
DAVID WILLIAMS, PE

DRAINAGE ENGINEER
CYNTHIA JAMES, EIT

VICINITY MAP
APRIL 2005
WEI #W03-055


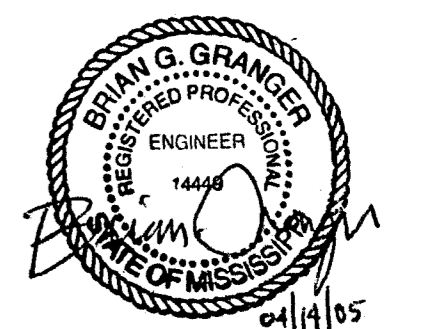


RIDGELAND, MISSISSIPPI
PONDAROSA PLACE DRAINAGE IMPROVEMENTS
W03-055

PWP-01633

BOP STA. -2+76.35

MATCH LINE STA. 0+00

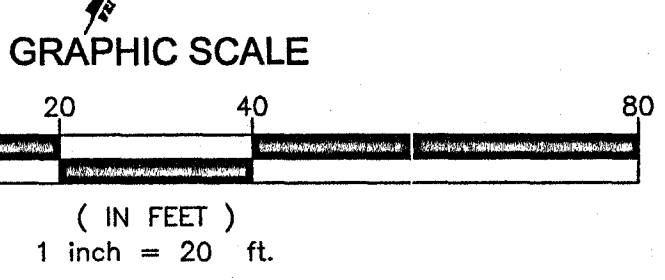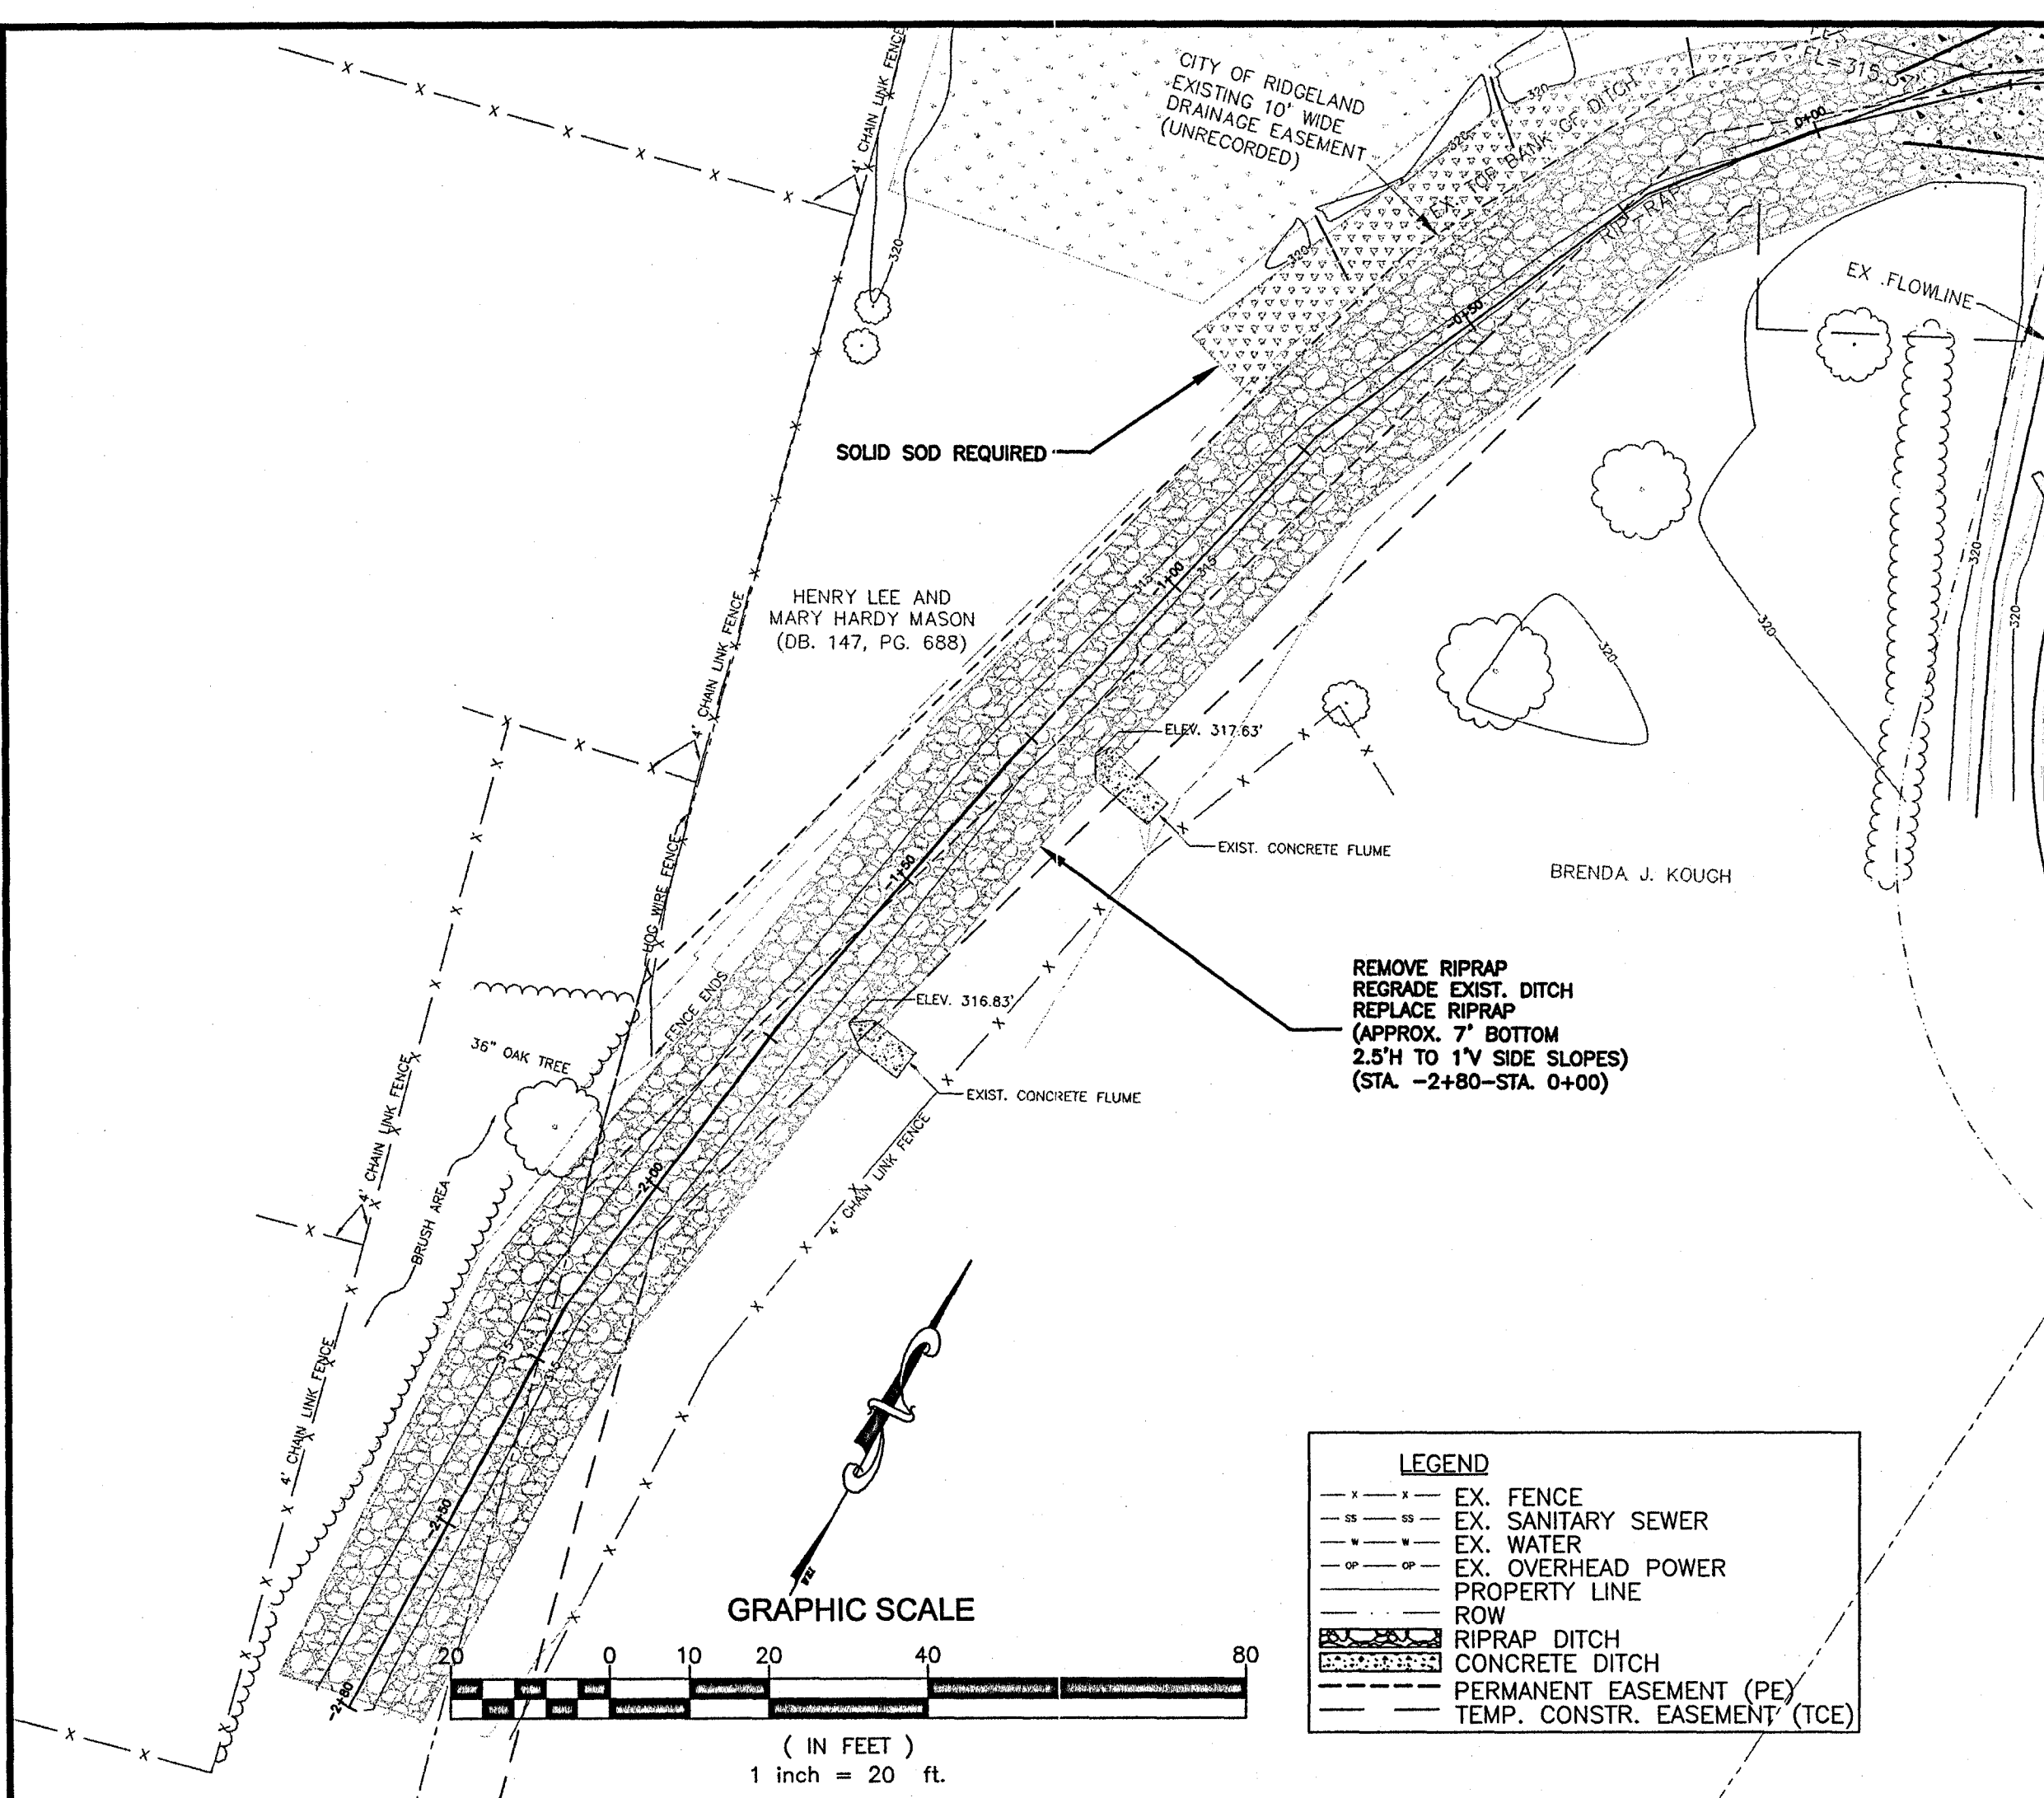

LEGEND


- - - EX. FENCE
- - - EX. SANITARY SEWER
- - - EX. WATER
- - - EX. OVERHEAD POWER
- — — PROPERTY LINE
- — — ROW
- — — RIPRAP DITCH
- — — CONCRETE DITCH
- — — PERMANENT EASEMENT (PE)
- — — TEMP. CONSTR. EASEMENT (TCE)

ELEV
330
325
320
315
310
305
EXISTING ELEV.
PROPOSED ELEV.

ELEV
330
325
320
315
310
305
EXISTING ELEV.
PROPOSED ELEV.

LEGEND

- - - EXISTING FLOWLINE
- — — PROPOSED FLOWLINE


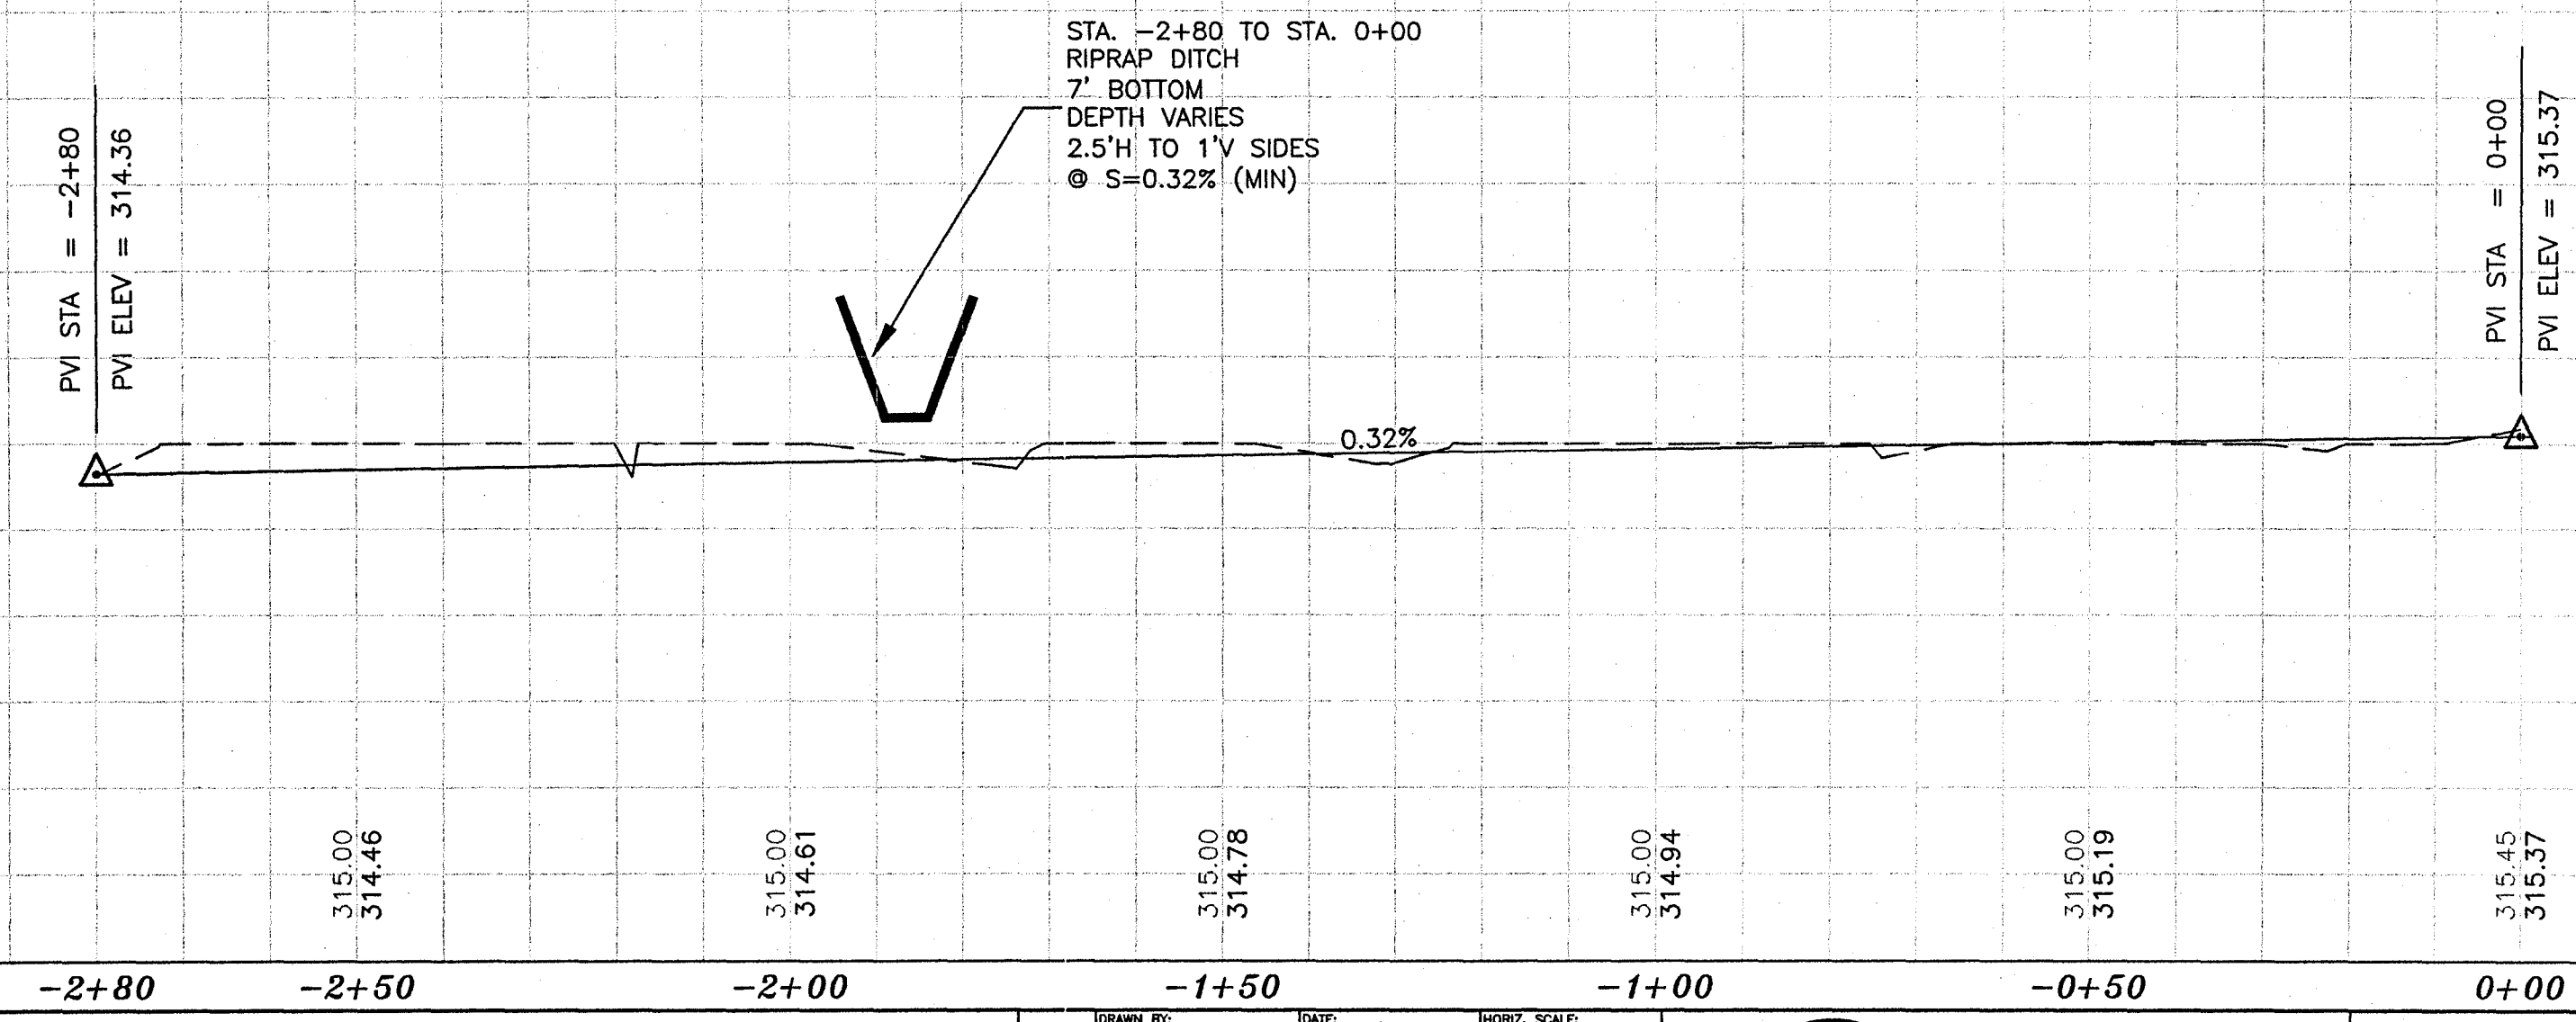


NO.	DATE	REVISIONS	BY	DESIGNED BY: JJP	CHECKED BY: BGG	DATE: 4/05	PROJECT: W03055	HORIZ. SCALE: 1" = 20'	VERT. SCALE: 1" = 5'		143-A LEFLEURS SQUARE JACKSON, MS 39211 601-355-9526 FAX 601-352-3945	CITY OF RIDGELAND PONDAROSA PLACE DRAINAGE IMPROVEMENTS W03-055	PLAN/PROFILE (STA. -2+80 TO STA. 0+00)	SHEET NUMBER: PP1.1
-----	------	-----------	----	------------------	-----------------	------------	-----------------	------------------------	----------------------	--	--	---	---	-------------------------------

P:\Ridgeland_City of W03-055-Pondarosa\dwg\W03055 PLAN_09-14-04.dwg, PP1.1, 4/13/2005 4:06:35 PM, Doc ID5600_3-res.pct

MATCH LINE STA. 0+00



MATCH LINE STA. 6+00

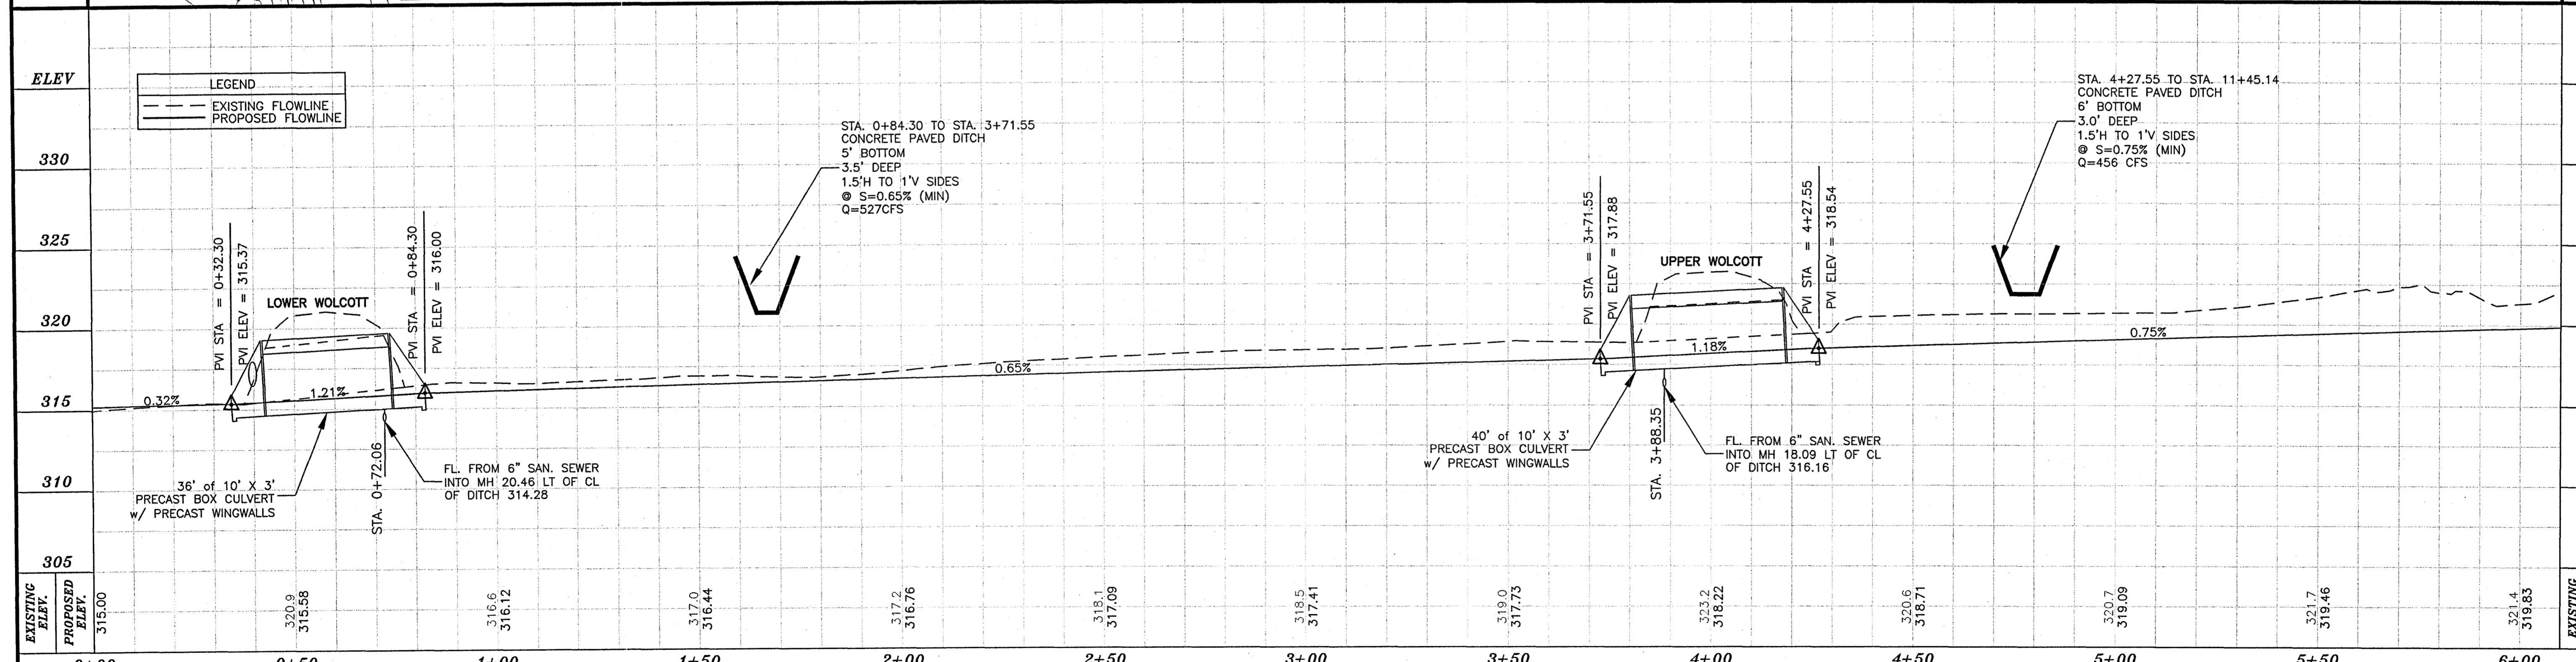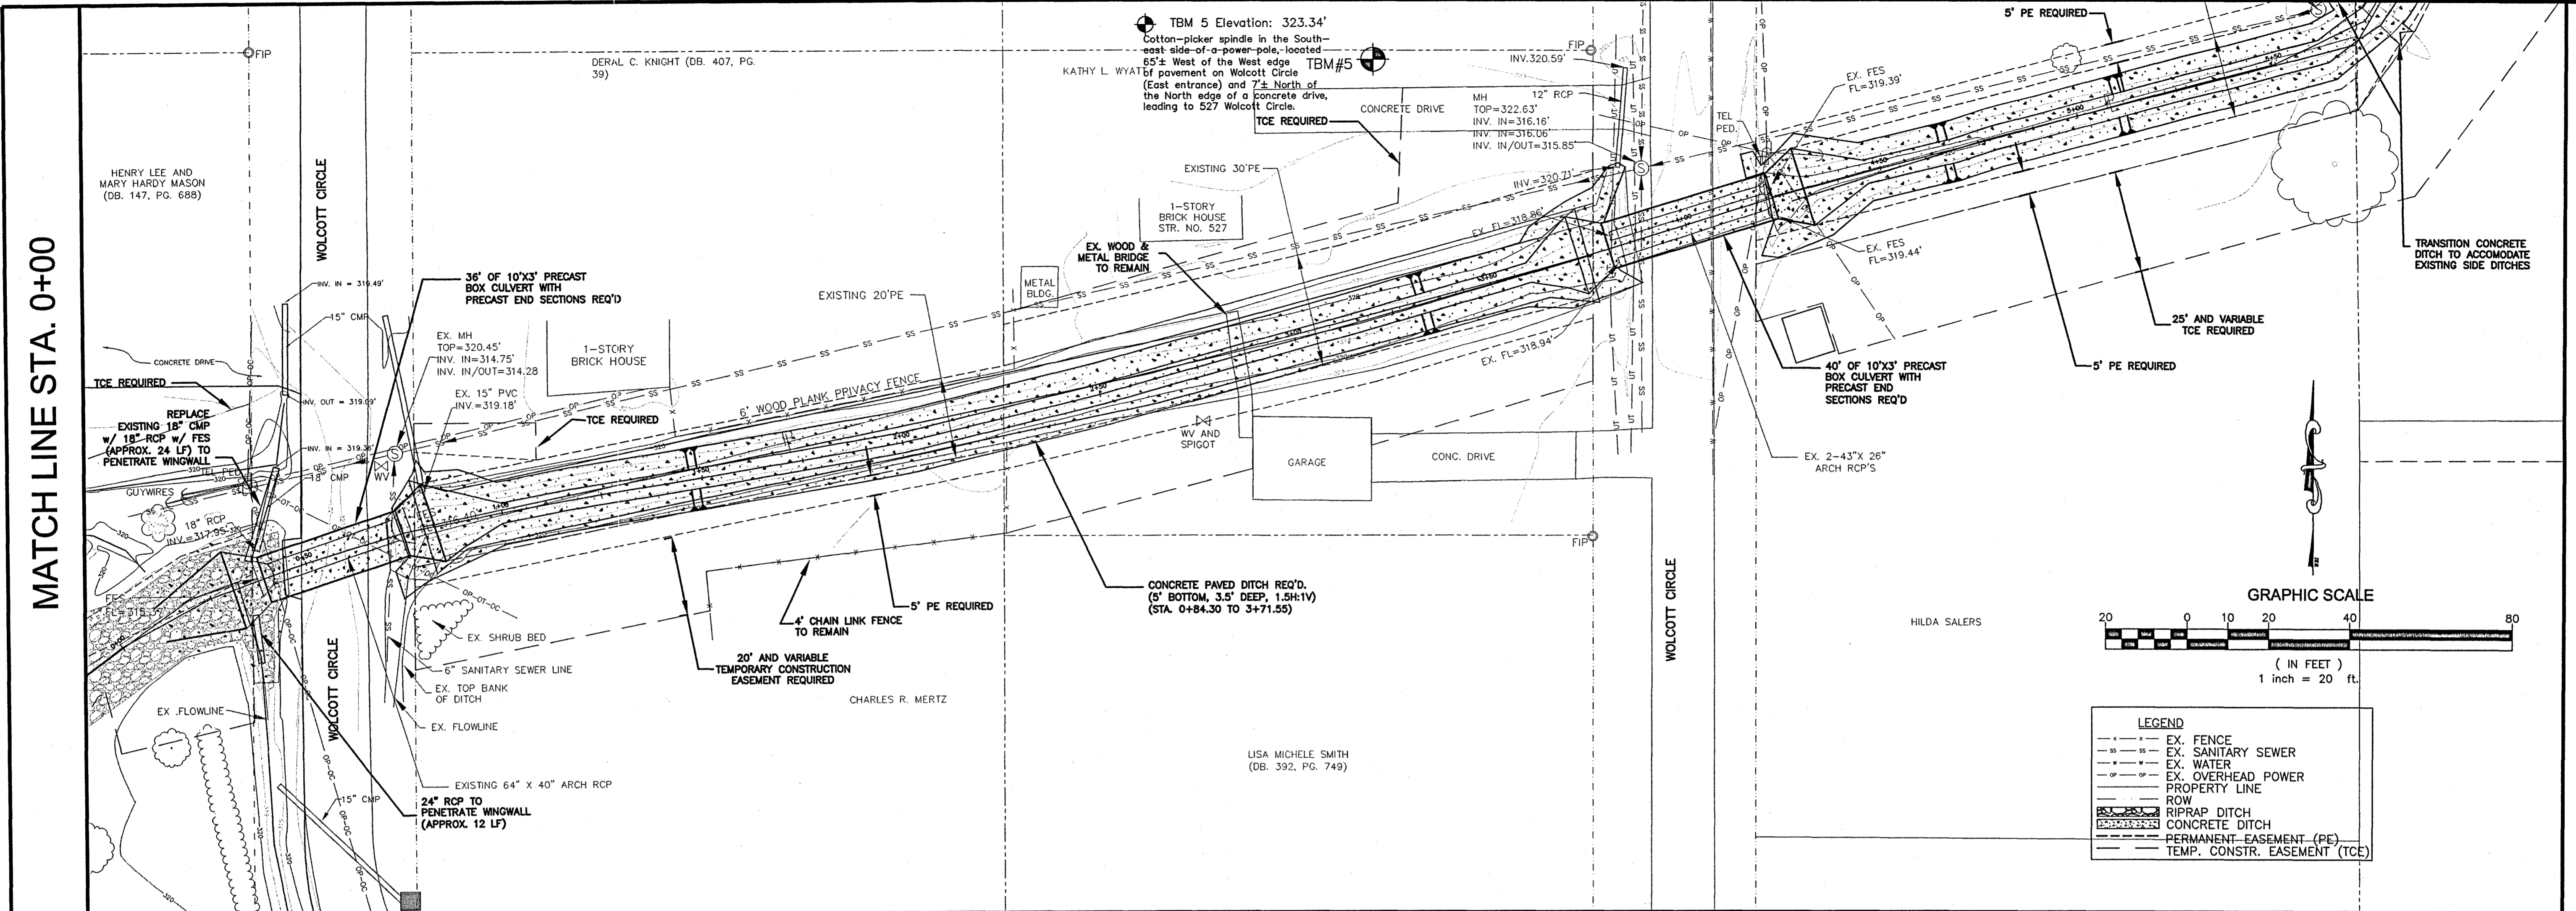

NO.	DATE	REVISIONS	BY	DESIGNED BY: JP	DATE: 4/05	HORIZ. SCALE: 1" = 20'		143-A LEFLEURS SQUARE JACKSON, MS 39211 601-355-9526 FAX 601-352-3945	CITY OF RIDGELAND PONDAROSA PLACE DRAINAGE IMPROVEMENTS W03-055	PLAN/PROFILE (STA. 0+00 TO STA. 6+00)	SHEET NUMBER: PP1.2
				CHECKED BY: BGG	PROJECT: W03055	VERT. SCALE: 1" = 5'					

P:\Ridgeland_City\W03-055-Pondarosa\W03055 PLAN_03-14-04.dwg, PP1.2, 4/13/2005 4:07:16 PM, Oce IDS600 3-new.plt

P:\Ridgeland_City_of\W03-055-Pondarosa\Drawings\W03055_PLAN_09-14-04.dwg, PP1.3, 4/13/2005 4:07:48 PM, Cse TDS800_3--new.pct

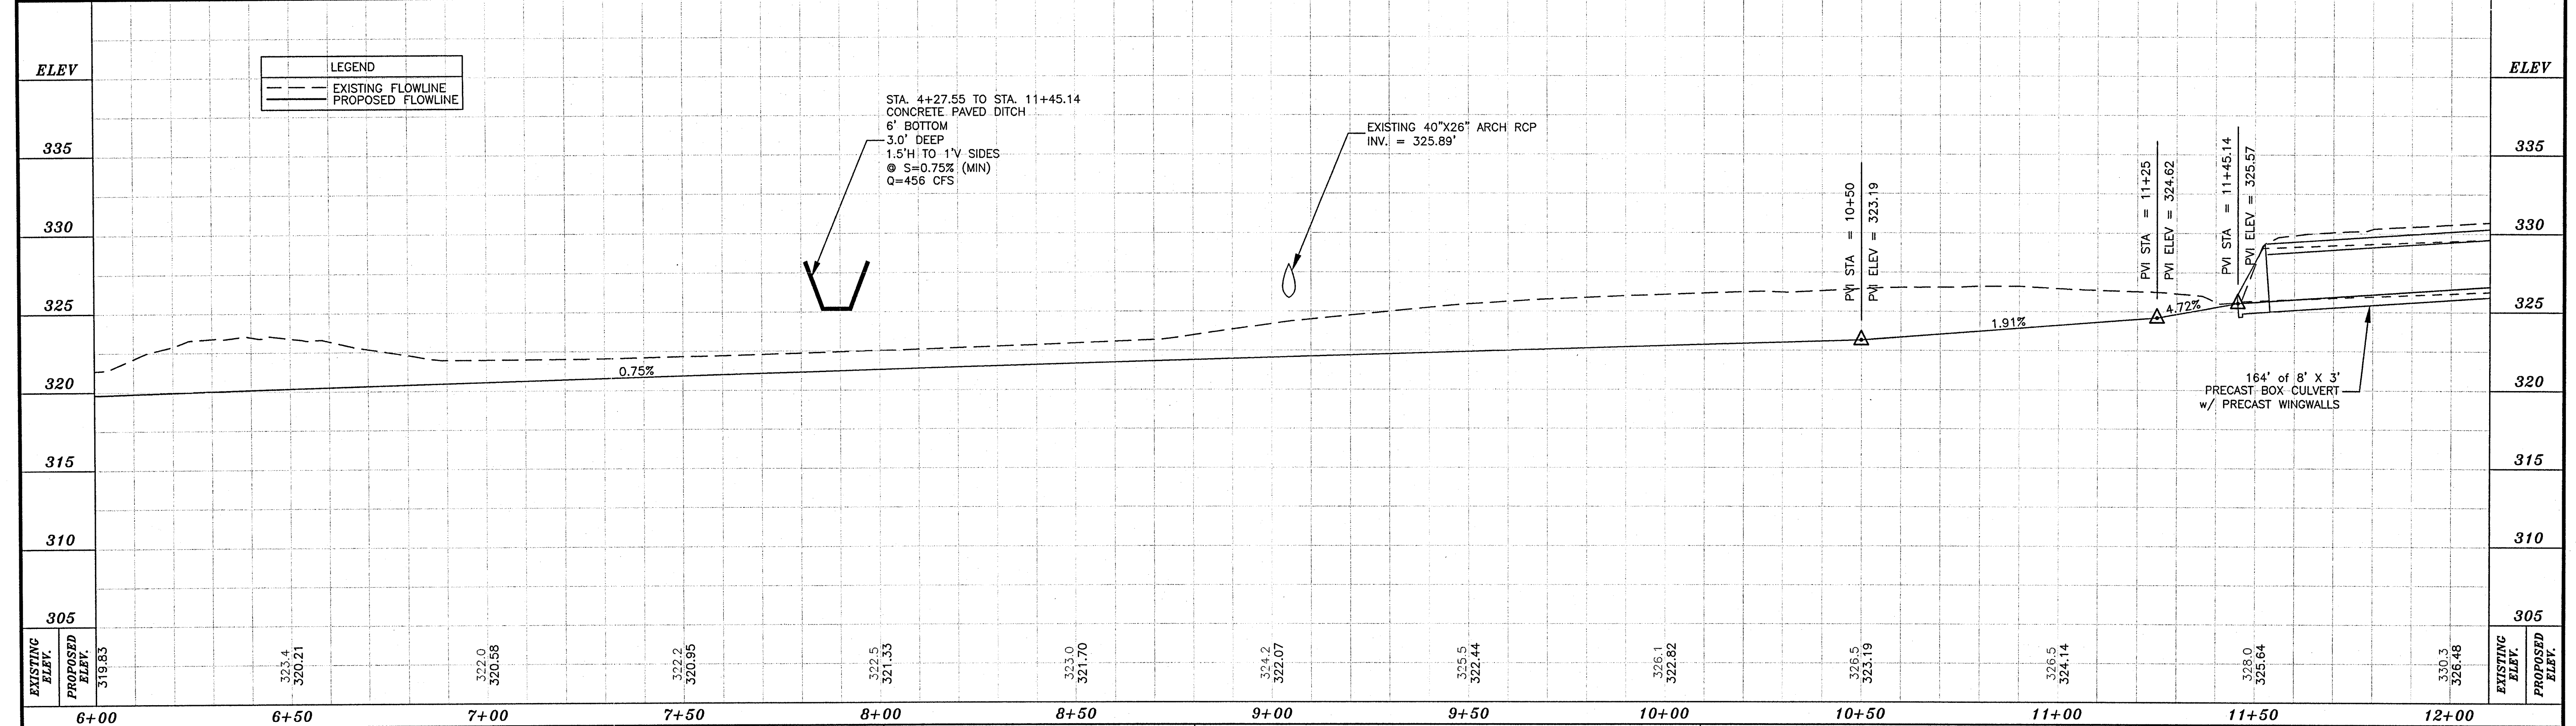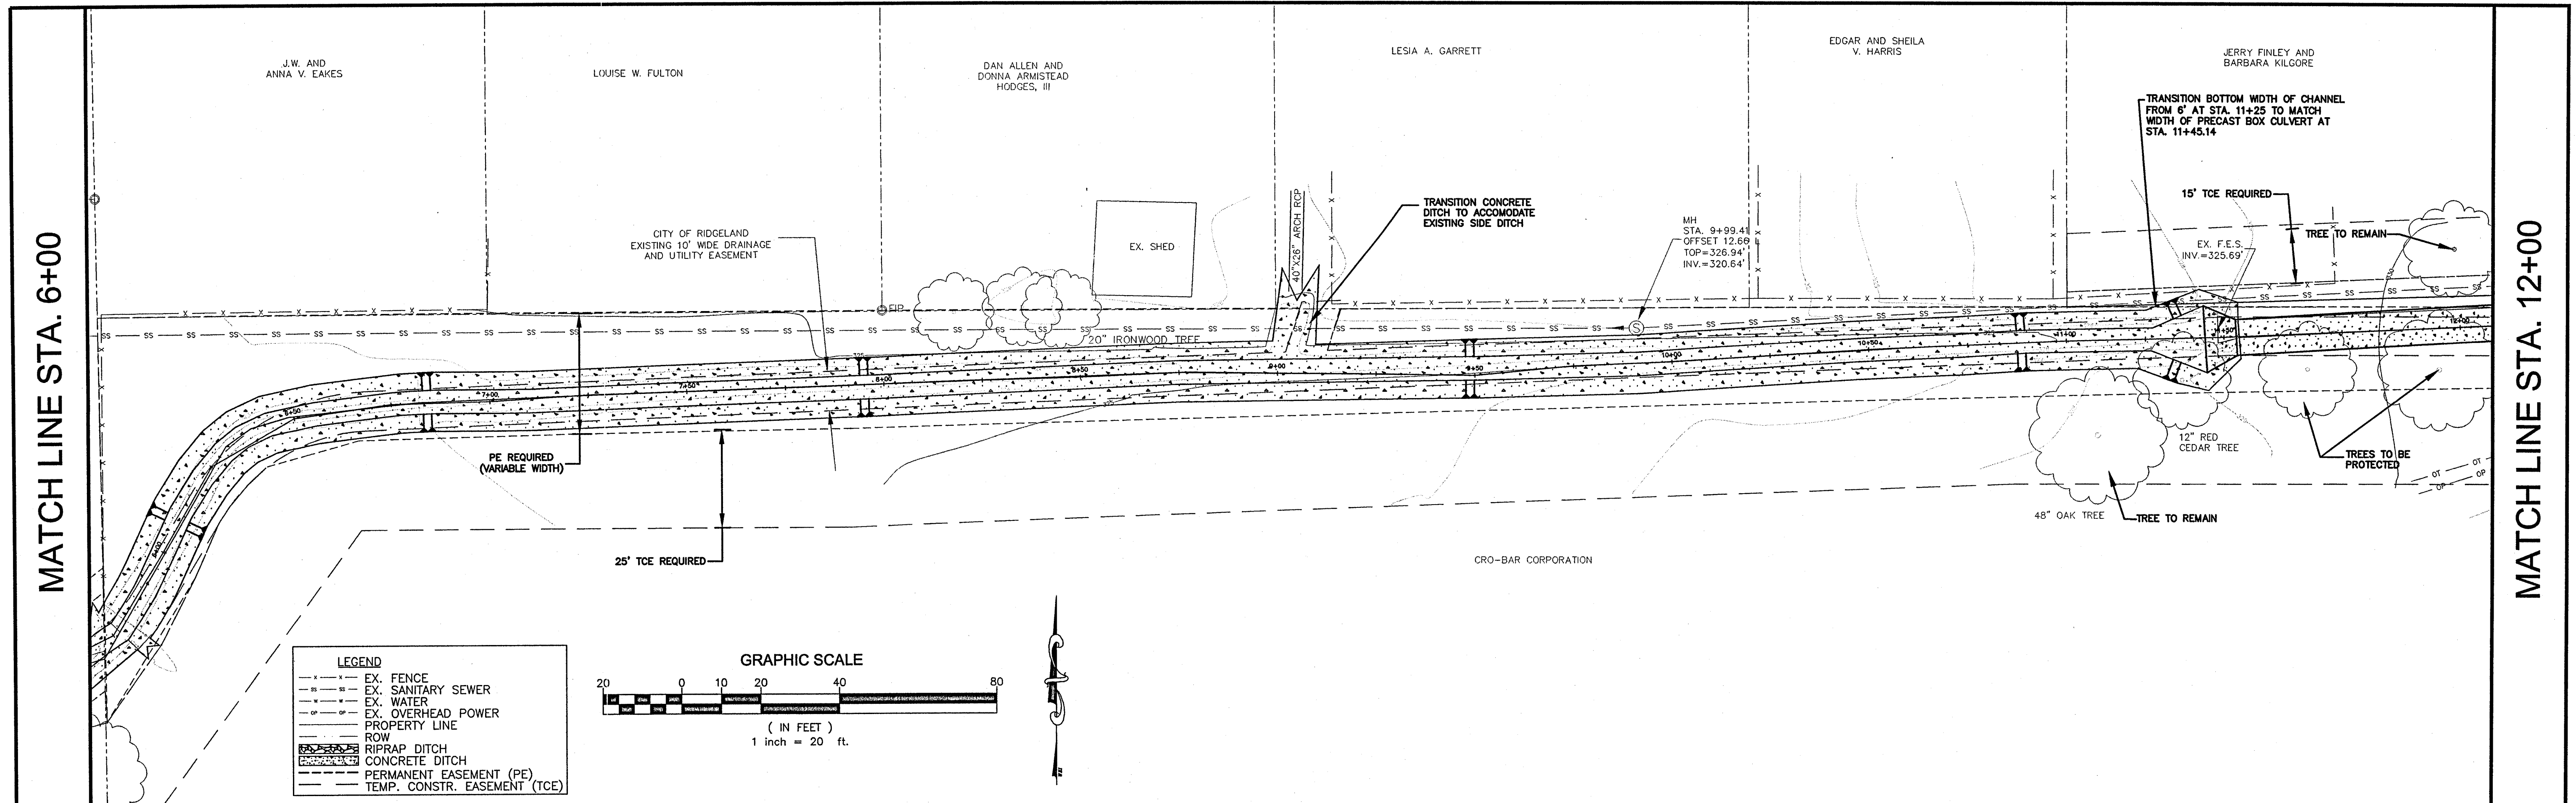


NO.	DATE	REVISIONS	BY

DRAWN BY: JP DESIGNED BY: GBA CHECKED BY: BGC	DATE: 4/05 PROJECT: W03055	HORIZ. SCALE: 1" = 20' VERT. SCALE: 1" = 5'	143-A LEFLEURS SQUARE JACKSON, MS 39211 601-355-9326 FAX 601-352-3945	CITY OF RIDGELAND PONDAROSA PLACE DRAINAGE IMPROVEMENTS W03-055	PLAN/PROFILE (STA. 6+00 TO STA. 12+00)	SHEET NUMBER: PP1.3
---	-------------------------------	--	--	---	---	-------------------------------

MATCH LINE STA. 12+00


MATCH LINE STA. 18+00

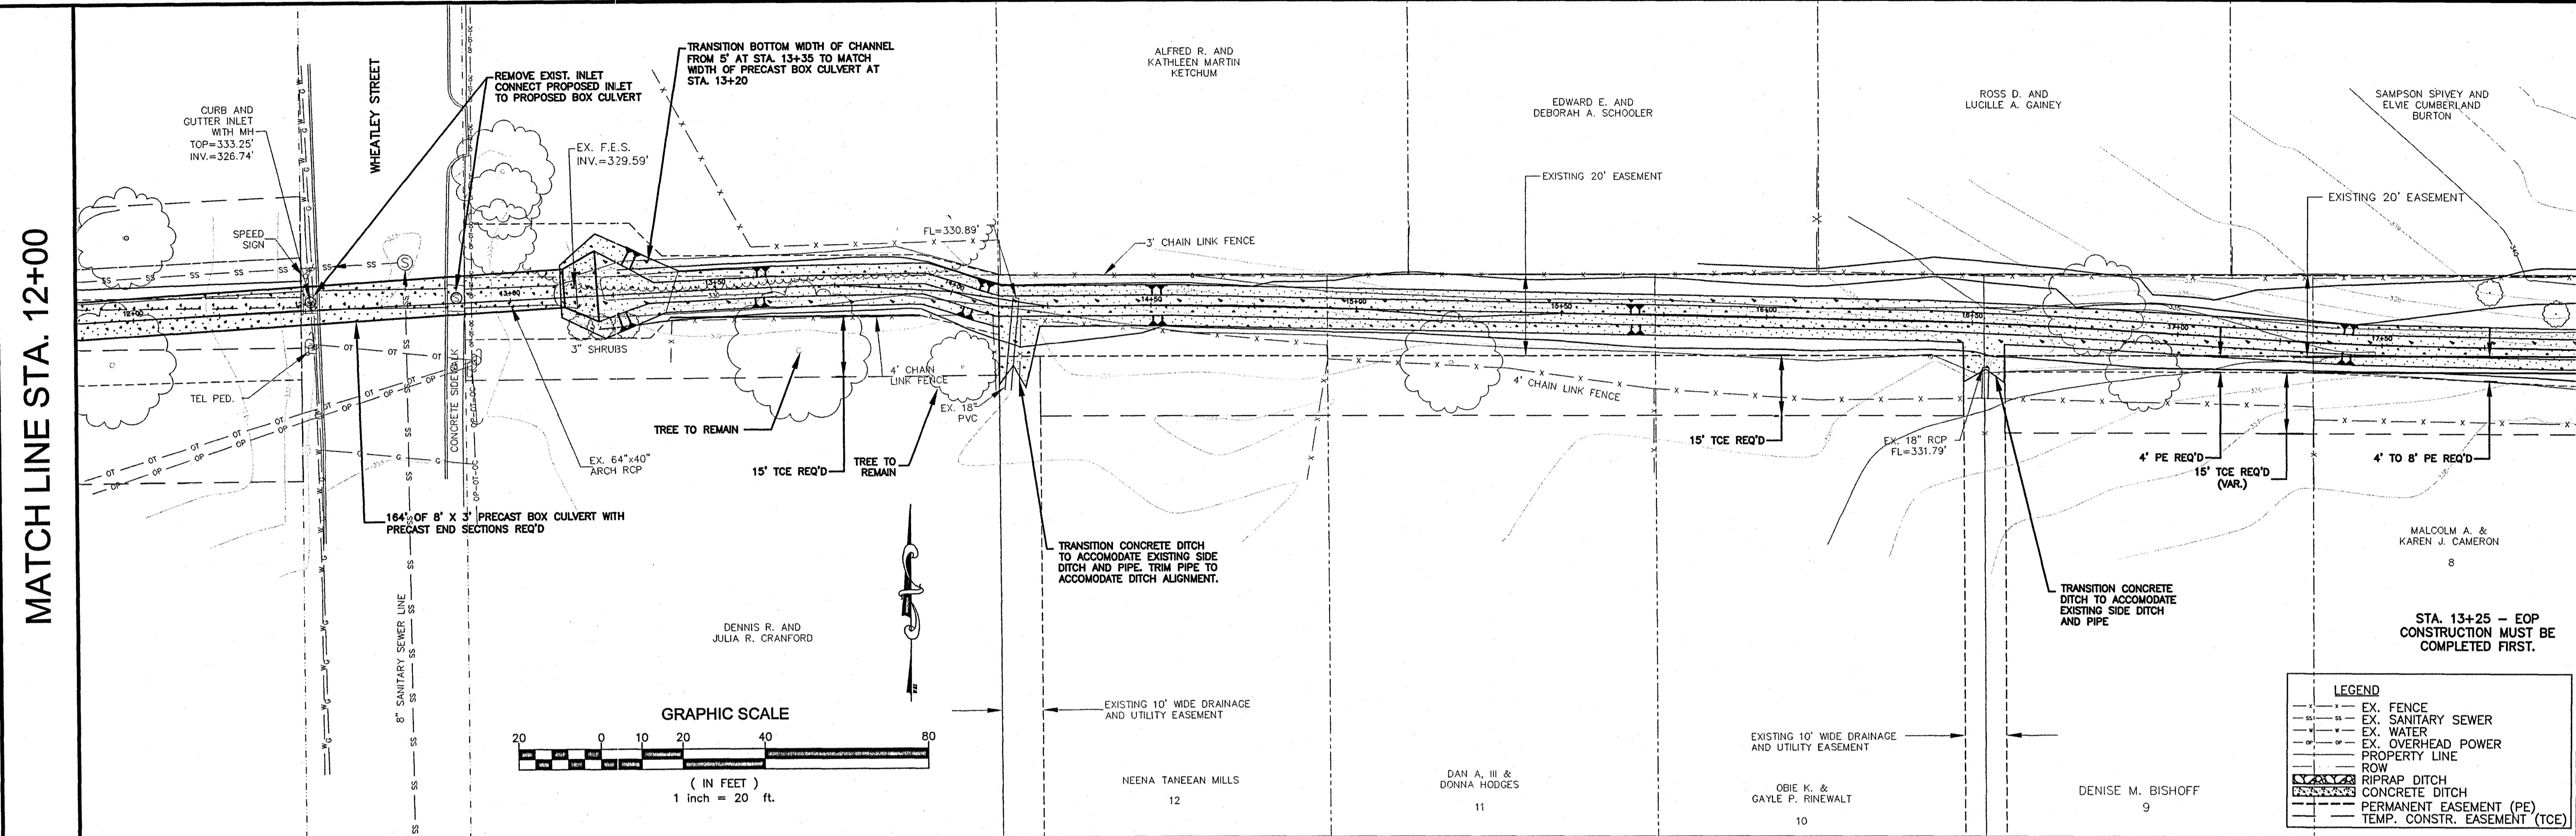

LEGEND

- EX. FENCE
- EX. SANITARY SEWER
- EX. WATER
- EX. OVERHEAD POWER
- PROPERTY LINE
- ROW
- RIPRAP DITCH
- CONCRETE DITCH
- PERMANENT EASEMENT (PE)
- TEMP. CONSTR. EASEMENT (TCE)

STA. 13+25 - EOP CONSTRUCTION MUST BE COMPLETED FIRST.

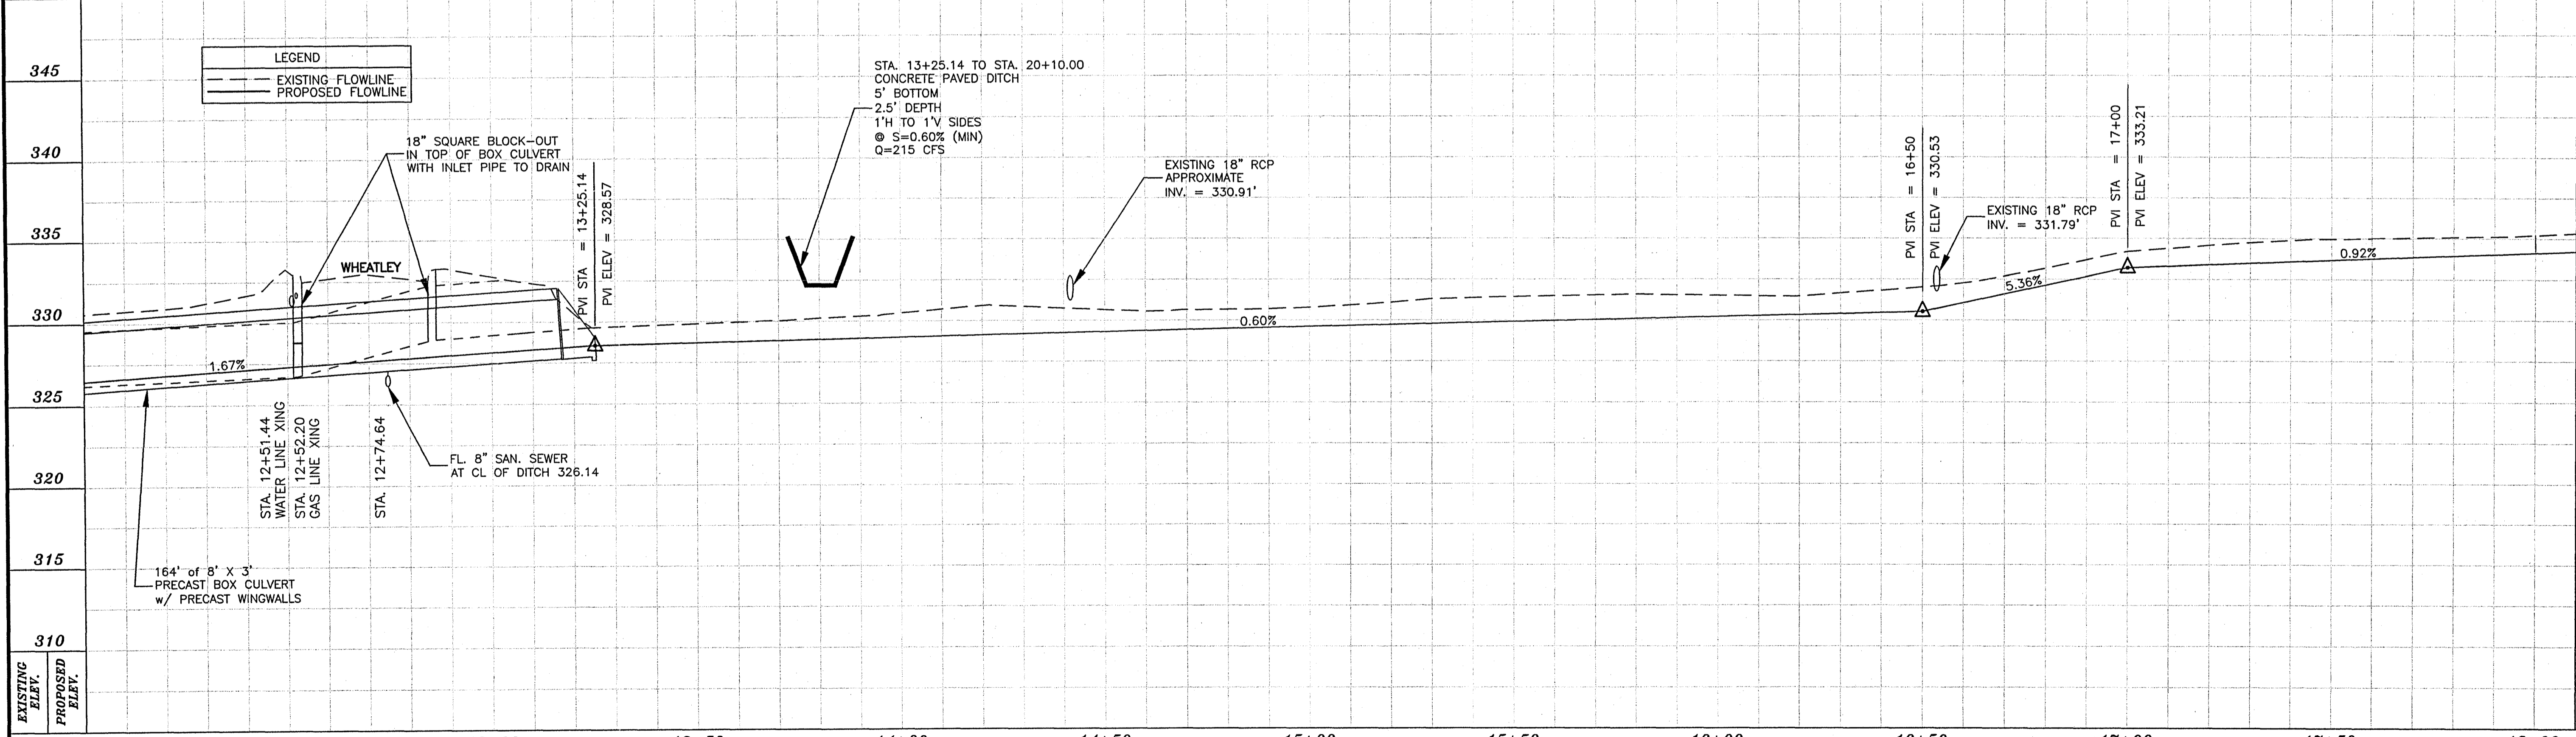












LEGEND

- EXISTING FLOWLINE
- PROPOSED FLOWLINE





NO.	DATE	REVISIONS	BY	DESIGNER: JP	DATE: 4/05	HORIZ. SCALE: 1" = 20'		143-A LEFLEURS SQUARE JACKSON, MS 39211 601-355-9526 FAX 601-352-3945	CITY OF RIDGELAND PONDAROSA PLACE DRAINAGE IMPROVEMENTS W03-055	PLAN/PROFILE (STA. 12+00 TO STA. 18+00)	SHEET NUMBER: PP1.4
				CHECKED BY: GBA	PROJECT: W03055	VERT. SCALE: 1" = 5'					

P:\Ridgeland_City of W03-055-Pondarosa\W03055_Plan_09-14-04.dwg, PP1.4, 4/13/2005 4:08:42 PM, Oce TD5600 3-new.rvt

**PONDAROSA PLACE
DRAINAGE IMPROVEMENTS**
CITY OF RIDGELAND, MS

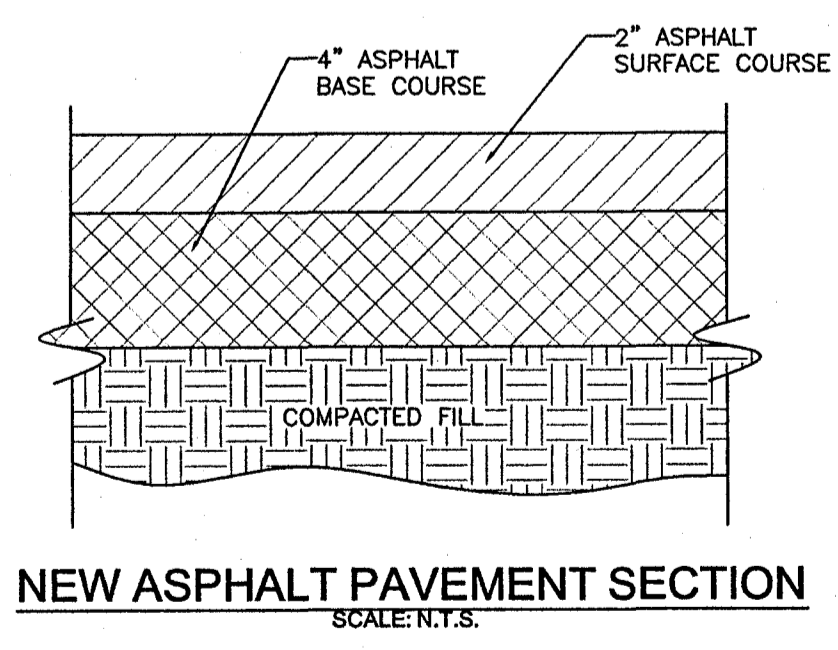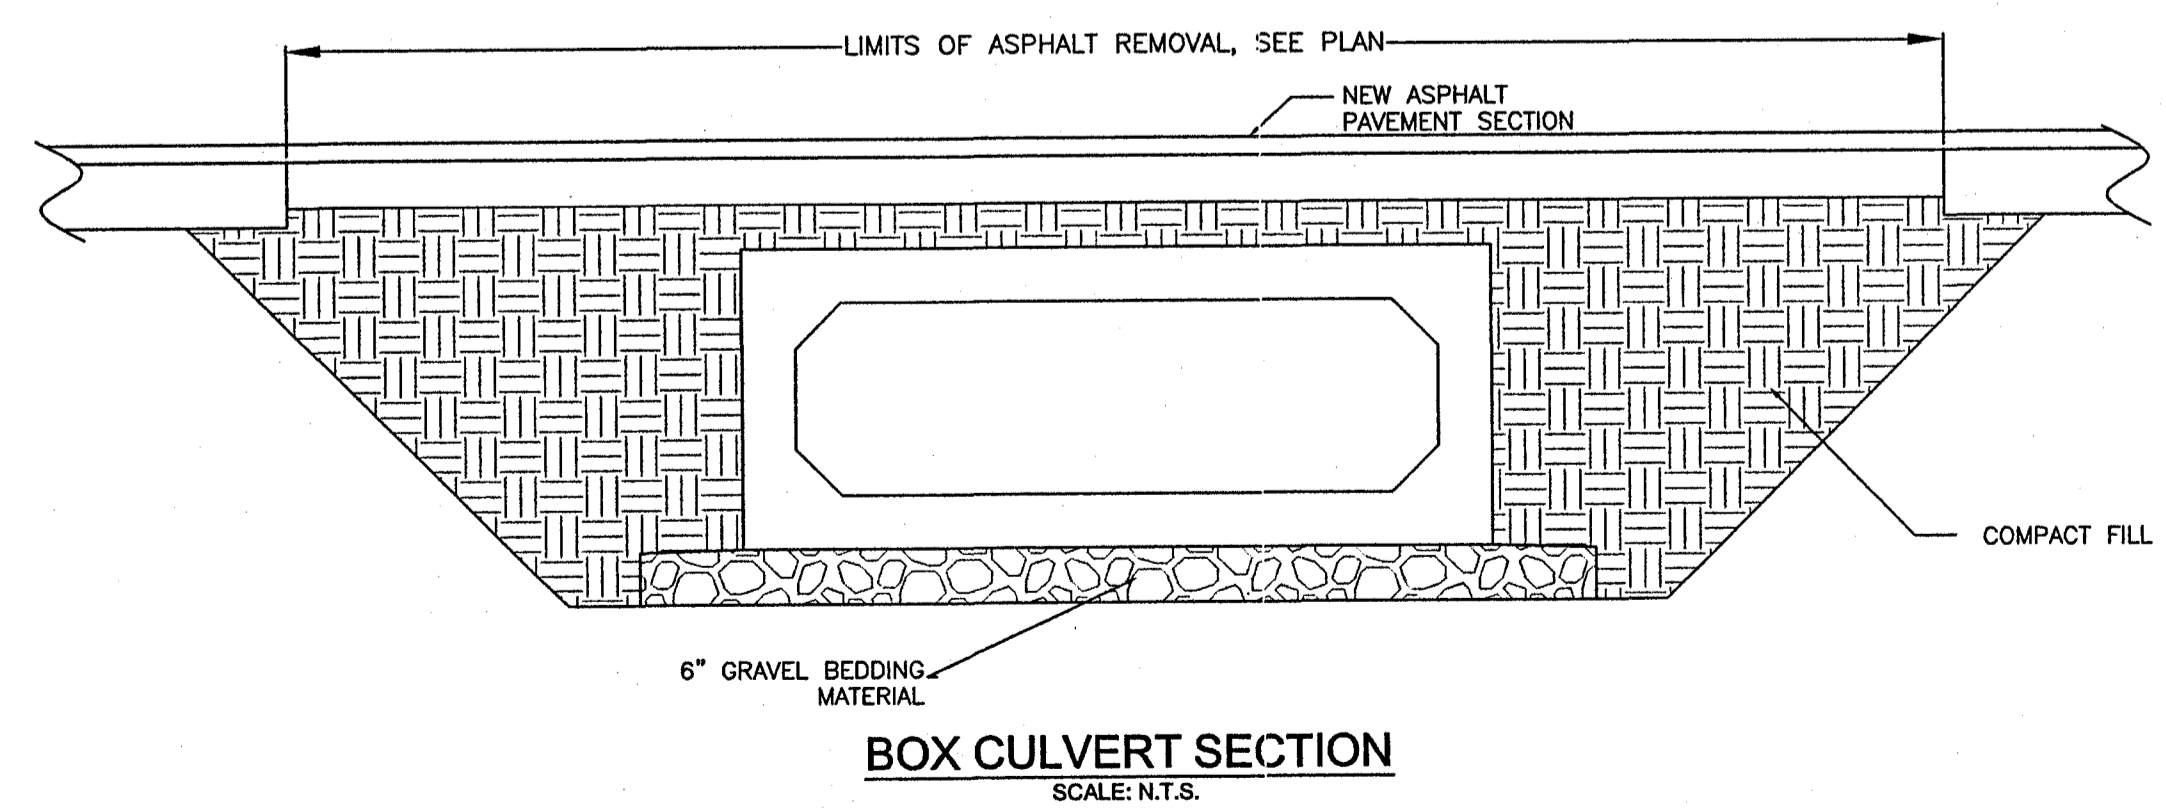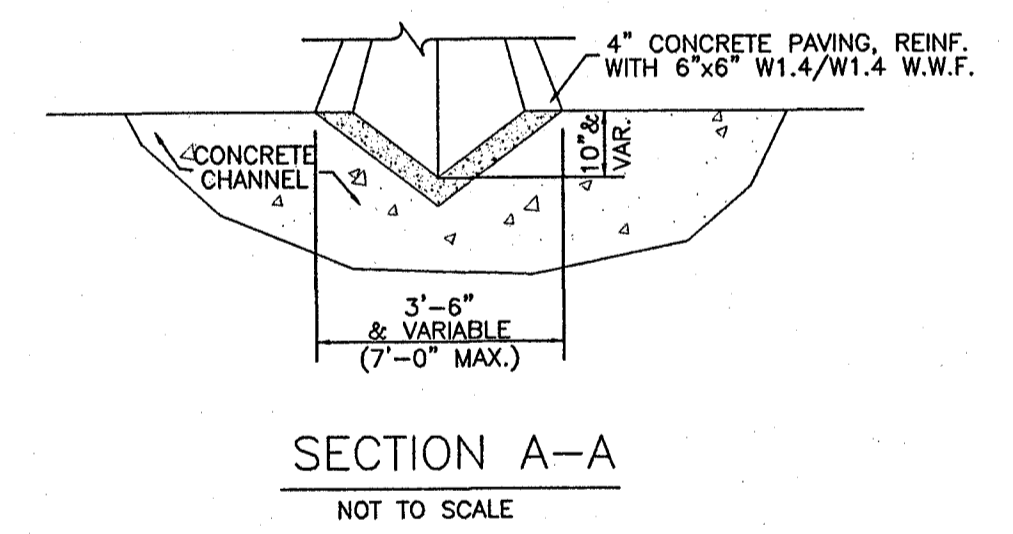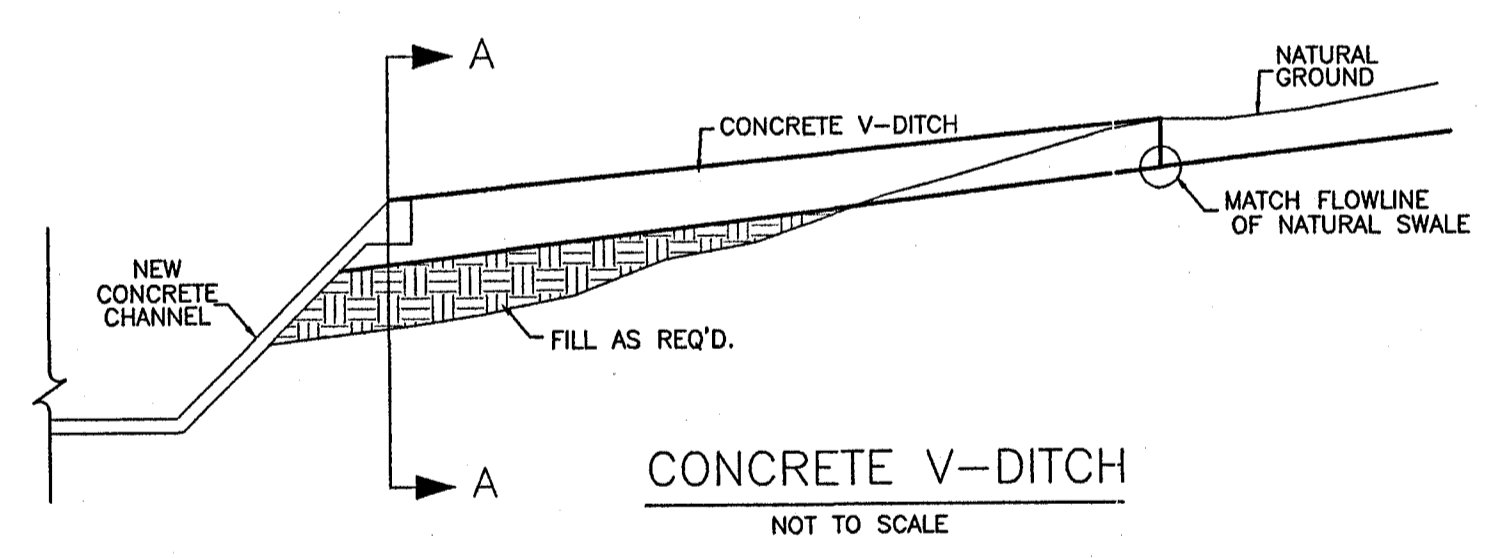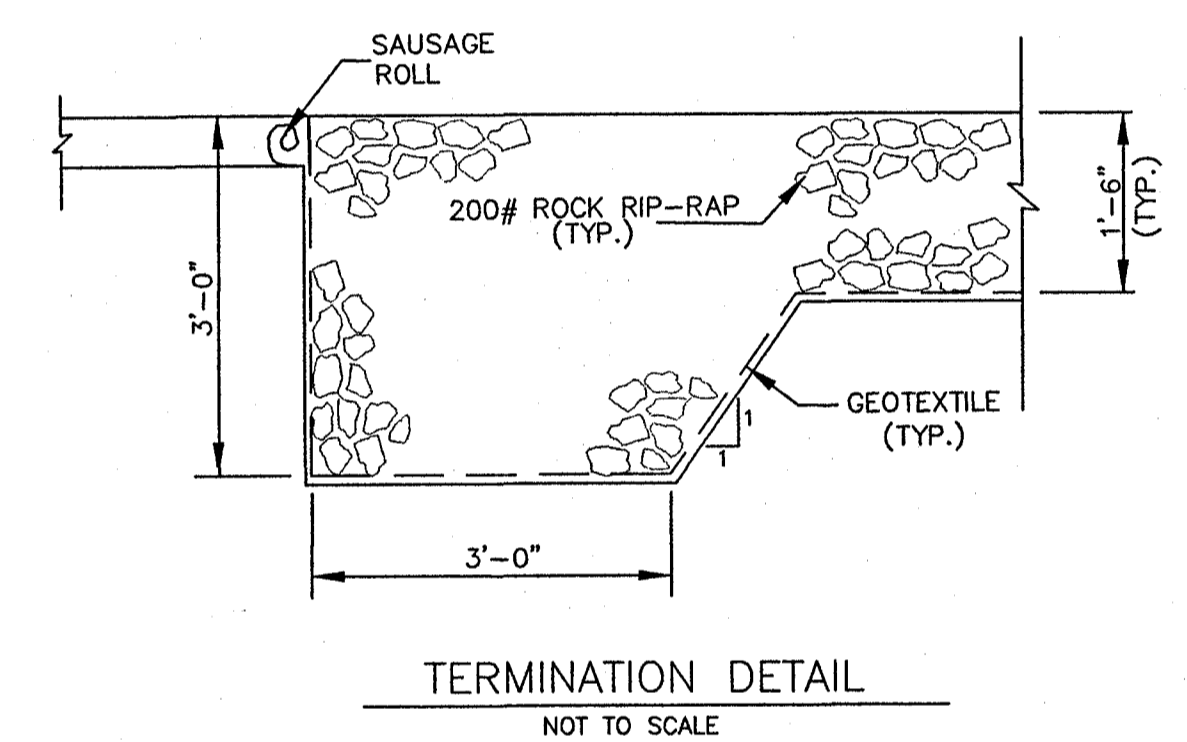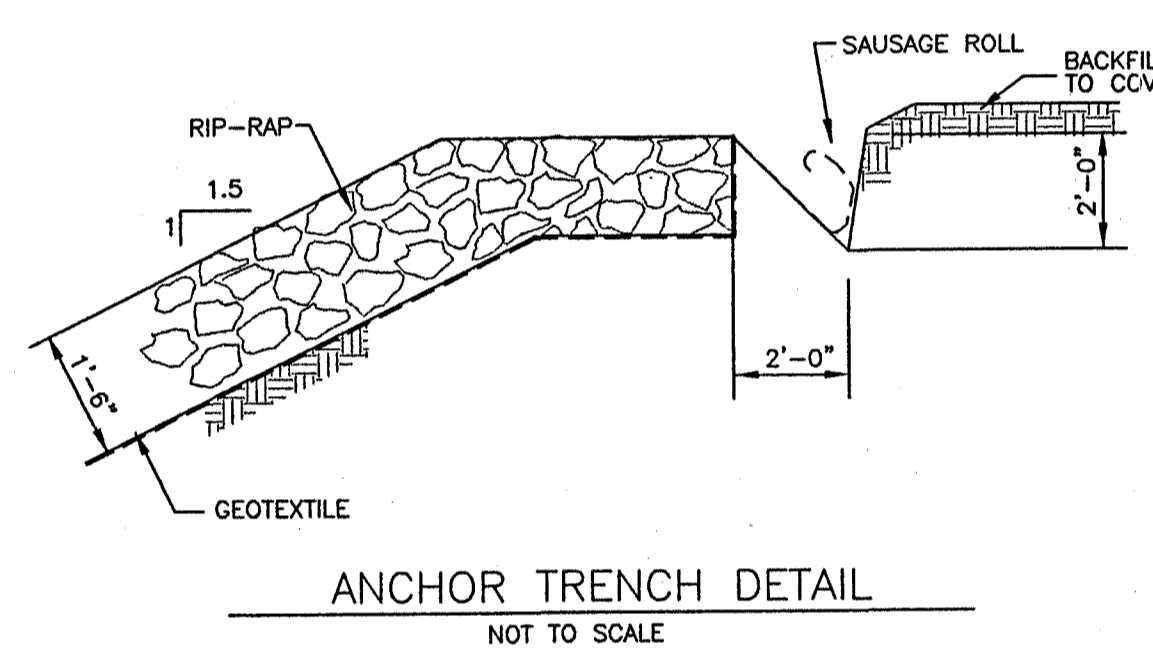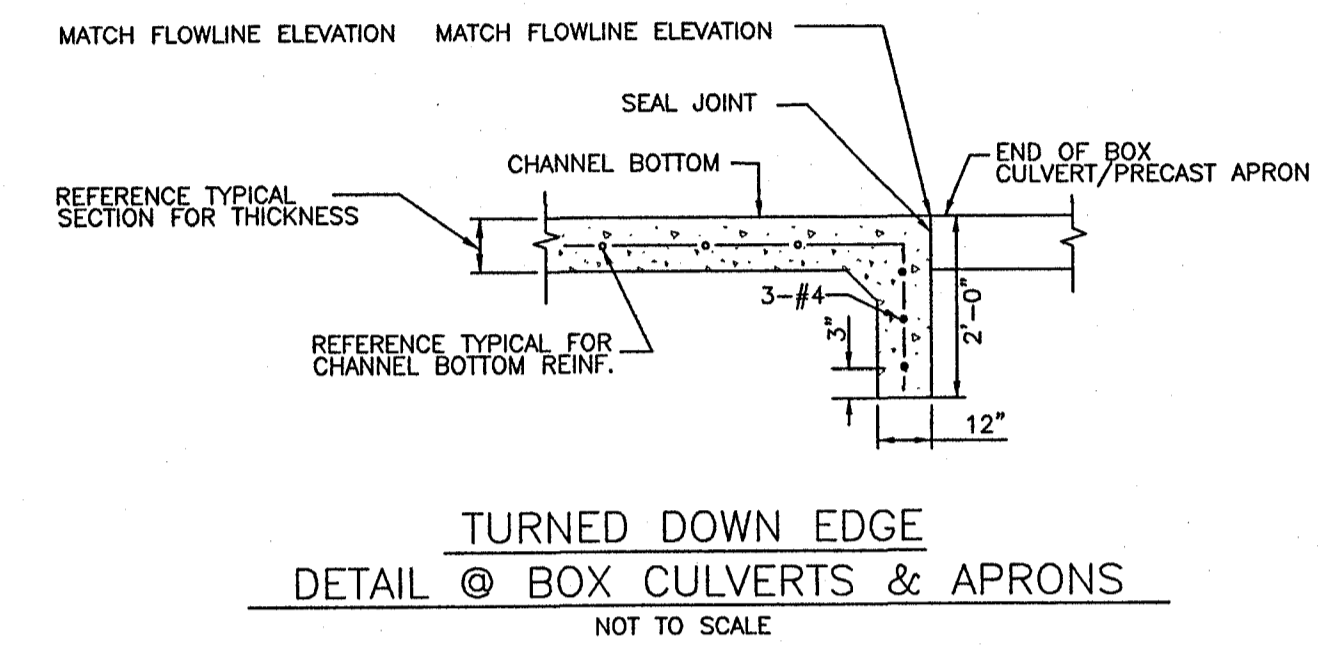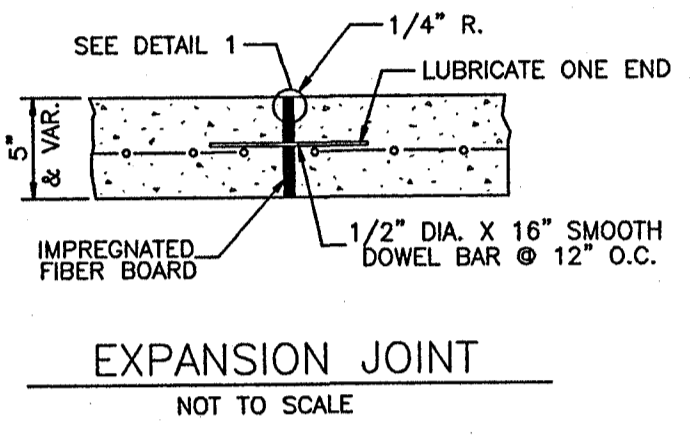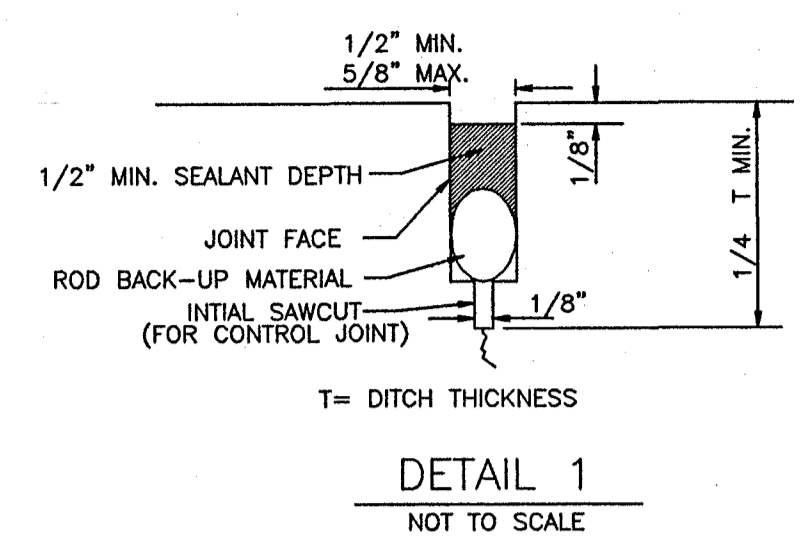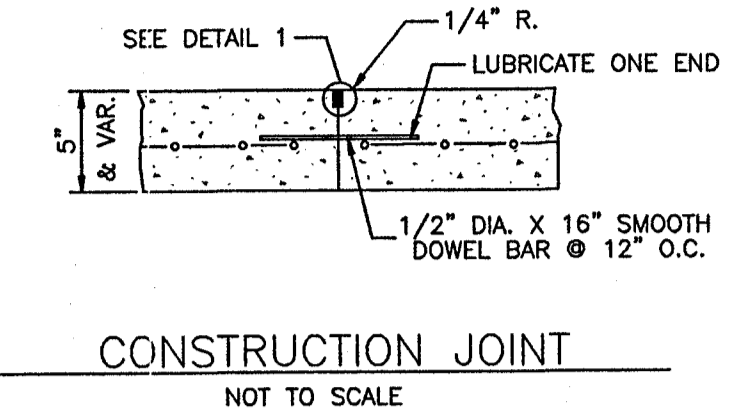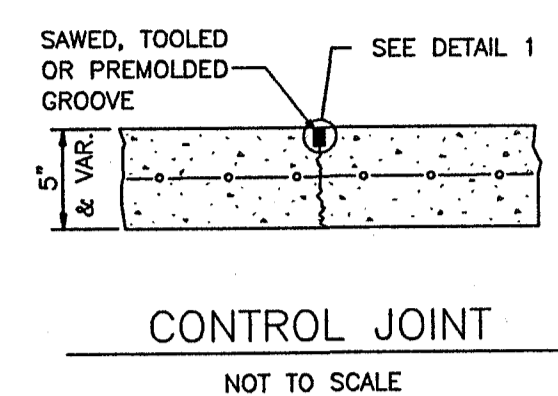

TYPICAL SECTIONS

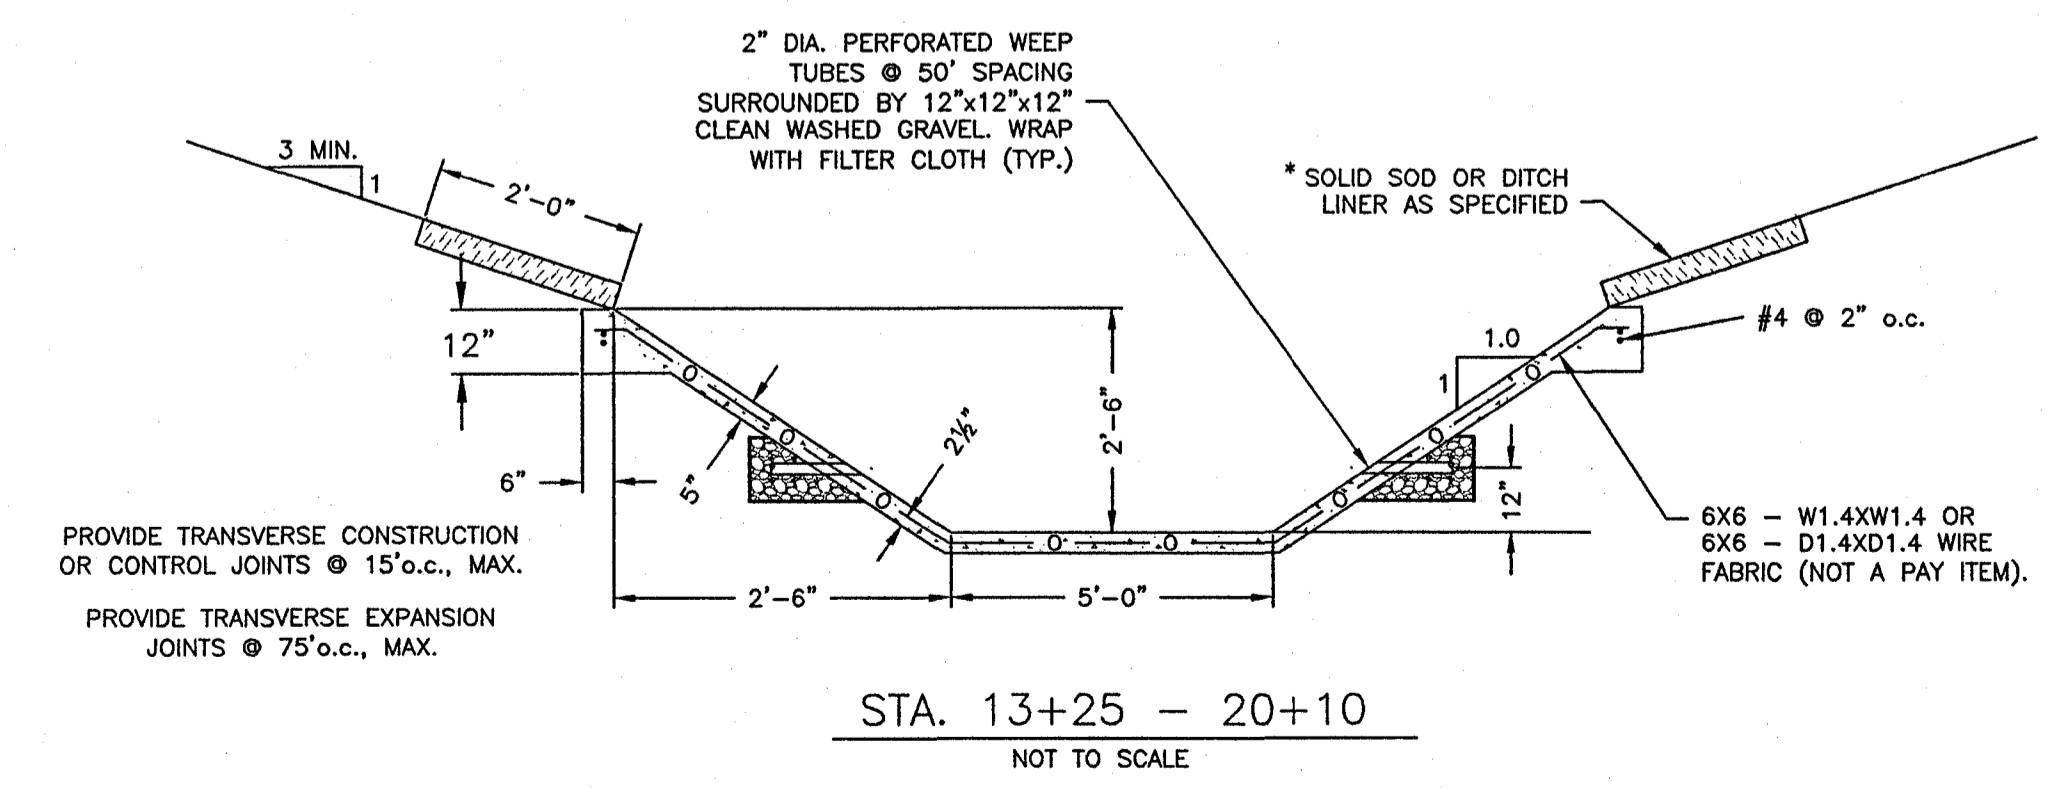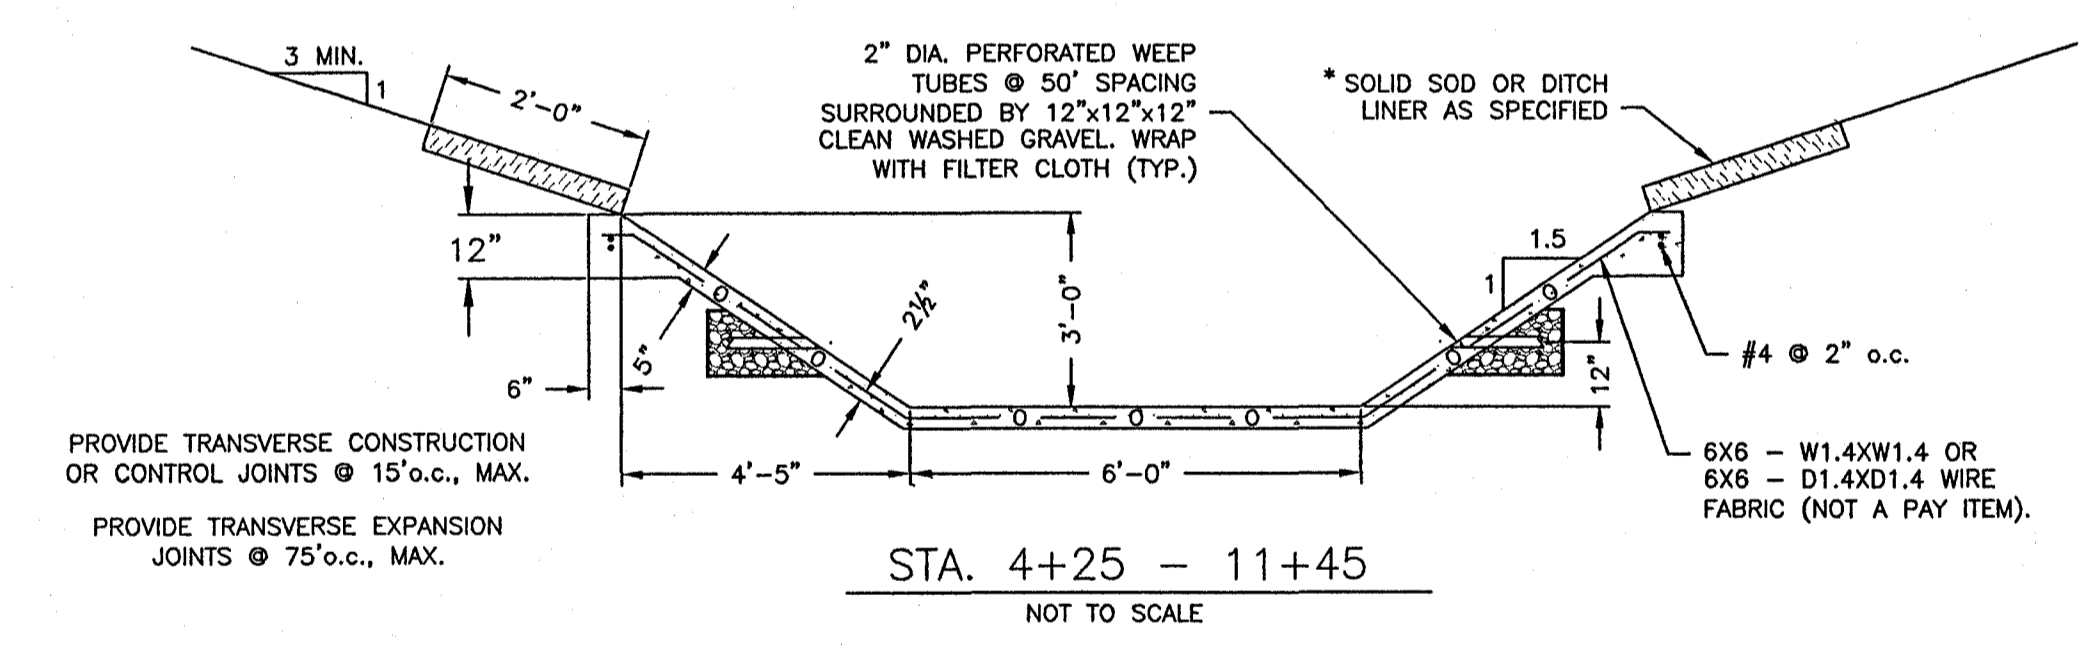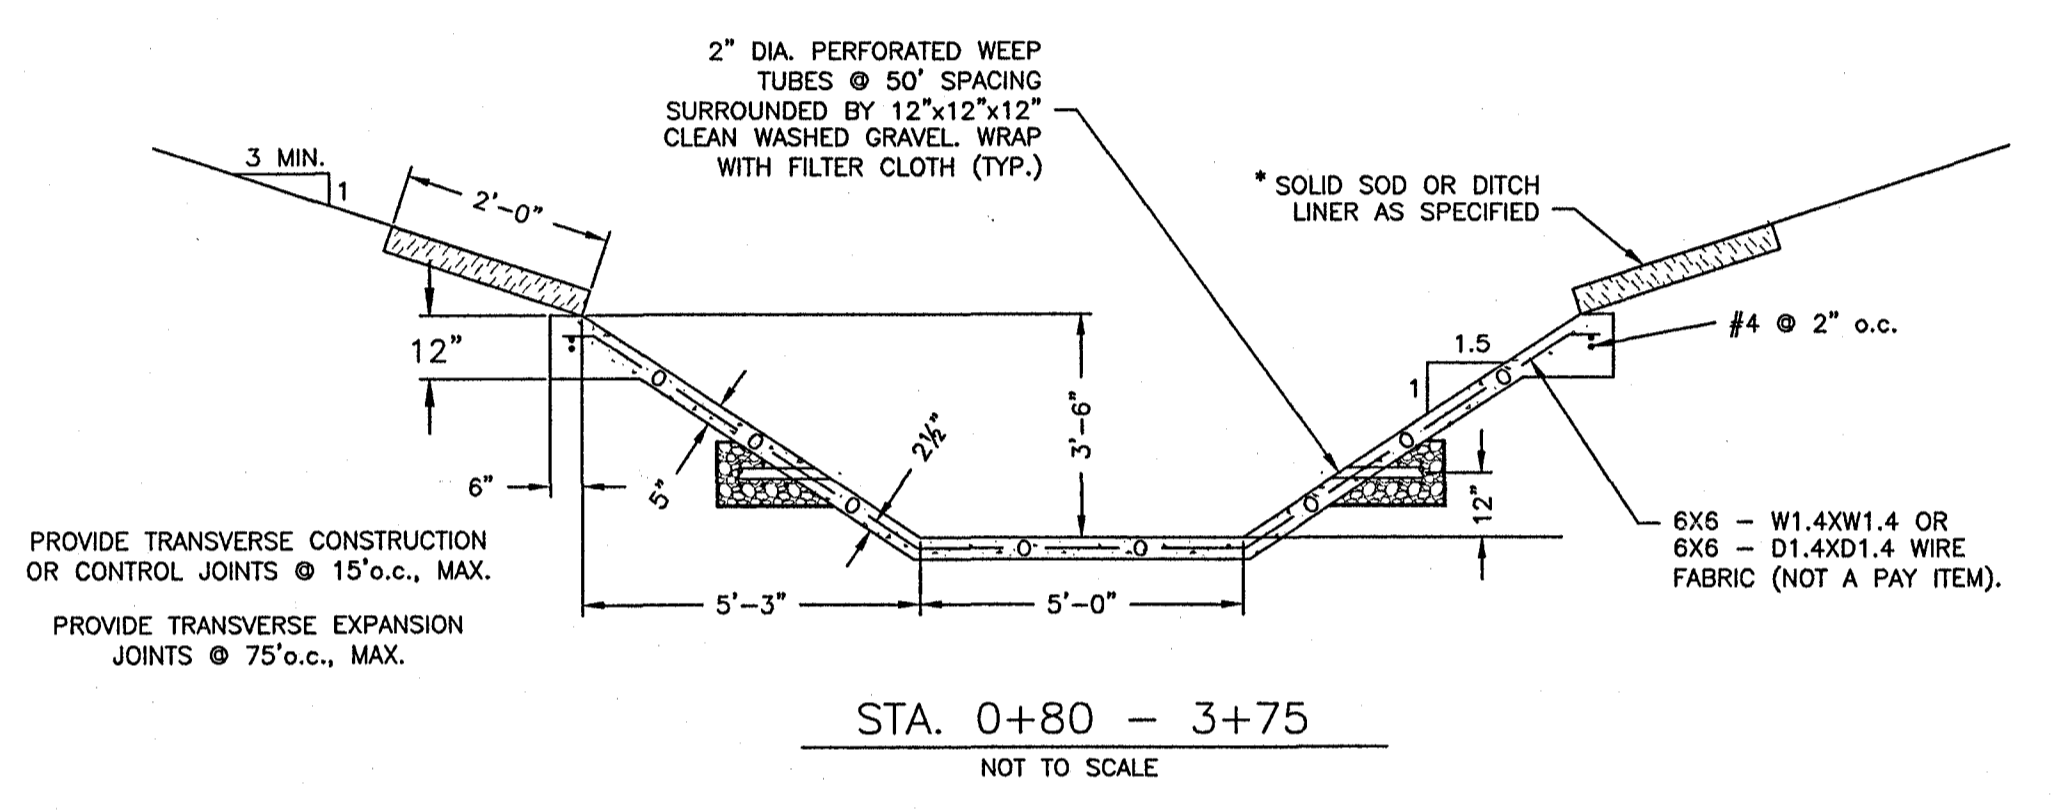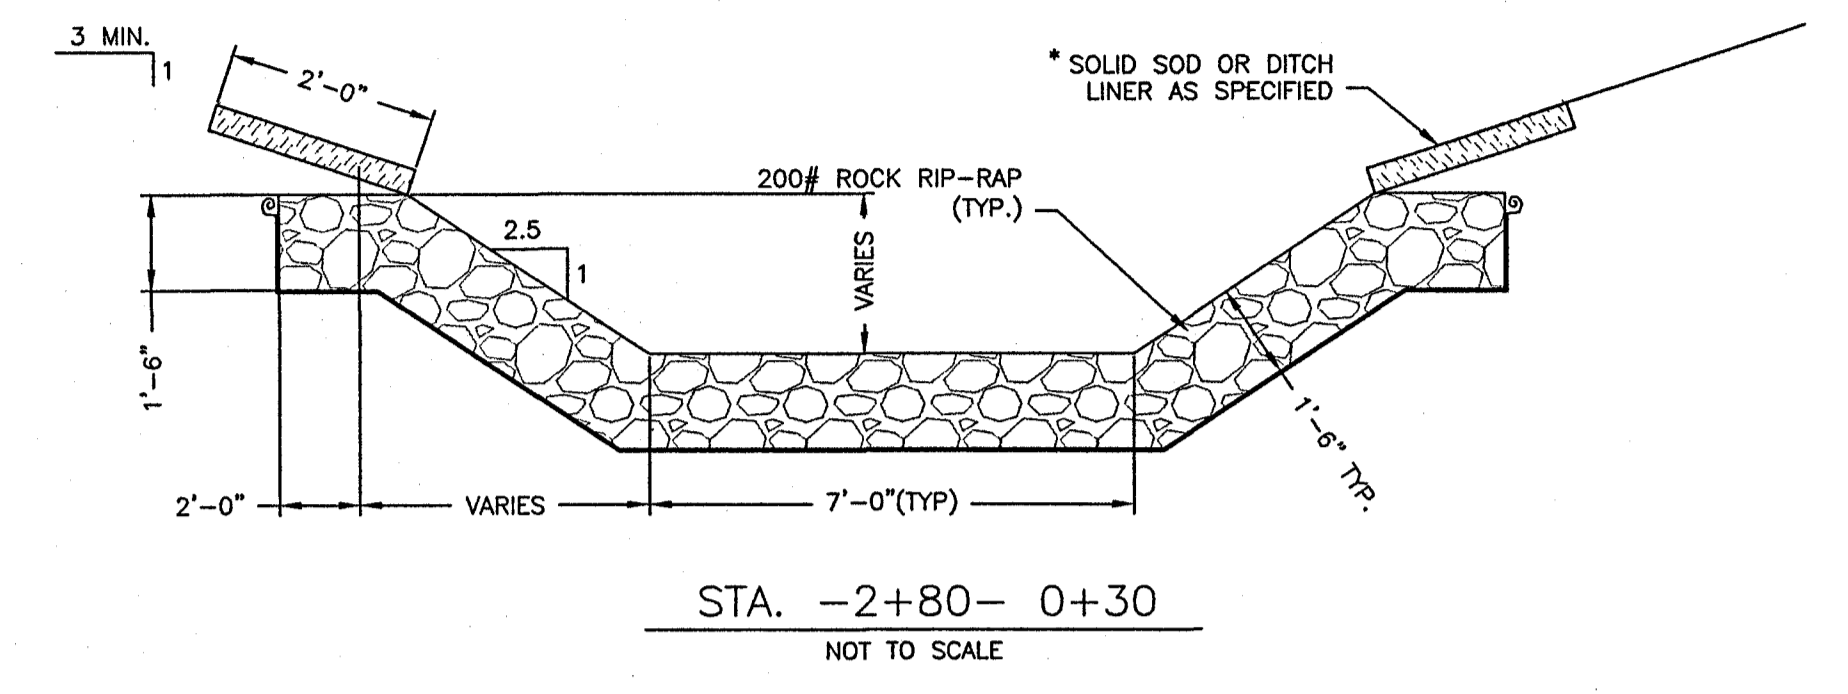

DRAWING REVISIONS		
NO.	REMARKS	DATE

DRAWN BY: OBA	SCALE: N.T.S.
DESIGNED BY: OBA	DATE: APRIL 2004
CHECKED BY: BG	PROJECT: W03055
DRAWING TITLE:	

**STANDARD
DETAILS**

SHEET NUMBER
D1.1

