

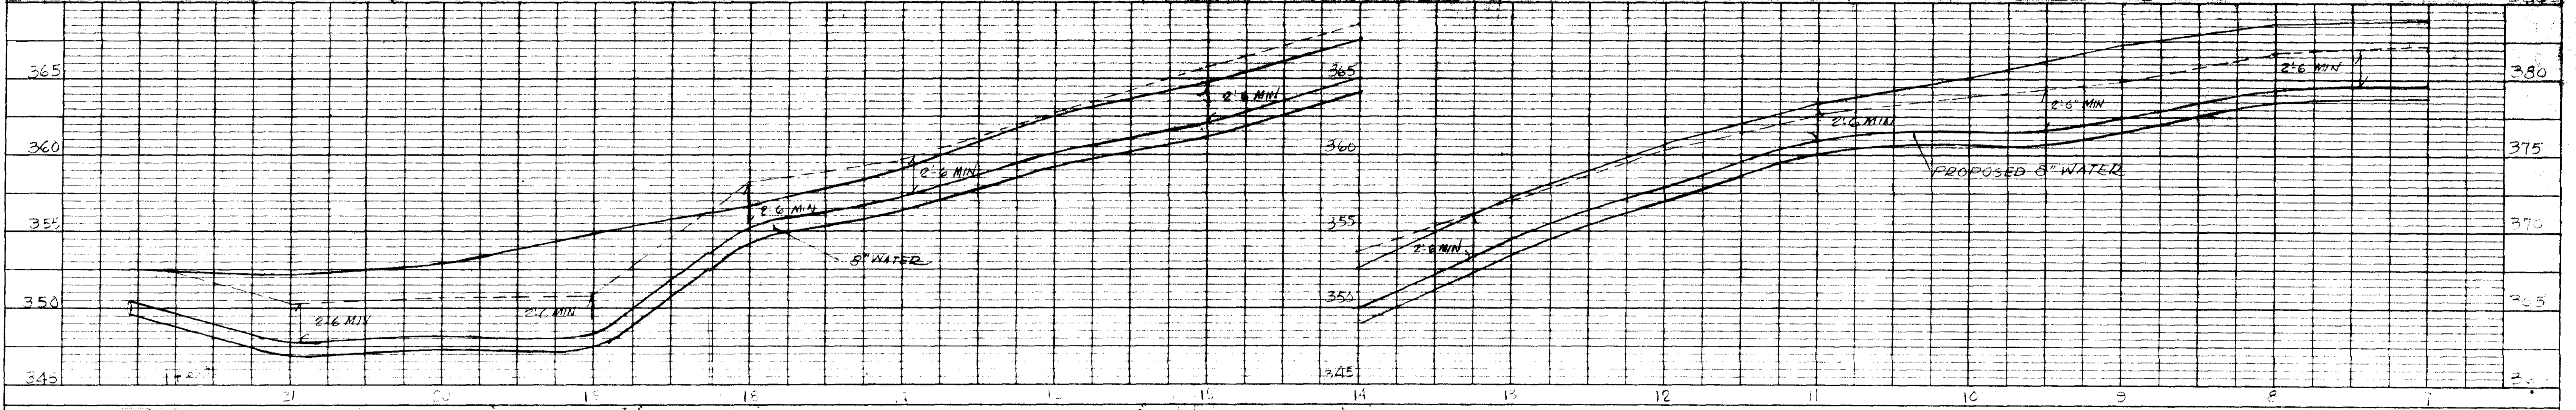
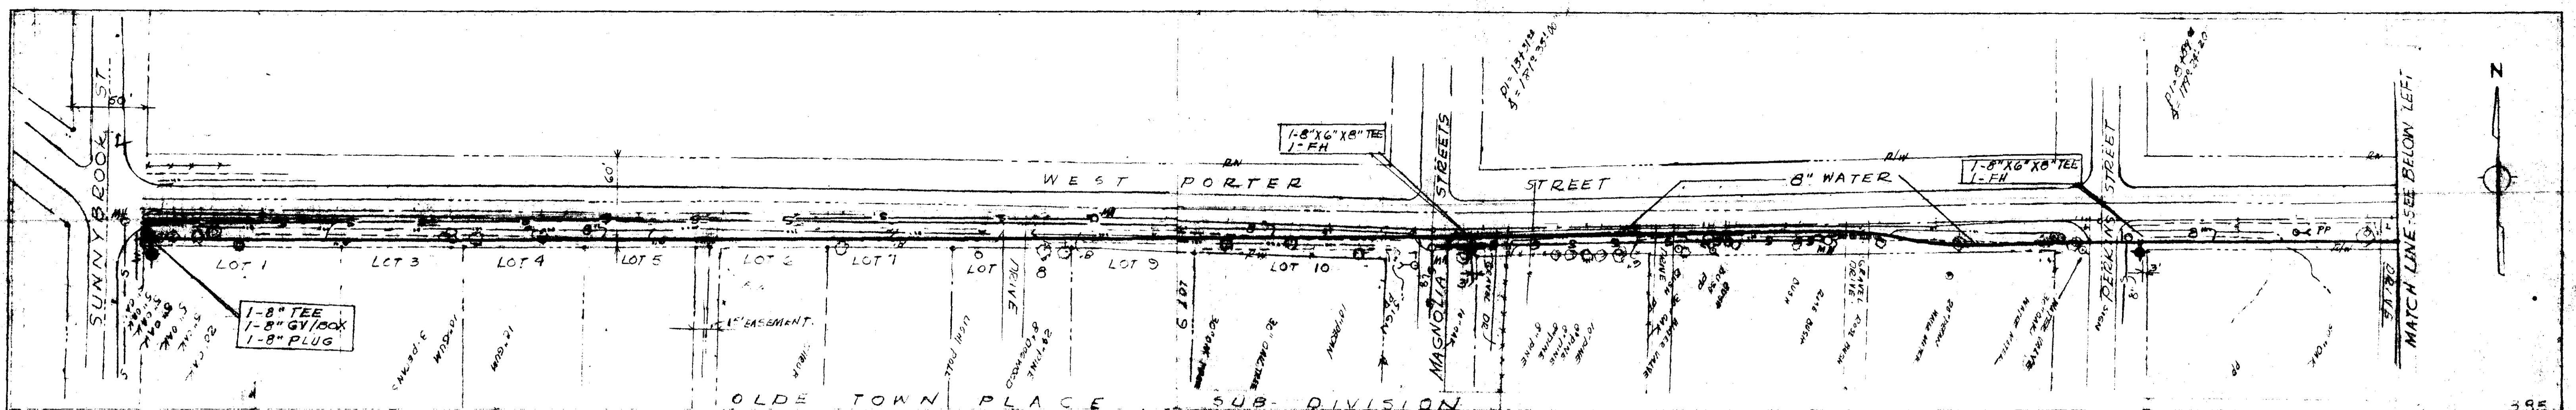


PLAN
 SURVIVED
 NOTED
 NOTE BOOK
 ALIGNED CHECKED
 BY: []
 DATE: []
 NO. []

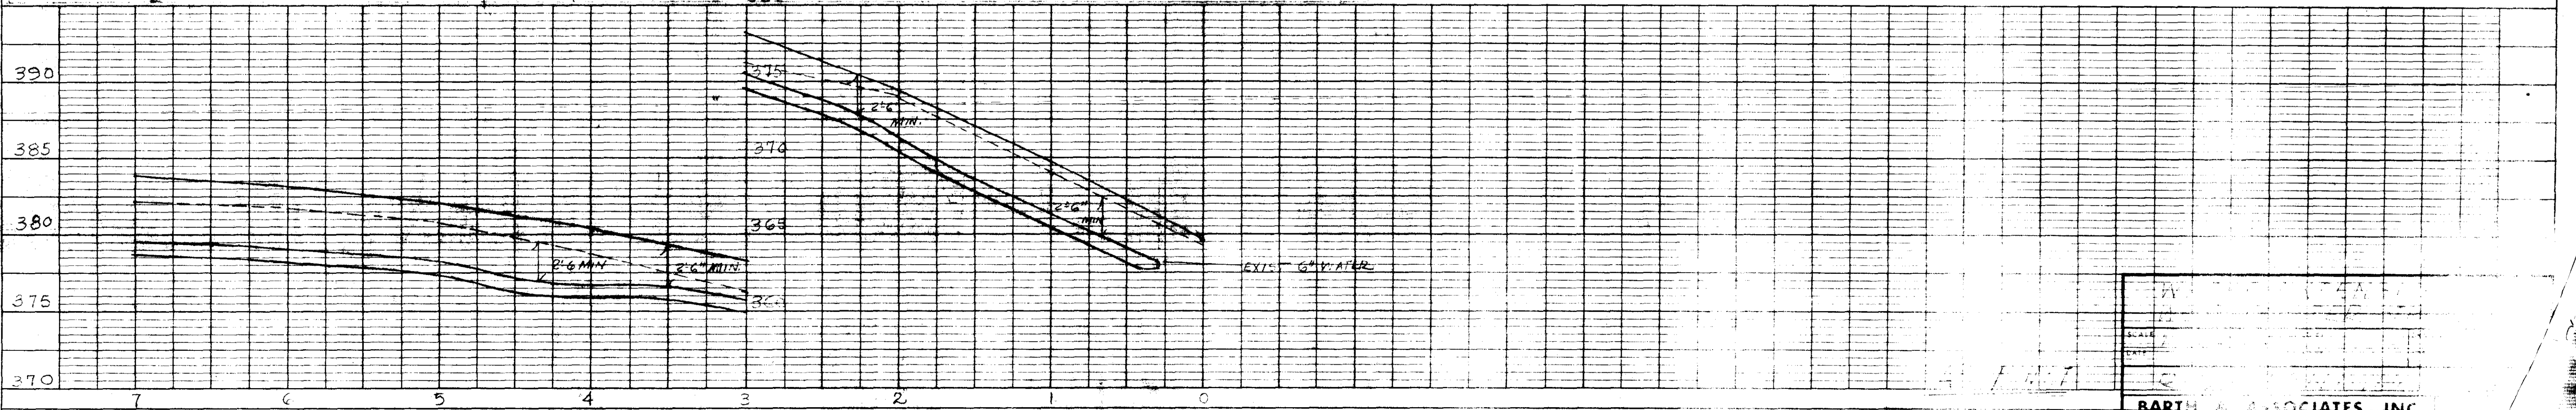

PROFILE
 SURVIVED
 NOTED
 NOTE BOOK
 STRUCTURE MODIFICATIONS CHECKED
 BY: []
 DATE: []
 NO. []

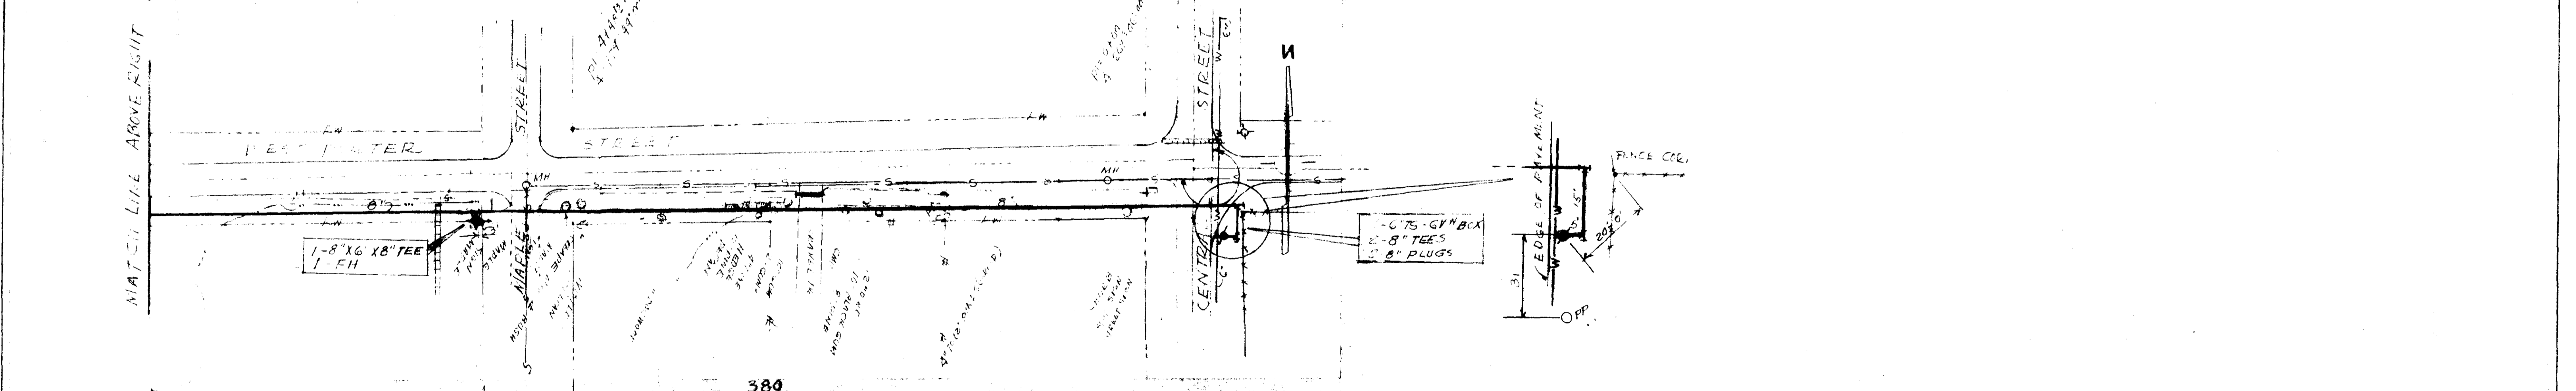

BARTH & ASSOCIATES, INC.
 ENGINEERS
PWP-1610