


B. M. Elevation 373.00  
 East Front Door Finished floor Elevation  
 Public Library Building  
 See As Built Plans

**NOTE:**

Confirm location through South Central Bell before design completion or excavation.  
 Confirm location of Underground Electric Services with Miss. Power and Light Co. before design completion or excavation.  
 Confirm location of Natural Gas lines with Entex, Inc. before design completion or excavation.  
 Confirm location of Sanitary Sewer Force Main (Pressure Sewer), Water Mains, services and sprinkler system piping with the City of Ridgeland, Miss. Forces before design completion or excavation.

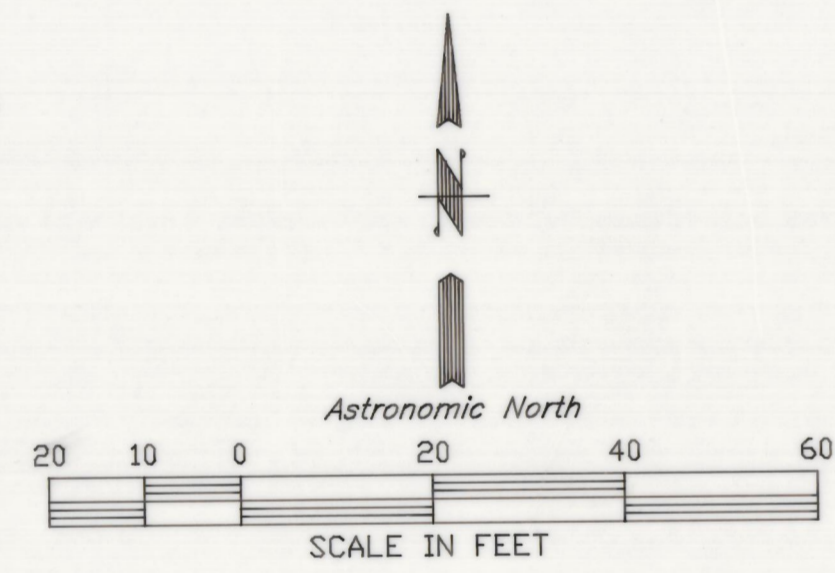

**Topographic Survey for  
 The City of Ridgeland, Miss.  
 The Public Works Shop Site**



Dewey Knight  
 Registered Land Surveyor  
 Jackson, Miss.  
 Scale: 1" = 20'  
 Date: October 22, 1990  
 Revised: October 28, 1990  
 Revised Additional Topo: November 28, 1990

