


CITY OF RIDGELAND, MISSISSIPPI

RICHARDSON ROAD WATER LINE IMPROVEMENTS

MAYOR:
GENE F. MCGEE

MAYOR PRO TEM:
HARVEY CARR, JR.

CITY ATTORNEY:
JERRY MILLS

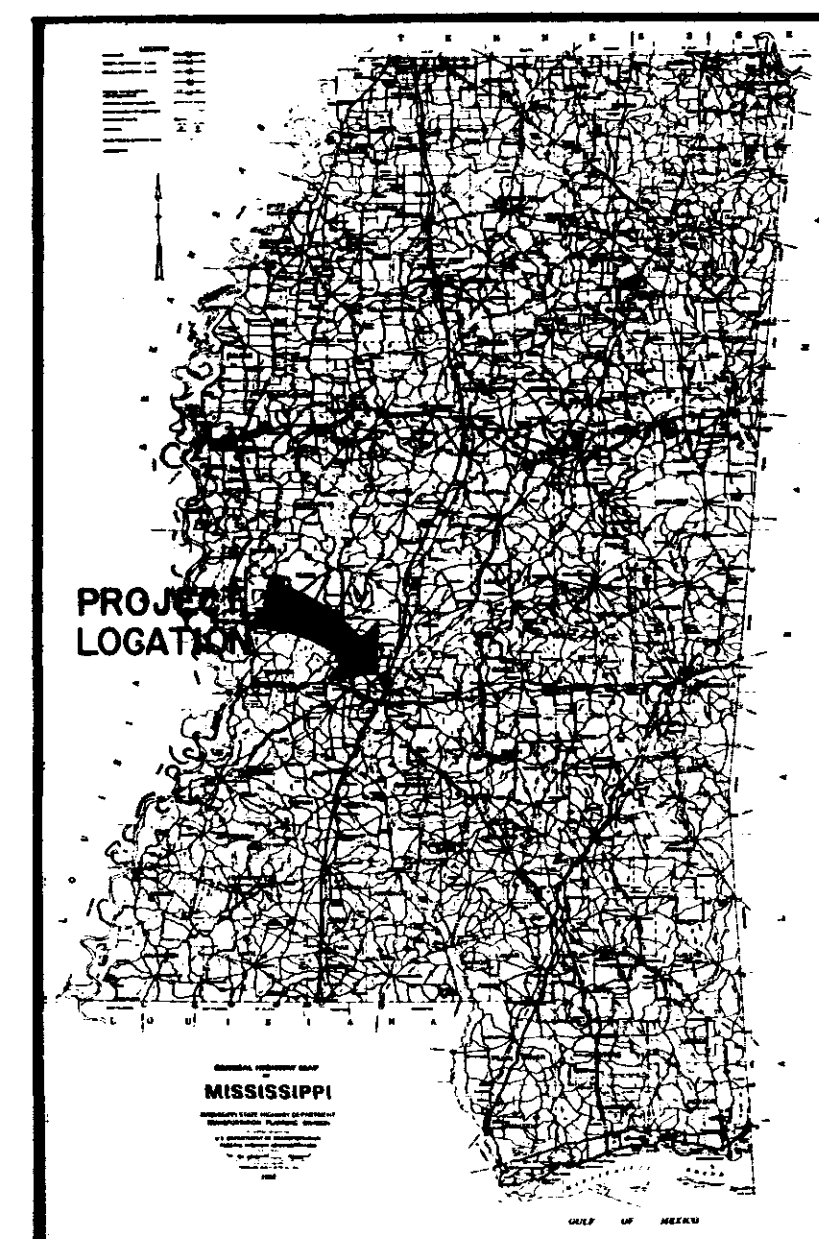


LOCATION MAP

ALDERMEN:
BRIAN BARCELLONA
AL BIBLE
HARVEY CARR, JR.
LINDA DAVIS
DARYL SMITH

PUBLIC WORKS DIRECTOR:
SAM VINSON P.E.

CITY CLERK:
MICHAEL McPHEARSON

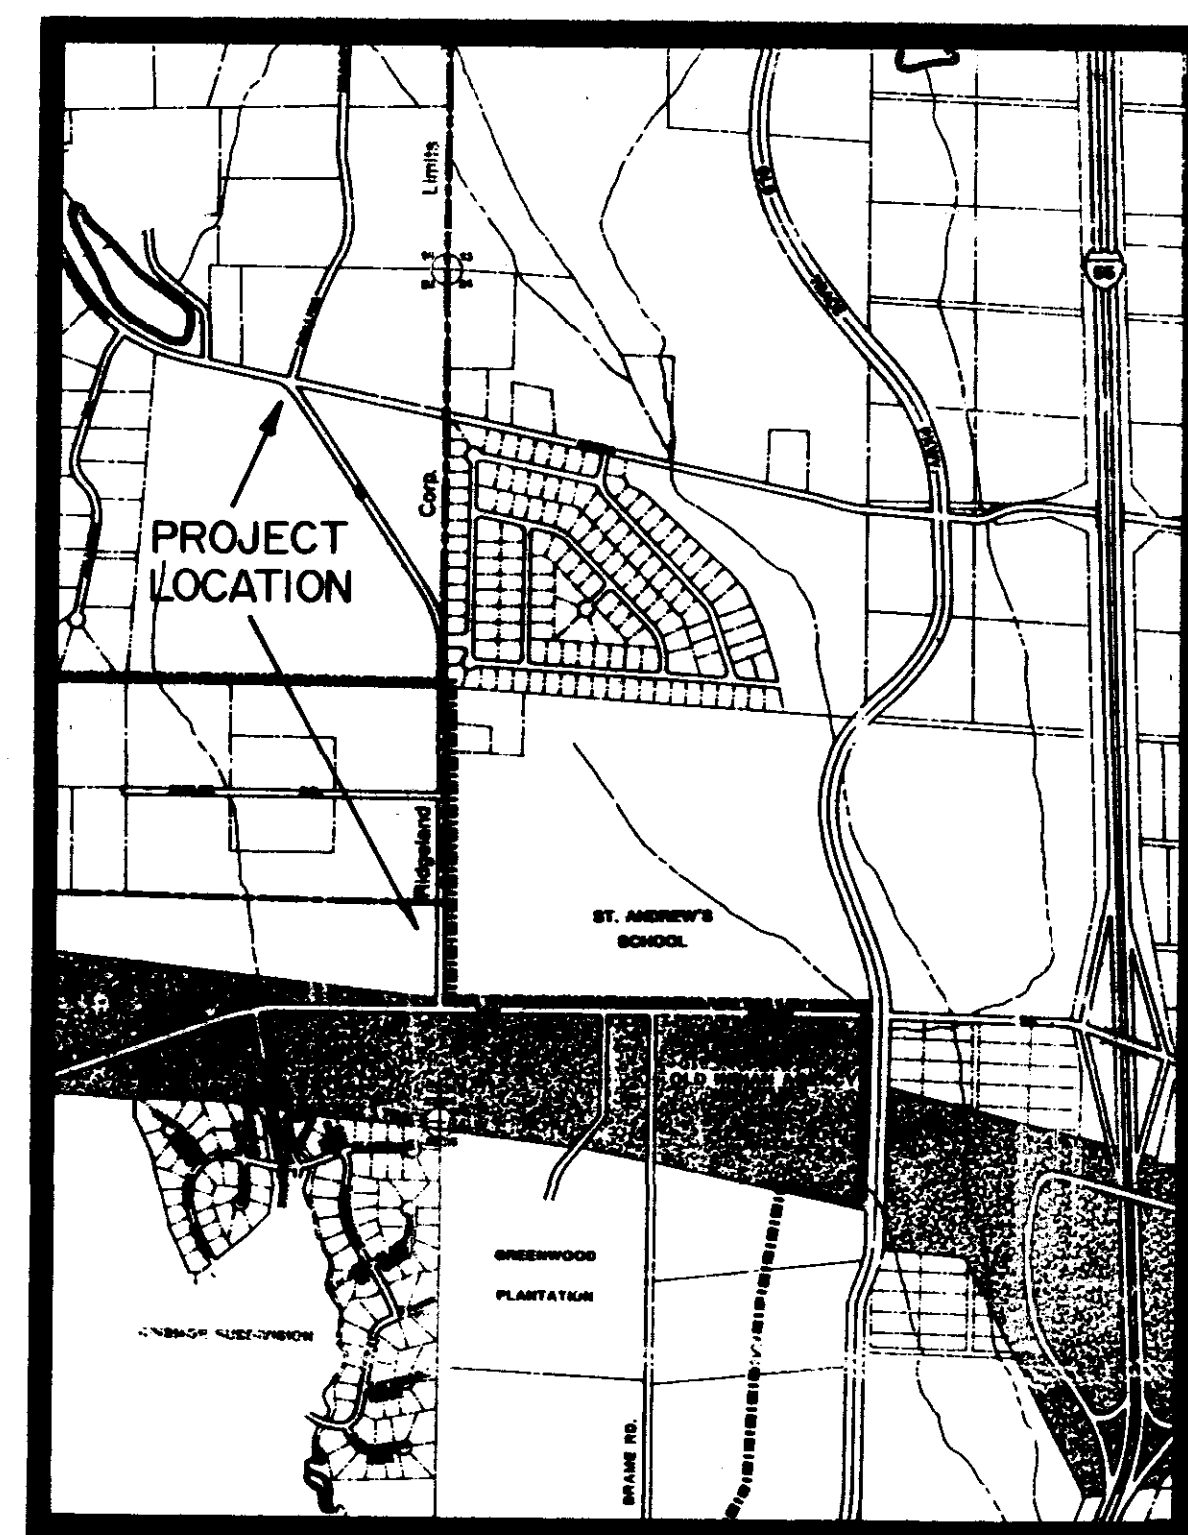

VICINITY MAP

INDEX TO DRAWINGS	
TITLE	DWG. NO.
COVER SHEET	
PLAN	1 of 3
PLAN	2 of 3
DETAILS	3 of 3







City Of Ridgeland
Public Works Department
Ridgeland, Mississippi


_____ Date _____

Sam C. Vinson, Jr. P.E.
Mississippi License No. 2325

PWP-1824

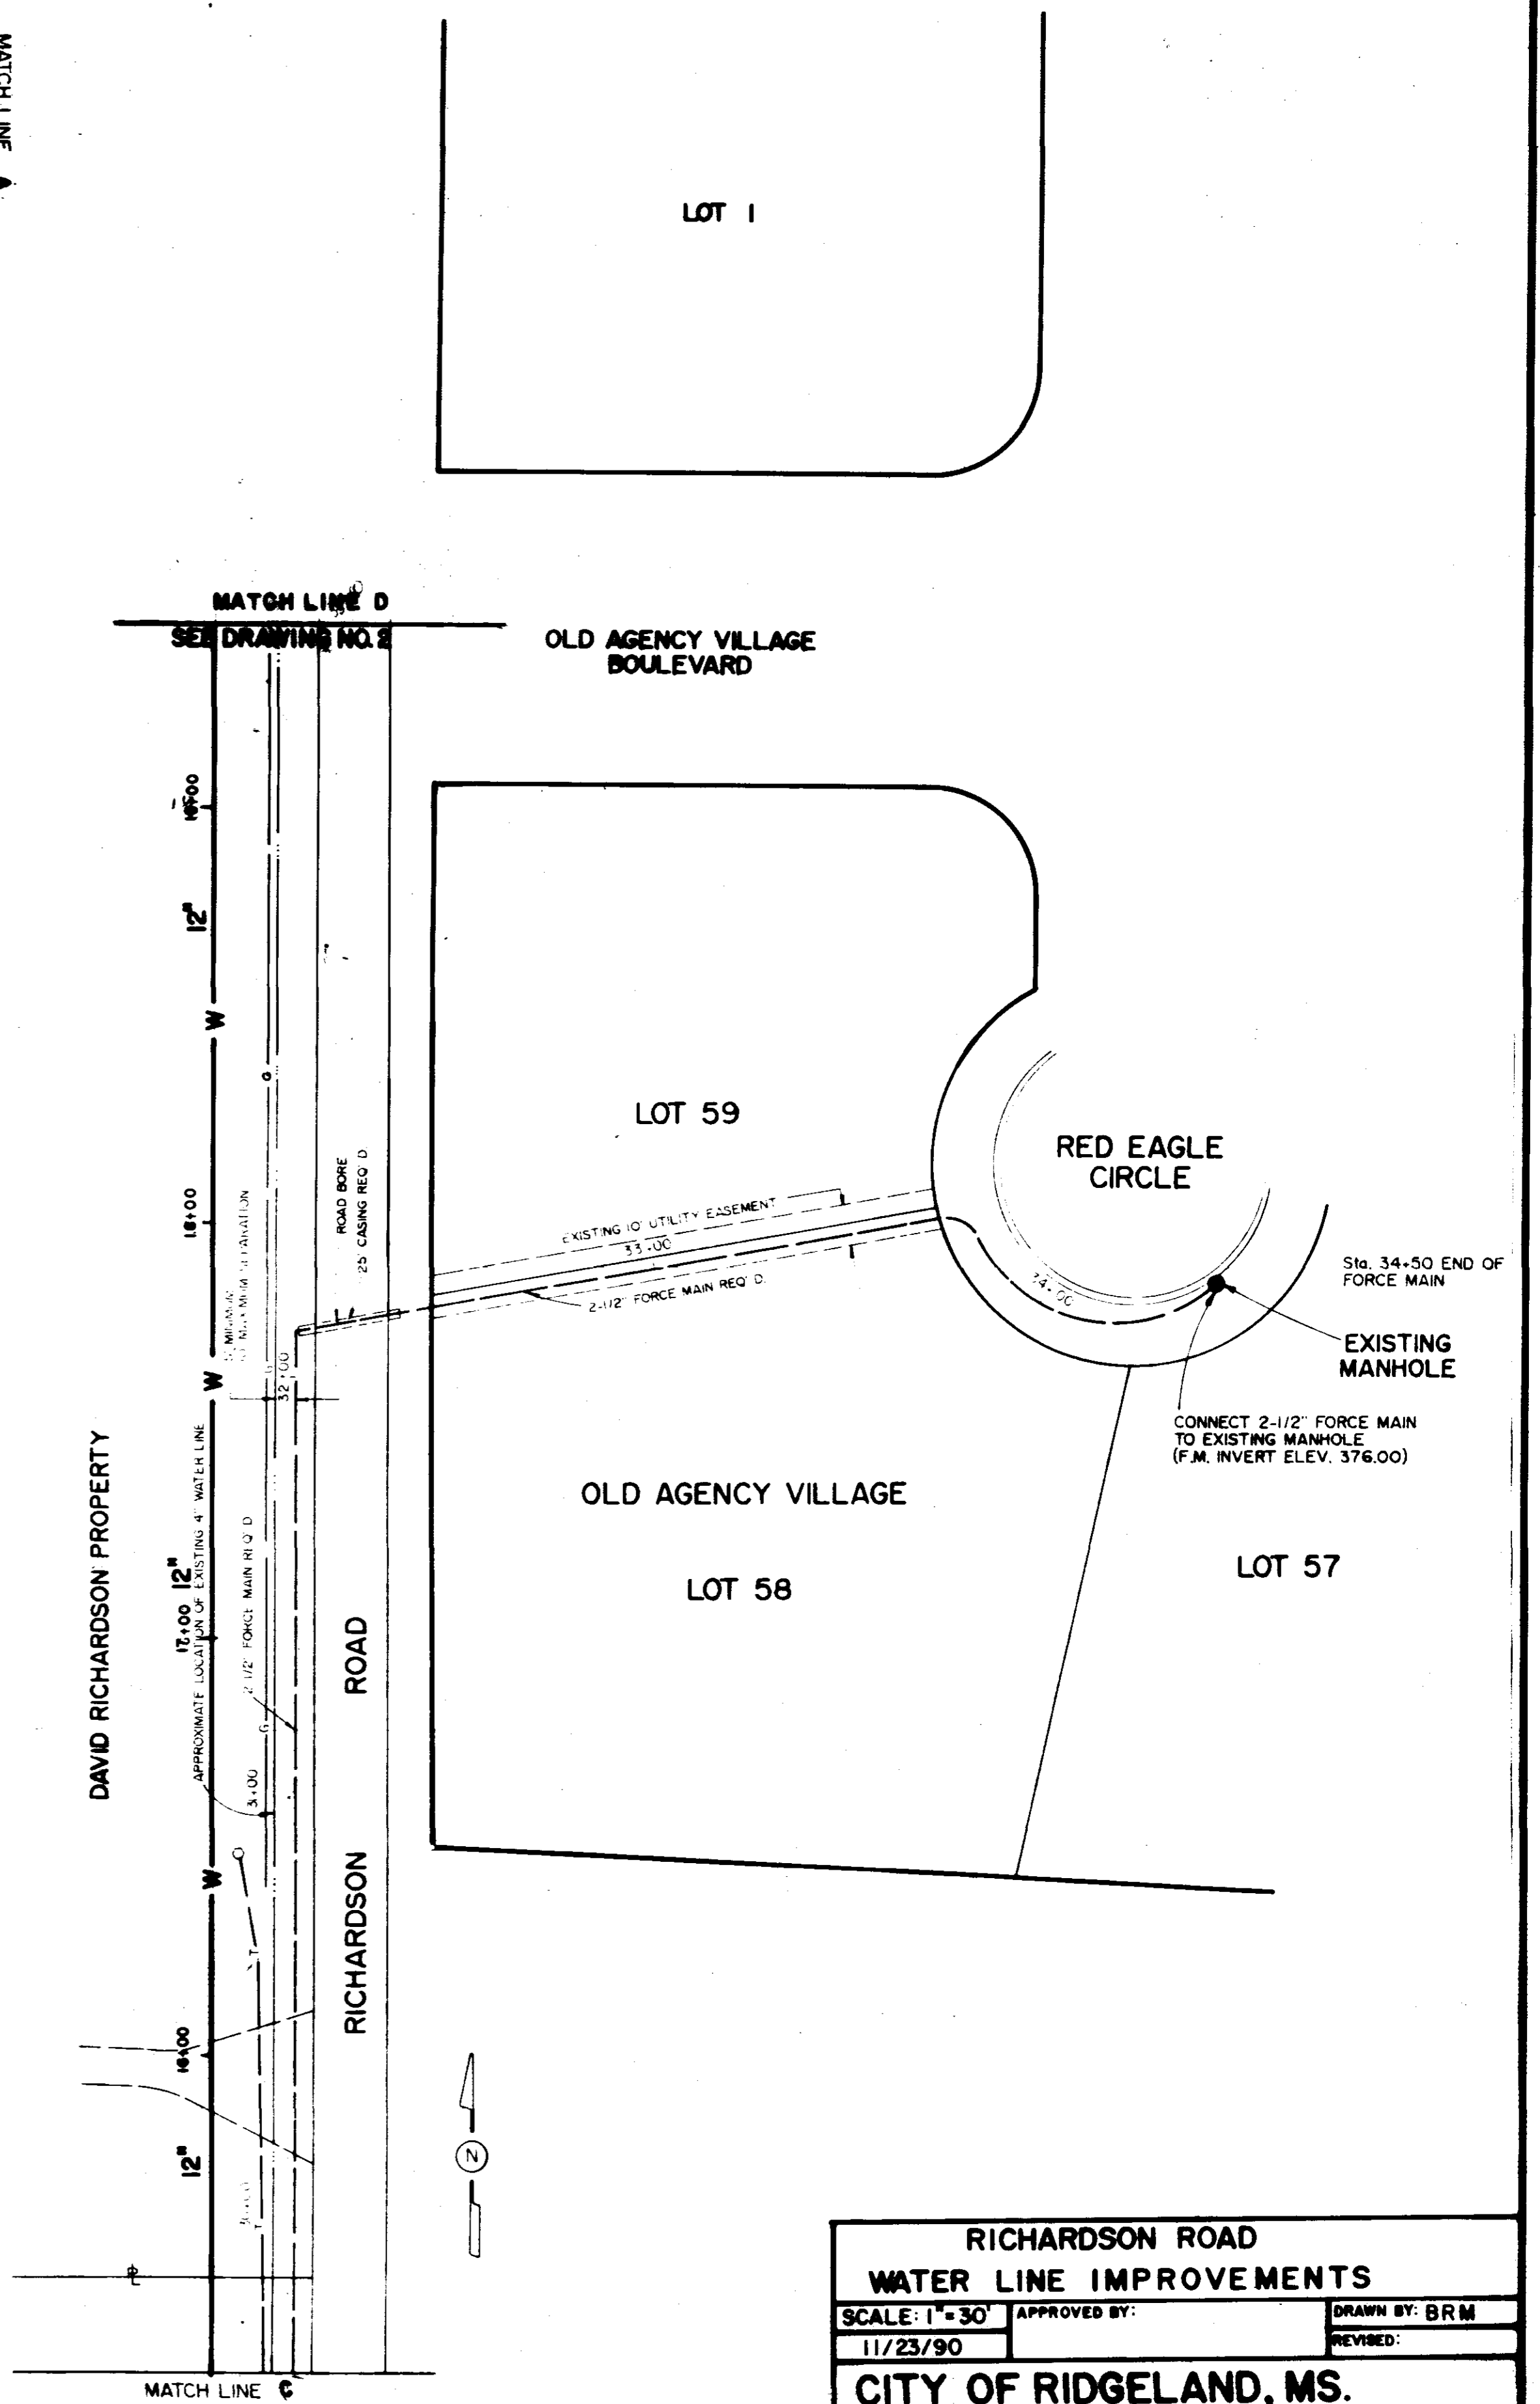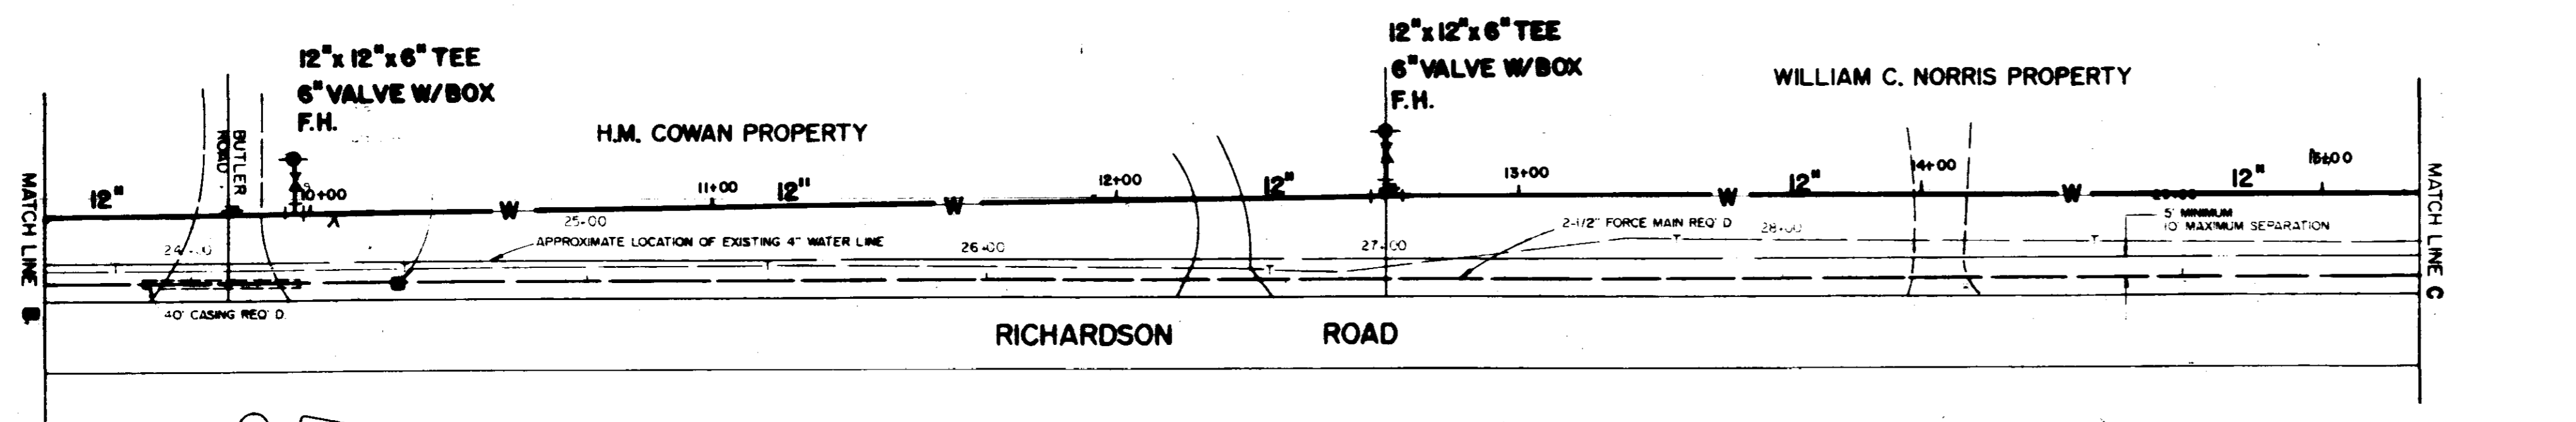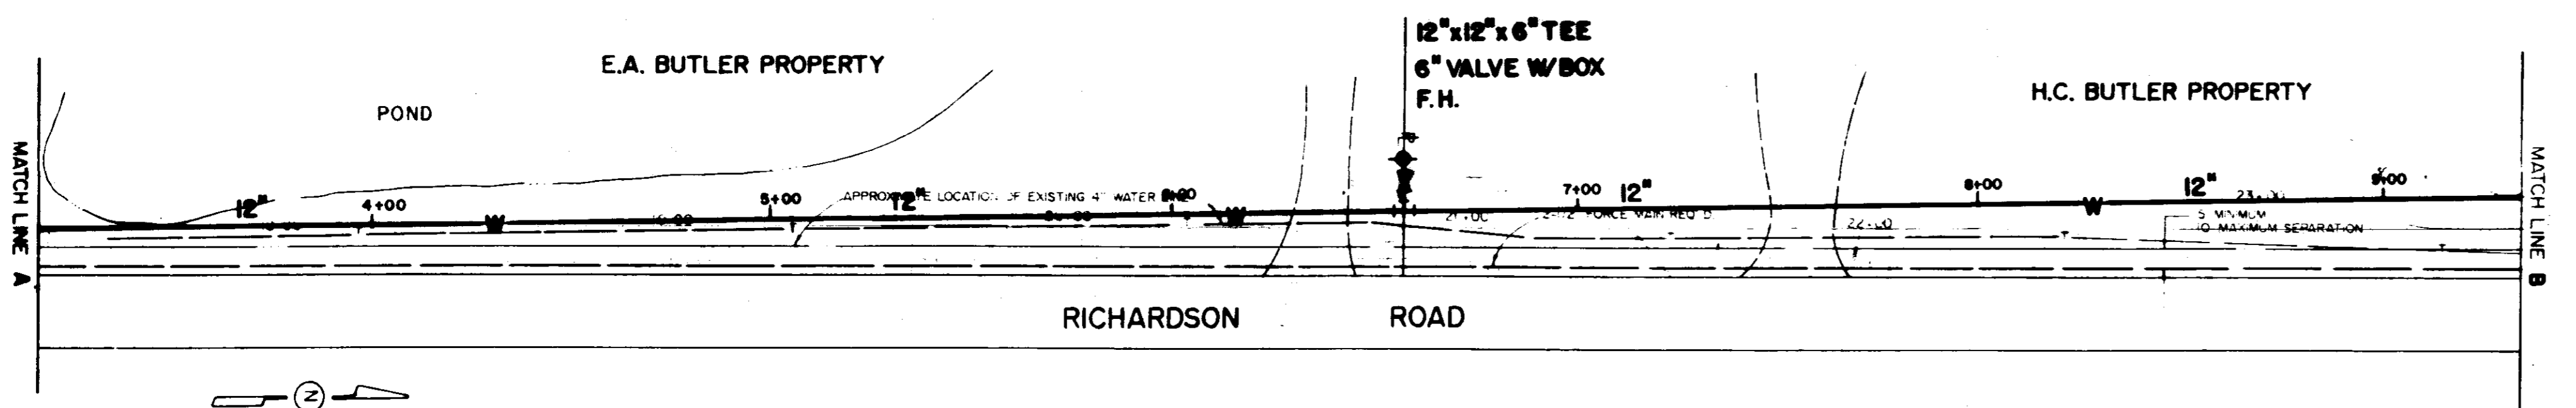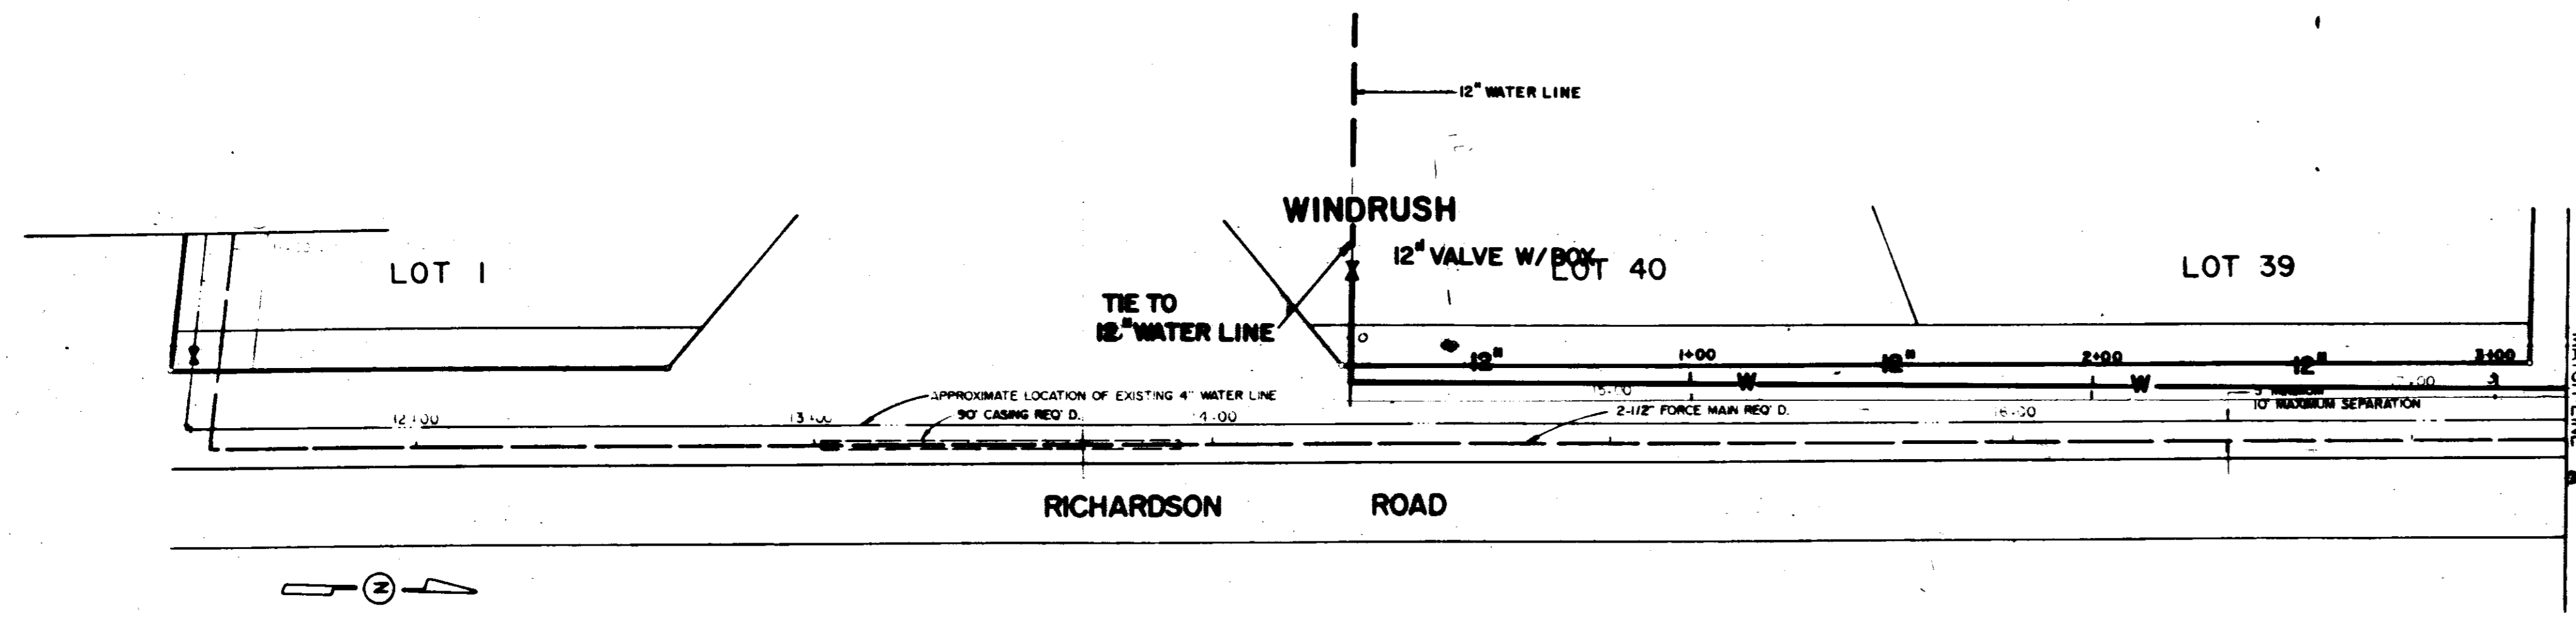

RICHARDSON ROAD	
WATER LINE IMPROVEMENTS	
SCALE: 1" = 30'	APPROVED BY:
11/23/90	DRAWN BY: BRM
CITY OF RIDGELAND, MS.	
PLAN	DRAWING NUMBER 1 of 3

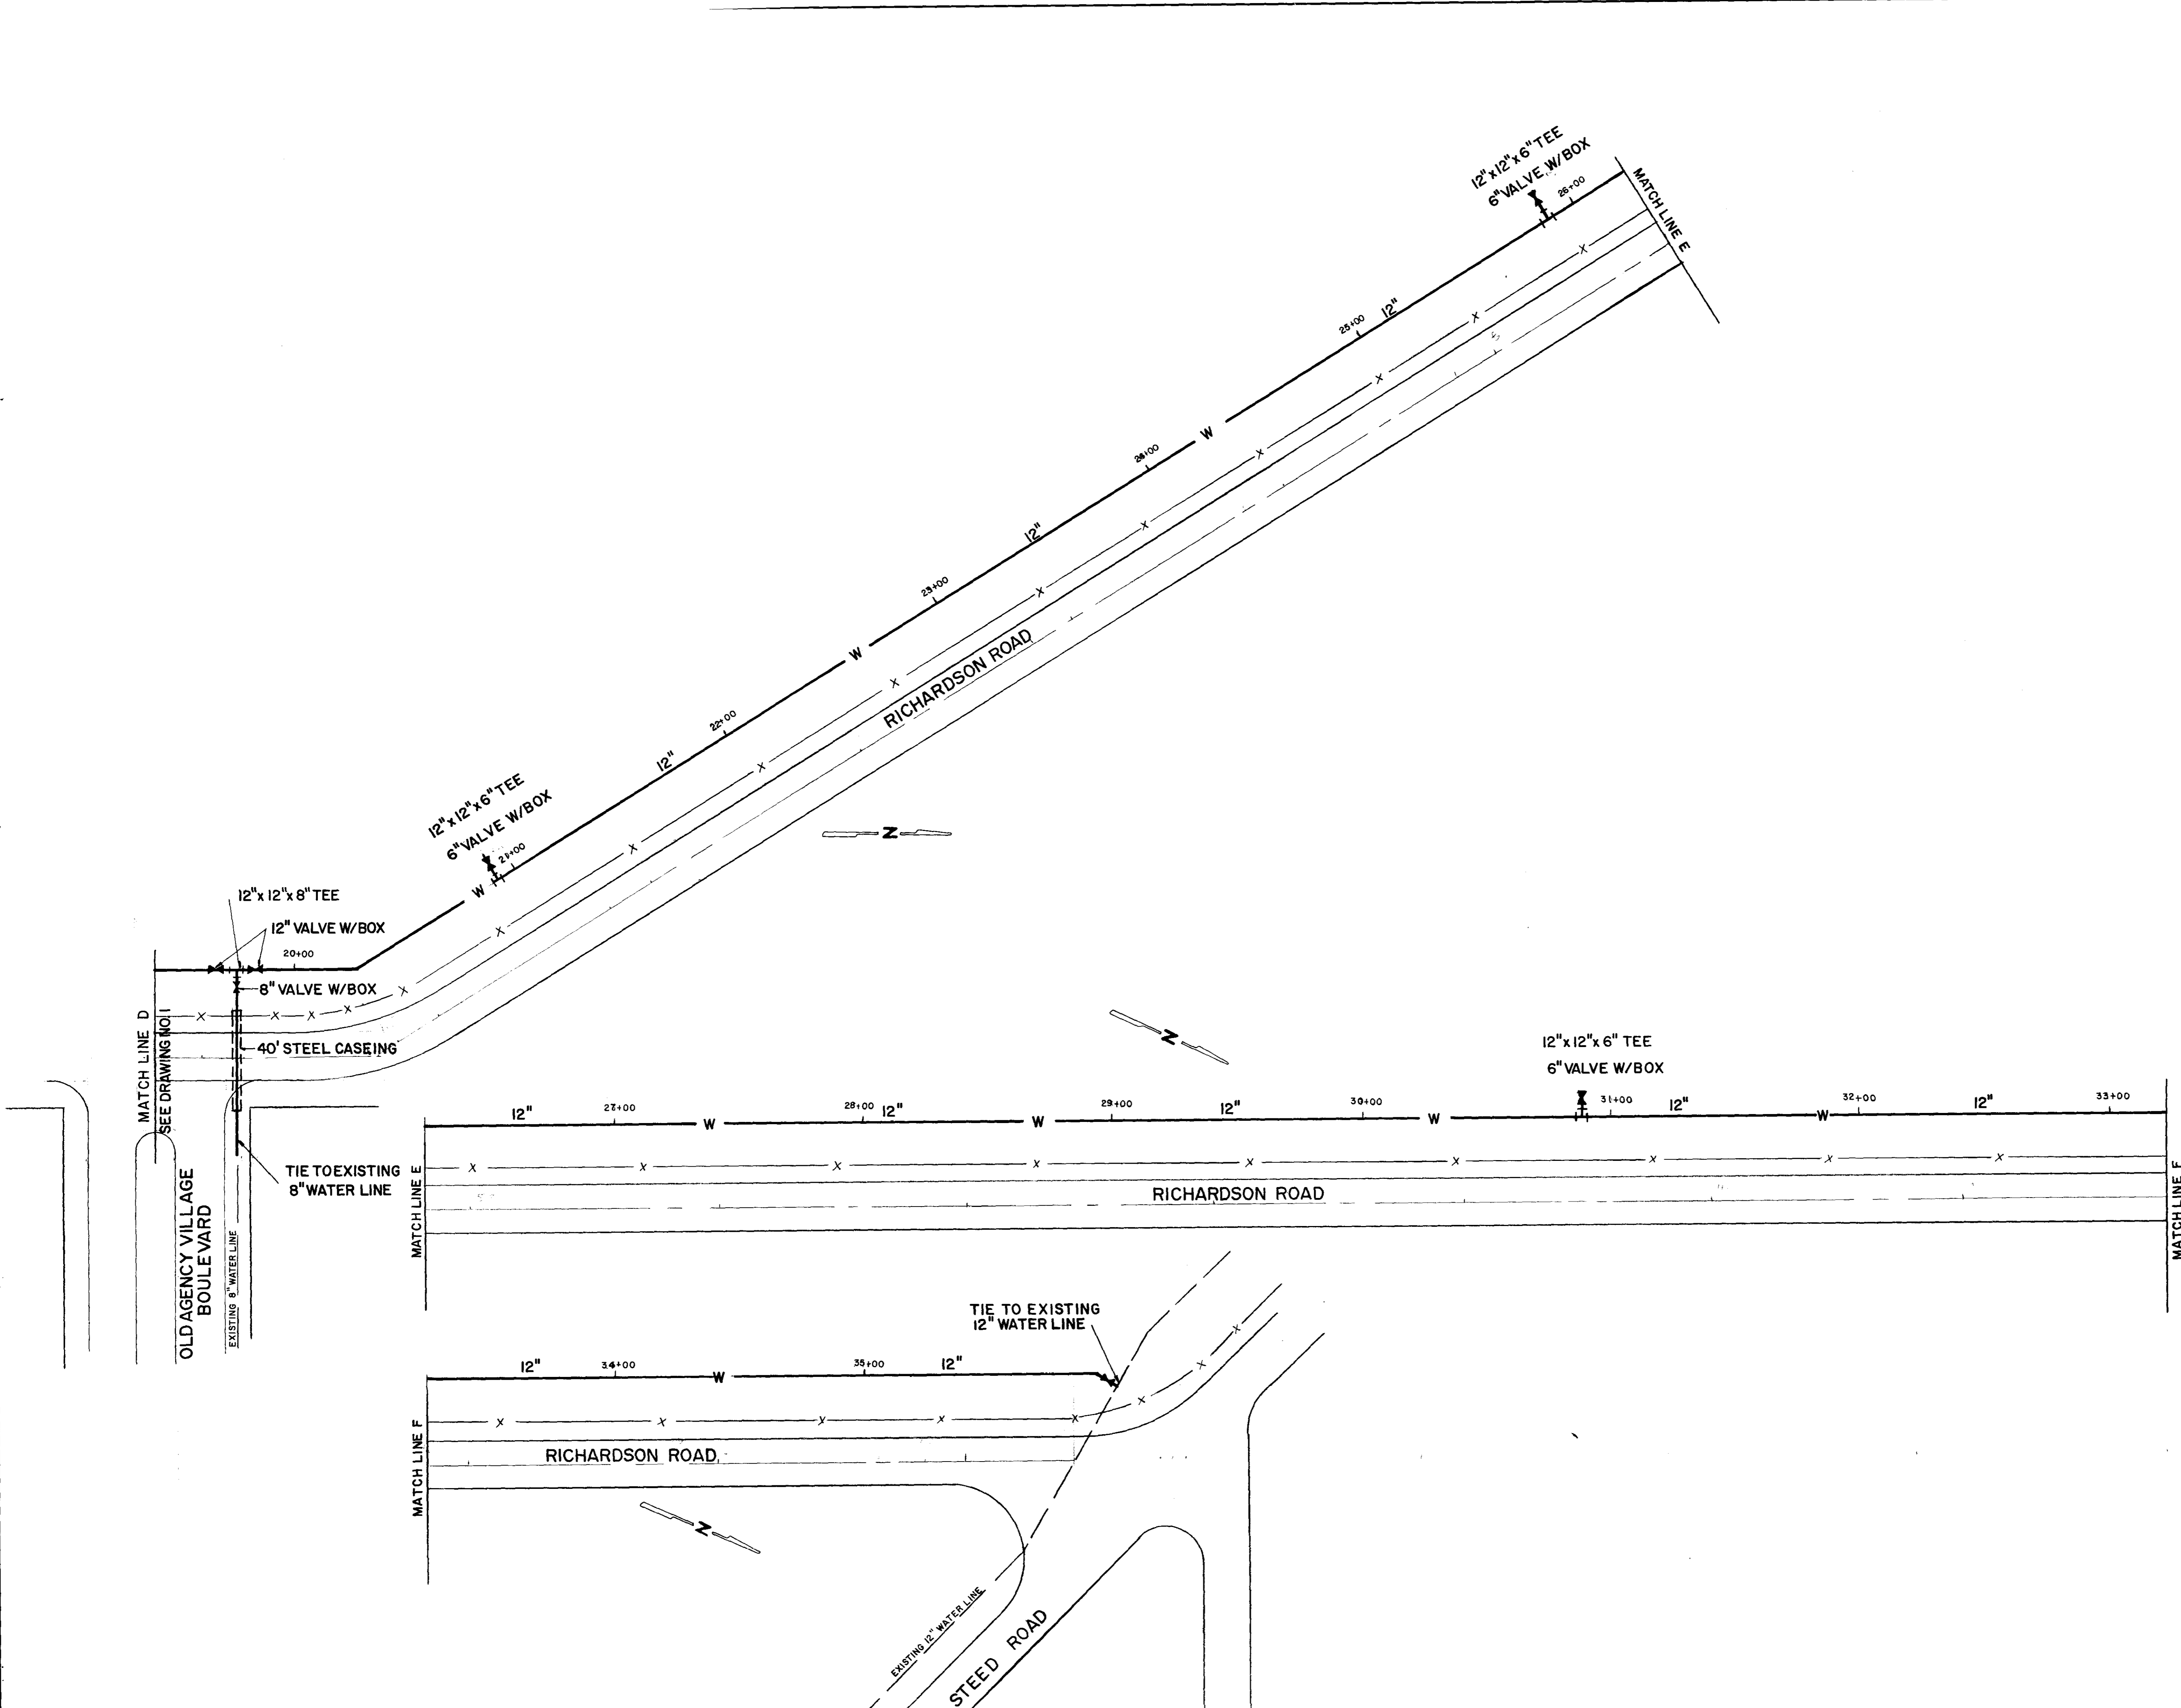

RICHARDSON ROAD WATER LINE IMPROVEMENTS			
SCALE: 1"=30'	APPROVED BY:	DRAWN BY: BRM	REVISED:
DATE: 11/28/90			
CITY OF RIDGELAND, MS.			
PLAN	DRAWING NUMBER		2 of 3