



BM #0-A ELEV 350.87
 ARROW TOP F.M. 514 COR.
 RIDGELAND AVE. & CENTRAL
 STREET.

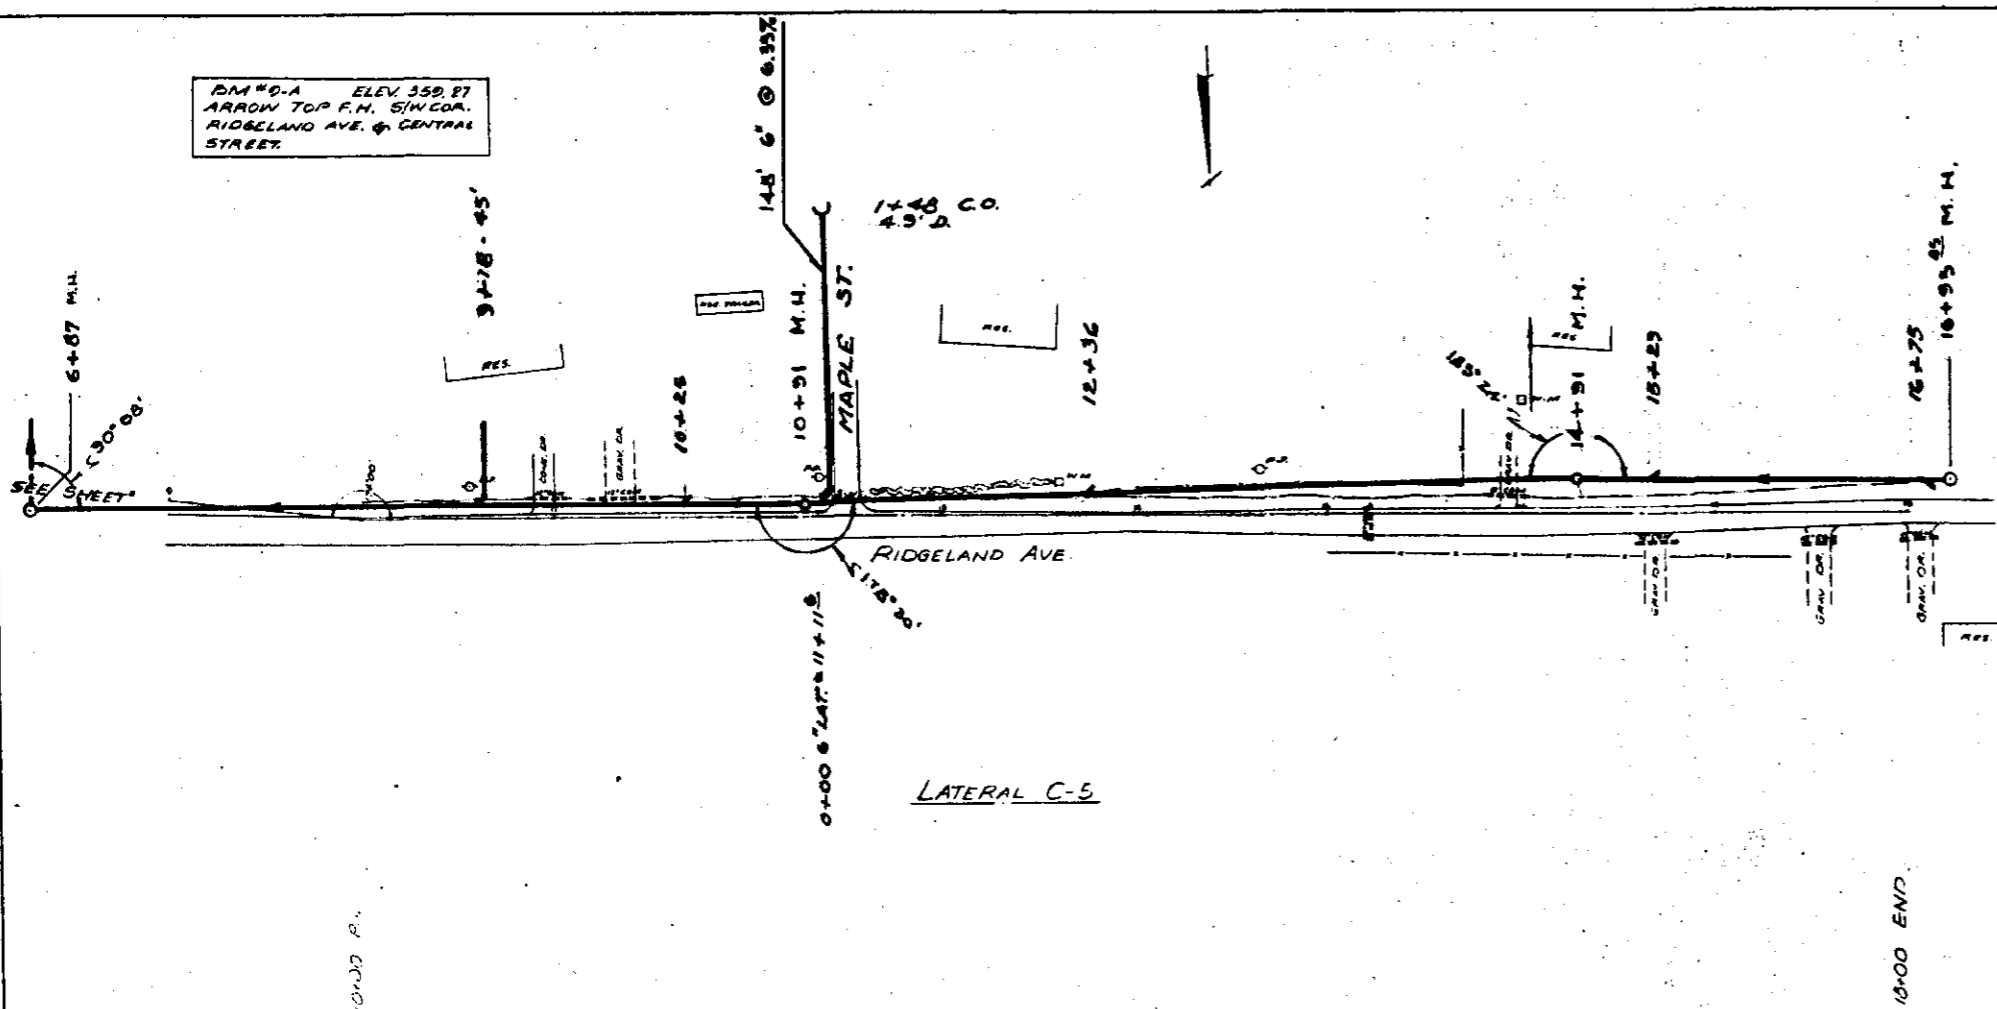

LATERAL C-5

1"=50' HORIZONTAL
 1"=5' VERTICAL

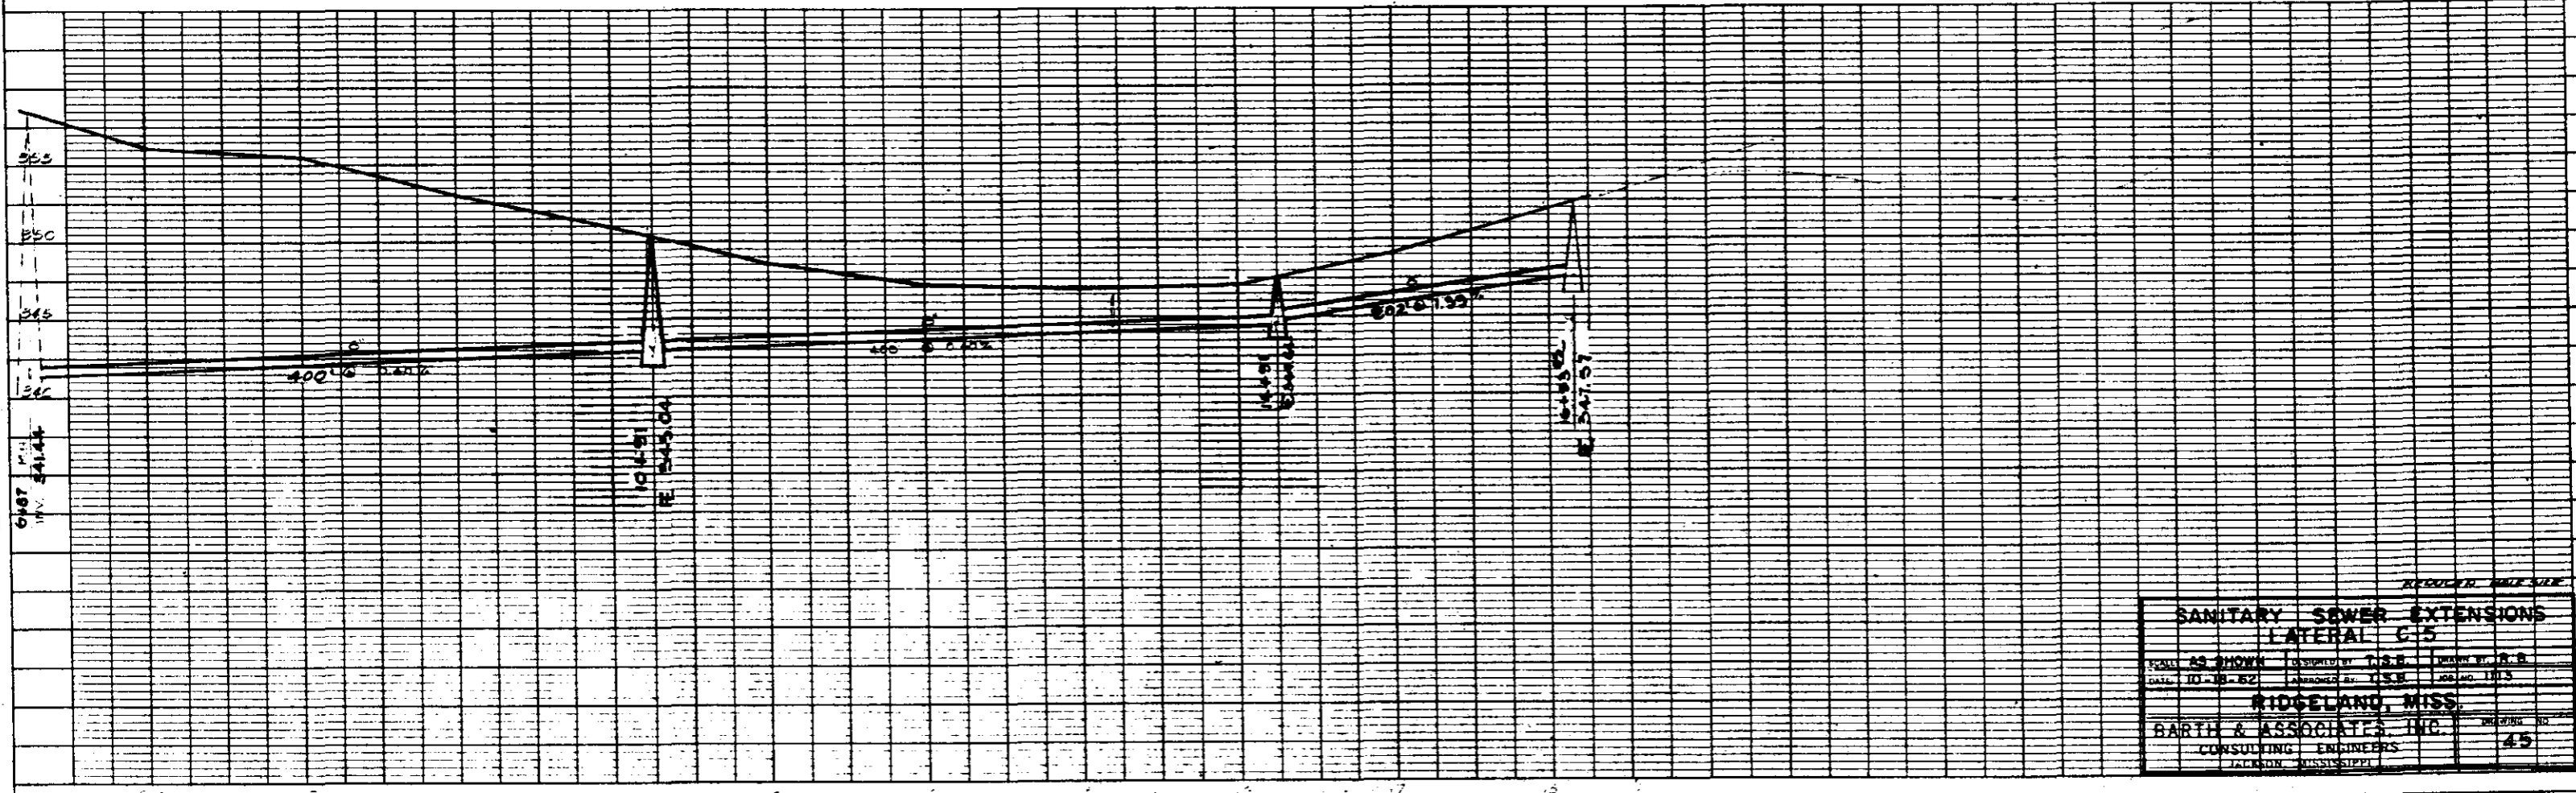

SANITARY SEWER EXTENSIONS		
LATERAL C-5		
SCALE AS SHOWN	DESIGNED BY T.S.B.	DRAWN BY R.B.
DATE 10-18-52	APPROVED BY T.S.B.	JOB NO. 1175
RIDGELAND, MISS.		
BARTH & ASSOCIATES, INC.		DRAWING NO.
CONSULTING ENGINEERS		45
JACKSON, MISSISSIPPI		