


SANITARY SEWER INDEX

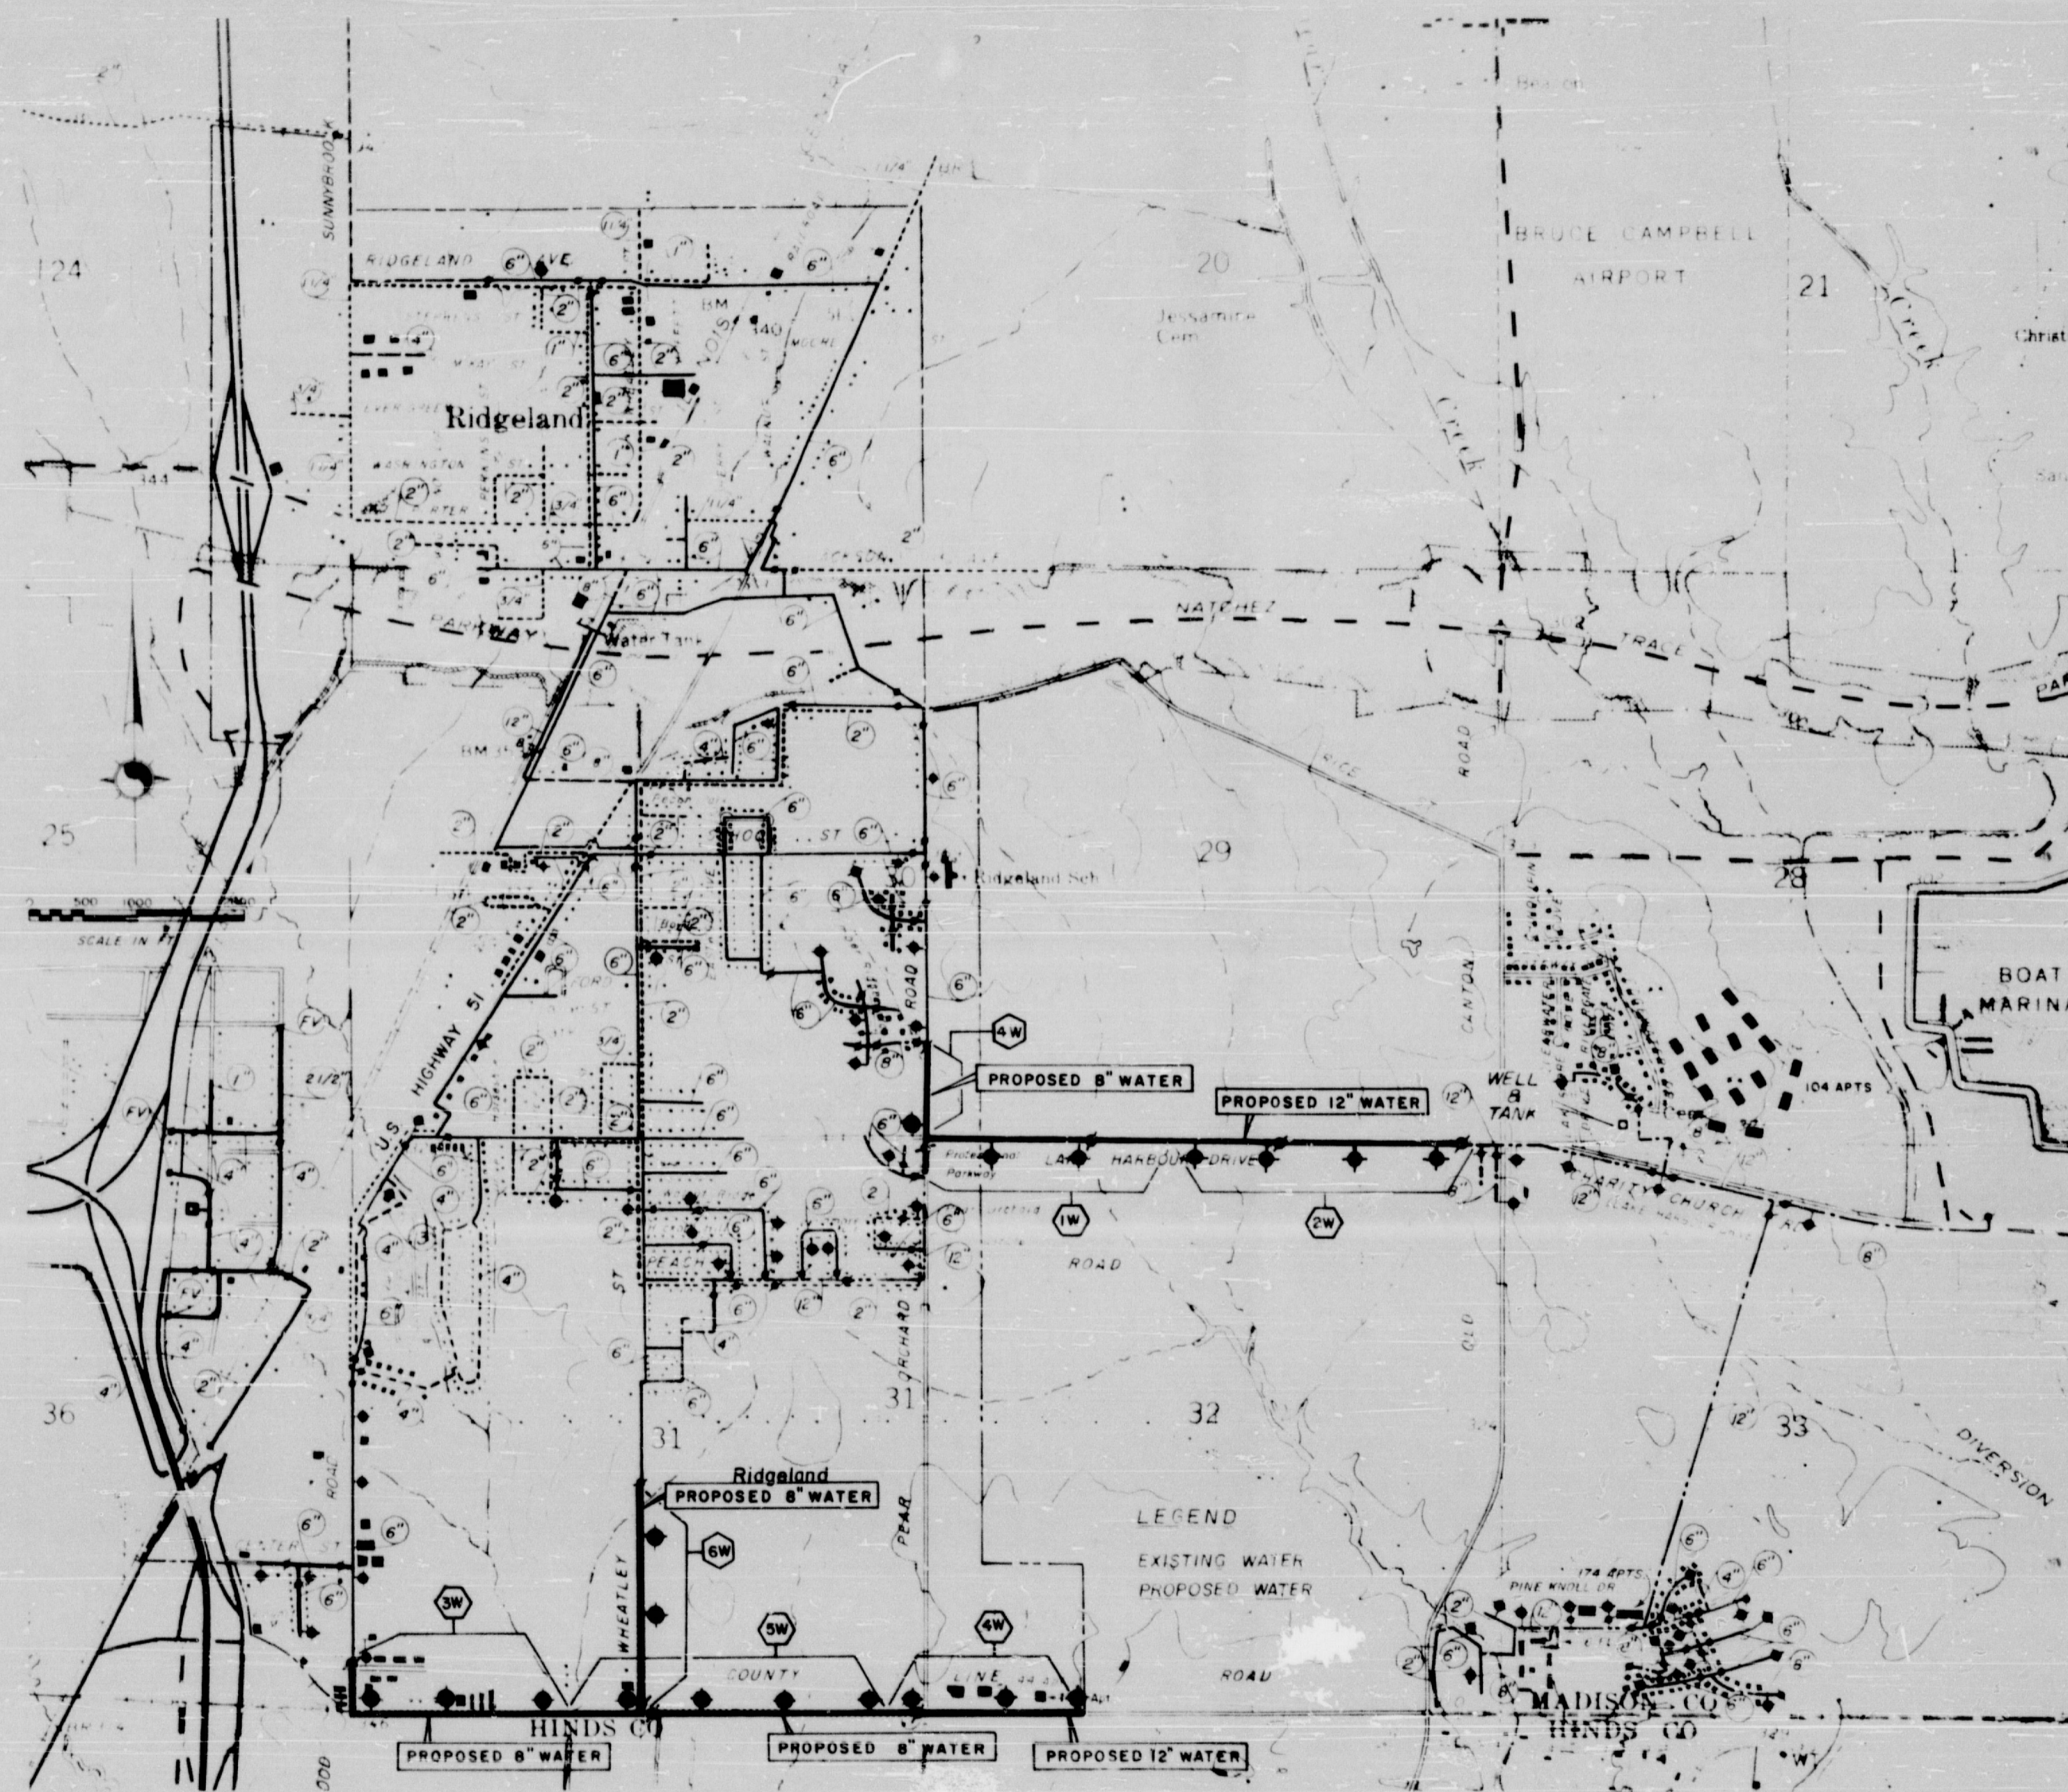

WATER INDEX

LEGEND

- PROPOSED WATER
- EXISTING WATER
- PROPOSED SEWER
- EXISTING SEWER
- SHEET NUMBER

H 143

INDEX MAP			
SCALE AS SHOWN	DESIGNED BY T.S.B.	DRAWN BY G.B.E.	
DATE NOV 10, 1977	APPROVED BY T.S.B.	JOB NO.	
RIDGELAND, MISSISSIPPI			
BARTH & ASSOCIATES, INC. CONSULTING ENGINEERS JACKSON, MISSISSIPPI			DRAWING NO. <b>INDEX</b>