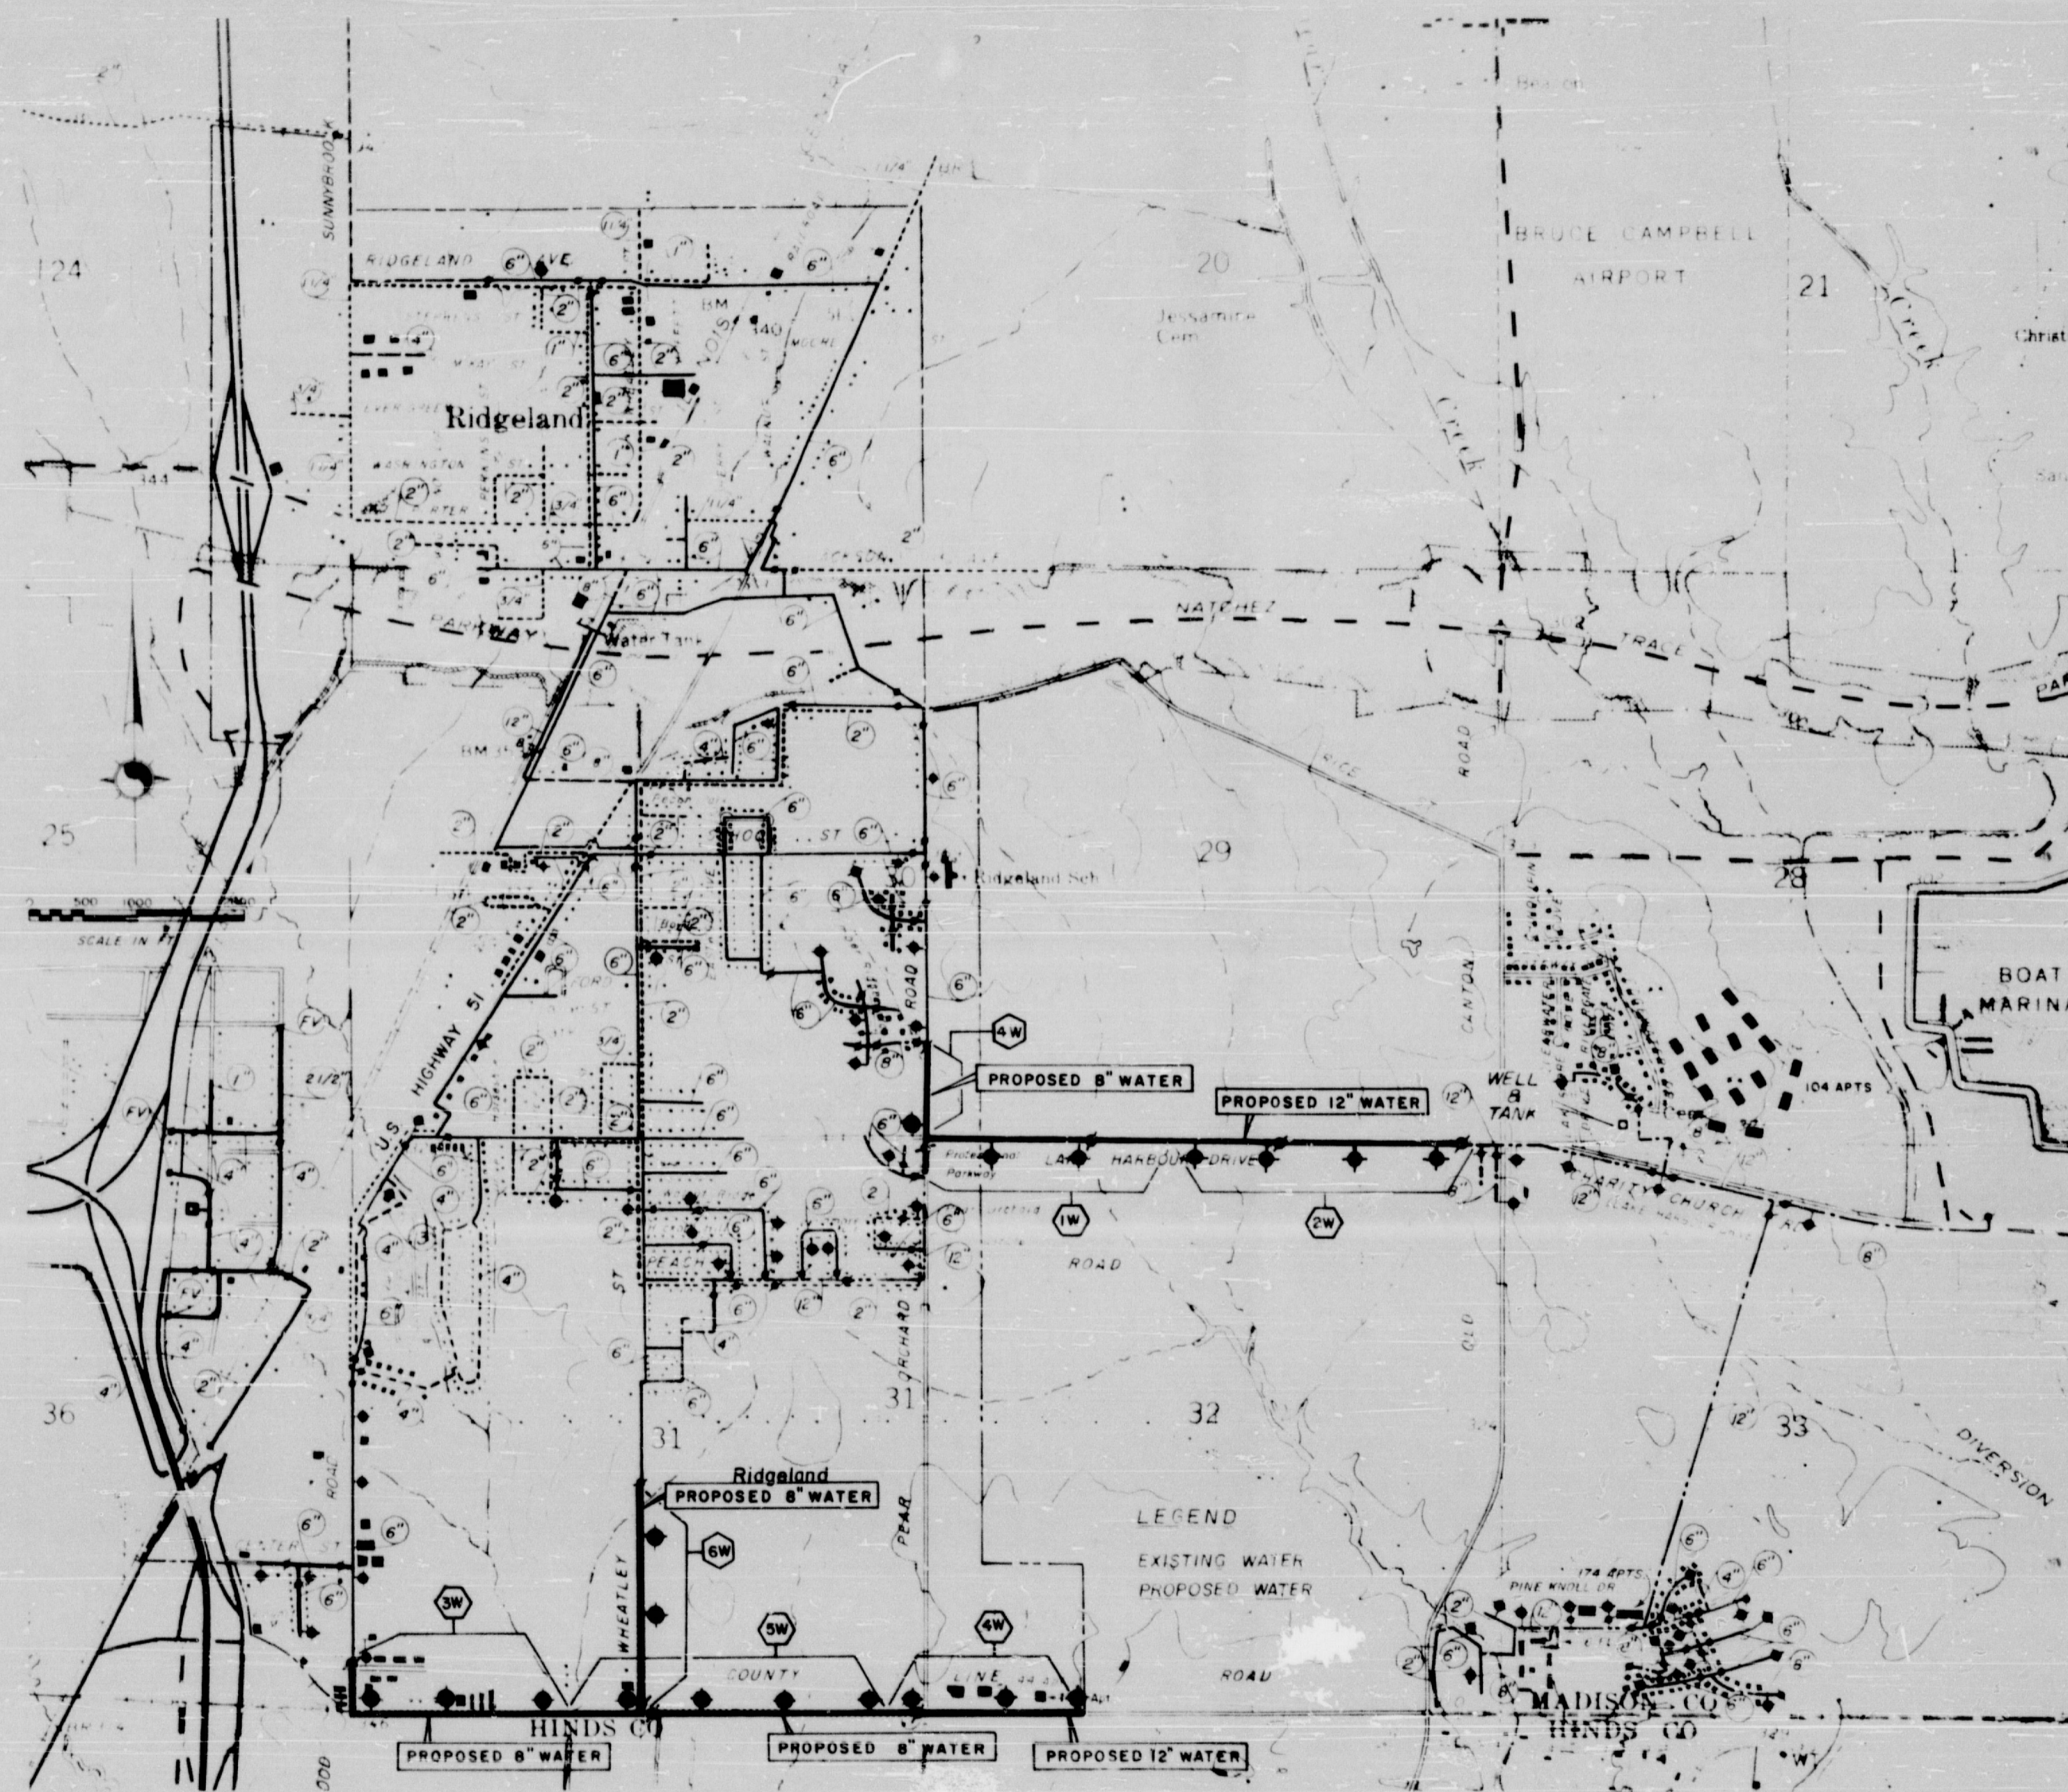


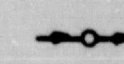
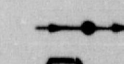



SANITARY SEWER INDEX



WATER INDEX

LEGEND

-  PROPOSED WATER
-  EXISTING WATER
-  PROPOSED SEWER
-  EXISTING SEWER
-  SHEET NUMBER

H 143

INDEX MAP			
SCALE AS SHOWN	DESIGNED BY T.S.B.	DRAWN BY G.B.E.	
DATE NOV 10, 1977	APPROVED BY T.S.B.	JOB NO.	
RIDGELAND, MISSISSIPPI			
BARTH & ASSOCIATES, INC. CONSULTING ENGINEERS JACKSON, MISSISSIPPI			DRAWING NO. INDEX