





RECEIVED
 MAY 02 2000
 PUBLIC WORKS DEPT

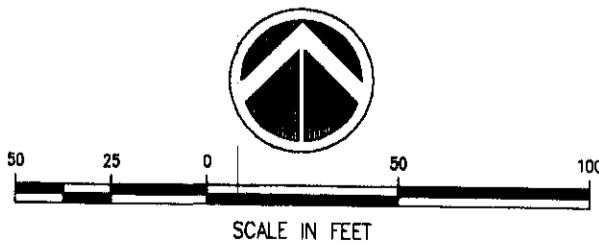

PWP-01940

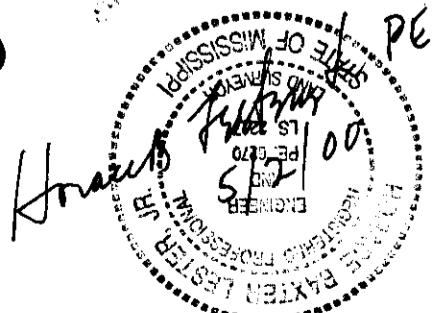

**SHADOWWOOD, PART 1
 LIMITED STORM SEWER AS-BUILT PLAN**

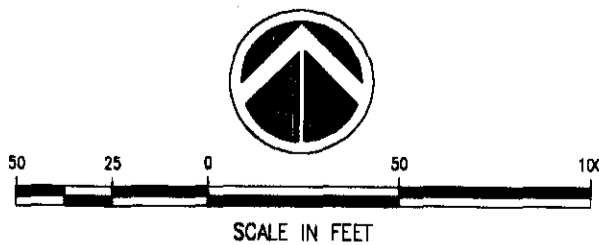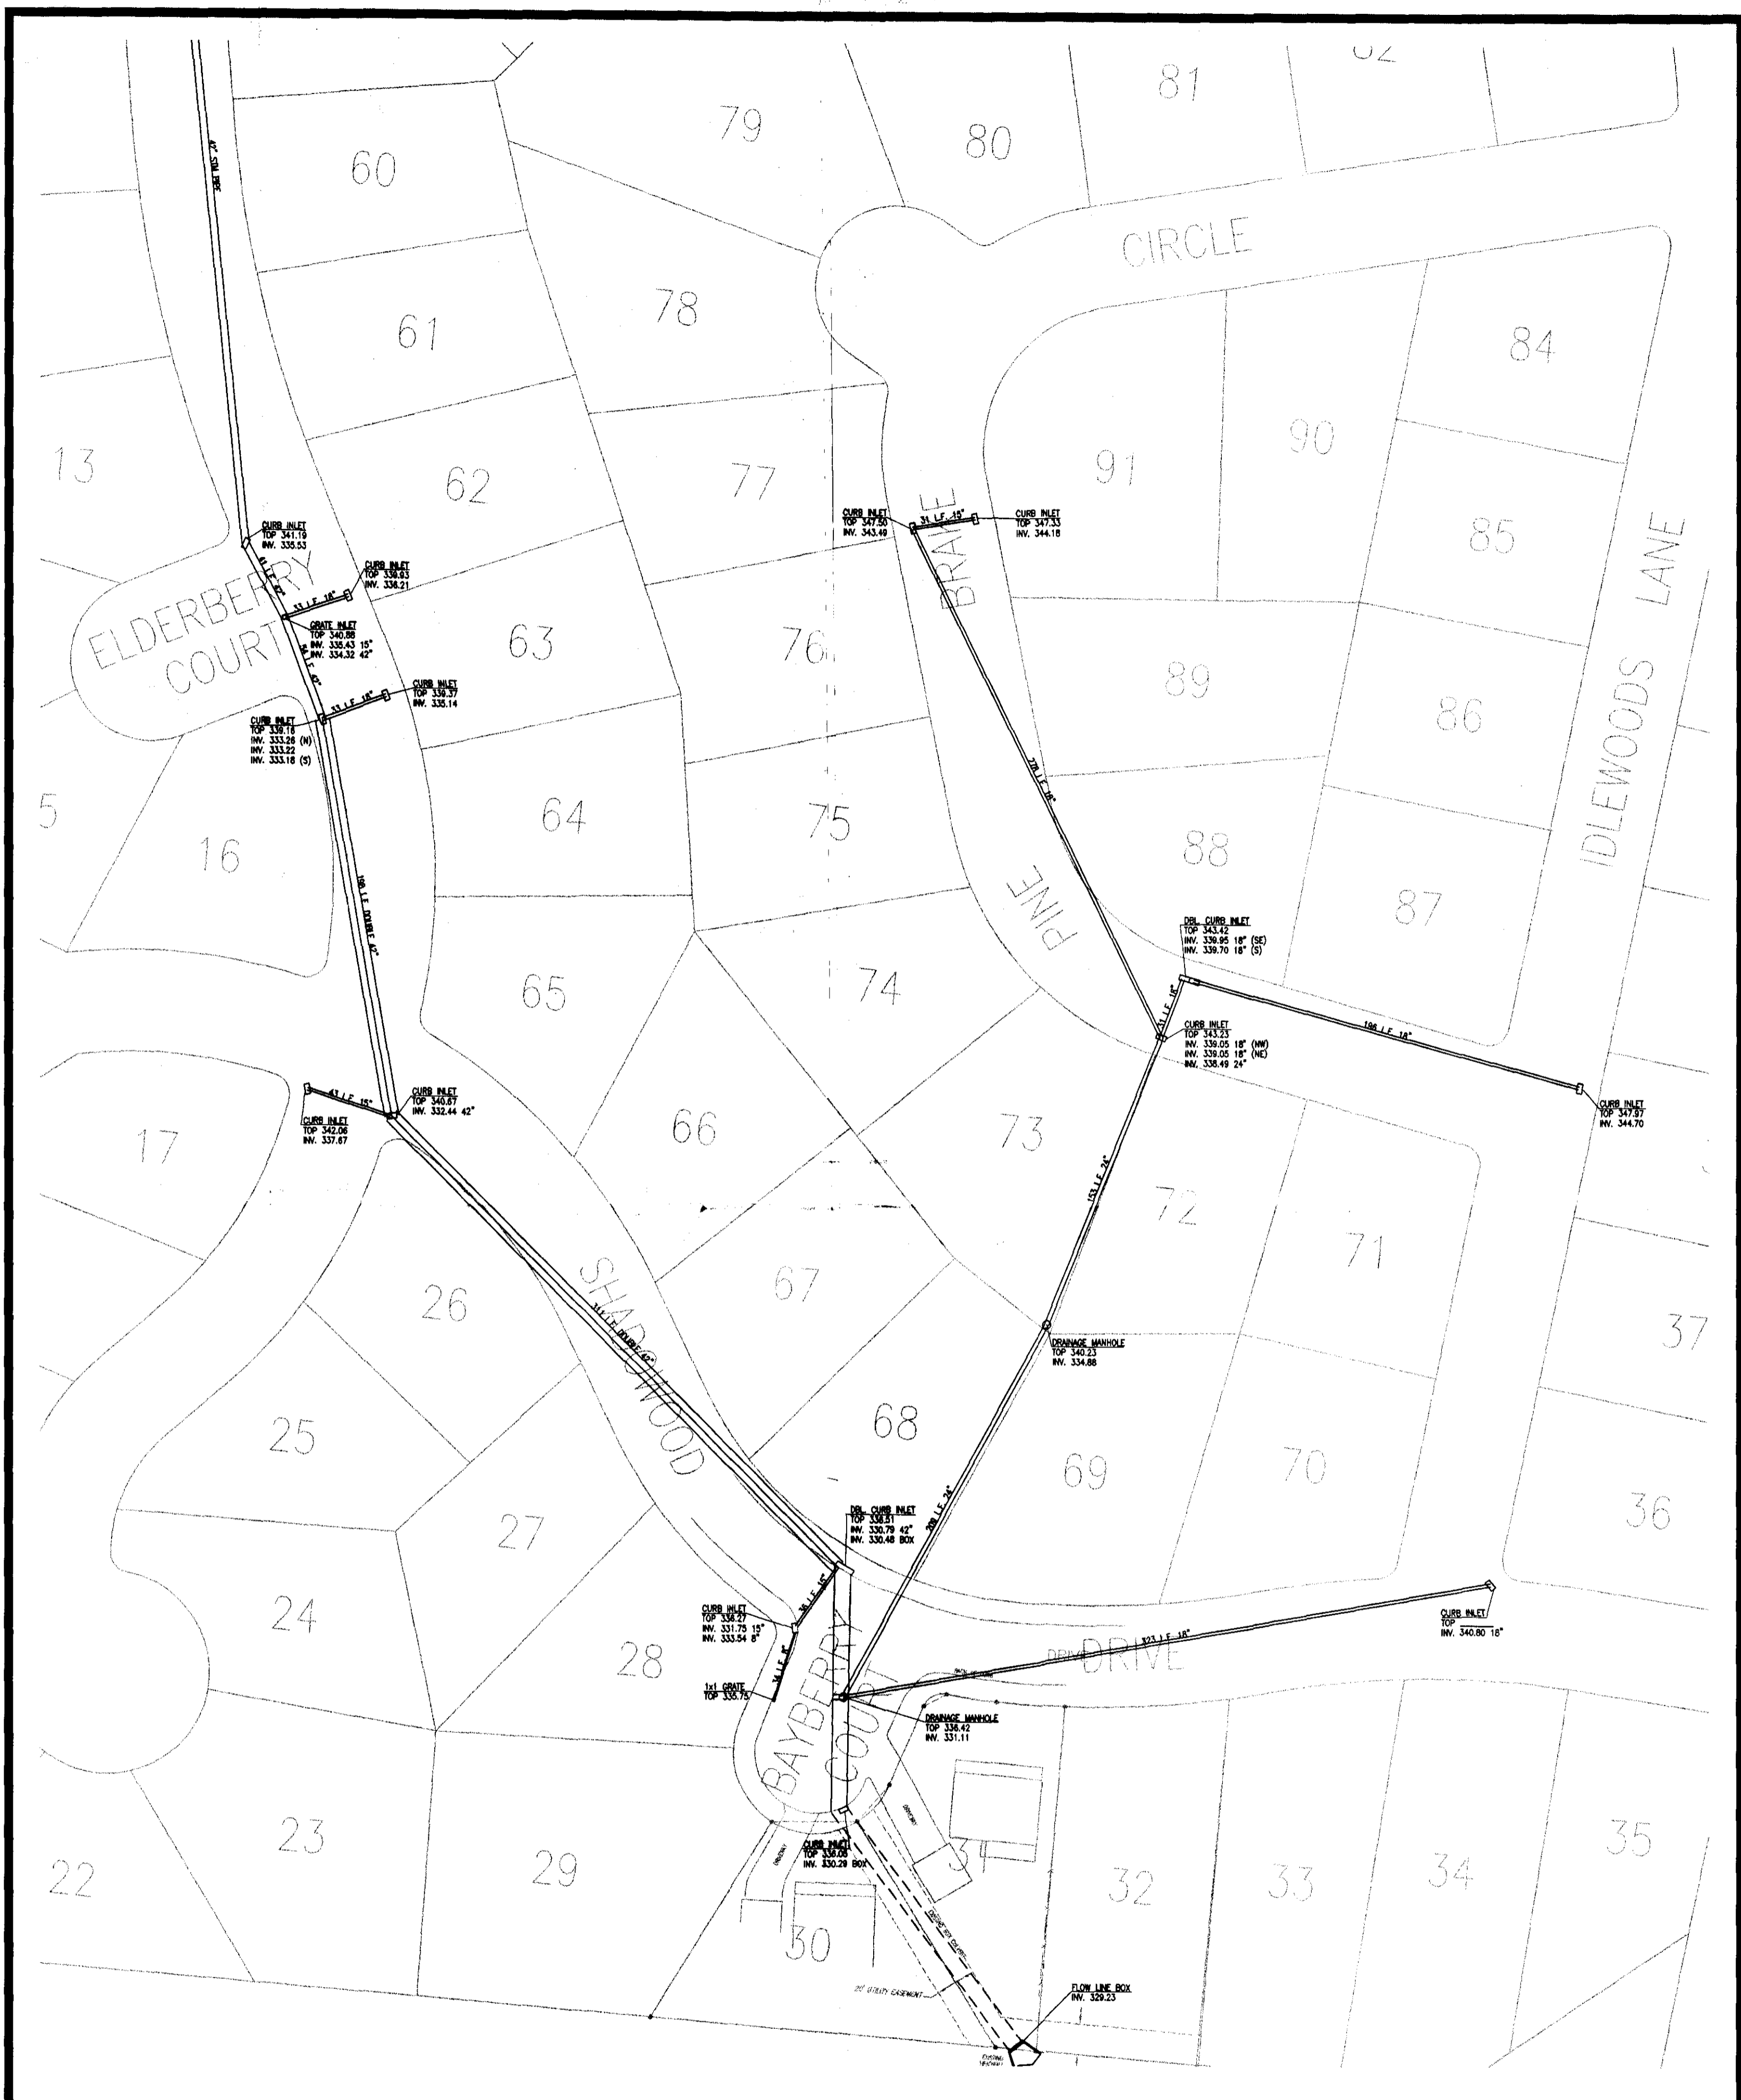

**SHADOWOOD, PART 1
LIMITED STORM SEWER AS-BUILT PLAN**

PW 1940