


SQUIRREL HILL

Situated in the S 1/2 of the NE 1/4 of the NW 1/4 of
Section 31, T7N, R2E, Madison County, Mississippi

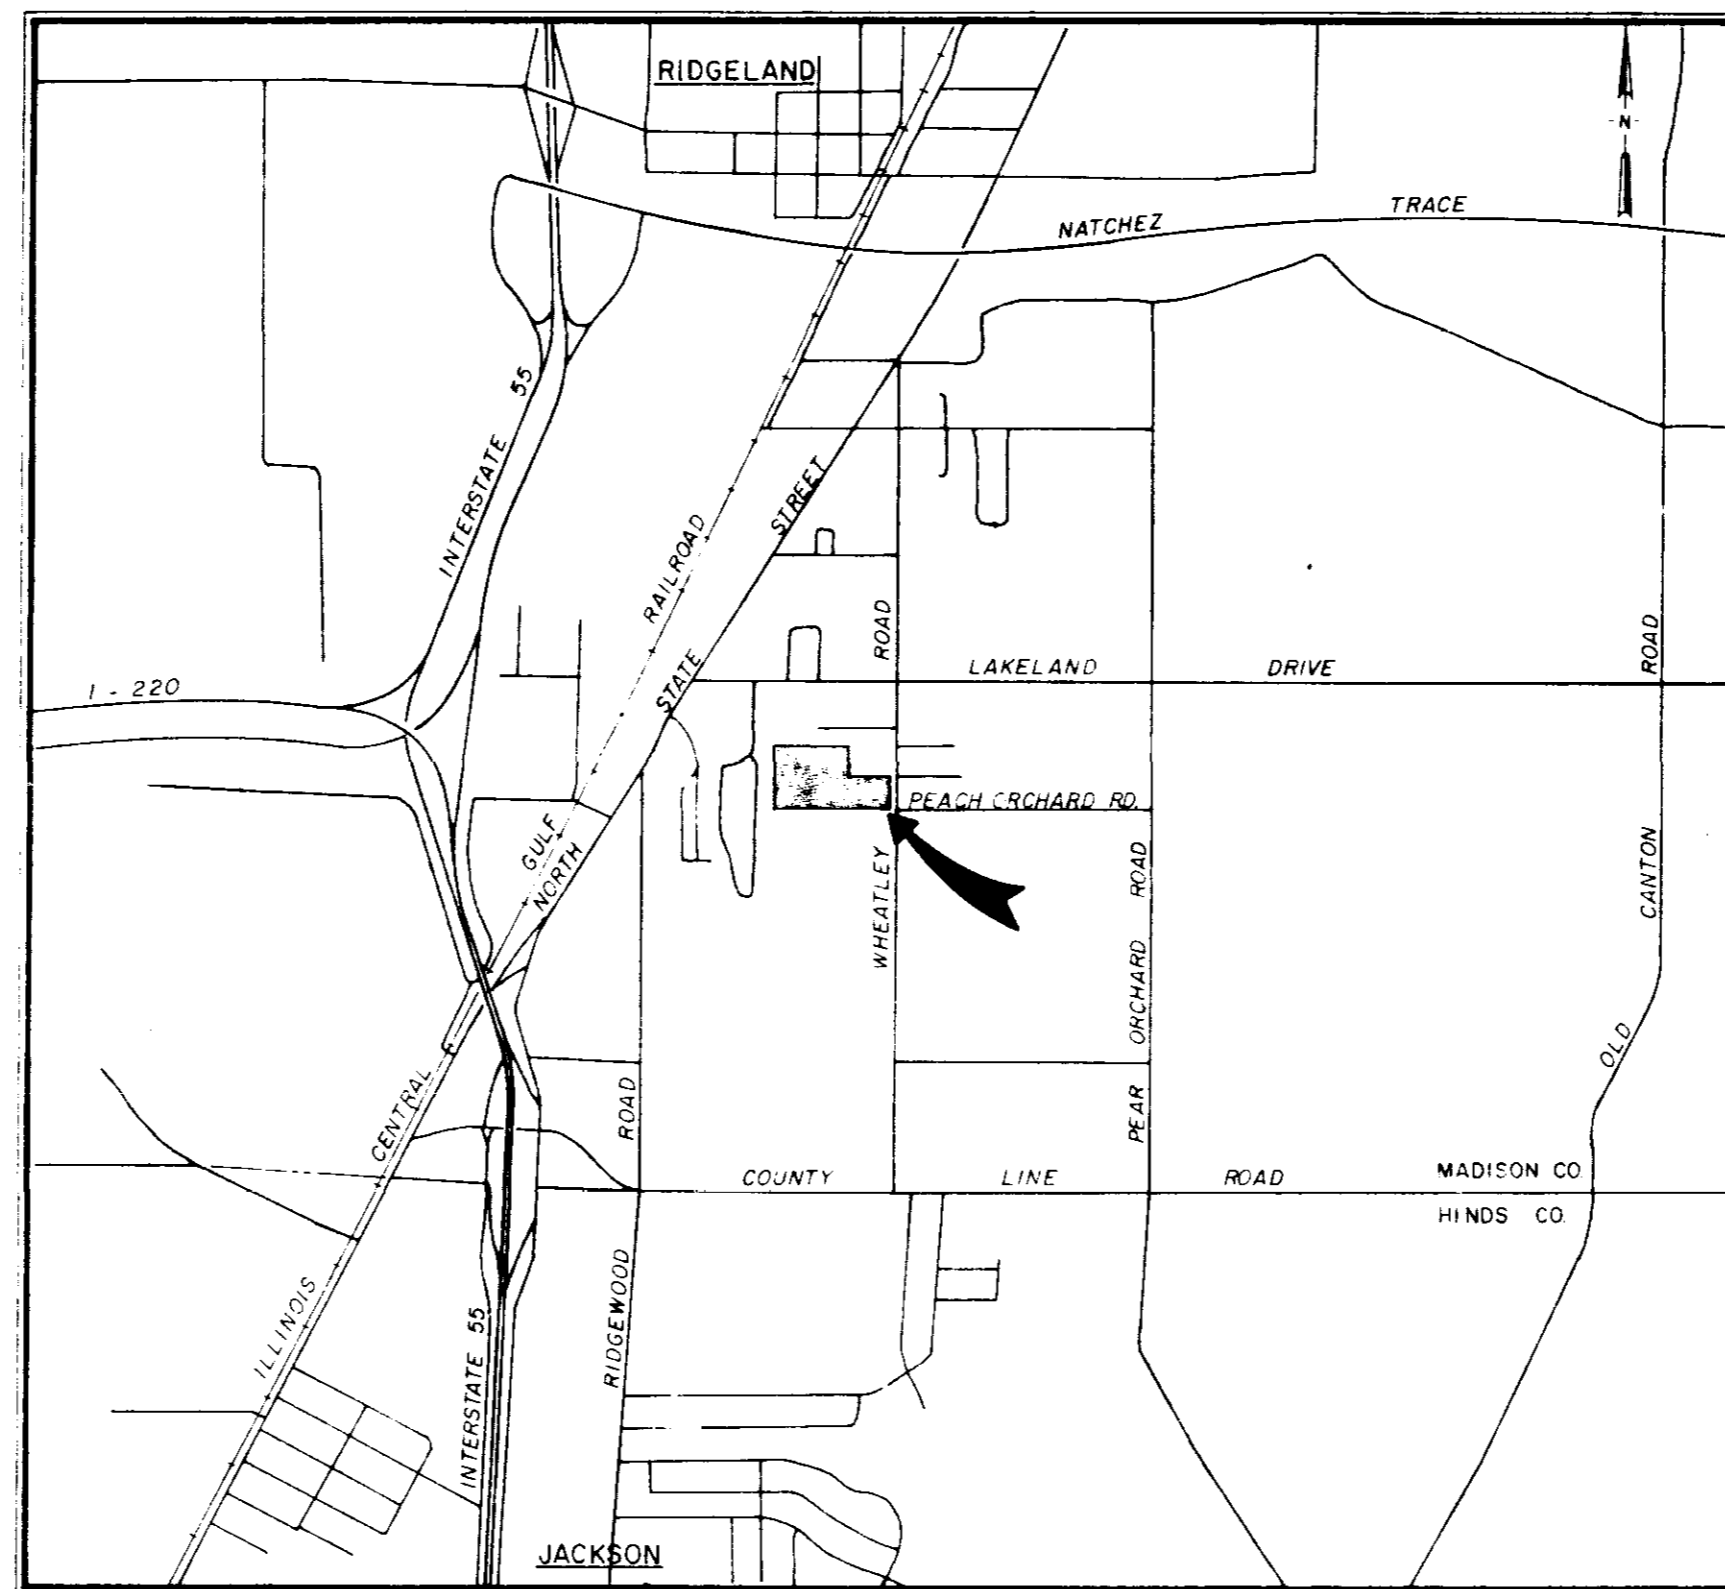






Developed By
HARKINS & HARKINS BUILDERS, INC.

JOE A. WAGGONER
Civil Engineer
Brandon / Jackson, Mississippi





"AS-BUILTS"

2-28-1980

PWP-01919

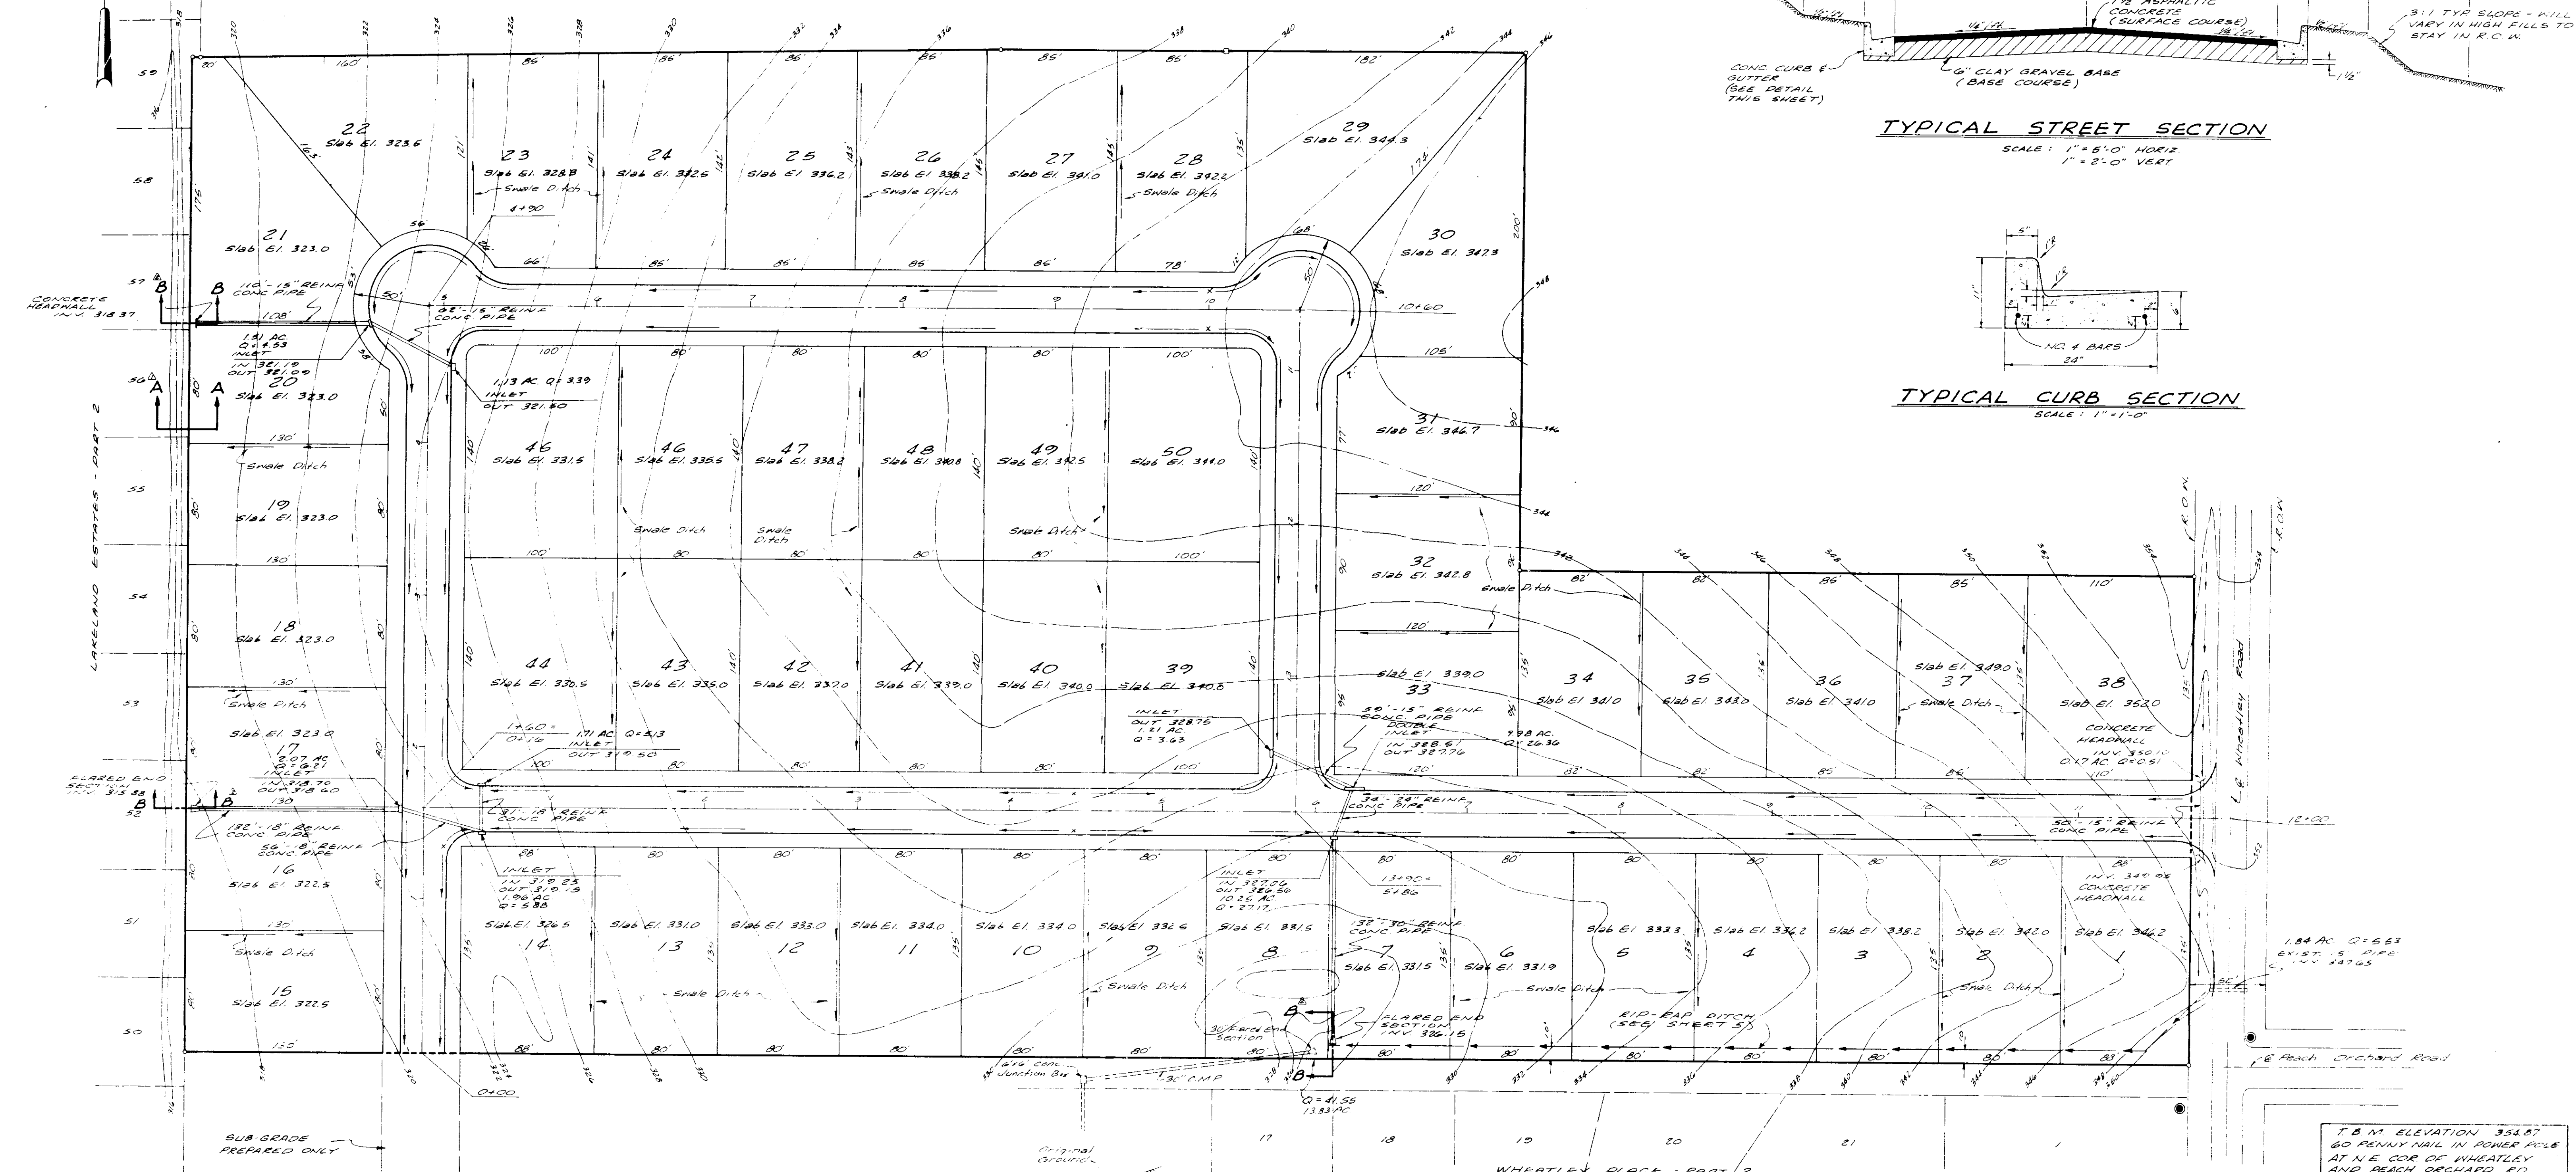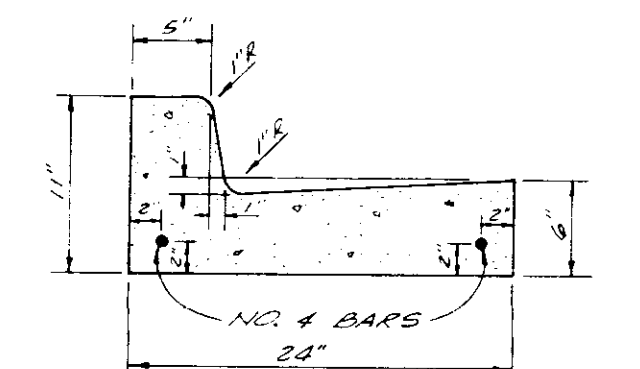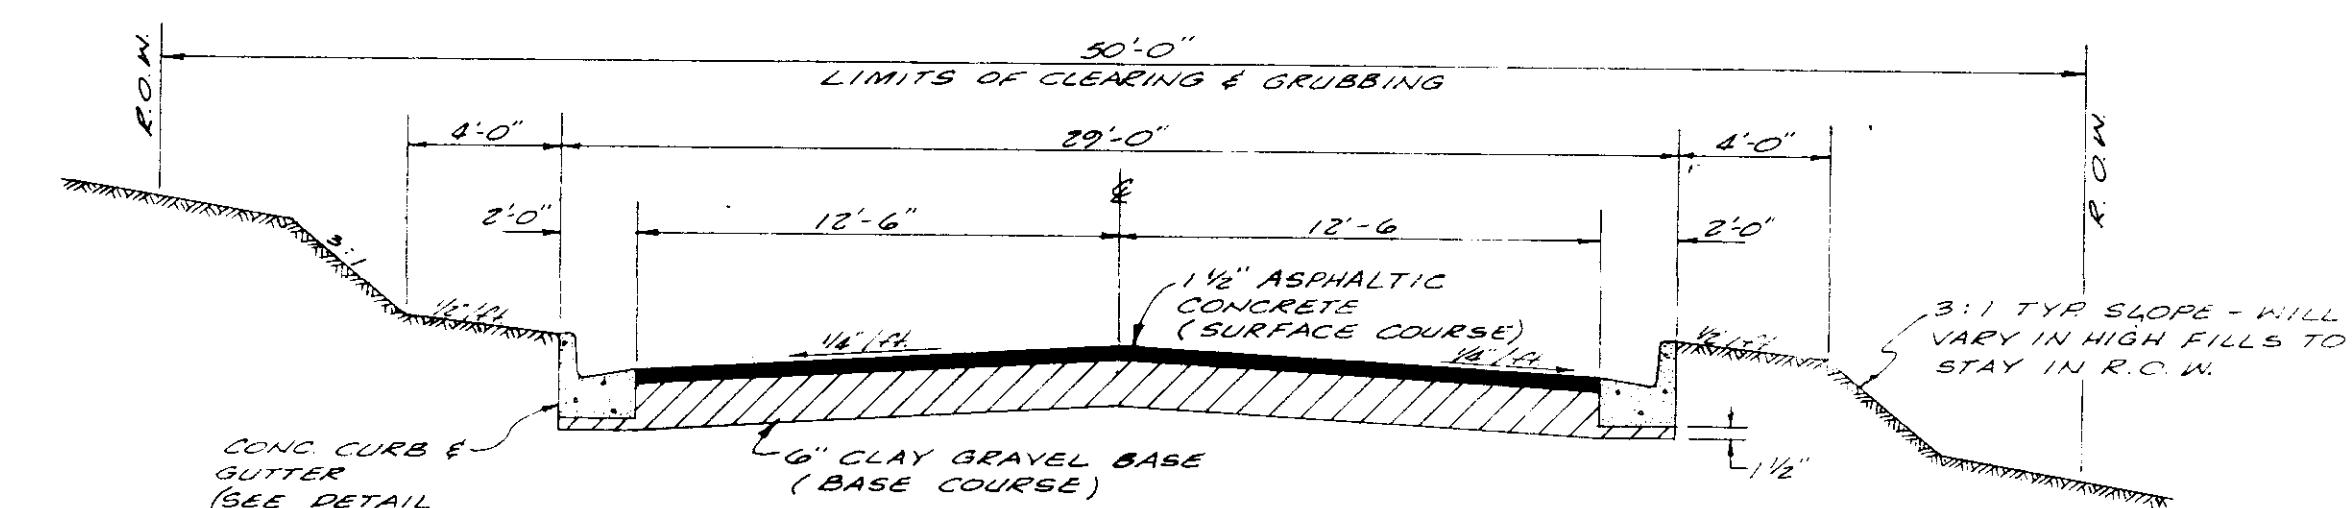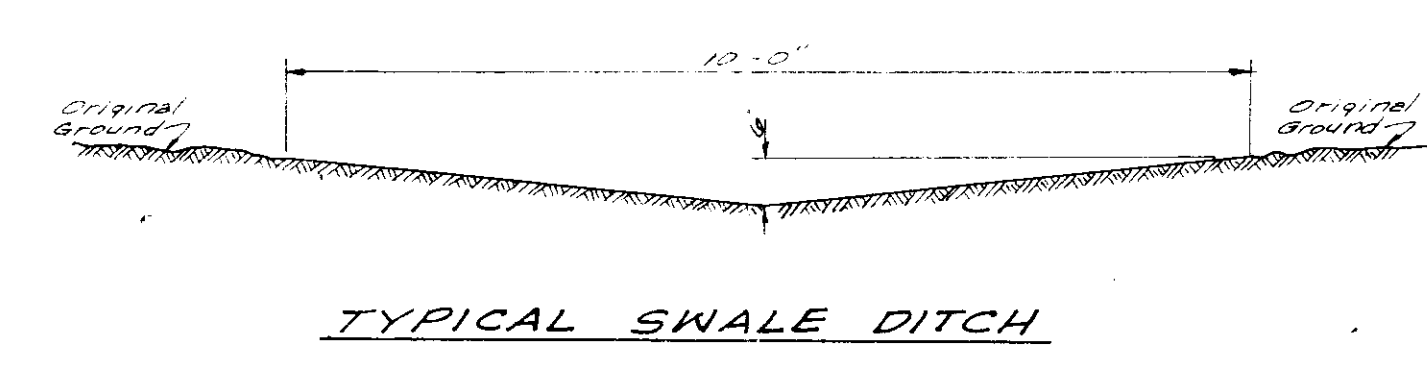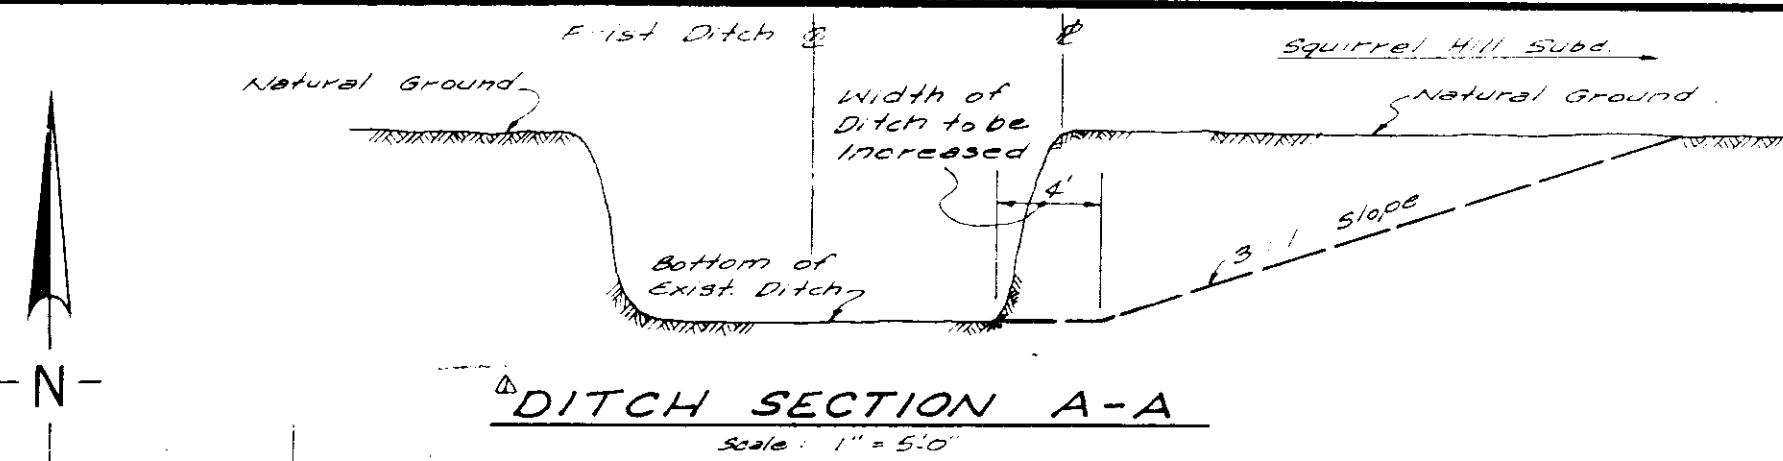

SUB-GRADE PREPARED ONLY

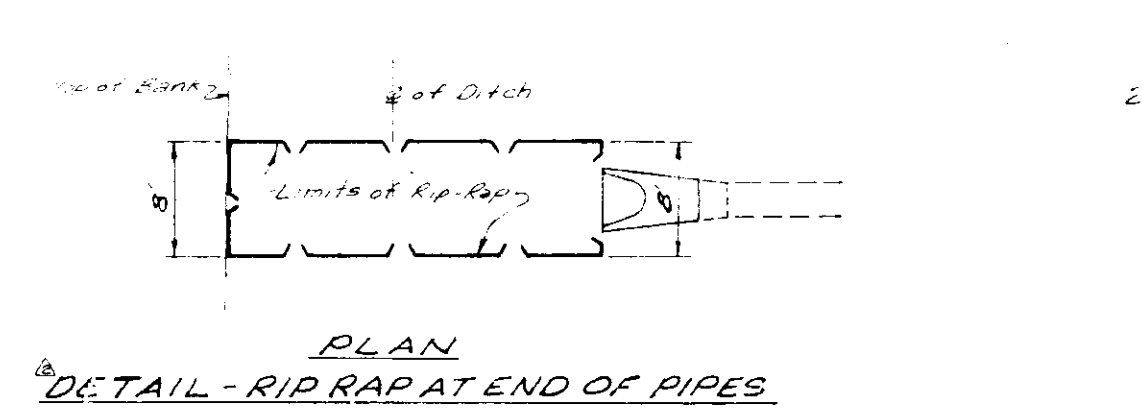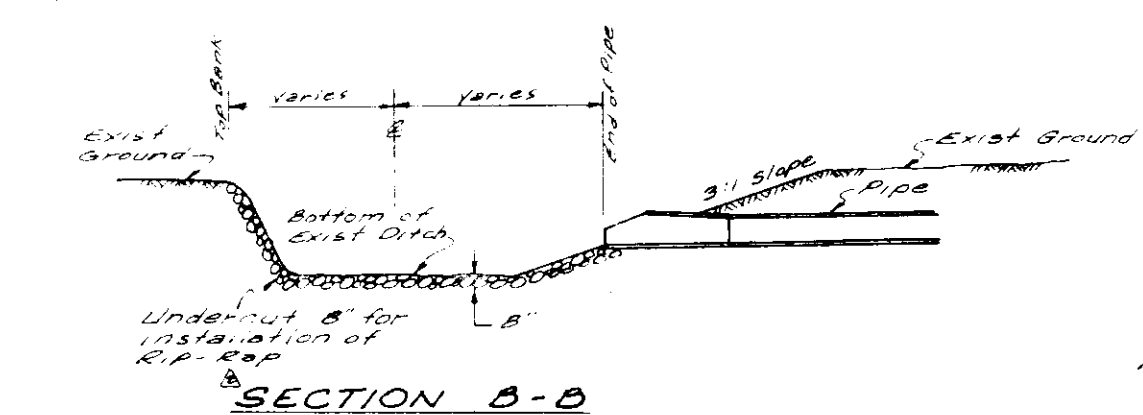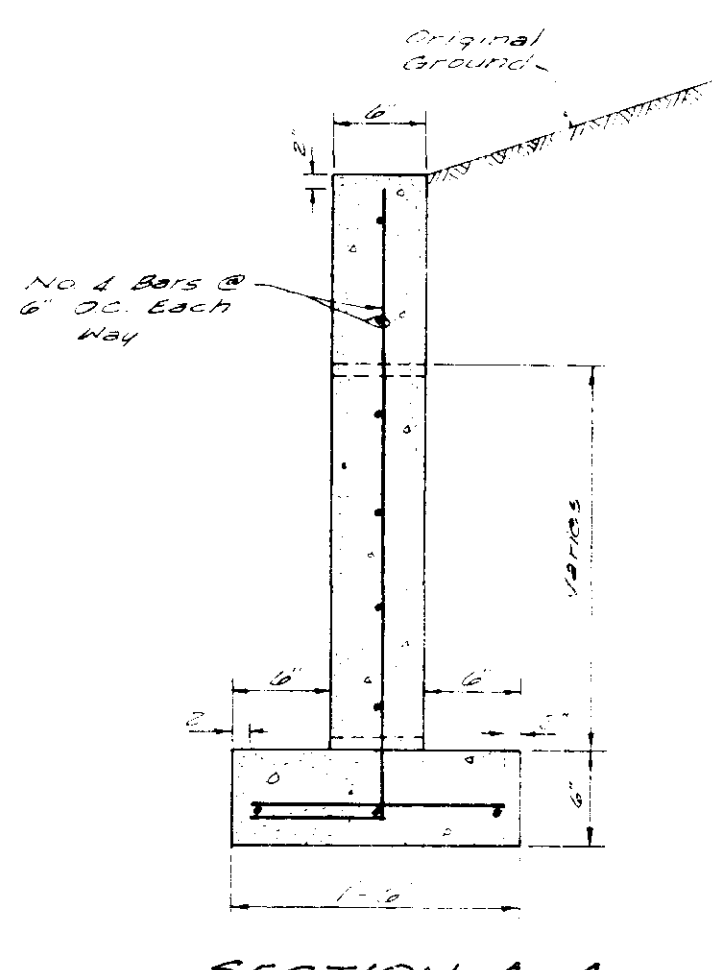
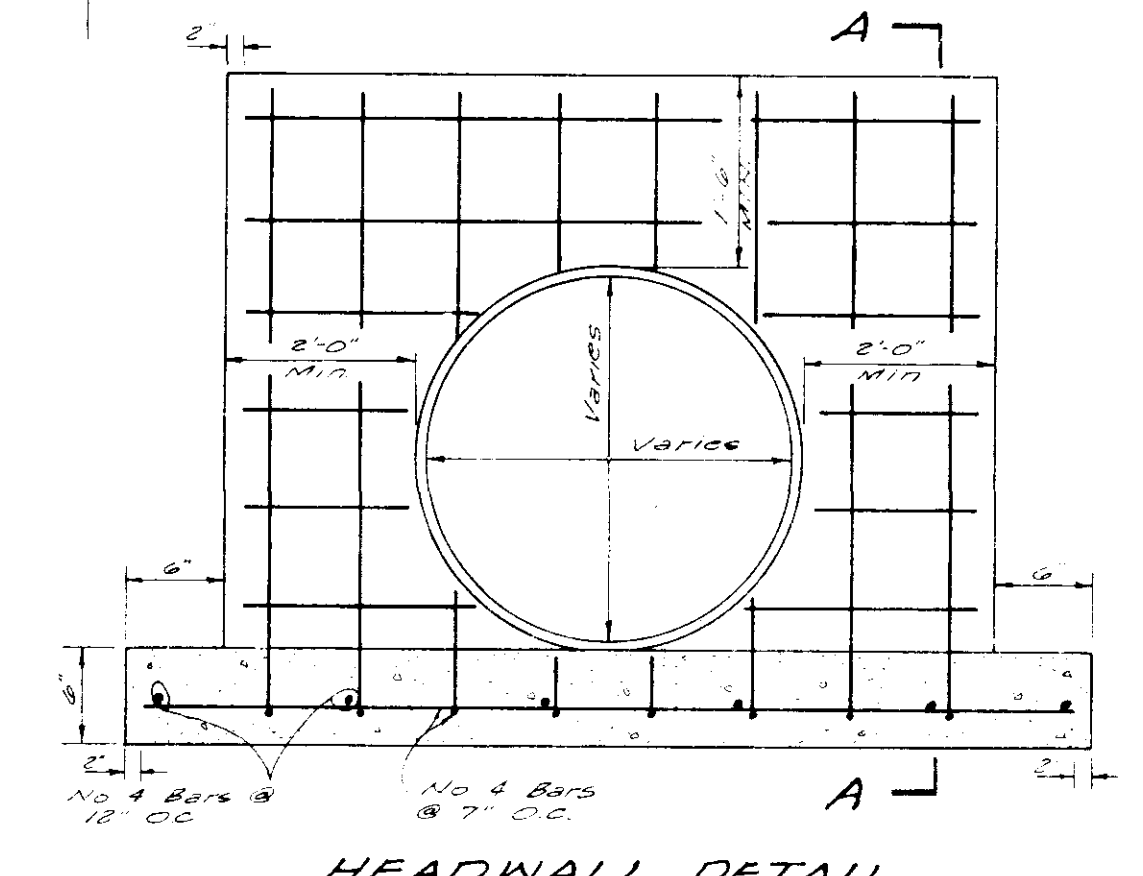


NOTES:
1. Contractor Shall Be Responsible for Determining Exact Location of All Existing Utilities and Shall Contact Any Public and/or Private Utility Company Prior to Construction.
2. Contractor Shall Convey Excavated Material From Streets to Lots as Directed By Engineer to Attain Elevations Shown.

T.B.M. ELEVATION 35777
NUT ON NORTH SIDE OF FIRE HYDRANT 50' SOUTH OF S.E. COR. COR.

T.B.M. ELEVATION 35407
60 PENNY NAIL IN POWER POLE AT N.E. COR. OF WHEATLEY AND BEACH ORCHARD RD.

DRAINAGE & GEOMETRIC LAYOUT			
SQUIRREL HILL			
JOE A. WAGGONER Civil Engineer - Brandon / Jackson, Miss.			
DRAWN BY	DATE	SHEET NO	
M.A.I.	Apr 1 1979	1 OF 7	
CHECKED BY	SCALE		
J.W.	1" = 50'		

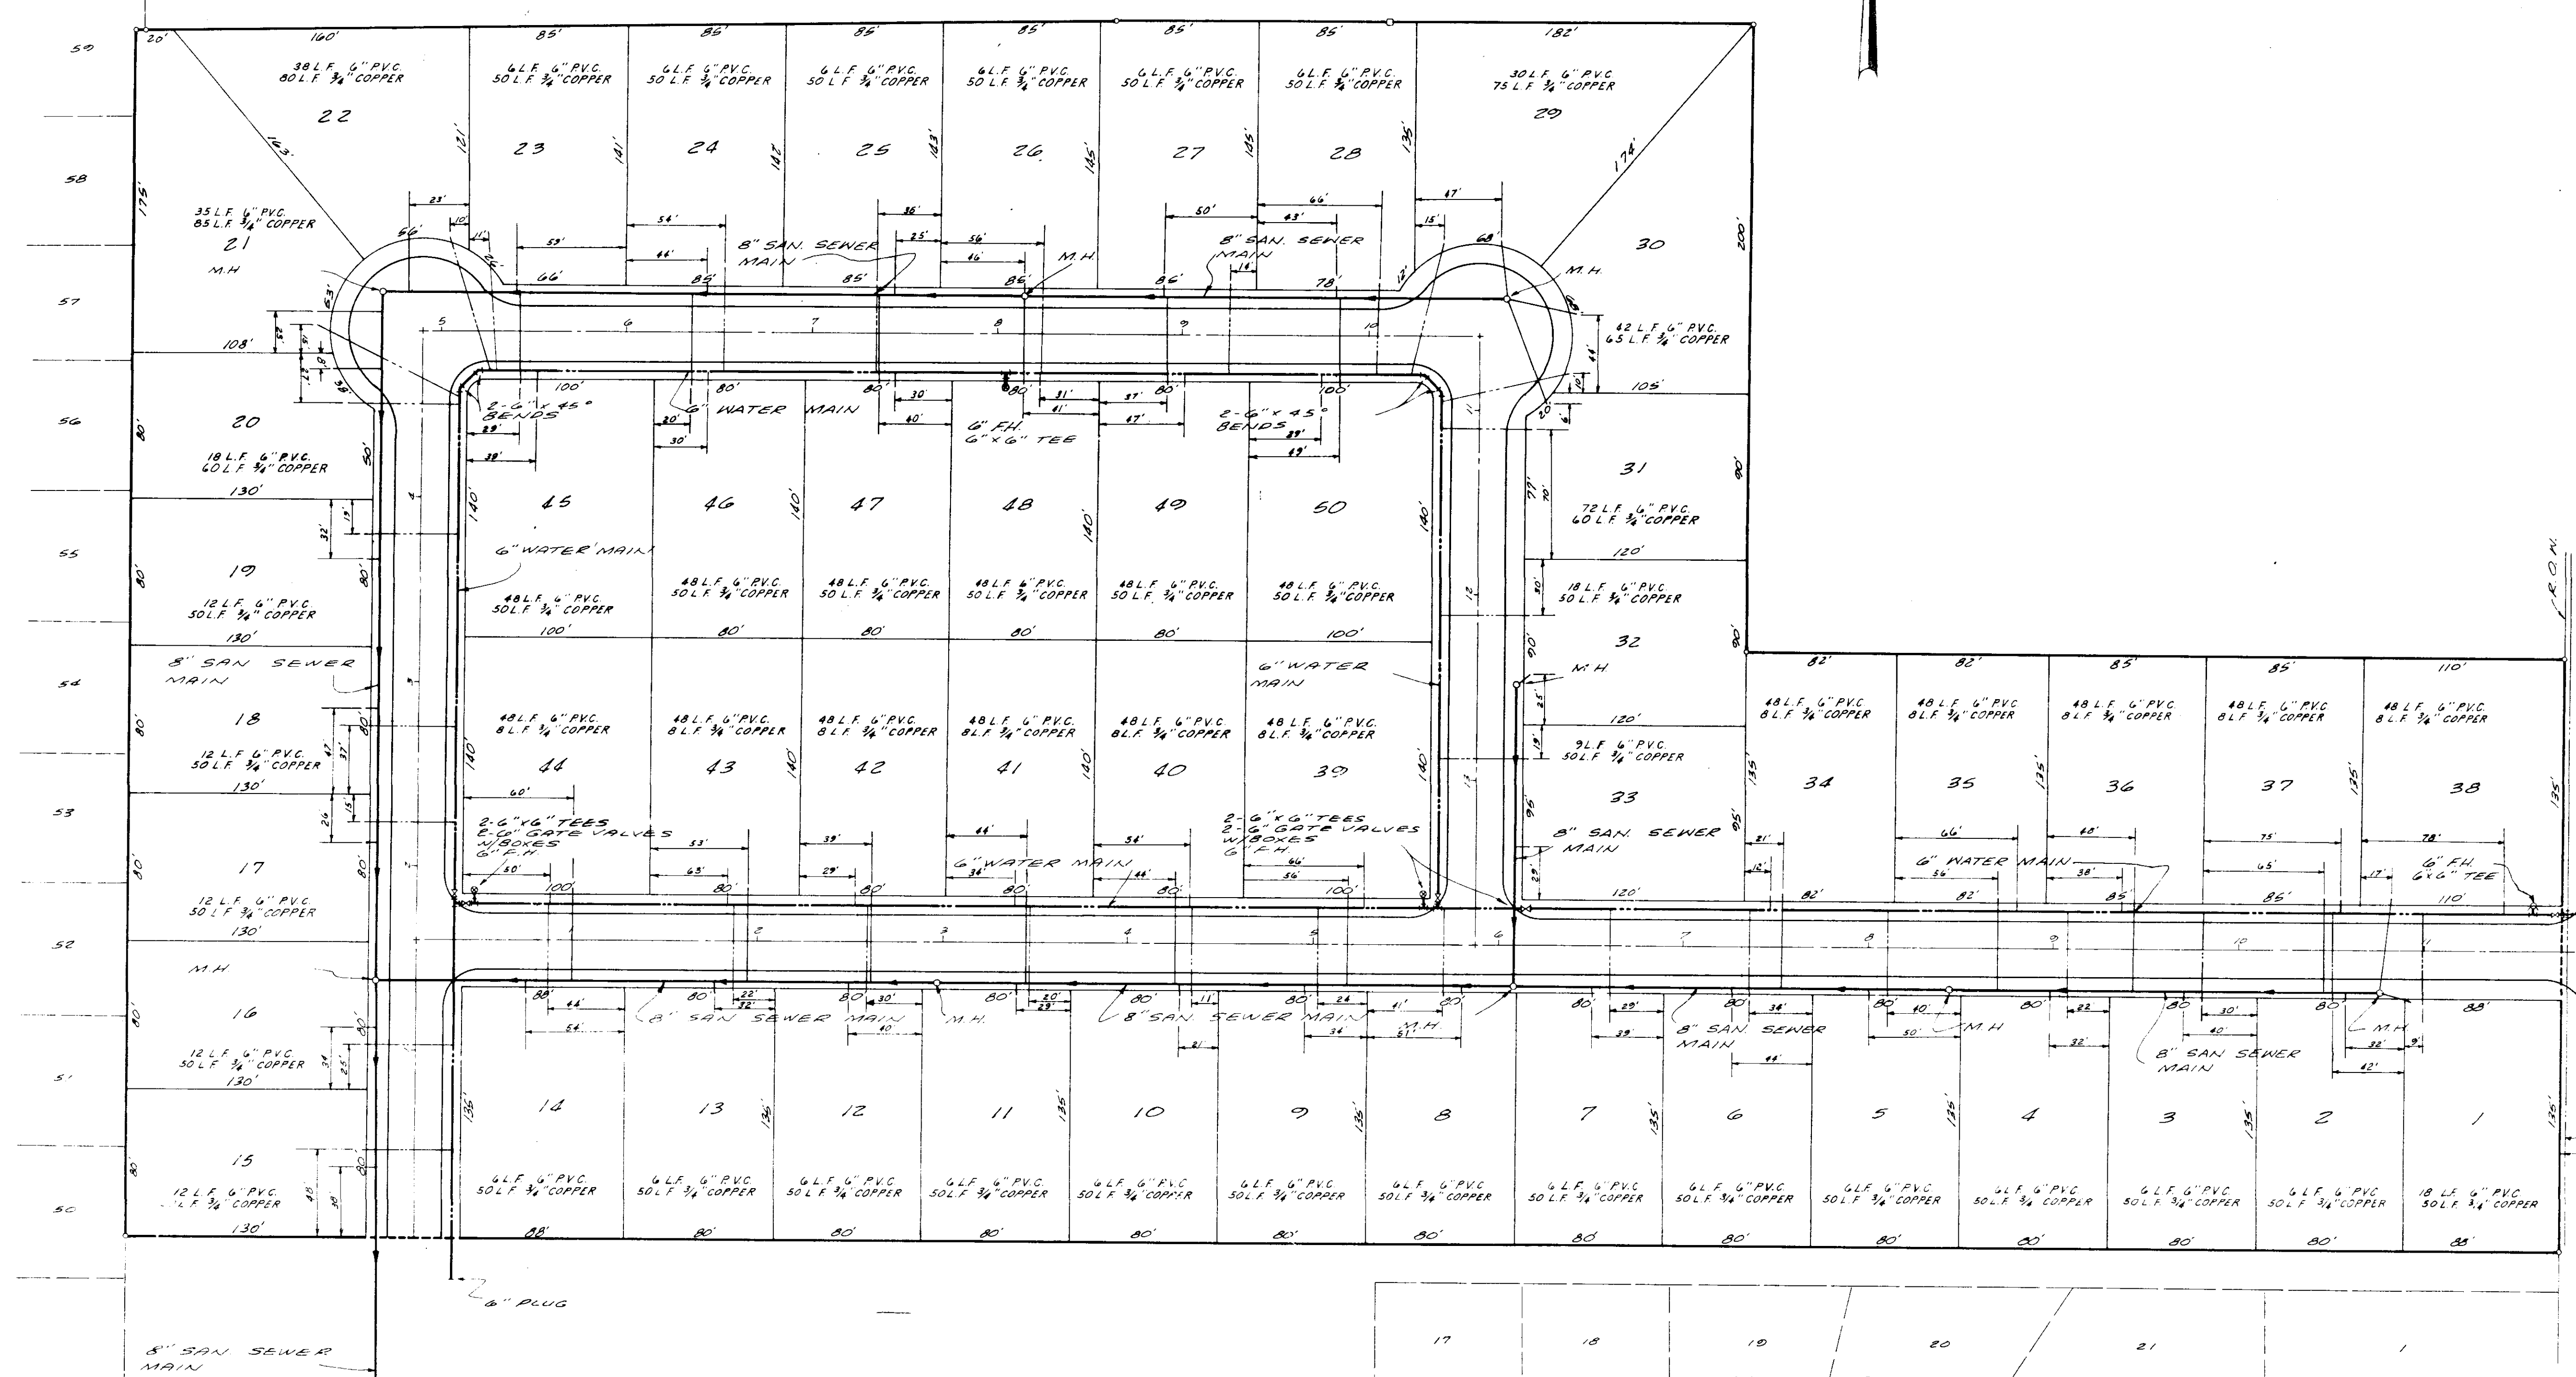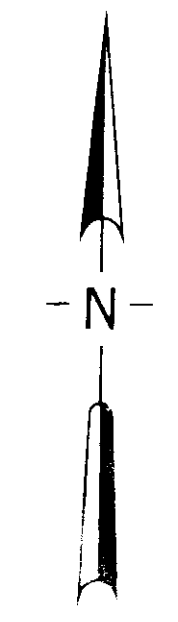

CONNECTION TO EXIST.
12" WATER MAIN
12" 45° TAPPING SLEEVE
W/ 6" GATE VALVE & BOX
NOTE: NOTIFY RIDGELAND CITY
ENGINEER 48 HRS BEFORE
CONNECTION IS MADE

EXIST 12"
Water Main


1/2 Fresh Orchard Road

EXIST M.H.
CONNECTION TO
EXIST. M.H.


NOTES:
1 Contractor shall be responsible for determining
exact location of all existing utilities and shall
contact any public and/or private utility company
prior to construction.

WATER & SEWER LAYOUT			
SQUIRREL HILL			
JOE A. WAGGONER Civil Engineer - Brandon / Jackson, Miss.			
DRAWN BY: MAL	DATE: April 1979	SHEET NO.	
CHECKED BY: JAW	SCALE: 1" = 50'	2 OF 7	

NOTE: SEE SHEET 1 FOR LOT DIMENSIONS

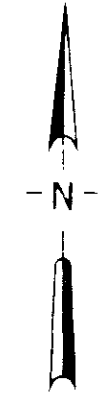

PLAN	SURVEYED	DATE
	PLOTTED	BY
NO.	NOTE BOOK	NO.
	NO. OF WAY CHECKED	NO.

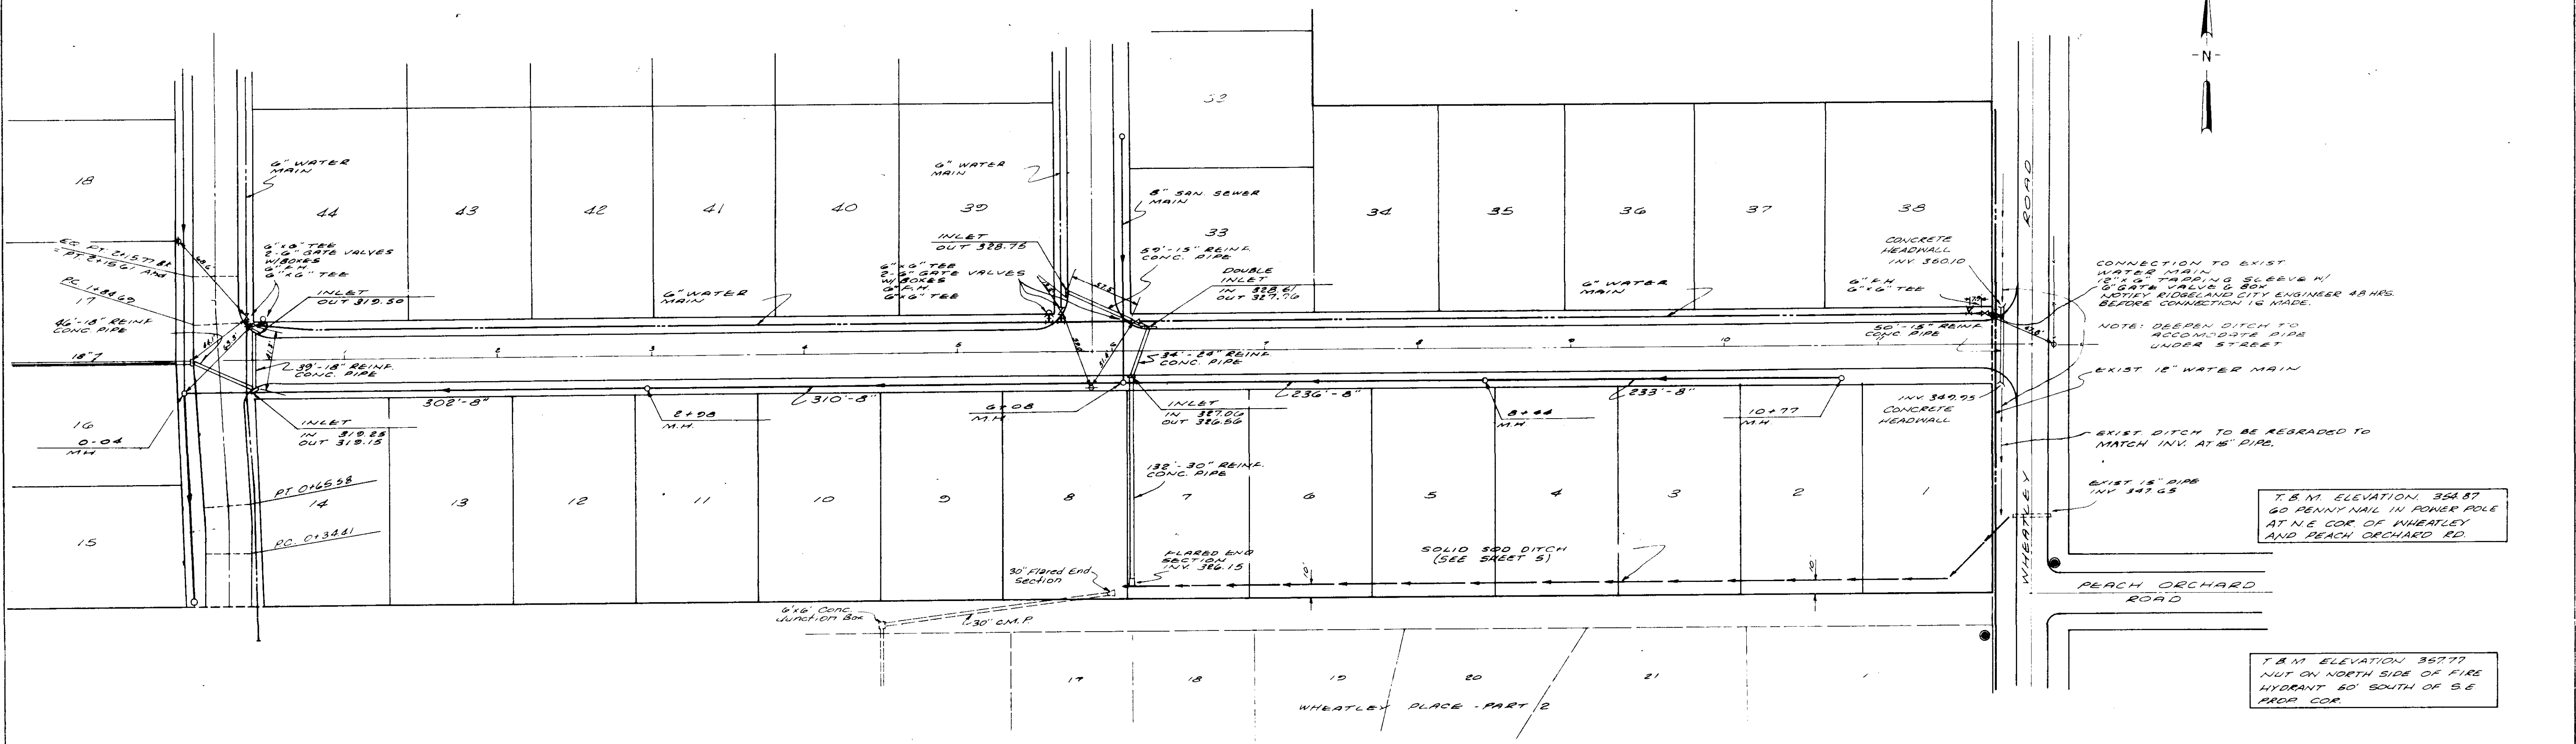

PROFILE	SURVEYED	DATE
	PLOTTED	BY
NO.	NOTE BOOK	NO.
	NO. OF WAY CHECKED	NO.


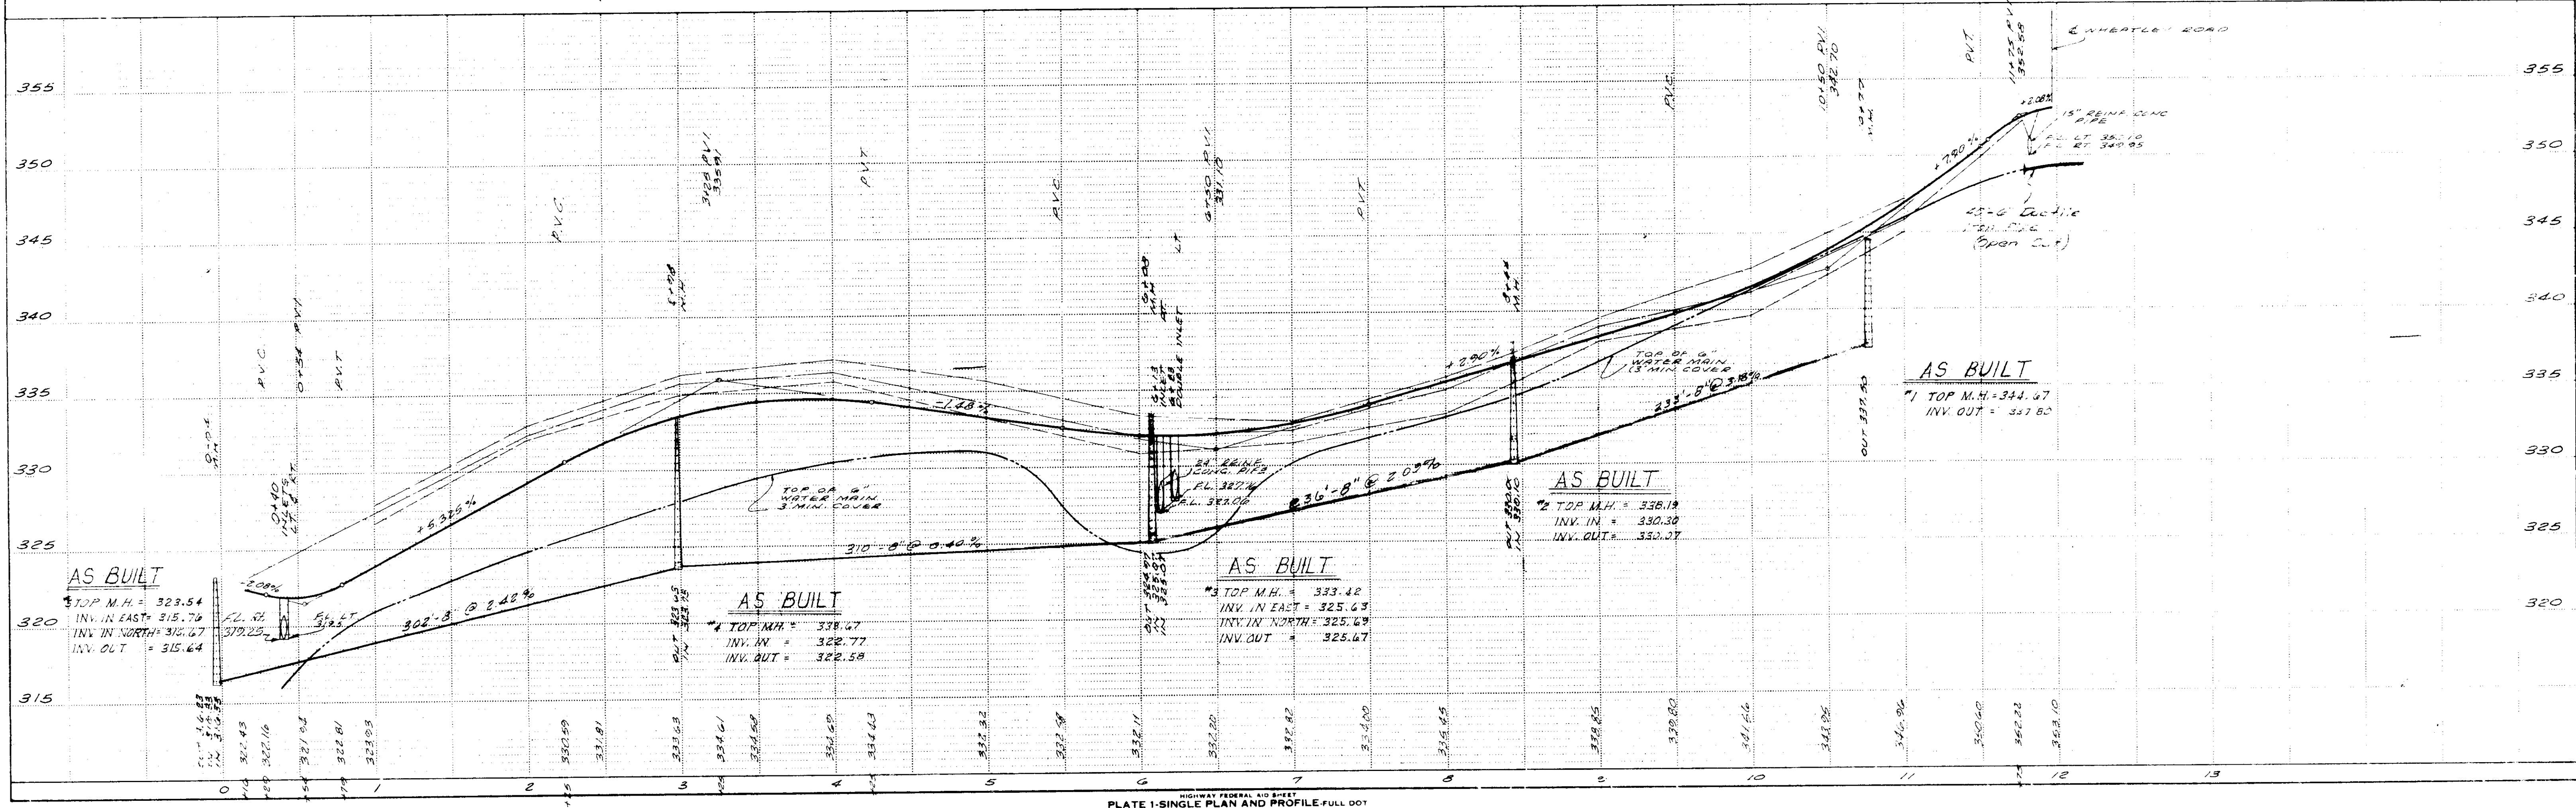




PLATE 1-SINGLE PLAN AND PROFILE-FULL DOT
DESIGNED BY T. B. EDWARDS
 DRAWN BY J. B. EDWARDS
 CHECKED BY T. B. EDWARDS
 DATE 10-1-54

NOTE: SEE SHEET 1 FOR LOT DIMENSIONS

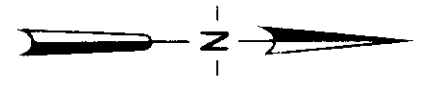

LAKELAND ESTATES, PART 2

DATE	
BY	
DESIGNED	
CHECKED	
NOTED	
NO.	
PLAN	
NO.	

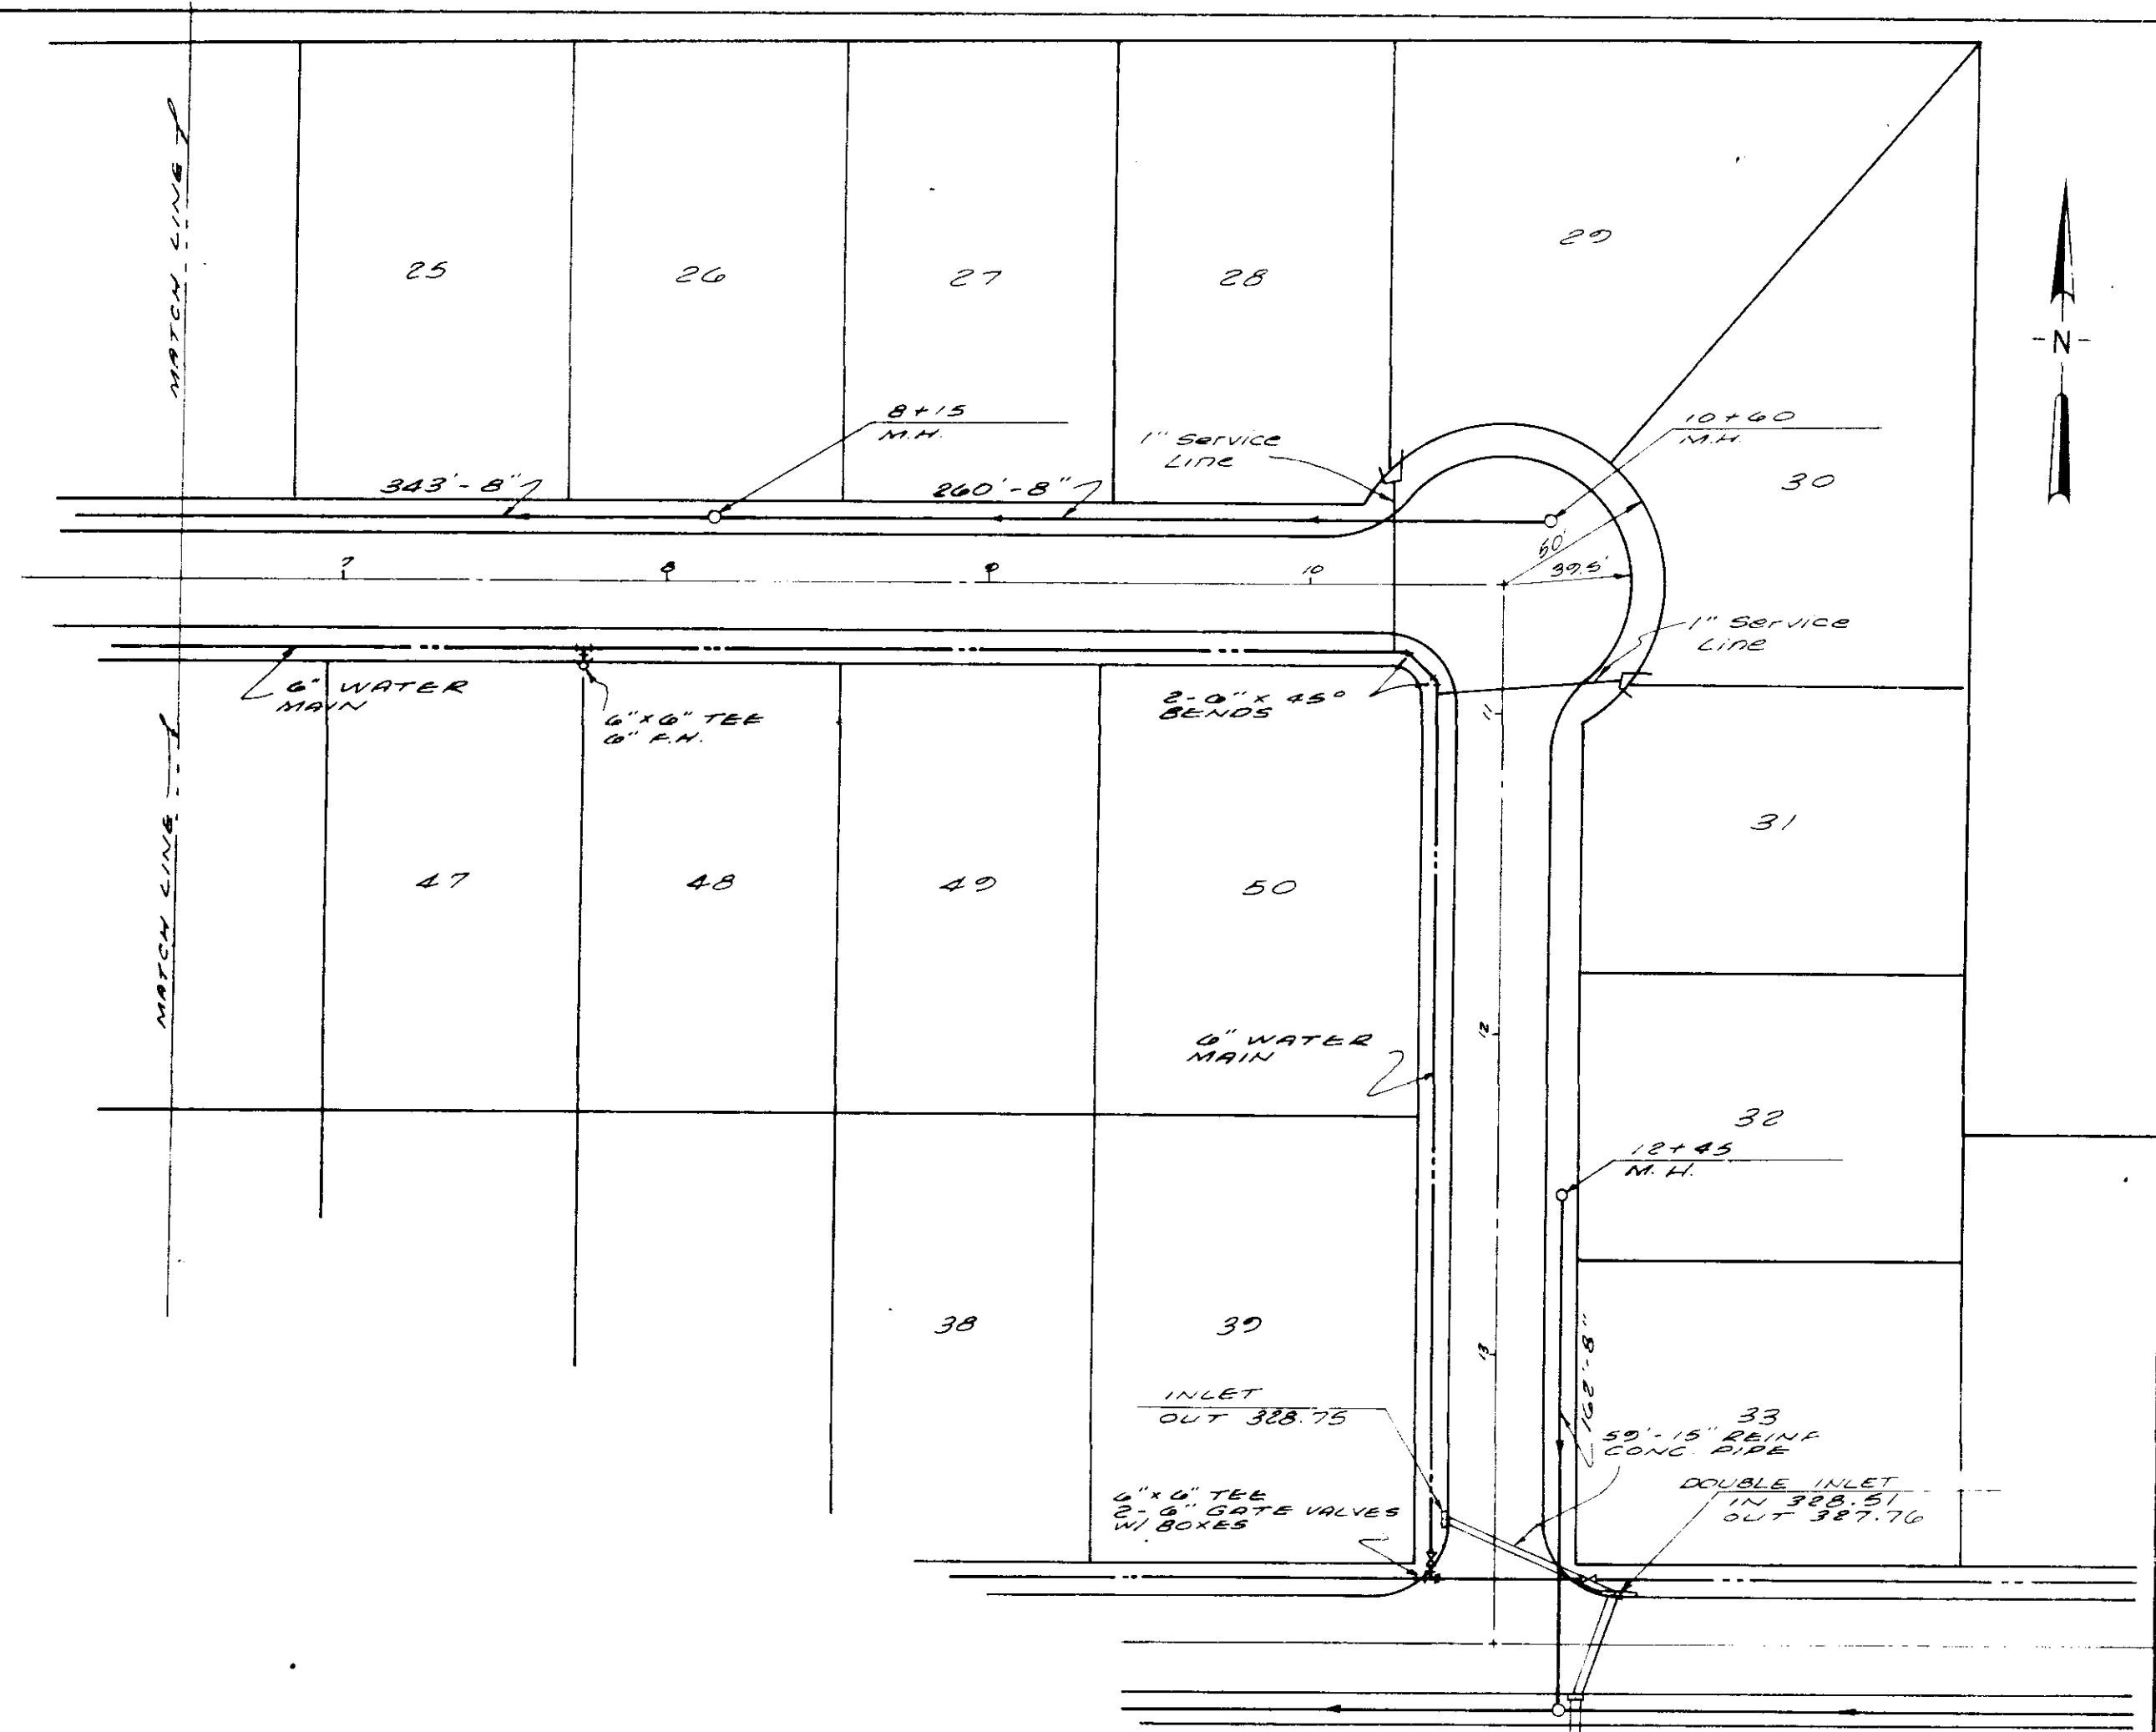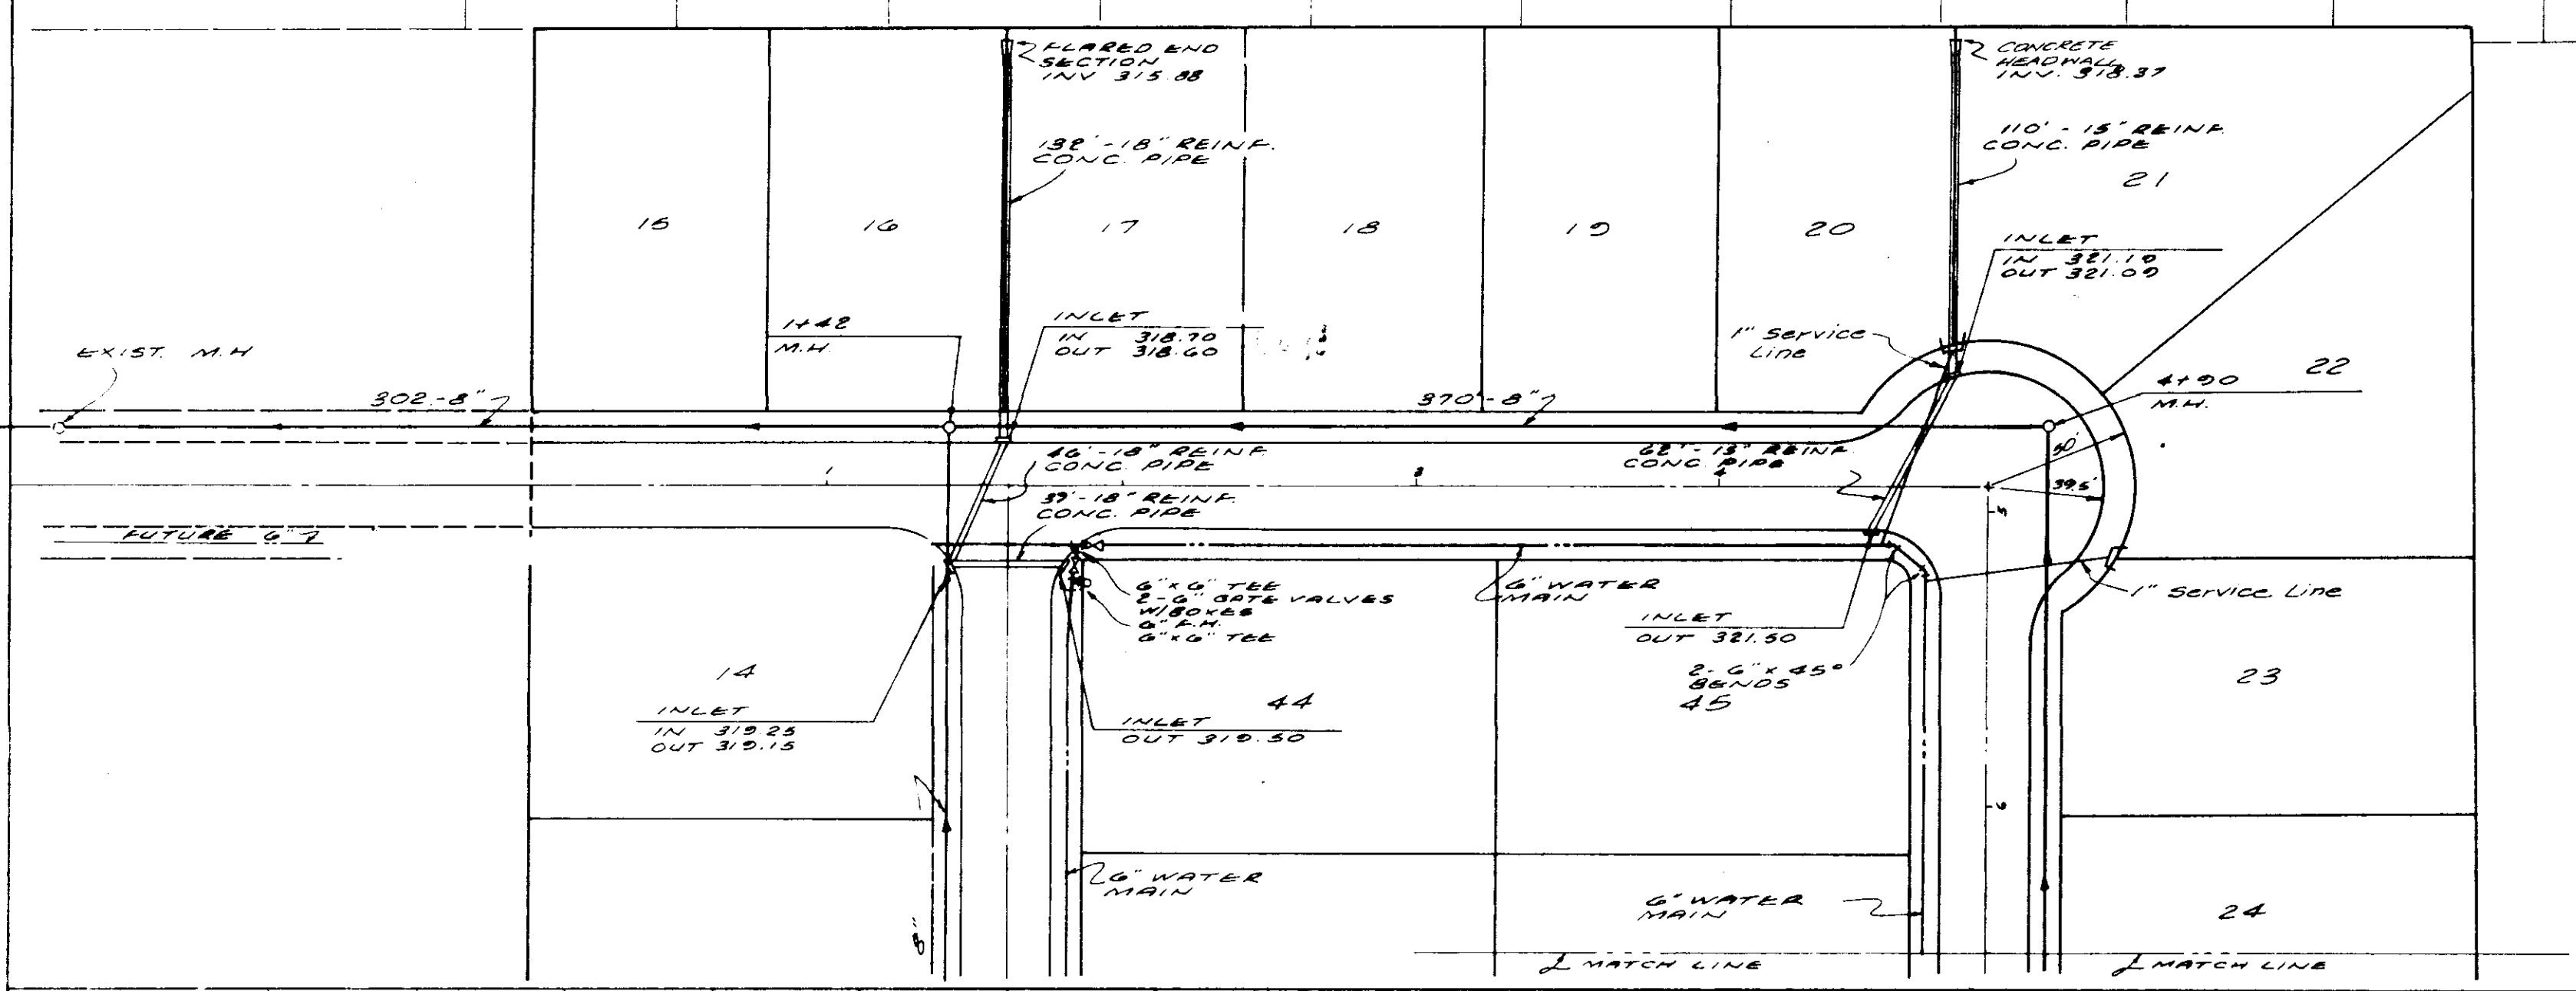

DATE	
BY	
DESIGNED	
CHECKED	
NOTED	
NO.	
PROFILE	
NO.	



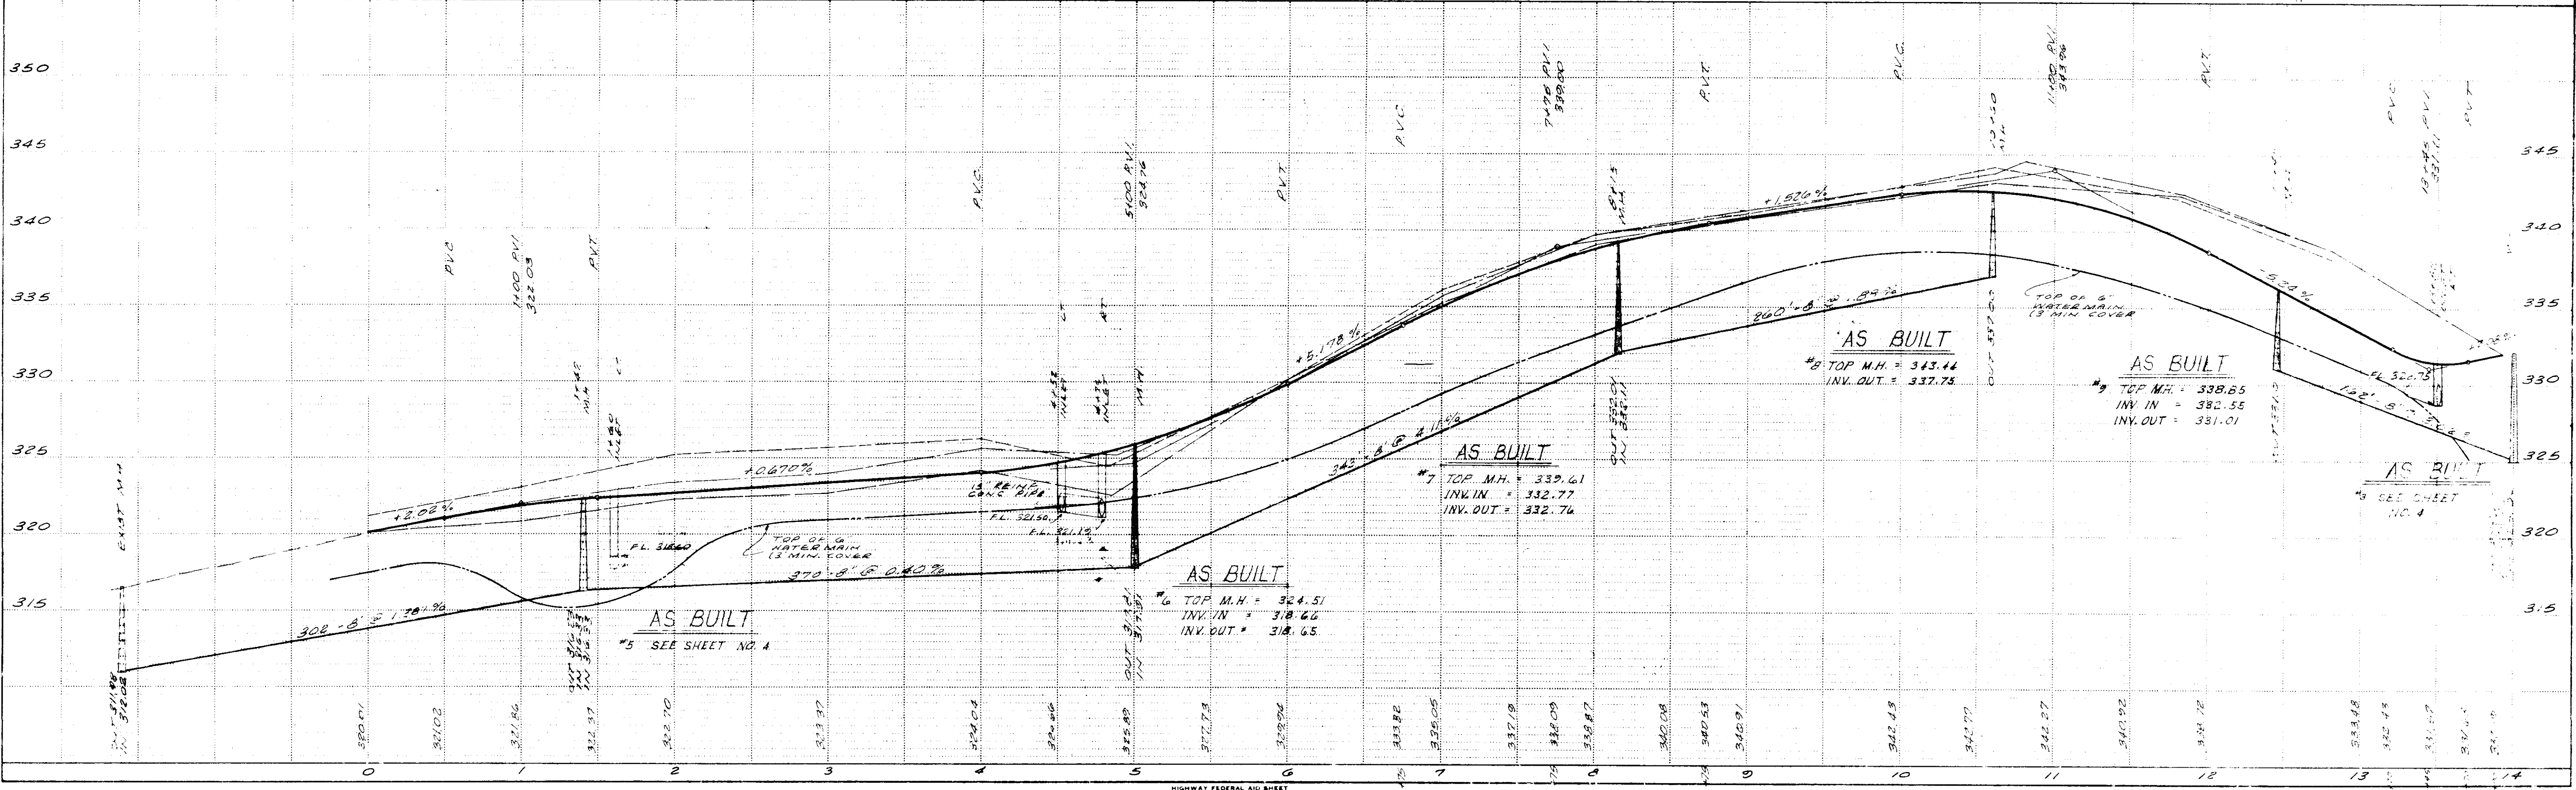




PLATE 1-SINGLE PLAN AND PROFILE-FULL DOT
PRINTED IN U.S.A.

DATE	
BY	
SURVEYED	
ALIGNMENT CHECKED	
NOTED	
RT OF WAY CHECKED	
PLAN	
NO.	

DATE	
BY	
SURVEYED	
GRADES CHECKED	
NOTED	
STRUCTURE DATA CHECKED	
PROFILE	
NO.	

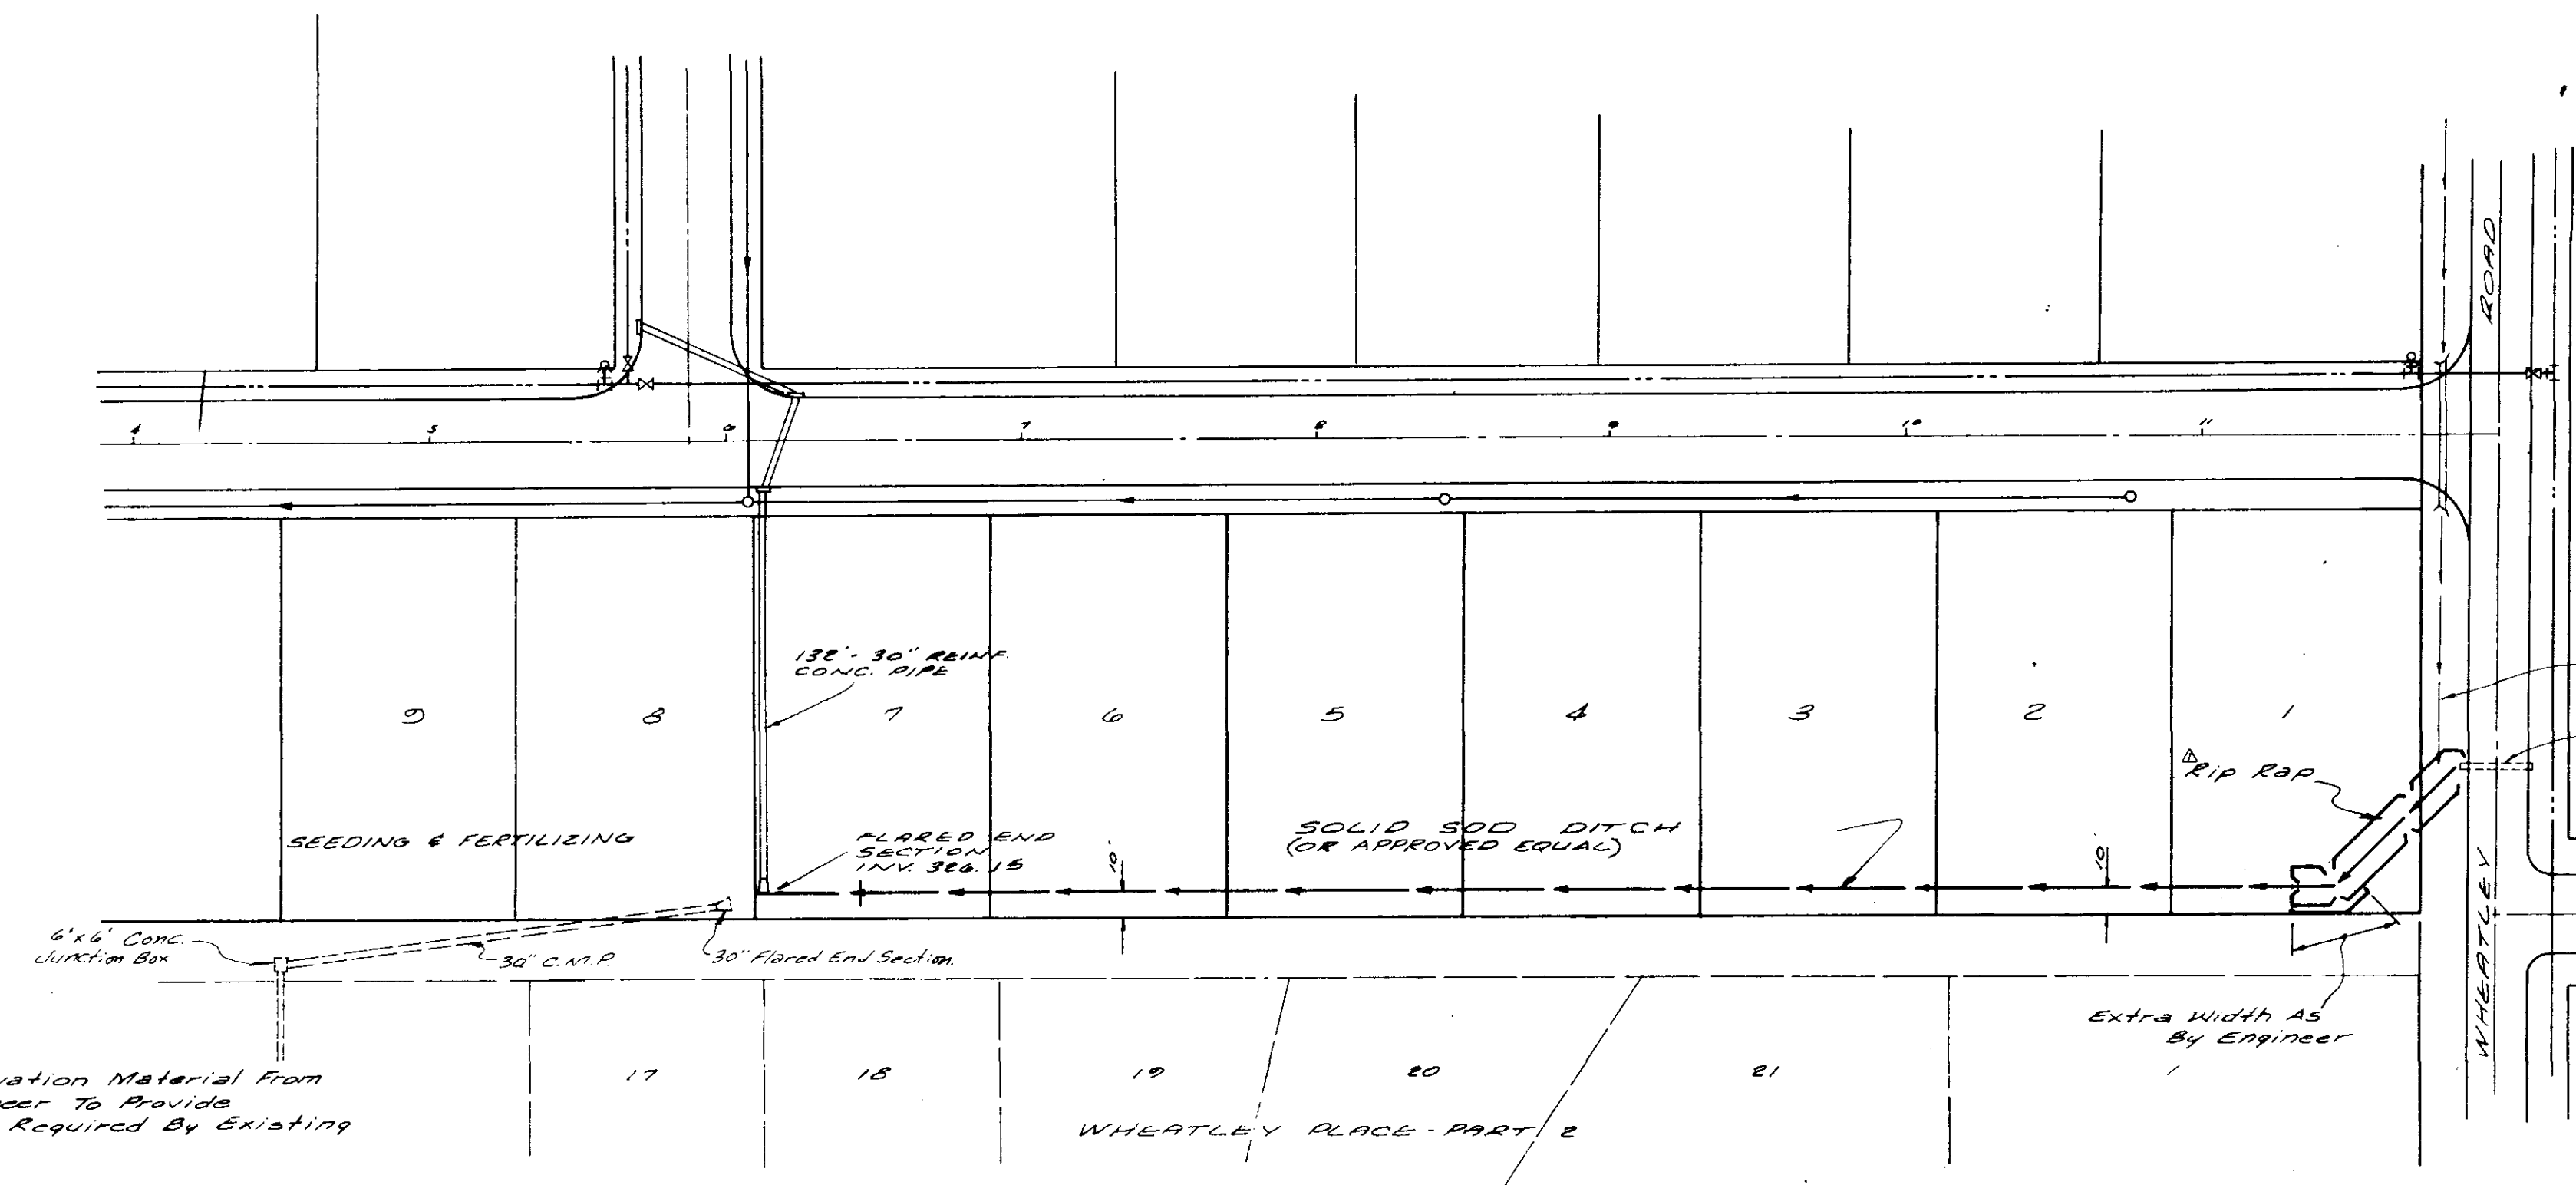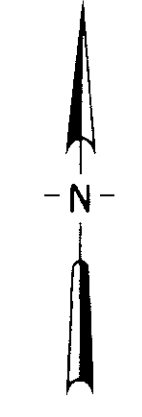

NOTE:
Contractor Shall Utilize Excavation Material from Streets as Directed By Engineer To Provide Sufficient Depth for Ditch as Required By Existing Topography.

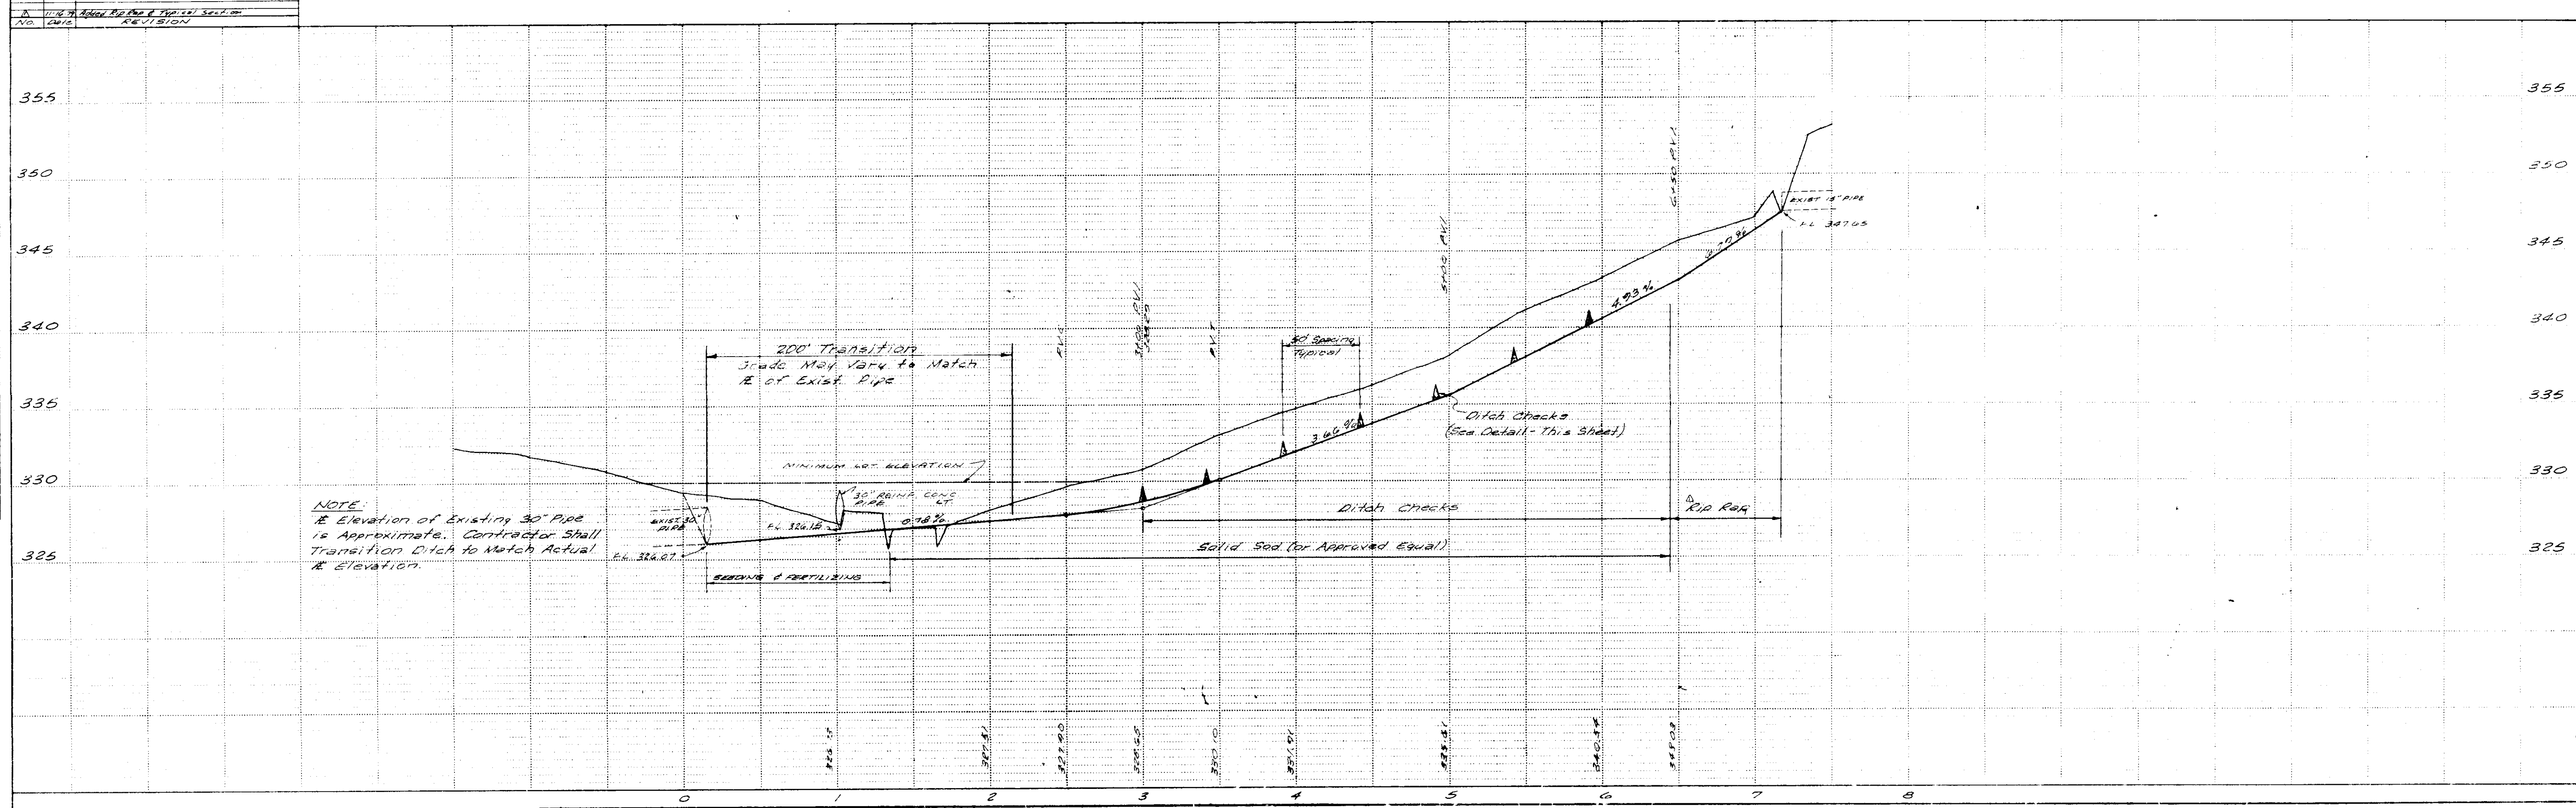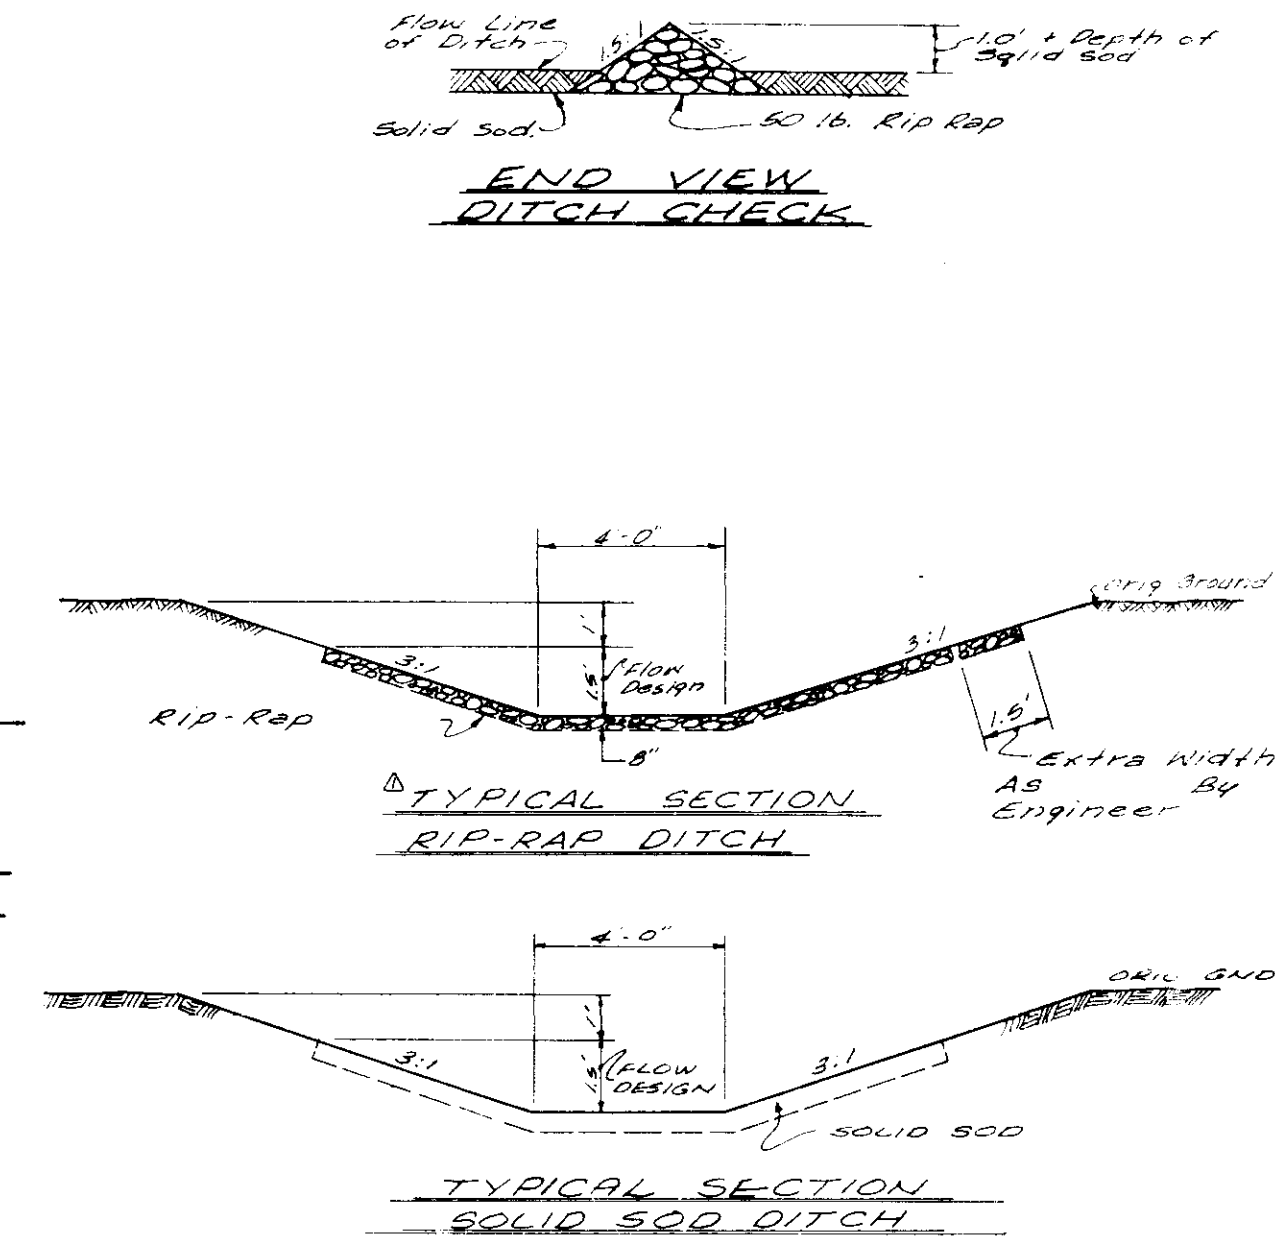

NOTE:
E Elevation of Existing 30" Pipe is Approximate. Contractor Shall Transition Ditch to Match Actual E Elevation.