


THE CITY OF

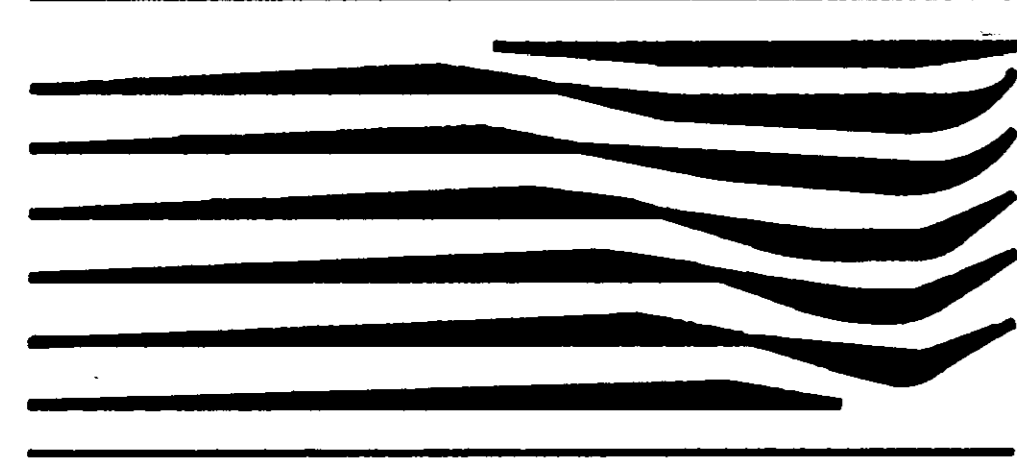

RIDGELAND

# CITY OF RIDGELAND MADISON COUNTY, MISSISSIPPI STEED ROAD IMPROVEMENTS

N.S. ACCOUNT NO. 2-1918-03

MAYOR

GENE F. McGEE

MAYOR PRO TEM

HARVEY CARR, JR.

CITY ATTORNEY

JERRY MILLS

BOARD OF ALDERMEN

BRIAN BARCELLONA  
AL BIBLE  
HARVEY CARR, JR.  
LINDA DAVIS  
DARYL SMITH

PUBLIC WORKS DIRECTOR

SAM VINSON, P.E.


ASSISTANT PUBLIC WORKS DIRECTOR

SID HAWTHORNE

CITY CLERK

MICHAEL McPHEARSON

BEGINNING OF PROJECT  
AT STA. 60+50

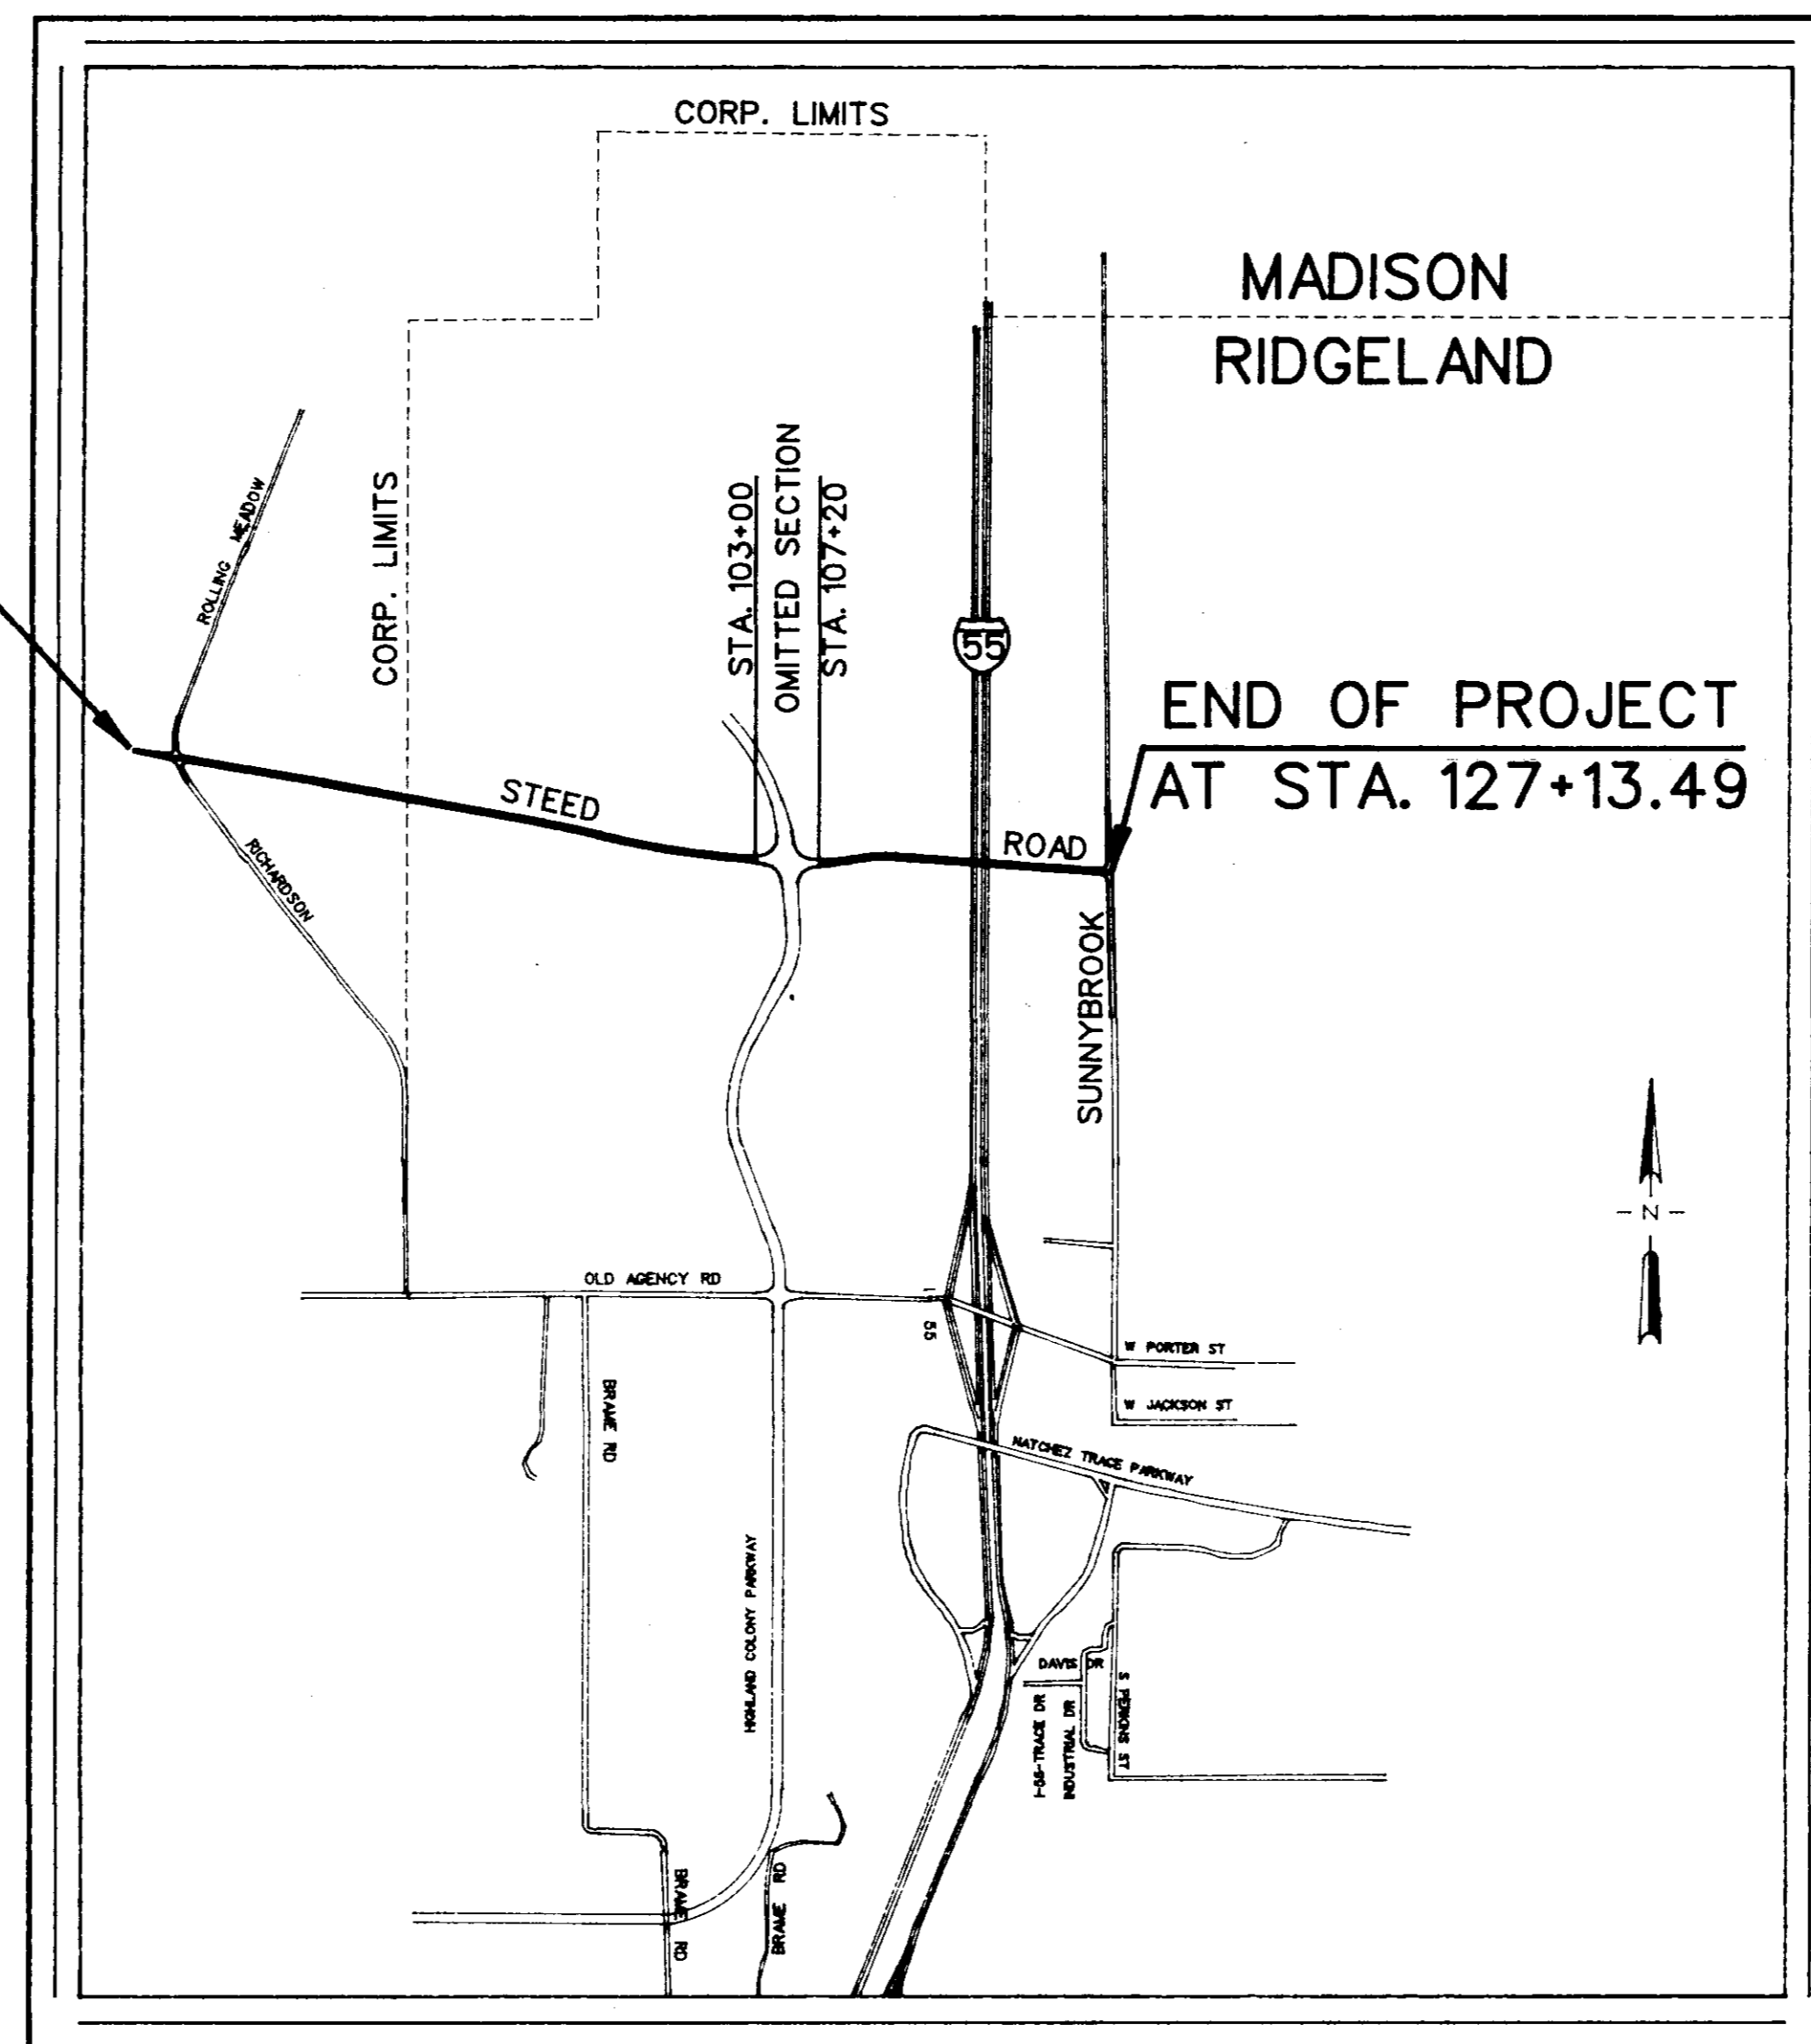


**VICINITY MAP**

**OCTOBER 1992**

**EQUATIONS**

**LENGTH DATA**

LENGTH OF ROADWAY	6632.49	FT.	1.256	MI.
LENGTH OF BRIDGES	31.00	FT.	0.006	MI.
LENGTH OF PROJECT (NET)	6663.49	FT.	1.262	MI.
LENGTH OF EXCEPTIONS	500.00	FT.	0.095	MI.
LENGTH OF PROJECT (GROSS)	6163.49	FT.	1.167	MI.

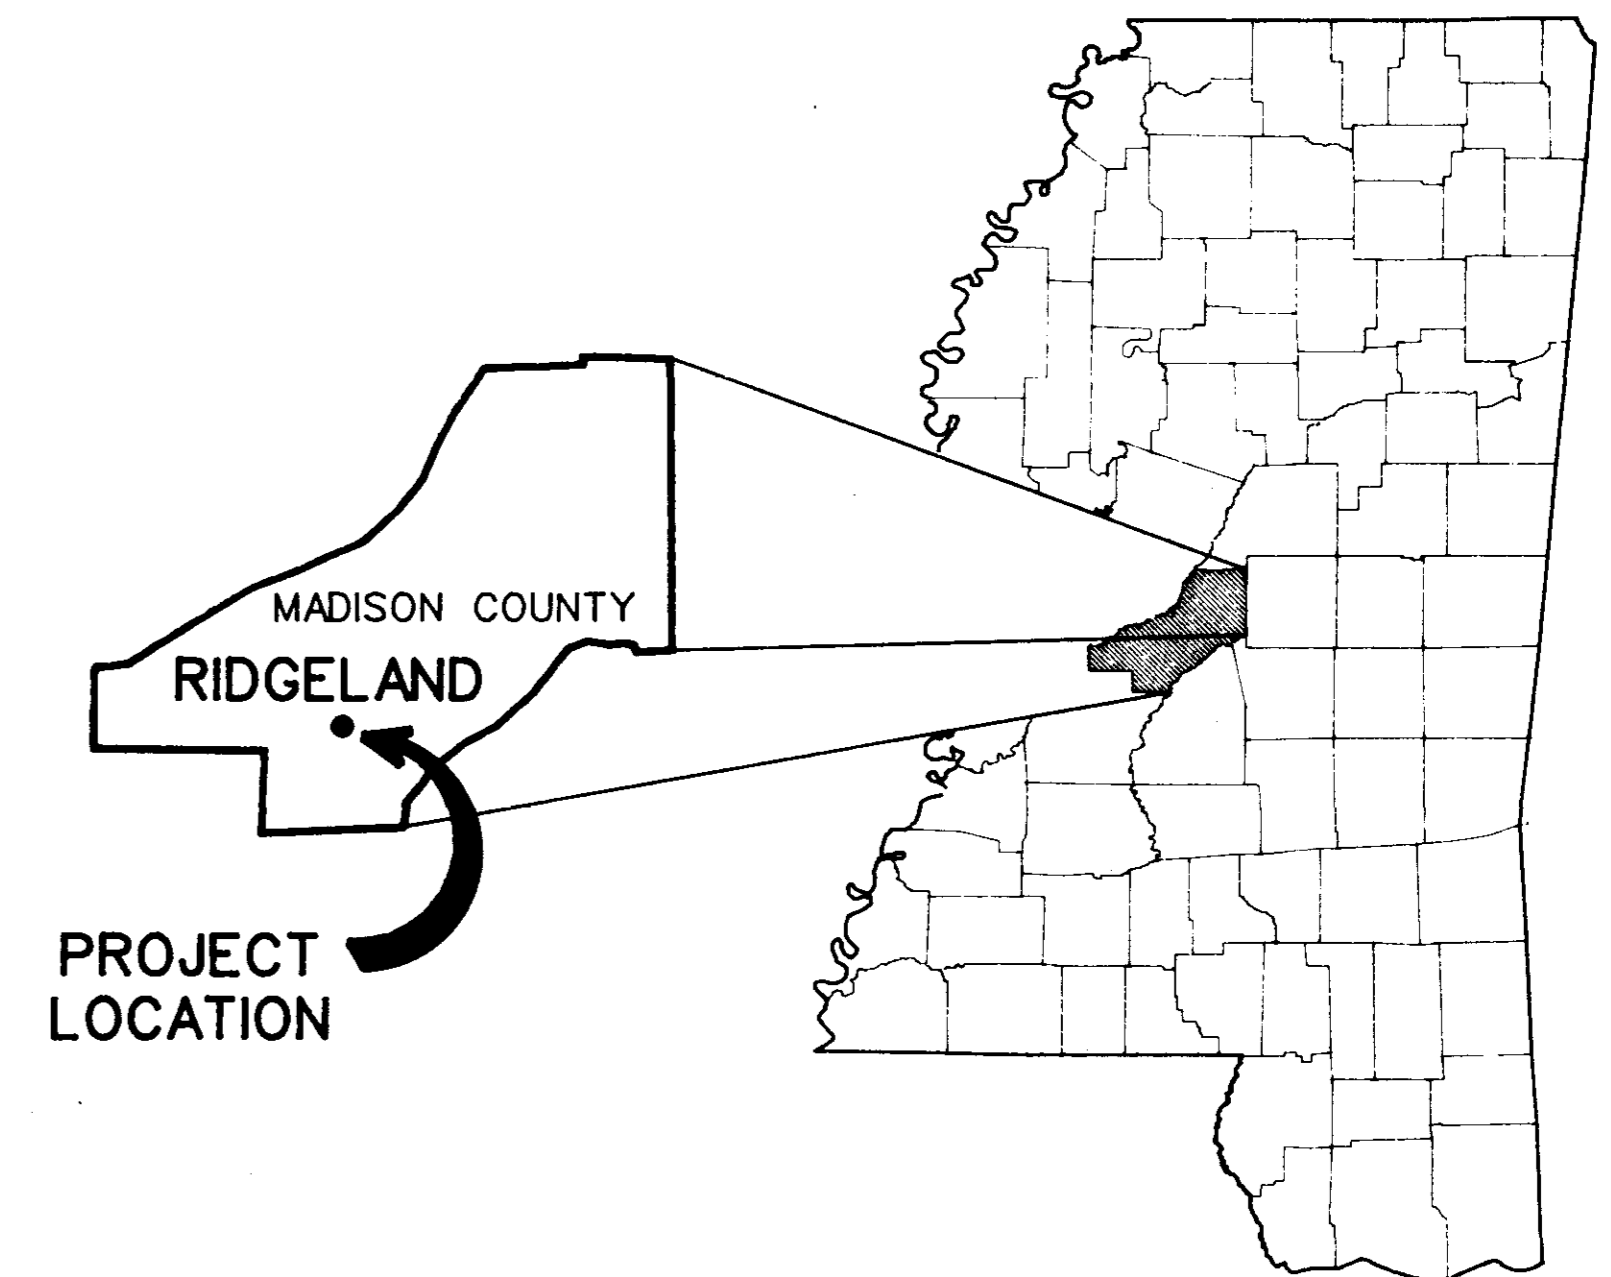

LOCATION MAP


**RECEIVED**  
MAY 30 1997  
PUBLIC WORKS DEPT.

DESIGN CONTROL  
40 MPH - V (SPEED DESIGN)  
ADT (1993) - 500; ADT (2013) - 5000  
DHV = 500; D = 55%; T = 5%

PREPARED BY :



NEEL-SCHAFFER, INC,  
Engineers • Planners  
Jackson, Mississippi

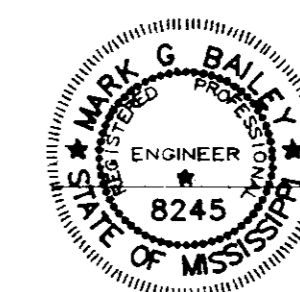

DATE :


MARK G. BAILEY, P.E.  
MISSISSIPPI LICENSE NO. 8245

PWP-01914


PREFINAL  
10-30-92





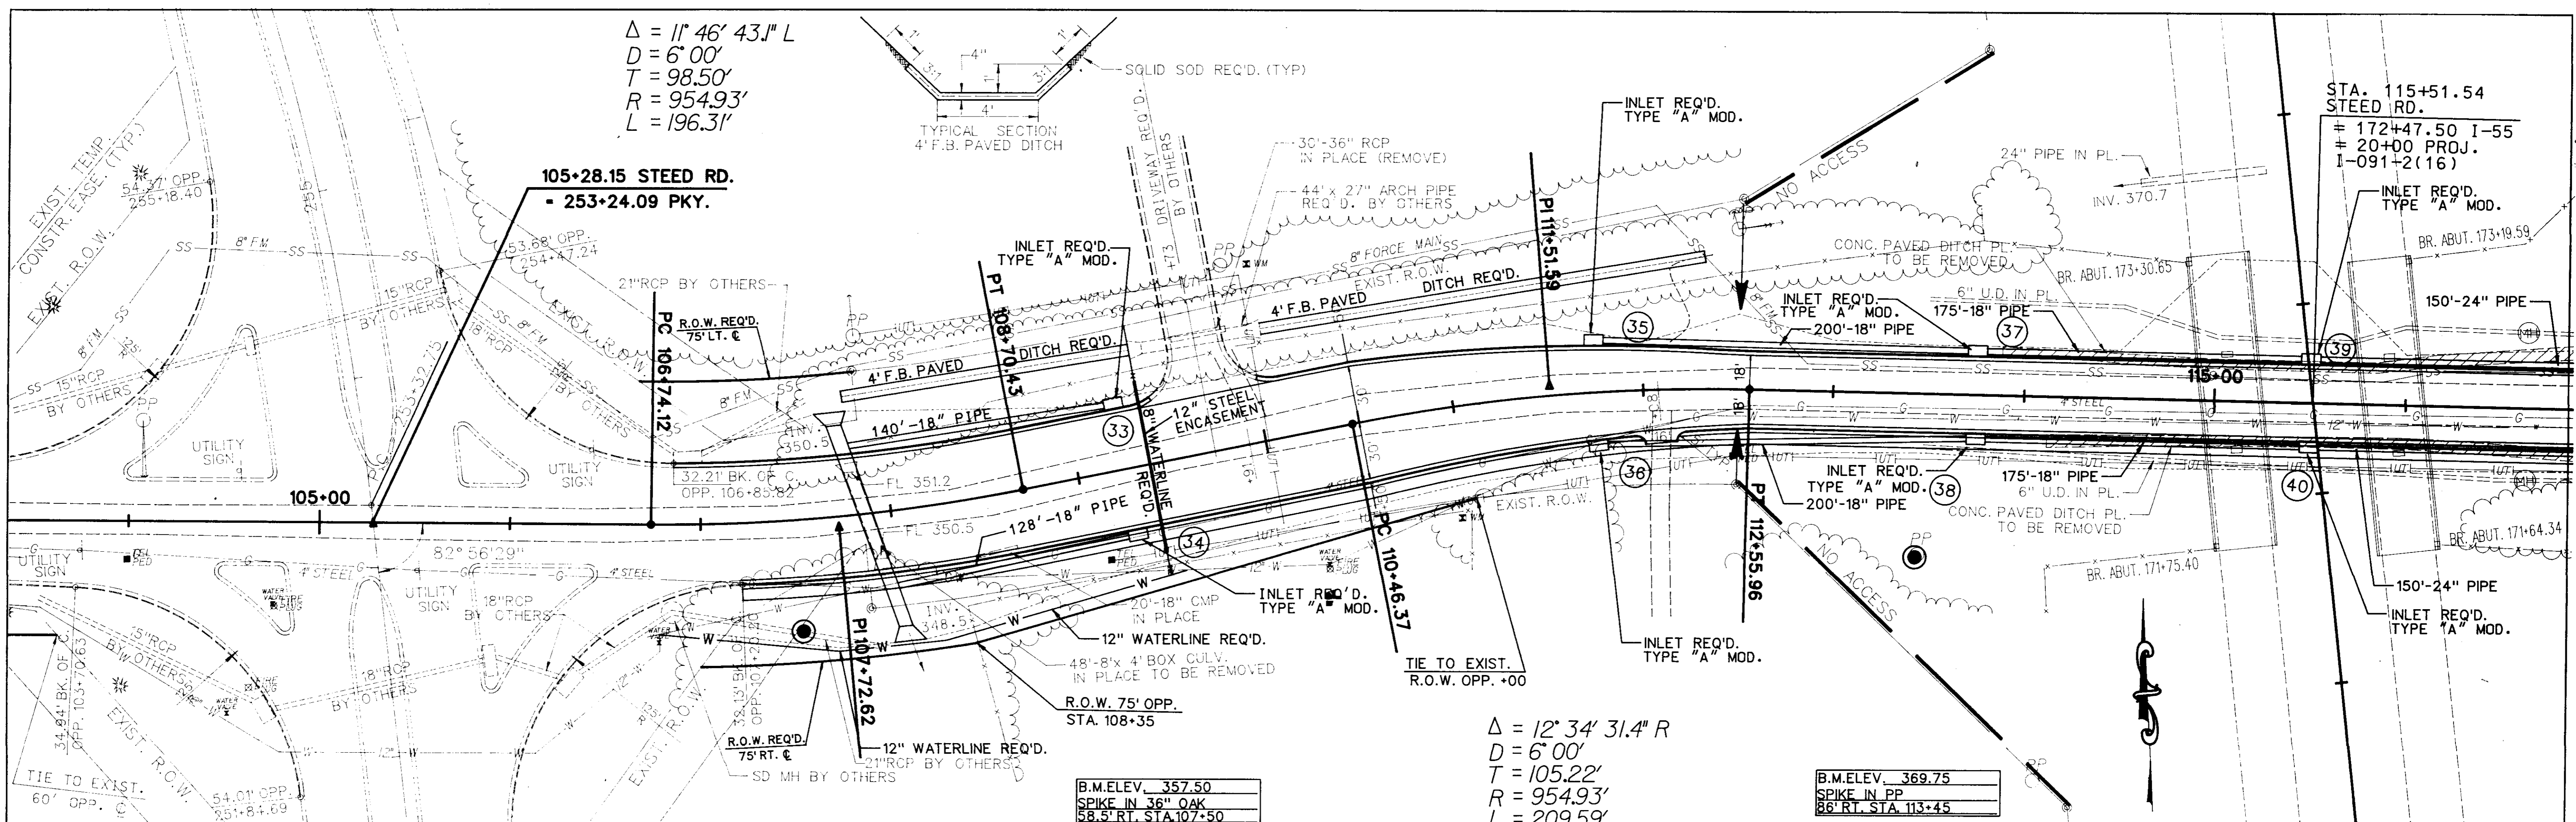


STA. 107+85 D.A. = 142 Ac. 100'-8' x 6' BOX CULVERT REQ'D. SK. 12° 30' RT. FWD. 2 : 1 HDWLS. REQ'D.	STA. 109+25 T.C. = 359.00 INV. = 355.2	INLET *33	STA. 111+75 T.C. = 357.52 INV. = 353.8	INLET *35	STA. 113+75 T.C. = 356.33 INV. = 352.6	INLET *37	STA. 115+50 T.C. = 355.32 INV. = 351.0	INLET *39
EXISTING 48' - 8' x 4' BOX CULVERT TO BE REMOVED	STA. 109+25 T.C. = 359.00 INV. = 355.2	INLET *34	STA. 111+75 T.C. = 357.52 INV. = 353.8	INLET *36	STA. 113+75 T.C. = 356.33 INV. = 352.6	INLET *38	STA. 115+50 T.C. = 355.32 INV. = 351.0	INLET *40

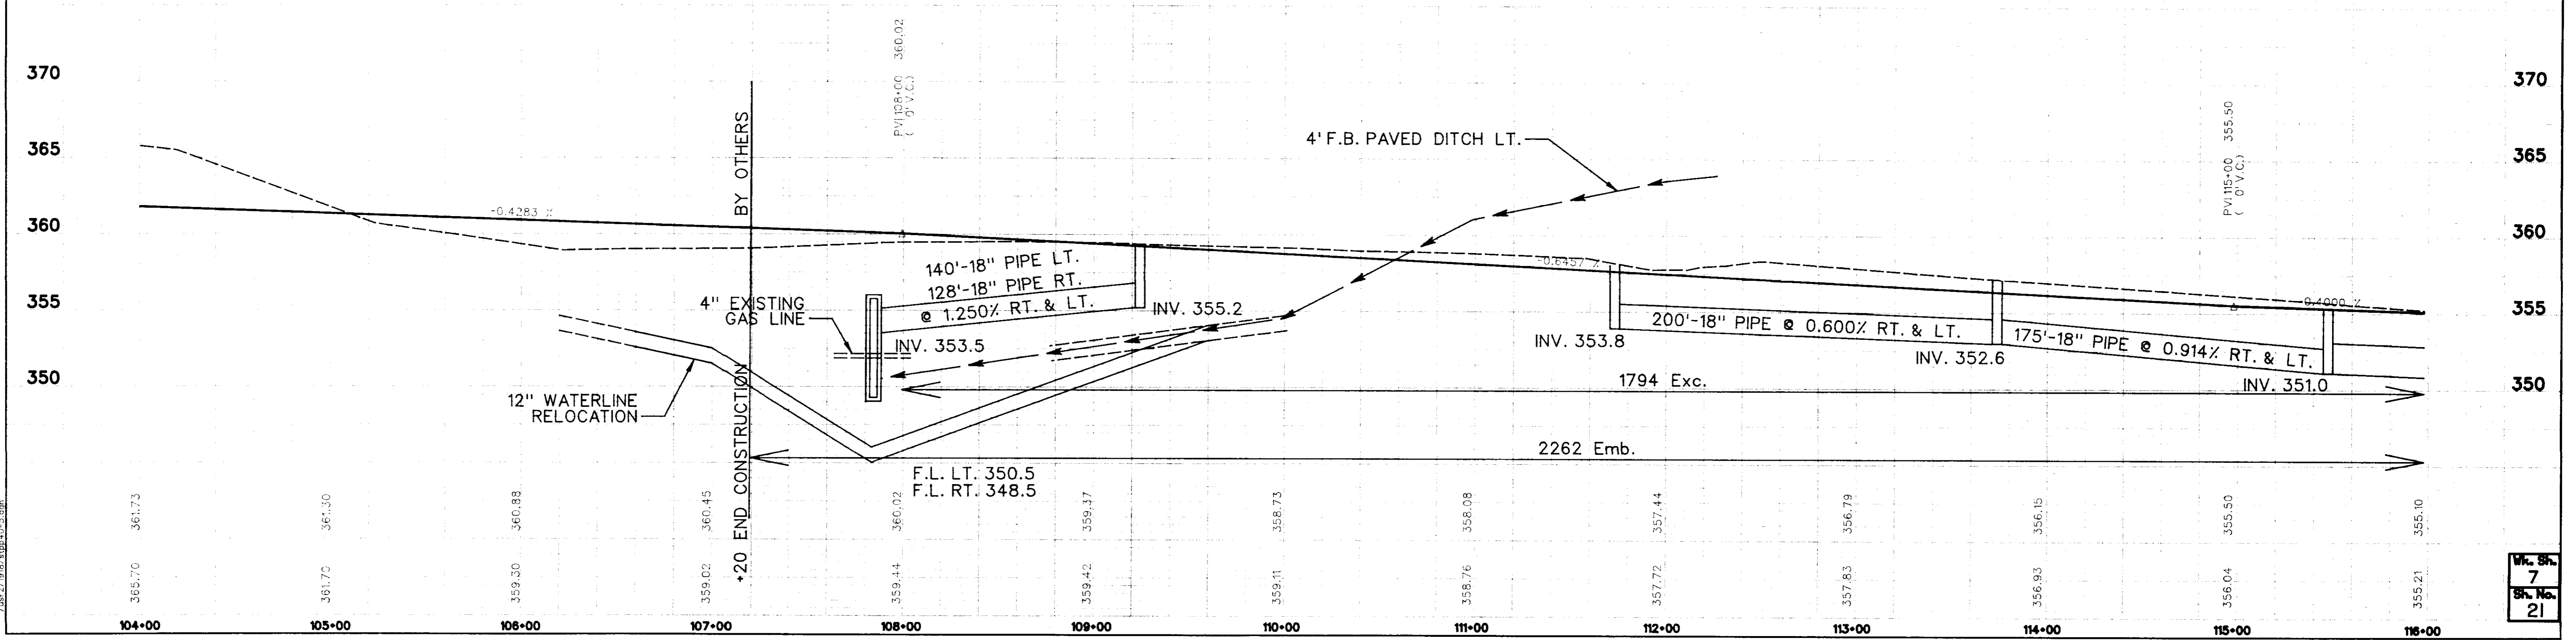


PLAN  
 NOTE BOOK  
 NO.

PROFILE  
 NOTE BOOK  
 NO.

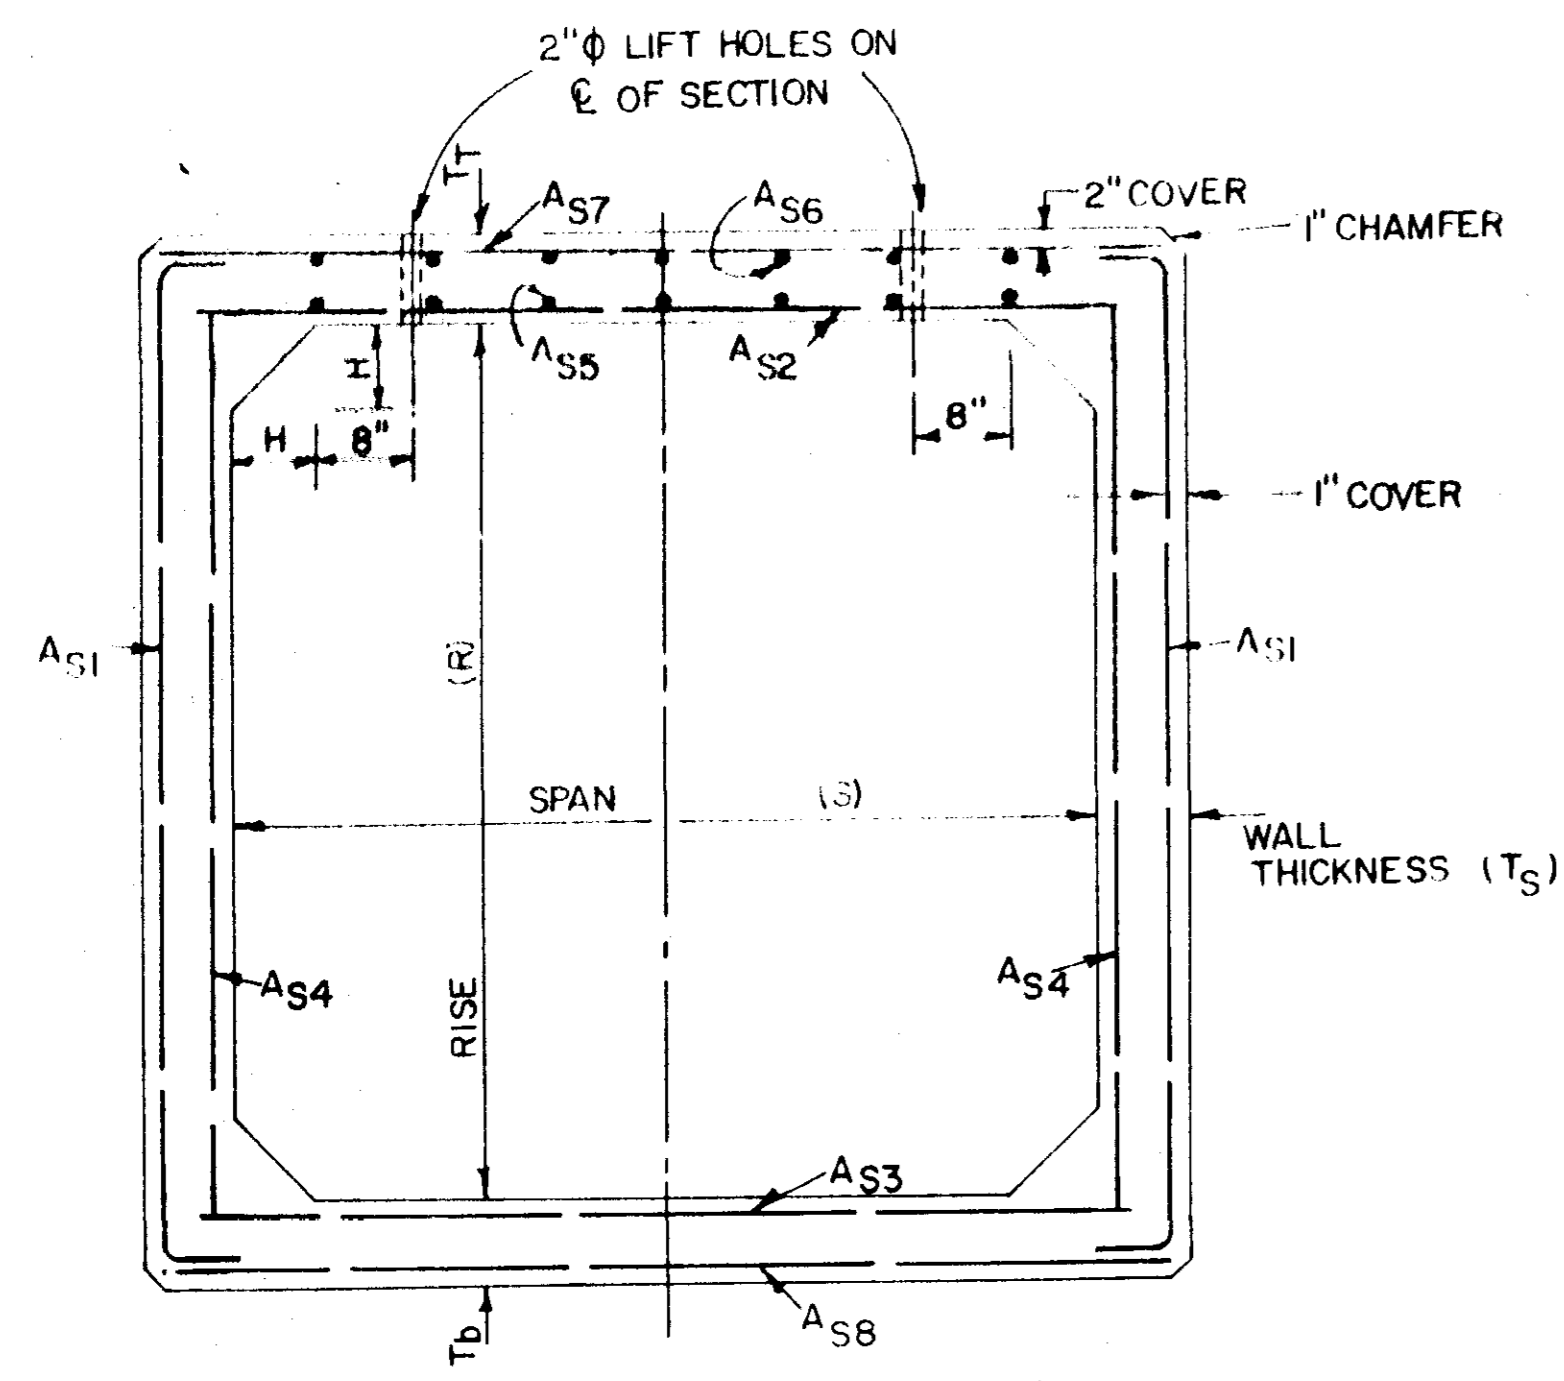

**SECTION A-A**  
(ASTM C850 DESIGN)  
AASHTO M 273  
(LESS THAN 2' COVER)

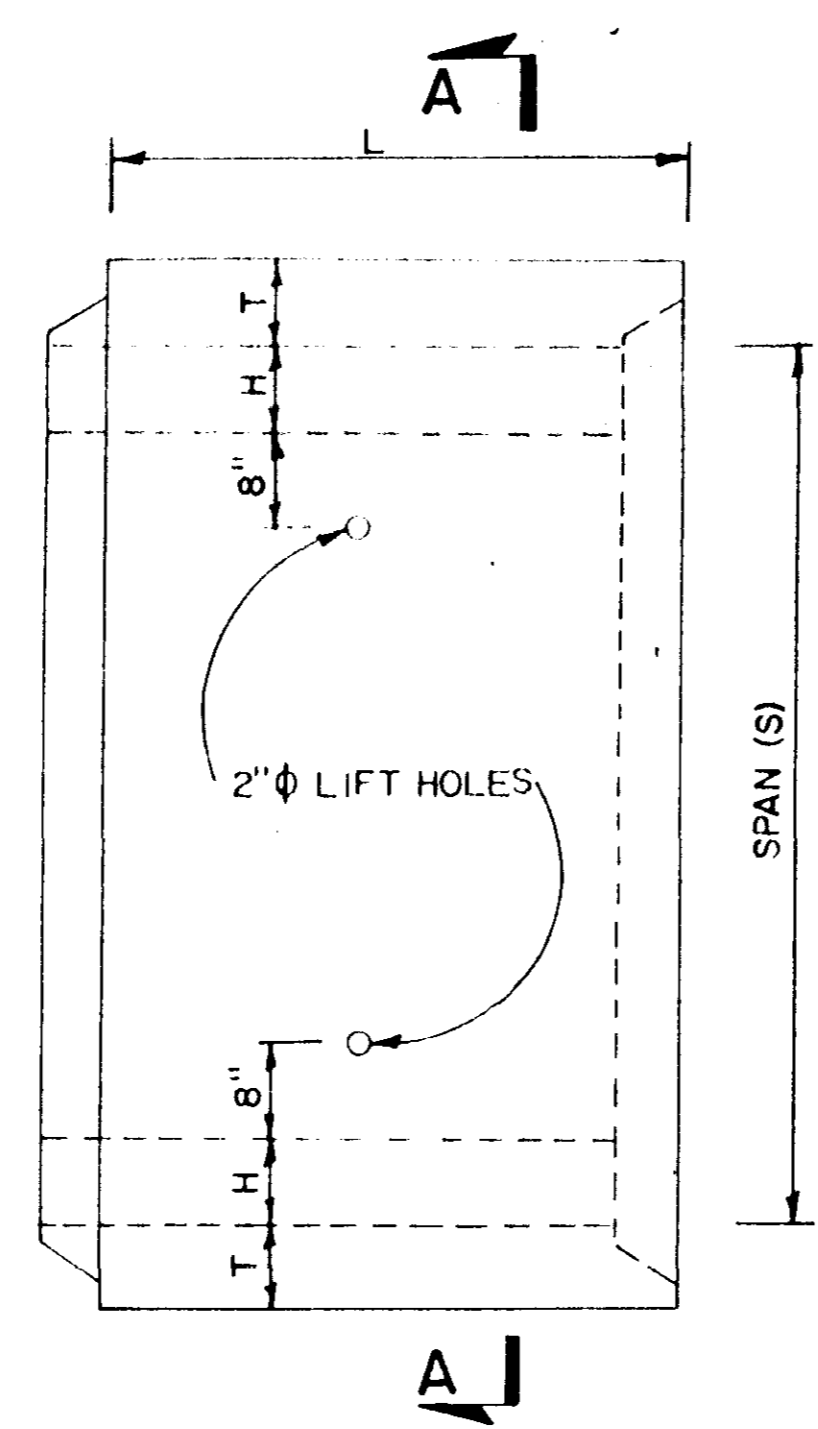


**PLAN**

SPAN (FT.)	RISE (FT.)	COVER EQUAL TO OR LESS THAN 2' ASTM C850 DESIGN (AASHTO M273) TABLE 1			COVER OF 2' TO MAXIMUM AS SHOWN ASTM C789 DESIGN (AASHTO M259) TABLE 1	
		MINIMUM THICKNESSES (IN.)			TOP BOTTOM, WALL THICKNESSES (T) (INCHES)	MAXIMUM FILL HEIGHT TO TOP OF BOX. (FEET)
		TOP SLAB (T <sub>1</sub> )	BOTTOM SLAB (T <sub>2</sub> )	WALL (T <sub>3</sub> )		
4	2	7 1/2	6	5	5	18
4	4	7 1/2	6	5	5	18
6	4	8	7	7	7	18
8	4	8	8	8	8	14
* 10	4	10	10	10	10	5
6	5	8	7	7	7	18
8	5	8	8	8	8	12
10	5	10	10	10	10	14
6	6	8	7	7	7	18
8	6	8	8	8	8	12
10	6	10	10	10	10	14
8	8	8	8	8	8	12
10	8	10	10	10	10	12


\* SPECIAL DESIGNED (SEE NOTE 3)

**GENERAL NOTES**

- ① THE PRECAST REINFORCED CONCRETE BOX SECTION, EXCLUDING SPECIAL DESIGNED, SHALL BE DESIGNED, AND MANUFACTURED IN ACCORDANCE WITH THE SPECIFICATION OF ASTM C850 (AASHTO M273) (TABLE 1) FOR LESS THAN 2 FEET OF COVER SUBJECTED TO HIGHWAY LOADING OR ASTM C789 (AASHTO M259) (TABLE 1) FOR 2 FEET OR MORE EARTH COVER.
- ② THE HAUNCH DIMENSION (H) IS EQUAL TO THE WALL THICKNESS.
- ③ CONCRETE BOXES INDICATED AS SPECIAL DESIGNS HAVE BEEN APPROVED AND ARE ON FILE AT THE ROADWAY DESIGN AND TESTING DIVISION OF THE MISSISSIPPI STATE HIGHWAY DEPARTMENT, AND SHALL BE MANUFACTURED IN ACCORDANCE WITH THE SPECIFICATIONS OF ASTM C850 (AASHTO M273) (TABLE 1) FOR LESS THAN 2 FEET OF COVER SUBJECTED TO HIGHWAY LOADING OR ASTM C789 (AASHTO M259) (TABLE 1) FOR 2 FEET OR MORE EARTH COVER.

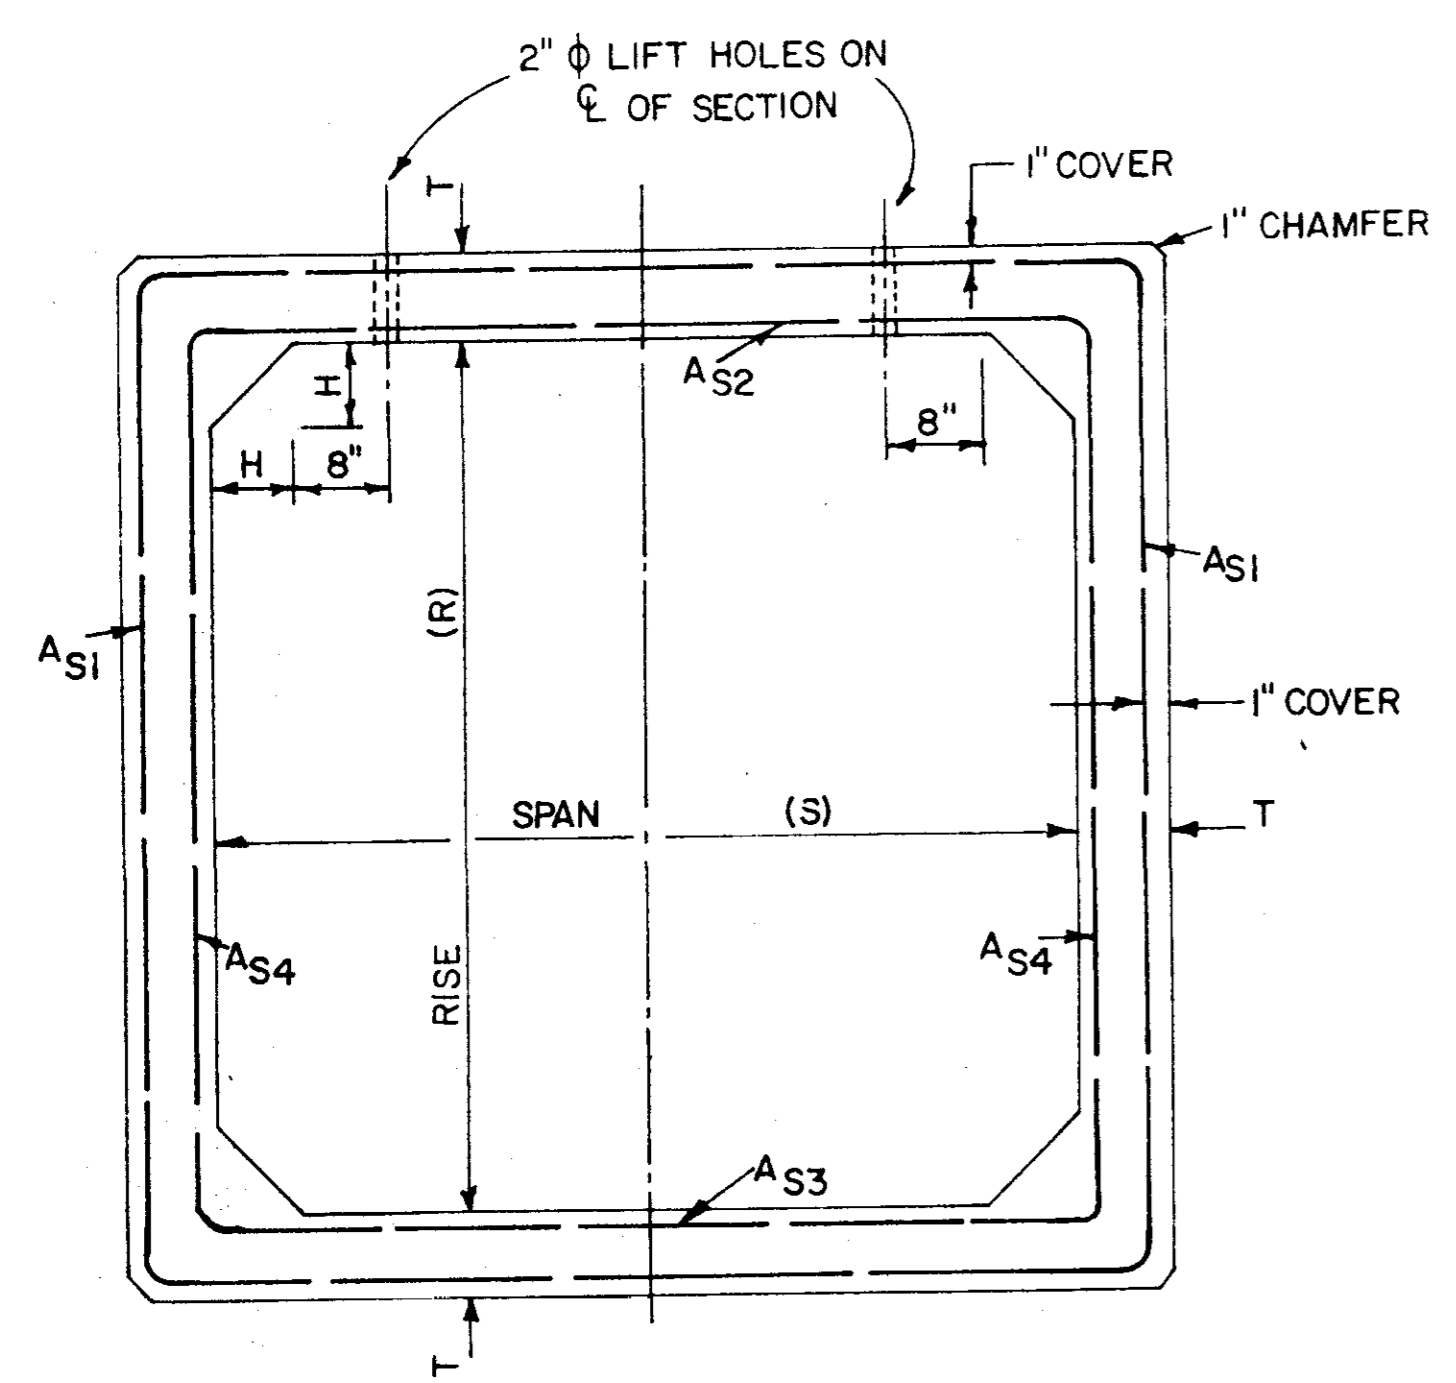

**SECTION A-A**  
(ASTM C789 DESIGN)  
AASHTO M 259  
(2' OR MORE COVER)

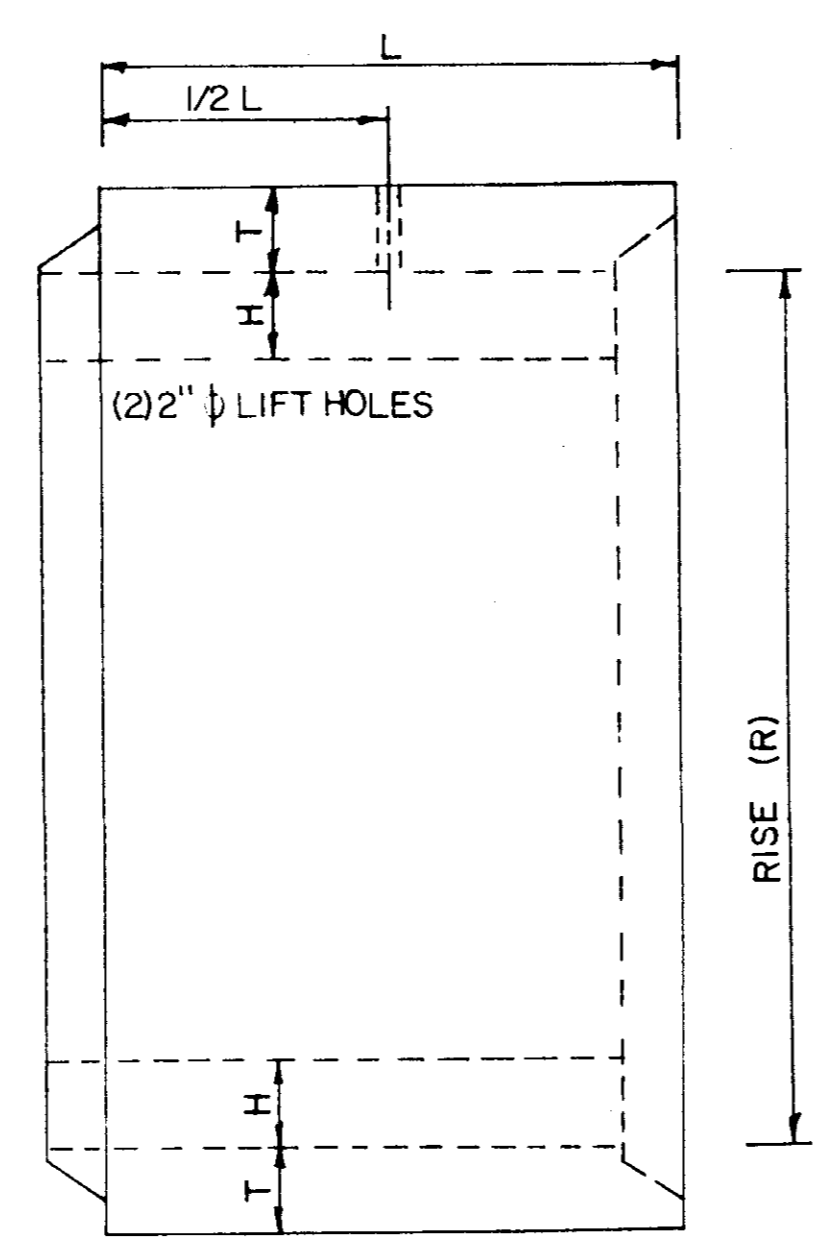

**ELEVATION**


MISSISSIPPI STATE HIGHWAY DEPARTMENT			
<b>PRECAST CONCRETE BOX CULVERT</b>			
DESIGNED	AWK	DATE	11-15-85
DRAWN	M.S. JR.	DATE	
CHECKED	E.L.S.	DATE	
ISSUED		DATE	
BY			
REVISIONS			
DATE			
ADDED	4 X 2		
A.K.			
A.P.			
WORKING NUMBER			PBC-1
SHEET NUMBER			67








GROUP I DIAGRAMS  
 2-1/2 FT. TRAFFIC LANES  
 4 FT. THRU 60 FT. MEDIANS  
 GROUP II DIAGRAMS  
 2-1/2 FT. TRAFFIC LANES  
 4 FT. THRU 60 FT. MEDIANS  
 GROUP III DIAGRAMS  
 2-1/2 FT. TRAFFIC LANES  
 4 FT. THRU 60 FT. MEDIANS  
 GROUP IV DIAGRAMS  
 2-1/2 FT. TRAFFIC LANES  
 4 FT. THRU 60 FT. MEDIANS

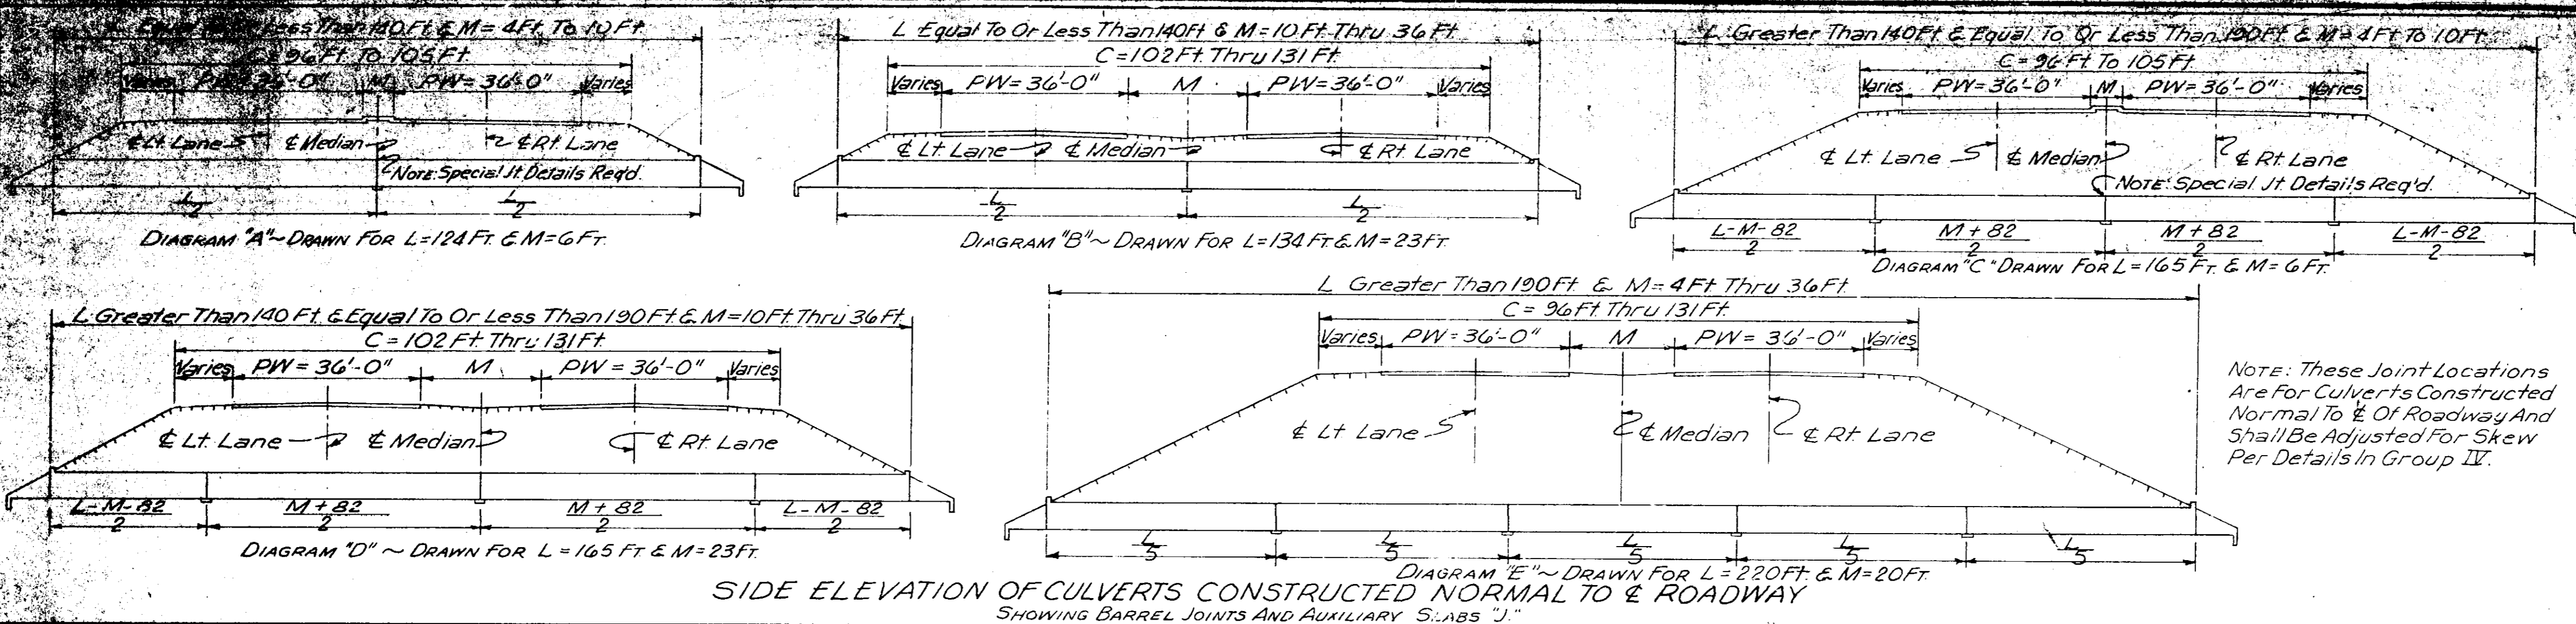


**SIDE ELEVATION OF CULVERTS CONSTRUCTED NORMAL TO & ROADWAY**  
 SHOWING BARREL JOINTS AND AUXILIARY SLABS "J"


**APPLICATION OF DIAGRAMS**  
 The following diagrams show the general application of location diagrams in Groups I, II, III, and IV. 1. With LSK (Length of Skewed Culvert) and M (Median Length of Barrel Section) Required, MULTIPLY LSK BY THE SKEW ANGLE (θ) TO OBTAIN L (Length of Culvert Normal to Roadway). 2. Enter Group I, II, or III Determined by Roadway Cross Section. The Number of Joints and Length of Each Barrel Section for a Normal to Roadway. 3. DIVIDE Each Length of Section By The COSINE of the SKEW ANGLE to Determine the Length of Each Barrel Section Along the Skew. 4. Place the Barrel Joints (Type Per Basic Dwg.) at These Locations. Length of Any Section Exceeds 70 FT. AND A CONSTRUCTION JOINT IS REQUIRED. Reduce Yardage of Four) Place A Construction Joint in Center of Section.

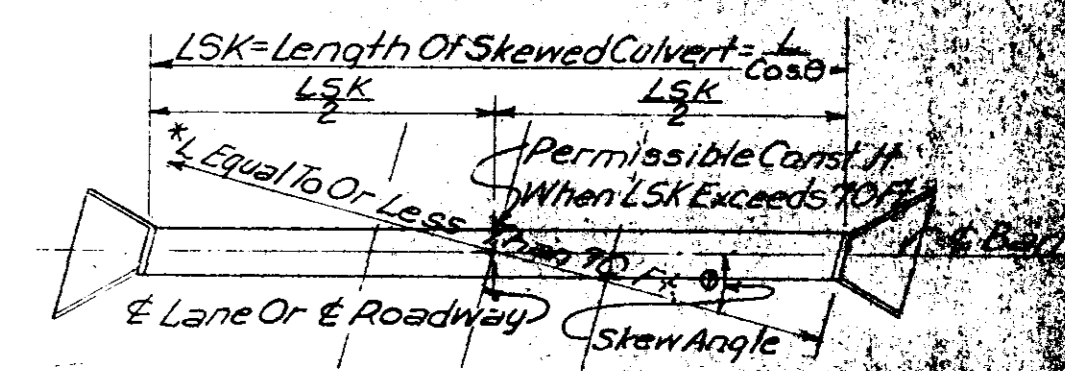


**DIAGRAM "A"**  
**PLAN OF SKEWED CULVERT**  
 TYPICAL FOR DIAGRAM "A" GROUP I AND SKEWED 15° RIGHT FORWARD  
 (NO BARREL JOINTS REQUIRED)  
 NOTE: LSK = 1.03528L FOR 15° SKEW

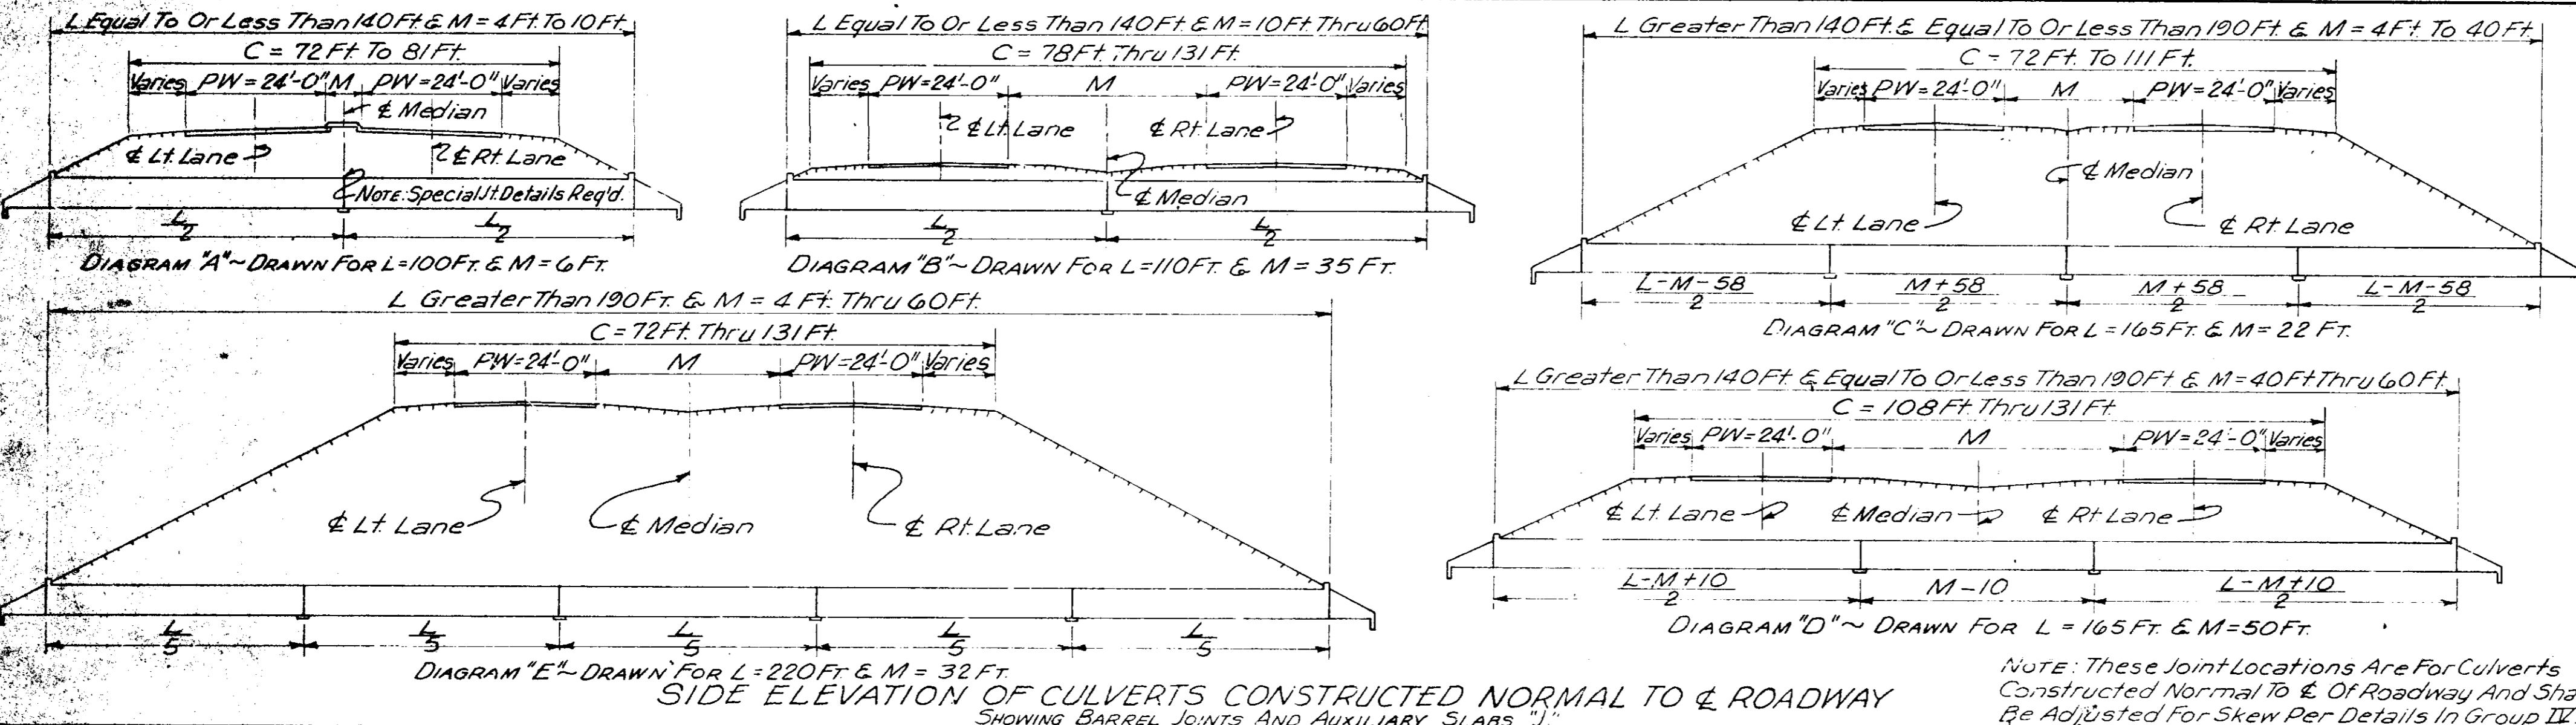


**SIDE ELEVATION OF CULVERTS CONSTRUCTED NORMAL TO & ROADWAY**  
 SHOWING BARREL JOINTS AND AUXILIARY SLABS "J"

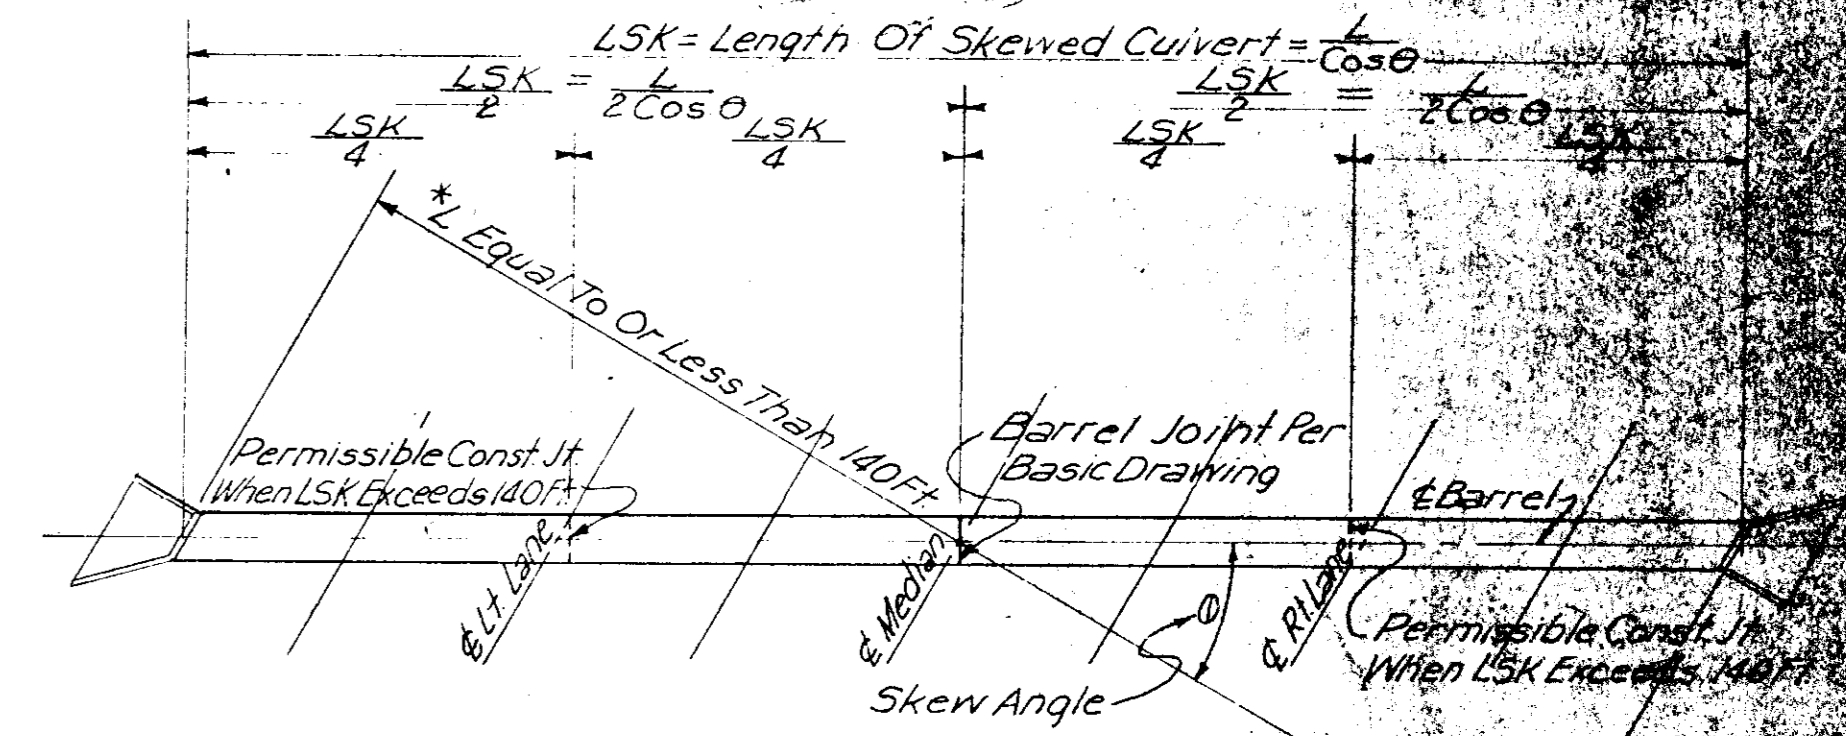


**DIAGRAM "B"**  
**PLAN OF SKEWED CULVERT**  
 TYPICAL FOR DIAGRAM "B" GROUP III AND SKEWED 30° RIGHT FORWARD  
 (ONE BARREL JOINT REQUIRED)  
 NOTE: LSK = 1.15470L FOR 30° SKEW

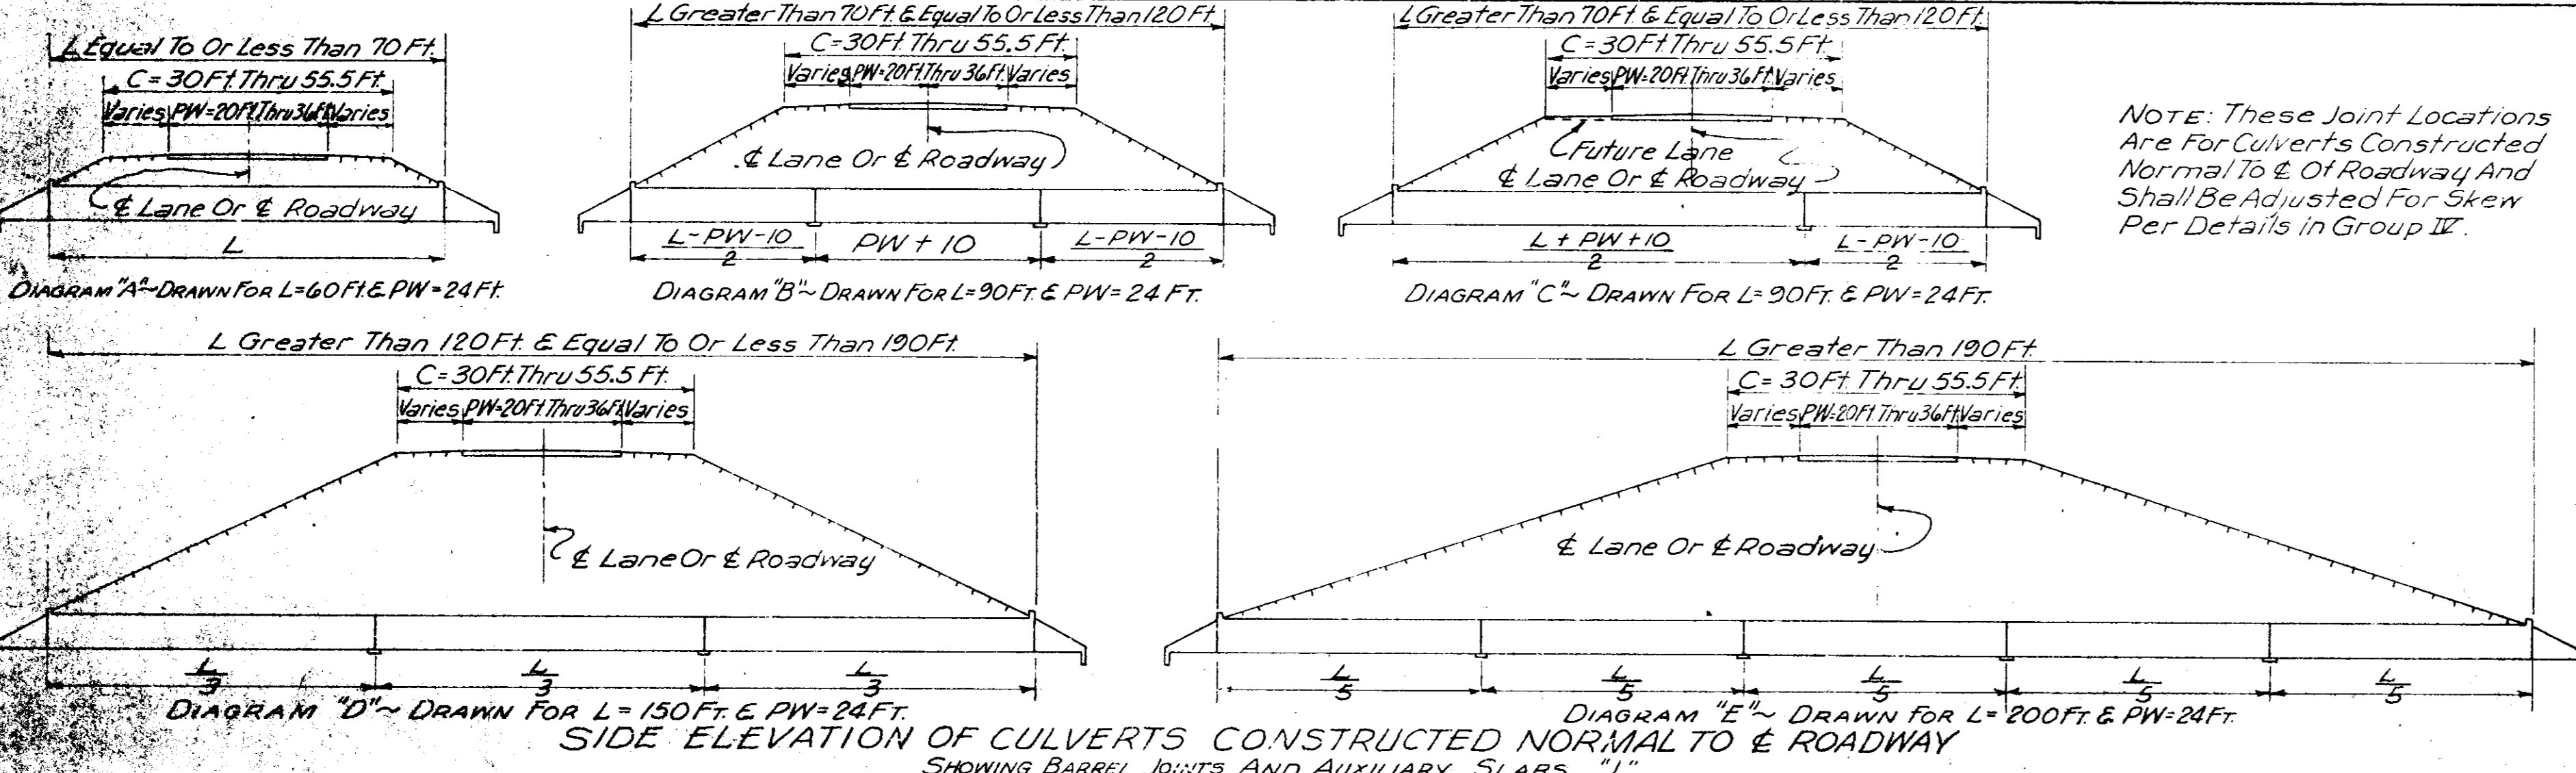

**SIDE ELEVATION OF CULVERTS CONSTRUCTED NORMAL TO & ROADWAY**  
 SHOWING BARREL JOINTS AND AUXILIARY SLABS "J"

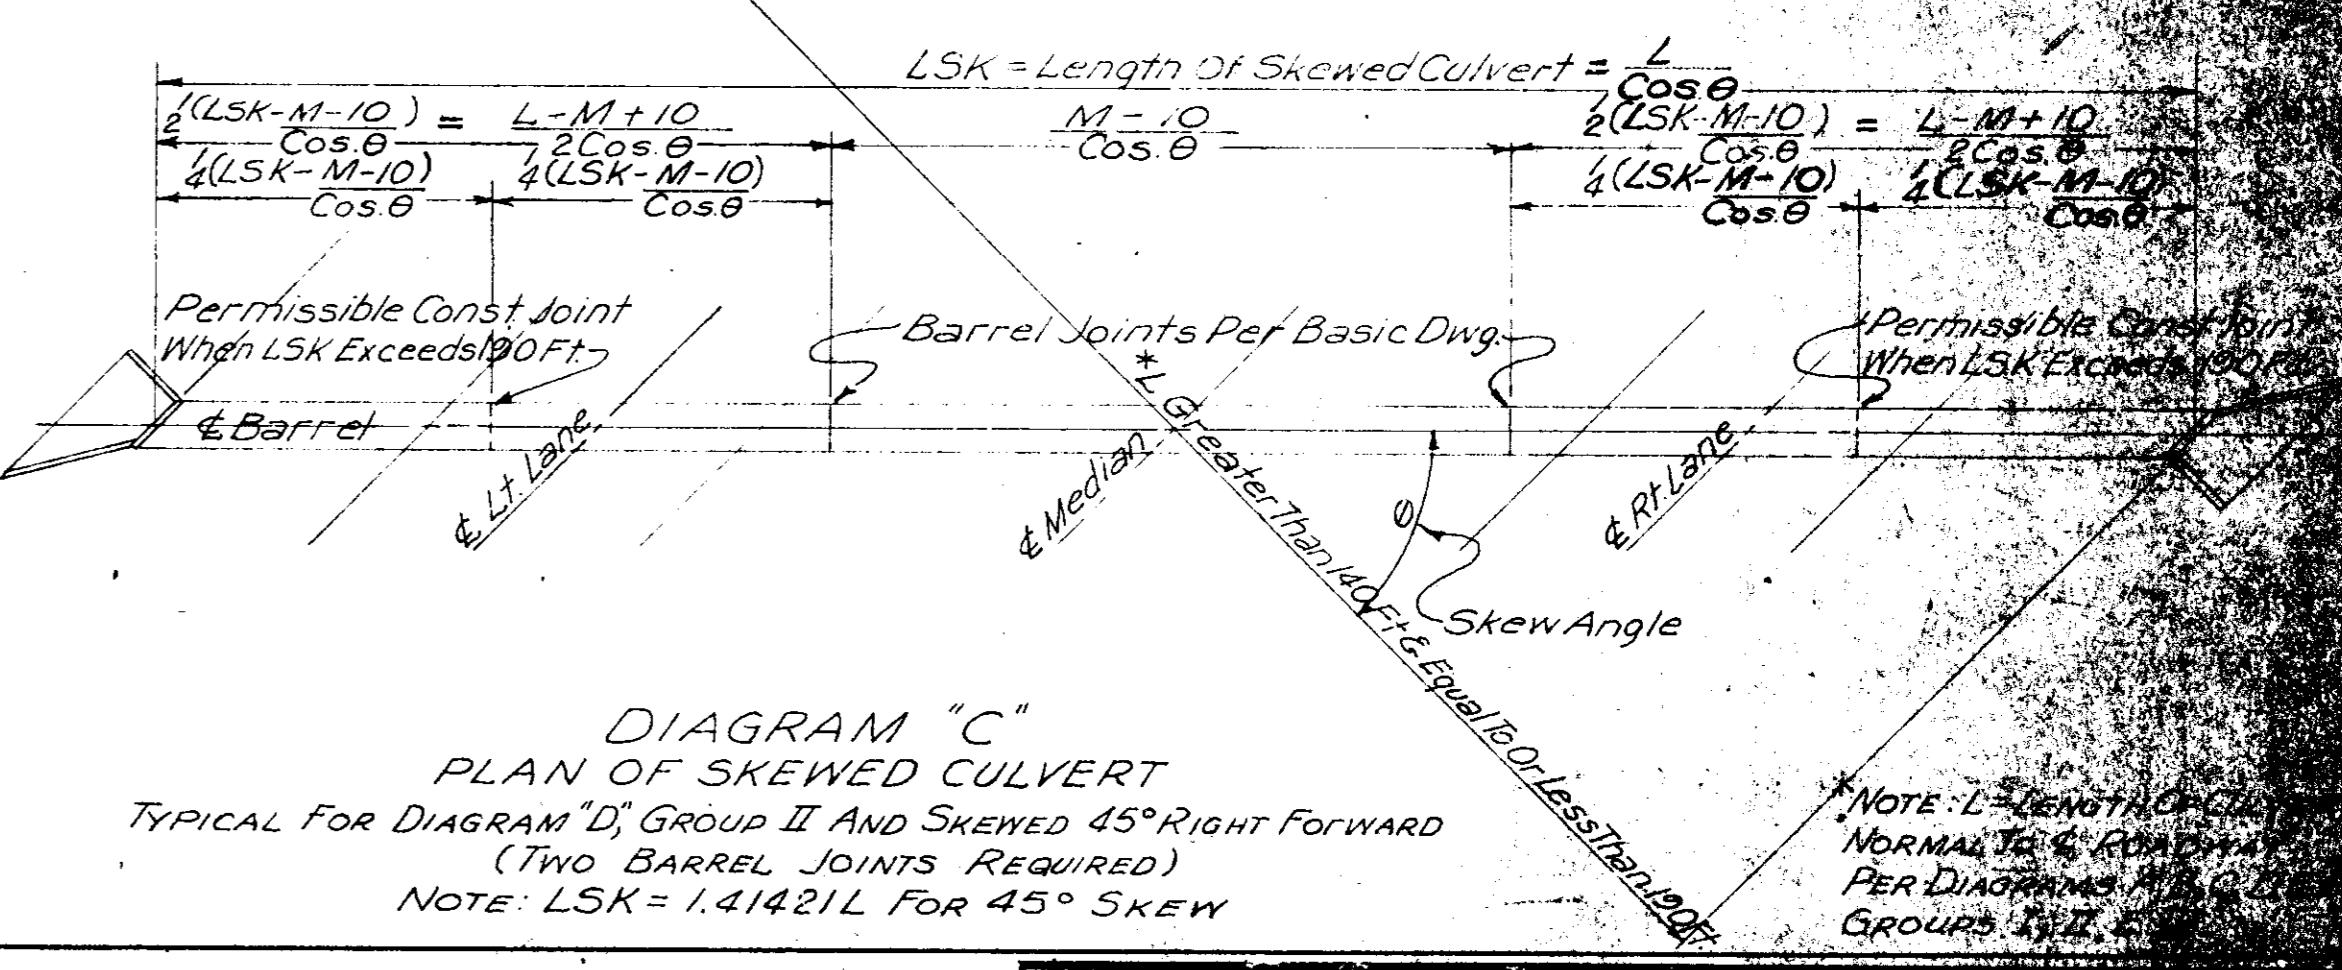

**DIAGRAM "C"**  
**PLAN OF SKEWED CULVERT**  
 TYPICAL FOR DIAGRAM "D" GROUP II AND SKEWED 45° RIGHT FORWARD  
 (TWO BARREL JOINTS REQUIRED)  
 NOTE: LSK = 1.41421L FOR 45° SKEW

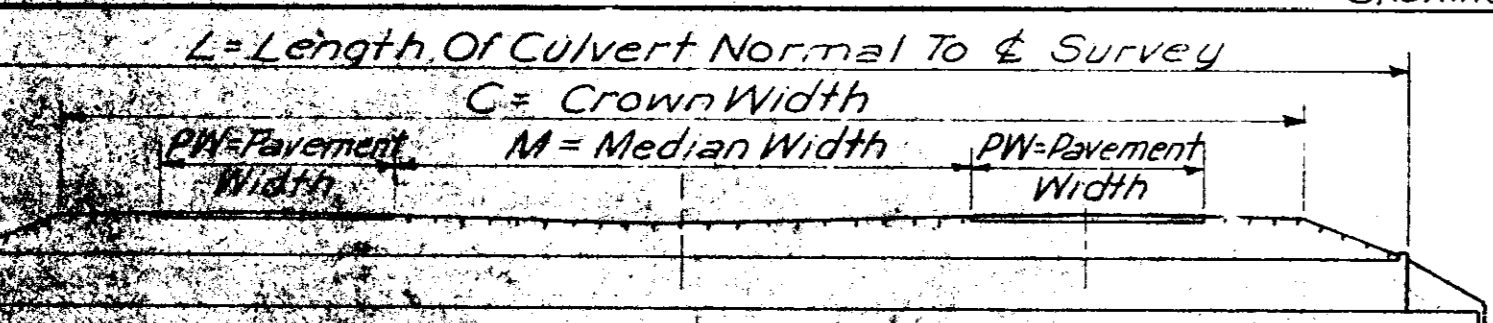



**SIDE ELEVATION OF CULVERT CONST. NORMAL TO & SURVEY**  
 SHOWING BARREL JOINTS AND AUXILIARY SLABS "J"

**GENERAL NOTES:**  
 This Drawing Shows The Barrel Joint Locations For Box Culverts Constructed Normal To & Of Roadway And General Details Necessary To Locate Joints For Culverts On 15, 30 And 45° Skews. The Diagrams On This Sheet Show Joint Locations For Culverts Under Variable Amounts Of Cover, Crown Width And Side Slopes. Barrel Joints Shall Be Of Type Per Basic Drawing And Shall Be Placed Only At Locations Shown Unless Otherwise Stated. Joints Shall Not Be Located Closer Than 5 FT. Outside Pavement For Cover Of 8 FT. Or Less Except In Cases Where Median Is Less Than 10 FT. Where Cover Is 8 FT. Or Less And A Joint Occurs Within The Limits Of 5 FT. Beyond Each Edge Of Pavement, Use Complete Collar At Joints Per Drawing 1CJ-1 Or 1CJ-5-1. Where Cover Exceeds 8 FT. Joints May Be Located Without Regard To Pavement Edge. Construction Joints Per Group III, If Required, Shall Have Reinforcement Continuous Thru Joint And Shall Be Placed Only At Locations Indicated. General Requirements Of Basic Culvert Drawings Shall Apply Except As Specifically Modified Herein.






**MISSISSIPPI STATE HIGHWAY DEPARTMENT**  
**BOX CULVERT DRAWING**  
**BARREL JOINT LOCATIONS**  
**NORMAL AND SKEWED**



CULVERT DIMENSIONS		ESTIMATED QUANTITIES				BAR LIST FOR BARREL (L=150') PARAPETS & 2 AUXILIARY SLABS																															
CLEAR SPAN	MAX. COVER	T	V	W	Y	CONC. CU. YD.	REIN. STEEL LB.	CONC. CU. YD.	REIN. STEEL LB.	CONC. CU. YD.	REIN. STEEL LB.	BARS "A"		BARS "B"		DOWELS "Q"		SPACERS "S"		SETS OF BARS "AST"		SETS OF BARS "ASB"		SETS OF BARS "BS"		BARS "K"		BARS "N"		BARS "V"		BARS "W"		BARS "Y"			
4'	2 1/2"	7"	7"	1'-2"	16'-10 1/2"	84.17	10,202	0.4825	60.7	0.26	15	480	#5	7 1/2"	6'-11"	788	#3	4"	5'-8"	24	2'-6"	4	5'-7"	4	152'-9"	4	155'-7"	20	152'-9"	8	4'-0"	4	4'-10"	4	4'-10"	4	4'-10"
6'	1 1/4"	7 1/2"	7 1/2"	1'-2"	18'-10 1/2"	101.85	14,258	0.5910	86.8	0.35	21	800	#5	6"	6'-11"	1200	#4	6"	6'-4"	24	2'-6"	4	5'-7"	6	152'-9"	6	155'-7"	24	152'-9"	12	4'-1"	4	6'-10"	4	6'-10"	4	6'-10"
8'	10'	8 1/2"	7 1/2"	1'-3 1/2"	20'-10 1/2"	129.16	18,948	0.7631	117.3	0.46	26	480	#6	7 1/2"	9'-0"	960	#5	7 1/2"	7'-1"	24	2'-6"	4	5'-7"	8	152'-9"	8	155'-7"	24	152'-9"	16	4'-3"	4	8'-10"	4	8'-10"	4	8'-10"
10'	8'	9 1/2"	8"	1'-4 1/2"	22'-10 1/2"	160.31	25,194	0.9609	158.1	0.56	32	576	#6	6 1/2"	11'-1"	1152	#5	6 1/2"	9'-3"	24	2'-6"	4	5'-7"	10	152'-9"	10	155'-7"	28	152'-9"	20	4'-5"	4	10'-10"	4	10'-10"	4	10'-10"
12'	7'	10 1/2"	8 1/2"	1'-5 1/2"	24'-10 1/2"	195.30	31,113	1.1844	196.9	0.66	38	654	#6	5 1/2"	13'-2"	1308	#5	5 1/2"	8'-4"	24	2'-6"	4	5'-7"	12	152'-9"	12	155'-7"	28	152'-9"	24	4'-7"	4	12'-10"	4	12'-10"	4	12'-10"
14'	7'	11 1/2"	9 1/2"	1'-7"	26'-10 1/2"	245.12	39,315	1.5062	250.3	0.77	44	534	#7	6 3/4"	15'-4"	1068	#6	6 3/4"	9'-3"	24	2'-6"	4	5'-7"	14	152'-9"	14	155'-7"	32	152'-9"	28	4'-10"	4	14'-10"	4	14'-10"	4	14'-10"
16'	6'	11 1/2"	10"	1'-8"	28'-10 1/2"	288.88	45,780	1.7881	292.9	0.87	49	576	#7	6 1/2"	17'-5"	1152	#6	6 1/2"	9'-10"	24	2'-6"	4	5'-7"	16	152'-9"	16	155'-7"	32	152'-9"	32	5'-0"	4	16'-10"	4	16'-10"	4	16'-10"
18'	6'	11 1/2"	11 1/2"	1'-9"	30'-10 1/2"	344.23	57,285	2.1471	368.7	0.98	55	480	#8	7 1/2"	19'-8"	1440	#6	5"	10'-7"	24	2'-6"	4	5'-7"	18	152'-9"	18	155'-7"	36	152'-9"	36	5'-8"	4	18'-10"	4	18'-10"	4	18'-10"
20'	6'	11 1/2"	11 1/2"	1'-10"	32'-10 1/2"	403.75	67,670	2.5339	436.2	1.09	61	402	#9	9"	21'-11"	1200	#7	6"	11'-5"	24	2'-6"	4	5'-7"	20	152'-9"	20	155'-7"	36	152'-9"	40	5'-4"	4	20'-10"	4	20'-10"	4	20'-10"

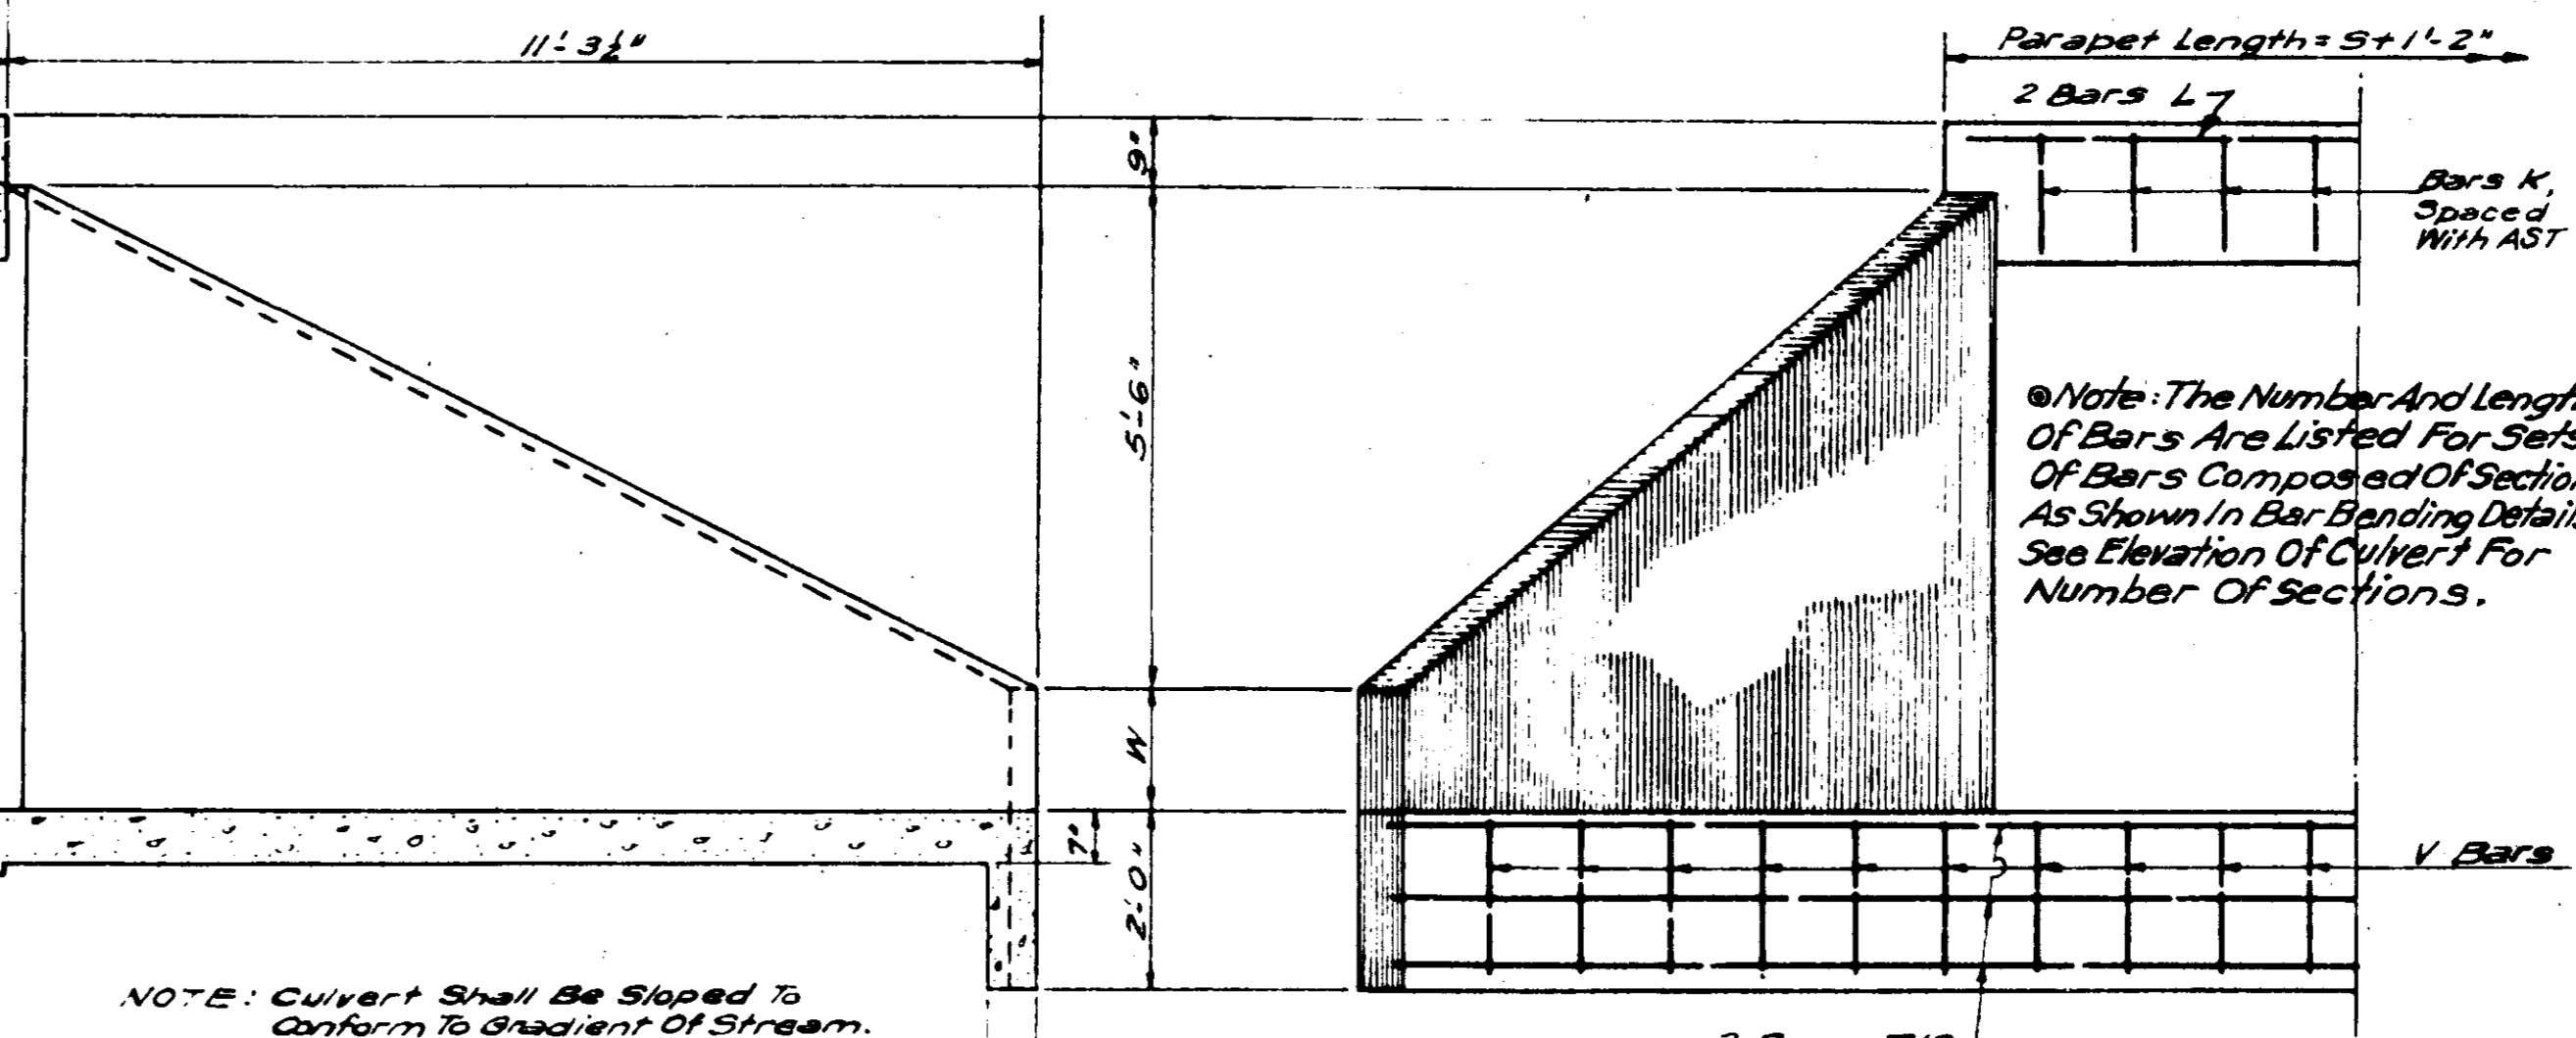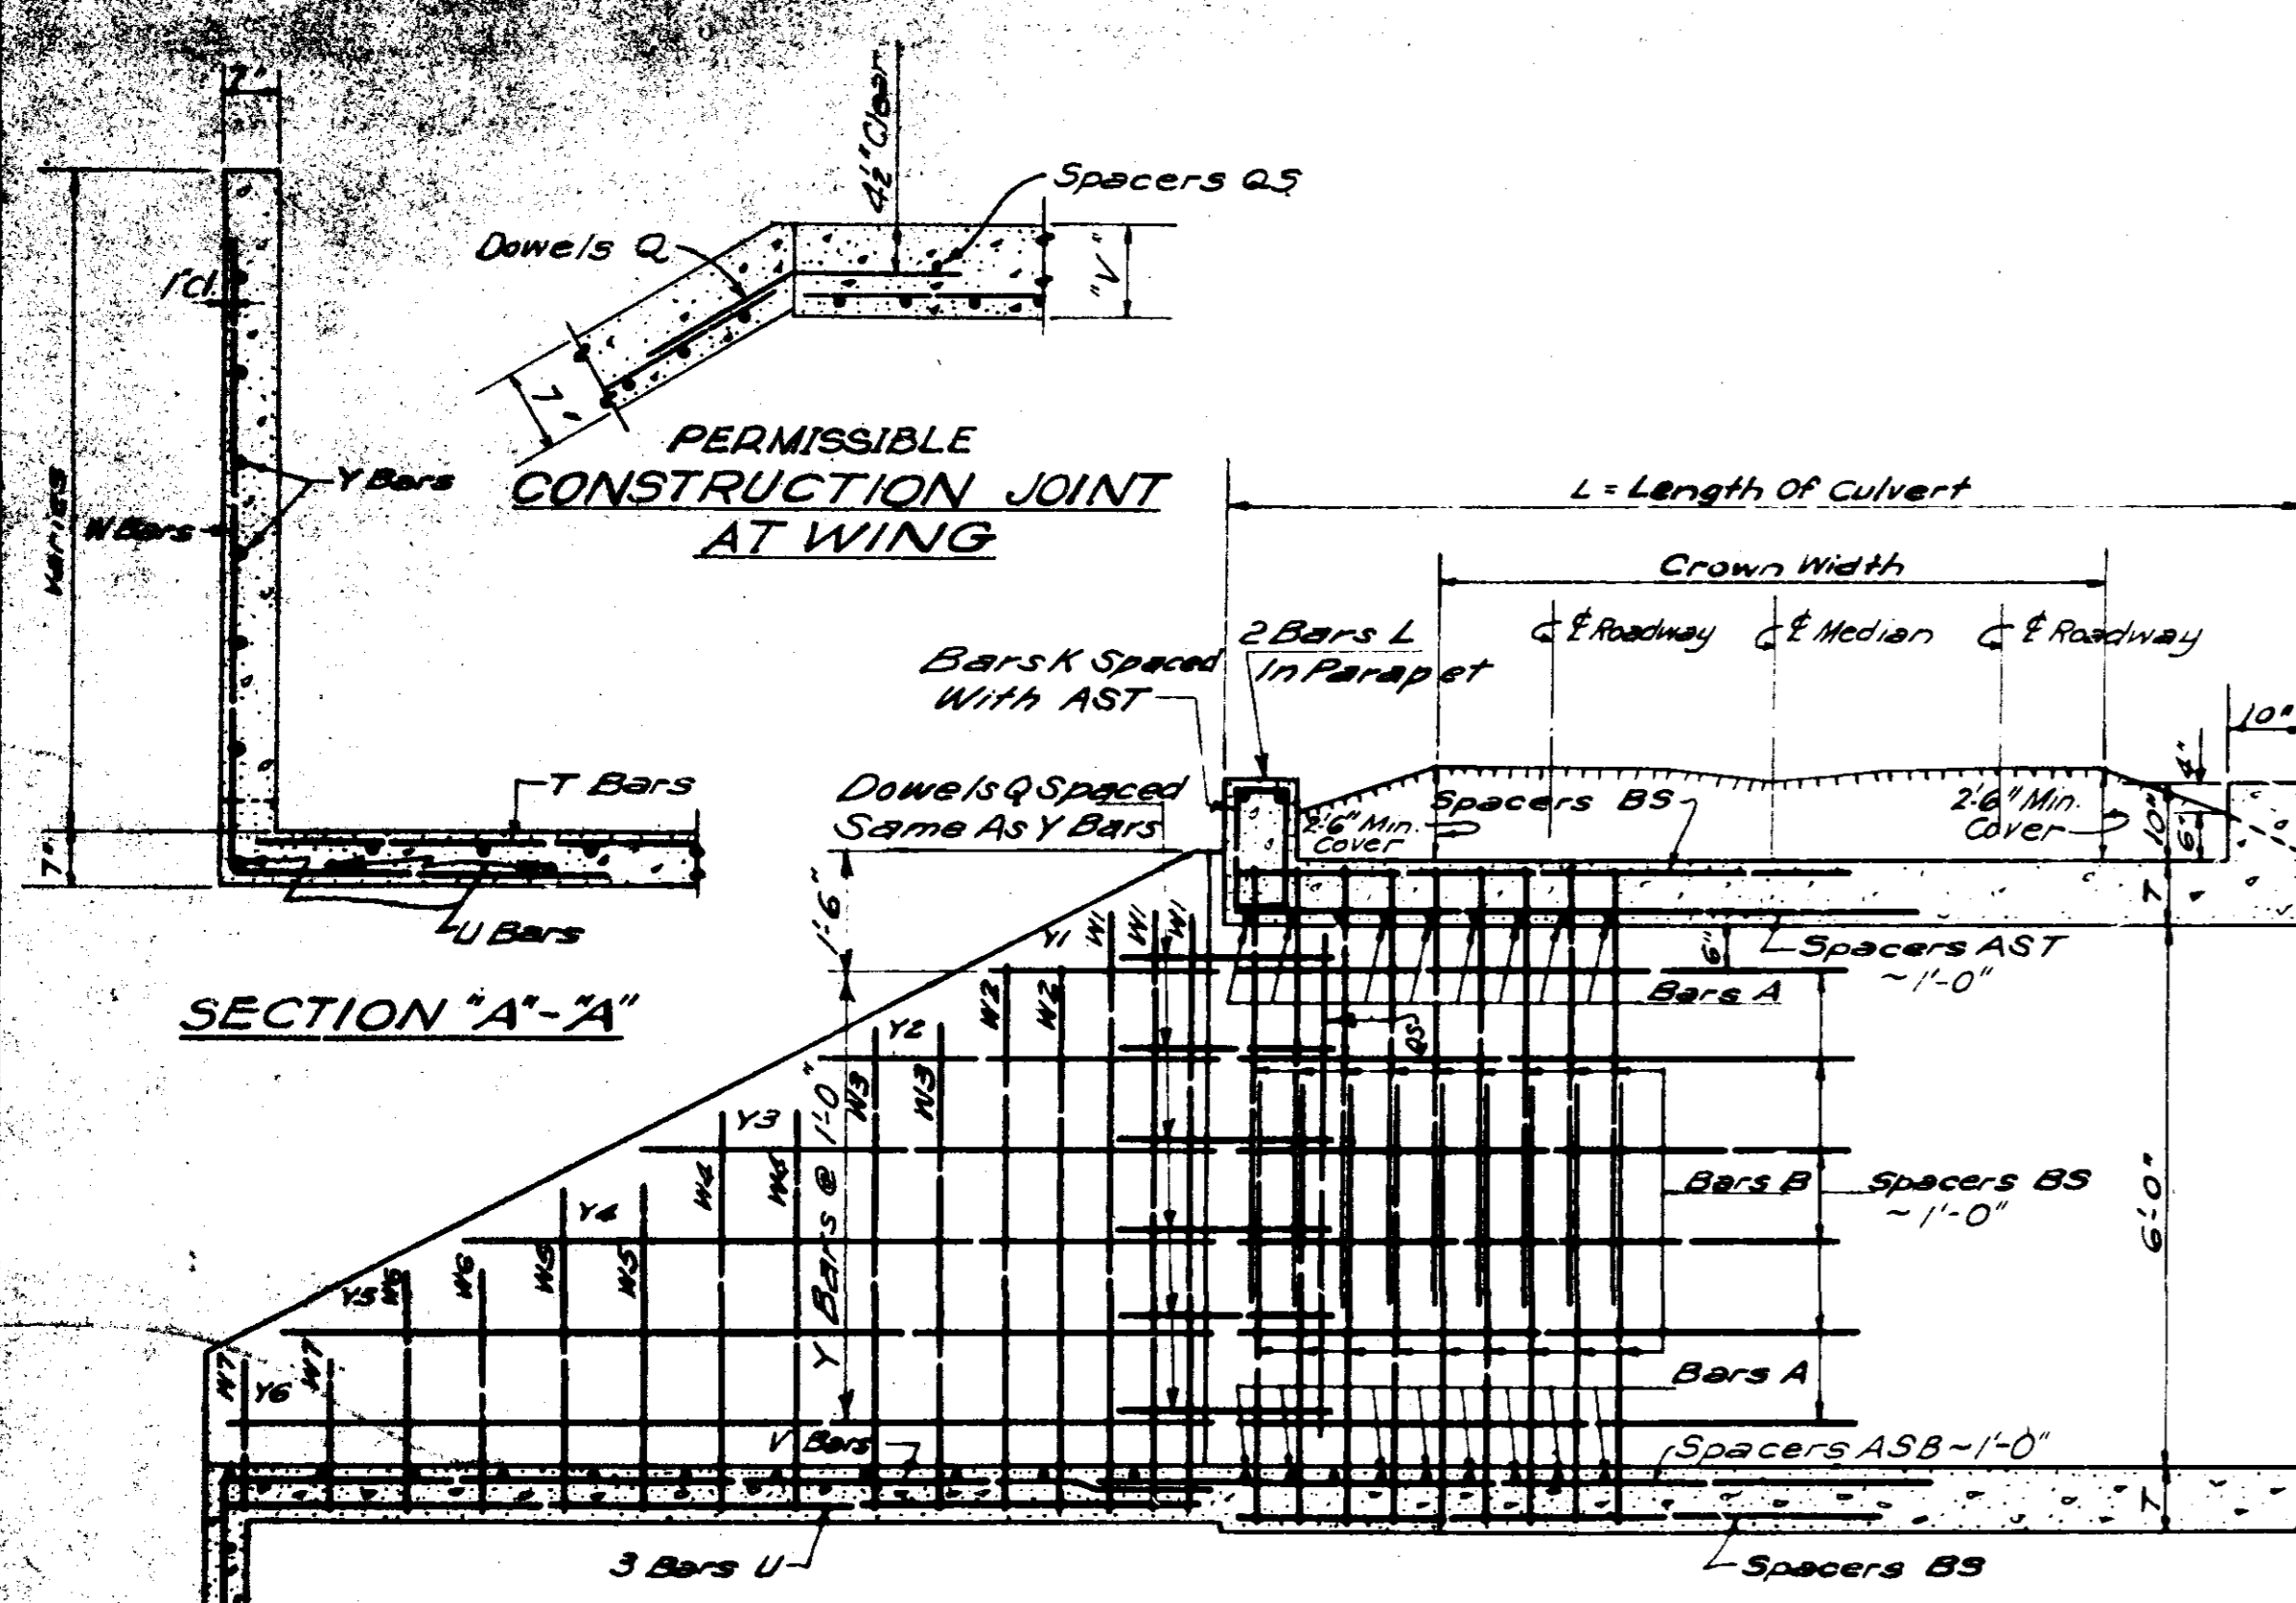

BAR SIZE		NO. REQUIRED		SPAN		DIM.		DIM.		LENGTH	
BAR	SIZE	NO.	REQUIRE	SPAN	SPAN	X	Y	X	Y	LENGTH	LENGTH
T1	#4	2	2	2	2	2	2	2	2	2	2
T2	#4	2	2	2	2	2	2	2	2	2	2
T3	#4	2	2	2	2	2	2	2	2	2	2
T4	#4	2	2	2	2	2	2	2	2	2	2
T5	#4	2	2	2	2	2	2	2	2	2	2
T6	#4	2	2	2	2	2	2	2	2	2	2
T7	#4	2	2	2	2	2	2	2	2	2	2
T8	#4	2	2	2	2	2	2	2	2	2	2
T9	#4	2	2	2	2	2	2	2	2	2	2
T10	#4	2	2	2	2	2	2	2	2	2	2
T11	#4	2	2	2	2	2	2	2	2	2	2
T12	#4	6	6	6	6	6	6	6	6	6	6
U	#4	12	12	12	12	12	12	12	12	12	12
V1	#4	12	16	20	24	28	32	36	40	44	11'-0"
V2	#4	4	4	4	4	4	4	4	4	4	9'-11"
V3	#4	4	4	4	4	4	4	4	4	4	7'-4"
V4	#4	4	4	4	4	4	4	4	4	4	5'-7"
V5	#4	4	4	4	4	4	4	4	4	4	3'-10"
V6	#4	4	4	4	4	4	4	4	4	4	2'-11"
W1	#4	12	12	12	12	12	12	12	12	12	4'-0"
W2	#4	8	8	8	8	8	8	8	8	8	3'-2"
W3	#4	8	8	8	8	8	8	8	8	8	3'-4"
W4	#4	8	8	8	8	8	8	8	8	8	3'-0"
W5	#4	8	8	8	8	8	8	8	8	8	2'-8"
W6	#4	8	8	8	8	8	8	8	8	8	2'-0"
W7	#4	8	8	8	8	8	8	8	8	8	2'-0"
Y1	#4	4	4	4	4	4	4	4	4	4	7'-11"
Y2	#4	4	4	4	4	4	4	4	4	4	5'-0"
Y3	#4	4	4	4	4	4	4	4	4	4	7'-11"
Y4	#4	4	4	4	4	4	4	4	4	4	9'-11"
Y5	#4	4	4	4	4	4	4	4	4	4	12'-11"
Y6	#4	4	4	4	4	4	4	4	4	4	12'-11"

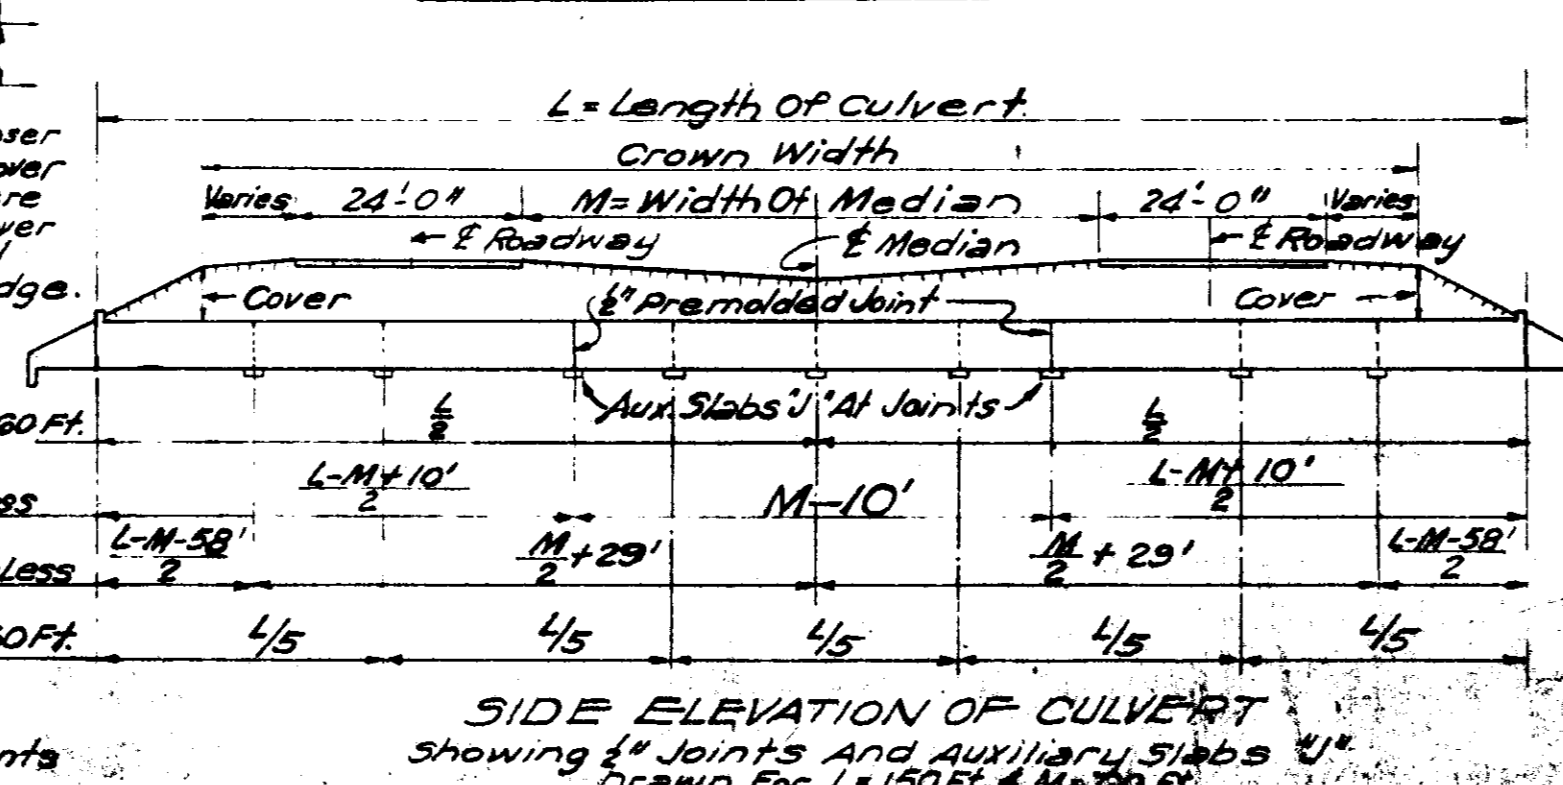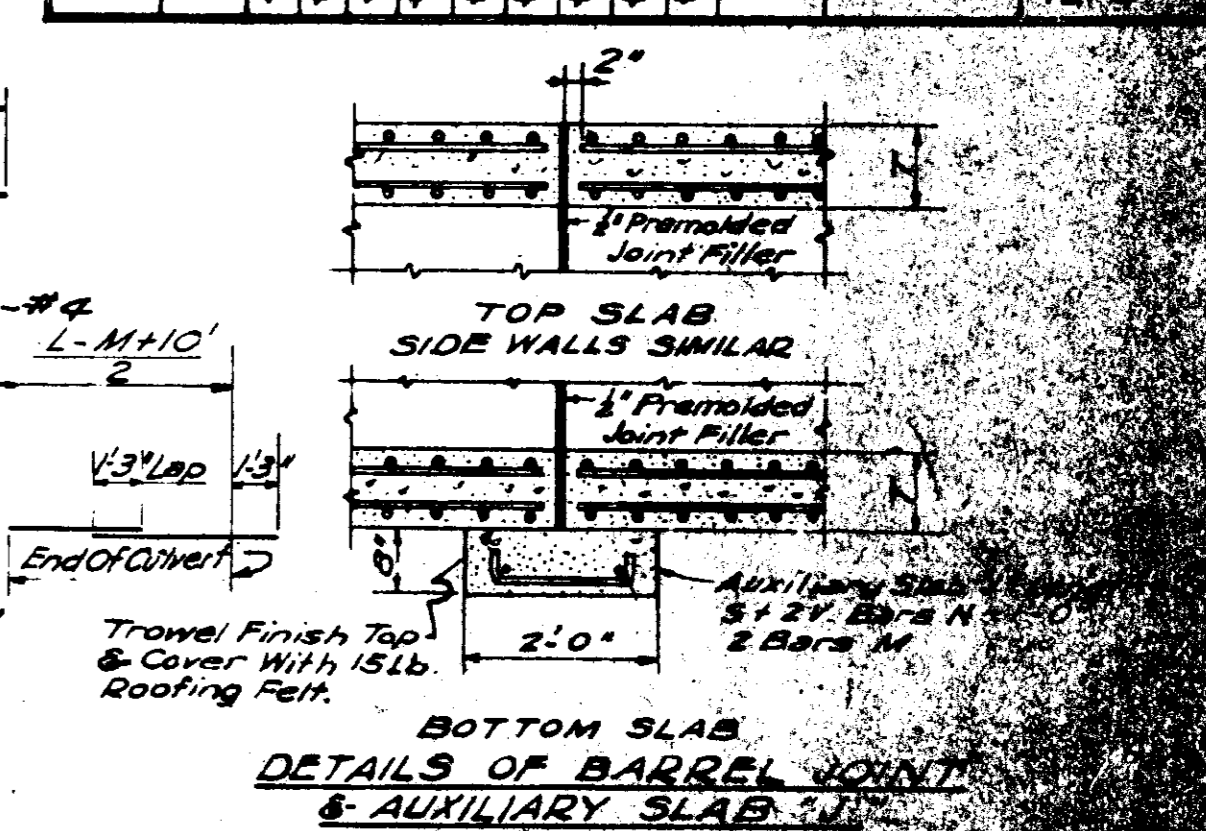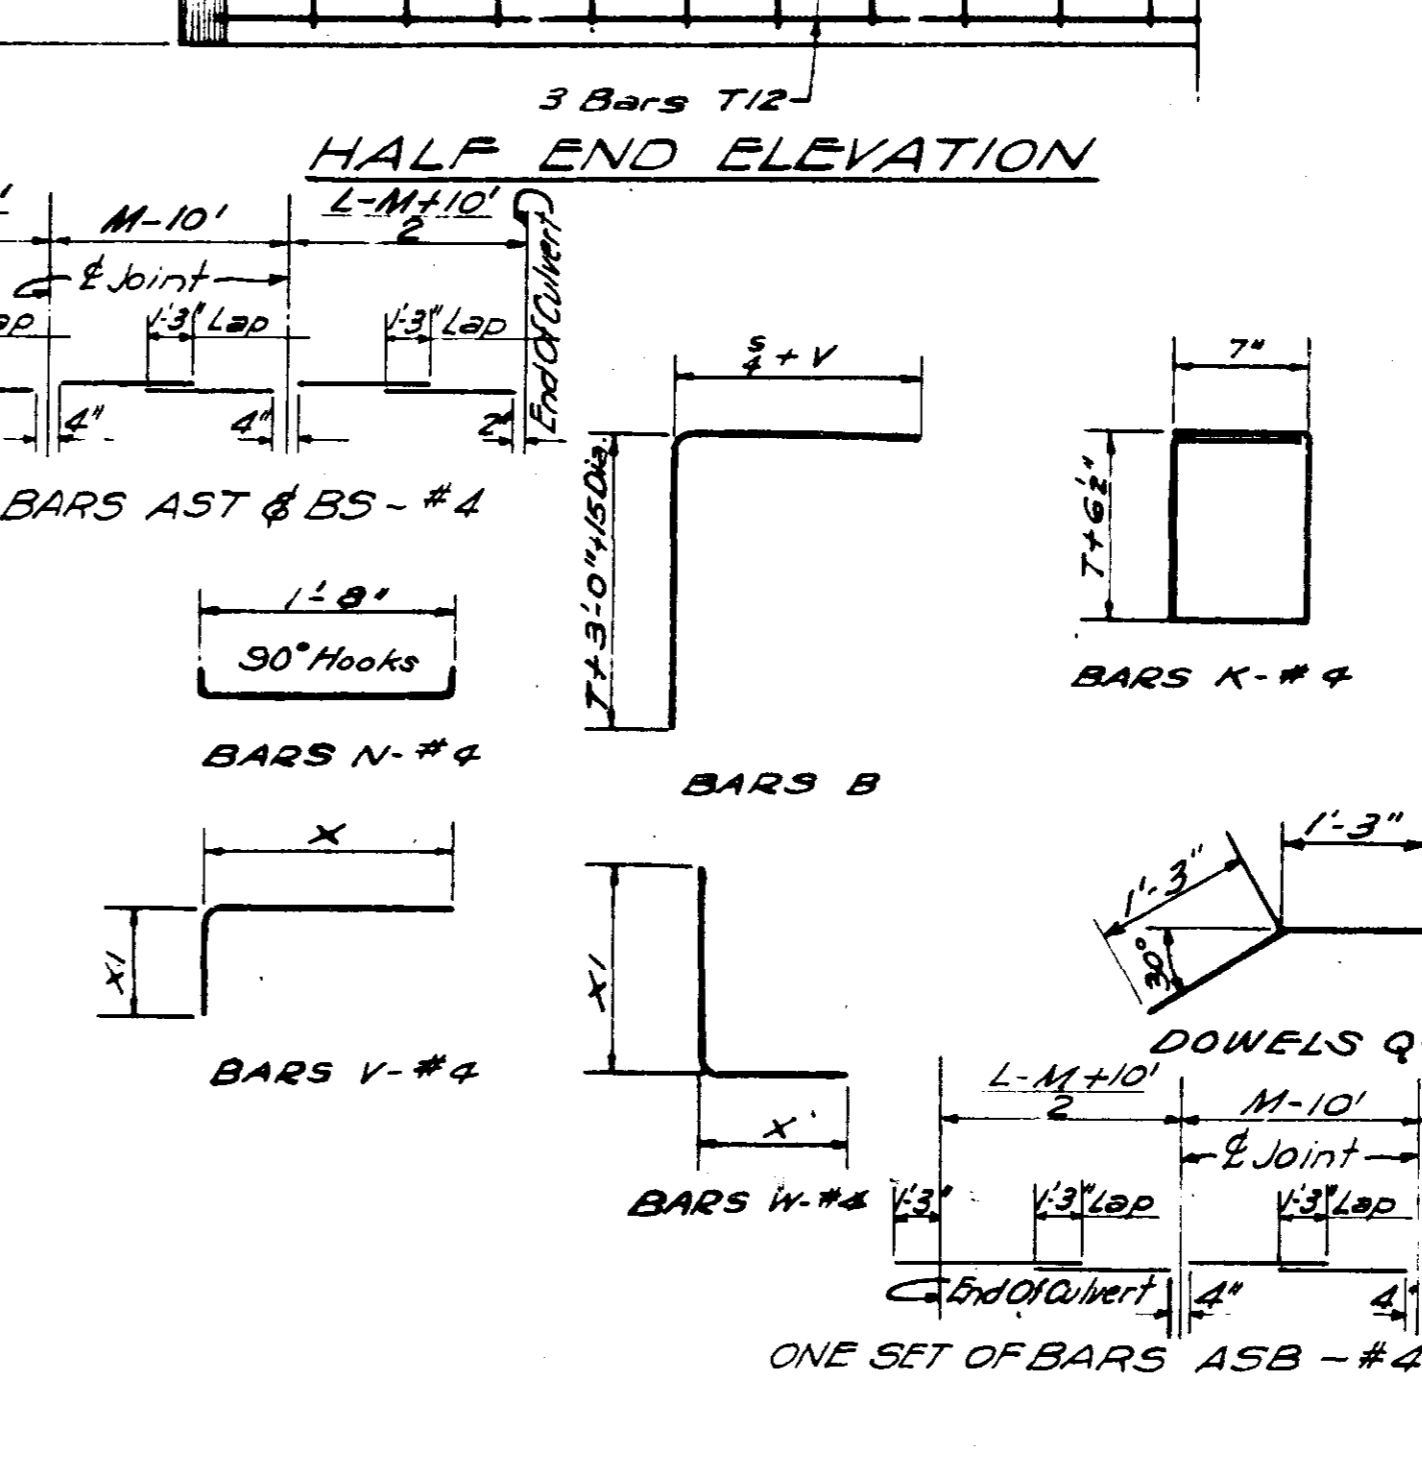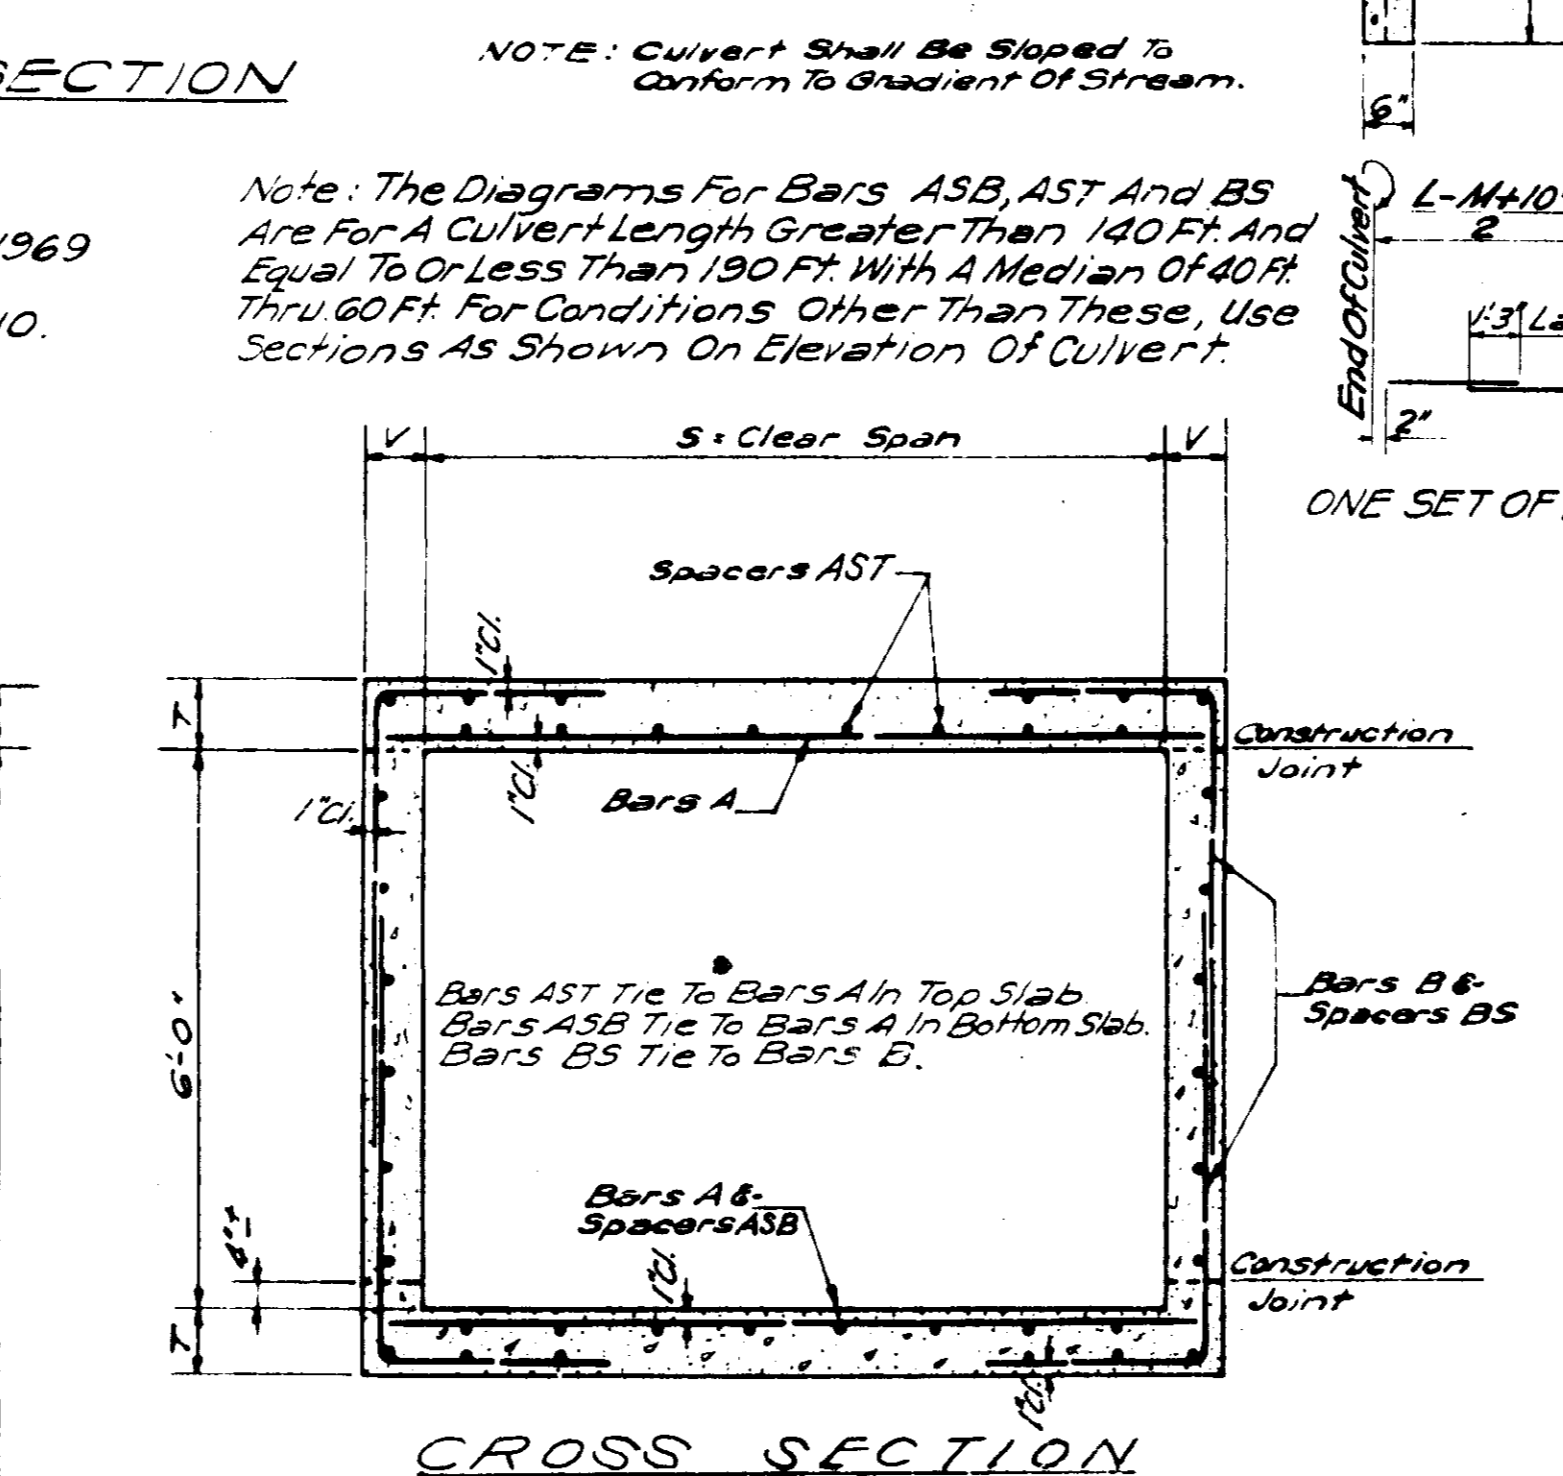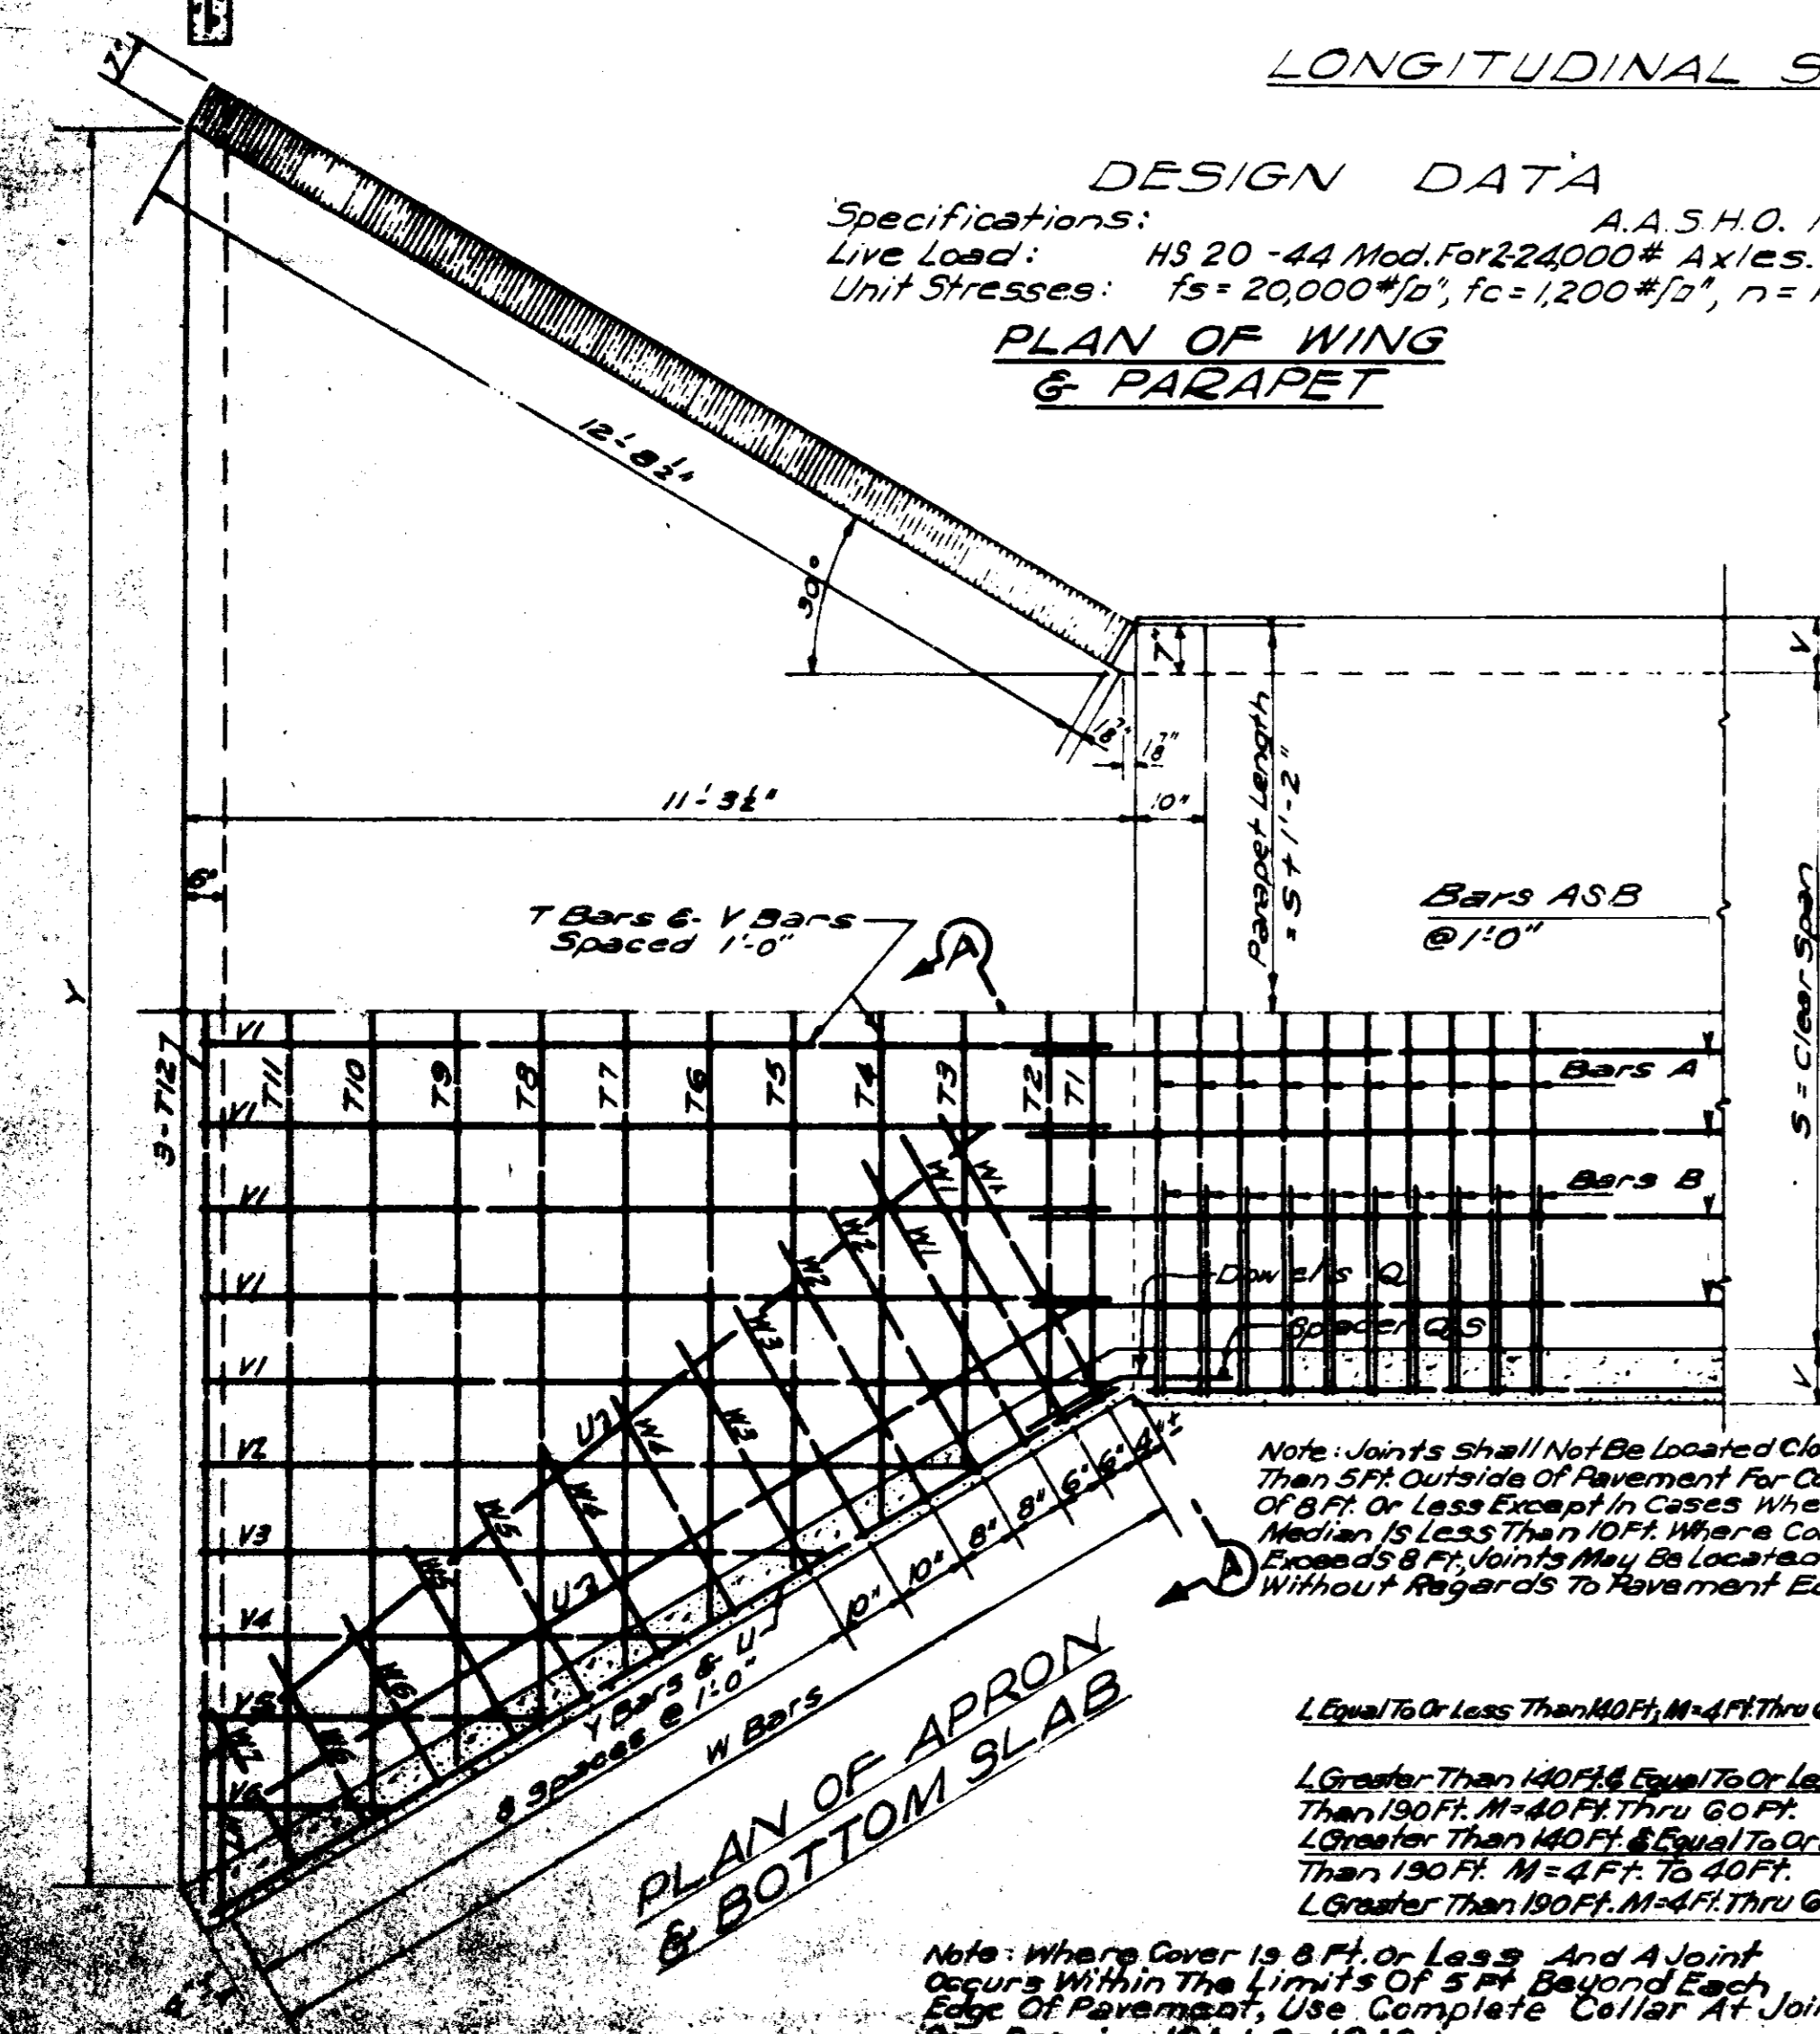

**GENERAL NOTES:**  
 Specifications: Mississippi State Highway Department, All Concrete Shall Be Class "B" For Box Culverts And Class "BB" For Box Bridges.  
 Concrete Shall Be Finished In Accordance With Sub-section 804.24. All Exposed Corners Shall Be Chamfered 3 Inch. Reinforcing Steel Shall Be Placed 1" Clear Minimum From The Surface Of The Concrete And Shall Be Adequately Supported From The Forms.  
 All Bars Shall Be Accurately Spaced And Securely Wired At Each Intersection Before Placing Concrete. Horizontal Construction Joints Shall Be Placed Only At The Locations Shown, And The Concrete Shall Be Allowed To Set A Minimum Period Of 2 Hours Before Continuing The Pour.  
 The Quantities Shown Will Be Used As A Basis For Final Payment Unless This Drawing Is Modified.

MISSISSIPPI STATE HIGHWAY DEPARTMENT  
**BASIC CULVERT DRAWING**  
**SINGLE CELL**  
**HEIGHT**  
**SPANS**