
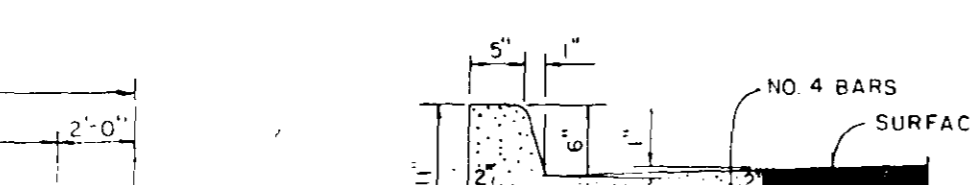
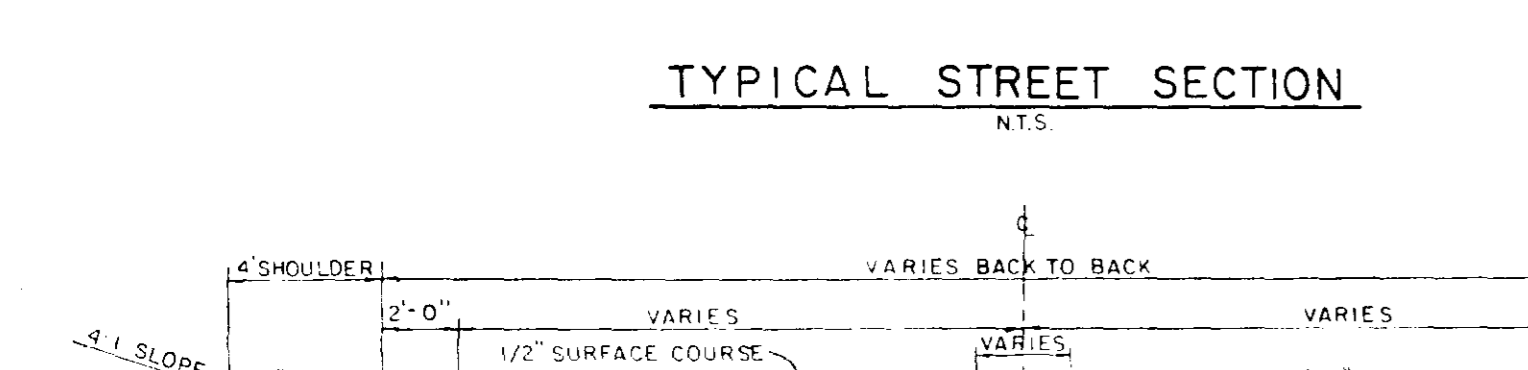
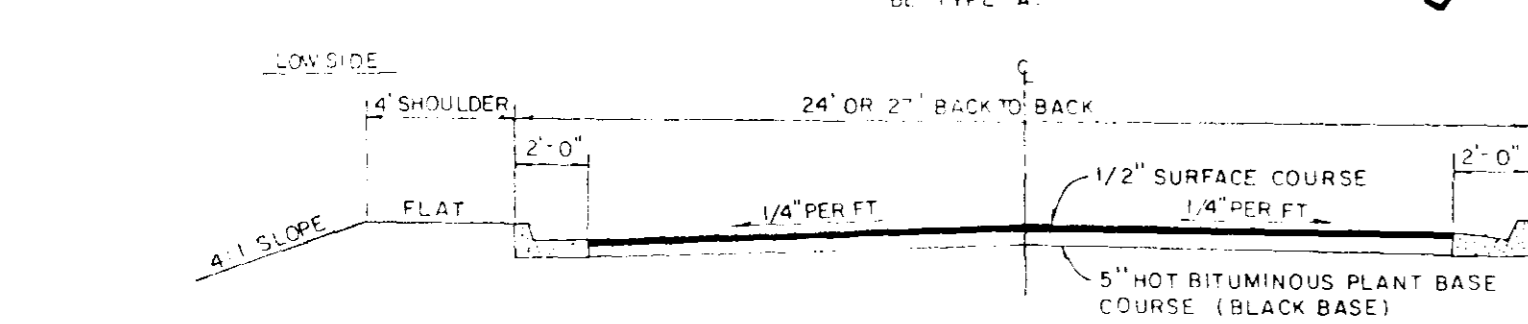
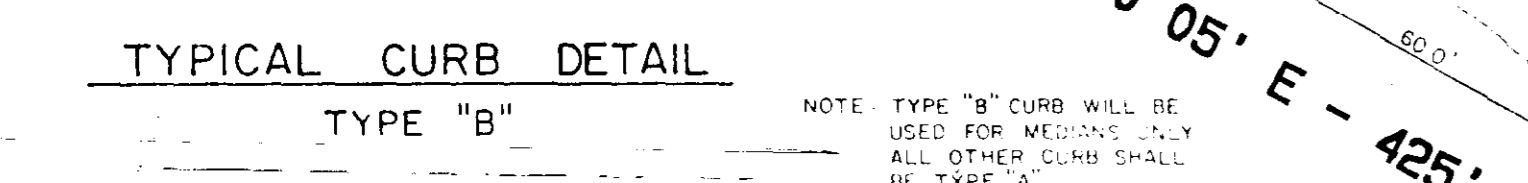


| | | |
|--|---|--|
| 1 A = 05° 53' 27" T = 25.00' R = 299.065' L = 49.887' D = 19.15830' | 2 A = 09° 33' 27" T = 25.00' R = 299.065' L = 49.887' D = 19.15830' | 3 A = 21° 30' 45" T = 25.00' R = 129.544' L = 49.393' D = 23.60955' |
| 4 A = 30° 23' 03" T = 25.00' R = 92.064' L = 81.835' D = 18.04844' | 5 A = 42° 44' 57" T = 25.00' R = 109.682' L = 81.835' D = 52.23608' | 6 A = 78° 56' 20" T = 25.00' R = 94.936' L = 130.864' D = 60.41564' |
| 7 A = 07° 51' 08" T = 20' R = 291.413' L = 39.927' D = 19.66137' | 8 A = 07° 51' 08" T = 20' R = 291.413' L = 39.927' D = 19.66137' | 9 A = 25° 04' 03" T = 40.0' R = 179.927' L = 78.720' D = 31.84380' |
| 10 A = 17° 46' 46" T = 40.0' R = 255.735' L = 78.307' D = 22.40435' | 11 A = 40° 00' 03" T = 17.38' R = 47.742' L = 33.331' D = 120.01126' | 12 A = 40° 00' T = 13.74' R = 37.745' L = 28.291' D = 151.79700' |
| 13 A = 15° 19' 19" T = 15.0' R = 111.514' L = 28.821' D = 51.37970' | 14 A = 08° 18' 12" T = 15.0' R = 206.848' L = 29.947' D = 27.72626' | 15 A = 13° 14' 12" T = 12.0' R = 183.427' L = 23.863' D = 55.39945' |
| 16 A = 10° 07' 10" T = 12.0' R = 125.421' L = 23.937' D = 42.30537' | 17 A = 13° 14' 12" T = 12.0' R = 183.427' L = 23.863' D = 55.39945' | 18 A = 13° 14' 12" T = 12.0' R = 183.427' L = 23.863' D = 55.39945' |

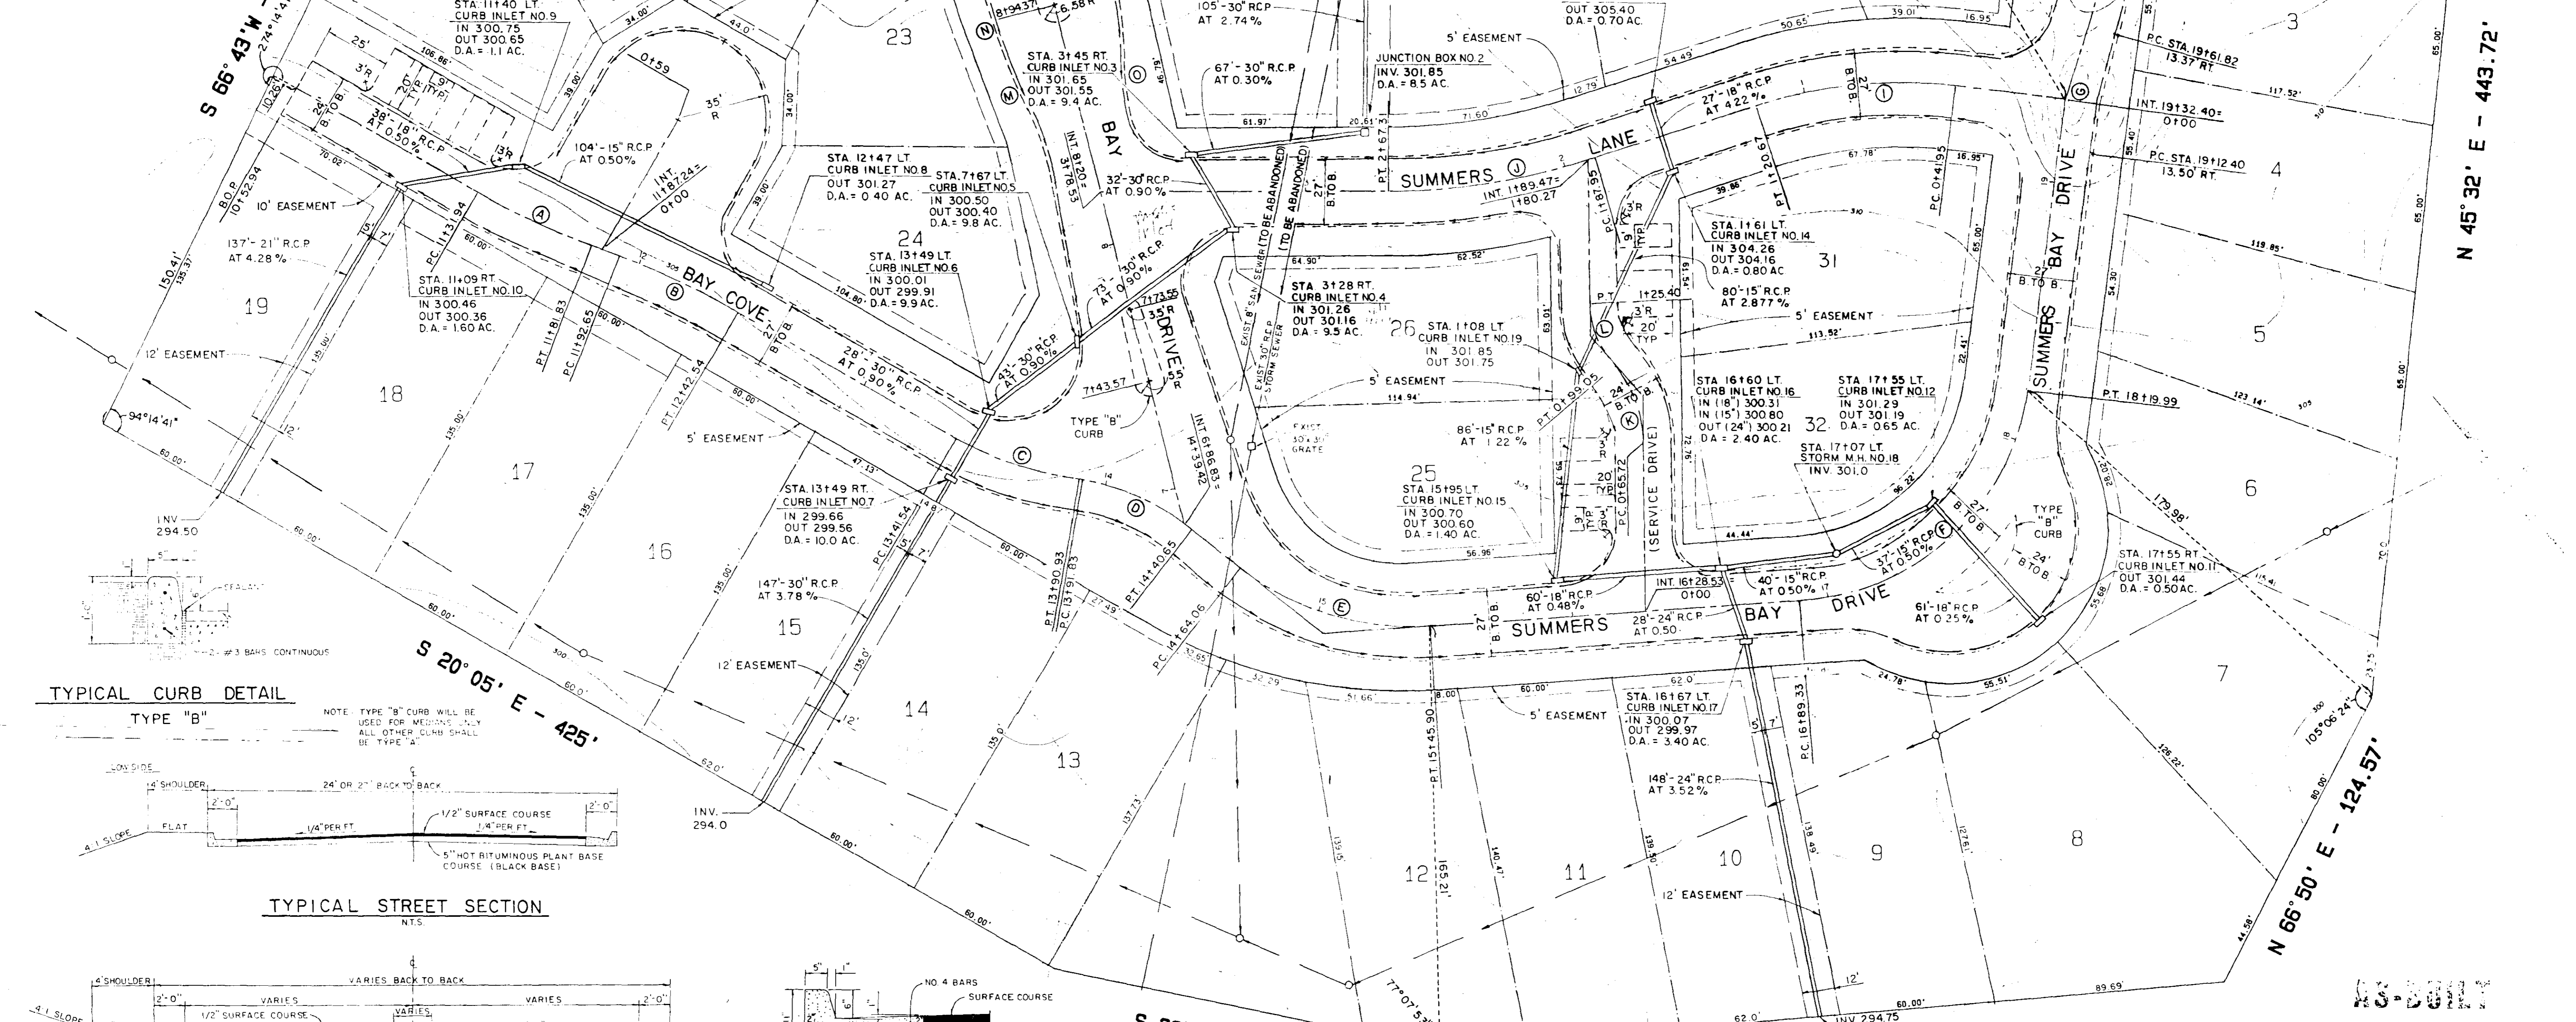

PWP-01943

| | | | | | | | | |
|--------------------|---------------------|----|-------|-------------------|---|-------------------------------------|---|---------------------------|
| DESIGNED J.L.J. | DATE 10-93 | | | | OWNER UNDERWOOD DEVELOPMENT COMPANY | PROJECT TITLE SUMMERS BAY | DRAWING TITLE DRAINAGE & GEOMETRIC LAYOUT | PROJECT NO. 585 |
| DRAWN D.P. | SCALE 1" = 30' | | | | | | | |
| DATE | NATURE OF REVISIONS | BY | APP'D | CHECKED J.L.J. | JOB NO. 002-0585-00 | CONTRACT | SHEET 1 | |